



HCA - LEE'S SUMMIT MEDICAL CENTER ADMINISTRATION RELOCATION

△ 2000 SE BLUE PKWY
LEE'S SUMMIT, MO 64063

DGL PROJECT NO. 6406.24.0001 DATE: 07/18/2025
HCA PROJECT NO. 0972400009
HCA DESIGN MANAGER: MIKAL MALIK
HCA CONSTRUCTION MANAGER: ERIC SJODIN

SUBMITTALS:	DATE:
CITY & STATE - 1 ST - REVIEW	04/18/2025
CITY - 2 ND - REVIEW	05/29/2025
CITY - 3 RD - REVIEW	07/18/2025
DESIGN COORDINATION	07/18/2025

△



Devenney Group Ltd., Architects
6900 E. Camelback Road,
Suite #500
Phoenix, Arizona 85013
T: 602.943.8950
F: 602.943.7645
www.devenneygroup.com

HCA VENDOR INFORMATION

REMAR (TV)
DARRELL LEFTWICH, DLEFTWICH@REMARINC.COM

STORAGE SYSTEMS UNLIMITED (STORAGE)
LANCE MCCORMICK, LMCCORMICK@STORAGESYSTEMSUL.COM

DEVENNEY GROUP, LTD.

ARCHITECTS
ARCHITECTS

6900 E CAMELBACK RD, SUITE #500
SCOTTSDALE, AZ 85251
PROJECT MANAGER: KEVIN COOK

602.541.7287



DATE SIGNED: 07.18.25

WSP

MECHANICAL, PLUMBING & ELECTRICAL ENGINEERS
300 WYANDOTTE, SUITE 200
KANSAS CITY, MO 64105
PROJECT MANAGER: MINDY WHISLER

816.702.4247

INNER DESIGN STUDIO

INTERIOR DESIGNER
7103 BAKER'S BRIDGE AVE, SUITE 106
BRENTWOOD, TN 37027
PROJECT MANAGER: BEVERLY PHILLEY

615.321.0696

NABHOLZ
GENERAL CONTRACTOR

6640 CAROTHERS PARKWAY, STE 150
FRANKLIN, TN 37067
PROJECT EXECUTIVE: JEREMY BRANSON

913.393.6552



Devenney Group Ltd., Architects
 6900 East Camelback Road
 Suite 500
 Scottsdale, AZ 85251
 T: 602.943.8950
 www.devenneygroup.com

Consultant:



DATE SIGNED: 07.18.25

IF THESE PLANS DO NOT BEAR THE SEAL OF A REGISTERED PROFESSIONAL ENGINEER, THEY ARE TO BE CONSIDERED PRELIMINARY AND ARE NOT TO BE USED FOR CONSTRUCTION OR RECORDING. THESE PLANS ARE COPYRIGHTED AND ARE SUBJECT TO COPYRIGHT PROTECTION UNDER THE COPYRIGHT ACT OF 1976 AND AS AMENDED DECEMBER 1996 AND KNOWN AS ARCHITECTURAL WORKS COPYRIGHT PROTECTION ACT OF 1990. THE PROTECTION HELD HEREIN IS NOT LIMITED TO THE OVERALL FORM AS WELL AS THE ARRANGEMENT AND COMPOSITION OF SPACES AND ELEMENTS OF THE DESIGN. UNDER SUCH PROTECTION, UNAUTHORIZED USE OF THESE PLANS CAN LEGALLY RESULT IN THE CEASATION OF CONSTRUCTION OR BUILDINGS BEING SEIZED AND/OR MONETARY COMPENSATION TO DEVENNEY GROUP LTD.

ADMINISTRATION RELOCATION

HCA - LEE'S SUMMIT
MEDICAL CENTER
2000 SE BLUE PKWY
LEE'S SUMMIT, MO 64063

AUTHORITY HAVING JURISDICTION:
 CITY OF LEE'S SUMMIT BUILDING DEPT.
 MISSOURI DHSS

FACILITY NUMBER:
 0972400009

AGENCY APPROVALS:
 AGENCY

REVISIONS		
REV #	DESCRIPTION	DATE
A	CITY - 2ND REVIEW	2025/05/29
B	CITY - 3RD REVIEW	2025/07/18
C	DESIGN COORDINATION	2025/07/18

DATE: 04/18/2025
 SCALE:
 DRAWN: JV
 REVIEWED: MM/DP
 JOB NUMBER: 6406.24


SHEET INDEX

GI001

SHEET INDEX		1ST CITY SUBMITTAL - 04/18/2025	CITY - 2ND REVIEW - 05/29/2025	CITY - 3RD REVIEW - 07/18/2025	DESIGN COORDINATION - 07/18/2025
R = REVISED SHEET					
F = FOR REFERENCE ONLY					
D = DELETED SHEET					
SHEET NUMBER	SHEET NAME				
GENERAL INFORMATION					
GI000	COVER SHEET	X	R	R	R
GI001	SHEET INDEX	X	R	R	R
GI101	PROJECT INFORMATION, AREA MAPS, SYMBOLS	X	R		
ARCHITECTURAL SITE					
AS001	ARCHITECTURAL SITE PLAN	X	R		
ARCHITECTURAL LIFESAFETY					
AC101	LIFE SAFETY FLOOR PLAN - LEVEL 1	X	R	R	
AC501	PARTITION TYPES & DETAILS	X	R		
AC521	TYPICAL MOUNTING HEIGHTS	X	R		
ARCHITECTURAL DEMOLITION					
AD101	DEMOLITION PLAN - LEVEL 1	X	R		
AD171	DEMOLITION RCP - LEVEL 1	X	R		
ARCHITECTURAL					
AE111	DIMENSION FLOOR PLAN - LEVEL 1 - ADMIN	X	R	R	
AE131	ANNOTATION FLOOR PLAN - LEVEL 1 - ADMIN	X	R	R	R
AE181	REFLECTED CEILING PLAN - LEVEL 1 - ADMIN	X	R	R	R
AE601	DOOR SCHEDULES - LEVEL 1 ADMIN	X	R	R	R
AE701	INTERIOR DETAILS	X	R		
AE720	CEILING DETAILS	X	R		
AE740	CASEWORK DETAILS & LEGEND	X	R		
AE741	MILLWORK DETAILS	X	R		
INTERIORS					
AF001	GENERAL FINISH SPECIFICATIONS AND NOTES	X	R		
AF002	GENERAL FINISH SPECIFICATIONS AND NOTES	X	R		
AF101	FINISH FLOOR PLAN - LEVEL 1	X	R	R	
AF103	FLOOR PATTERN PLAN - LEVEL 1	X	R	R	
AF104	FURNITURE PLAN - LEVEL 1	X	R	R	
AF105	SIGNAGE PLAN - LEVEL 1	X	R	R	R
AF106	SIGNAGE KEY	X	R		
AF107	SIGNAGE KEY	X	R		
PLUMBING					
P00-00	GENERAL INFORMATION - PLUMBING	X	R	R	
PD02-00	UNDERFLOOR DEMOLITION PLAN - PLUMBING	X	R		
PD02-01	DEMOLITION PLAN - LEVEL 01 - PLUMBING	X	R		
P02-00	UNDERFLOOR PLAN - PLUMBING	X	R		
P02-01	FLOOR PLAN - LEVEL 01 - PLUMBING	X	R		
P07-01	DETAILS - PLUMBING	X	R		
P08-01	SCHEDULES - PLUMBING	X	R		
MECHANICAL					
M00-00	GENERAL INFORMATION - MECHANICAL	X	R		
M01-01	CONTROLS - MECHANICAL	X	R		
MD02-01	DEMOLITION PLAN - LEVEL 01 - HVAC	X	R		
MD03-01	DEMOLITION PLAN - LEVEL 01 - HVAC PIPING	X	R		
M02-01	FLOOR PLAN - LEVEL 01 - HVAC	X	R		
M03-01	FLOOR PLAN - LEVEL 01 - HVAC PIPING	X	R	R	
M06-01	RISER DIAGRAM - MECHANICAL	X	R		
M07-01	DETAILS - MECHANICAL	X	R		
M07-02	DETAILS - MECHANICAL	X	R		
M08-01	SCHEDULES - MECHANICAL	X	R		
MEP02-03	ATTACHED MOB ROOF PLAN - MEP	X	R		
ELECTRICAL					
E00-00	GENERAL INFORMATION - ELECTRICAL	X	R		
ED02-01	DEMOLITION PLAN - LEVEL 01 ELECTRICAL	X	R	R	
ED2-01	FLOOR PLAN - LEVEL 01 - POWER	X	R		
ED3-01	FLOOR PLAN - LEVEL 01 - LIGHTING	X	R		
ED4-01	FLOOR PLAN - LEVEL 01 - SPECIAL SYSTEMS	X	R		
ED6-01	ONE LINE DIAGRAM - ELECTRICAL	X	R		
ED7-01	DETAILS - ELECTRICAL	X	R		
ED8-01	SCHEDULES - ELECTRICAL	X	R	R	
TECHNOLOGIES					
T00-00	GENERAL INFORMATION - TECHNOLOGY	X	R		
TD02-01	DEMOLITION PLAN - LEVEL 01 - COMMUNICATIONS	X	R	R	
T02-01	FLOOR PLAN - LEVEL 01 - COMMUNICATIONS	X	R		
T03-01	FLOOR PLAN - LEVEL 01 - LOW VOLTAGE	X	R	R	
T04-01	FLOOR PLAN - LEVEL 01 - SECURITY	X	R		
T05-01	ENLARGED PLAN - TECHNOLOGY	X	R		
T06-01	RISER DIAGRAM - TECHNOLOGY	X	R		
T07-01	DETAILS - TECHNOLOGY	X	R		
T07-02	DETAILS - TECHNOLOGY	X	R		
T07-03	DETAILS - TECHNOLOGY	X	R		
T08-01	SCHEDULES - TECHNOLOGY	X	R		
STORAGE SYSTEMS (VENDOR)					
SS-1	STORAGE SYSTEMS LAYOUT	F	R		
SS-2	EQUIPMENT ELEVATIONS	F	R		

Autodesk Docs://6406.24 - HCA - Lee's Summit Medical Center (LSMC) - r123/6406.24.001 LICA - LSMC Admin Relocation.rvt 7/17/2025 9:24:58 AM

Consultant:

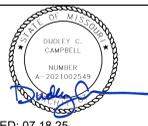

DATE SIGNED: 07.18.25

IF THESE PLANS DO NOT BEAR THE SEAL OF A REGISTERED ARCHITECT, THEY ARE TO BE CONSIDERED PRELIMINARY AND ARE NOT TO BE USED FOR CONSTRUCTION OR RECORDING. THESE PLANS ARE COPYRIGHTED AND ARE SUBJECT TO COPYRIGHT PROTECTION BY ARCHITECTURAL RIGHTS UNDER SEC. 302 OF THE COPYRIGHT ACT, 17 U.S.C. AS AMENDED DECEMBER 1990 AND KNOWN AS ARCHITECTURAL WORKS COPYRIGHT PROTECTION ACT OF 1990. THE PROTECTION HEREIN IS NOT LIMITED TO THE OVERALL FORM AS WELL AS THE ARRANGEMENT AND COMPOSITION OF SPACES AND ELEMENTS OF THE DESIGN. UNDER SUCH PROTECTION, UNAUTHORIZED USE OF THESE PLANS CAN LEGALLY RESULT IN THE CEASATION OF CONSTRUCTION ON BUILDINGS BEING SUEZ AND/OR MONETARY COMPENSATION TO DEVENNEY GROUP LTD.

ADMINISTRATION RELOCATION

HCA - LEE'S SUMMIT
 MEDICAL CENTER
 2000 SE BLUE PKWY
 LEE'S SUMMIT, MO 64063

AUTHORITY HAVING JURISDICTION:
 CITY OF LEE'S SUMMIT BUILDING DEPT.
 MISSOURI DHSS

FACILITY NUMBER:
 0972400009

AGENCY APPROVALS:
 AGENCY

REV #	REVISIONS	DATE
A	CITY - 2ND REVIEW	2025/05/29
B	CITY - 3RD REVIEW	2025/07/18

DATE: 04/18/2025
 SCALE: As indicated
 DRAWN: JV
 REVIEWED: MM/DP
 JOB NUMBER: 6406.24

LIFE SAFETY FLOOR PLAN - LEVEL 1

AC101

MAXIMUM FLOOR AREA ALLOWANCES PER OCCUPANT			
FUNCTION OF SPACE	ID	LOAD FACTOR	COMMENT
ACCESSORY STORAGE AREAS	S	300 SF	GROSS
ASSEMBLY W/O FIXED SEATS - CHAIRS ONLY	AC	7 SF	NET
ASSEMBLY W/O FIXED SEATS - TABLES & CHAIRS (WAITING)	AT	15 SF	NET
BUSINESS AREA (OFFICE)	B	150 SF	GROSS
INSTITUTIONAL - INFANT PATIENT TREATMENT AREA	II	240 SF	GROSS
INSTITUTIONAL - OUTPATIENT AREA	IO	100 SF	GROSS
INSTITUTIONAL - SLEEPING AREA	IS	120 SF	GROSS

ROOM OCCUPANCY - LEVEL 1					
NUMBER	NAME	AREA	OCC ID	LOAD FACTOR	OCC LOAD
1-1335	(E) VESTIBULE	78 SF			
2-2000	WAITING	102 SF	AT	15 SF	7
2-2001	RECEPTION	139 SF	B	150 SF	1
2-2002	CEO OFFICE	198 SF	B	150 SF	2
2-2003	CNO OFFICE	139 SF	B	150 SF	1
2-2004	COO OFFICE	139 SF	B	150 SF	1
2-2005	CFO OFFICE	137 SF	B	150 SF	1
2-2006	CMO OFFICE	132 SF	B	150 SF	1
2-2007	PHYSICIAN PROVIDER RELATIONSHIP OFFICE	106 SF	B	150 SF	1
2-2008	MARKETING OFFICE	106 SF	B	150 SF	1
2-2009	SHARED OFFICE	143 SF	B	150 SF	1
2-2010	CONFERENCE	213 SF	AT	15 SF	15
2-2011	BOARD ROOM	552 SF	AT	15 SF	37
2-2012	COPY/WORK	124 SF	B	150 SF	1
2-2013	STORAGE	46 SF	S	300 SF	1
2-2014	STORAGE	45 SF	S	300 SF	1
2-2015	BREAK/NOURISH	114 SF	B	150 SF	1
2-2016	COMM	75 SF	S	300 SF	1
2-2017	STORAGE	56 SF	S	300 SF	1
2-2018	MEN TLT	51 SF	B	150 SF	1
2-2019	WOMEN TLT	54 SF	B	150 SF	1
					77

LEVEL 1 EXISTING OCCUPANT LOAD AT B OCCUPANCY = 197 OCCUPANTS
 LEVEL 1 ADMINISTRATION OCCUPANT LOAD AT B OCCUPANCY = 77 OCCUPANTS
 274 OCCUPANTS / 4 EXITS = 69 OCCUPANTS PER EXIT

LIFE SAFETY LEGEND

- EXIT
- EXIT ACCESS DOORWAY
- HORIZONTAL EXIT/ SMOKE COMPARTMENT EXIT
- TRAVEL DISTANCE
- INDICATES SMOKE COMPARTMENT SEPARATIONS (NEW PARTITIONS TO BE CONSTRUCTED PER THE PARTITION TYPES & DETAILS SHEETS)
- FIRE EXTINGUISHER CABINET. PROVIDE FIRE EXTINGUISHERS THROUGHOUT THE PROJECT SO THAT OCCUPANTS ARE WITHIN A 75'-0" TRAVEL DISTANCE. REFER TO IFC TABLE 906.3(1)
- SURFACE MOUNTED FIRE EXTINGUISHER
- ILLUMINATED EXIT SIGN

MEANS OF EGRESS GENERAL NOTES

THE FOLLOWING MINIMUM CLEAR WIDTHS OF EGRESS COMPONENTS SHALL BE MET OR EXCEEDED.

COMPONENT	MINIMUM CLEAR WIDTH
DOORS:	
MEANS OF EGRESS	32 INCHES
MEANS OF EGRESS IN I-2 OCCUPANCY USED FOR MOVEMENT OF BEDS	41 1/2 INCHES
STAIRWAYS:	
GENERAL	44 INCHES
AIISLES:	36 INCHES
CORRIDORS, RAMPS, AND EXIT PASSAGEWAYS:	
50 OCCUPANTS OR GREATER	44 INCHES
LESS THAN 50 OCCUPANTS	36 INCHES
WHERE REQUIRED FOR BED MOVEMENT	96 INCHES
OUTPATIENT GURNEY TRAFFIC	72 INCHES

PARTITION LEGEND

EXISTING	NEW	DESCRIPTION
[Pattern]	[Pattern]	NON-RATED PARTITION
[Pattern]	[Pattern]	2-HOUR FIRE BARRIER
[Pattern]	[Pattern]	1-HOUR FIRE BARRIER
[Pattern]	[Pattern]	1-HOUR SMOKE BARRIER
[Pattern]	[Pattern]	SMOKE PARTITION
[Pattern]	[Pattern]	1-HOUR FIRE PARTITION
[Pattern]	[Pattern]	LIMITS OF CONSTRUCTION (SHADE INDICATES AREA OUTSIDE OF SCOPE)

EXIT ACCESS TRAVEL DISTANCE - LEVEL 1


PER IBC 1016.1 THE MAX LENGTH OF EXIT ACCESS TRAVEL SHALL NOT EXCEED 300FT (B OCCUPANCY)

PATH NAME	DISTANCE
A PATH	102'-3"
B PATH	263'-7"

EXIT DOOR SCHEDULE


MINIMUM EGRESS WIDTH REQUIRED IS THE GREATER WIDTH CALCULATED PER IBC SECTION 1005.3 AND 1010.1.1. AND MINIMUM EGRESS WIDTH PROVIDED ASSUMES LEAF THICKNESS OF 2", INCLUDING HINGES

DOOR #	DESCRIPTION	OCC. LOAD	WIDTH REQUIRED	WIDTH PROVIDED
DOOR #2	@ MOB ENT.	76	31 3/4"	36"
DOOR #5	@ REAR	76	31 3/4"	60"

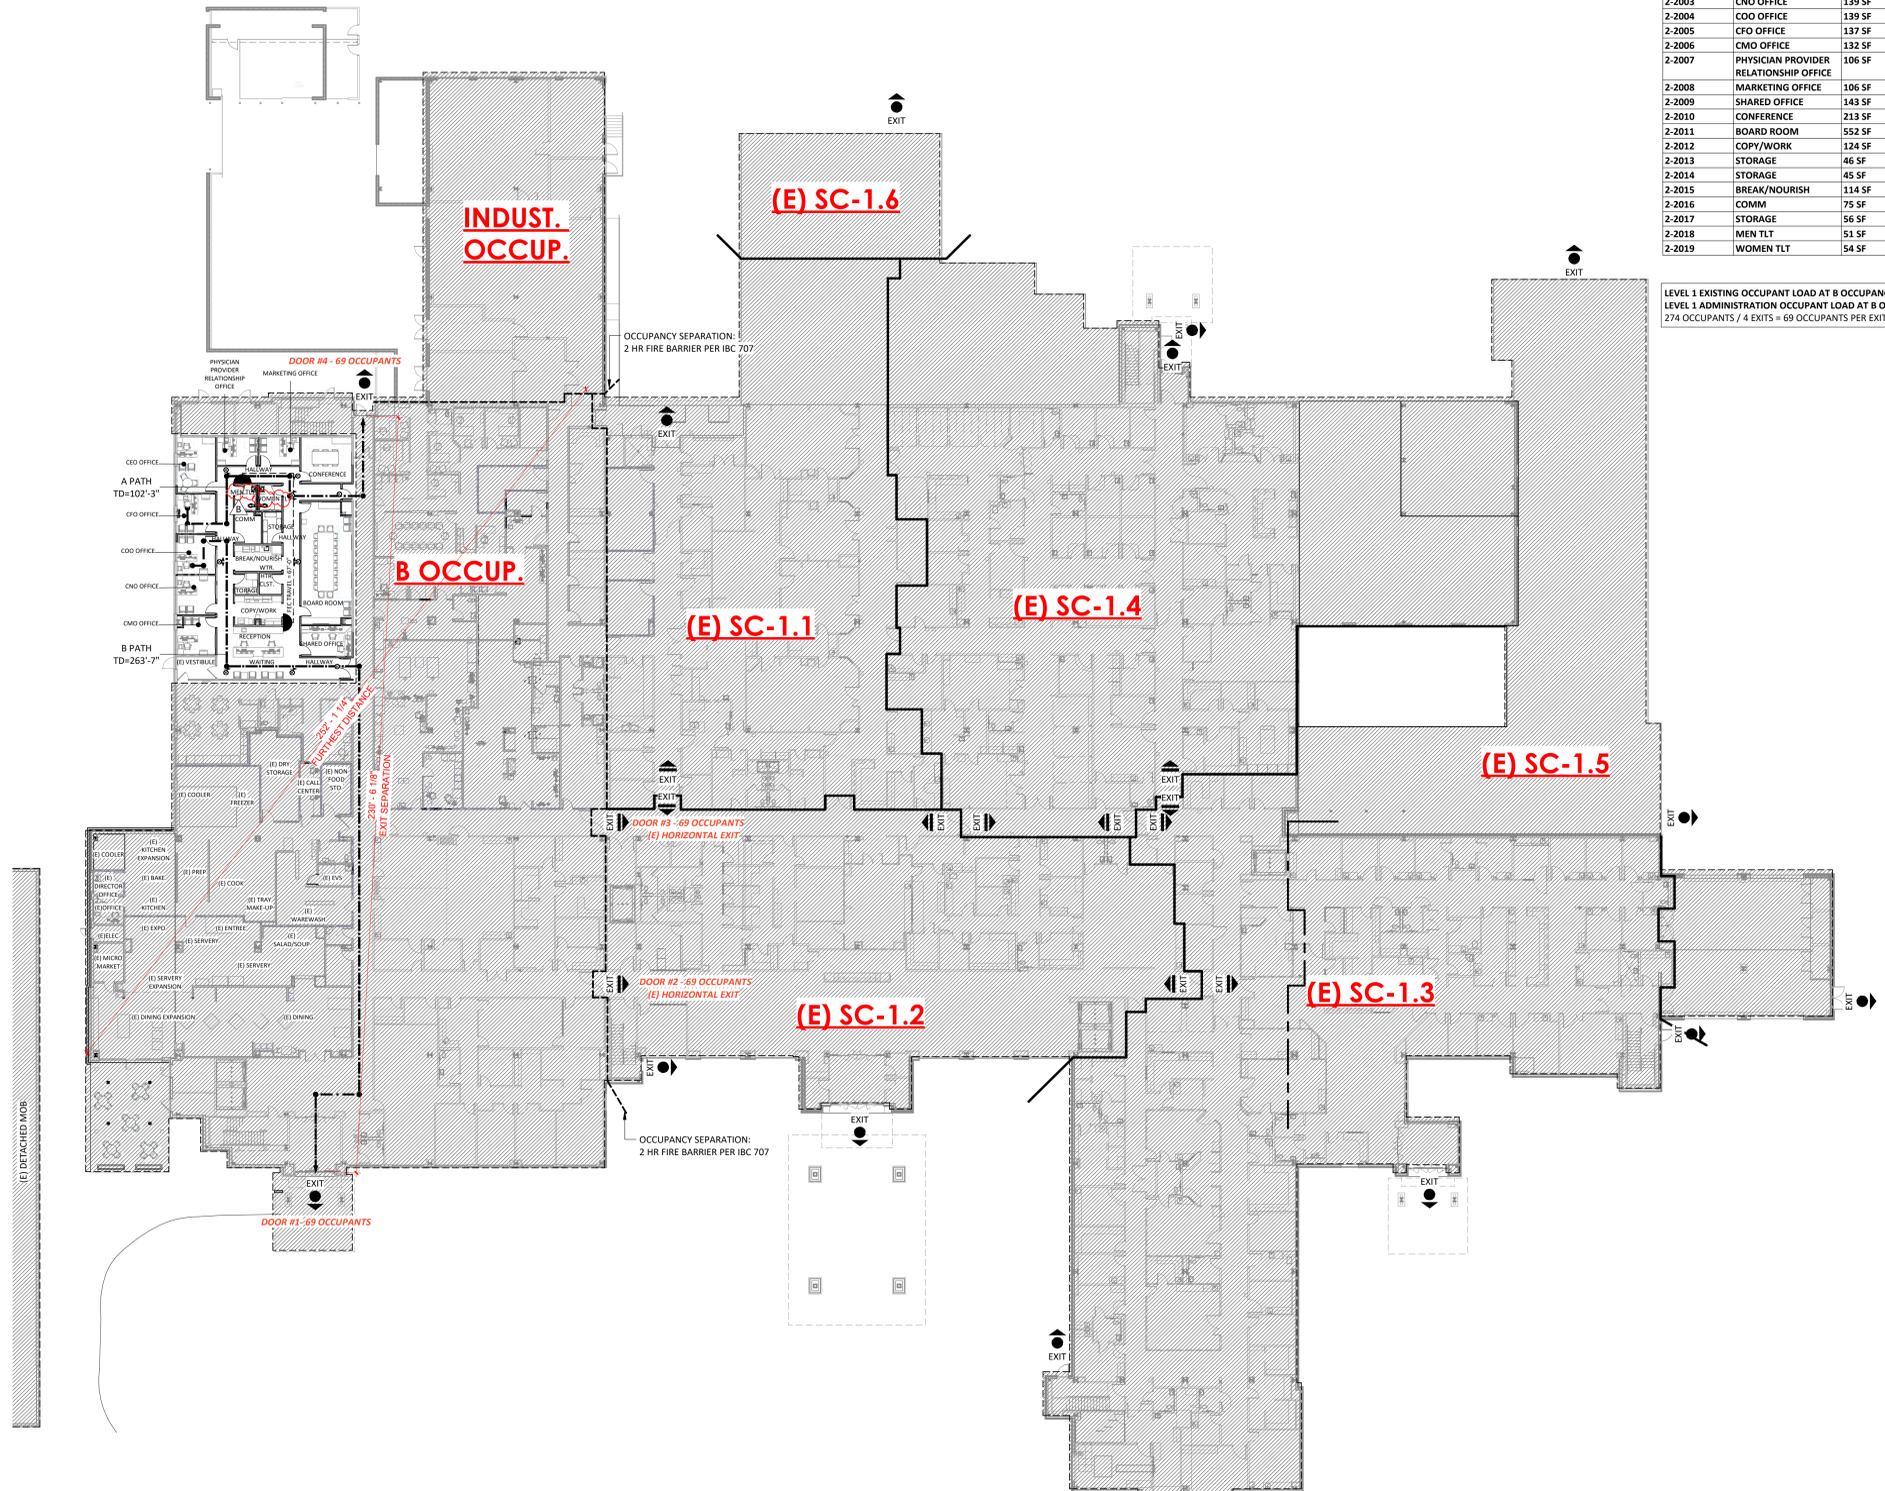

1 LIFE SAFETY FLOOR PLAN - LEVEL 1
 3/64" = 1'-0"

Autodesk Docx/16406.24 - HCA - Lee's Summit Medical Center (LSMC) - r12316406.24.0001 HCA - LSMC Admin Relocation.rvt 7/17/2025 9:24:58 AM

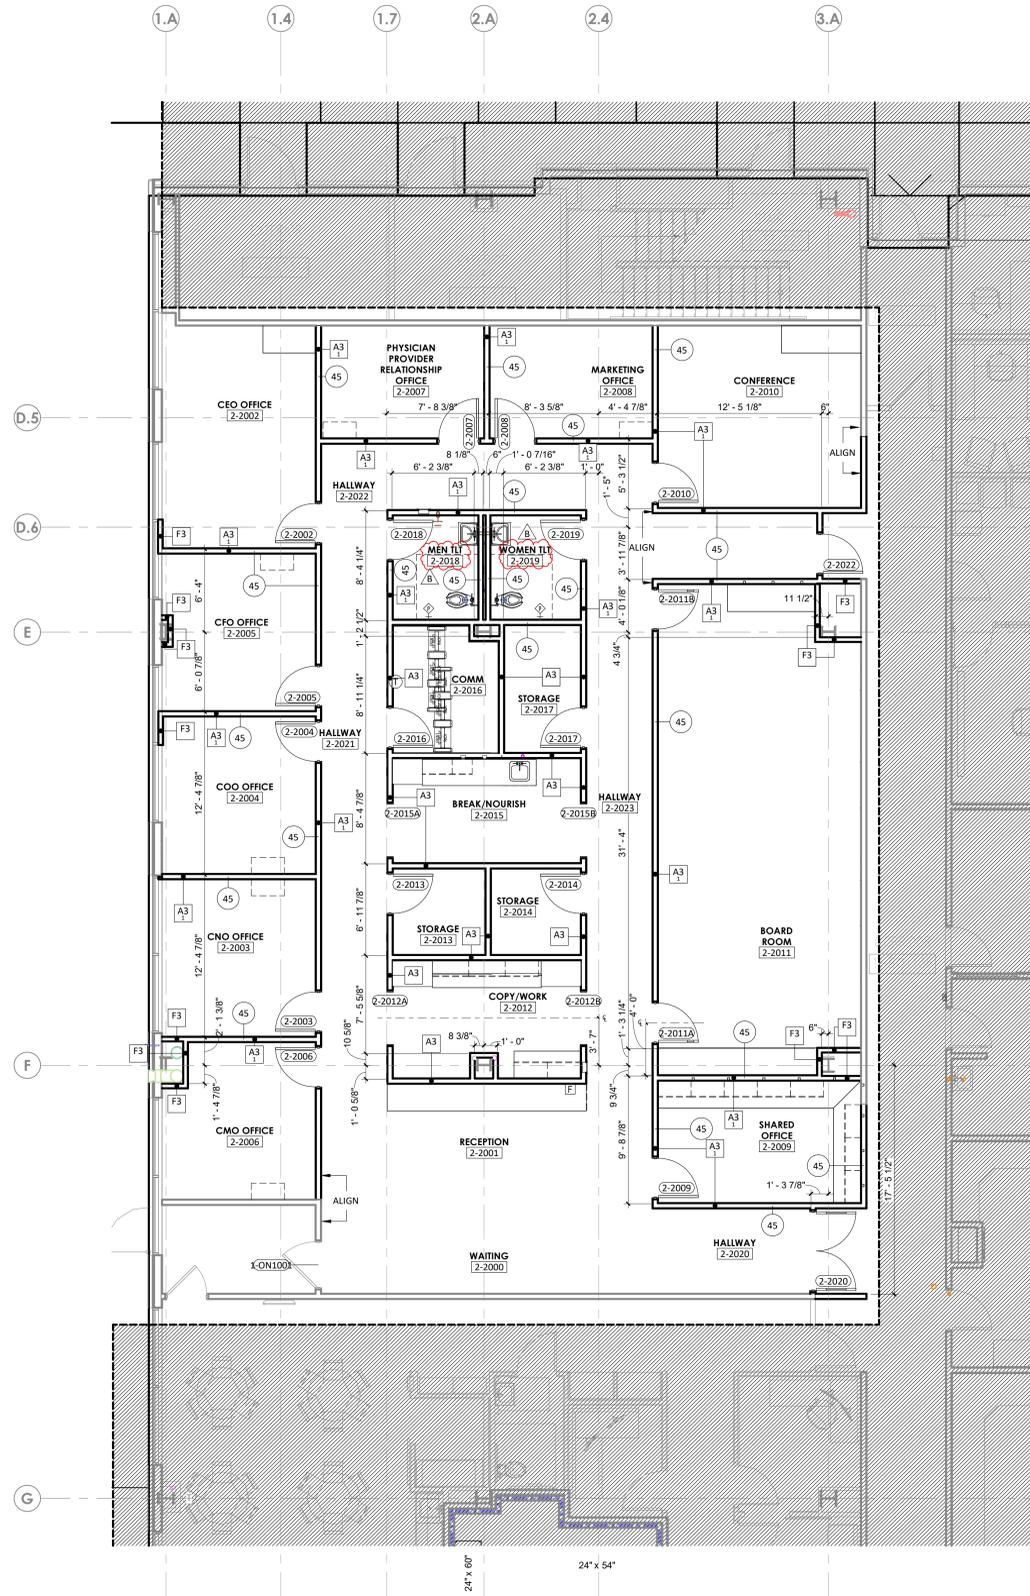

DIMENSION PLANS GENERAL NOTES

1. THE WORD "CLEAR" INDICATES CRITICAL DIMENSIONS FOR ACCESSIBLE EQUIPMENT OR FUNCTIONAL CLEARANCES FROM FACE OF FINISH TO FACE OF FINISH.
2. DIMENSIONS MEASURE FROM THE EXPOSED SURFACE OF EXISTING WALLS, PARTITIONS, COLUMNS, ETC.; NEW PARTITIONS ARE DIMENSIONED TO THE FACE OF THE FRAMING; MEASURE AND VERIFY DIMENSIONS IN FIELD.
3. ALL INFORMATION GRAYED-OUT INDICATES EXISTING OR SCOPE PROVIDED BY OTHERS.
4. WHERE NEW PARTITIONS ADJUT EXISTING PARTITIONS, BUILD NEW PARTITION TIGHT TO FACE OF EXISTING PARTITION U.N.O.

PARTITION LEGEND

EXISTING	NEW	
		NON-RATED PARTITION
		2-HOUR FIRE BARRIER
		1-HOUR FIRE BARRIER
		1-HOUR SMOKE BARRIER
		SMOKE PARTITION
		1-HOUR FIRE PARTITION
		LIMITS OF CONSTRUCTION (SHADE INDICATES AREA OUTSIDE OF SCOPE)

KEYNOTE LEGEND

KEY	NOTE


STC PARTITION RATINGS (#)

DESIGN CRITERIA FOR MIN. SOUND ISOLATION PERFORMANCE BETWEEN ENCLOSED ROOMS ¹		
TOILET ROOM	PUBLIC SPACE	45
OFFICE	ADJACENT ROOM	45

- NOTES:
- REFER TO SPECIFICATIONS FOR GYP BD REQUIREMENTS AT STC >40 CONDITIONS.
1. THE STC VALUES STATED ASSUME THE NEED FOR NORMAL SPEECH PRIVACY AS PER FGI 2018 TABLE 1.2.7 - EXCEPT AT CORRIDOR WALLS WITH DOORS - ASSUMING A BACKGROUND SOUND LEVEL OF AT LEAST 30DBA. WHEN SELECTING ASSEMBLIES BASED ON THEIR TESTED OR PUBLISHED STC RATINGS, IT SHOULD BE NOTED THAT LABORATORY STC TEST REPORTS CAN, IN GENERAL, BE CONSIDERED ACCURATE TO +/- 2 STC POINTS. CONSEQUENTLY, AN ASSEMBLY WITH A TESTED OR PUBLISHED STC RATING AS LOW AS 2 POINTS BELOW THE STATED MINIMUM MAY BE CONSIDERED ACCEPTABLE.
 2. STC 45 RATING AT OFFICE PROVIDED FOR CONVENIENCE, NOT CODE REQUIRED.
 3. THIS IS THE PERFORMANCE REQUIRED FOR THE WALL AROUND THE DOOR. NOTE THAT SOUND ISOLATION IN THESE INSTANCES WILL BE LIMITED BY THE DOORS PERFORMANCE (E.G., STC 20 FOR A CLOSE-FITTED 5-PST DOOR). IT IS UP TO THE FACILITY TO DETERMINE IF DOORS REQUIRE A HIGHER ACOUSTIC PERFORMANCE OR IF FULL PERIMETER GASKETING AND BOTTOM SEALS SHOULD BE REQUIRED. DOORS ARE NOT REQUIRED TO BE SOUND SEALED TO MAINTAIN THE STC RATING, ALTHOUGH A FACILITY MAY CHOOSE TO DO SO FOR SPECIALTY PATIENT ENVIRONMENTS SUCH AS BEREAVEMENT ROOMS, CONSULTATION ROOMS, SLEEP THERAPY ROOMS, ETC.
 4. RELAXATION OF STC 60 RATINGS SHALL BE PERMITTED IF COMPLIANCE WITH ROOM NOISE REQUIREMENTS IS ACHIEVED WITH LOWER PERFORMANCE CONSTRUCTIONS SEE FGI 2018 TABLE 1.2.5
 5. ELECTRONIC MASKING SHALL PROVIDE A MAXIMUM BACKGROUND LEVEL OF 48 DBA

STC GENERAL NOTES

1. NOT ALL ADJACENCIES LISTED IN STC PARTITION RATINGS LEGEND MAY OCCUR IN THIS PROJECT.
2. IN PARTITIONS WITH AND STC RATING OF 44 OR GREATER PROVIDE ACOUSTICAL PUTTY PADS AT ELECTRICAL ROUGH-IN BOXES THAT ARE BACK-TO-BACK CONFIGURATION OR WHERE ELECTRICAL BOX SEPARATION DISTANCES IS LESS THAN 24"
3. PENETRATIONS THROUGH FULL HEIGHT STC PARTITIONS SHOULD BE CENTERED IN OPENING AND SEALED AIRTIGHT.
4. CALBE TRAY PENETRATIONS IN STC PARTITIONS SHOULD BE PACKED TIGHTLY WITH HEAVY DENSITY PUTTY.

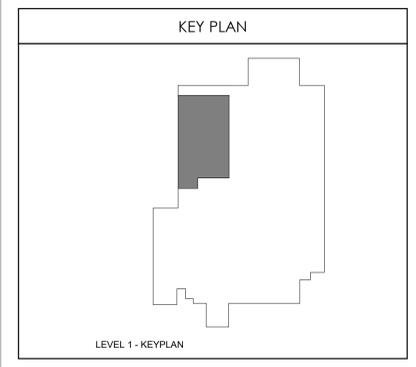

Devenney Group Ltd., Architects
 6900 East Camelback Road
 Suite 500
 Scottsdale, AZ 85251
 T: 602.943.8950
 www.devenneygroup.com

Consultant:

DATE SIGNED: 07.18.25

IF THESE PLANS DO NOT BEAR THE SEAL OF A REGISTERED ARCHITECT, THEY ARE TO BE CONSIDERED PRELIMINARY AND ARE NOT TO BE USED FOR CONSTRUCTION OR RECORDING. THESE PLANS ARE COPYRIGHTED AND ARE SUBJECT TO COPYRIGHT PROTECTION BY ARCHITECTURAL WORKS UNDER SEC. 108 OF THE COPYRIGHT ACT, 17 U.S.C. AS AMENDED DECEMBER 1990 AND KNOWN AS ARCHITECTURAL WORKS COPYRIGHT PROTECTION ACT OF 1990. THE PROTECTION HEREON IS NOT LIMITED TO THE OVERALL FORM AS WELL AS THE ARRANGEMENT AND COMPOSITION OF SPACES AND ELEMENTS OF THE DESIGN. UNDER SUCH PROTECTION, UNAUTHORIZED USE OF THESE PLANS CAN LEGALLY RESULT IN THE CESSION OF CONSTRUCTION OR BUILDINGS BEING SEIZED AND/OR MONETARY COMPENSATION TO DEVENNEY GROUP LTD.

ADMINISTRATION RELOCATION

HCA - LEE'S SUMMIT MEDICAL CENTER
 2000 SE BLUE PKWY
 LEE'S SUMMIT, MO 64063

AUTHORITY HAVING JURISDICTION:
 CITY OF LEE'S SUMMIT BUILDING DEPT.
 MISSOURI DHSS

FACILITY NUMBER:
 097240009

AGENCY APPROVALS:
 AGENCY

REVISIONS		
REV #	DESCRIPTION	DATE
A	CITY - 2ND REVIEW	2025/05/29
B	CITY - 3RD REVIEW	2025/07/18

DATE: 04/18/2025
 SCALE: 3/16" = 1'-0"
 DRAWN: JV
 REVIEWED: MM/DP
 JOB NUMBER: 6406.24

DIMENSION FLOOR PLAN - LEVEL 1 - ADMIN

AE111

Autodesk Docs://6406.24 - HCA - Lee's Summit Medical Center (LSMC) - r123/6406.24.001 LICA - LSMC Admin Relocation.rvt 7/17/2025 9:20:44 AM

Consultant:

DATE SIGNED: 07.18.25

IF THESE PLANS DO NOT BEAR THE SEAL OF A REGISTERED ARCHITECT, THEY ARE TO BE CONSIDERED "PRELIMINARY" AND ARE NOT TO BE USED FOR CONSTRUCTION OR RECORDING. THESE PLANS ARE COPYRIGHTED AND ARE SUBJECT TO COPYRIGHT PROTECTION BY ARCHITECTURAL RIGHTS UNDER THE COPYRIGHT ACT OF 1976, AS AMENDED DECEMBER 1990 AND KNOWN AS ARCHITECTURAL WORKS COPYRIGHT PROTECTION ACT OF 1990. THE PROTECTION HEREIN IS NOT LIMITED TO THE OVERALL FORM AS WELL AS THE ARRANGEMENT AND COMPOSITION OF SPACES AND ELEMENTS OF THE DESIGN. UNDER SUCH PROTECTION, UNAUTHORIZED USE OF THESE PLANS CAN LEGALLY RESULT IN THE CEASATION OF CONSTRUCTION OF BUILDINGS BEING SIZED AND/OR MONETARILY COMPENSATION TO DEVENNEY GROUP LTD.

ADMINISTRATION RELOCATION

HCA - LEE'S SUMMIT MEDICAL CENTER
 2000 SE BLUE PKWY
 LEE'S SUMMIT, MO 64063

AUTHORITY HAVING JURISDICTION:
 CITY OF LEE'S SUMMIT BUILDING DEPT.
 MISSOURI DHSS

FACILITY NUMBER:
 0972400009

AGENCY APPROVALS:
 AGENCY

REV #	REVISIONS	DATE
A	CITY - 2ND REVIEW	2025/05/29
B	CITY - 3RD REVIEW	2025/07/18
C	DESIGN COORDINATION	2025/07/18

DATE: 04/18/2025
 SCALE: As indicated
 DRAWN: JV
 REVIEWED: MM/DP
 JOB NUMBER: 6406.24

ANNOTATION FLOOR PLAN - LEVEL 1 - ADMIN

AE131

ANNOTATION PLAN GENERAL NOTES

- THE WORD "CLEAR" INDICATES CRITICAL DIMENSIONS FOR ACCESSIBLE EQUIPMENT OR FUNCTIONAL CLEARANCES FROM FACE OF FINISH TO FACE OF FINISH.
- DIMENSIONS MEASURE FROM THE EXPOSED SURFACE OF EXISTING WALLS, PARTITIONS, COLUMNS, ETC.; NEW PARTITIONS ARE DIMENSIONED TO THE FACE OF THE FRAMING; MEASURE AND VERIFY DIMENSIONS IN FIELD.
- ALL INFORMATION GRAYED-OUT INDICATES EXISTING.
- GRAY DASHED INDICATES OWNER FURNISHED/OWNER INSTALLED FURNITURE/EQUIPMENT.





INTERIOR ELEVATIONS GENERAL NOTES

- PROVIDE CONTINUOUS BACKING FOR SURFACE MOUNTED EQUIPMENT, MILLWORK, AND ACCESSORIES.
- LOCATE MILLWORK GROMMETS IN FIELD PER OWNER.
- EXPOSED MILLWORK SURFACES SHALL BE FINISHED.
- MOUNT EQUIPMENT, FIXTURES, AND ACCESSORIES ACCORDING TO THE TYPICAL MOUNTING HEIGHTS SHEET, UNLESS NOTED OTHERWISE.
- PROVIDE WATER RESISTANT GYPSUM BOARD AT WET WALL CONDITIONS.
- PROVIDE COUNTERTOP SUPPORTS AT OPEN KNEESPACE LOCATION. INSTALL AT 32" ON CENTER MAXIMUM.


PARTITION LEGEND

EXISTING	NEW	NON-RATED PARTITION
[Pattern]	[Pattern]	2-HOUR FIRE BARRIER
[Pattern]	[Pattern]	1-HOUR FIRE BARRIER
[Pattern]	[Pattern]	1-HOUR SMOKE BARRIER
[Pattern]	[Pattern]	SMOKE PARTITION
[Pattern]	[Pattern]	1-HOUR FIRE PARTITION


LIMITS OF CONSTRUCTION (SHADE INDICATES AREA OUTSIDE OF SCOPE)

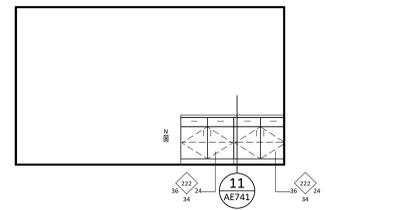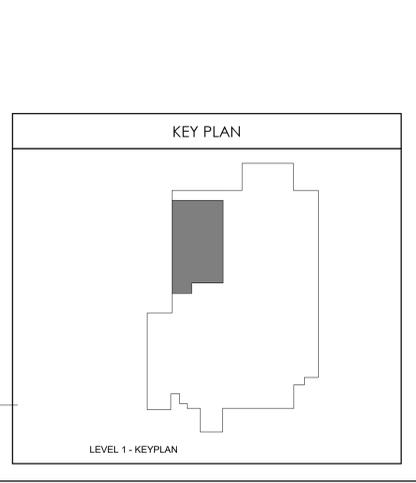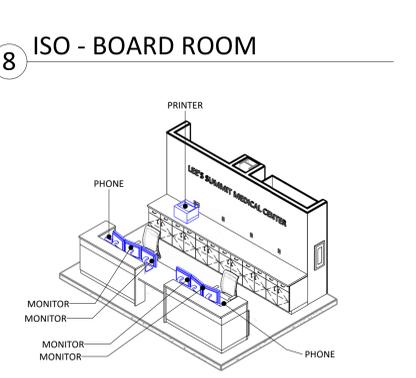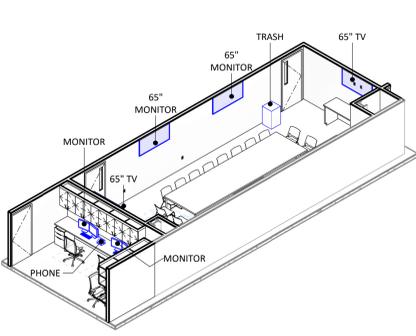


3 CONFERENCE A
 1/4" = 1'-0"

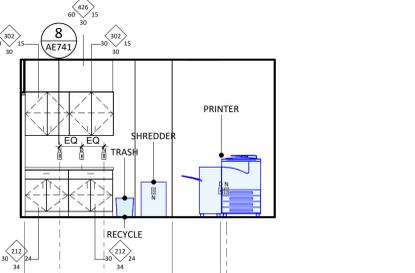


5 COPY/WORK C
 1/4" = 1'-0"

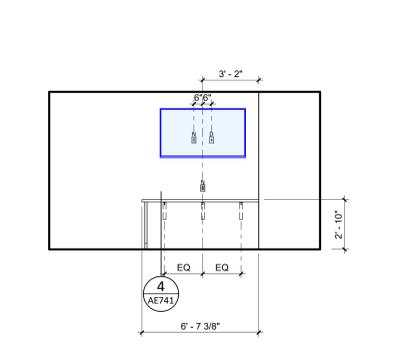


7 BOARD ROOM B
 1/4" = 1'-0"

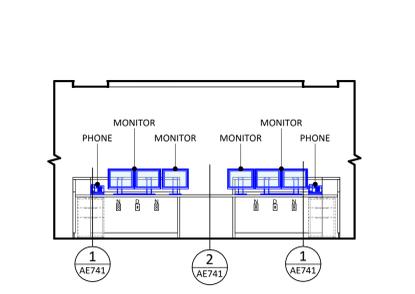


10 ADMIN - RECEPTION C
 1/4" = 1'-0"

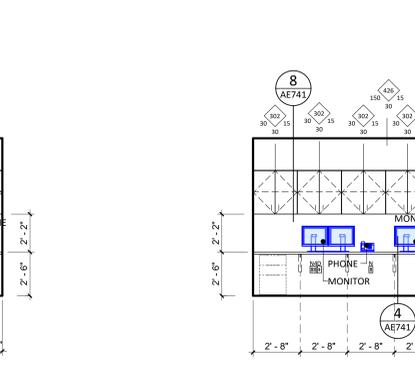


14 ADMIN - SHARED OFFICE A
 1/4" = 1'-0"

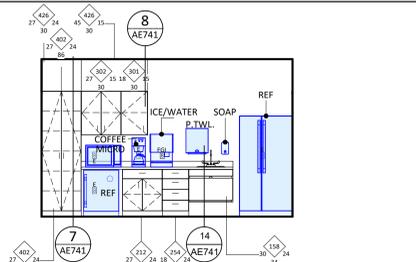


2 BREAK/NOURISH
 1/4" = 1'-0"

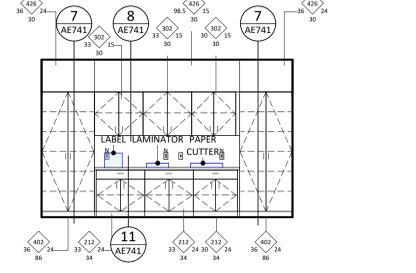


4 COPY/WORK A
 1/4" = 1'-0"

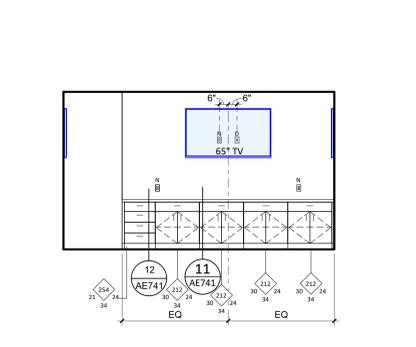

6 BOARD ROOM A
 1/4" = 1'-0"

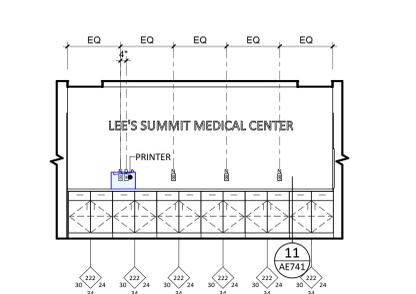


9 ADMIN - RECEPTION - A
 1/4" = 1'-0"

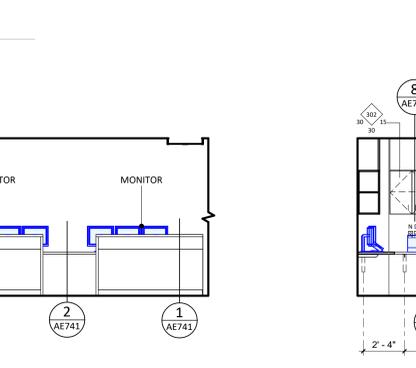


12 ADMIN - RECEPTION A1
 1/4" = 1'-0"

13 ADMIN - SHARED OFFICE B
 1/4" = 1'-0"

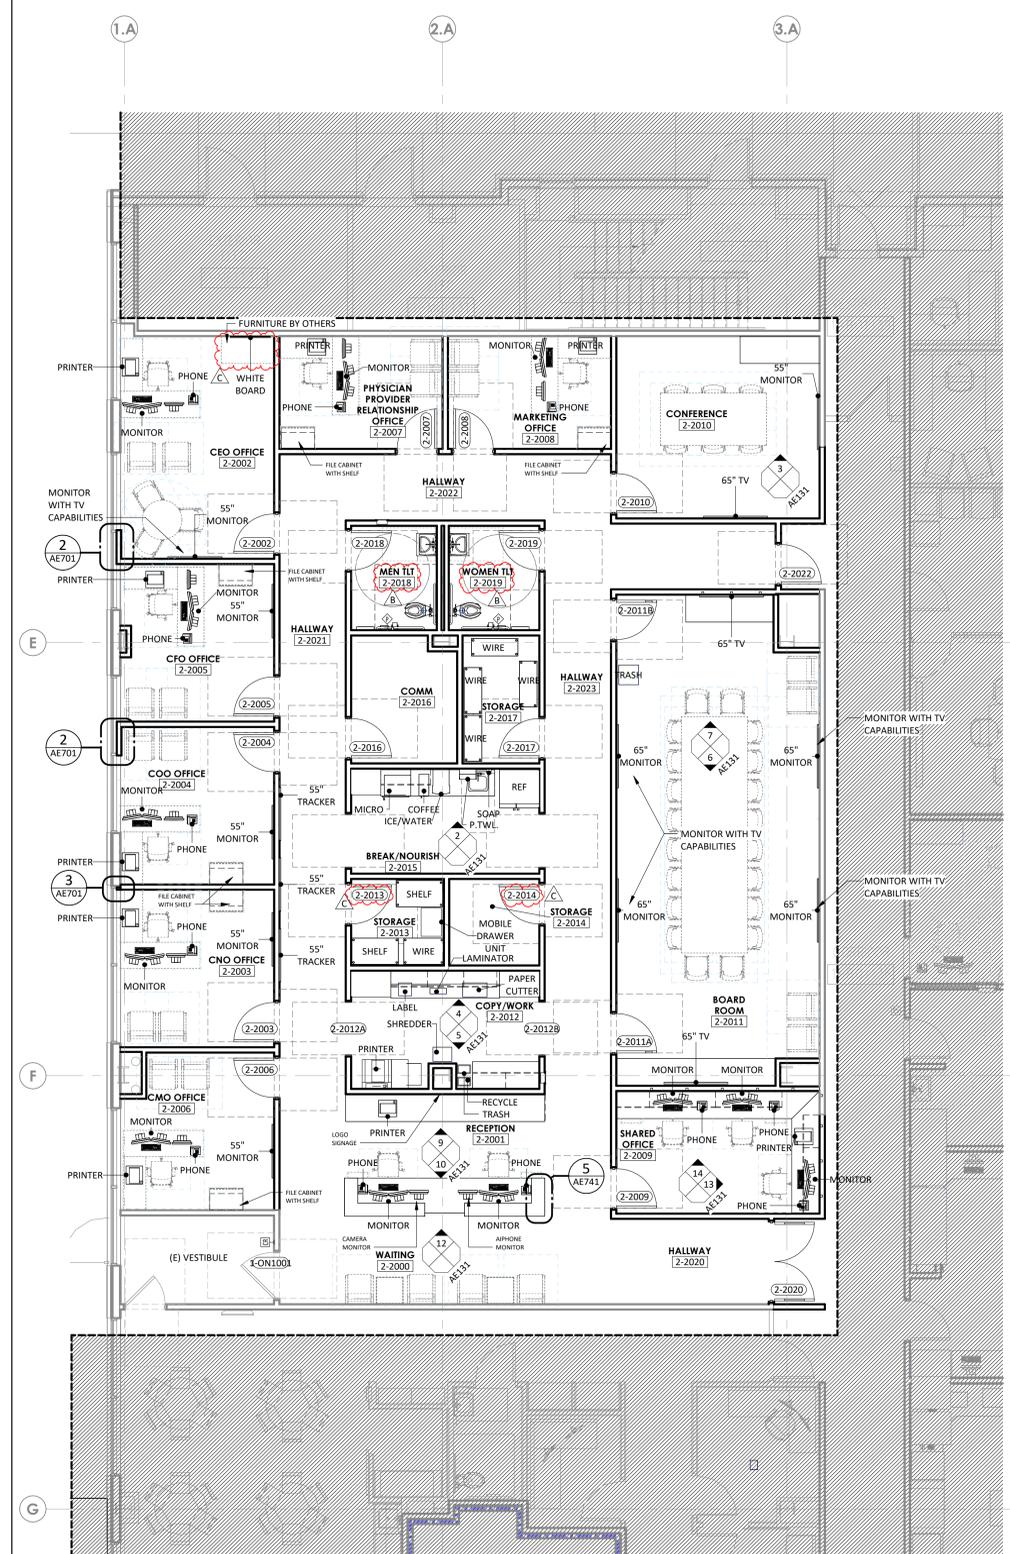

1 ANNOTATION PLAN - ENLARGED - LEVEL 1 - ADMIN
 3/16" = 1'-0"

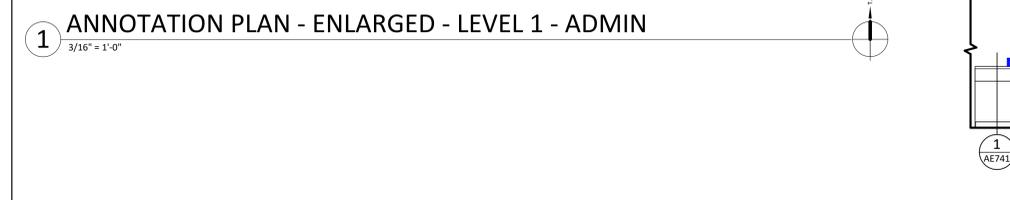

12 ADMIN - RECEPTION A1
 1/4" = 1'-0"

13 ADMIN - SHARED OFFICE B
 1/4" = 1'-0"

14 ADMIN - SHARED OFFICE A
 1/4" = 1'-0"

7/17/2025 9:25:30 AM Autodesk Docs://6406.24 - HCA - Lee's Summit Medical Center (LSMC) - r12316406.24.001 L1CA - LSMC Admin Relocation.rvt

Consultant:



DATE SIGNED: 07.18.25

IF THESE PLANS DO NOT BEAR THE SEAL OF A REGISTERED ARCHITECT, THEY ARE TO BE CONSIDERED "PRELIMINARY" AND ARE NOT TO BE USED FOR CONSTRUCTION OR RECORDING. THESE PLANS ARE COPYRIGHTED AND ARE SUBJECT TO COPYRIGHT PROTECTION BY ARCHITECTURAL WORKS UNDER SEC. 102 OF THE COPYRIGHT ACT, 17 U.S.C. AS AMENDED DECEMBER 1990 AND KNOWN AS ARCHITECTURAL WORKS COPYRIGHT PROTECTION ACT OF 1990. THE PROTECTION HELD HEREIN IS NOT LIMITED TO THE OVERALL FORM AS WELL AS THE ARRANGEMENT AND COMPOSITION OF SPACES AND ELEMENTS OF THE DESIGN. UNDER SUCH PROTECTION, UNAUTHORIZED USE OF THESE PLANS CAN LEGALLY RESULT IN THE CESSION OF CONSTRUCTION OR BUILDINGS BEING SEIZED AND/OR MONETARY COMPENSATION TO DEVENNEY GROUP LTD.

ADMINISTRATION RELOCATION

HCA - LEE'S SUMMIT MEDICAL CENTER
 2000 SE BLUE PKWY
 LEE'S SUMMIT, MO 64063

AUTHORITY HAVING JURISDICTION:
 CITY OF LEE'S SUMMIT BUILDING DEPT.
 MISSOURI DHSS

FACILITY NUMBER:
 097240009

AGENCY APPROVALS:
 AGENCY

REVISIONS		
REV #	DESCRIPTION	DATE
A	CITY - 2ND REVIEW	2025/05/29
B	CITY - 3RD REVIEW	2025/07/18
C	DESIGN COORDINATION	2025/07/18

DATE: 04/18/2025
 SCALE: 3/16" = 1'-0"
 DRAWN: JV
 REVIEWED: MM/DP
 JOB NUMBER: 6406.24

REFLECTED CEILING PLAN - LEVEL 1 - ADMIN

AE181

REFLECTED CEILING GENERAL NOTES

1. CEILING HEIGHTS 9'-0" AFF UNLESS NOTED OTHERWISE. ALL SOFFIT HEIGHTS 8'-0" AFF UNLESS NOTED OTHERWISE.
2. CENTER CEILING SYSTEMS IN ROOMS UNLESS NOTED OTHERWISE.
3. CENTER SPRINKLER HEADS, SPEAKERS, RECESSED LIGHTS, AND SMOKE OR THERMAL DETECTORS IN CEILING TILE UNLESS NOTED OTHERWISE.
4. EXTEND SOFFIT GYPSUM BOARD TO 6" ABOVE FINISHED CEILING.
5. IF SPECIFIED HEIGHT OF FINISHED CEILING NEEDS TO BE LOWERED DUE TO CONDITIONS FOUND DURING CONSTRUCTION OR DEMOLITION, CONTACT ARCHITECT IMMEDIATELY.
6. PROVIDE ACCESS PANELS AS NECESSARY FOR VALVES AND DAMPERS IN GYPSUM BOARD CEILINGS.
7. ALL SOFFIT FACES SHALL RECEIVE SAME PAINT COLOR. SEE PLAN FOR COLOR ASSIGNMENTS.

REFLECTED CEILING LEGEND

		2 X 2 ACOUSTICAL CEILING GRID SYSTEM
		2 X 4 ACOUSTICAL CEILING GRID SYSTEM
		GYPSUM BOARD
		RECESSED FLUORESCENT / LED FIXTURE
		SURFACE MOUNT FLUORESCENT / LED FIXTURE
		FLUORESCENT / LED STRIP LIGHT
		LINEAR PENDENT STRIP LIGHT
		LINEAR PENDENT LIGHT
		PENDENT LIGHT
		RECESSED DOWNLIGHT
		EMERGENCY EXIT SIGN
		SPEAKER
		SMOKE DETECTOR
		SPRINKLER
		UNDER CABINET LIGHT
		WALL SCONCE
		ACCESS PANEL (DIMENSIONED ON PLAN)
		SUPPLY DIFFUSER
		RETURN AIR GRILLE
		EXHAUST GRILLE



PARTITION LEGEND

		NON-RATED PARTITION
		2-HOUR FIRE BARRIER
		1-HOUR FIRE BARRIER
		1-HOUR SMOKE BARRIER
		SMOKE PARTITION
		1-HOUR FIRE PARTITION
		LIMITS OF CONSTRUCTION (SHADE INDICATES AREA OUTSIDE OF SCOPE)

KEYNOTE LEGEND

KEY	NOTE
14	EXTEND EXISTING HALLWAY CEILING INTO NEW ALCOVE ENTRANCE - MATCH EXISTING CONDITIONS
22	NO FINISH CEILING SYSTEM IN THIS ROOM.

KEY PLAN

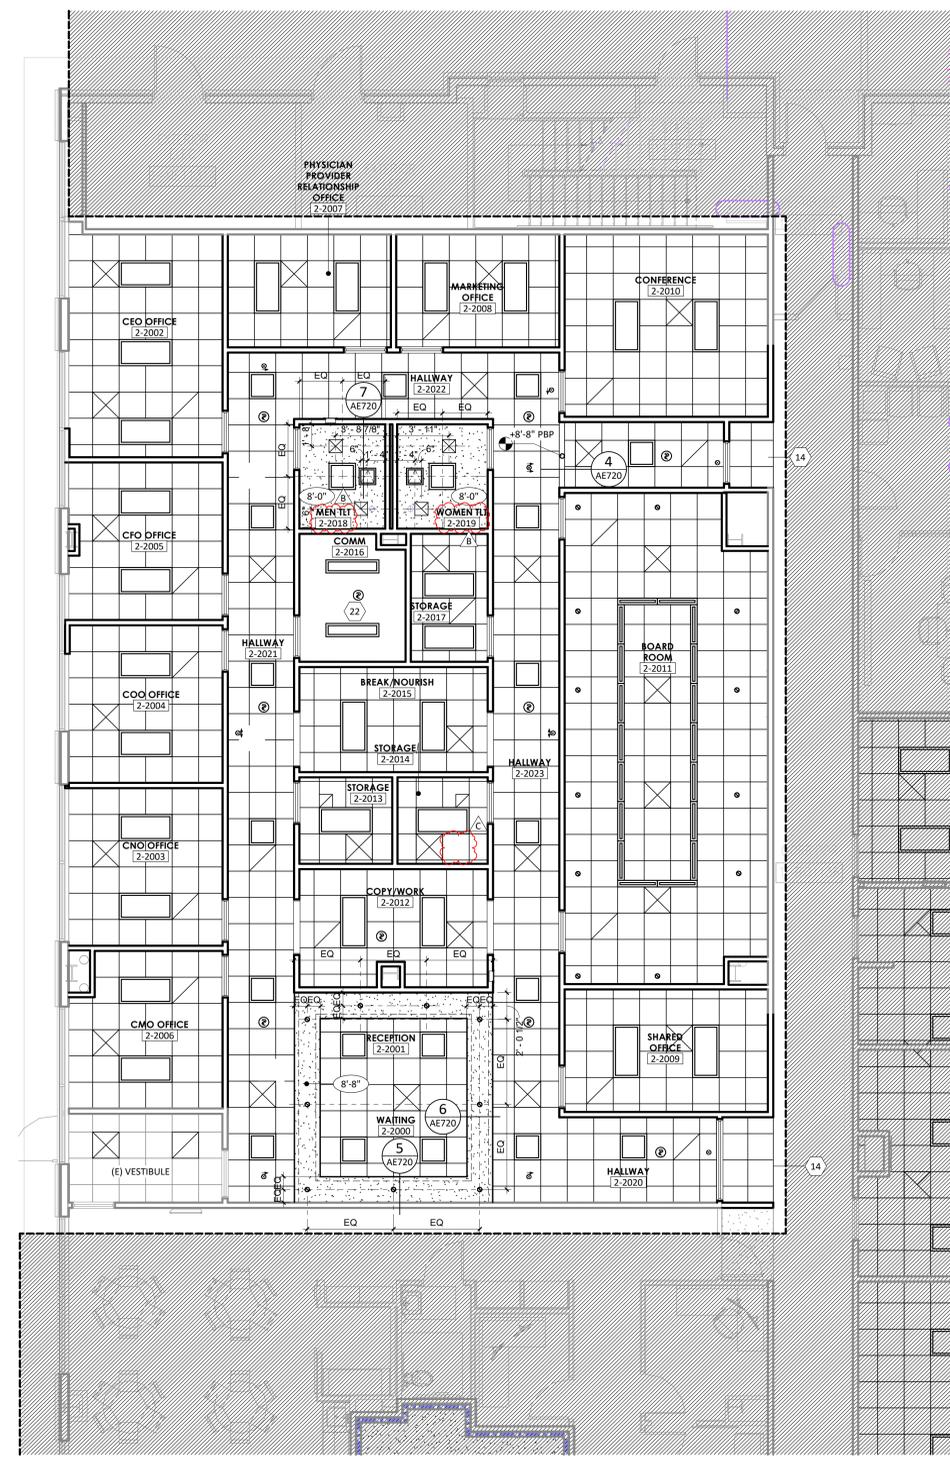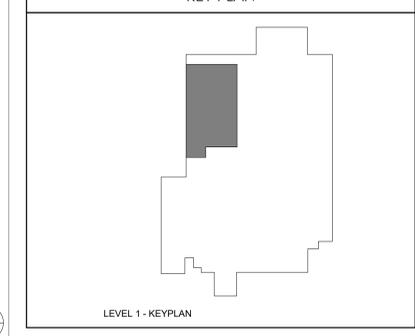


Autodesk Docs://6406.24 - HCA - Lee's Summit Medical Center (LSMC) - r123/6406.24.0001 HCA - LSMC Admin Relocation.rvt 7/17/2025 9:24:34 AM


DOOR SCHEDULE														
DOOR MATERIAL			DOOR GLAZING			FRAME MATERIAL			FRAME GLAZING			REMARKS		
WD	-	SOLID CORE WOOD	T	-	TEMPERED	HM	-	HOLLOW METAL	T	-	TEMPERED	1	-	CARD READER
WDPL	-	PLASTIC LAMINANT WOOD	L	-	LAMINATED	AL	-	ALUMINUM	L	-	LAMINATED			
WDIR	-	IMPACT RESISTANT WOOD	FR	-	FIRE RESISTIVE	FP	-	FIRE PROTECTIVE	FR	-	FIRE RESISTIVE			
HM	-	HOLLOW METAL	FP	-	FIRE PROTECTIVE	EX	-	EXISTING	FP	-	FIRE PROTECTIVE			
AL	-	ALUMINUM	SP	-	SPANDREL				SP	-	SPANDREL			
STL	-	STEEL	IGU	-	INSULATED GLASS UNIT				IGU	-	INSULATED GLASS UNIT			
EX	-	EXISTING	B	-	BALLISTIC				B	-	BALLISTIC			

DOOR SCHEDULE																		
ID	WIDTH	HEIGHT	DOOR PANEL			FRAME			SIDELITE		DETAILS				RATING	HARDWARE	REMARKS	CURRENT REVISION
			MATERIAL	ELEV.	GLAZING	MATERIAL	ELEV.	GLAZING	WIDTH	SILL HEIGHT	HEAD	JAMB	SILL	SIDELITE				
LEVEL 1																		
1-0N1001	3'-6"	7'-0"	EXIST	EXIST		EXIST	EXIST								009A-EX	1	C	
2-2002	3'-0"	7'-0"	WDPL	A		HM	1								003A			
2-2003	3'-0"	7'-0"	WDPL	A		HM	1								003A			
2-2004	3'-0"	7'-0"	WDPL	A		HM	1								003A			
2-2005	3'-0"	7'-0"	WDPL	A		HM	1								003A			
2-2006	3'-0"	7'-0"	WDPL	A		HM	1								003A			
2-2007	3'-0"	7'-0"	WDPL	A		HM	1								003A			
2-2008	3'-0"	7'-0"	WDPL	A		HM	1								003A			
2-2009	3'-0"	7'-0"	WDPL	A		HM	1								004A			
2-2010	3'-0"	7'-0"	WDPL	A		HM	1								004A			
2-2011A	3'-0"	7'-0"	WDPL/GL	C	T	HM	1								004A			
2-2011B	3'-0"	7'-0"	WDPL/GL	C	T	HM	1								004A			
2-2012A	4'-0"	7'-0"	-	-		HM	1									CASED OPENING		
2-2012B	4'-0"	7'-0"	-	-		HM	1										CASED OPENING	
2-2013	3'-0"	7'-0"	WDPL	A		HM	1								007C			
2-2014	3'-0"	7'-0"	WDPL	A		HM	1								007C			
2-2015A	4'-0"	7'-0"	-	-		HM	1										CASED OPENING	
2-2015B	4'-0"	7'-0"	-	-		HM	1										CASED OPENING	
2-2016	3'-0"	7'-0"	WDPL	A		HM	1								009A	1		
2-2017	3'-0"	7'-0"	WDPL	A		HM	1								007C			
2-2018	3'-0"	7'-0"	WDPL	A		HM	1								005A			
2-2019	3'-0"	7'-0"	WDPL	A		HM	1								005A			
2-2020	6'-0"	7'-0"	WDPL/GL	CC	T	HM	1		0"	0"					009E	1		
2-2022	3'-0"	7'-0"	WDPL	A		HM	1								009A	1		


- ### DOOR GENERAL NOTES
- THE PURPOSE OF THIS SHEET IS TO DESCRIBE AND ILLUSTRATE DOOR TYPES. NOT ALL DOOR TYPES SHOWN ARE NECESSARILY USED. SEE DOOR MARK SCHEDULE FOR DOOR TYPES USED.
 - FIRE DOORS AND FRAMES SHALL HAVE AN APPROVED LABEL OR LISTING MARK INDICATING THE FIRE PROTECTION RATING WHICH IS PERMANENTLY AFFIXED AT THE FACTORY WHERE FABRICATION AND ASSEMBLY ARE DONE.
 - SMOKE BARRIER DOORS INSTALLED ACROSS THE CORRIDORS AND EXIT ACCESS DOORS LOCATED AT ZONE BOUNDARIES SHALL BE EQUIPPED WITH APPROVED VISION PANELS.
 - ALL SMOKE BARRIER DOORS LOCATED ON THE FLOOR OR IN THE AFFECTED ZONE SHALL COMPLY WITH CURRENT APPLICABLE CODES AND SHALL BE AUTOMATIC CLOSING UPON ACTIVATION OF THE FIRE ALARM OR FIRE SPRINKLER SYSTEM.
 - ALL DOORS IN SMOKE BARRIERS AND OPENING INTO RATED EXIT WAYS SHALL BEAR AN APPROVED LABEL DISPLAYING THE LETTER "S" FOR CURRENT APPLICABLE CODES.
 - FIRE ASSEMBLIES REQUIRED TO HAVE 1 1/2 HOURS, 1 HOUR OR 3/4 HOUR FIRE PROTECTION RATING SHALL BE EITHER AUTOMATIC OR SELF CLOSING FIRE ASSEMBLIES. AUTOMATIC CLOSING FIRE ASSEMBLIES TO BE ACTIVATED BY AN INCREASE IN TEMPERATURE SHALL HAVE HEAT-ACTUATING DEVICES INSTALLED ON EACH SIDE OF THE WALL AT THE CEILING HEIGHT WHERE THE CEILING IS MORE THAN 3 FEET ABOVE THE TOP OF THE OPENING OR BY A SINGLE FUSIBLE LINK IN THE OPENING INCORPORATED IN THE CLOSING DEVICE.
 - GLASS:
 - INTERIOR DOORS:
 - NON-RATED DOORS SHALL HAVE 1/4" CLEAR TEMPERED GLASS.
 - ALL RATED DOORS - SEE SPECIFICATIONS.
 - LEAD LINED DOORS SHALL HAVE LEAD GLASS.
 - GLAZING IN THE FOLLOWING LISTED AREAS SHALL BE DEEMED TO BE LOCATED IN HAZARDOUS LOCATIONS AND SUBJECT TO HUMAN IMPACT:
 - INGRESS AND EGRESS DOORS.
 - FIXED PANELS IN SWINGING DOORS.
 - ALL GLAZING WITHIN 18" OF THE FLOOR AND WITHIN 12" OF A DOOR SHALL BE TEMPERED.
 - EACH LITE OF THE GLAZING SHALL BEAR THE MANUFACTURER'S LABEL DESIGNATING THE TYPE AND THICKNESS OF GLASS. WHEN APPROVED BY THE AGENCY, LABELS MAY BE OMITTED FROM OTHER THAN GLAZING MATERIALS, PROVIDED AN AFFIDAVIT IS FURNISHED BY THE GLAZING CONTRACTOR CERTIFYING THAT EACH LIGHT IS GLAZED IN ACCORDANCE WITH APPROVED PLANS AND SPECIFICATIONS. IDENTIFICATION OF GLAZING IN HAZARDOUS LOCATIONS AND SUBJECT TO HUMAN IMPACT SHALL BE ETCHED OR CERAMIC FIRED ON THE GLASS AND READABLE FROM THE INSIDE OF THE BUILDING AFTER INSTALLATION.
 - EXIT DOORS SHALL BE OPERABLE FROM THE INSIDE WITHOUT THE USE OF A KEY OR ANY SPECIAL KNOWLEDGE OR EFFORT.
 - PANIC HARDWARE SHALL COMPLY WITH THE REQUIREMENTS OF CURRENT APPLICABLE CODES. THE ACTIVATING MEMBER SHALL BE MOUNTED AT A HEIGHT OF NOT LESS THAN 30 INCHES NOR MORE THAN 48 INCHES ABOVE THE FLOOR. THE UNLATCHING FORCE SHALL NOT EXCEED 15 POUNDS WHEN APPLIED IN THE DIRECTION OF TRAVEL.
 - DOOR ASSEMBLIES, APPROACHES AND FINISH HARDWARE SHALL BE IN COMPLIANCE WITH ACCESSIBILITY STANDARDS.
 - THE MAXIMUM EFFORT TO OPERATE DOORS SHALL NOT EXCEED THE FOLLOWING:
 - EXTERIOR DOORS 5.0 POUNDS
 - INTERIOR DOORS 5.0 POUNDS
 - FIRE DOORS 15.0 POUNDS
 - WATER CLOSET ROOMS SHALL BE SEPARATED FROM FOOD PREPARATION AND STORAGE AREAS WITH TIGHT FITTING DOORS.
 - DOOR OPENING LOCATIONS:
 - IMMEDIATELY (5") ADJACENT TO A FLANKING WALL UNLESS NOTED OTHERWISE
 - AT THE CENTERLINE OF THE ROOM, UNLESS NOTED OTHERWISE
 - CENTERED ON A GRID DOOR OPENINGS IN OTHER LOCATIONS ARE LOCATED BY DIMENSIONS
 - SEE SPECIFICATIONS FOR HARDWARE SCHEDULE
 - ALL DOOR FRAMES ARE WELDED FRAMES, UNLESS NOTED OTHERWISE.
 - FINISH FLOOR TRANSITIONS OCCUR AT CENTERLINE OF DOORS, UNLESS NOTED OTHERWISE.
 - ALL INTERIOR DOORS WITH FIRE RATINGS GREATER THAN 20 MINUTE SHALL HAVE A NON-COMBUSTIBLE SILL WITH AN UNDERCUT OF 3/8" MAXIMUM ABOVE THE SILL.
 - WEIGHT OF LEAD-LINED DOORS, LEAD STRIPS IN DOOR FRAMES AND LEAD GLAZING WHERE OCCURS SHALL MATCH WEIGHT OF LEAD IN ADJACENT PARTITION, UNLESS NOTED OTHERWISE. LEAD LINING SHALL BE INSTALLED SUCH THAT SHIELDING IS CONTINUOUS IN INSTALLED DOORWAY.
 - ALL EXTERIOR DOORS SHALL HAVE METAL THRESHOLDS. SEE HARDWARE SCHEDULE.
 - WHERE DOOR HOLD-OPEN DEVICES OR DOOR STOPS OCCUR AT WALLS, PROVIDE BACKING PLATE PER BACKING PLATE SCHEDULE.
 - ALL SOLID CORE WOOD DOORS TO BE STAIN GRADE, UNLESS NOTED OTHERWISE (SEE DOOR SCHEDULE).
 - DOORS WITH AUTO DOOR OPENINGS SHALL MEET REQUIREMENTS IN CURRENT APPLICABLE CODES.
 - THRESHOLDS AT DOORWAYS AND TRANSITION STRIPS SHALL NOT EXCEED 1/2" IN HEIGHT. RAISED THRESHOLDS AND FLOOR LEVEL CHANGES AT ACCESSIBLE DOORWAYS SHALL BE BEVELED WITH A SLOPE NO GREATER THAN 1:2.

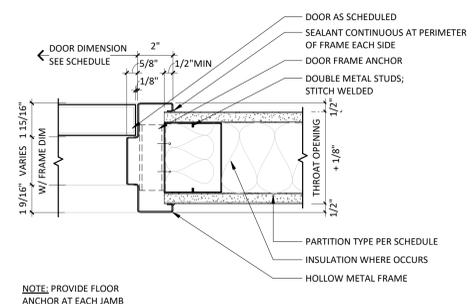


2 JAMB AT HOLLOW METAL FRAME
3" = 1'-0"

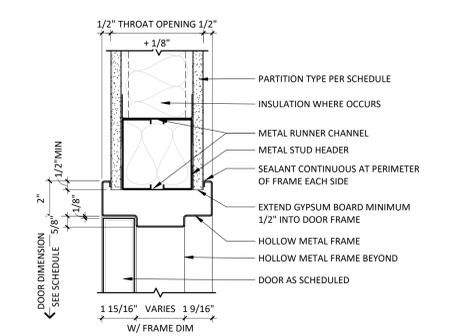

1 HEAD AT HOLLOW METAL FRAME
3" = 1'-0"

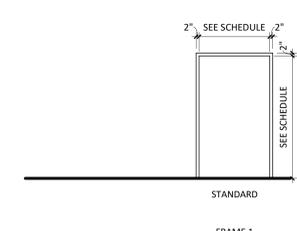

FRAME ELEVATIONS

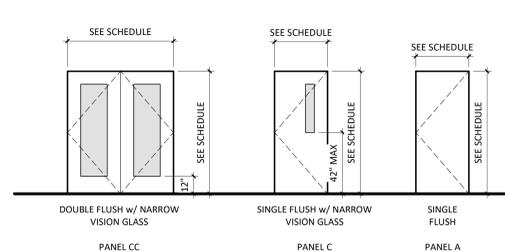

DOOR PANEL ELEVATIONS

Devenney GROUP
Devenney Group Ltd., Architects
6900 East Camelback Road
Suite 500
Scottsdale, AZ 85251
T: 602.943.8950
www.devenneygroup.com

Consultant:

DATE SIGNED: 07.18.25

IF THESE PLANS DO NOT BEAR THE SEAL OF A REGISTERED ARCHITECT, THEY ARE TO BE CONSIDERED "PRELIMINARY" AND ARE NOT TO BE USED FOR CONSTRUCTION OR RECORDING. THESE PLANS ARE COPYRIGHTED AND ARE SUBJECT TO COPYRIGHT PROTECTION BY "ARCHITECTURAL RIGHTS" UNDER REG. 302 OF THE COPYRIGHT ACT, 17 U.S.C. AS AMENDED DECEMBER 1990 AND KNOWN AS ARCHITECTURAL WORKS COPYRIGHT PROTECTION ACT OF 1990. THE PROTECTION RELIEVES BUT IS NOT LIMITED TO THE OVERALL FORM AS WELL AS THE ARRANGEMENT AND COMPOSITION OF SPACES AND ELEMENTS OF THE DESIGN. UNDER SUCH PROTECTION, UNAUTHORIZED USE OF THESE PLANS CAN LEGALLY RESULT IN THE CEASATION OF CONSTRUCTION OR BUILDINGS BEING SEIZED AND/OR MONETARY COMPENSATION TO DEVENNEY GROUP LTD.

ADMINISTRATION RELOCATION

HCA - LEE'S SUMMIT MEDICAL CENTER
2000 SE BLUE PKWY
LEE'S SUMMIT, MO 64063

AUTHORITY HAVING JURISDICTION:
CITY OF LEE'S SUMMIT BUILDING DEPT.
MISSOURI DHS

FACILITY NUMBER:
097240009

AGENCY APPROVALS:
AGENCY

REVISIONS		
REV #	DESCRIPTION	DATE
A	CITY - 2ND REVIEW	2025/05/29
C	DESIGN COORDINATION	2025/07/18

DATE: 04/18/2025
SCALE: As indicated
DRAWN: JV
REVIEWED: MM/DP
JOB NUMBER: 6406.24

DOOR SCHEDULES - LEVEL 1 ADMIN

AE601

Autodesk Docs/16406.24 - HCA - Lee's Summit Medical Center (LSMC) - r12316406.24.001 LICA - LSMC Admin Relocation.rvt 7/17/2025 9:24:35 AM



Devenney Group Ltd., Architects
 6900 East Camelback Road
 Suite 500
 Scottsdale, AZ 85251
 T: 602.943.8950
 www.devenneygroup.com

Consultant:



INNER DESIGN STUDIO
 7103 Bakers Bridge
 Ave., Suite 106
 Brentwood, TN 37027
 615.321.0698
 www.innerdesignstudio.com



DATE SIGNED: 07.18.25

IF THESE PLANS DO NOT BEAR THE SEAL OF A REGISTERED ARCHITECT, THEY ARE TO BE CONSIDERED PRELIMINARY AND ARE NOT TO BE USED FOR CONSTRUCTION OR RECORDING. THESE PLANS ARE COPYRIGHTED AND ARE SUBJECT TO COPYRIGHT PROTECTION BY "INNER DESIGN STUDIO" UNDER SEC. 102 OF THE COPYRIGHT ACT, 17 U.S.C. AS AMENDED DECEMBER 1990 AND KNOWN AS ARCHITECTURAL WORKS COPYRIGHT PROTECTION ACT OF 1990. THE PROTECTION INCLUDES BUT IS NOT LIMITED TO THE OVERALL FORM AS WELL AS THE ARRANGEMENT AND COMPOSITION OF SPACES AND ELEMENTS OF THE DESIGN. UNDER SUCH PROTECTION, UNAUTHORIZED USE OF THESE PLANS CAN LEGALLY RESULT IN THE CEASING OF CONSTRUCTION OF BUILDINGS BEING SIZED AND/OR MONETARY COMPENSATION TO DEVENNEY GROUP LTD.

ADMINISTRATION RELOCATION

HCA - LEE'S SUMMIT
 MEDICAL CENTER
 2000 SE BLUE PKWY
 LEE'S SUMMIT, MO 64063

AUTHORITY HAVING JURISDICTION:
 CITY OF LEE'S SUMMIT BUILDING DEPT.
 MISSOURI DHSS

FACILITY NUMBER:
 097240009


AGENCY APPROVALS:

REVISIONS		
REV #	DESCRIPTION	DATE
A	CITY - 2ND REVIEW	2025/05/29
B	CITY - 3RD REVIEW	2025/07/18


DATE: 2025.04.18
 SCALE: 3/16" = 1'-0"
 DRAWN: PC
 REVIEWED: PF
 JOB NUMBER: 6406.24

FINISH FLOOR PLAN - LEVEL
 1


AF101

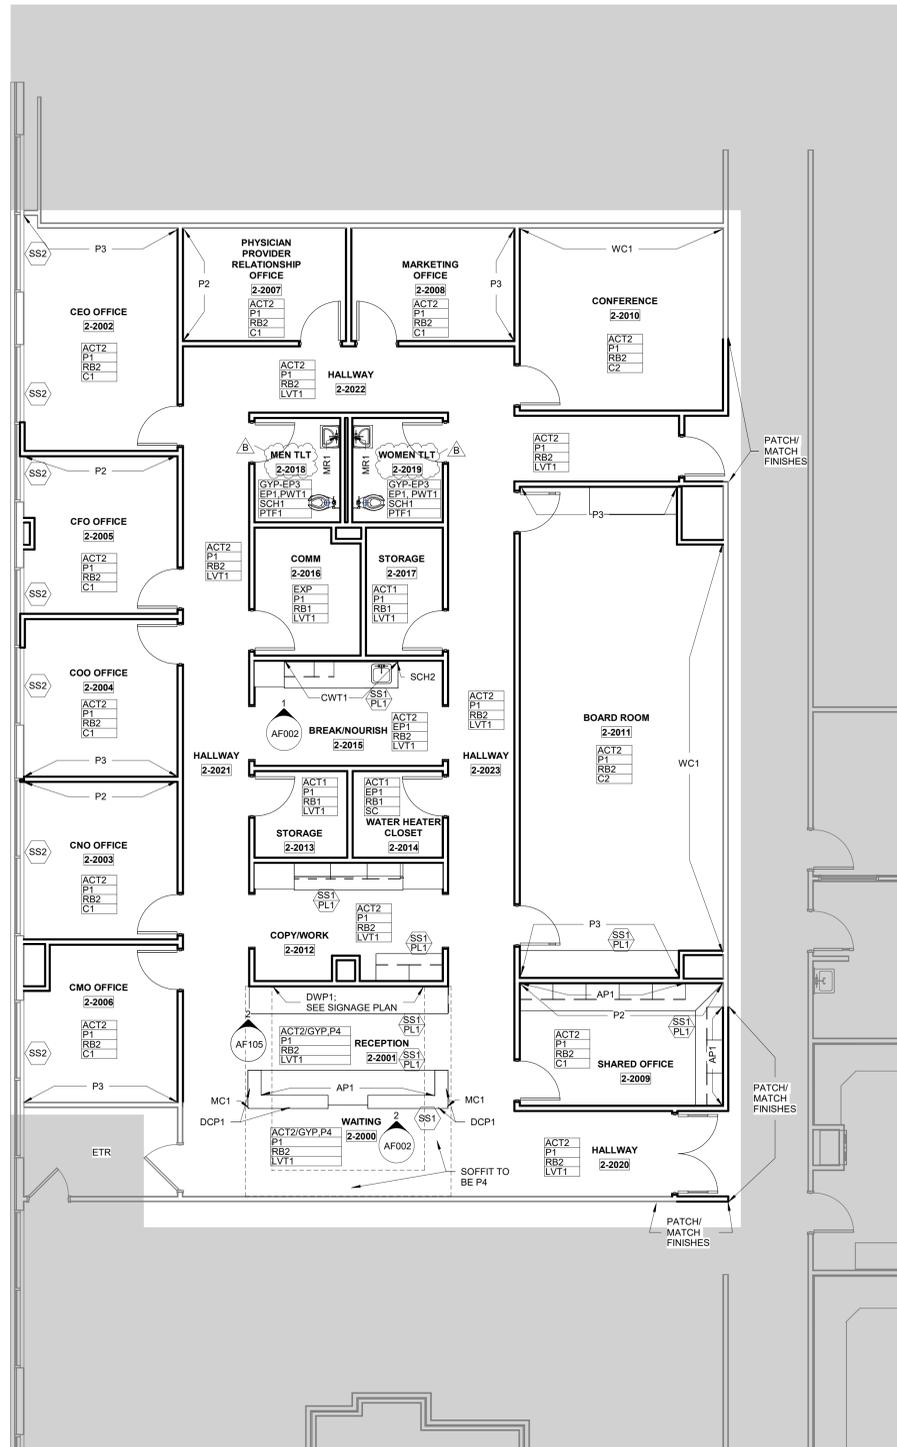

1 FINISH PLAN - LEVEL 1
 3/16" = 1'-0"

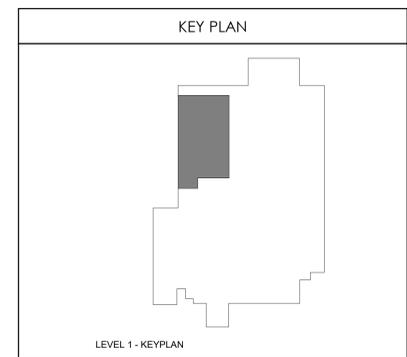

7/10/2025 2:15:25 PM Autodesk Docs://6406.24 - HCA - Lee's Summit Medical Center (LSMC)_LV23/LSMC-Admin Relocation_ID5_103.rvt

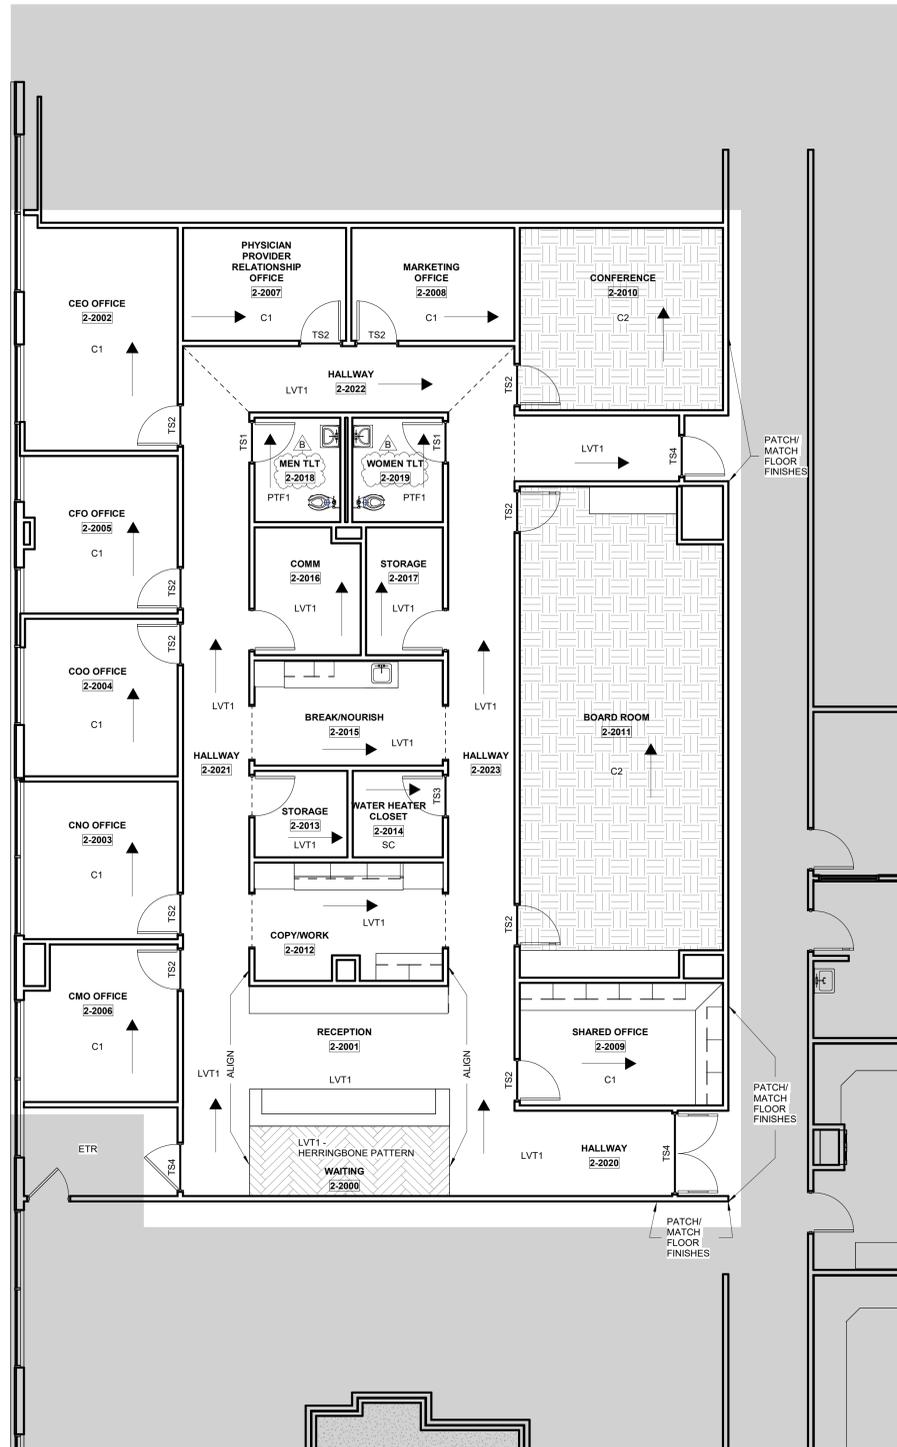


1 FLOOR PATTERN PLAN - LEVEL 1
3/16" = 1'-0"

FLOORING				
CODE/KEY	ITEM	LOCATION	MANUFACT.	DESCRIPTION
C1	Carpet	Offices	Shaw	Style: Living Systems, Source Tile 5T315 Color: Radiant 05515 Format: Plank Size: 9' x 36" x 0.209 in. thickness Backing: Synthetic/Ecovorx Adhesive: Manufacturer Recommended Installation: Ashlar
C2	Carpet	Conference Room	Shaw	Style: Living Systems, Observe Tile 5T306 Color: Radiant 05515 Format: Plank Size: 9' x 36" x 0.272 in. thickness Backing: Synthetic/Ecovorx Adhesive: Manufacturer Recommended Installation: Ashlar
LVT1	Luxury Vinyl Tile	Floors	Mannington	Style: Amtico Wood Collection Color: Manor Oak AR0W7970- Square Edge Size: 9' x 48" x 2.5mm thickness Adhesive: Manufacturer Recommended
PTF1	Porcelain Wall Tile	Walls-Field	Emser Tile	Pattern: Milestone Color: Gray Size: 12" x 24" x 8mm Grout: Laticrete, Spectralock Pro Premium Grout Color: Dusty Grey 60 Grout Joint: 1/8" Installation: 1/3rd Offset
SC	Sealed Concrete	Floors	Sherwin Williams	Style: Armorseal Treadplex Color: Haze Gray Notes: See architectural specifications for information

FLOORING TRANSITION STRIPS				
TS1	Transition Strip	LVT to SVF	Griffon	Ramping TRT#, 1/8" Beveled Color: Neutral Concrete See Flooring for Detail Note About Ramp Size.
TS2	Transition Strip	1/8" Resilient to Carpet	Schluter Systems	Vingro- S, Aluminum Finish: Brushed Nickel Anodized Aluminum Backfill with thin set to prevent denting.
TS3	Transition Strip	1/8" Resilient to Concrete	Schluter Systems	Vingro- U, Aluminum Finish: Brushed Nickel Anodized Aluminum Backfill with thin set to prevent denting.
TS4	Existing	New Floor to Existing Flooring	Schluter Systems	Contractor to submit ADA compliant transition from that is appropriate for new/existing flooring heights. Stainless Steel ONLY

FLOORING LEGEND	
TS	FLOORING TRANSITION TYPE
→	PLANK OR TILE DIRECTION
-----	PATTERN DIRECTION CHANGE

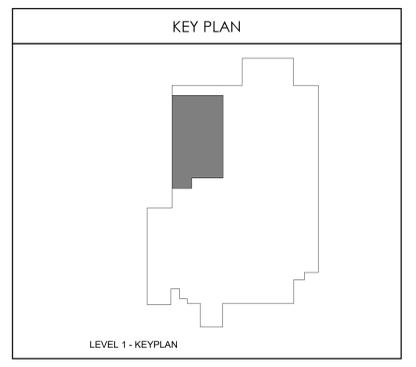

Devenney Group Ltd., Architects
6900 East Camelback Road
Suite 500
Scottsdale, AZ 85251
T: 602.943.8950
www.devenneygroup.com



INNER DESIGN STUDIO
7103 Bakers Bridge
Ave., Suite 106
Brentwood, TN 37027
615.321.0698
www.innerdesignstudio.com



DATE SIGNED: 07.18.25

IF THESE PLANS DO NOT BEAR THE SEAL OF A REGISTRANT, THEY ARE TO BE CONSIDERED PRELIMINARY AND ARE NOT TO BE USED FOR CONSTRUCTION OR RECORDING. THESE PLANS ARE COPYRIGHTED AND ARE SUBJECT TO COPYRIGHT PROTECTION BY "INNER DESIGN STUDIO" UNDER SEC. 102 OF THE COPYRIGHT ACT, 17 U.S.C. AS AMENDED DECEMBER 1990 AND KNOWN AS ARCHITECTURAL WORKS COPYRIGHT PROTECTION ACT OF 1990. THE PROTECTION INCLUDES BUT IS NOT LIMITED TO THE OVERALL FORM AS WELL AS THE ARRANGEMENT AND COMPOSITION OF SPACES AND ELEMENTS OF THE DESIGN. UNDER SUCH PROTECTION, UNAUTHORIZED USE OF THESE PLANS CAN LEGALLY RESULT IN THE CESSION OF CONSTRUCTION OF BUILDINGS BEING SUED AND/OR MONETARY COMPENSATION TO DEVENNEY GROUP LTD.

ADMINISTRATION RELOCATION

HCA - LEE'S SUMMIT
MEDICAL CENTER
2000 SE BLUE PKWY
LEE'S SUMMIT, MO 64063

AUTHORITY HAVING JURISDICTION:
CITY OF LEE'S SUMMIT BUILDING DEPT.
MISSOURI DHSS

FACILITY NUMBER:
0972400009

AGENCY APPROVALS:

REVISIONS		
REV #	DESCRIPTION	DATE
A	CITY - 2ND REVIEW	2025/05/29
B	CITY - 3RD REVIEW	2025/07/18

DATE: 2025.04.18
SCALE: As indicated
DRAWN: PC
REVIEWED: PF
JOB NUMBER: 6406.24

FLOOR PATTERN PLAN - LEVEL 1

AF103

Autodesk Docx/16406_24 - HCA - Lee's Summit Medical Center (LSMC)_rv23/LSMC Admin Relocation_105_103.rvt 7/10/2025 2:15:26 PM



Devenney Group Ltd., Architects
 6900 East Camelback Road
 Suite 500
 Scottsdale, AZ 85251
 T: 602.943.8950
 www.devenneygroup.com

Consultant:



INNER DESIGN STUDIO
 7103 Bakers Bridge
 Ave., Suite 106
 Brentwood, TN 37027
 615.321.0698
 www.innerdesignstudio.com



DATE SIGNED: 07.18.25

IF THESE PLANS DO NOT BEAR THE SEAL OF A REGISTRANT, THEY ARE TO BE CONSIDERED "PRELIMINARY" AND ARE NOT TO BE USED FOR CONSTRUCTION OR RECORDING. THESE PLANS ARE COPYRIGHTED AND ARE SUBJECT TO COPYRIGHT PROTECTION BY "ARCHITECTURAL RIGHTS" UNDER SEC. 302 OF THE COPYRIGHT ACT, 17 U.S.C. AS AMENDED DECEMBER 1990 AND KNOWN AS ARCHITECTURAL WORKS COPYRIGHT PROTECTION ACT OF 1990. THE PROTECTION INCLUDES BUT IS NOT LIMITED TO THE OVERALL FORM AS WELL AS THE ARRANGEMENT AND COMPOSITION OF SPACES AND ELEMENTS OF THE DESIGN. UNDER SUCH PROTECTION, UNAUTHORIZED USE OF THESE PLANS CAN LEGALLY RESULT IN THE CESSION OF CONSTRUCTION OR BUILDINGS BEING SUEZ AND/OR MONETARY COMPENSATION TO DEVENNEY GROUP LTD.

ADMINISTRATION RELOCATION

HCA - LEE'S SUMMIT
 MEDICAL CENTER
 2000 SE BLUE PKWY
 LEE'S SUMMIT, MO 64063

AUTHORITY HAVING JURISDICTION:
 CITY OF LEE'S SUMMIT BUILDING DEPT.
 MISSOURI DHSS

FACILITY NUMBER:
 0972400009


AGENCY APPROVALS:

REVISIONS		
REV #	DESCRIPTION	DATE
A	CITY - 2ND REVIEW	2025/05/29
B	CITY - 3RD REVIEW	2025/07/18


DATE: 2025.04.18
 SCALE: 3/16" = 1'-0"
 DRAWN: PC
 REVIEWED: PF
 JOB NUMBER: 6406.24

FURNITURE PLAN - LEVEL 1


AF104

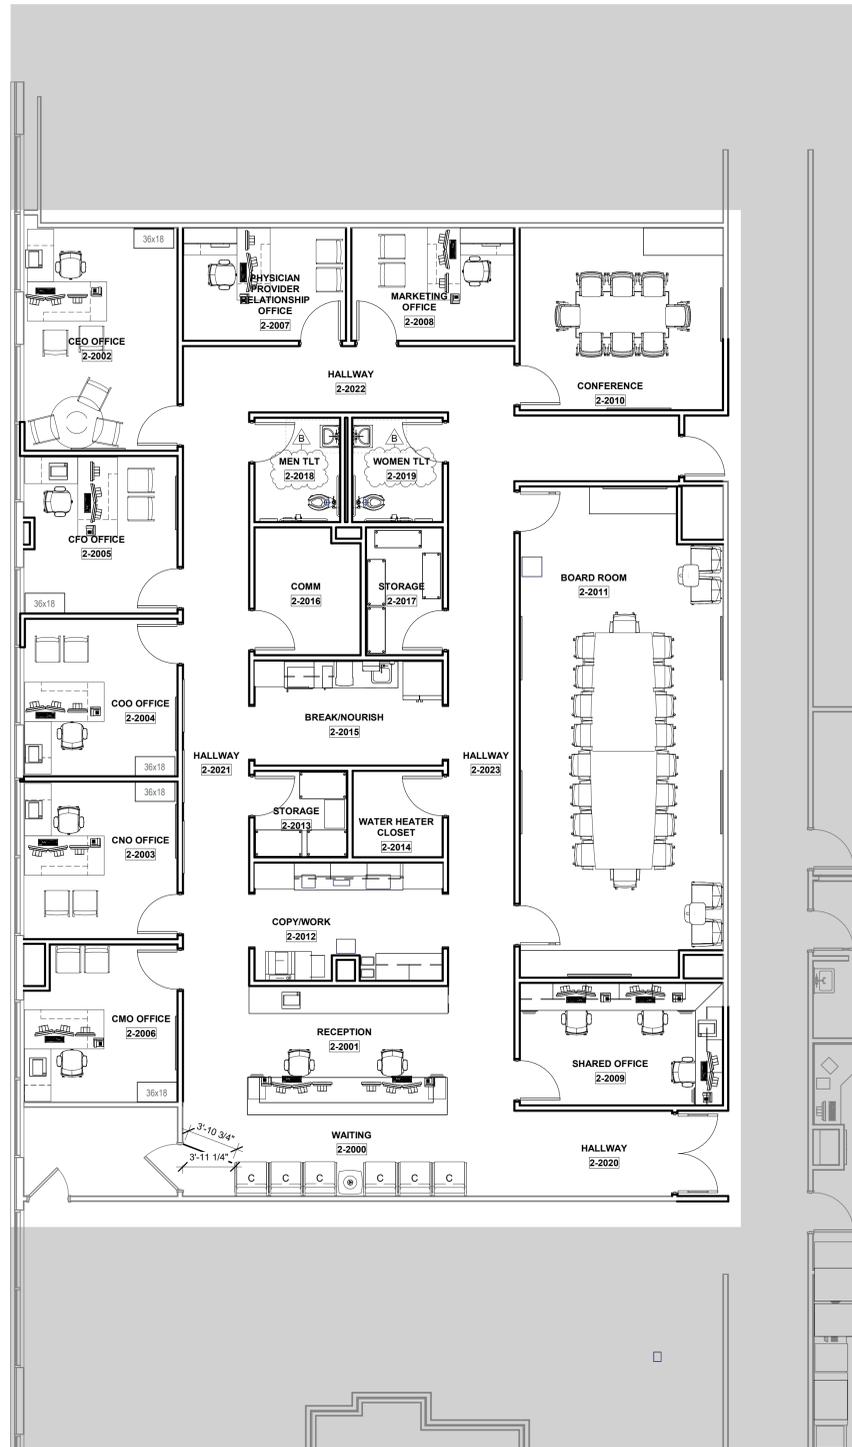

1 FURNITURE PLAN - LEVEL 1
 3/16" = 1'-0"

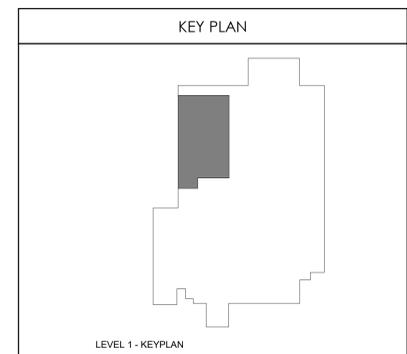



Autodesk Docs://6406.24 - HCA - Lee's Summit Medical Center (LSMC)_rv23/LSMC-Admin Relocation_IDS_103.rvt 7/10/2025 2:15:29 PM

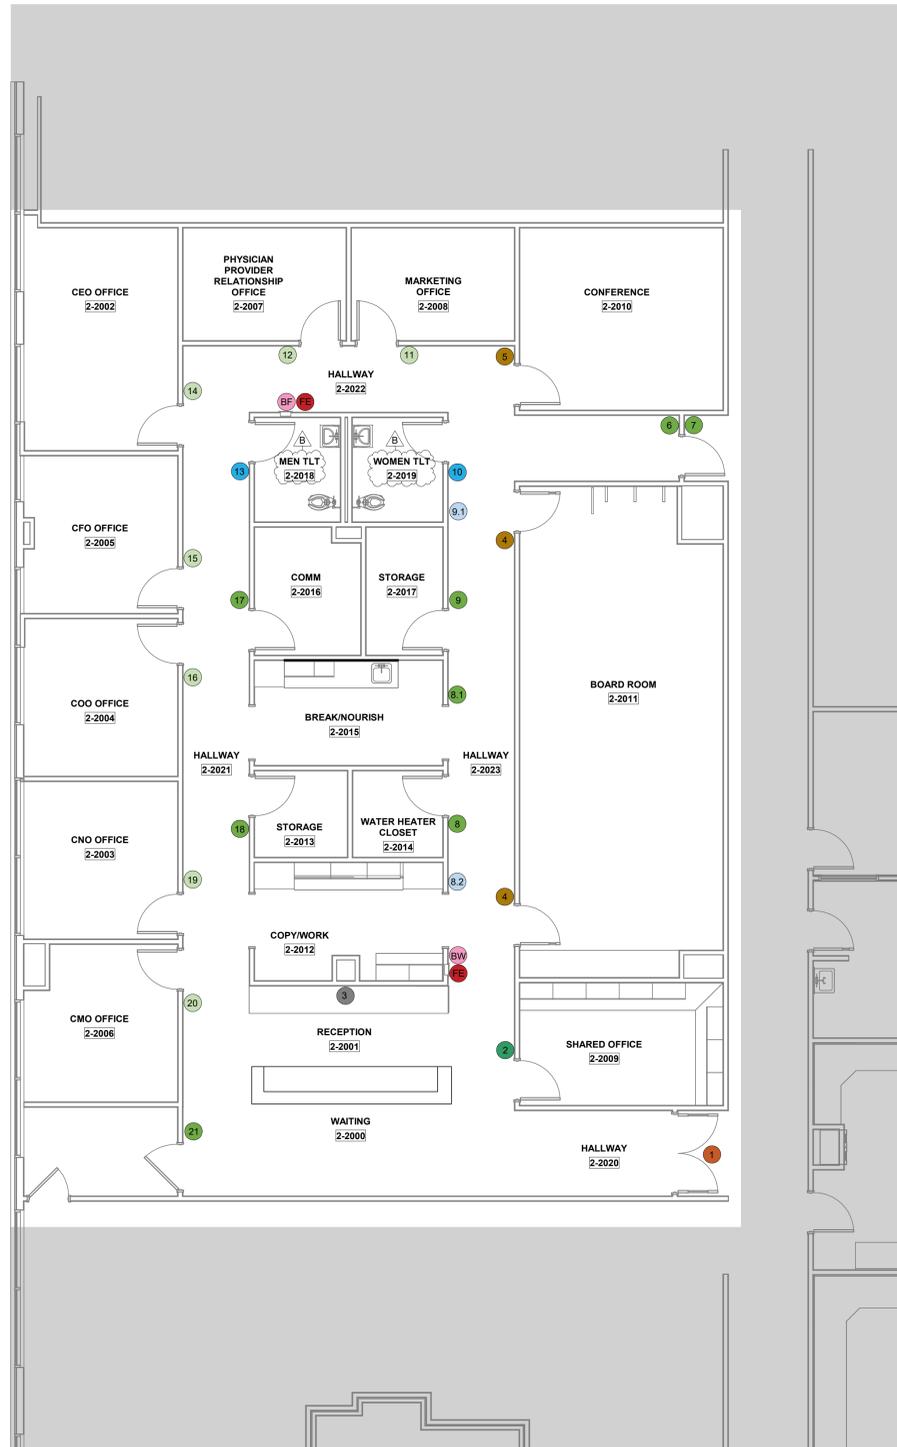

1 SIGNAGE PLAN - LEVEL 1
3/16" = 1'-0"

LOCATION	QTY	FLOOR	INT-EXT	TYPE	MESSAGE	SYMBOL	NOTES
ADMINISTRATION							
1	1	1	INT	V	ADMINISTRATION		VINYL DOOR?
2	1	1	INT	P4	OFFICE		FACILITY TO CONFIRM VERBIAGE
3	1	1	INT	M	HCA BRANDING SIGNAGE		
4	2	1	INT	D	BOARDROOM		DIGITAL SIGN; COORDINATE WITH FACILITY AND ELEC ENGINEER
5	1	1	INT	D	CONFERENCE		DIGITAL SIGN; COORDINATE WITH FACILITY AND ELEC ENGINEER
6	1	1	INT	P	EXIT		
7	1	1	INT	P	STAFF ONLY		FACILITY TO CONFIRM VERBIAGE
8	1	1	INT	P	ELEC/WATER HEATER		FACILITY TO CONFIRM VERBIAGE
8.1	1	1	INT	P	BREAK/NOURISH		FACILITY TO CONFIRM VERBIAGE
8.2	1	1	INT	SD	BREAKROOM & RESTROOM		FACILITY TO CONFIRM VERBIAGE
9	1	1	INT	P	STORAGE		
9.1	1	1	INT	SD	BREAKROOM & LOBBY		FACILITY TO CONFIRM VERBIAGE
10	1	1	INT	S	RESTROOM	FEMALE/MALE/HANDICAP	
11	1	1	INT	P3	MARKETING		NAME SLOT
12	1	1	INT	P3	PHYSICIAN PROVIDER RELATIONSHIP		NAME SLOT/FACILITY TO CONFIRM VERBIAGE
13	1	1	INT	S	RESTROOM	FEMALE/MALE/HANDICAP	
14	1	1	INT	P3	CEO		NAME SLOT
15	1	1	INT	P3	CFO		NAME SLOT
16	1	1	INT	P3	COO		NAME SLOT
17	1	1	INT	P	COMMUNICATION		
18	1	1	INT	P	STORAGE		
19	1	1	INT	P3	CNO		NAME SLOT
20	1	1	INT	P3	CMO		NAME SLOT
21	1	1	INT	P	TBD		
2	2	1	INT	BW	FIRE EXTINGUISHER		BLADE
2	1	1	INT	FE	FIRE EVACUATION MAPS		LOCATE AS REQUIRED BY FIRE MARSHAL

SIGN TYPE LEGEND	
V	Sign Type : Vinyl Signs
D	Sign Type : Digital Room Sign
P	Sign Type : Room Sign
P3	Sign Type : Room Sign with Name Inserts
P4	Sign Type: Room sign with 2-3 Name Inserts
S	Sign Type : Room Sign with symbol
BW	Sign Type : Blade Ceilings (Fire Extinguisher signs)
FE	Sign Type : Fire Evacuation Plan Signs
M	Sign Type: HCA Branding Metal routed (Logo)
SD	Sign Type: Small Directional

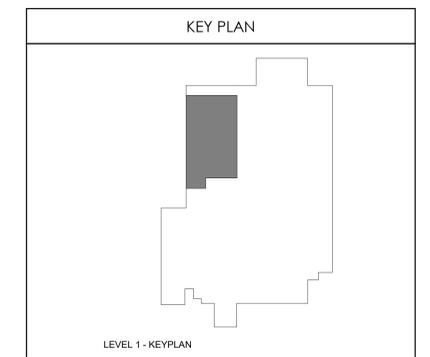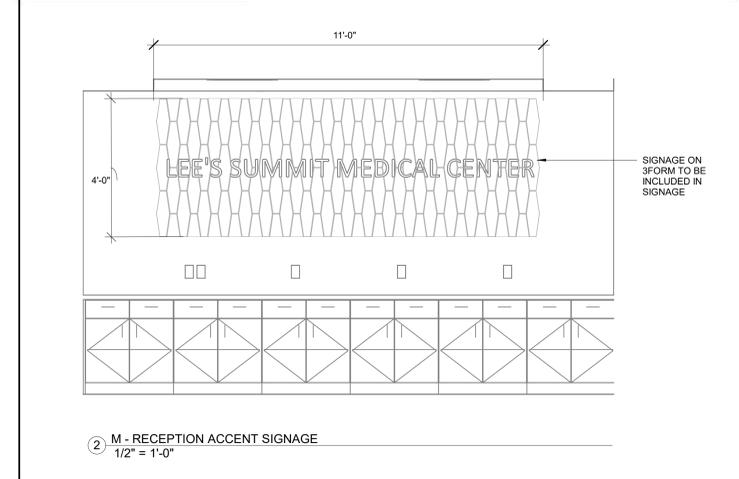

Devenney GROUP
Devenney Group Ltd., Architects
6900 East Camelback Road
Suite 500
Scottsdale, AZ 85251
T: 602.943.8950
www.devenneygroup.com

Consultant:
INNER DESIGN STUDIO
7103 Bakers Bridge
Ave., Suite 106
Brentwood, TN 37027
615.321.0698
www.innerdesignstudio.com

Professional seal for Shelby C. Campbell, Missouri Professional Engineer, License No. A-202100240.
DATE SIGNED: 07.18.25

IF THESE PLANS DO NOT BEAR THE SEAL OF A REGISTRANT, THEY ARE TO BE CONSIDERED "PRELIMINARY" AND ARE NOT TO BE USED FOR CONSTRUCTION OR RECORDING. THESE PLANS ARE COPYRIGHTED AND ARE SUBJECT TO COPYRIGHT PROTECTION BY "ARCHITECTURAL WORK" UNDER SEC. 102 OF THE COPYRIGHT ACT, 17 U.S.C. AS AMENDED DECEMBER 1990 AND KNOWN AS ARCHITECTURAL WORKS COPYRIGHT PROTECTION ACT OF 1990. THE PROTECTION INCLUDES BUT IS NOT LIMITED TO THE OVERALL FORM AS WELL AS THE ARRANGEMENT AND COMPOSITION OF SPACES AND ELEMENTS OF THE DESIGN. UNDER SUCH PROTECTION, UNAUTHORIZED USE OF THESE PLANS CAN LEGALLY RESULT IN THE SEIZURE OF CONSTRUCTION OR BUILDINGS BEING SEIZED AND/OR MONETARY COMPENSATION TO DEVENNEY GROUP LTD.

ADMINISTRATION RELOCATION
HCA - LEE'S SUMMIT MEDICAL CENTER
2000 SE BLUE PKWY
LEE'S SUMMIT, MO 64063

AUTHORITY HAVING JURISDICTION:
CITY OF LEE'S SUMMIT BUILDING DEPT.
MISSOURI DHSS
FACILITY NUMBER:
097240009
AGENCY APPROVALS:


REVISIONS		
REV #	DESCRIPTION	DATE
A	CITY - 2ND REVIEW	2025/05/29
B	CITY - 3RD REVIEW	2025/07/18
C	DESIGN COORDINATION	2025/07/18

DATE: 2025.04.18
SCALE: As indicated
DRAWN: PC
REVIEWED: PF
JOB NUMBER: 6406.24


SIGNAGE PLAN - LEVEL 1

AF105

Autodesk Docs://6406.24 - HCA - Lee's Summit Medical Center (LSMC) - r123/LSMC-Admin Relocation_105_103.rvt 7/10/2025 2:15:30 PM

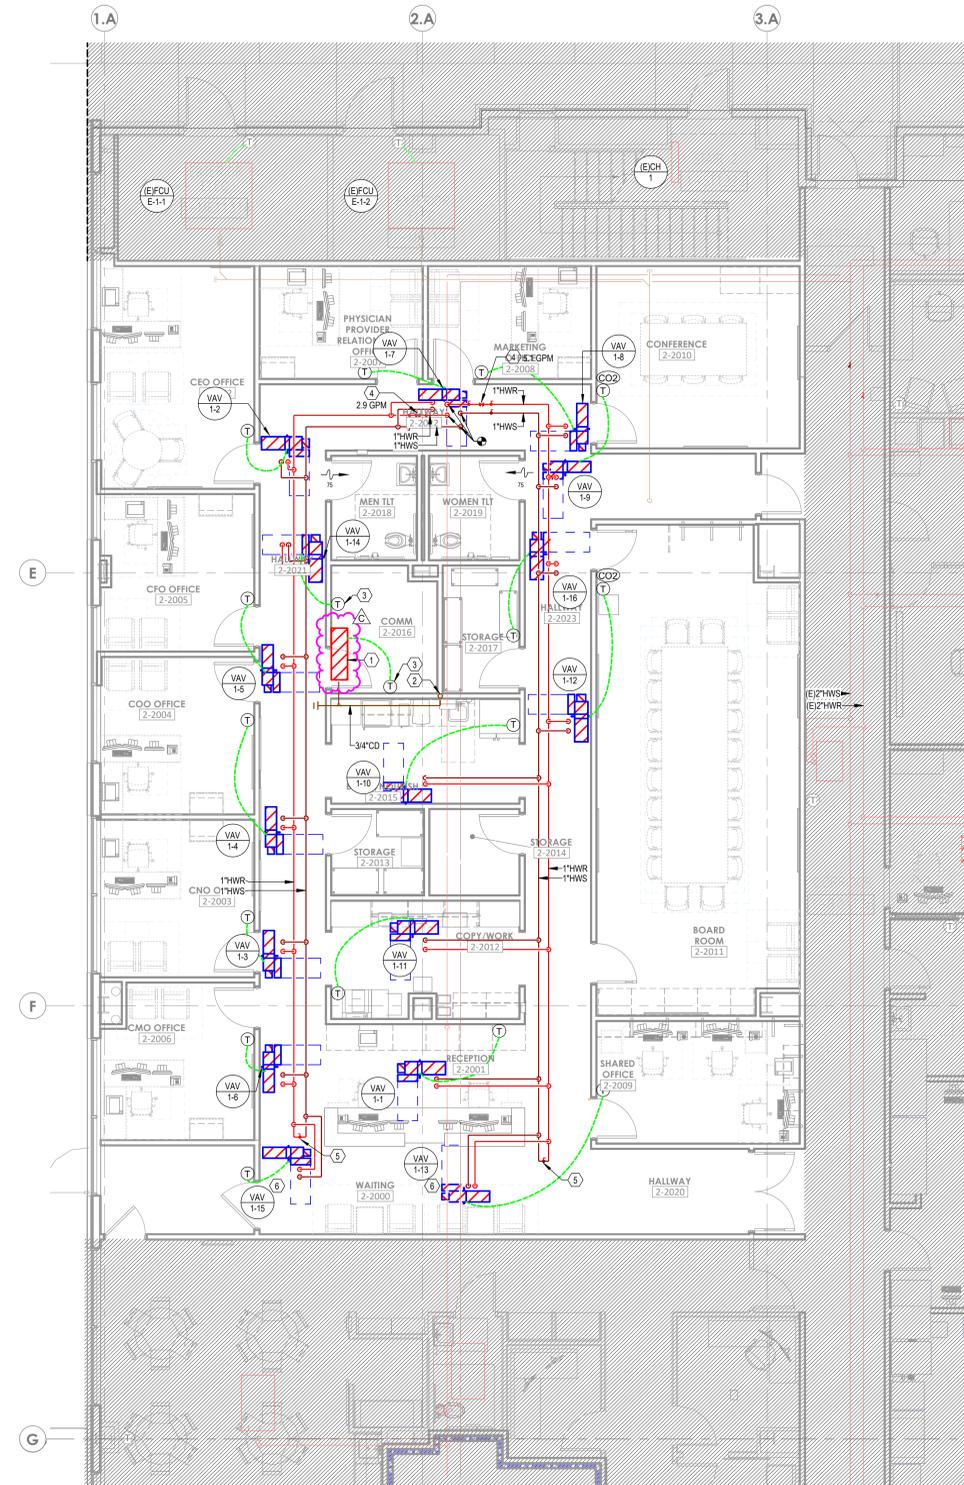

1 FLOOR PLAN - LEVEL 1 - ADMIN - HVAC PIPING
3/16" = 1'-0"

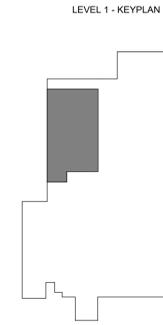

GENERAL DEMO NOTES

- A. REFER TO M00-00 FOR GENERAL MECHANICAL NOTES AND SYMBOLS.
- B. ALL EXISTING CONDITIONS INDICATED ON THESE DRAWINGS ARE APPROXIMATE AND BASED UPON A COMBINATION OF AVAILABLE RECORD DESIGN AND AS-BUILT DOCUMENTS. CONTRACTOR TO VERIFY EXISTING CONDITIONS.
- C. ALL EXISTING PIPE SIZES ON PLAN ARE PER THE DESIGN DOCUMENTS PROVIDED.
- D. CONTRACTOR TO PROVIDE ALL SUPPLY AND RETURN PIPING SERVED BY EXISTING SYSTEMS MODIFIED AS A PART OF THIS SCOPE. CONTRACTOR TO DOCUMENT PRECONSTRUCTION VALUES AND PROVIDE TO ENGINEER OF RECORD. UPON COMPLETION OF CONSTRUCTION, REBALANCE ALL EXISTING AREAS TO PRE-TABBED CONSTRUCTION VALUES.

LEGEND NOTES

- 1. SIZE AND ROUTE REFRIGERANT PIPING PER MANUFACTURER'S INSTRUCTIONS FROM AC-1 UP TO CONDENSING UNIT (ACCU-1) ON ROOF. CONTRACTOR SHALL UTILIZE SHAFT AND MINIMIZE DISTURBANCE TO OTHER TENANTS WITH ROUTING.
- 2. ROUTE 3/4" CONDENSATE DRAIN DOWN TO HUB DRAIN BELOW SINK.
- 3. SET THERMOSTAT FOR VAV-14 THREE DEGREES BELOW THERMOSTAT FOR AC-1.
- 4. CALIBRATED ORIFICE BALANCING VALVE BALANCED TO GPM INDICATED.
- 5. PROVIDE END OF MAIN FLUSHING VALVE AT THE END OF HW PIPING RUN. REFER TO DETAIL 06M07-01.
- 6. PROVIDE 3-WAY CONTROL VALVE FOR VAV AT THE END OF THE PIPING RUN.



Devenney Group Ltd., Architects
6900 East Camelback Road
Suite 500
Scottsdale, AZ 85251
T: 602.943.8950
www.devenneygroup.com



IF THESE PLANS DO NOT BEAR THE SEAL OF A REGISTERED PROFESSIONAL ENGINEER, THEY ARE TO BE CONSIDERED PRELIMINARY AND ARE NOT TO BE USED FOR CONSTRUCTION OR RECORDING. THESE PLANS ARE COPYRIGHTED AND ARE SUBJECT TO COPYRIGHT PROTECTION BY WSP USA BUILDINGS INC. UNDER REG. 303 OF THE COPYRIGHT ACT, 17 U.S.C. AS AMENDED DECEMBER 1990 AND KNOWN AS ARCHITECTURAL WORKS COPYRIGHT PROTECTION ACT OF 1990. THE PROTECTION INCLUDES BUT IS NOT LIMITED TO THE OVERALL FORM AS WELL AS THE ARRANGEMENT AND COMPOSITION OF SPACES AND ELEMENTS OF THE DESIGN. UNDER SUCH PROTECTION, UNAUTHORIZED USE OF THESE PLANS CAN LEGALLY RESULT IN THE SEIZURE OF CONSTRUCTION OR BUILDINGS BEING SEIZED AND/OR MONETARY COMPENSATION TO DEVENNEY GROUP LTD.

ADMINISTRATION RELOCATION

HCA - LEE'S SUMMIT MEDICAL CENTER
2000 SE BLUE PKWY
LEE'S SUMMIT, MO 64063

AUTHORITY HAVING JURISDICTION:
CITY OF LEE'S SUMMIT BUILDING DEPT.
MISSOURI DHSS

FACILITY NUMBER:
097240009

AGENCY APPROVALS:

REVISIONS		
REV #	DESCRIPTION	DATE
A	CITY - 2ND REVIEW	2025/05/29
C	DESIGN COORDINATION	2025/07/18

DATE: 04/18/2025
SCALE: As indicated
DRAWN: HO
REVIEWED: JD
JOB NUMBER: 6406.24

FLOOR PLAN - LEVEL 1 - ADMIN - HVAC PIPING

M03-01

Autodesk Docs://eg02-24-HCA - Lee's Summit Medical Center [LSMC] - rvt02/MP - LSVC Admin Relocation_033.rvt 7/16/2025 10:11:53 AM Notice of Alternate Billing or Payment Cycle: The Owner may plan to make payments on an alternative schedule. A written description of such billing or payment cycle applicable to the Project is available from the Owner or the Owner's designated agent upon request.



Devenney Group Ltd., Architects
 6900 East Camelback Road
 Suite 500
 Scottsdale, AZ 85251
 T: 602.943.8950
 www.devenneygroup.com



IF THESE PLANS DO NOT BEAR THE SEAL OF A REGISTERED PROFESSIONAL ENGINEER, THEY ARE TO BE CONSIDERED "PRELIMINARY" AND ARE NOT TO BE USED FOR CONSTRUCTION OR RECORDING. THESE PLANS ARE COPYRIGHTED AND ARE SUBJECT TO COPYRIGHT PROTECTION UNDER FEDERAL AND STATE LAWS. THE PROTECTION HEREIN IS NOT LIMITED TO THE OVERALL FORM AS WELL AS THE ARRANGEMENT AND COMPOSITION OF SPACES AND ELEMENTS OF THE DESIGN. UNDER SUCH PROTECTION, UNAUTHORIZED USE OF THESE PLANS CAN LEGALLY RESULT IN THE SEIZURE OF CONSTRUCTION OR BUILDINGS BEING SEIZED AND/OR MONETARY COMPENSATION TO DEVENNEY GROUP LTD.

ADMINISTRATION RELOCATION

HCA - LEE'S SUMMIT MEDICAL CENTER
 2000 SE BLUE PKWY
 LEE'S SUMMIT, MO 64063

AUTHORITY HAVING JURISDICTION:
 CITY OF LEE'S SUMMIT BUILDING DEPT.
 MISSOURI DHSS

FACILITY NUMBER:
 097240009

AGENCY APPROVALS:

REVISIONS		
REV #	DESCRIPTION	DATE
A	CITY - 2ND REVIEW	2025/05/29
C	DESIGN COORDINATION	2025/07/18

DATE: 04/18/2025
 SCALE: As indicated
 DRAWN: Author
 REVIEWED: Checker
 JOB NUMBER: 6406.24

DEMOLITION PLAN - LEVEL 1 - ADMIN - ELECTRICAL


ED02-01

GENERAL DEMO NOTES


- A. REFER TO AND COORDINATE WITH THE ARCHITECTURAL PLANS, ELEVATIONS, AND DETAILS FOR DEMOLITION REQUIREMENTS.
- B. REFER TO E00-00 FOR ADDITIONAL DEMOLITION NOTES.
- C. WHERE WALLS ARE BEING DEMOLISHED DOWN TO STUDS, REMOVE ALL ELECTRICAL DEVICES AND ASSOCIATED CONDUIT AND CONDUCTORS CONTAINED THEREIN UNLESS NOTED OTHERWISE.
- D. WHERE ENTIRE CIRCUIT IS REMOVED, CIRCUIT SHALL BE DEMOLISHED BACK TO POINT OF ORIGIN. TURN THE CIRCUIT BREAKER OFF AND LABEL AS "SPARE".
- E. ENERGIZE ALL EXISTING DEVICES THAT WERE INTERRUPTED DURING DEMOLITION.
- F. WHERE REMOVAL OF DEVICES AND ASSOCIATED CONDUIT AND CONDUCTORS EFFECTS OTHER DEVICES, RECONNECT OR PROVIDE NEW CONDUIT AND CONDUCTORS AS REQUIRED TO ASSURE THAT DEVICES IN ADJACENT AREAS AFFECTED BY THE RENOVATION REMAIN COMPLETELY OPERATIONAL.

LEGEND NOTES

- # 1 EXISTING POWER DEVICES, FIRE ALARM DEVICES, AND LIGHTING FIXTURES IN THIS ROOMAREA TO BE DEMOLISHED, UNLESS NOTED OTHERWISE.

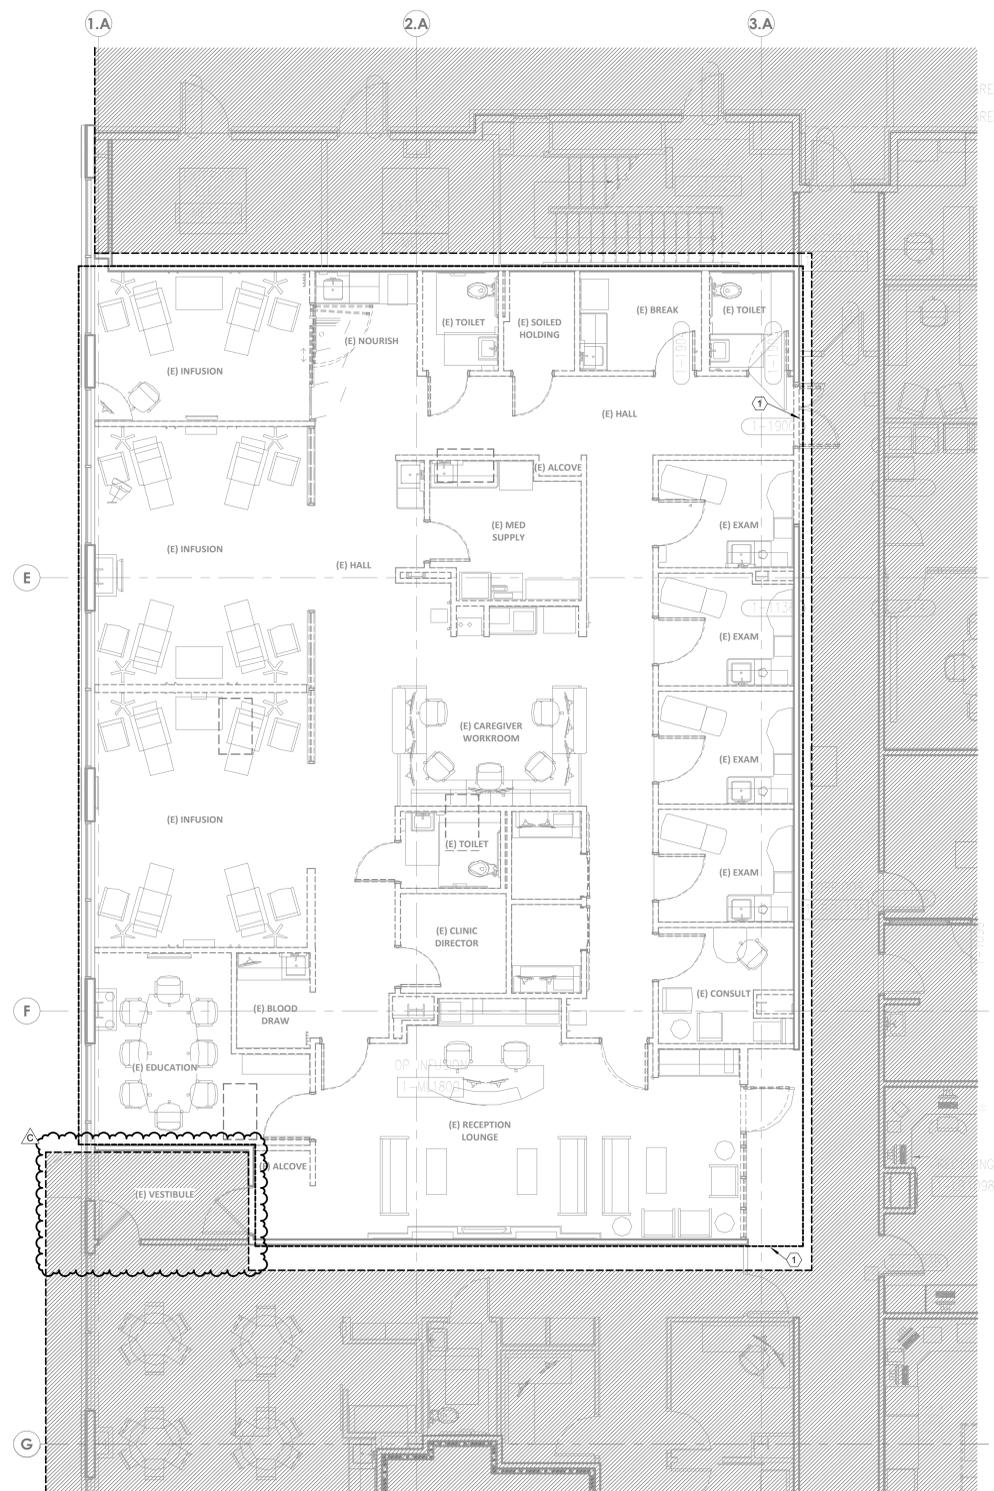

1 DEMOLITION PLAN - LEVEL 1 - ADMIN - ELECTRICAL
 3/16" = 1'-0"

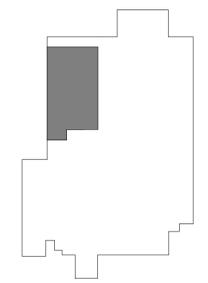

Autodesk Docx/6406.24 - HCA - Lee's Summit Medical Center (LSMC)_rv23(MEP)_LSMC Admin Relocation_02.23.rvt 7/16/2025 3:17:27 PM

ELECTRICAL LUMINAIRE FIXTURE SCHEDULE

TYPE	DESCRIPTION	LOCATION	PHYSICAL DESCRIPTION				ELECTRICAL SPECIFICATIONS										MANUFACTURER INFORMATION		REMARKS
			HOUSING	REFLECTOR	SHIELDING	FINISH	MOUNTING	COLOR TEMP.	LAMP	LUMENS	HOURS	VA	UNITS	BALLAST / DRIVER	VOLTAGE	MANUFACTURER	CATALOG NUMBER		
A1	2 x 4 LED VOLUMETRIC TROFFER	PUBLIC AND CORRIDOR	ONE PIECE STEEL	ACRYLIC LINEAR PRISMATIC	N/A	MATTE WHITE POWDERCOAT	RECESSED GYPSUM BOARD OR LAY IN CEILING	4,000	LED	4,000	60000	32	EACH	LED DRIVER - LINEAR DIMMING 0-10V DOWN TO 1%	120	LITHONIA	#2VTL4 40L ADP E21 LP840		
D2	2 x 2 LED VOLUMETRIC TROFFER	STAFF WORKING	ONE PIECE STEEL	ACRYLIC LINEAR PRISMATIC DIFFUSER	WHITE REGRESSED ALUMINUM DOOR	MATTE WHITE POWDERCOAT	RECESSED GYPSUM BOARD OR LAY IN CEILING	4,000	LED	4,000	60000	33	EACH	LED DRIVER - LINEAR DIMMING 0-10V DOWN TO 1%	120	LITHONIA	#2VTL2 40L ADP E21 LP840		
F1	2 x 2 LED ACRYLIC LENSED PREMIUM TROFFER	RESTROOM	22 GA. STEEL HOUSING	#12 TRANSMISSIVE 0.125" LENS	ENCLOSED SPRING LOADED CAM LATCH, WHITE REGRESSED ALUMINUM DOOR WITH MITERED CORNERS	PAINTED AFTER FABRICATION	RECESSED GYPSUM BOARD OR LAY IN CEILING	4,000	LED	3,300	72000	29	EACH	LED DRIVER - LINEAR DIMMING 0-10V DOWN TO 1%	120	LITHONIA	#2GTL X 2 33L RW E21 LP840		
J2	4-7' LED LOW PROFILE LENSED STRIPLIGHT WITH DROP LENS FOR 10% UPLIGHT	STORAGE AND FACILITY	20 GA. HEAVY DUTY STEEL HOUSING	SYMMETRIC REFLECTOR	COLD ROLLED STEEL	WHITE FINISH, PAINTED AFTER FABRICATION	CHAIN HUNG AT 9'-0" A.F.F. LOCATED AROUND EQUIPMENT	4,000	LED	7,000	50000	30	EACH	LED DRIVER - LINEAR DIMMING 0-10V DOWN TO 1%	120	LITHONIA	#ZL10 L48 SMR 7000LM FST MVOLT 40K 80CRI W/PAF		
M4	6' LED DOWNLIGHT WITH 45 DEGREE CUT OFF	PATIENT ROOMS	18 GA. GALVANIZED STEEL	HIGH-IMPACT, FROSTED POLYCARBONATE LENS	LIGHT ENGINE AND DRIVER ACCESSIBLE THROUGH APERTURE	MATTE WHITE SELF-FLANGED, SEMI-SPECULAR FINISH	RECESSED GYPSUM BOARD OR LAY IN CEILING	4,000	LED	2,000	60000	20	EACH	LED DRIVER - LINEAR DIMMING 0-10V DOWN TO 1%	120	GOTHAM	#EVO6 4020 AR MVD LSS MVOL GT210		
N1	RECESSED LINER PERIMETER COVE SYSTEM CONTINUOUS ROWS - REFER TO ARCHITECTURAL DRAWINGS FOR EXACT LENGTHS	BOARD ROOMS, PERIMETER SYSTEM	EXTRUDED ALUMINUM, 20 GA. COLD ROLLED STEEL INTERNAL WIRING TRAYS	EXTRUDED CLEAR FROST REGRESSED ACRYLIC LENS	N/A	NATURAL ALUMINUM HOUSING, HIGH REFLECTANCE WHITE WHITE FINISH	RECESSED CEILING, VERIFY CEILING TYPE PRIOR TO ORDERING	4,000	LED	109	50000	10	LF	LED DRIVER - LINEAR DIMMING 0-10V DOWN TO 1%	120	MARK ARCHITECTURAL LIGHTINGS	#SPRLED LQP 3FT RLP FL 80CRI 40K 600LM MV1 MVOL1.27		
X1	LED DECORATIVE RECESSED EDGE-LIT EXIT LIGHT, SINGLE FACE	EGRESS	20 GA. GALVANIZED STEEL, EXTRUDED ALUMINUM HOUSING	SATIN ALUMINUM TRIM PLATE, MOLDED TEXTURED LETTERS	N/A	N/A	6 INCH HIGH RED LETTERS ON MIRROR BACKGROUND, DIRECTIONAL CHEVRON INDICATORS AS REQUIRED	0	LED	10	87600	1	EACH	N/A	120	LITHONIA	#LRP 1 RMR 120277		
X2	LED DECORATIVE RECESSED EDGE-LIT EXIT LIGHT, DOUBLE FACE	EGRESS	20 GA. GALVANIZED STEEL, EXTRUDED ALUMINUM HOUSING	SATIN ALUMINUM TRIM PLATE, MOLDED TEXTURED LETTERS	N/A	N/A	6 INCH HIGH RED LETTERS ON MIRROR BACKGROUND, DIRECTIONAL CHEVRON INDICATORS AS REQUIRED	0	LED	15	87600	2	EACH	N/A	120	LITHONIA	#LRP 2 RMR 120277		

LIGHTING CONTROL REQUIREMENTS AND SEQUENCE OF OPERATIONS

TAG	SPACE TYPES	CONTROL		MANUAL CONTROL/OVERRIDE		OCCUPANCY SENSOR		PHOTOCELL CONTROL	
		CONTROL DESCRIPTION	CONTROL SYSTEM TYPE	DEVICE	DURATION	TYPE/LOCATION	SET POINT	CEILING MOUNTED IN DAYLIGHT ZONES OVER 150W, 1 MIN FAD RATE	CEILING MOUNTED IN DAYLIGHT ZONES OVER 150W, 1 MIN FAD RATE
1	PUBLIC AREAS, RECEPTION, CORRIDORS	MANUAL ON TO 100%, MANUAL OFF, DIMMING VIA MANUAL CONTROLS	STAND-ALONE	LINE VOLTAGE SWITCH	N/A	N/A	N/A	CEILING MOUNTED IN DAYLIGHT ZONES OVER 150W, 1 MIN FAD RATE	CEILING MOUNTED IN DAYLIGHT ZONES OVER 150W, 1 MIN FAD RATE
2	RESTROOMS/TOILET	AUTO ON TO 100%, AUTO OFF, MANUAL ON/OFF/DIM	STAND-ALONE	LINE VOLTAGE SWITCH	20 MIN	DUAL-TECH, WALL	AUTO ON/DIM, 20 MIN SET POINT	CEILING MOUNTED IN DAYLIGHT ZONES OVER 150W, 1 MIN FAD RATE	CEILING MOUNTED IN DAYLIGHT ZONES OVER 150W, 1 MIN FAD RATE
3	ENCLOSED ROOMS (OFFICE, BREAK, SUPPORT, ETC)	AUTO ON TO 50%, MANUAL ON TO 100%/OFF/DIM, AUTO OFF	STAND-ALONE	LINE VOLTAGE SWITCH	20 MIN	DUAL-TECH, WALL	AUTO ON 50%, AUTO OFF, 20 MIN SET POINT	CEILING MOUNTED IN DAYLIGHT ZONES OVER 150W, 1 MIN FAD RATE	CEILING MOUNTED IN DAYLIGHT ZONES OVER 150W, 1 MIN FAD RATE
4	ELECTRICAL, MECHANICAL, COMM ROOMS	MANUAL ON/OFF	STAND-ALONE	LINE VOLTAGE SWITCH	N/A	N/A	N/A	CEILING MOUNTED IN DAYLIGHT ZONES OVER 150W, 1 MIN FAD RATE	CEILING MOUNTED IN DAYLIGHT ZONES OVER 150W, 1 MIN FAD RATE
5	ENCLOSED ROOMS (LARGE OFFICE, BREAK, SUPPORT, ETC)	AUTO ON TO 50%, MANUAL ON TO 100%/OFF/DIM, AUTO OFF	STAND-ALONE	LOW VOLTAGE WALL STATION	20 MIN	DUAL-TECH, CEILING	AUTO ON 50%, AUTO OFF, 20 MIN SET POINT	CEILING MOUNTED IN DAYLIGHT ZONES OVER 150W, 1 MIN FAD RATE	CEILING MOUNTED IN DAYLIGHT ZONES OVER 150W, 1 MIN FAD RATE

EXIST: M1NLA

LOCATION: EXTERIOR ELEC 1-ME1131
 MAIN BUS: 225 A
 MCB: N/A
 VOLTAGE: 120/208 WYE
 AIC AVAILABLE: 9970 A
 AIC RATING: 10000 A

NORMAL

FED FROM: MIDP1N1
 WIRES: 4W + G + IG
 ENCLOSURE: NEMA 1
 BUS TYPE: COPPER
 MOUNTING: SURFACE
 PANEL LUGS: N/A
 NUMBER OF SECTIONS: 2

CKT NO.	DESCRIPTION	TOTAL LOAD (VA)	CIRCUIT BREAKER (VA)	A	B	C	CIRCUIT BREAKER (VA)	TOTAL LOAD (VA)	DESCRIPTION	CKT NO.
1	EXISTING LOAD	20	1	1	20	--	EXISTING LOAD	2	2	
3	EXISTING LOAD	20	1	1	20	--	EXISTING LOAD	4	4	
5	EXISTING LOAD	20	1	1	20	--	EXISTING LOAD	6	6	
7	EXISTING LOAD	20	1	1	20	--	EXISTING LOAD	8	8	
9	EXISTING LOAD	20	1	1	20	--	EXISTING LOAD	10	10	
11	EXISTING LOAD	20	1	1	20	--	EXISTING LOAD	12	12	
13	SPARE	15	3	1	20	--	EXISTING LOAD	14	14	
15	SPARE	15	3	1	20	--	EXISTING LOAD	16	16	
17	SPARE	15	3	1	20	--	EXISTING LOAD	18	18	
19	SPARE	20	3	1	20	--	EXISTING LOAD	20	20	
21	SPARE	20	3	1	20	--	EXISTING LOAD	22	22	
23	SPARE	20	3	1	20	--	EXISTING LOAD	24	24	
125	SPARE	20	3	1	20	--	EXISTING LOAD	126	126	

LOAD CLASSIFICATION	CONNECTED LOAD (VA)	ESTIMATED DEMAND (VA)		PANEL TOTALS	
		56 A / 100 A / 83 A	56 A / 100 A / 83 A	KVA	AMPS
LGHT	1,576	1,969		35.2	97.8
RCPT	24,580	17,290		26.6	73.8
				28.2	72.6
				34.8	96.5
				27.9	77.4

NOTES: EXISTING LOAD IS BASED ON DESIGN LOAD FROM AN ONGOING PROJECT AT THE FACILITY.

EXIST: M1ELK

LOCATION: ELEC 1-ME1072
 MAIN BUS: 225 A
 MCB: N/A
 VOLTAGE: 120/208 WYE
 AIC AVAILABLE: EXISTING
 AIC RATING: 10000 A

EMERGENCY

FED FROM: MIDPEL1
 WIRES: 4W + G
 ENCLOSURE: NEMA 1
 BUS TYPE: COPPER
 MOUNTING: SURFACE
 PANEL LUGS: MLO
 NUMBER OF SECTIONS: 2

CKT NO.	DESCRIPTION	TOTAL LOAD (VA)	CIRCUIT BREAKER (VA)	A	B	C	CIRCUIT BREAKER (VA)	TOTAL LOAD (VA)	DESCRIPTION	CKT NO.
1	EXISTING LOAD	20	1	1	20	--	EXISTING LOAD	2	2	
3	EXISTING LOAD	20	1	1	20	--	EXISTING LOAD	4	4	
5	EXISTING LOAD	20	1	1	20	--	EXISTING LOAD	6	6	
7	EXISTING LOAD	20	1	1	20	--	EXISTING LOAD	8	8	
9	EXISTING LOAD	20	1	1	20	--	EXISTING LOAD	10	10	
11	SPARE	20	1	1	20	--	EXISTING LOAD	12	12	
13	SPARE	15	3	1	20	--	EXISTING LOAD	14	14	
15	SPARE	15	3	1	20	--	EXISTING LOAD	16	16	
17	SPARE	15	3	1	20	--	EXISTING LOAD	18	18	
19	SPARE	20	3	1	20	--	EXISTING LOAD	20	20	
21	SPARE	20	3	1	20	--	EXISTING LOAD	22	22	
23	SPARE	20	3	1	20	--	EXISTING LOAD	24	24	
25	SPARE	20	3	1	20	--	EXISTING LOAD	26	26	
27	SPARE	20	3	1	20	--	EXISTING LOAD	28	28	
29	SPARE	20	3	1	20	--	EXISTING LOAD	30	30	
31	SPARE	20	3	1	20	--	EXISTING LOAD	32	32	
33	EXISTING LOAD	20	1	1	20	--	EXISTING LOAD	34	34	
35	EXISTING LOAD	20	1	1	20	--	EXISTING LOAD	36	36	
37	EXISTING LOAD	20	1	1	20	--	EXISTING LOAD	38	38	
39	SPARE	20	1	1	20	--	EXISTING LOAD	40	40	
41	SPARE	20	1	1	20	--	EXISTING LOAD	42	42	
43	ADMIN ACCU-1	4,784	30	2	1	20	--	EXISTING LOAD	44	44
45	ADMIN VAVS	500	20	1	1	20	--	EXISTING LOAD	46	46
47	ADMIN VAVS	500	20	1	1	20	--	EXISTING LOAD	48	48
49	RCPT - BOARD ROOM 2-2011	1,440	20	1	1	20	--	EXISTING LOAD	50	50
51	RCPT - COMM 2-2016	180	20	1	1	20	--	EXISTING LOAD	52	52
53	RCPT - COMM 2-2016	180	20	1	1	20	--	EXISTING LOAD	54	54
55	AC-1 COND PUMP	200	20	1	1	20	--	EXISTING LOAD	56	56
57	SPARE	20	1	1	20	--	EXISTING LOAD	58	58	
59	EXISTING LOAD	20	1	1	20	--	EXISTING LOAD	60	60	
61	EXISTING LOAD	20	1	1	20	--	EXISTING LOAD	62	62	
63	RCPT - COMM 2-2016	180	20	1	1	20	--	EXISTING LOAD	64	64
65	SPARE	20	1	1	20	--	EXISTING LOAD	66	66	
67	SPARE	20	1	1	20	--	EXISTING LOAD	68	68	
69	SPARE	20								

GENERAL NOTES

- A. ALL PLUMBING WORK SHALL COMPLY WITH ALL APPLICABLE FEDERAL, STATE AND LOCAL BUILDING CODES AND ORDINANCES INCLUDING, BUT NOT LIMITED TO, THE LEE'S SUMMIT, MISSOURI, PLUMBING AND BUILDING CODES & ORDINANCES, NFPA 13 & 14, THE AMERICAN DISABILITIES ACT AND THE LIFE SAFETY CODE. IT IS A REQUIREMENT OF THIS CONTRACT THAT THE CONTRACTOR BE EXPERIENCED IN THIS TYPE OF WORK AND BE THOROUGHLY FAMILIAR WITH THE REQUIREMENTS OF THE APPLICABLE CODES, WHETHER SPECIFICALLY REFERRED TO IN THE DOCUMENTS OR NOT.
- B. THE CONTRACTOR SHALL OBTAIN ALL NECESSARY PERMITS AND PAY ALL NECESSARY FEES FOR THE PLUMBING WORK.
- C. THE CONTRACTOR SHALL FURNISH ALL MATERIALS, EQUIPMENT, AND LABOR REQUIRED TO PROVIDE COMPLETE AND WORKING PLUMBING SYSTEMS, AS DESCRIBED IN THE CONTRACT DOCUMENTS, AND FULLY COORDINATED WITH ALL OTHER TRADES.
- D. REFER TO THE SPECIFICATIONS, THE DRAWINGS AND MANUFACTURER'S CUT SHEETS FOR COMPLETE INFORMATION ON MATERIALS AND METHODS REQUIRED TO INSTALL THE PLUMBING SYSTEMS.
- E. ALL PLUMBING WORK DONE UNDER THIS CONTRACT SHALL BE ACCOMPLISHED IN A SKILLED WORKMANLIKE AND PROFESSIONAL MANNER.
- F. ALL PLUMBING AND FIRE PROTECTION PIPING SHALL BE INDEPENDENTLY SUPPORTED, AND EACH SUPPORT SHALL BE INDEPENDENT OF PARTITION AND CEILING SYSTEM SUPPORTS. WHERE INDEPENDENT SUPPORT IS NOT POSSIBLE AN ENGINEERED SUPPORT SYSTEM SHALL BE UTILIZED. HOLD ALL PIPING IN CEILING SPACES HIGH TO STRUCTURE AS POSSIBLE.
- G. ALL WORK SHALL BE SCHEDULED AND PERFORMED IN COORDINATION WITH ARCHITECTURAL PLANS, PROJECT SCHEDULES AND HOSPITAL OPERATIONS & REQUIREMENTS. COORDINATE ALL REQUIRED SHUT DOWN OF SYSTEMS OR OUT OF PHASE WORK WITH THE OWNER'S REPRESENTATIVE & HOSPITAL PERSONNEL.
- H. THE CONTRACTOR SHALL PROTECT THE PLUMBING EQUIPMENT AND FIXTURES FROM DAMAGE DURING HANDLING AND INSTALLATION UNTIL THE PROJECT IS COMPLETED. ANY EQUIPMENT OR FIXTURE THAT IS DAMAGED DURING CONSTRUCTION SHALL BE REPAIRED OR REPLACED, AT THE ARCHITECT AND ENGINEER'S DISCRETION, AND AT THE CONTRACTOR'S EXPENSE.
- I. THE CONTRACTOR SHALL REMOVE ALL EXCESS MATERIAL AND DEBRIS AND CLEAN ALL EQUIPMENT AND FIXTURES UPON COMPLETION OF THE PROJECT.
- J. THE CONTRACTOR SHALL VISIT THE JOB SITE PRIOR TO BIDDING TO VERIFY THE EXACT SIZE AND LOCATION OF ALL EXISTING PIPING RELATED TO HIS WORK.
- K. THE CONTRACTOR SHALL COORDINATE THE PLUMBING WORK WITH ALL OTHER TRADES. WORK SHOWN ON THE DRAWINGS IS INTENDED TO PROVIDE THE OVERALL ENGINEERING DESIGN CONCEPT AND MAY REQUIRE RELOCATIONS, FIELD ADJUSTMENTS OR OFFSETS TO COORDINATE WITH OTHER TRADES AND THE BUILDING STRUCTURE. COSTS FOR ALL SUCH MINOR FIELD ADJUSTMENTS SHALL BE INCLUDED IN THE CONTRACTOR'S BID.
- L. IT IS THE REQUIREMENT OF THESE DOCUMENTS TO ALLOW ALL CEILINGS TO BE CONSTRUCTED AT HEIGHTS AS SHOWN ON THE ARCHITECTURAL DRAWINGS. COORDINATE THE LOCATION OF PIPING AND PROVIDE OFFSETS IN PIPING AS REQUIRED TO MEET THIS REQUIREMENT.
- M. THE CONTRACTOR SHALL PROVIDE DETAILED AND DIMENSIONED PIPING FABRICATION DRAWINGS FOR APPROVAL BY THE ARCHITECT/ENGINEER. ONE BLUE LINE SET OF THE APPROVED DRAWINGS SHALL BE KEPT ON-SITE AT ALL TIMES AND ANY CHANGES REQUIRED IN THE FIELD SHALL BE MARKED ON THESE DRAWINGS. AT THE END OF THE PROJECT, ALL CHANGES SHALL BE TRANSFERRED TO A REPRODUCIBLE DRAWING TO BE GIVEN TO THE OWNER FOR "AS-BUILT" DRAWINGS. REPRODUCTIONS OF THIS DRAWING WILL NOT BE CONSIDERED AS PIPING FABRICATION DRAWINGS.
- N. ALL PLUMBING EQUIPMENT OR VALVES REQUIRING ACCESS THAT ARE LOCATED ABOVE GYP. BOARD OR OTHERWISE INACCESSIBLE CEILINGS SHALL BE PROVIDED WITH A CEILING ACCESS PANEL SUPPLIED AND INSTALLED BY THE GENERAL CONTRACTOR. THE MECHANICAL CONTRACTOR SHALL COORDINATE THE EXACT LOCATION OF THESE ACCESS PANELS WITH THE GENERAL CONTRACTOR.
- O. LOCATE ISOLATION VALVES FOR EQUIPMENT AND FIXTURES AS CLOSE TO THE MAIN AS POSSIBLE. PROVIDE CEILING OR WALL ACCESS PANELS AS NEEDED.

PLUMBING NOTES GENERAL NOTES, CONT.

- P. COORDINATE ALL WALL MOUNTED DEVICE LOCATIONS WITH ARCHITECTURAL INTERIOR ELEVATIONS.
- Q. ALL CONNECTIONS BETWEEN PIPES OF DISSIMILAR MATERIALS SHALL BE MADE WITH ELECTRIC UNIONS.
- R. ALL PLUMBING PIPING SHALL BE IDENTIFIED AS DESCRIBED IN THE SPECIFICATIONS.
- S. ALL PLUMBING VALVES SHALL BE TAGGED AND NOTED ON THE "AS-BUILT" DRAWINGS.
- T. SLOPE AND ARRANGE WATER PIPING SYSTEMS TO ESTABLISH HIGH POINTS FOR AIR ELIMINATION AND LOW POINTS TO PERMIT PROPER DRAINING OF EACH SECTION.
- U. COORDINATE ALL PIPING PENETRATIONS THROUGH THE ROOF AND FLOOR WITH THE BUILDING'S STRUCTURE. REFER TO THE PLUMBING PENETRATION DETAILS, THE ARCHITECTURAL DRAWINGS AND THE PLUMBING SPECIFICATIONS FOR SLEEVING AND SUPPORT INFORMATION.
- V. PROVIDE CLEANOUTS AT THE BASE OF ALL STORM AND SANITARY STACKS AND IN INDIVIDUAL WASTE & VENT STACKS AS SHOWN ON THE RISERS.
- W. LOCATE VENTS THROUGH THE ROOF AT LEAST 2' AWAY FROM ALL FRESH AIR INTAKES OR BUILDING OPENINGS.
- X. LOCATE ALL WALL CLEANOUTS 18" ABOVE THE FINISHED FLOOR.
- Y. PROVIDE BACKFLOW PREVENTION DEVICES APPROVED BY THE AHJ FOR ALL ITEMS OF EQUIPMENT THAT ARE REQUIRED BY THE AHJ TO HAVE CROSS CONTAMINATION PROTECTION, WHETHER SHOWN ON THE DRAWINGS OR NOT.
- Z. PROVIDE A PRV AT THE DOMESTIC WATER SERVICE ENTRANCE TO LIMIT WATER SYSTEM PRESSURE TO THE BUILDING TO 80 PSI.
- AA. RUN ALL PIPING IN WALLS, CHASES AND ABOVE THE CEILING. PROVIDE CHROME PLATED PIPING WHERE EVER PIPING HAS TO BE EXPOSED.
- BB. PROVIDE DRIP PANS UNDER PLUMBING LINES WERE REQUIRED BY CODE AND/OR THE OWNER.
- CC. PROVIDE ACCESS TO ALL VALVES AND TRAP PRIMERS.

PLUMBING ABBREVIATIONS

ABV	ABOVE	GPM	GALLONS PER MINUTE
AFF	ABOVE FINISHED FLOOR	GW	GREASE WASTE
AFG	ABOVE FINISH GRADE	HB	HOSE BIBB
AP	ACCESS PANEL	HD	HUB DRAIN
AD	AREA DRAIN	HW	HOT WATER
BFF	BELOW FINISH FLOOR	HWR	HOT WATER RETURN
BIG	BELOW GRADE	I.E.	INVERT ELEVATION
BV	BALANCING VALVE	L	LAVATORY
CA	COMPRESSED AIR	MH	MANHOLE
CO	CLEAN OUT	MS	MOP SINK
CSS	CLINICAL SERVICE SINK	NC	NORMALLY CLOSED VALVE
CW	COLD WATER	NO	NORMALLY OPEN VALVE
DD	DECK DRAIN	NFWH	NON-FREEZE WALL HYDRANT
DF	DRINKING FOUNTAIN	NFHH	NON-FREEZE YARD HYDRANT
DN	DOWN	OS&V	OUTSIDE STEM AND YOKE
DS	DOWNSPOUT	PD	PLANTER DRAIN
DSN	DOWNSPOUT NOZZLE	PRV	PRESSURE REDUCING VALVE
ESH	EMERGENCY SHOWER	T&V	THERMOSTATIC MIXING VALVE
EW	EYE WASH	T&P	TEMPERATURE AND PRESSURE VALVE
EWC	ELECTRIC WATER COOLER	TP	TRAP PRIMER
FCVA	FLOOR CONTROL VALVE ASSEMBLY	V	VENT PIPING
FCO	FLOOR CLEANOUT	VB	VACUUM BREAKER
FD	FLOOR DRAIN	VTR	VENT THROUGH ROOF
FS	FLOOR SINK	WB	WALL BOX
GC	GENERAL CONTRACTOR		
GCO	GRADE CLEANOUT		

DEMOLITION NOTES

- A. ALL SECTIONS OF PLUMBING PIPING THAT ARE SHOWN TO BE DEMO'D SHALL BE REMOVED BACK TO MAINS, OR NEAREST ACTIVE LINES, AND CAPPED OR PLUGGED SO THAT NO DEAD ENDS ARE CREATED.
- B. ALL DEMOLITION WORK SHALL BE SCHEDULED AND PERFORMED IN STRICT COORDINATION WITH ARCHITECTURAL PHASING PLANS, HOSPITAL SCHEDULES, AREA OCCUPANCIES AND OTHER TRADES.
- C. ALL DEMOLISHED ITEMS THAT ARE NOT RETAINED BY THE OWNER AND ARE NOT CALLED OUT TO BE REINSTALLED BY THE CONTRACT DOCUMENTS SHALL BE DISPOSED OF LEGALLY.
- D. ANY EXISTING PLUMBING RISERS EXPOSED BY THE REMOVAL OF EXISTING WALLS OR CHASES SHALL BE RELOCATED TO A NEARBY LOCATION AS NOTED ON THE DRAWINGS OR AS APPROVED BY THE ARCHITECT.
- E. THE CONTRACTOR SHALL REPLACE ALL DAMAGED CEILING TILES AND REPAIR ALL DAMAGED WALL FINISHES DURING DEMOLITION WORK.
- F. PROVIDE ADDITIONAL VALVES, FITTINGS AND/OR PIPING AS NECESSARY TO PROVIDE UNINTERRUPTED SERVICE TO AREAS OUTSIDE AND INSIDE OF THE AREA WHERE WORK IS BEING PERFORMED.
- G. INFORMATION PROVIDED ON THESE DRAWINGS HAS BEEN TAKEN FROM DESIGN DRAWINGS AND FIELD OBSERVATIONS. THE CONTRACTOR SHALL VERIFY ALL EXISTING CONDITIONS PRIOR TO PRICING AND COMMENCEMENT OF WORK.
- H. ALL EXISTING PIPING THAT IS CAPPED OFF OR PLUGGED DURING DEMOLITION SHALL BE CHECKED FOR LEAKS.
- I. PROVIDE AND INSTALL ALL NECESSARY PIPING AND ACCESSORIES REQUIRED TO MAINTAIN SERVICE TO ALL "EXISTING TO REMAIN" FIXTURES AND EQUIPMENT THAT MAY BE INTERRUPTED DURING DEMOLITION.
- J. WHERE EXISTING MECHANICAL EQUIPMENT IS DEMOLISHED, REMOVE ALL RELATED PLUMBING TO THE EQUIPMENT AND THEIR ASSOCIATED PIPING BACK TO THE POINT OF ORIGINATING.
- K. ANY FLOOR DRAIN OR FLOOR SINK INDICATED TO BE REMOVED SHALL BE REMOVED COMPLETELY.
- L. EXISTING FIXTURES AND EQUIPMENT NOT INDICATED TO BE REMOVED SHALL REMAIN IN USE.

PROJECT DESIGN CRITERIA

LOCATION:	LEE'S SUMMIT, MO
CITY/STATE:	
APPLICABLE CODES:	2018 INTERNATIONAL BUILDING CODE 2018 INTERNATIONAL MECHANICAL CODE 2018 INTERNATIONAL PLUMBING CODE 2018 INTERNATIONAL FIRE CODE 2017 INTERNATIONAL ELECTRICAL CODE

PLUMBING PIPING MATERIAL SCHEDULE

DOMESTIC WATER

- HARD COPPER TUBE, ASTM B 88, TYPE L WATER TUBE, DRAWN TEMPER
- HARD COPPER TUBE, ASTM B 88, TYPE L COPPER PRESSURE-SEAL FITTINGS, AND PRESSURE-SEAL JOINTS.

UNDER-BUILDING-SLAB, DOMESTIC WATER PIPING, NPS 2 AND SMALLER

- SOFT COPPER TUBE, ASTM B 88, TYPE K, NO JOINTS BELOW GRADE.

SANITARY WASTE AND VENT

ABOVE GROUND SOIL AND WASTE PIPING

- SERVICE CLASS, CAST-IRON SOIL PIPE AND FITTINGS; GASKETS, AND GASKETED JOINTS.
- HUBLESS CAST-IRON SOIL PIPE AND FITTINGS; HEAVY-DUTY SHIELDED, STAINLESS-STEEL COUPLINGS; AND HUBLESS-COUPLING JOINTS.
- COPPER DWV TUBE, COPPER DRAINAGE FITTINGS, AND SOLDERED JOINTS.

ABOVE GROUND VENT PIPING

- SERVICE CLASS, CAST-IRON SOIL PIPE AND FITTINGS; GASKETS, AND GASKETED JOINTS.
- HUBLESS CAST-IRON SOIL PIPE AND FITTINGS; HEAVY-DUTY SHIELDED, STAINLESS-STEEL COUPLINGS; AND HUBLESS-COUPLING JOINTS.
- COPPER DWV TUBE, COPPER DRAINAGE FITTINGS, AND SOLDERED JOINTS.

UNDER GROUND SOIL AND WASTE PIPING

- SERVICE CLASS, CAST-IRON SOIL PIPING; GASKETS, AND GASKETED JOINTS.
- SOLID WALL PVC PIPE, PVC SOCKET FITTINGS, AND SOLVENT-CEMENTED JOINTS.

PLUMBING SYMBOLS

ALL SYMBOLS SHOWN MAY NOT APPEAR IN ALL DRAWINGS

SYMBOL	DESCRIPTION	SYMBOL	DESCRIPTION
	DOMESTIC COLD WATER (CW)		PRESSURE GAUGE WITH GAUGE COCK
	DOMESTIC HOT WATER (HW)		THERMOMETER WITH GAUGE COCK
	DOMESTIC HOT WATER RETURN (HWR)		HOSE BIBB (HB)
	NON-POTABLE WATER		FLOOR CLEANOUT OR GRADE CLEANOUT (FCO, GCO)
	TRAP PRIMER LINE (1/2")		WALL CLEANOUT (WCO)
	TEMPERED WATER		CLEANOUT PLUG
	COLD OR HOT REDUCED PRESSURE PRINCIPLE BACKFLOW PREVENTER (RPP)		DIRECTION OF SLOPE - GRAVITY PIPING
	EXISTING PIPING TO REMAIN		DIRECTION OF FLOW - PRESSURE PIPING
	EXISTING PIPING TO BE REMOVED		PIPING CAPPED OFF
	SANITARY SEWER/WASTE PIPING		SANITARY VENT PIPING
	SANITARY VENT PIPING		BALANCING VALVE
	INDIRECT WASTE		STRAINER
	CONNECT NEW TO EXISTING		SHOCK ARRESTOR
	STORM DRAIN PIPING		HUB DRAIN (HD)
	OVERFLOW STORM DRAIN PIPING		FLOOR DRAIN (FD)
	COMPRESSED AIR PIPING		LEGEND NOTE
	GREASY WASTE		FUEL OIL SUPPLY PIPING
	SUBSOIL/PERIMETER DRAIN PIPING		FUEL OIL RETURN PIPING
	BUTTERFLY VALVE		DRY FIRE STANDPIPE PIPING
	BALL VALVE		SPRINKLER PIPING
	GLOBE VALVE		DRY SPRINKLER PIPING
	TEMPERATURE AND PRESSURE RELIEF VALVE		FIRE PROTECTION PIPING
	GAS COCK / PLUG VALVE		CONNECT TO EXISTING
	SOLENOID VALVE		DEMOLISH TO
	PRESSURE REGULATING VALVE		
	CHECK VALVE		
	GATE VALVE		



Devenney Group Ltd., Architects
6900 East Camelback Road
Suite 500
Scottsdale, AZ 85251
T: 602.943.8950
www.devenneygroup.com

Consultant:



IF THESE PLANS DO NOT BEAR THE SEAL OF A REGISTERED PROFESSIONAL ENGINEER, THEY ARE TO BE CONSIDERED "PRELIMINARY" AND ARE NOT TO BE USED FOR CONSTRUCTION OR RECORDING. THESE PLANS ARE COPYRIGHTED AND ARE SUBJECT TO COPYRIGHT PROTECTION. ANY REPRODUCTION OR TRANSMISSION OF THESE PLANS WITHOUT THE WRITTEN PERMISSION OF WSP USA BUILDINGS INC. IS STRICTLY PROHIBITED. THE PROTECTION RELIEVES BUT IS NOT LIMITED TO THE OVERALL FORM AS WELL AS THE ARRANGEMENT AND COMPOSITION OF SPACES AND ELEMENTS OF THE DESIGN. UNDER SUCH PROTECTION, UNAUTHORIZED USE OF THESE PLANS CAN LEGALLY RESULT IN THE OBTAINING OF CONSTRUCTION OR RECORDING BEING SUED AND/OR INDEMNITY COMPENSATION TO DEVENEY GROUP LTD.

ADMINISTRATION RELOCATION

HCA - LEE'S SUMMIT MEDICAL CENTER
2000 SE BLUE PKWY
LEE'S SUMMIT, MO 64063

AUTHORITY HAVING JURISDICTION:
CITY OF LEE'S SUMMIT BUILDING DEPT.
MISSOURI DHSS

FACILITY NUMBER:
097240009


AGENCY APPROVALS:

REVISIONS		
REV #	DESCRIPTION	DATE
A	CITY - 2ND REVIEW	2025/05/29
B	CITY - 3RD REVIEW	2025/07/18

DATE: 04/18/2025
SCALE: 1/8" = 1'-0"
DRAWN: CD
REVIEWED: LW
JOB NUMBER: 6406.24

GENERAL INFORMATION - PLUMBING

P00-00

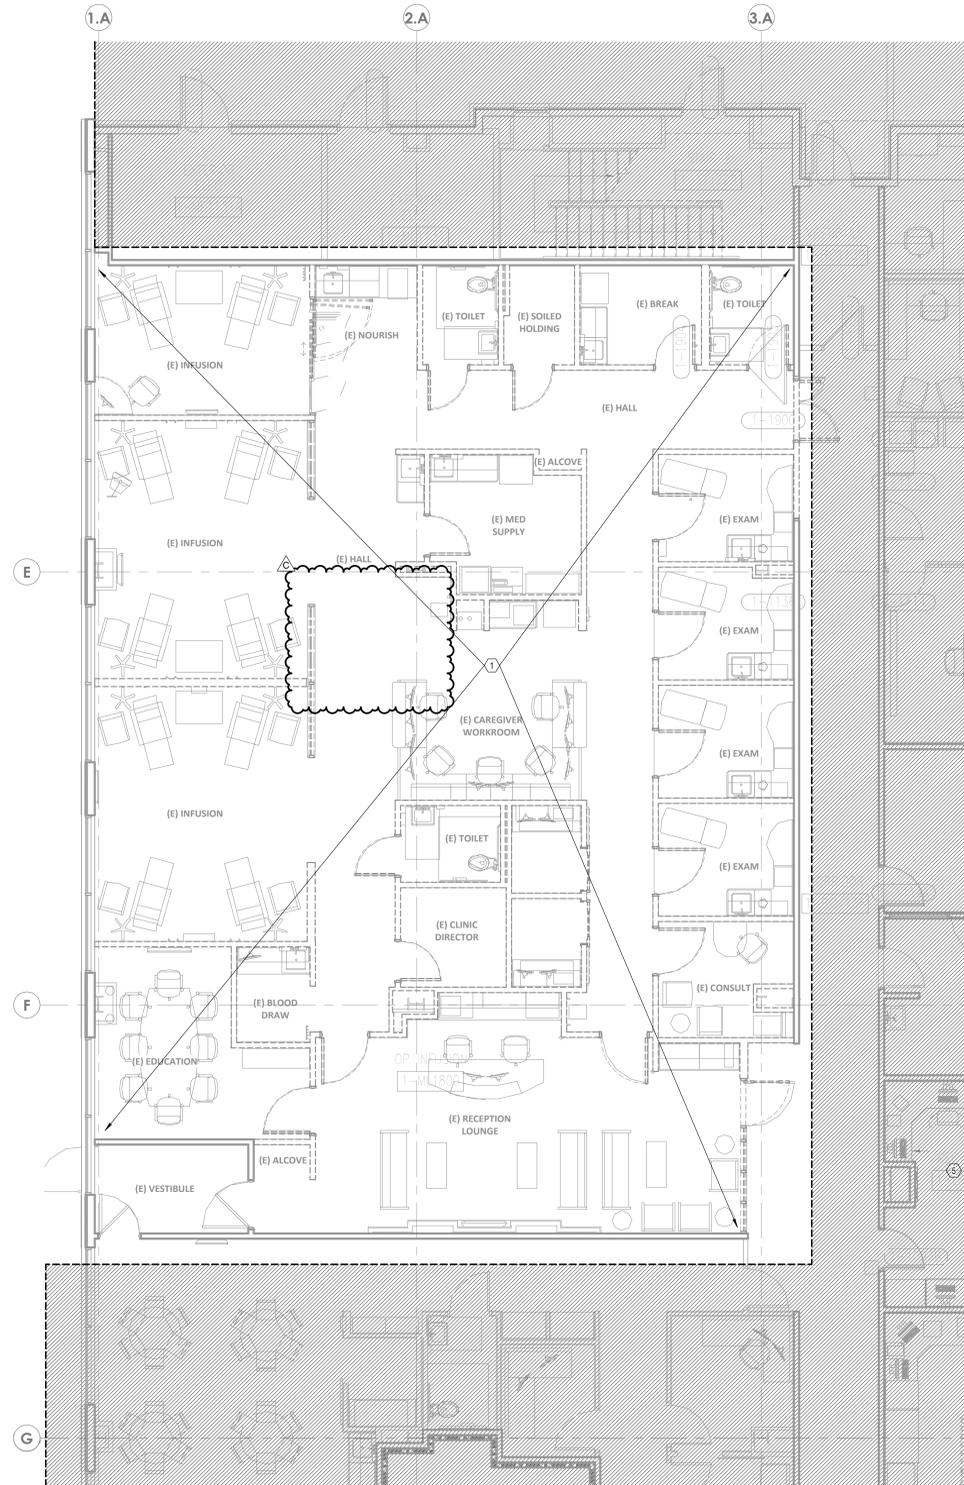

1 DEMOLITION PLAN - LEVEL 1 - ADMIN - COMMUNICATIONS
3/16" = 1'-0"

GENERAL NOTES:

- A. ALL EXISTING DEVICES MAY NOT BE SHOWN ON PLAN. CONTRACTOR SHALL FIELD VERIFY EXISTING CONDITIONS AND COORDINATE WITH ARCHITECTURAL PLANS AND OTHER TRADES TO DETERMINE THE OUTCOME OF EACH DEVICE. WHERE NO CONSTRUCTION IS TO OCCUR, EXISTING DEVICES SHALL BE PROTECTED IN PLACE AND REMAIN IN OPERATION THROUGHOUT DURATION OF ALL PROJECT PHASES.
- B. INFORMATION PROVIDED ON THESE DRAWINGS HAVE BEEN TAKEN FROM DESIGN DRAWING AND FIELD OBSERVATIONS. CONTRACTOR SHALL VERIFY ALL EXISTING CONDITIONS PRIOR TO PRICING AND COMMENCEMENT OF WORK.
- C. PROVIDE FOR ANY AND ALL DEMOLITION WORK NECESSARY TO ACCOMMODATE ALL NEW CONSTRUCTION, INCLUDING ARCHITECTURAL, MECHANICAL, PLUMBING AND/OR ELECTRICAL WORK.
- D. WHERE EXISTING WALLS ARE BEING DEMOLISHED, REMOVE ALL EXISTING COMMUNICATIONS/LOW VOLTAGE DEVICES AND THEIR ASSOCIATED CONDUITS, BACKBOXES AND CABLING BACK TO POINT OF ORIGIN. EXISTING CABLING PASSING THROUGH DEMO AREA, NOT BEING DEMOLISHED, SHALL BE SUPPORTED UTILIZING J-HOOK CABLE SUPPORTS INSTALLED PER DIVISION 27 SPECIFICATIONS.
- E. CONTRACTOR SHALL COORDINATE THE REMOVAL OR RELOCATION OF ALL COMMUNICATIONS/LOW VOLTAGE DEVICES INCLUDING BUT NOT LIMITED TO VOICE, DATA, OVERHEAD PAGING, VIDEO SURVEILLANCE CAMERAS, PHYSIOLOGICAL MONITORING, TELEMETRY, NURSE CALL, SECURITY ACCESS CONTROL, ETC.) WITH ARCHITECTURAL DRAWINGS.
- F. CONTRACTOR IS RESPONSIBLE FOR RESTORATION OF DAMAGE TO FIREPROOFING, FINISHES OR STRUCTURE CAUSED BY TELECOM/LOW-VOLTAGE, OR SECURITY CONTRACTORS. RESTORATION SHALL BE RESTORED TO "SAME CONDITION" AS BEFORE DAMAGE OCCURRED. CONTRACTOR SHALL OBTAIN WRITTEN ACCEPTANCE OF RESTORATION FROM OWNER. IF DEMOLITION IS REQUIRED TO INSTALL AN ITEM, THE CONTRACTOR SHALL RESTORE THE AREA TO PREVIOUS CONDITION, OR REPLACE DAMAGED ITEMS WITH NEW ITEMS TO MATCH EXISTING.
- G. WHERE AREAS BEING DEMOLISHED CONTAIN INFANT PROTECTION SYSTEM (IPS) DEVICES, CONTRACTOR SHALL DISABLE IPS EQUIPMENT AND PROVIDE INTERIM SYSTEM PROGRAMMING PRIOR TO REMOVAL TO PREVENT FALSE ALARMING AND LOCKDOWN OF DEMOLITION AREA.

LEGEND NOTES

- 1. EXISTING WALL MOUNTED AND CEILING DEVICES AND ASSOCIATED CABLING, CONDUIT AND BACKBOXES WITHIN WALL/AREA SHALL BE DEMOLISHED TO POINT OF ORIGIN. EXISTING CABLING ROUTING THROUGH THIS AREA THAT IS NOT TO BE DEMOLISHED SHALL BE SUPPORTED BY J-HOOK STYLE SUPPORTS INSTALLED PER DIVISION 27 SPECIFICATIONS.



Devenney Group Ltd., Architects
6900 East Camelback Road
Suite 500
Scottsdale, AZ 85251
T: 602.943.8950
www.devenneygroup.com



IF THESE PLANS DO NOT BEAR THE SEAL OF A REGISTERED PROFESSIONAL ENGINEER, THEY ARE TO BE CONSIDERED PRELIMINARY AND ARE NOT TO BE USED FOR CONSTRUCTION OR RECORDING. THESE PLANS ARE COPYRIGHTED AND ARE SUBJECT TO COPYRIGHT PROTECTION BY WSP USA BLDG INC. UNDER SEC. 105 OF THE COPYRIGHT ACT, 17 U.S.C. AS AMENDED DECEMBER 1990 AND KNOWN AS ARCHITECTURAL WORKS COPYRIGHT PROTECTION ACT OF 1990. THE PROTECTION HELD HEREIN IS NOT LIMITED TO THE OVERALL FORM AS WELL AS THE ARRANGEMENT AND COMPOSITION OF SPACES AND ELEMENTS OF THE DESIGN. UNDER SUCH PROTECTION, UNAUTHORIZED USE OF THESE PLANS CAN LEGALLY RESULT IN THE SEIZURE OF CONSTRUCTION MATERIALS BEING SEIZED AND/OR MONETARY COMPENSATION TO DEVENNEY GROUP LTD.

ADMINISTRATION RELOCATION

HCA - LEE'S SUMMIT MEDICAL CENTER
2000 SE BLUE PKWY
LEE'S SUMMIT, MO 64063


AUTHORITY HAVING JURISDICTION:
CITY OF LEE'S SUMMIT BUILDING DEPT.
MISSOURI DHSS

FACILITY NUMBER:
097240009

AGENCY APPROVALS:

REVISIONS		
REV #	DESCRIPTION	DATE
A	CITY - 2ND REVIEW	2025/05/29
C	DESIGN COORDINATION	2025/07/18

LEVEL 1 - KEYPLAN

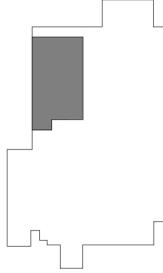

DATE: 04/18/2025
SCALE: 3/16" = 1'-0"
DRAWN: FT
REVIEWED: MC
JOB NUMBER: 6406.24

DEMOLITION PLAN - LEVEL 1 - ADMIN - COMMUNICATIONS

TD02-01

Notice of Alternate Billing or Payment Cycle: The Owner may plan to make payments on an alternative schedule. A written description of such billing or payment cycle applicable to the Project is available from the Owner or the Owner's designated agent upon request.

Autodesk Docx/16406.24 - HCA - Lee's Summit Medical Center (LSMC) - r123/MEP - LSMC Admin Relocation - R2.3.rvt 7/16/2025 4:44:03 PM



IF THESE PLANS DO NOT BEAR THE SEAL OF A REGISTERED PROFESSIONAL ENGINEER, THEY ARE TO BE CONSIDERED PRELIMINARY AND ARE NOT TO BE USED FOR CONSTRUCTION OR RECORDING. THESE PLANS ARE COPYRIGHTED AND ARE SUBJECT TO COPYRIGHT PROTECTION BY WSP USA BULLHORN INC. UNDER SEC. 108 OF THE COPYRIGHT ACT, 17 U.S.C. AS AMENDED DECEMBER 1990 AND KNOWN AS ARCHITECTURAL WORKS COPYRIGHT PROTECTION ACT OF 1990. THE PROTECTION HELD HEREIN IS NOT LIMITED TO THE OVERALL FORM AS WELL AS THE ARRANGEMENT AND COMPOSITION OF SPACES AND ELEMENTS OF THE DESIGN. UNDER SUCH PROTECTION, UNAUTHORIZED USE OF THESE PLANS CAN LEGALLY RESULT IN THE SEIZURE OF CONSTRUCTION OR BUILDINGS BEING SEIZED AND/OR MONETARY COMPENSATION TO DEVENNEY GROUP LTD.

**ADMINISTRATION
RELOCATION**

HCA - LEE'S SUMMIT MEDICAL
CENTER
2000 SE BLUE PKWY
LEE'S SUMMIT, MO 64063

AUTHORITY HAVING JURISDICTION:
CITY OF LEE'S SUMMIT BUILDING DEPT.
MISSOURI DHS

FACILITY NUMBER:
097240009

AGENCY APPROVALS:

REVISIONS		
REV #	DESCRIPTION	DATE
A	CITY - 2ND REVIEW	2025/05/29
C	DESIGN COORDINATION	2025/07/18


DATE: 04/18/2025
SCALE: 3/16" = 1'-0"
DRAWN: FT
REVIEWED: MC
JOB NUMBER: 6406.24

FLOOR PLAN - LEVEL 1 -
ADMIN - LOW VOLTAGE

T03-01


GENERAL NOTES:

- REFER TO AND COORDINATE WITH ARCHITECTURAL PLANS, ELEVATIONS, AND DETAILS FOR EXACT LOCATIONS OF ALL DEVICES.
- REFER TO SHEET T03-00 FOR GENERAL NOTES AND SYMBOLS APPEARING ON THIS SHEET.
- ALL DEVICES WITHIN ROOMS CONTAINING HARD PAN CEILINGS SHALL HAVE CONDUITS ROUTED TO ABOVE ACCESSIBLE CEILING SPACE IN CORRIDOR.
- COMMUNICATIONS CONDUIT PATHWAYS SHALL NOT CONTAIN ANY LENGTH GREATER THAN 100 FEET BETWEEN PULL POINTS. NO SECTION OF CONDUIT SHALL CONTAIN MORE THAN TWO 90 DEGREE BENDS OR EQUIVALENT BETWEEN PULL POINTS. IF THERE IS REVERSE BEND IN THE SECTION, A PULL POINT SHALL BE INSTALLED. PULL BOXES SHALL NOT BE USED IN LIEU OF BENDS. THE INSIDE RADIUS OF ALL CONDUIT BENDS SHALL BE AT LEAST 10 TIMES THE INTERNAL DIAMETER. BENDS IN CONDUIT SHALL NOT CONTAIN ANY KINKS OR OTHER DISCONTINUITIES THAT MAY HAVE A DETRIMENTAL EFFECT ON THE CABLE SHEATH DURING INSTALLATION. NO DAISY CHAINING OF BACK BOXES ALLOWED UNLESS OTHERWISE NOTED.
- ALL CABLING SHALL BE SUPPORTED ABOVE ACCESSIBLE CEILING SPACE USING LOW-VOLTAGE SUPPORTS SIZED AT 40% FILL BASED ON CURRENT NEEDS.
- ALL OVERHEAD PAGING SPEAKERS SHOWN SHALL BE DAISY-CHAINED USING PUBLIC ADDRESS CALL CABLE TYPE "S".
- CONTRACTOR SHALL SIZE PAGING AMPLIFIER TO PROVIDE A 40% GROWTH RATE AT TIME OF INSTALLATION. OVERHEAD PAGING EQUIPMENT WILL BE HOUSED IN ONE IDF ROOM PER FLOOR AS NOTED PER ENLARGED FLOOR PLANS.
- CONTRACTOR SHALL LABEL BOTH ENDS OF NURSE CALL CABLE TO CLEARLY IDENTIFY WHAT ROOM/SPACE & DEVICE EACH CABLE IS ASSOCIATED WITH.
- CONTRACTOR SHALL LEAVE A MINIMUM OF 18 INCHES OF SLACK AT ALL WALL MOUNTED NURSE CALL DEVICES, 15 FEET AT ALL CEILING MOUNTED NURSE CALL DEVICES, AND 25 FEET OF SLACK AT THE NURSE CALL HEADEND PANEL/NETWORK SWITCH LOCATION.

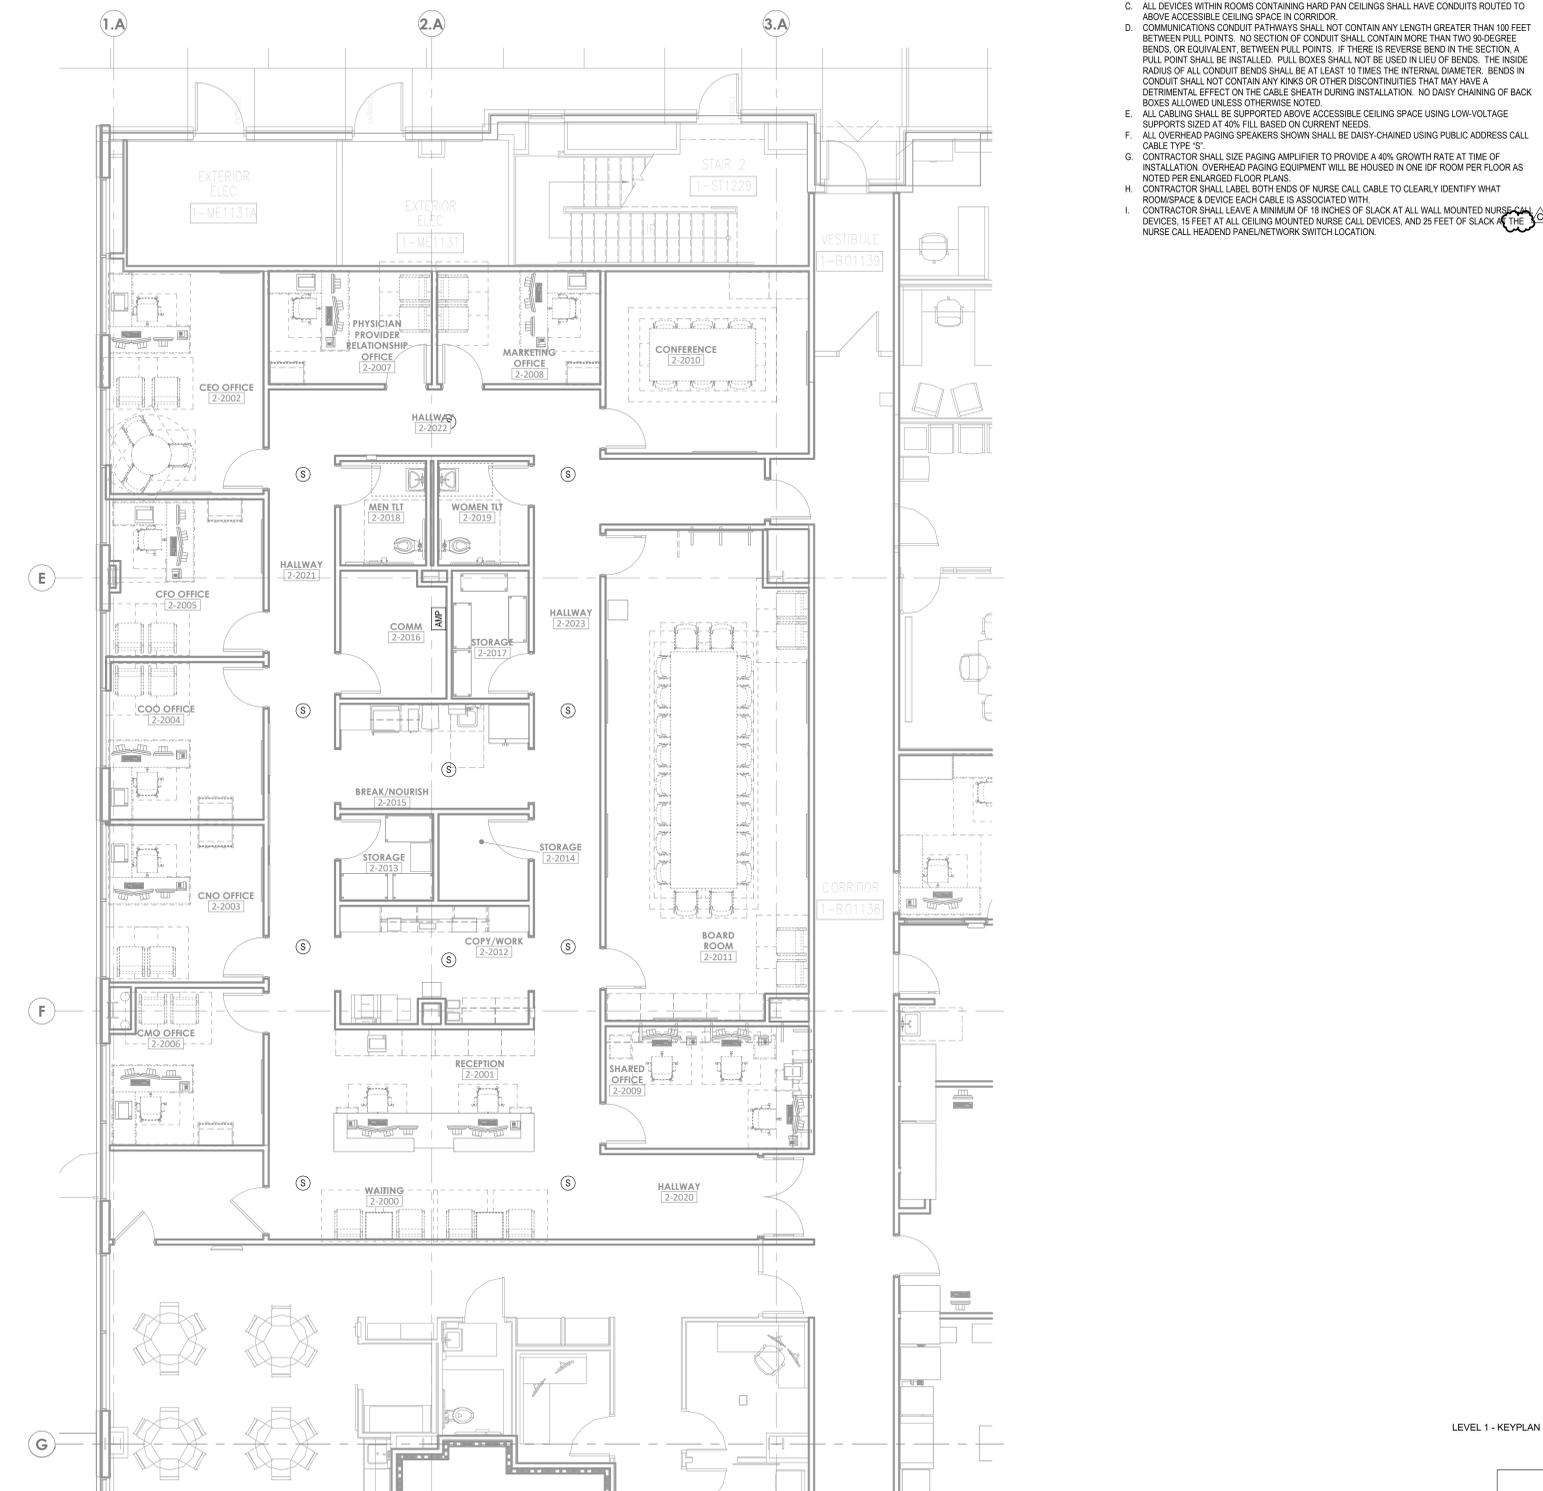

1 FLOOR PLAN - LEVEL 1 - ADMIN - LOW VOLTAGE
3/16" = 1'-0"

LEVEL 1 - KEYPLAN

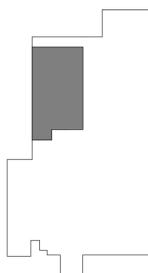

Autodesk Docx/6406.24 - HCA - Lee's Summit Medical Center (LSMC) - r123/MEP - LSAC Admin Relocation - R2.3.rvt 7/16/2025 4:44:03 PM