


AS GRADED PLOT PLAN


Ordered by:Elevate Design and Build
Description:Lot 145, Hook Farms 2nd Plat in Lee's Summit, MO.
Address: 2610 SW Firefly Lane
Lot Area 9750 sf

RELEASE FOR CONSTRUCTION
AS NOTED FOR PLAN REVIEW
DEVELOPMENT SERVICES
LEE'S SUMMIT, MISSOURI
07/31/2025

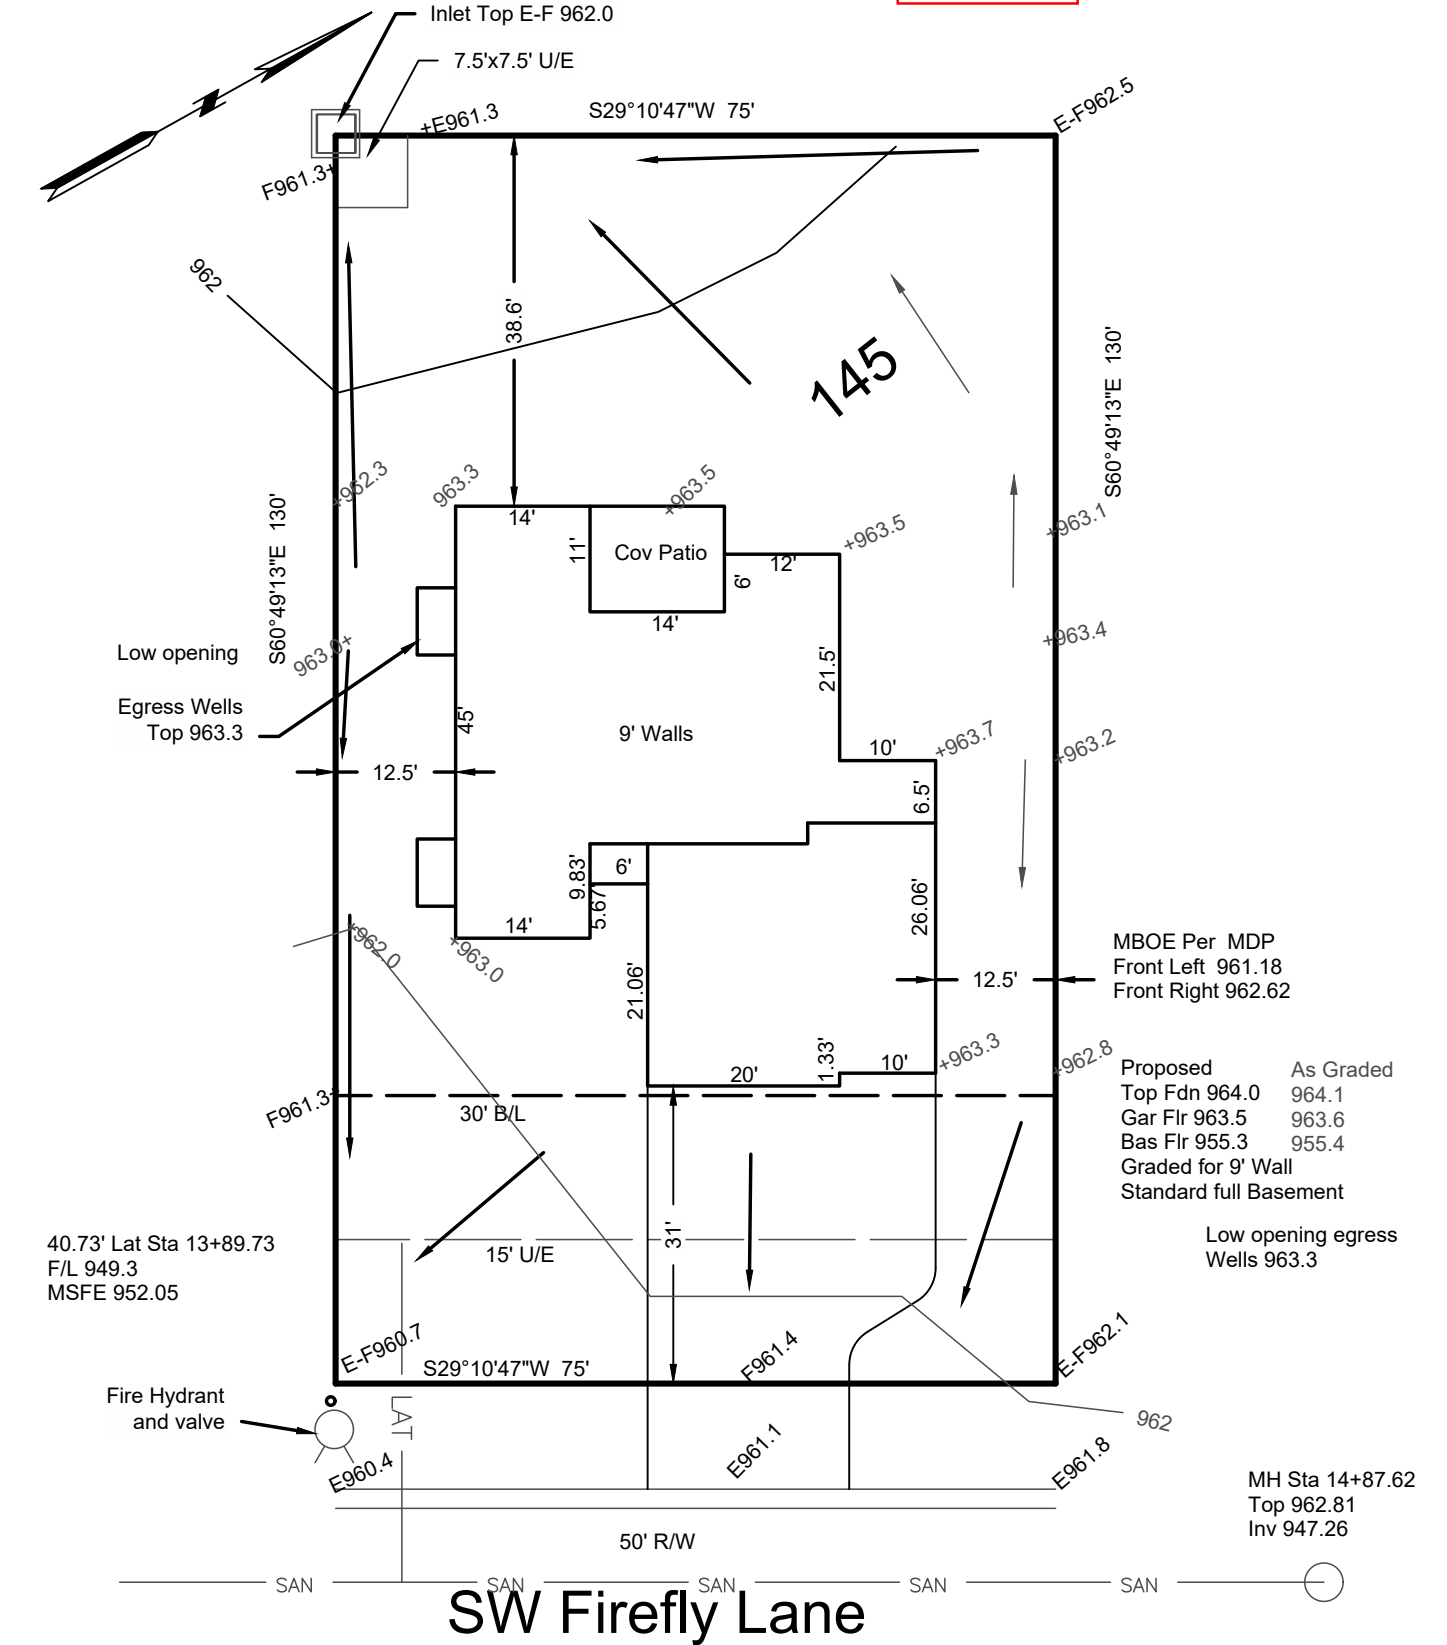

Grades shown are as of 07-31-2025

→ = DRAINAGE PATTERN

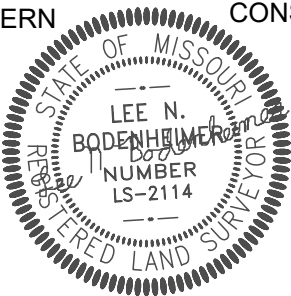

CONSTRUCTION ENGINEERING SERVICES, INC.
16810-C East 40 Highway
Independence, MO 64055
(816)478-2323
lee@engineeringkc.com
SCALE: 1" = 20'
DATE: 12-26-2024 & 07-30-2025
JOB NO:19302 & 19536

LEE BODENHEIMER, L.S.
Land Surveyor