


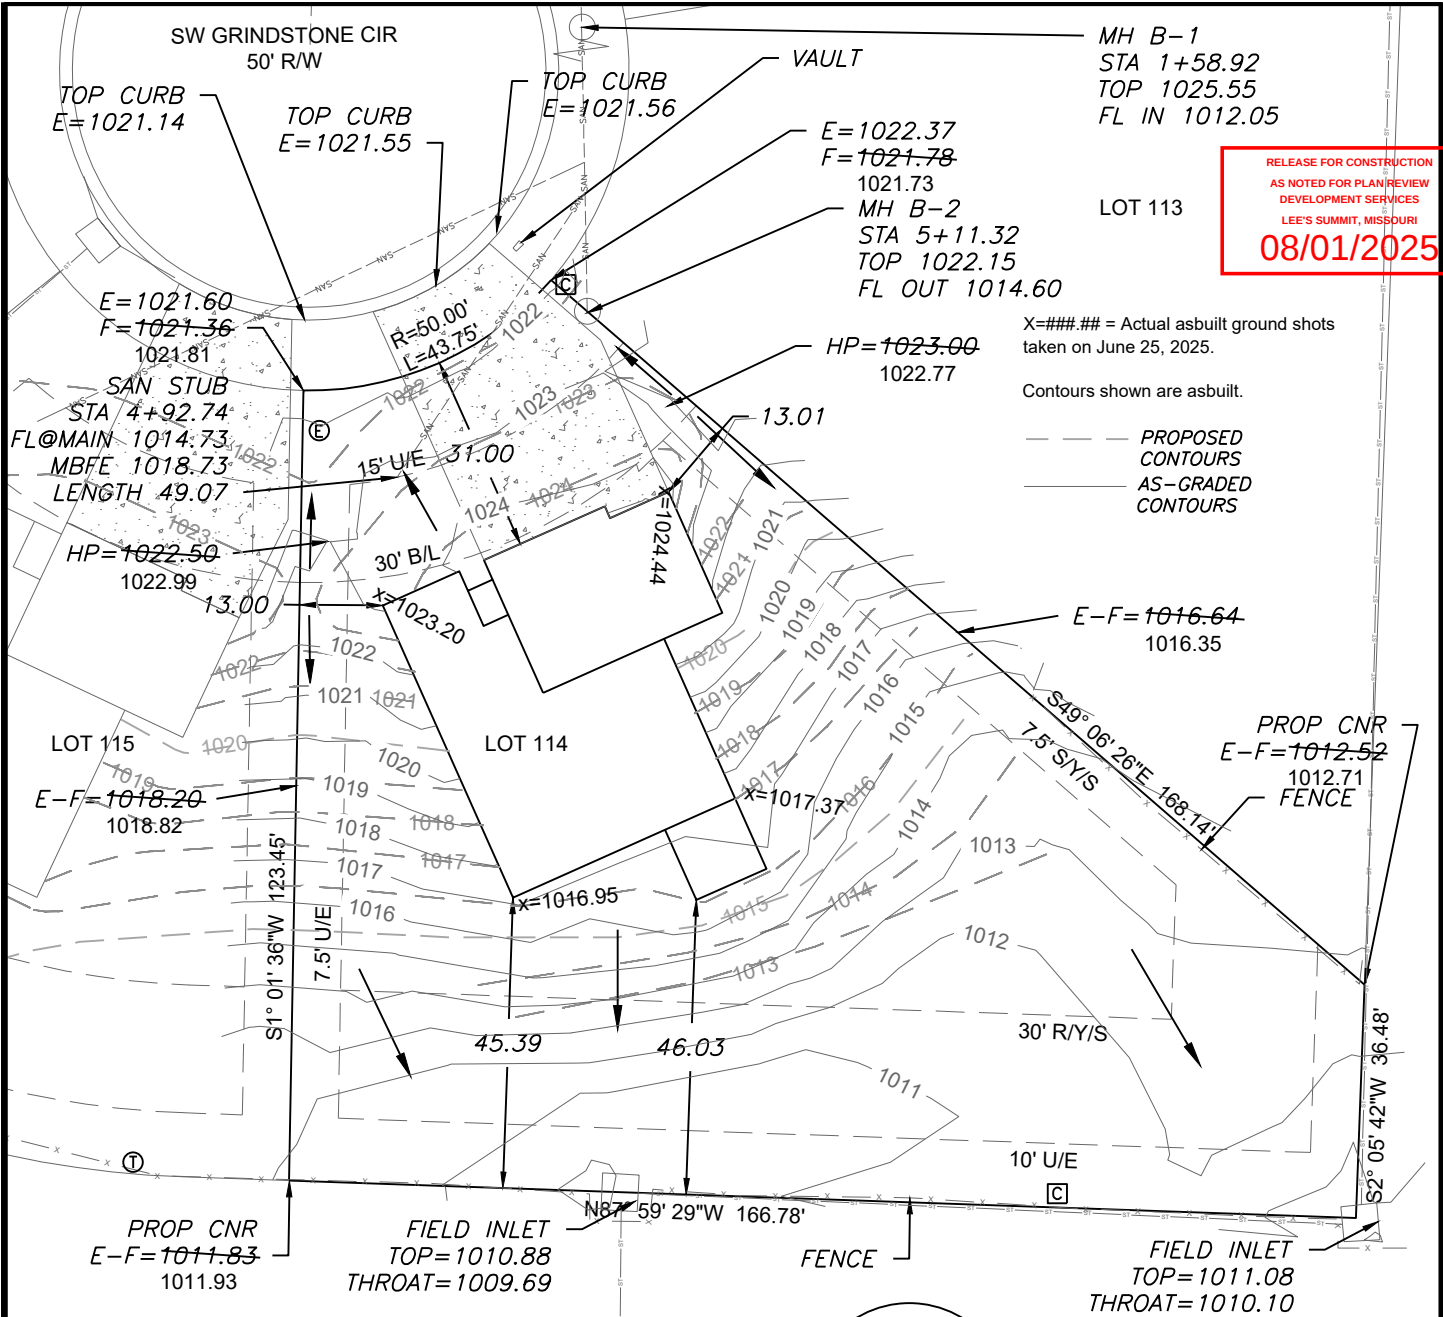

RELEASE FOR CONSTRUCTION
AS NOTED FOR PLAN REVIEW
DEVELOPMENT SERVICES
LEE'S SUMMIT, MISSOURI
08/01/2025

X=###.## = Actual asbuilt ground shots
taken on June 25, 2025.
Contours shown are asbuilt.

--- PROPOSED
CONTOURS
--- AS-GRADED
CONTOURS

LEGEND

- Gas Meter
- Telephone or Fiber-Optic Pedestal
- Cable TV Pedestal
- Electric Pedestal
- Light Pole
- Mailbox
- Fire Hydrant
- Water Valve

PROPOSED HOUSE

TOP FOUNDATION = 1026.25
GARAGE FLOOR = 1024.25
TOP FOOTING = 1017.25
BASEMENT FLOOR = 1017.58
DRIVE SLOPE = 8.0%


E = EXISTING ELEVATION
F = PROPOSED FINAL ELEVATION
G = ADJACENT GRADE AT EGRESS
U/E = UTILITY EASEMENT
B/L = BUILDING LINE
S/Y/S = SIDE YARD SETBACK
R/Y/S = REAR YARD SETBACK

NOTES

1. BUILDER TO VERIFY ALL BUILDING ELEVATIONS AND DIMENSIONS.
2. THIS PLOT PLAN DOES NOT CONSTITUTE A BOUNDARY SURVEY.
3. THE EASEMENTS SHOWN ON THIS PLOT PLAN ARE TAKEN FROM THE FINAL PLAT. OTHER EASEMENTS MAY EXIST.

AS-GRADED PLOT PLAN IS
REQUIRED PRIOR TO SODDING.

NOTE : GRINDER PUMP MAY BE
REQUIRED ON THIS LOT.

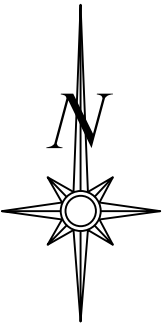


Scale 1"=30'

LOT INFORMATION

16,471.46 SQ. FT.
LEFT MBOE = 1015.07
RIGHT MBOE = 1015.50
MBFE = 1018.73
ADDRESS
4421 SW GRINDSTONE CIR

LEGAL DESCRIPTION


LOT 114, THE MANOR AT STONEY
CREEK 4TH PLAT, A SUBDIVISION
AS RECORDED IN LEE'S SUMMIT,
JACKSON COUNTY, MISSOURI.

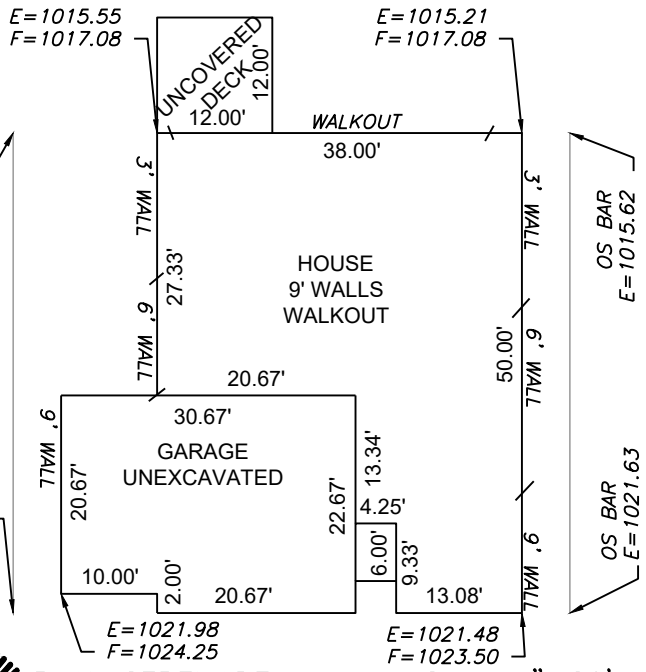

PLAN: SERENADE

Scale 1"=20'

ENGINEERING SOLUTIONS
ENGINEERING & SURVEYING
50 SE 30TH STREET
LEE'S SUMMIT, MO 64082
P: (816) 623-9888 F: (816) 623-9849
WWW.ENGINEERINGSOLUTIONSKC.COM

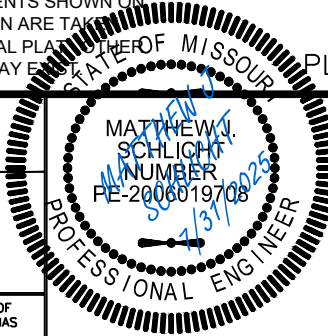

AS-GRADED PLOT PLAN - LOT 114

THE MANOR AT STONEY CREEK 4TH PLAT
LEE'S SUMMIT, JACKSON COUNTY, MISSOURI

AVITAL PROPERTIES GROUP
P.O. BOX 23100
OVERLAND PARK, KS 66283

PROJECT NO.	FILE NAME	DATE	SHEET	OF
1	LOT 114, 115, MANOR AT STONEY CREEK	9/18/24	1	1

THIS DRAWING IS NOT VALID UNLESS THE SIGNATURE, DATE AND SEAL OF
THE ENGINEER WHO SUPERVISED THE PREPARATION OF THIS DRAWING HAS
BEEN AFFIXED HERETO.