


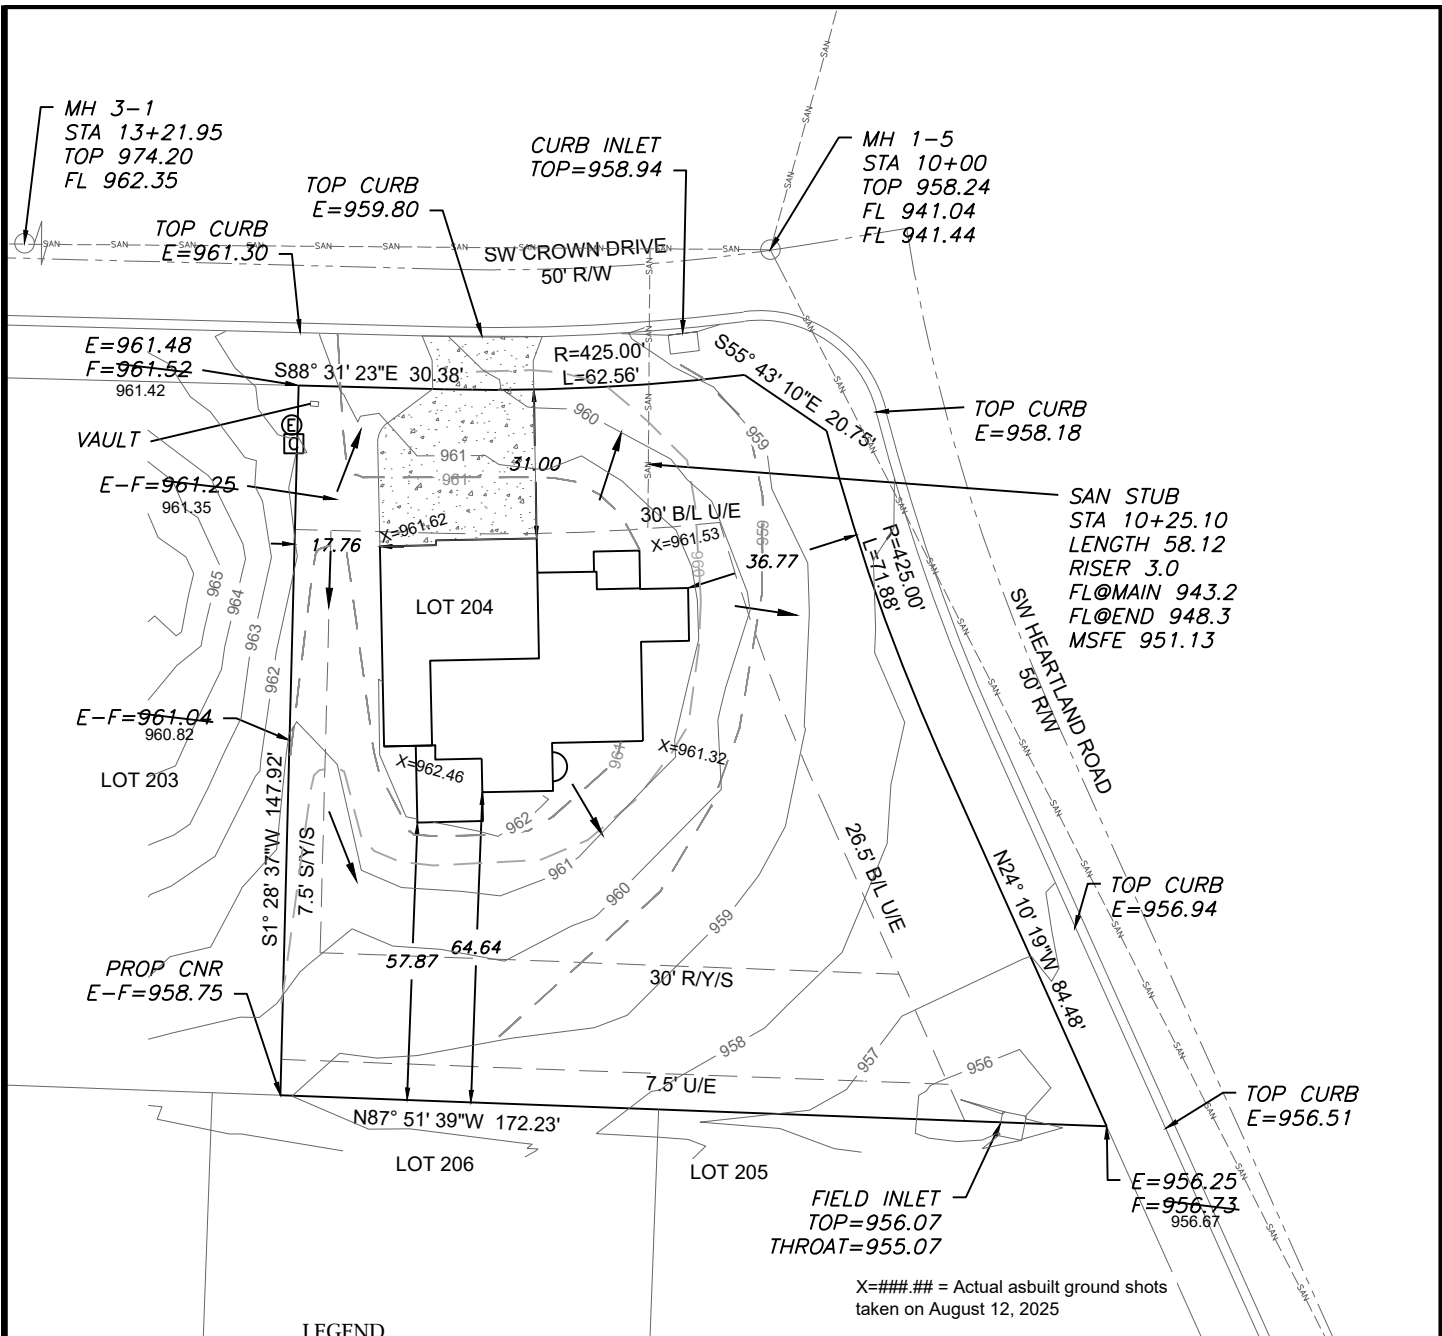

LEGEND

- Gas Meter
- Telephone or Fiber-Optic Pedestal
- Cable TV Pedestal
- Electric Pedestal
- Light Pole
- Mailbox
- Fire Hydrant
- Water Valve

PROPOSED HOUSE

TOP FOUNDATION = 962.75
GARAGE FLOOR = 961.75
TOP FOOTING = 953.75
BASEMENT FLOOR = 954.08
DRIVE SLOPE = 5.6%

E = EXISTING ELEVATION
F = PROPOSED FINAL ELEVATION
G = ADJACENT GRADE AT EGRESS
U/E = UTILITY EASEMENT
B/L = BUILDING LINE
S/Y/S = SIDE YARD SETBACK
R/Y/S = REAR YARD SETBACK


NOTES

- BUILDER TO VERIFY ALL BUILDING ELEVATIONS AND DIMENSIONS.
- THIS PLOT PLAN DOES NOT CONSTITUTE A BOUNDARY SURVEY.
- THE EASEMENTS SHOWN ON THIS PLOT PLAN ARE TAKEN FROM THE FINAL PLAT. EASEMENTS MAY EXIST.

X=###.## = Actual asbuilt ground shots taken on August 12, 2025

Contours shown are asbuilt.

PROPOSED CONTOURS
AS-GRADED CONTOURS

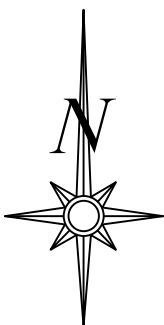


Scale 1"=40'

LOT INFORMATION

20,537 SQ. FT.
REAR LEFT MBOE= 956.98
REAR RIGHT MBOE=960.64
MSFE = 951.13
ADDRESS
2221 SW CROWN DRIVE

LEGAL DESCRIPTION


LOT 204, THE RETREAT AT HOOK FARMS SECOND PLAT, LEE'S SUMMIT, JACKSON COUNTY, MISSOURI.

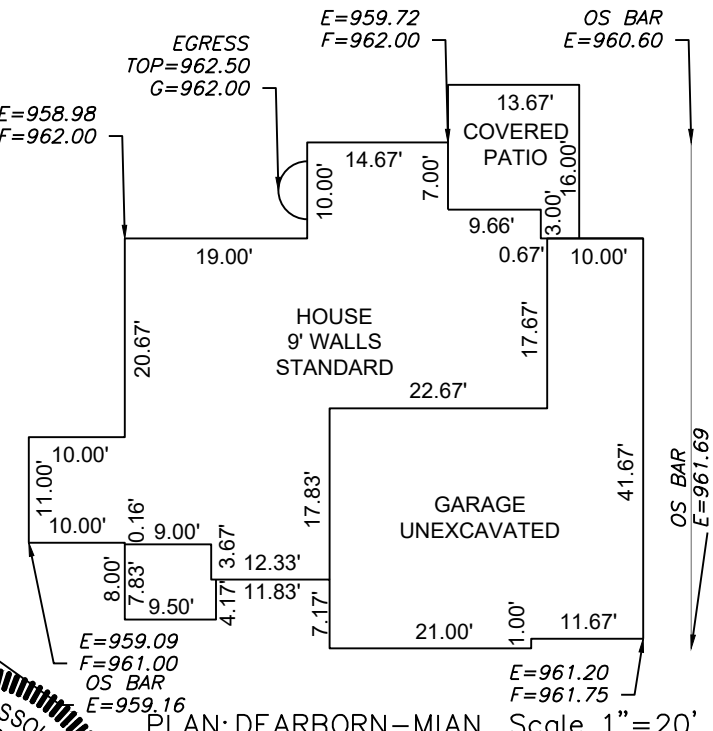

PLAN: DEARBORN-MIAN Scale 1"=20'

ENGINEERING & SURVEYING SOLUTIONS

50 SE 30TH STREET
LEE'S SUMMIT, MO 64082
P:(816) 623-9888 F:(816)623-9849
WWW.ENGINEERINGSOLUTIONKCC.COM

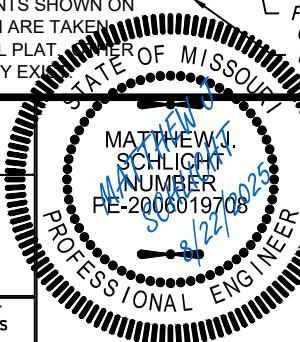

AS-GRADED PLOT PLAN - LOT 204

THE RETREAT AT HOOK FARMS SECOND PLAT
LEE'S SUMMIT, JACKSON COUNTY, MISSOURI

SAB CONSTRUCTION, LLC
200 NW COMMERCE COURT
LEE'S SUMMIT, MO 64086

THIS DRAWING IS NOT VALID UNLESS THE SIGNATURE, DATE AND SEAL OF THE ENGINEER WHO SUPERVISED THE PREPARATION OF THIS DRAWING HAS BEEN AFFIXED HERETO.

PROJECT NO.	FILE NAME	DATE	SHEET	OF
1	LOT 204, RETREAT AT HOOK FARMS	12/9/24	1	1