

FITNESS STUDIO  
SUMMIT FAIR  
910 NW BLUE PARKWAY  
LEE'S SUMMIT, MO 64086  
FIRE ALARM SYSTEM

DRAWING INDEX

| SHEET NO. | DESCRIPTION                                    |
|-----------|------------------------------------------------|
| 1.        | COVER SHEET & GENERAL SPECIFICATIONS           |
| 2.        | FLOOR PLAN                                     |
| 3.        | POWER CALC. / FA RISER / BOM / CABLE<br>LEGEND |
| 4.        | FA MATRIX / TYPICAL DEVICE HEIGHT              |

RELEASED FOR CONSTRUCTION  
As Noted on Plan Review

Lee's Summit Fire Department  
Lee's Summit, Missouri  
09/04/2025

SCOPE OF WORK

INSTALLATION OF NEW FIRE ALARM OCCUPANT NOTIFICATION  
DEVICES INTO EXISTING FIRE ALARM SYSTEM INSIDE OF  
TENANT SUITE AS-NOTED.

APPLICABLE BUILDING CODES:

2018 INTERNATIONAL FIRE CODE  
2022 NFPA 72  
2020 NFPA 70

BUILDING INFO:

OCCUPANCY GROUP: B - BUSINESS

SQUARE FOOTAGE: 2,368

SPRINKLER PROTECTION: BUILDING IS SPRINKLED

1. ABBREVIATIONS:

- 1.1 F.A.C. – Marmic Partner Fire Alarm Contractor  
1.2 E.C. – Electrical Installing Contractor

2. GENERAL ELECTRICAL SPECIFICATIONS & INSTALLATION NOTES

- 2.1 All wiring shall be in compliance with applicable codes, primarily Article 760, OSHA, NFPA 72 and installed to the satisfaction of the authority having jurisdiction.
- 2.2 Do not energize control panels until specific instruction has been issued to do so. Generally, control panel will not be energized until wiring has been checked out by F.A.C.
- 2.3 All wire shall be continuous (without splicing) from beginning terminal point to ending terminal point.
- 2.4 The use of Brady-type tags on all wiring is required.
- 2.5 Color coding of all pairs is required to maintain proper polarity.
- 2.6 The use of Sta-Kon terminals is required at all screw terminal connections unless compression type lugs are being used. Where pigtail connections are to be made, the use of wire nuts is permitted.
- 2.7 All wire, conduit, junction boxes, etc. to be supplied and installed by E.C.
- 2.8 E.C. is responsible for mounting and making all final connections to all supplied detectors, control panels, signal devices, manual alarm stations, etc.
- 2.9 E.C. to supply one set of "as built" electrical drawings, showing termination's, number of wires and conduit runs. A "red" mark-up is sufficient. Provide numbering assigned to wiring and cables.
- 2.10 All wiring to be in protective metallic conduit (EMT, rigid, or Flexible) as conditions require. All Terminations on EMT shall be set screw. Plenum rated cable is acceptable where approved in writing.
- 2.11 Audible circuits are parallel circuits, utilizing an end-of-line resistor. These circuits shall be wired as shown, no branching permitted.
- 2.12 All signaling and initiation device wires shall be shielded from all other wires not related to these functions. 120 VAC run independent of 24 VDC. Input functions independent of output functions.

- 2.13 Wiring specified as shielded by description or by  $\frac{1}{2}$  shall utilize shield multi-conductor cable. This shielded cable shall be – minimum #18 AWG – stranded one or two pair. Total number of conductors within the outer jacket shall be shielded as one bundle. This shielding shall be aluminum foil wrapped or equivalent and each cable shall carry a continuous bare ground conductor. At junctions or breaks, ground conductors shall be spliced for continuity to following cable run. In the event where the bare ground wire is exposed in junction boxes, etc., care shall be take to insulate this bare ground conductor from any adjacent bare terminal strips, etc. This insulation shall be accomplished by wrapping with tape or by the use of spaghetti insulation.

- 2.14 Supply a two wire power supply – 120 VAC single phase 20 amp dedicated circuit to main control panel. Mark breaker –FIRE CONTROL SYSTEM – lock on.

- 2.15 All resistors and diodes shown on final electrical schematic shall be supplied by F.A.C.

- 2.16 E.C. shall provide personnel to assist and witness all checkout of electrical wiring prior to energizing control panels and devices.

3. WIRE SPECIFICATIONS

- 3.1 Power Wiring to Control Panel:  
120 VAC: Dedicated Circuit 12 AWG Stranded Type THHN, Black, White & Green.
- 3.2 Field Wiring to Detectors and Manual Alarm Stations:  
18 AWG Solid, 2 Conductor, Non-shielded, Type FPLP.
- 3.3 Field Wiring to Audible/Visual Alarms:  
14 AWG Solid, 2 conductor, Non-shielded, Type FPLP.
- 3.4 Internal Panel Wiring:  
16 AWG stranded, Belden 8521, non-shielded.
- 3.5 All Other Wiring Not Specified:  
As indicated on Devices Layouts.

4. EQUIPMENT BACK BOX AND ELEVATION

- 4.1 Control Panel:  
Top of cabinet 5'–9" above finished floor.
- 4.2 Manual Fire Alarm Station:  
Single gang handy box, 4'–0" Above finished floor.
- 4.3 Alarm Horn/Strobe:  
Deep 4" square box, 6'–8" to bottom above finished floor or on ceiling.

DURING A FIRE EMERGENCY OR OTHER ABNORMAL CONDITION PRIOR TO OR UPON OPERATION OF THIS SYSTEM(S) PROTECTED AREA(S) LIGHTING MAY BE AFFECTED. RELIABLE EMERGENCY LIGHTING FOR EVACUATION AND/OR RESCUE OF PERSONNEL MUST BE PROVIDED. UNLESS SPECIFICALLY NOTED AND SHOWN ON THESE DRAWINGS AND/OR STATED IN THE SPECIFICATIONS, THE MARMIC PARTNER FIRE ALARM CONTRACTOR IS NOT RESPONSIBLE FOR PROVIDING ANY AREA EMERGENCY LIGHTING.



MEP Engineering Group  
Certificate of Authority #2016015108  
mepengineeringgroup@gmail.com  
(816)778-1195

JOB # - 42932006

BY

REVISION

DATE

NO.




FITNESS STUDIO / SUMMIT FAIR  
910 NW BLUE PARKWAY  
LEE'S SUMMIT, MO 64086  
FIRE ALARM SYSTEM  
COVER SHEET / GENERAL SPECIFICATION



JOB NAME

|              |                    |
|--------------|--------------------|
| DRAWN        | D. FLINT           |
| DATE         | 8/22/25            |
| DESIGN BY    | D. FLINT<br>121007 |
| SCALE        | NIS                |
| JOB NO.      | 42932006           |
| SHEET NUMBER | 1 of 4             |

THE INFORMATION CONTAINED IN THIS DRAWING IS THE PROPERTY OF MPE GROUP. IT IS TO BE SUBMITTED IN CONFIDENCE AND IS NOT TO BE DISCLOSED OR UTILIZED WITHOUT WRITTEN PERMISSION EXCEPT IN CONNECTION WITH OUR WORK.

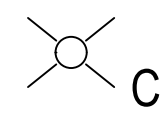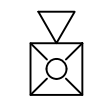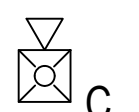

| DEVICE LEGEND                                                                         |               |         |
|---------------------------------------------------------------------------------------|---------------|---------|
| SYMBOL                                                                                | MANUFACTURER  | PART NO |
|  C | SYSTEM SENSOR | SCRLED  |
|    | SYSTEM SENSOR | P2RLED  |
|  C | SYSTEM SENSOR | PC2RLED |

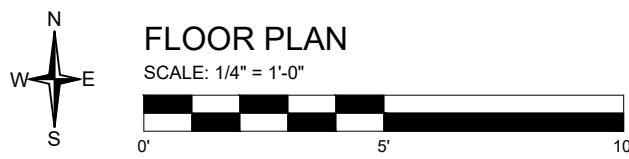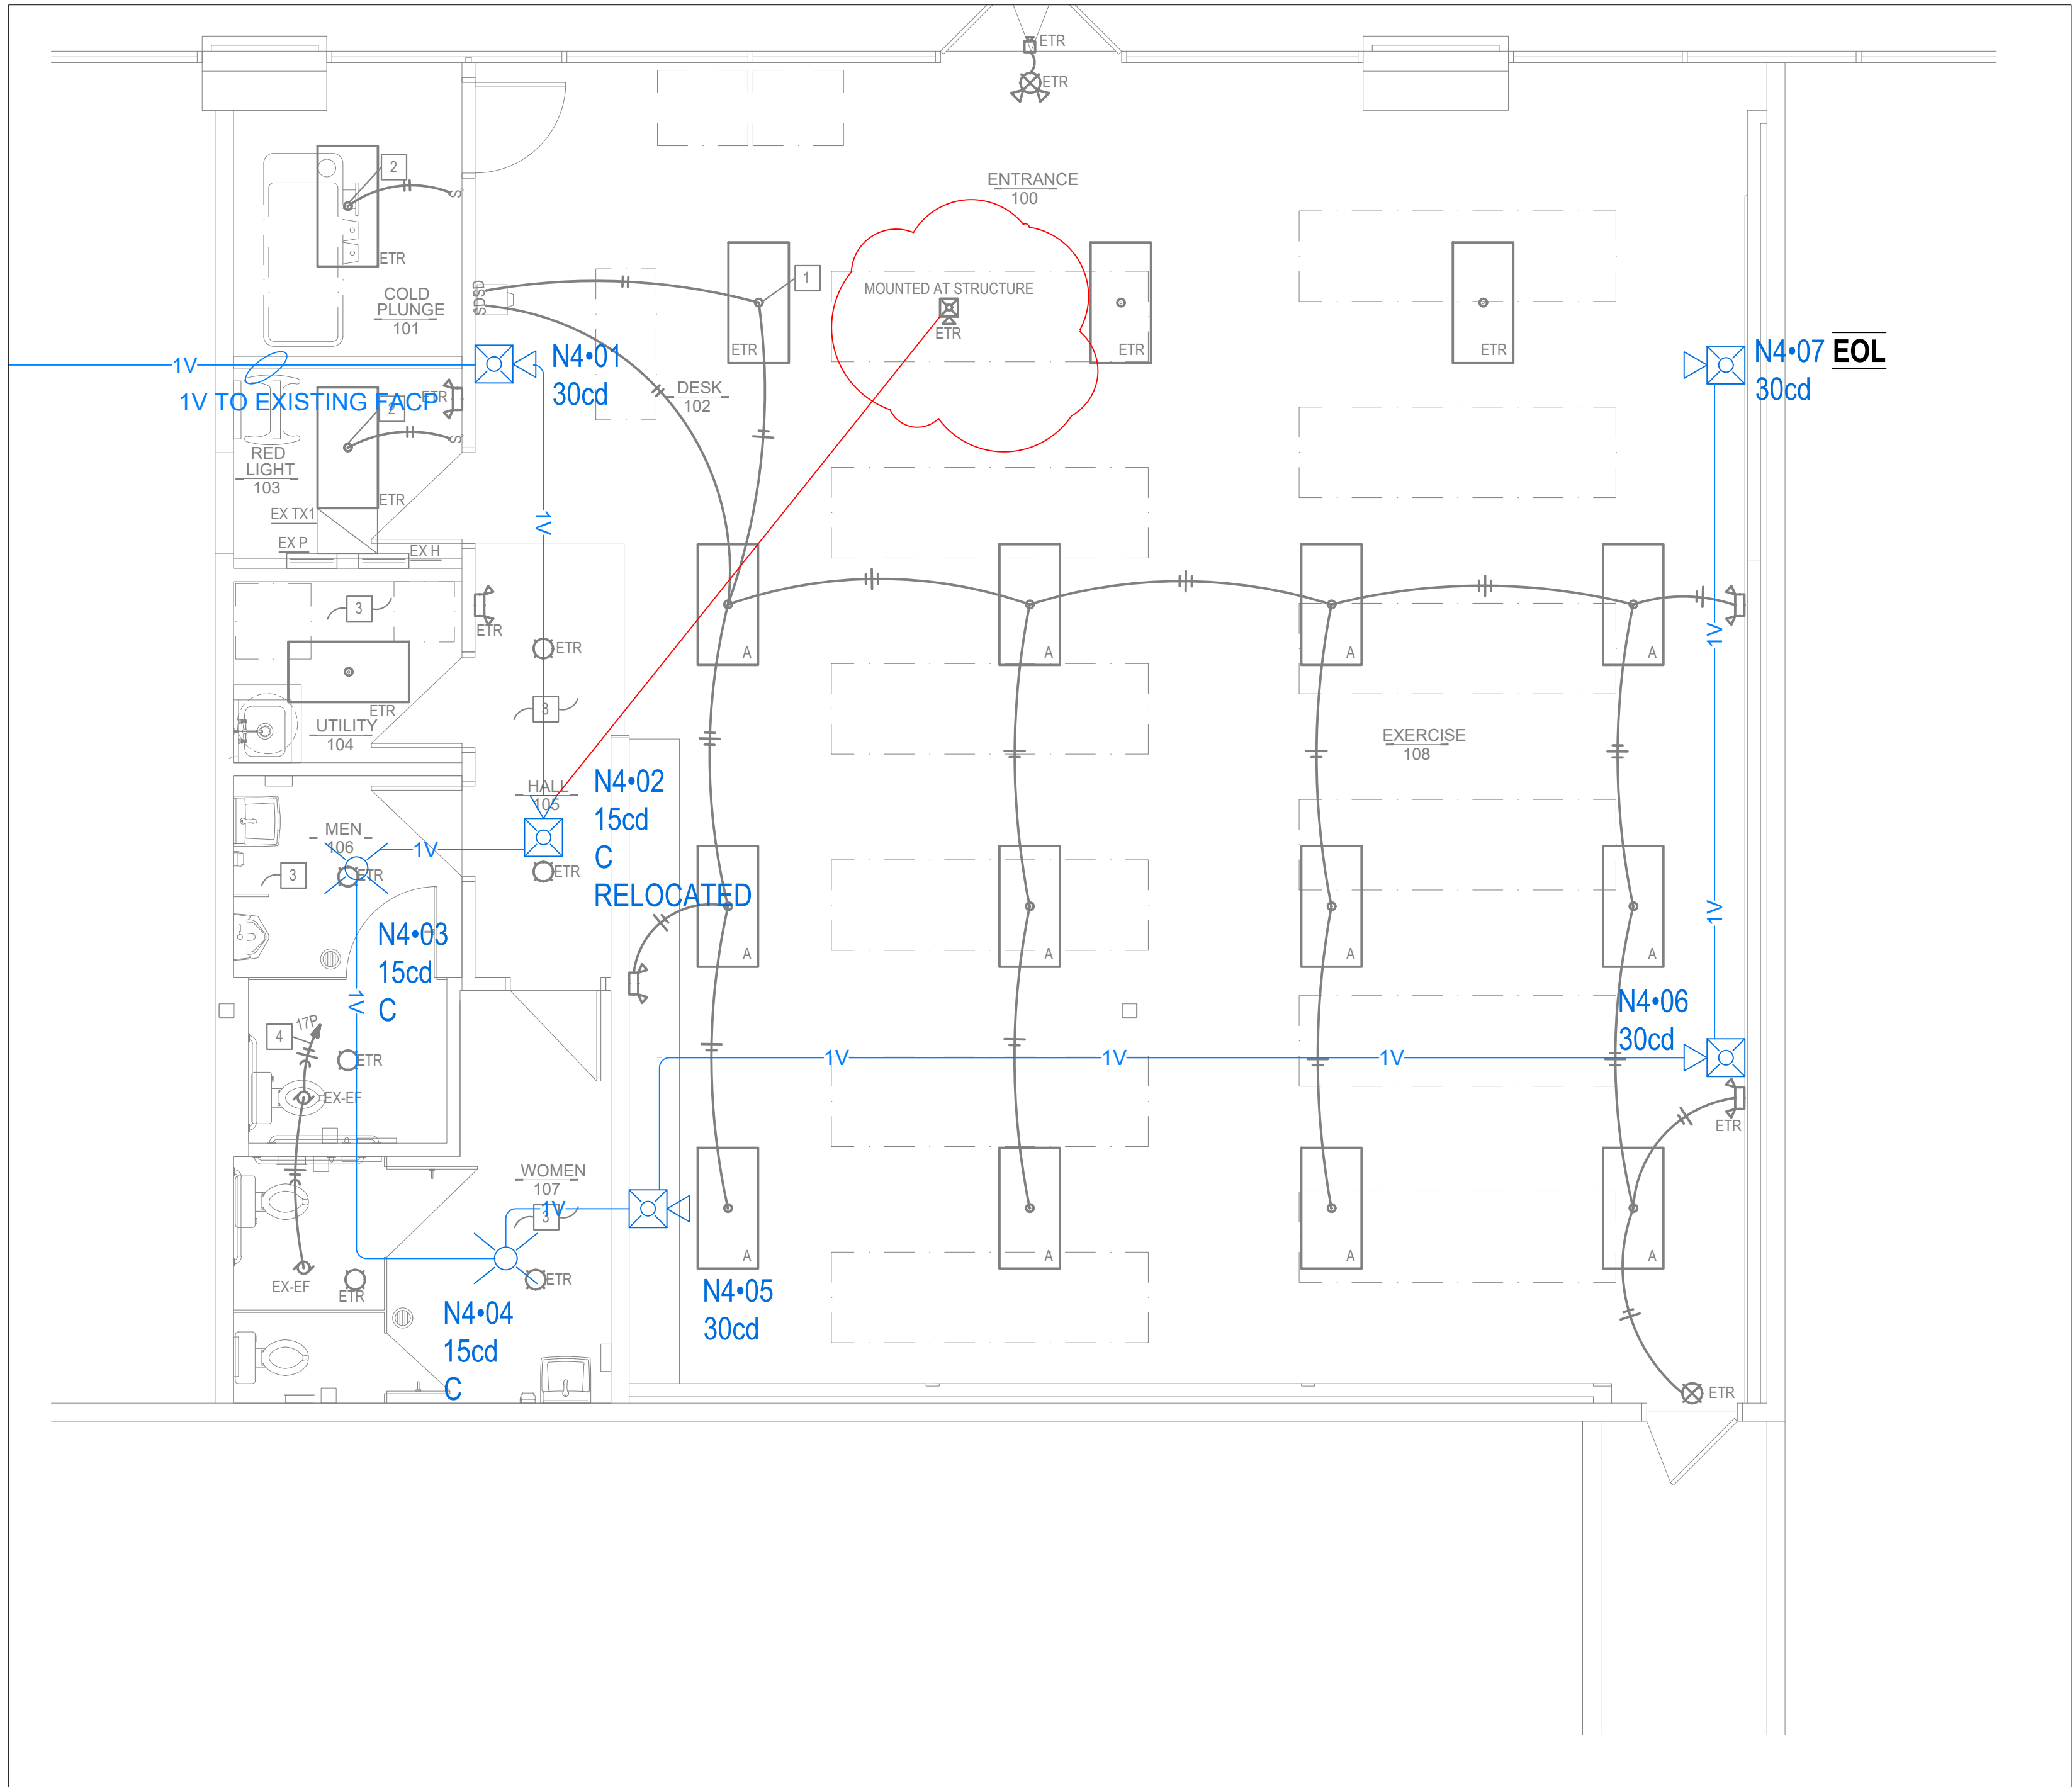

MEP Engineering Group  
Certificate of Authority #2016015108  
[mepengineeringgroup@gmail.com](mailto:mepengineeringgroup@gmail.com)  
(816)778-1195




FITNESS STUDIO / SUMMIT FAIR  
910 NW BLUE PARKWAY  
LEE'S SUMMIT, MO 64086  
FIRE ALARM SYSTEM  
FLOOR PLAN

|                                                                                                                                                                                                                                                  |            |
|--------------------------------------------------------------------------------------------------------------------------------------------------------------------------------------------------------------------------------------------------|------------|
| JOB NAME                                                                                                                                                                                                                                         |            |
| THE INFORMATION CONTAINED IN THIS DRAWING IS THE PROPERTY OF MPEP ENGINEERING GROUP. IT IS TO BE USED ONLY FOR THE PROJECT AND NOT TO BE REPRODUCED OR USED FOR ANY OTHER PROJECT WITHOUT WRITTEN PERMISSION EXCEPT IN CONNECTION WITH OUR WORK. |            |
| DRAWN                                                                                                                                                                                                                                            | D. FLUNT   |
| DATE                                                                                                                                                                                                                                             | 8/22/25    |
| DESIGN BY                                                                                                                                                                                                                                        | D. FLUNT   |
| SCALE                                                                                                                                                                                                                                            | 1/4"=1'-0" |
| JOB NO.                                                                                                                                                                                                                                          | 42932006   |
| SHEET NUMBER                                                                                                                                                                                                                                     |            |
| 2                                                                                                                                                                                                                                                | of 4       |




| PANEL EXISTING SLP REDS BATTERY CALCULATION                                   |               |                |                 |                                                                                   |            |                                                                                        |                                        |                   |                         |                   |           |
|-------------------------------------------------------------------------------|---------------|----------------|-----------------|-----------------------------------------------------------------------------------|------------|----------------------------------------------------------------------------------------|----------------------------------------|-------------------|-------------------------|-------------------|-----------|
| SECONDARY POWER SOURCE REQUIREMENTS                                           |               |                |                 |                                                                                   |            |                                                                                        |                                        |                   |                         |                   |           |
| PANEL COMPONENTS                                                              |               |                |                 | QTY                                                                               | PART NO.   | DESCRIPTION                                                                            | STANDBY CURRENT                        |                   | SECONDARY ALARM CURRENT |                   |           |
|                                                                               |               |                |                 |                                                                                   |            |                                                                                        | CURRENT DRAIN (A)                      | TOTAL (A)         | CURRENT DRAIN (A)       | TOTAL (A)         |           |
|                                                                               |               |                |                 | 1                                                                                 | SLP-RED    | 51 STEREO PANEL W/BACKBOX, DACT-EL, RPT-ES-UTP, SLC-PM, LCD SLP AND 7.0 A POWER SUPPLY | 0                                      | 0                 | 0                       | 0                 |           |
|                                                                               |               |                |                 | 1                                                                                 | DACT-E3    | DIGITAL ALARM COMMUNICATOR TRANSMITTER                                                 | 0.018                                  | 0.018             | 0.018                   | 0.018             |           |
|                                                                               |               |                |                 | 1                                                                                 | FLPST-48B  | 7 AMP POWER SUPPLY                                                                     | 0                                      | 0                 | 0                       | 0                 |           |
|                                                                               |               |                |                 | 1                                                                                 | RPT-ES-UTP | REPEATER MODULE-6-TWISTED-PAIRS, SECOND LOOP                                           | 0.016                                  | 0.016             | 0.017                   | 0.017             |           |
|                                                                               |               |                |                 | 1                                                                                 | SLC-PM     | SLC LOOP POWER SUPPLY SECOND LOOP                                                      | 0.014                                  | 0.014             | 0.014                   | 0.014             |           |
|                                                                               |               |                |                 | 1                                                                                 | SLP-E3     | INTER-ACE MAIN BOARD                                                                   | 0.1                                    | 0.1               | 0.18                    | 0.18              |           |
| CIRCUIT                                                                       | MAX CARD AMPS | USED CARD AMPS | SPARE CARD AMPS | SYMBOL                                                                            | QTY        | PART NO.                                                                               | DESCRIPTION                            | CURRENT DRAIN (A) | TOTAL (A)               | CURRENT DRAIN (A) | TOTAL (A) |
| EXISTING/NA                                                                   | NA            | 0.223000       |                 |  | 4          | PCRLD                                                                                  | 2-WIRE, HORN STROBE, RED 30CD          | 0                 | 0                       | 0.038             | 0.152     |
|                                                                               |               |                |                 |  | 1          | PCRLD                                                                                  | 2-WIRE, HORN STROBE, CEILING, RED 15CD | 0                 | 0                       | 0.055             | 0.055     |
|                                                                               |               |                |                 |  | 2          | SCRLED                                                                                 | STROBE, CEILING, RED 15CD              | 0                 | 0                       | 0.018             | 0.036     |
|                                                                               |               |                |                 | TOTAL STANDBY (A)                                                                 |            | 0.146                                                                                  |                                        | TOTAL ALARM (A)   |                         | 0.452             |           |
|                                                                               |               |                |                 | REQUIRED STANDBY TIME (HOURS)                                                     |            | 24                                                                                     |                                        |                   |                         |                   |           |
|                                                                               |               |                |                 | REQUIRED STANDBY TIME (MINUTES)                                                   |            | 24                                                                                     |                                        |                   |                         |                   |           |
|                                                                               |               |                |                 | SECONDARY STANDBY LOAD (A)                                                        |            | 0.146                                                                                  |                                        | 3.59              |                         |                   |           |
|                                                                               |               |                |                 | SECONDARY ALARM LOAD (A)                                                          |            | 0.452                                                                                  |                                        | 1.25              |                         |                   |           |
|                                                                               |               |                |                 | STANDBY AND ALARM SUBTOTAL (AMP HOURS)                                            |            | 0.83                                                                                   |                                        | 4.84              |                         |                   |           |
|                                                                               |               |                |                 | OPERATING FACTOR                                                                  |            |                                                                                        |                                        | 1.25              |                         |                   |           |
|                                                                               |               |                |                 | SECONDARY (CARD) REQUIREMENTS (AMP HOURS)                                         |            |                                                                                        |                                        | 4.84              |                         |                   |           |
| RECOMMENDED BATTERY SIZES NOT SPECIFIED. REFER TO MANUFACTURER DOCUMENTATION. |               |                |                 |                                                                                   |            |                                                                                        |                                        |                   |                         |                   |           |
| BATTERY BOX SIZE CAPACITY NOT SPECIFIED. REFER TO MANUFACTURER DOCUMENTATION. |               |                |                 |                                                                                   |            |                                                                                        |                                        |                   |                         |                   |           |

| CURRENT SUMMARY                                                                     |          |          |                                   |         | POWER SUMMARY                                                                                 |                   |  |  |  |  |  |  |  |
|-------------------------------------------------------------------------------------|----------|----------|-----------------------------------|---------|-----------------------------------------------------------------------------------------------|-------------------|--|--|--|--|--|--|--|
| MAX CIRCUIT CURRENT (A)                                                             |          |          |                                   |         | STARTING CALC. VOLTAGE                                                                        |                   |  |  |  |  |  |  |  |
| TOTAL CIRCUIT CURRENT (A)                                                           |          |          |                                   |         | MAX VOLTAGE DROP                                                                              |                   |  |  |  |  |  |  |  |
| SPARE CIRCUIT CURRENT (A)                                                           |          |          |                                   |         | VOLTAGE DROP %                                                                                |                   |  |  |  |  |  |  |  |
| MAX CIRCUIT CURRENT %                                                               |          |          |                                   |         | MIN OPERATIONAL VOLTAGE                                                                       |                   |  |  |  |  |  |  |  |
| MAX CARD CURRENT (A)                                                                |          |          |                                   |         | END OF LINE VOLTAGE                                                                           |                   |  |  |  |  |  |  |  |
| TOTAL CARD CURRENT (A)                                                              |          |          |                                   |         | WIRE RESISTANCE (MFT)                                                                         |                   |  |  |  |  |  |  |  |
| SPARE CARD CURRENT %                                                                |          |          |                                   |         | TOTAL CIRCUIT LENGTH (FT)                                                                     |                   |  |  |  |  |  |  |  |
|                                                                                     |          |          |                                   |         | TOTAL CIRCUIT RESISTANCE (Ω)                                                                  |                   |  |  |  |  |  |  |  |
|                                                                                     |          |          |                                   |         | CIRCUIT WIRING PROPERTIES: 16/2 FPLP/NAAC 18 AWG, 2 COND. SOLID COPPER FPLP/ANALOG UNSHIELDED |                   |  |  |  |  |  |  |  |
|                                                                                     |          |          |                                   |         | DISTANCE MEASURED (USING DRAWING REQUIREMENT) LENGTH WITH 100% ADDITIONAL LENGTH CALCULATED   |                   |  |  |  |  |  |  |  |
| SYMBOL                                                                              | QUANTITY | PART NO. | DESCRIPTION                       | CANDELS | ALARM CURRENT (A)                                                                             | TOTAL CURRENT (A) |  |  |  |  |  |  |  |
|  | 4        | PCRLD    | 2-WIRE, HORN STROBE, RED          | 30CD    | 0.008                                                                                         | 0.152             |  |  |  |  |  |  |  |
|  | 1        | PCRLD    | 2-WIRE, HORN STROBE, CEILING, RED | 15CD    | 0.005                                                                                         | 0.005             |  |  |  |  |  |  |  |
|  | 2        | SCRLED   | STROBE, CEILING, RED              | 15CD    | 0.018                                                                                         | 0.036             |  |  |  |  |  |  |  |
| CALCULATION METHODS:                                                                |          |          |                                   |         |                                                                                               |                   |  |  |  |  |  |  |  |
| TOTAL RESISTANCE (Ω) = WIRE RESISTANCE (MFT) X 2 X TOTAL CIRCUIT LENGTH (MFT)       |          |          |                                   |         |                                                                                               |                   |  |  |  |  |  |  |  |
| TOTAL VOLTAGE DROP = TOTAL RESISTANCE (Ω) X TOTAL CIRCUIT CURRENT (A)               |          |          |                                   |         |                                                                                               |                   |  |  |  |  |  |  |  |
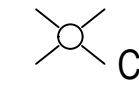
| DEVICE LEGEND                                                                       |          |               |         |                          |
|-------------------------------------------------------------------------------------|----------|---------------|---------|--------------------------|
| SYMBOL                                                                              | QUANTITY | MANUFACTURER  | PART NO | DESCRIPTION              |
|  | 2        | SYSTEM SENSOR | SCRLED  | STROBE, CEILING, RED     |
|  | 4        | SYSTEM SENSOR | P2RLED  | 2-WIRE, HORN STROBE, RED |

| CABLE AND WIRE LEGEND |             |             |                |     |                                               |
|-----------------------|-------------|-------------|----------------|-----|-----------------------------------------------|
| LABEL                 | PART NO     | APPLICATION | RESISTANCE MFT | AWG | DESCRIPTION                                   |
| V                     | 16/2 FPLP/R | NAC         | 4.89           | 16  | 2 COND. SOLID COPPER FPLP/R ANALOG UNSHIELDED |

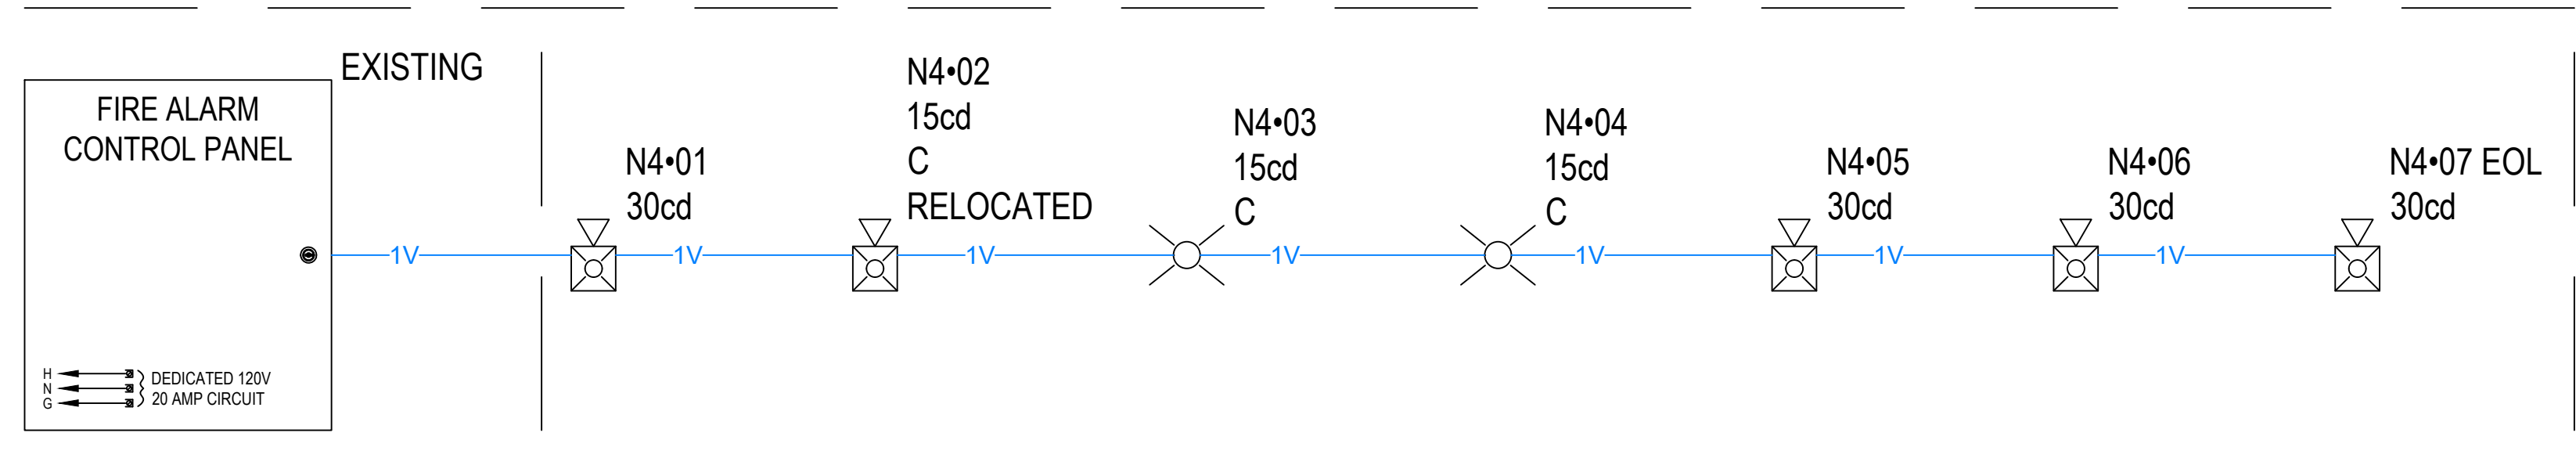

MEP Engineering Group  
Certificate of Authority #2016015108  
[mepengineeringgroup@gmail.com](mailto:mepengineeringgroup@gmail.com)  
(816)778-1195

FITNESS STUDIO / SUMMIT FAIR  
910 NW BLUE PARKWAY  
LEE'S SUMMIT, MO 64086  
FIRE ALARM SYSTEM  
POWER CALC / FA RISER / BOM / CABLE LEGEND

|           |            |
|-----------|------------|
| DRAWN     | D. FLINT   |
| DATE      | 8/22/25    |
| DESIGN BY | D. FLINT   |
| SCALE     | 1/8"=1'-0" |
| JOB NO.   | 42932006   |


SHEET NUMBER

3 of 4

Filename: FITNESS STUDIO



| FIRE ALARM SYSTEM<br>INPUT/OUTPUT MATRIX |                                      | SYSTEM OUTPUTS                                                                                                                                                                                                                                                                                                                                                                                                                                                                                                                                                             |   |   |------------------------------------------|--------------------------------------|----------------------------------------------------------------------------------------------------------------------------------------------------------------------------------------------------------------------------------------------------------------------------------------------------------------------------------------------------------------------------------------------------------------------------------------------------------------------------------------------------------------------------------------------------------------------------|---|---|---|---|--------------|---|---|---|---|------------------------------|---|---|---|---|---|---|---|---|---|---|---|---|---|----|
|                                          |                                      | FACP ANNUNCIATION                                                                                                                                                                                                                                                                                                                                                                                                                                                                                                                                                          |   |   |   |   | NOTIFICATION |   |   |   |   | REQUIRED FIRE SAFETY CONTROL |   |   |   |   |   |   |   |   |   |   |   |   |   |    |
| SYSTEM INPUTS                            |                                      | ACTUATE COMMON ALARM SIGNAL INDICATOR<br>ACTUATE AUDIBLE ALARM SIGNAL<br>ACTUATE COMMON SUPERVISORY SIGNAL INDICATOR<br>ACTUATE AUDIBLE SUPERVISORY SIGNAL<br>ACTUATE COMMON TROUBLE SIGNAL INDICATOR<br>ACTUATE AUDIBLE TROUBLE SIGNAL<br>ACTUATE ZONE OR DEVICE ADDRESS SIGNAL<br>DISPLAY CHANGE OF STATUS<br>TRANSMIT FIRE ALARM SIGNAL TO CENTRAL STATION<br>TRANSMIT SUPERVISORY SIGNAL TO CENTRAL STATION<br>TRANSMIT TROUBLE SIGNAL TO CENTRAL STATION<br>RELEASE MANUALLY HELD DOORS<br>SHUT DOWN OF WAREHOUSE FANS<br>SHUT DOWN RESPECTIVE AIR HANDLING EQUIPMENT |   |   |                                          |                                      | A                                                                                                                                                                                                                                                                                                                                                                                                                                                                                                                                                                          | B | C | D | E | F            | G | H | I | J | K                            | L | M | N | O | P | Q | R | S | T | U | V | W | X | Y  |
| 1                                        | FIRE ALARM SYSTEM AC POWER FAILURE   |                                                                                                                                                                                                                                                                                                                                                                                                                                                                                                                                                                            |   |   |   | ● | ●            |   |   |   |   |                              | ● |   |   |   |   |   |   |   |   |   |   |   |   | 1  |
| 2                                        | FIRE ALARM SYSTEM LOW BATTERY        |                                                                                                                                                                                                                                                                                                                                                                                                                                                                                                                                                                            |   |   |   | ● | ●            |   |   |   |   |                              | ● |   |   |   |   |   |   |   |   |   |   |   |   | 2  |
| 3                                        | OPEN CIRCUIT                         |                                                                                                                                                                                                                                                                                                                                                                                                                                                                                                                                                                            |   |   |   | ● | ●            |   |   |   |   |                              | ● |   |   |   |   |   |   |   |   |   |   |   |   | 3  |
| 4                                        | GROUND FAULT                         |                                                                                                                                                                                                                                                                                                                                                                                                                                                                                                                                                                            |   |   |   | ● | ●            |   |   |   |   |                              | ● |   |   |   |   |   |   |   |   |   |   |   |   | 4  |
| 5                                        | NOTIFICATION APPLIANCE CIRCUIT SHORT |                                                                                                                                                                                                                                                                                                                                                                                                                                                                                                                                                                            |   |   |   | ● | ●            |   |   |   |   |                              | ● |   |   |   |   |   |   |   |   |   |   |   |   | 5  |
| 6                                        | BUILDING MANUAL PULL STATIONS        | ●                                                                                                                                                                                                                                                                                                                                                                                                                                                                                                                                                                          | ● |   |   |   |              | ● | ● | ● | ● |                              |   | ● |   |   |   | ● |   |   |   |   |   |   |   | 6  |
| 7                                        | CORRIDOR SMOKE DETECTORS             | ●                                                                                                                                                                                                                                                                                                                                                                                                                                                                                                                                                                          | ● |   |   |   |              | ● | ● | ● | ● |                              |   | ● |   |   |   | ● |   |   |   |   |   |   |   | 7  |
| 8                                        | AREA SMOKE DETECTORS                 | ●                                                                                                                                                                                                                                                                                                                                                                                                                                                                                                                                                                          | ● |   |   |   |              | ● | ● | ● | ● |                              |   | ● |   |   |   | ● |   |   |   |   |   |   |   | 8  |
| 9                                        | HEAT DETECTORS                       | ●                                                                                                                                                                                                                                                                                                                                                                                                                                                                                                                                                                          | ● |   |   |   |              | ● | ● | ● | ● |                              |   | ● |   |   |   | ● |   |   |   |   |   |   |   | 9  |
| 10                                       |                                      |                                                                                                                                                                                                                                                                                                                                                                                                                                                                                                                                                                            10 |
| 11                                       |                                      |                                                                                                                                                                                                                                                                                                                                                                                                                                                                                                                                                                            11 |
| 12                                       |                                      |                                                                                                                                                                                                                                                                                                                                                                                                                                                                                                                                                                            12 |
| 13                                       |                                      |                                                                                                                                                                                                                                                                                                                                                                                                                                                                                                                                                                            13 |
| 14                                       |                                      |                                                                                                                                                                                                                                                                                                                                                                                                                                                                                                                                                                            14 |
| 15                                       |                                      |                                                                                                                                                                                                                                                                                                                                                                                                                                                                                                                                                                            15 |
| 16                                       |                                      |                                                                                                                                                                                                                                                                                                                                                                                                                                                                                                                                                                            16 |
| 17                                       |                                      |                                                                                                                                                                                                                                                                                                                                                                                                                                                                                                                                                                            17 |
| 18                                       |                                      |                                                                                                                                                                                                                                                                                                                                                                                                                                                                                                                                                                            18 |
| 19                                       |                                      |                                                                                                                                                                                                                                                                                                                                                                                                                                                                                                                                                                            19 |
| 20                                       |                                      |                                                                                                                                                                                                                                                                                                                                                                                                                                                                                                                                                                            20 |
| 21                                       |                                      |                                                                                                                                                                                                                                                                                                                                                                                                                                                                                                                                                                            21 |
| 22                                       | -                                    |                                                                                                                                                                                                                                                                                                                                                                                                                                                                                                                                                                            |   22 |
| 23                                       | -                                    |                                                                                                                                                                                                                                                                                                                                                                                                                                                                                                                                                                            |   23 |
| 24                                       |                                      |                                                                                                                                                                                                                                                                                                                                                                                                                                                                                                                                                                            24 |
| 25                                       |                                      |                                                                                                                                                                                                                                                                                                                                                                                                                                                                                                                                                                            25 |
| 26                                       |                                      |                                                                                                                                                                                                                                                                                                                                                                                                                                                                                                                                                                            26 |
| 27                                       |                                      |                                                                                                                                                                                                                                                                                                                                                                                                                                                                                                                                                                            27 |
|                                          |                                      | A                                                                                                                                                                                                                                                                                                                                                                                                                                                                                                                                                                          | B | C | D | E | F            | G | H | I | J | K                            | L | M | N | O | P | Q | R | S | T | U | V | W | V | W  |

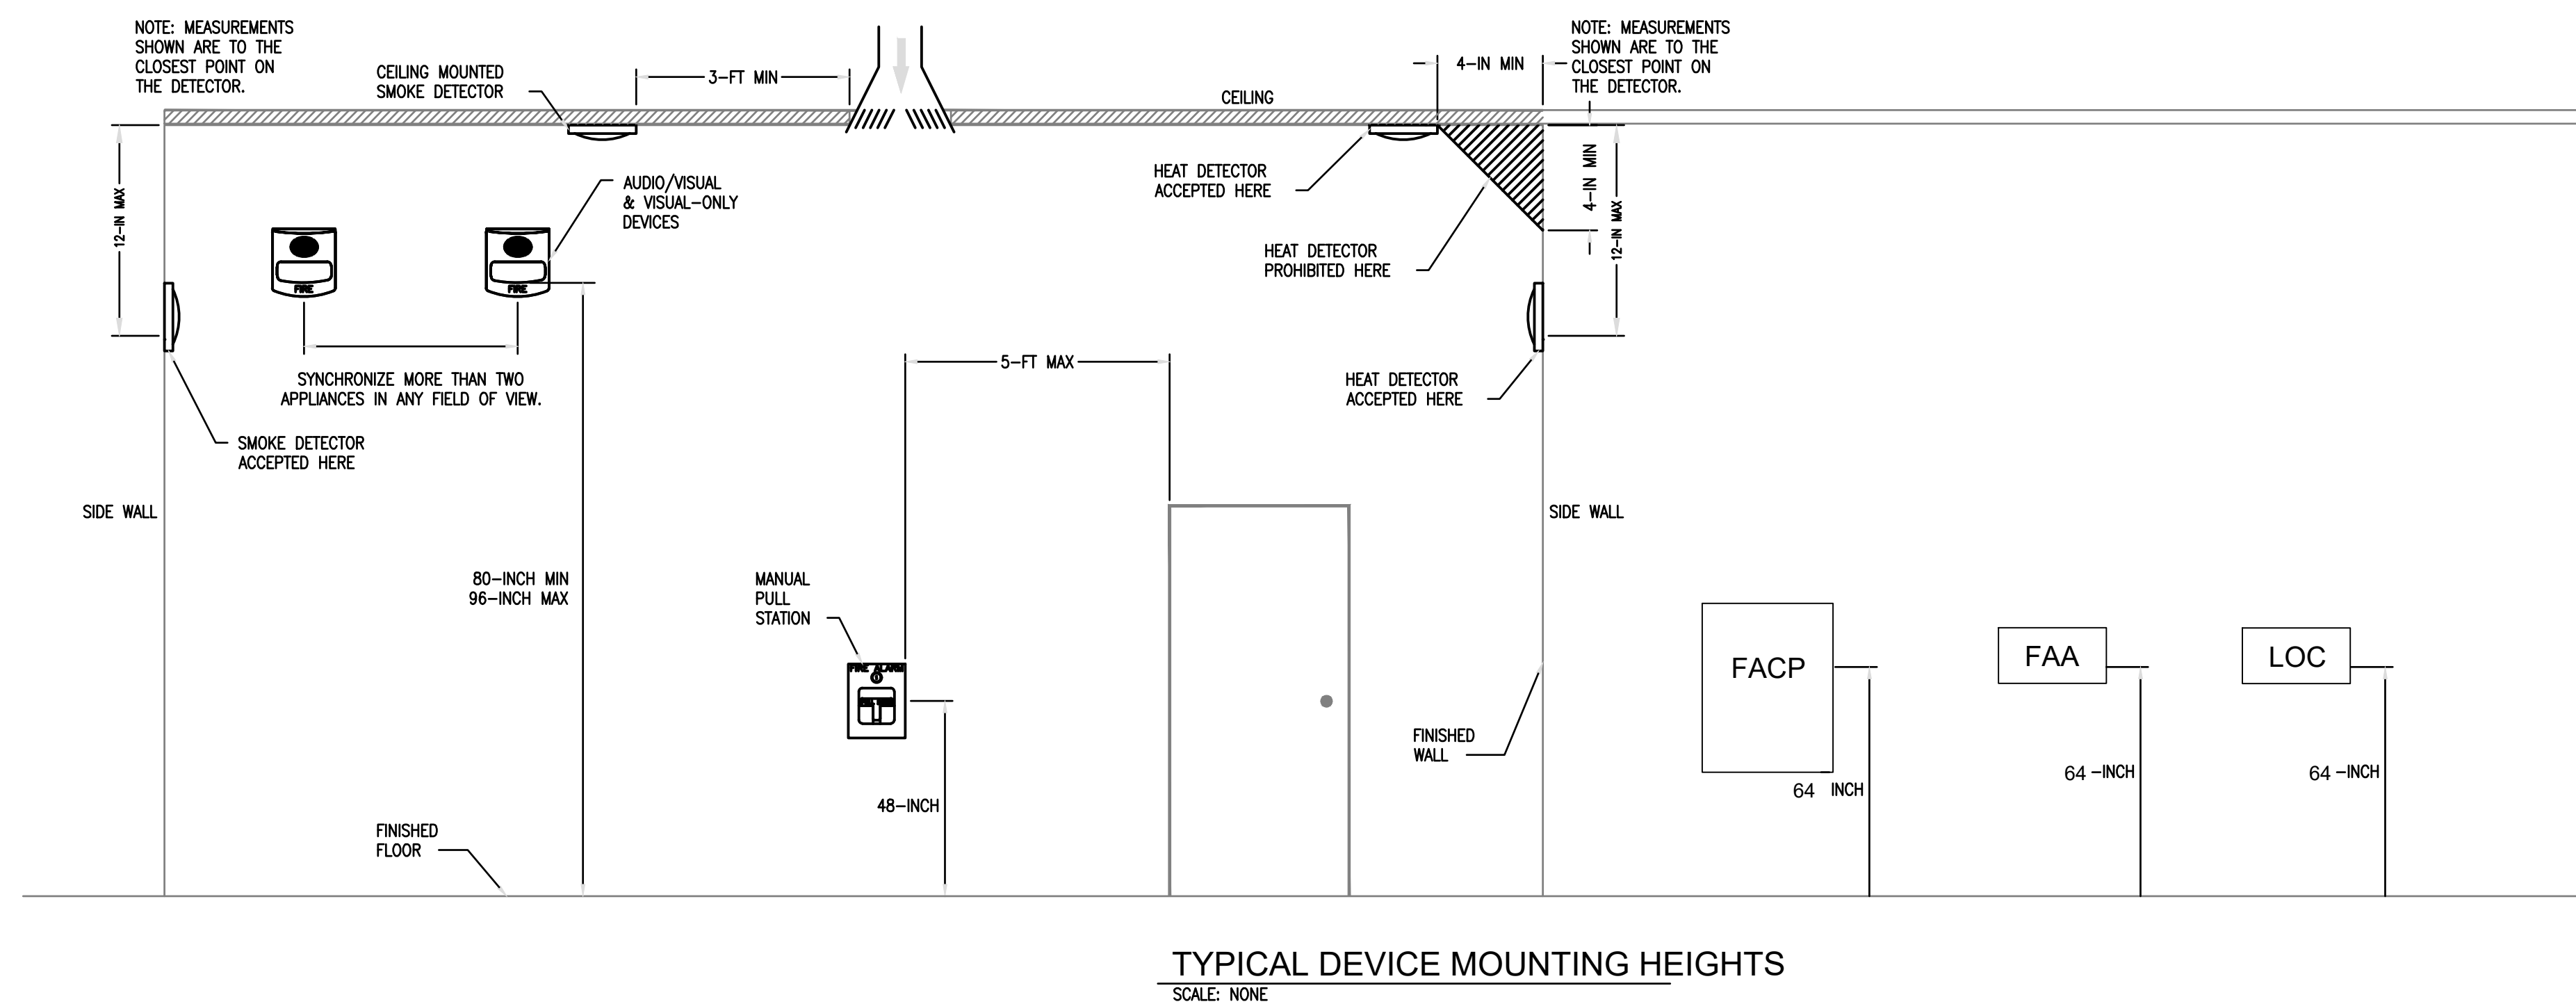

MEP Engineering Group  
Certificate of Authority #2016015108  
[mepengineeringgroup@gmail.com](mailto:mepengineeringgroup@gmail.com)  
(816)778-1195

|           |                    |
|-----------|--------------------|
| DRAWN     | D. FLINT           |
| DATE      | 8/22/25            |
| DESIGN BY | D. FLINT<br>121007 |
| SCALE     | NTS                |
| JOB NO.   | 42932006           |