# ALURA CLUBHOUSE DISCOVERY PARK, LEE'S SUMMIT, MO

#### ARCHITECT:

PWARCHITECTS, INC. 2120 FORUM BLVD., STE. 101 COLUMBIA, MO 65203 (573) 449-2683 (573) 442-6213 FAX

**LOCATION PLAN** 

SCALE: 1" = 200'-0"

#### CIVIL & STRUCTURAL ENGINEER:

CROCKETT ENGINEERING CONSULTANTS 1000 W. NIFONG BLVD. COLUMBIA, MO 65203 (573) 447-0292

#### MECHANICAL ENGINEER:

J-SQUARED ENGINEERING 2400 BLUFF CREEK DR #101, COLUMBIA, MO 65201 (573) 234-4492

## SITE LOCATION University Health Lakewood Medical. NE Strother Rd 291 Lees Summit Municipal Airport Village UNITY RIDGE NE Colbern Rd E Bannister Rd East Hospital Sout NW Chipman Rd NE Chipman Rd OAK TREE FARM E Langsford Rd Lees SW 3rd St SW 3rd St SE 5th Terrace WINTERSET SW Longview Rd SW Scherer Rd SOUTH LEE

#### LIST OF DRAWINGS

GENERAL

G001 COVER SHEET, LOCATION PLAN, LEGENDS, DRAWING INDEX G002 CODE AND EGRESS PLAN

G002 CODE AND EGRESS F G003 SPECIFICATIONS G004 SPECIFICATIONS

G005 SPECIFICATIONS

CIVIL
UNDER SEPARATE SUBMITTAL

## STRUCTURAL

S100 COVER / GENERAL STRUCTURAL DATA S200 FOUNDATION PLAN S210 FOUNDATION DETAILS S211 FOUNDATION DETAILS S300 ROOF FRAMING PLAN S301 STAIR FRAMING PLAN & DETAILS S310 ROOF FRAMING DETAILS S311 ROOF FRAMING PLAN

### ARCHITECTURAL

- A101 FIRST FLOOR PLAN A102 REFLECTED CEILING PLAN A103 ROOF PLAN
- A104 ENLARGED FLOOR PLANS A105 FLOOR FINISH PLAN AND SCHEDULE A201 BUILDING ELEVATIONS

A202 INTERIOR ELEVATIONS AND DETAILS

- A301 BUILDING AND WALL SECTIONS A501 STAIR DETAILS A601 DOOR AND WINDOW SCHEDULE AND DETAILS

#### MEP

MEP1 MECHANICAL ELECTRICAL PLUMBING COVER SHEET MEP2 SITE UTILITIES PLAN MEP3 SITE LIGHTING PLAN MEP4 ROOF MEP PLAN

M101 HVAC PLAN
M501 HVAC DETAILS
M601 HVAC SCHEDULES
EP101 POWER PLAN - FIRST FLOOR
EL101 LIGHTING PLAN
E501 ELECTRICAL DETAILS & SCHEDULES

E502 ELECTRICAL SCHEDULES FP101 FIRE PROTECTION PLAN PS101 SANITARY SEWER PLAN PW101 WATER & GAS PLAN P501 PLUMBING DETAILS & SCHEDULES

DRAWING INDEX

SCALE: NTS

LARGE S	SCALE	SMALL S	SCALE
BRICK MASONRY UNIT			PLAN, SECTION ELEVATION
CONCRETE MASONRY UNIT			PLAN, SECTION ELEVATION
CONCRETE	4 4 4 4 4		PLAN, SECTION
GYPSUM BOARD			PLAN, SECTION
			ELEVATION
GROUTED AREA OF: CMU/CAVITY/DOOR FRAME			PLAN, SECTION
MISCELLANEOUS ITEMS: AS NOTED ON EACH SHEET			PLAN, SECTION, ELEVATION
INSULATION	***************************************		PLAN, SECTION
ROOF SHINGLES			PLAN, ELEVATION
CONTINUOUS WOOD FRAMING			PLAN, SECTION
WOOD BLOCKING			PLAN, SECTION
PLYWOOD	,,,		PLAN, SECTION
EXISTING BUILDING			PLAN, SECTION


MATERIAL LEGEND

SCALE: NTS

	ODID DEFEDENCE
	GRID REFERENCE
DRAWING TITLE	
?? SCALE: X/X" = 1'-0"	ARCH. SCALE
DRAWING BULLET WITHOUT NORTH ARROW	
	GRID REFERENCE
A2 DRAWING TITLE	ARCH. SCALE
A100 SCALE: X/X" = 1'-0"	PAGE FIRST REFERENCED (IF
	APPLICABLE)
ELEVATION BULLETS	PLAN/ELEVATION DETAIL BULLET
AND DEFENSAGE	
A0 GRID REFERENCE	
SHEET NOWIDER	
ONE ELEVATION	- GRID REFERENCE
SCOPE OF WORK BULLET	A1 A1
$\langle 1 \rangle$	A100 SHEET NUMBER
	SECTION BULLET
DOOR MARK BULLET	SECTION BOLLET
(000A)	GRID REFERENCE ALWAYS ON TOP
COOCA	A1 A100
WINDOW MARK BULLET	SHEET NUMBER
	STEET NOMBER
9	NORTH ARROW
REVISION NOTE BULLET	
$\wedge$	
<u>/1</u>	
GENERAL NOTE BULLET	
$\langle 1 \rangle$	COLUMN LINE BULLETS
·/	(1)
BENCHMARK BULLET	<b>1</b>
	A - · · - · · -
000.OO'	
***** FLOOR	SPOT ELEV. BULLETS
	/ / 10 100 05 0100 10
	TC - TOP OF CURB TG -
	TOP OF WALL TP - TOP
	OF PAVING


SYMBOL LEGEND

SCALE: NTS

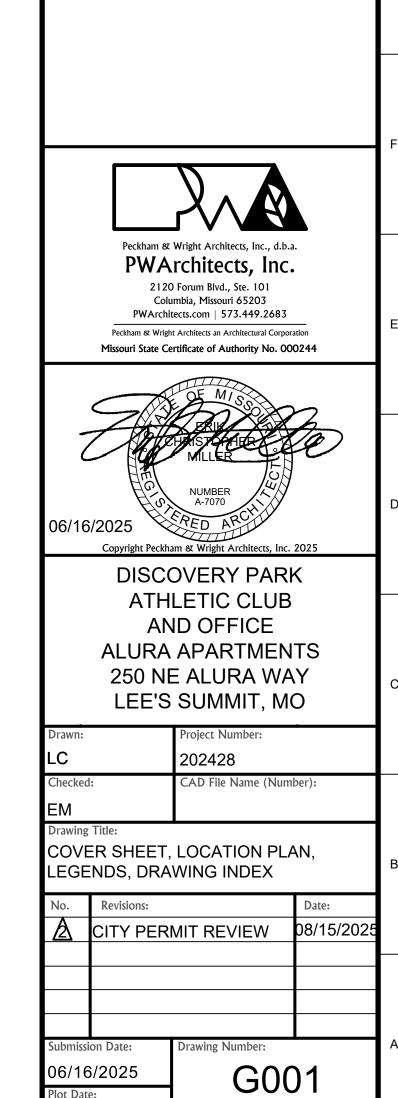


06/16/2025

CONSTRUCTION
As Noted on Plans Review

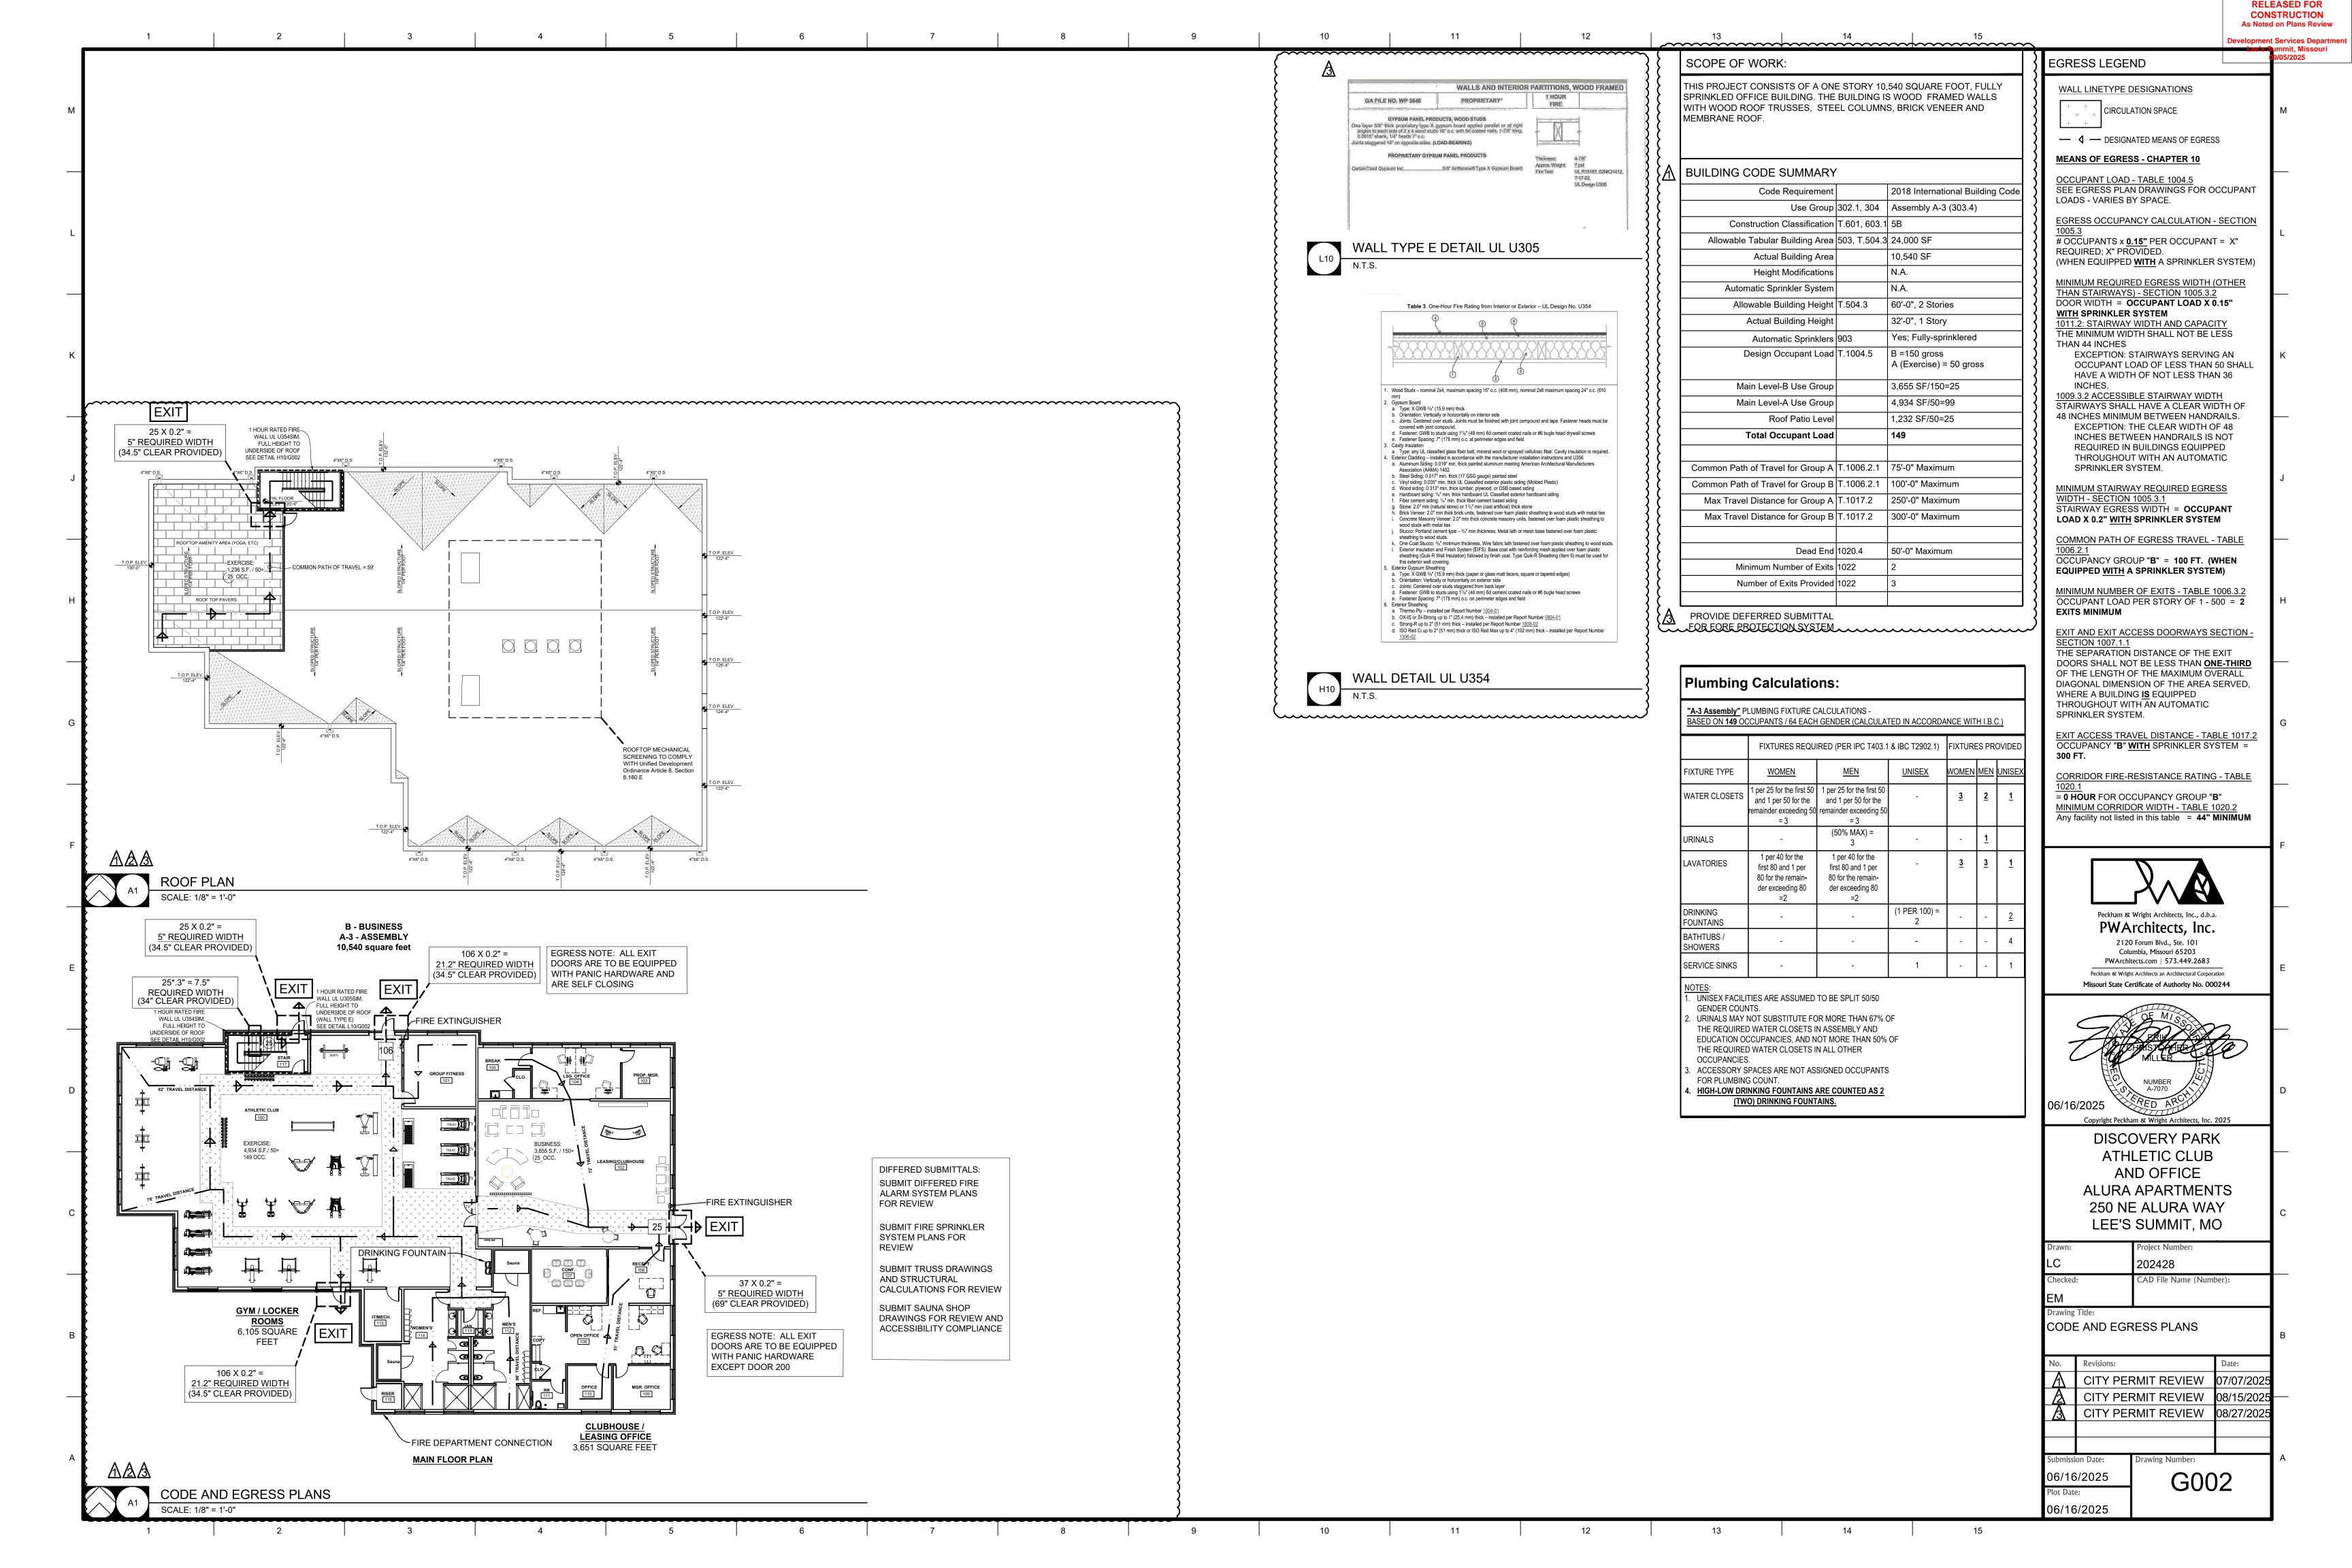

RELEASED FOR CONSTRUCTION As Noted on Plans Review

RELEASED FOR CONSTRUCTION

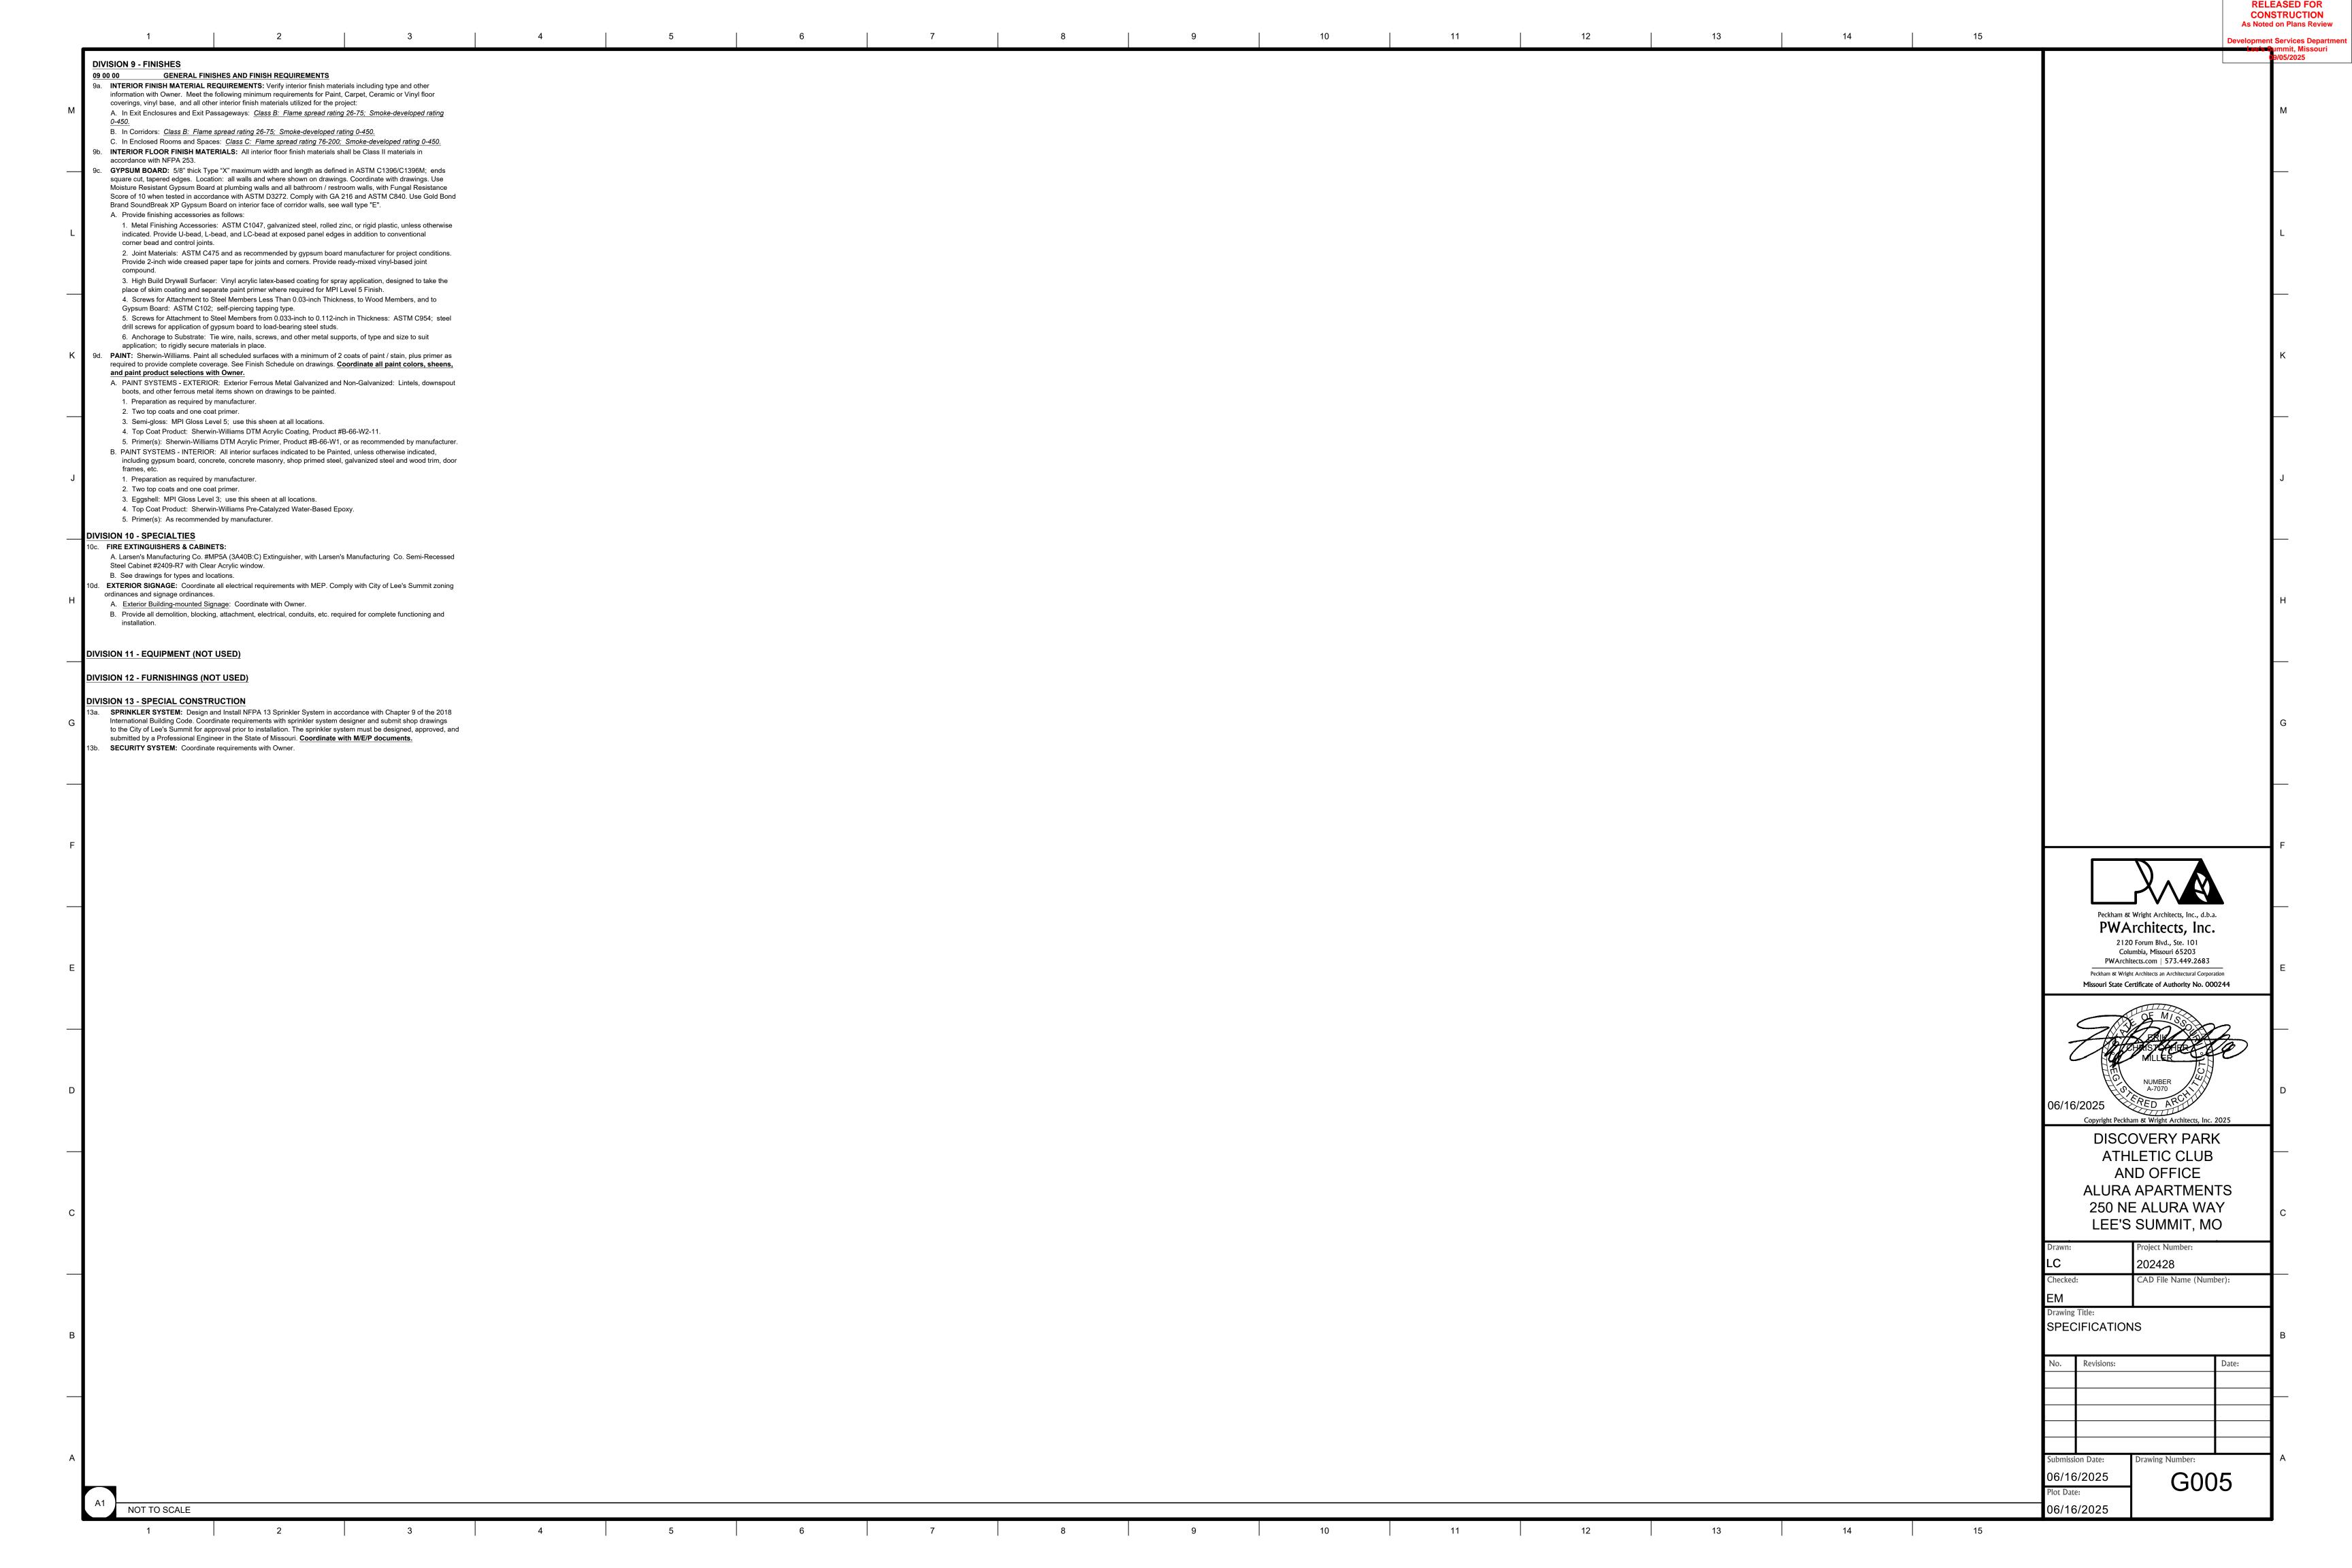

CONSTRUCTION

# Discovery - Alura Clubhouse

#### GENERAL NOTES

SEE ARCHITECTURAL DRAWINGS OR SITE PLAN FOR FINISH FLOOR ELEVATIONS

2018 INTERNATIONAL BUILDING CODE

EARTHWORK OPERATIONS SHALL BE PERFORMED UNDER THE DIRECTION OF A PROFESSIONAL TESTING AGENCY TO ASSURE COMPLIANCE WITH THE RECOMMENDATIONS OF THE SOILS REPORT BY OWN, INC. DATED APRIL 1, 2024 & ADDENDUM LETTER DATED DECEMBER 19, 2024.

#### CONCRETE

CONCRETE WORK SHALL CONFORM TO ALL REQUIREMENTS OF THE CURRENT ACI 301, SPECIFICATIONS FOR STRUCTURAL CONCRETE FOR BUILDINGS, ACI 318 BUILDING CODE REQUIREMENTS FOR STRUCTURAL CONCRETE, ACI 305 SPECIFICATIONS FOR HOT WATER CONCRETE, AND ACI 306 SPECIFICATIONS FOR COLD WEATHER CONCRETE, WITH THE FOLLOWING ADDITIONAL REQUIREMENTS:

- 1. CONCRETE SHALL DEVELOP THE FOLLOWING 28-DAY MINIMUM COMPRESSIVE STRENGTH:
- CAST-IN-PLACE WALLS
- EXTERIOR SLABS, WALLS AND CURBS 4,000 PSI
- 2. ALL FOOTINGS SHALL BEAR ON UNDISTURBED SOIL OR ENGINEERED FILI
- 3. CHLORIDE- BASED ADMIXTURES ARE PROHIBITED IN ALL REINFORCED CONCRETE.
- 4. REINFORCING STEEL SHALL CONFORM TO ASTM A615, A616, OR A617, GRADE 60.
- 5. ALL CONTINUOUS REINFORCING STEEL THAT MEETS AT A CORNER SHALL BE TIED TOGETHER WITH A CORNER BAR THAT HAS SUFFICIENT LAP DISTANCE IN EACH DIRECTION
- 6. CONTINUOUS REINFORCING BARS LAP LENGTH SHALL BE A MINIMUM OF 48 BAR DIAMETERS UNLESS
- 7. CONCRETE SLUMP SHALL BE A MAXIMUM OF 4" +/- 1" (ASTM C- 143) AS DELIVERED IN THE FIELD. CONTRACTOR MAY USE CHEMICAL ADMIXTURES TO ATTAIN A MAXIMUM SLUMP OF 8" FOR WORKABILITY. NO WATER MAY BE ADDED TO THE CONCRETE MIX ON SITE UNLESS WATER IS WITHHELD AT THE BATCHING FACILITY. IF WATER IS WITHHELD AT THE BATCHING FACILITY IT SHOULD BE REFLECTED ON THE LOAD TICKET. THE TOTAL AMOUNT OF WATER IN THE MIX SHALL NOT EXCEED WHAT IS NOTED ON
- THE APPROVED MIXED. THIS SHALL BE NOTED IN THE SPECIAL INSPECTOR'S RECORDS. 8. CONCRETE EXPOSED TO WEATHER, VEHICLES, AND/OR DEICING CHEMICALS SHALL BE AIR-ENTRAINED WITH 6% (+/-) 1.5% ENTRAINED AIR BY VOLUME AT POINT OF DISCHARGE. DO NOT ALLOW AIR
- CONTENT OF TROWELED FINISHED FLOORS TO EXCEED 3%. 9. SUBMIT CONCRETE MIX PROPORTIONS PRIOR TO START OF WORK. DO NOT BEGIN CONCRETE
- PRODUCTION UNTIL MIXES HAVE BEEN REVIEWED AND ARE ACCEPTABLE TO THE ENGINEER. 10.READY MIX CONCRETE SHALL COMPLY WITH REQUIREMENTS OF ASTM C94. 11.CONCRETE WORK EXECUTION
- A. CONSTRUCT FORMS TO CORRECT SIZE, SHAPE, ALIGNMENT, ELEVATION AND POSITION; AND TO SUPPORT VERTICAL AND LATERAL LOADS.
- B. POSITION, SUPPORT, AND SECURE REINFORCEMENT AGAINST DISPLACEMENT. MINIMUM CONCRETE COVER FOR REINFORCEMENT SHALL BE. UNLESS NOTED OTHERWISE ON THE DRAWINGS: CAST AGAINST AND EXPOSED TO EARTH.......3 INCHES EXPOSED TO EARTH OR WEATHER......2 INCHES NOT EXPOSED TO WEATHER OR
- IN CONTACT WITH EARTH..... ......1 ½ INCHES C. PROVIDE CONTROL JOINTS IN SLABS-ON-GRADE AT NOT GREATER THAN 15 FEET ON CENTER IN EACH DIRECTION. SAW CUT CONTROL JOINTS MINIMUM 1/4 OF SLAB DEPTH. AS SOON AFTER SLAB
- FINISHING WITHOUT DISLODGING AGGREGATE. D. STEEL TROWEL FINISH ALL INTERIOR CONCRETE SLABS, BROOM FINISH ALL EXTERIOR CONCRETE
- E. CURE ALL CONCRETE IN COMPLIANCE WITH ACI 301, USING A LIQUID TYPE MEMBRANE, NON-RESIDUAL, CURING COMPOUND COMPLYING WITH ASTM C309. ASSURE COMPATIBILITY WITH FINISH FLOOR COVERING.

### STRUCTURAL STEEL

- 1. FABRICATION AND ERECTION OF STRUCTURAL STEEL SHALL BE IN ACCORDANCE WITH THE CURRENT EDITION OF THE AISC SPECIFICATIONS FOR STRUCTURAL STEEL BUILDINGS, THE AISC CODE OF STANDARD PRACTICE FOR STEEL BUILDINGS AND BRIDGES AND CURRENT OSHA STANDARDS.
- 2. WIDE FLANGE SHAPES SHALL CONFORM TO ASTM A992. STRUCTURAL TUBES SHALL CONFORM TO ASTM A500 GRADE B. ALL OTHER STRUCTURAL STEEL SHALL CONFORM TO ASTM A36.
- 3. BOLTS, UNLESS OTHERWISE SHOWN, SHALL CONFORM TO ASTM A325-N,
- SIZE AS PER PLAN. 4. ANCHOR BOLTS, UNLESS OTHERWISE SHOWN, SHALL CONFORM TO
- ASTM F1554 GRADE 36.
- 5. SPLICING OF STRUCTURAL STEEL IS PROHIBITED EXCEPT AS DETAILED. 6. ALL STRUCTURAL AND MISCELLANEOUS STEEL ITEMS SHALL RECEIVE ONE COAT OF "IRONCLAD RETARDO RUST INHIBITIVE PAINT 163" (BENJAMIN MOORE) OR APPROVED EQUAL UNLESS OTHERWISE INDICATED IN THE SPECIFICATIONS. ALL STEEL SURFACES EMBEDDED IN CONCRETE SHALL NOT BE PAINTED. PREPARATION OF STEEL SURFACES SHALL MEET THE REQUIREMENTS OF THE STEEL STRUCTURES PAINTING COUNCIL (SSPC-SP1) AND THE REMOVAL OF GREASE AND OIL BY SOLVENT CLEANING (SSPC-SP1) AND THE REMOVAL OF MILL SCALE, RUST, WELD FLUX AND SLAG BY HAND TOOL CLEANING (SSPC-SP2). PRIMER SHALL BE APPLIED AT THE MANUFACTURER'S RECOMMENDED RATE BUT NOT LESS THAN ONE GALLON PER 400 SQ.FT. THEREBY DEPOSITING A DRY FILM THICKNESS OF NOT LESS
- THAN 1.5 MILS. ANY SCARRED AREAS SHALL BE TOUCHED UP WITH THE SAME PAINT AFTER ERECTION. 7. ALL WELDING SHALL BE DONE BY QUALIFIED WELDERS IN ACCORDANCE WITH THE CURRENT EDITION OF THE AWS STRUCTURAL WELDING CODE. WELDING ELECTRODES SHALL BE E70XX.

#### POST-INSTALLED ANCHORS

- 1. ALL POST-INSTALLED ANCHORS SHALL MEET THE REQUIREMENTS OF THE CODE-CITED EDITION OF ACI 318, APPENDIX "D", AND SHALL BE ACCEPTABLE FOR BOTH CRACKED AND UNCRACKED CONCRETE. 2. EXPANSION ANCHORS HAVE BEEN DESIGNED AS HILTI KWIK BOLT TZ ANCHORS, UNLESS NOTED
- 3. ADHESIVE ANCHORS HAVE BEEN DESIGNED TO USE HILTI HIT HY 200 ADHESIVE IN CONCRETE OR SOLID MASONRY, UNLESS NOTED OTHERWISE.
- 4. EQUIVALENT ANCHORS MAY BE SUBMITTED FOR THE ENGINEER'S APPROVAL. SUBMITTALS ARE THE CONTRACTOR'S RESPONSIBILITY AND MUST INCLUDE EVALUATION REPORTS FROM THE INTERNATIONAL
- CONFERENCE OF BUILDING OFFICIALS (ICBO). 5. EMBEDMENT DEPTH IS DEFINED AS THE DISTANCE FROM THE SURFACE OF THE LOAD-BEARING BASE MATERIAL TO THE DEEPEST PART OF THE ANCHOR AFTER THE ANCHOR HAS BEEN DRIVEN INTO THE
- 6. ADHESIVE ANCHORS SHALL BE ACCEPTABLE FOR LONG—TERM LOADING. WHEN BASE MATERIAL TEMPERATURES ARE BELOW 40 DEG F, ONLY NON-EPOXY-BASED ADHESIVES SHALL BE USED.
- 7. POST-INSTALLED ANCHORS SHALL ONLY BE USED WHERE SPECIFIED ON THE DRAWINGS. THE CONTRACTOR SHALL OBTAIN APPROVAL FROM THE ENGINEER PRIOR TO USING POST-INSTALLED ANCHORS FOR MISSING OR MISPLACED CAST-IN-PLANE ANCHORS. CARE SHALL BE TAKEN TO AVOID CONFLICTS WITH EXISTING REINFORCING BARS. HOLES SHALL BE DRILLED AND CLEANED PER ANCHOR
- 8. STAINLESS STEEL ANCHORS ARE REQUIRED AT ALL PERMANENTLY EXPOSED WEATHER CONDITIONS.

TIMBER WORK SHALL CONFORM TO ALL REQUIREMENTS OF THE CURRENT ANSI/AF&PA NATIONAL DESIGN SPECIFICATION (NDS) FOR WOOD CONSTRUCTION, WITH THE FOLLOWING SUPPLEMENTAL REQUIREMENTS:

- 1. FOR COMMON MEMBER SIZES, THE SPECIES AND GRADES SHALL BE AS FOLLOWS, UNLESS NOTED OTHERWISE:
  - A. 2X4 SPF No.1/No.2
  - 2X6 SPF No.1/No.2
  - 2X8 DF-L No.2
  - D. 2X10 DF-L S.S.
  - E. 2X12 DF-L S.S.

EQUIVALENT (OR BETTER) GRADES & SPECIES MAY BE SUBMITTED FOR THE ENGINEER'S APPROVAL.

- 2. SIZES SHOWN FOR LUMBER ARE NOMINAL SIZES.
- 3. TIMBER EXPOSED TO WEATHER OR GROUND, OR IN CONTACT WITH CONCRETE OR MASONRY SHALL BE PRESSURE-IMPREGNATED BY AN APPROVED PROCESS AND PRESERVATIVE.
- 4. SPLICING OF JOISTS, STUDS, OR HEADERS IS PROHIBITED EXCEPT AS SHOWN. 5. BOLTS SHALL CONFORM TO ASTM A307. HOLES SHALL BE DRILLED PER SECTION 11.1.2 OF THE
- CURRENT ANSI/AF&PA NDS FOR WOOD CONSTRUCTION. 6. LAG SCREWS AND WOOD SCREWS SHALL BE INSTALLED PER SECTIONS 11.1.3 AND 11.1.4,
- RESPECTIVELY, OF THE CURRENT ANSI/AF&PA NDS FOR WOOD CONSTRUCTION. 7. COMMON NAILS SHALL BE USED, UNLESS NOTED OTHERWISE. IN ADDITION, NAILS SHALL BE
- GALVANIZED, IF EXPOSED TO WEATHER OR MOISTURE. TOE-NAILS SHALL BE DRIVEN PER SECTION 11.1.5.4 OF THE CURRENT ANSI/AF&PA NDS FOR WOOD CONSTRUCTION.
- 8. FASTENING SHALL BE PER THE IBC MINIMUM FASTENING SCHEDULE, TABLE 2304.9.1, UNLESS NOTED
- 9. CONNECTIONS/CONNECTORS SHALL BE INSTALLED PER MANUFACTURER'S SPECIFICATIONS.

#### BRICK LINTELS

1. ALL STEEL LINTELS TO BE A36 STEEL, A992 GRADE 50, OR A500 GRADE B. ALL LINTELS TO BE HOT DIPPED GALVANIZED.

#### PREFABRICATED WOOD TRUSSES

- 1. FLOOR & ROOF TRUSSES SHALL BE DESIGNED IN ACCORDANCE WITH THE TRUSS PLATE INSTITUTE (TPI) DESIGN SPECIFICATION FOR METAL PLATE CONNECTED WOOD TRUSSES, AND THE ANSI/NF&PA NATIONAL DESIGN SPECIFICATION (NDS) FOR WOOD CONSTRUCTION.
- 2. PROVIDE TEMPORARY AND PERMANENT BRACING ON ALL TRUSSES, AS REQUIRED TO PROVIDE MEMBER
- 3. FLOOR & ROOF TRUSSES SHALL BE DESIGNED AND CONSTRUCTED FOR A MAXIMUM TOTAL LOAD DEFLECTION OF L/360 AND TO SAFELY SUPPORT THE FOLLOWING LOADS:
- A. DEAD, LIVE, SNOW, WIND, EARTHQUAKE: SEE PROJECT DESIGN DATA ON COVER SHEET. B. MECHANICAL PIPE LOAD: TRUSSES SHALL BE DESIGNED FOR A CONCENTRATED LOAD OF 250
- C. OVER-FRAMING LOAD: TRUSSES SHALL ALSO BE DESIGNED TO SUPPORT ADDITIONAL OVERBUILD FRAMING, SUCH AS THAT WHICH FORMS VALLEYS AND HIPS ON ROOFS.
- D. DRIFTED SNOW LOAD: TRUSSES SHALL BE DESIGNED TO SUPPORT DRIFTED SNOW LOADS IN ACCORDANCE WITH THE APPROPRIATE BUILDING CODE.
- E. IN-PLANE LATERAL LOADS: TRUSSES SHALL BE DESIGNED TO SUPPORT ANY LATERAL LOADS CARRIED AXIALLY IN THE PLANE OF THE TRUSS, AS SHOWN ON THE PLANS.
- 4. GABLED END TRUSSES SHALL HAVE VERTICAL MEMBERS SPACED AT 16" O.C. MAXIMUM.

LBS HUNG ANYWHERE ALONG THE BOTTOM CHORD.

- 5. SUBMITTALS SHALL INCLUDE THE FOLLOWING: A. SHOP DRAWINGS PREPARED UNDER THE SUPERVISION OF, AND SIGNED AND SEALED BY, A PROFESSIONAL ENGINEER REGISTERED IN THE STATE WHERE THE PROJECT IS BUILT. THESE
- DRAWINGS SHALL INDICATE SPECIES, GRADE, AND SIZES OF LUMBER TO BE USED; PITCH, SPAN, CAMBER, CONFIGURATION, AND SPACING FOR EACH TYPE OF TRUSS REQUIRED; TYPE, SIZE, MATERIAL, FINISH, AND LOCATION OF METAL CONNECTOR PLATES; AND BEARING DETAILS. SHOW TRUSS LAYOUT AND ALL REQUIRED TEMPORARY AND PERMANENT BRACING AFFECTING THE STRUCTURAL CAPACITY OF THE TRUSSES.

PROVIDE COMPLETE ENGINEERING DESIGN CALCULATIONS THAT INCLUDE DESIGN VALUES, DESIGN ANALYSIS INDICATING LOADING, ASSUMED ALLOWABLE STRESSES, STRESS DIAGRAMS, AND CALCULATIONS, AND ANY OTHER INFORMATION NEEDED FOR REVIEW. THE CALCULATIONS SHALL HAVE BEEN SIGNED AND SEALED BY A QUALIFIED PROFESSIONAL ENGINEER WHO IS REGISTERED IN THE STATE WHERE THE PROJECT IS BUILT AND WHO IS RESPONSIBLE FOR PREPARATION OF THE CALCULATIONS.

### SPECIAL INSPECTIONS

THE FOLLOWING ITEMS REQUIRE SPECIAL INSPECTION IN ACCORDANCE WITH CHAPTER 17 OF THE INTERNATIONAL BUILDING CODE.

- a. CONCRETE GROUT DESIGN MIX (PERIODIC)
- b. PLACING OF CONCRETE AND REINFORCING STEEL (CONTINUOUS OF CONCRETE SAMPLING / PERIODIC OF REINFORCING)
- c. BOLTS & ANCHORS EMBEDDED IN CONCRETE (PERIODIC)
- d. STRUCTURAL STEEL FABRICATIONS (UNLESS AISC APPROVED)
- e. STRUCTURAL STEEL BOLTING & WELDING (PERIODIC)
- f. POST INSTALLED ANCHORS IN CONCRETE (CONTINUOUS)
- a. IN-SITU SOILS, EXCAVATIONS, FILLING & COMPACTION (PERIODIC) h. MASONRY AND REINFORCING STEEL (CONTINUOUS ON CELL GROUTING / PERIODIC ON
- i. WOOD FRAMING:
- i.a. SHEAR WALLS; WALL SIZE, CONFIGURATION, BLOCKING, PANEL GRADE, PANEL THICKNESS,
- i.b. DIAPHRAGMS (FLOOR AND ROOF SHEATHING); SIZE, CONFIGURATION, BLOCKING, PANEL GRADE, PANEL THICKNESS, AND FASTENING. (PERIODIC)
- i.c. FRAMING MEMBERS AND DETAILS (PERIODIC)
- i.d. MATERIAL GRADE (PERIODIC)
- i.e. CONNECTIONS; HANGERS, HOLD DOWNS, BUILT-UP COLUMNS, BUILT-UP BEAMS (PERIODIC)
- i.f. PRE-ENGINEERED TRUSSES; FRAMING, CONNECTIONS, BRIDGING (PERIODIC)


THE CONTRACTOR SHALL REQUEST SPECIAL INSPECTION OF THE ITEMS LISTED ABOVE PRIOR TO THOSE ITEMS BECOMING INACCESSIBLE AND UNOBSERVABLE DUE TO PROGRESSION OF THE WORK.

#### BUILDING OCCUPANCY CATEGORY **ROOF LOAD DATA** LIVE LOAD (COMMON AREA) ASPHALT SHINGLES + FELT 5/8" OSB ROOF SHEATHING PRE-ENGINEERED WOOD TRUSSES @ 2'-0" O.C. INSULATION (BLOWN) MECHANICAL ALLOWANCE 5/8" GYP. CEILING SOLAR TOTAL TO TRUSSES 45 lbs/sq.ft **ROOF TOP AMENITY AREA** LIVE LOAD COMMON AREA 3/4" GYPCRETE & 3/4"SHEATHING MECHANICAL ALLOWANCE 5/8" GYP. CEILING FLOOR STRUCTURE TOTAL TO FLOOR TRUSS 140 lbs/sq.ft RAIN LOADING 15 MINUTE RAIN INTENSITY 7.49 in/hr 60 MINUTE RAIN INTENSITY 3.52 in/hr ROOF SNOW LOAD DATA\* (\*UNBALANCED & DRIFTING SNOW TO BE DETERMINED IN ADDITION TO UNIFORM LOAD, WHERE APPLICABLE) 20 lbs/saft $C_e =$ 14.00 lbs/sq.ft WIND DESIGN DATA 109 M.P.H. (3-SECOND GUST) RISK CATEGORY **EXPOSURE** INTERNAL PRESSURE COEFFICIENT = ± 0.18 DIRECTIONAL PROCEDURE (MWFRS - ASCE 7, CH 27; C&C - ASCE 7, CH 30, PART 4) MAXIMUM COMPONENTS & CLADDING WIND +/-25.33 lbs/sq.ft EARTHQUAKE DESIGN DATA RISK CATEGORY 0.068 SITE CLASS 0.107 S DS= 0.109 SEISMIC DESIGN CATEGORY BASIC SEISMIC-FORCE-RESISTING SYSTEM = LIGHT-FRAME (WOOD) WALLS SHEATHED WITH WOOD STRUCTURAL PANELS RATED FOR SHEAR RESISTANCE 6.5 $\Omega_o =$ 3.0 $C_d =$ V = 0.016 WDESIGN BASE SHEAR **EQUIVALENT LATERAL FORCE PROCEDURE** BASIC SEISMIC-FORCE-RESISTING SYSTEM = STEEL ORDINARY CONCENTRICALLY BRACED FRAMES 3.25 2.0 3.25 V = 0.033 WDESIGN BASE SHEAR **EQUIVALENT LATERAL FORCE PROCEDURE NET ALLOWABLE SOIL BEARING** 2,500 lbs/sq.ft\*\* (\*\*PER GEOTECHNICAL REPORT BY OWN, Inc. DATED APRIL 1, 2024)

**DESIGN DATA** 

2018 INTERNATIONAL BUILDING CODE / ASCE 7-16


INDEX OF SHEETS S100 COVER / GENERAL STRUCTURAL DATA FOUNDATION PLAN S200 S210-S211 FOUNDATION DETAILS ROOF FRAMING PLAN S300 STAIR FRAMING PLANS & DETAILS S301 ROOF FRAMING DETAILS

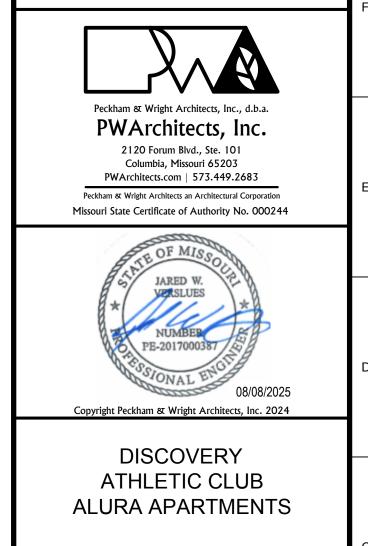



**CEC Project Number:** 230286 CAD File Name (Number): JWV Drawing Title: **GENERAL** STRUCTURAL DATA Revisions: REVISION #1 - CITY COMMENTS 08/12/202

08/12/2025 08/12/2025


08/12/2025

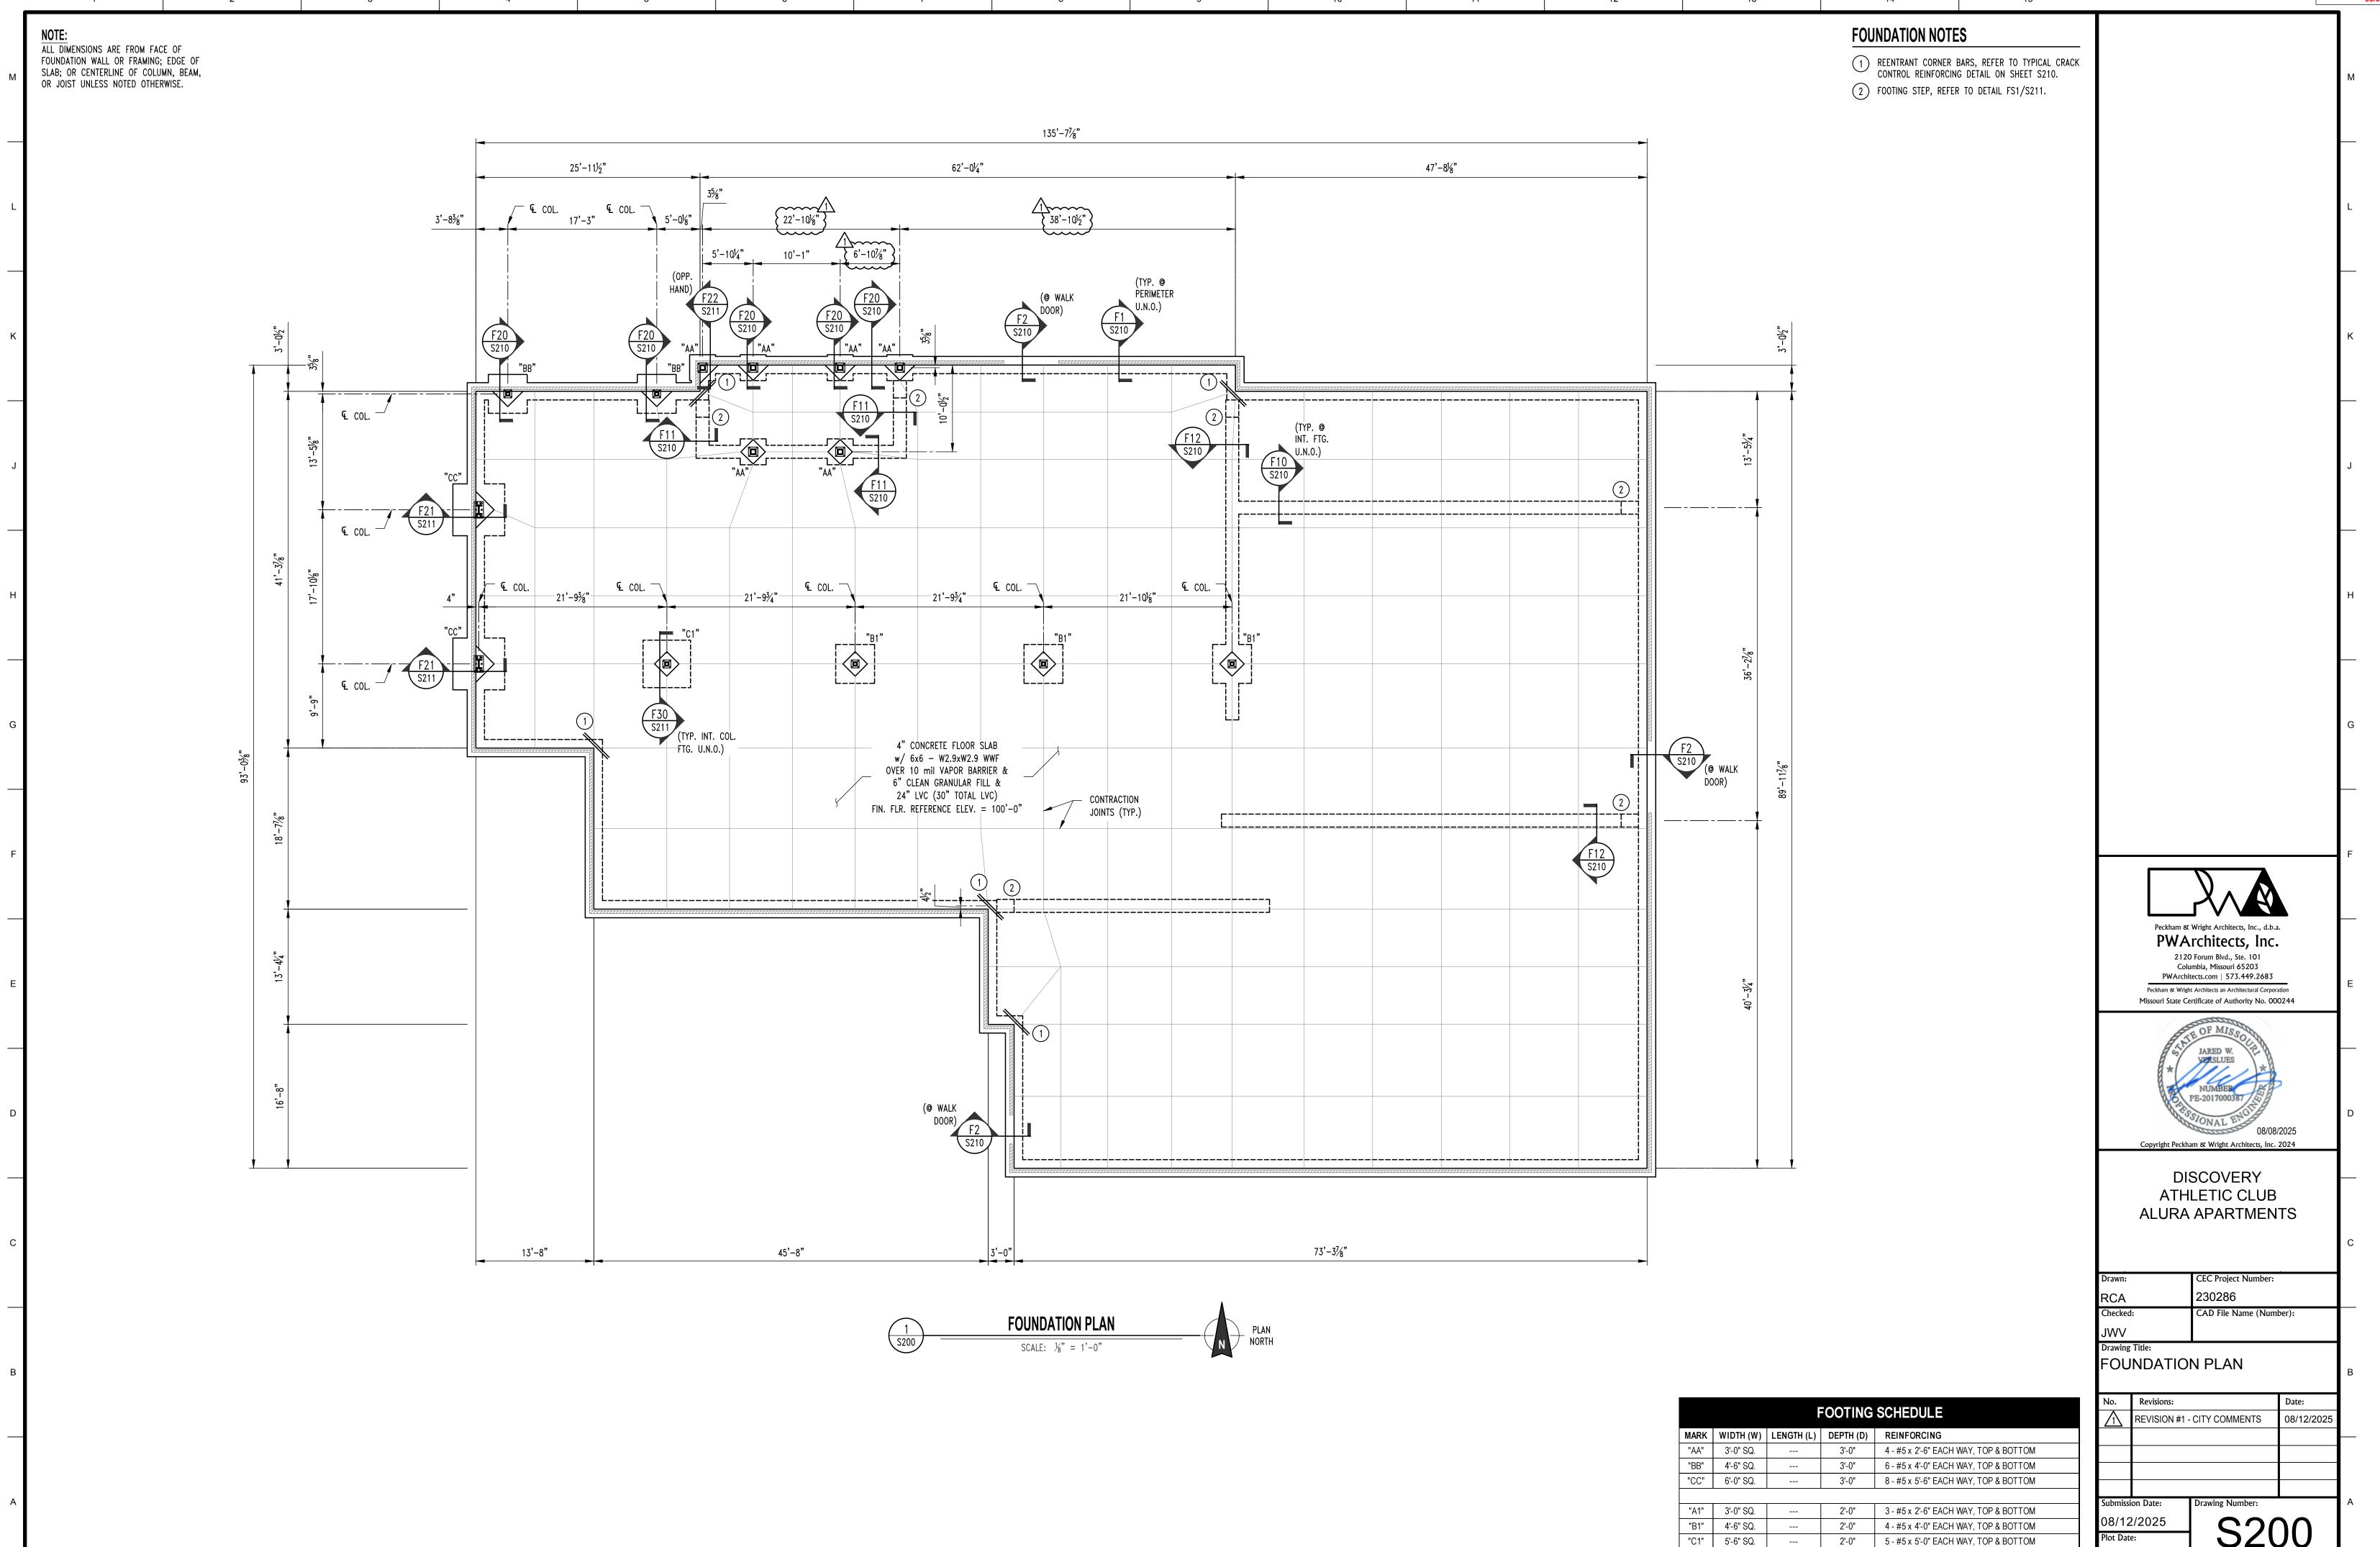

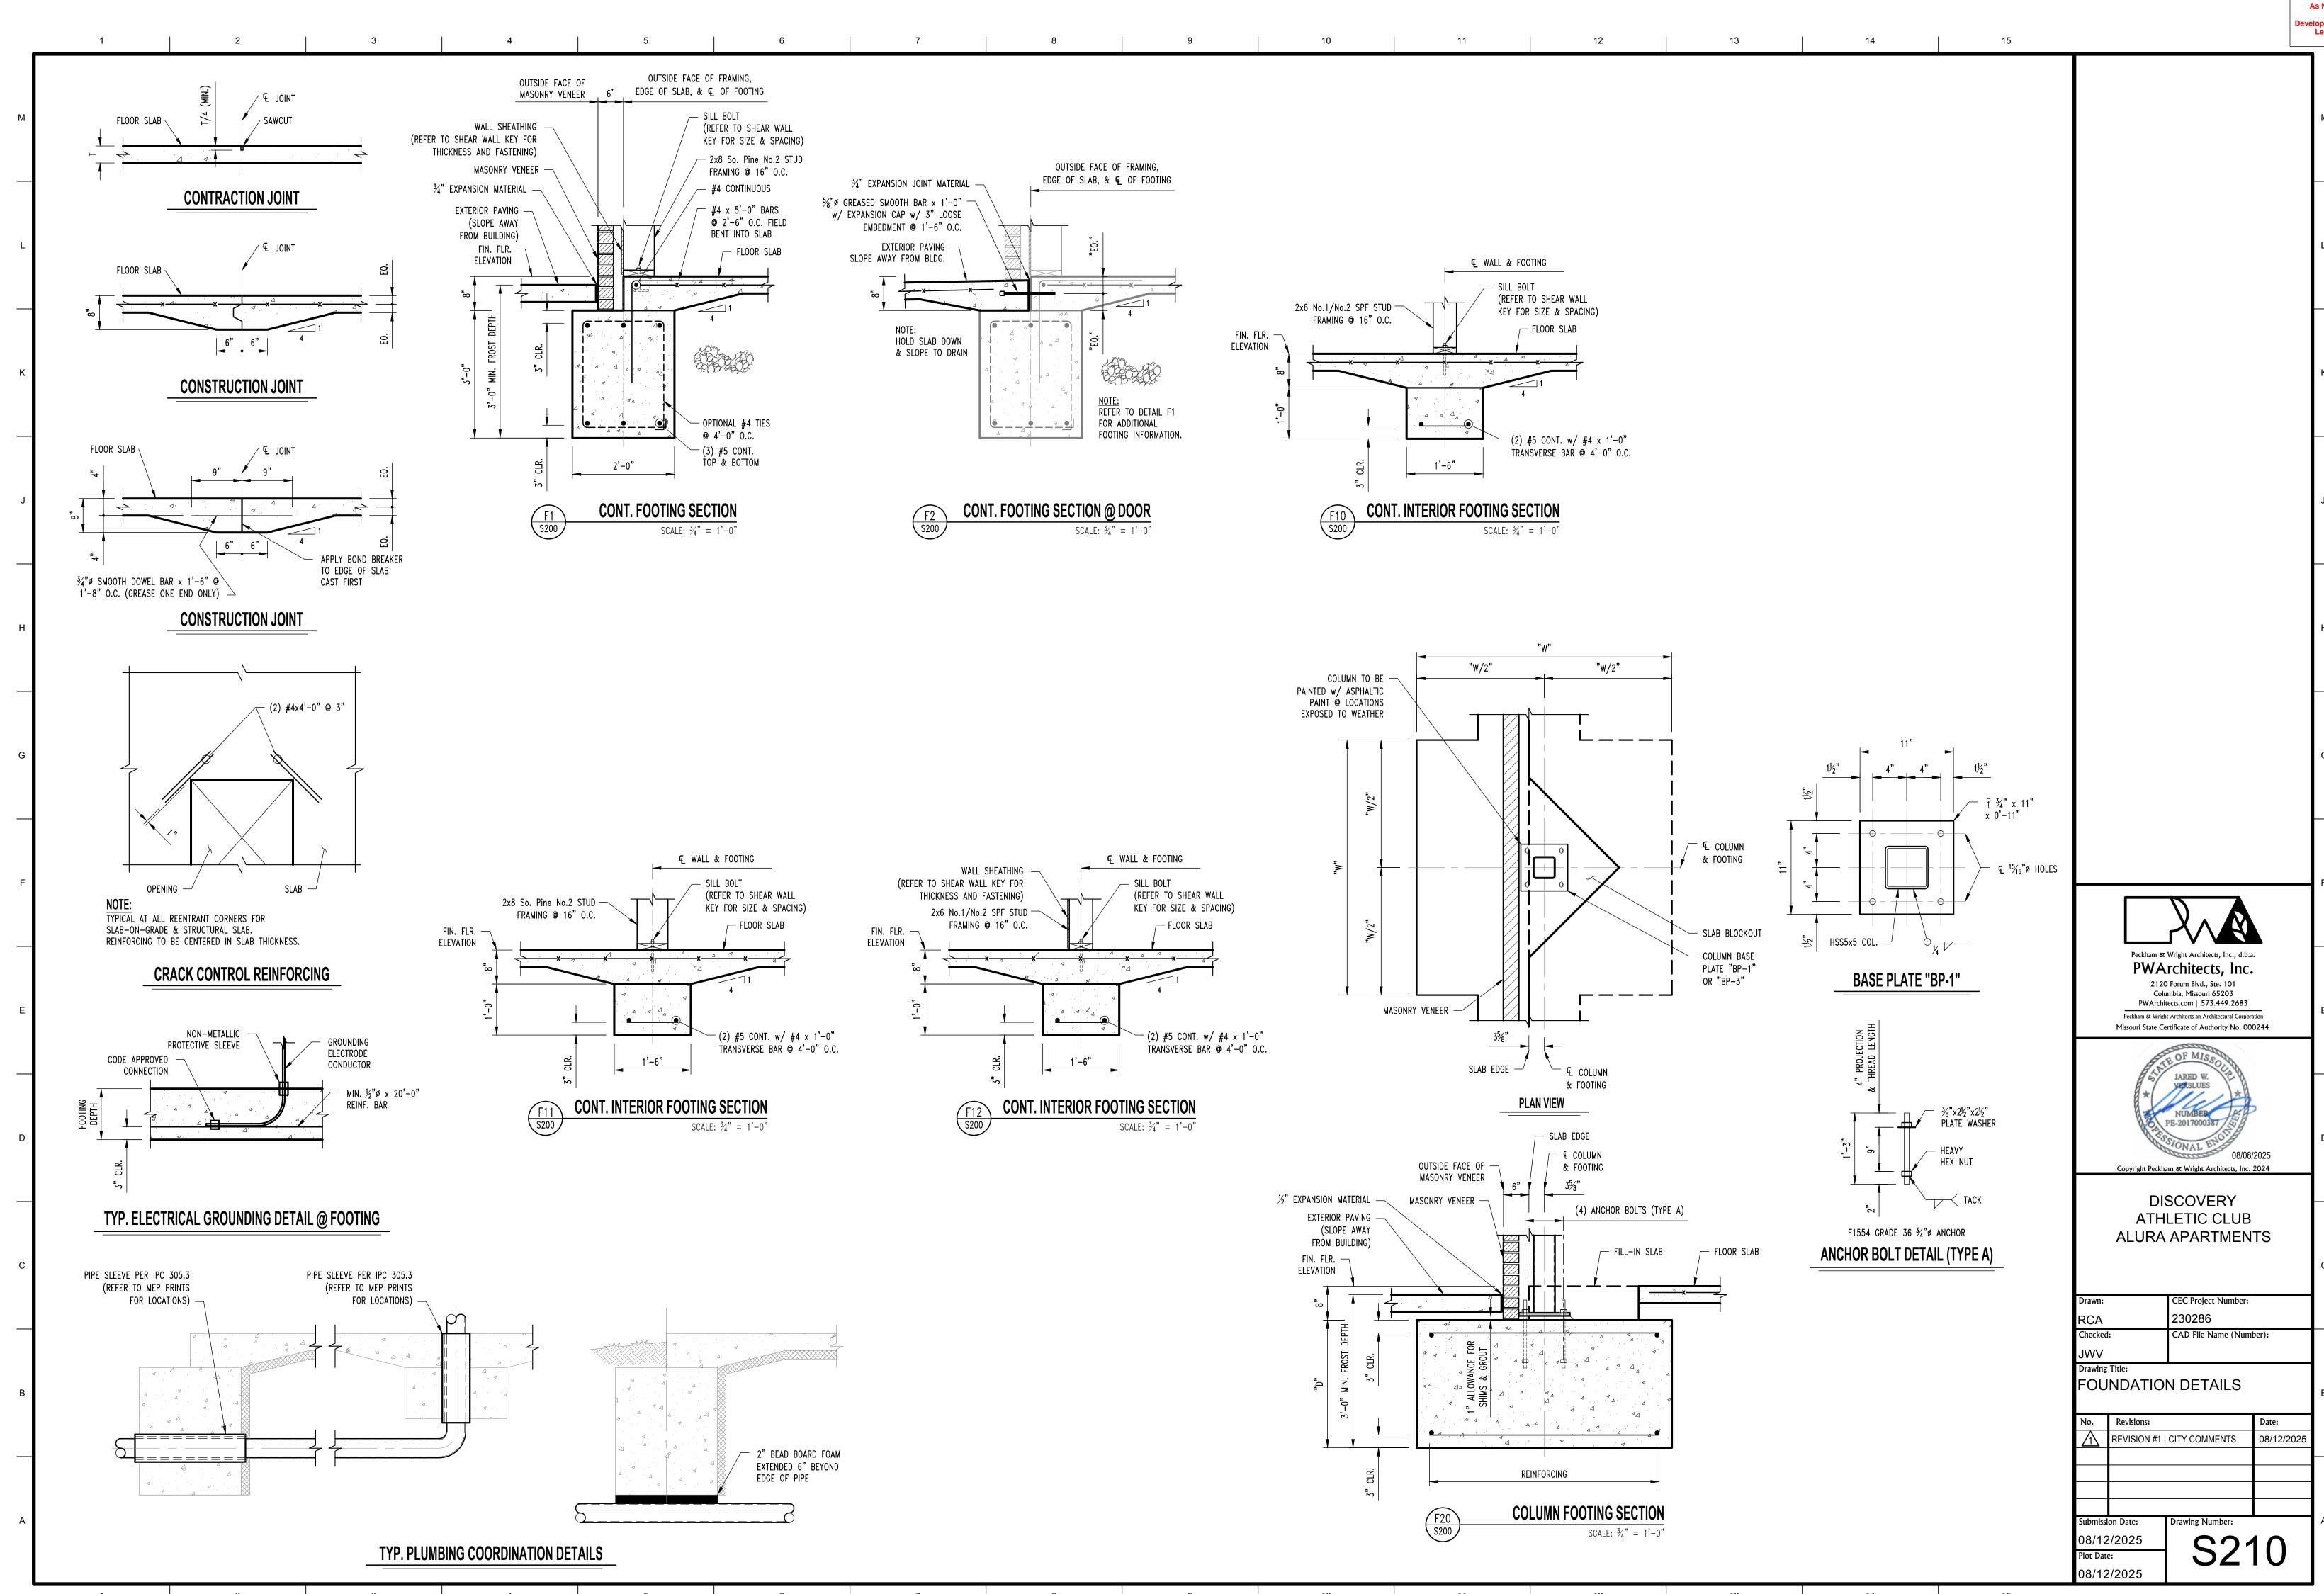

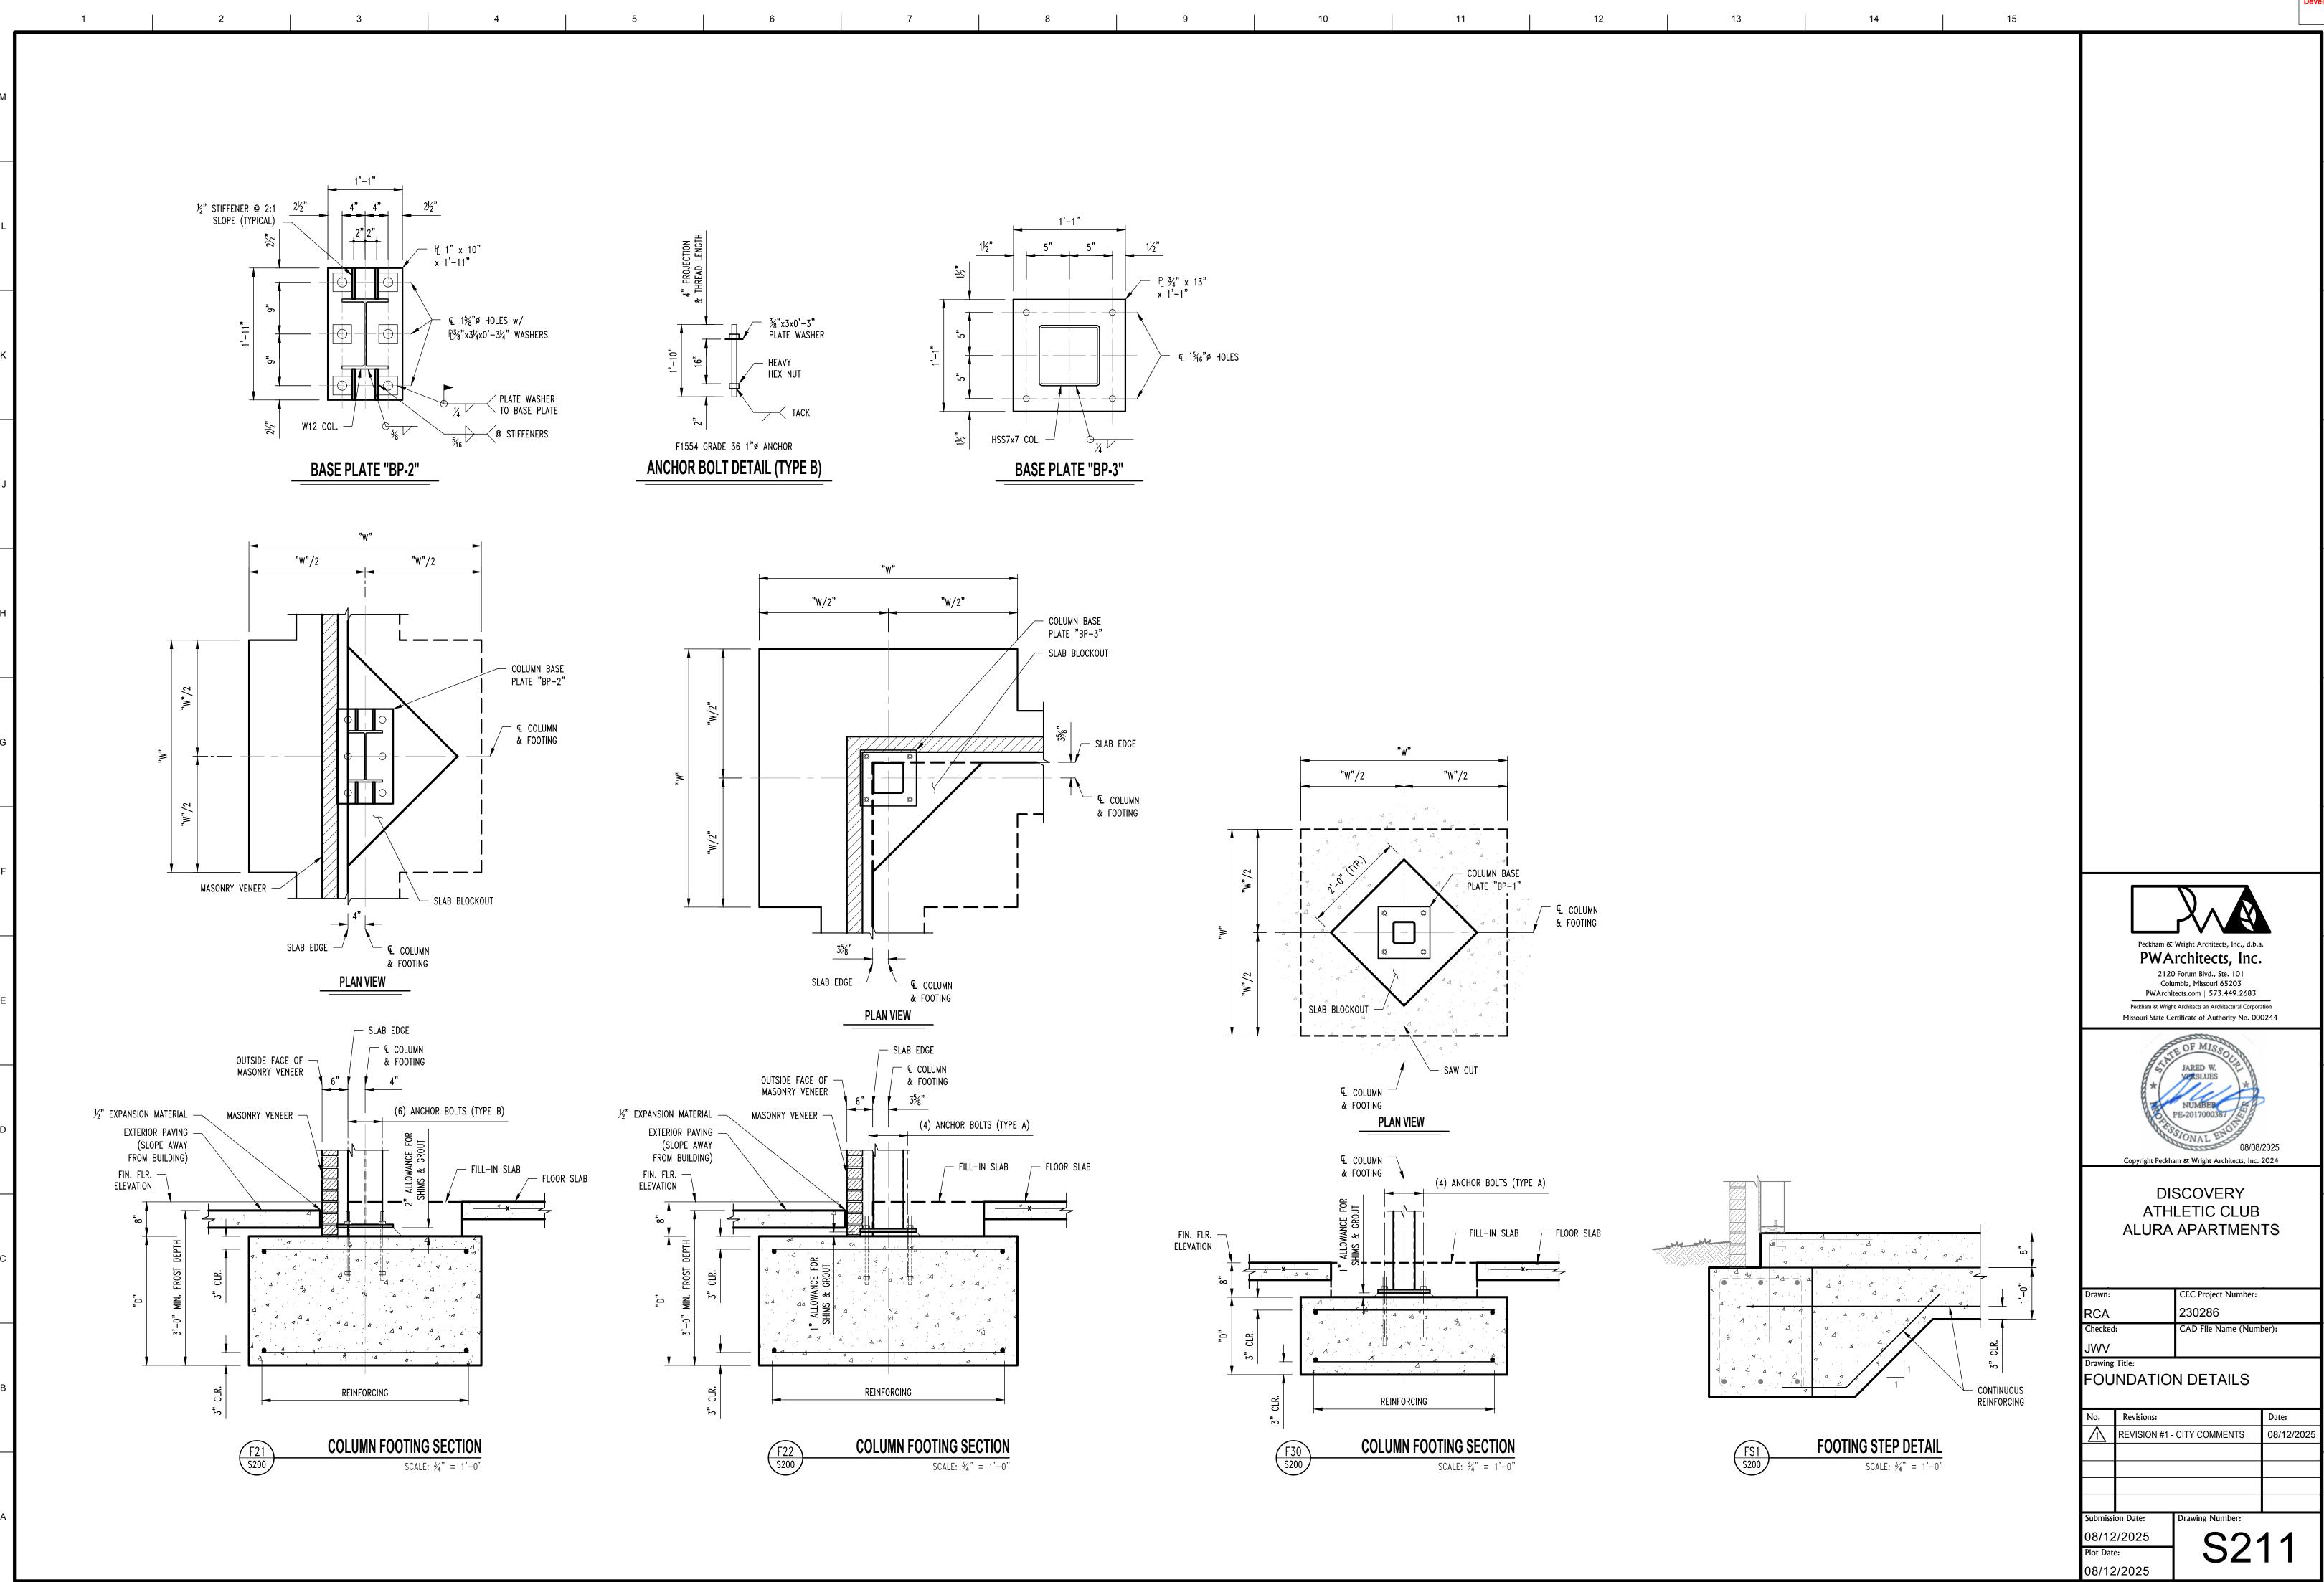


08/12/2025

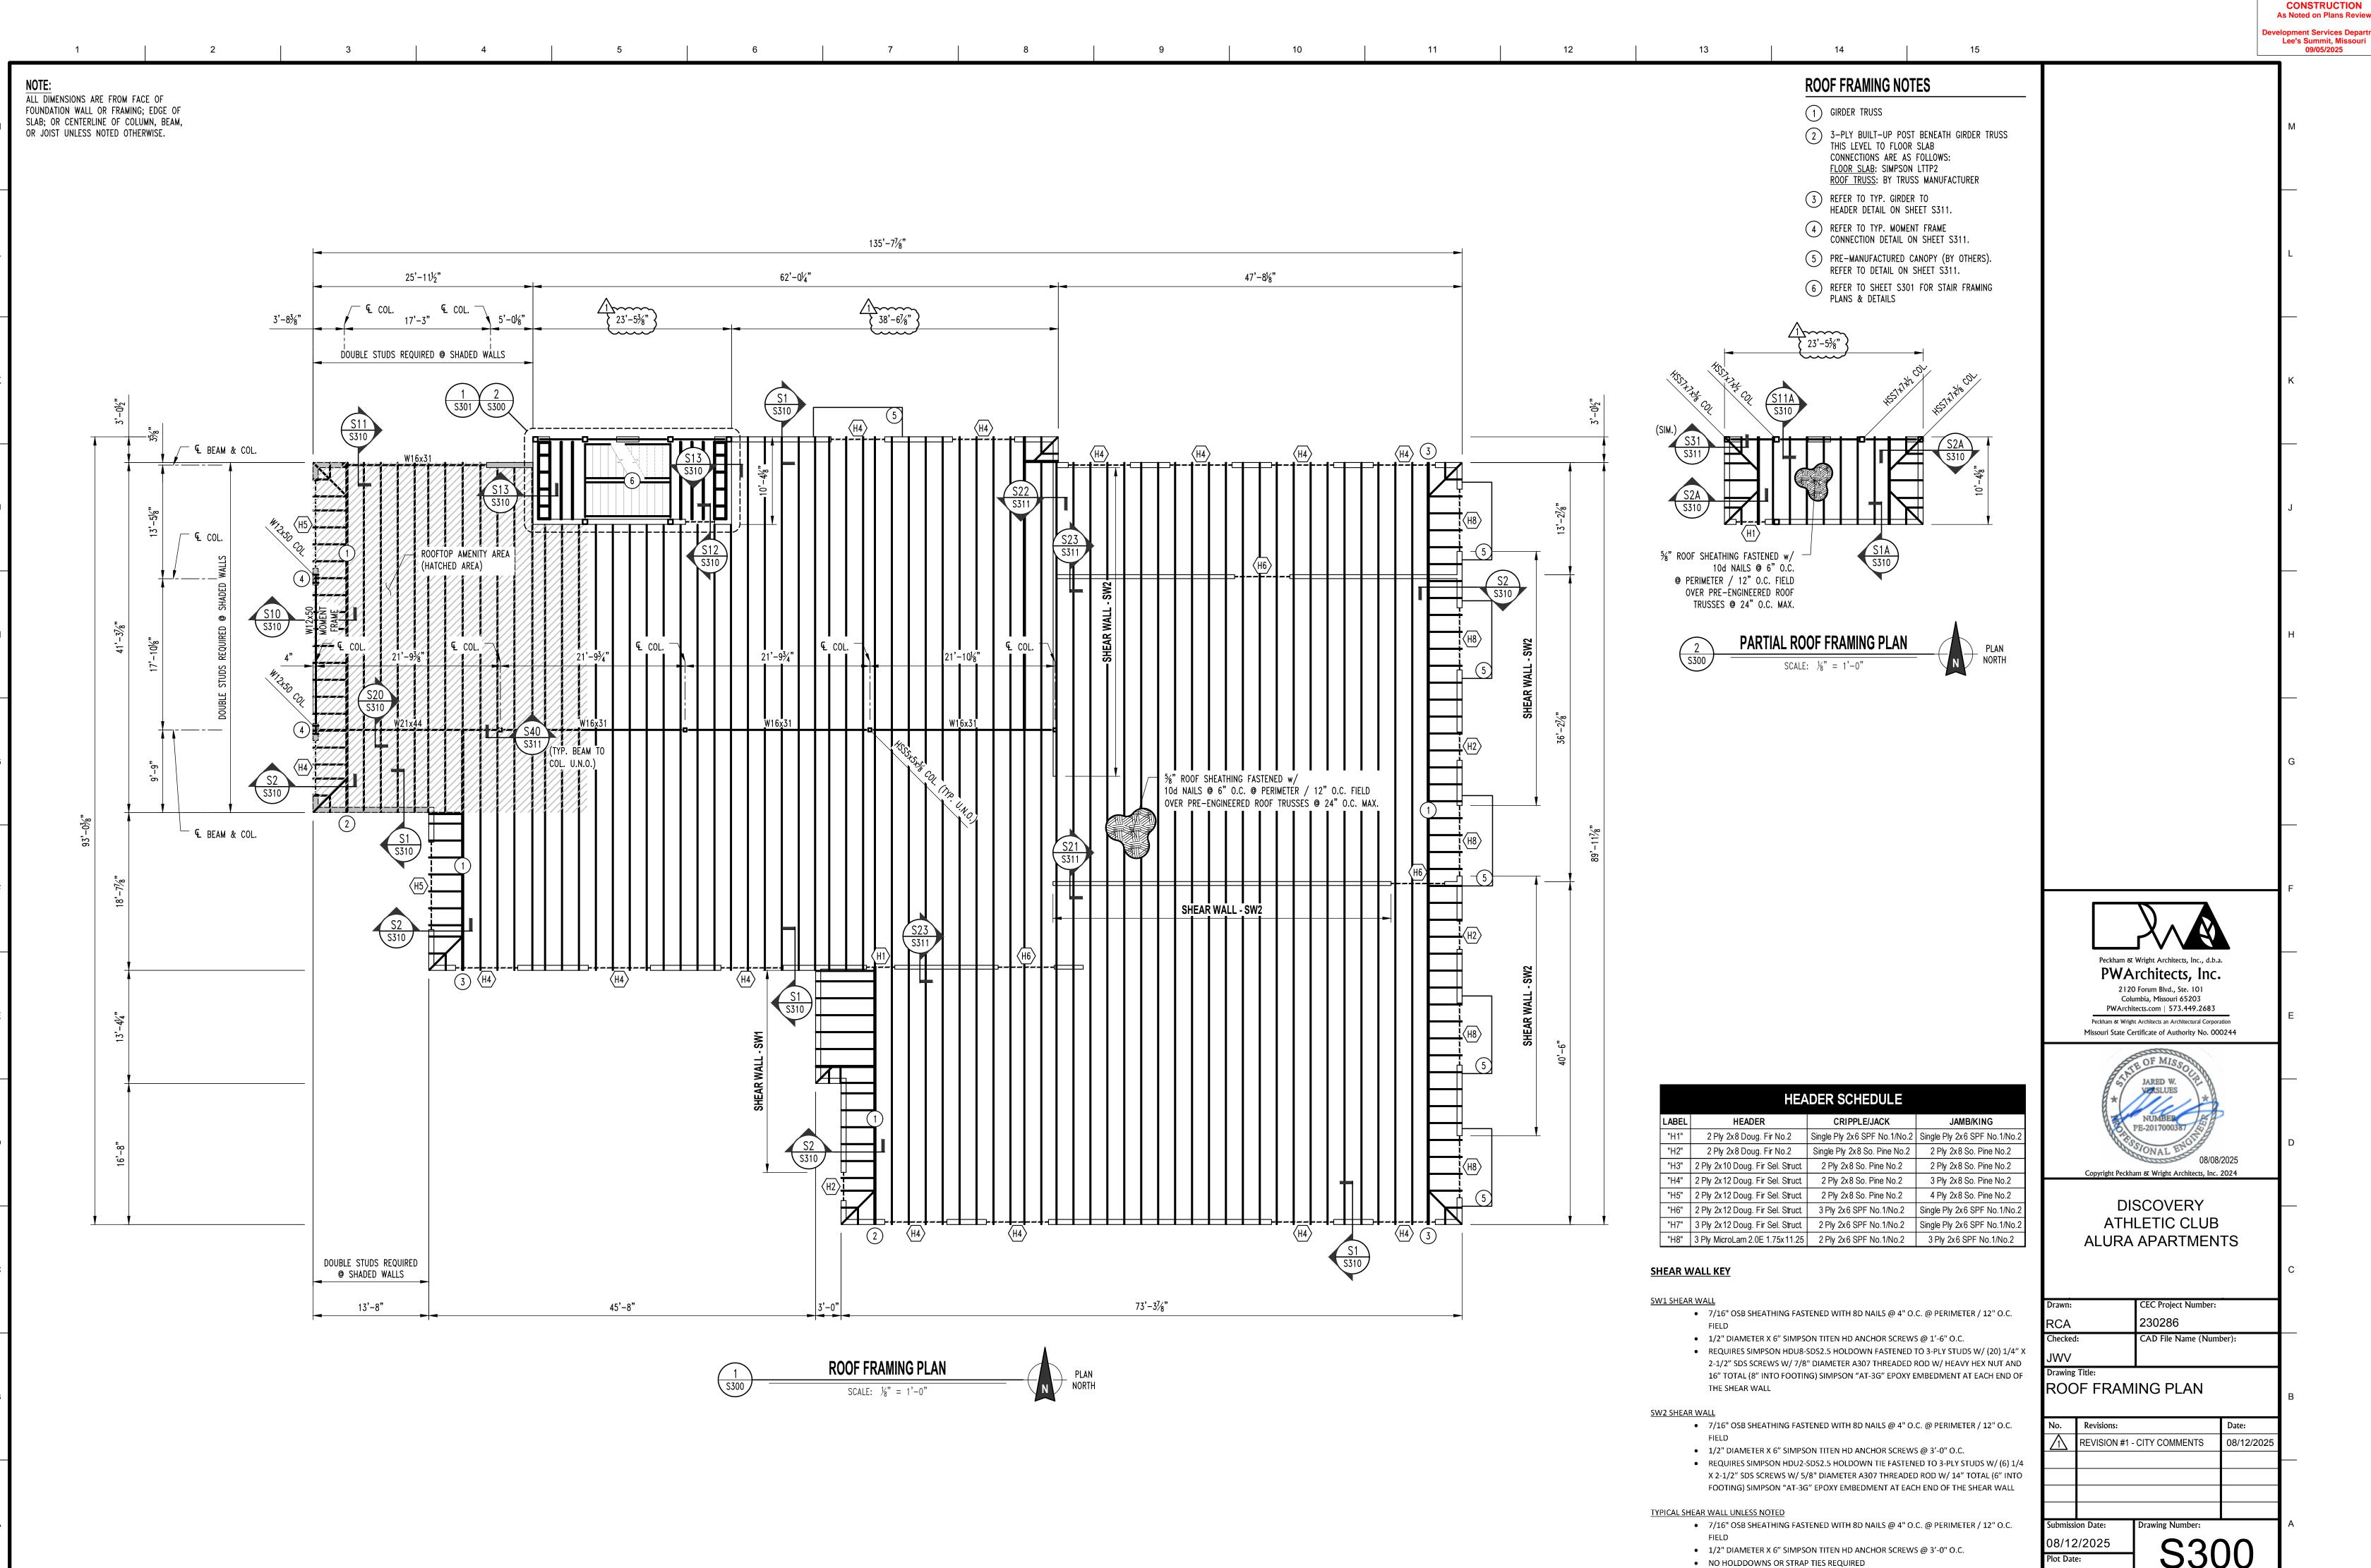

RELEASED FOR CONSTRUCTION As Noted on Plans Review  $23'-5\frac{3}{8}$ 1<del>\</del> 6'-1%" 6'-1%" 10'-1" 10'-1" 5'-101/4" 5'-10½" (TYP. @ TUBE (TYP. @ TUBE C12x20.7 STRINGER C12x20.7 STRINGER ▼ C12x20.7 STRINGER C12x20.7 STRINGER C12x20.7 STRINGER ------11/2" GYPCRETE OVER 3/4" FLOOR SHEATHING FASTENED w/ 1½" GYPCRETE OVER ¾" FLOOR SHEATHING FASTENED w/  $1\frac{1}{2}$ " GYPCRETE OVER  $\frac{3}{4}$ " FLOOR SHEATHING FASTENED w/ 10d NAILS @ 6" O.C. @ PERIMETER / 12" O.C. FIELD 10d NAILS @ 6" O.C. @ PERIMETER / 12" O.C. FIELD 10d NAILS @ 6" O.C. @ PERIMETER / 12" O.C. FIELD OVER DF-L Sel. Str. 2x10's @ 16" O.C. MAX. OVER DF-L Sel. Str. 2x10's @ 16" O.C. MAX. OVER DF-L Sel. Str. 2x10's @ 16" O.C. MAX. FIN. FLR. REFERENCE ELEV. =  $106'-11\frac{3}{4}$ " FIN. FLR. REFERENCE ELEV. =  $113'-9\frac{3}{4}$ " FIN. FLR. REFERENCE ELEV. = 120'-9" STAIR FRAMING PLAN @ LOW ROOF LEVEL STAIR FRAMING PLAN NORTH SCALE:  $\frac{3}{8}$ " = 1'-0" TIMBER TREAD w/ INTEGRAL SUPPORT  $1\frac{1}{2}$ " GYPCRETE OVER  $\frac{3}{4}$ " FLOOR SHEATHING FASTENED w/ ANGLE & RISER 1½" GYPCRETE OVER ¾" FLOOR SHEATHING FASTENED w/ √ 5/16" BENT PLATE 10d NAILS @ 6" O.C. @ PERIMETER / 12" O.C. FIELD 10d NAILS @ 6" O.C. @ PERIMETER / 12" O.C. FIELD OVER DF-L Sel. Str. 2x10's @ 16" O.C. MAX. OVER DF-L Sel. Str. 2x10's @ 16" O.C. MAX. STRINGER TO CHANNEL 1½" GYPCRETE OVER ¾" FLOOR SHEATHING FASTENED w/ - C12x20.7 STRINGER 10d NAILS @ 6" O.C. @ PERIMETER / 12" O.C. FIELD TIMBER TREAD w/ OVER DF-L Sel. Str. 2x10's @ 16" O.C. MAX. TIMBER TREAD w/ HSS COLUMN — INTEGRAL SUPPORT INTEGRAL SUPPORT ANGLE & RISER ANGLE & RISER ½"ø EXPANSION ANCHORS w/ 3" EMBEDMENT C12x20.7 STRINGER Peckham & Wright Architects, Inc., d.b.a. <sup>5</sup>∕<sub>16</sub>" BENT PLATE PWArchitects, Inc. 2120 Forum Blvd., Ste. 101 FLOOR SLAB Columbia, Missouri 65203 PWArchitects.com | 573.449.2683 - C12x20.7 CHANNEL Peckham & Wright Architects an Architectural Corporation  $\frac{9}{16}$  \( \text{4x0'-9" w/ (3)} C12x20.7 CHANNEL A325 BOLTS @ 0'-3" O.C. Missouri State Certificate of Authority No. 000244 C12x20.7 CHANNEL C12x20.7 STRINGER TYP. STAIR FRAMING SECTION STAIR FRAMING SECTION STAIR FRAMING SECTION STAIR FRAMING SECTION SCALE:  $1\frac{1}{2}$ " = 1'-0" Copyright Peckham & Wright Architects, Inc. 2024 DISCOVERY 1½" GYPCRETE OVER ¾" FLOOR SHEATHING FASTENED w/ 10d NAILS @ 6" O.C. @ PERIMETER / 12" O.C. FIELD  $-1\frac{1}{2}$ " GYPCRETE OVER  $\frac{3}{4}$ " FLOOR SHEATHING FASTENED w/ ATHLETIC CLUB 10d NAILS @ 6" O.C. @ PERIMETER / 12" O.C. FIELD OVER DF-L Sel. Str. 2x10's @ 16" O.C. MAX. OVER DF-L Sel. Str. 2x10's @ 16" O.C. MAX. ALURA APARTMENTS TIMBER TREAD w/ INTEGRAL SUPPORT ANGLE & RISER CEC Project Number: C12x20.7 STRINGER 230286 CAD File Name (Number): 2x8 So. Pine No.2 STUD — 2x8 So. Pine No.2 STUD — JWV FRAMING @ 16" O.C. FRAMING @ 16" O.C. Drawing Title: WALL SHEATHING OVER STUD FRAMING — WALL SHEATHING OVER STUD FRAMING STAIR FRAMING (REFER TO SHEARWALL KEY FOR (REFER TO SHEARWALL KEY FOR PLANS & DETAILS THICKNESS AND FASTENING) THICKNESS AND FASTENING) L1x1x1/8 x 0'-8" TREAD SUPPORT ANGLE — 2x10 BLOCKING SIMPSON LUS210 JOIST HANGER ON No. Revisions: @ 2'-0" O.C. CONT. 2x10 LEDGER FASTENED w/ (3) REVISION #1 - CITY COMMENTS 08/12/2025 5" FLATLOK SCREWS @ EACH STUD STAIR FRAMING SECTION STAIR FRAMING SECTION TYPICAL TREAD CONNECTION DETAIL SCALE:  $1\frac{1}{2}$ " = 1'-0" SCALE:  $1\frac{1}{2}$ " = 1'-0" 08/12/2025 S301 08/12/2025

RELEASED FOR
CONSTRUCTION
As Noted on Plans Review


Development Services Department
Lee's Summit, Missouri
09/05/2025

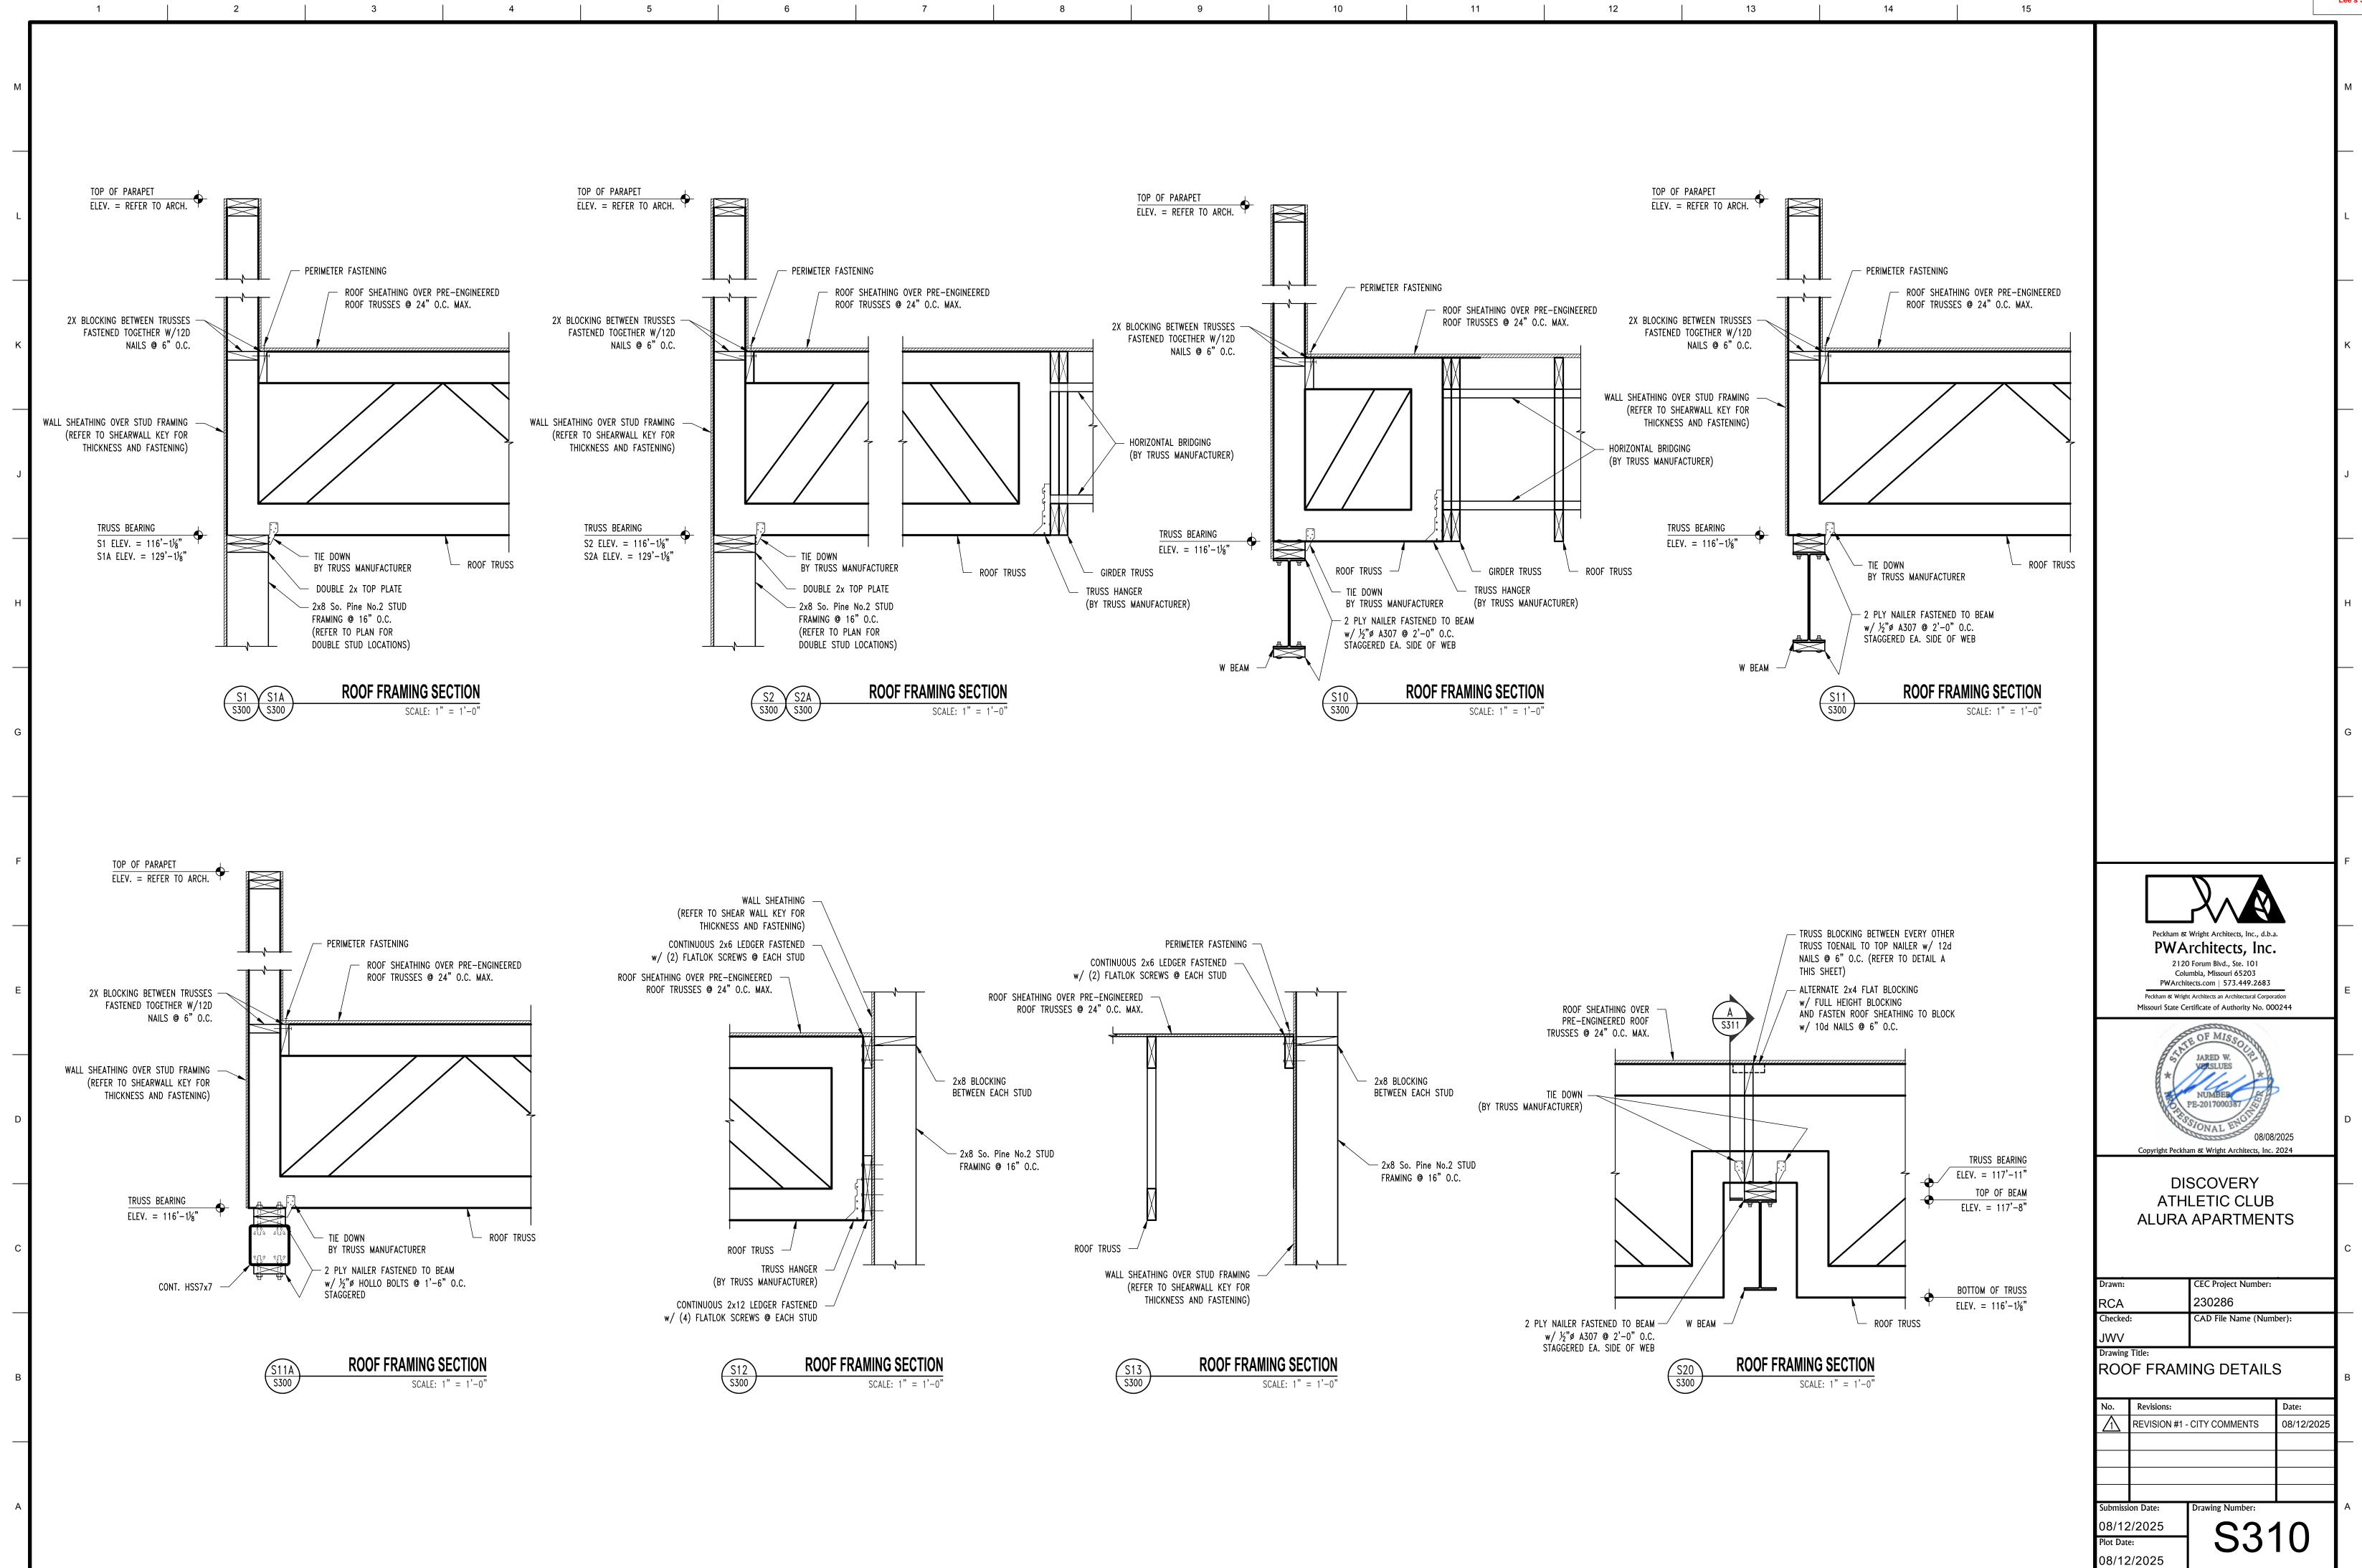

12

RELEASED FOR
CONSTRUCTION
As Noted on Plans Review

Development Services Department
Lee's Summit, Missouri
09/05/2025

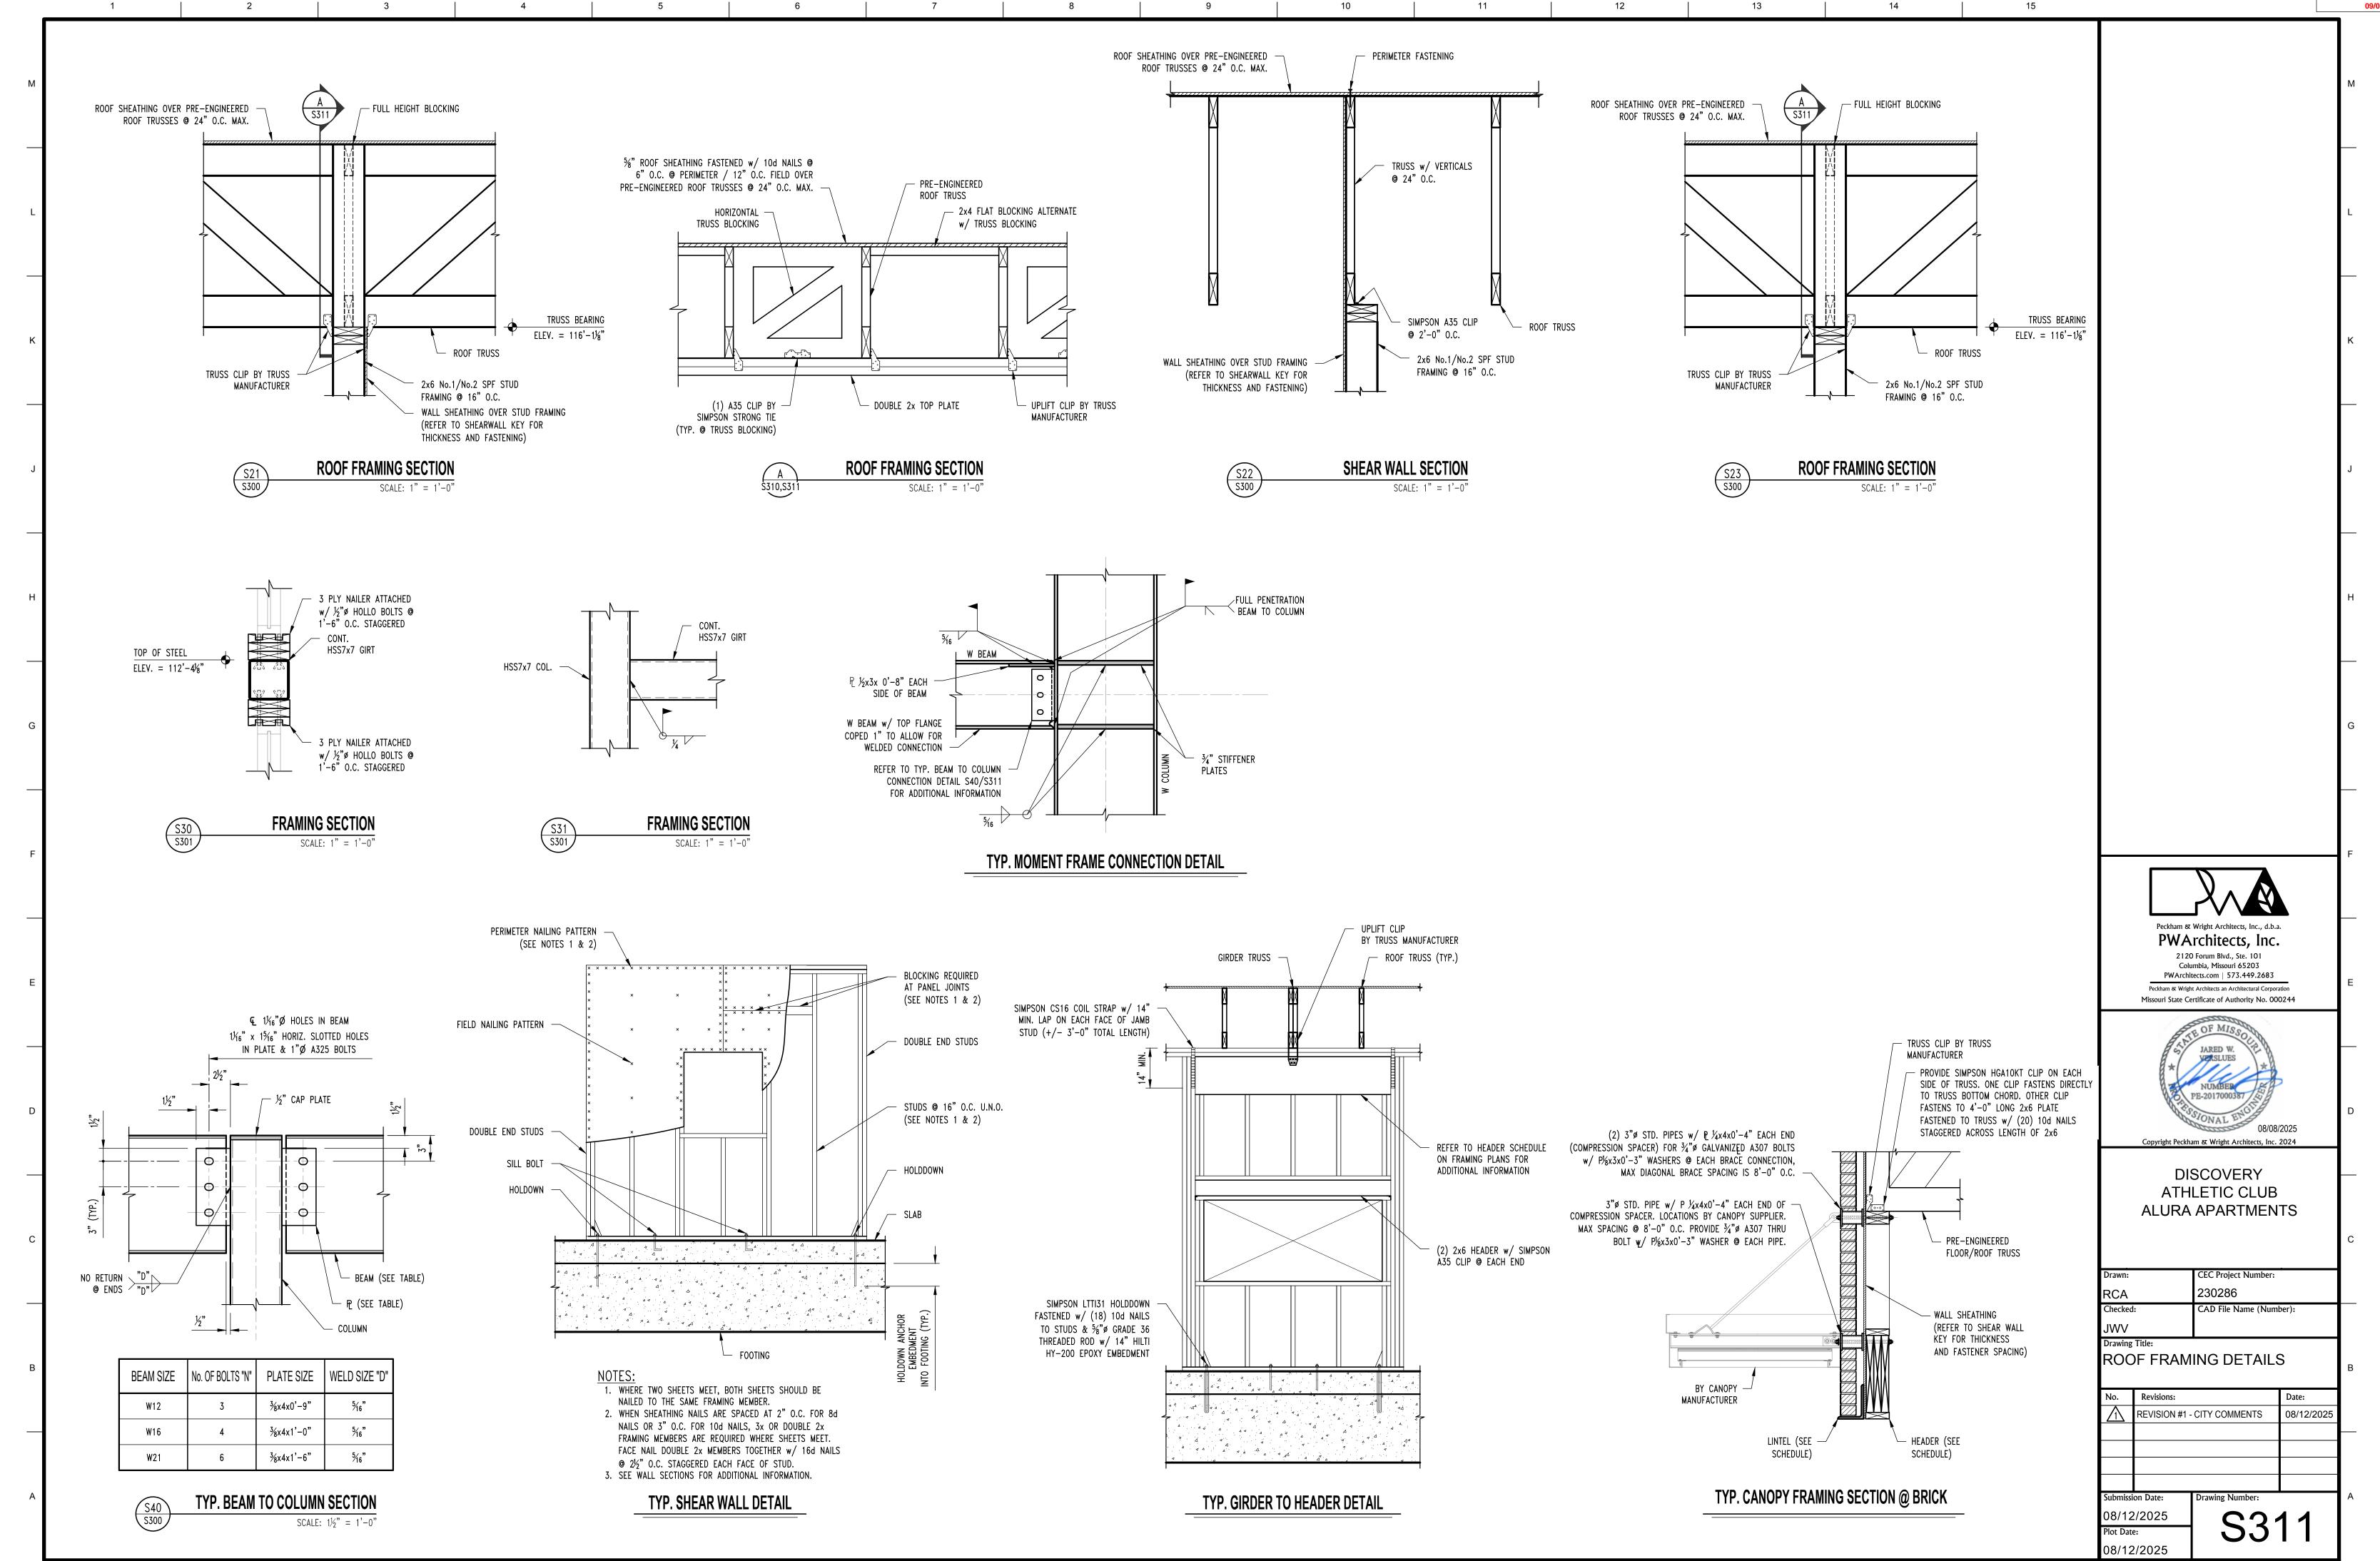

RELEASED FOR CONSTRUCTION As Noted on Plans Review GENERAL FLOOR PLAN NOTES FIELD VERIFY ALL DIMENSIONS AND CONDITIONS PRIOR TO EXECUTING ANY WORK. NOTIFY ARCHITECT OF ANY DIMENSIONS OR WORK DIFFERING FROM THAT SHOWN, FOR CLARIFICATION BY THE ARCHITECT PRIOR TO PROCEEDING WITH WORK. VERIFY ALL ROUGH OPENINGS FOR DOORS, WINDOWS, EQUIPMENT, & OTHER "BUILT-IN" ITEMS PRIOR TO EXECUTION OF ANY WORK AFFECTED BY LOCATE DOOR OPENINGS WHICH ARE NOT DIMENSIONED OTHERWISE, CENTERED IN WALL AND 6" FROM FINISH WALL TO FINISH JAMB. LOCATE DOOR OPENINGS IN MASONRY WALLS BETWEEN 4" TO 6" OFF WALLS SO THAT PROPER COURSING IS ACHIEVED COORDINATE ALL FLOOR DRAINS AND OTHER REFERENCED MECHANICAL, ELECTRICAL, OR PLUMBING ITEMS W/ COORDINATE ALL REQUIRED UTILITIES WITH EQUIPMENT MANUFACTURER. ALL DIMENSIONS ARE TO FACE OF STUD - OR MASONRY - UNLESS OTHERWISE NOTED. DO NOT SCALE DRAWINGS - WHERE DIMENSIONAL DISCREPANCIES ARE ENCOUNTERED NOTIFY ARCHITECT PRIOR TO PROCEEDING WITH THE WORK. COORDINATE HEIGHTS OF OUTLETS & SWITCHING WITH ALL ARCHITECTURAL ITEMS. SEE M/E DRAWINGS FOR LOCATIONS. SEE A300 FOR INTERIOR PARTITION WALL TYPES AND DETAILS. SEE INTERIOR ELEVATIONS FOR ADDITIONAL KEY NOTED ITEMS NOT LABELED IN PLAN. Remarks Peckham & Wright Architects, Inc., d.b.a. PWArchitects, Inc. 2120 Forum Blvd., Ste. 101 Columbia, Missouri 65203 PWArchitects.com | 573.449.2683 Peckham & Wright Architects an Architectural Corporation Missouri State Certificate of Authority No. 000244 Copyright Peckham & Wright Architects, Inc. 2025 **DISCOVERY PARK** ATHLETIC CLUB AND OFFICE ALURA APARTMENTS 250 NE ALURA WAY LEE'S SUMMIT, MO 202428 CAD File Name (Number): FLOOR FINISH PLAN AND SCHEDULE CITY PERMIT REVIEW 08/15/202 A105 06/16/2025 Plot Date: 06/16/2025

Ceiling

Finish

ACT-1

ACT-1 / P-4

ACT-1

ACT-1

West

-

-


-

-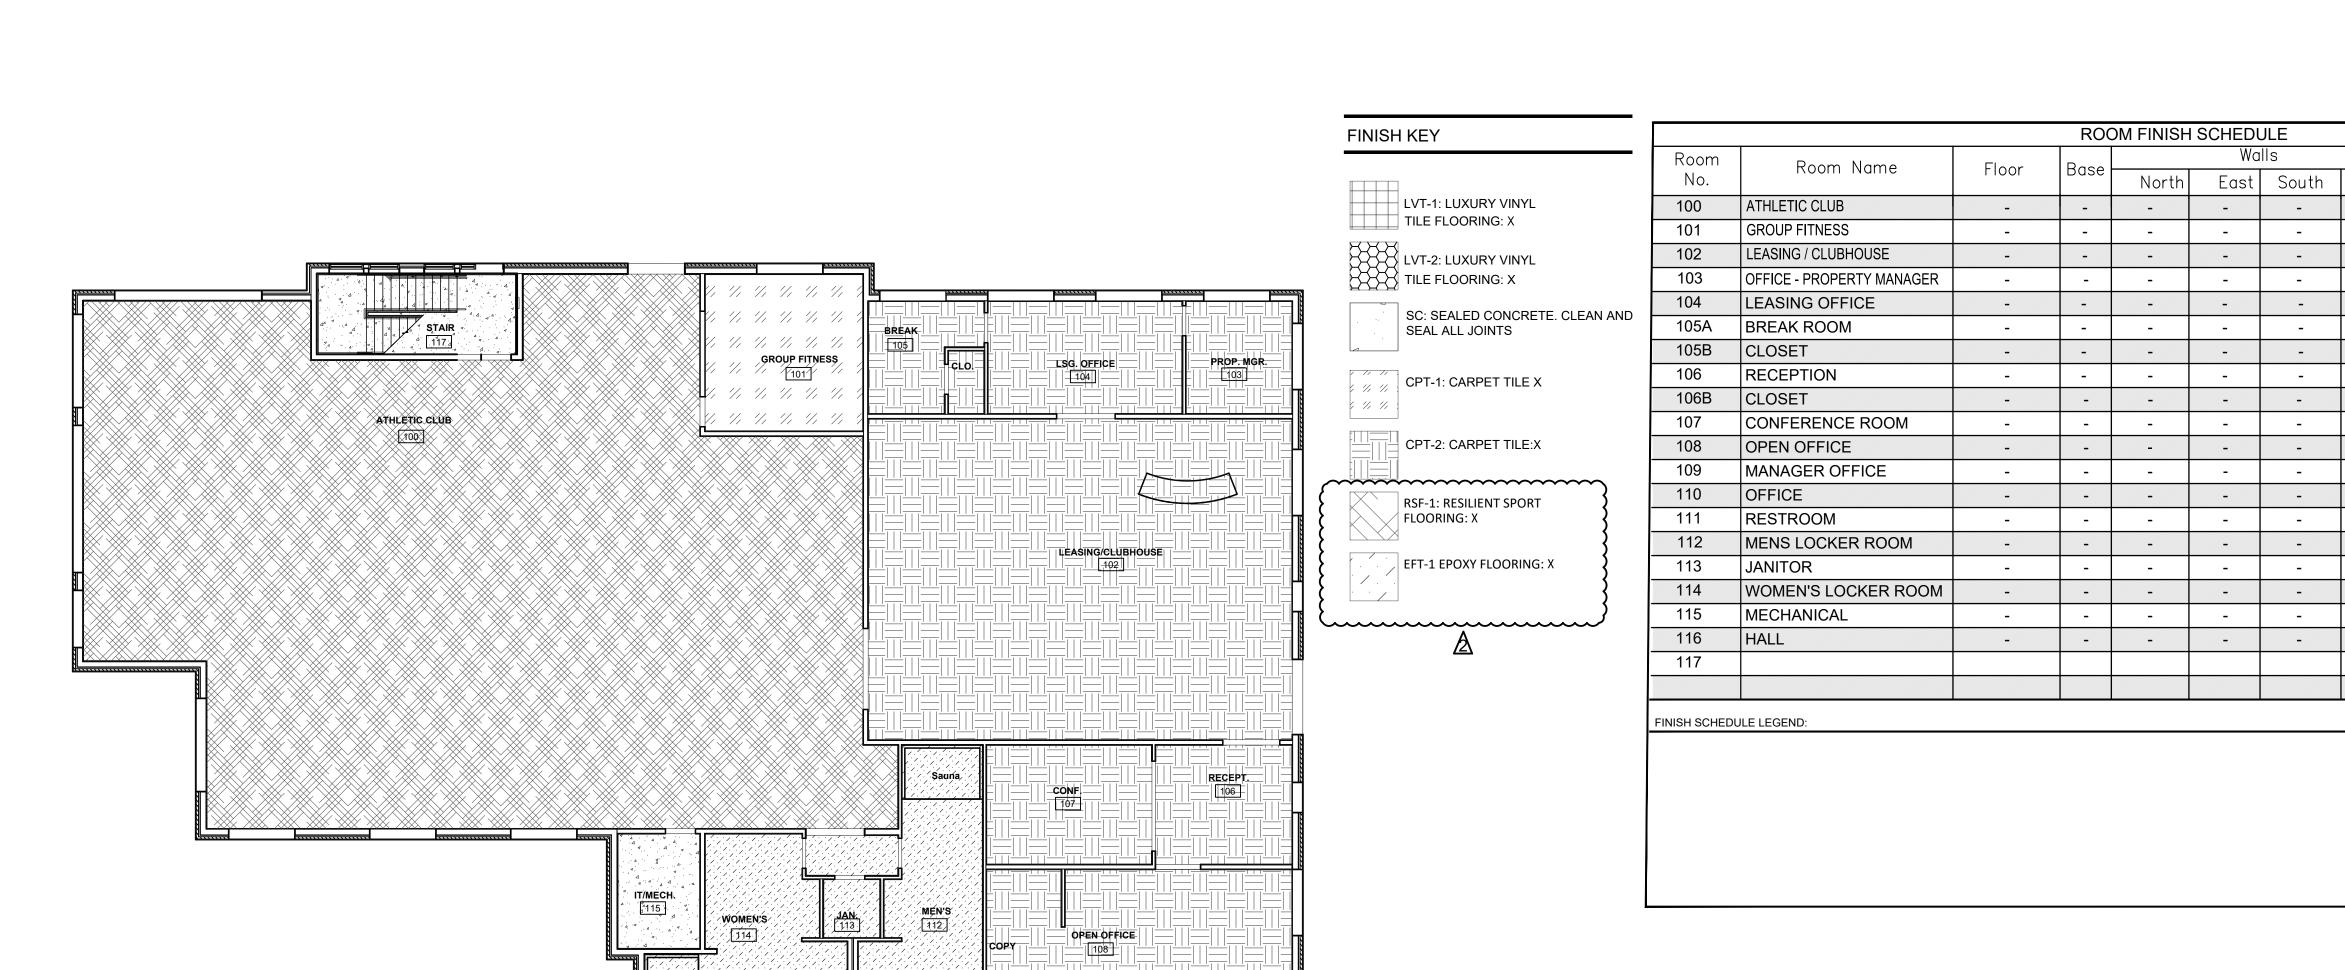

MGR. OFFICE


FIRST FLOOR FINISH PLAN

SCALE: 3/32" = 1'-0"

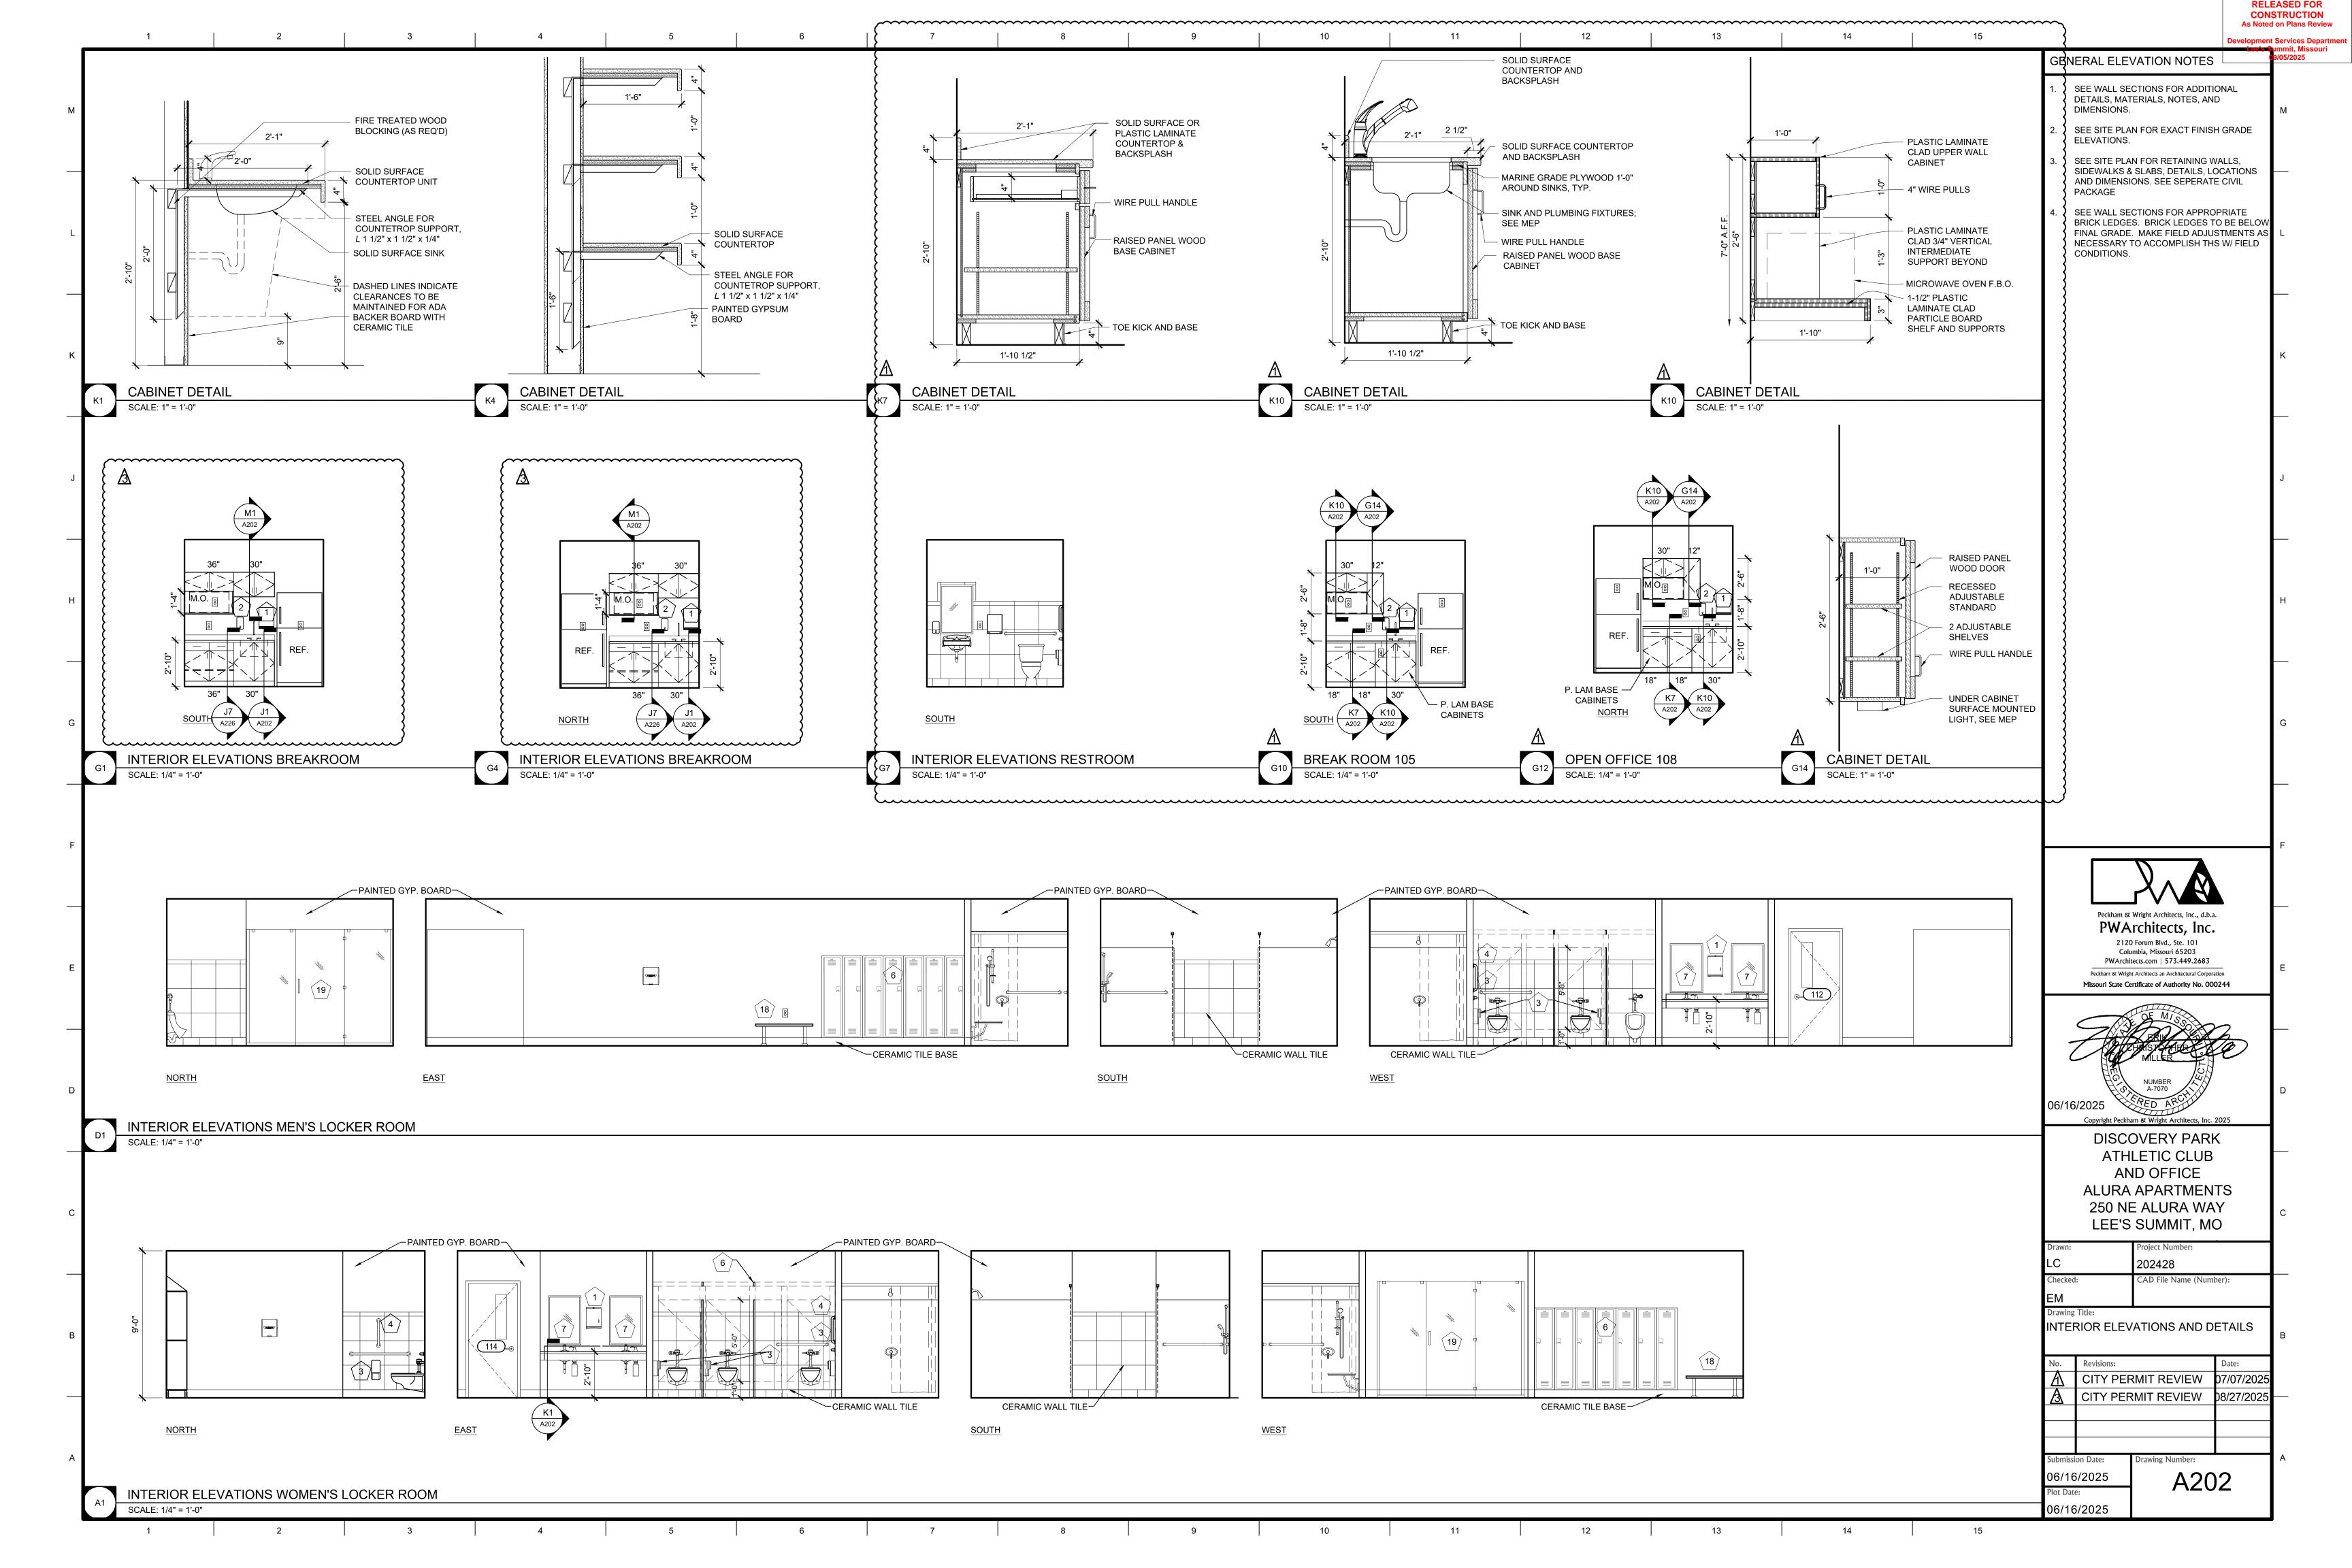

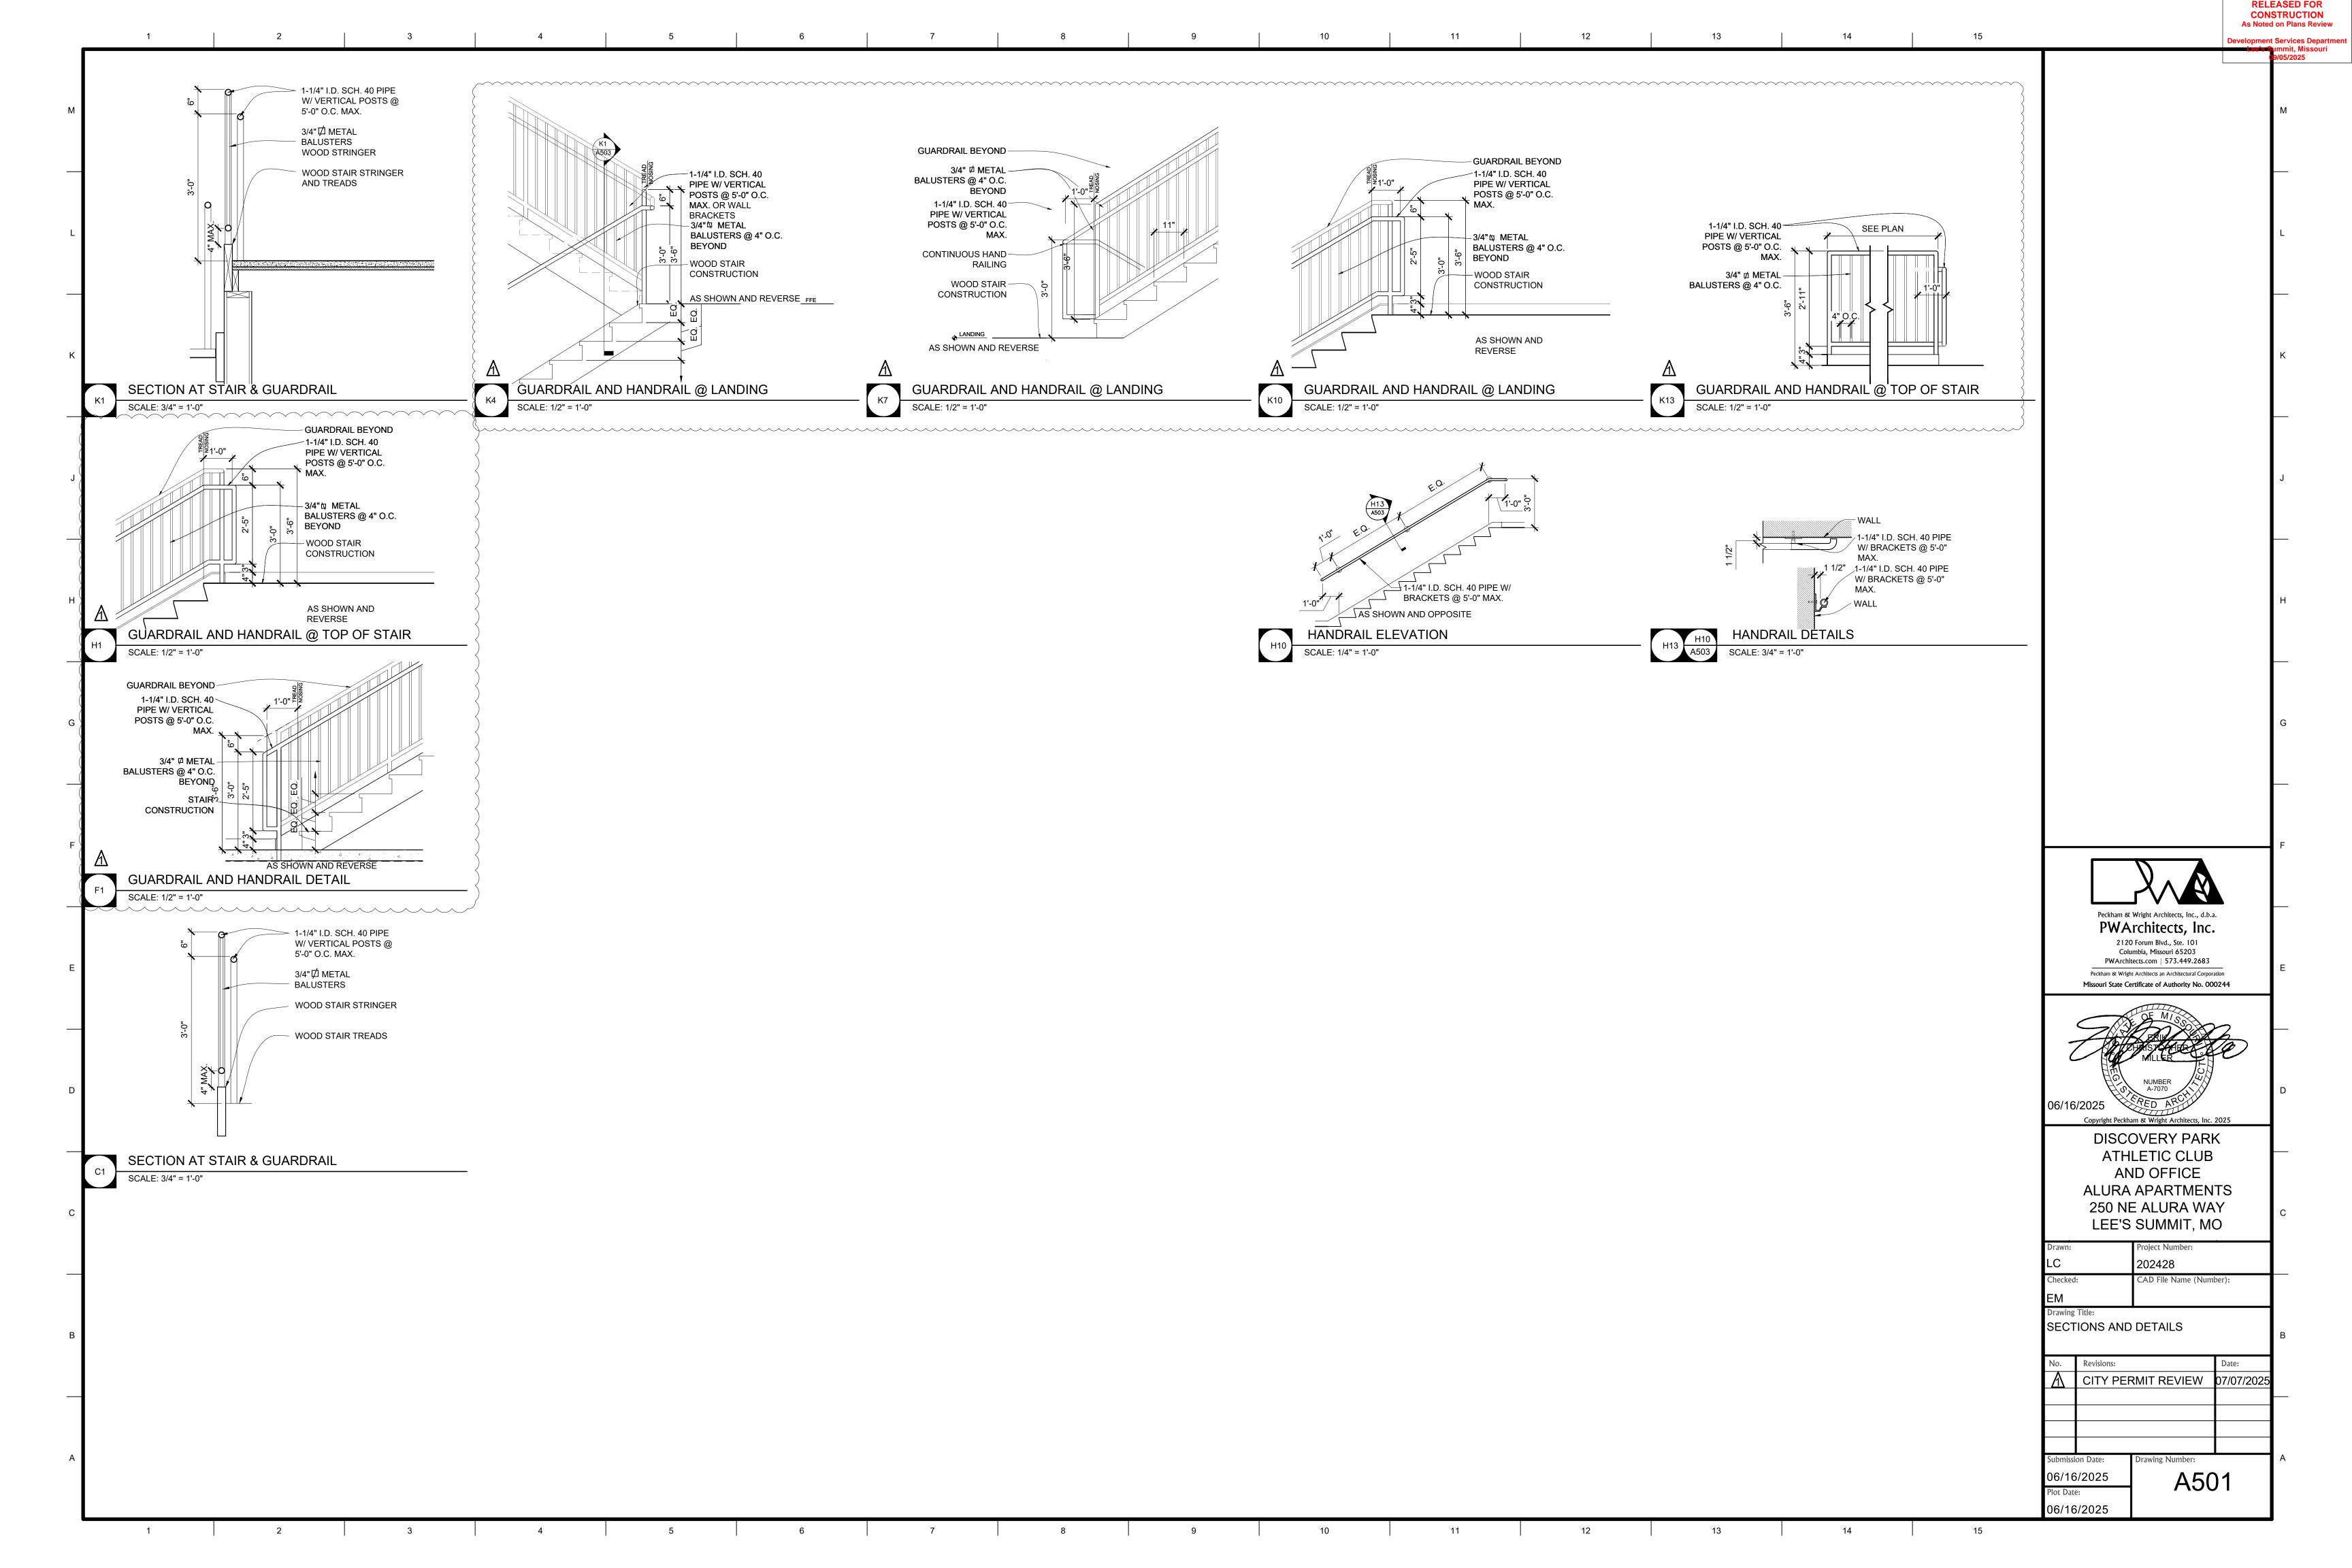

RELEASED FOR

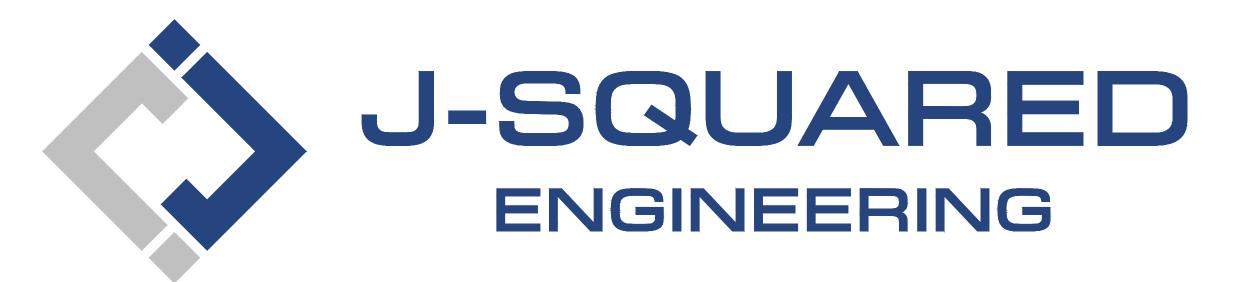

## MECHANICAL - ELECTRICAL - PLUMBING DESIGN DRAWINGS FOR:

# Discovery Park Athletic Club & Office

250 NE Alura Way, Lot 13 Lee's Summit, MO 64064

### GENERAL MEP SPECIFICATIONS

#### 1. GENER

- 1.1. ALL WORK SHALL BE PERFORMED IN COMPLIANCE WITH LOCALLY ADOPTED CODES AND ORDINANCES.

  1.2. IT IS THE RESPONSIBILITY OF CONTRACTOR TO REVIEW AND UNDERSTAND ALL DRAWINGS AND SPECIFICATIONS IN CONTRACT DOCUMENTS. EACH CONTRACTOR IS RESPONSIBLE FOR ALL WORK ASSOCIATED WITH THEIR TRADE, REGARDLESS OF WHERE WORK IS DEPICTED IN PROJECT DRAWINGS OR SPECIFICATIONS.
- 1.3. LAYOUT OF SYSTEMS SHOWN ON PLANS ARE APPROXIMATE AND SCHEMATIC IN NATURE. ALL SYSTEMS WILL NEED TO BE FIELD-COORDINATED. CONTRACTOR SHALL INCLUDE THIS COORDINATION IN THEIR SCOPE AND INCLUDE ALL COSTS OF MODIFYING LAYOUT AS REQUIRED IN THEIR BID. PLANS ARE NOT INTENDED TO BE SHOP DRAWINGS FROM WHICH MATERIALS CAN BE ORDERED, FABRICATED, OR INSTALLED WITHOUT ADDITIONAL FIELD MEASUREMENTS AND COORDINATION.
- 1.4. NOT ALL SPECIFIC PIECES AND COMPONENTS OF EACH SYSTEM ARE DETAILED OR OUTLINED ON PLANS. CONTRACTOR IS RESPONSIBLE FOR PROVIDING ALL NECESSARY PARTS AND LABOR TO PRODUCE A COMPLETE AND FULLY OPERATIONAL SYSTEM UNLESS STATED OTHERWISE ON PLANS. CONTRACTOR IS TO PROVIDE AND INCLUDE ALL EQUIPMENT AND MATERIAL NEEDED TO COMPLETE WORK ASSOCIATED WITH THEIR BID UNLESS ANY ITEMS ARE SPECIFICALLY NOTED ON PLANS AS PROVIDED BY OTHERS. ALL MATERIALS TO BE NEW, FIRST CLASS, AND INSTALLED PER MANUFACTURER'S PUBLISHED INSTRUCTIONS.
- 1.5. WHERE CONFLICTS EXIST BETWEEN MEP PLANS AND CIVIL, ARCHITECTURAL, OR STRUCTURAL PLANS, NOTIFY MEP ENGINEER OF DISCREPANCIES FOR CLARIFICATION PRIOR TO PERFORMING ANY WORK THAT MAY CONTRADICT INFORMATION ELSEWHERE IN THE PROJECT PLANS.
- 1.6. THESE PLANS ARE NOT TO BE SCALED. SEE ARCHITECTURAL PLANS FOR DIMENSIONS. WHERE THERE IS A CONFLICT BETWEEN ARCHITECTURAL DIMENSIONS AND MEP DIMENSIONS, ARCHITECTURAL SHALL GOVERN.
- 1.7. CONTRACTOR IS TO INCLUDE IN THEIR SCOPE THE COST OF ALL PERMITS, INSPECTIONS, METERING, TAPS, ETC. ASSOCIATED WITH THEIR WORK.
- 1.8. CONTRACTOR IS RESPONSIBLE FOR ALL EXCAVATION, CUTTING, CORING, PATCHING, AND BACKFILL
- REQUIRED TO COMPLETE THEIR WORK, UNLESS NOTED OTHERWISE ON PLANS.

  1.9. SPECIFIC EQUIPMENT MANUFACTURERS AND/OR MODEL NUMBERS LISTED ON PLANS ARE TO ESTABLISH A BASIS-OF-DESIGN FOR QUALITY AND PERFORMANCE, VERIFY THAT SUBSTITUTIONS WILL BE ACCEPTABLE PRIOR TO PURCHASE & INSTALLATION.
- 1.10. NOTIFY ENGINEER OF ANY MAJOR PLAN DISCREPANCIES OR CONFLICTS PRIOR TO PROVIDING BIDS OR
- COMPLETING ANY WORK.

  1.11. SEE DISCIPLINE SHEETS FOR ADDITIONAL TRADE SPECIFIC SPECIFICATIONS.
- ..12. WHERE SHUTDOWN OF ANY EXISTING UTILITY OR SERVICE TO BUILDING IS REQUIRED FOR COMPLETION OF WORK, COORDINATE OUTAGE WITH OWNER AS TO NOT DISRUPT TYPICAL OPERATIONS

#### 2. WORKMANSH

- 2.1. SYSTEMS SHALL BE INSTALLED IN A FIRST-CLASS MANNER USING BEST ACCEPTABLE METHODS AND
- 2.2. ALL SYSTEMS SHALL BE INSTALLED PARALLEL OR PERPENDICULAR TO BUILDING ORIENTATION.
  COMPONENTS SHALL BE INSTALLED LEVEL AND PLUMB WITH ATTENTION GIVEN TO OVERALL
- 2.3. CONTRACTOR IS RESPONSIBLE FOR COORDINATING EQUIPMENT LOCATIONS AND SYSTEM ROUTING WITH OTHER TRADES PRIOR TO INSTALLATION.
- 2.4. CONTRACTOR TO GUARANTEE ALL MATERIALS AND WORKMANSHIP FOR A PERIOD OF ONE YEAR FROM THE DATE THE COMPLETED PROJECT IS RELEASED TO THE OWNER, UNLESS NOTED OTHERWISE ON PLANS.
- 2.5. DURING INSTALLATION OF MATERIALS OR ACTIVITIES IN NEW WORK SCOPE, AVOID DAMAGING EXISTING SURFACES AND EQUIPMENT TO REMAIN. ANY DAMAGE TO EXISTING SURFACES OR EQUIPMENT SHALL BE CORRECTED AT NO COST TO OWNER.

#### **DEFERRED SUBMITTAL NOTES**

#### 1. FIRE ALARM SYST

- 1.1. FIRE ALARM CONTRACTOR SHALL PROVIDE DEFERRED SUBMITTAL PACKAGE FOR FIRE ALARM SYSTEM SUBMITTAL SHALL INCLUDE BATTERY CALCULATIONS, VOLTAGE DROP CALCULATIONS, EQUIPMENT SPECIFICATIONS FOR DEVICES AND PANELS, ETC. DESIGN SHALL BE SEALED BY A QUALIFIED DESIGN PROFESSIONAL LICENSED BY THE STATE.
- 1.2. FIRE ALARM SYSTEM COMPONENTS SHOWN (IF APPLICABLE) ARE GENERAL AND SCHEMATIC IN NATURE SHOWN FOR APPROXIMATE ROUGH-IN LOCATIONS AND QUANTITIES ONLY. CONTRACTOR TO VERIFY EXACT DEVICE LOCATIONS AND REQUIREMENTS WITH FIRE ALARM SYSTEM DESIGNER OF RECORD PRIOR TO ROUGH-IN.

#### 2. FIRE SPRINKLER SYSTEM

- 1.1. FIRE SPRINKLER CONTRACTOR TO PROVIDE DEFERRED SUBMITTAL PACKAGE FOR FIRE SPRINKLER SYSTEM. SUBMITTAL SHALL INCLUDE HYDRAULIC CALCULATIONS AND SPRINKLER SYSTEM DRAWINGS SEALED BY A QUALIFIED DESIGN PROFESSIONAL LICENSED BY THE STATE.
- 1.2. WHERE COMBINED FIRE & DOMESTIC WATER SUPPLY LINES ARE SHOWN ON PLANS, INSTALLING CONTRACTOR SHALL VERIFY WITH FIRE SPRINKLER CONTRACTOR THAT INCOMING LINE SIZE IS ADEQUATE FOR FIRE SUPPRESSION SYSTEM.

### REFERENCED CODES IN EFFECT

PROJECT HAS BEEN DESIGNED IN COMPLIANCE WITH THE FOLLOWING CODES LISTED BELOW, BUT THIS IS NOT AN EXHAUSTIVE LIST. PROJECT SHALL COMPLY WITH ALL APPLICABLE CODES, STANDARDS, AND LOCAL REQUIREMENTS

- 2018 INTERNATIONAL MECHANICAL CO
- 2018 INTERNATIONAL PLUMBING CODE
   3018 INTERNATIONAL FUEL CAS CODE
- 2018 INTERNATIONAL FUEL GAS CODE
   2018 INTERNATIONAL FIRE CODE
- 2018 INTERNATIONAL FIRE CODE
   2017 NATIONAL ELECTRIC CODE

**SHEET LIST TABLE SHEET TITLE** MECHANICAL ELECTRICAL PLUMBING COVER SHEET SITE UTILITIES PLAN SITE LIGHTING PLAN **ROOF MEP PLAN** M101 **HVAC PLAN HVAC DETAILS HVAC SCHEDULES POWER PLAN - FIRST FLOOR EL101** LIGHTING PLAN **ELECTRICAL DETAILS & SCHEDULES ELECTRICAL SCHEDULES** FIRE PROTECTION PLAN SANITARY SEWER PLAN PW101 **WATER & GAS PLAN** 

PLUMBING DETAILS & SCHEDULES

As Noted on Plans Review

Description Services Departme
OFLet Services Departm

CONSTRUCTION

James Watson, P.E. June 13, 2029 PE-2015017071 MO Certificate of Authority # 2018029680



# J-SQUARED

2400 Bluff Creek Drive, Suite 10 Columbia, Missouri 65201 573.234.4492 www.j-squaredeng.com

J2 DESIGN: ACW

ISSUE TITLE DATE

PERMIT SET

06 - 13 - 2025

# ub & Office

Athletic Club

Ø

**COV** 


AHJ APPROVAL STAMP

SHEET TIT

MECHANICAL ELECTRICAL PLUMBING COVER SHEET


HEET NUMBER

MEP1

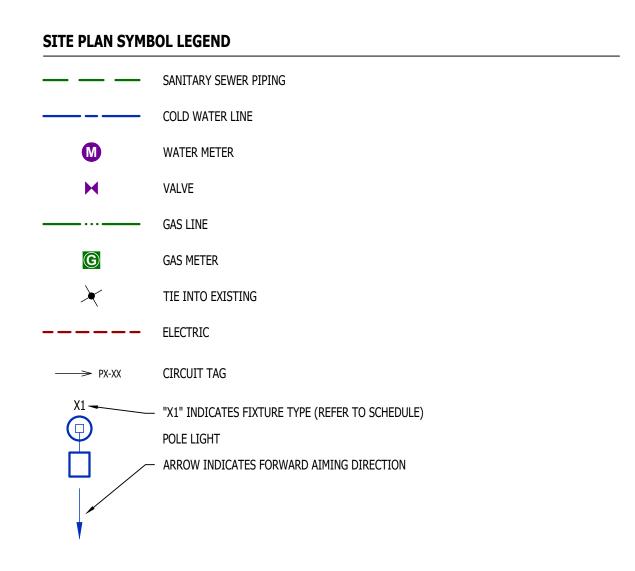

#### SITE UTILITIES PLAN GENERAL NOTES:

- 1. REFER TO CIVIL PLANS FOR EXACT UTILITY LOCATIONS, CONNECTIONS, DETAILS, ETC.
- 2. VERIFY SPRINKLER LINE SIZING & DETAILS WITH FIRE SUPPRESSION CONTRACTOR.

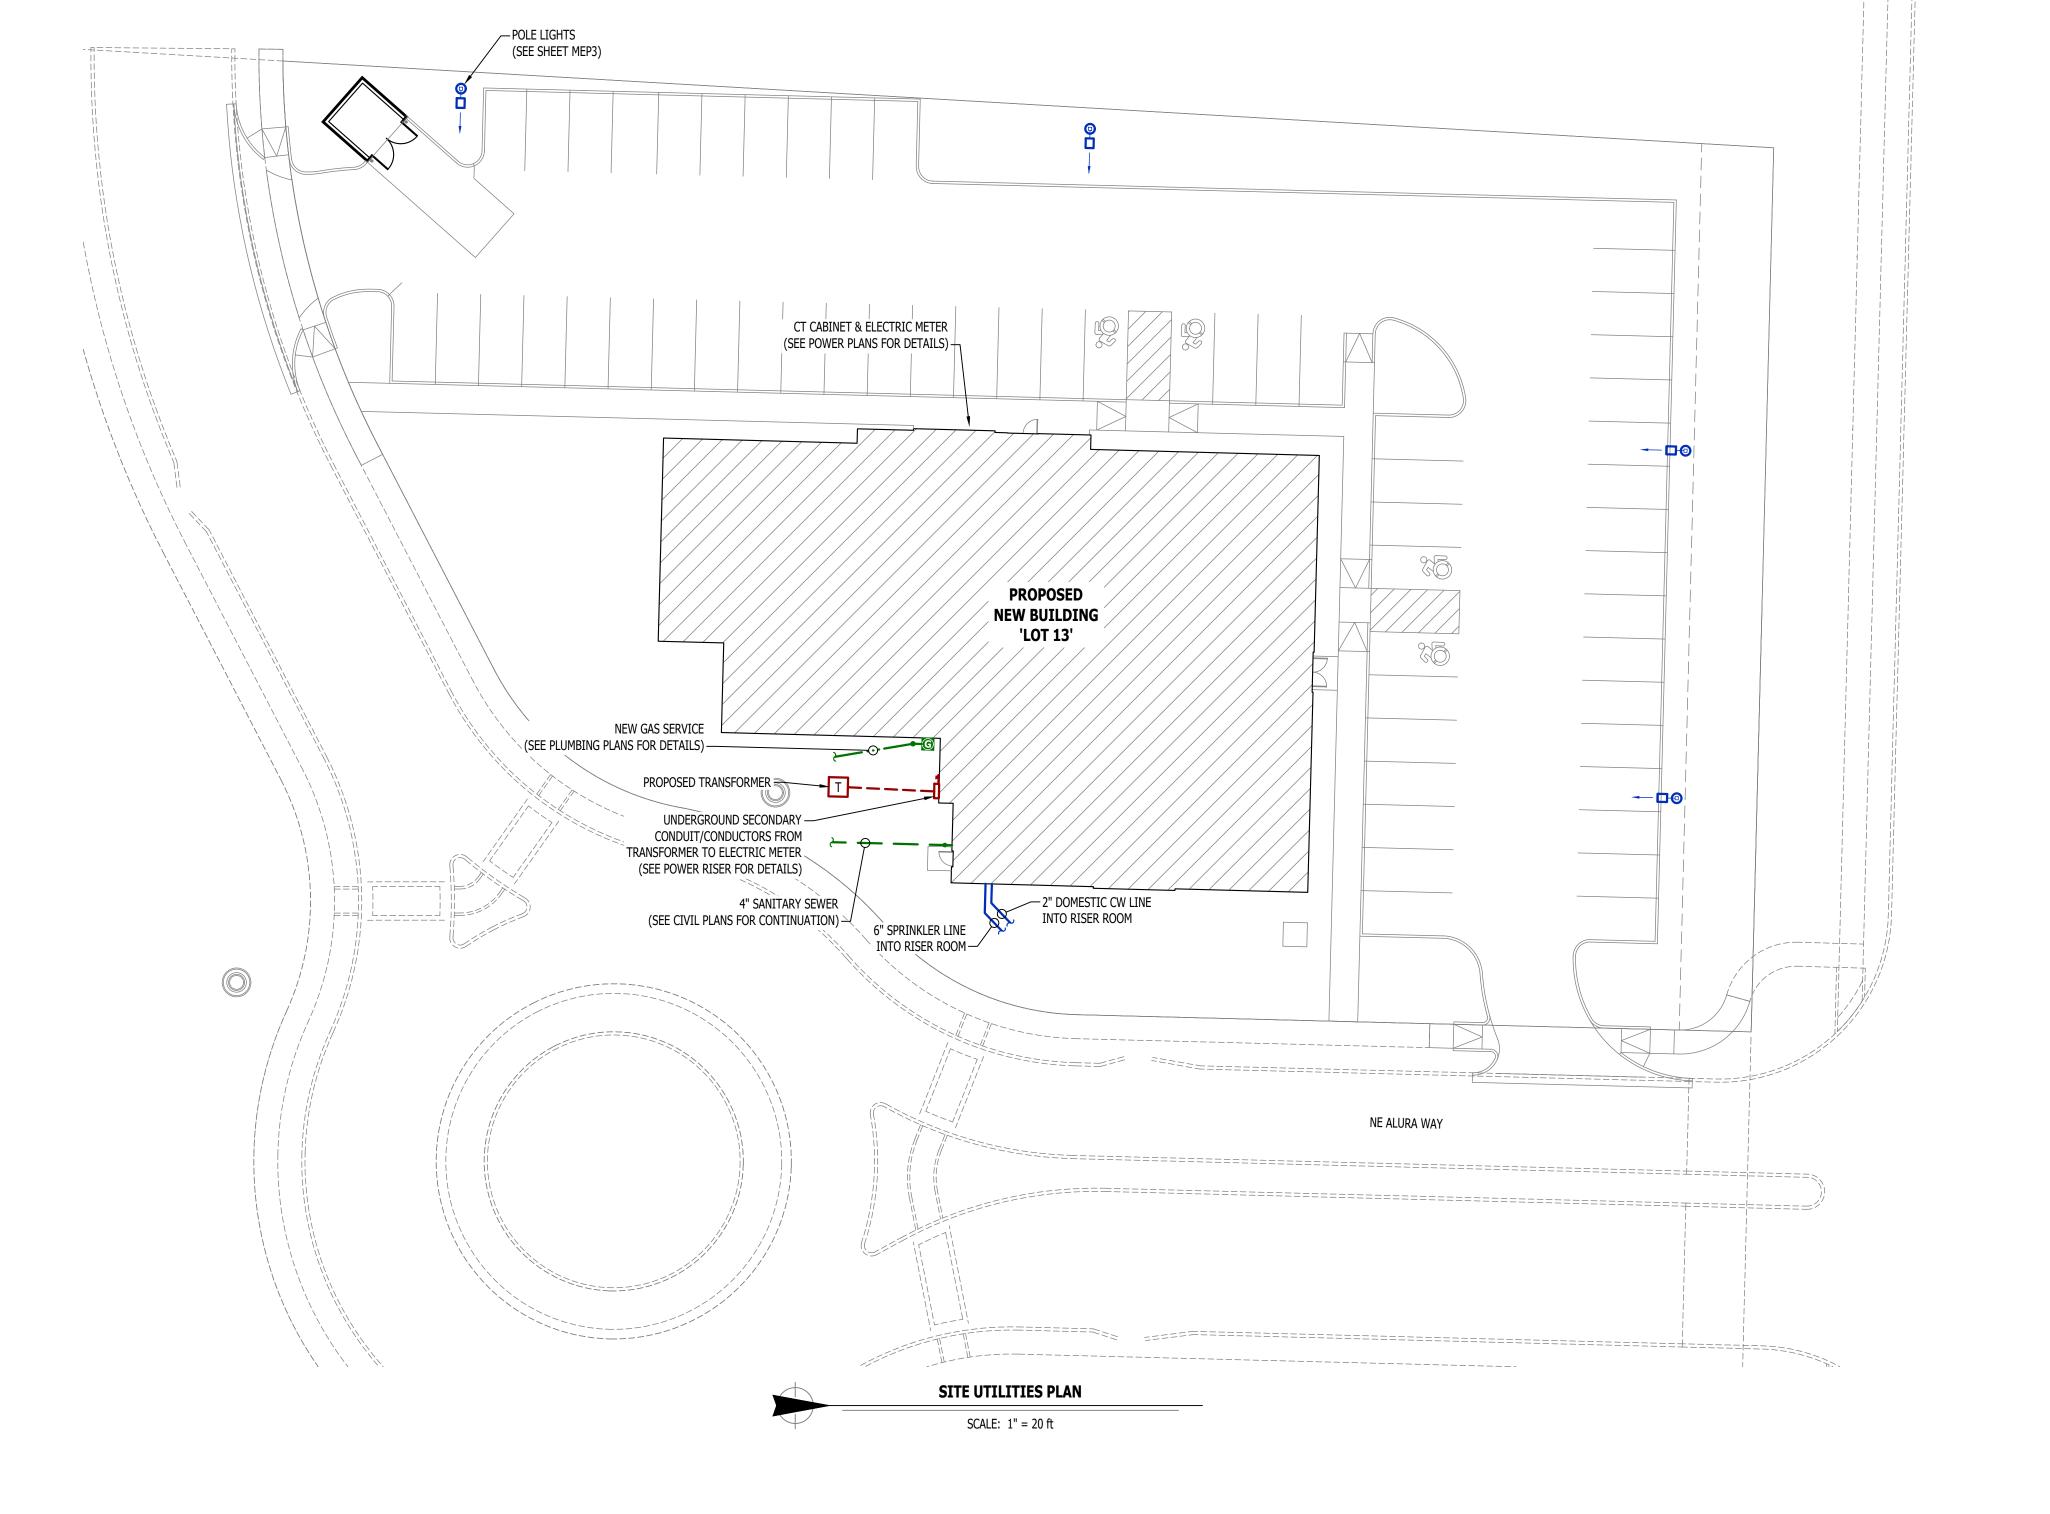

RELEASED FOR CONSTRUCTION
As Noted on Plans Review

James Watson, P.E. June 13, 2025 PE-2015017071 MO Certificate of Authority # 2018029680



#### J-SQUARED **ENGINEERING**

2400 Bluff Creek Drive, Suite 101 Columbia, Missouri 65201 573.234.4492 www.j-squaredeng.com

J2 PROJECT No: J2 DESIGN: ACW

ISSUE TITLE DATE PERMIT SET 06 - 13 - 2025

# 02 qn D

Park


AHJ APPROVAL STAMP

SITE UTILITIES PLAN

SITE LIGHTING CALCULATION SUMMARY								
AREA / LABEL	CALC TYPE	UNITS	AVG	MAX	MIN	AVG/MIN	MAX/MIN	
SITE	ILLUMINANCE	FC	2.04	4.6	0.7	2.9	6.6	
SPILL LIGHT	ILLUMINANCE	FC	0.12	1.6	0	N/A	N/A	
NOTES:								
1. PHOTOMETRIC CALCULATIONS	DO NOT INCLUDE EXISTIN	NG LIGHTING						

			SITE LI	GHTING FIXTURE S	CHEDU	LE				
TAG	MANUFACTURER (OR EQUAL)	MODEL NUMBER (OR EQUAL)	DESCRIPTION	MOUNTING	LUMEN OUTPUT	сст (°К)	CRI	VOLTS	WATTS	NOTES
PL1	MCGRAW-EDISON	PRV-XL-PA3A-740-U-T4W-HSS	LED POLE LIGHT	20' #SSS POLE ON 30" BASE	17,617	4000	70	208	172	WITH #MS/DIM-L40W MOTION SENSING DIMMING
NOTES:										
1. VERIF	Y LIGHT FIXTURE FINISHE	S WITH OWNER / ARCHITECT PRIOR TO ORDERING.								

#### SITE LIGHTING PLAN SYMBOL LEGEND

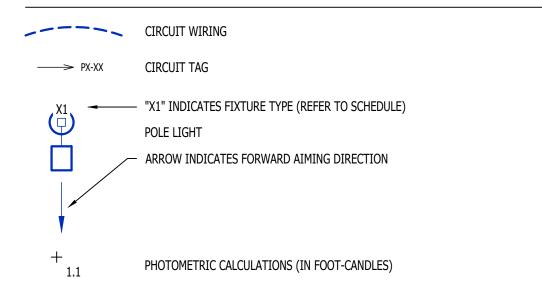


#### **SITE LIGHTING PLAN GENERAL NOTES:**


- 1. SITE PHOTOMETRIC VALUES SHOWN HAVE BEEN CALCULATED PER SPECIFIED LIGHT FIXTURES AT INDICATED MOUNTING HEIGHTS. ANY CHANGES OR ALTERATIONS TO LIGHTING LAYOUT SHOWN WILL REQUIRE RECALCULATING SITE PHOTOMETRICS AND WILL THE RESPONSIBILITY OF THE ELECTRICAL CONTRACTOR / EQUIPMENT SUPPLIER.
- PHOTOMETRIC CALCULATIONS SHOWN DO NOT INCLUDE EXISTING LIGHT FIXTURE(S), ONLY NEW POLE LIGHT FIXTURE(S) SHOWN.
- 3. BUILDING-MOUNTED EXTERIOR LIGHTING IS NOT YET DESIGNED FOR PROPOSED BUILDING. ALL BUILDING-MOUNTED LIGHTING WILL BE INTENDED AS ACCENT LIGHTING AND NOT INTENDED TO PROVIDE GENERAL AREA LIGHTING. ALL BUILDING-MOUNTED LIGHTING SHALL COMPLY WITH CITY OF LEE'S SUMMIT UDO SECTIONS 8.220, 8.260, & 8.270.

#### SITE LIGHTING PLAN GENERAL NOTES:

1) 1" CONDUIT WITH (2) #8 CU. & (1) #8 CU. EQ. GRD.
2) 1" CONDUIT WITH (2) #10 CU. & (1) #10 CU. EQ. GRD.

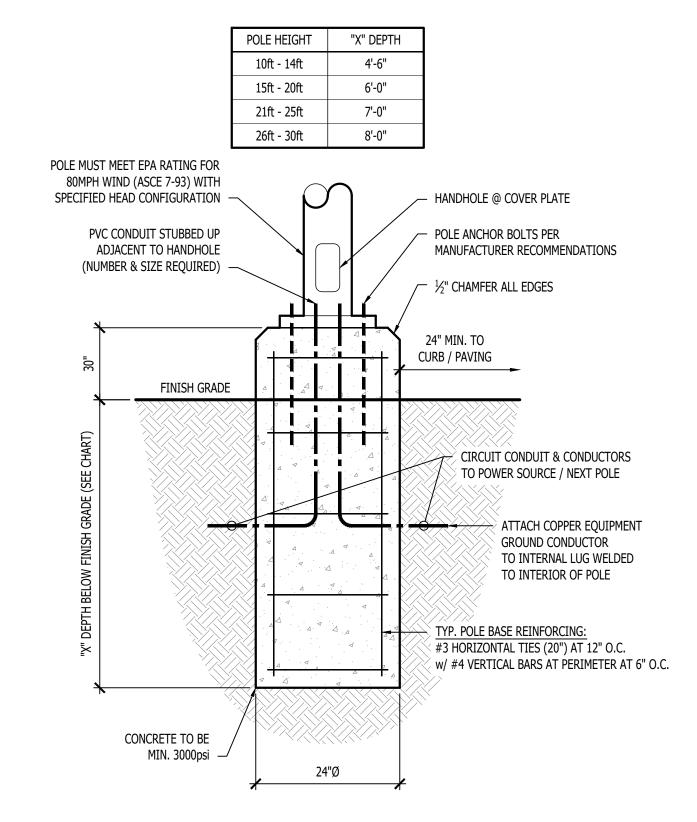

TYPICAL LIGHT POLE DETAIL

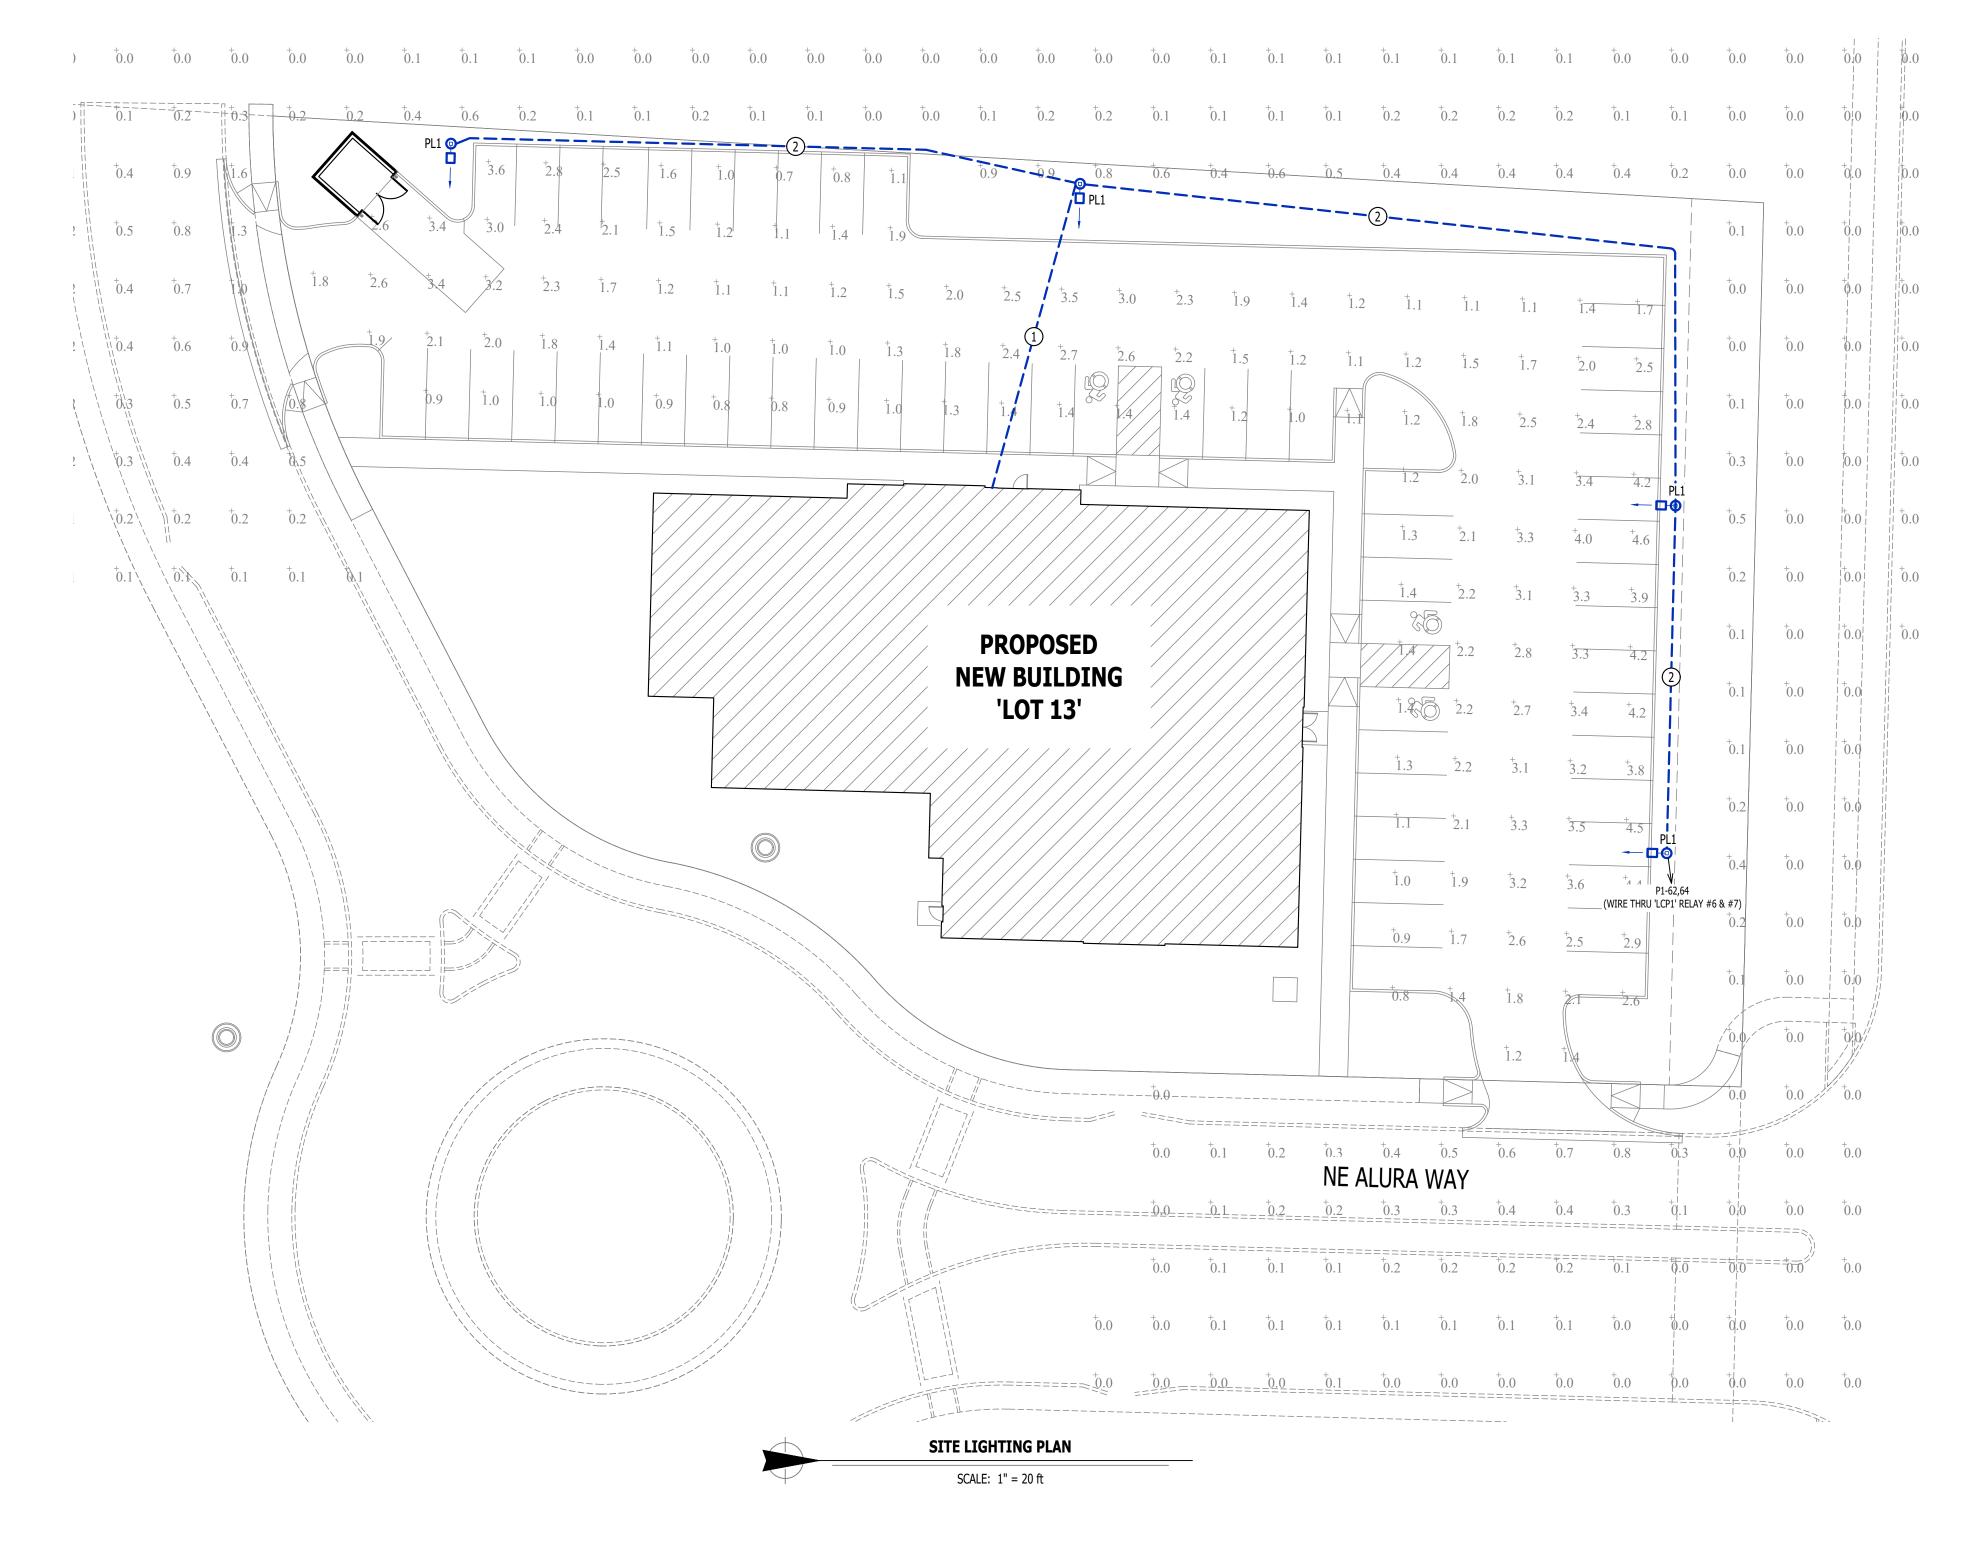

CONSTRUCTION
As Noted on Plans Review

Personal Services Department Office Services Department Office

RELEASED FOR

James Watson, P.E. June 13, 2025 PE-2015017071 MO Certificate of Authority # 2018029680



## J-SQUARED ENGINEERING

2400 Bluff Creek Drive, Suite 101 Columbia, Missouri 65201 573.234.4492 www.j-squaredeng.com

J2 PROJECT No:	J21211
J2 DESIGN:	ACW
	_
ISSUE TITLE	DATE
PERMIT SET	06 - 13 - 2025
	<del></del>

# Office

Athletic Club &

Discovery Park Athl


AHJ APPROVAL STAMP

SHEET TITLE

SITE LIGHTING PLAN

SHEET NUMBER

MEP3

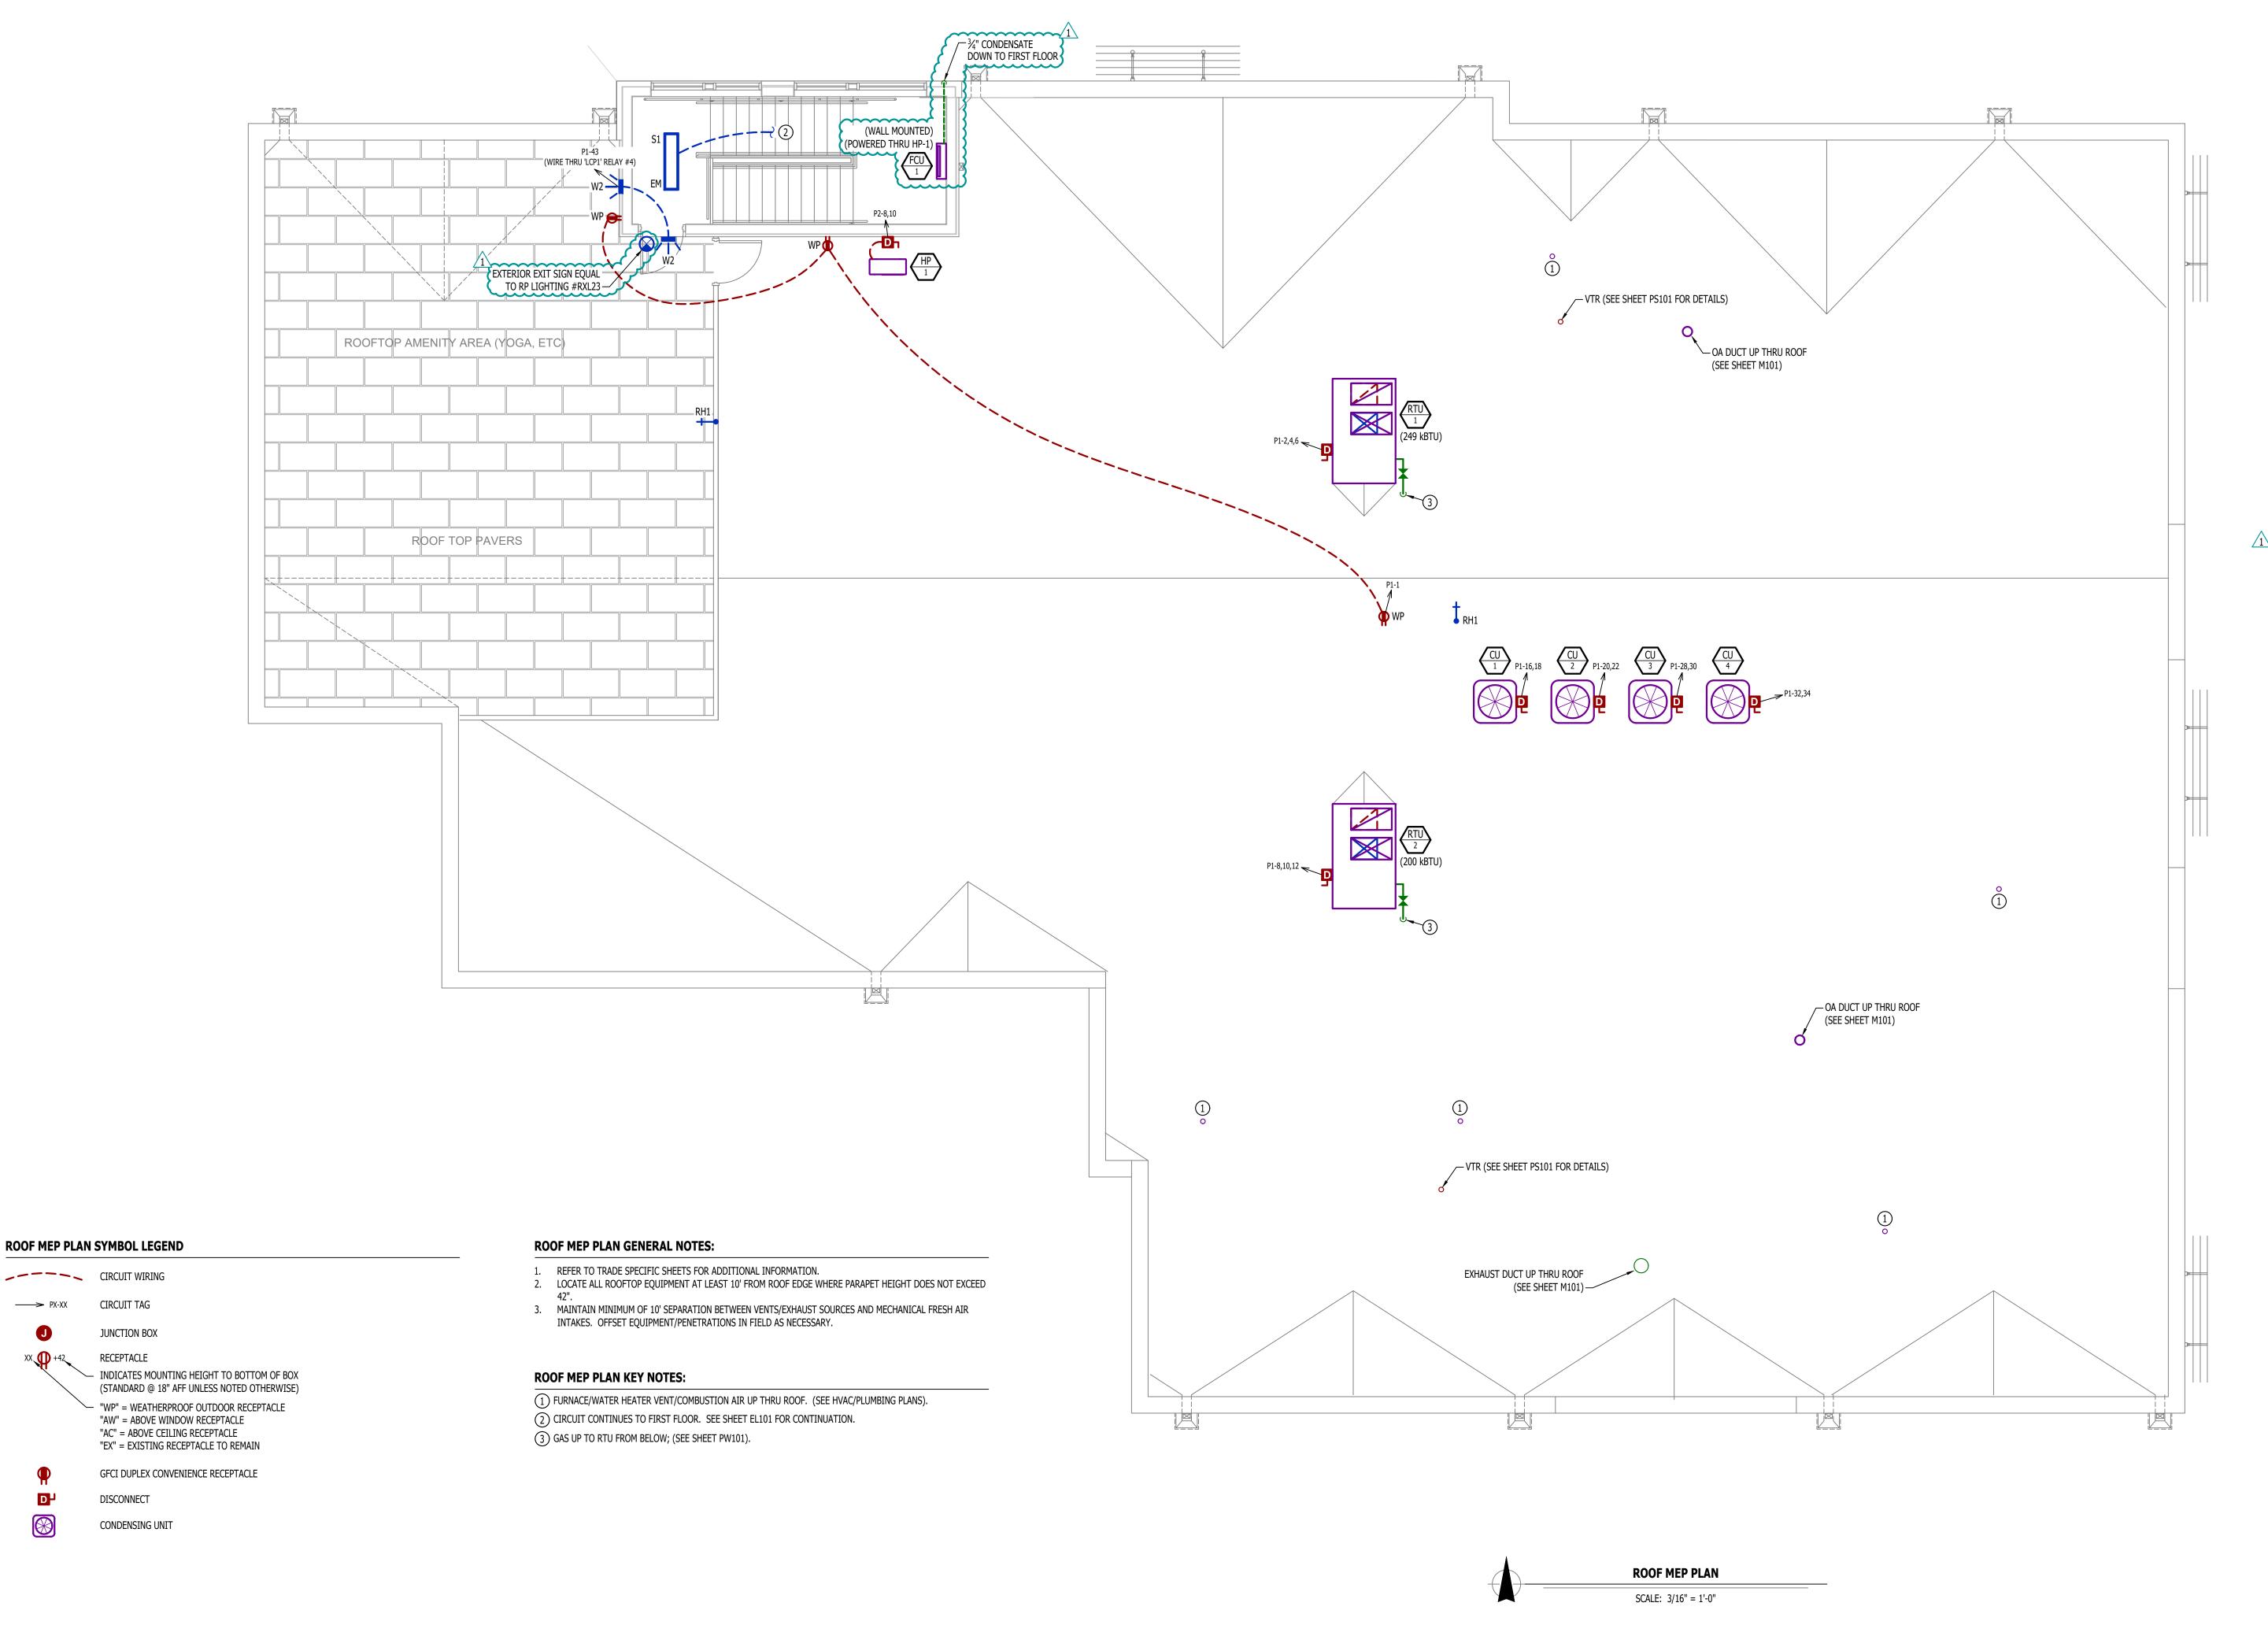

RELEASED FOR
CONSTRUCTION
As Noted on Plans Review

James Watson, P.E. August 11, 2025 PE-2015017071 MO Certificate of Authority # 2018029680



#### **J-SQUARED** ENGINEERING

2400 Bluff Creek Drive, Suite 101 Columbia, Missouri 65201 573.234.4492 www.j-squaredeng.com

J2 PROJECT No: J2 DESIGN: ACW

ISSUE TITLE DATE PERMIT SET 06 - 13 - 2025 08 / 11 / 2025 CITY COMMENTS

# **Office 0**

qn O 4


Q Discovery

AHJ APPROVAL STAMP

SHEET TITLE

**ROOF MEP PLAN** 

SHEET NUMBER

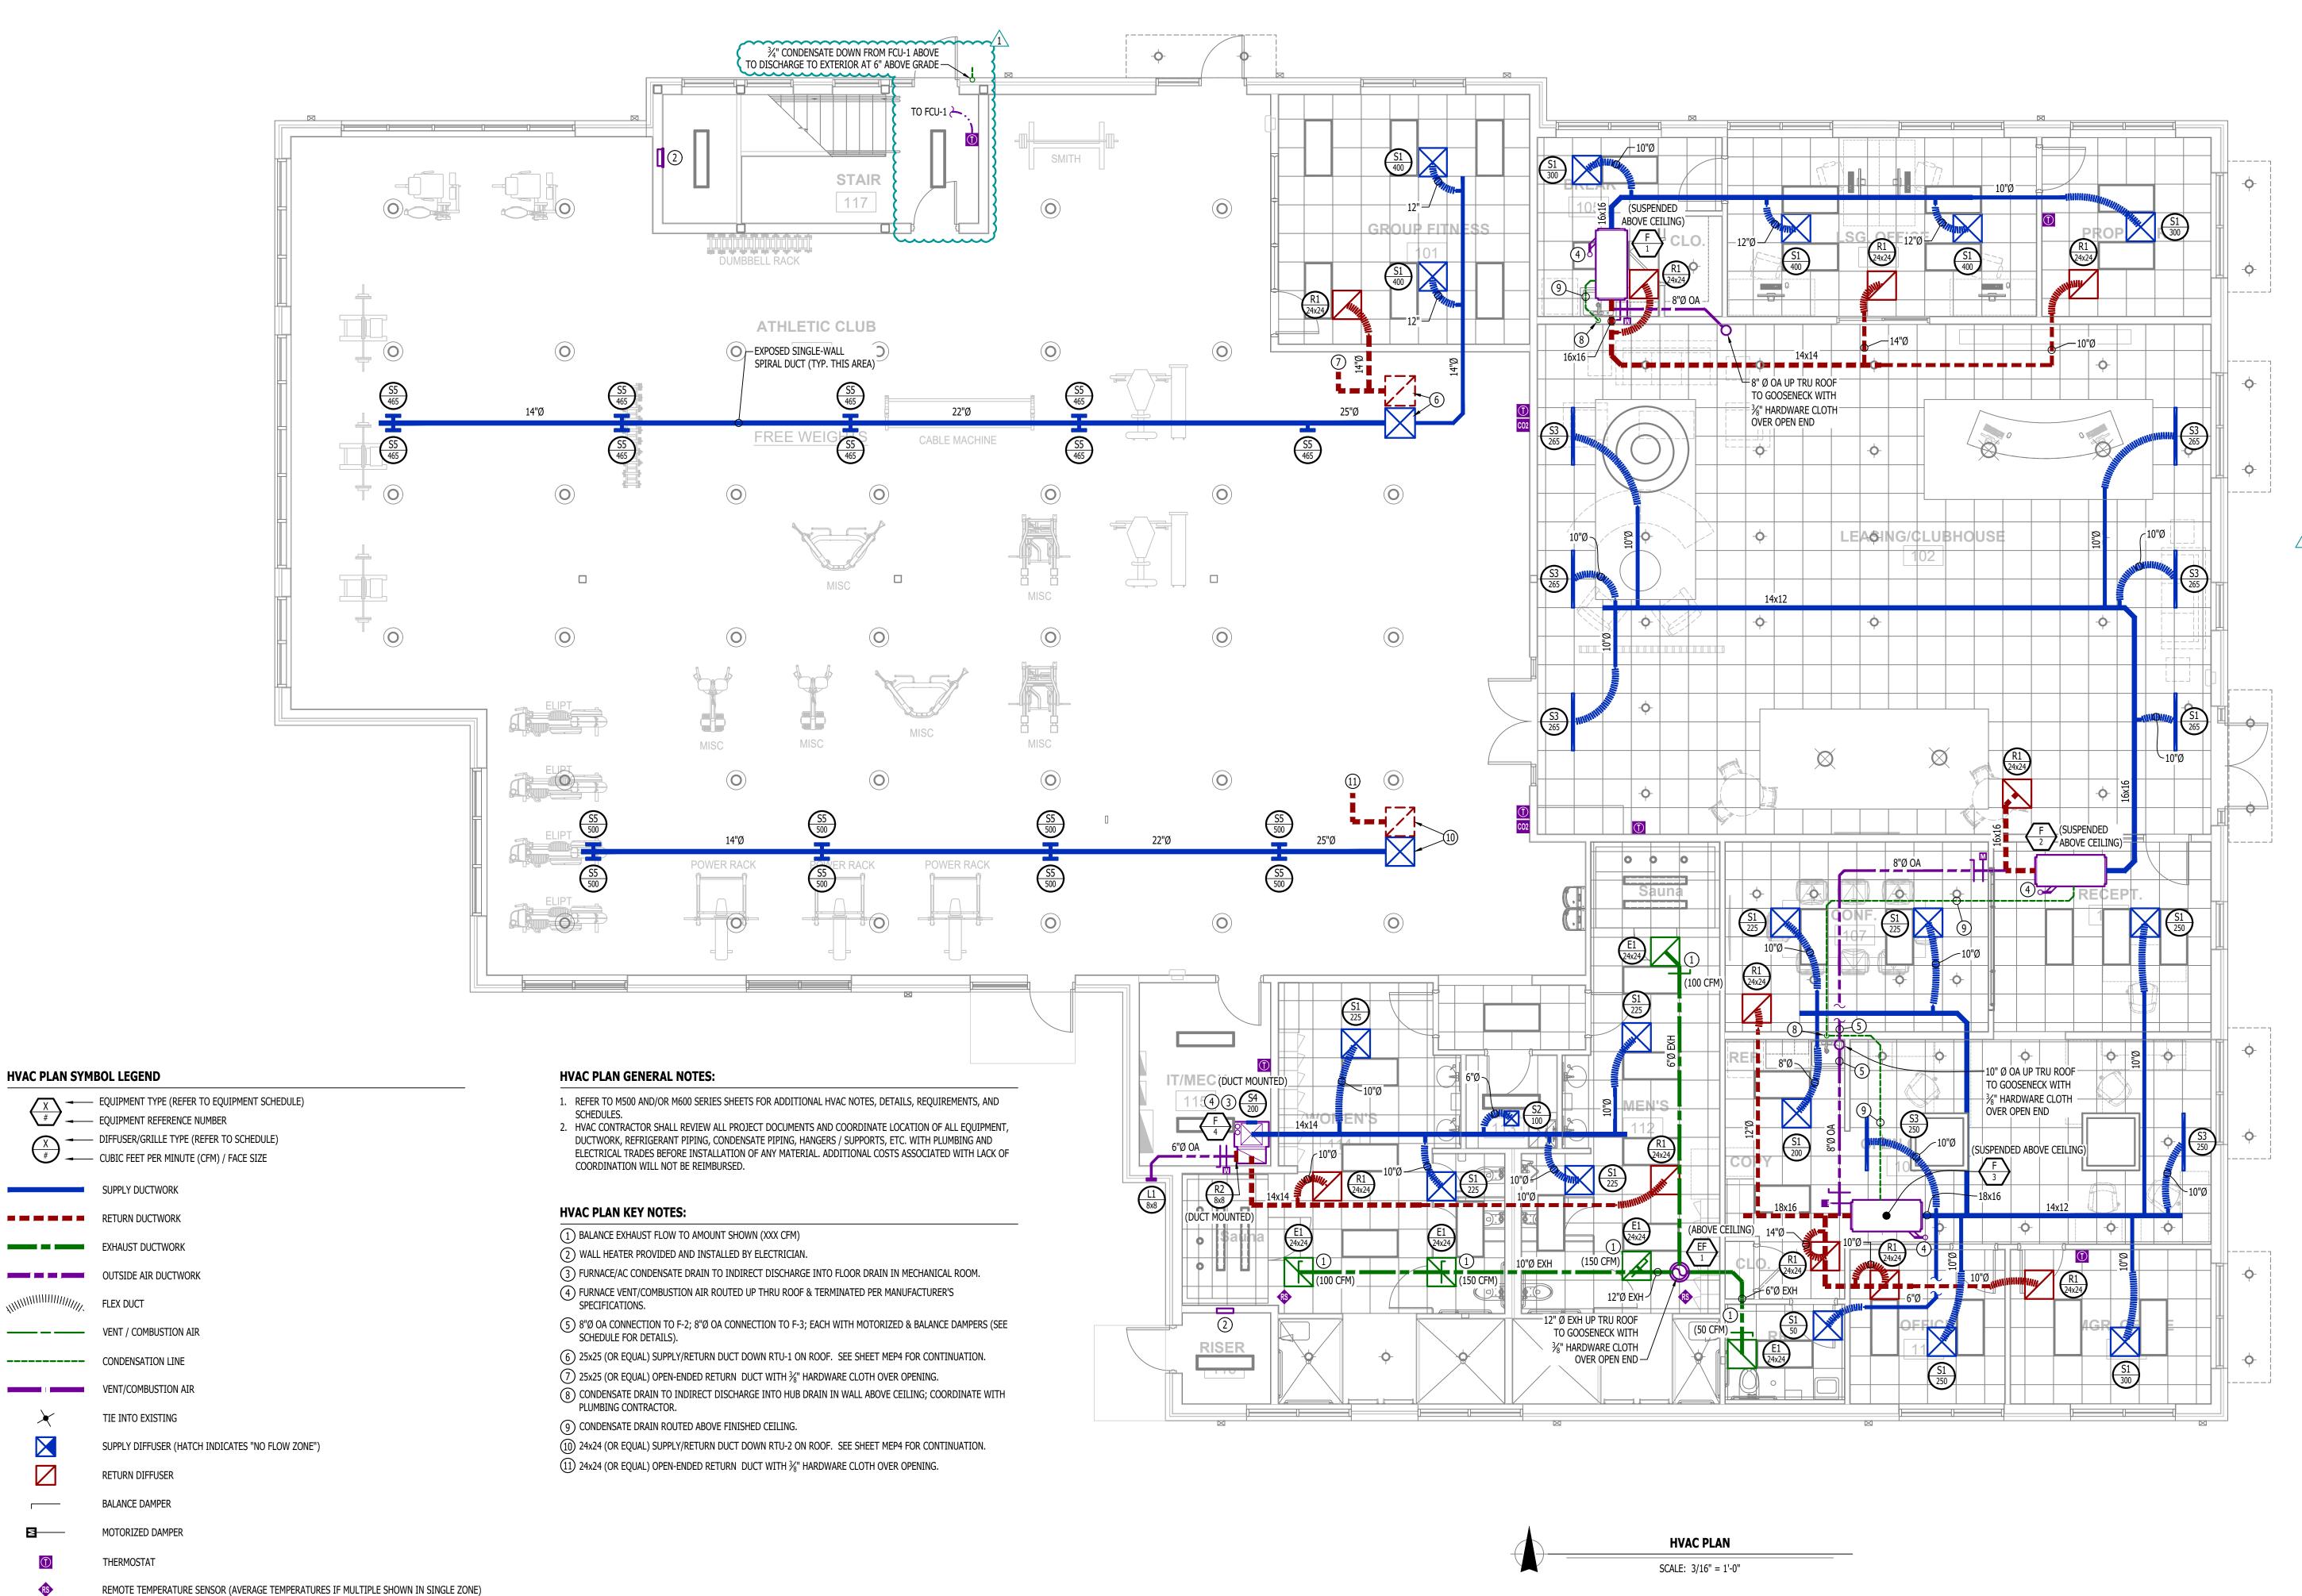

CONSTRUCTION
As Noted on Plans Review

RELEASED FOR

James Watson, P.E. August 11, 2025 PE-2015017071 MO Certificate of Authority # 2018029680



#### **J-SQUARED ENGINEERING**

2400 Bluff Creek Drive, Suite 101 Columbia, Missouri 65201 573.234.4492

www.j-squaredeng.com J2 PROJECT No: J2 DESIGN: ACW

ISSUE TITLE DATE

PERMIT SET 06 - 13 - 2025 CITY COMMENTS 08 / 11 / 2025

# **Office**

02 qn O 

P

**COV** 

AHJ APPROVAL STAMP

SHEET TITLE

**HVAC PLAN** 

SHEET NUMBER

#### **HVAC SPECIFICATIONS**

APPROVED PRE-MANUFACTURED BASE.

#### 1. GENERA

1.1. REFER TO GENERAL MEP SPECIFICATIONS SECTION FOR ADDITIONAL REQUIREMENTS.

#### 2. WORKMANSHI

- COORDINATE WITH ALL OTHER TRADES SO THAT HVAC EQUIPMENT AND DUCT WORK DOES NOT BLOCK REQUIRED ACCESS OR CLEARANCE TO ANY EQUIPMENT, ACCESS PANELS, ELECTRICAL JUNCTION BOXES, ELECTRICAL PANELS, ETC.
- 2.2. ALL HVAC EQUIPMENT IS TO BE INSTALLED PER MANUFACTURER'S PUBLISHED RECOMMENDATIONS AND/OR INSTALLATION INSTRUCTIONS.
- 2.3. ALL EQUIPMENT TO BE INSTALLED LEVEL AND PLUMB, PARALLEL OR PERPENDICULAR TO BUILDING ORIENTATION WHERE POSSIBLE.
- 2.4. ROOFTOP MOUNTED RTU'S & EXHAUST FANS SHALL BE INSTALLED ON CURBS PER MANUFACTURER'S INSTRUCTIONS. CURB HEIGHT SHALL PROVIDE A MINIMUM OF 12" BETWEEN EQUIPMENT AND TOP OF
- ROOF IN ALL LOCATIONS.

  2.5. GRADE MOUNTED RTUS, CONDENSING UNITS, AND HEAT PUMPS TO BE INSTALLED ON 4" REINFORCED CONCRETE PAD EXTENDING 4" BEYOND EACH EDGE OF THE EQUIPMENT, OR A MANUFACTURER
- 2.6. APPROPRIATE ATTENTION SHALL BE GIVEN TO INDOOR AIR QUALITY THROUGHOUT CONSTRUCTION; PROTECT INSIDE OF NEW DUCTWORK & AIR-HANDLING EQUIPMENT FROM DUST, DIRT, DEBRIS, PAINT, MOISTURE, ETC. INSULATION SHALL BE REPLACED IF EXPOSED TO MOISTURE. AN INDEPENDENT, PROFESSIONAL DUCT CLEANING COMPANY SHALL CLEAN ALL NEW DUCTWORK IF EQUIPMENT WAS USED DURING CONSTRUCTION, AND EQUIPMENT/COILS SHALL ALSO BE THOROUGHLY CLEANED.
- 7. FIELD COORDINATE LOCATIONS OF ALL DIFFUSERS, GRILLES, REGISTERS, ETC. WITH LIGHT FIXTURE LOCATIONS AND ADJUST AS NECESSARY.

#### 3. EOUIPME

- 3.1. ALL EQUIPMENT SHOWN ON MECHANICAL PLANS SHALL BE PROVIDED & INSTALLED BY MECHANICAL CONTRACTOR UNLESS NOTED OTHERWISE.
- 3.2. ALL EQUIPMENT MUST PROVIDE PERFORMANCE AS SPECIFIED ON PLANS. WHERE SPECIFIC MANUFACTURERS AND/OR MODELS ARE INDICATED ON PLANS, CONTRACTOR TO PROVIDE MODEL INDICATED OR APPROVED EQUAL. VERIFY SUBSTITUTION APPROVAL PRIOR TO PURCHASE OR INSTALLATION OF EQUIPMENT.
- 3.3. CONTRACTOR TO SUPPLY SUBMITTALS FOR ALL EQUIPMENT FOR REVIEW BY ARCHITECT AND ENGINEER. FORMAL APPROVAL SHALL BE RECEIVED BY CONTRACTOR PRIOR TO EQUIPMENT PURCHASE.
- 3.4. CONTRACTOR TO SHARE APPROVED EQUIPMENT SUBMITTALS WITH ANY PERTINENT ELECTRICAL OR PLUMBING REQUIREMENTS WITH RESPECTIVE CONTRACTORS WITHIN TWO WEEKS OF RECEIVING
- APPROVED SUBMITTALS FROM ARCHITECT/ENGINEER.

  3.5. ALL EQUIPMENT SHOWN ON PLANS SHALL BE INSTALLED PER MANUFACTURER'S SPECIFICATIONS WITH
- ADEQUATE ACCESS AND CLEARANCE FOR SERVICING OR REPLACEMENT.

  3.6. ALL HORIZONTAL FURNACES WITH AC COILS SHALL BE EQUIPPED WITH CORROSION RESISTANT DRAIN PAIN. DRAIN PAN TO DISCHARGE TO SANITARY WASTE VIA INDIRECT CONNECTION WITH AIR GAP. DRAIN PAN TO PROVIDE SECONDARY OVERFLOW OR FLOAT SWITCH INTERLOCKED WITH UNIT TO SHUT
- DOWN UNIT ON HIGH WATER SIGNAL.

  3.7. ALL EXTERIOR REFRIGERANT COILS TO BE PROTECTED BY FACTORY EQUIPPED HAIL GUARDS.
- 3.8. REFRIGERANT PIPING TO BE ACR COPPER OR TYPE L COPPER.

  3.9 ALL AIR HANDLING FOLITIMENT SHALL BE FOLITIPED WITH MERV
- 3.9. ALL AIR HANDLING EQUIPMENT SHALL BE EQUIPPED WITH MERV-8 FILTRATION AT RETURN OPENING UNLESS OTHERWISE NOTED.
- 3.10. ALL AIR FILTERS SHALL BE SIZED FOR A MAXIMUM FACE VELOCITY OF 500FPM.
   3.11. PROVIDE & INSTALL ALL EQUIPMENT FLUES/VENTS PER MANUFACTURER'S SPECIFICATIONS.
- TERMINATIONS SHALL BE AT LEAST 10' FROM ANY FRESH AIR INTAKE.

  3.12. PROVIDE NEW AIR FILTERS IN ALL EQUIPMENT PRIOR TO TESTING & BALANCING AND BEFORE TURNING
- OVER SYSTEM(S) TO OWNERSHIP.

  3.13. IF ANY EXISTING EQUIPMENT IS TO BE REUSED, CLEAN AND INSPECT EQUIPMENT PRIOR TO BEGINNING
- WORK. VERIFY THAT EQUIPMENT IS IN GOOD WORKING CONDITION, REPORT ANY DEFICIENCIES TO ENGINEER.

#### 4. DUCTWORK

- 4.1. DUCTWORK TO BE GALVANIZED STEEL, SEAL CLASS B, CONSTRUCTED PER SMACNA STANDARDS.4.2. DUCTWORK THICKNESS:
- 4.2.1. 26 GA. MINIMUM UP TO 16" DUCT
- 4.2.2. 24 GA. UP TO 20"
- 4.2.3. 22 GA. UP TO 24" 4.2.4. 20 GA. UP TO 28"
- 4.2.4. 20 GA. UP TO 28" 4.2.5. 18 GA. UP TO 36"
- TURNING VANES SHALL BE PROVIDED AND INSTALLED AT ALL 90° BENDS AND TEES.

  ALL DUCT DIMENSIONS LISTED ARE TO INTERIOR OF DUCT LINER UNLESS NOTED OTHERWISE ON
- 4.4. ALL DUCT DIMENSIONS LISTED ARE TO INTERIOR OF DUCT LINER UNLESS NOTED OTHERWISE ON PLANS.
- 4.5. BALANCE DAMPERS MUST BE PROVIDED TO ALLOW ADJUSTMENT AT EACH AIR TERMINAL.
  4.5.1. WHERE BRANCH TAKEOFF IS ACCESSIBLE (ABOVE LAY-IN CEILING OR EXPOSED DUCT), BALANCE
- DAMPER IS TO BE INSTALLED AT TAKEOFF.
  4.5.2. WHERE TAKEOFF IS INACCESSIBLE (IN ATTIC OR SOFFIT), BALANCE DAMPER IS TO BE LOCATED
- SUCH THAT IT IS ACCESSIBLE FROM FACE OF AIR DEVICE.

  4.6. HVAC CONTRACTOR RESPONSIBLE FOR ALL DUCTWORK TRANSITIONS AND FITTINGS AS REQUIRED FOR
- FINAL CONNECTIONS TO HVAC EQUIPMENT.
  4.7. UNLESS NOTED OTHERWISE ON PLANS, FLEXIBLE DUCT CONNECTIONS MAY USED FROM BRANCH DUCTS
- TO FINAL AIR DEVICES, BUT SHALL NOT EXCEED 8'-0" IN LENGTH. FLEXIBLE DUCT CONNECTORS MUST BE SUPPORTED PER PLAN DETAILS.

#### 5. <u>INSULATION</u>


#### 5.1. DUCTWORK

- 5.1.1. SEE "TYPICAL DUCT INSULATION DIAGRAM" FOR INSTALLATION SPECIFIC REQUIREMENTS.5.1.2. INTERNAL DUCT LINER TO BE EQUAL TO 'JOHNS MANVILLE LINACOUSTIC R-300'.
- 5.1.3. EXTERNAL DUCT WRAP TO INCLUDE VAPOR BARRIER. EQUAL TO 'JOHNS MANVILLE MICROLITE'
- 5.1.4. WHERE INSULATION IS REQUIRED IN "TYPICAL DUCT INSULATION DIAGRAM", INCLUDE INSULATION ON ALL FITTINGS, INCLUDING CANVAS FLEX CONNECTION FITTINGS.
- 5.2. REFRIGERANT PIPING
- 5.2.1. SPLIT SYSTEM (SUCTION LINE ONLY) 1" CLOSED CELL ELASTOMERIC FOAM (EQUAL TO 'ARMAFLEX AP').
- VRV/VRF SYSTEMS (BOTH SUCTION AND HOT GAS LINES) 1½" EPDM (EQUAL TO 'AEROFLEX AEROCEL AC') WITHIN CONDITIONED SPACES & 2" EDPM (EQUAL TO 'AEROFLEX AEROCEL AC') IN UNCONDITIONED SPACES, AND WITH BANDED ALUMINUM SHIELDING IN EXTERIOR SPACES.
- 5.4. CONDENSATE PIPING
  5.4.1. SPLIT SYSTEMS WHERE CONDENSATE PIPING IS LOCATED IN UNCONDITIONED SPACE, INSULATE
- WITH ½" ELASTOMERIC. NO INSULATION REQUIRED WITHIN CONDITIONED SPACES.


  5.4.2. VRV/VRF INSULATE WITH ½" ELASTOMERIC.

### 6. TESTING AND BALANCING


- 6.1. ALL SYSTEMS MUST BE BALANCED TO WITHIN 10% OF VALUES INDICATED ON PLAN.
- 6.2. HVAC CONTRACTOR TO PROVIDE WRITTEN BALANCE REPORT INCLUDING FLOW VALUES INDICATED ON PLANS, INITIAL MEASURED FLOW VALUES, AND FINAL MEASURED VALUES.
- 6.3. THIRD PARTY CERTIFIED TEST AND BALANCE NOT REQUIRED UNLESS OTHERWISE NOTED ON PLANS OR WITHIN PROJECT MANUAL.

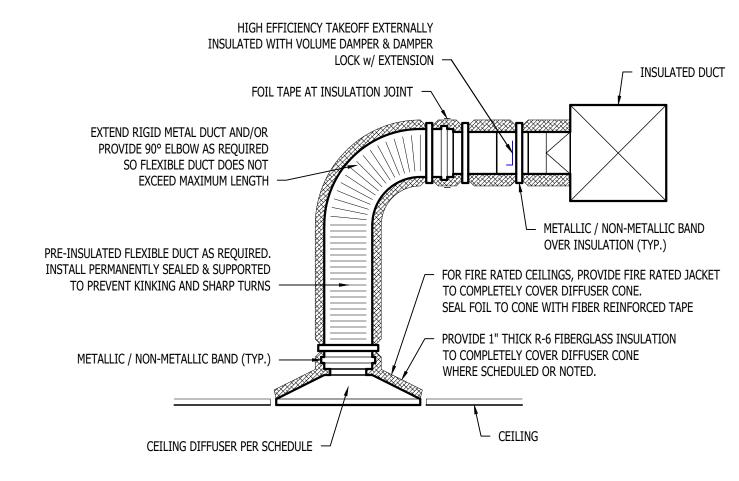


#### TYPICAL LAY-IN DIFFUSER DETAIL

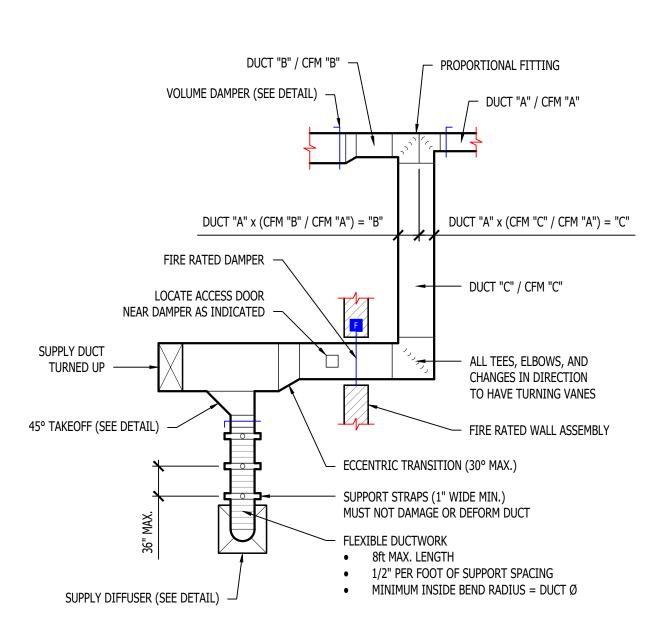


TYPICAL DUCTWORK DETAIL

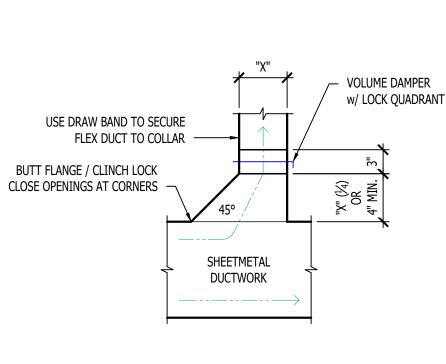




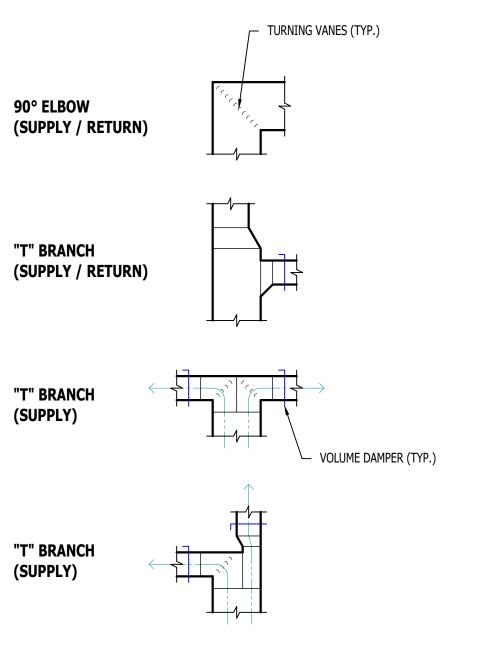

TYPICAL DUCTWORK FITTINGS DETAIL

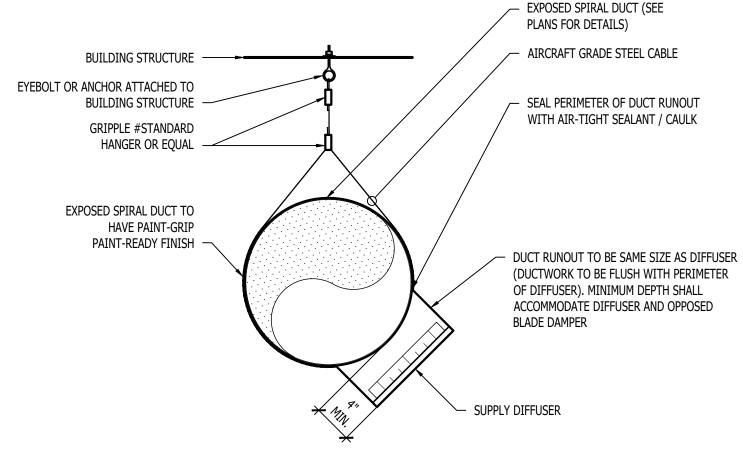

**EXPOSED SPIRAL DUCT SECTION DETAIL** 

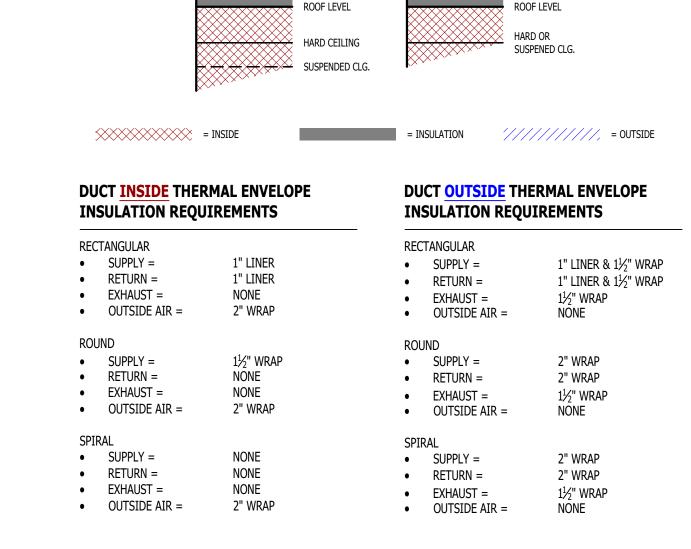

TYPICAL BUILDING INTERIOR DUCT INSULATION DIAGRAM

RELEASED FOR
CONSTRUCTION
As Noted on Plans Review

December Services Departmen
OH.ek/s Surring, Missouri
OH.ek/s Surring,

PE-2015017071
MO Certificate of Authority # 2018029680

### J-SQUARED ENGINEERING

2400 Bluff Creek Drive, Suite 101 Columbia, Missouri 65201 573.234.4492

www.j-squaredeng.com

J2 PROJECT No:	J21211
J2 DESIGN:	ACW
ISSUE TITLE	DATE
PERMIT SET	06 - 13 - 2025

# Office —

Athletic Club

Siscovery Park Ath

UI ADDDOVAL CTAMD

AHJ APPROVAL STAMP

SHEET TITLE

HVAC DETAILS

SHEET NUMBER

M501

							RTU SC	HEDULE							
	EQUIPMENT	SIZE		TOTAL	E.S.P.	OA AIRFLOW	GAS H	EATING	(IA:	COOLII 80 DB/67 WE			ELECTRICAL		
TAG	DESCRIPTION	(TONS)	ORIENTATION	AIRFLOW (CFM)	(in. H20)	MAX/MIN - (CFM)	INPUT (kBTU)	OUTPUT (kBTU)	SENSIBLE (KBTU)	TOTA L (KBTU)	MIN. EFFICIENCY	VOLTS / PHASE	MCA	ОСР	NOTES
RTU-1	ROOFTOP UNIT	12.5	DOWN FLOW	5000	1.0	5000 / 300	249	194	118.8	154.3	14.0 IEER	208/3	61	80	1, 2, 3, 4, 5, 6, 7, 8
RTU-2	ROOFTOP UNIT	10	DOWN FLOW	4000	1.0	5000 / 300	200	162	96.1	124.4	14.6 IEER	208/3	49	60	1, 2, 3, 4, 5, 7, 8

#### NOTES:

- 1. PROVIDE AND INSTALL 7 DAY PROGRAMABLE HONEYWELL THERMOSTAT. COORDINATE EXACT MOUNTING LOCATION WITH OWNER.
- 2. WITH FACTORY HAIL GUARD.
- 3. WITH FACTORY INSTALLED DISCONNECT.
- 4. ECONOMIZER (WITH EITHER BAROMETRIC RELIEF SIZED AT 100% OF FLOW AT 1/10" RETURN DUCT STATIC PRESSURE, OR POWERED EXHAUST); CONTROL TO BE ADJUSTABLE FIXED POINT SET AT 65°F. ECONOMIZER TO BE IECC COMPLIANT WITH FAULT DETECTION AND NOTIFICATION.
- 5. WITH POWERED WEATHERPROOF GFCI RECEPTACLE.
- 6. WITH HOT GAS REHEAT/DEHUMIDIFICATION OPTION.
- 7. WITH SMOKE DETECTOR IN RETURN AIR DUCT TO SHUT DOWN UNIT AND SEND SIGNAL TO BUILDING FIRE ALARM SYSTEM UPON DETECTION OF SMOKE.
- 8. PROVIDE CO2 SENSOR MODULATE BETWEEN MAX AND MIN OA AMOUNTS INDICATED.

						SPLIT SY	STEM SO	CHEDULE							
T4.6	EQUIPMENT	SIZE		TOTAL	E.S.P.	OA AIRFLOW	HEA	TING	(IA: 80 I	COOLING DB/67 WB, OA	A: 95 DB)		ELECTRICAL		NOTEC
TAG	DESCRIPTION	(TONS)	ORIENTATION	AIRFLOW (CFM)	(in. H20)	MAX/MIN (CFM)	GAS INPUT (KBTU)	MIN. A FUE EFF. (%)	SENSIBLE (KBTU)	TOTAL (KBTU)	MIN EFF. (SEER2)	VOLTS/PH	MCA	ОСР	NOTES
F-1	FURNACE	3.5	HORIZONTAL	1400	0.5	125 / 0	80	90	-	-	-	120	10	20	1, 2, 3
F-2	FURNACE	4.0	HORIZONTAL	1600	0.5	150 / 0	100	90	-	-	-	120	12	20	1, 2, 3
F-3	FURNACE	5.0	HORIZONTAL	2000	0.5	170 / 0	100	90	-	-	-	120	14	20	1, 2, 3
F-4	FURNACE	3.0	UPFLOW	1200	0.5	100 / 100	60	90	-	-	-	120	10	20	1, 2
CU-1	CONDENSING UNIT	3.5	-	-	-	-	-	-	31.2	41.5	13.4	208/1	20	35	4, 5
CU-2	CONDENSING UNIT	4.0	-	-	-	-	-	-	35.1	46.9	13.4	208/1	24	40	4, 5
CU-3	CONDENSING UNIT	5.0	-	-	-	-	-	-	44.1	56.4	13.4	208/1	34	60	4, 5
CU-4	CONDENSING UNIT	3.0	-	-	-	-	-	-	25.0	33.7	13.4	208/1	18	30	4, 5

#### NOTES:

- 1. PROVIDE AND INSTALL 7 DAY PROGRAMABLE HONEYWELL THERMOSTAT. COORDINATE EXACT MOUNTING LOCATION WITH OWNER.
- 2. INCLUDE CORROSION RESISTANT DRAIN PAN WITH OVERFLOW SWITCH WIRED TO SHUT DOWN UNIT.
- 3. WITH LOW LEAKAGE MOTORIZED OUTSIDE AIR DAMPER, DAMPER TO OPEN DURING OCCUPIED HOURS AND CLOSE DURING UNOCCUPIED HOURS THRU THERMOSTAT SCHEDULE.
- 4. WITH FACTORY HAIL GUARD.
- 5. LOW AMBIENT PACKAGE FOR OPERATION TO 0°F.

				MINI-	SPLIT SYST	EM SCHE	DULE							
TAG	EQUIPMENT	MA NUFA CTURER	MODEL NUMBER	SIZE	ORIENTA TION	TOTAL AIRFLOW	HEATING (IA:70 DB, OA:5 DB)	(IA: 80 E	COOLING DB/67 WB, C	OA: 95 DB)		ELECTRICAL		NOTES
IAG	DESCRIPTION	(OR EQUAL)	(OR EQUAL)	(TONS)	ORIENTA HON	(CFM)	TOTAL (KBTU)	SENSIBLE (KBTU)	TOTAL (KBTU)	EFFICIENCY (SEER2)	VOLTS/PH	МСА	ОСР	NOTES
FCU-1	WALL-MOUNT FAN COIL UNIT	MITSUBISHI	MSZ-GX24NL	2.0	HORIZONTAL	324 - 765	-	-	-	-	POW	ERED THRU I	HP-1	1
HP-1	HEAT PUMP	MITSUBISHI	MUZ-GX24NL	2.0	STANDARD	-	19.4	17.5	22.4	21.5	208/1	14	25-2	2, 3

#### NOTES:

2. WITH SPEED CONTROLLER

- 1. WITH WIRED REMOTE CONTROLLER & LOCKING COVER
- 2. WITH HEAT PUMP STAND
- 3. WITH HAIL GUARDS

			EXHAUST	FAN S	CHEDU	LE					
TAG	FOLIDATATE TVDE	MA NUFA CTURER	MODEL	FL	ow		ELECTRICA	_	PHYS	SICAL	NOTEC
TAG	EQUIPMENT TYPE	(OR EQUAL)	(OR EQUAL)	СРМ	S.P.	VOLT/PH	MCA	ОСР	DIM.	WEIGHT	NOTES
EF-1	IN-LINE EXHAUST FAN	SOLER & PALAU	TD-SILENT	550	3/8"	120/1	1	20-1	23x13x11	20 lbs.	1, 2
NOTES:											
1. WITH	H BACKDRAFT DAMPER										

DIFFUSER NECK S	SIZING SCHEDULE
A IRFLOW (CFM)	NECK SIZE (in)
0 - 120	6"
120 - 210	8"
210 - 325	10"
325 - 470	12"
470 640	1/4"

TAG	SERVICE	MANUFACTURER (OR EQUAL)	MODEL (OR EQUAL)	SIZE	COLOR / FINISH	NOTES
L1	EXH / OA	POTTORFF	EFD	AS INDICATED	PRIMED	PAINT TO MATCH EXTERIOR
R1	RETURN	PRICE	80	AS INDICATED	WHITE	
R2	RETURN	PRICE	530	AS INDICATED	WHITE	
S1	SUPPLY	PRICE	SPD	24x24	WHITE	WITH DRYWALL KIT WHERE REQUIR
S2	SUPPLY	PRICE	SPD	12x12	WHITE	
<b>S</b> 3	SUPPLY	PRICE	SDS100	48"L x 4-SLOT	WHITE	WITH 'SDB' PLENUM
S4	SUPPLY	PRICE	520	10x6	WHITE	
S5	SUPPLY	PRICE	520	18x8	WHITE	

ЕО ПОМЕМ	OA / EXH (CFM)						
EQUIPMENT	OCCUPIED HOURS	UNOCCUPIED HOURS					
RTU-1	300	300					
RTU-2	300	300					
F-1	125	0					
F-2	150	0					
F-3	170	0					
F-4	100	100					
EF-1	-550	-550					
NET CFM	595	150					
NOTES:	_	_					
1. EF-1 TO OPERATE CONTINUOUSLY							

BUILDING AIR BALANCE SUMMARY

CONSTRUCTION
As Noted on Plans Review

Description Services Departme
Office(s) Substitution, Missouri
Office(s) Substitution, Missou

James Watson, P.E. June 13, 2025 PE-2015017071 MO Certificate of Authority # 2018029680



## J-SQUARED ENGINEERING

2400 Bluff Creek Drive, Suite 101 Columbia, Missouri 65201 573.234.4492

www.j-squaredeng.com

J2 PROJECT No:	J21211
J2 DESIGN:	ACW

ISSUE TITLE	DATE
PERMIT SET	06 - 13 - 2025

# )ffice

# tic Club & O


rery Park Athletic

AHJ APPROVAL STAMP

HVAC SCHEDULES

SHEET NUMBER

**M601** 

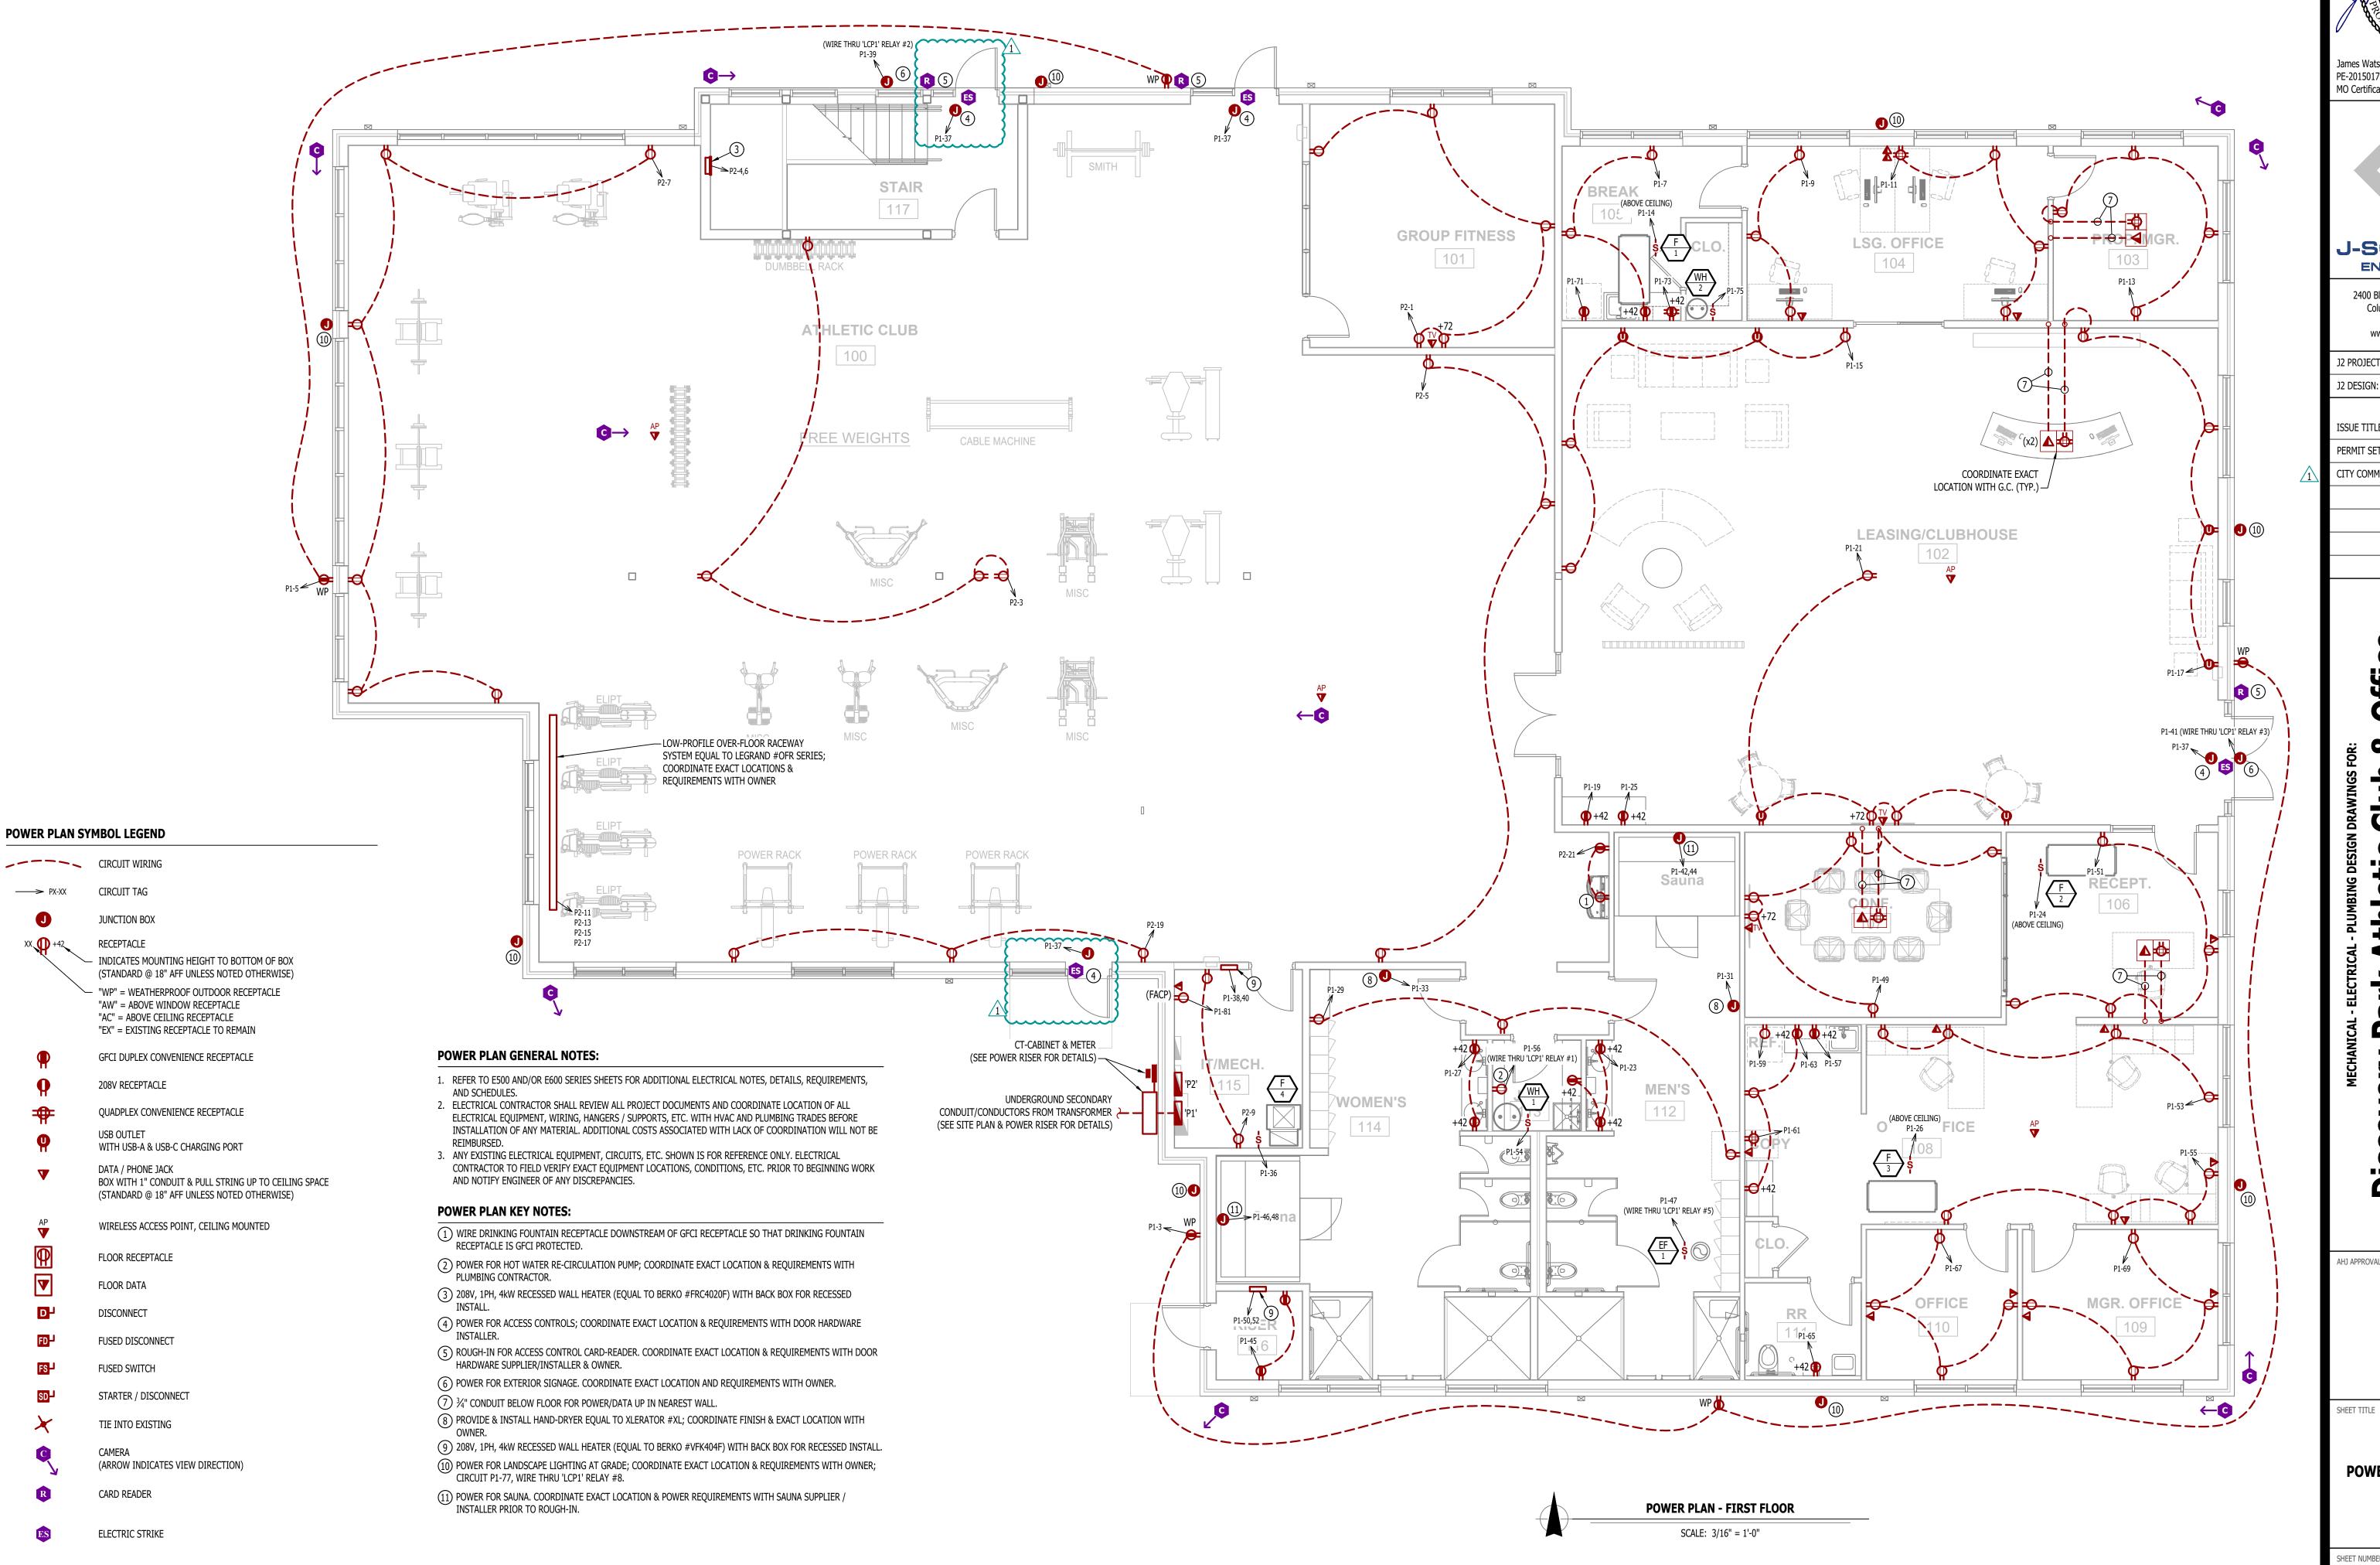

RELEASED FOR
CONSTRUCTION
As Noted on Plans Review

James Watson, P.E. August 11, 2025 PE-2015017071 MO Certificate of Authority # 2018029680



#### **J-SQUARED** ENGINEERING

2400 Bluff Creek Drive, Suite 101 Columbia, Missouri 65201 573.234.4492 www.j-squaredeng.com

J2 PROJECT No:	J21211
J2 DESIGN:	ACW

ISSUE TITLE	DATE
PERMIT SET	06 - 13 - 2025
CITY COMMENTS	08 / 11 / 2025

# **6** qn O


Δ. 8

4

P

AHJ APPROVAL STAMP

**POWER PLAN - FIRST FLOOR** 

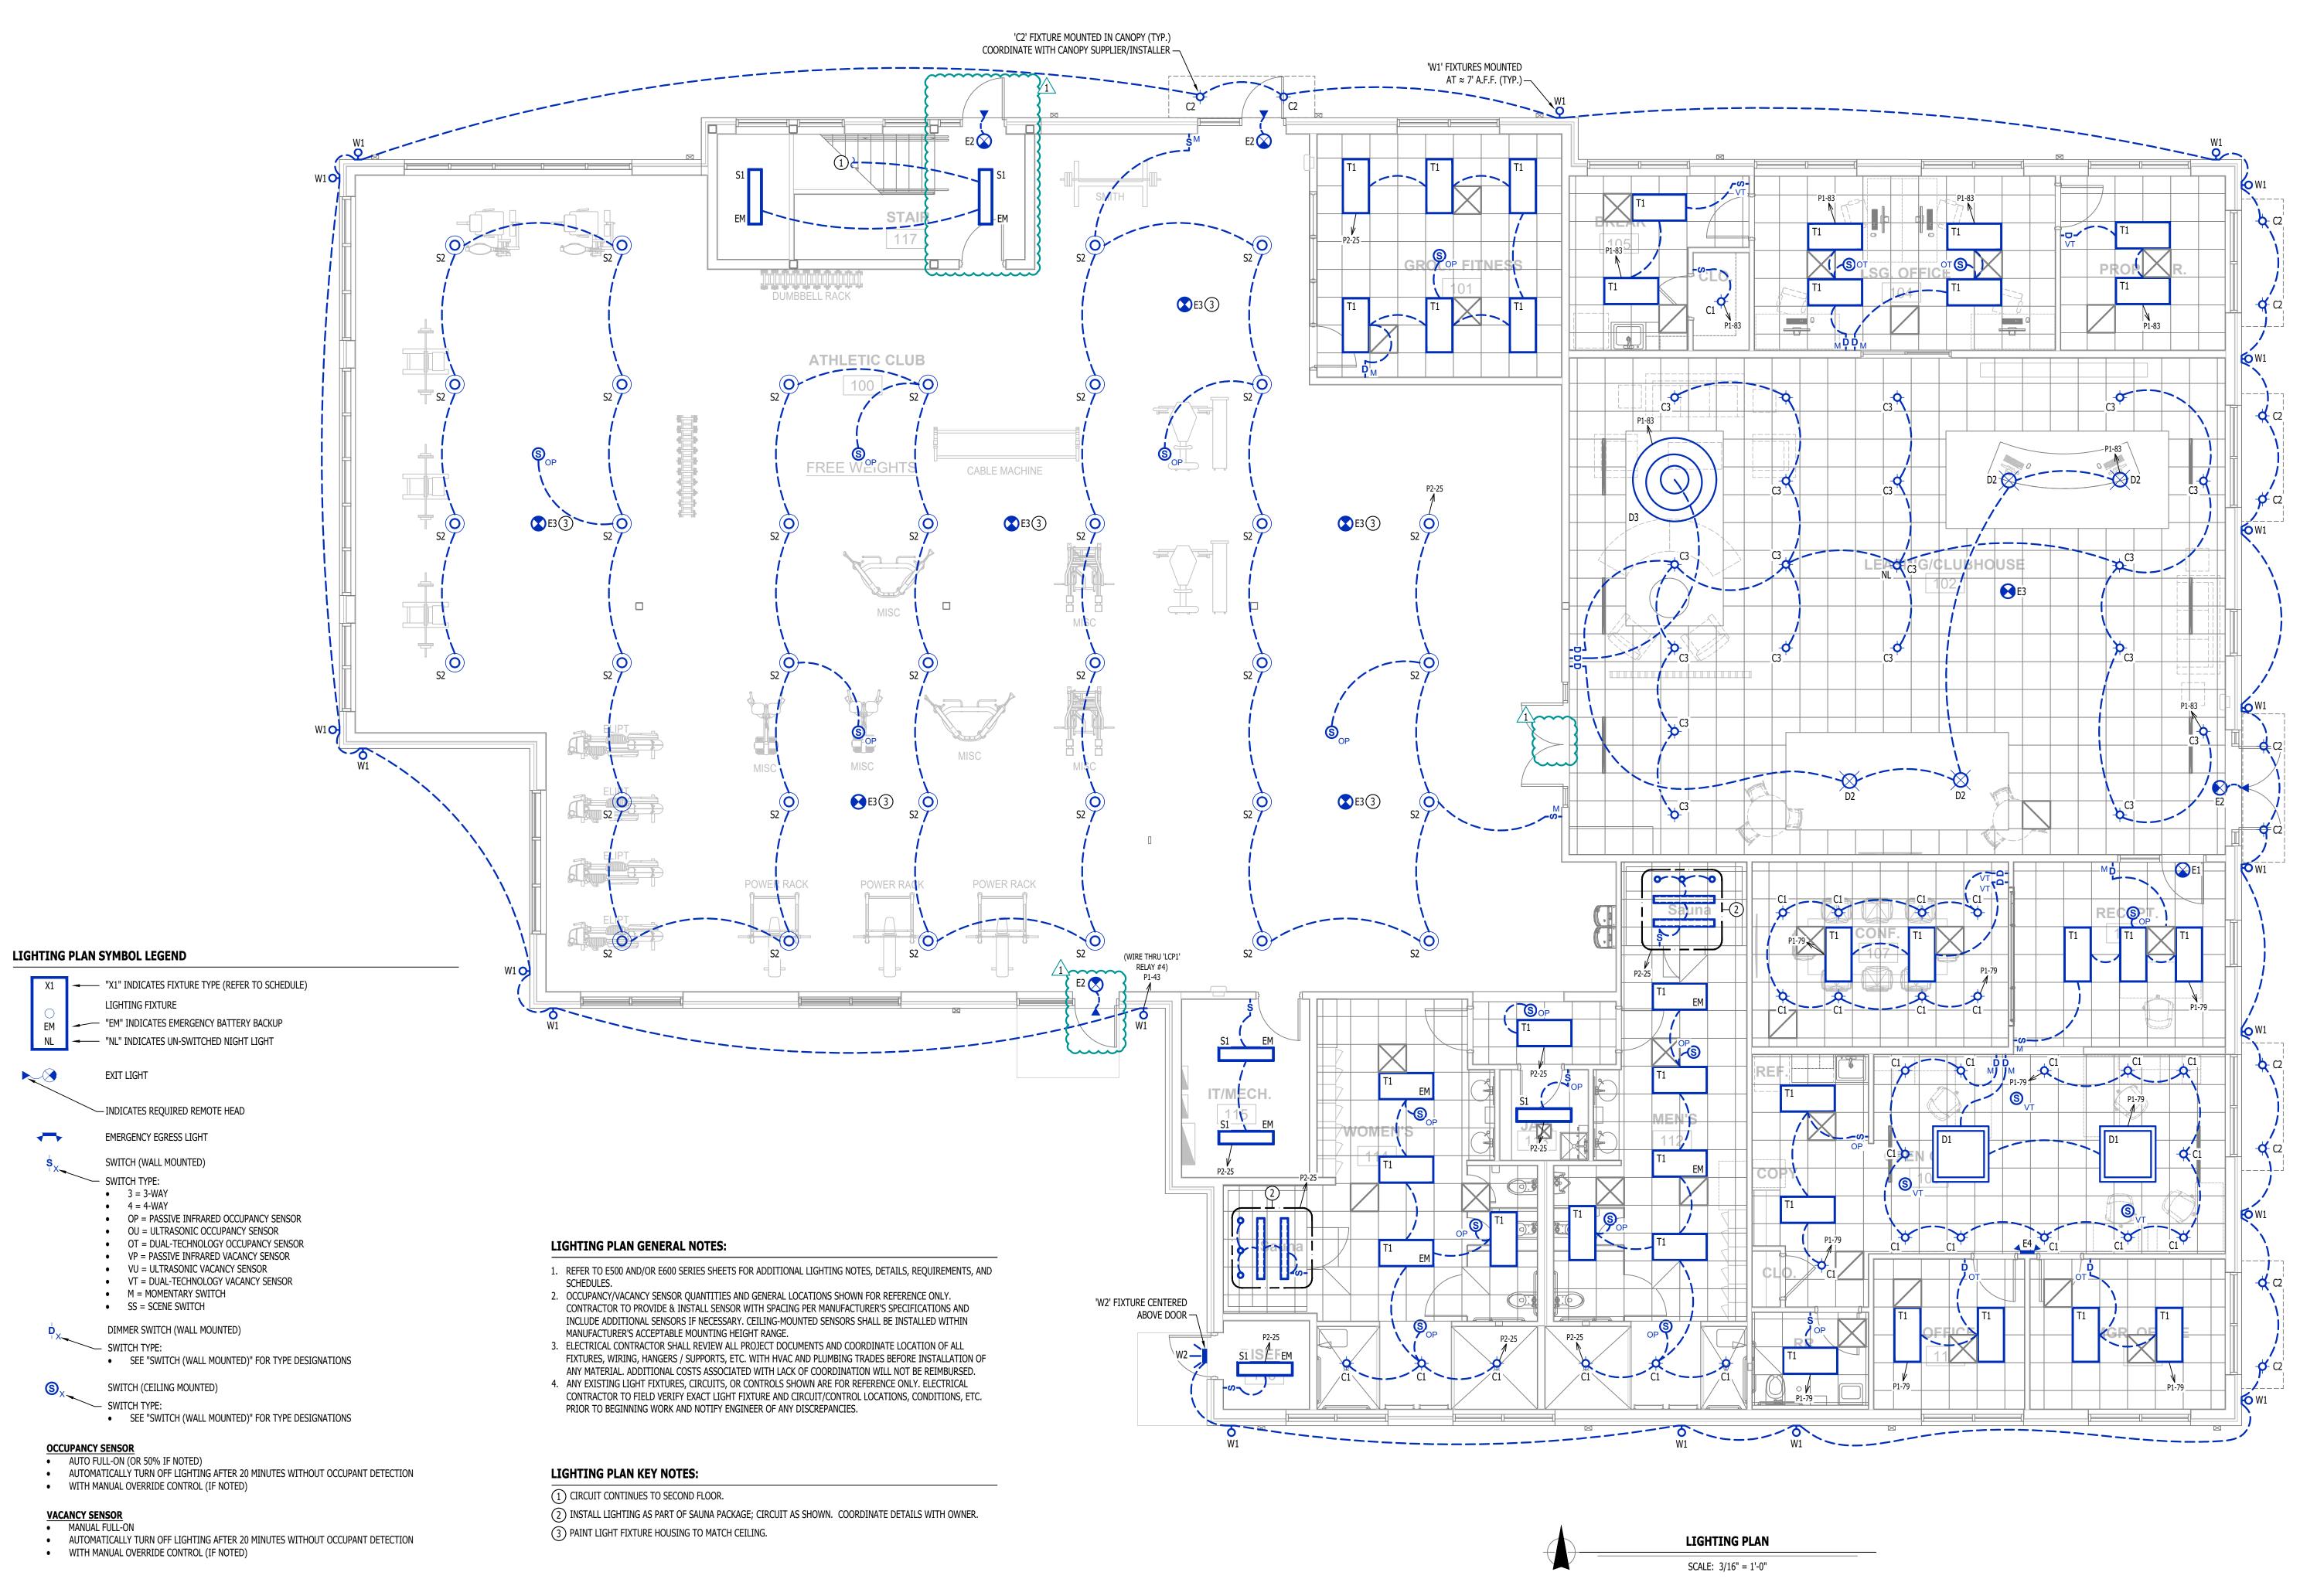

CONSTRUCTION
As Noted on Plans Review

Decod/Surfact, Missouri
Surfact, Missouri
Sur

RELEASED FOR

James Watson, P.E. August 11, 2025 PE-2015017071 MO Certificate of Authority # 2018029680



## J-SQUARED ENGINEERING

2400 Bluff Creek Drive, Suite 101 Columbia, Missouri 65201 573.234.4492 www.j-squaredeng.com

J2 PROJECT No: J21211

J2 DESIGN: ACW

ISSUE TITLE DATE

PERMIT SET 06 - 13 - 2025

s FOR: **5 & Office** 

rk Athletic Club

covery Park Athleti

AHJ APPROVAL STAMP

SHEET TITLE

LIGHTING PLAN

SHEET NUMBER

**EL101** 

#### GENERAL

- CONTRACTOR IS RESPONSIBLE TO PROVIDE ALL NECESSARY PIECES AND COMPONENTS TO PROVIDE A 1.1. COMPLETE AND COMPLIANT ELECTRICAL SYSTEM UNLESS OTHERWISE NOTED ON PLANS.
- THE ENTIRE ELECTRICAL SYSTEM SHALL BE CONTINUOUSLY GROUNDED. EVERY BRANCH CONDUIT
- SHALL INCLUDE A GREEN GROUND CONDUCTOR SIZED PER NEC. ARC-FAULT CIRCUITS SHALL BE RUN WITH A DEDICATED NEUTRAL AS REQUIRED BY MANUFACTURER.
- PROVIDE PERMANENT ARC-FLASH LABEL AFFIXED TO EVERY DISCONNECT AND PANEL. PROVIDE TYPE WRITTEN PANEL SCHEDULE FOR EACH PANEL.

- ALL ELECTRICAL SYSTEM COMPONENTS SHALL BE INSTALLED LEVEL, PLUMB, AND PARALLEL/PERPENDICULAR TO BUILDING ORIENTATION WHERE POSSIBLE.
- ALL ELECTRICAL DEVICES AND LIGHT FIXTURES SHALL BE INSTALLED IN A SAFE, FIRST-CLASS MANNER WITH ATTENTION GIVEN TO OVERALL AESTHETICS.

CARE SHOULD BE TAKEN TO ALLOW FOR FUTURE REPLACEMENT AND ACCESS FOR SERVICE.

#### 3. MATERIALS

#### 3.1. CONDUIT & CONDUCTORS

- 3.1.1. ALL CONDUCTORS SIZES INDICATED ARE COPPER UNLESS NOTED OTHERWISE ON PLANS.
- ABOVE GRADE CONDUCTORS SHALL BE TYPE THHN. BELOW GRADE CONDUCTORS SHALL BE TYPE XHHW-2.
- MINIMUM CONDUCTOR SIZE SHALL BE #12 AWG UNLESS NOTED OTHERWISE. 120-VOLT, 20-AMP CIRCUITS WITH CONDUCTOR LENGTHS GREATER THAN 100' SHALL BE #10 AWG MINIMUM. ELECTRICAL CONTRACTOR IS RESPONSIBLE FOR MEASURING ACTUAL CONDUCTOR LENGTH AND INCREASING CONDUCTOR SIZE TO COMPENSATE FOR VOLTAGE DROP AS REQUIRED BY NEC.
- RIGID GALVANIZED OR SCHEDULE 40 PVC CONDUIT SHALL BE USED FOR SERVICE WIRING, BELOW GRADE INSTALLATIONS, OR WHERE EXPOSED TO WEATHER.
- IN APPLICATIONS OTHER THAN THOSE LISTED IN 3.1.4, EMT OR MC CABLE IS ACCEPTABLE. WHERE CONDUCTORS ARE PROTECTED FROM DAMAGE, ENCLOSED IN BUILDING MATERIALS, AND CONSTRUCTION IS OF A PERMITTED TYPE, NM CABLE MAY BE USED.
- FOR CAST-IN-PLACE CONCRETE, TILT-UP WALL CONSTRUCTION, OR PRE-MANUFACTURED WALL SYSTEMS, COORDINATE EXACT LOCATIONS OF ALL DEVICES WITHIN WALLS WITH WALL SUPPLIER. CONDUIT EMBEDDED IN WALLS SHALL BE SCHEDULE 80 PVC OR LFMC, OR OTHER SYSTEM APPROVED BY WALL MANUFACTURER.
- EXPOSED CONDUIT SHALL BE PAINTED TO MATCH ADJACENT SURFACES, VERIFY COLOR WITH ARCHITECT/OWNER.

### 3.2. DEVICES

- CONTRACTOR TO PROVIDE J-BOXES, COVER PLATES, AND ANY ACCESSORIES REQUIRED TO
- PROVIDE A COMPLETE SYSTEM. SEE ARCHITECTURAL PLANS FOR DEVICE COLORS. DUPLEX RECEPTACLES SHALL BE TAMPER RESISTANT, 20-AMP, EQUAL TO LEVITON #TBR-20.
- SINGLE POLE TOGGLE WALL SWITCHES SHALL BE EQUAL TO LEVITON CS120-2. THREE-WAY TOGGLE WALL SWITCHES SHALL BE EQUAL TO LEVITON CS320-2.
- DIMMER SWITCHES SHALL BE TESTED WITH FIXTURES AND LAMPS FOR COMPATIBILITY. SEE
- LIGHTING PLANS FOR DETAILS. WHERE GFCI PROTECTION IS SHOWN ON PLANS AND UNLESS OTHERWISE NOTED, PROVIDE A LISTED GFCI-PROTECTED RECEPTACLE WHERE THE RECEPTACLE IS ACCESSIBLE ON PLANS. IF THE RECEPTACLE LOCATION IS NOT ACCESSIBLE AS DEFINED BY NEC, PROVIDE GFCI PROTECTION AT
- CIRCUIT BREAKER. DO NOT INSTALL OCCUPANCY/VACANCY SENSORS WITHIN 48" OF HVAC DIFFUSERS/GRILLES OR SIMILAR OBSTRUCTION THAT MAY AFFECT SENSOR FUNCTIONALITY. ALL SENSORS SHALL BE INSTALLED PER MANUFACTURER'S SPECIFICATIONS.
- ALL APPLICABLE SWITCHES, RECEPTACLES, CONTROLS, ETC. SHALL BE MOUNTED AT ADA-ACCESSIBLE HEIGHTS.
- WIRING DEVICES SHOWN ON PLANS NEXT TO ONE ANOTHER SHALL UTILIZE A SINGLE COVER PLATE UNLESS NOTED OTHERWISE.
- WIRING DEVICES SHOWN BACK-TO-BACK ON EACH SIDE OF A WALL SHALL BE OFFSET TO REDUCE SOUND TRANSMISSION.
- EACH RECEPTACLE COVER SHALL BE NEATLY AND LEGIBLY LABELED WITH CORRESPONDING PANEL AND CIRCUIT NUMBER FOR CIRCUIT IDENTIFICATION.

#### 4. **EMERGENCY LIGHTING**

WALL MOUNTED GROUNDING BAR

COPPER BUS BAR (1/4" x 4" x 16")


BURNDY# BBB14416H GROUND BAR

w/ INSULATORS & MOUNTING BRACKETS

- BRANCH CIRCUIT FEEDING EMERGENCY FIXTURE(S) SHALL BE SAME BRANCH CIRCUIT AS THAT SERVING
- NORMAL LIGHTING IN SAME AREA AND CONNECTED AHEAD OF ANY LOCAL SWITCHES. EMERGENCY LIGHTING SYSTEM SHALL PROVIDE 1FC AVERAGE AND 0.1FC MINIMUM ALONG EGRESS PATHS. ADJUST ANY EMERGENCY FIXTURES AS NECESSARY TO PROVIDE PROPER ILLUMINATION

WITHOUT OBSTRUCTION FROM FURNITURE OR OBSTACLES.

WATER PIPE (REQUIRED IF PRESENT)	CDOLINDING ELECTRODE CONDLICTOR (CEC) SIZED DER DISER

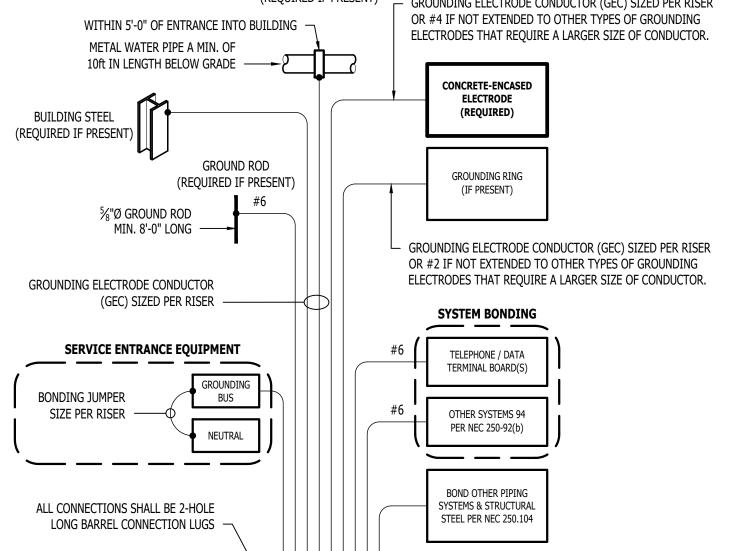

TYPICAL GROUNDING & BONDING DETAIL

	RELAY 7	# ¬		
ELECTRIC PANEL TO CIRCUIT 7	# <u>]</u>	LCI	P1	
HWR PUMP	P1-56 —	1		
EXT. SIGNAGE	P1-39 —	2		PC PHOTOCELL
EXT. SIGNAGE	P1-41	3		
EXT. LIGHTING	P1-43	4		→ WATTSTOPPER LIGHTING
EXHAUST FANS	P1-47 —	5		CONTROL PANEL "LC8"
POLE LIGHTS	P1-62 —	6		
POLE LIGHTS	P1-64	7		
LANDSCAPE LIGHTING	P1-77 —	8		

## LIGHTING CONTROL PANEL SCHEDULE

RELAY #	OVERRIDE SWITCH	OPERATIONAL SCHEDULE
1	NO	ON DURING OCCUPIED HOURS
2	NO	ON DURING NIGHT HOURS (PHOTOCELL
3	NO	ON DURING NIGHT HOURS (PHOTOCELL
4	NO	ON DURING NIGHT HOURS (PHOTOCELL
5	NO	ON CONTINUOUSLY
6	NO	ON DURING NIGHT HOURS (PHOTOCELL
7	NO	ON DURING NIGHT HOURS (PHOTOCELL
8	NO	ON DURING NIGHT HOURS (PHOTOCELL

	THIS MUST BE STAMPED ON OUTSIDE OF CABLE JACKET)
LIGHTING CONTROL PANEL	

PAD PROVIDED & INSTALLED BY CONTRACTOR;

PHONE & CABLE

(SEE CIVIL PLANS)

PEDESTALS

TRANSFORMER PROVIDED BY EVERGY -

	LIGHT FIXTURE SCHEDULE										
TAG	MA NUFA CTURER MODEL NUMBER (OR EQUAL) (OR EQUAL)		DESCRIPTION	MOUNTING	LUMEN OUTPUT	сст (°к)	CCT (°K) CRI	VOLTAGE	WATTS	DIMMING	NOTES
C1	HALO	SLD6129SE010MWR	6" LED SURFACE CAN	SURFACE / CEILING	1200	3500	90	120	15	0 - 10V	
C2	HALO	SLD6129SE010MWR	6" LED SURFACE CAN	SURFACE / CANOPY	1200	4000	90	120	15	0 - 10V	
C3	HALO	HC6-50-D010 / HM6-4560-835-61-WD-H	6" RECESSED DOWNLIGHT	RECESSED / CEILING	5000	3500	80	120	40	0 - 10V	
D1	-	-	DECORATIVE EXECUTIVE OFFICE PEDNANT	PENDANT	-	-	-	120	100 MAX	-	SELECTED BY OWNER
D2	-	-	DECORATIVE CLUBHOUSE PENDANT	PENDANT	-	-	-	120	75 MAX	-	SELECTED BY OWNER
D3	-	-	DECORATIVE LEASING DESK PENDANT	PENDANT	-	-	-	120	200 MAX	-	SELECTED BY OWNER
E1	SURE LITES	APCH7R	INTERIOR EXIT LIGHT WITH HEADS	WALL / CEILING	-	-	-	120	1	-	WITH RED LETTERS
E2	SURE LITES	APCH7R WITH APWR2	INTR EXIT LIGHT WITH EXTR RMT HD	CEILING	-	-	-	120	1	-	WITH RED LETTERS
E3	SURE LITES	SELRA50SD	RECESSED EMERGENCY LIGHT	RECESSED / CEILING	-	-	-	120	3	-	
E4	SURE LITES	SEL60R4SD	EMERGENCY EGRESS LIGHT	WALL	-	-	-	120	2	-	
S1	METALUX	RSLSTP4040DD-UNV	4' LED STRIP	WALL / CEILING	5210	4000	80	UNV	39	0 - 10V	WITH 'EBPLED14W' BATTERY BACKUP WHERE INDICATED
S2	SPECTRUM LIGHTING	PRSUR16GV-55L-35K-DS10X-FS-SM-DF16	16" LED MIDBAY	SURFACE / CEILING	4832	3500	80	120	39	0 - 10V	
T1	METALUX	24FPSL2SCT3	2x4 LED FLAT PANEL	CEILING / GRID	4550	3500	80	120	40	0 - 10V	
W1	TECH LIGHTING	7000WVEX9404ZUNV	UP/DOWN WALL SCONCE	EXTERIOR WALL	554	4000	90	120	19	-	
W2	LUMARK	XTOR2B-W	EXTERIOR WALLPACK	EXTERIOR WALL	2103	4000	70	120	18	-	

- 1. VERIFY LIGHT FIXTURE FINISHES WITH OWNER / ARCHITECT PRIOR TO INSTALLATION.
- 2. REFER TO ARCHITECTURAL REFLECTED CEILING PLAN FOR CEILING TYPES THROUGHOUT. COORDINATE EXACT MOUNTING DETAILS WITH GENERAL CONTRACTOR.
- 3. CONTACT JUSTIN HATFIELD (573) 289-0880 (JHATFIELD@LAIWEB.NET) OR PAUL WARNER (314) 531-3500 (PWARNER@LAIWEB.NET) AT LIGHTING ASSOCIATES FOR NATIONAL ACCOUNT DETAILS.
- 4. CONTACT TRAVIS VOGT (471) 621-5210 (TVOGT@CED1135.COM) AT CED-PHILLIPS & COMPANY FOR NATIONAL ACCOUNT DETAILS.

	BRANCH	CIRCUI	T CONDU	CTOR SC	HEDULE			
	COPPED ANG		MAXIMUM DISTANCE (FEET)					
AMPACITY	COPPER AWG SIZE	1	ιØ	3	3Ø			
		120V	277V	208V	480V	CONDUIT SIZE		
20	12	55'	130'	115'	260'	1/2"		
20	10	90'	205'	180'	415'	3/4"		
30	10	60'	135'	120'	275'	3/4"		
30	8	95'	220'	190'	445'	1"		
35	8	80'	190'	165'	380'	1"		
35	6	130'	300'	260'	605'	1"		
40	8	70'	165'	145'	330'	1"		
	6	110'	260'	225'	525'	1"		
45	6	100'	235'	200'	470'	1'		
43	4	160'	370'	325'	750'	1-1/4"		
50	6	90'	210'	180'	420'	1-1/4"		
50	4	145'	335'	290'	675'	1-1/4"		
60	6	75'	175'	150'	350'	1-1/4"		
60	4	120'	280'	240'	560'	1-1/4"		
70	4	105'	240'	205'	480'	1-1/4"		
70	3	130'	300'	260'	605'	1-1/4"		
80	4	55'	210'	180'	420'	1-1/4"		
80	3	90'	260'	230'	530'	1-1/4"		
90	3	100'	235'	200'	470'	1-1/4"		
90	2	125'	295'	255'	595'	1-1/4"		
100	3	90'	210'	180'	420'	1-1/4"		
100	2	115'	265'	230'	535'	1-1/4"		

- 1. ALL BRANCH CIRCUIT CONDUCTORS SHALL BE COPPER. ALL WIRE SIZES SHOWN ARE BASED ON CONDUCTOR TEMPERATURE RATING OF 75°C & AMBIENT TEMPERATURE OF 30°C PER NEC.
- 2. DISTANCE SHOWN ABOVE IS LENGTH FROM OVERCURRENT PROTECTION TO DEVICE/EQUIPMENT.
- 3. REFER TO PLAN SHEETS FOR BRANCH CONDUCTOR SIZING LENGTHS GREATER THAN SHOWN ABOVE. 4. VOLTAGE DROP CALCULATIONS BASED ON 3% DROP, 80% CIRCUIT LOAD, THHN/THWN INSULATION, 100% POWER FACTOR, BALANCED LOAD, NEGLIGIBLE REACTANCE, & SIX OR LESS CURRENT-CARRYING CONDUCTORS IN RACEWAY.

208Y/120V, 3PH,

PAD-MOUNTED

TRANSFORMER

CT CABINET & METER PER

(2) 4" CONDUITS WITH EITHER:

(4) #350 CU. OR (4) #500 AL. IN EACH

(ALUMINUM AS ALTERNATE BID; ALUMINUM

CONDUCTORS ARE REQUIRED TO BE AA\_8000 SERIES.

FEEDER CONDUCTOR SCHEDULE									
			CONDUCTORS	EQUIPMEN	MINIMUM				
AMPACITY	# OF SETS	QUANTIT	Y PER SET	AWG	SIZE	AWG	CONDUIT SIZE		
	# OI 3LI3	3Ø 'WYE'	1Ø OR 3Ø▲	COPPER	ALUMINUM	COPPER	ALUMINUM	(PER SET)	
30	1	4	3	10	8	10	8	3/4"	
40	1	4	3	8	8	8	8	1"	
45	1	4	3	8	6	8	8	1"	
50	1	4	3	8	6	10	8	1"	
60	1	4	3	6	4	10	6	1"	
70	1	4	3	4	2	8	6	1-1/4"	
80	1	4	3	4	2	8	6	1-1/4"	
90	1	4	3	3	2	8	6	1-1/4"	
100	1	4	3	3	1	8	6	1-1/4"	
110	1	4	3	2	1/0	6	4	1-1/4"	
125	1	4	3	1	2/0	6	4	2"	
150	1	4	3	1/0	3/O	6	4	2"	
175	1	4	3	2/0	4/0	6	4	2"	
200	1	4	3	3/0	250	6	4	2-1/2"	
225	1	4	3	4/0	300	4	2	2-1/2"	
250	1	4	3	250	350	4	2	3"	
300	1	4	3	350	500	4	2	4"	
350	1	4	3	400	600	3	1	4"	
400	1	4	3	500	750	3	1	4"	
500	2	4	3	250	350	2	1/0	4"	
600	2	4	3	350	500	1	2/O	4"	
800	2	4	3	500	750	1/0	3/0	4"	
1000	3	4	3	400	350	2/0	4/0	4"	
1200	4	4	3	350	500	3/0	250	4"	
1600	5	4	3	400	750	4/0	350	4"	
2000	6	4	3	400	750	250	400	4"	

"P1"

208Y/120V, 3PH,

600A, MCB

ELECTRICAL PANEL

(2) 3" CONDUITS WITH

(4) #350 CU IN EACH-

CABINET

- 1. ALL WIRE SIZES SHOWN ARE BASED ON CONDUCTOR TEMPERATURE RATING OF 75°C & AMBIENT TEMPERATURE RATING OF 30°C PER NEC. 2. MAXIMUM ALLOWABLE VOLTAGE DROP FOR FEEDER CONDUCTORS SHALL BE 2%.
- 3. ELECTRICAL CONTRACTOR TO ADJUST CONDUCTOR SIZES FOR LONG CIRCUIT LENGTHS & AMBIENT TEMPERATURES HIGHER THAN 30°C.

DEMARC

DEMARC

#### **POWER RISER GENERAL NOTES:**

- 1. COORDINATE DETAILS & REQUIREMENTS OF NEW ELECTRIC SERVICE WITH EVERGY.
- ALL NEW METERING EQUIPMENT MUST BE APPROVED BY EVERGY.
- EACH METER MUST BE PERMANENTLY LABELED.
- 4. AIC-RATINGS BASED ON: 4.1. TRANSFORMER: 225kVA, 100% POWER FACTOR, 3.50% Z,
- LOCATED APPROXIMATELY WHERE SHOWN ON PLANS. METER LOCATION INSTALLED APPROXIMATELY WHERE SHOWN ON
- ELECTRICAL PANEL LOCATION INSTALLED APPROXIMATELY WHERE
- SHOWN ON PLANS. CONTRACTOR TO FIELD VERIFY FINAL EQUIPMENT LOCATIONS

AND PERFORM ADDITIONAL AIC RATING CALCULATIONS IF

**EVERGY SPECIFICATIONS** (1) SPARE 4" CONDUIT — #2/O CU. GROUNDING W/ PULL-STRING — ELECTRODE CONDUCTOR 3" CONDUIT WITH PULL-STRING —

**POWER RISER** 

☐1¼" CONDUIT WITH

208Y/120V, 3PH,

100A, MLO

**ELECTRICAL PANEL** 

(4) #3 CU. & (1) #8 CU. EQ. GRD.

**ELECTRICAL DETAILS &** 

**SCHEDULES** 

SHEET NUMBER

RELEASED FOR CONSTRUCTION As Noted on Plans Review

James Watson, P.E. June 13, 2025 PE-2015017071 MO Certificate of Authority # 2018029680

J-SQUARED ENGINEERING

> 2400 Bluff Creek Drive, Suite 101 Columbia, Missouri 65201 573.234.4492 www.j-squaredeng.com

J2 PROJECT No: J2 DESIGN: ACW

ISSUE TITLE DATE PERMIT SET 06 - 13 - 2025

O P

P

**COV** 

AHJ APPROVAL STAMP

SHEET TITLE

PA NEL SPECIFICA TIONS								TOTAL CONNECTED LO	OA D
VOLTAGE: 120/208V 3-PH   NEMA RATING: 1								PHASE "A" LOAD: 35	
AMPACITY: 600A MCB PANEL MOUNTING: SURFACE							PHASE "B" LOAD: 37		
	RATING: 22kA	TAILLITOONING	JON ACL					PHASE "C" LOAD: 34	
CIRCUIT	DESCRI	PTION	BREAKER SIZE	AMPS	PHASE	AMPS	BREAKER SIZE	DESCRIPTION	CIRCUIT
1	ROOFTOP R	ECEPTS.	20-1	3	Α	61	80-3	RTU-1	2
3	EXTERIOR R	ECEPTS.	20-1	4.5	В	61	-	-	4
5	EXTERIOR R	ECEPTS.	20-1	3	С	61	-	-	6
7	BREAK ROOM	RECEPTS.	20-1	4.5	Α	39	60-3	RTU-2	8
9	LEASING OFFIC		20-1	4.5	В	39	-		10
11	LEASING OFFIC		20-1	7.5	С	39	-	-	12
13	COMM. LEASING MANAG		20-1	9	A	10	20-1	F-1	14
15	LEASING AREA		20-1	7.5	В	20	35-2	CU-1	16
17	LEASING AREA		20-1	9	C	20	-	-	18
19	LEASING COFFEE ST		20-1	1.5	A	24	40-2	CU-2	20
21	LEASING AREA		20-1	7.5	В	24	-	-	22
23	RESTROOM I		20-1	3	C	12	20-1	F-2	24
25	LEASING COFFEE ST		20-1	1.5	A	14	20-1	F-3	26
27	RESTROOM I		20-1	3	В	24	60-2	CU-3	28
29	RESTROOM		20-1	4.5	С	24	-	-	30
31	HAND DI		20-1	8	A	18	30-2	CU-4	32
33	HAND DI		20-1	8	В	18	-	-	34
35	SPAR		20-1	0	С	10	20-1	- F-4	36
37	ACCESS CC		20-1	8		14	20-1	WALL HEATER	38
39	EXTERIOR S		20-1	5	A B	14	20-2	WALL REATER	40
				5	С	24	30-2	MENS SAUNA	40
41	EXTERIOR S		20-1					MENS SAUNA	
43	EXTERIOR L		20-1	5	A	24	- 20.2	- NAMORATRIC CALIRIA	44
45	RISER ROOM		20-1	3	В	24	30-2	WOMENS SAUNA	46
47	EF-:		20-1	5	C	24	-	-	48
49	CONFERENCE		20-1	10.5	A	14	20-2	WALL HEATER	50
51	RECEPTION I		20-1	9	В	14	-	-	52
53	OPEN OFFICE		20-1	7.5	С	5	20-1	WH-1	54
55	OPEN OFFICE		20-1	6	A	2	20-1	RECIRCULATION PUMP	56
57	BREAK ROOM COUNT		20-1	1.5	В		20-1	SPARE	58
59	BREAK ROOM RE		20-1	8	С		20-1	SPARE	60
61	PRINTER/0		20-1	8	A	4	20-2	POLE LIGHTS	62
63	PRINT ARE	-	20-1	3	В	4	-		64
65	RESTROOM		20-1	1.5	С			OPEN	66
67	OFFICE RE		20-1	6	A			OPEN	68
69	MGR. OFFICE		20-1	6	В			OPEN	70
71	BREAK ROOM RE		20-1	8	С			OPEN	72
73	BREAK ROOM COUN		20-1	3	Α			OPEN	74
75	WH-		20-1	15	В			OPEN	76
77	LANDSCAPE		20-1	5	С			OPEN	78
79	OFFICE AREA		20-1	7	Α	50	100-3	SUB-FEED PANEL 'P2'	80
81	FAC		20-1	1	В	53.5	-	<u> </u>	82
83	CLUBHOUSE AR	EA LIGHTING	20-1	7	С	52	-	-	84

A: PANEL SHALL BE EQUAL TO SQUARE D MODEL "NQ"

B: ELECTRICIAN SHALL VERIFY EXACT EQUIPMENT OVERCURRENT PROTECTION REQUIREMENTS PRIOR TO PURCHASE & INSTALLATION OF EQUIPMENT.

C: AFTER COMPLETION OF WORK, ELECTRICAN SHALL PROVIDE A TYPE WRITTEN PANEL DIRECTORY IN NEW PANEL.

			PA	NEL '	P2' S0	CHED	ULE				
PANEL SPECIFICATIONS									TOTAL CONNEC	TED LO	AD
VOLTAGE: 120/208V 3-PH NEMA RATING: AMPACITY: 100A MLO PANEL MOUNTING: AIC-RATING: 10kA									PHASE "A" LOAD:	50	AMPS
									PHASE "B" LOAD:	53.5	AMPS
									PHASE "C" LOAD:	52	AMPS
CIRCUIT NUMBER	DESCRIPTION		BREAKER SIZE	AMPS	PHASE	AMPS	BREAKER SIZE		DESCRIPTION		CIRCUIT NUMBER
1	GROUP FITNES	SS RECEPTS.	20-1	7.5	Α		20-1		SPARE		2
3	FITNESS AREA RECEPTS.		20-1	6	В	14	20-2	V	WALL HEATER		
5	FITNESS AREA RECEPTS.		20-1	6	С	14	20-1		-		
7	FITNESS AREA RECEPTS.		20-1	9	Α	14	25-2	STAIR MIN	STAIR MINI-SPLIT (FCU-1 / HP-1)		8
9	MECHANICAL ROOM RECEPTS.		20-1	4.5	В	14	-		<u>-</u>		10
11	FITNESS EQUIPMENT		20-1	10	С		20-1		SPARE		12
13	FITNESS EQUIPMENT		20-1	10	Α		20-1	SPARE			14
15	FITNESS EQUIPMENT		20-1	10	В		20-1	SPARE			16
17	FITNESS EQUIPMENT		20-1	10	С		20-1	SPARE			18
19	FITNESS ARE	A RECEPTS.	20-1	4.5	Α				OPEN		20
21	DRINKING I	FOUNTAIN	20-1	5	В				OPEN		22
23	FITNESS I	IGHTING	20-1	12	С				OPEN		24
25	GROUP FITNESS / RE	STROOMS LIGHTING	20-1	5	Α				OPEN		26
27	SPA	RE	20-1		В				OPEN		28
29	SPA	RE	20-1		С				OPEN		30

#### NOTES:

- A: PANEL SHALL BE EQUAL TO SQUARE D MODEL "QO"
- B: ELECTRICIAN SHALL VERIFY EXACT EQUIPMENT OVERCURRENT PROTECTION REQUIREMENTS PRIOR TO PURCHASE & INSTALLATION OF EQUIPMENT.
- C: AFTER COMPLETION OF WORK, ELECTRICAN SHALL PROVIDE A TYPE WRITTEN PANEL DIRECTORY IN NEW PANEL.

RELEASED FOR CONSTRUCTION
As Noted on Plans Review

Processing Services Department Missouri

Processing Services Depart

James Watson, P.E. June 13, 2025 PE-2015017071 MO Certificate of Authority # 2018029680



## J-SQUARED ENGINEERING

2400 Bluff Creek Drive, Suite 101 Columbia, Missouri 65201 573.234.4492 www.j-squaredeng.com

J2 PROJECT No: J21211

J2 DESIGN: ACW

ISSUE TITLE DATE

PERMIT SET 06 - 13 - 2025

# & Office

SIC CIUD &

ery Park Athletic


AHJ APPROVAL STAMP

SHEET TI

ELECTRICAL SCHEDULES

SHEET NUM

E502

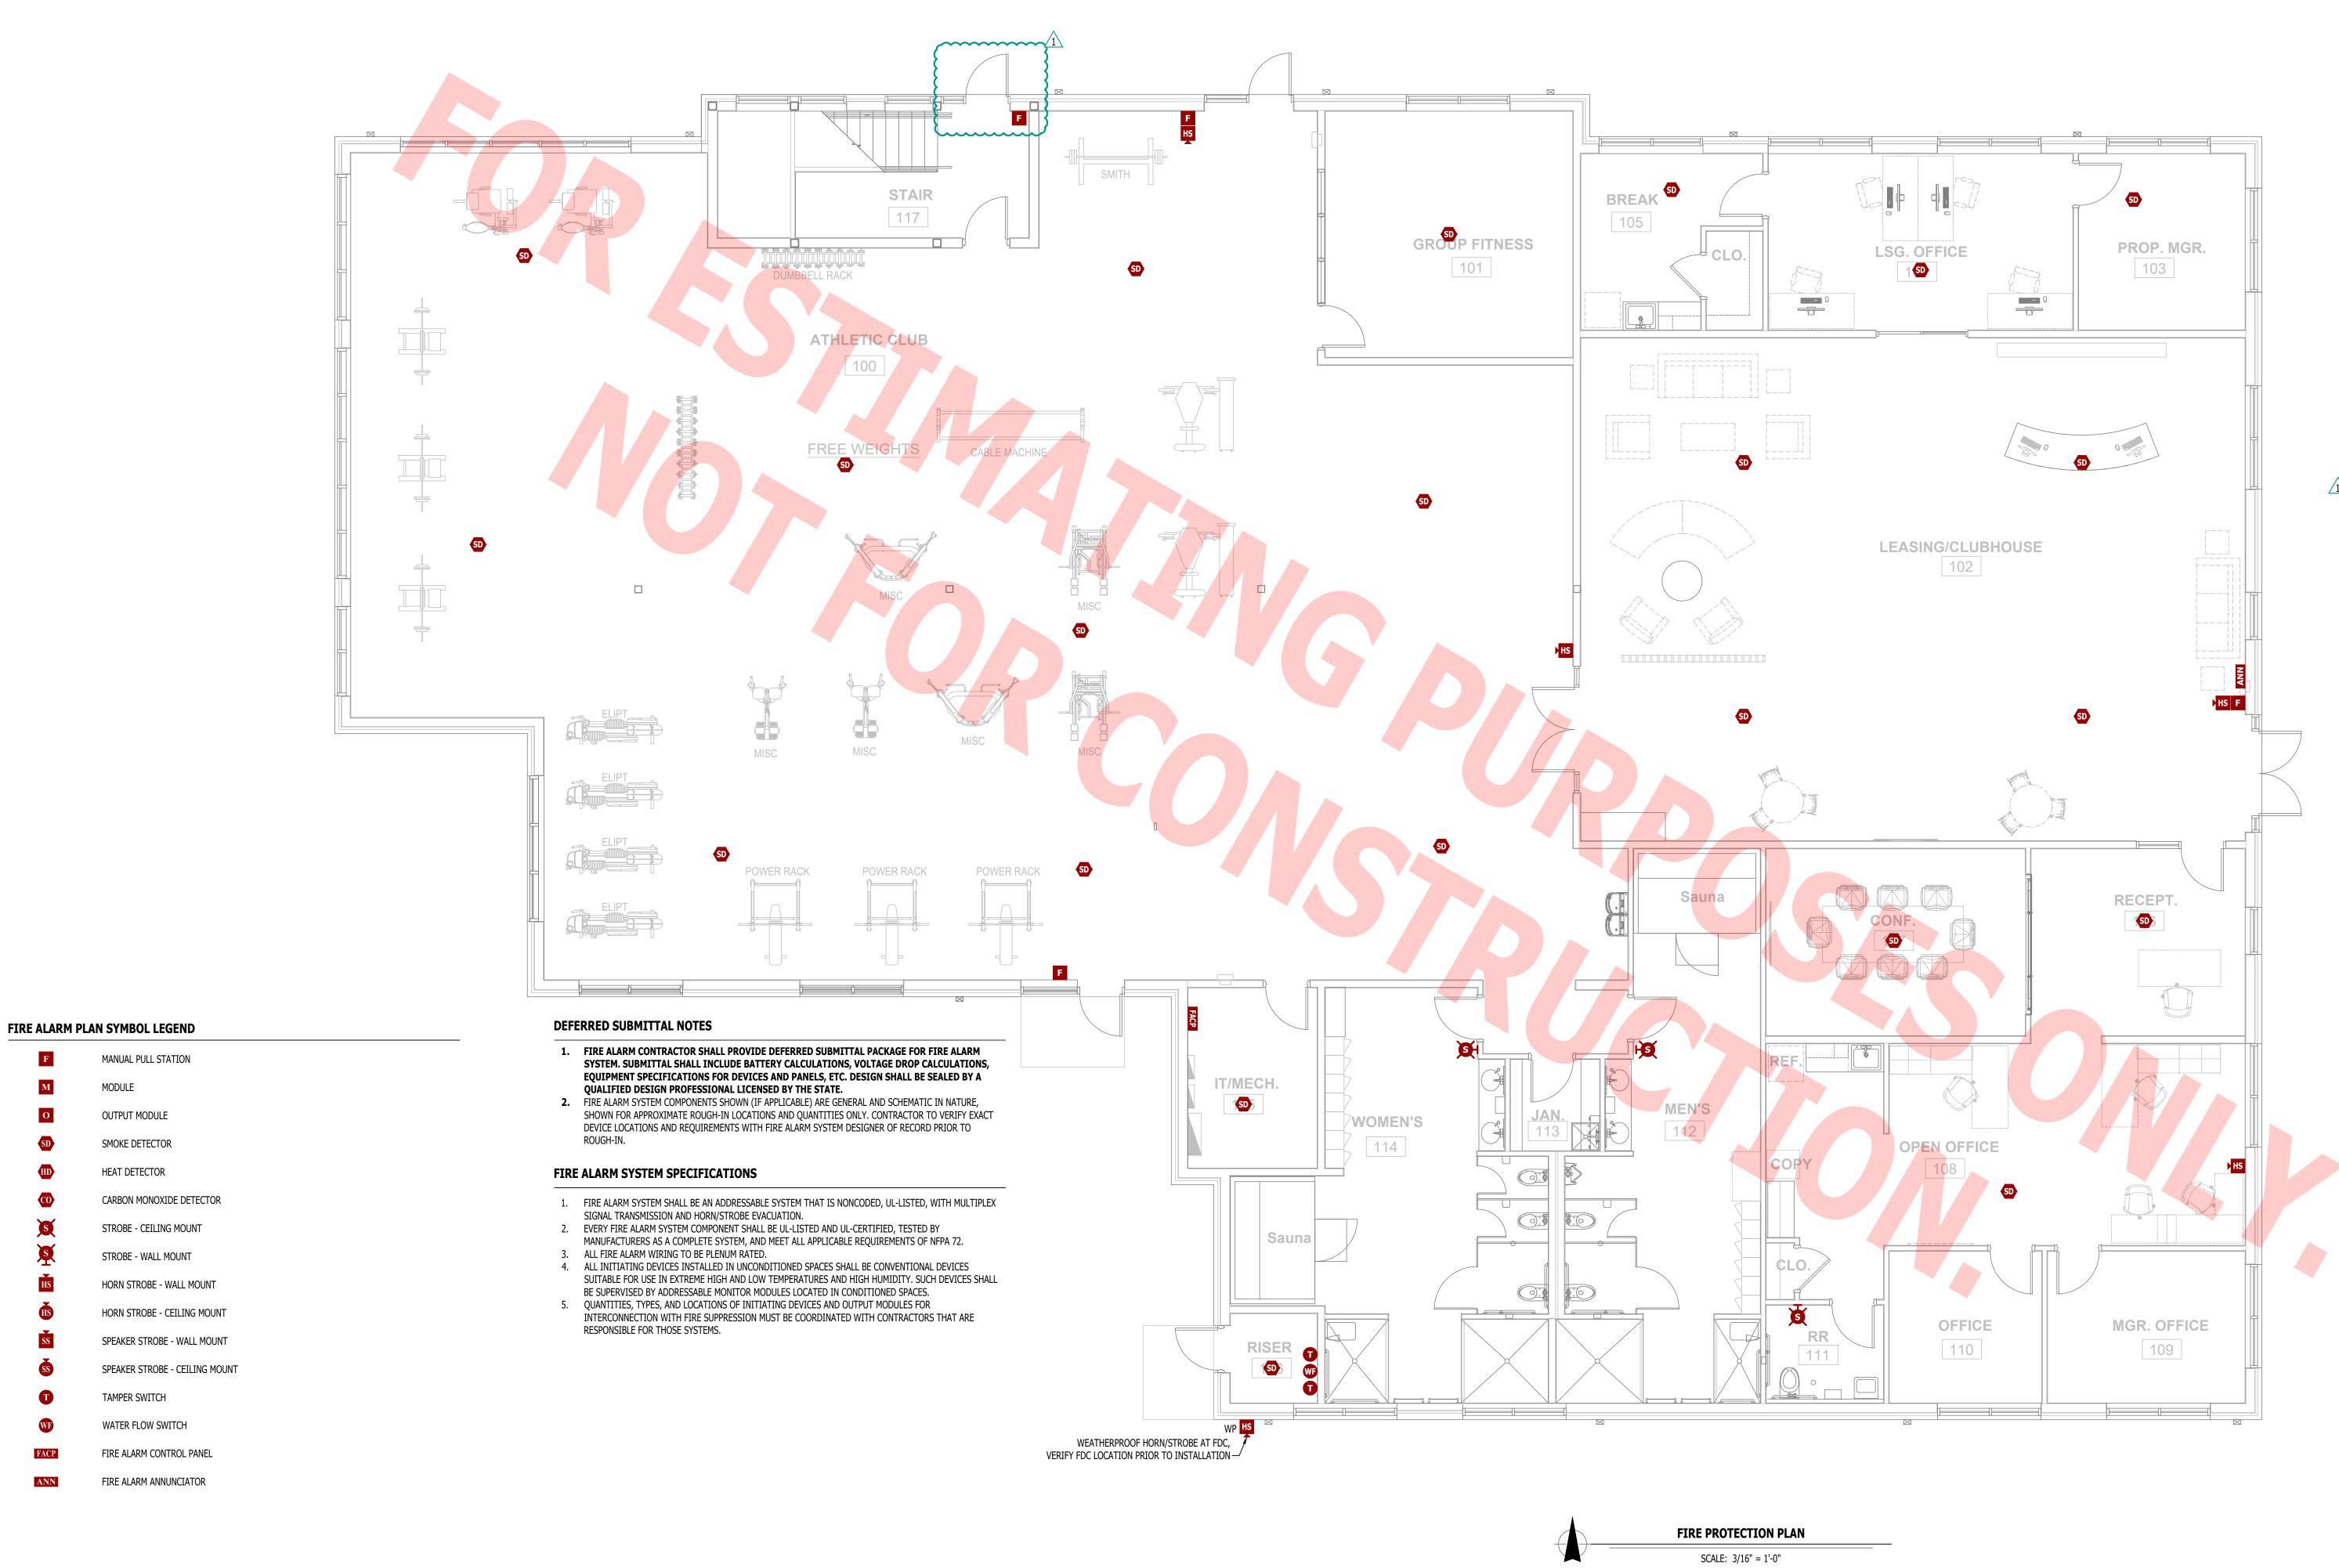

RELEASED FOR
CONSTRUCTION
As Noted on Plans Review



J-SQUARED **ENGINEERING** 

2400 Bluff Creek Drive, Suite 101 Columbia, Missouri 65201 573.234.4492

www.j-squaredeng.com J2 PROJECT No: J2 DESIGN:

ISSUE TITLE PERMIT SET

06 - 13 - 2025 08 / 11 / 2025 CITY COMMENTS

ංජ qn O


4 Q Discove

AHJ APPROVAL STAMP

SHEET TITLE

**FIRE PROTECTION** PLAN

SHEET NUMBER

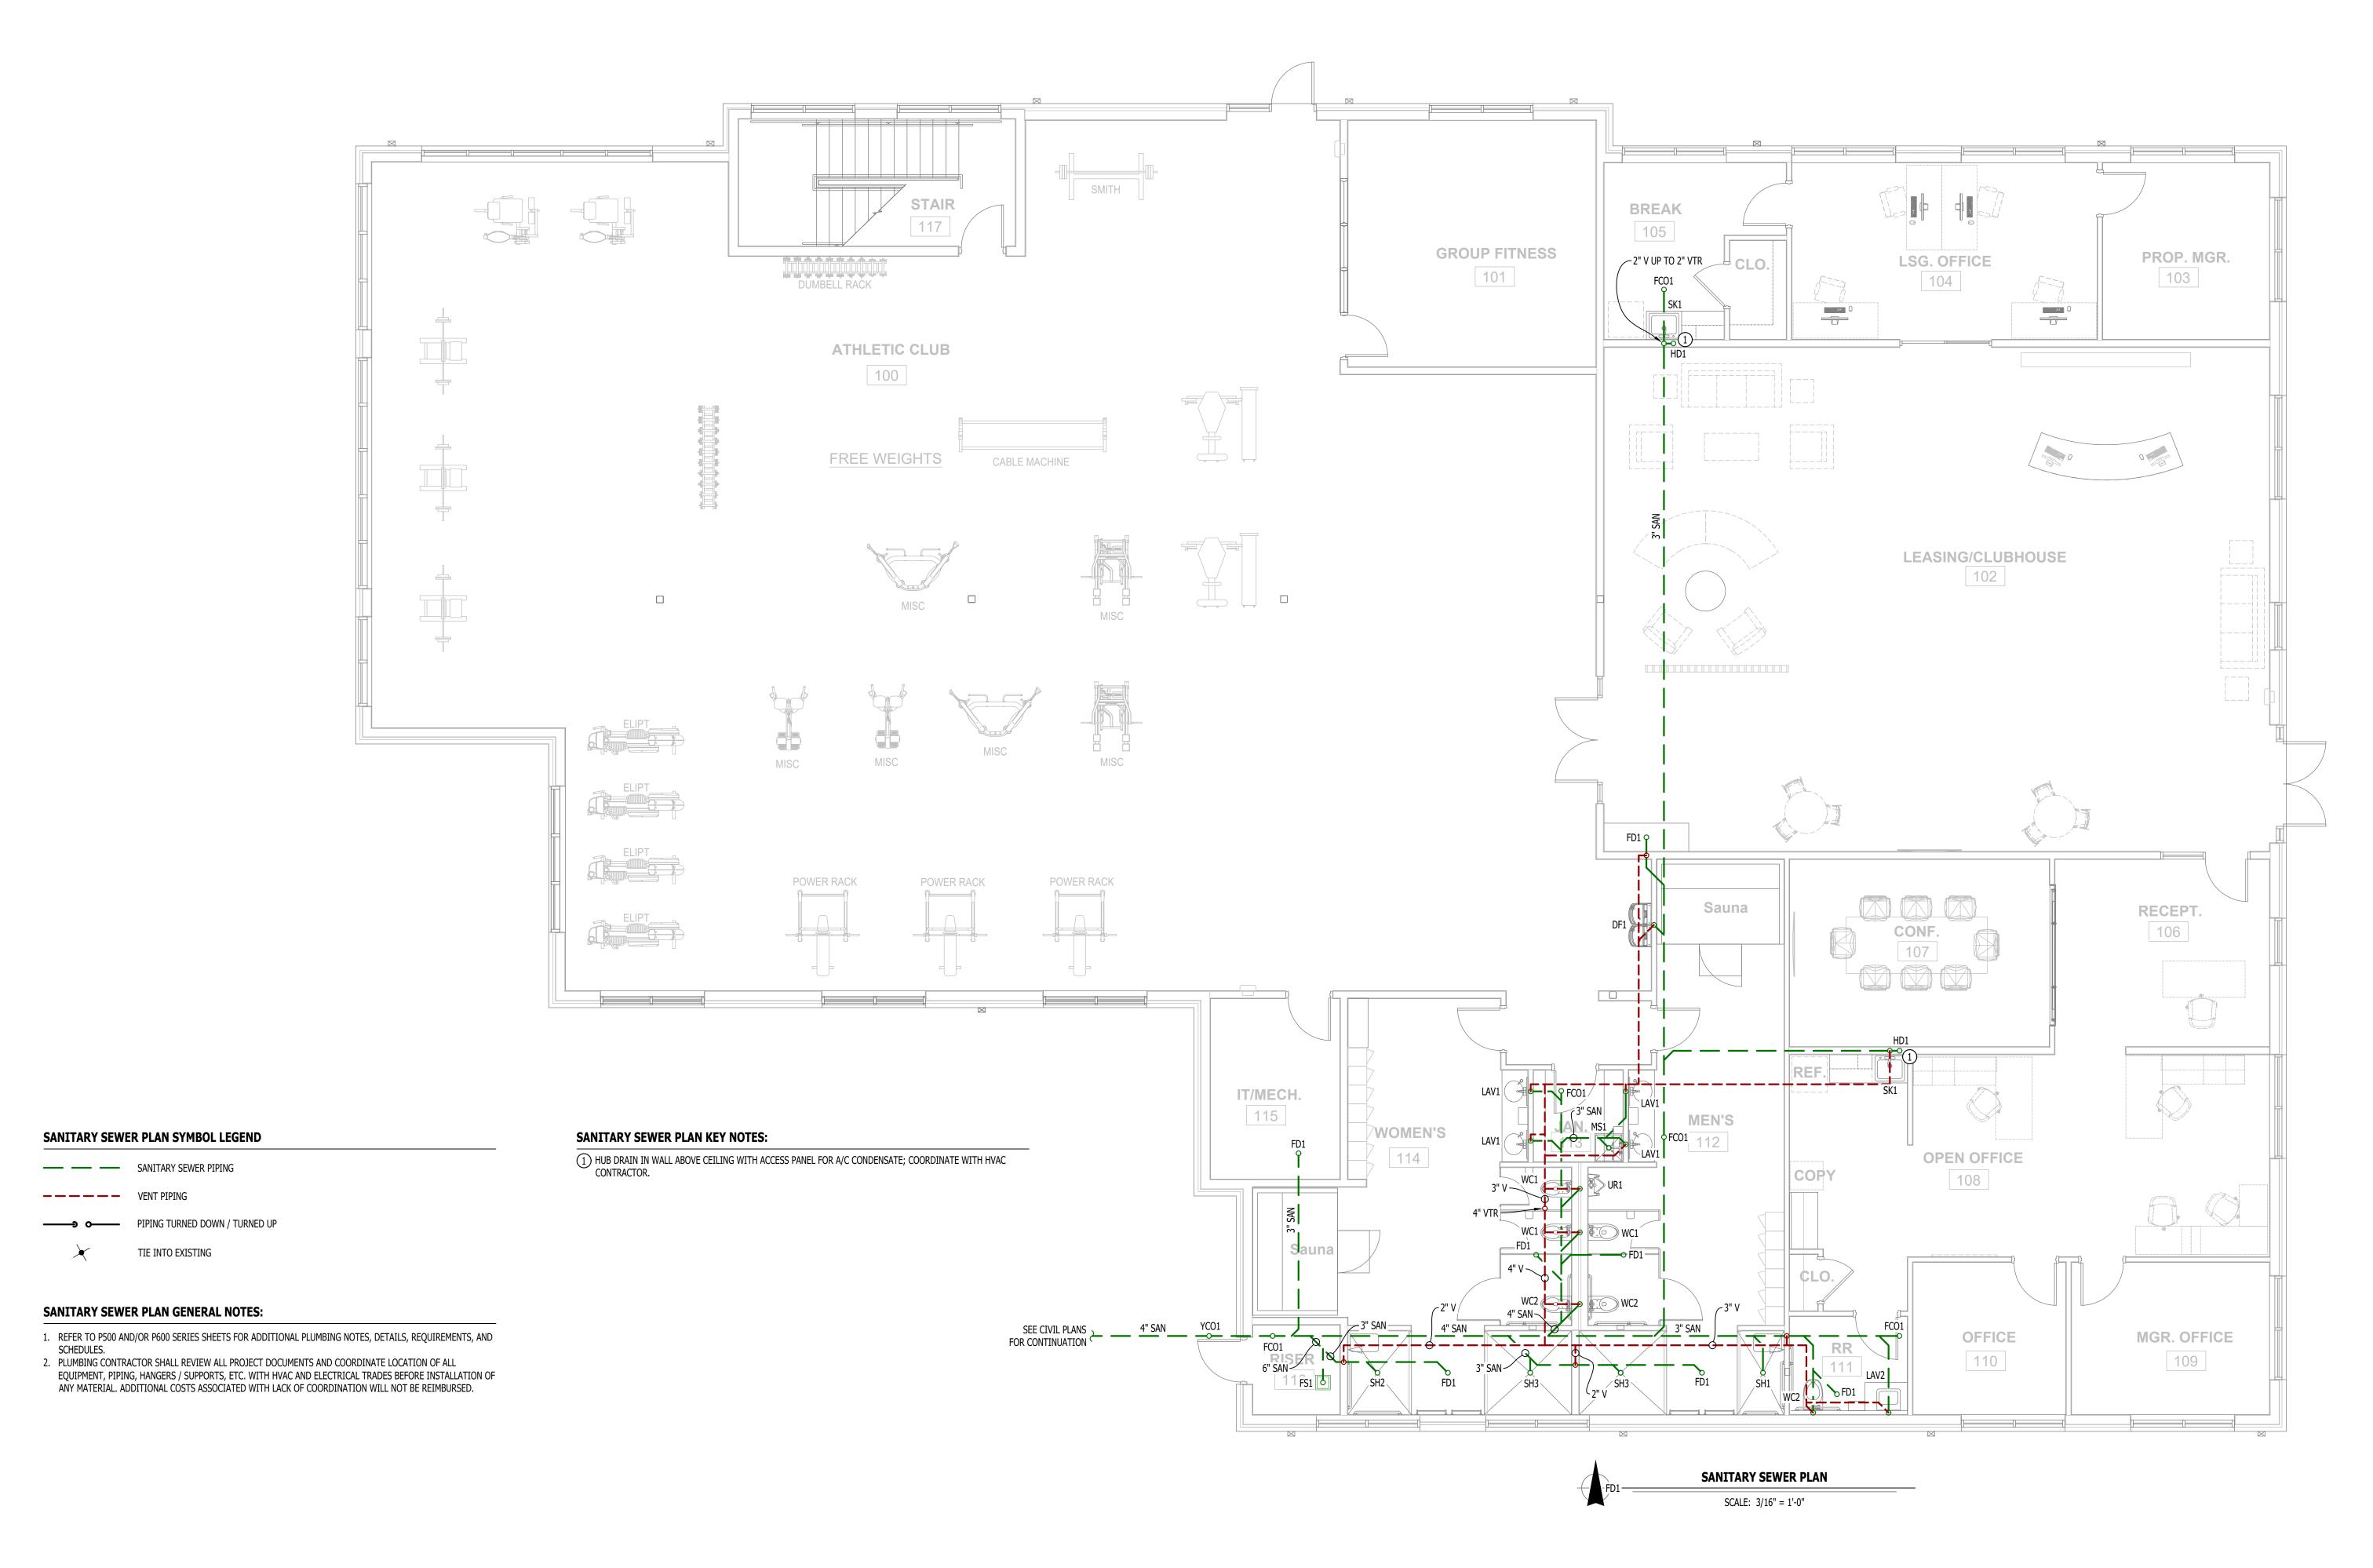

RELEASED FOR
CONSTRUCTION
As Noted on Plans Review

James Watson, P.E. June 13, 2025 PE-2015017071 MO Certificate of Authority # 2018029680



J-SQUARED ENGINEERING

2400 Bluff Creek Drive, Suite 101 Columbia, Missouri 65201 573.234.4492

www.j-squaredeng.com J2 PROJECT No: J2 DESIGN:

ACW ISSUE TITLE DATE 06 - 13 - 2025

PERMIT SET

**Office** ංජ qn O **Athletic** 


Q 

Discovery

AHJ APPROVAL STAMP

**SANITARY SEWER PLAN** 

**PS101** 

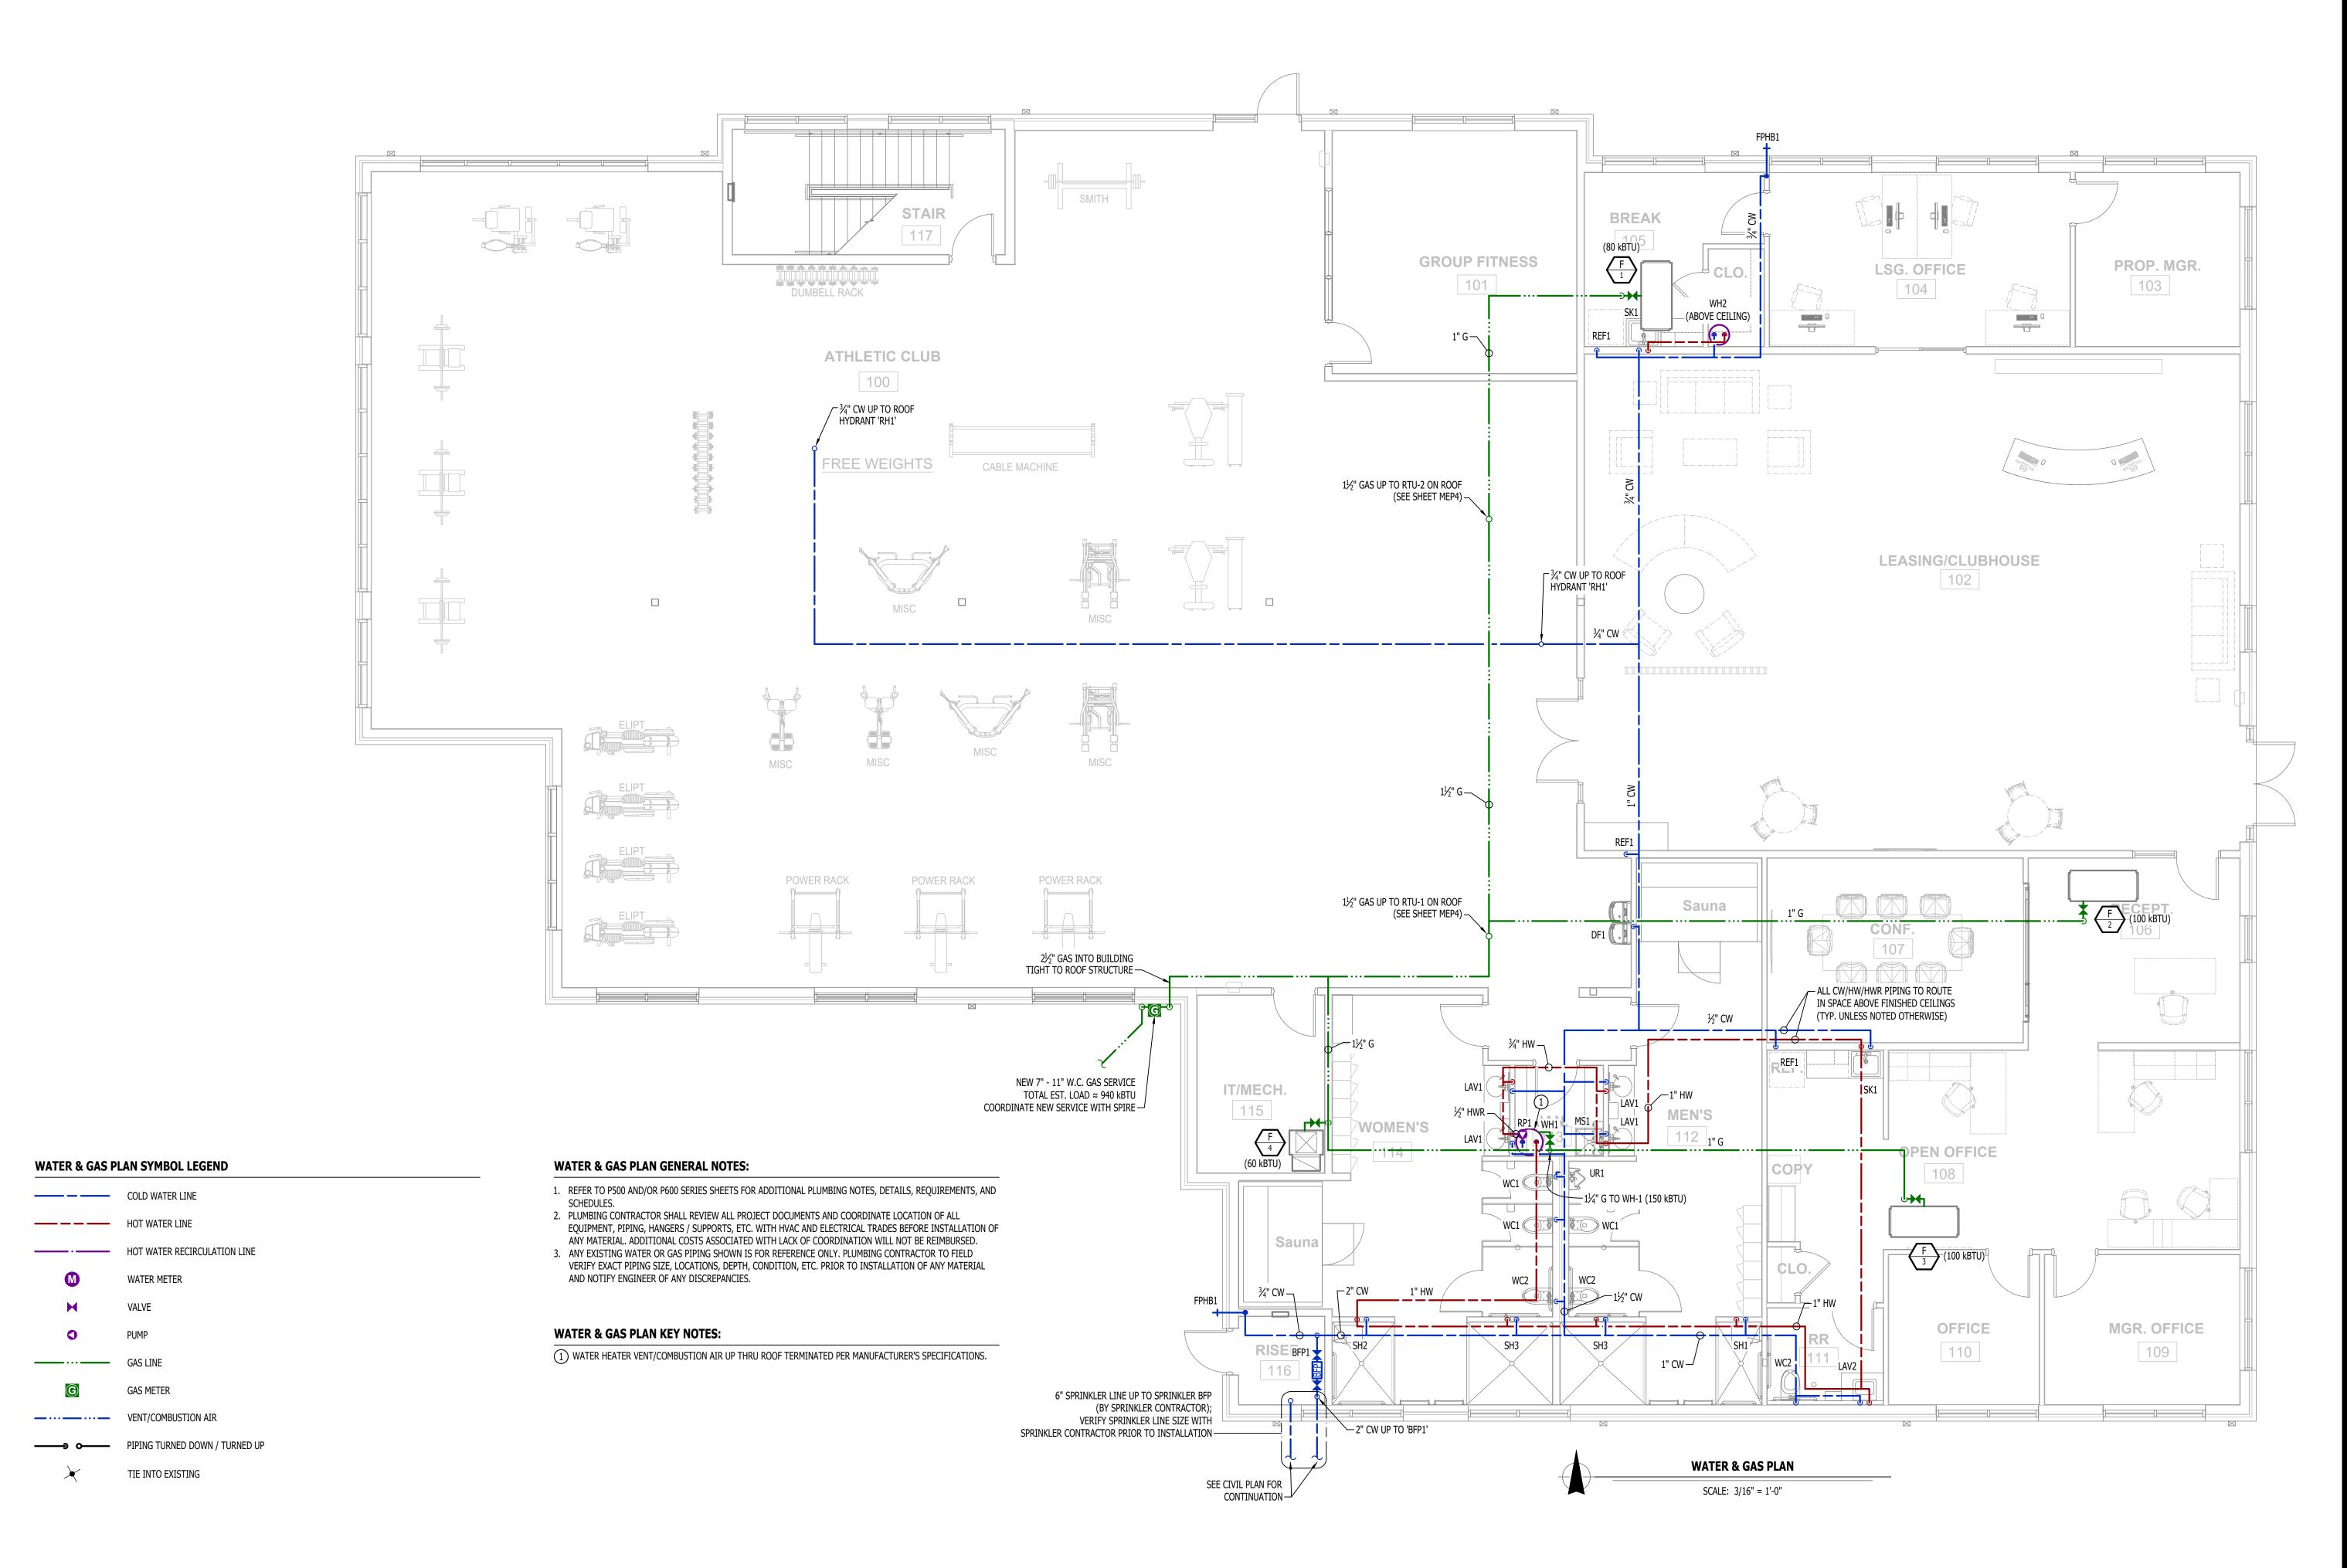

RELEASED FOR CONSTRUCTION
As Noted on Plans Review

Property Services Department Office of Servi

James Watson, P.E. June 13, 2025 PE-2015017071 MO Certificate of Authority # 2018029680



# J-SQUARED ENGINEERING

2400 Bluff Creek Drive, Suite 101 Columbia, Missouri 65201 573.234.4492

www.j-squaredeng.com

J2 PROJECT No: J21211

J2 DESIGN: ACW

ISSUE TITLE DATE
PERMIT SET 06 - 13 - 2025

# Office —

Athletic Club & Of

Pa

Discovery

AHJ APPROVAL STAMP

SHEET TITLE

WATER & GAS PLAN

CLIEFT NUMBER

**PW101** 

#### PLUMBING SPECIFICATIONS

- 1.1. PLUMBING CONTRACTOR IS RESPONSIBLE TO PROVIDE ALL ESCUTCHEONS, ½ TURN STOPS, P-TRAPS, AND SUPPLY LINES TO PROVIDE A COMPLETE SYSTEM AT EACH FIXTURE INDICATED ON PLANS UNLESS
- ALL PLUMBING SYSTEMS SHALL BE INSTALLED LEVEL, PLUMB, AND PARALLEL/PERPENDICULAR TO BUILDING ORIENTATION WHERE POSSIBLE.
- COORDINATE ALL PIPING INSTALLATIONS WITH STRUCTURAL GRADE BEAMS, FOOTINGS, COLUMN PIERS, ETC. SLEEVE PIPING THRU STRUCTURAL ELEMENTS AS NECESSARY, VERIFY WITH STRUCTURAL
- VERIFY ALL UTILITY CONNECTION POINTS WITH PROPOSED PLUMBING LAYOUTS PRIOR TO BEGINNING
- CLEAN ALL PLUMBING FIXTURES AND CHANGE FAUCET AERATORS AND SINK STRAINERS AT PROJECT COMPLETION PRIOR TO TURNING OVER TO OWNERSHIP.

- 2.1. ALL EQUIPMENT AND/OR FIXTURES MUST MEET OR EXCEED THE PERFORMANCE, FUNCTIONAL INTENT, AND AESTHETICS AS MODELS SPECIFIED ON PLANS. WHERE SPECIFIC MANUFACTURERS AND/OR MODELS ARE INDICATED ON PLANS OR WITHIN SCHEDULES, CONTRACTOR TO PROVIDE MODEL INDICATED OR APPROVED EQUAL. VERIFY SUBSTITUTION APPROVAL PRIOR TO PURCHASE OR
- INSTALLATION OF EQUIPMENT. CONTRACTOR TO SUPPLY SUBMITTALS FOR ALL EQUIPMENT FOR REVIEW BY ARCHITECT AND ENGINEER. FORMAL APPROVAL SHALL BE RECEIVED BY CONTRACTOR PRIOR TO EQUIPMENT PURCHASE.
- CONTRACTOR TO SHARE APPROVED EQUIPMENT SUBMITTALS WITH ANY PERTINENT ELECTRICAL REQUIREMENTS WITH ELECTRICAL CONTRACTORS WITHIN TWO WEEKS OF RECEIVING APPROVED SUBMITTALS FROM ARCHITECT/ENGINEER.

- 3.1. BELOW AND ABOVE GRADE WASTE AND VENT PIPING IN BUILDING TO BE SOLID CORE SCHEDULE 40 PVC LISTED FOR DWV APPLICATIONS.
- NO WASTE OR VENT PIPING INSTALLED BELOW GRADE SHALL BE SMALLER THAN 2".
- MINIMUM SLOPES FOR WASTE PIPING (UNLESS NOTED OTHERWISE ON PLANS):
- 2 ½" OR LESS DIAMETER: ¼" PER FOOT
- 3" to 6" diameter:  $\frac{1}{8}$ " per foot
- 8" OR LARGER DIAMETER:  $\frac{1}{16}$ " PER FOOT ACCESSIBLE FULL PIPE SIZE CLEANOUTS SHALL BE PROVIDED & INSTALLED ON BUILDING SANITARY LINES AT LOCATIONS SHOWN ON PLANS, AT INTERVALS OF NO MORE THAN 100', AT EVERY CHANGE IN DIRECTION GREATER THAN 45°, AND AT THE BASE OF EACH WASTE STACK.
- WASTE AND VENT PIPING IN PLENUMS SHALL BE CAST IRON, PLENUM-RATED CPVC, OR PVC WITH AN INSULATION WRAP LISTED FOR USE AS SUCH AN ASSEMBLY.
- ALL VENT PIPE TERMINATIONS SHALL BE LOCATED EITHER 10' HORIZONTALLY OR 3' ABOVE MECHANICAL AIR INTAKE LOCATIONS. TERMINATIONS SHALL NOT BE INSTALLED UNDER ANY OPERABLE BUILDING OPENING OR OPERABLE ADJACENT BUILDING OPENING. CONTRACTOR TO OFFSET VENT PIPING AS NECESSARY TO MEET THESE REQUIREMENTS.

#### 4. **DOMESTIC WATER**

- 4.1. ALL DOMESTIC WATER PIPING TO BE EITHER COPPER OR PEX, SHALL CONFORM TO NSF 61 AND BE LISTED FOR USE IN POTABLE WATER SYSTEMS.
- WHERE PEX PIPING IS USED, IT SHALL BE INCREASED ONE PIPE SIZE FROM WHAT IS INDICATED ON PLANS FOR ALL PORTIONS OF DISTRIBUTION SYSTEM.
- PEX-A MAY BE INSTALLED AT SIZES INDICATED ON PLANS ONLY IF AN ENGINEERED PLAN IS SUBMITTED SHOWING ACCEPTABLE PRESSURE DROPS AND FLUID VELOCITIES, APPROVAL MUST
- BE GRANTED PRIOR TO PURCHASE AND INSTALLATION. COPPER WATER PIPING BELOW GRADE SHALL BE TYPE "K". BELOW GRADE JOINTS SHALL BE SILVER SOLDERED. THERE SHALL BE NO JOINTS IN WATER PIPING LOCATED BENEATH BUILDING
- 4.1.4. COPPER WATER PIPING ABOVE GRADE SHALL BE TYPE "L".
- PROVIDE WATER HAMMER ARRESTORS AT ALL QUICK-CLOSE VALVES. FIXTURES REQUIRING WATER HAMMER ARRESTORS INCLUDE BUT ARE NOT LIMITED TO FLUSH VALVES, SENSOR FAUCETS, AND WASHING MACHINE BOXES. AIR CHAMBERS SHALL NOT BE PERMITTED.
- ALL DOMESTIC WATER PIPING SHALL BE ROUTED WITHIN BUILDING THERMAL ENVELOPE AND WITHIN WALL CAVITIES, ABOVE FINISHED CEILINGS, OR BELOW SLAB TO REMAIN CONCEALED UNLESS OTHERWISE NOTED. NOTIFY ENGINEER OF ANY NECESSARY ADJUSTMENTS THAT REQUIRE PIPING TO BE

### 4.4. DOMESTIC WATER PIPING INSULATION

- ALL HW & HWR PIPING, WHETHER COPPER OR PEX, SHALL BE INSULATED WITH PLENUM RATED
- CLOSED CELL ELASTOMERIC INSULATION. 4.4.1.1.
  - FOR PIPING LESS THAN  $1\frac{1}{2}$ ", INSULATION THICKNESS TO BE 1". FOR PIPING  $1\frac{1}{2}$ " OR GREATER, INSULATION THICKNESS SHALL BE  $1\frac{1}{2}$ ".
- 4.4.1.2. CW COPPER PIPING TO INSULATED WITH 1/3" PLENUM RATED CLOSED CELL ELASTOMERIC 4.4.2.
- INSULATION. CW PEX NEED NOT BE INSULATED UNLESS NOTED OTHERWISE ON PLANS.

#### 5. GAS PIPING

- GAS PIPING SHALL BE INSTALLED LEVEL, PLUMB, AND PARALLEL OR PERPENDICULAR TO BUILDING 5.1. ORIENTATION WHERE POSSIBLE.
- QUARTER-TURN FULL-PORT SHUTOFF VALVES SHALL BE INCLUDED AT EACH APPLIANCE CONNECTION, AS WELL AS AN IN-LINE REGULATOR FROM DELIVERY PRESSURE TO APPLIANCE OPERATING PRESSURE IF REQUIRED. INCLUDE SEDIMENT TRAPS PER IFGC REQUIREMENTS.
- NATURAL GAS AND LIQUID PROPANE (LP) PIPING TO SHALL BE SCHEDULE 40 BLACK STEEL. PIPE JOINTS SHALL BE THREADED WITH CLASS 150 FITTINGS, OR WELDED. NOTIFY OWNER/GC OF ANY
- NECESSARY HOT-WORK ASSOCIATED WITH WELDED CONNECTIONS. WHERE PIPING IS EXPOSED ON EXTERIOR FACE OF BUILDING, PAINT TO MATCH BUILDING. PAINT
- YELLOW IN ALL OTHER LOCATIONS.


### 5.4. ON ROOFTOPS, INSTALL GAS PIPE WITH "ROOFTOP BLOX" PER MANUFACTURER'S INSTRUCTION.

- 6.1. ABOVE AND BELOW GRADE STORM PIPING SHALL BE SOLID CORE SCHEDULE 40 PVC. ALL PRIMARY & SECONDARY STORM DRAIN PIPING & FITTINGS SHALL BE INSULATED WITH
- ½" FIBERGLASS INSULATION WITH ASJ JACKET.
- STORM DRAIN PIPING IN PLENUMS SHALL BE CAST IRON, PLENUM-RATED CPVC, OR PVC WITH AN INSULATION WRAP LISTED FOR USE AS SUCH AN ASSEMBLY.

PLUMBING FIXTURE SCHEDULE							
TAG DESCRIPTION		MANUFACTURER (OR EQUAL)	MODEL (OR EQUAL)	NOTES			
BFP1	BACKFLOW PREVENTER	WILKINS	975XL2	2" RPZ			
DF1	DRINKING FOUNTAIN WITH BOTTLE FILLER	ELKAY	LZSTL8WLSK	HIGH / LOW WITH BOTTLE FILLER			
EXP1	EXPANSION TANK	WATTS	PLT-12				
EXP2	EXPANSION TANK	WATTS	PLT-5				
FCO1	FLOOR CLEANOUT	ZURN	1400				
FD1	FLOOR DRAIN	ZURN	Z415-BZ	WITH Z1072 TRAP SEAL			
FPHB1	FROST PROOF HOSE BIB	WOODFORD	MODEL 67				
FS1	FLOOR SINK	ZURN	FS12				
LAV1	LAVATORY - (INTEGRAL BOWL W/ HANDS FREE FAUCET)	-	-	WITH ZURN Z6915-XL-L-TMV-1 FAUCET, 1/4 TURN STOPS, BRAIDED STAINLESS STEEL SUPPLIES			
LAV2	LAVATORY (WALL HUNG W/MANUAL FAUCET)	AMERICAN STANDARD	0355.012	WITH ZURN Z81104-XL FAUCET, 1/4 TURN STOPS, BRAIDED STAINLESS STEEL SUPPLIES, AND TRUBRO LAV GUARD 2			
MS1	MOP SINK	FIAT	MSB2424	WITH ZURN Z843M1 FAUCET WITH WALL HOOK			
REF1	REFRIGERATOR BOX	SIOUX CHIEF	696-G1000				
RH1	ROOF HYDRANT	WOODFORD	SRH-MS				
RP1	RECIRCULATION PUMP	GRUNDFOS	UP10-15BUA/TLC	WITH AQUASTAT CONTROL KIT			
SH1	ADA SHOWER	ZURN	Z415-BZ	WITH Z1072 TRAP SEAL; WITH MOEN POSI-TEMP MIXING VALVE, SLIDE BAR AND HANDHELD SH ASSEMBLY			
SH2	SHOWER	ZURN	Z415-BZ	WITH Z1072 TRAP SEAL; WITH MOEN POSI-TEMP MIXING VALVE AND TRIM KIT			
SH3	SHOWER	ZURN	Z415-BZ	WITH Z1072 TRAP SEAL; WITH MOEN POSI-TEMP MIXING VALVE AND TRIM KIT			
TMV1	THERMOSTATIC MIXING VALVE - POINT OF USE	WATTS	LFUSG				
UR1	URINAL - MANUAL FLUSH	AMERICAN STANDARD	6550.001	WITH ZURN Z6003AV-WS1 MANUAL FLUSH VALVE (1.0 GPM/FLUSH)			
WC1	WATER CLOSET - STANDARD HEIGHT - PRESSURE ASSIST TANK	AMERICAN STANDARD	2462.016	WITH CHURCH 9500SSCT SELF SUSTAINING SEAT			
WC2	WATER CLOSET - ADA HEIGHT - PRESSURE ASSIST TANK	AMERICAN STANDARD	2467.016	WITH CHURCH 9500SSCT SELF SUSTAINING SEAT			
WH1	WATER HEATER - GAS - 100 GALLON	A.O. SMITH	BTH-150	150kBTU, 100 GALLON, WITH 'EXP1'			
WH2	WATER HEATER - ELECTRIC - 6 GALLON	RUUD	EGSP6	120V, 1500W, WITH 'EXP2'			
YCO1	YARD CLEAN OUT	ZURN	Z1400				


1. VERIFY NECESSARY FIXTURES MEET ADA REQUIREMENTS WITH ARCHITECT PRIOR TO INSTALLATION.

2. VERIFY FIXTURE FINISHES WITH OWNER / ARCHITECT.

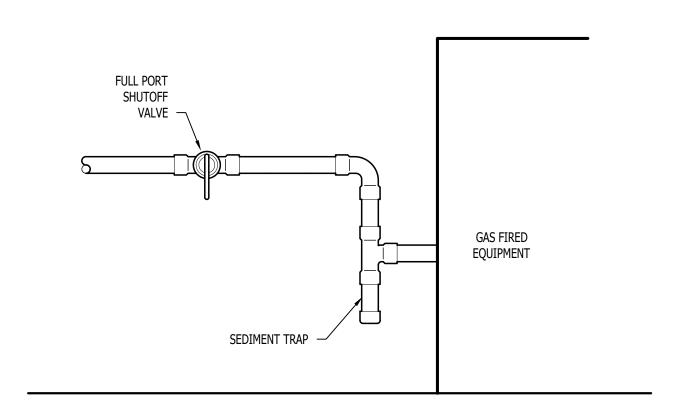



FIXTURE	SA NITA P	Y PIPING	SUPPLY PIPING		
ТҮРЕ	TYPICAL ABBREVIATION	WASTE CONNECTION	VENT CONNECTION	COLD WATER CONNECTION	HOT WATER CONNECTION
DRINKING FOUNTAIN	DF	1-1/2"	1-1/4"	1/2"	-
FLOOR DRAIN	FD	3"	2"	-	-
HAND / HAIR SINK	HS / SK	2"	1-1/4"	1/2"	1/2"
HOSE BIBB	НВ	-	-	3/4"	-
LAVATORY	LAV	1-1/2"	1-1/4"	1/2"	1/2"
MOP SINK	MS	3"	1-1/2"	1/2"	1/2"
ICE MAKER OUTLET BOX	REF	-	-	1/2"	-
SHOWER	SH	3"	1-1/2"	1/2"	1/2"
URINAL	UR	2"	1-1/4"	3/4"	-
WATER CLOSET (FLUSH TANK)	WC	3"	2"	1/2"	-
WATER CLOSET (FLUSH VALVE)	WC	3"	2"	1"	-

#### GAS EQUIPMENT SUPPLY DETAIL W/O REGULATOR

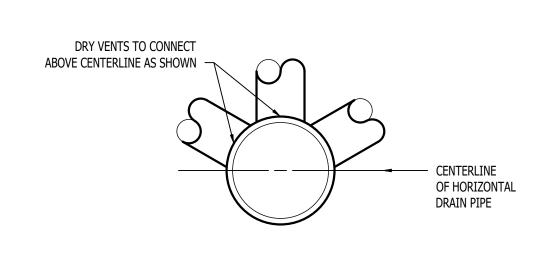

**DRY VENT DETAIL** 

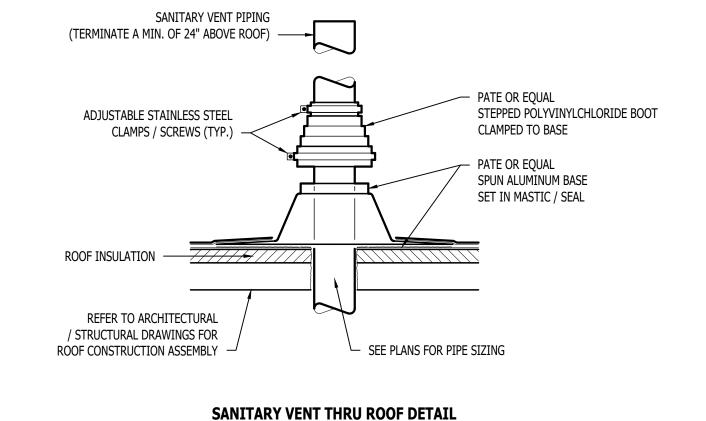

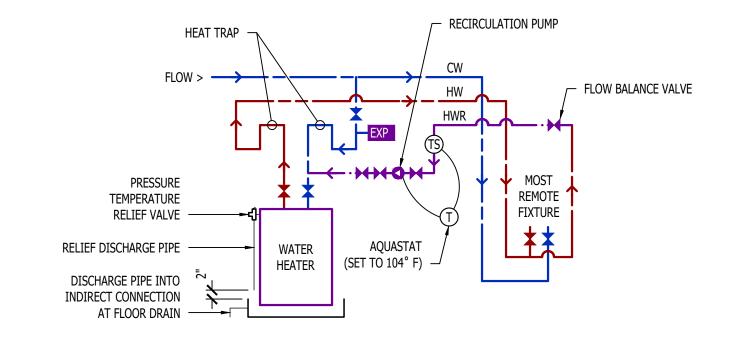

**HOT WATER RECIRCULATION DETAIL** 

AHJ APPROVAL STAMP

SHEET TITLE

PLUMBING DETAILS & **SCHEDULES** 

RELEASED FOR CONSTRUCTION As Noted on Plans Review

James Watson, P.E. June 13, 2025

MO Certificate of Authority # 2018029680

J-SQUARED

ENGINEERING

2400 Bluff Creek Drive, Suite 101

Columbia, Missouri 65201

573.234.4492

www.j-squaredeng.com

ACW

DATE

06 - 13 - 2025

J2 PROJECT No:

J2 DESIGN:

ISSUE TITLE

PERMIT SET

O

D

COV

PE-2015017071

SHEET NUMBER