

# HCA - LEE'S SUMMIT MEDICAL CENTER MED SURG & DIETARY EXPANSION


2100 SE BLUE PKWY LEE'S SUMMIT, MO 64063

DGL PROJECT NO HCA PROJECT NO.

6406.24.0001 0972400009

HCA DESIGN MANAGER: MIKAL MALIK HCA CONSTRUCTION MANAGER: ERIC SJODIN



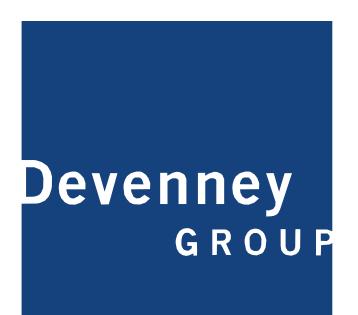

Devenney Group Ltd., Architects

6900 E. Camelback Road, Suite #500 Phoenix, Arizona 85013

T: 602.943.8950 F: 602.943.7645

www.devenneygroup.com

## HCA VENDOR INFORMATION

REMAR (TV) DARRELL LEFTWICH, DLEFTWICH@REMARINC.COM

GE HEALTHCARE TECHNOLOGIES TAREY ISBELL, TAREY.ISBELL@GE.COM

HILL-ROM (NURSE CALL) SEDRIC MCQUEEN, SEDRIC.MCQUEEN@HILL-ROM.COM

STORAGE SYSTEMS UNLIMITED (STORAGE) LANCE MCCORMICK, LMCCORMICK@STORAGESYSTEMSUL.COM

STO (EXTERIOR PRE-FAB PANELS)

NEOPOD (INTERIOR PRE-FAB) RYAN HAUSER, RHAUSER@NEOPODSYSTEMS.COM

JOHNSON LANCASTER & ASSOCIATES (KITCHEN AND SERVERY) PHIL REGISTER, PHILR@JOHNSON-LANCASTER.COM


## DEVENNEY GROUP, LTD. ARCHITECTS

ARCHITECTS

6900 E CAMELBACK RD, SUITE #500 SCOTTSDALE, AZ 85251

PROJECT MANAGER: KEVIN COOK

602.541.7287

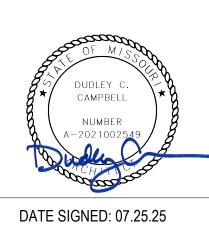

## WSP

### MECHANICAL, PLUMBING & ELECTRICAL ENGINEERS

300 WYANDOTTE, SUITE 200

KANSAS CITY, MO 64105

PROJECT MANAGER: MINDY WHISLER 816.702.4247

## INNER DESIGN STUDIO

INTERIOR DESIGNER

7103 BAKER'S BRIDGE AVE, SUITE 106

BRENTWOOD, TN 37027

PROJECT MANAGER: BEVERLY PHILLEY

615.321.0696

## STANELY D. LINDSEY AND ASSOCIATES, LTD.

STRUCTURAL

750 OLD HICKORY BLVD, BUILDING 1 SUITE 175

BRENTWOOD, TN 37027

PRINICPAL-IN-CHARGE/PROJECT MANAGER: JASON PERRY

615.963.3727

## CATALYST DESIGN GROUP

CIVIL

5100 TENNESSEE AVE

NASHVILLE, TN 37209 PRINICPAL ENGINEER: JACK PARKER

615.622.7220

## NABHOLZ

### GENERAL CONTRACTOR

6640 CAROTHERS PARKWAY, STE 150 FRANKLIN, TN 37067

PROJECT EXECUTIVE: JEREMY BRANSON

913.393.6552

DATE: **SUBMITTALS:** CITY & STATE - 1ST REVIEW 12/05/2024 ACITY - 2ND REVIEW 02/06/2025 © DESIGN COORDINATION 02/06/2025 06/06/2025 △ DESIGN COORDINATION DESIGN COORDINATION 07/25/2025

|   | X = ISSUED SHEET   | 4           | \A\          | <u>B</u>            |              | <u>{                                    </u> |
|---|--|-------------|--------------|---------------------|--------------|--|
|   | R = REVISED SHEET  |             | 96/2         | /90                 | )9(          | Ç  |
|   | F = FOR REFERENCE ONLY   | - 12/05/24  | 02/06/25     | 02/06/25            | 06/06/25     | L  |
|   | D = DELETED SHEET  |             | •            | '                   | '            | 700/30/20                                    |
|   |  | VIE         |              | Z                   | Z            | 1  |
|   |  | 1ST REVIEW  | _            | ) I                 | COORDINATION |  |
|   |  | 151         | lE.          | Ž                   | Ž            |  |
|   |  | <u>+</u>    | - 2ND REVIEW | ORE                 | ORE          | 5  |
|   |  | STATE       | N<br>N       | S                   | 8            | Š  |
| SHEET   |  | ত           | 2            | <u>N</u>            | <u>N</u>     | 7  |
| NUMBER  | SHEET NAME   | CITY        | CITY         | DESIGN COORDINATION | DESIGN       | 1  |
|   |  |             |              |                     |              |  |
| NERAL IN  | IFORMATION   |             |              |                     |              |  |
| GI000   | COVER SHEET  | Х           | R            | R                   | R            | F  |
| GI001   | SHEET INDEX  | Х           | R            | R                   | R            | F  |
| GI101   | PROJECT INFORMATION, AREA MAPS, SYMBOLS  | X           | R            |                     |              |  |
|   |  |             |              |                     |              |  |
| VIL   | T.   |             |              | 1                   | ı            | _  |
| C0.0  | COVER SHEET  | X           |              | R                   |              | I  |
| C1.0  | EXISTING CONDITIONS  | X           |              |                     |              | -  |
| C2.0  | GENERAL NOTES  | X           |              |                     |              | -  |
| C3.0  | INITIAL EROSION CONTROL PLAN   | X           |              | R                   |              | +  |
| C3.1  | FINAL EROSION CONTROL PLAN SEDIMENT AND EROSION CONTROL DETAILS  | X           |              | R                   |              | +  |
| C3.2  | SEDIMENT AND EROSION CONTROL DETAILS SEDIMENT AND EROSION CONTROL DETAILS  | X           |              |                     |              | -  |
| C3.3<br>C4.0  | OVERALL DEMOLITION PLAN  | X           |              | R                   |              | +'   |
| C4.0<br>C4.1  | DETAILED DEMOLITION PLAN   | X           |              | R                   |              | +  |
| C4.1  | DETAILED DEMOLITION PLAN   | X           |              | R                   |              | +  |
| C4.2  | OVERALL LAYOUT PLAN  | X           |              | R                   |              | -  |
| C5.0<br>C5.1  | DETAILED LAYOUT PLAN   | X           |              | R                   |              | +  |
| C5.1  | DETAILED LAYOUT PLAN   | X           |              | R                   |              | +  |
| C5.2  | DETAILED LAYOUT PLAN   |             |              | 1,                  |              | +,   |
| C6.0  | OVERALL GRADING & DRAINAGE PLAN  | X           |              | R                   |              | +'   |
| C6.1  | DETAILED GRADING & DRAINAGE PLAN   | X           |              | R                   |              | +  |
| C6.2  | DETAILED GRADING & DRAINAGE PLAN  DETAILED GRADING & DRAINAGE PLAN   | X           |              | R                   |              | +  |
| C6.3  | DETENTION BASIN DETAILS  | X           |              | R                   |              | F  |
| C6.4  | PEDESTRIAN BRIDGE PLAN & PROFILE   | X           |              | R                   |              | †  |
| C7.0  | OVERALL UTILITY PLAN   | X           |              | R                   |              | +  |
| C7.1  | DETAILED UTILITY PLAN  | X           |              | R                   |              |  |
| C8.0  | SITE DETAILS   | X           |              | R                   |              | +  |
| C8.1  | SITE DETAILS   | X           |              |                     |              | $\top$                                       |
| C8.2  | SITE DETAILS   | X           |              |                     |              | $\top$                                       |
| L1.0<br>L1.1<br>L1.2  | OVERALL LANDSCAPE PLAN DETAILED LANDSCAPE PLAN DETAILED LANDSCAPE PLAN   | X<br>X<br>X |              | R<br>R<br>R         |              |  |
| L2.0  | LANDSCAPE DETAILS  | X           |              | R                   |              | L  |
| RUCTURA   | ıl.  |             |              |                     |              |  |
| S001  | STRUCTURAL AXON VIEWS  | Х           |              |                     |              | T  |
| S011  | STRUCTURAL NOTES   | X           |              |                     |              | +  |
| S012  | STRUCTURAL NOTES   | X           |              |                     |              |  |
| S013  | STRUCTURAL SPECIAL INSPECTIONS   | X           |              |                     |              |  |
| S120  | PEDESTRIAN BRIDGE FOUNDATION AND FRAMING PLANS   | Х           |              |                     | R            | T  |
| S121  | LEVEL 1 FOUNDATION PLAN  | Х           |              | R                   |              |  |
| S122  | LEVEL 2 FRAMING PLAN   | Х           |              | R                   |              |  |
| S123A   | LEVEL 3 FRAMING PLAN - SECTOR A  | Х           |              | R                   | R            | F  |
| S123B   | LEVEL 3 FRAMING PLAN - SECTOR B  | Х           |              | R                   | R            |  |
| S124A   | ROOF FRAMING PLAN - SECTOR A   | Х           |              | R                   |              |  |
| S124B   | ROOF FRAMING PLAN - SECTOR B   | X           |              | R                   | R            |  |
| S201  | TYPICAL FOUNDATION AND SLAB ON GROUND SECTIONS AND DETAILS   | Х           |              | R                   |              | $\perp^{}$                                   |
| S211  | PEDESTRIAN BRIDGE STRUCTURAL SECTIONS AND DETAILS  | X           |              | R                   |              | $\perp$                                      |
| S301  | TYPICAL COMPOSITE STEEL FRAMING SECTIONS AND DETAILS   | X           |              |                     |              | 1  |
| S302  | TYPICAL STEEL FRAMING SECTIONS AND DETAILS   | X           |              |                     | R            | $\downarrow$                                 |
| S303  | TYPICAL STEEL ROOF FRAMING SECTIONS AND DETAILS  | X           |              |                     |              | 1  |
| S401  | TYPICAL VERTICAL TRANSPORTATION SYSTEMS SECTIONS AND DETAILS   | X           |              |                     |              | $\perp$                                      |
|   | COLUMN SECTIONS AND DETAILS  | l v         |              |                     | R            | +  |
| S501  | A COMPANY ED AND SECTIONS AND SECTIONS   | X           | i .          | 1                   |              | _  |
|   | MOMENT FRAME SECTIONS AND DETAILS  | X           |              |                     |              |  |
| S501<br>S601  |  |             |              |                     |              |  |
| S501<br>S601  | JRAL LIFESAFETY  | Х           |              |                     |              | Τ  |
| S501<br>S601<br><b>ECHITECT</b><br>AC101  |  |             |              |                     | R            | -  |
| S501<br>S601<br><b>CCHITECT</b><br>AC101<br>AC103   | JRAL LIFESAFETY  LIFE SAFETY FLOOR PLAN – LEVEL 1  | X           |              |                     | R            |  |
| S501<br>S601<br>RCHITECTU<br>AC101<br>AC103<br>AC501  | JRAL LIFESAFETY  LIFE SAFETY FLOOR PLAN – LEVEL 1  LIFE SAFETY FLOOR PLAN – LEVEL 3  | X X X       |              |                     | R            |  |
| S501<br>S601<br>RCHITECT<br>AC101<br>AC103<br>AC501<br>AC521  | JRAL LIFESAFETY  LIFE SAFETY FLOOR PLAN – LEVEL 1  LIFE SAFETY FLOOR PLAN – LEVEL 3  PARTITION TYPES & DETAILS   | X           |              |                     | R            |  |
| S501<br>S601  | JRAL LIFESAFETY  LIFE SAFETY FLOOR PLAN – LEVEL 1  LIFE SAFETY FLOOR PLAN – LEVEL 3  PARTITION TYPES & DETAILS  TYPICAL MOUNTING HEIGHTS   | X           |              |                     | R            |  |
| S501<br>S601<br>AC101<br>AC103<br>AC501<br>AC521<br>AC522   | JRAL LIFESAFETY  LIFE SAFETY FLOOR PLAN – LEVEL 1  LIFE SAFETY FLOOR PLAN – LEVEL 3  PARTITION TYPES & DETAILS  TYPICAL MOUNTING HEIGHTS  TYPICAL MOUNTING HEIGHTS   | X X X X X   |              |                     | R            |  |
| S501<br>S601<br>AC101<br>AC103<br>AC501<br>AC521<br>AC522<br>AC523  | JRAL LIFESAFETY  LIFE SAFETY FLOOR PLAN – LEVEL 1  LIFE SAFETY FLOOR PLAN – LEVEL 3  PARTITION TYPES & DETAILS  TYPICAL MOUNTING HEIGHTS  TYPICAL MOUNTING HEIGHTS   | X X X X X   |              |                     | R            |  |
| S501<br>S601<br>RCHITECT<br>AC101<br>AC103<br>AC501<br>AC521<br>AC522<br>AC523  | JRAL LIFESAFETY  LIFE SAFETY FLOOR PLAN – LEVEL 1  LIFE SAFETY FLOOR PLAN – LEVEL 3  PARTITION TYPES & DETAILS  TYPICAL MOUNTING HEIGHTS  TYPICAL MOUNTING HEIGHTS  TYPICAL MOUNTING HEIGHTS   | X X X X X   |              | R                   | R            |  |
| S501<br>S601<br>RCHITECTI<br>AC101<br>AC103<br>AC501<br>AC521<br>AC522<br>AC523   | JRAL LIFESAFETY  LIFE SAFETY FLOOR PLAN — LEVEL 1  LIFE SAFETY FLOOR PLAN — LEVEL 3  PARTITION TYPES & DETAILS  TYPICAL MOUNTING HEIGHTS  TYPICAL MOUNTING HEIGHTS  TYPICAL MOUNTING HEIGHTS  TYPICAL MOUNTING HEIGHTS  JRAL DEMOLITION  | X X X X X X |              | R                   | R            |  |
| S501<br>S601<br>RCHITECT<br>AC101<br>AC103<br>AC501<br>AC521<br>AC522<br>AC523<br>RCHITECT<br>AD101<br>AD103                | JRAL LIFESAFETY  LIFE SAFETY FLOOR PLAN – LEVEL 1  LIFE SAFETY FLOOR PLAN – LEVEL 3  PARTITION TYPES & DETAILS  TYPICAL MOUNTING HEIGHTS  TYPICAL MOUNTING HEIGHTS  TYPICAL MOUNTING HEIGHTS  TYPICAL MOUNTING HEIGHTS  JRAL DEMOLITION  DEMOLITION PLAN - LEVEL 1   | X           |              |                     | R            |  |
| S501<br>S601<br>AC101<br>AC103<br>AC501<br>AC521<br>AC522<br>AC523  | JRAL LIFESAFETY  LIFE SAFETY FLOOR PLAN – LEVEL 1  LIFE SAFETY FLOOR PLAN – LEVEL 3  PARTITION TYPES & DETAILS  TYPICAL MOUNTING HEIGHTS  TYPICAL MOUNTING HEIGHTS  TYPICAL MOUNTING HEIGHTS  TYPICAL MOUNTING HEIGHTS  JRAL DEMOLITION  DEMOLITION PLAN - LEVEL 1  DEMOLITION PLAN - LEVEL 3  | X           |              | R                   | R            |  |
| S501<br>S601<br>ACHITECTI<br>AC101<br>AC501<br>AC521<br>AC522<br>AC523<br>ACHITECTI<br>AD101<br>AD103<br>AD104              | JRAL LIFESAFETY  LIFE SAFETY FLOOR PLAN – LEVEL 1  LIFE SAFETY FLOOR PLAN – LEVEL 3  PARTITION TYPES & DETAILS  TYPICAL MOUNTING HEIGHTS  TYPICAL MOUNTING HEIGHTS  TYPICAL MOUNTING HEIGHTS  JRAL DEMOLITION  DEMOLITION PLAN - LEVEL 1  DEMOLITION PLAN - LEVEL 3  DEMOLITION PLAN - ROOF  | X           |              | R                   | R            |  |
| S501<br>S601<br>AC101<br>AC103<br>AC501<br>AC521<br>AC522<br>AC523<br>ACHITECTI<br>AD101<br>AD103<br>AD104<br>AD171         | JRAL LIFESAFETY  LIFE SAFETY FLOOR PLAN — LEVEL 1  LIFE SAFETY FLOOR PLAN — LEVEL 3  PARTITION TYPES & DETAILS  TYPICAL MOUNTING HEIGHTS  TYPICAL MOUNTING HEIGHTS  TYPICAL MOUNTING HEIGHTS  JRAL DEMOLITION  DEMOLITION PLAN - LEVEL 1  DEMOLITION PLAN - LEVEL 3  DEMOLITION PLAN - ROOF  DEMOLITION RCP - LEVEL 1  | X           |              | R                   | R            |  |
| S501<br>S601<br>AC101<br>AC103<br>AC501<br>AC521<br>AC522<br>AC523<br>ACHITECT<br>AD101<br>AD103<br>AD104<br>AD171<br>AD173 | JRAL LIFESAFETY  LIFE SAFETY FLOOR PLAN — LEVEL 1  LIFE SAFETY FLOOR PLAN — LEVEL 3  PARTITION TYPES & DETAILS  TYPICAL MOUNTING HEIGHTS  TYPICAL MOUNTING HEIGHTS  TYPICAL MOUNTING HEIGHTS  JRAL DEMOLITION  DEMOLITION PLAN - LEVEL 1  DEMOLITION PLAN - ROOF  DEMOLITION RCP - LEVEL 3   | X           |              | R<br>R              | R            |  |
| S501 S601 SCHITECT AC101 AC103 AC501 AC521 AC522 AC523 CCHITECT AD101 AD103 AD104 AD171 AD173 AD311                         | LIFE SAFETY FLOOR PLAN – LEVEL 1 LIFE SAFETY FLOOR PLAN – LEVEL 3 PARTITION TYPES & DETAILS TYPICAL MOUNTING HEIGHTS TYPICAL MOUNTING HEIGHTS TYPICAL MOUNTING HEIGHTS  TYPICAL MOUNTING HEIGHTS  JRAL DEMOLITION  DEMOLITION PLAN - LEVEL 1 DEMOLITION PLAN - LEVEL 3 DEMOLITION PLAN - ROOF DEMOLITION RCP - LEVEL 1 DEMOLITION RCP - LEVEL 3 ARCHITECTURAL DEMOLITION SECTIONS & DETAILS      | X           |              | R<br>R              | R            |  |
| S501 S601 SCHITECT AC101 AC103 AC501 AC521 AC522 AC523 SCHITECT AD101 AD103 AD104 AD171 AD173 AD311                         | LIFE SAFETY FLOOR PLAN – LEVEL 1 LIFE SAFETY FLOOR PLAN – LEVEL 3 PARTITION TYPES & DETAILS TYPICAL MOUNTING HEIGHTS TYPICAL MOUNTING HEIGHTS TYPICAL MOUNTING HEIGHTS  TYPICAL MOUNTING HEIGHTS  JRAL DEMOLITION  DEMOLITION PLAN - LEVEL 1  DEMOLITION PLAN - LEVEL 3  DEMOLITION PLAN - ROOF  DEMOLITION RCP - LEVEL 1  DEMOLITION RCP - LEVEL 3  ARCHITECTURAL DEMOLITION SECTIONS & DETAILS | X           |              | R<br>R              | R            |  |

| SHEET   |   | ı   | Â                 | 1                   |                     |      |
|---|---|---|-------------------|---------------------|---------------------|------|
|   | X = ISSUED SHEET R = REVISED SHEET  | 12/05/24  | 02/06/25          | 02/06/25            | 06/06/25            | 1000 |
|   | F = FOR REFERENCE ONLY D = DELETED SHEET  | - 1   | - 02/             | - 07/               | 90 -                | 7,75 |
| SHEET<br>NUMBER   | SHEET NAME  | CITY & STATE - 1ST REVIEW                           | CITY - 2ND REVIEW | DESIGN COORDINATION | DESIGN COORDINATION |      |
| ARCHITECT   | URAL  |   |                   |                     |                     |      |
| AE101<br>AE103  | OVERALL SCOPE FLOOR PLAN - LEVEL 1  OVERALL SCOPE FLOOR PLAN - LEVEL 3  | X   |                   |                     | R                   |      |
| AE111   | OVERALL ROOF PLAN   | Х   | R                 | R                   |                     |      |
| AE121A<br>AE123A  | DIMENSION FLOOR PLAN - LEVEL 1 - SECTOR A - KITCHEN, SERVERY & DINING  DIMENSION FLOOR PLAN - LEVEL 3 - SECTOR A - MEDSURG  | X   |                   | R<br>R              | R                   | F    |
| AE123B<br>AE131A  | DIMENSION FLOOR PLAN - LEVEL 3 - SECTOR B - MEDSURG  ANNOTATION FLOOR PLAN - LEVEL 1 - SECTOR A - KITCHEN, SERVERY & DINING   | X   |                   | R<br>R              | R                   | F    |
| AE133A  | ANNOTATION FLOOR PLAN - LEVELS 2 & 3 - SECTOR A - MEDSURG   | Х   |                   | R                   | R                   |      |
| AE133B<br>AE141   | ANNOTATION FLOOR PLAN - LEVEL 3 - SECTOR B - MEDSURG  OVERALL EDGE-OF-SLAB - LEVEL 1  | X   |                   | R                   | R                   | F    |
| AE143<br>AE144  | OVERALL EDGE-OF-SLAB - LEVEL 3  OVERALL EDGE-OF-SLAB - LEVEL 4  | X   |                   | R<br>R              | R                   |      |
| AE144<br>AE181A   | REFLECTED CEILING PLAN - LEVEL 1 - SECTOR A - KITCHEN, SERVERY & DINING   | Х   |                   | R                   |                     |      |
| AE182A<br>AE182B  | REFLECTED CEILING PLAN - LEVEL 2 - SECTOR A - EXISTING MEDSURG  REFLECTED CEILING PLAN - LEVEL 2 - SECTOR B - EXISTING MEDSURG  | X   |                   |                     |                     |      |
| AE183A  | REFLECTED CEILING PLAN - LEVEL 3 - SECTOR A - MEDSURG  REFLECTED CEILING PLAN - LEVEL 3 - SECTOR B - MEDSURG  | X   |                   | R                   | R                   |      |
| AE183B<br>AE201   | EXTERIOR BUILDING ELEVATIONS - DIETARY  | X   |                   | R<br>R              |                     |      |
| AE202<br>AE203  | EXTERIOR BUILDING ELEVATIONS - MED/SURG  EXTERIOR BUILDING ELEVATIONS - MED/SURG  | X   |                   | R<br>R              | R<br>R              | +    |
| AE301   | BUILDING SECTIONS - DIETARY   | Х   |                   |                     |                     |      |
| AE302<br>AE303  | BUILDING SECTIONS - MED/SURG  BUILDING SECTIONS - MED/SURG  | X   |                   |                     | R<br>R              |      |
| AE311<br>AE312  | EXTERIOR WALL SECTIONS - DIETARY  EXTERIOR WALL SECTIONS - MED/SURG   | X   |                   | R                   | R                   | F    |
| AE331   | INTERIOR SHAFT WALL SECTIONS & DETAILS  | Х   |                   | R                   | IX.                 | F    |
| AE361<br>AE401  | STAIR WALL SECTIONS  ENLARGED FLOOR PLANS - LEVEL 3 - MED SURG  | X   |                   | R                   | R                   | F    |
| AE402   | ENLARGED FLOOR PLANS - LEVEL 3 - MED SURG   | X   |                   |                     |                     |      |
| AE421<br>AE450  | ENLARGED STAIR PLANS ENLARGED CANOPY PLANS, SECTIONS & DETAILS  | X   |                   |                     |                     |      |
| AE501<br>AE502  | EXTERIOR WALL DETAILS - DIETARY  EXTERIOR WALL DETAILS - MED/SURG   | X   | R<br>R            |                     | R                   |      |
| AE531   | EXTERIOR ROOF DETAILS   | Х   |                   |                     | - 1                 |      |
| AE532<br>AE533  | EXTERIOR ROOF DETAILS  EXTERIOR ROOF DETAILS  | X   | R                 |                     |                     |      |
| AE601   | DOOR SCHEDULES - LEVEL 1 - DIETARY  | X   |                   |                     |                     | F    |
| AE602<br>AE621  | DOOR SCHEDULES - LEVEL 3 - MED/SURG  EXTERIOR & INTERIOR DOOR DETAILS   | X   | R                 | R                   |                     | F    |
| AE651<br>AE671  | WINDOW SCHEDULES, ELEVATIONS & DETAILS  EXTERIOR WINDOW, LOUVER & BRICK SILL DETAILS  | X   |                   | R                   |                     |      |
| AE673   | EXTERIOR WINDOW, LOOVER & BRICK SILE DETAILS  EXTERIOR WINDOW DETAILS   | ^   |                   | Х                   |                     |      |
| AE701<br>AE720  | INTERIOR DETAILS CEILING DETAILS  | X   |                   |                     |                     |      |
| AE740   | CASEWORK DETAILS & LEGEND   | Х   |                   |                     |                     |      |
| AE741<br>AE760  | MILLWORK DETAILS STAIR DETAILS  | X   |                   | R                   |                     | F    |
| INTERIORS   |   |   |                   |                     |                     |      |
| AF001   | GENERAL FINISH SPECIFICATIONS AND NOTES   | X   |                   | R                   |                     | F    |
| AF002<br>AF003  | GENERAL FINISH SPECIFICATIONS AND NOTES  SIGNAGE KEY  | X   |                   | R                   |                     | R    |
| AF004<br>AF005  | SIGNAGE KEY SIGNAGE KEY   | X   |                   |                     |                     |      |
| AF006   | SIGNAGE KEY   | Х   |                   |                     |                     |      |
| AF007<br>AF101  | SIGNAGE KEY FINISH FLOOR PLAN - LEVEL 1   | X   |                   | R                   |                     |      |
| AF102   | WALL PROTECTION PLAN - LEVEL 1  | X   |                   | R                   |                     | R    |
| AF103<br>AF104  | FLOOR PATTERN PLAN - LEVEL 1 FURNITURE PLAN - LEVEL 1   | X   |                   |                     |                     |      |
| AF105<br>AF301  | SIGNAGE PLAN - LEVEL 1  OVERALL FLOOR PLAN - LEVEL 3 MED SURG   | X   |                   | R                   |                     |      |
| AF301A  | FINISH FLOOR PLAN - LEVEL 3 - SECTOR A -(16) BED UNIT   | Х   |                   | R                   |                     | R    |
| AF301B<br>AF302A  | FINISH FLOOR PLAN - LEVEL 3 SECTOR B - (12) BED UNIT WALL PROTECTION PLAN - LEVEL 3 SECTOR A (16) BED UNIT  | X   |                   | R<br>R              |                     | R    |
| AF302B<br>AF303A  | WALL PROTECTION PLAN - LEVEL 3 SECTOR B (12) BED UNIT FLOOR PATTERN PLAN - LEVEL 3 - SECTOR A - (16) BED UNIT   | X   |                   | R<br>R              |                     | R    |
| AF303A<br>AF303B  | FLOOR PATTERN PLAN - LEVEL 3 - SECTOR B - (12) BED UNIT   | Х   |                   | R                   |                     |      |
|   | FURNITURE PLAN - LEVEL 3 SECTOR A FURNITURE PLAN - LEVEL 3 SECTOR B   | X   |                   |                     |                     |      |
| AF304A<br>AF304B  | SIGNAGE PLAN - LEVEL 3 - SECTOR A - (16) BED UNIT   | Х   |                   |                     |                     |      |
| AF304B<br>AF305A  | SIGNAGE PLAN - LEVEL 3 - SECTOR B - (12) BED UNIT   | X   |                   |                     |                     |      |
| AF304B  |   |   |                   |                     |                     | T    |
| AF304B<br>AF305A<br>AF305B<br>PLUMBING  |   | v   |                   | -                   |                     |      |
| AF304B<br>AF305A<br>AF305B<br>PLUMBING<br>P00-00<br>PD02-00   | GENERAL INFORMATION - PLUMBING UNDERFLOOR DEMOLITION PLAN - PLUMBING  | X   |                   |                     |                     |      |
| AF304B<br>AF305A<br>AF305B<br>PLUMBING<br>P00-00<br>PD02-00<br>PD02-01  | GENERAL INFORMATION - PLUMBING UNDERFLOOR DEMOLITION PLAN - PLUMBING  |   |                   |                     |                     | 1    |
| AF304B<br>AF305A<br>AF305B<br>PLUMBING<br>P00-00<br>PD02-00<br>PD02-01<br>PD02-02A<br>PD02-02B  | GENERAL INFORMATION - PLUMBING  UNDERFLOOR DEMOLITION PLAN - PLUMBING  DEMOLITION PLAN - LEVEL 1 - SECTOR A - KITCHEN, SERVERY & DINING - PLUMBING  DEMOLITION PLAN - LEVEL 02 - SECTOR A - PLUMBING  DEMOLITION PLAN - LEVEL 02 - SECTOR B - PLUMBING  | x<br>x<br>x<br>x                                    |                   | D                   |                     |      |
| AF304B<br>AF305A<br>AF305B<br>PLUMBING<br>P00-00<br>PD02-00<br>PD02-01<br>PD02-02A<br>PD02-02B  | GENERAL INFORMATION - PLUMBING  UNDERFLOOR DEMOLITION PLAN - PLUMBING  DEMOLITION PLAN - LEVEL 1 - SECTOR A - KITCHEN, SERVERY & DINING - PLUMBING  DEMOLITION PLAN - LEVEL 02 - SECTOR A - PLUMBING  DEMOLITION PLAN - LEVEL 02 - SECTOR B - PLUMBING  DEMOLITION PLAN - LEVEL 03 - SECTOR A - PLUMBING  | X<br>X<br>X<br>X<br>X                               |                   | R<br>R              |                     |      |
| AF304B AF305A AF305B  PLUMBING P00-00 PD02-00 PD02-01 PD02-02A PD02-02B PD02-03A PD02-03B PD03-01   | GENERAL INFORMATION - PLUMBING  UNDERFLOOR DEMOLITION PLAN - PLUMBING  DEMOLITION PLAN - LEVEL 1 - SECTOR A - KITCHEN, SERVERY & DINING - PLUMBING  DEMOLITION PLAN - LEVEL 02 - SECTOR A - PLUMBING  DEMOLITION PLAN - LEVEL 02 - SECTOR B - PLUMBING  DEMOLITION PLAN - LEVEL 03 - SECTOR A - PLUMBING  DEMOLITION PLAN - LEVEL 03 - SECTOR B - PLUMBING  DEMOLITION PLAN - LEVEL 01 - KITCHEN, SERVERY & DINING - MEDICAL GAS  | X<br>X<br>X<br>X<br>X<br>X                          |                   |                     |                     |      |
| AF304B AF305A AF305B  PLUMBING P00-00 PD02-00 PD02-01 PD02-02A PD02-03A PD02-03B PD03-01 PD03-02A PD03-02A  | GENERAL INFORMATION - PLUMBING  UNDERFLOOR DEMOLITION PLAN - PLUMBING  DEMOLITION PLAN - LEVEL 1 - SECTOR A - KITCHEN, SERVERY & DINING - PLUMBING  DEMOLITION PLAN - LEVEL 02 - SECTOR A - PLUMBING  DEMOLITION PLAN - LEVEL 02 - SECTOR B - PLUMBING  DEMOLITION PLAN - LEVEL 03 - SECTOR A - PLUMBING  DEMOLITION PLAN - LEVEL 03 - SECTOR B - PLUMBING  DEMOLITION PLAN - LEVEL 01 - KITCHEN, SERVERY & DINING - MEDICAL GAS  DEMOLITION PLAN - LEVEL 02 - SECTOR A - MEDICAL GAS  UNDERFLOOR PLAN - PLUMBING   | X<br>X<br>X<br>X<br>X<br>X<br>X                     | R                 | R                   |                     | F    |
| AF304B AF305A AF305B  PLUMBING P00-00 PD02-00 PD02-01 PD02-02A PD02-02B PD02-03A PD02-03B PD03-01 PD03-02A  | GENERAL INFORMATION - PLUMBING  UNDERFLOOR DEMOLITION PLAN - PLUMBING  DEMOLITION PLAN - LEVEL 1 - SECTOR A - KITCHEN, SERVERY & DINING - PLUMBING  DEMOLITION PLAN - LEVEL 02 - SECTOR A - PLUMBING  DEMOLITION PLAN - LEVEL 02 - SECTOR B - PLUMBING  DEMOLITION PLAN - LEVEL 03 - SECTOR A - PLUMBING  DEMOLITION PLAN - LEVEL 03 - SECTOR B - PLUMBING  DEMOLITION PLAN - LEVEL 01 - KITCHEN, SERVERY & DINING - MEDICAL GAS  DEMOLITION PLAN - LEVEL 02 - SECTOR A - MEDICAL GAS   | X<br>X<br>X<br>X<br>X<br>X<br>X                     | R<br>R            |                     |                     | F    |
| AF304B AF305A AF305B  PLUMBING P00-00 PD02-00 PD02-01 PD02-02A PD02-03A PD02-03B PD03-01 PD03-02A P02-00 P02-01 P02-02A   | GENERAL INFORMATION - PLUMBING  UNDERFLOOR DEMOLITION PLAN - PLUMBING  DEMOLITION PLAN - LEVEL 1 - SECTOR A - KITCHEN, SERVERY & DINING - PLUMBING  DEMOLITION PLAN - LEVEL 02 - SECTOR A - PLUMBING  DEMOLITION PLAN - LEVEL 02 - SECTOR B - PLUMBING  DEMOLITION PLAN - LEVEL 03 - SECTOR A - PLUMBING  DEMOLITION PLAN - LEVEL 03 - SECTOR B - PLUMBING  DEMOLITION PLAN - LEVEL 01 - KITCHEN, SERVERY & DINING - MEDICAL GAS  DEMOLITION PLAN - LEVEL 02 - SECTOR A - MEDICAL GAS  UNDERFLOOR PLAN - PLUMBING  FLOOR PLAN - LEVEL 01 - SECTOR A - KITCHEN, SERVERY & DINING - PLUMBING  FLOOR PLAN - LEVEL 02 - SECTOR A - PLUMBING  FLOOR PLAN - LEVEL 02 - SECTOR B - PLUMBING  | X<br>X<br>X<br>X<br>X<br>X<br>X<br>X<br>X           |                   | R R                 |                     | F    |
| AF304B AF305A AF305B  PLUMBING P00-00 P002-00 PD02-01 PD02-02A PD02-03B PD02-03B PD03-01 PD03-02A P02-00 P02-01 P02-01  | GENERAL INFORMATION - PLUMBING  UNDERFLOOR DEMOLITION PLAN - PLUMBING  DEMOLITION PLAN - LEVEL 1 - SECTOR A - KITCHEN, SERVERY & DINING - PLUMBING  DEMOLITION PLAN - LEVEL 02 - SECTOR A - PLUMBING  DEMOLITION PLAN - LEVEL 02 - SECTOR B - PLUMBING  DEMOLITION PLAN - LEVEL 03 - SECTOR A - PLUMBING  DEMOLITION PLAN - LEVEL 03 - SECTOR B - PLUMBING  DEMOLITION PLAN - LEVEL 01 - KITCHEN, SERVERY & DINING - MEDICAL GAS  DEMOLITION PLAN - LEVEL 02 - SECTOR A - MEDICAL GAS  UNDERFLOOR PLAN - PLUMBING  FLOOR PLAN - LEVEL 01 - SECTOR A - KITCHEN, SERVERY & DINING - PLUMBING  FLOOR PLAN - LEVEL 02 - SECTOR A - PLUMBING   | X<br>X<br>X<br>X<br>X<br>X<br>X<br>X<br>X           |                   | R                   |                     |      |
| AF304B AF305A AF305B  PLUMBING P00-00 P002-00 PD02-01 PD02-02A PD02-03A PD03-01 PD03-02A P02-01 P02-02A P02-03A P02-03A P02-03B P03-01  | GENERAL INFORMATION - PLUMBING  UNDERFLOOR DEMOLITION PLAN - PLUMBING  DEMOLITION PLAN - LEVEL 1 - SECTOR A - KITCHEN, SERVERY & DINING - PLUMBING  DEMOLITION PLAN - LEVEL 02 - SECTOR A - PLUMBING  DEMOLITION PLAN - LEVEL 03 - SECTOR B - PLUMBING  DEMOLITION PLAN - LEVEL 03 - SECTOR B - PLUMBING  DEMOLITION PLAN - LEVEL 03 - SECTOR B - PLUMBING  DEMOLITION PLAN - LEVEL 01 - KITCHEN, SERVERY & DINING - MEDICAL GAS  DEMOLITION PLAN - LEVEL 02 - SECTOR A - MEDICAL GAS  UNDERFLOOR PLAN - PLUMBING  FLOOR PLAN - LEVEL 01 - SECTOR A - PLUMBING  FLOOR PLAN - LEVEL 02 - SECTOR A - PLUMBING  FLOOR PLAN - LEVEL 03 - SECTOR B - PLUMBING  FLOOR PLAN - LEVEL 03 - SECTOR A - PLUMBING  FLOOR PLAN - LEVEL 03 - SECTOR B - PLUMBING  FLOOR PLAN - LEVEL 03 - SECTOR B - PLUMBING  FLOOR PLAN - LEVEL 03 - SECTOR B - PLUMBING  FLOOR PLAN - LEVEL 01 - KITCHEN, SERVERY & DINING - MEDICAL GAS   | X<br>X<br>X<br>X<br>X<br>X<br>X<br>X<br>X<br>X<br>X |                   | R R R R             |                     |      |
| AF304B AF305A AF305B  PLUMBING P00-00 PD02-00 PD02-01 PD02-02A PD02-03A PD03-01 PD03-02A P02-00 P02-01 P02-02A P02-03A P02-03B  | GENERAL INFORMATION - PLUMBING  UNDERFLOOR DEMOLITION PLAN - PLUMBING  DEMOLITION PLAN - LEVEL 1 - SECTOR A - KITCHEN, SERVERY & DINING - PLUMBING  DEMOLITION PLAN - LEVEL 02 - SECTOR A - PLUMBING  DEMOLITION PLAN - LEVEL 02 - SECTOR B - PLUMBING  DEMOLITION PLAN - LEVEL 03 - SECTOR A - PLUMBING  DEMOLITION PLAN - LEVEL 03 - SECTOR B - PLUMBING  DEMOLITION PLAN - LEVEL 01 - KITCHEN, SERVERY & DINING - MEDICAL GAS  DEMOLITION PLAN - LEVEL 02 - SECTOR A - MEDICAL GAS  UNDERFLOOR PLAN - PLUMBING  FLOOR PLAN - LEVEL 01 - SECTOR A - KITCHEN, SERVERY & DINING - PLUMBING  FLOOR PLAN - LEVEL 02 - SECTOR A - PLUMBING  FLOOR PLAN - LEVEL 03 - SECTOR B - PLUMBING  FLOOR PLAN - LEVEL 03 - SECTOR B - PLUMBING  FLOOR PLAN - LEVEL 03 - SECTOR B - PLUMBING  | X X X X X X X X X X X X X X X X X X X               |                   | R R R R             |                     |      |
| AF304B AF305A AF305B  PLUMBING P00-00 P002-00 PD02-01 PD02-02A PD02-03A PD03-01 PD03-02A P02-00 P02-01 P02-02B P02-03B P02-03B P02-03B P02-03B P02-03B P03-01 P03-03A P03-03B                   | GENERAL INFORMATION - PLUMBING  UNDERFLOOR DEMOLITION PLAN - PLUMBING  DEMOLITION PLAN - LEVEL 1 - SECTOR A - KITCHEN, SERVERY & DINING - PLUMBING  DEMOLITION PLAN - LEVEL 02 - SECTOR A - PLUMBING  DEMOLITION PLAN - LEVEL 03 - SECTOR B - PLUMBING  DEMOLITION PLAN - LEVEL 03 - SECTOR B - PLUMBING  DEMOLITION PLAN - LEVEL 03 - SECTOR B - PLUMBING  DEMOLITION PLAN - LEVEL 01 - KITCHEN, SERVERY & DINING - MEDICAL GAS  DEMOLITION PLAN - LEVEL 02 - SECTOR A - MEDICAL GAS  UNDERFLOOR PLAN - PLUMBING  FLOOR PLAN - LEVEL 01 - SECTOR A - KITCHEN, SERVERY & DINING - PLUMBING  FLOOR PLAN - LEVEL 02 - SECTOR A - PLUMBING  FLOOR PLAN - LEVEL 03 - SECTOR B - PLUMBING  FLOOR PLAN - LEVEL 03 - SECTOR B - PLUMBING  FLOOR PLAN - LEVEL 03 - SECTOR B - PLUMBING  FLOOR PLAN - LEVEL 03 - SECTOR B - PLUMBING  FLOOR PLAN - LEVEL 03 - SECTOR B - PLUMBING  FLOOR PLAN - LEVEL 03 - SECTOR B - PLUMBING  FLOOR PLAN - LEVEL 03 - SECTOR B - PLUMBING  FLOOR PLAN - LEVEL 03 - SECTOR B - MEDICAL GAS  FLOOR PLAN - LEVEL 03 - SECTOR A - MEDICAL GAS  FLOOR PLAN - LEVEL 03 - SECTOR A - MEDICAL GAS  FLOOR PLAN - LEVEL 03 - SECTOR B - MEDICAL GAS  FLOOR PLAN - LEVEL 03 - SECTOR B - MEDICAL GAS  | X X X X X X X X X X X X X X X X X X X               |                   | R R R R             |                     |      |
| AF304B AF305A AF305B  PLUMBING P00-00 P002-00 PD02-01 PD02-02A PD02-03B PD03-01 PD03-02A P02-03A P02-03B P02-03A P02-03B P03-01 P02-03A P03-03A P03-03A P03-03A P03-03B P03-03B P03-03B P03-03B | GENERAL INFORMATION - PLUMBING  UNDERFLOOR DEMOLITION PLAN - PLUMBING  DEMOLITION PLAN - LEVEL 1 - SECTOR A - KITCHEN, SERVERY & DINING - PLUMBING  DEMOLITION PLAN - LEVEL 02 - SECTOR A - PLUMBING  DEMOLITION PLAN - LEVEL 03 - SECTOR B - PLUMBING  DEMOLITION PLAN - LEVEL 03 - SECTOR A - PLUMBING  DEMOLITION PLAN - LEVEL 03 - SECTOR B - PLUMBING  DEMOLITION PLAN - LEVEL 01 - KITCHEN, SERVERY & DINING - MEDICAL GAS  DEMOLITION PLAN - LEVEL 02 - SECTOR A - MEDICAL GAS  UNDERFLOOR PLAN - PLUMBING  FLOOR PLAN - LEVEL 01 - SECTOR A - KITCHEN, SERVERY & DINING - PLUMBING  FLOOR PLAN - LEVEL 02 - SECTOR A - PLUMBING  FLOOR PLAN - LEVEL 03 - SECTOR B - PLUMBING  FLOOR PLAN - LEVEL 03 - SECTOR B - PLUMBING  FLOOR PLAN - LEVEL 03 - SECTOR B - PLUMBING  FLOOR PLAN - LEVEL 03 - SECTOR B - PLUMBING  FLOOR PLAN - LEVEL 03 - SECTOR A - MEDICAL GAS  FLOOR PLAN - LEVEL 03 - SECTOR A - MEDICAL GAS  FLOOR PLAN - LEVEL 03 - SECTOR B - MEDICAL GAS  FLOOR PLAN - LEVEL 03 - SECTOR B - MEDICAL GAS  FLOOR PLAN - LEVEL 03 - SECTOR B - MEDICAL GAS  FLOOR PLAN - LEVEL 03 - SECTOR B - MEDICAL GAS  FLOOR PLAN - LEVEL 03 - SECTOR B - MEDICAL GAS  FLOOR PLAN - LEVEL 03 - SECTOR B - MEDICAL GAS  FLOOR PLAN - LEVEL 03 - SECTOR B - MEDICAL GAS  FLOOR PLAN - LEVEL 03 - SECTOR B - MEDICAL GAS  FLOOR PLAN - LEVEL 03 - SECTOR B - MEDICAL GAS  FLOOR PLAN - LEVEL 03 - SECTOR B - MEDICAL GAS  FLOOR PLAN - LEVEL 03 - SECTOR B - MEDICAL GAS  RISER DIAGRAM - PLUMBING  RISER DIAGRAM - PLUMBING | X X X X X X X X X X X X X X X X X X X               |                   | R R R R             |                     |      |
| AF304B AF305A AF305B  PLUMBING P00-00 P002-00 PD02-01 PD02-02A PD02-03A PD03-01 P02-02B P02-03A P02-03B P02-03A P02-03B P03-01 P03-02A P03-03A P03-03A P03-03A P03-03A P03-03A P03-03A P03-03B  | GENERAL INFORMATION - PLUMBING  UNDERFLOOR DEMOLITION PLAN - PLUMBING  DEMOLITION PLAN - LEVEL 1 - SECTOR A - KITCHEN, SERVERY & DINING - PLUMBING  DEMOLITION PLAN - LEVEL 02 - SECTOR A - PLUMBING  DEMOLITION PLAN - LEVEL 03 - SECTOR B - PLUMBING  DEMOLITION PLAN - LEVEL 03 - SECTOR B - PLUMBING  DEMOLITION PLAN - LEVEL 03 - SECTOR B - PLUMBING  DEMOLITION PLAN - LEVEL 01 - KITCHEN, SERVERY & DINING - MEDICAL GAS  DEMOLITION PLAN - LEVEL 02 - SECTOR A - MEDICAL GAS  UNDERFLOOR PLAN - PLUMBING  FLOOR PLAN - LEVEL 01 - SECTOR A - KITCHEN, SERVERY & DINING - PLUMBING  FLOOR PLAN - LEVEL 02 - SECTOR A - PLUMBING  FLOOR PLAN - LEVEL 03 - SECTOR B - PLUMBING  FLOOR PLAN - LEVEL 03 - SECTOR B - PLUMBING  FLOOR PLAN - LEVEL 03 - SECTOR B - PLUMBING  FLOOR PLAN - LEVEL 03 - SECTOR B - PLUMBING  FLOOR PLAN - LEVEL 03 - SECTOR B - PLUMBING  FLOOR PLAN - LEVEL 03 - SECTOR B - PLUMBING  FLOOR PLAN - LEVEL 03 - SECTOR B - MEDICAL GAS  FLOOR PLAN - LEVEL 03 - SECTOR A - MEDICAL GAS  FLOOR PLAN - LEVEL 03 - SECTOR B - MEDICAL GAS  FLOOR PLAN - LEVEL 03 - SECTOR B - MEDICAL GAS  FLOOR PLAN - LEVEL 03 - SECTOR B - MEDICAL GAS  FLOOR PLAN - LEVEL 03 - SECTOR B - MEDICAL GAS  FLOOR PLAN - LEVEL 03 - SECTOR B - MEDICAL GAS  FLOOR PLAN - LEVEL 03 - SECTOR B - MEDICAL GAS  FLOOR PLAN - LEVEL 03 - SECTOR B - MEDICAL GAS  FLOOR PLAN - LEVEL 03 - SECTOR B - MEDICAL GAS  RISER DIAGRAM - PLUMBING   | X X X X X X X X X X X X X X X X X X X               |                   | R R R R             |                     |      |
| AF304B AF305A AF305B  PLUMBING P00-00 P002-00 PD02-01 PD02-02A PD02-03B PD03-01 PD03-02A P02-03A P02-03B P02-03A P02-03B P03-01 P02-03A P03-03A P03-03A P03-03A P03-03B P03-03B P03-03B P03-03B | GENERAL INFORMATION - PLUMBING  UNDERFLOOR DEMOLITION PLAN - PLUMBING  DEMOLITION PLAN - LEVEL 1 - SECTOR A - KITCHEN, SERVERY & DINING - PLUMBING  DEMOLITION PLAN - LEVEL 02 - SECTOR A - PLUMBING  DEMOLITION PLAN - LEVEL 02 - SECTOR B - PLUMBING  DEMOLITION PLAN - LEVEL 03 - SECTOR A - PLUMBING  DEMOLITION PLAN - LEVEL 03 - SECTOR B - PLUMBING  DEMOLITION PLAN - LEVEL 01 - KITCHEN, SERVERY & DINING - MEDICAL GAS  DEMOLITION PLAN - LEVEL 02 - SECTOR A - MEDICAL GAS  UNDERFLOOR PLAN - PLUMBING  FLOOR PLAN - LEVEL 01 - SECTOR A - KITCHEN, SERVERY & DINING - PLUMBING  FLOOR PLAN - LEVEL 02 - SECTOR A - PLUMBING  FLOOR PLAN - LEVEL 03 - SECTOR B - PLUMBING  FLOOR PLAN - LEVEL 03 - SECTOR B - PLUMBING  FLOOR PLAN - LEVEL 03 - SECTOR B - PLUMBING  FLOOR PLAN - LEVEL 03 - SECTOR A - MEDICAL GAS  FLOOR PLAN - LEVEL 03 - SECTOR B - MEDICAL GAS  FLOOR PLAN - LEVEL 03 - SECTOR A - MEDICAL GAS  FLOOR PLAN - LEVEL 03 - SECTOR B - MEDICAL GAS  FLOOR PLAN - LEVEL 03 - SECTOR B - MEDICAL GAS  FLOOR PLAN - LEVEL 03 - SECTOR B - MEDICAL GAS  FLOOR PLAN - LEVEL 03 - SECTOR B - MEDICAL GAS  FLOOR PLAN - LEVEL 03 - SECTOR B - MEDICAL GAS  FLOOR PLAN - LEVEL 03 - SECTOR B - MEDICAL GAS  FLOOR PLAN - LEVEL 03 - SECTOR B - MEDICAL GAS  FLOOR PLAN - LEVEL 03 - SECTOR B - MEDICAL GAS  FLOOR PLAN - LEVEL 03 - SECTOR B - MEDICAL GAS  FLOOR PLAN - LEVEL 03 - SECTOR B - MEDICAL GAS  RISER DIAGRAM - PLUMBING  RISER DIAGRAM - PLUMBING  RISER DIAGRAM - PLUMBING                    | X X X X X X X X X X X X X X X X X X X               |                   | R R R R             |                     | R    |

|  | X = ISSUED SHEET  | /24          | /25        | /25          | /25                 |
|--|---|--------------|------------|--------------|---------------------|
|  | R = REVISED SHEET   | - 12/05/24   | 02/06/25   | 02/06/25     | 06/06/25            |
|  | F = FOR REFERENCE ONLY D = DELETED SHEET  |              | - 02       | - 05         | 90                  |
|  | D - DELETED SHEET   | /IEW         |            | Z            | z                   |
|  |   | - 1ST REVIEW | IEW        | INATIO       | INATIO              |
|  |   | & STATE -    | 2ND REVIEW | COORDINATION | DESIGN COORDINATION |
| SHEET<br>NUMBER  | SHEET NAME  | CITY & S     | CITY - 2   | DESIGN       | DESIGN              |
| MECHANICA  | 1   |              |            |              |                     |
| M00-00   | GENERAL INFORMATION - MECHANICAL  | Х            |            |              |                     |
| M01-01   | CONTROLS - MECHANICAL   | Х            |            |              |                     |
| M01-02   | CONTROLS - MECHANICAL   | Х            |            |              |                     |
| M01-03   | CONTROLS - MECHANICAL   | Х            |            |              |                     |
| M01-04   | CONTROLS - MECHANICAL   | X            |            |              |                     |
| M01-05   | CONTROLS - MECHANICAL   | X            |            |              |                     |
| M01-06<br>M01-07   | CONTROLS - MECHANICAL  CONTROLS - MECHANICAL  | X            |            |              |                     |
| MD02-01  | DEMOLITION PLAN - LEVEL 01 - KITCHEN, SERVERY & DINING - HVAC   | X            |            |              |                     |
|  | DEMOLITION PLAN - LEVEL 02 - SECTOR A HVAC  | Х            |            |              |                     |
| MD02-02B   | DEMOLITION PLAN - LEVEL 02 - SECTOR B HVAC  | Х            |            |              |                     |
| MD02-03A   | DEMOLITION PLAN - LEVEL 03 - SECTOR A HVAC  | Х            |            |              | R                   |
| MD02-03B   | DEMOLITION PLAN - LEVEL 03 - SECTOR B HVAC  | Х            |            |              | R                   |
|  | DEMOLITION PLAN - LEVEL 01 - KITCHEN, SERVERY & DINING - HVAC PIPING  | Х            |            |              |                     |
|  | DEMOLITION PLAN - LEVEL 01 - KITCHEN, SERVERY & DINING - SECTOR C HVAC PIPING   | X            |            |              |                     |
|  | DEMOLITION PLAN - LEVEL 03 - SECTOR A HVAC PIPING  DEMOLITION PLAN - LEVEL 03 - SECTOR B HVAC PIPING                            | X            |            |              |                     |
| M02-00   | SITE PLAN - MECHANICAL PLAN   | X            |            |              |                     |
| M02-01   | FLOOR PLAN - LEVEL 01 - KITCHEN, SERVERY & DINING - HVAC  | X            | R          | R            |                     |
| M02-02A  | FLOOR PLAN - LEVEL 02 - SECTOR A HVAC   | X            | -          | -            |                     |
| M02-02B  | FLOOR PLAN - LEVEL 02 - SECTOR B HVAC   | Х            |            |              |                     |
| M02-03A  | FLOOR PLAN - LEVEL 03 - SECTOR A HVAC   | X            |            |              | R                   |
| M02-03B  | FLOOR PLAN - LEVEL 03 - SECTOR B HVAC   | Х            |            | R            | R                   |
| M03-01   | FLOOR PLAN - LEVEL 01 - KITCHEN, SERVERY & DINING - HVAC PIPING   | X            | R          |              | _                   |
| M03-03A<br>M03-03B   | FLOOR PLAN - LEVEL 03 - SECTOR A HVAC PIPING FLOOR PLAN - LEVEL 03 - SECTOR B HVAC PIPING                                       | X            |            | R            | R                   |
| M05-03B  | ENLARGED PLAN - MECHANICAL  | X            |            | R            |                     |
| M06-01   | RISER DIAGRAM - MECHANICAL  | X            |            | R            |                     |
| M06-02   | RISER DIAGRAM - MECHANICAL  | Х            |            |              |                     |
| M06-03   | RISER DIAGRAM - MECHANICAL  | Х            |            |              |                     |
| M07-01   | DETAILS - MECHANICAL  | Х            |            |              |                     |
| M07-02   | DETAILS - MECHANICAL  | X            |            |              |                     |
| M07-03   | DETAILS - MECHANICAL  | X            |            |              |                     |
| M07-04   | DETAILS - MECHANICAL  | X            |            |              |                     |
| M07-05<br>M08-01   | DETAILS - MECHANICAL SCHEDULES - MECHANICAL   | X            |            | R            |                     |
| M08-01   | SCHEDULES - MECHANICAL SCHEDULES - MECHANICAL   | X            |            | - N          |                     |
|  | SCHEDULES - MECHANICAL  | Х            |            | R            |                     |
| M08-04   | SCHEDULES - MECHANICAL  | Х            |            | R            |                     |
|  |   |              |            |              |                     |
| MEPD02   | ATTACHED MADD DOOF DEMANISTICAL DIAM  |              |            |              |                     |
| -03  | ATTACHED MOB ROOF DEMOLITION PLAN   | Х            |            |              |                     |
|  | SITE PLAN - UNDERGROUND - MEP   | X            |            |              |                     |
|  | ROOF PLAN - AREA D - MEP  | X            | R          |              | _                   |
|  | ATTACHED MOB ROOF PLAN - MEP  ROOF PLAN - AREA A - MEP  | X            | R          |              |                     |
|  | ROOF PLAN - AREA B - MEP  | X            |            |              |                     |
|  | NOOT TE WY THIEF THE  |              |            |              |                     |
| ELECTRICAL   |   |              |            |              |                     |
| E00-00   | GENERAL INFORMATION - ELECTRICAL  | X            |            |              |                     |
| ED02-01  | DEMOLITION PLAN - LEVEL 01 - SECTOR A - KITCHEN, SERVERY & DINING - ELECTRICAL  | X            |            |              |                     |
|  | DEMOLITION PLAN - LEVEL 03 - SECTOR A - ELECTRICAL  DEMOLITION PLAN - LEVEL 03 - SECTOR B - ELECTRICAL                          | X            |            |              |                     |
| E01-01   | SITE PLAN - PHOTOMETRICS  | X            |            | R            |                     |
| E01-02   | SITE PLAN - ELECTRICAL  | X            |            | - 11         |                     |
| E02-01   | FLOOR PLAN - LEVEL 01 SECTOR A - KITCHEN, SERVERY & DINING - POWER  | Х            |            | R            | R                   |
| E02-03A  | FLOOR PLAN - LEVEL 03 - SECTOR A POWER  | Х            |            | R            | R                   |
| E02-03B  | FLOOR PLAN - LEVEL 03 - SECTOR B POWER  | X            |            | R            | R                   |
| E03-01   | FLOOR PLAN - LEVEL 01 - SECTOR A - KITCHEN, SERVERY & DINING - LIGHTING   | X            |            |              |                     |
| E03-03A  | FLOOR PLAN - LEVEL 03 - SECTOR A LIGHTING   | X            |            | R            | R                   |
| E03-03B<br>E04-01  | FLOOR PLAN - LEVEL 03 - SECTOR B LIGHTING FLOOR PLAN - LEVEL 01 - SECTOR A - KITCHEN, SERVERY & DINING - SPECIAL SYSTEMS        | X            |            | R            | R                   |
| E04-01   | FLOOR PLAN - LEVEL 01 - SECTOR A - KITCHEN, SERVERY & DINING - SPECIAL SYSTEMS FLOOR PLAN - LEVEL 03 - SECTOR A SPECIAL SYSTEMS | X            |            | R            | R                   |
| E04-03B  | FLOOR PLAN - LEVEL 03 - SECTOR B SPECIAL SYSTEMS  | X            |            | R            | '`                  |
| E05-01   | ENLARGED PLANS - ELECTRICAL   | X            |            |              | R                   |
| E05-02   | ENLARGED PLANS - ELECTRICAL   | Х            |            | R            |                     |
| E06-01   | ONE LINE DIAGRAM - ELECTRICAL   | Х            |            | R            |                     |
| E06-02   | ONE LINE DIAGRAM - ELECTRICAL   | Х            |            | R            |                     |
| E06-03   | ONE LINE DIAGRAM - ELECTRICAL   | X            |            | R            |                     |
|  | DEMO ONE LINE DIAGRAM - ELECTRICAL  | X            |            |              | -                   |
| E06-04   | ONE LINE DIAGRAM - ELECTRICAL   | X            |            |              | R                   |
| E06-04<br>E06-05   | DETAILS - ELECTRICAL  | V            |            |              |                     |
| E06-04<br>E06-05<br>E07-01   | DETAILS - ELECTRICAL DETAIL - FLECTRICAL  | X            |            | P            |                     |
| E06-04<br>E06-05<br>E07-01<br>E07-02                               | DETAIL - ELECTRICAL   | Х            |            | R            |                     |
| E06-04<br>E06-05<br>E07-01   |   |              |            | R            |                     |
| E06-04<br>E06-05<br>E07-01<br>E07-02<br>E07-03                     | DETAIL - ELECTRICAL DETAILS - ELECTRICAL  | X            |            | R<br>R       |                     |
| E06-04<br>E06-05<br>E07-01<br>E07-02<br>E07-03<br>E08-01           | DETAIL - ELECTRICAL DETAILS - ELECTRICAL SCHEDULES - ELECTRICAL   | X<br>X<br>X  |            |              |                     |
| E06-04<br>E06-05<br>E07-01<br>E07-02<br>E07-03<br>E08-01<br>E08-02 | DETAIL - ELECTRICAL  DETAILS - ELECTRICAL  SCHEDULES - ELECTRICAL  SCHEDULES - ELECTRICAL                                       | X<br>X<br>X  |            |              |                     |

E08-05 SCHEDULES - ELECTRICAL
E08-06 SCHEDULES - ELECTRICAL

| SHEET I  | X = ISSUED SHEET   | 4                          | ι.           | B<br>B              | L)                  |
|--|--|----------------------------|--------------|---------------------|---------------------|
|  | X = ISSUED SHEET  R = REVISED SHEET  | - 12/05/24                 | 02/06/25     | 02/06/25            | 06/06/25            |
|  |  | 7/0                        | 7/0          | 7/0                 | 0/9                 |
|  | F = FOR REFERENCE ONLY   |                            | 0 -          | 0                   | 0                   |
|  | D = DELETED SHEET  | ΕW                         |              | _                   | _                   |
|  |  | - 1ST REVIEW               |              | DESIGN COORDINATION | DESIGN COORDINATION |
|  |  | 1ST                        | - 2ND REVIEW | Σ                   | A                   |
|  |  | щ                          | \EV          | SC                  |                     |
|  |  | CITY & STATE               | 9            |                     | 5                   |
|  |  | 8                          | - 2          | Z                   | Z                   |
| SHEET  |  | ₹                          | CITY         | ESIC                | FSIC                |
| NUMBER   | SHEET NAME   | ס                          | ַ            | □□                  |                     |
| TECHNOLOG  | SIES   |                            |              |                     |                     |
| T00-00   | GENERAL INFORMATION - TECHNOLOGY   | Х                          |              |                     |                     |
| TD02-01  | DEMOLITION PLAN - LEVEL 01 - SECTOR A - KITCHEN, SEVERY & DINING - COMMUNICATIONS  | Χ                          |              | R                   |                     |
| TD02-03A   | DEMOLITION PLAN - LEVEL 03 - SECTOR A COMMUNICATIONS   | Х                          |              |                     |                     |
| T02-01   | FLOOR PLAN - LEVEL 01 - SECTOR A - KITCHEN, SEVERY & DINING - COMMUNICATIONS   | Х                          |              |                     |                     |
| T02-03A  | FLOOR PLAN - LEVEL 03 - SECTOR A COMMUNICATIONS  | Х                          |              |                     | R                   |
| T02-03B  | FLOOR PLAN - LEVEL 03 - SECTOR B COMMUNICATIONS  | Χ                          |              |                     | R                   |
| T03-01   | FLOOR PLAN - LEVEL 1 - SECTOR A - KITCHEN, SEVERY & DINING - LOW VOLTAGE   | Χ                          |              |                     |                     |
| T03-03A  | FLOOR PLAN - LEVEL 03 - SECTOR A LOW VOLTAGE   | Х                          |              |                     |                     |
| T03-03B  | FLOOR PLAN - LEVEL 03- SECTOR B LOW VOLTAGE  | Х                          |              |                     | R                   |
| T04-01   | FLOOR PLAN - LEVEL 01 - KITCHEN, SEVERY & DINING - SECURITY  | Х                          |              |                     |                     |
| T04-03A  | FLOOR PLAN - LEVEL 03 - SECTOR A SECURITY  | Χ                          |              |                     |                     |
| T04-03B  | FLOOR PLAN - LEVEL 03- SECTOR B SECURITY   | Х                          |              |                     |                     |
| T05-01   | ENLARGED PLAN - TECHNOLOGY   | Х                          |              |                     |                     |
| T06-01   | RISER DIAGRAM - TECHNOLOGY   | Х                          |              |                     |                     |
| T07-01   | DETAILS - TECHNOLOGY   | Х                          |              |                     |                     |
| T07-02   | DETAILS - TECHNOLOGY   | Х                          |              |                     |                     |
| T07-03   | DETAILS - TECHNOLOGY   | Х                          |              |                     |                     |
| T07-04   | DETAILS - TECHNOLOGY   | Х                          |              |                     |                     |
| T08-01   | SCHEDULES - TECHNOLOGY   | Х                          |              |                     |                     |
| VENDOR (N  | EOPOD)   |                            |              |                     |                     |
| NP0.00   | VENDOR COVER SHEET   | F                          |              |                     |                     |
| NP1.3  | LEVEL 3 MODULE FLOOR PLAN  | F                          |              |                     |                     |
| NP1.3.1  | LEVEL 3 NEOPODWALL FLOOR PLAN  | F                          |              |                     |                     |
| NP1.3.2  | LEVEL 3 NEOPODWALL AXON  | F                          |              |                     |                     |
| NP3.01   | ENLARGED ROOM PLANS  | F                          |              |                     |                     |
| NP3.02   | ENLARGED MODULE VIEWS-BPR82  | F                          |              |                     |                     |
|  | ENLARGED MODULAR VIEWS   | F                          |              |                     |                     |
| NP3.03   | LINEARGED MIODOLAR VIEWS   |                            | 1            |                     |                     |
| NP3.03<br>NP3.52   | NEOPPODWALL DETAILS  | F                          |              |                     | 1                   |
|  |  | F<br>F                     |              |                     |                     |
| NP3.52   | NEOPPODWALL DETAILS  |                            |              |                     |                     |
| NP3.52<br>NP4.00   | NEOPPODWALL DETAILS NEOPODWALL ENLARGED FLOOR PLAN   | F                          |              |                     |                     |
| NP3.52<br>NP4.00<br>NP4.01   | NEOPPODWALL DETAILS NEOPODWALL ENLARGED FLOOR PLAN NEOPODWALL ENLARGED FLOOR PLAN  | F<br>F                     |              |                     |                     |
| NP3.52<br>NP4.00<br>NP4.01<br>NP4.02   | NEOPPODWALL DETAILS NEOPODWALL ENLARGED FLOOR PLAN NEOPODWALL ENLARGED FLOOR PLAN NEOPODWALL ENLARGED FLOOR PLAN   | F<br>F                     |              |                     |                     |
| NP3.52<br>NP4.00<br>NP4.01<br>NP4.02<br>NP4.03   | NEOPPODWALL DETAILS NEOPODWALL ENLARGED FLOOR PLAN NEOPODWALL ENLARGED FLOOR PLAN NEOPODWALL ENLARGED FLOOR PLAN NEOPODWALL ENLARGED FLOOR PLAN  | F<br>F<br>F                |              |                     |                     |
| NP3.52<br>NP4.00<br>NP4.01<br>NP4.02<br>NP4.03<br>NP4.04   | NEOPPODWALL ENLARGED FLOOR PLAN NEOPODWALL ENLARGED FLOOR PLAN   | F<br>F<br>F                |              |                     |                     |

Devenney Group Ltd., Architects


Suite 500 Scottsdale, AZ 85251 T: 602.943.8950

www.devenneygroup.com

6900 East Camelback Road

Consultant:

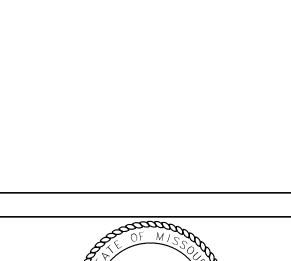

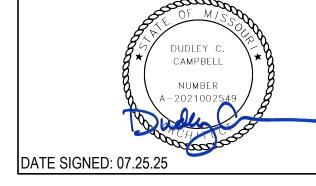

IF THESE PLANS DO NOT BEAR THE SEAL OF A REGISTRANT, THEY ARE TO BE CONSIDERED "PRELIMINARY" AND ARE NOT TO BE USED FOR CONSTRUCTION OR RECORDING. THESE PLANS ARE COPYRIGHTED AND ARE SUBJECT TO COPYRIGHT PROTECTION AS AN "ARCHITECTURAL WORK" UNDER SEC. 102 OF THE COPYRIGHT ACT, 17 U.S.O. AS AMENDED DECEMBER 1990 AND KNOWN AS ARCHITECTURAL WORKS COPYRIGHT PROTECTION ACT OF 1990. THE PROTECTION INCLUDES BUT IS NOT LIMITED TO THE OVERALL FORM AS WELL AS THE ARRANGEMENT AND COMPOSITION OF SPACES AND ELEMENTS OF THE DESIGN. UNDER SUCH PROTECTION, UNAUTHORIZED USE OF THESE PLANS CAN LEGALLY RESULT IN THE CESSATION OF CONSTRUCTION OR BUILDINGS BEING SEIZED AND/OR MONETARY COMPENSATION TO DEVENNEY GROUP LTD.

MED SURG &
DIETARY
EXPANSION

HCA - LEE'S SUMMIT

MEDICAL CENTER

2100 SE BLUE PKWY

LEE'S SUMMIT, MO 64063

AUTHORITY HAVING JURISDICTION:
CITY OF LEE'S SUMMIT BUILDING DEPT.
MISSOURI DHSS

FACILITY NUMBER: **0972400009** 

AGENCY APPROVALS:

| REVISIONS | REV # DESCRIPTION | DATE | A CITY - 2ND REVIEW | 2025/02/06 | B DESIGN COORDINATION | 2025/02/06 | 1 DESIGN COORDINATION | 2025/06/06 |


DESIGN COORDINATION

2025/07/25

DATE: 2024/12/05
SCALE: DRAWN:
REVIEWED: JOB NUMBER: 6406.24

SHEET INDEX

G1001

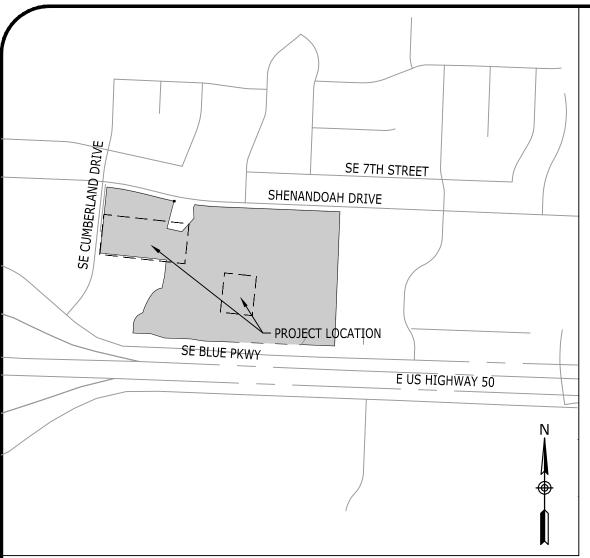

VICINITY MAP

NOT TO SCALE

#### SITE DATA

PARCEL ID.: 60-420-99-15-00-0-00-000 SITE ADDRESS EXISTING ZONING

0.04 AC. (1,766 FT<sup>2</sup>) DRIVES/SIDEWALKS: 0.94 AC. (40,787 FT<sup>2</sup>) TOTAL PROPOSED IMPERVIOUS AREA 0.98 AC. (42,553 FT<sup>2</sup>)

HOSPITAL:

5 SPACES / 1,000SF PROPOSED 26 BED FACILITY: 1.8 SPACES / BED

|  | LEE'S SUM           | IMIT MEDICA          | AL CENTER        |                   |                       |
|--|---------------------|----------------------|------------------|-------------------|-----------------------|
| COMPONENT  | EXISTING<br>PARKING | DISPLACED<br>PARKING | ADDED<br>PARKING | ACTUAL<br>PARKING | CODE REQUIRED PARKING |
| EXISTING (88 BEDS + 122,799 SF OF MOB'S          | 752                 | 0                    | 0                | 752               | 773                   |
| PROPOSED PROJECT - (26<br>BED ADD/TOTAL 114 BEDS | 752                 | 2                    | 75               | 825               | 820                   |

TOTAL PARKING REQUIRED:

88 BEDS X 1.8 SPACES = 159 SPACES REQUIRED 614 SPACES REQUIRED (122,799 SF OF MOB'S / 1,000SF) X 5 = 26 BEDS X 1.8 SPACES = 47 SPACES REQUIRED TOTAL REQUIRED: 820 SPACES REQUIRED **EXISTING PARKING:** 752 SPACES

PARKING PROVIDED:

STANDARD PARKING: 795 SPACES ADA PARKING: TOTAL PROVIDED PARKING:

THE 30 EXISTING ADA SPACES EXCEED THE ADA PARKING REQUIREMENT (17 ADA SPACES) WITH THE REMOTE PARKING LOT ADDITION.

OWNER: ADDRESS:

MIDWEST DIVISION LSH LLC PO BOX 80610 INDIANAPOLIS, IN 46280

PROJECT REPRESENTATIVE: CATALYST DESIGN GROUP ADDRESS: 1524 WILLIAMS DRIVE MURFREESBORO, TN 37129

PHONE NO.: 615-701-6411 CONTACT NAME: JACK PARKER CONTACT E-MAIL ADDRESS: jparker@catalyst-dg.com

THE SUBJECT PROPERTY DOES NOT LIE WITHIN A SPECIAL FLOOD HAZARD ZONE ACCORDING TO COMMUNITY PANEL NO. 29095C0439G, 01/20/2017, COMMUNITY NAME: JACKSON COUNTY.


### **LEGAL DESCRIPTION:**

A TRACT OF LAND IN THE NORTHWEST QUARTER OD SECTION 36, TOWNSHIP 48, RANGE 32 IN THE CITY OD LEE'S SUMMIT, JACKSON COUNTY, MISSOURI MORE PARTICULARLY DESCRIBED AS FOLLOWS: BEGINNING AT THE SOUTHEAST CORNER OF THE NORTHWEST QUARTER OF SAID SECTION 36; THENCE NORTH 86 DEGREES 19 MINUTES 41 SECONDS WEST, ALONG THE SOUTH LINE OF SAID NORTHWEST QUARTER OD SAID SECTION 36, 310.15 FEET TO A POINT ON THE WESTERLY RIGHT-OF-WAY LINE OF OLD MISSOURI HIGHWAY 50, SAID POINT BEING THE TRUE POINT OF BEGINNING; THENCE CONTINUING ALONG A PROLONGATION OF THE LAST DESCRIBED COURSE, 225.49 FEET TO A PONT ON THE EASTERLY RIGHT-OF-WAY LINE OF RELOCATED MISSOURI HIGHWAY 50; THENCE NORTHEASTERLY ALONG A CURVE TO THE LEFT, ALONG SAID EASTERLY RIGHT-OF-WAY LINE, HAVING A RADIAL BEARING OF NORTH 74 DEGREES 59 MINUTES 09 SECONDS WEST AND A RADIUS OF 1104.93 FEET AN ARC DISTANCE OF 140.47 FEET, SAID POINT BEING 150.00 FEET EASTERLY FROM STA. 11+26.6 ON RAMP 8 ON SAID RELOCATED MISSOURI HIGHWAY 50, AS MEASURED PERPENDICULAR THERETO; THENCE NORTH 7 DEGREES 43 MINUTES 49 SECONDS EAST, PARALLEL WITH SAID RAMP 8AND ALONG SAID EASTERLY RIGHT-OF-WAY LINE, 180.60 FEET TO A POINT 150.00 FEET RIGHT OF STA 13+07.20 ON SAID RAMP 8, AS MEASURED PERPENDICULAR THERETO; THENCE NORTHEASTERLY ALONG A CURVE TO THE RIGHT, ALONG SAID EASTERLY RIGHT-OF-WAY LINE HAVING A RADIAL BEARING OF SOUTH 82 DEGREES 16 MINUTES 11 SECONDS EAST AND A RADIUS OF 613.94 FEET AN ARC DISTANCE OF 23.99 FEET TO A POINT 150.00 FEET RIGHT OF STA 13+37.05 ON SAID RAMP 8, AS MEASURED PERPENDICULAR THERETO; THENCE NORTH 77 DEGREES 07 MINUTES 26 SECONDS EAST, ALONG THE SOUTHERLY RIGHT-OF-WAY LINE OF INTERSTATE ROUTE 470, 61.96 FEET (60.9 FEET RECORD) TO A POINT ON THE WESTERLY RIGHT-OF-WAY LINE OF OLD MISSOURI HIGHWAY 50, SAID POINT BEING 90.00 FEET RIGHT OF STA 540+50.00 AS MEASURED PERPENDICULAR THERETO; THENCE SOUTH 16 DEGREES 28 MINUTES 19 SECONDS EAST ALONG SAID WESTERLY RIGHT-OF-WAY LINE, 384.30 FEET TO THE TRUE POINT OF BEGINNING.

# CONSTRUCTION DOCUMENTS HCA - LEE'S SUMMIT MEDICAL CENTER

## LEE'S SUMMIT, JACKSON COUNTY COUNTY, MO

CATALYST PROJECT NO. 20240037 JULY 25, 2025

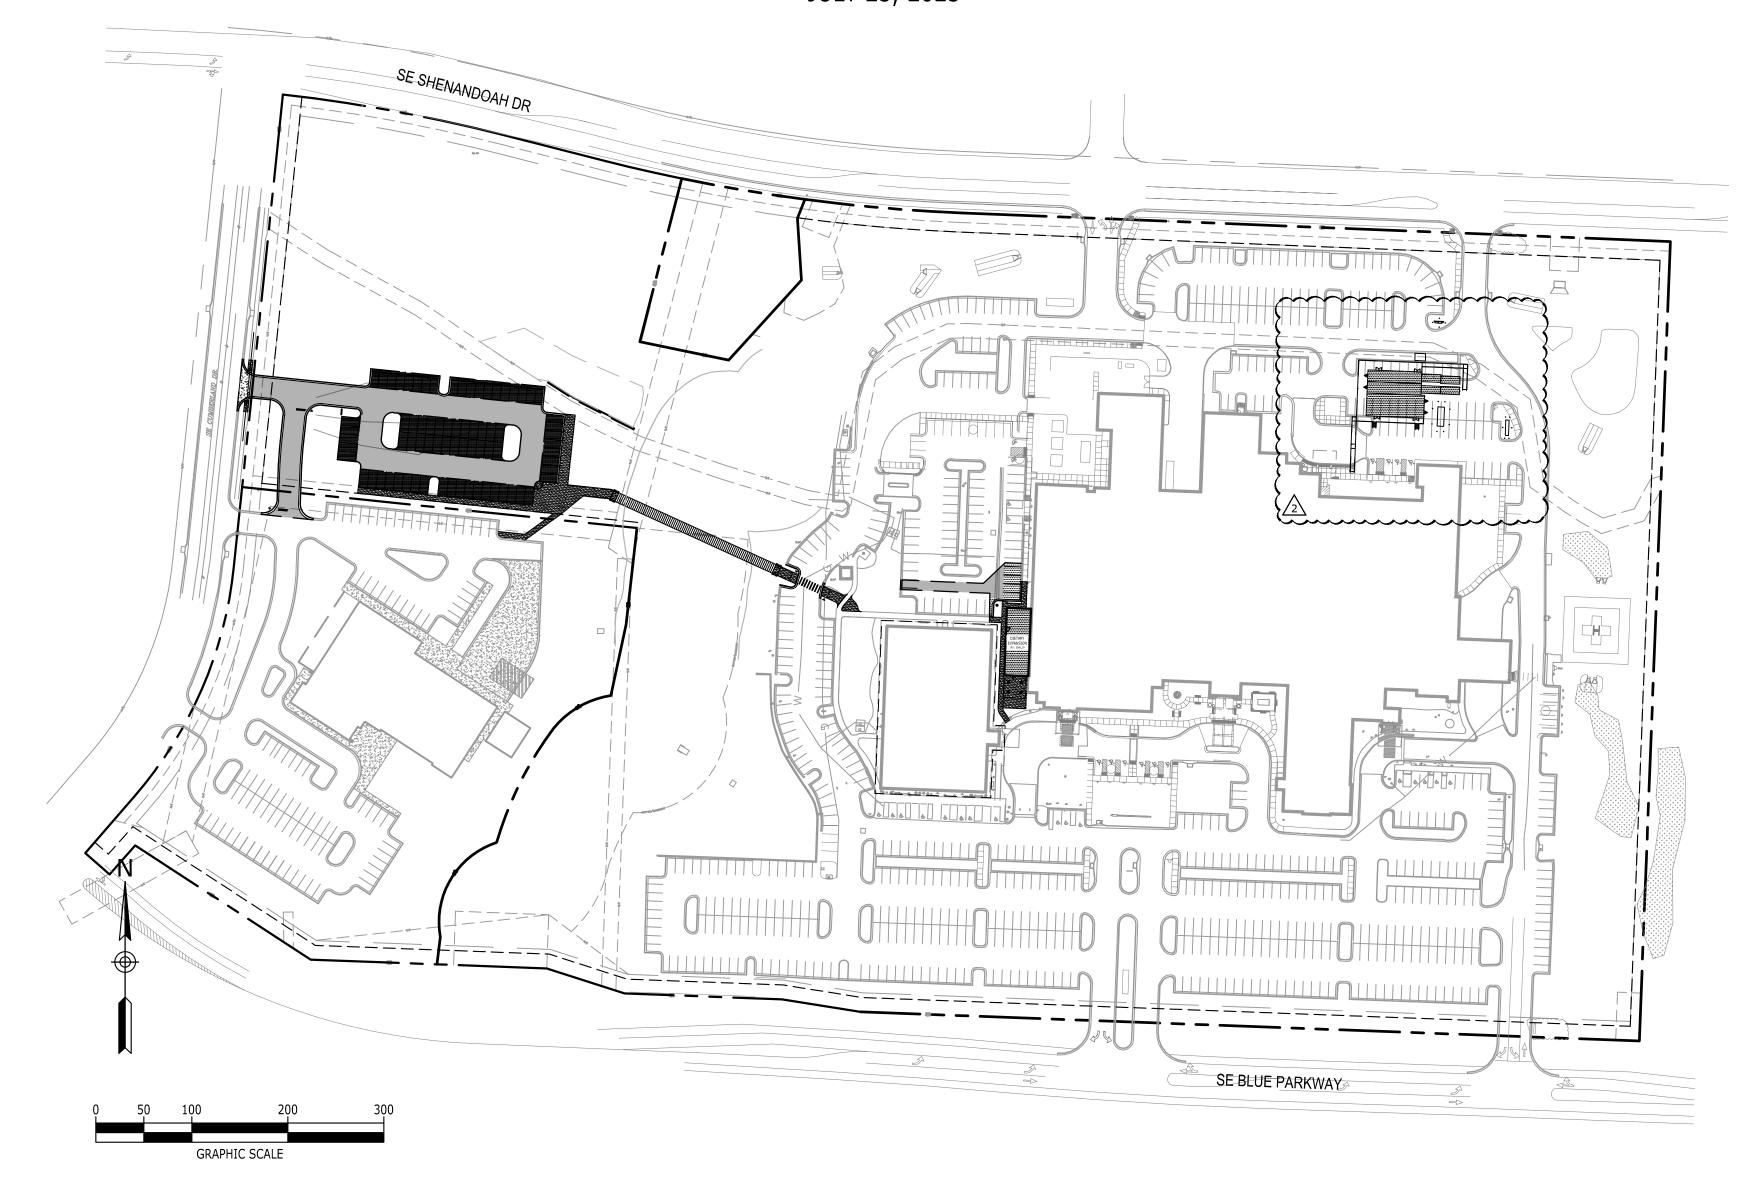

| Sheet List Table |                                      |  |  |  |
|------------------|--------------------------------------|--|--|--|
| Sheet Number     | Sheet Title                          |  |  |  |
| C0.0             | COVER SHEET                          |  |  |  |
| C1.0             | EXISTING CONDITIONS                  |  |  |  |
| C2.0             | GENERAL NOTES                        |  |  |  |
| C3.0             | INITIAL EROSION CONTROL PLAN         |  |  |  |
| C3.1             | FINAL EROSION CONTROL PLAN           |  |  |  |
| C3.2             | SEDIMENT AND EROSION CONTROL DETAILS |  |  |  |
| C3.3             | SEDIMENT AND EROSION CONTROL DETAILS |  |  |  |
| C4.0             | OVERALL DEMOLITION PLAN              |  |  |  |
| C4.1             | DETAILED DEMOLITION PLAN             |  |  |  |
| C4.2             | DETAILED DEMOLITION PLAN             |  |  |  |
| C5.0             | OVERALL LAYOUT PLAN                  |  |  |  |
| C5.1             | DETAILED LAYOUT PLAN                 |  |  |  |
| C5.2             | DETAILED LAYOUT PLAN                 |  |  |  |
| C5.3             | DETAILED LAYOUT PLAN 2               |  |  |  |
| C6.0             | OVERALL GRADING & DRAINAGE PLAN      |  |  |  |
| C6.1             | DETAILED GRADING & DRAINAGE PLAN     |  |  |  |
| C6.2             | DETAILED GRADING & DRAINAGE PLAN     |  |  |  |
| C6.3             | DETENTION BASIN DETAILS              |  |  |  |
| C6.4             | PEDESTRIAN BRIDGE PLAN & PROFILE     |  |  |  |
| C7.0             | OVERALL UTILITY PLAN                 |  |  |  |
| C7.1             | DETAILED UTILITY PLAN                |  |  |  |
| C8.0             | SITE DETAILS                         |  |  |  |
| C8.1             | SITE DETAILS                         |  |  |  |
| C8.2             | SITE DETAILS                         |  |  |  |
| L1.0             | OVERALL LANDSCAPE PLAN               |  |  |  |
| L1.1             | DETAILED LANDSCAPE PLAN              |  |  |  |
| L1.2             | DETAILED LANDSCAPE PLAN              |  |  |  |
| L2.0             | LANDSCAPE DETAILS                    |  |  |  |

## DEVENNEY GROUP LTD., ARCHITECTS LEE'S SUMMIT MEDICAL CENTER


6900 EAST CAMELBACK ROAD, SUITE 500 SCOTTSDALE, AZ 85251 602-943-8950

## PREPARED FOR


2100 SE BLUE PARKWAY LEE'S SUMMIT, MO 64063 816-282-5000





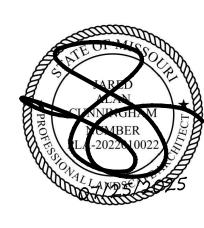

**COVER SHEET** 

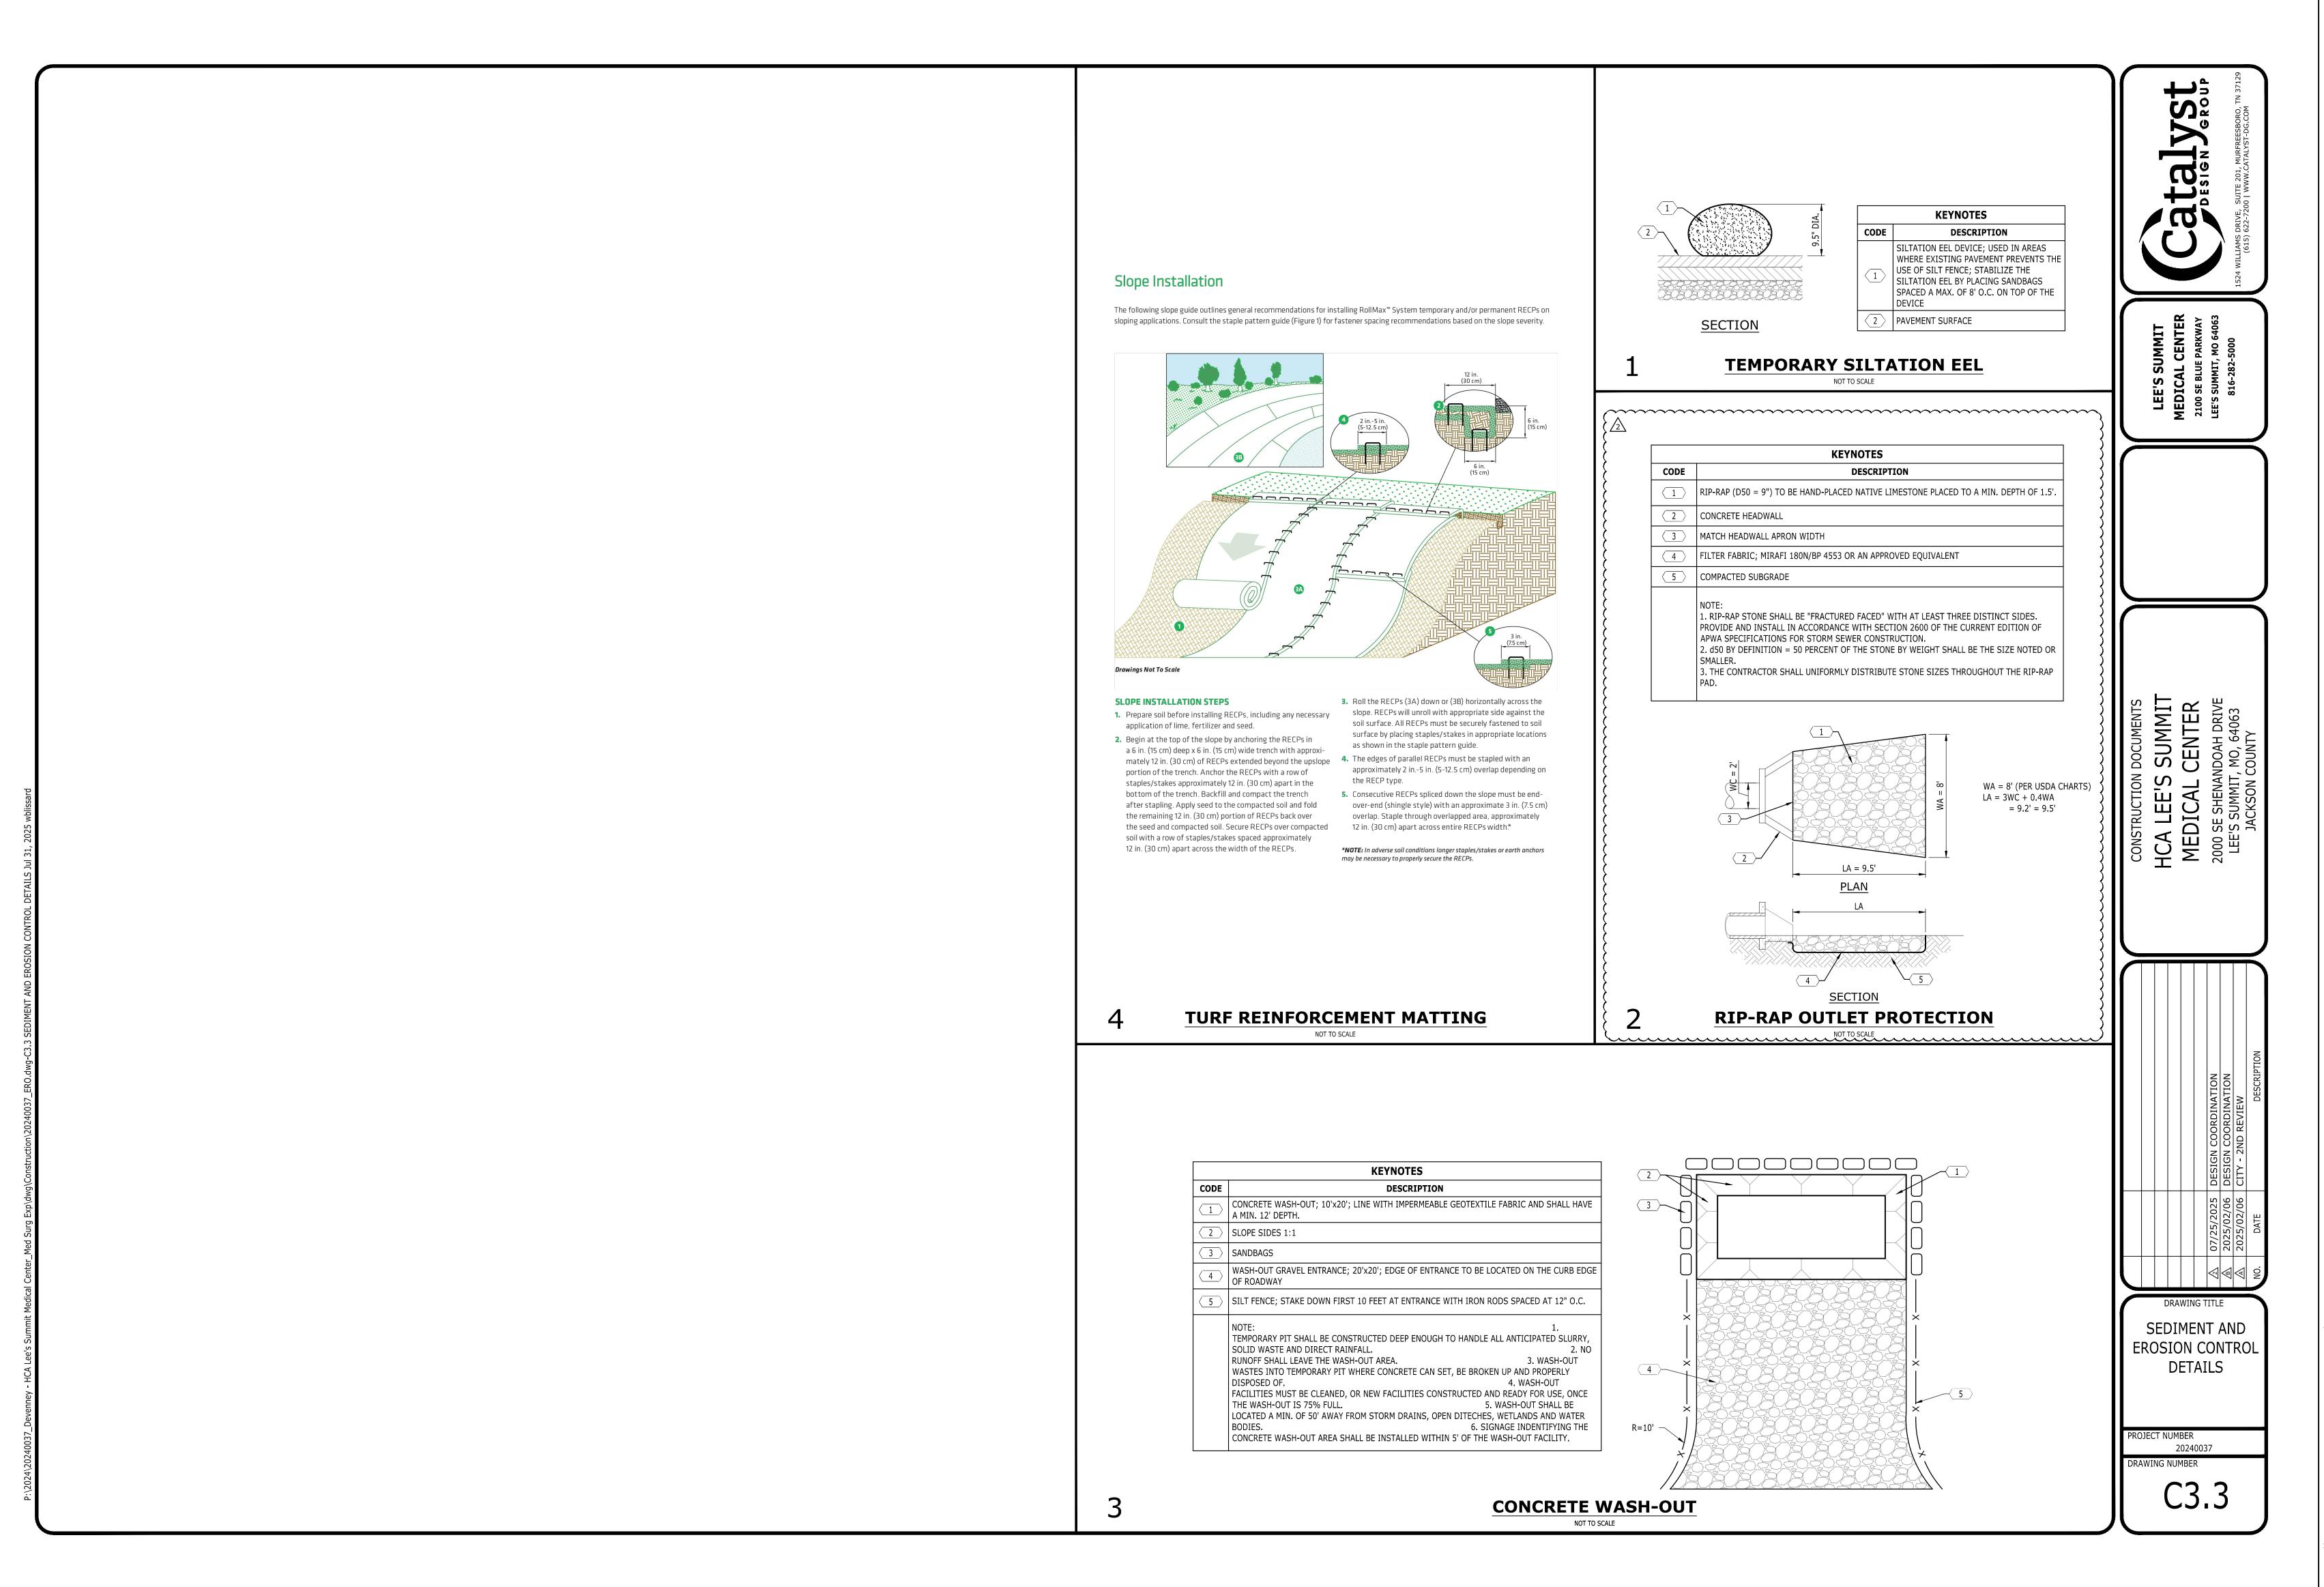




Devenney Group Ltd., Architect 6900 East Camelback Road Suite 500 Scottsdale, AZ 85251

www.devenneygroup.com

T: 602.943.8950



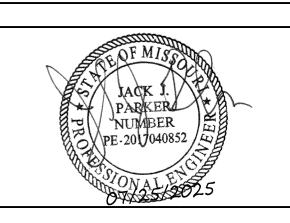

IF THESE PLANS DO NOT BEAR THE SEAL OF A REGISTRANT, THEY ARE TO BE CONSIDERED "PRELIMINARY" AND ARE NOT TO BE USED FOR CONSTRUCTION OR RECORDING. THESE PLANS ARE COPYRIGHTED AND ARE SUBJECT TO COPYRIGHT PROTECTION AS AN "ARCHITECTURAL WORK" UNDER SEC. 102 OF THE COPYRIGHT ACT, 17 U.S.O. AS AMENDED DECEMBER 1990 AND KNOWN AS ARCHITECTURAL WORKS COPYRIGHT PROTECTION ACT OF 1990. THE PROTECTION INCLUDES BUT IS NOT LIMITED TO THE OVERALL FORM AS WELL AS THE ARRANGEMENT AND COMPOSITION OF SPACES AND ELEMENTS OF THE DESIGN. UNDER SUCH PROTECTION, UNAUTHORIZED USE OF THESE PLANS CAN LEGALLY RESULT IN THE CESSATION OF CONSTRUCTION OR BUILDINGS BEING SEIZED AND/OR MONETARY COMPENSATION TO DEVENNEY GROUP LTD.

# INPATIENT BED EXPANSION

HCA - LEE'S SUMMIT MEDICAL CENTER 2100 SE BLUE PKWY LEE'S SUMMIT, MO 64063

AUTHORITY HAVING JURISDICTION:
CITY OF LEE'S SUMMIT BUILDING DEPT.
MISSOURI DHSS

FACILITY NUMBER: **0972400009** 

AGENCY APPROVALS:
AGENCY

| Expa                              |      |                     |            |
|-----------------------------------|------|---------------------|------------|
| 1 ge _                            |      |                     |            |
| ed Su                             |      | REVISIONS           |            |
| ≥                                 | REV# | DESCRIPTION         | DATE       |
| <u> </u>                          | Α    | CITY - 2ND REVIEW   | 2025/02/06 |
| -                                 | В    | DESIGN COORDINATION | 2025/02/06 |
| 2                                 | 2    | DESIGN COORDINATION | 2025/07/25 |
| 6406.24.0001 HCA - LSMC Med Surge |      |                     |            |

DATE: 2025/07/25

SCALE: AP


DRAWN: AP

REVIEWED: WB

JOB NUMBER: 6406.24

SEDIMENT AND EROSION CONTROL DETAILS

C3.3

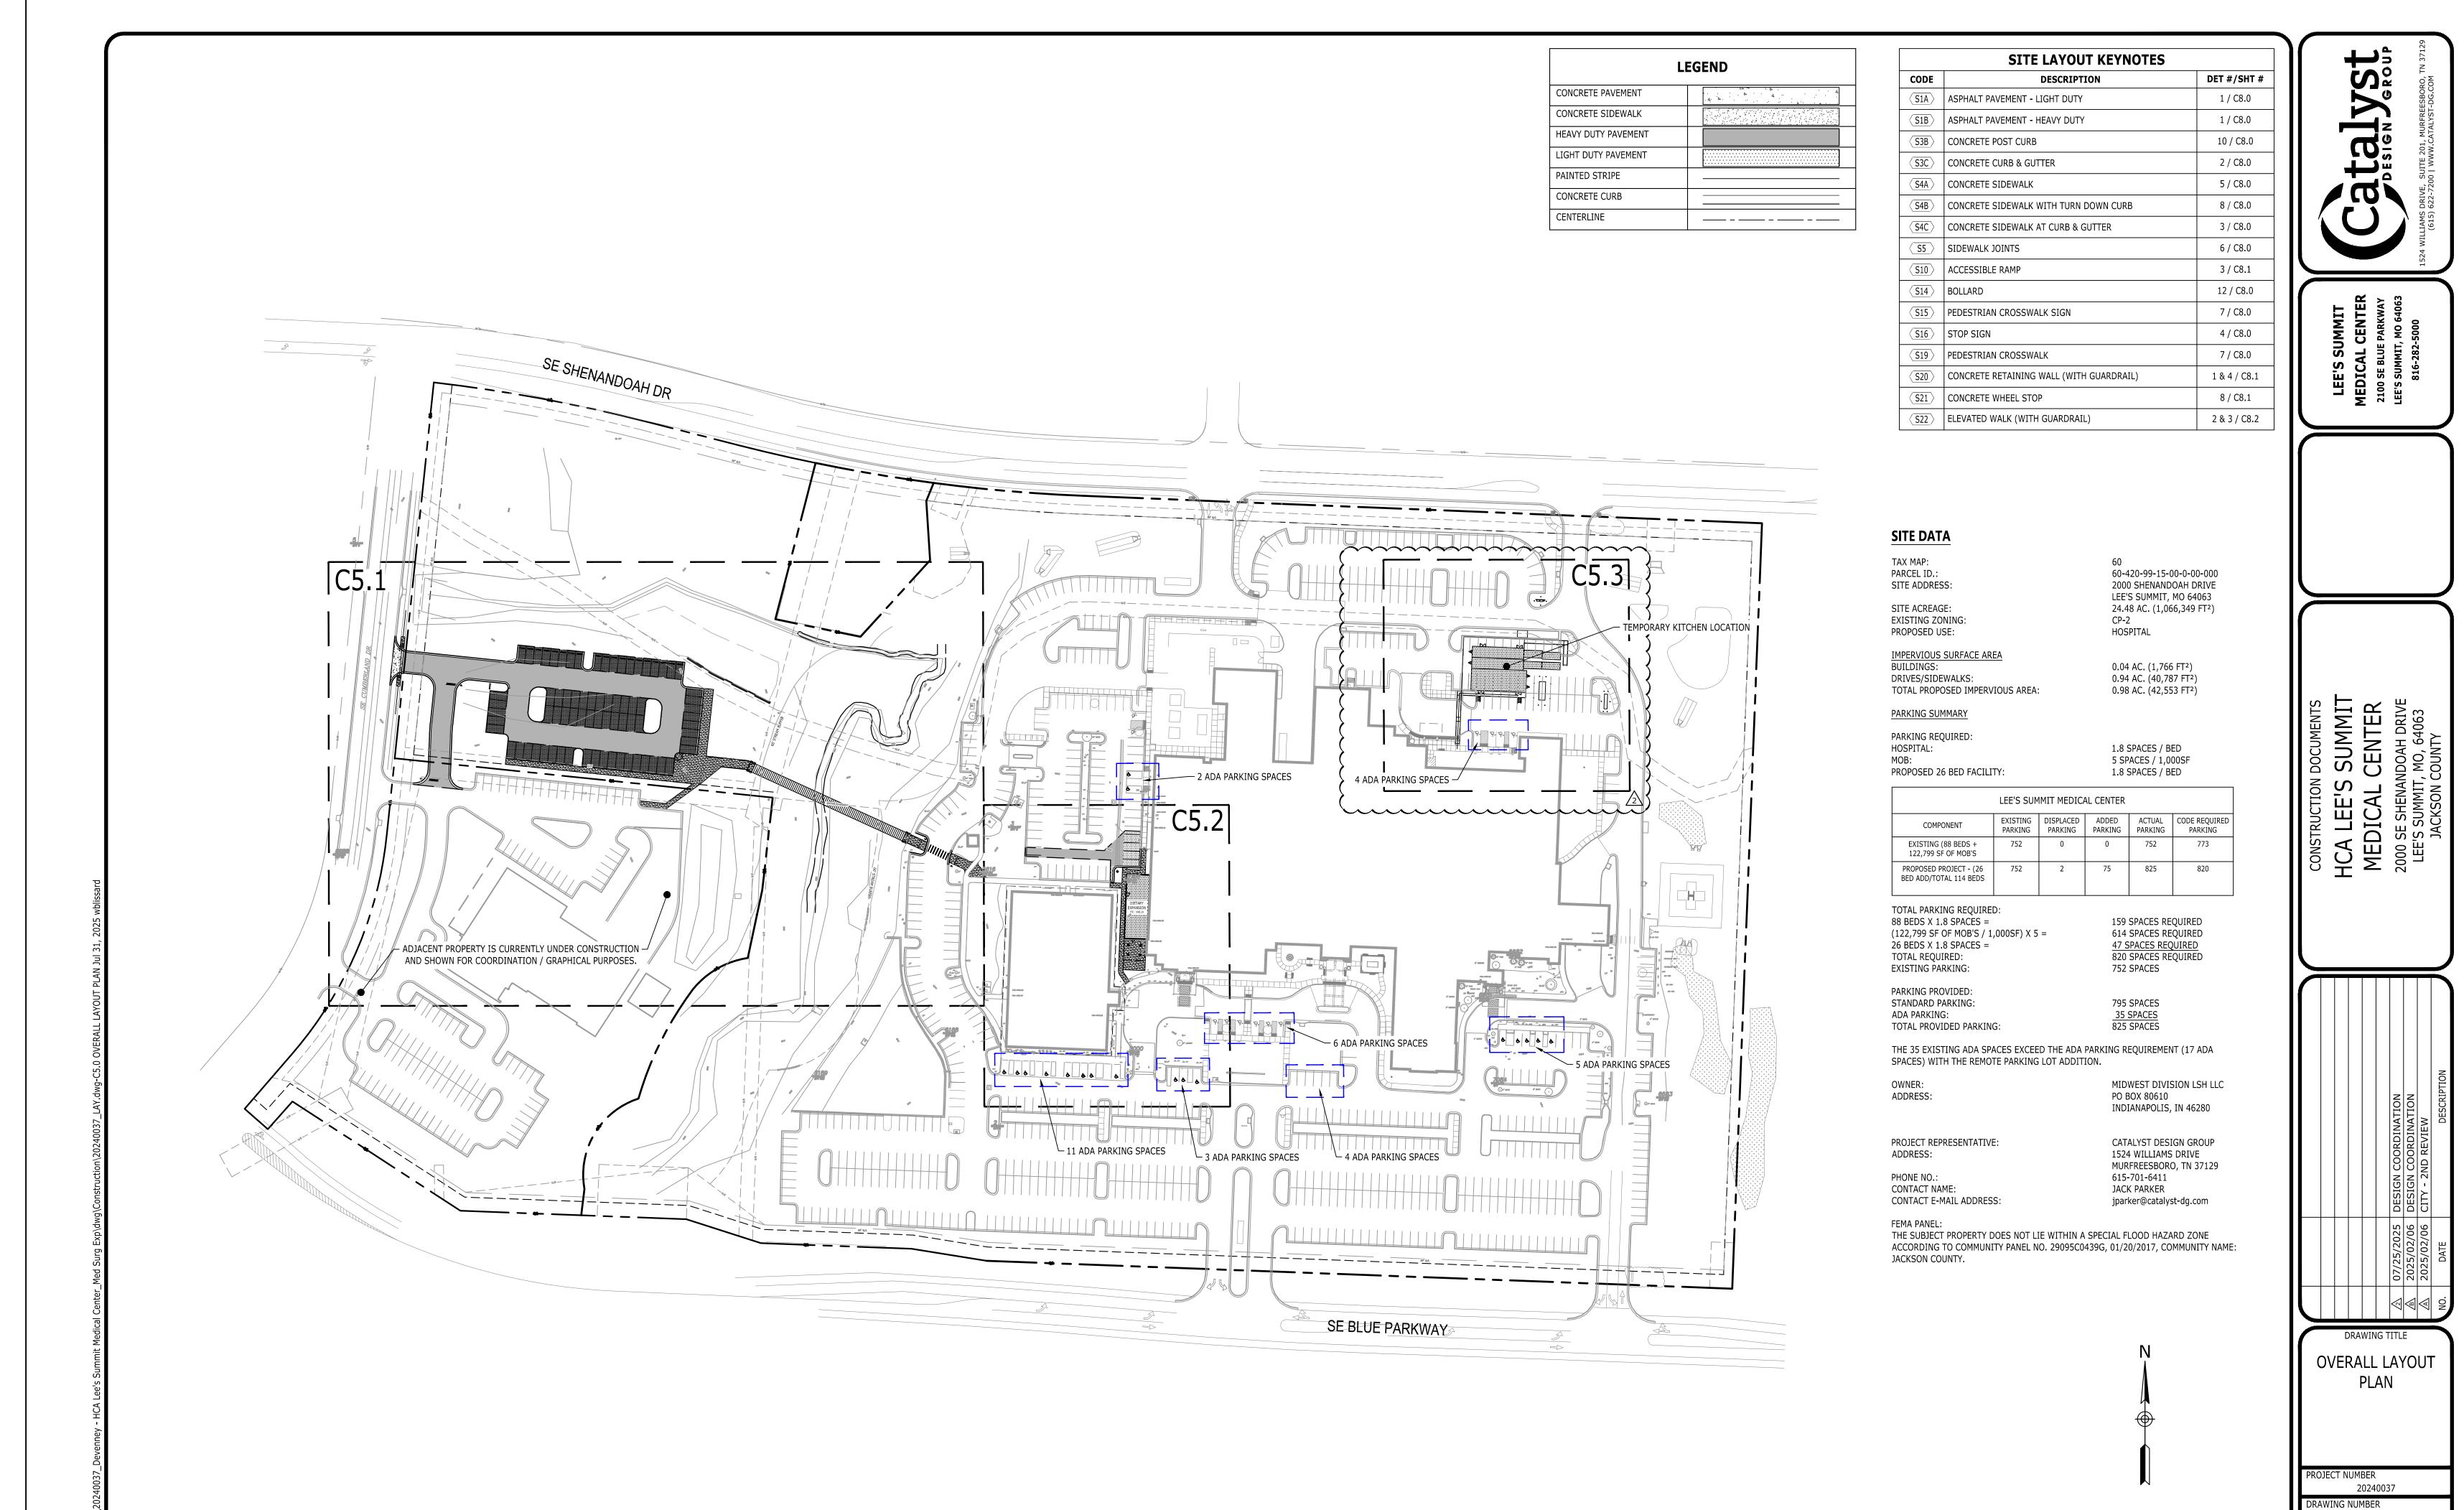




Devenney Group Ltd., Archit 6900 East Camelback Road Suite 500 Scottsdale, AZ 85251 T: 602.943.8950

www.devenneygroup.com

Consultant:



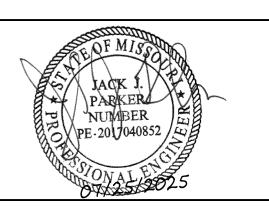

IF THESE PLANS DO NOT BEAR THE SEAL OF A REGISTRANT, THEY ARE TO BE CONSIDERED "PRELIMINARY" AND ARE NOT TO BE USED FOR CONSTRUCTION OR RECORDING. THESE PLANS ARE COPYRIGHTED AND ARE SUBJECT TO COPYRIGHT PROTECTION AS AN "ARCHITECTURAL WORK" UNDER SEC. 102 OF THE COPYRIGHT ACT, 17 U.S.O. AS AMENDED DECEMBER 1990 AND KNOWN AS ARCHITECTURAL WORKS COPYRIGHT PROTECTION ACT OF 1990. THE PROTECTION INCLUDES BUT IS NOT LIMITED TO THE OVERALL FORM AS WELL AS THE ARRANGEMENT AND COMPOSITION OF SPACES AND ELEMENTS OF THE DESIGN. UNDER SUCH PROTECTION, UNAUTHORIZED USE OF THESE PLANS CAN LEGALLY RESULT IN THE CESSATION OF CONSTRUCTION OR BUILDINGS BEING SEIZED AND/OR MONETARY COMPENSATION TO DEVENNEY GROUP LTD.

# INPATIENT BED EXPANSION

HCA - LEE'S SUMMIT MEDICAL CENTER 2100 SE BLUE PKWY LEE'S SUMMIT, MO 64063

AUTHORITY HAVING JURISDICTION:
CITY OF LEE'S SUMMIT BUILDING DEPT.
MISSOURI DHSS

FACILITY NUMBER: **0972400009** 

AGENCY APPROVALS:

| Expan                                  |      |                     |            |
|--|------|---------------------|------------|
| ırge l                                 |      |                     |            |
| ed Sı                                  |      | REVISIONS           |            |
| Σ                                      | REV# | DESCRIPTION         | DATE       |
| SM                                     | Α    | CITY - 2ND REVIEW   | 2025/02/06 |
| 7-\                                    | В    | DESIGN COORDINATION | 2025/02/06 |
| Ϋ́                                     | 2    | DESIGN COORDINATION | 2025/07/25 |
| vt23/6406.24.0001 HCA - LSMC Med Surge |      |                     |            |

DATE: 2025/07/25

SCALE: 1:40


DRAWN: AP


REVIEWED: WB

JOB NUMBER: 6406.24

हूं OVERALL LAYOUT PLAN

C5.0

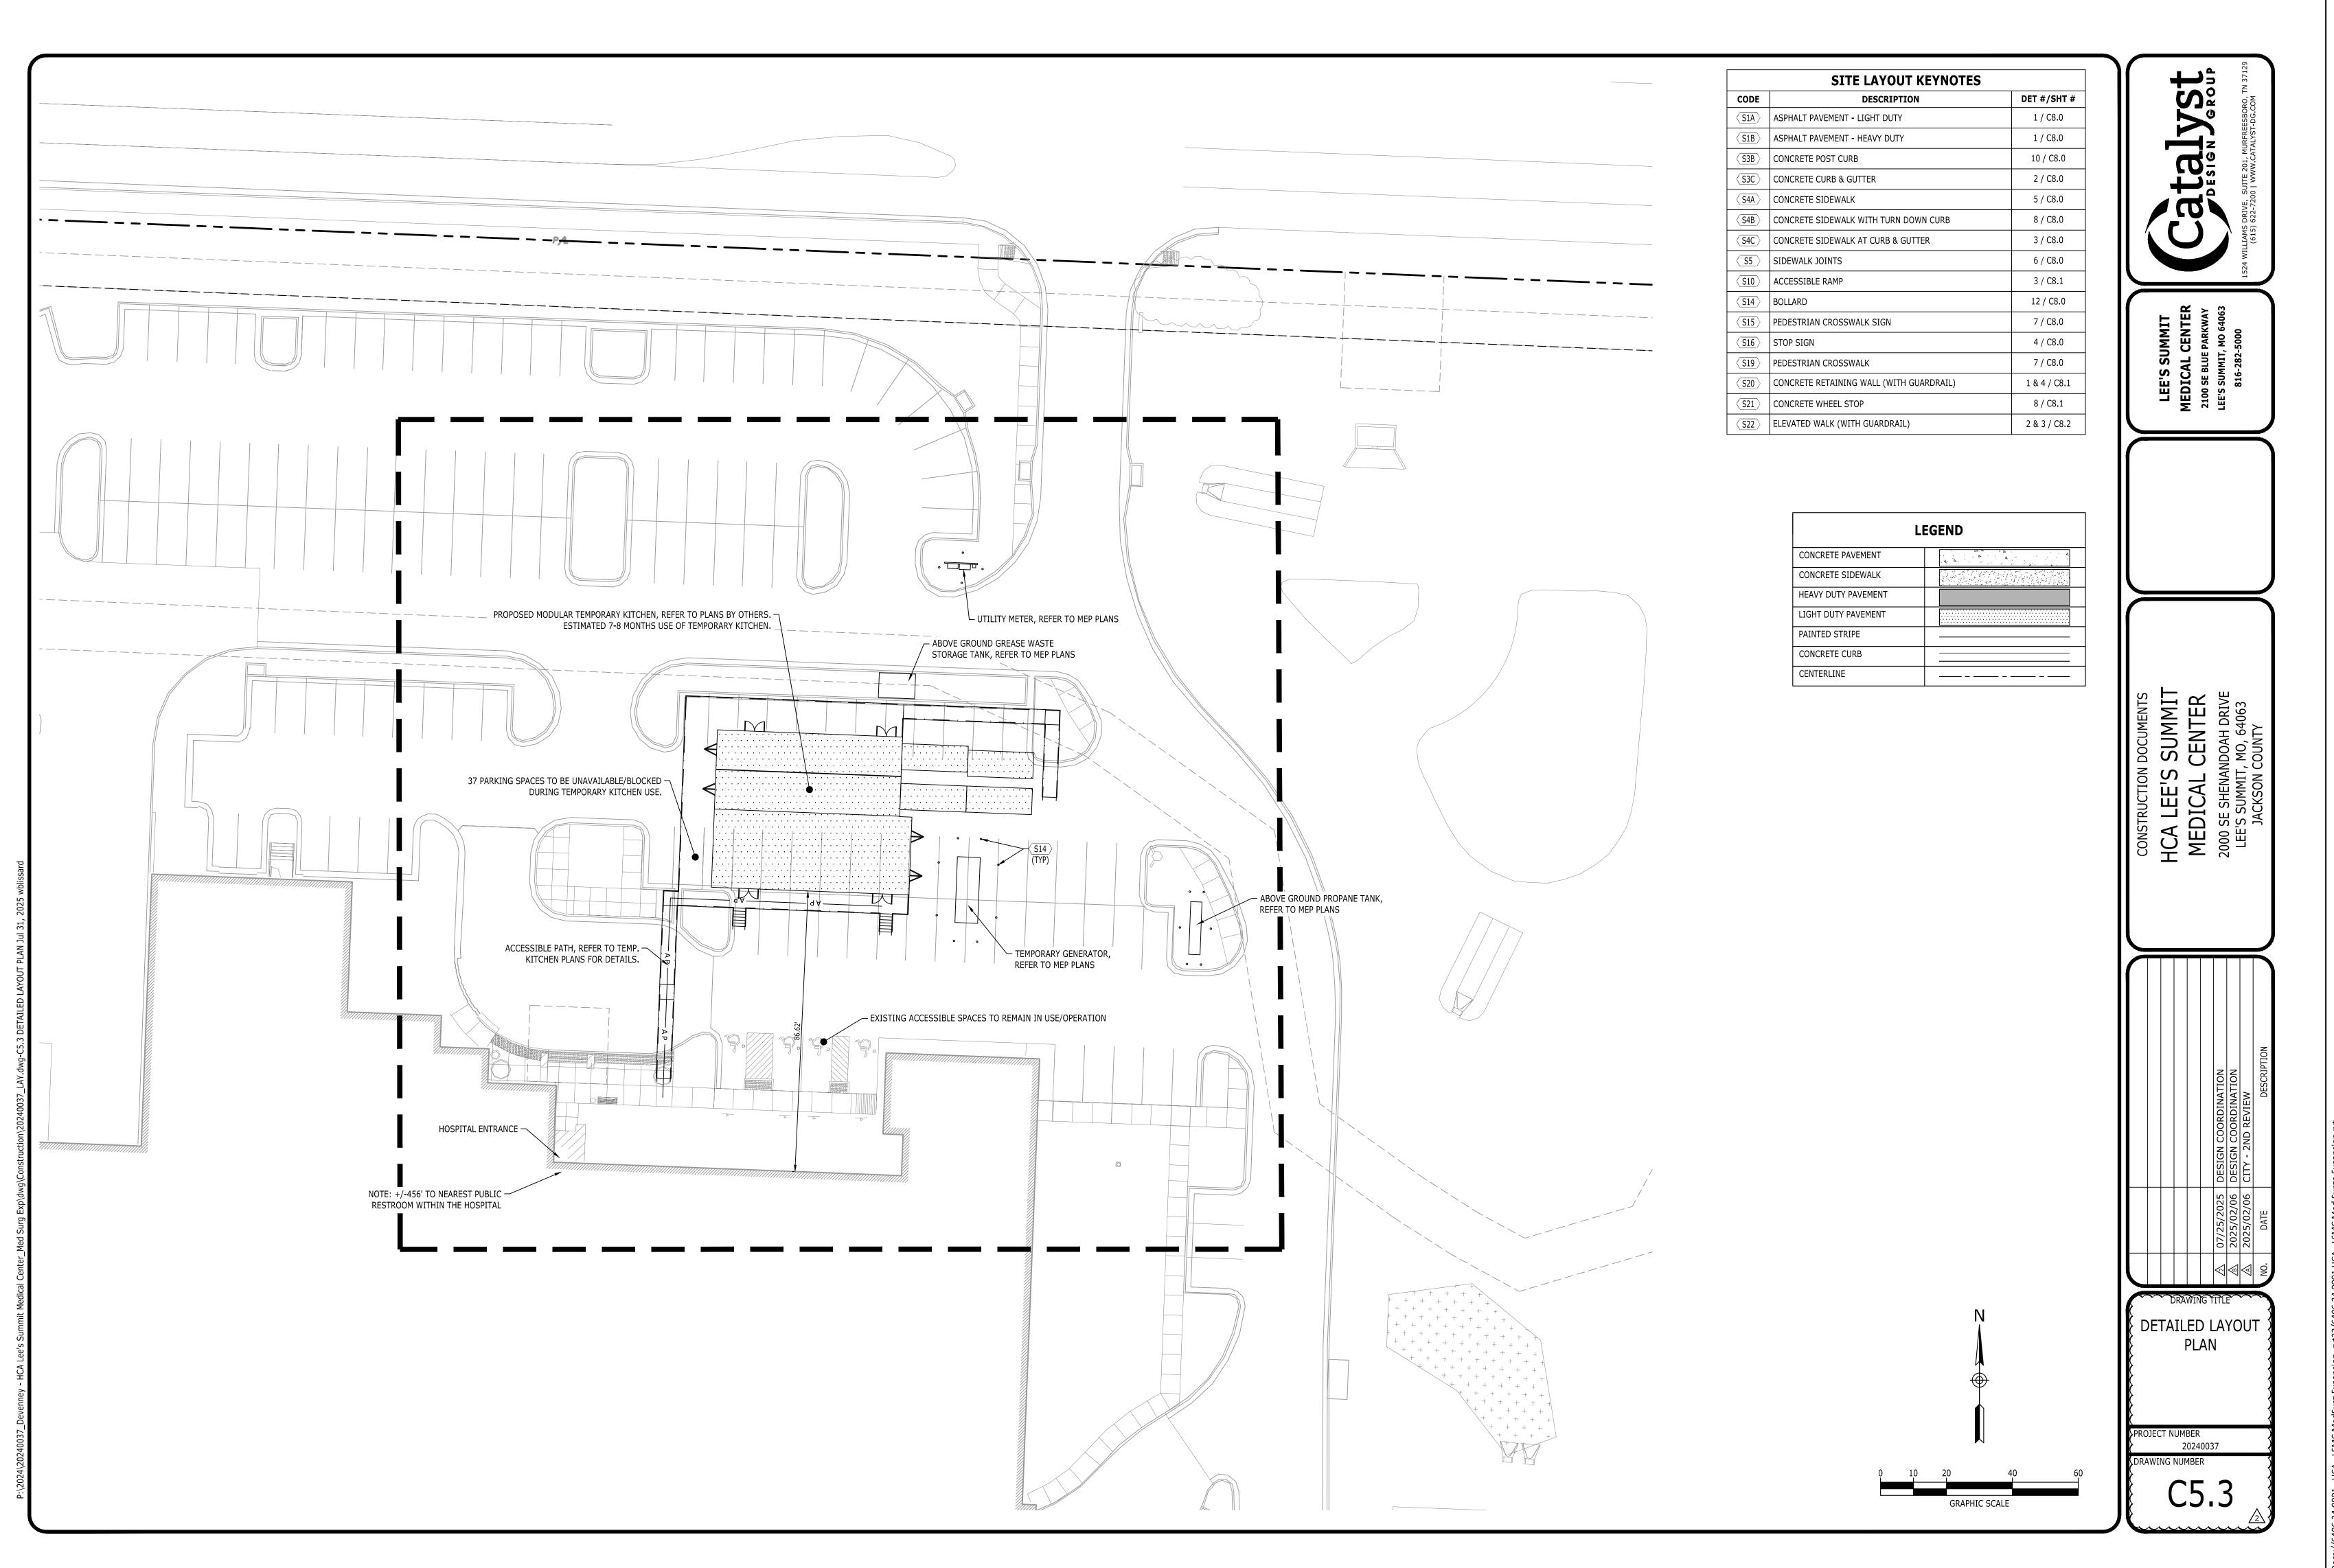

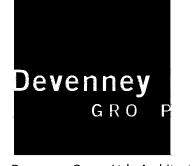


Devenney Group Ltd., Architects
6900 East Camelback Road
Suite 500
Scottsdale, AZ 85251

T: 602.943.8950 www.devenneygroup.com

Catalyst Catalyst STEEN JGROUP 1524 WILLIAMS DRIVE, SUITE 201, MURFREESBORO, TN 37129

(615) 622-7200 | WWW.CATALYST-DG.COM

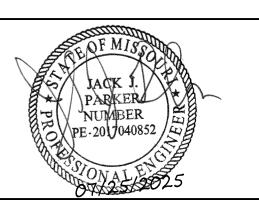

IF THESE PLANS DO NOT BEAR THE SEAL OF A REGISTRANT, THEY ARE TO BE CONSIDERED "PRELIMINARY" AND ARE NOT TO BE USED FOR CONSTRUCTION OR RECORDING. THESE PLANS ARE COPYRIGHTED AND ARE SUBJECT TO COPYRIGHT PROTECTION AS AN "ARCHITECTURAL WORK" UNDER SEC. 102 OF THE COPYRIGHT ACT, 17 U.S.O. AS AMENDED DECEMBER 1990 AND KNOWN AS ARCHITECTURAL WORKS COPYRIGHT PROTECTION ACT OF 1990. THE PROTECTION INCLUDES BUT IS NOT LIMITED TO THE OVERALL FORM AS WELL AS THE ARRANGEMENT AND COMPOSITION OF SPACES AND ELEMENTS OF THE DESIGN. UNDER SUCH PROTECTION, UNAUTHORIZED USE OF THESE PLANS CAN LEGALLY RESULT IN THE CESSATION OF CONSTRUCTION OR BUILDINGS BEING SEIZED AND/OR MONETARY COMPENSATION TO DEVENNEY GROUP LTD.

## NPATIENT BED EXPANSION

HCA - LEE'S SUMMIT

MEDICAL CENTER

2100 SE BLUE PKWY

LEE'S SUMMIT, MO 64063

AUTHORITY HAVING JURISDICTION:
CITY OF LEE'S SUMMIT BUILDING DEPT.
MISSOURI DHSS

FACILITY NUMBER: **0972400009** 

AGENCY APPROVALS: AGENCY

|      | REVISIONS           |            |
|------|---------------------|------------|
| REV# | DESCRIPTION         | DATE       |
| Α    | CITY - 2ND REVIEW   | 2025/02/06 |
| В    | DESIGN COORDINATION | 2025/02/06 |
| 2    | DESIGN COORDINATION | 2025/07/25 |
|      |                     |            |
|      |                     |            |
|      |                     |            |

DATE: 2025/07/25

SCALE: 1:20


DRAWN: AP

REVIEWED: WB

JOB NUMBER: 6406.24

DETAILED LAYOUT

C5 3

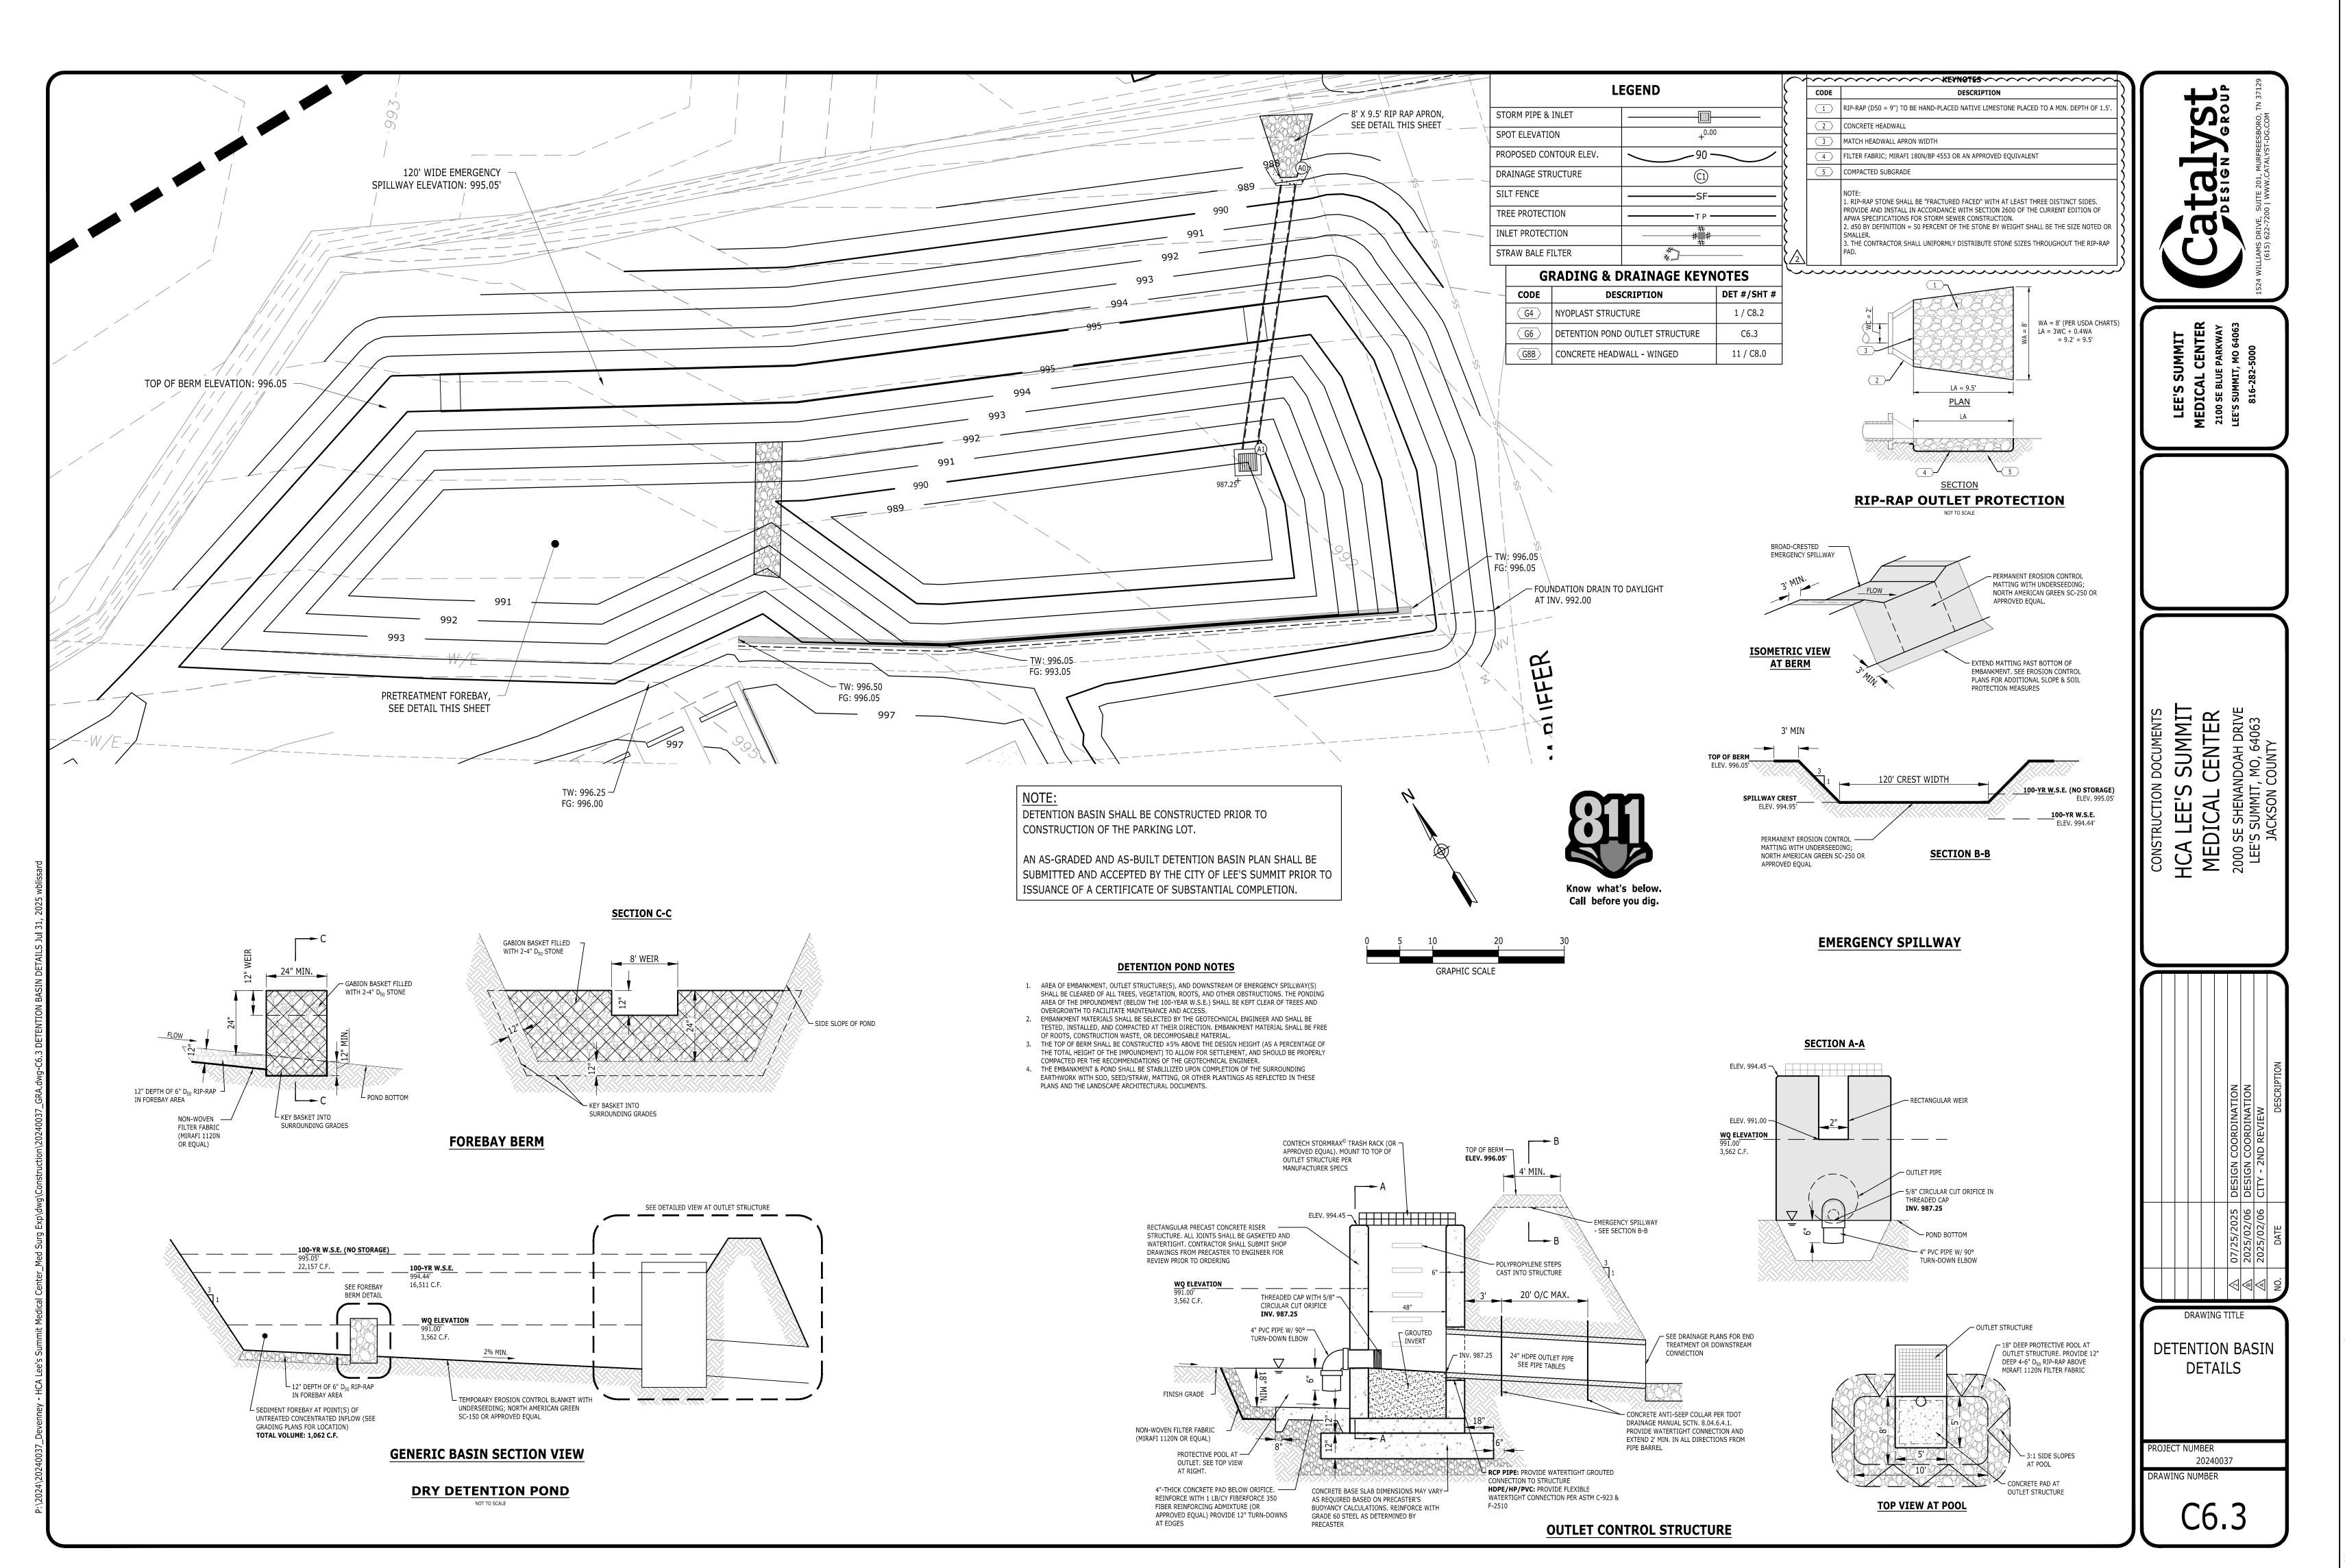




6900 East Camelback Road Suite 500 Scottsdale, AZ 85251 T: 602.943.8950

www.devenneygroup.com

Consultant:

Catalyst
Catalyst
DESIGN JGROUP

1524 WILLIAMS DRIVE, SUITE 201, MURFREESBORO, TN 37129
(615) 622-7200 | WWW.CATALYST-DG.COM

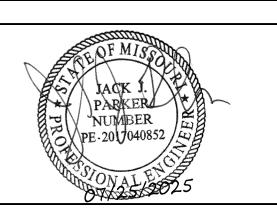

IF THESE PLANS DO NOT BEAR THE SEAL OF A REGISTRANT, THEY ARE TO BE CONSIDERED "PRELIMINARY" AND ARE NOT TO BE USED FOR CONSTRUCTION OR RECORDING. THESE PLANS ARE COPYRIGHTED AND ARE SUBJECT TO COPYRIGHT PROTECTION AS AN "ARCHITECTURAL WORK" UNDER SEC. 102 OF THE COPYRIGHT ACT, 17 U.S.O. AS AMENDED DECEMBER 1990 AND KNOWN AS ARCHITECTURAL WORKS COPYRIGHT PROTECTION ACT OF 1990. THE PROTECTION INCLUDES BUT IS NOT LIMITED TO THE OVERALL FORM AS WELL AS THE ARRANGEMENT AND COMPOSITION OF SPACES AND ELEMENTS OF THE DESIGN. UNDER SUCH PROTECTION, UNAUTHORIZED USE OF THESE PLANS CAN LEGALLY RESULT IN THE CESSATION OF CONSTRUCTION OR BUILDINGS BEING SEIZED AND/OR MONETARY COMPENSATION TO DEVENNEY GROUP LTD.

## NPATIENT BED EXPANSION

HCA - LEE'S SUMMIT

MEDICAL CENTER

2100 SE BLUE PKWY

LEE'S SUMMIT, MO 64063

AUTHORITY HAVING JURISDICTION:
CITY OF LEE'S SUMMIT BUILDING DEPT.
MISSOURI DHSS

FACILITY NUMBER:
0972400009

AGENCY APPROVALS:
AGENCY

| 낊  |      |                     |            |
|--|------|---------------------|------------|
| ırge   |      |                     |            |
| ansion_rvt23/6406.24.0001 HCA - LSMC Med Surge |      | REVISIONS           |            |
| ≥  | REV# | DESCRIPTION         | DATE       |
| NS   | Α    | CITY - 2ND REVIEW   | 2025/02/06 |
| <u> </u>                                       | В    | DESIGN COORDINATION | 2025/02/06 |
| \$   | 2    | DESIGN COORDINATION | 2025/07/25 |
| 201  |      |                     |            |
| 4.00   |      |                     |            |
| 36.2   |      |                     |            |
| /64(   |      |                     |            |
| t23,   |      |                     |            |
| 2  |      |                     |            |
| sio  |      |                     |            |
| au   |      |                     |            |

DATE: 2025/07/25

SCALE: 1:10


DRAWN: AP


REVIEWED: WB

JOB NUMBER: 6406.24

DETENTION BASIN
DETAILS

C6.3

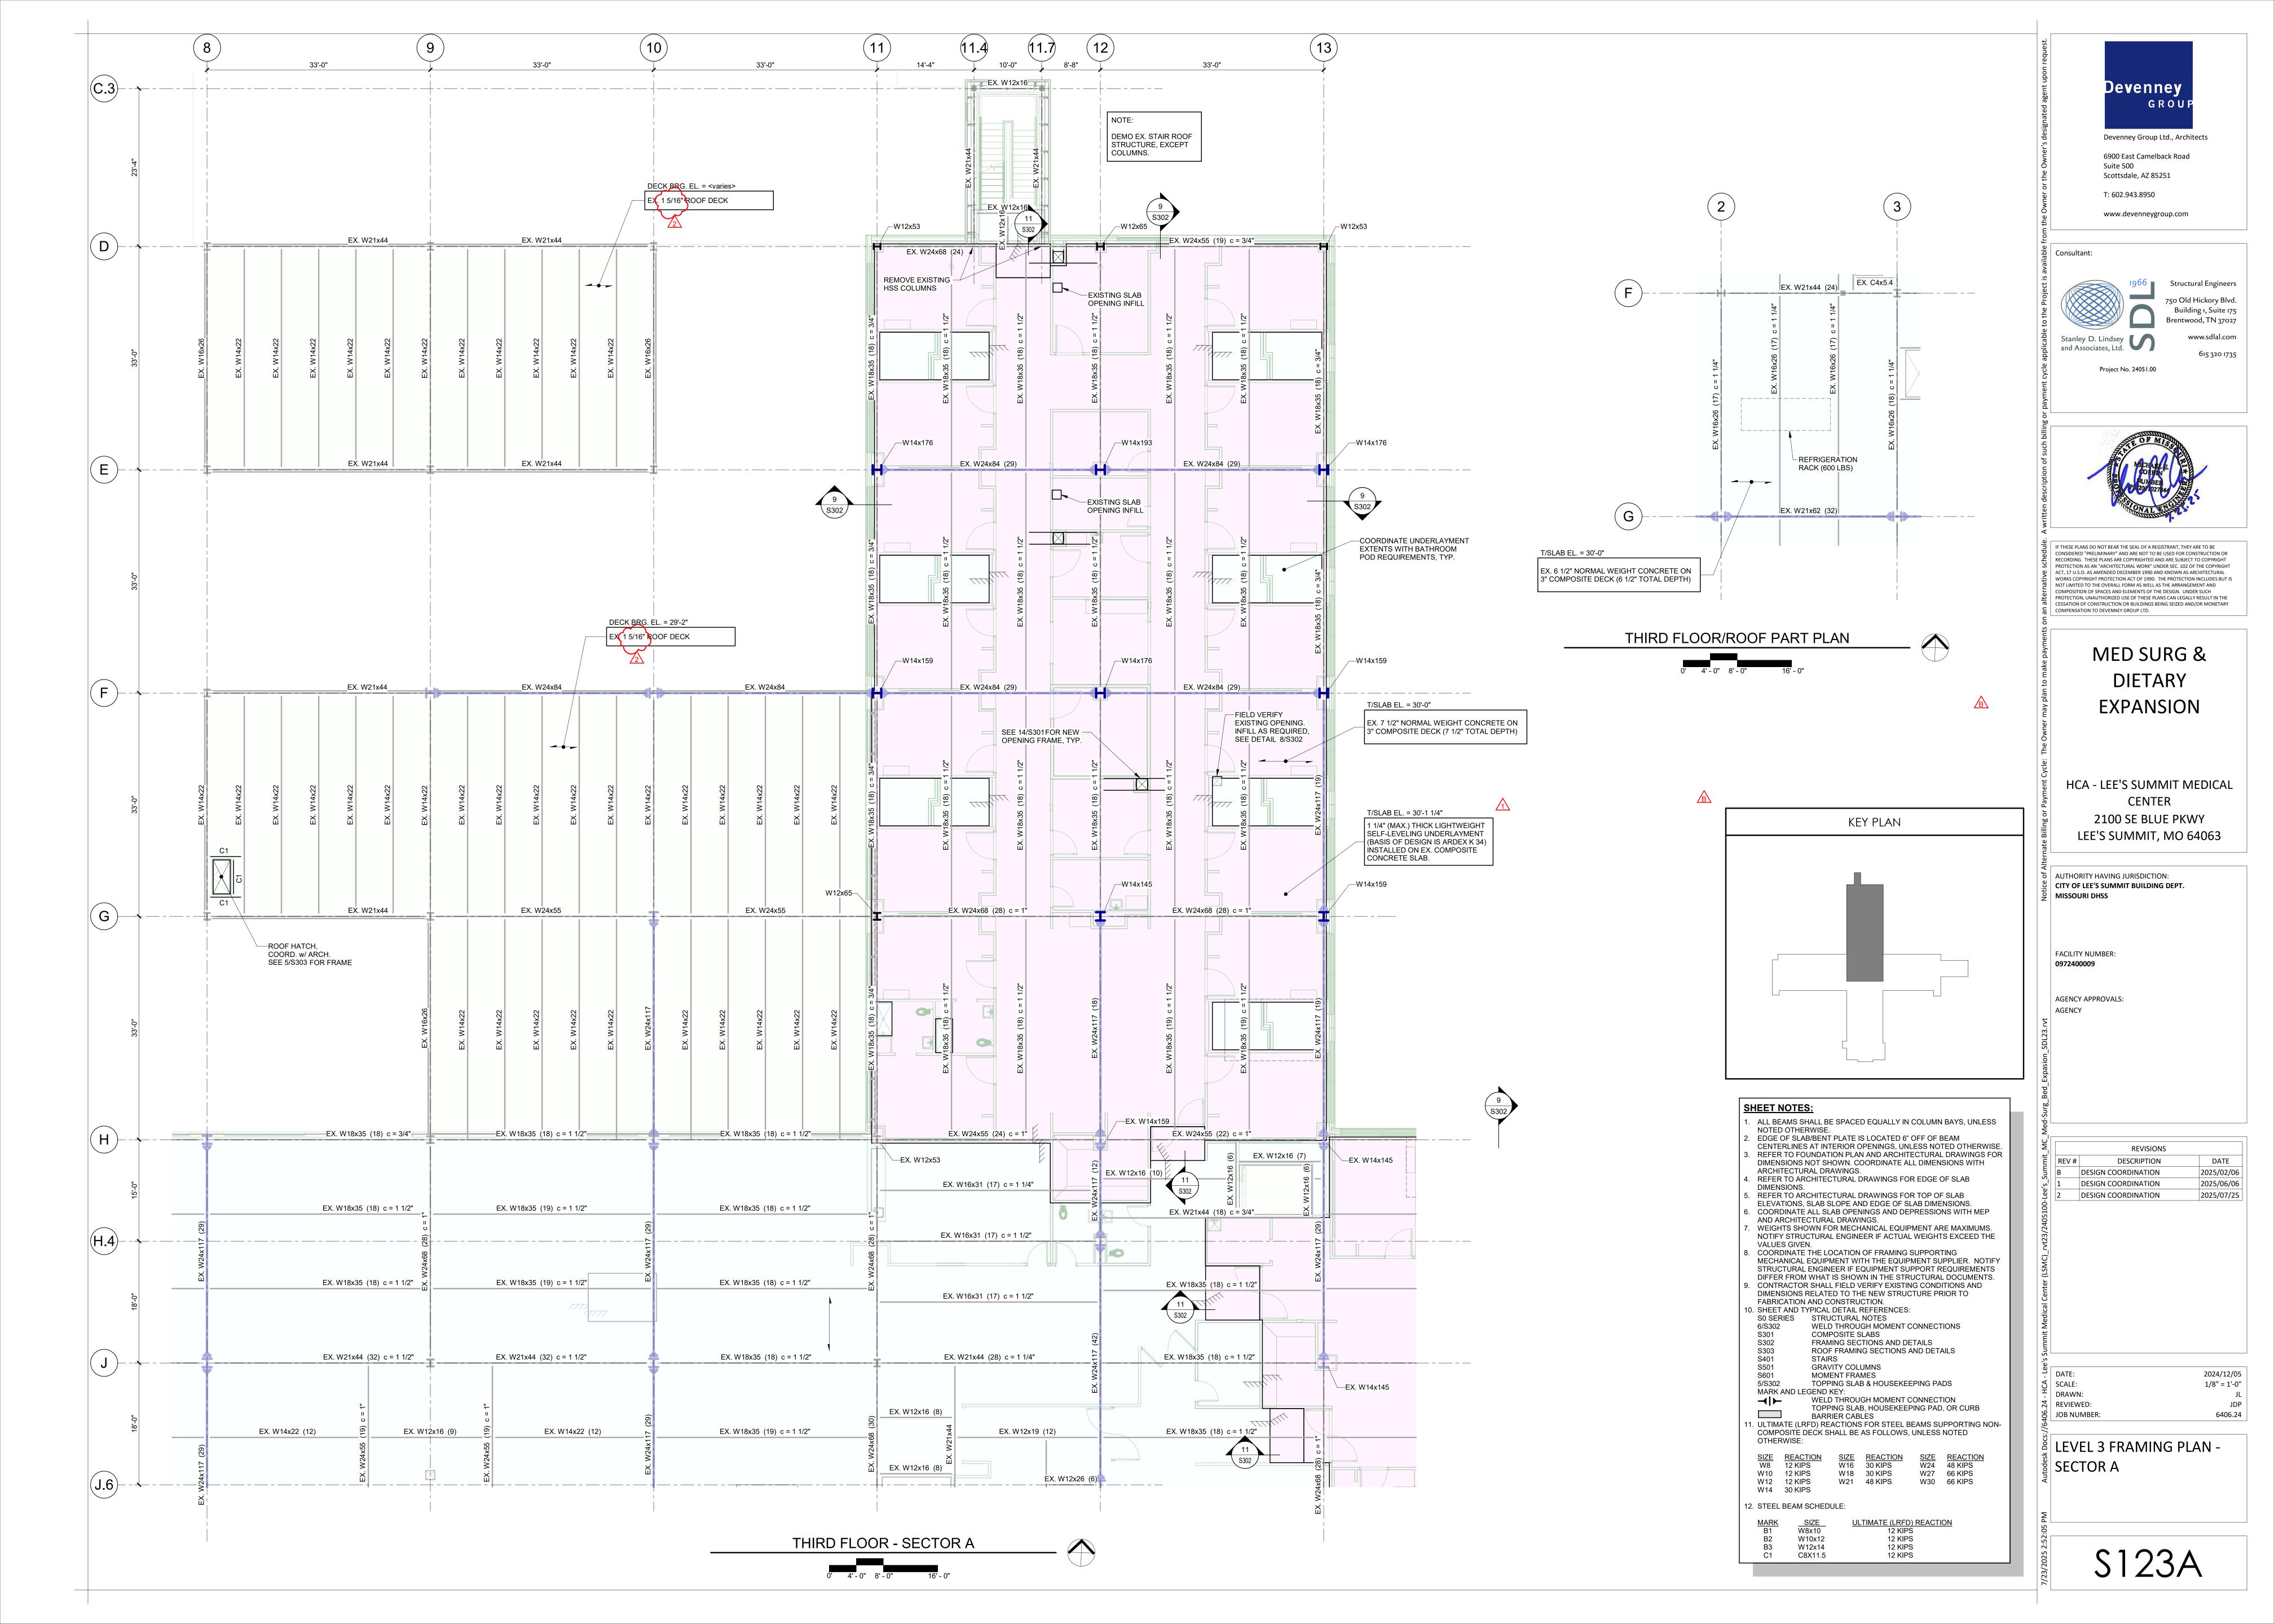

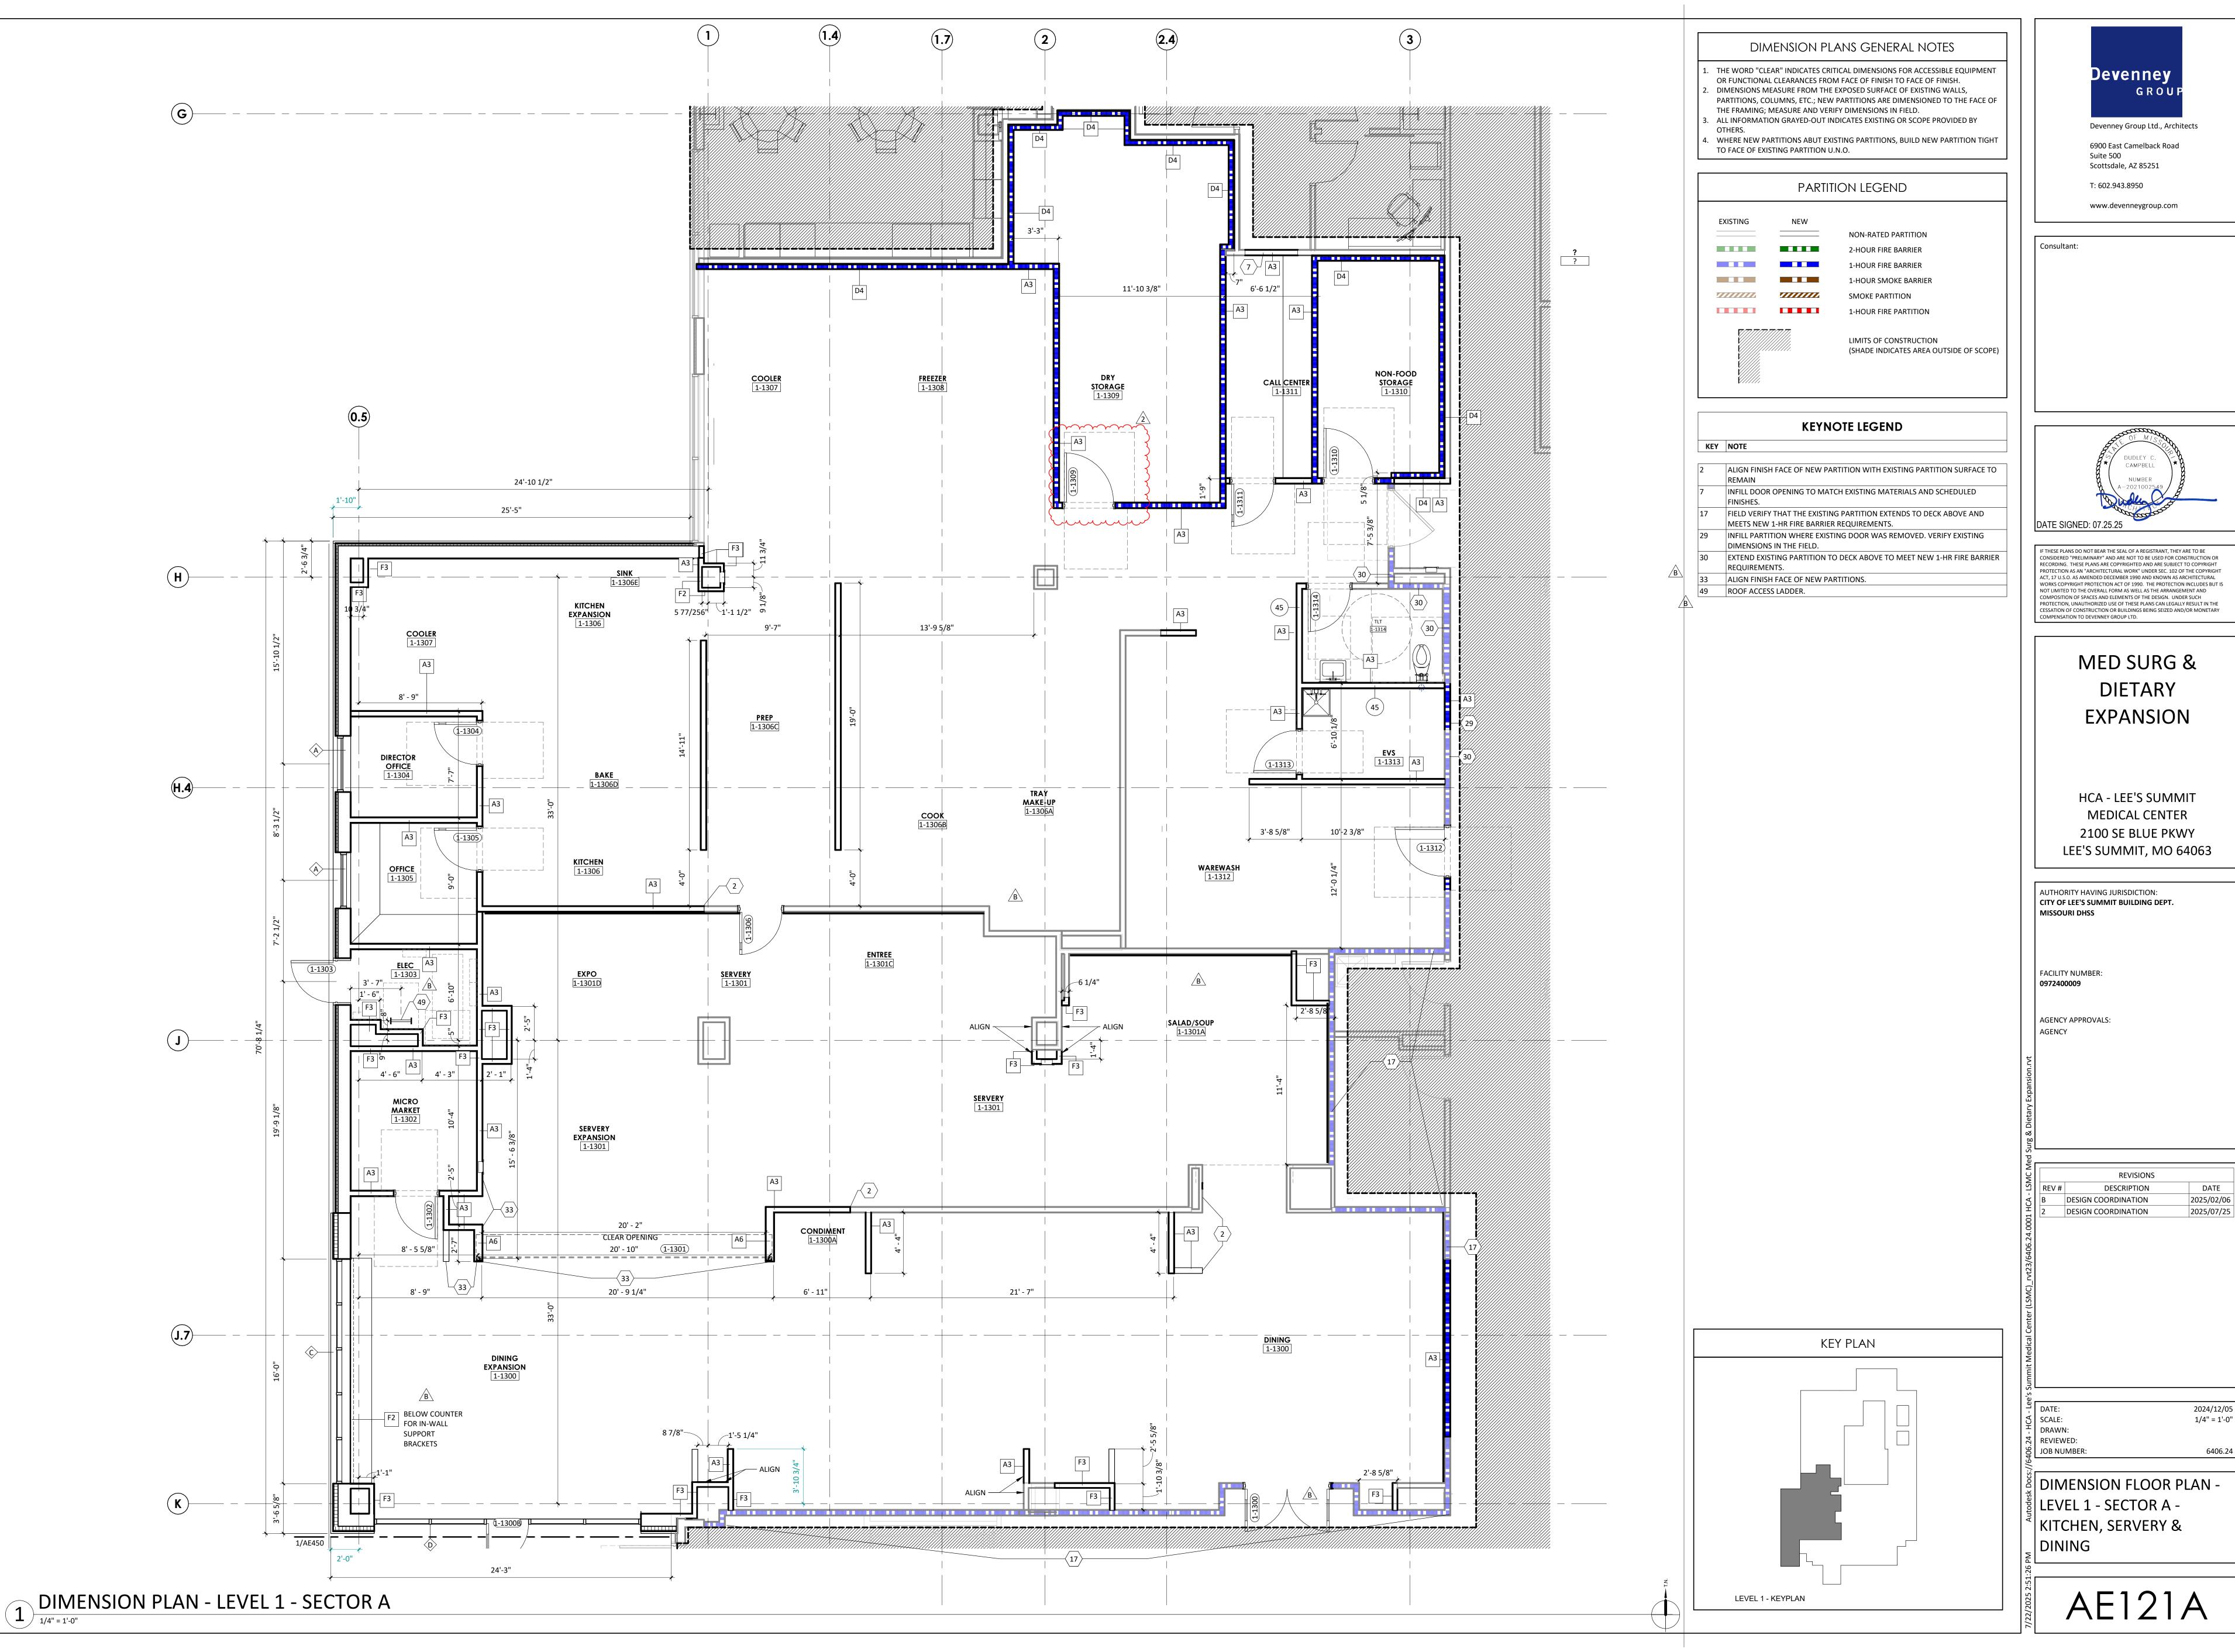



### DIMENSION PLANS GENERAL NOTES

- THE WORD "CLEAR" INDICATES CRITICAL DIMENSIONS FOR ACCESSIBLE EQUIPMENT OR FUNCTIONAL CLEARANCES FROM FACE OF FINISH TO FACE OF FINISH. DIMENSIONS MEASURE FROM THE EXPOSED SURFACE OF EXISTING WALLS,
- PARTITIONS, COLUMNS, ETC.; NEW PARTITIONS ARE DIMENSIONED TO THE FACE OF THE FRAMING; MEASURE AND VERIFY DIMENSIONS IN FIELD. ALL INFORMATION GRAYED-OUT INDICATES EXISTING OR SCOPE PROVIDED BY
- WHERE NEW PARTITIONS ABUT EXISTING PARTITIONS, BUILD NEW PARTITION TIGHT TO FACE OF EXISTING PARTITION U.N.O.

### PARTITION LEGEND

NON-RATED PARTITION 2-HOUR FIRE BARRIER 1-HOUR FIRE BARRIER 1-HOUR SMOKE BARRIER SMOKE PARTITION 1-HOUR FIRE PARTITION



LIMITS OF CONSTRUCTION (SHADE INDICATES AREA OUTSIDE OF SCOPE)

### STC GENERAL NOTES

- . NOT ALL ADJANCIIES LISTED IN STC PARTITION RATINGS LEGEND MAY OCCUR IN THIS
- IN PARTITIONS WITH AND STC RATING OF 44 OR GREATER PROVIDE ACOUSTICAL PUTTY PADS AT ELECTRICAL ROUGH-IN BOXES THAT ARE BACK-TO-BACK CONFIGURATOIN OR WHERE ELECTRICAL BOX SEPARATION DISTANCES IS LESS THAN
- PENETRATIONS TRHOUGH FULL HEIGHT STC PARTITIONS SHOULD BE CENTERED IN OPENING AND SEALED AIRTIGHT.
- CALBE TRAY PENTRATIONS IN STC PARTITIONS SHOULD BE PACKED TIGHTLY WITH HEAVY DENSITY PUTTY.

### STC PARTITION RATINGS (##)

| DESIGN CRIT      | ERIA FOR MIN. SOUND ISOLATION PERFORMANCE B<br>ENCLOSED ROOMS | ETWEEN |
|------------------|---|--------|
| ADJACENCY COMBIN | ATION   | S      |
| PATIENT ROOM     | PATIENT ROOM (WALL-SAME FLOOR)                                | 4      |
| PATIENT ROOM     | PATIENT ROOM (FLOOR TO FLOOR)                                 | 5      |
| PATIENT ROOM     | CORRIDOR (WITH ENTRANCE)                                      | 3      |
| PATIENT ROOM     | PUBLIC SPACE  | 5      |
| PATIENT ROOM     | SERVICE AREA  | 6      |
| EXAM ROOM        | CORRIDOR (WITH ENTRANCE)                                      | 3      |
| EXAM ROOM        | PUBLIC SPACE  | 5      |
| TREATMENT        | ROOM  | 5      |
| TREATMENT        | CORRIDOR  | 3      |
| TOILET ROOM      | PUBLIC SPACE  | 4      |
| CONSULT ROOM     | PUBLIC SPACE  | 5      |
| CONSULT ROOM     | PATIENT ROOM  | 5      |
| CONSULT ROOM     | CORRIDOR (WITH ENTRANCE)                                      | 3      |
| PATIENT ROOM     | MRI ROOM  | 6      |
| EXAM ROOM        | MRI ROOM  | 6      |
| EXAM ROOM        | EXAM RM (NO ELECTRICAL MASKING)                               | 5      |
| EXAM ROOM        | EXAM RM (W/ ELECTRICAL MASKING)                               | 4      |
| PUBLIC SPACE     | MRI ROOM  | 5      |

KEY NOTE

THE STC RATINGS LISTED WITHIN THE TABLE ARE CONSIDERED THE MINIMUM COMPOSITE SOUND ISOLATION PERFORMANCE VALUE REQUIRED FOR THE ENTIRE DEMISING CONSTRUCTION (FLOOR/ CEILING AND WALL PARTITIONS)

SERVICE AREAS INCLUDE KITCHENS, ELEVATORS, ELEVATOR MACHINE ROOMS, LAUNDRIES, GARAGES, MAINTENANCE ROOMS, BOILER AND MECHANICAL EQUIPMENT


### SEE FGI GUIDLINES (2014) FOR MORE INFORMATION

- NOT ALL SPACES NOTED ABOVE ARE APPLICABLE TO PROJECT.

## **KEYNOTE LEGEND**

INFILL PARTITION WHERE EXISTING DOOR WAS REMOVED. MATCH EXISTING PARTITION CONSTRUCTION.

EXISTING DOOR AND FRAME TO REMAIN. ADD NEW MAG HOLD OPEN

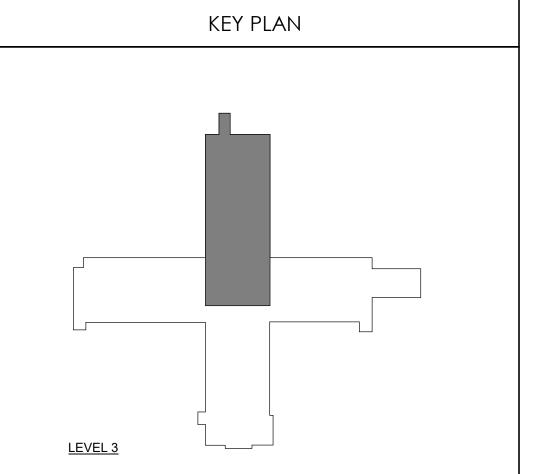




Devenney Group Ltd., Architects

6900 East Camelback Road

Suite 500 Scottsdale, AZ 85251 T: 602.943.8950

www.devenneygroup.com

Consultant:

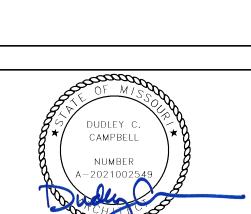

DATE SIGNED: 07.25.25

IF THESE PLANS DO NOT BEAR THE SEAL OF A REGISTRANT, THEY ARE TO BE CONSIDERED "PRELIMINARY" AND ARE NOT TO BE USED FOR CONSTRUCTION OR RECORDING. THESE PLANS ARE COPYRIGHTED AND ARE SUBJECT TO COPYRIGHT PROTECTION AS AN "ARCHITECTURAL WORK" UNDER SEC. 102 OF THE COPYRIGHT ACT, 17 U.S.O. AS AMENDED DECEMBER 1990 AND KNOWN AS ARCHITECTURAL WORKS COPYRIGHT PROTECTION ACT OF 1990. THE PROTECTION INCLUDES BUT IS NOT LIMITED TO THE OVERALL FORM AS WELL AS THE ARRANGEMENT AND COMPOSITION OF SPACES AND ELEMENTS OF THE DESIGN. UNDER SUCH PROTECTION, UNAUTHORIZED USE OF THESE PLANS CAN LEGALLY RESULT IN THE ESSATION OF CONSTRUCTION OR BUILDINGS BEING SEIZED AND/OR MONETARY MPENSATION TO DEVENNEY GROUP LTD.

## DIETARY **EXPANSION**

HCA - LEE'S SUMMIT MEDICAL CENTER 2100 SE BLUE PKWY LEE'S SUMMIT, MO 64063

AUTHORITY HAVING JURISDICTION: CITY OF LEE'S SUMMIT BUILDING DEPT. MISSOURI DHSS

FACILITY NUMBER:

0972400009

AGENCY APPROVALS:

|      | REVISIONS           |            |  |  |  |  |
|------|---------------------|------------|--|--|--|--|
| REV# | DESCRIPTION         | DATE       |  |  |  |  |
| В    | DESIGN COORDINATION | 2025/02/06 |  |  |  |  |
| 1    | DESIGN COORDINATION | 2025/06/06 |  |  |  |  |
| 2    | DESIGN COORDINATION | 2025/07/25 |  |  |  |  |
|      |                     |            |  |  |  |  |
|      |                     |            |  |  |  |  |

DATE:
SCALE:
DRAWN:
REVIEWED: As indicated 9 JOB NUMBER: 6406.24

DIMENSION FLOOR PLAN -LEVEL 3 - SECTOR A -MEDSURG

AE123A



### DIMENSION PLANS GENERAL NOTES

- THE WORD "CLEAR" INDICATES CRITICAL DIMENSIONS FOR ACCESSIBLE EQUIPMENT OR FUNCTIONAL CLEARANCES FROM FACE OF FINISH TO FACE OF FINISH. DIMENSIONS MEASURE FROM THE EXPOSED SURFACE OF EXISTING WALLS, PARTITIONS, COLUMNS, ETC.; NEW PARTITIONS ARE DIMENSIONED TO THE FACE OF
- THE FRAMING; MEASURE AND VERIFY DIMENSIONS IN FIELD. ALL INFORMATION GRAYED-OUT INDICATES EXISTING OR SCOPE PROVIDED BY
- WHERE NEW PARTITIONS ABUT EXISTING PARTITIONS, BUILD NEW PARTITION TIGHT TO FACE OF EXISTING PARTITION U.N.O.

### PARTITION LEGEND

EXISTING NON-RATED PARTITION 

2-HOUR FIRE BARRIER 1-HOUR FIRE BARRIER 1-HOUR SMOKE BARRIER SMOKE PARTITION 1-HOUR FIRE PARTITION

LIMITS OF CONSTRUCTION

(SHADE INDICATES AREA OUTSIDE OF SCOPE)

### STC GENERAL NOTES

- . NOT ALL ADJANCIIES LISTED IN STC PARTITION RATINGS LEGEND MAY OCCUR IN THIS
- IN PARTITIONS WITH AND STC RATING OF 44 OR GREATER PROVIDE ACOUSTICAL PUTTY PADS AT ELECTRICAL ROUGH-IN BOXES THAT ARE BACK-TO-BACK CONFIGURATOIN OR WHERE ELECTRICAL BOX SEPARATION DISTANCES IS LESS THAN
- PENETRATIONS TRHOUGH FULL HEIGHT STC PARTITIONS SHOULD BE CENTERED IN OPENING AND SEALED AIRTIGHT.
- CALBE TRAY PENTRATIONS IN STC PARTITIONS SHOULD BE PACKED TIGHTLY WITH HEAVY DENSITY PUTTY.

### STC PARTITION RATINGS (##)

| DESIGN CRIT      | ERIA FOR MIN. SOUND ISOLATION PERFORMANCE BE<br>ENCLOSED ROOMS | TWEEN           |
|------------------|--|-----------------|
| ADJACENCY COMBIN | ATION  | STC             |
| PATIENT ROOM     | PATIENT ROOM (WALL-SAME FLOOR)                                 | 45              |
| PATIENT ROOM     | PATIENT ROOM (FLOOR TO FLOOR)                                  | 50              |
| PATIENT ROOM     | CORRIDOR (WITH ENTRANCE)                                       | 35 <sup>1</sup> |
| PATIENT ROOM     | PUBLIC SPACE   | 50              |
| PATIENT ROOM     | SERVICE AREA   | 60              |
| EXAM ROOM        | CORRIDOR (WITH ENTRANCE)                                       | 35 <sup>1</sup> |
| EXAM ROOM        | PUBLIC SPACE   | 50              |
| TREATMENT        | ROOM   | 50              |
| TREATMENT        | CORRIDOR   | 35              |
| TOILET ROOM      | PUBLIC SPACE   | 45              |
| CONSULT ROOM     | PUBLIC SPACE   | 50              |
| CONSULT ROOM     | PATIENT ROOM   | 50              |
| CONSULT ROOM     | CORRIDOR (WITH ENTRANCE)                                       | 35 <sup>1</sup> |
| PATIENT ROOM     | MRI ROOM   | 60              |
| EXAM ROOM        | MRI ROOM   | 60              |
| EXAM ROOM        | EXAM RM (NO ELECTRICAL MASKING)                                | 50              |
| EXAM ROOM        | EXAM RM (W/ ELECTRICAL MASKING)                                | 40              |
| PUBLIC SPACE     | MRI ROOM   | 50              |

THE STC RATINGS LISTED WITHIN THE TABLE ARE CONSIDERED THE MINIMUM COMPOSITE SOUND ISOLATION PERFORMANCE VALUE REQUIRED FOR THE ENTIRE DEMISING CONSTRUCTION (FLOOR/ CEILING AND WALL PARTITIONS)

PUBLIC SPACE INCLUDES CORRIDORS (EXCEPT PATIENT ROOM ACCESS CORRIDORS), LOBBIES, DINING ROOMS, RECREATION ROOMS, AND SIMILAR SPACE THAT IS NOT DIRECTLY ASSOCIATED WITH THE HEALTHCARE MISSION

SERVICE AREAS INCLUDE KITCHENS, ELEVATORS, ELEVATOR MACHINE ROOMS, LAUNDRIES, GARAGES, MAINTENANCE ROOMS, BOILER AND MECHANICAL EQUIPMENT ROOMS, AND SIMILAR NON-PUBLIC SPACES THAT SERVE THE OPERATION OF THE FACILITY

### SEE FGI GUIDLINES (2014) FOR MORE INFORMATION

- THE STC RATING LISTED IS THE MINIMUM COMPOSITE SOUND ISOLATION PERFORMANCE VALUE REQUIRED FOR THE ENTIRE WALL ASSEMBLY, WHICH INCLUDES THE WALL PARTITION, AND ANY/ ALL OPENINGS (IE, DOOR, WINDOW, DUCT PENETRATION, ETC.) REFER TO SPECIFICATIONS FOR GYP BD REQUIREMENTS AT
- STC >40 CONDITIONS . NOT ALL SPACES NOTED ABOVE ARE APPLICABLE TO PROJECT.



Devenney Group Ltd., Architects

6900 East Camelback Road Suite 500 Scottsdale, AZ 85251

T: 602.943.8950

www.devenneygroup.com

Consultant:

DATE SIGNED: 07.25.25

IF THESE PLANS DO NOT BEAR THE SEAL OF A REGISTRANT, THEY ARE TO BE CONSIDERED "PRELIMINARY" AND ARE NOT TO BE USED FOR CONSTRUCTION OR RECORDING. THESE PLANS ARE COPYRIGHTED AND ARE SUBJECT TO COPYRIGHT PROTECTION AS AN "ARCHITECTURAL WORK" UNDER SEC. 102 OF THE COPYRIGHT ACT, 17 U.S.O. AS AMENDED DECEMBER 1990 AND KNOWN AS ARCHITECTURAL WORKS COPYRIGHT PROTECTION ACT OF 1990. THE PROTECTION INCLUDES BUT IS NOT LIMITED TO THE OVERALL FORM AS WELL AS THE ARRANGEMENT AND COMPOSITION OF SPACES AND ELEMENTS OF THE DESIGN. UNDER SUCH PROTECTION, UNAUTHORIZED USE OF THESE PLANS CAN LEGALLY RESULT IN THE ESSATION OF CONSTRUCTION OR BUILDINGS BEING SEIZED AND/OR MONETARY OMPENSATION TO DEVENNEY GROUP LTD.

DIETARY

HCA - LEE'S SUMMIT MEDICAL CENTER 2100 SE BLUE PKWY LEE'S SUMMIT, MO 64063

AUTHORITY HAVING JURISDICTION: CITY OF LEE'S SUMMIT BUILDING DEPT. MISSOURI DHSS

FACILITY NUMBER: 0972400009

AGENCY APPROVALS: AGENCY

> REVISIONS DATE DESCRIPTION 2025/02/06 DESIGN COORDINATION

DESIGN COORDINATION

DESIGN COORDINATION

2025/06/06


2025/07/25

DATE:
SCALE:
DRAWN:
REVIEWED: 1/8" = 1'-0" 9 JOB NUMBER:

DIMENSION FLOOR PLAN -LEVEL 3 - SECTOR B -MEDSURG

AE123B

KEY PLAN LEVEL 3

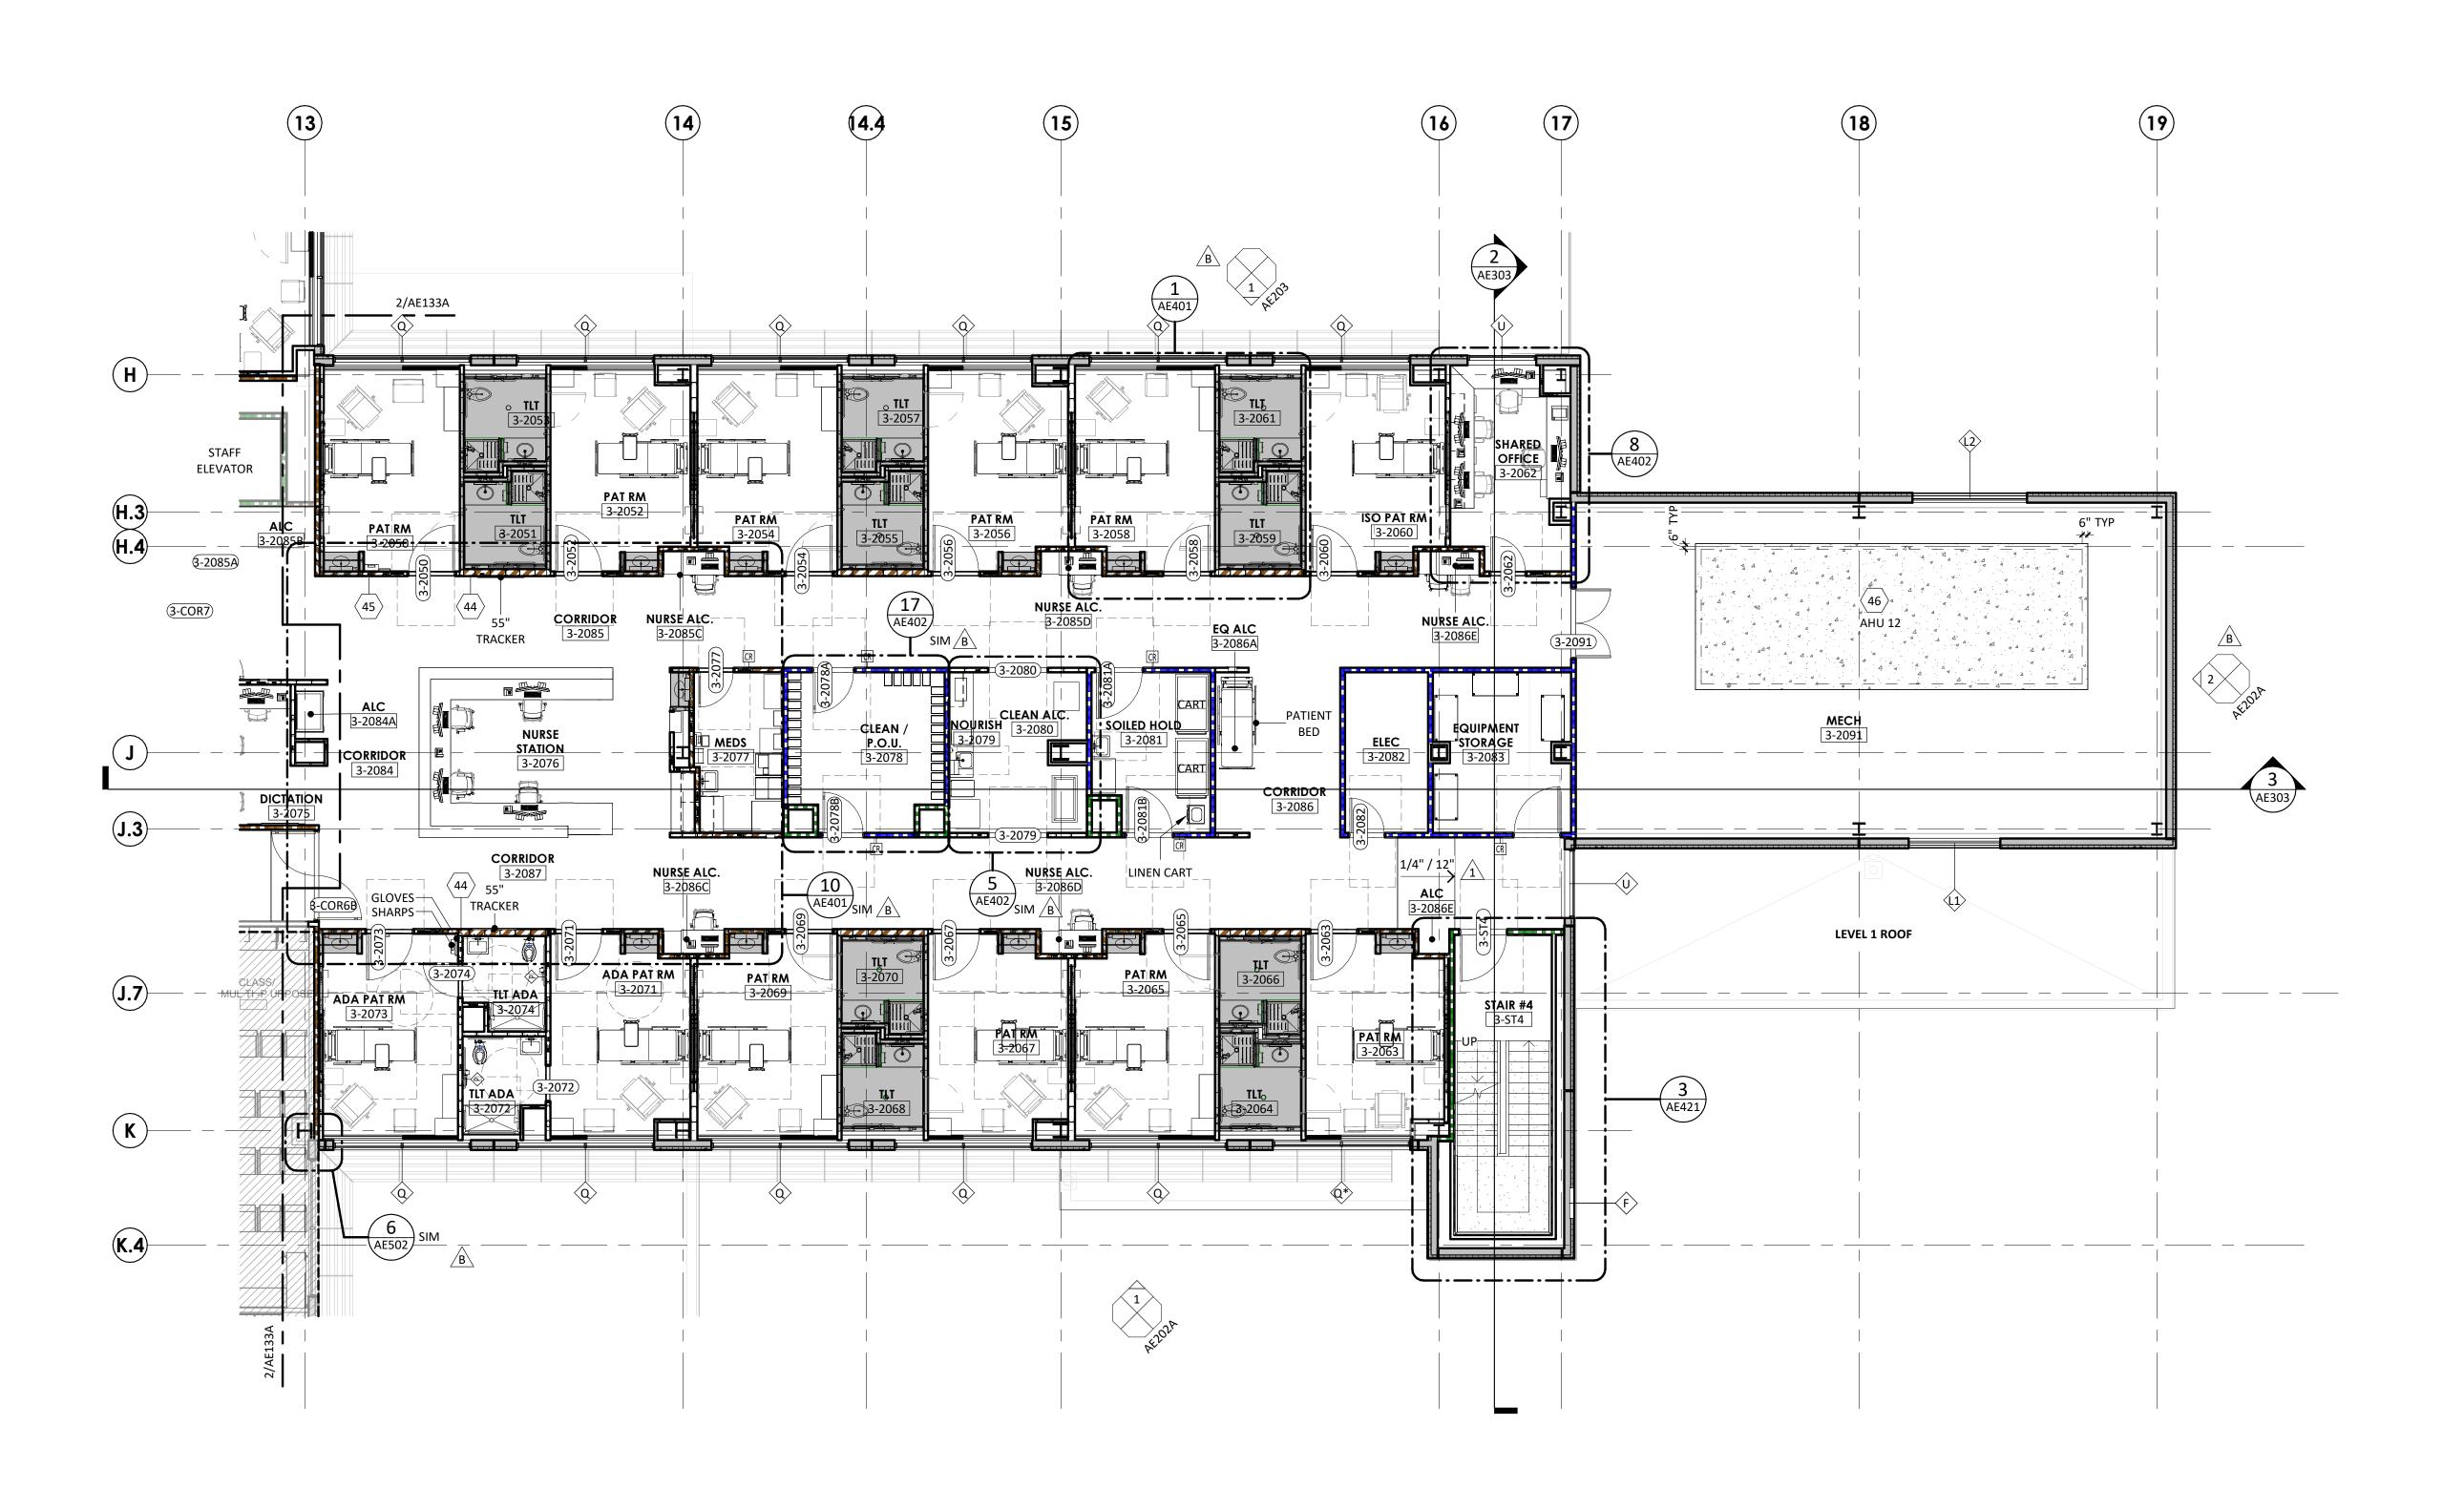

ANNOTATION PLAN - LEVEL 3 - SECTOR B - MED/SURG (12-BED UNIT)

### ANNOTATION PLAN GENERAL NOTES

- THE WORD "CLEAR" INDICATES CRITICAL DIMENSIONS FOR ACCESSIBLE EQUIPMENT OR FUNCTIONAL CLEARANCES FROM FACE OF FINISH TO FACE OF FINISH.
   DIMENSIONS MEASURE FROM THE EXPOSED SURFACE OF EXISTING WALLS, PARTITIONS, COLUMNS, ETC.; NEW PARTITIONS ARE DIMENSIONED TO THE FACE OF THE FRAMING; MEASURE AND VERIFY DIMENSIONS IN FIELD.
- ALL INFORMATION GRAYED-OUT INDICATES EXISTING.
   SOLID GRAY INFORMATION INDICATES PRE-FABRICATED COMPONENTS BY OWNER VENDOR. REFER TO VENDOR DRAWINGS FOR ADDITIONAL INFORMATION.

|          | PARTIT | TON LEGEND   |
|----------|--------|--|
| EXISTING | NEW    |  |
|          |        | NON-RATED PARTITION  |
|          |        | 2-HOUR FIRE BARRIER  |
|          |        | 1-HOUR FIRE BARRIER  |
|          |        | 1-HOUR SMOKE BARRIER   |
|          |        | SMOKE PARTITION  |
|          |        | 1-HOUR FIRE PARTITION  |
|          |        | LIMITS OF CONSTRUCTION (SHADE INDICATES AREA OUTSIDE OF SCOP |

|     | KEYNOTE LEGEND  |
|-----|---|
| KEY | NOTE  |
|     |   |
| 44  | MED GAS ZONE VALVE BOX  |
| 45  | MED GAS AREA ALARM PANEL  |
| 46  | HOUSEKEEPING PAD. COORDINATE FINAL SIZE WITH MECHANICAL. REFER TO |
|     | MECHANICAL AND STRUCTURAL DRAWINGS.                               |

|           | <u>OFCI</u> | <b>EQUIPMENT SCHEDU</b>     | <u>LE</u> |         |
|-----------|-------------|-----------------------------|-----------|---------|
| HCA EQUIP |             |                             | FURNISHED | INSTALL |
| NO        | ABBREV      | DESCRIPTION                 | ВҮ        | ВҮ      |
|           |             |                             | T         | T       |
| 100912    | CACTUS SINK | CACTUS SINK                 | OF        | CI      |
| 101351    | REF         | UNDERCOUNDER                | OF        | CI      |
|           |             | REFRIGERATOR - MEDS         |           |         |
| 101475    | REF         | REFIGERATOR -SIDE BY SIDE   | OF        | CI      |
| 101534    | MICRO       | MICROWAVE OVEN              | OF        | CI      |
|           |             | COUNTERTOP                  |           |         |
| 101610    | POWER       | CACTUS SINK - POWER ADAPTER | OF        | CI      |
|           | ADAPTER     |                             |           |         |
| 101869    | REF         | REFIGERATOR W/ FREEZER      | OF        | CI      |
| 714443    | ICE         | ICE & WATER MAKER           | OF        | CI      |
| 714519    | FILTER      | WATER FILTER SYSTEM         | OF        | CI      |
| 715943    | STAND       | ICE/WATER DISPENSER STAND   | OF        | CI      |
| 727039    | САВ         | WARMING CABINET             | OF        | CI      |
| 727553    | COFF        | COFFEE MACHINE              | OF        | CI      |
|           | 1           | 1                           | 1         |         |




Devenney Group Ltd., Architects

6900 East Camelback Road

www.devenneygroup.com

Suite 500 Scottsdale, AZ 85251 T: 602.943.8950

Consultant:

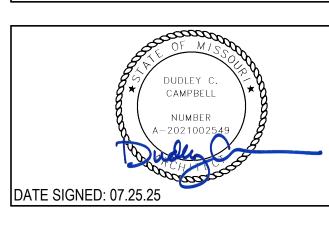

IF THESE PLANS DO NOT BEAR THE SEAL OF A REGISTRANT, THEY ARE TO BE CONSIDERED "PRELIMINARY" AND ARE NOT TO BE USED FOR CONSTRUCTION OR RECORDING. THESE PLANS ARE COPYRIGHTED AND ARE SUBJECT TO COPYRIGHT PROTECTION AS AN "ARCHITECTURAL WORK" UNDER SEC. 102 OF THE COPYRIGHT ACT, 17 U.S.O. AS AMENDED DECEMBER 1990 AND KNOWN AS ARCHITECTURAL WORKS COPYRIGHT PROTECTION ACT OF 1990. THE PROTECTION INCLUDES BUT IS NOT LIMITED TO THE OVERALL FORM AS WELL AS THE ARRANGEMENT AND COMPOSITION OF SPACES AND ELEMENTS OF THE DESIGN. UNDER SUCH PROTECTION, UNAUTHORIZED USE OF THESE PLANS CAN LEGALLY RESULT IN THE CESSATION OF CONSTRUCTION OR BUILDINGS BEING SEIZED AND/OR MONETARY COMPENSATION TO DEVENNEY GROUP LTD.

MED SURG &
DIETARY
EXPANSION

HCA - LEE'S SUMMIT MEDICAL CENTER 2100 SE BLUE PKWY LEE'S SUMMIT, MO 64063

AUTHORITY HAVING JURISDICTION:
CITY OF LEE'S SUMMIT BUILDING DEPT.
MISSOURI DHSS

FACILITY NUMBER:
0972400009


AGENCY APPROVALS:
AGENCY


|      | REVISIONS           |            |
|------|---------------------|------------|
| REV# | DESCRIPTION         | DATE       |
| В    | DESIGN COORDINATION | 2025/02/06 |
| 1    | DESIGN COORDINATION | 2025/06/06 |
| 2    | DESIGN COORDINATION | 2025/07/25 |

DATE: 2024/12/05
SCALE: 1/8" = 1'-0"
DRAWN:
REVIEWED:
JOB NUMBER: 6406.24

ANNOTATION FLOOR PLAN - LEVEL 3 - SECTOR B - MEDSURG

AE133B

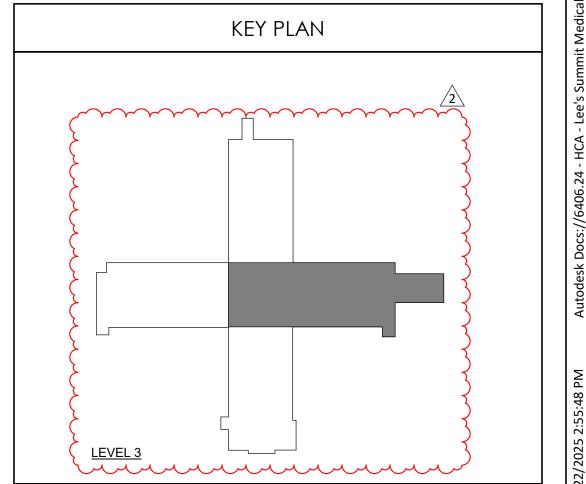

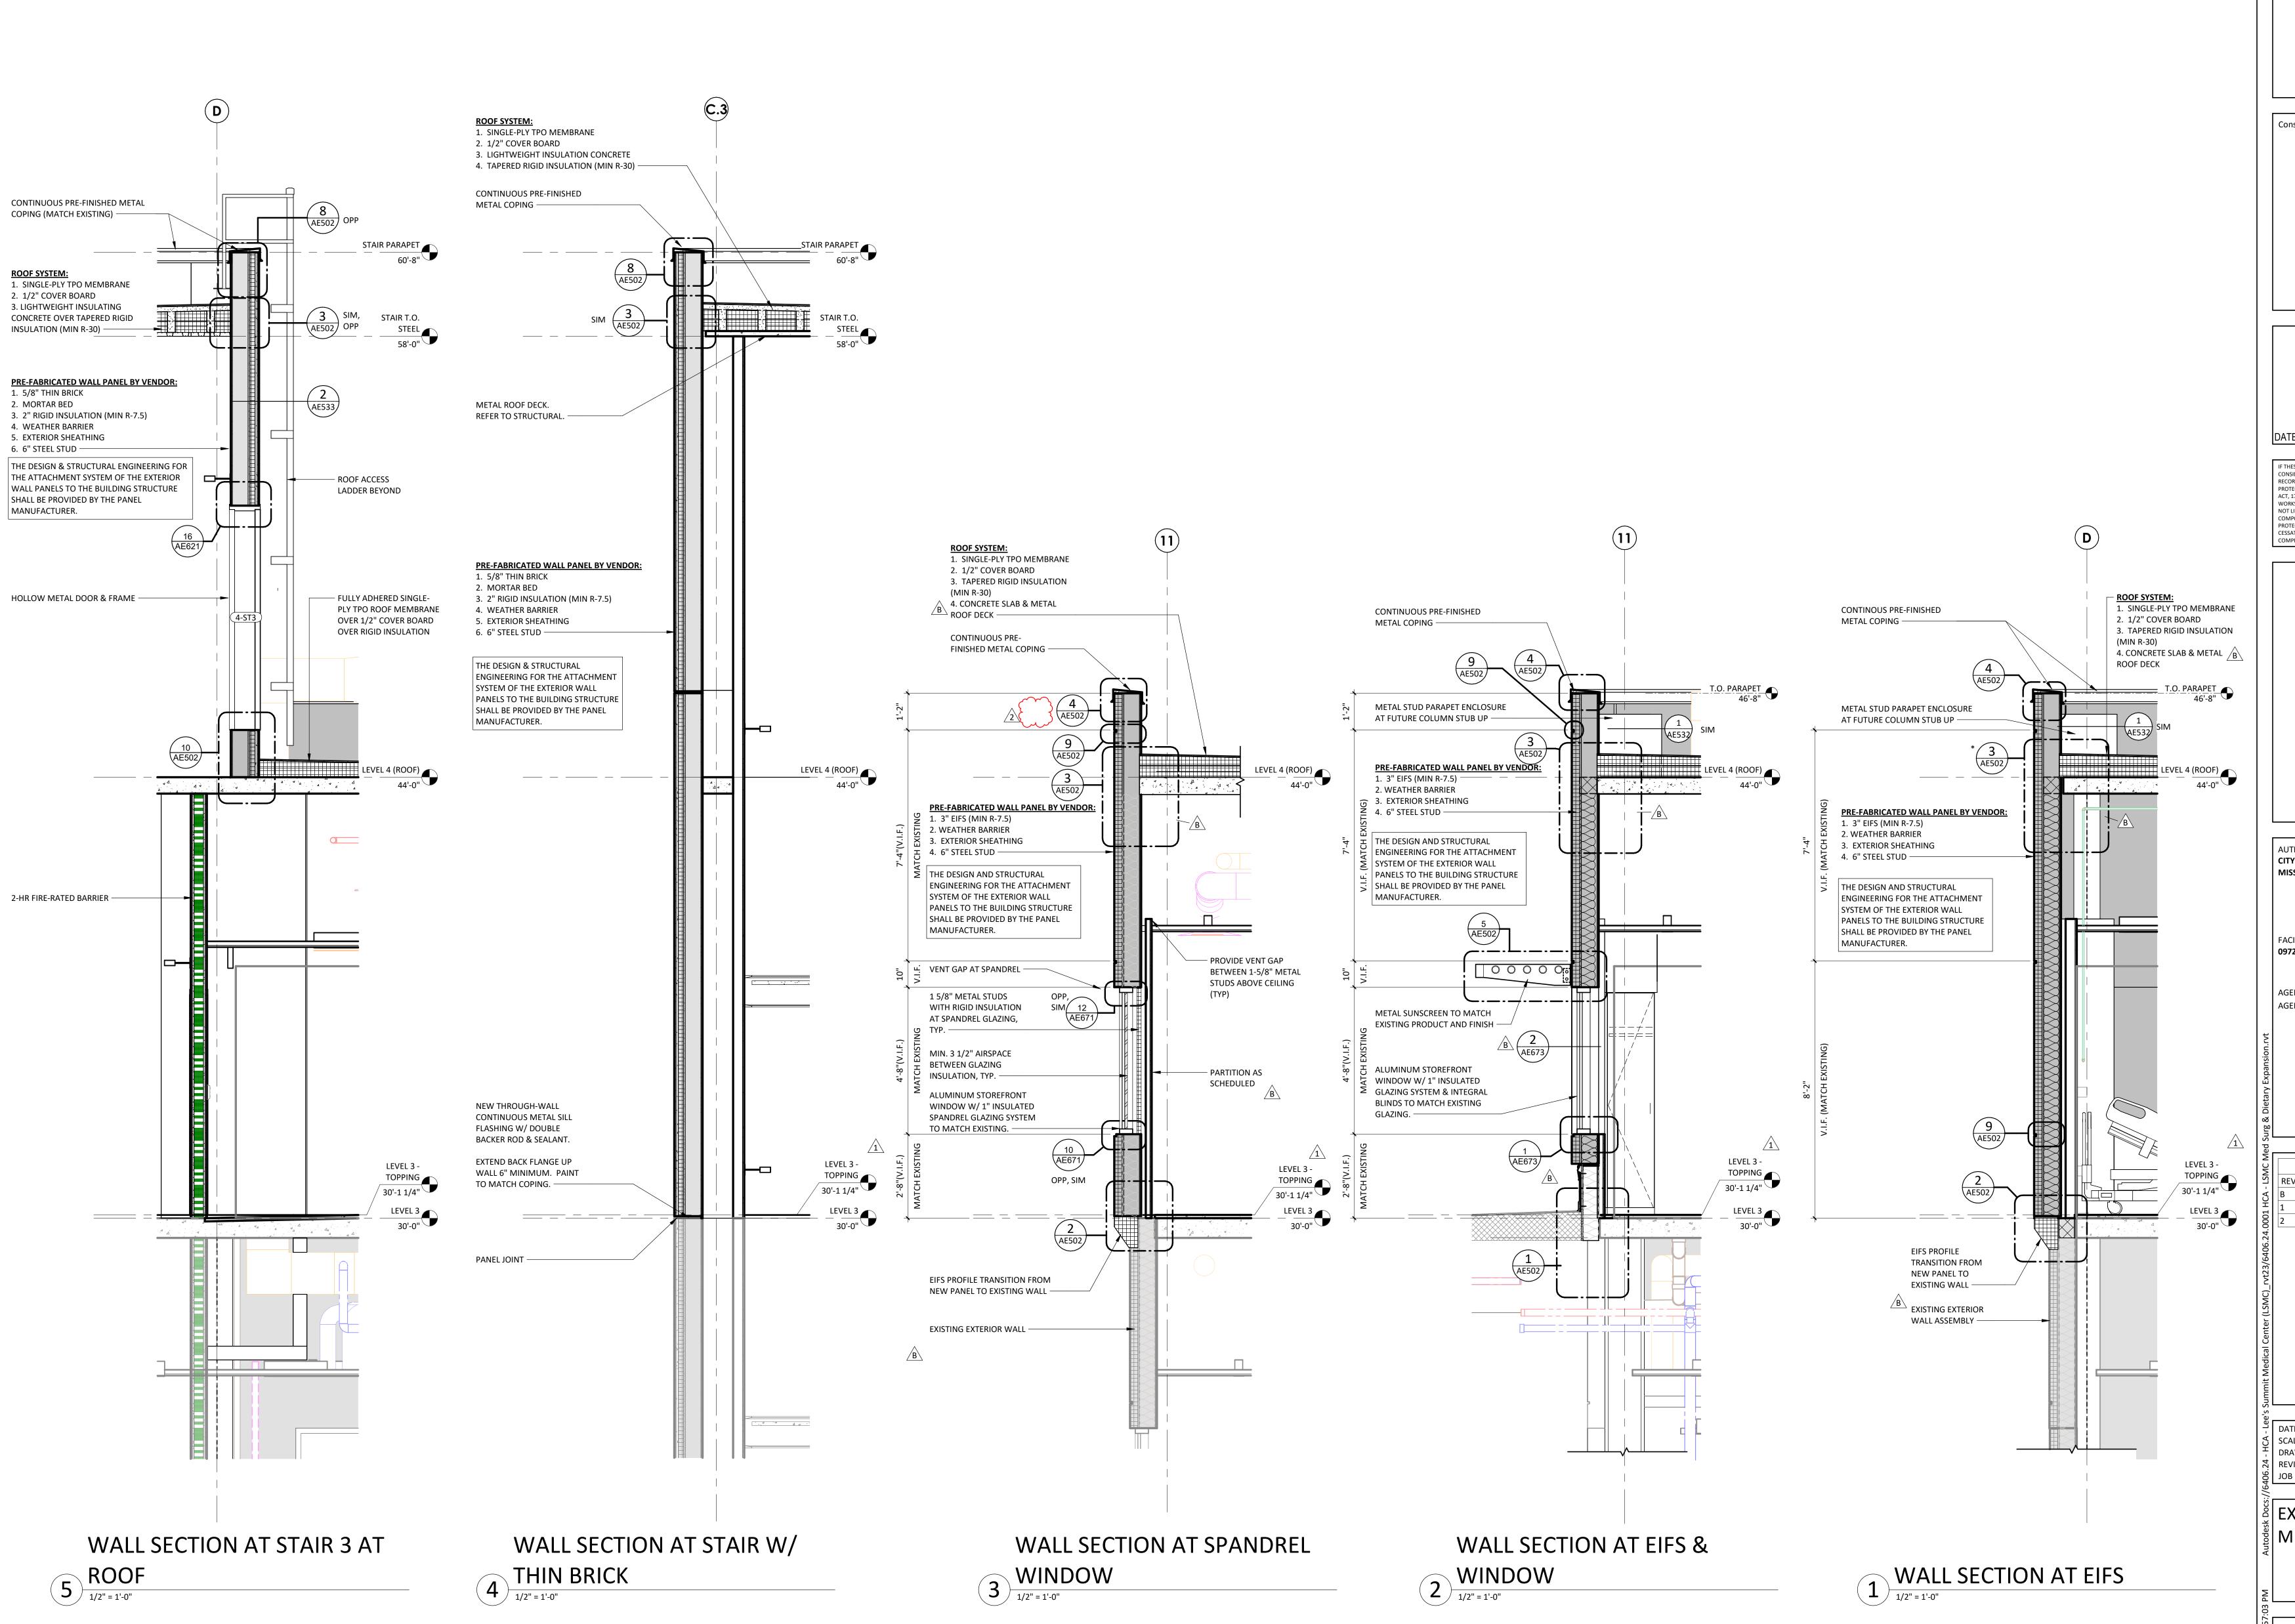




6900 East Camelback Road Suite 500 Scottsdale, AZ 85251 T: 602.943.8950

www.devenneygroup.com

Consultant:

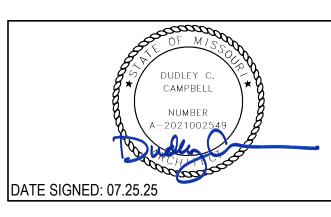

IF THESE PLANS DO NOT BEAR THE SEAL OF A REGISTRANT, THEY ARE TO BE CONSIDERED "PRELIMINARY" AND ARE NOT TO BE USED FOR CONSTRUCTION OR RECORDING. THESE PLANS ARE COPYRIGHTED AND ARE SUBJECT TO COPYRIGHT PROTECTION AS AN "ARCHITECTURAL WORK" UNDER SEC. 102 OF THE COPYRIGHT ACT, 17 U.S.O. AS AMENDED DECEMBER 1990 AND KNOWN AS ARCHITECTURAL WORKS COPYRIGHT PROTECTION ACT OF 1990. THE PROTECTION INCLUDES BUT IS NOT LIMITED TO THE OVERALL FORM AS WELL AS THE ARRANGEMENT AND COMPOSITION OF SPACES AND ELEMENTS OF THE DESIGN. UNDER SUCH PROTECTION, UNAUTHORIZED USE OF THESE PLANS CAN LEGALLY RESULT IN THE CESSATION OF CONSTRUCTION OR BUILDINGS BEING SEIZED AND/OR MONETARY COMPENSATION TO DEVENNEY GROUP LTD.

# MED SURG & DIETARY EXPANSION

HCA - LEE'S SUMMIT MEDICAL CENTER 2100 SE BLUE PKWY LEE'S SUMMIT, MO 64063

AUTHORITY HAVING JURISDICTION:
CITY OF LEE'S SUMMIT BUILDING DEPT.
MISSOURI DHSS


FACILITY NUMBER:
0972400009

AGENCY APPROVALS:
AGENCY


| ·  |        |                     |              |
|--|--------|---------------------|--------------|
| B DESIGN COORDINATION 2025/02/06 1 DESIGN COORDINATION 2025/06/06 2 DESIGN COORDINATION 2025/07/25  DATE: 2024/12/05 SCALE: 1/2" = 1'-0"     |        | REVISIONS           |              |
| 1       DESIGN COORDINATION       2025/06/06         2       DESIGN COORDINATION       2025/07/25     DATE:  SCALE:  2024/12/05 1/2" = 1'-0" | REV#   | DESCRIPTION         | DATE         |
| DATE: 2024/12/05 SCALE: 2024/12/05   | В      | DESIGN COORDINATION | 2025/02/06   |
| DATE: 2024/12/05<br>SCALE: 1/2" = 1'-0"  | 1      | DESIGN COORDINATION | 2025/06/06   |
| SCALE: 1/2" = 1'-0"  | 2      | DESIGN COORDINATION | 2025/07/25   |
| SCALE: 1/2" = 1'-0"  |        |                     |              |
| SCALE: 1/2" = 1'-0"  |        |                     |              |
| ·  | DATE:  |                     | 2024/12/05   |
| DDAMAN.  | SCALE: |                     | 1/2" = 1'-0" |

EXTERIOR WALL SECTIONS -

MED/SURG

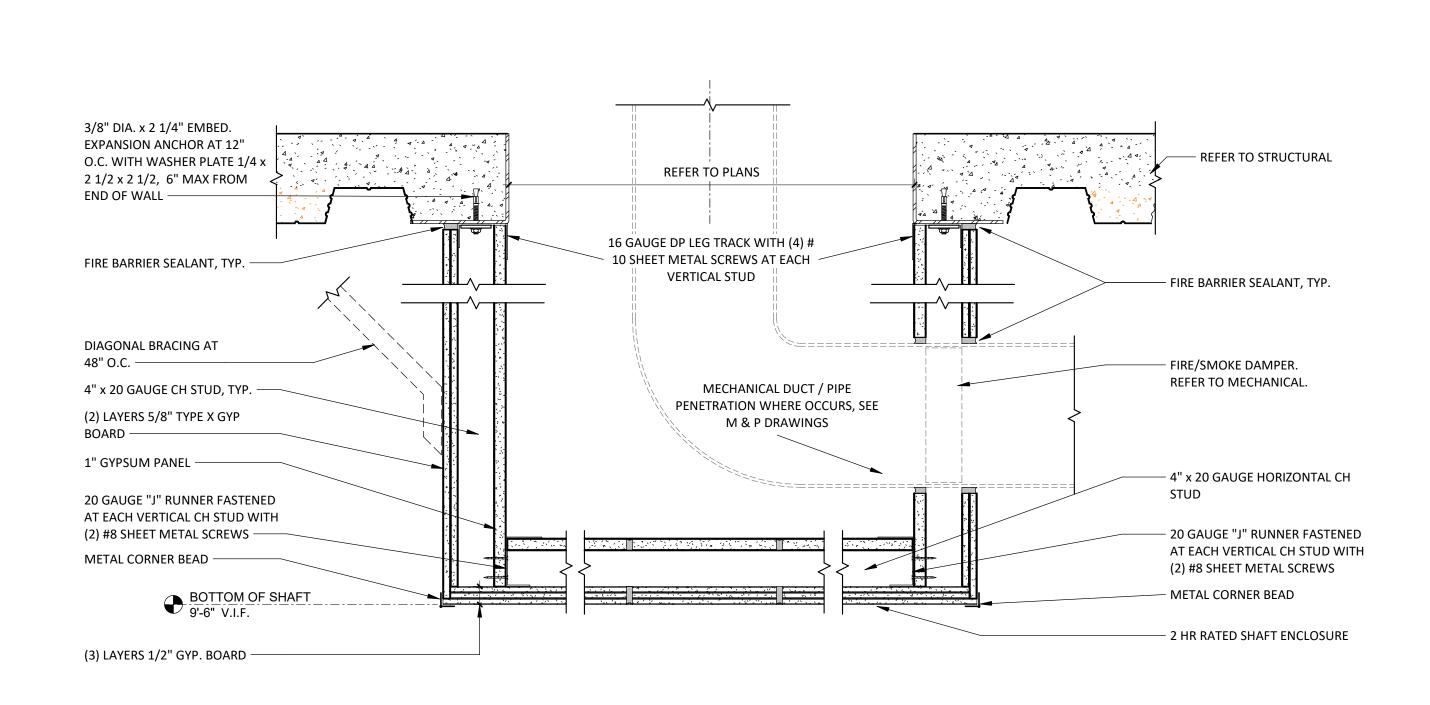




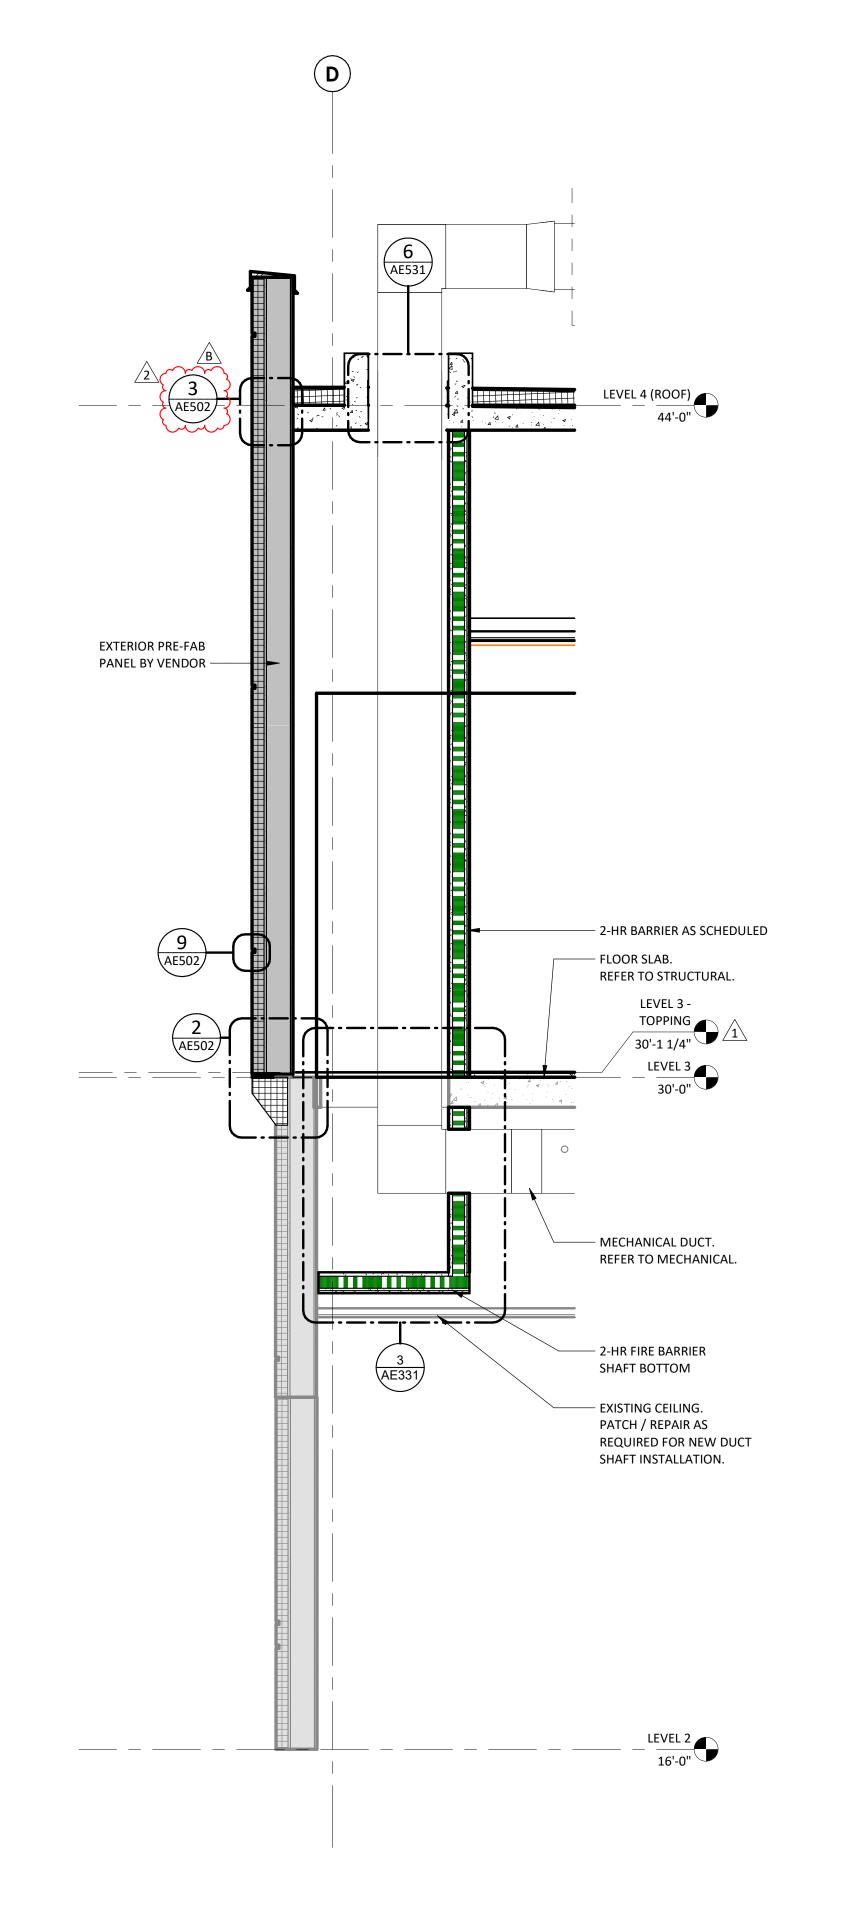

WALL SECTION AT 2-HR FIRE RATED DUCT SHAFT

ENCLOSURE AT EXTERIOR WALL

1/2" = 1'-0"

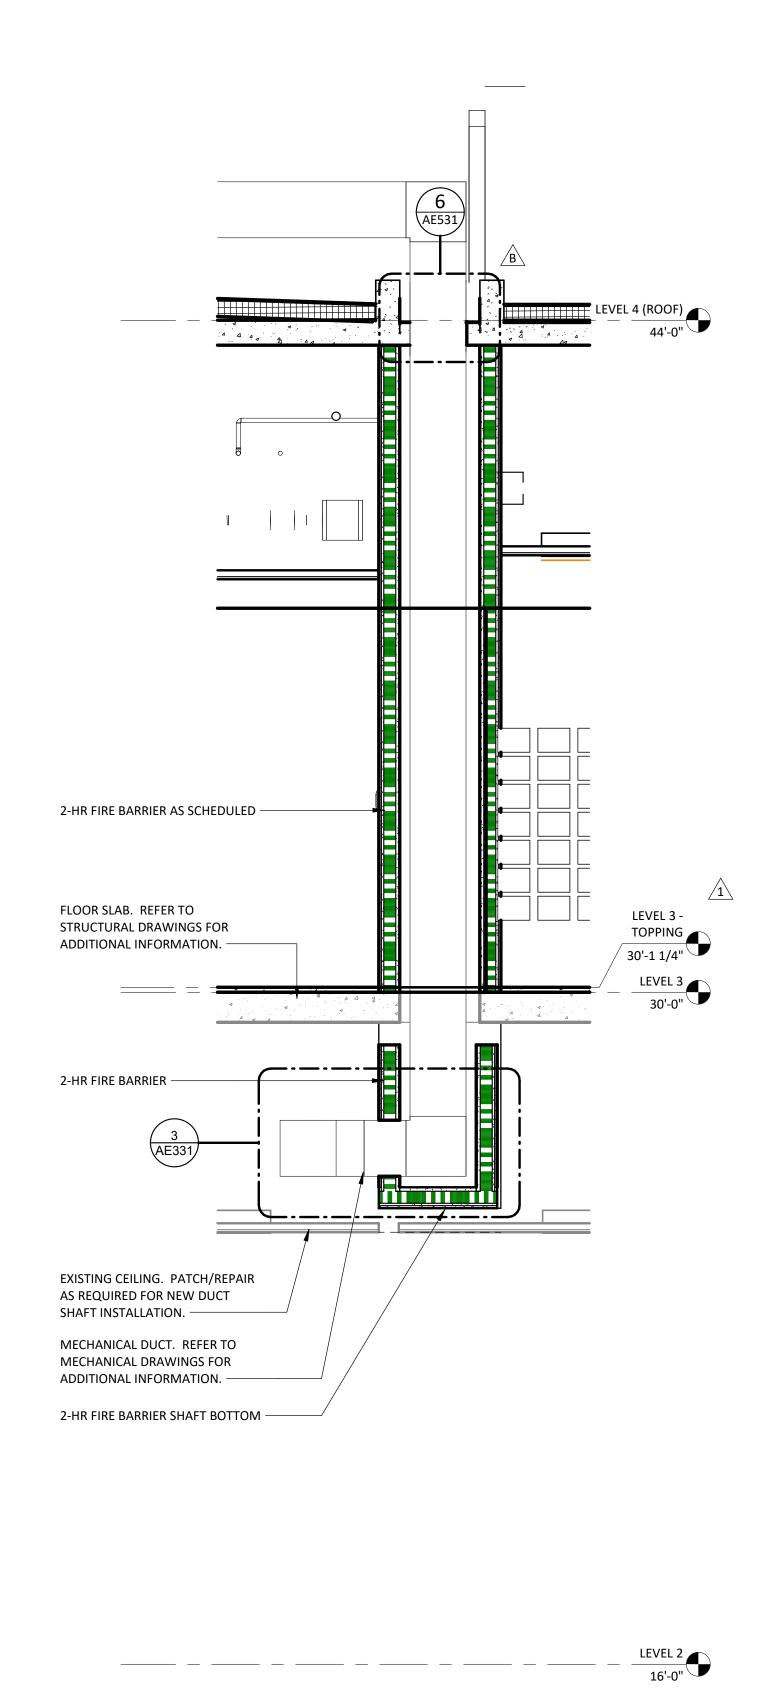

WALL SECTION AT 2-HR FIRE RATED DUCT SHAFT

ENCLOSURE (TYP)

1/2" = 1'-0"



6900 East Camelback Road Suite 500 Scottsdale, AZ 85251 T: 602.943.8950

www.devenneygroup.com

Consultant:

DUDLEY C.
CAMPBELL

NUMBER
A-2021002549

DATE SIGNED: 07.25.25

IF THESE PLANS DO NOT BEAR THE SEAL OF A REGISTRANT, THEY ARE TO BE CONSIDERED "PRELIMINARY" AND ARE NOT TO BE USED FOR CONSTRUCTION OR RECORDING. THESE PLANS ARE COPYRIGHTED AND ARE SUBJECT TO COPYRIGHT PROTECTION AS AN "ARCHITECTURAL WORK" UNDER SEC. 102 OF THE COPYRIGHT ACT, 17 U.S.O. AS AMENDED DECEMBER 1990 AND KNOWN AS ARCHITECTURAL WORKS COPYRIGHT PROTECTION ACT OF 1990. THE PROTECTION INCLUDES BUT IS NOT LIMITED TO THE OVERALL FORM AS WELL AS THE ARRANGEMENT AND COMPOSITION OF SPACES AND ELEMENTS OF THE DESIGN. UNDER SUCH PROTECTION, UNAUTHORIZED USE OF THESE PLANS CAN LEGALLY RESULT IN THE CESSATION OF CONSTRUCTION OR BUILDINGS BEING SEIZED AND/OR MONETARY COMPENSATION TO DEVENNEY GROUP LTD.

MED SURG &
DIETARY
EXPANSION

HCA - LEE'S SUMMIT MEDICAL CENTER 2100 SE BLUE PKWY LEE'S SUMMIT, MO 64063

AUTHORITY HAVING JURISDICTION:
CITY OF LEE'S SUMMIT BUILDING DEPT.
MISSOURI DHSS

FACILITY NUMBER: **0972400009** 

AGENCY APPROVALS: AGENCY

REVISIONS

/# DESCRIPTION DATE


DESIGN COORDINATION 2025/02/06

DESIGN COORDINATION 2025/06/06

DESIGN COORDINATION 2025/07/25

DATE: 2024/12/05
SCALE: As indicated
DRAWN:
REVIEWED:
JOB NUMBER: 6406.24

INTERIOR SHAFT WALL
SECTIONS & DETAILS

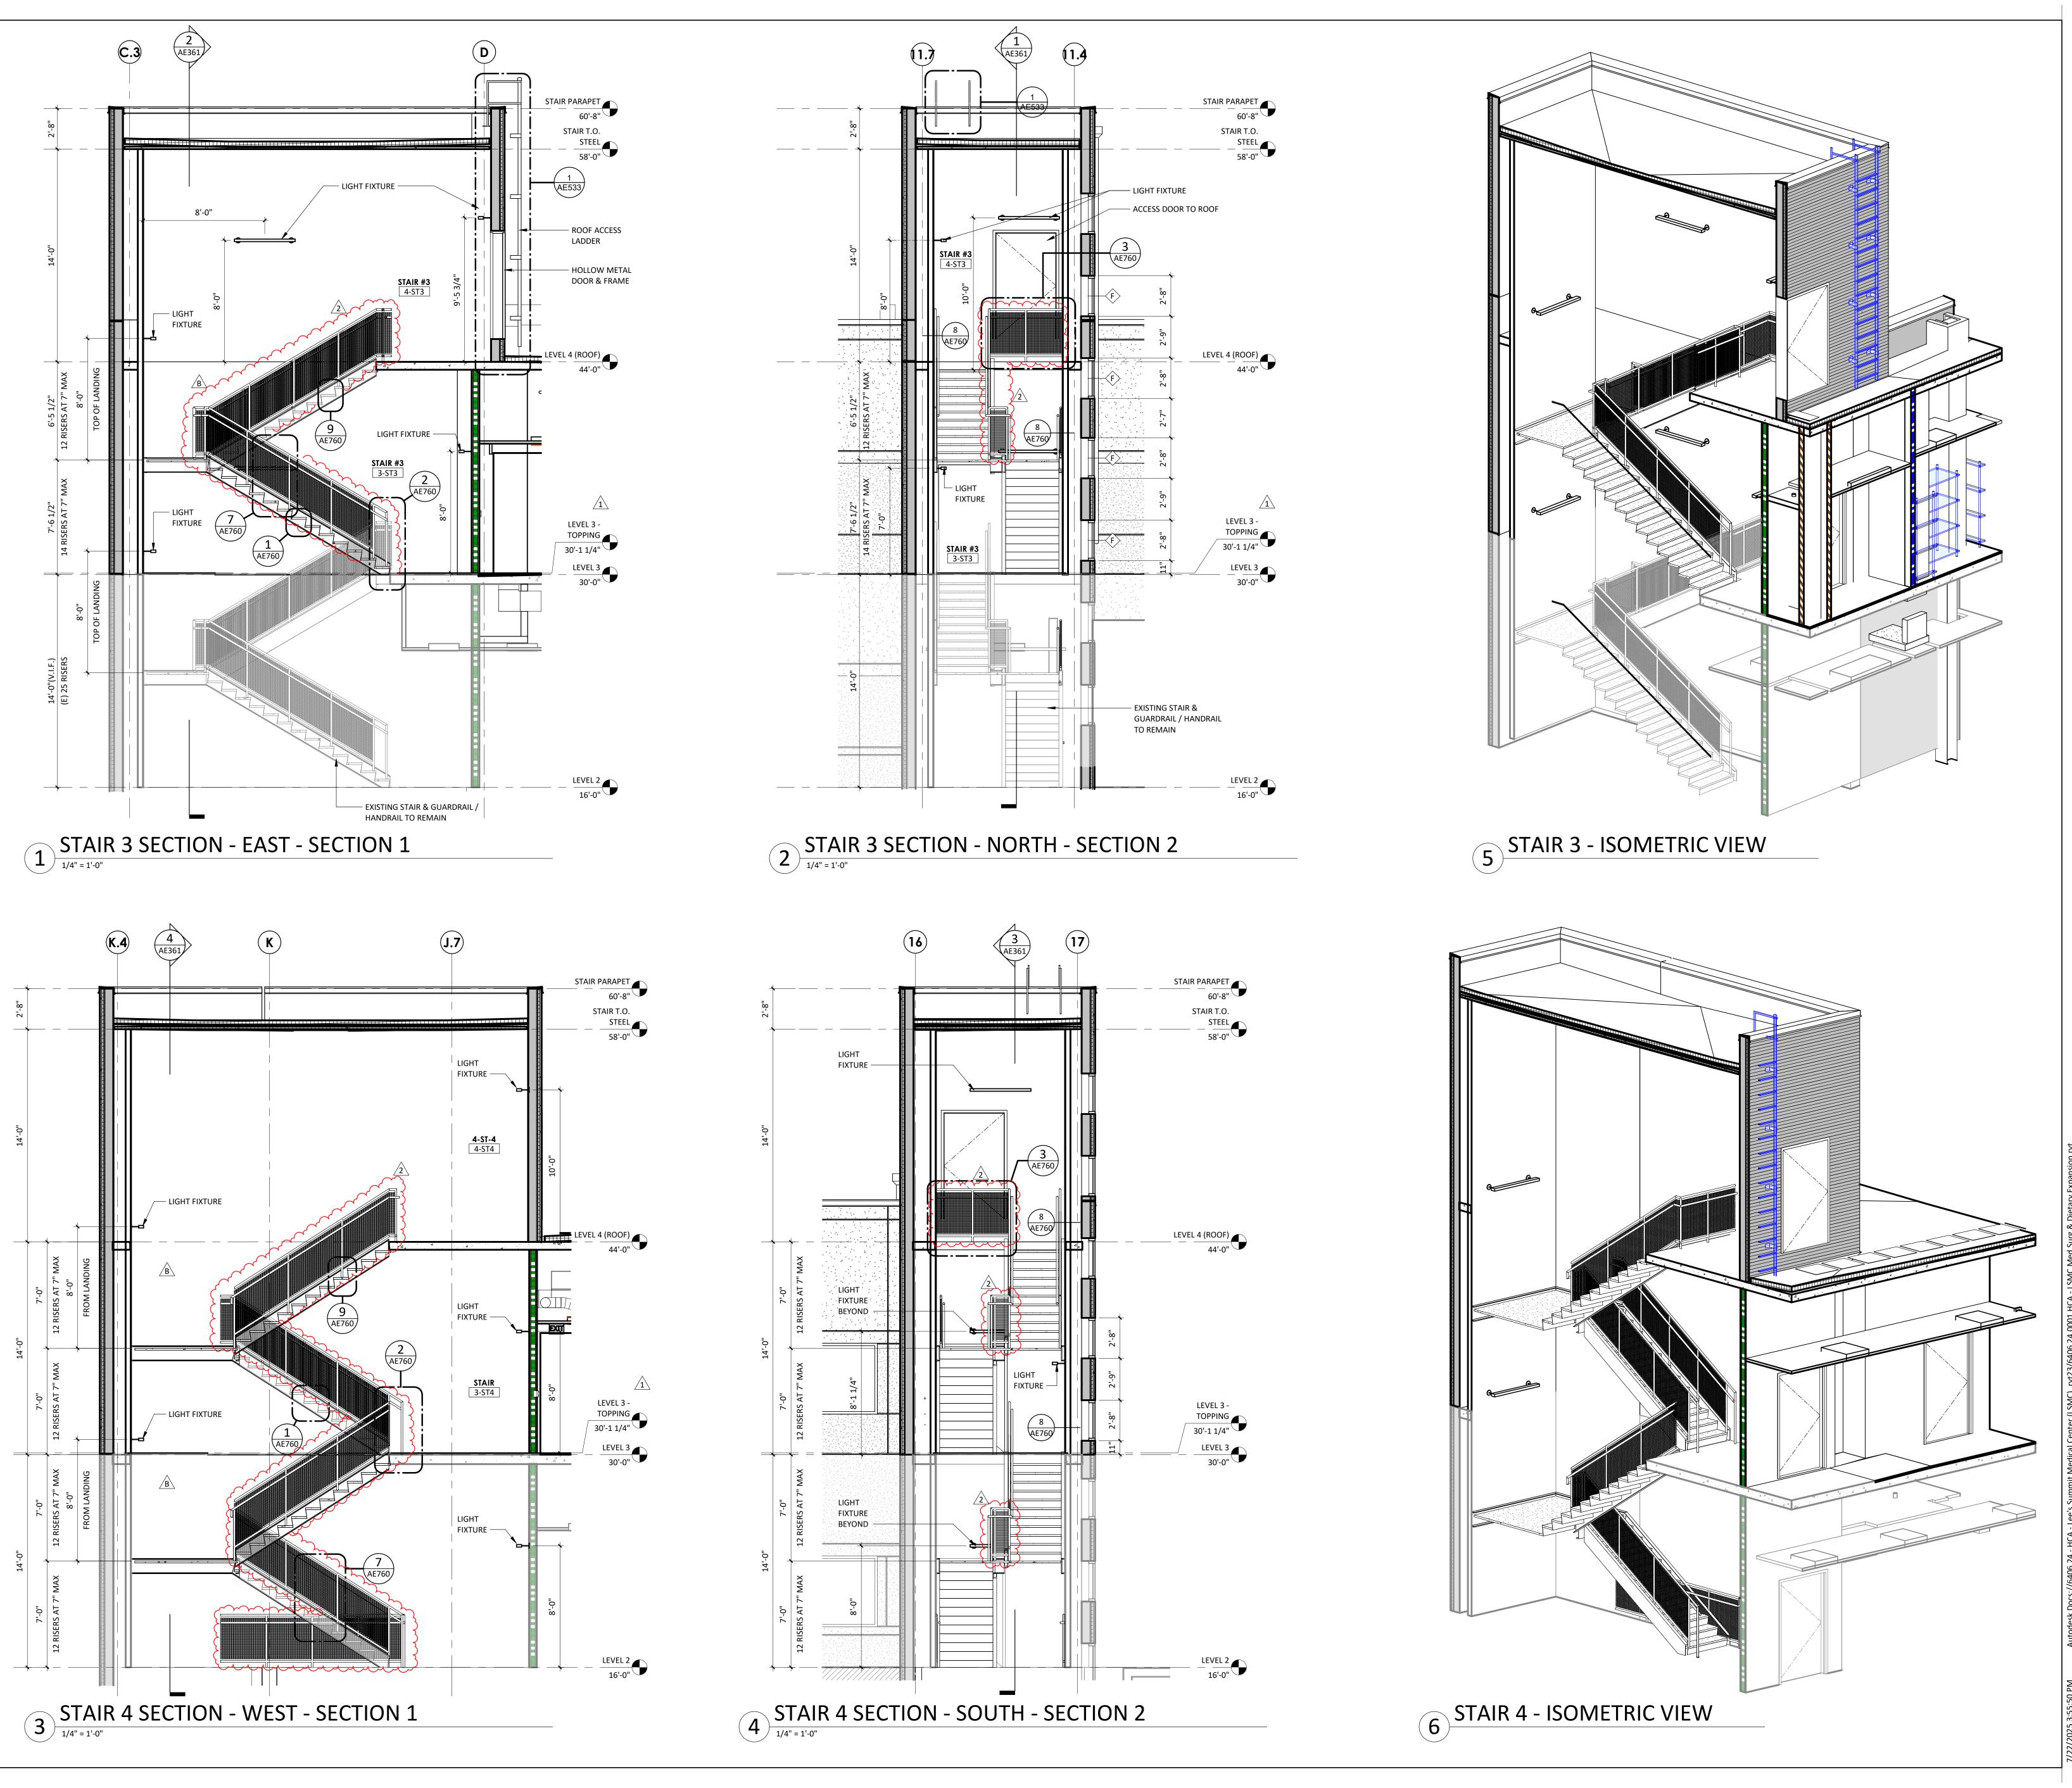

Devenney
GROUP


Devenney Group Ltd., Architects

Devenney Group Ltd., Archit 6900 East Camelback Road Suite 500 Scottsdale, AZ 85251 T: 602.943.8950

www.devenneygroup.com

Consultant:

amm

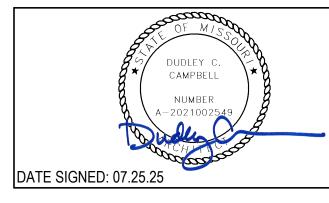

IF THESE PLANS DO NOT BEAR THE SEAL OF A REGISTRANT, THEY ARE TO BE CONSIDERED "PRELIMINARY" AND ARE NOT TO BE USED FOR CONSTRUCTION OR RECORDING. THESE PLANS ARE COPYRIGHTED AND ARE SUBJECT TO COPYRIGHT PROTECTION AS AN "ARCHITECTURAL WORK" UNDER SEC. 102 OF THE COPYRIGHT ACT, 17 U.S.O. AS AMENDED DECEMBER 1990 AND KNOWN AS ARCHITECTURAL WORKS COPYRIGHT PROTECTION ACT OF 1990. THE PROTECTION INCLUDES BUT IS NOT LIMITED TO THE OVERALL FORM AS WELL AS THE ARRANGEMENT AND COMPOSITION OF SPACES AND ELEMENTS OF THE DESIGN. UNDER SUCH PROTECTION, UNAUTHORIZED USE OF THESE PLANS CAN LEGALLY RESULT IN THE CESSATION OF CONSTRUCTION OR BUILDINGS BEING SEIZED AND/OR MONETARY COMPENSATION TO DEVENNEY GROUP LTD.

MED SURG &
DIETARY
EXPANSION

HCA - LEE'S SUMMIT MEDICAL CENTER 2100 SE BLUE PKWY LEE'S SUMMIT, MO 64063

AUTHORITY HAVING JURISDICTION:
CITY OF LEE'S SUMMIT BUILDING DEPT.
MISSOURI DHSS

FACILITY NUMBER:
0972400009

AGENCY APPROVALS: AGENCY

REV# DESCRIPTION DATE
B DESIGN COORDINATION 2025/02/06
1 DESIGN COORDINATION 2025/06/06
2 DESIGN COORDINATION 2025/07/25

DATE: 2024/12/05
SCALE: 1/4" = 1'-0"
DRAWN:
REVIEWED:
JOB NUMBER: 6406.24

STAIR WALL SECTIONS

|                              |                            | DOOR SCHEDULE      |                            |  |
|------------------------------|----------------------------|--------------------|----------------------------|--|
| DOOR MATERIAL                | DOOR GLAZING               | FRAME MATERIAL     | FRAME GLAZING              | REMARKS                                      |
| WD - SOLID CORE WOOD         | T - TEMPERED               | HM - HOLLOW METAL  | T - TEMPERED               | 1 - CASED OPENING                            |
| WDPL - PLASTIC LAMINATE WOOD | L - LAMINATED              | AL - ALUMINUM      | L - LAMINATED              | 2 - DELAYED EGRESS                           |
| WDIR - IMPACT RESISTANT WOOD | FR - FIRE RESISTIVE        | STL - STEEL        | FR - FIRE RESISTIVE        | 3 - PANIC HARDWARE                           |
| HM - HOLLOW METAL            | FP - FIRE PROTECTIVE       | EXIST 🛆 - EXISTING | FP - FIRE PROTECTIVE       | 4 - MAGNETIC HOLD OPEN                       |
| AL - ALUMINUM                | SP - SPANDREL              | <u> </u>           | SP - SPANDREL              | 5 - INTEGRAL BLINDS W/ CONTROLS ON ROOM SIDE |
| STL - STEEL                  | IGU - INSULATED GLASS UNIT |                    | IGU - INSULATED GLASS UNIT |  |
| EVICT EVICTING               |                            |                    |                            |  |

| ID      | MIDTH  | LIFICLIT |           | DOOR PANEL |         | FRA      | ME    |             | DETAILS     |          | RATING | HADDWADE | 2  |
|---------|--------|----------|-----------|------------|---------|----------|-------|-------------|-------------|----------|--------|----------|--|
| ID WI   | WIDTH  | HEIGHT   | MATERIAL  | ELEV.      | GLAZING | MATERIAL | ELEV. | HEAD        | JAMB        | SILL     | FIRE   | HARDWARE | REMARKS  |
| VEL 1   |        |          |           |            |         |          |       |             |             |          |        |          |  |
| 1-1300  | 6'-0"  | 7'-0"    | WDPL/GL   | CC         | Т       | HM       | 1     | 3/AE621     | 2/AE621     | 1/AE621  | 45 MIN | 107A.1   |  |
| 1-1300B | 3'-0"  | 7'-2"    | AL/GL     | E          | IGU     | AL       | 1     | 13/AE621    | 12/AE621    | 11/AE621 | -      | 105A.1   | 1  |
| 1-1301  | 20'-2" | 9'-8"    | AL        | ASSEMBLY 1 | -       | STL      |       | 6/AE621     | 5/AE621     | BY MANUF | -      | BY MANUF | ROLLING SECURITY GRILLE, ASSEMBLY 1 DOO ELEVATION, KEYED, MOTOR OPERATED |
| 1-1302  | 3'-0"  | 7'-0"    | WDPL      | А          | -       | НМ       | 1     | 3/AE621     | 2/AE621     | 1/AE621  | -      | 009A     | 3  |
| 1-1303  | 3'-0"  | 7'-0"    | HM        | А          | -       | HM       | 1     | 16/AE621    | 16/AE621    | 15/AE621 | -      | 101B     |  |
| 1-1304  | 3'-0"  | 7'-0"    | WDPL/GL   | С          | Т       | HM       | 1     | 3/AE621     | 2/AE621     | 1/AE621  | -      | 003A     |  |
| 1-1305  | 3'-0"  | 7'-0"    | WDPL/GL   | С          | Т       | HM       | 1     | 3/AE621     | 2/AE621     | 1/AE621  | -      | 003A     |  |
| 1-1306  | 3'-0"  | 7'-0"    | WDPL/GL   | С          | Т       | HM       | 1     | 3/AE621     | 2/AE621     | 1/AE621  | -      | 008B     |  |
| 1-1309  | 3'-6"  | 7'-0"    | WDPL      | А          | -       | НМ       | 1     | 3/AE621     | 2/AE621     | 1/AE621  | 45 MIN | 004F     |  |
| 1-1310  | 3'-6"  | 7'-0"    | WDPL      | A          | -       | HM       | 1     | 3/AE621     | 2/AE621     | 1/AE621  | 45 MIN | 004F     |  |
| 1-1311  | 3'-0"  | 7'-0"    | , WDPL/GL | С          | Т       | HM       | 1     | 3/AE621     | 2/AE621     | 1/AE621  | -      | 003B     |  |
| 1-1312  | 3'-6"  | 7'-0"    | B EXIST   | -          | -       | EXIST    | EXIST | 3/AE621 SIM | 2/AE621 SIM | 1/AE621  | 45 MIN | EX11     | RELOCATED DOOR, FRAME & HARDWARE   |
| 1-1313  | 3'-0"  | 7'-0"    | WDPL      | A          | _       | HM       | 1     | 3/AE621     | 2/AE621     | 1/AE621  | -      | 006A     |  |
| 1-1314  | 3'-0"  | 7'-0"    | WDPL      | A          | -       | HM       | 1     | 3/AE621     | 2/AE621     | 1/AE621  | _      | 005B     |  |

### DOOR GENERAL NOTES

- THE PURPOSE OF THIS SHEET IS TO DESCRIBE AND ILLUSTRATE DOOR TYPES. NOT ALL DOOR TYPES SHOWN ARE NECESSARILY USED. SEE DOOR MARK SCHEDULE FOR

  POOR TYPES LISER.
- DOOR TYPES USED.

  2. FIRE DOORS AND FRAMES SHALL HAVE AN APPROVED LABEL OR LISTING MARK INDICATING THE FIRE PROTECTION RATING WHICH IS PERMANENTLY AFFIXED AT THE
- INDICATING THE FIRE PROTECTION RATING WHICH IS PERMANENTLY AFFIXED AT FACTORY WHERE FABRICATION AND ASSEMBLY ARE DONE.

  SMOKE BARRIER DOORS INSTALLED ACROSS THE CORRIDORS AND EXIT ACCESS DOORS LOCATED AT ZONE BOUNDARIES SHALL BE EQUIPPED WITH APPROVED
- VISION PANELS.

  4. ALL SMOKE BARRIER DOORS LOCATED ON THE FLOOR OR IN THE AFFECTED ZONE SHALL COMPLY WITH CURRENT APPLICABLE CODES AND SHALL BE AUTOMATIC CLOSING UPON ACTIVATION OF THE FIRE ALARM OR FIRE SPRINKLER SYSTEM.

  5. ALL DOORS IN SMOKE BARRIERS AND OPENING INTO RATED EXIT WAYS SHALL BEAR
- AN APPROVED LABEL DISPLAYING THE LETTER "S" PER CURRENT APPLICABLE CODES. FIRE ASSEMBLIES REQUIRED TO HAVE 1 ½ HOURS, 1 HOUR OR ¾ HOUR FIRE PROTECTION RATING SHALL BE EITHER AUTOMATIC OR SELF CLOSING FIRE ASSEMBLIES. AUTOMATIC CLOSING FIRE ASSEMBLIES TO BE ACTIVATED BY AN INCREASE IN TEMPERATURE SHALL HAVE HEAT-ACTUATING DEVICES INSTALLED ON EACH SIDE OF THE WALL AT THE CEILING HEIGHT WHERE THE CEILING IS MORE THAN 3 FEET ABOVE THE TOP OF THE OPENING OR BY A SINGLE FUSIBLE LINK IN THE OPENING INCORPORATED IN THE CLOSING DEVICE.
- 7. GLASS:
  A. INTERIOR DOORS:
- 1. NON-RATED DOORS SHALL HAVE ¼" CLEAR TEMPERED GLASS.
- ALL RATED DOORS SEE SPECIFICATIONS.
   LEAD LINED DOORS SHALL HAVE LEAD GLASS.
- . GLAZING IN THE FOLLOWING LISTED AREAS SHALL BE DEEMED TO BE LOCATED IN HAZARDOUS LOCATIONS AND SUBJECT TO HUMAN IMPACT:
- INGRESS AND EGRESS DOORS.
   FIXED PANELS IN SWINGING DOORS.
- 3. ALL GLAZING WITHIN 18" OF THE FLOOR AND WITHIN 12" OF A DOOR SHALL BE TEMPERED.
- 9. EACH LITE OF THE GLAZING SHALL BEAR THE MANUFACTURER'S LABEL DESIGNATING THE TYPE AND THICKNESS OF GLASS. WHEN APPROVED BY THE AGENCY, LABELS MAY BE OMITTED FROM OTHER THAN GLAZING MATERIALS, PROVIDED AN AFFIDAVIT IS FURNISHED BY THE GLAZING CONTRACTOR CERTIFYING THAT EACH LIGHT IS GLAZED IN ACCORDANCE WITH APPROVED PLANS AND SPECIFICATIONS. IDENTIFICATION OF GLAZING IN HAZARDOUS LOCATIONS AND SUBJECT TO HUMAN IMPACT SHALL BE ETCHED OR CERAMIC FIRED ON THE GLASS AND READABLE FROM
- THE INSIDE OF THE BUILDING AFTER INSTALLATION.

  10. EXIT DOORS SHALL BE OPERABLE FROM THE INSIDE WITHOUT THE USE OF A KEY OR

  ANY SPECIAL KNOWLEDGE OR FEFORT.
- ANY SPECIAL KNOWLEDGE OR EFFORT.

  11. PANIC HARDWARE SHALL COMPLY WITH THE REQUIREMENTS OF CURRENT APPLICABLE CODES. THE ACTIVATING MEMBER SHALL BE MOUNTED AT A HEIGHT OF NOT LESS THAN 30 INCHES NOR MORE THAN 44 INCHES ABOVE THE FLOOR. THE UNLATCHING FORCE SHALL NOT EXCEED 15 POUNDS WHEN APPLIED IN THE
- DIRECTION OF TRAVEL.

  12. DOOR ASSEMBLIES, APPROACHES AND FINISH HARDWARE SHALL BE IN COMPLIANCE WITH ACCESSIBILITY STANDARDS.
- WITH ACCESSIBILITY STANDARDS.

  13. THE MAXIMUM EFFORT TO OPERATE DOORS SHALL NOT EXCEED THE FOLLOWING:

  A SYSTEM OF THE POORS OF THE POOR OF THE POOR
- A. EXTERIOR DOORS 5.0 POUNDS
  B. INTERIOR DOORS 5.0 POUNDS
- C. FIRE DOORS 15.0 POUNDS

  14. WATER CLOSET ROOMS SHALL BE SEPARATED FROM FOOD PREPARATION AND STORAGE AREAS WITH TIGHT FITTING DOORS.
- 15. DOOR OPENING LOCATIONS:A. IMMEDIATELY (5") ADJACENT TO A FLANKING WALL UNLESS NOTED OTHERWISEB. AT THE CENTERLINE OF THE ROOM, UNLESS NOTED OTHERWISE
- C. CENTERED ON A GRID DOOR OPENINGS IN OTHER LOCATIONS ARE LOCATED BY DIMENSIONS
   16. SEE SPECIFICATIONS FOR HARDWARE SCHEDULE
- 17. ALL DOOR FRAMES ARE WELDED FRAMES, UNLESS NOTED OTHERWISE.

  18. FINISH FLOOR TRANSITIONS OCCUR AT CENTERLINE OF DOORS, UNLESS NOTED
- OTHERWISE.

  19. ALL INTERIOR DOORS WITH FIRE RATINGS GREATER THAN 20 MINUTE SHALL HAVE A
- NON-COMBUSTIBLE SILL WITH AN UNDERCUT OF 3/8" MAXIMUM ABOVE THE SILL.


  20. WEIGHT OF LEAD-LINED DOORS, LEAD STRIPS IN DOOR FRAMES AND LEAD GLAZING WHERE OCCURS SHALL MATCH WEIGHT OF LEAD IN ADJACENT PARTITION, UNLESS NOTED OTHERWISE. LEAD LINING SHALL BE INSTALLED SUCH THAT SHIELDING IS
- CONTINUOUS IN INSTALLED DOORWAY.

  21. ALL EXTERIOR DOORS SHALL HAVE METAL THRESHOLDS. SEE HARDWARE SCHEDULE.
- 22. WHERE DOOR HOLD-OPEN DEVICES OR DOOR STOPS OCCUR AT WALLS, PROVIDE BACKING PLATE PER BACKING PLATE SCHEDULE.
  23. ALL SOLID CORE WOOD DOORS TO BE STAIN GRADE, UNLESS NOTED OTHERWISE (SEE
- DOOR SCHEDULE).

  24. DOORS WITH AUTO DOOR OPENINGS SHALL MEET REQUIREMENTS IN CURRENT
- APPLICABLE CODES.

  25. THRESHOLDS AT DOORWAYS AND TRANSITION STRIPS SHALL NOT EXCEED 1/2" IN HEIGHT. RAISED THRESHOLDS AND FLOOR LEVEL CHANGES AT ACCESSIBLE


DOORWAYS SHALL BE BEVELED WITH A SLOPE NO GREATER THAN 1:2.

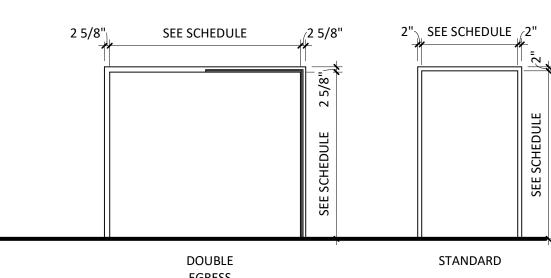


EGRESS

EDANAE 1

## **FRAME ELEVATIONS**

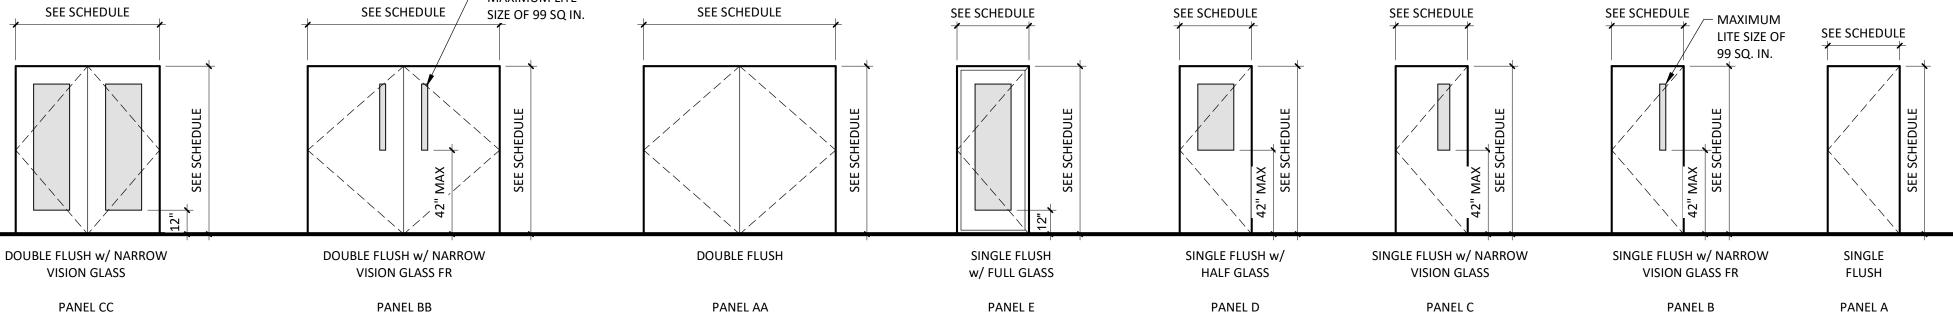

## **DOOR PANEL ELEVATIONS**

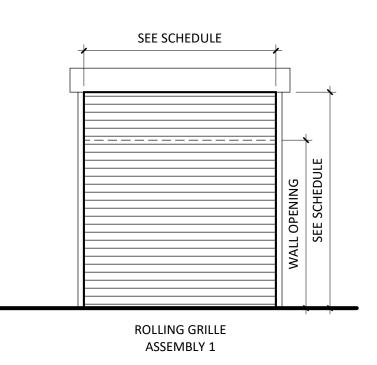

DOOR ASSEMBLY ELEVATIONS



Devenney Group Ltd., Architects


6900 East Camelback Road

www.devenneygroup.com

Scottsdale, AZ 85251 T: 602.943.8950

Suite 500

Consultant:

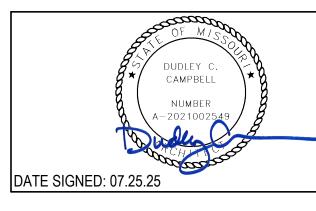

IF THESE PLANS DO NOT BEAR THE SEAL OF A REGISTRANT, THEY ARE TO BE CONSIDERED "PRELIMINARY" AND ARE NOT TO BE USED FOR CONSTRUCTION OR RECORDING. THESE PLANS ARE COPYRIGHTED AND ARE SUBJECT TO COPYRIGHT PROTECTION AS AN "ARCHITECTURAL WORK" UNDER SEC. 102 OF THE COPYRIGHT ACT, 17 U.S.O. AS AMENDED DECEMBER 1990 AND KNOWN AS ARCHITECTURAL WORKS COPYRIGHT PROTECTION ACT OF 1990. THE PROTECTION INCLUDES BUT IS NOT LIMITED TO THE OVERALL FORM AS WELL AS THE ARRANGEMENT AND COMPOSITION OF SPACES AND ELEMENTS OF THE DESIGN. UNDER SUCH PROTECTION, UNAUTHORIZED USE OF THESE PLANS CAN LEGALLY RESULT IN THE CESSATION OF CONSTRUCTION OR BUILDINGS BEING SEIZED AND/OR MONETARY COMPENSATION TO DEVENNEY GROUP LTD.

MED SURG &
DIETARY
EXPANSION

HCA - LEE'S SUMMIT

MEDICAL CENTER

2100 SE BLUE PKWY

LEE'S SUMMIT, MO 64063

AUTHORITY HAVING JURISDICTION:
CITY OF LEE'S SUMMIT BUILDING DEPT.
MISSOURI DHSS

FACILITY NUMBER:

0972400009

AGENCY APPROVALS: AGENCY

REVISIONS

REV # DESCRIPTION DATE

B DESIGN COORDINATION 2025/02/06

2 DESIGN COORDINATION 2025/07/25

DATE: 2024/12/05
SCALE: 1/4" = 1'-0"
DRAWN:
REVIEWED:
SOURCE: 6406.24

DOOR SCHEDULES - LEVEL 1
- DIETARY

| DOOR SCHEDULE                |                            |                   |                            |  |  |  |  |  |  |
|------------------------------|----------------------------|-------------------|----------------------------|--|--|--|--|--|--|
| DOOR MATERIAL                | DOOR GLAZING               | FRAME MATERIAL    | FRAME GLAZING              | REMARKS                                      |  |  |  |  |  |
| WD - SOLID CORE WOOD         | T - TEMPERED               | HM - HOLLOW METAL | T - TEMPERED               | 1 - CASED OPENING                            |  |  |  |  |  |
| WDPL - PLASTIC LAMINATE WOOD | L - LAMINATED              | AL - ALUMINUM     | L - LAMINATED              | 2 - DELAYED EGRESS                           |  |  |  |  |  |
| WDIR - IMPACT RESISTANT WOOD | FR - FIRE RESISTIVE        | STL - STEEL       | FR - FIRE RESISTIVE        | 3 - PANIC HARDWARE                           |  |  |  |  |  |
| HM - HOLLOW METAL            | FP - FIRE PROTECTIVE       | EXIST - EXISTING  | FP - FIRE PROTECTIVE       | 4 - MAGNETIC HOLD OPEN                       |  |  |  |  |  |
| AL - ALUMINUM                | SP - SPANDREL              |                   | SP - SPANDREL              | 5 - INTEGRAL BLINDS W/ CONTROLS ON ROOM SIDE |  |  |  |  |  |
| STL - STEEL                  | IGU - INSULATED GLASS UNIT |                   | IGU - INSULATED GLASS UNIT |  |  |  |  |  |  |
| EXIST - EXISTING             |                            |                   |                            |  |  |  |  |  |  |

|                    |                |                |                    |                  |               | DOO              | R SCHED     | ULE                |                    |                    |                 |                |         |                     |
|--------------------|----------------|----------------|--------------------|------------------|---------------|------------------|-------------|--------------------|--------------------|--------------------|-----------------|----------------|---------|---------------------|
| ID                 | WIDTH          | HEIGHT         | MATERIAL           | DOOR PANEL ELEV. | GLAZING       | FRAI<br>MATERIAL | ME<br>ELEV. | HEAD               | DETAILS<br>JAMB    | SILL               | RATING          | HARDWARE       | REMARKS | CURRENT<br>REVISION |
| EVEL 2             |                |                |                    |                  |               |                  |             |                    |                    |                    | B               |                |         | 0~0~0               |
| 3-2001             | 3'-0"          | 7'-0"          | WDPL               | A                |               | HM               | 1           | 3/AE621            | 2/AE621            | 1/AE621            | _               | 002A           |         |                     |
| 3-2001             | 3'-0"          | 7'-0"          | WDPL               | A                | <u> </u>      | HM               | 1           | 3/AE621            | 2/AE621<br>2/AE621 | 1/AE621            |                 | 002A<br>002A   |         |                     |
| 3-2072             | 3'-0"          | 7'-0"          | WDPL               | A                | _             | HM               | 1           | 3/AE621            | 2/AE621            | 1/AE621            | _               | 002A           |         |                     |
| 3-2083             | 4'-0"          | 7'-0"          | WDPL               | A                | _             | HM               | 1           | 3/AE621            | 2/AE621            | 1/AE621            | 45 MIN          | 009B           |         |                     |
| 3-2085A            | 3'-0"          | 7'-0"          | WDPL               | А                | -             | НМ               | 1           | 3/AE621            | 2/AE621            | 1/AE621            | SMOKE           | 006A           |         |                     |
| 3-2118             | 3'-0"          | 7'-0"          | WDPL               | А                | -             | HM               | 1           | 3/AE621            | 2/AE621            | 1/AE621            | SMOKE           | 009A           |         |                     |
| 3-2119             | 3'-0"          | 7'-0"          | WDPL               | А                | -             | HM               | 1           | 3/AE621            | 2/AE621            | 1/AE621            | SMOKE           | 005B           |         |                     |
| 3-2120             | 3'-0"          | 7'-0"          | WDPL               | A                | -             | HM               | 1           | 3/AE621            | 2/AE621            | 1/AE621            | SMOKE           | 005B           |         |                     |
| 3-2121             | 3'-0"          | 7'-0"          | WDPL               | A                | -             | НМ               | 1           | 3/AE621            | 2/AE621            | 1/AE621            | SMOKE           | 003A           |         |                     |
| 3-COR5             | 7'-8"          | 7'-0"          | EXIST              | EXIST            | EXIST         | EXIST            | EXIST       | -                  | -                  | -                  | EX34            | -              | 4       | 2                   |
| 3-COR6A            | 7'-8"          | 7'-0"          | WDPL/GL            | ВВ               | -             | НМ               | 2           | 3/AE621            | 2/AE621            | 1/AE621            | -               | 011C           | 3,4     |                     |
| LEVEL 3 - TOPPI    | 1              | 71.01          | MDDI               |                  |               | 110.4            | 4           | 2/45624            | 2/45624            | 4 /45624           | CNACKE          | 001.4          |         |                     |
| 3-2000<br>3-2002   | 4'-0"<br>4'-0" | 7'-0"<br>7'-0" | WDPL<br>WDPL       | A                | -             | HM<br>HM         | 1           | 3/AE621<br>3/AE621 | 2/AE621<br>2/AE621 | 1/AE621<br>1/AE621 | SMOKE<br>SMOKE  | 001A<br>001B   |         |                     |
| 3-2002             | 4'-0"          | 7'-0"          | WDPL               | A                | -             | HM               | 1<br>1      | 3/AE621            | 2/AE621<br>2/AE621 | 1/AE621<br>1/AE621 | SMOKE           | 001B<br>001A   |         |                     |
| 3-2004             | 4'-0"          | 7'-0"          | WDPL               | A                |               | HM               | 1           | 3/AE621            | 2/AE621            | 1/AE621            | SMOKE           | 001A<br>001B   |         |                     |
| 3-2008             | 4'-0"          | 7'-0"          | WDPL               | A                | -             | HM               | 1           | 3/AE621            | 2/AE621            | 1/AE621            | SMOKE           | 001B           |         |                     |
| 3-2010             | 4'-0"          | 7'-0"          | WDPL               | A                | -             | HM               | 1           | 3/AE621            | 2/AE621            | 1/AE621            | SMOKE           | 001K           |         | +                   |
| 3-2012             | 4'-0"          | 7'-0"          | WDPL               | A                | -             | HM               | 1           | 3/AE621            | 2/AE621            | 1/AE621            | SMOKE           | 001A           |         |                     |
| 3-2014             | 4'-0"          | 7'-0"          | WDPL/GL            | D                | Т             | НМ               | 1           | 3/AE621            | 2/AE621            | 1/AE621            | SMOKE           | 001E           | 5       | 2                   |
| 3-2016             | 4'-0"          | 7'-0"          | WDPL               | А                | -             | HM               | 1           | 3/AE621            | 2/AE621            | 1/AE621            | SMOKE           | 001B           |         |                     |
| 3-2018             | 4'-0"          | 7'-0"          | WDPL               | А                | -             | HM               | 1           | 3/AE621            | 2/AE621            | 1/AE621            | SMOKE           | 001A           |         |                     |
| 3-2020             | 4'-0"          | 7'-0"          | WDPL               | А                | -             | HM               | 1           | 3/AE621            | 2/AE621            | 1/AE621            | SMOKE           | 001B           |         |                     |
| 3-2022             | 4'-0"          | 7'-0"          | WDPL               | A                | -             | НМ               | 1           | 3/AE621            | 2/AE621            | 1/AE621            | SMOKE /         | B 001A         |         |                     |
| 3-2024             | 4'-0"          | 7'-0"          | WDPL               | A                | -             | НМ               | 1           | 3/AE621            | 2/AE621            | 1/AE621            | SMOKE           | 001B           |         |                     |
| 3-2026             | 4'-0"          | 7'-0"          | WDPL               | Α                | -             | HM               | 1           | 3/AE621            | 2/AE621            | 1/AE621            | SMOKE           |                |         |                     |
| 3-2028             | 4'-0"          | 7'-0"          | WDPL               | A                | -             | HM               | 1           | 3/AE621            | 2/AE621            | 1/AE621            | SMOKE           | 001B           |         |                     |
| 3-2030             | 4'-0"          | 7'-0"          | WDPL /CI           | A                | <br>          | HM               | 1           | 3/AE621            | 2/AE621            | 1/AE621            | SMOKE           | B 001A         |         |                     |
| 3-2034<br>3-2035A  | 3'-0"<br>3'-6" | 7'-0"<br>7'-0" | WDPL/GL<br>WDPL/GL | D<br>B           | T ED          | HM<br>HM         | 1           | 3/AE621<br>3/AE621 | 2/AE621<br>2/AE621 | 1/AE621<br>1/AE621 | SMOKE<br>45 MIN | 009A<br>009B   |         |                     |
| 3-2035A<br>3-2035B | 3'-6"          | 7'-0"          | WDPL/GL<br>WDPL/GL | В                | FP<br>FP      | HM               | 1<br>1      | 3/AE621            | 2/AE621<br>2/AE621 | 1/AE621<br>1/AE621 | 45 MIN /        | В 009В         |         |                     |
| 3-20336            | 4'-0"          | 7'-0"          | WDPL               | A                | - Ir          | HM               | 1           | 3/AE621            | 2/AE621            | 1/AE621            | 90 MIN          | 009B           |         |                     |
| 3-2038A            | 6'-0"          | 7'-0"          | -                  | -                | -             | HM               | 1           | 3/AE621            | 2/AE621            | 1/AE621            | -               | 14             | 1       |                     |
| 3-2038B            | 6'-0"          | 7'-0"          | -                  | -                | -             | HM               | 1           | 3/AE621            | 2/AE621            | 1/AE621            | -               | 14             | 1       |                     |
| 3-2039A            | 4'-0"          | 7'-0"          | WDPL               | А                | -             | НМ               | 1           | 3/AE621            | 2/AE621            | 1/AE621            | 45 MIN          | 009B.1         |         |                     |
| 3-2039B            | 4'-0"          | 7'-0"          | WDPL               | А                | -             | HM               | 1           | 3/AE621            | 2/AE621            | 1/AE621            | 45 MIN          | 009B           |         |                     |
| 3-2040             | 3'-0"          | 7'-0"          | WDPL               | A                | -             | HM               | 1           | 3/AE621            | 2/AE621            | 1/AE621            | 45 MIN          | 007A           |         |                     |
| 3-2041             | 3'-0"          | 7'-0"          | WDPL               | A                | -             | HM               | 1           | 3/AE621            | 2/AE621            | 1/AE621            | SMOKE           | 003A           |         |                     |
| 3-2042             | 4'-0"          | 7'-0"          | WDPL               | A                | -             | HM               | 1           | 3/AE621            | 2/AE621            | 1/AE621            | 45 MIN          | 009B           |         |                     |
| 3-2043             | 7'-8"          | 7'-0"          | WDPL/GL            | BB               | FP            | НМ               | 2           |                    |                    |                    | 20 MIN          |                | 3,4     | 2                   |
| 3-2050             | 4'-0"          | 7'-0"          | WDPL               | A                | -             | HM               | 1           | 3/AE621            | 2/AE621            | 1/AE621            | SMOKE           | 001B           |         |                     |
| 3-2052             | 4'-0"          | 7'-0"          | WDPL               | A                | -             | HM               | 1           | 3/AE621            | 2/AE621            | 1/AE621            | SMOKE           | 001A           |         |                     |
| 3-2054             | 4'-0"          | 7'-0"          | WDPL               | A                | -             | HM               | 1           | 3/AE621            | 2/AE621            | 1/AE621            | SMOKE           | 001B           |         |                     |
| 3-2056<br>3-2058   | 4'-0"<br>4'-0" | 7'-0"<br>7'-0" | WDPL<br>WDPL       | A                | -             | HM<br>HM         | 1           | 3/AE621            | 2/AE621            | 1/AE621            | SMOKE<br>SMOKE  | 001A<br>001B   |         |                     |
| 3-2058             | 4'-0"          | 7'-0"          | WDPL/GL            | A D              | <u>-</u><br>Т | HM               | 1           | 3/AE621<br>3/AE621 | 2/AE621<br>2/AE621 | 1/AE621<br>1/AE621 | SMOKE           | 001B<br>001E   | 5       | 2                   |
| 3-2060             | 3'-0"          | 7'-0"          | WDPL/GL            | A                | <u> </u>      | HM               | 1<br>1      | 3/AE621<br>3/AE621 | 2/AE621<br>2/AE621 | 1/AE621<br>1/AE621 | SMOKE           | 001E<br>004A   | J       | 2                   |
| 3-2063             | 4'-0"          | 7'-0"          | WDPL               | A                | -             | HM               | 1           | 3/AE621            | 2/AE621            | 1/AE621            | SMOKE           | 001A           |         |                     |
| 3-2065             | 4'-0"          | 7'-0"          | WDPL               | A                | -             | НМ               | 1           | 3/AE621            | 2/AE621            | 1/AE621            | SMOKE           | , 001B         |         |                     |
| 3-2067             | 4'-0"          | 7'-0"          | WDPL               | A                | -             | НМ               | 1           | 3/AE621            | 2/AE621            | 1/AE621            | SMOKE Z         | $\wedge$       |         |                     |
| 3-2069             | 4'-0"          | 7'-0"          | WDPL               | А                | -             | НМ               | 1           | 3/AE621            | 2/AE621            | 1/AE621            | SMOKE           | 001B           |         |                     |
| 3-2071             | 4'-0"          | 7'-0"          | WDPL               | А                | -             | НМ               | 1           | 3/AE621            | 2/AE621            | 1/AE621            | SMOKE           | 001A           |         |                     |
| 3-2073             | 4'-0"          | 7'-0"          | WDPL               | А                | -             | НМ               | 1           | 3/AE621            | 2/AE621            | 1/AE621            | SMOKE           | 001B           |         |                     |
| 3-2074             | 3'-0"          | 7'-0"          | WDPL               | А                | -             | НМ               | 1           | 3/AE621            | 2/AE621            | 1/AE621            | -               | 002A           |         |                     |
| 3-2077             | 3'-0"          | 7'-0"          | WDPL/GL            | D                | Т             | НМ               | 1           | 3/AE621            | 2/AE621            | 1/AE621            | +               | B 009A         |         |                     |
| 3-2078A            | 3'-6"          | 7'-0"          | WDPL/GL            | В                | FP            | HM               | 1           | 3/AE621            | 2/AE621            | 1/AE621            | 45 MIN          | 009B.1         |         |                     |
| 3-2078B            | 3'-6"          | 7'-0"          | WDPL/GL            | В                | FP            | HM               | 1           | 3/AE621            | 2/AE621            | 1/AE621            | 45 MIN <b>/</b> |                | 4       |                     |
| 3-2079             | 5'-0"          | 7'-0"          | -                  | -                | -             | HM               | 1           | 3/AE621            | 2/AE621            | 1/AE621            | -               | 14             | 1       |                     |
| 3-2080<br>3-2081A  | 5'-0"<br>4'-0" | 7'-0"<br>7'-0" | -<br>WDPL          | -<br>^           | <u>-</u>      | HM<br>HM         | 1           | 3/AE621<br>3/AE621 | 2/AE621<br>2/AE621 | 1/AE621<br>1/AE621 | -<br>45 MIN     | 14<br>A 009B   | 1       |                     |
| 3-2081A<br>3-2081B | 4'-0"          | 7'-0"          | WDPL               | A                | <u>-</u>      | HM               | 1           | 3/AE621<br>3/AE621 | 2/AE621<br>2/AE621 | 1/AE621<br>1/AE621 | 45 MIN 45 MIN   | 009B           |         | -                   |
| 3-2081B<br>3-2082  | 3'-0"          | 7'-0"          | WDPL               | A                | -             | HM               | 1           | 3/AE621<br>3/AE621 | 2/AE621<br>2/AE621 | 1/AE621<br>1/AE621 | 45 MIN /        | <u> </u>       |         |                     |
| 3-2082             | 3 -0<br>6'-0"  | 7'-0"          | WDPL               | AA               | <u>-</u><br>- | HM               | 1           | 3/AE621<br>3/AE621 | 2/AE621<br>2/AE621 | 1/AE621<br>1/AE621 | 45 MIN          | 007A<br>007A.1 |         |                     |
| 3-2091<br>3-COR6B  | 7'-8"          | 7'-0"          | WDPL/GL            | BB               | FP            | HM               | 2           | 3/AE621            | 2/AE621<br>2/AE621 | 1/AE621<br>1/AE621 | 20 MIN          | 007A.1<br>011C | 3,4     |                     |
| 3-COR0B 3-COR7     | 7'-8"          | 7'-0"          | WDPL/GL<br>WDPL/GL | BB               | FP            | HM               | 2           | 3/AE621            | 2/AE621            | 1/AE621            | 20 MIN          | 011C<br>011C   | 3,4     |                     |
| 3-ST3              | 4'-0"          | 7'-0"          | WDPL               | A                | -             | HM               | 1           | 3/AE621            | 2/AE621            | 1/AE621            | 90 MIN          | 010C           | 2,3     |                     |
| 3-ST4              | 4'-0"          | 7'-0"          | WDPL               | A                | -             | HM               | 1           | 3/AE621            | 2/AE621            | 1/AE621            | 90 MIN          | 010C           | 2,3     |                     |
| LEVEL 4 (ROOF)     | 1              | 1              | 1                  |                  |               |                  |             | 1                  | 1                  | 1                  | -1              | 1              | ı       | 1                   |
| 4-ST3              | 4'-0"          | 7'-0"          | WDPL               | А                | -             | НМ               | 1           | 16/AE621           | 16/AE621           | 10/AE502           | 90 MIN          | 101B           |         |                     |
| 4-ST4              | 4'-0"          | 7'-0"          | WDPL               | А                | -             | НМ               | 1           | 16/AE621           | 16/AE621           | 10/AE502           | 90 MIN          | 101B           |         |                     |

### DOOR GENERAL NOTES

- THE PURPOSE OF THIS SHEET IS TO DESCRIBE AND ILLUSTRATE DOOR TYPES. NOT ALL DOOR TYPES SHOWN ARE NECESSARILY USED. SEE DOOR MARK SCHEDULE FOR DOOR TYPES USED.
- 2. FIRE DOORS AND FRAMES SHALL HAVE AN APPROVED LABEL OR LISTING MARK INDICATING THE FIRE PROTECTION RATING WHICH IS PERMANENTLY AFFIXED AT THE FACTORY WHERE FABRICATION AND ASSEMBLY ARE DONE
- FACTORY WHERE FABRICATION AND ASSEMBLY ARE DONE.

  SMOKE BARRIER DOORS INSTALLED ACROSS THE CORRIDORS AND EXIT ACCESS DOORS LOCATED AT ZONE BOUNDARIES SHALL BE EQUIPPED WITH APPROVED
- VISION PANELS.

  4. ALL SMOKE BARRIER DOORS LOCATED ON THE FLOOR OR IN THE AFFECTED ZONE SHALL COMPLY WITH CURRENT APPLICABLE CODES AND SHALL BE AUTOMATIC
- CLOSING UPON ACTIVATION OF THE FIRE ALARM OR FIRE SPRINKLER SYSTEM.

  5. ALL DOORS IN SMOKE BARRIERS AND OPENING INTO RATED EXIT WAYS SHALL BEAR AN APPROVED LABEL DISPLAYING THE LETTER "S" PER CURRENT APPLICABLE CODES.

  6. FIRE ASSEMBLIES REQUIRED TO HAVE 1 ½ HOURS, 1 HOUR OR ¾ HOUR FIRE PROTECTION RATING SHALL BE EITHER AUTOMATIC OR SELF CLOSING FIRE
- PROTECTION RATING SHALL BE EITHER AUTOMATIC OR SELF CLOSING FIRE ASSEMBLIES. AUTOMATIC CLOSING FIRE ASSEMBLIES TO BE ACTIVATED BY AN INCREASE IN TEMPERATURE SHALL HAVE HEAT-ACTUATING DEVICES INSTALLED ON EACH SIDE OF THE WALL AT THE CEILING HEIGHT WHERE THE CEILING IS MORE THAN 3 FEET ABOVE THE TOP OF THE OPENING OR BY A SINGLE FUSIBLE LINK IN THE OPENING INCORPORATED IN THE CLOSING DEVICE.

  7. GLASS:
- A. INTERIOR DOORS:
- NON-RATED DOORS SHALL HAVE ¼" CLEAR TEMPERED GLASS.
   ALL RATED DOORS SEE SPECIFICATIONS.
- 3. LEAD LINED DOORS SHALL HAVE LEAD GLASS.
- . GLAZING IN THE FOLLOWING LISTED AREAS SHALL BE DEEMED TO BE LOCATED IN HAZARDOUS LOCATIONS AND SUBJECT TO HUMAN IMPACT:
- INGRESS AND EGRESS DOORS.
   FIXED PANELS IN SWINGING DOORS.
- 3. ALL GLAZING WITHIN 18" OF THE FLOOR AND WITHIN 12" OF A DOOR SHALL BE TEMPERED.
- 9. EACH LITE OF THE GLAZING SHALL BEAR THE MANUFACTURER'S LABEL DESIGNATING THE TYPE AND THICKNESS OF GLASS. WHEN APPROVED BY THE AGENCY, LABELS MAY BE OMITTED FROM OTHER THAN GLAZING MATERIALS, PROVIDED AN AFFIDAVIT IS FURNISHED BY THE GLAZING CONTRACTOR CERTIFYING THAT EACH LIGHT IS GLAZED IN ACCORDANCE WITH APPROVED PLANS AND SPECIFICATIONS. IDENTIFICATION OF GLAZING IN HAZARDOUS LOCATIONS AND SUBJECT TO HUMAN IMPACT SHALL BE ETCHED OR CERAMIC FIRED ON THE GLASS AND READABLE FROM THE INSIDE OF THE BUILDING AFTER INSTALLATION.
- 10. EXIT DOORS SHALL BE OPERABLE FROM THE INSIDE WITHOUT THE USE OF A KEY OR
  ANY SPECIAL KNOWLEDGE OR EFFORT.
- 11. PANIC HARDWARE SHALL COMPLY WITH THE REQUIREMENTS OF CURRENT APPLICABLE CODES. THE ACTIVATING MEMBER SHALL BE MOUNTED AT A HEIGHT OF NOT LESS THAN 30 INCHES NOR MORE THAN 44 INCHES ABOVE THE FLOOR. THE UNLATCHING FORCE SHALL NOT EXCEED 15 POUNDS WHEN APPLIED IN THE DIRECTION OF TRAVEL.
- 12. DOOR ASSEMBLIES, APPROACHES AND FINISH HARDWARE SHALL BE IN COMPLIANCE WITH ACCESSIBILITY STANDARDS.
- WITH ACCESSIBILITY STANDARDS.

  13. THE MAXIMUM EFFORT TO OPERATE DOORS SHALL NOT EXCEED THE FOLLOWING:
- A. EXTERIOR DOORS 5.0 POUNDS
  B. INTERIOR DOORS 5.0 POUNDS
  C. FIRE DOORS 15.0 POUNDS
- 14. WATER CLOSET ROOMS SHALL BE SEPARATED FROM FOOD PREPARATION AND STORAGE AREAS WITH TIGHT FITTING DOORS.15. DOOR OPENING LOCATIONS:
- A. IMMEDIATELY (5") ADJACENT TO A FLANKING WALL UNLESS NOTED OTHERWISE B. AT THE CENTERLINE OF THE ROOM, UNLESS NOTED OTHERWISE
- C. CENTERED ON A GRID DOOR OPENINGS IN OTHER LOCATIONS ARE LOCATED BY DIMENSIONS
- 16. SEE SPECIFICATIONS FOR HARDWARE SCHEDULE
  17. ALL DOOR FRAMES ARE WELDED FRAMES, UNLESS NOTED OTHERWISE.
- 18. FINISH FLOOR TRANSITIONS OCCUR AT CENTERLINE OF DOORS, UNLESS NOTED OTHERWISE.
- ALL INTERIOR DOORS WITH FIRE RATINGS GREATER THAN 20 MINUTE SHALL HAVE A NON-COMBUSTIBLE SILL WITH AN UNDERCUT OF 3/8" MAXIMUM ABOVE THE SILL.
   WEIGHT OF LEAD-LINED DOORS, LEAD STRIPS IN DOOR FRAMES AND LEAD GLAZING WHERE OCCURS SHALL MATCH WEIGHT OF LEAD IN ADJACENT PARTITION, UNLESS
- CONTINUOUS IN INSTALLED DOORWAY.
  21. ALL EXTERIOR DOORS SHALL HAVE METAL THRESHOLDS. SEE HARDWARE SCHEDULE.

NOTED OTHERWISE. LEAD LINING SHALL BE INSTALLED SUCH THAT SHIELDING IS

- 22. WHERE DOOR HOLD-OPEN DEVICES OR DOOR STOPS OCCUR AT WALLS, PROVIDE BACKING PLATE PER BACKING PLATE SCHEDULE.23. ALL SOLID CORE WOOD DOORS TO BE STAIN GRADE, UNLESS NOTED OTHERWISE (SEE
- DOOR SCHEDULE).

  24. DOORS WITH AUTO DOOR OPENINGS SHALL MEET REQUIREMENTS IN CURRENT
- APPLICABLE CODES.

  25. THRESHOLDS AT DOORWAYS AND TRANSITION STRIPS SHALL NOT EXCEED 1/2" IN HEIGHT. RAISED THRESHOLDS AND FLOOR LEVEL CHANGES AT ACCESSIBLE DOORWAYS SHALL BE BEVELED WITH A SLOPE NO GREATER THAN 1:2.




Devenney Group Ltd., Architects

6900 East Camelback Road

Suite 500 Scottsdale, AZ 85251 T: 602.943.8950

Consultant:

www.devenneygroup.com

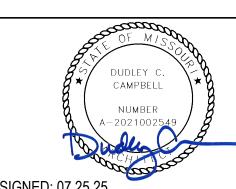

DATE SIGNED: 07.25.25

IF THESE PLANS DO NOT BEAR THE SEAL OF A REGISTRANT, THEY ARE TO BE CONSIDERED "PRELIMINARY" AND ARE NOT TO BE USED FOR CONSTRUCTION OR RECORDING. THESE PLANS ARE COPYRIGHTED AND ARE SUBJECT TO COPYRIGHT PROTECTION AS AN "ARCHITECTURAL WORK" UNDER SEC. 102 OF THE COPYRIGHT ACT, 17 U.S.O. AS AMENDED DECEMBER 1990 AND KNOWN AS ARCHITECTURAL WORKS COPYRIGHT PROTECTION ACT OF 1990. THE PROTECTION INCLUDES BUT IS NOT LIMITED TO THE OVERALL FORM AS WELL AS THE ARRANGEMENT AND COMPOSITION OF SPACES AND ELEMENTS OF THE DESIGN. UNDER SUCH PROTECTION, UNAUTHORIZED USE OF THESE PLANS CAN LEGALLY RESULT IN THE CESSATION OF CONSTRUCTION OR BUILDINGS BEING SEIZED AND/OR MONETARY COMPENSATION TO DEVENNEY GROUP LTD.

# MED SURG & DIETARY EXPANSION

HCA - LEE'S SUMMIT

MEDICAL CENTER

2100 SE BLUE PKWY

LEE'S SUMMIT, MO 64063

AUTHORITY HAVING JURISDICTION:
CITY OF LEE'S SUMMIT BUILDING DEPT.

FACILITY NUMBER: **0972400009** 

AGENCY

MISSOURI DHSS

AGENCY APPROVALS:

REVISIONS
REV # DESCRIPTION DATE
A CITY - 2ND REVIEW 2025/02/06

2025/02/06


2025/07/25


DESIGN COORDINATION


DESIGN COORDINATION


DATE: 2024/12/05
SCALE:
DRAWN:
REVIEWED:
JOB NUMBER: 6406.24

DOOR SCHEDULES - LEVEL 3
- MED/SURG

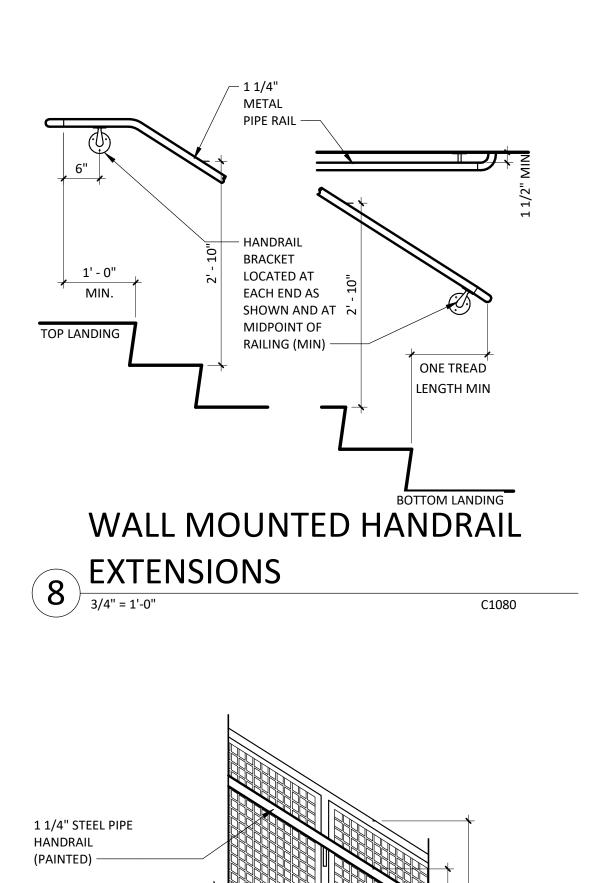

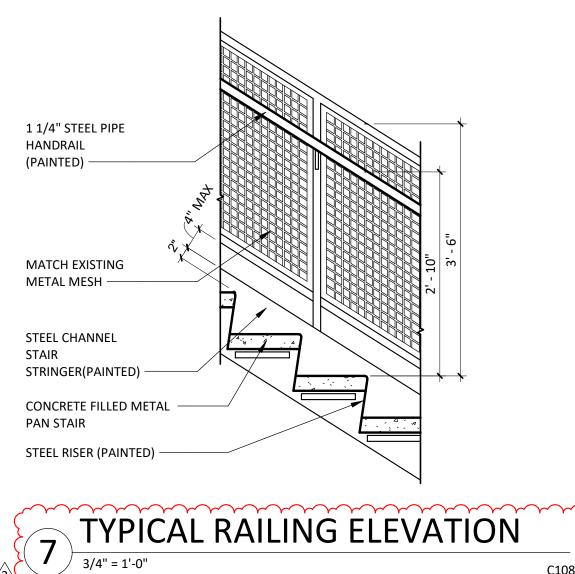


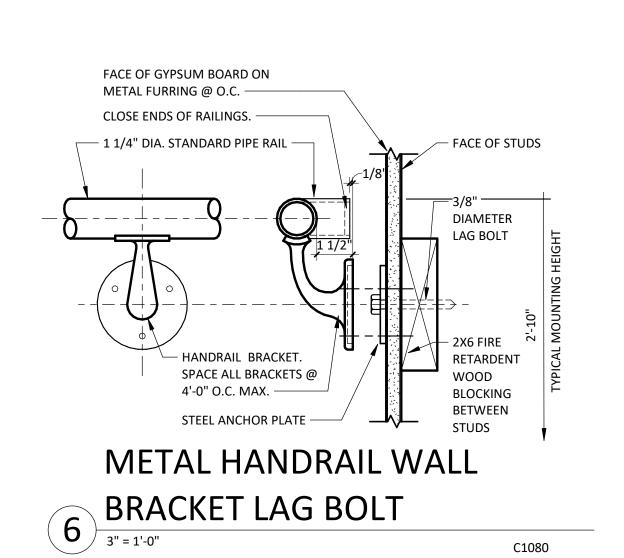


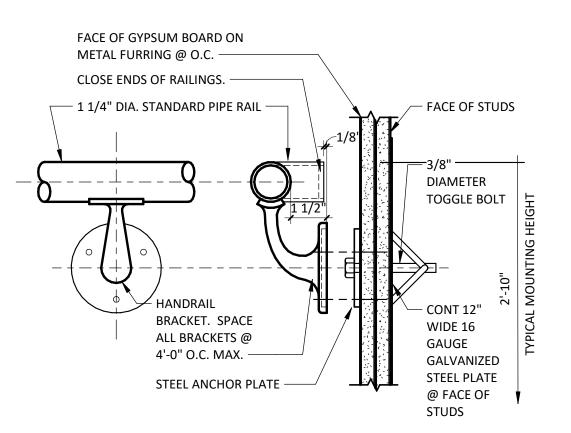



METAL HANDRAIL WALL BRACKET TOGGLE BOLT

3" = 1'-0" C1080

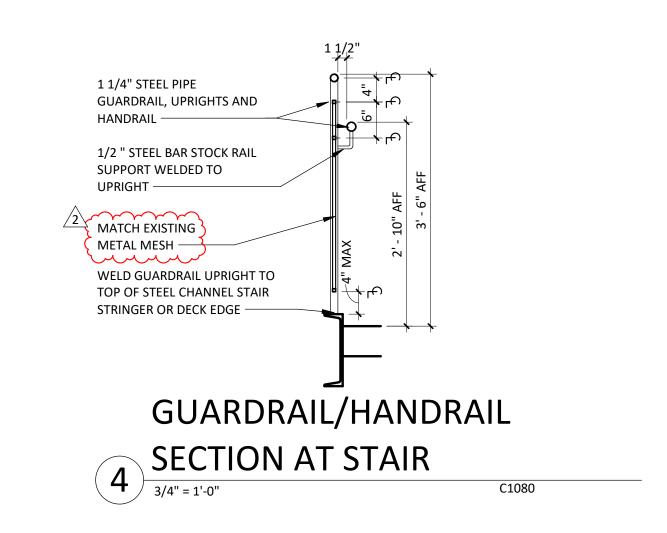

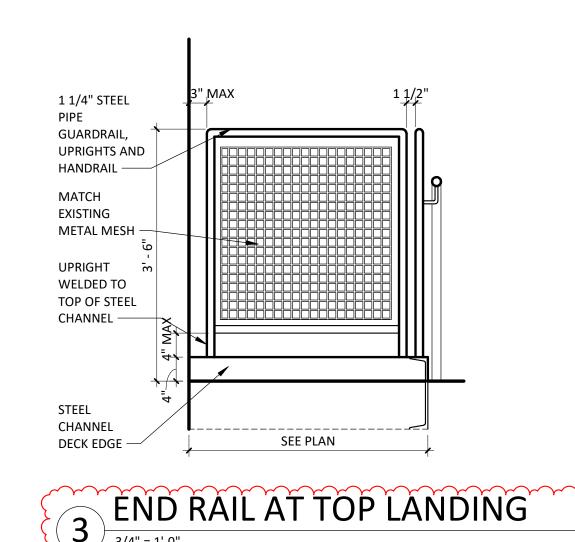


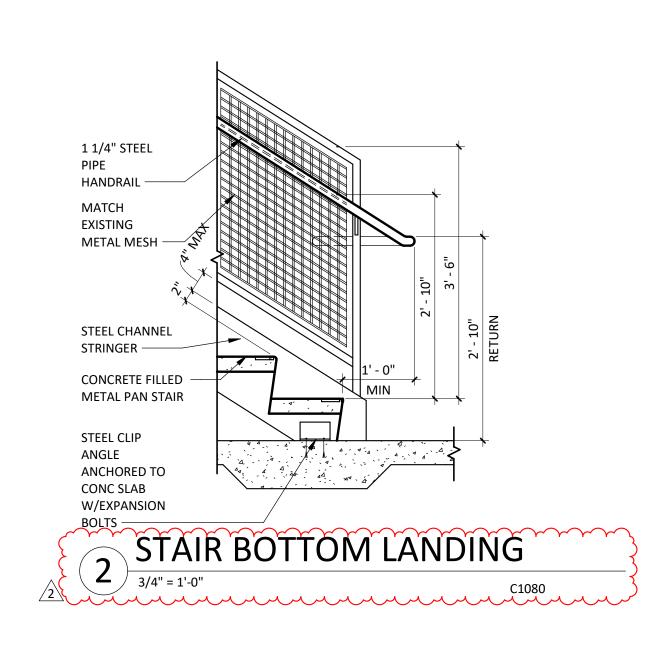

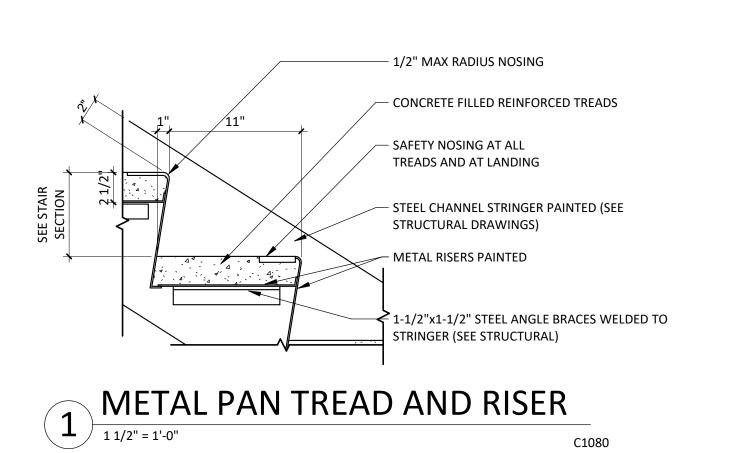



Consultant:

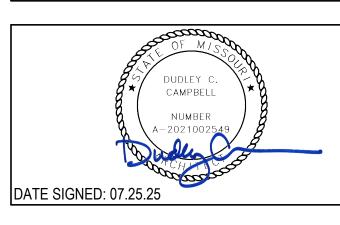

IF THESE PLANS DO NOT BEAR THE SEAL OF A REGISTRANT, THEY ARE TO BE CONSIDERED "PRELIMINARY" AND ARE NOT TO BE USED FOR CONSTRUCTION OR RECORDING. THESE PLANS ARE COPYRIGHTED AND ARE SUBJECT TO COPYRIGHT PROTECTION AS AN "ARCHITECTURAL WORK" UNDER SEC. 102 OF THE COPYRIGHT ACT, 17 U.S.O. AS AMENDED DECEMBER 1990 AND KNOWN AS ARCHITECTURAL WORKS COPYRIGHT PROTECTION ACT OF 1990. THE PROTECTION INCLUDES BUT IS NOT LIMITED TO THE OVERALL FORM AS WELL AS THE ARRANGEMENT AND COMPOSITION OF SPACES AND ELEMENTS OF THE DESIGN. UNDER SUCH PROTECTION, UNAUTHORIZED USE OF THESE PLANS CAN LEGALLY RESULT IN THE CESSATION OF CONSTRUCTION OR BUILDINGS BEING SEIZED AND/OR MONETARY COMPENSATION TO DEVENNEY GROUP LTD.

> MED SURG & DIETARY **EXPANSION**

HCA - LEE'S SUMMIT MEDICAL CENTER 2100 SE BLUE PKWY LEE'S SUMMIT, MO 64063

AUTHORITY HAVING JURISDICTION: CITY OF LEE'S SUMMIT BUILDING DEPT. MISSOURI DHSS FACILITY NUMBER: 0972400009 AGENCY APPROVALS: AGENCY

| ed Surg   |      |                     |            |
|---|------|---------------------|------------|
| MC M  |      | REVISIONS           |            |
| <u>s</u>  | REV# | DESCRIPTION         | DATE       |
| اخ  | 2    | DESIGN COORDINATION | 2025/07/25 |
| al Center (LSMC)_rvt23/6406.24.0001 HCA - LSMC Med Surg |      |                     |            |


DATE:

DRAWN:

REVIEWED: 2024/12/05 As indicated JOB NUMBER: 6406.24

STAIR DETAILS

AE760

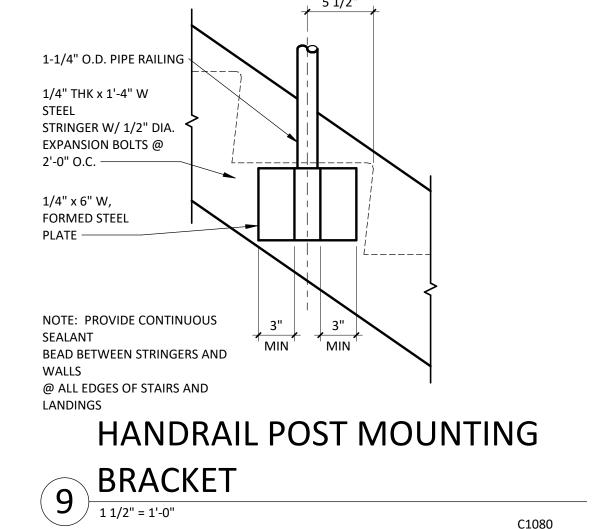

C1080

### FINISH SELECTIONS AND GENERAL NOTES

|                                   | MATERIAL                               | CONTACTS  |          |
|-----------------------------------|--|---|----------|
| Please contact the fol            | lowing representatives for sp          | pecial pricing.   |          |
| MANUFACTURER                      | TYPE OF FINISH                         | NAME, EMAIL, PHONE #  |          |
| Armstrong<br>Ceilings             | Acoustical Ceiling Tile                | Jen Bartlett<br>717.396.4325<br>HCA@armstrong.com<br>HPG#6924               |          |
| Bennu<br>Enterprises              | Signage                                | Tony Hatchell<br>615.226.4577<br>tony@bennusigns.com                        |          |
| Carnegie Fabrics                  | Acoustical Panel Fabric                | Tim Butler<br>615.479.4950<br>tbutler@mainsolutionsllc.com                  |          |
| Claridge                          | Marker Boards/<br>Tack Boards          | Jeff Alldredge<br>314.363.6536<br>jeffalldredge@oedreps.com                 |          |
| Corian                            | Solid Surface                          | Meg Tucker<br>629.224.7179<br>mtucker@oldenkamp.com                         |          |
| Daltile                           | Ceramic Tile                           | Abby Finnegan<br>615.519.9672<br>abby.finnegan@daltile.com                  |          |
| Durasein                          | Solid Surface                          | Pam Dervarics<br>610.360.5825<br>pam.dervarics@durasein.com                 |          |
| Emser Tile                        | Porcelain Tile                         | Natasha Sanchez<br>615.918.0773<br>Natasha.Sanchez@emser.com                |          |
| Grifform                          | Solid Surface Transition               | www.grifform.com  | -        |
| Herman Miller                     | Lab/Pharmacy<br>Casework               | Donna Doss<br>615.351.3344<br>donna_doss@hermanmiller.com                   |          |
| InPro<br>Corporation,<br>Ferguson | Wall Protection &<br>Shower insert     | Abbey Rice<br>1.800.222.5556 ext 5319<br>arice@inprocorp.com<br>HPG# 44661  |          |
| Ketchum Walton<br>CO.             | Acoustic Panel -<br>Fabriktrak         | Kay Reinhardt<br>312.550.2967<br>kreinhardt@ketchumandwalton.com            |          |
| Fry Reglet                        | Casework Corner Guard                  | Derek Sanderson<br>dereksanderson@fryreglet.com<br>770.551.8749             |          |
| Logistic Solutions                | Floor Purchasing                       | Logistics Solutions LLC<br>Customersvc@logisolutions.net<br>615.750.2014    |          |
| Mannington                        | Flooring<br>Chairrail and Base         | Terri Bailey<br>615.427.8980<br>hca@mannington.com<br>HPG#5468              |          |
| MDC Wall<br>Covering              | Vinyl Wall<br>Covering                 | Monica Fox<br>800.621.4006<br>mfox@mdcwall.com                              |          |
| Peter Pepper<br>Products          | Clocks, Markerboards<br>& Combo Boards | www.peterpepperproducts.com   |          |
| Platform Surface                  | Porcelain Tile                         | Erica Dickson<br>615.945.7510<br>edickson@platformsurfaces.com              |          |
| Schluter Systems                  | Metal Trim                             | Jack Leblanc<br>225.483.2758<br>Jack Leblanc@schluter.com                   |          |
| Sherwin<br>Williams               | Interior Paint                         | Andrew Flippin<br>Andrew.flippin@sherwin.com<br>HPG#5893                    |          |
| Stonhard                          | Flooring, base, and<br>Walls           | Tom Burns<br>800.854.0310<br>tburns@stonhard.com<br>HPG#5467                |          |
| Penco<br>Storage Systems          | Metal Lockers                          | Bill Kreager<br>888.614.0004<br>bkreager@storagesystemsul.com<br>HPG#500166 |          |
| Tarkett                           | Stair tread/risers                     | Diane Drake<br>440.780.5717<br>dianedrake@tarkett.com<br>HPG#5498           |          |
| Tile Bar                          | Ceramic Tile                           | Emily Watson<br>775.450.5403<br>ewatson@tilebar.com                         |          |
| Uttermost                         | Upgraded Mirrors                       | www.uttermost.com   | $\dashv$ |
| Wilsonart                         | Plastic Laminate                       | Chris Fleming<br>615.292.2188<br>fleminc2@wilsonart.com                     |          |
| 3form                             | Poly Resin/Glass                       | Jenna Harris<br>615.708.3126  |          |

|      |  |  | j         | enna.harris@3-form.com  |  |  |  |  |
|------|--|--|-----------|---|--|--|--|--|
|      | CEILINGS                                       |  |           |   |  |  |  |  |
| CODE | CODE ITEM TYPE/ LOCATION MANUFACT. DESCRIPTION |  |           |   |  |  |  |  |
| ACT1 | Acoustical<br>Ceiling<br>Tile -<br>General     | General,<br>Back of<br>House,<br>Staff Areas | Armstrong | "Fine Fissured High NRC" 1754 Medium Texture 24"x48" Square Lay-In with 15/16" Prelude XL Grid, Factory Painted White NRC: 0.75, CAC: 35  |  |  |  |  |
| ACT2 | Acoustical<br>Ceiling<br>Tile -<br>Upgraded    | Upgraded<br>Public or<br>Patient<br>Areas    | Armstrong | "Ultima Healthzone High NRC" 1445 Fine Texture 24"x24" Square Lay-In with 15/16" Prelude XL Grid, Factory Painted White NRC: 0.80; CAC: 35  |  |  |  |  |
| ACT3 | Acoustical<br>Ceiling<br>Tile -                | Lab/<br>Kitchen                              | Armstrong | "Ultima Healthzone" High NRC<br>1445 Fine Texture 24"x24"<br>Square Lay-In with 15/16"<br>Prelude Plus Fireguard XL Grid, Factory<br>Painted White. NRC: 0.80, CAC: 35  |  |  |  |  |
| ACT4 | Acoustical<br>Ceiling<br>Tile -<br>Scrubbable  | Scrubbable<br>Ceilings                       | Armstrong | "Clean Room VL Unperforated" 868 Smooth Texture 24"x24" Square Lay-In with 15/16" Clean Room Grid, Factory Painted White CAC: 40  |  |  |  |  |
| ACT5 | Acoustical<br>Ceiling<br>Tile -<br>Specialty   | Feature<br>Areas                             | Armstrong | Metal Works Linear Classics 8122 FXCB Plank Size: 10" x 96" unperforated Suspension: 7177 Color: Cocoa Bean FXCB Bioacoustic infill panel color: Black Notes: Class A, Utilize all necessary trim pieces, sprinkler heads to be finished to match wood grain. |  |  |  |  |
| EXP  | Exposed<br>Ceiling                             | See Finish<br>Plans                          |           |   |  |  |  |  |
| GYP  | Gypsum<br>Board<br>Ceiling                     | See Finish<br>Plans                          |           | See WALLS section for ceiling paints.   |  |  |  |  |

|       |                                   |   | WAL                       | LS   |
|-------|-----------------------------------|---|---------------------------|--|
| CODE  | ITEM                              | LOCATION  | MANUFACT.                 | DESCRIPTION  |
| CWT1  | Ceramic<br>Wall Tile              | Walls-<br>Field   | Daltile                   | Pattern: Artcrafted Color:Tide, AC29 Glossy Size: 3"x"12" Grout: Laticrete, Spectralock Pro Premium Grout Color: light Pewter 90 Grout Joint:1/8" Installation Method: 1/3rd overlay |
| DCP1  | Decorative<br>Polyresin<br>Panel  | Med Surg<br>Nurse<br>Stations   | 3form                     | Varia Ecoresin Color: Specialty Wave Sage + Avalanche (D0 LID # 1093997 Size: 3/8" thick Front: Wave Emboss Back: Sandstone  |
| DGWP1 | Decorative<br>Glass Wall<br>Panel | Dietary   | 3form                     | Glass Panel<br>Color: Ombre Frosted<br>Size: 1/4" thick<br>LID # TBD   |
| EW1   | Poured                            | Kitchen   | Stonhard                  | Style: Stoneglaze VSE  |
| EP1   | Epoxy<br>Walls<br>Epoxy<br>Paint  | Walls Walls- General  | Sherwin<br>Williams       | Color: Ash Gray Height: Full height  Color: SW6141 Softer Tan Formula/Finish: Eg-shell Water-Based Epoxy   |
| EP2   | Epoxy<br>Paint                    | -Med Surg Walls- Accent   | Sherwin<br>Williams       | Color: SW6222 Riverway Formula/Finish: Eg-shell Water-Based Epoxy  |
| EP3   | Epoxy<br>Paint                    | -Med Surg  GYP Ceilings   | Sherwin                   | Color: SW7007 Ceiling Bright White Formula/Finish: Eg-shell Water-Based Epoxy  |
| EP4   | Epoxy<br>Paint                    | Walls-<br>Accent  | Williams Sherwin Williams | Color: SW6219 Rain Formula/Finish: Eg-shell Water-Based Epoxy  |
| EP5   | Epoxy<br>Paint                    | -Dietary Walls- Accent  | Sherwin<br>Williams       | Color: SW7508 Tavern Taupe Formula/Finish: Eg-shell Water-Based Epoxy  |
| EP6   | Epoxy<br>Paint                    | -Medsurg Walls- Accent  | Sherwin<br>Williams       | Color: SW6221 Moody Blue<br>Formula/Finish: Eg-shell Water-Based Epoxy   |
| P1    | Wall<br>Paint                     | -Dietary Walls- General   | Sherwin<br>Williams       | Color: SW6141 Softer Tan<br>Formula/Finish: Latex Eggshell   |
| P2    | Wall<br>Paint                     | -Med Surg<br>Walls-<br>Accent   | Sherwin<br>Williams       | Color: SW6219 Rain<br>Formula/Finish: Latex Eggshell   |
| P3    | Wall<br>Paint                     | -Med Surg Walls- Accent   | Sherwin<br>Williams       | Color: SW7508 Tavern Taupe<br>Formula/Finish: Latex Eggshell   |
| P4    | Wall<br>Paint                     | -Med Surg Walls- Accent -Med Surg   | Sherwin<br>Williams       | Color: SW6222 Riverway Formula/Finish: Latex Eggshell  |
| P5    | Ceiling<br>Paint                  | GYP<br>Ceilings   | Sherwin<br>Williams       | Color: SW7007 Ceiling Bright White Formula/Finish: Latex Eggshell  |
| P6    | Metal<br>Paint                    | Door Frames Inter. Metal Doors, Metal Door Lite, Stair Rail, Stringers & Risers -Med Surg | Sherwin<br>Williams       | Color: Black Bean SW6006 Formula/Finish: Semi Gloss Alkyd Enamel Note: For INTERIOR doors ONLY, See architectural drawings and specifications for a exterior finishes.               |
| P7    | Wall<br>Paint                     | Walls-<br>General<br>-Dietary   | Sherwin<br>Williams       | Color: SW9166 Drift of Mist<br>Formula/Finish: Latex Eggshell  |
| P8    | Wall<br>Paint                     | Walls-<br>accent<br>-Dietary  | Sherwin<br>Williams       | Color: SW6221 Moody Blue<br>Formula/Finish: Latex Eggshell   |
| P9    | Wall<br>Paint                     | Door Frames Inter. Metal Doors, Metal Door Lite, Stair Rail, Stringers & Risers -Dietary  | Sherwin<br>Williams       | Color: Thunder Gray SW7645 Formula/Finish: Semi Gloss Alkyd Enamel Note: For INTERIOR doors ONLY, See architectural drawings and specifications for a exterior finishes.             |
| P10   | Detail<br>Paint                   | Storage/<br>Supply  | Sherwin<br>Williams       | Color: SW6868 Real Red<br>Formula/Finish: Latex Eggshell   |
| PWT1  | Porcelain<br>Wall Tile            | Walls-<br>Field   | Tile Bar                  | Pattern: Portmore Color: White, Glossy Size: 3"x8" Grout: Laticrete, Spectralock Pro Premium Grout Color: Light pewter 90 Grout Joint:1/8"   |
| PWT2  | Porcelain<br>Wall Tile            | Walls-<br>Accent  | Tile bar                  | Pattern: Portmore<br>Color:Sky<br>Size: 3"x8"<br>Grout: Laticrete, Spectralock Pro Premium<br>Grout Color: Light pewter 90<br>Grout Joint:1/8"                                       |
| PWT3  | Porcelain<br>Wall Tile            | Walls-<br>Accent  | Emser<br>Tile             | Pattern: Milestone Color: Dust Size: 12"x24" Grout: Laticrete, Spectralock Pro Premium Grout Color: Light pewter 90  |

| ı ı |            |  |                |                     |  |  |  |
|-----|------------|--|----------------|---------------------|--|--|--|
|     |            |  |                |                     |  |  |  |
|     | METAL TRIM |  |                |                     |  |  |  |
|     | CODE       | ITEM                                     | LOCATION       | MANUFACT.           | DESCRIPTION  |  |  |
|     | SCH1       | Tile Cove<br>Piece                       | Walls-<br>Tile | Schluter<br>Systems | Dilex-AHK<br>Finish: Brushed Nickel Anodized Aluminum      |  |  |
|     | SCH2       | Tile Edge<br>Trim                        | Walls-<br>Tile | Schluter<br>Systems | Jolly Aluminum<br>Finish: Brushed Nickel Anodized Aluminum |  |  |
|     | SCH3       | Wall Tile<br>to<br>Resilient<br>Flooring | Walls-<br>Tile | Schluter<br>Systems | Schluter -VInpro-S<br>11 mm lip, Finish: Alum              |  |  |

|      |  |                                | BAS           |   |
|------|--|--------------------------------|---------------|---|
| CODE | ITEM                                       | LOCATION                       | MANUFACT.     | DESCRIPTION   |
| EB1  | Epoxy<br>Base                              | Walls-<br>Poured<br>Epoxy      | Stonhard      | Series: Stonclad UT<br>Color: Pewter<br>Height:6"H  |
| IB   | Integral<br>Sheet<br>Vinyl<br>Base         | Walls-<br>Sheet Vinyl          | Mannington    | Series and Color: To Match Sheet Vinyl Floor<br>Height: 6"H<br>Outside Corner: Boot<br>Adhesive: Manufacturer Recommended<br>Notes: Flash cove up walls to form self cove<br>integral base.   |
| PTB1 | Porcelain<br>Tile<br>Base -<br>factory cut | Walls-<br>Tile                 | Emser<br>Tile | Pattern: Milestone Color: Moon Size:cut 6"x24" Grout: Laticrete, Spectralock Pro Premium Grout Color: 24 Natural Gray Grout Joint:3/16" Utilize SCH2 Jolly as cap to the tile base.   |
| RB1  | Rubber<br>Base                             | Walls-<br>General<br>-Medsurg  | Mannington    | Style: Optimum Edge TP rubber Height: 4"H, 1/8" thick Color: 104 Fudge Adhesive: Manufacturer Recommended Notes: Coved and continuous rolls. Miter inside corners. Do NOTuse pre-molded outside corners.  If installed over sheet wall protection, utilize  |
| RB2  | Rubber<br>Base                             | Walls-<br>upgraded<br>-Medsurg | Mannington    | Mannington's premium contact adhesive.  Style: Edge Effects, Elegance EEELE rubber wall base Height: 6"H Color: 104 Fudge Adhesive: Manufacturer Recommended Notes: Miter cut all joints. Utilize matching quarter round EEQRT when installed on top hard surface.  If installed over sheet wall protection, utilize Mannington's premium contact adhesive. |
| RB3  | Rubber<br>Base                             | Walls-<br>Dietary.             | Mannington    | Style: Optimum Edge TP Rubber rubber wall base Height: 4" H Color: Mocha 597 Adhesive: Manufacturer Recommended Notes: Miter cut all joints. If installed over sheet wall protection, utilize Mannington's premium contact adhesive.  |

| CODE/      | ITEM                         | LOCATION                        | MANUEACT            | DESCRIPTION   |
|------------|------------------------------|---------------------------------|---------------------|---|
| KEY<br>EF1 | Epoxy<br>Flooring            | Floors                          | MANUFACT. Stonhard  | Style:Stonclad UT<br>Color: Pewter<br>Light Texture   |
|            |                              |                                 |                     | Note: Utlize Stonhards Stonproof ME7 membrane and Texture #3 Broadcast for waterproofing  |
| LVT1       | Luxury<br>Vinyl<br>Tile      | Floors-<br>Field-<br>Med Surg   | Mannington          | Style: Amtico Signiture Wood Collection<br>Color: Merbau AROW7590<br>Size: 7.25" x49" x 2.5 mm thick<br>Adhesive: Manufacturer Recommended  |
| LVT2       | Luxury<br>Vinyl<br>Tile      | Floors-<br>Accent -<br>Med Surg | Mannington          | Style: Amtico Signiture Wood Collection<br>Color: Manor Oak AROW7970<br>Size: 7.25" x 48" x 2.5 mm thick<br>Adhesive: Manufacturer Recommended  |
| LVT3       | Luxury<br>Vinyl<br>Tile      | Floors-<br>Accent -<br>Med Surg | Mannington          | Style: Amtico Collection<br>Color: Stria Basalt AROSMS43<br>Size: 12"x 24" x 2.5 mm<br>Adhesive: Manufacturer Recommended   |
| PTF1       | Porcelain<br>Tile<br>Floor   | Floors-<br>Field                | Emser<br>Tile       | Style: Fixt Stone Matte Color: Gray Size: 12"x24" x 3/8" thick Grout: Laticrete, Spectralock Pro Premium Grout Color: 24 Natural Gray Grout Joint:1/8" Installation/Overlay: 1/3rd offset   |
| PTF2       | Porcelain<br>Tile<br>Floor   | Floors-<br>Medsurg              | Emser<br>Tile       | Style: Milestone<br>Color: Moon<br>Size: 12"x24" x 3/8" thickness   |
|            | 11001                        |                                 |                     | Grout: Laticrete, Spectralock Pro Premium Grout Color: 24 Natural Gray Grout Joint: 1/8" Installation/Overlay:1/3rd offset  |
| RF1        | Rubber<br>Treads &<br>Risers | Stairs                          | Tarkett             | Style: Visually Impaired Stair Tread w/Integral Riser PVIRNRDTR-38 Color: 38 Pewter CG Texture: Rounded Adhesive: Manufacturer Recommended Accent Strip:20 Charcoal   |
| SC         | Sealed<br>Concrete           | Floors                          | Sherwin<br>Williams | Style: Armorseal Treadplex<br>Color: Haze Gray<br>Notes: See architectural specifications for<br>information  |
| SVF1       | Sheet<br>Vinyl<br>Floor      | Floors-<br>Field                | Mannington          | Style: Biospec MD Color: New Glacier 15364 Roll Width: 6'-6" x 0.080" Adhesive: Manufacturer Recommended Notes: Seams to be heat welded with solid weld rod 842361 Cream *Utilize 2 coats of Quantam Guard HP Seam Coater Pen on weld rods*     |
| SVF2       | Sheet<br>Vinyl<br>Floor      | Floors-<br>Slip<br>Resistant    | Mannington          | Style: Assurance III Color: Cremello 16349 Roll Width: 6'-6" x 0.080" Adhesive: Manufacturer Recommended Notes: Seams to be heat welded with solid weld rod 842322 Off White *Utilize 2 coats of Quantam Guard HP Seam Coater Pen on weld rods* |

| + + + | Floor               | Resistant   |                     | Adhesive: Manufacturer Recommended Notes: Seams to be heat welded with solid weld rod 842322 Off White *Utilize 2 coats of Quantam Guard HP Seam Coater Pen on weld rods* |
|-------|---------------------|---|---------------------|---|
|       | F                   | LOORIN  | IG TRA              | NSITION STRIPS  |
| TS1   | Transition<br>Strip | Porcelain/<br>Ceramic<br>to 1/8"<br>Resilient             | Grifform            | Ramping TRT#, 1/8" Beveled<br>Corian Color: Concrete<br>See Flooring for detail note about Ramp size.   |
| TS2   | Transition<br>Strip | LVT to SVF  | Sheet<br>Flooring   | Manufacturer, Weld Rod# *Utilize 2 coats of Quantum Guard HP Seam Coater Pen on Weld Rods   |
| TS3   | Transition<br>Strip | 1/8" Resilient<br>to Concrete                             | Schluter<br>Systems | Vinpro- U, Aluminum<br>Finish: Brushed Nickel Anodized Aluminum<br>Backfill with thin set to prevent denting.   |
| TS4   | Transition<br>Strip | New Floor to<br>Existing<br>Flooring                      | Schluter<br>Systems | Contractor to submit ADA compliant transition from that is appropriate for new/existing flooring heights. Stainless Steel ONLY  |
| TS5   | Transition<br>Strip | Poured Epoxy Floor to Porcelain Tile/Resilient at doorway | Grifform            | Threshold TT2 2" Deep<br>1/8" Beveled on each side<br>Corian Color: Concrete  |
| TS6   | Existing            | Subfloor<br>Leveler<br>Ramping<br>solutions               | Mannington          | Subfloor Leveling transition<br>189 Wide Reducer<br>Notes: Ulitize to create ADA compliant transition   |
| TS7   | Transition<br>Strip | Epoxy<br>Floor to<br>Porcelain<br>in middle<br>of room    | Stonhard            | Stonhard built in place transition  |

|    |      |                     | (  |                      | 2   | VALL P       | ROTE<br>OR WALL PROT     |                                   |        |
|----|------|---------------------|--|----------------------|---|--------------|--------------------------|-----------------------------------|--------|
|    | CODE | ITEM                | LOCATION   | MANUFACT.            | DESCRIPTION   | CODE         | ITEM                     | LOCATION                          | MANUFA |
|    | MC1  | Millwork<br>Corner  | Misc.<br>Casework<br>Corners                         | Fry Reglet           | Item: Millwork Corner Key<br>Angle: 3/16" wing<br>Finish: Clear Anodized Aluminum           | •            | Corner<br>Guard 3"       | Corners-<br>90 degree             | InPro  |
| ng | FR1  | Millwork<br>Corner  | Casework<br>Reveal<br>trim                           | Fry Reglet           | Item: Millwork Channel Post<br>Angle: 1/4"<br>Finish: Clear Anodized Aluminum               |              | Partial<br>Height        |                                   |        |
|    | PL1  | Plastic<br>Laminate | Vertical<br>Surfaces/<br>Interior Doors              | Wilsonart            | Pattern: Williamsburg Cherry 7936K<br>Finish: 07 textured gloss, Aeon Scratch<br>Resistance |              | Corner<br>Guard 3"       | Corners-<br>90 degree             | InPro  |
|    | PL2  | Plastic<br>Laminate | Vertical<br>Surfaces<br>Accent                       | Wilsonart            | Pattern: Raleigh Walnut 17015K<br>Finish: 67 Aligned Walnut, Aeon Scratch<br>Resistance     |              | Full Height              |                                   |        |
|    | PL3  | Plastic<br>Laminate | Vertical<br>Surfaces/Inte<br>rior Doors/<br>Med surg | Wilsonart            | Pattern:Pinnacle Walnut 7992<br>Finish:38 Fine Velvent Texture, Aeon Scratch<br>Resistance  |              | Corner<br>Guard 3"       | Corners-<br>End Walls             | InPro  |
|    | QZ1  | Quartz              | Servery<br>Countertops                               | Corian               | Pattern: London Abbey<br>Finish:Polished<br>Thickness: 3cm                                  |              | Partial<br>Height        |                                   |        |
|    | SS1  | Solid<br>Surface    | Countertops<br>-Medsurg<br>general                   | Corian               | Color: Clam Shell<br>Thickness: 1/2"<br>Edge Profile: Eased w/1.5" Apron                    |              | Corner<br>Guard 2"       | Corners-<br>90 degree<br>-Kitchen | InPro  |
|    | SS2  | Solid<br>Surface    | Transaction -<br>Medsurg<br>Nurse<br>station         | Corian               | Color: Concrete<br>Thickness: 1/2"<br>Edge Profile: Eased w/1.5" Apron                      |              | 8' High                  | -Michell                          |        |
| f  | SS3  | Solid<br>Surface    | Transactions/<br>Countertops                         | Durasein             | Color: Sun Kissed DM5044<br>Thickness: 1/2"<br>Edge Profile: Eased w/ 1.5" apron            |              |                          |                                   |        |
|    | SS4  | Solid<br>Surface    | Window<br>stools/<br>columns                         | Solid<br>Surface     | Color: Cameo White<br>Thickness: 1/2"<br>Edge Profile: Eased                                | See<br>Below | Hand Rail-<br>Wood       | See plans                         | InPro  |
|    | SS5  | Solid<br>Surface    | NeoPod<br>surfaces and<br>shower pan                 | Inpro/<br>Ferguson   | Color: Bright White   | See          | Hand Rail-               | See plans                         | InPro  |
|    |      | Casework            | Casework<br>Interior                                 | See<br>Architectural | Color: White  | Below        | Vinyl                    | occ plans                         |        |
|    |      | Interior            | Melamine   | Specs                | See Architectural Sheets for further details.   | See<br>Below | Crash Rail-<br>Vinyl     | See plans                         | InPro  |
|    |      | M                   | IILLWOR  | K CORI               | NER DETAIL  | See<br>Below | Bumper<br>Rail-<br>Vinvl | See plans                         | InPro  |

| Millwork Panel  Millwork Corner Key | Substrate  Fry Reglet Millwork Corner Key N.T.S.  |
|-------------------------------------|---|
| MILLW                               | ORK EDGE DETAIL   |
| Case                                | work Corner Guard -Top View   |
| Millwork Panel                      | Substrate  .5mm PVC Edgeband to match specified face color  Specified Reveal Color  5mm PVC Edgeband to match specified |
| N.T.S.                              | .5mm PVC Edgeband to match specified face color  N.T.S.   |

|      |                                  |  | SCELLA<br>htractor Provided |  |
|------|----------------------------------|--|-----------------------------|--|
| CODE | ITEM                             | LOCATION                                   | MANUFACT.                   | DESCRIPTION  |
| AP1  | Acoustical<br>Panel-<br>Tackable | Dictation/<br>Nurse<br>Station<br>Casework | Ketchum<br>Walton Co.       | Fabritrak Stretched Fabric Wall System<br>Profile: 1", S Square<br>NRC Rating of: 0.75<br>Fire Rating: Class A<br>Notes: Utilize tackable Core, Micore   |
|      |                                  |  |                             | Fabric Manufacturer: Carnegie Pattern: Meteor Color: 6427 703 Notes: See Acoustical Panel section for more information   |
| AP2  | Acoustical<br>Panel-<br>Tackable | Dining                                     | Ketchum<br>Walton Co.       | AVL Systems, AcousTech-<br>Profile: Contour 2.0 2" Flat panel Custom<br>Sizes: - to be finalized in shop drawings<br>NRC Rating of: 1.10<br>Fire Rating: Class A<br>Notes: Utilize tackable Core, Micore |
|      |                                  |  |                             | Fabric Manufacturer: Carnegie Pattern: Xorel, Meteor Color: A: 6427 2031 B: 6427 2032 C: 6427 703 Notes: See Acoustical Panel section for more information   |
| CL1  | Clocks                           | See finish plans                           | Peter Pepper<br>Products    | Style: 820 Face: 37 Bezel Finish: Diameter: 13-7/8" Notes: Flush Acrylic Cover, Wall Mount, Atomic, Battery Operated   |
| D1   | Doors                            | New<br>Interior<br>Arch. Doors             | See Arch.<br>Specs          | Finish: PL1  |
| LK1  | Lockers                          | Locker<br>Room                             | Penco                       | Color: Canvas Notes: See architectural specifications for more information on style/sizes  |
| MB1  | Marker-<br>Board                 | Med Surg<br>Patient<br>Rooms               | Claridge                    | Style: 2900 Series Patient Information Board 1 3/4" Flat Face Trim w/Radius Corners Size: 2' x 3' with Pencil Rail Custom Graphic to be provided by facility Mounting Height: TBD by Facility            |
| MB2  | Marker-<br>Board                 | See finish plans                           | Claridge                    | Style: 2900 Series Markerboard 1 3/4" Flat Face Trim w/Radius Corners Porcelain enamel steel writing surface Size: 5'H x 4'L Finish: Mohagany Stain Mounting Height: TBD by facility                     |
| MR1  | Decor.<br>Mirror                 | Upgraded<br>Toilets                        | Uttermost                   | Frame: Aramis 09605<br>Size: 24"x36"   |
| #    | Signage                          | See sign<br>plans                          | Bennu<br>Enterprises        | Style: to Match Facility Standards  Notes: Allow a 5% allowance in bid   |
| TB1  | Tack<br>Board                    | See finish<br>plans -<br>Med Surg          | Claridge                    | Style: 2900 Wood Framed Tackboard<br>Size: 4' x 4'<br>Cork Color: Natural Tan Nucork<br>Frame Finish: Mahogany Stain   |

|           | <b>Devenney</b><br>GROU                                     |
|-----------|---|
|           | Devenney Group Ltd., Ar                                     |
|           | 6900 East Camelback Ro<br>Suite 500<br>Scottsdale, AZ 85251 |
|           | T: 602.943.8950   |
|           | www.devenneygroup.co  |
|           |   |
| nsultant: |   |
|           |   |

WALL PROTECTION ITEMS

\*SEE AF002 FOR WALL PROTECTION CONFIGURATIONS

DESCRIPTION

Height: 48" Notes: Install above wall base. Utilize top and

Style: 150BN Color: See Wall Protection Color Legend

Style: 150BN Color: See Wall Protection Color Legend

Style: 150DBN Color: See Wall Protection Color Legend

Notes: Install above wall base. Utilize top and

Notes: Install above wall base. Utilize top and

Style: Stainless Steel Corner Guards 2" Surface Mount, Screw-on Installation

Type 304, Kitchen Grade, 16 Gauge thickness

Notes: Install above poured wall base. Caulk at bottom where guard meets base. Utilize clear

\*If there are any locations where stainless steel corner guards are specified and interferes/

overlaps kitchen equipment plans, please contact the interior designer for further

Style: 3520WV Silhouette with wood hand rail

Wood Finish: Crown Cherry
Vinyl Color: See Wall Protection Color Legend

Height: 6"
Vinyl Color: See Wall Protection Color Legend

Height: 4-1/16"
Vinyl Color: See Wall Protection Color Legend

Vinyl Color: See Wall Protection Color Legend

WALL PROTECTION COLOR

Notes: Utilize vinyl seal caulk at seams, NOT vinyl trim pieces. Factory-cut sheets, do NOT

Style: Rigid Vinyl Sheet Wall Protection Thickness: 0.060"

DO NOT APPLY RIGID SHEET TO ANY EXTERIOR WALL.

Oatmeal 0239 Serenity 0166

Hickory 0377

Feather 0238

English Green 0125

Retainer: Vinyl

Retainer: Vinyl Height: Full Height

Retainer: Vinyl

bottom caps.

information.

Style: 1600

Texture: Velvet

WALL PROTECTION COLOR LEGEND

LOCATION

Medsurg

and vinyl bumper Height: 7-7/8"

Style: 1200 Height: 6-1/4" Vinyl Color: Crown Cherry 0545

Style: 1300 w/mounting cushion

Height: 48" Sheet Texture: Velvet

bottom caps.


bottom caps.

ITEM LOCATION MANUFACT.

See Rigid Sheet- See plans InPro Vinyl

WALL PAINT COLOR



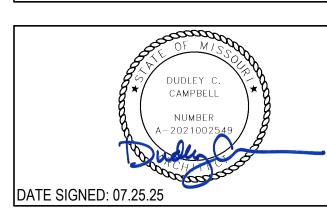

IF THESE PLANS DO NOT BEAR THE SEAL OF A REGISTRANT, THEY ARE TO BE CONSIDERED "PRELIMINARY" AND ARE NOT TO BE USED FOR CONSTRUCTION OR PROTECTION AS AN "ARCHITECTURAL WORK" UNDER SEC. 102 OF THE COPYRIGHT ACT, 17 U.S.O. AS AMENDED DECEMBER 1990 AND KNOWN AS ARCHITECTURAL WORKS COPYRIGHT PROTECTION ACT OF 1990. THE PROTECTION INCLUDES BUT IS NOT LIMITED TO THE OVERALL FORM AS WELL AS THE ARRANGEMENT AND COMPOSITION OF SPACES AND ELEMENTS OF THE DESIGN. UNDER SUCH PROTECTION, UNAUTHORIZED USE OF THESE PLANS CAN LEGALLY RESULT IN THE CESSATION OF CONSTRUCTION OR BUILDINGS BEING SEIZED AND/OR MONETARY COMPENSATION TO DEVENNEY GROUP LTD.

## LSMC MEDSURG AND DIETARY **EXPANSION**

HCA - LEE'S SUMMIT MEDICAL CENTER 2100 SE BLUE PKWY LEE'S SUMMIT, MO 64063

AUTHORITY HAVING JURISDICTION: CITY OF LEE'S SUMMIT BUILDING DEPT. MISSOURI DHSS

FACILITY NUMBER: 0972400009

AGENCY APPROVALS:


| · <u>š</u> l  |      |                     |            |
|---|------|---------------------|------------|
| pan   |      |                     |            |
| ary Ex  |      | REVISIONS           |            |
| ieta  | REV# | DESCRIPTION         | DATE       |
| 8 D   | В    | DESIGN COORDINATION | 2025/02/06 |
| Jrg   | 2    | DESIGN COORDINATION | 2025/07/25 |
| Center (LSMC)_rvt23/LSMC Med Surg & Dietary Expansi |      |                     |            |

| - Le    | DATE:       | 2024/12/  |
|---------|-------------|-----------|
| CA      | SCALE:      | 1/8" = 1' |
| - HC    | DRAWN:      | BP/       |
| 24      | REVIEWED:   |           |
| 3406.   | JOB NUMBER: | 6406      |
| ' کر، ا |             |           |

GENERAL FINISH SPECIFICATIONS AND NOTES

AF001

### FINISH SELECTIONS AND GENERAL NOTES

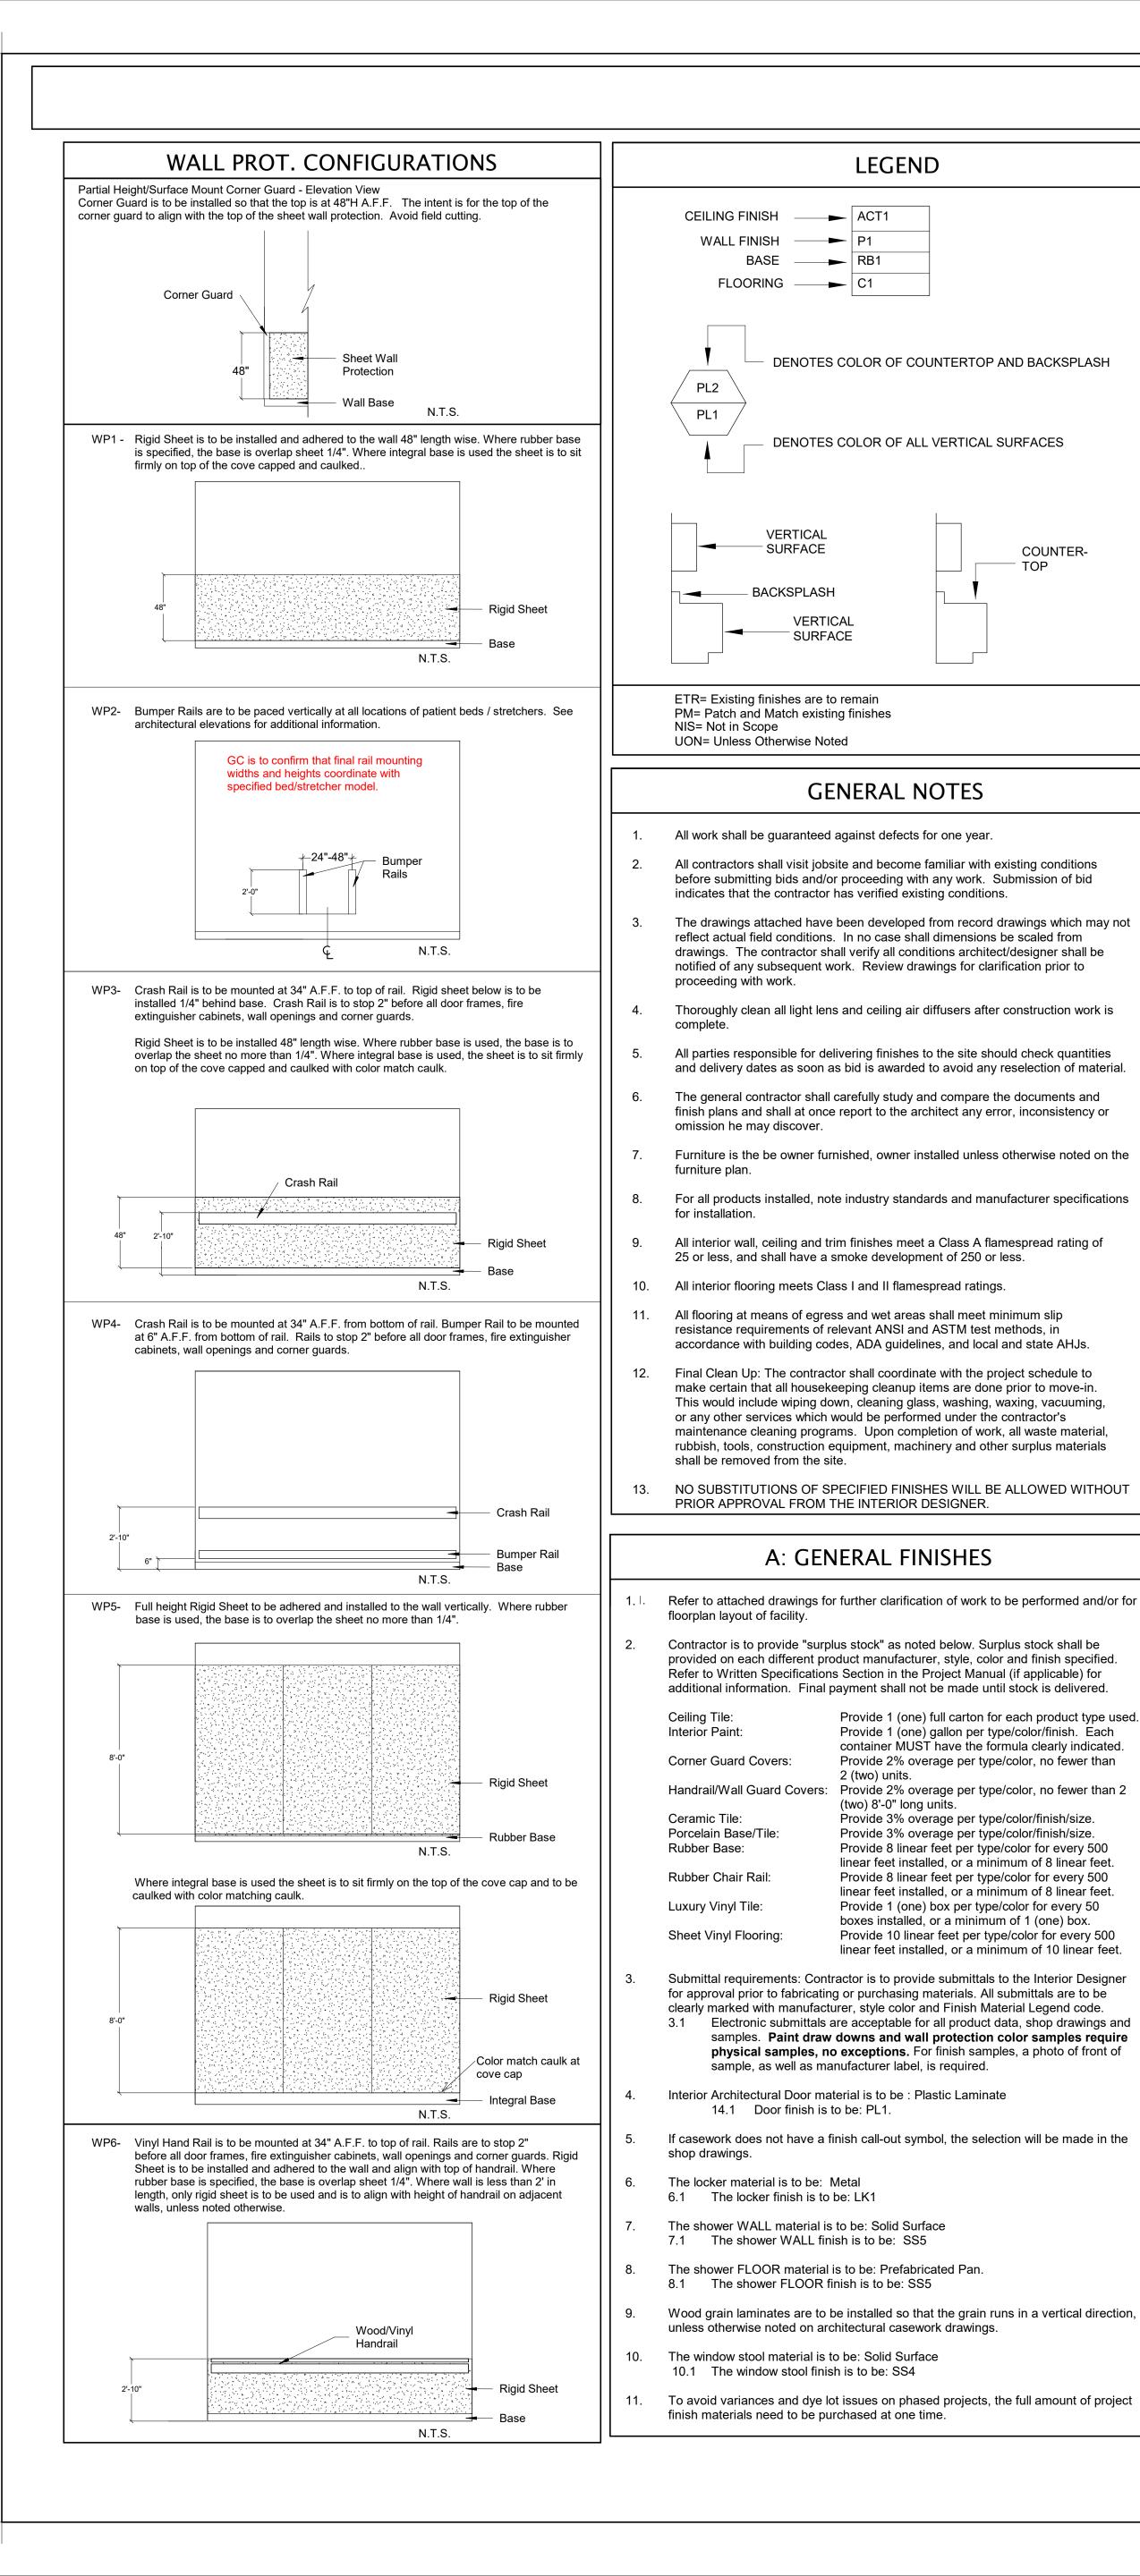

### LEGEND B: CEILING When installing lay-in ceilings, lay out grid in room so that cut tiles at perimeter

**FLOORING** 

VERTICAL

SURFACE

BACKSPLASH

VERTICAL

SURFACE

DENOTES COLOR OF COUNTERTOP AND BACKSPLASH

COUNTER-

TOP

DENOTES COLOR OF ALL VERTICAL SURFACES

**GENERAL NOTES** 

A: GENERAL FINISHES

2 (two) units.

(two) 8'-0" long units.

samples. Paint draw downs and wall protection color samples require physical samples, no exceptions. For finish samples, a photo of front of

sample, as well as manufacturer label, is required.

14.1 Door finish is to be: PL1.

Provide 1 (one) full carton for each product type used.

Provide 1 (one) gallon per type/color/finish. Each

container MUST have the formula clearly indicated.

Provide 2% overage per type/color, no fewer than

Provide 3% overage per type/color/finish/size.

Provide 3% overage per type/color/finish/size.

Provide 8 linear feet per type/color for every 500

linear feet installed, or a minimum of 8 linear feet.

Provide 8 linear feet per type/color for every 500

linear feet installed, or a minimum of 8 linear feet.

linear feet installed, or a minimum of 10 linear feet.

Provide 1 (one) box per type/color for every 50 boxes installed, or a minimum of 1 (one) box. Provide 10 linear feet per type/color for every 500 are no less than 9" wide.

Gypsum (GYP) ceilings are to be painted with the same paint type as adjacent wall. If walls are epoxy, ceilings should be epoxy as well. If walls are latex eggshell, ceilings should be as well. \*ALL CEILINGS SHOULD BE COLOR "CEILING BRIGHT WHITE" UNLESS A SOFFIT ACCENT COLOR IS INDICATED\*

Edges of cut ceiling tiles are to be painted with ceiling manufacturer's matching touch up paint.

For renovation work where not all ceiling tiles are being replaced: Replace all damaged ceiling tiles as necessary. Utilize existing ceiling tiles from one enclosed room for replacement tiles. Provide all new in above-mentioned enclosed room. This ensures ceiling tiles look uniform, avoiding a mismatched look when damaged tiles are sporadically replaced with new.

### C: PAINT

Prior to the application of paint, the contractor is to repair new or existing surfaces by patching, smoothing and sanding as needed to achieve a surface acceptable for the application of new finish. Prepare door frames or metal surfaces by sanding by chips/burrs, filling dents and caulking cracks at corners as required.

Miscellaneous metal (return and air supply grilles, expansion joints, etc) located on wall surface is to be painted to match the adjacent wall color.

The contractor is to submit one paint sample of each paint color in the appropriate finish to the Interior designer for approval prior to purchasing paint. Samples are to be painted on 8.5"x11" card stock. Each sample should have the Finish Material Legend code and color formula clearly indicated, as well as the store location where the paint is to be purchased.

When specified in the Finish Plan, provide paint finishes as noted for the surfaces listed below. Refer to written Architectural Paint Specifications section for further information regarding products, primers, etc. If surfaces exist on the job that are not listed, contact the Interior Designer.

Caulk all plumbing fixtures, millwork and trim to adjacent surfaces. Color of caulk to match adjacent finish.

Typical Paint Finishes and Locations: These are "typicals" only. For all locations, refer to finish plans.

| to illigit plane.  |   |               | SCH 1<br>Cove B               |
|--|---|---------------|-------------------------------|
| GYPSUM BO  | DARD WALLS AND SOFFITS  |               |                               |
| Eggshell Waterbased Epoxy  | Janitors Closets, Toilets, Soiled Areas,<br>Sterile Areas, Kitchens, ISO Pat Rms.   |               | Sink Wall N.T.S.              |
| Latex Eggshell   | All Other Areas   |               |                               |
| GYPS   | UM BOARD CEILINGS   |               | SCH 2<br>Finishir             |
| Egshell Waterbased Epoxy   | Showers, Soiled Areas, Kitchen, Sterile   |               |                               |
| Latex Eggshell   | All Other Areas   |               |                               |
| INTERIO  | OR METAL SURFACES   |               |                               |
| Semigloss Alkyd Enamel   | Door Frames, Metal Doors, View Window Sills/Frames, Shelving, Previously painted Wood Trim, Previously painted Metal.                                 |               |                               |
| All prefinished store front windo unless otherwise directed archit | ws or factory prefinished frames should not be painted ect or Interior Designer.  | Approx. 5'-2" | SCH 1                         |
| unless otherwise noted. Soffits i                                  | soffits over upper casework to match the vertical wall indicated to receive accent paint are to be painted on DF THE SOFFIT IS TO BE PAINTED THE SAME |               | Cove B                        |
|  | FIT SIDES, NOT CEILING WHITE.   | \             | Remaining Toilet Walls N.T.S. |
| In the case where a door frame                                     | receives a paint color on one side and another paint  |               |                               |

Paint A: Project Scope Paint B: Existing

color on the opposite side of the door, the transition shall occur on the inside corner of

If rubber base is not used, finish drywall to the floor where sealed concrete is the flooring. Contractor is to install a bead of caulk at drywall/concrete transition.


the jamb stop.

All Storage/Supply rooms are to receive a 1" painted horizontal red line 18" from bottom of the sprinkler head around the room, paint color: P10

In IT, COMM or DATA rooms, do not paint the fire retardant plywood or cover/obstruct the fire rating label in any way.

## D: ACOUSTICAL PANELS

Acoustical Panels are to be furnished and installed by the general contractor. All dimensions must be field-verified before production. Panels are to align with countertops below. Outlets are to be located below the countertop, with grommets. In locations with outlet in panel locations refer to diagram below.

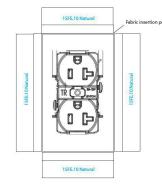

For panel specification and fabric selection and fabric selection(s), see

MISCELLANEOUS sections. For locations, see finish plans.

2.1 Dictation - Panels to be 1" from each corner and 1" above counter/backsplash.

The height of panels are be 3'-0". On wall between upper and lower cabinets. Panels are to be 1" from each corner and 1" above counter/backsplash.

2.2 Nurse station Casework - Panels to be applied between upper transaction top and work surface. Line up edges evenly. 3. AP2 is to be applied to the wall in the following pattern.

A: 6427 2031 B: 6427 2032

C: 6427 703

Center panels between walls

AP2 - Dietary 1/4" = 1'-0"

FULL HEIGHT 40" A.F.F. Sink Wall, N.T.S.

E: TILE

Mirror is to be installed so the bottom of the reflective surface is at 40" AFF.

All transitions between wall tile and paint/wallcovering are to be made with SCH2

Center Mirror


over Sink

See Finish Material Legend for grout formulas and colors.

along with a bead of wall color matching caulk.


If floor tile is larger than 2"x2," cut tile to slope to drain.

Walls in Toilets are to receive the following tile pattern(s): Install so that tile runs fully behind grab bars and dispensers.

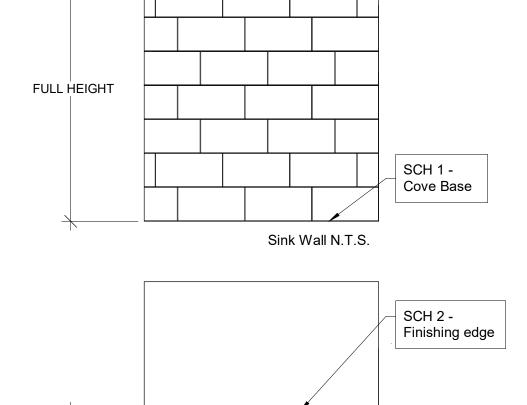


Wall Tile Key:

PWT1,2 to be installed in a similiar installation to the following pattern in all locations marked in the Dietary Servery. Tiles are be randamly staggered in a vertical pattern in a 1/3rd offset pattern. These tiles have a high variation in color, so follow manafacturers instructions for percentage and installation instructions to ensure they are installed randomly as well.

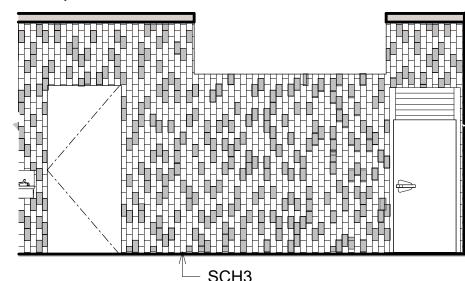


Dietary - TYPICAL TILE PATTERN FOR PWT1,2 ACCENT TILE WALLS

Where PWT2 is installed by itself in Dietary, install tile vertically in a 1/2 offset pattern, from floor to ceiling in the same randomized color variation pattern.

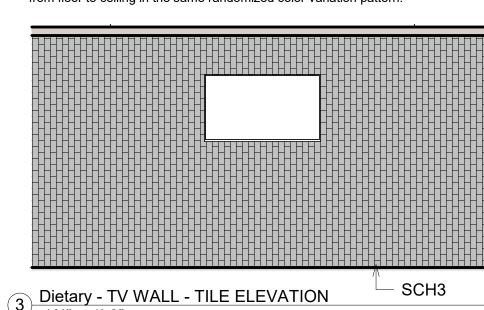

Wall Tile Key: PWT2

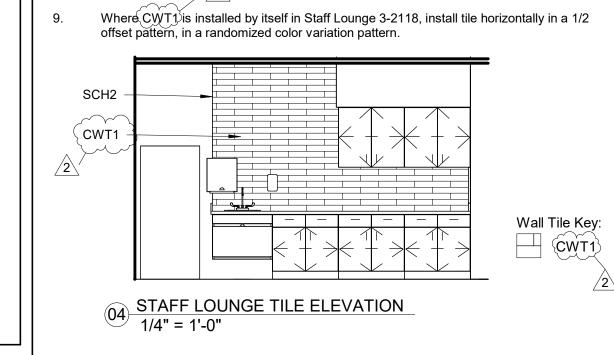

## F: FLOORING

All traditional rubber base is to be 4" H, coved, and continuous rolls. Miter inside corners, wrap outside corners of jobsite. Do NOT use premolded corners.

- All sculptured rubber base is to be 6" H, straight sections. Miter inside and outside corners. Do NOT use premolded corners.
- All reducer strips and other thresholds are to be located at the centerline of door

when in a closed position, unless otherwise noted.

- Utilize clear caulk to seal where flooring transition meets flooring, to eliminate
- Transition strips are indicated by a bold line on the floor pattern plans. It is the contractor's responsibility to identify locations and quanities of the material-tomaterial transition strips. If a strip is needed that is not listed in Floor Transisiton, contractor is to submit proposed product via submittal for approval. All transition are required to meet ADA guidelines.

Flooring Transition = TS#

ADA compliant porcelain to resilient floor details: 1/4" MAX VERTICAL \_\_\_\_ 1 MAX RISE/RUN N.T.S. RESILENT FLOORING

All floor transitions are to be taped or covered during construction, to protect the material until final completion.


PORCELAIN/CERAMIC/QUARRY

TO HAVE SLIGHT RECESS. NO

- Where new flooring or base is specified, the same flooring or base should extend into any closets, storage areas, etc. adjacent to that space unless otherwise
- For renovations, existing flooring is to be removed by the contractor prior to applying the specified flooring product.
- Floor pattern shall extend under any open space under casework or kneespace, even when it appears to stop on plan.
- 11. Where specified sheet vinyl flooring is to be heatwelded at seams using manufacturer's sealer. Flash cove material up wall to form self-coved base. Continuous Resilient cove support to be Mannington #070. Aluminum trim to be provided by Powerhold, mill finished anodized 409105 PH 901 MFA.
- 12. Apply Mannington's "Seam Coater Pen" to ALL welded seams of sheet vinyl flooring immediately after installation.
- 13. Where sheet vinyl flooring is used, a proposed seaming diagram MUST be submitted and approved by the Interior Designer.
- Minimize the amount of seams. Avoid seams extending into a doorway.
- Manufacturer's recommended adhesive is to be based on application and concrete moisture %.
- In the following locations, utilize manufacturer recommended traditional epoxy - Under Patient Room beds receiving sheet vinyl flooring.
- In the following locations, utilize manufacturer recommended pre-applied adhesive or traditional epoxy adhesive.
- 17. For HCA projects, all flooring should be purchased and tracked through Logistic Solutions and Mannington. See material contacts section for contact people.

- In Elevators receiving LVT.

Transition between Stonhard Epoxy and Porcelain Tile within room in Dietary area is to recieve the following transition between the two floorings.

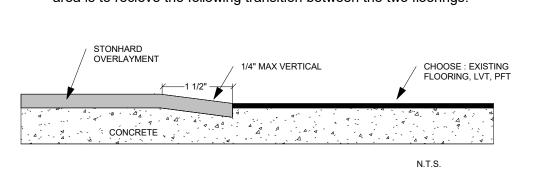




Typical Casework Designs are to be as shown in elevations below. All Graining to run in the same direction, unless otherwise noted. All 1/4" reveals are to be plastic laminate PL4. Typical Med Surg Nurse Station


SS3 MC1

NURSE STATION, TYP. 1/4" = 1'-0"

Front Elevation, TYP

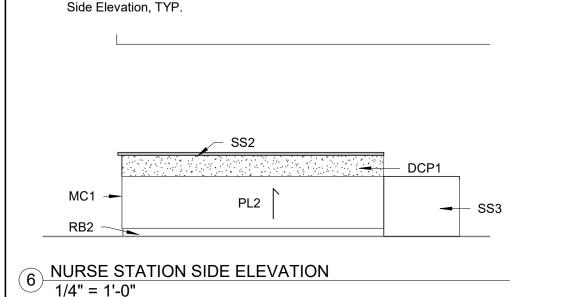

2. Glass Divider panels to be mounted to the top of half walls in dietary, in each location shown

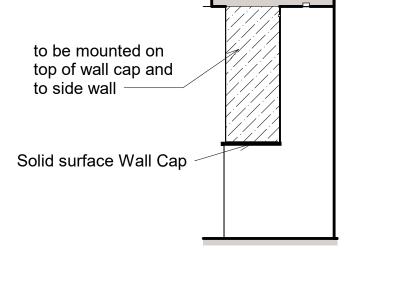

7 Dietary - DGWP1 - Glass panel divider




Devenney Group Ltd., Architects 6900 East Camelback Road

Scottsdale, AZ 85251 T: 602.943.8950

Suite 500

www.devenneygroup.com

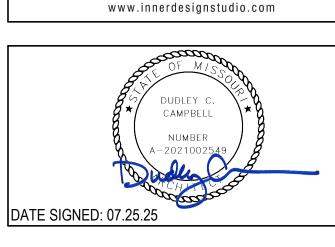

IF THESE PLANS DO NOT BEAR THE SEAL OF A REGISTRANT, THEY ARE TO BE CONSIDERED "PRELIMINARY" AND ARE NOT TO BE USED FOR CONSTRUCTION OR PROTECTION AS AN "ARCHITECTURAL WORK" UNDER SEC. 102 OF THE COPYRIGHT ACT, 17 U.S.O. AS AMENDED DECEMBER 1990 AND KNOWN AS ARCHITECTURAL WORKS COPYRIGHT PROTECTION ACT OF 1990. THE PROTECTION INCLUDES BUT IS NOT LIMITED TO THE OVERALL FORM AS WELL AS THE ARRANGEMENT AND COMPOSITION OF SPACES AND ELEMENTS OF THE DESIGN. UNDER SUCH PROTECTION, UNAUTHORIZED USE OF THESE PLANS CAN LEGALLY RESULT IN THE CESSATION OF CONSTRUCTION OR BUILDINGS BEING SEIZED AND/OR MONETARY OMPENSATION TO DEVENNEY GROUP LTD

> LSMC MEDSURG AND DIETARY

HCA - LEE'S SUMMIT MEDICAL CENTER 2100 SE BLUE PKWY LEE'S SUMMIT, MO 64063

**AUTHORITY HAVING JURISDICTION:** CITY OF LEE'S SUMMIT BUILDING DEPT. **MISSOURI DHSS** 

**FACILITY NUMBER:** 0972400009

AGENCY APPROVALS:

REVISIONS DATE DESCRIPTION REV# 2025/02/06 DESIGN COORDINATION **DESIGN COORDINATION** 2025/07/25


SCALE: As indicated T DRAWN:

7 REVIEWED:

JOB NUMBER:

GENERAL FINISH SPECIFICATIONS AND NOTES

AF002

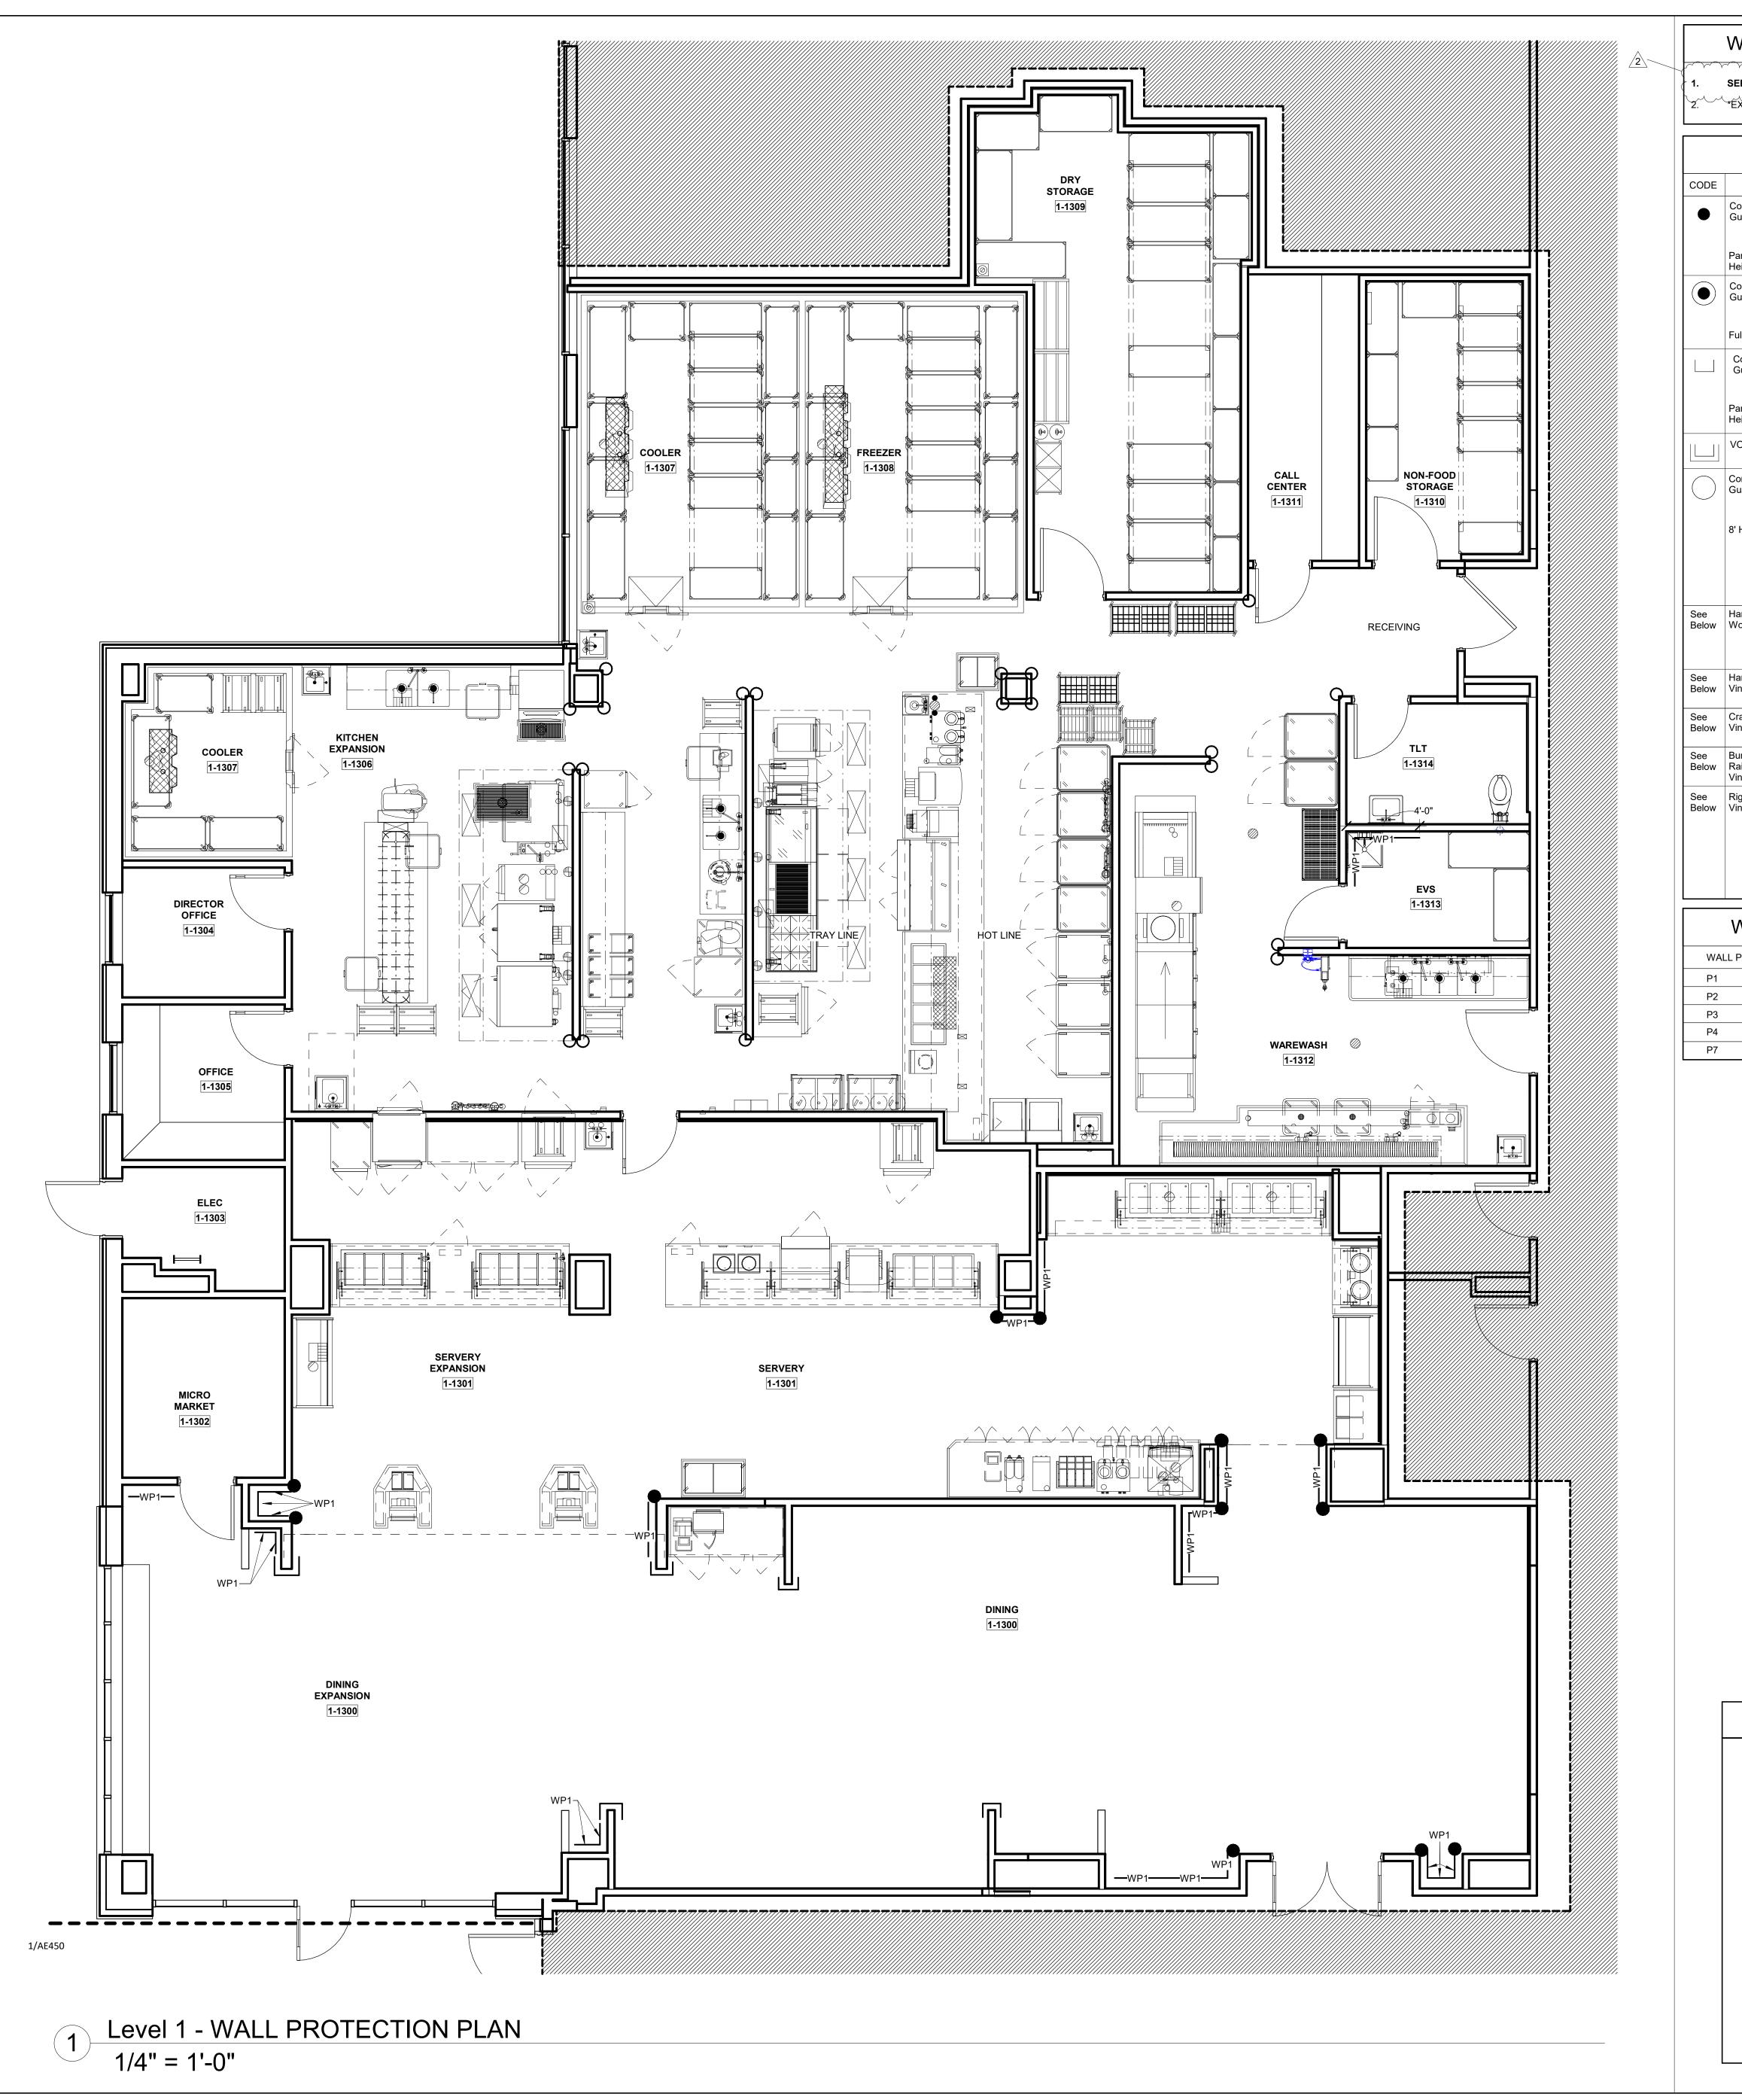

### WALL PROTECTION GENERAL NOTES

1. SEE AF001/AF002 FOR MORE WALL PROTECTION DETAILS AND CONFIGURATIONS.

2. \*ÉXTÉRIÓR WALLS SHOULD BE FURRED IN ORDER TO RECEIVE RIGID SHÉET VINYL

|              | \(\sqrt{2}\)-                           | 7' Y' Y'                          | ROIEC  OR WALL PROTECTION | CONTEMS  |
|--------------|---|-----------------------------------|---------------------------|--|
| CODE         | ITEM                                    | LOCATION                          | MANUFACT.                 | DESCRIPTION  |
| •            | Corner<br>Guard 3"<br>Partial<br>Height | Corners-<br>90 degree             | InPro                     | Style: 150BN Color: See Wall Protection Color Legend Retainer: Vinyl Height: 48" Notes: Install above wall base. Utilize top an bottom caps.   |
|              | Corner<br>Guard 3"<br>Full Height       | Corners-<br>90 degree             | InPro                     | Style: 150BN Color: See Wall Protection Color Legend Retainer: Vinyl Height: Full Height Notes: Install above wall base. Utilize top an bottom caps.   |
|              | Corner<br>Guard 3"                      | Corners-<br>End Walls             | InPro                     | Style: 150DBN Color: See Wall Protection Color Legend Retainer: Vinyl Height: 48" Sheet Texture: Velvet Notes: Install above wall base. Utilize top and  |
|              | Height                                  |                                   |                           | bottom caps.   |
|              | VOID                                    |                                   |                           |  |
|              | Corner<br>Guard 2"<br>8' High           | Corners-<br>90 degree<br>-Kitchen | InPro                     | Style: Stainless Steel Corner Guards 2" Surface Mount, Screw-on Installation Type 304, Kitchen Grade, 16 Gauge thicknes Height: 8' Notes: Install above poured wall base. Caulk bottom where guard meets base. Utilize clear caulk. *If there are any locations where stainless st corner guards are specified and interferes/ overlaps kitchen equipment plans, please contact the interior designer for further information. |
| See<br>Below | Hand Rail-<br>Wood                      | See plans                         | InPro                     | Style: 3520WV Silhouette with wood hand ra<br>and vinyl bumper<br>Height: 7-7/8"<br>Wood Finish: Crown Cherry<br>Vinyl Color: See Wall Protection Color Leger  |
| See<br>Below | Hand Rail-<br>Vinyl                     | See plans                         | InPro                     | Style: 1200<br>Height: 6-1/4"<br>Vinyl Color: Crown Cherry 0545  |
| See<br>Below | Crash Rail-<br>Vinyl                    | See plans                         | InPro                     | Style: 1600<br>Height: 6"<br>Vinyl Color: See Wall Protection Color Leger  |
| See<br>Below | Bumper<br>Rail-<br>Vinyl                | See plans                         | InPro                     | Style: 1300 w/mounting cushion<br>Height: 4-1/16"<br>Vinyl Color: See Wall Protection Color Leger  |
| See<br>Below | Rigid Sheet-<br>Vinyl                   | See plans                         | InPro                     | Style: Rigid Vinyl Sheet Wall Protection Thickness: 0.060" Texture: Velvet Vinyl Color: See Wall Protection Color Leger  |

| WALL PROTECTION COLOR LEGEND |          |                       |  |
|------------------------------|----------|-----------------------|--|
| WALL PAINT COLOR             | LOCATION | WALL PROTECTION COLOR |  |
| P1                           | Medsurg  | Oatmeal 0239          |  |
| P2                           | Medsurg  | Serenity 0166         |  |
| P3                           | Medsurg  | Hickory 0377          |  |
| P4                           | Medsurg  | English Green 0125    |  |
| P7                           | Dietary  | Feather 0238          |  |

KEY PLAN

LEVEL 1 - KEYPLAN

Vinyl Color: See Wall Protection Color Legend Notes: Utilize vinyl seal caulk at seams, NOT

vinyl trim pieces. Factory-cut sheets, do NOT

DO NOT APPLY RIGID SHEET TO ANY EXTERIOR WALL.



Devenney Group Ltd., Architects


6900 East Camelback Road

Suite 500 Scottsdale, AZ 85251 T: 602.943.8950

www.devenneygroup.com

nt:

INNER DESIGN STUDIO
7 1 0 3 Bakers Bridge
Ave, Suite 1 0 6
Brentwood, TN 37027
6 1 5 . 3 2 1 . 0 6 9 6
www.innerdesignstudio.com

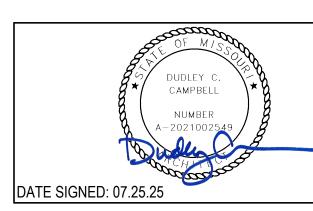

IF THESE PLANS DO NOT BEAR THE SEAL OF A REGISTRANT, THEY ARE TO BE CONSIDERED "PRELIMINARY" AND ARE NOT TO BE USED FOR CONSTRUCTION OR RECORDING. THESE PLANS ARE COPYRIGHTED AND ARE SUBJECT TO COPYRIGHT PROTECTION AS AN "ARCHITECTURAL WORK" UNDER SEC. 102 OF THE COPYRIGHT ACT, 17 U.S.O. AS AMENDED DECEMBER 1990 AND KNOWN AS ARCHITECTURAL WORKS COPYRIGHT PROTECTION ACT OF 1990. THE PROTECTION INCLUDES BUT IS NOT LIMITED TO THE OVERALL FORM AS WELL AS THE ARRANGEMENT AND COMPOSITION OF SPACES AND ELEMENTS OF THE DESIGN. UNDER SUCH PROTECTION, UNAUTHORIZED USE OF THESE PLANS CAN LEGALLY RESULT IN THE CESSATION OF CONSTRUCTION OR BUILDINGS BEING SEIZED AND/OR MONETARY COMPENSATION TO DEVENNEY GROUP LTD.

## LSMC MEDSURG AND DIETARY EXPANSION

HCA - LEE'S SUMMIT MEDICAL CENTER 2100 SE BLUE PKWY LEE'S SUMMIT, MO 64063

AUTHORITY HAVING JURISDICTION:
CITY OF LEE'S SUMMIT BUILDING DEPT.
MISSOURI DHSS

FACILITY NUMBER:
0972400009


AGENCY APPROVALS:


| REV#   | DESCRIPTION         | DATE         |
|--------|---------------------|--------------|
| В      | DESIGN COORDINATION | 2025/02/06   |
| 2      | DESIGN COORDINATION | 2025/07/25   |
|        |                     |              |
|        |                     |              |
| DATE:  |                     | 2024/12/05   |
| SCALE: |                     | As indicated |
| DRAWN  |                     | BP/PC        |
| REVIEW |                     | PF           |
| IOB NU | IMBFR:              | 6406.24      |

REVISIONS

WALL PROTECTION PLAN LEVEL 1


AF102

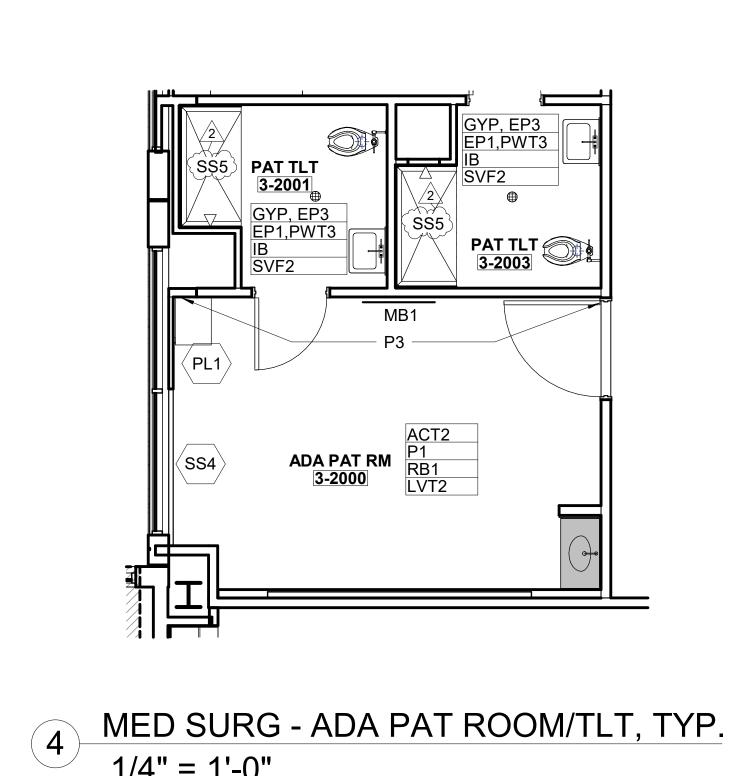

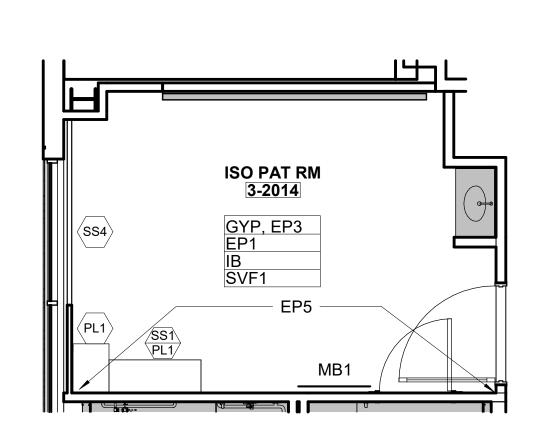

3 MED SURG - ISO PAT ROOM, TYP.

1/4" = 1'-0"

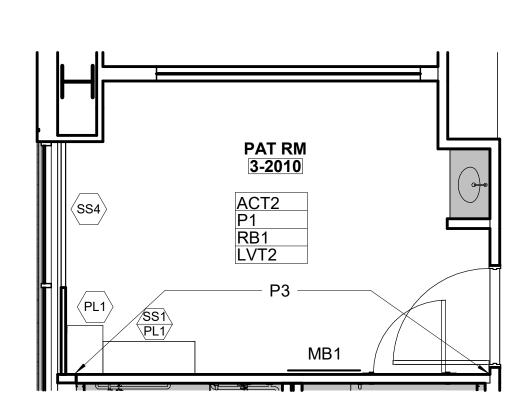

2 MED SURG - PAT ROOM, TYP. 1/4" = 1'-0"



### PRE-FABRICATED ELEMENTS

DENOTES HEADWALLS, FOOTWALLS, SINK ALCOVES, AND TOILETS PROVIDED BY PRE-FAB VENDOR.

\*REFER TO THE VENDOR SCOPING DOCUMENTS FOR ADDITIONAL SCOPING AND COORDINATION INFORMATION.



Devenney Group Ltd., Architects
6900 East Camelback Road

Scottsdale, AZ 85251

T: 602.943.8950

www.devenneygroup.com

Suite 500

ant:

INNER DESIGN STUDIO
7 1 0 3 Bakers Bridge
A ve, Suite 1 0 6
Brentwood, TN 37027

7103 Bakers Bridge
Ave, Suite 106
Brentwood, TN 37027
615.321.0696
www.innerdesignstudio.com

DUDLEY C. CAMPBELL
NUMBER
A-2021002549

DATE SIGNED: 07.25.25

IF THESE PLANS DO NOT BEAR THE SEAL OF A REGISTRANT, THEY ARE TO BE CONSIDERED "PRELIMINARY" AND ARE NOT TO BE USED FOR CONSTRUCTION OR RECORDING. THESE PLANS ARE COPYRIGHTED AND ARE SUBJECT TO COPYRIGHT PROTECTION AS AN "ARCHITECTURAL WORK" UNDER SEC. 102 OF THE COPYRIGHT ACT, 17 U.S.O. AS AMENDED DECEMBER 1990 AND KNOWN AS ARCHITECTURAL WORKS COPYRIGHT PROTECTION ACT OF 1990. THE PROTECTION INCLUDES BUT IS NOT LIMITED TO THE OVERALL FORM AS WELL AS THE ARRANGEMENT AND COMPOSITION OF SPACES AND ELEMENTS OF THE DESIGN. UNDER SUCH PROTECTION, UNAUTHORIZED USE OF THESE PLANS CAN LEGALLY RESULT IN THE CESSATION OF CONSTRUCTION OR BUILDINGS BEING SEIZED AND/OR MONETARY COMPENSATION TO DEVENNEY GROUP LTD.

LSMC MEDSURG AND DIETARY EXPANSION

HCA - LEE'S SUMMIT MEDICAL CENTER 2100 SE BLUE PKWY LEE'S SUMMIT, MO 64063

AUTHORITY HAVING JURISDICTION:
CITY OF LEE'S SUMMIT BUILDING DEPT.
MISSOURI DHSS

FACILITY NUMBER: **0972400009** 

AGENCY APPROVALS:

REVISIONS

REV # DESCRIPTION DATE

B DESIGN COORDINATION 2025/02/06


2 DESIGN COORDINATION 2025/07/25


DATE: 2024/12/05

SCALE: As indicated
DRAWN: PC/BP
REVIEWED: PF
JOB NUMBER: 6406.24

FINISH FLOOR PLAN - LEVEL
3 - SECTOR A - (16) BED


AF301A

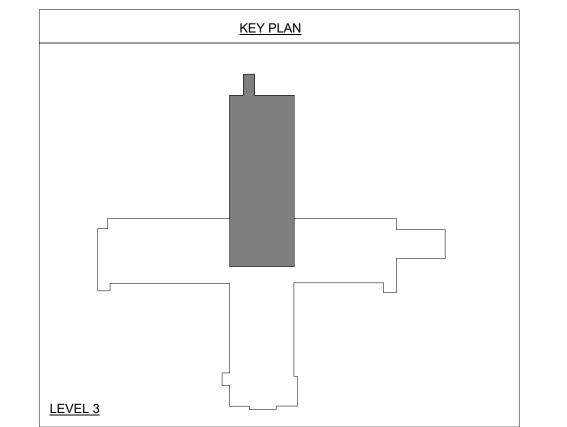

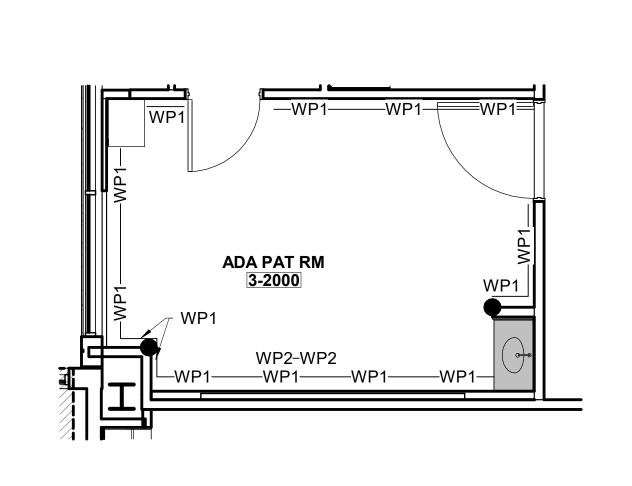


WALL PROTECTION PLAN - ADA PAT ROOM, TYP.

1/4" = 1'-0"

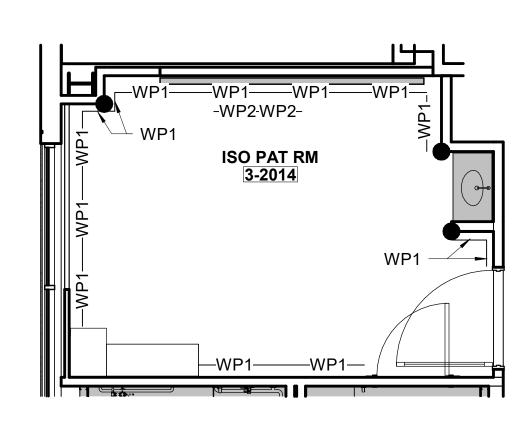

WALL PROTECTION PLAN - ISO PAT ROOM, TYP.

1/4" = 1'-0"

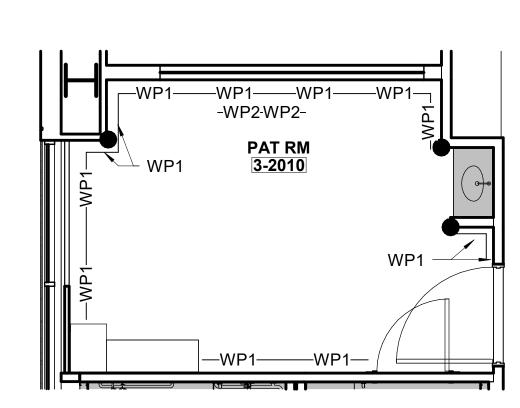

WALL PROTECTION PLAN - PAT ROOM, TYP.

1/4" = 1'-0"

TYP.



### WALL PROTECTION GENERAL NOTES

1. SEE AF001/AF002 FOR MORE WALL PROTECTION DETAILS AND CONFIGURATIONS.

2. \*EXTERIOR WALLS SHOULD BE FURRED IN ORDER TO RECEIVE RIGID SHEET VINYL

| CODE         | ITEM                     | LOCATION                          | MANUFACT. | DESCRIPTION  |
|--------------|--------------------------|-----------------------------------|-----------|--|
| •            | Corner<br>Guard 3"       | Corners-<br>90 degree             | InPro     | Style: 150BN Color: See Wall Protection Color Legend Retainer: Vinyl Height: 48" Notes: Install above wall base. Utilize top and   |
|              | Height                   |                                   |           | bottom caps.   |
|              | Corner<br>Guard 3"       | Corners-<br>90 degree             | InPro     | Style: 150BN Color: See Wall Protection Color Legend Retainer: Vinyl Height: Full Height Notes: Install above wall base. Utilize top and   |
|              |                          | 0                                 | In Due    | bottom caps.   |
|              | Corner<br>Guard 3"       | Corners-<br>End Walls             | InPro     | Style: 150DBN Color: See Wall Protection Color Legend Retainer: Vinyl Height: 48" Sheet Texture: Velvet  |
|              | Partial<br>Height        |                                   |           | Notes: Install above wall base. Utilize top and bottom caps.   |
|              | VOID                     |                                   |           |  |
|              | Corner<br>Guard 2"       | Corners-<br>90 degree<br>-Kitchen | InPro     | Style: Stainless Steel Corner Guards 2" Surface Mount, Screw-on Installation Type 304, Kitchen Grade, 16 Gauge thickness Height: 8' Notes: Install above poured wall base. Caulk at  |
|              | 8' High                  |                                   |           | bottom where guard meets base. Utilize clear caulk.  *If there are any locations where stainless steel corner guards are specified and interferes/ overlaps kitchen equipment plans, please contact the interior designer for further information.                             |
| See<br>Below | Hand Rail-<br>Wood       | See plans                         | InPro     | Style: 3520WV Silhouette with wood hand rail and vinyl bumper Height: 7-7/8" Wood Finish: Crown Cherry Vinyl Color: See Wall Protection Color Legend   |
| See<br>Below | Hand Rail-<br>Vinyl      | See plans                         | InPro     | Style: 1200<br>Height: 6-1/4"<br>Vinyl Color: Crown Cherry 0545  |
| See<br>Below | Crash Rail-<br>Vinyl     | See plans                         | InPro     | Style: 1600<br>Height: 6"<br>Vinyl Color: See Wall Protection Color Legend   |
| See<br>Below | Bumper<br>Rail-<br>Vinyl | See plans                         | InPro     | Style: 1300 w/mounting cushion<br>Height: 4-1/16"<br>Vinyl Color: See Wall Protection Color Legend   |
| See<br>Below | Rigid Sheet-<br>Vinyl    | See plans                         | InPro     | Style: Rigid Vinyl Sheet Wall Protection Thickness: 0.060" Texture: Velvet Vinyl Color: See Wall Protection Color Legend Notes: Utilize vinyl seal caulk at seams, NOT vinyl trim pieces. Factory-cut sheets, do NOT field-cut. DO NOT APPLY RIGID SHEET TO ANY EXTERIOR WALL. |




Devenney Group Ltd., Architects

6900 East Camelback Road Suite 500 Scottsdale, AZ 85251 T: 602.943.8950

www.devenneygroup.com



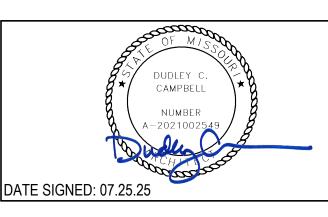

IF THESE PLANS DO NOT BEAR THE SEAL OF A REGISTRANT, THEY ARE TO BE CONSIDERED "PRELIMINARY" AND ARE NOT TO BE USED FOR CONSTRUCTION OR RECORDING. THESE PLANS ARE COPYRIGHTED AND ARE SUBJECT TO COPYRIGHT PROTECTION AS AN "ARCHITECTURAL WORK" UNDER SEC. 102 OF THE COPYRIGHT ACT, 17 U.S.O. AS AMENDED DECEMBER 1990 AND KNOWN AS ARCHITECTURAL WORKS COPYRIGHT PROTECTION ACT OF 1990. THE PROTECTION INCLUDES BUT IS NOT LIMITED TO THE OVERALL FORM AS WELL AS THE ARRANGEMENT AND COMPOSITION OF SPACES AND ELEMENTS OF THE DESIGN. UNDER SUCH PROTECTION, UNAUTHORIZED USE OF THESE PLANS CAN LEGALLY RESULT IN THE CESSATION OF CONSTRUCTION OR BUILDINGS BEING SEIZED AND/OR MONETARY COMPENSATION TO DEVENNEY GROUP LTD.

## LSMC MEDSURG AND DIETARY EXPANSION

HCA - LEE'S SUMMIT

MEDICAL CENTER

2100 SE BLUE PKWY

LEE'S SUMMIT, MO 64063

AUTHORITY HAVING JURISDICTION:
CITY OF LEE'S SUMMIT BUILDING DEPT.
MISSOURI DHSS

FACILITY NUMBER:
0972400009


AGENCY APPROVALS:


|      | KLVISIONS           |            |
|------|---------------------|------------|
| REV# | DESCRIPTION         | DATE       |
| В    | DESIGN COORDINATION | 2025/02/06 |
| 2    | DESIGN COORDINATION | 2025/07/25 |
|      |                     |            |
|      |                     |            |
| e's    |             |             |
|--------|-------------|-------------|
| - Lee  | DATE:       | 2024/12/0   |
| გ      | SCALE:      | As indicate |
| エ      | DRAWN:      | PC/B        |
| 24     | REVIEWED:   | Р           |
| 406.24 | JOB NUMBER: | 6406.2      |
|        |             |             |

WALL PROTECTION PLAN - LEVEL 3 - SECTOR A - (16)
BED UNIT



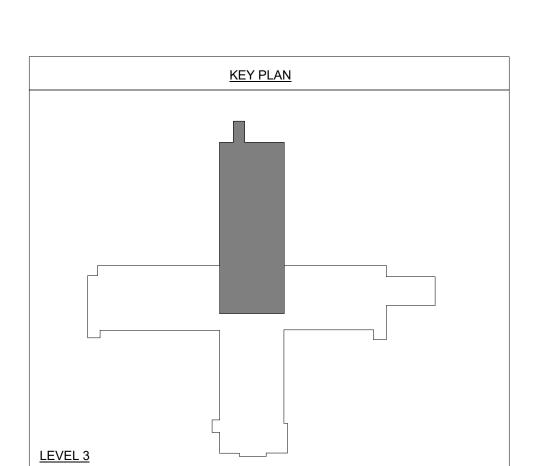


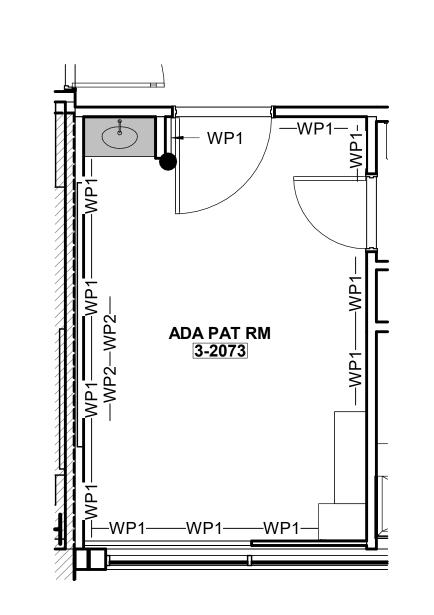

WALL PROTECTION PLAN - ADA PAT ROOM, TYP. 1/4" = 1'-0"


WALL PROTECTION PLAN - LEVEL 3 - SECTOR B - MED/SURG (12-BED UNIT)

1/8" = 1'-0"

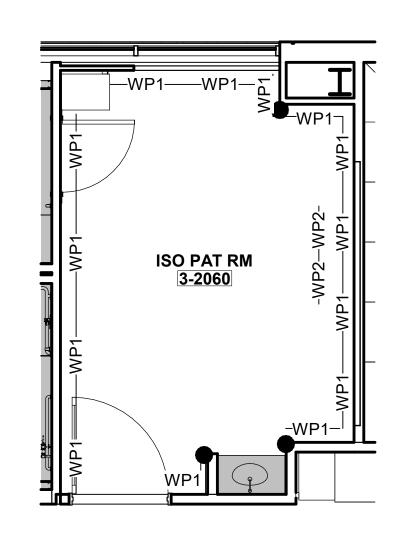

WALL PROTECTION PLAN - ISO PAT ROOM, TYP.

1/4" = 1'-0"

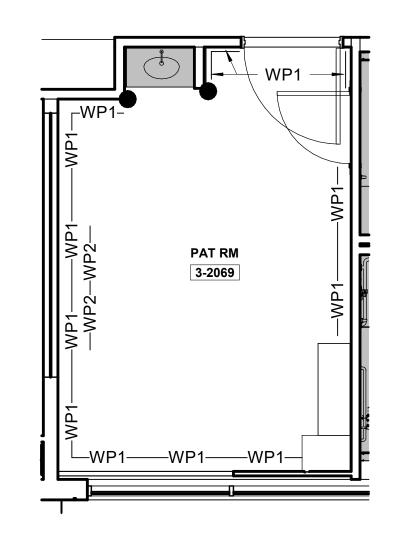

WALL PROTECTION PLAN - PAT ROOM, TYP.

1/4" = 1'-0"

## WALL PROTECTION GENERAL NOTES

1. SEE AF001/AF002 FOR MORE WALL PROTECTION DETAILS AND CONFIGURATIONS.

2. \*EXTERIOR WALLS SHOULD BE FURRED IN ORDER TO RECEIVE RIGID SHEET VINYL

|              | V                                       |                                   | ROTECTOR WALL PROTECTION | TION ITEMS  |
|--------------|---|-----------------------------------|--------------------------|---|
| CODE         | ITEM                                    | LOCATION                          | MANUFACT.                | DESCRIPTION   |
| •            | Corner<br>Guard 3"<br>Partial<br>Height | Corners-<br>90 degree             | InPro                    | Style: 150BN Color: See Wall Protection Color Legend Retainer: Vinyl Height: 48" Notes: Install above wall base. Utilize top and bottom caps.   |
|              | Corner<br>Guard 3"                      | Corners-<br>90 degree             | InPro                    | Style: 150BN Color: See Wall Protection Color Legend Retainer: Vinyl Height: Full Height Notes: Install above wall base. Utilize top and bottom caps.   |
|              | Corner<br>Guard 3"<br>Partial<br>Height | Corners-<br>End Walls             | InPro                    | Style: 150DBN Color: See Wall Protection Color Legend Retainer: Vinyl Height: 48" Sheet Texture: Velvet Notes: Install above wall base. Utilize top and bottom caps.  |
|              | VOID                                    |                                   |                          |   |
|              | Corner<br>Guard 2"<br>8' High           | Corners-<br>90 degree<br>-Kitchen | InPro                    | Style: Stainless Steel Corner Guards 2" Surface Mount, Screw-on Installation Type 304, Kitchen Grade, 16 Gauge thickness Height: 8' Notes: Install above poured wall base. Caulk a bottom where guard meets base. Utilize clear caulk. *If there are any locations where stainless stee corner guards are specified and interferes/ overlaps kitchen equipment plans, please contact the interior designer for further information. |
| See<br>Below | Hand Rail-<br>Wood                      | See plans                         | InPro                    | Style: 3520WV Silhouette with wood hand rail<br>and vinyl bumper<br>Height: 7-7/8"<br>Wood Finish: Crown Cherry<br>Vinyl Color: See Wall Protection Color Legend  |
| See<br>Below | Hand Rail-<br>Vinyl                     | See plans                         | InPro                    | Style: 1200<br>Height: 6-1/4"<br>Vinyl Color: Crown Cherry 0545   |
| See<br>Below | Crash Rail-<br>Vinyl                    | See plans                         | InPro                    | Style: 1600<br>Height: 6"<br>Vinyl Color: See Wall Protection Color Legend  |
| See<br>Below | Bumper<br>Rail-<br>Vinyl                | See plans                         | InPro                    | Style: 1300 w/mounting cushion<br>Height: 4-1/16"<br>Vinyl Color: See Wall Protection Color Legend  |
| See<br>Below | Rigid Sheet-<br>Vinyl                   | See plans                         | InPro                    | Style: Rigid Vinyl Sheet Wall Protection Thickness: 0.060" Texture: Velvet Vinyl Color: See Wall Protection Color Legend Notes: Utilize vinyl seal caulk at seams, NOT vinyl trim pieces. Factory-cut sheets, do NOT  |

vinyl trim pieces. Factory-cut sheets, do NOT

DO NOT APPLY RIGID SHEET TO

ANY EXTERIOR WALL.

KEY PLAN

LEVEL 3


Devenney GROUP

Devenney Group Ltd., Architects

6900 East Camelback Road Suite 500 Scottsdale, AZ 85251 T: 602.943.8950

www.devenneygroup.com



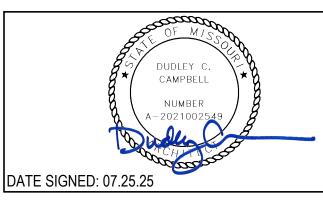

IF THESE PLANS DO NOT BEAR THE SEAL OF A REGISTRANT, THEY ARE TO BE CONSIDERED "PRELIMINARY" AND ARE NOT TO BE USED FOR CONSTRUCTION OR RECORDING. THESE PLANS ARE COPYRIGHTED AND ARE SUBJECT TO COPYRIGHT PROTECTION AS AN "ARCHITECTURAL WORK" UNDER SEC. 102 OF THE COPYRIGHT ACT, 17 U.S.O. AS AMENDED DECEMBER 1990 AND KNOWN AS ARCHITECTURAL WORKS COPYRIGHT PROTECTION ACT OF 1990. THE PROTECTION INCLUDES BUT IS NOT LIMITED TO THE OVERALL FORM AS WELL AS THE ARRANGEMENT AND COMPOSITION OF SPACES AND ELEMENTS OF THE DESIGN. UNDER SUCH PROTECTION, UNAUTHORIZED USE OF THESE PLANS CAN LEGALLY RESULT IN THE CESSATION OF CONSTRUCTION OR BUILDINGS BEING SEIZED AND/OR MONETARY COMPENSATION TO DEVENNEY GROUP LTD.


# LSMC MEDSURG AND DIETARY EXPANSION

HCA - LEE'S SUMMIT

MEDICAL CENTER

2100 SE BLUE PKWY

LEE'S SUMMIT, MO 64063

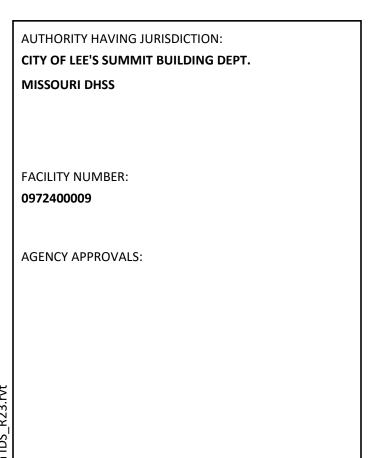

|       | REVISIONS           |            |
|-------|---------------------|------------|
| REV#  | DESCRIPTION         | DATE       |
| В     | DESIGN COORDINATION | 2025/02/06 |
| 2     | DESIGN COORDINATION | 2025/07/25 |
|       |                     |            |
|       |                     |            |
| DATE: |                     | 2024/12/05 |

DATE: 2024/12/05
SCALE: As indicated
DRAWN: PC/BP
REVIEWED: PF
JOB NUMBER: 6406.24

WALL PROTECTION PLAN - LEVEL 3 - SECTOR B - (12)
BED UNIT


AF302B




A. REFER TO P00-00 FOR GENERAL PLUMBING NOTES AND SYMBOLS.

### **LEGEND NOTES**

- 2" GREASE WASTE FROM HAND SINK.
   4" GREASE WASTE FROM FLOOR SINK.
- 2" VENT UP.
- 4. 4" GREASE WASTE FROM FLOOR TROUGH. 4" VENT UP.
- 6. 3" SANITARY FROM FUNNEL FLOOR DRAIN. UPTO FCO.
- 8. 2" GREASE WASTE FROM DISPOSER. 9. 3" GREASE WASTE FROM TROUGHVEYOR.
- 10. 3" GREASE WASTE FROM MOP SINK. 11. 4" SANITARY FROM WATER CLOSET.
- 12. 2" SANITARY FROM LAVATORY.

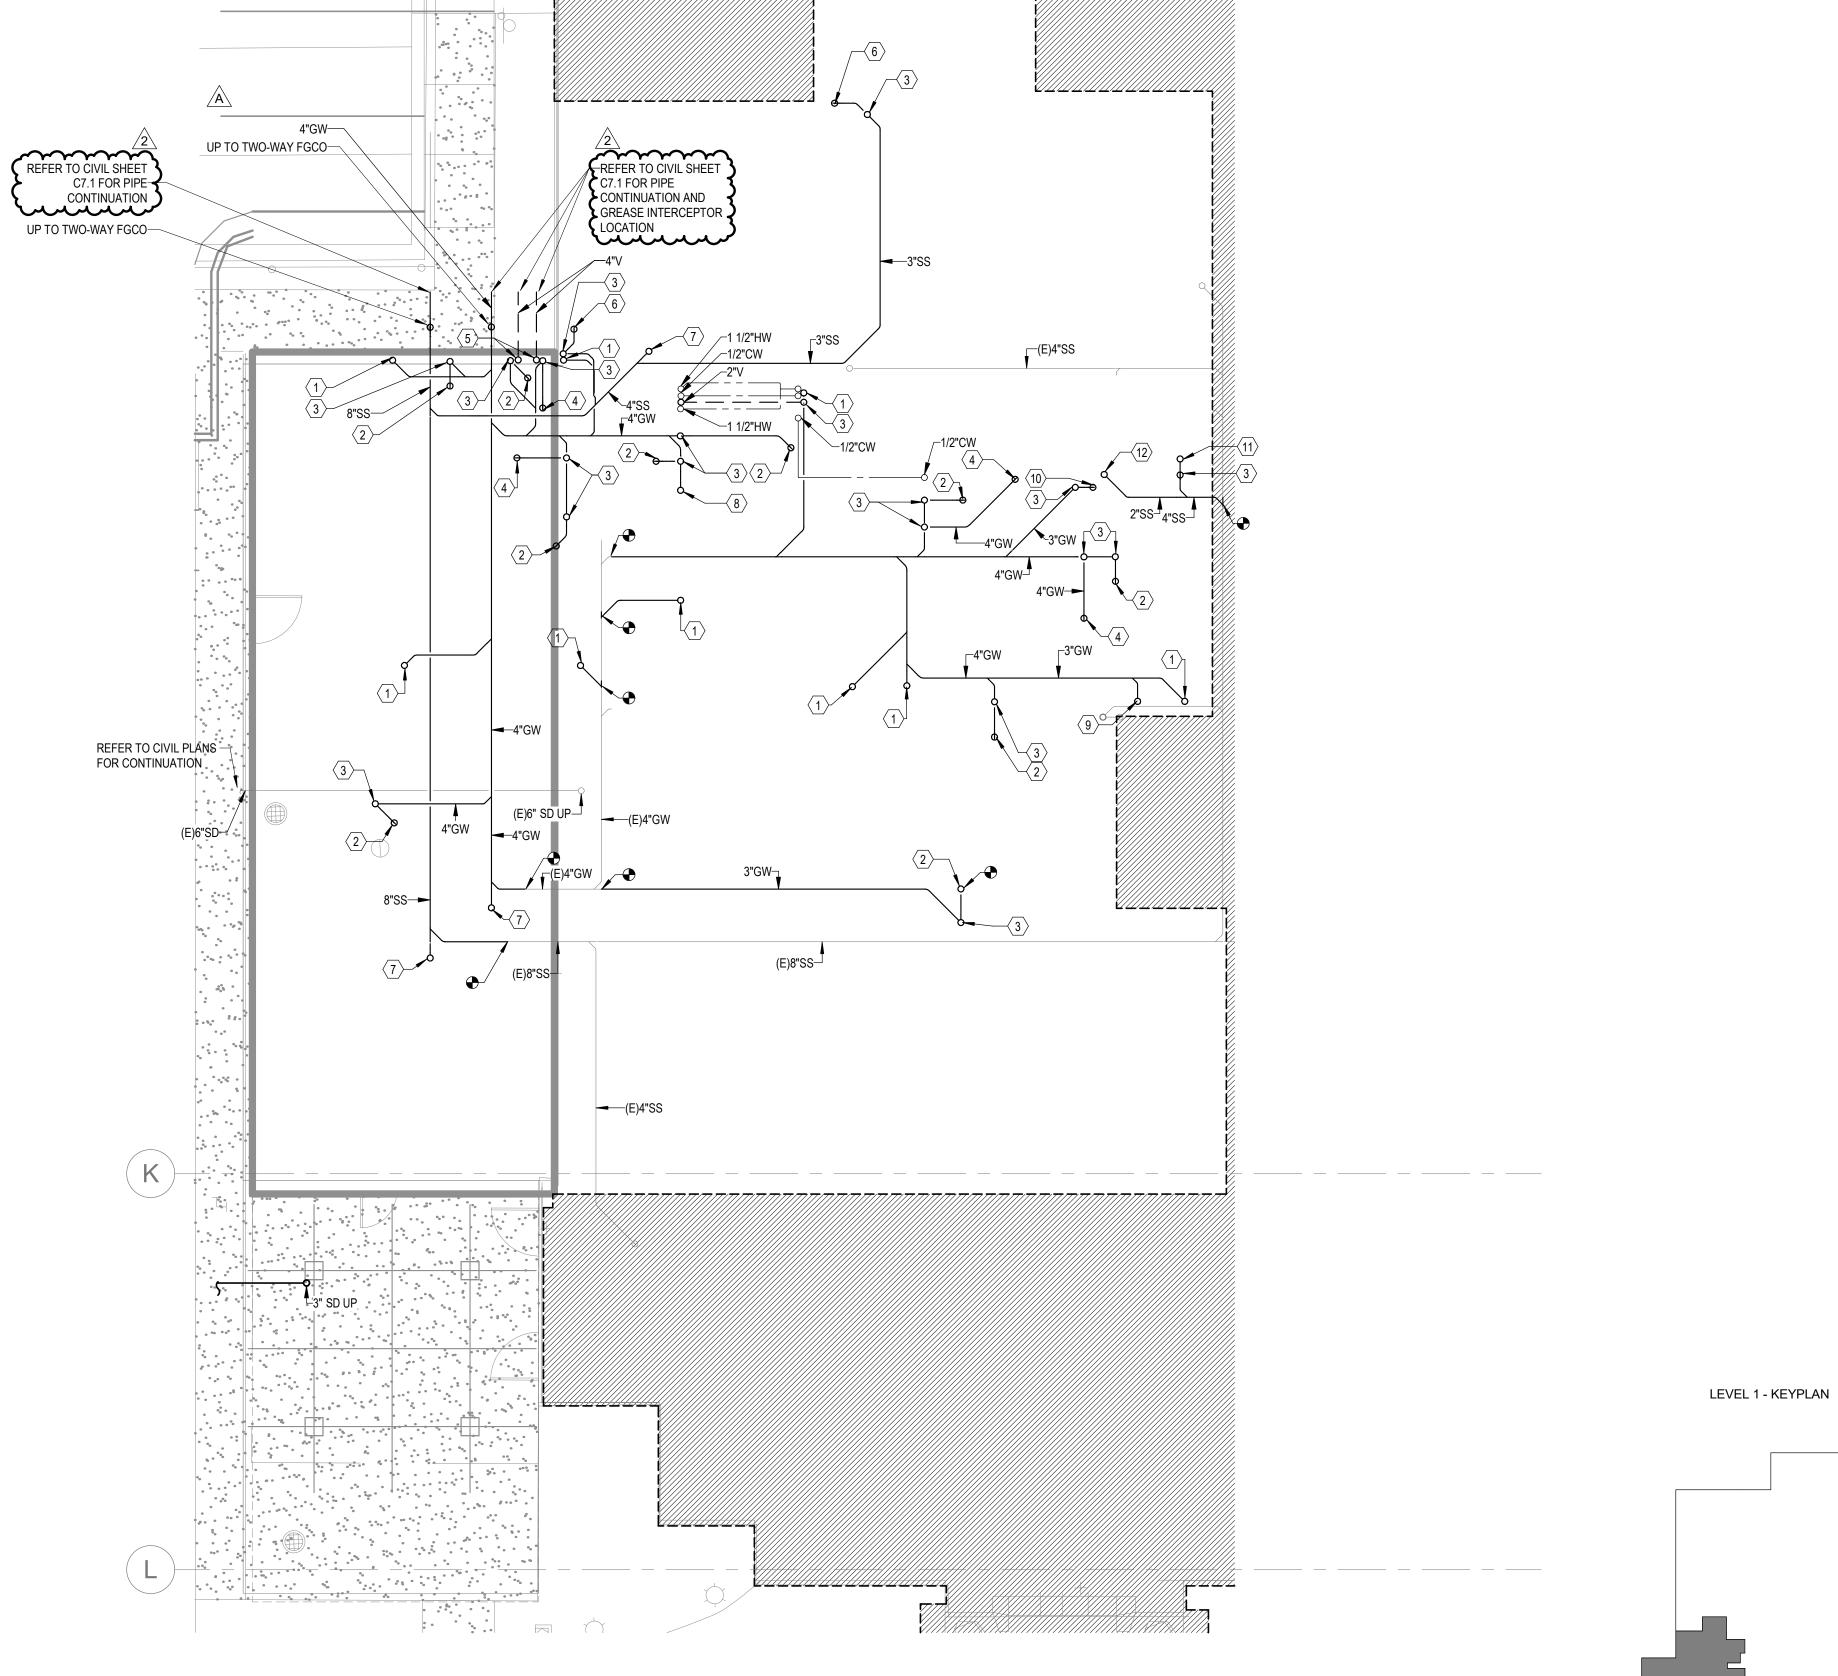

1 UNDERFLOOR PLAN - SECTOR A PLUMBING 1/8" = 1'-0"

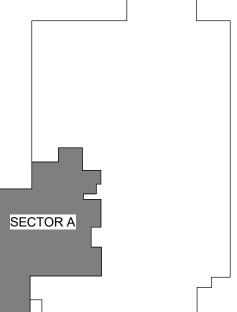




Devenney Group Ltd., Architects

6900 East Camelback Road Suite 500 Scottsdale, AZ 85251 T: 602.943.8950

www.devenneygroup.com



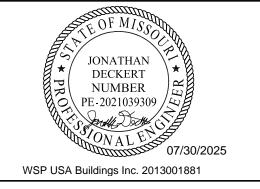

IF THESE PLANS DO NOT BEAR THE SEAL OF A REGISTRANT, THEY ARE TO BE CONSIDERED "PRELIMINARY" AND ARE NOT TO BE USED FOR CONSTRUCTION OR RECORDING. THESE PLANS ARE COPYRIGHTED AND ARE SUBJECT TO COPYRIGHT PROTECTION AS AN "ARCHITECTURAL WORK" UNDER SEC. 102 OF THE COPYRIGHT PROTECTION AS AN "ARCHITECTURAL WORK" UNDER SEC. 102 OF THE COPYRIGHT
ACT, 17 U.S.O. AS AMENDED DECEMBER 1990 AND KNOWN AS ARCHITECTURAL
WORKS COPYRIGHT PROTECTION ACT OF 1990. THE PROTECTION INCLUDES BUT IS
NOT LIMITED TO THE OVERALL FORM AS WELL AS THE ARRANGEMENT AND
COMPOSITION OF SPACES AND ELEMENTS OF THE DESIGN. UNDER SUCH
PROTECTION, UNAUTHORIZED USE OF THESE PLANS CAN LEGALLY RESULT IN THE
CESSATION OF CONSTRUCTION OR BUILDINGS BEING SEIZED AND/OR MONETARY
COMPENSATION TO DEVENNEY GROUP LTD.

## **INPATIENT BED EXPANSION**

HCA - LEE'S SUMMIT MEDICAL CENTER 2100 SE BLUE PKWY LEE'S SUMMIT, MO 64063

#### AUTHORITY HAVING JURISDICTION: CITY OF LEE'S SUMMIT BUILDING DEPT. MISSOURI DHSS

AUTHORITY HAVING JURISDICTION'S PROJECT NO:

FACILITY NUMBER: 0972400009

AGENCY APPROVALS:

| REVISIONS |                     |            |  |  |
|-----------|---------------------|------------|--|--|
| REV#      | DESCRIPTION         | DATE       |  |  |
| Α         | CITY - 2ND REVIEW   | 2025/02/06 |  |  |
| 2         | DESIGN COORDINATION | 2025/07/25 |  |  |

| -6,<br>6- |             |         |
|-----------|-------------|---------|
| - Lee     | DATE:       | 05/23/2 |
| CA        | SCALE:      | 1/8" =  |
| - HC/     | DRAWN:      |         |
| 106.24    | REVIEWED:   |         |
| 90:       | JOB NUMBER: | 640     |

UNDERFLOOR PLAN -PLUMBING

P02-00

A. REFER TO P00-00 FOR GENERAL PLUMBING NOTES AND SYMBOLS.

LEGEND NOTES


1. CONNECT COLD AND HOT WATER, VENT AND SANITARY LINES TO OWNER FURNISHED

1. CONNECT COLD AND HOT WATER, VENT AND SANITARY LINES TO OWNER FURNISHED lacksquare PREFABRICATED TOILET AND LAVATORY MODULES. CONTRACTOR TO FIELD COORDINATE EXACT CONNECTION POINTS AND PROVIDE ALL FITTINGS AND TRANSITIONS NECESSARY , TO COMPLETE THE SYSTEM. REFER TO THE PREFABRICATED MODULE'S DRAWINGS FOR FURTHER DETAILS.


2. AUTOMATIC BALANCING VALVE SET TO 1.25 GPM

3. AUTOMATIC BALANCING VALVE SET TO 5 GPM

B

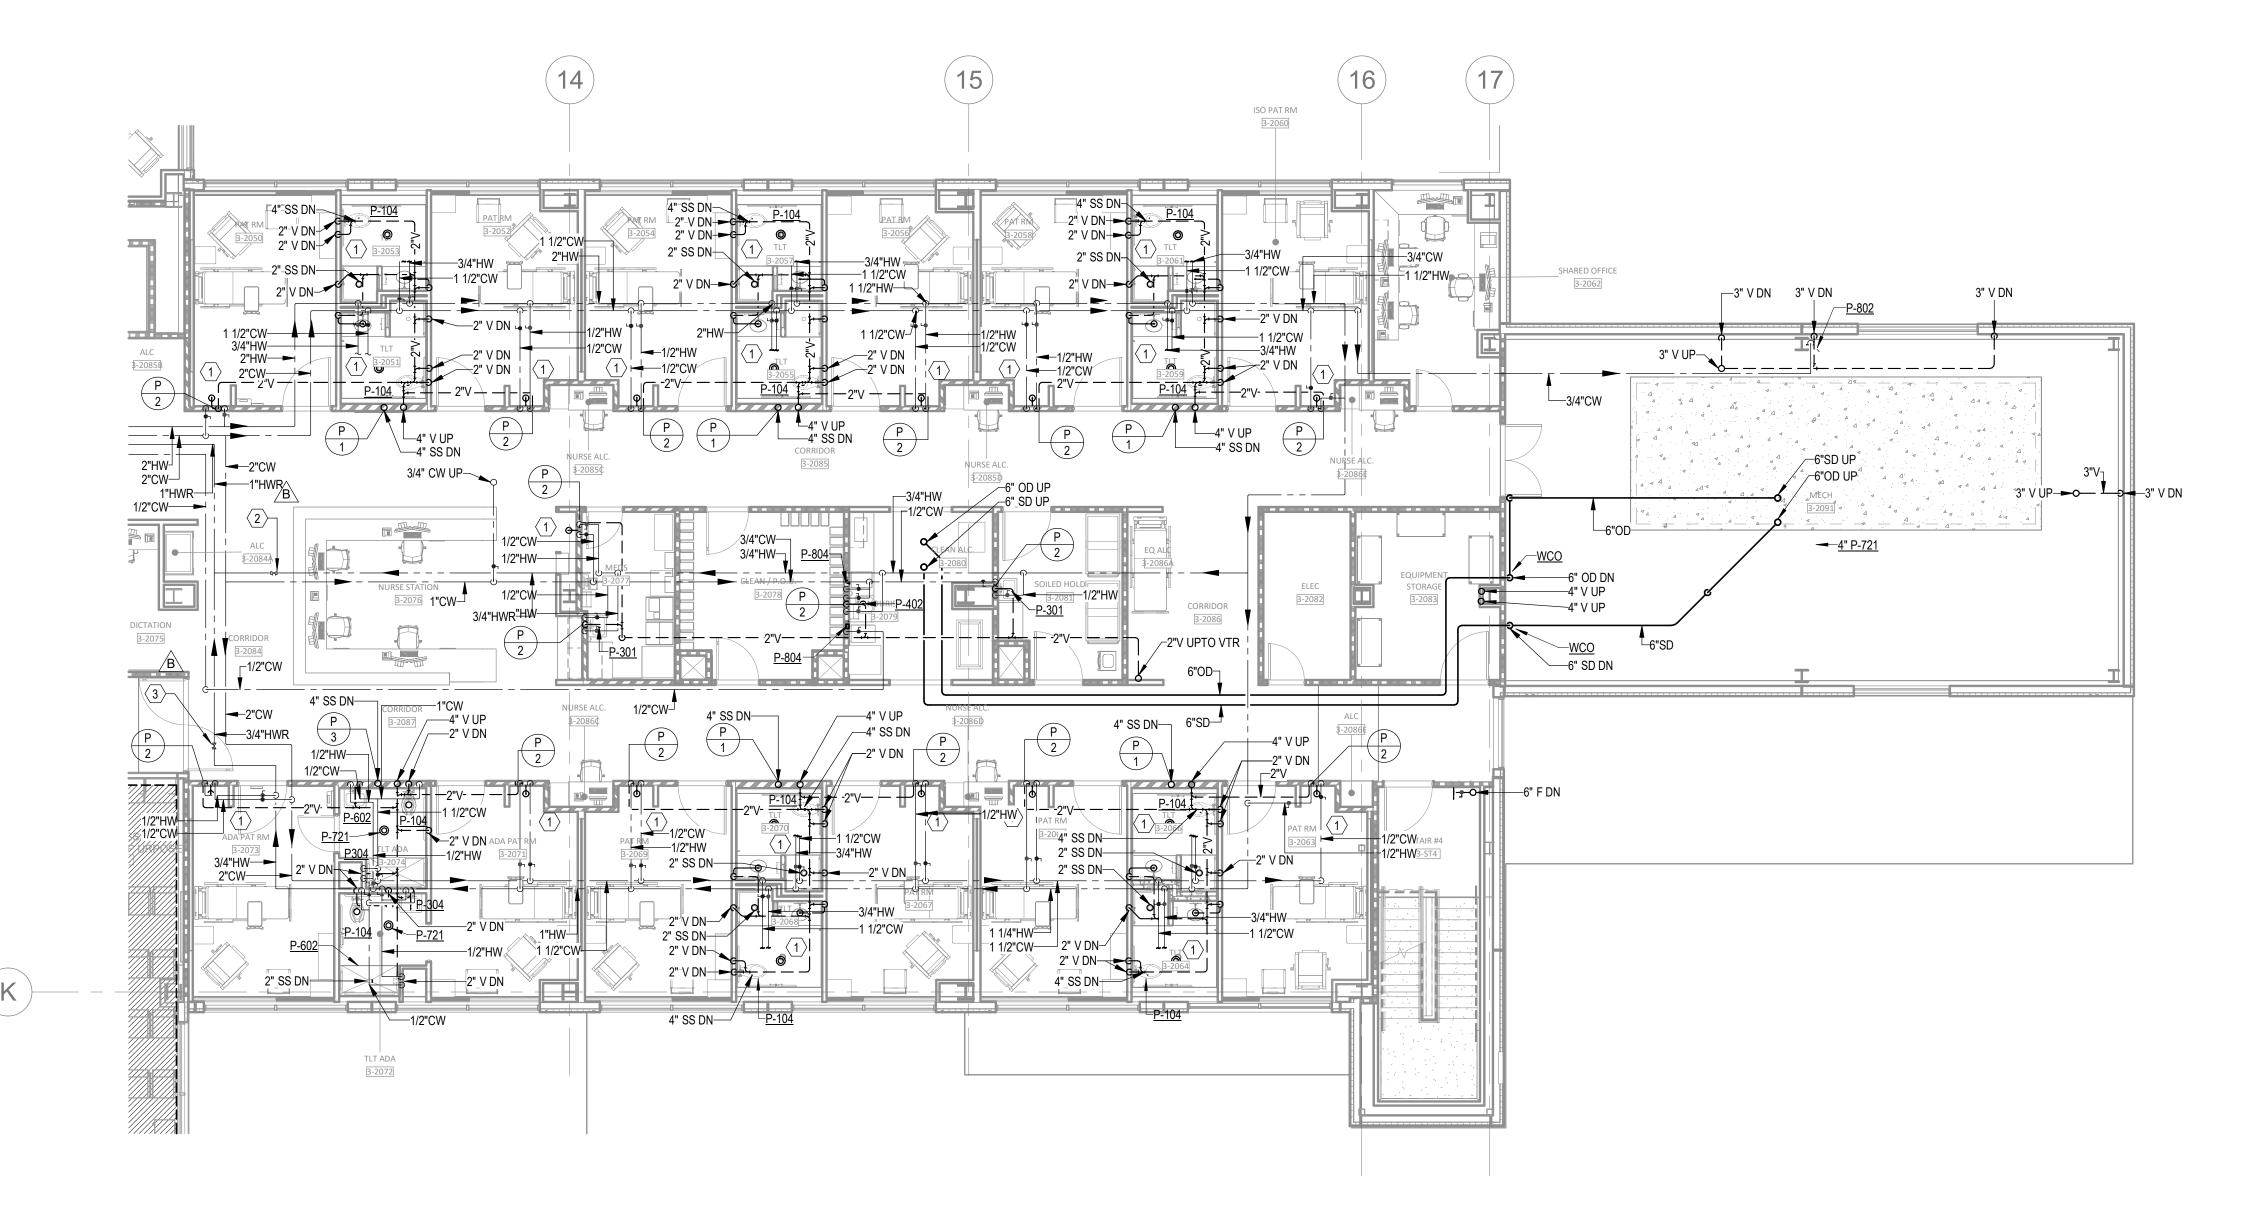

1 FLOOR PLAN - LEVEL 03 - SECTOR B PLUMBING 1/8" = 1'-0"

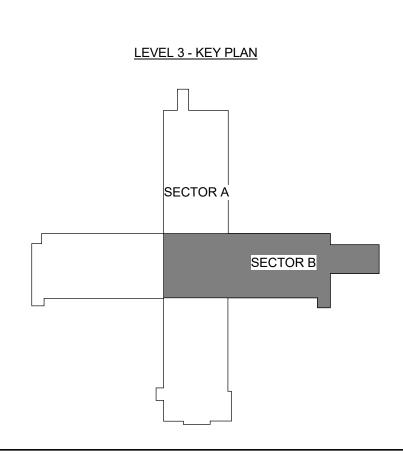




Devenney Group Ltd., Architects 6900 East Camelback Road Suite 500 Scottsdale, AZ 85251

T: 602.943.8950 www.devenneygroup.com



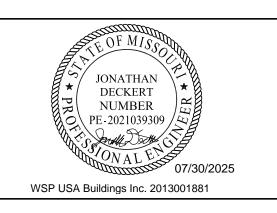

IF THESE PLANS DO NOT BEAR THE SEAL OF A REGISTRANT, THEY ARE TO BE CONSIDERED "PRELIMINARY" AND ARE NOT TO BE USED FOR CONSTRUCTION OR RECORDING. THESE PLANS ARE COPYRIGHTED AND ARE SUBJECT TO COPYRIGHT PROTECTION AS AN "ARCHITECTURAL WORK" UNDER SEC. 102 OF THE COPYRIGHT ACT, 17 U.S.O. AS AM "ARCHITECTURAL WORK" UNDER SEC. 102 OF THE COPYRIGHT

ACT, 17 U.S.O. AS AMENDED DECEMBER 1990 AND KNOWN AS ARCHITECTURAL

WORKS COPYRIGHT PROTECTION ACT OF 1990. THE PROTECTION INCLUDES BUT IS

NOT LIMITED TO THE OVERALL FORM AS WELL AS THE ARRANGEMENT AND

COMPOSITION OF SPACES AND ELEMENTS OF THE DESIGN. UNDER SUCH

PROTECTION, UNAUTHORIZED USE OF THESE PLANS CAN LEGALLY RESULT IN THE

COMPOSITION OF CONSTRUCTION OR BUILDINGS BEING SEIZED AND/OR MONETARY COMPENSATION TO DEVENNEY GROUP LTD.

## **INPATIENT BED EXPANSION**

HCA - LEE'S SUMMIT MEDICAL CENTER 2100 SE BLUE PKWY LEE'S SUMMIT, MO 64063

#### AUTHORITY HAVING JURISDICTION: CITY OF LEE'S SUMMIT BUILDING DEPT. MISSOURI DHSS

AUTHORITY HAVING JURISDICTION'S PROJECT NO:

FACILITY NUMBER: 0972400009

AGENCY APPROVALS:

|      | REVISIONS           |  |
|------|---------------------|--|
| REV# | DESCRIPTION         | DATE                                     |
| В    | DESIGN COORDINATION | 2025/02/06                               |
| 2    | DESIGN COORDINATION | 2025/07/25                               |
|      |                     |  |
|      |                     |  |
|      |                     |  |
|      | В                   | REV # DESCRIPTION  B DESIGN COORDINATION |

406.24 - HCA - Lee Scare:

A solution of the control of the contro 05/23/2025 1/8" = 1'-0"

> FLOOR PLAN - LEVEL 03 -SECTOR B - PLUMBING


> > P02-03B

- A. REFER TO M00-00 FOR GENERAL MECHANICAL NOTES AND
- B. CONTRACTOR TO VERIFY EXISTING CONDITIONS. EXISTING WORK SHOWN IS APPROXIMATE AND REPRESENTATIVE OF
- EXISTING DESIGN AND AS-BUILT DRAWINGS.
- C. PROVIDE REMOTE ADJUSTABLE DAMPERS FOR ANY BALANCING DAMPERS LOCATED ABOVE HARD CEILINGS.
- D. ACCESS PANELS TO BE PROVIDED FOR ANY MECHANICAL EQUIPMENT OR MECHANICAL DEVICES REQUIRING SERVICE
- LOCATED ABOVE HARD CEILINGS.


  E. CONTRACTOR SHALL PROVIDE TEMPORARY EXHAUST FANS FOR ALL EXHAUST SYSTEMS BEING MODIFIED BY THIS PROJECT. COORDINATE TEMPORARY EXHAUST, PHASING, AND ROOM SHUTDOWN REQUIREMENTS WITH OWNER.

### **LEGEND NOTES**

- 1. 14"x10" ISO EA DUCT UP TO IEF-02 ON ROOF.
- 24"x12" EA DUCT UP TO GEF-30 ON ROOF.
   CONNECT SUPPLY TO AIR DEVICE PROVIDED BY PRE-FABRICATED BATHROOM POD MANUFACTURER.
- CONNECT EXHAUST TO AIR DEVICE PROVIDED BY PRE-FABRICATED BATHROOM POD MANUFACTURER.
- 5. 18"x18" EA DUCT UP TO GEF-13 ON ROOF.
- 6. 16"x16" EA DUCT UP TO GEF-1 ON ROOF.7. 26"x18" EA DUCT UP TO GEF-2 ON ROOF.
- 8. PROVIDE SOUND LAGGING FOR 15' OF HORIZONTAL DUCT AND VERTICAL DUCT UP TO EXHAUST FAN AS SHOWN WITH DASHED LINE. REFER TO DETAIL 01/M07-02.
- 9. PROVIDE SOUND LAGGING FOR 25' OF HORIZONTAL DUCT AND VERTICAL DUCT DOWN
  TO AHU AS SHOWN WITH DASHED LINE.

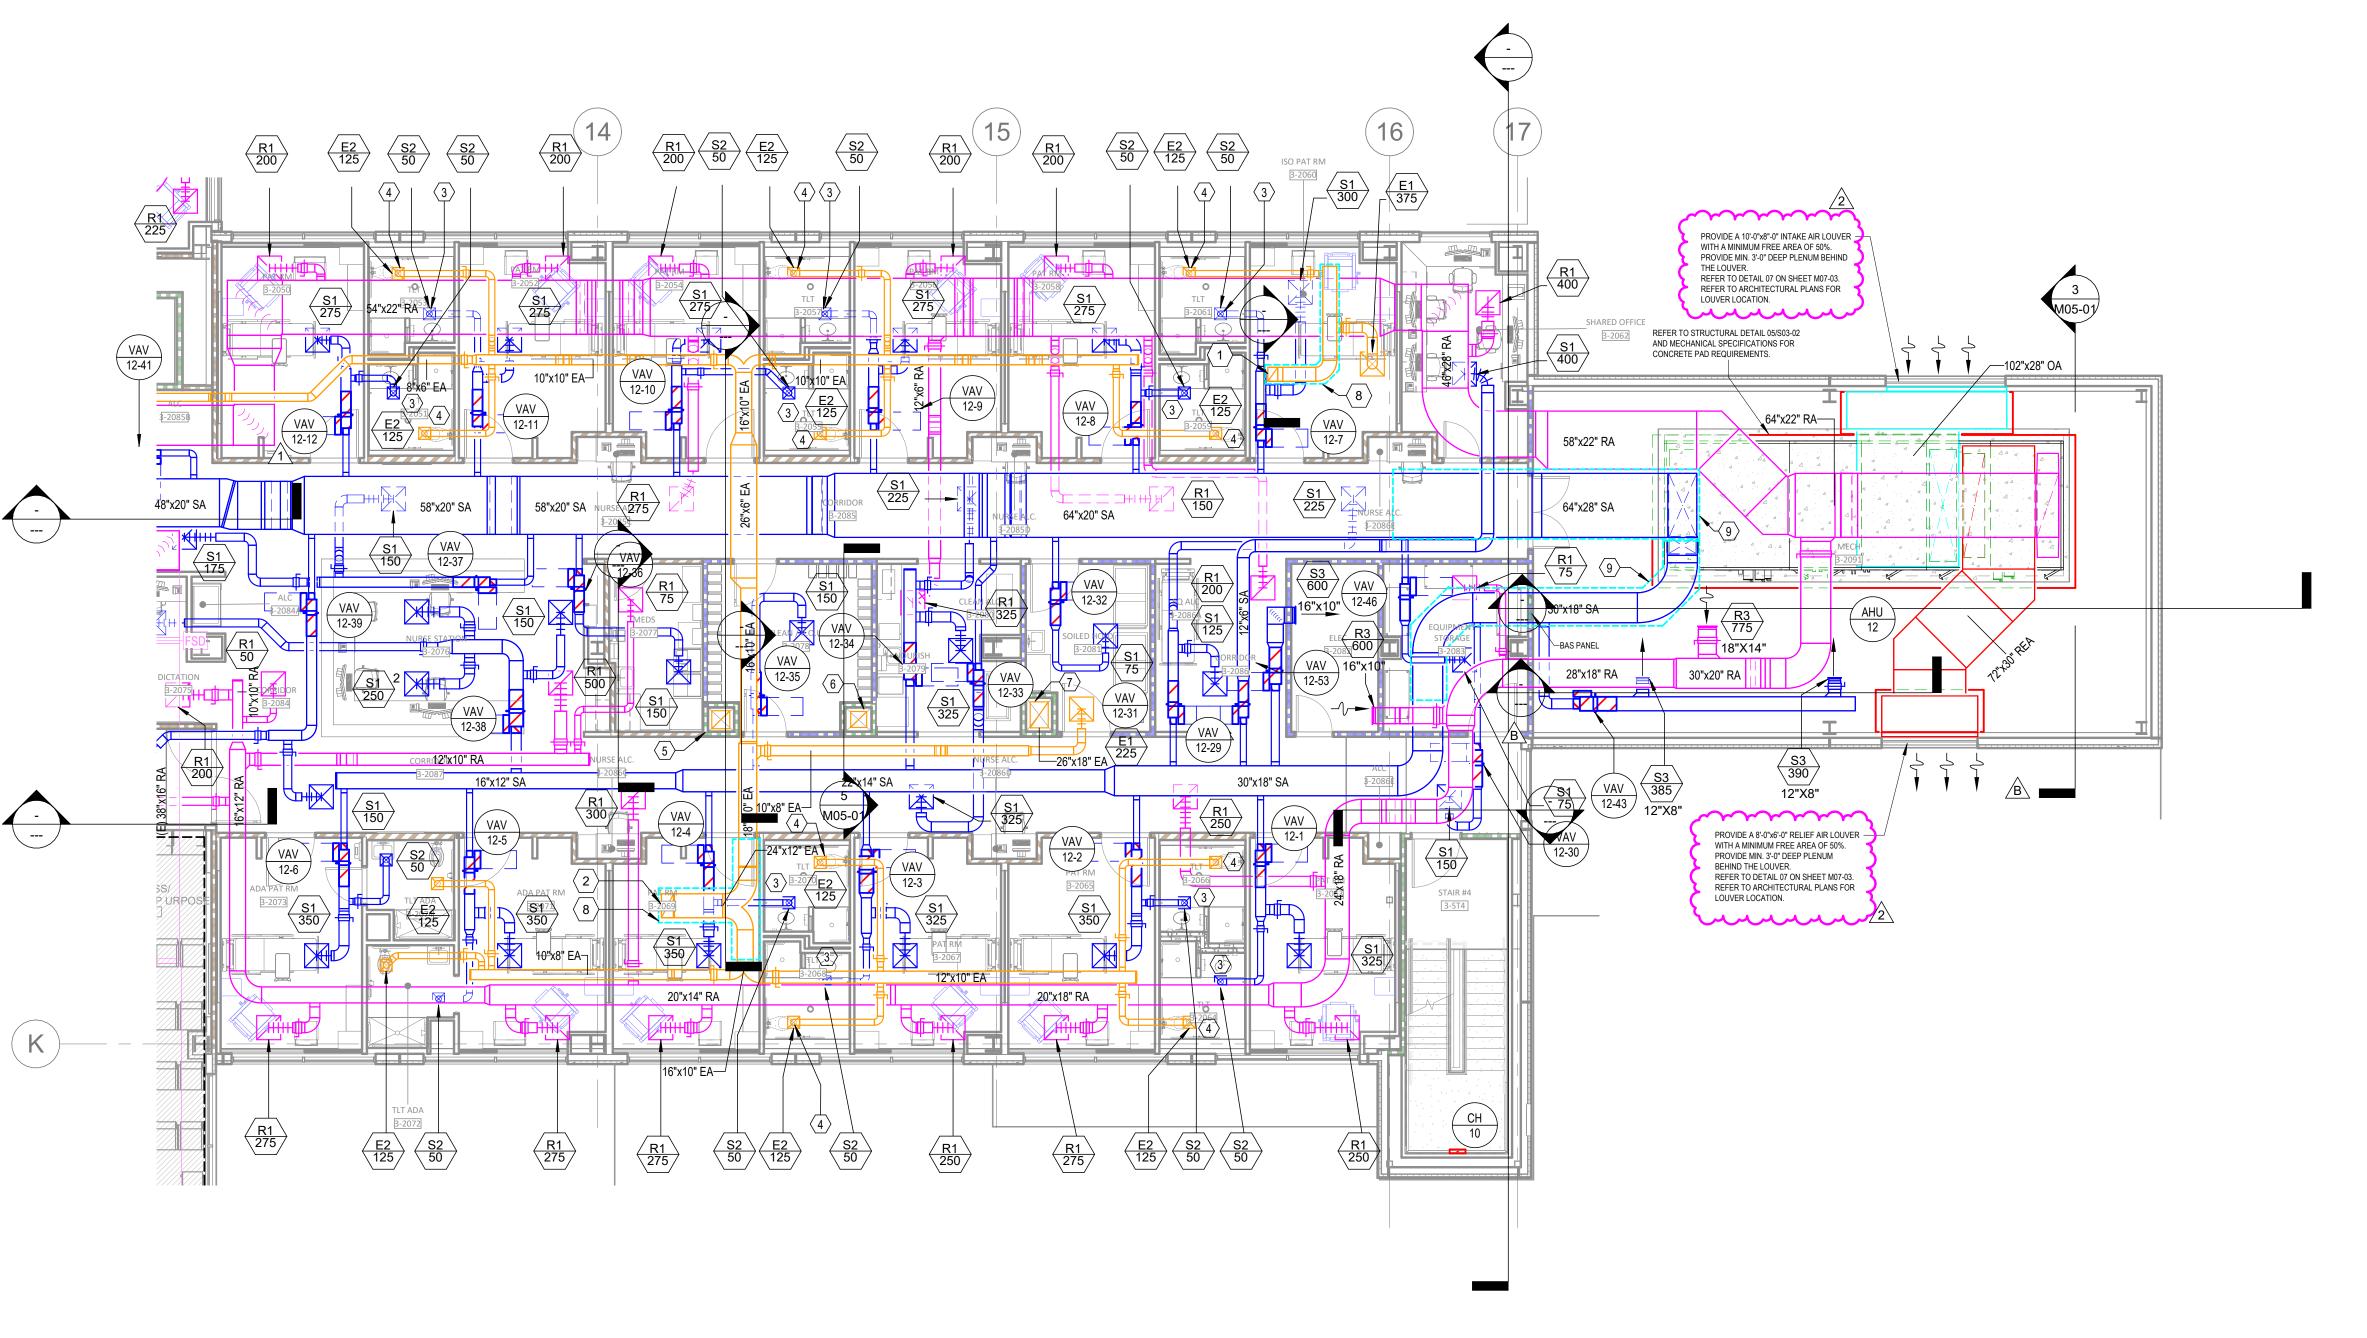

1 FLOOR PLAN - LEVEL 03 - SECTOR B HVAC 1/8" = 1'-0"

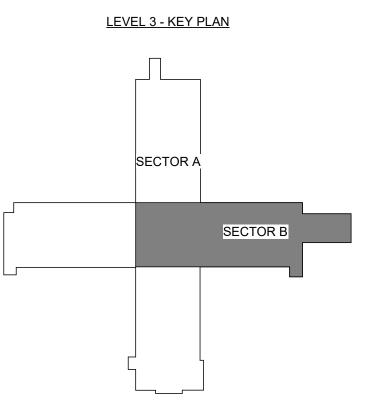




Devenney Group Ltd., Architects

6900 East Camelback Road

Suite 500 Scottsdale, AZ 85251 T: 602.943.8950

www.devenneygroup.com



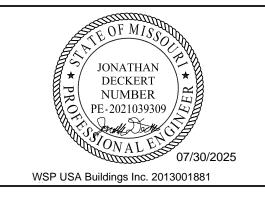

IF THESE PLANS DO NOT BEAR THE SEAL OF A REGISTRANT, THEY ARE TO BE
CONSIDERED "PRELIMINARY" AND ARE NOT TO BE USED FOR CONSTRUCTION OR
RECORDING. THESE PLANS ARE COPYRIGHTED AND ARE SUBJECT TO COPYRIGHT
PROTECTION AS AN "ARCHITECTURAL WORK" UNDER SEC. 102 OF THE COPYRIGHT
ACT, 17 U.S.O. AS AMENDED DECEMBER 1990 AND KNOWN AS ARCHITECTURAL
WORKS COPYRIGHT PROTECTION ACT OF 1990. THE PROTECTION INCLUDES BUT IS
NOT LIMITED TO THE OVERALL FORM AS WELL AS THE ARRANGEMENT AND
COMPOSITION OF SPACES AND ELEMENTS OF THE DESIGN. UNDER SUCH
PROTECTION, UNAUTHORIZED USE OF THESE PLANS CAN LEGALLY RESULT IN THE
CESSATION OF CONSTRUCTION OR BUILDINGS BEING SEIZED AND/OR MONETARY
COMPENSATION TO DEVENNEY GROUP LTD.

# INPATIENT BED EXPANSION

HCA - LEE'S SUMMIT MEDICAL CENTER 2100 SE BLUE PKWY LEE'S SUMMIT, MO 64063

## AUTHORITY HAVING JURISDICTION: CITY OF LEE'S SUMMIT BUILDING DEPT. MISSOURI DHSS

AUTHORITY HAVING JURISDICTION'S PROJECT NO:

FACILITY NUMBER: **0972400009** 

AGENCY APPROVALS:

| Med Surg & Dietery Ex |           |                     |            |  |
|-----------------------|-----------|---------------------|------------|--|
|                       | REVISIONS |                     |            |  |
|                       | REV#      | DESCRIPTION         | DATE       |  |
|                       | В         | DESIGN COORDINATION | 2025/02/06 |  |
|                       | 1         | DESIGN COORDINATION | 2025/06/06 |  |
|                       | 2         | DESIGN COORDINATION | 2025/07/25 |  |

|  | υ.      |             |           |
|--|---------|-------------|-----------|
|  | - Le    | DATE:       | 05/23/20  |
|  | ℴ       | SCALE:      | 1/8" = 1' |
|  | - HC    | DRAWN:      | 1         |
|  | 24      | REVIEWED:   |           |
|  | 3406.24 | JOB NUMBER: | 6406      |
|  | 5,      |             |           |

FLOOR PLAN - LEVEL 03 - SECTOR B HVAC

M02-03B

- A. REFER TO M00-00 FOR GENERAL MECHANICAL NOTES, SYMBOLS AND LEGENDS.
   B. ALL EXISTING CONDITIONS INDICATED ON THESE DRAWINGS ARE BASED UPON A
- COMBINATION OF AVAILABLE RECORD DESIGN AND AS-BUILT DOCUMENTS.


  C. PROVIDE CEILING ACCESS PANELS FOR ALL EQUIPMENT, COILS, ETC. THAT ARE LOCATED ABOVE HARD CEILINGS UNLESS NOTED OTHERWISE.

### **LEGEND NOTES**


- CALIBRATED ORIFICE BALANCING VALVE BALANCED TO GPM INDICATED.
   ROOM DIFFERENTIAL PRESSURE SENSOR AND MONITOR. SENSOR SHALL BE PLACED ABOVE THE DOOR AND MONITOR SHALL BE PLACED 48 "ABOVE FINISHED FLOOR. SYSTEM COMPONENTS SHALL INCLUDE THE FOLLOWING: PRESSURE SENSORS,
- 6" CHS/R PIPING FROM FLOOR BELOW. VALVE & CAP PIPING BELOW ROOF FOR FUTURE USE.
   4" HWS/R PIPING FROM FLOOR BELOW VALVE & CAP PIPING BELOW ROOF FOR FUTURE

PRESSURE MONITOR, PRESSURE CABLE, TRANSFORMER CABLE AND TRANSFORMER.

- 4" HWS/R PIPING FROM FLOOR BELOW. VALVE & CAP PIPING BELOW ROOF FOR FUTURE USE.
   1" HPS AND 1-1/2" HPCR FROM FLOOR BELOW. VALVE & CAP PIPING BELOW ROOF FOR
- 6. PROVIDE EPO SWITCH FOR NEW AHU-12. 2
- 8. TERMINATE AND AIR GAP CONDENSATE ABOVE FLOOR SINK LOCATED IN MECH ROOM
- 3-2091.
  9. PROVIDE PRV FOR STEAM LINE SERVING HUMIDIFCATION SECTION. REFER TO DETAIL
- DIFFERENTIAL PRESSURE CONTROL STATION BALANCED TO GPM INDICATED. REFER TO DETAIL 05/M07-03.
- 11. PROVIDE 3-WAY CONTROL VALVE FOR VAV AT THE END OF THE PIPING RUN.

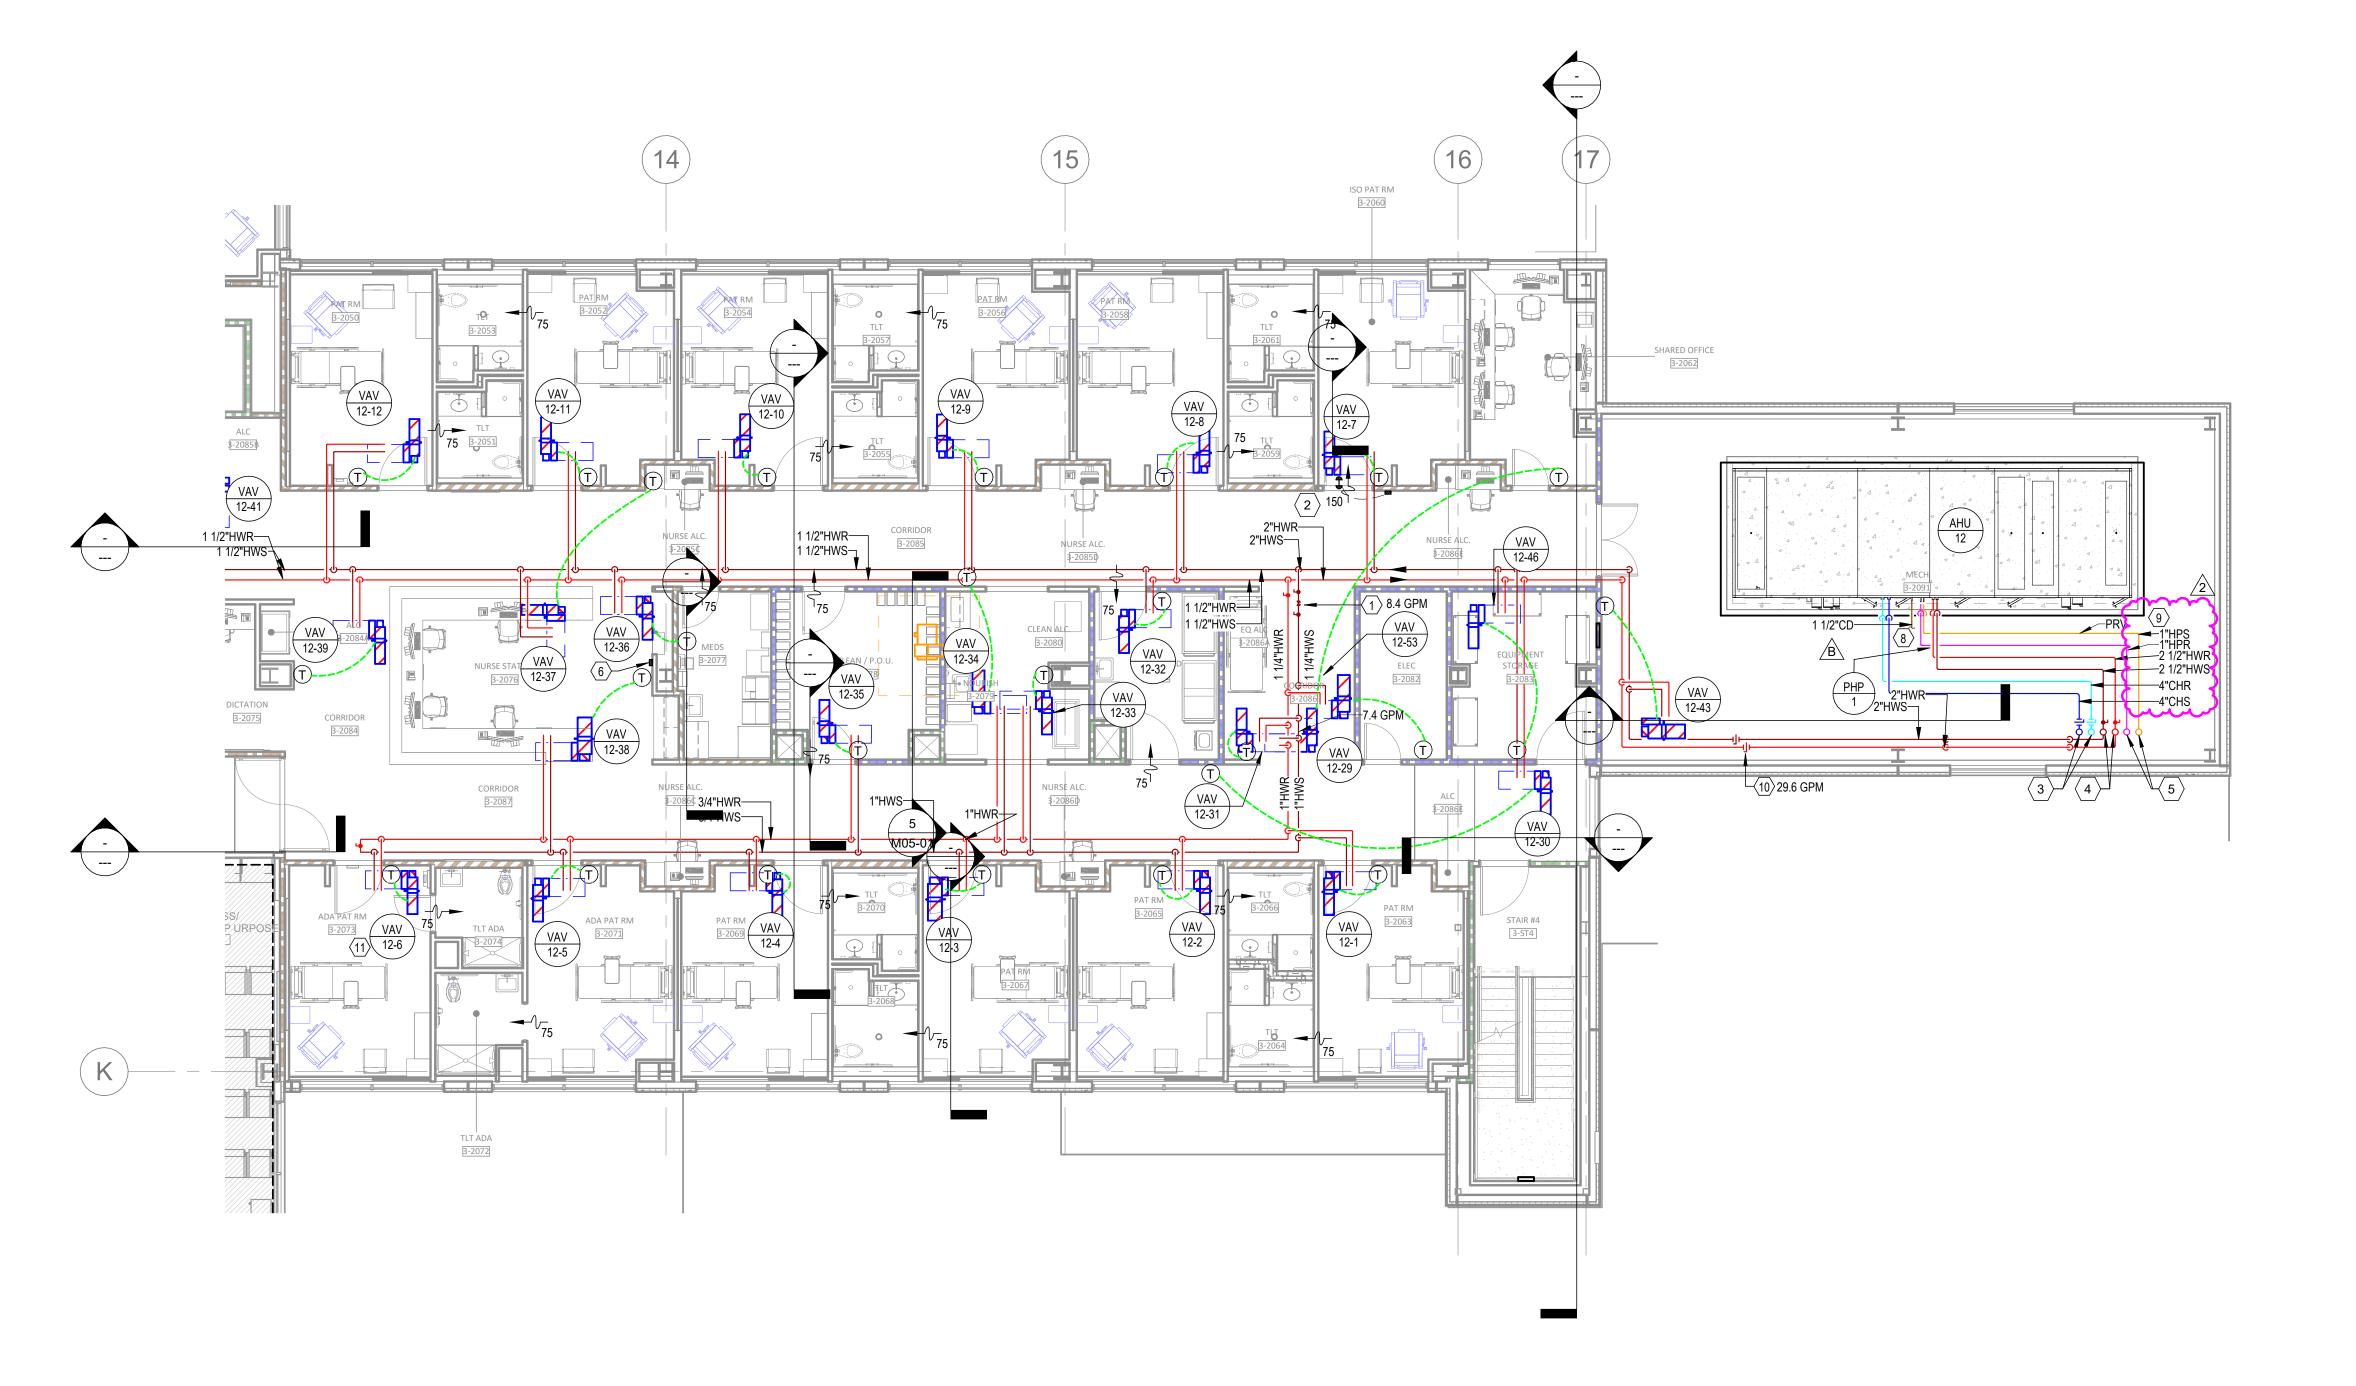

1) FLOOR PLAN - LEVEL 03 - SECTOR B HVAC PIPING 1/8" = 1'-0"

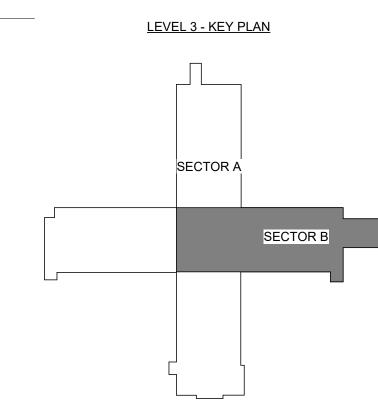



Devenney Group Ltd., Architects


GROUP

6900 East Camelback Road Suite 500 Scottsdale, AZ 85251

T: 602.943.8950

www.devenneygroup.com



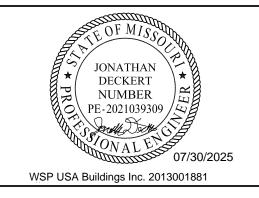

IF THESE PLANS DO NOT BEAR THE SEAL OF A REGISTRANT, THEY ARE TO BE CONSIDERED "PRELIMINARY" AND ARE NOT TO BE USED FOR CONSTRUCTION OR RECORDING. THESE PLANS ARE COPYRIGHTED AND ARE SUBJECT TO COPYRIGHT PROTECTION AS AN "ARCHITECTURAL WORK" UNDER SEC. 102 OF THE COPYRIGHT ACT, 17 U.S.O. AS AMENDED DECEMBER 1990 AND KNOWN AS ARCHITECTURAL WORKS COPYRIGHT PROTECTION ACT OF 1990. THE PROTECTION INCLUDES BUT IS NOT LIMITED TO THE OVERALL FORM AS WELL AS THE ARRANGEMENT AND COMPOSITION OF SPACES AND ELEMENTS OF THE DESIGN. UNDER SUCH PROTECTION, UNAUTHORIZED USE OF THESE PLANS CAN LEGALLY RESULT IN THE CESSATION OF CONSTRUCTION OR BUILDINGS BEING SEIZED AND/OR MONETARY COMPENSATION TO DEVENNEY GROUP LTD.

# INPATIENT BED EXPANSION

HCA - LEE'S SUMMIT MEDICAL CENTER 2100 SE BLUE PKWY LEE'S SUMMIT, MO 64063

AUTHORITY HAVING JURISDICTION:
CITY OF LEE'S SUMMIT BUILDING DEPT.
MISSOURI DHSS

AUTHORITY HAVING JURISDICTION'S PROJECT NO:

FACILITY NUMBER: **0972400009** 

AGENCY APPROVALS:

REVISIONS

REV # DESCRIPTION DATE


B DESIGN COORDINATION 2025/02/06

2 DESIGN COORDINATION 2025/07/25

| DATE: 05/23/2025 | SCALE: 1/8" = 1'-0" | DRAWN: HO | REVIEWED: JD | JOB NUMBER: 6406.24

FLOOR PLAN - LEVEL 03 - SECTOR B HVAC PIPING

M03-03B

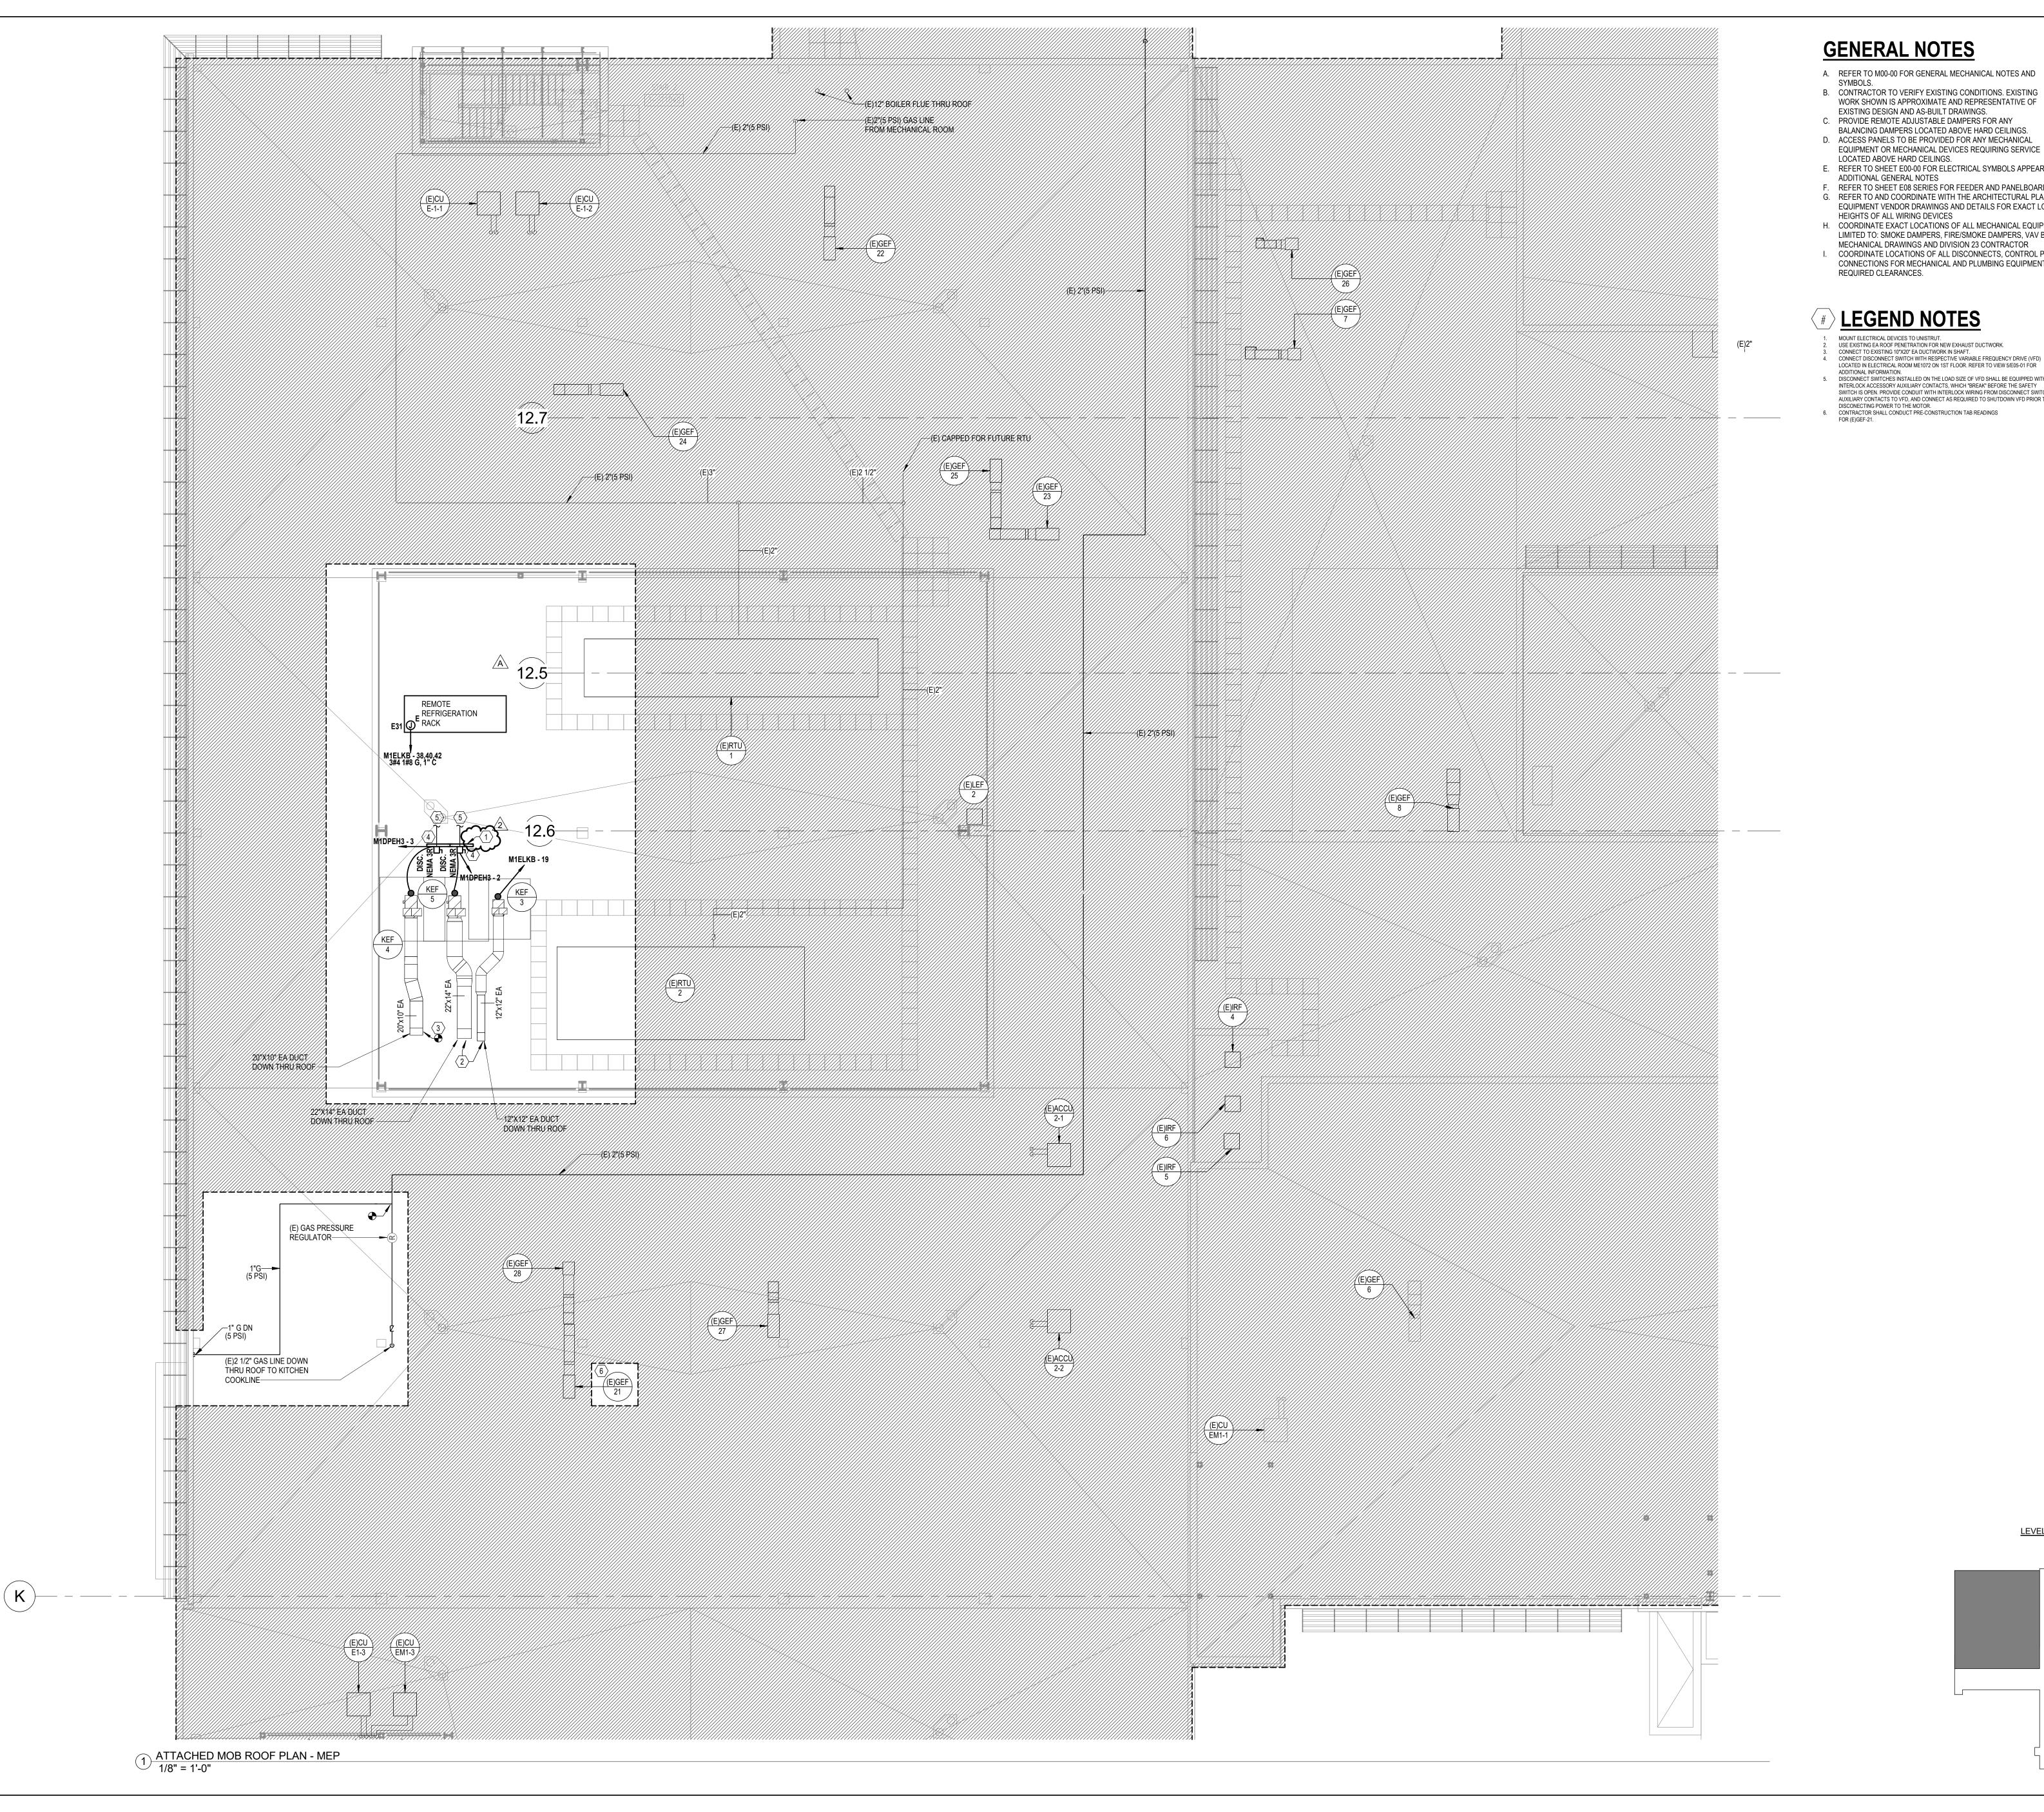

- A. REFER TO M00-00 FOR GENERAL MECHANICAL NOTES AND SYMBOLS.
- B. CONTRACTOR TO VERIFY EXISTING CONDITIONS. EXISTING WORK SHOWN IS APPROXIMATE AND REPRESENTATIVE OF
- EXISTING DESIGN AND AS-BUILT DRAWINGS.
- C. PROVIDE REMOTE ADJUSTABLE DAMPERS FOR ANY BALANCING DAMPERS LOCATED ABOVE HARD CEILINGS. D. ACCESS PANELS TO BE PROVIDED FOR ANY MECHANICAL
- LOCATED ABOVE HARD CEILINGS. E. REFER TO SHEET E00-00 FOR ELECTRICAL SYMBOLS APPEARING ON THIS SHEET AND
- ADDITIONAL GENERAL NOTES F. REFER TO SHEET E08 SERIES FOR FEEDER AND PANELBOARD SCHEDULES.
- G. REFER TO AND COORDINATE WITH THE ARCHITECTURAL PLANS, ELEVATIONS, EQUIPMENT VENDOR DRAWINGS AND DETAILS FOR EXACT LOCATIONS AND MOUNTING
- HEIGHTS OF ALL WIRING DEVICES H. COORDINATE EXACT LOCATIONS OF ALL MECHANICAL EQUIPMENT, INCLUDING BUT NOT LIMITED TO: SMOKE DAMPERS, FIRE/SMOKE DAMPERS, VAV BOXES, FCU'S, ETC. WITH
- I. COORDINATE LOCATIONS OF ALL DISCONNECTS, CONTROL PANELS, AND ELECTRICAL CONNECTIONS FOR MECHANICAL AND PLUMBING EQUIPMENT TO MAINTAIN NEC REQUIRED CLEARANCES.

### **LEGEND NOTES**

- 1. MOUNT ELECTRICAL DEVICES TO UNISTRUT.
  2. USE EXISTING EA ROOF PENETRATION FOR NEW EXHAUST DUCTWORK.
  3. CONNECT TO EXISTING 10"X20" EA DUCTWORK IN SHAFT.
  4. CONNECT DISCONNECT SWITCH WITH RESPECTIVE VARIABLE FREQUENCY DRIVE (VFD) LOCATED IN ELECTRICAL ROOM ME1072 ON 1ST FLOOR. REFER TO VIEW 5/E05-01 FOR ADDITIONAL INFORMATION.
  5. DISCONNECT SWITCHES INSTALLED ON THE LOAD SIZE OF VFD SHALL BE EQUIPPED WITH INTERLOCK ACCESSORY AUXILIARY CONTACTS, WHICH "BREAK" BEFORE THE SAFETY SWITCH IS OPEN. PROVIDE CONDUIT WITH INTERLOCK WIRING FROM DISCONNECT SWITCH AUXILIARY CONTACTS TO VFD, AND CONNECT AS REQUIRED TO SHUTDOWN VFD PRIOR TO DISCONECTING POWER TO THE MOTOR.

- DISCONECTING POWER TO THE MOTOR.

  6. CONTRACTOR SHALL CONDUCT PRE-CONSTRUCTION TAB READINGS FOR (E)GEF-21.



Devenney

GROU

Devenney Group Ltd., Architects


6900 East Camelback Road

www.devenneygroup.com

Scottsdale, AZ 85251

T: 602.943.8950

Suite 500

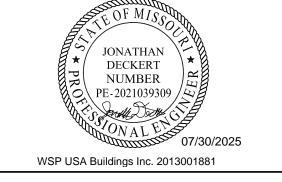

IF THESE PLANS DO NOT BEAR THE SEAL OF A REGISTRANT, THEY ARE TO BE F THESE PLANS DO NOT BEAR THE SEAL OF A REGISTRANT, THEY ARE TO BE
CONSIDERED "PRELIMINARY" AND ARE NOT TO BE USED FOR CONSTRUCTION OR
RECORDING. THESE PLANS ARE COPYRIGHTED AND ARE SUBJECT TO COPYRIGHT
PROTECTION AS AN "ARCHITECTURAL WORK" UNDER SEC. 102 OF THE COPYRIGHT
ACT, 17 U.S.O. AS AMENDED DECEMBER 1990 AND KNOWN AS ARCHITECTURAL
WORKS COPYRIGHT PROTECTION ACT OF 1990. THE PROTECTION INCLUDES BUT IS
NOT LIMITED TO THE OVERALL FORM AS WELL AS THE ARRANGEMENT AND
COMPOSITION OF SPACES AND ELEMENTS OF THE DESIGN. UNDER SUCH
PROTECTION, UNAUTHORIZED USE OF THESE PLANS CAN LEGALLY RESULT IN THE
CESSATION OF CONSTRUCTION OR BUILDINGS BEING SEIZED AND/OR MONETARY CESSATION OF CONSTRUCTION OR BUILDINGS BEING SEIZED AND/OR MONETARY COMPENSATION TO DEVENNEY GROUP LTD.

## **INPATIENT BED EXPANSION**

HCA - LEE'S SUMMIT MEDICAL CENTER 2100 SE BLUE PKWY LEE'S SUMMIT, MO 64063

AUTHORITY HAVING JURISDICTION: CITY OF LEE'S SUMMIT BUILDING DEPT. MISSOURI DHSS

AUTHORITY HAVING JURISDICTION'S PROJECT NO:

FACILITY NUMBER: 0972400009

AGENCY APPROVALS:

REVISIONS DESCRIPTION DATE ໝ REV# 2025/02/06 CITY - 2ND REVIEW

DESIGN COORDINATION

2025/07/25

1/8" = 1'-0"

6406.24

DATE:
SCALE:
DRAWN:
REVIEWED:

JOB NUMBER:

LEVEL 3 - KEY PLAN

ATTACHED MOB ROOF PLAN