

RELEASED FOR CONSTRUCTION  
As Noted on Plan Review

Development Services Department  
Lee's Summit, Missouri  
09/11/2025

REFERENCE G-003 FOR GENERAL NOTES

MATERIAL LEGEND

- MA-1 - STONE - ROCK FACE, SILVERCREEK
- MA-2 - STONE SILL - SMOOTH FACE
- BR-1 - BRICK - RED, WILLIAMSBURG CHERRY CREEK
- BR-3 - BRICK - GREY
- EIFS-1 - TAN
- MTL-1 - METAL - DARK BRONZE
- STCO - STUCCO - COLOR TO MATCH STONE
- BRICK RELIEF ANGLE LOCATION

PRINTS ISSUED

04/17/2024 - CITY SUBMISSION


REVISIONS:

11 09/04/2025 ASI #2.8


rosemann & ASSOCIATES P.C.

ARCHITECTURE  
INTERIOR DESIGN  
ENGINEERING  
PLANNING  
1526 Grand Boulevard  
Kansas City, MO 64108-1404  
P: 816.472.1448  
W: www.rosemann.com  
© 2024 Rosemann & Associates, P.C.

DENVER ▲ KANSAS CITY ▲ ST. LOUIS ▲ ATLANTA

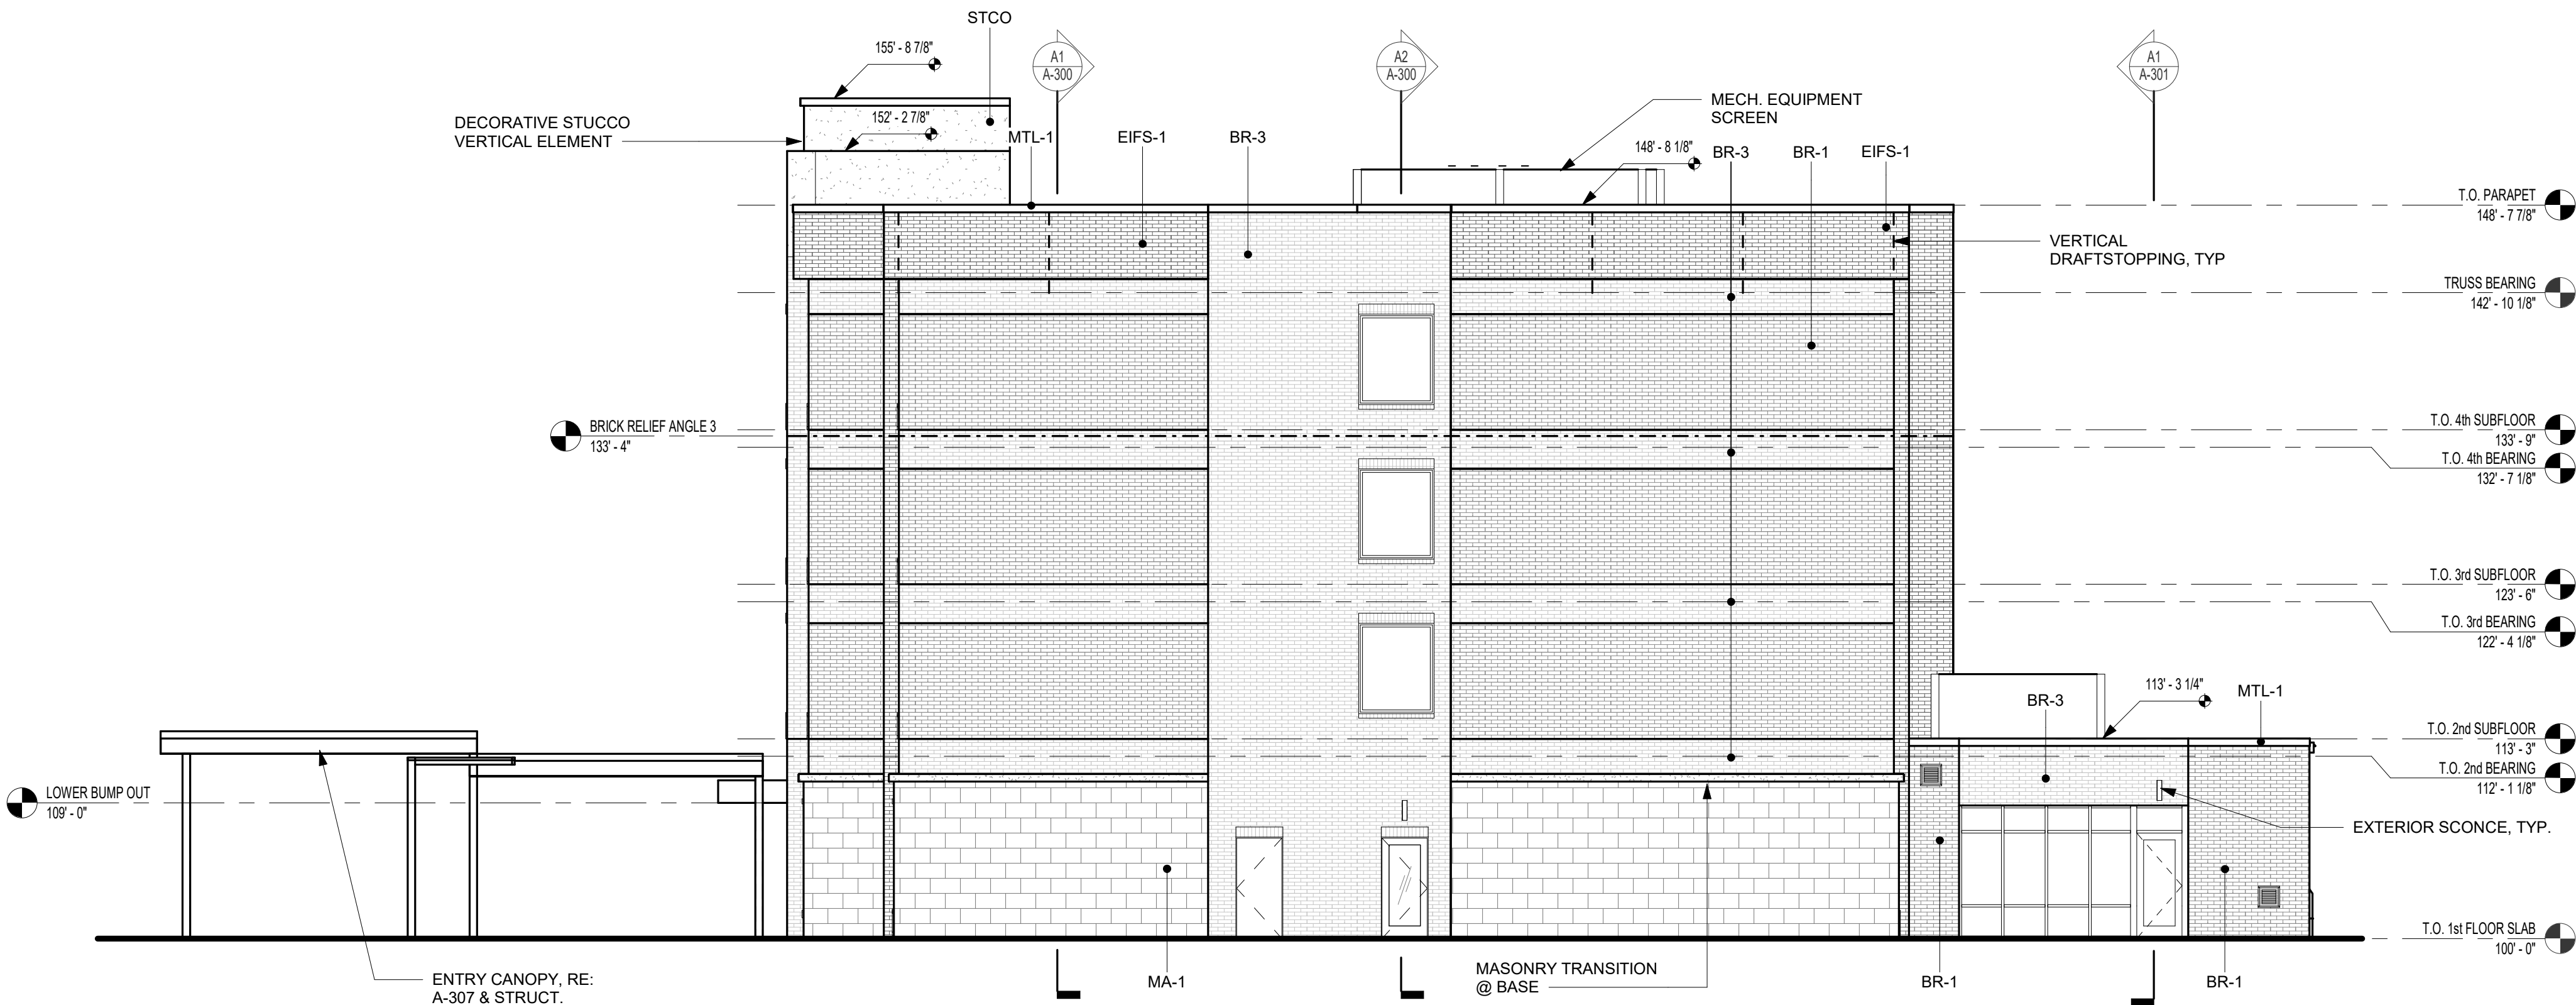

A2 SIDE ELEVATION  
1/8" = 1'-0"

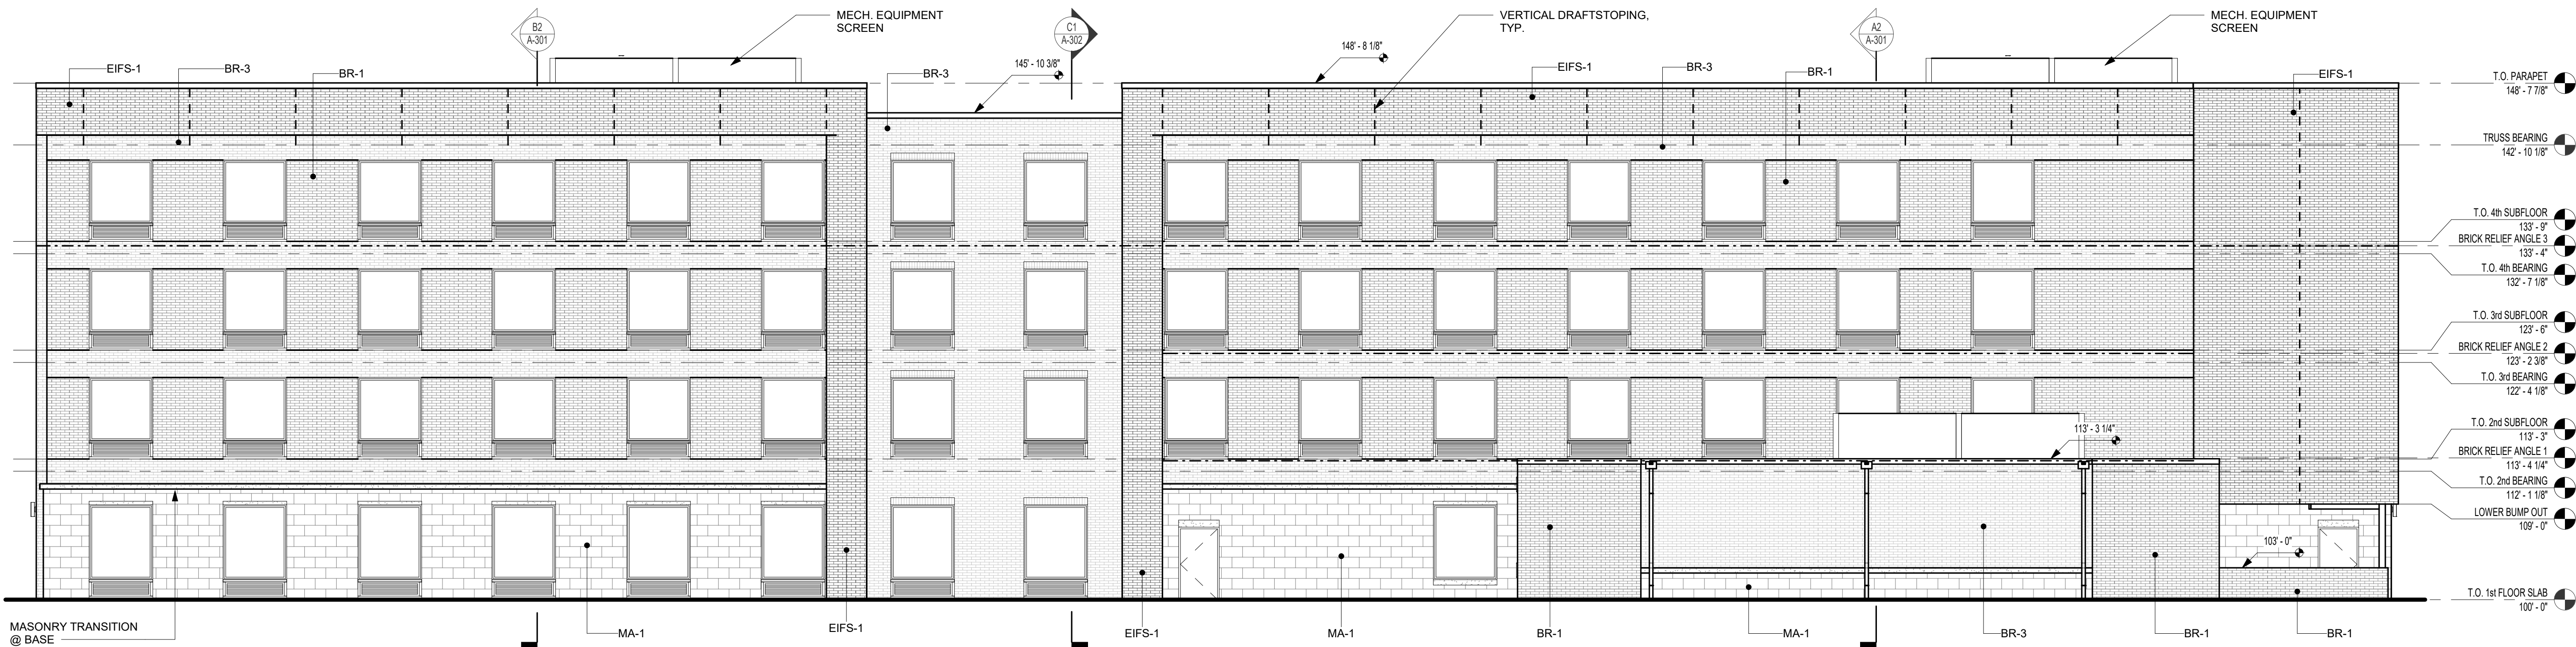

A1 REAR ELEVATION  
1/8" = 1'-0"

HOME2 SUITES BY HILTON

LEE'S SUMMIT, MO

SHEET TITLE  
EXTERIOR ELEVATIONS

PROJECT NUMBER: 22023

SHEET NUMBER:

A-200

RELEASED FOR CONSTRUCTION  
As Noted on Plan Review

Development Services Department  
Lee's Summit, Missouri

09/11/2025

REFERENCE G-003 FOR GENERAL NOTES

|                 |                                               |
|-----------------|-----------------------------------------------|
| MATERIAL LEGEND |                                               |
|                 | MA-1 - STONE - ROCK FACE, SILVERCREEK         |
|                 | MA-2 - STONE SILL - SMOOTH FACE               |
|                 | BR-1 - BRICK - RED, WILLIAMSBURG CHERRY CREEK |
|                 | BR-3 - BRICK - GREY                           |
|                 | EIFS-1 - TAN                                  |
|                 | MTL-1 - METAL - DARK BRONZE                   |
|                 | STCO - STUCCO - COLOR TO MATCH STONE          |
|                 | BRICK RELIEF ANGLE LOCATION                   |


PRINTS ISSUED  
04/17/2024 - CITY SUBMISSION

REVISIONS:  
11 09/04/2025 ASI #2.8


rosemann & associates P.C.  
ARCHITECTURE  
INTERIOR DESIGN  
ENGINEERING  
PLANNING

1526 Grand Boulevard  
Kansas City, MO 64108-1404  
p: 816.472.1448  
w: www.rosemann.com  
© 2024 Rosemann & Associates, P.C.

DENVER ▲ KANSAS CITY ▲ ST. LOUIS ▲ ATLANTA

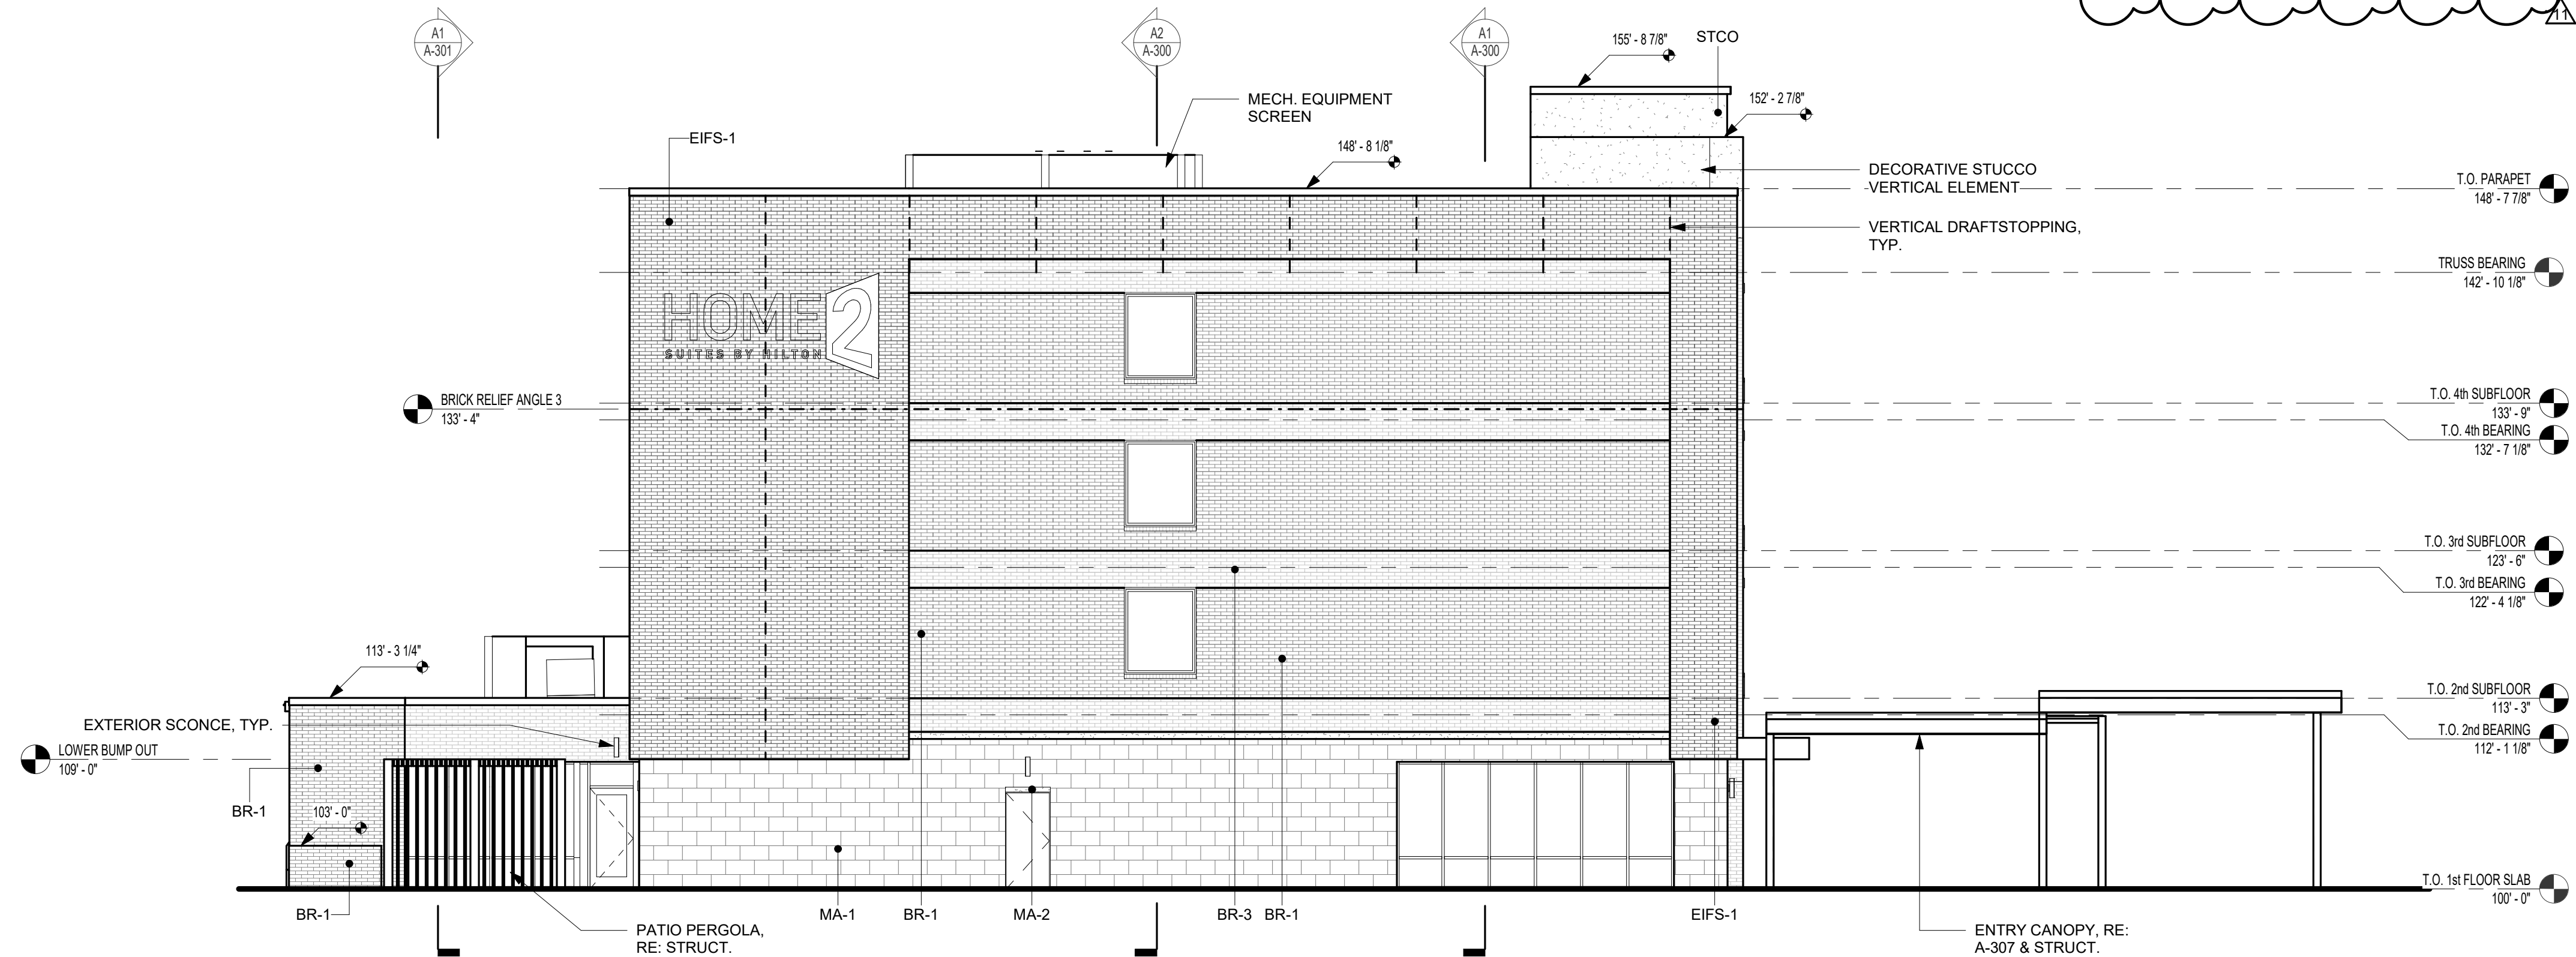

A2 SIDE ELEVATION  
1/8" = 1'-0"

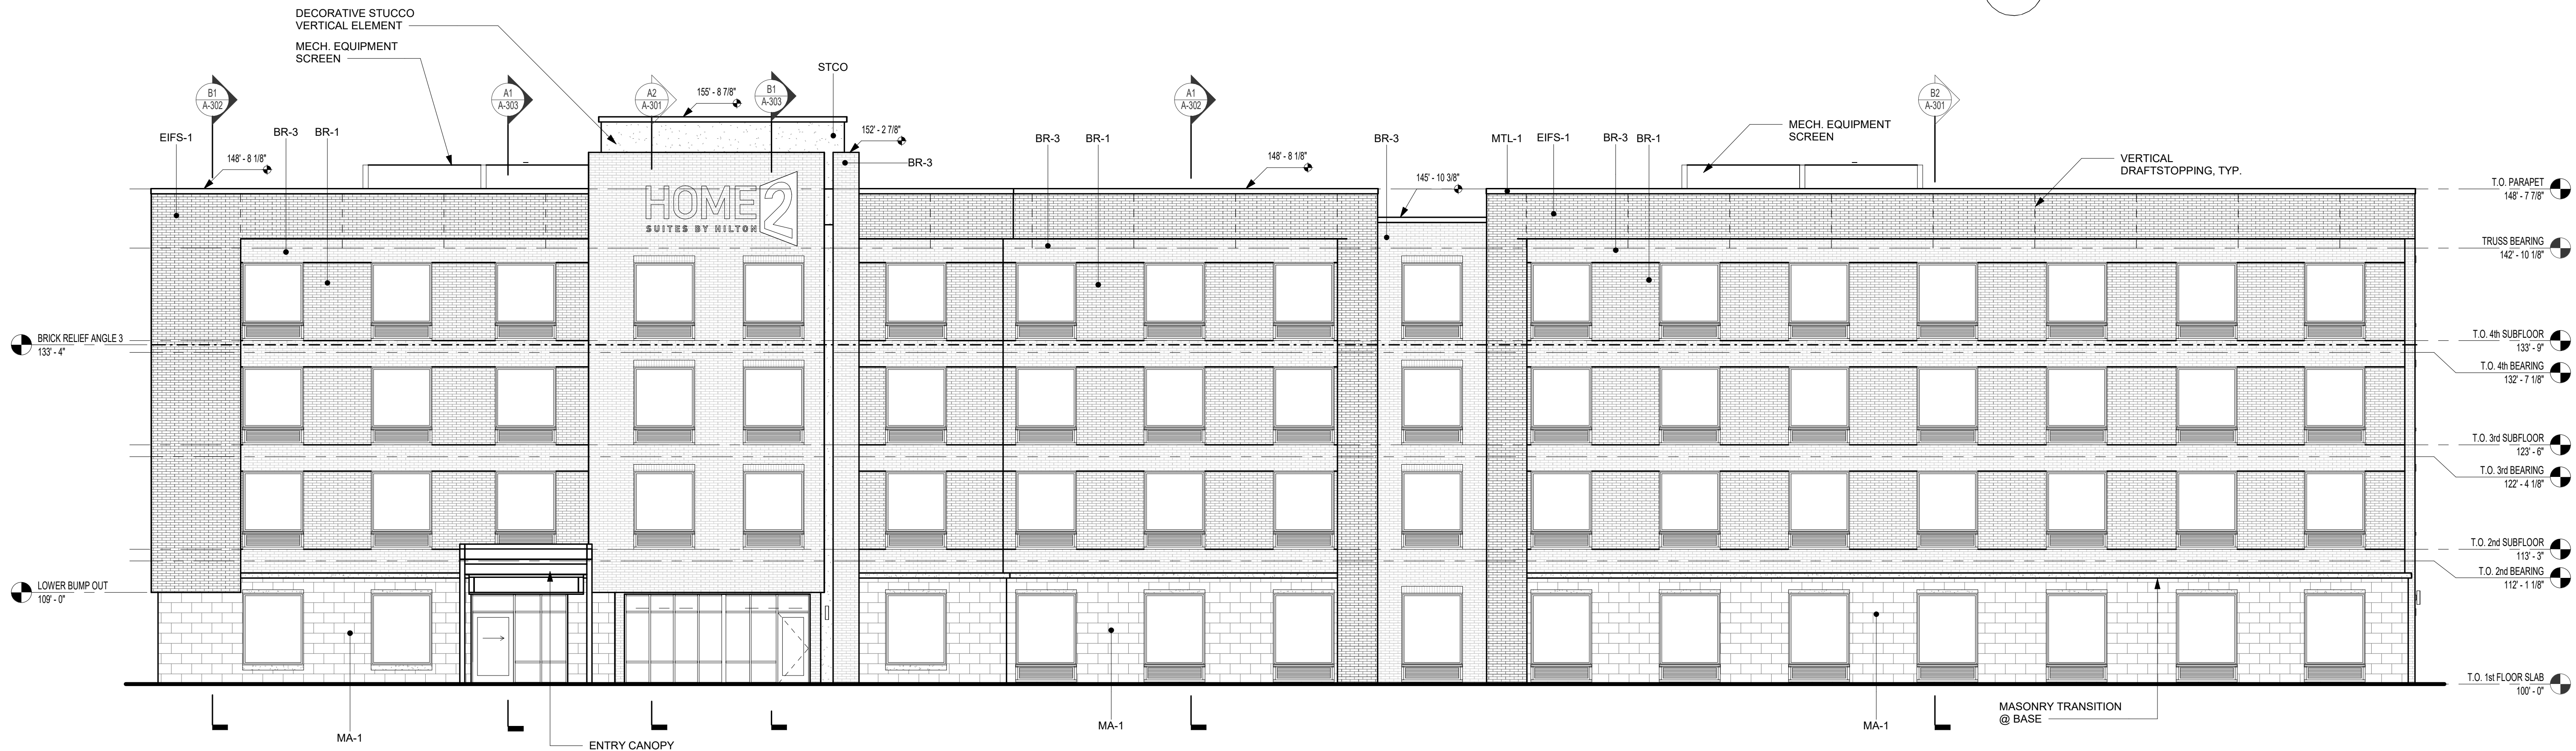

A1 FRONT ELEVATION  
1/8" = 1'-0"

HOME2 SUITES BY HILTON

LEE'S SUMMIT, MO

SHEET TITLE  
EXTERIOR ELEVATIONS

PROJECT NUMBER: 22023

SHEET NUMBER:

A-201

RELEASED FOR CONSTRUCTION  
As Noted on Plan Review

Development Services Department  
Lee's Summit, Missouri  
09/11/2025

REFERENCE G-003 FOR GENERAL NOTES

MATERIAL LEGEND

- MA-1 - STONE - ROCK FACE, SILVERCREEK
- MA-2 - STONE SILL - SMOOTH FACE
- BR-1 - BRICK - RED, WILLIAMSBURG CHERRY CREEK
- BR-3 - BRICK - GREY
- EIFS-1 - TAN
- MTL-1 - METAL - DARK BRONZE
- STCO - STUCCO - COLOR TO MATCH STONE
- BRICK RELIEF ANGLE LOCATION

PRINTS ISSUED

04/17/2024 - CITY SUBMISSION

REVISIONS:

2 06/14/2024 CITY & BRAND RESPONSE  
11 09/04/2025 ASI #2.8

rosemann  
& ASSOCIATES P.C.

ARCHITECTURE  
INTERIOR DESIGN  
ENGINEERING  
PLANNING


1526 Grand Boulevard  
Kansas City, MO 64108-1404

P: 816.472.1448


W: www.rosemann.com

© 2024 Rosemann & Associates, P.C.

DENVER ▲ KANSAS CITY ▲ ST. LOUIS ▲ ATLANTA

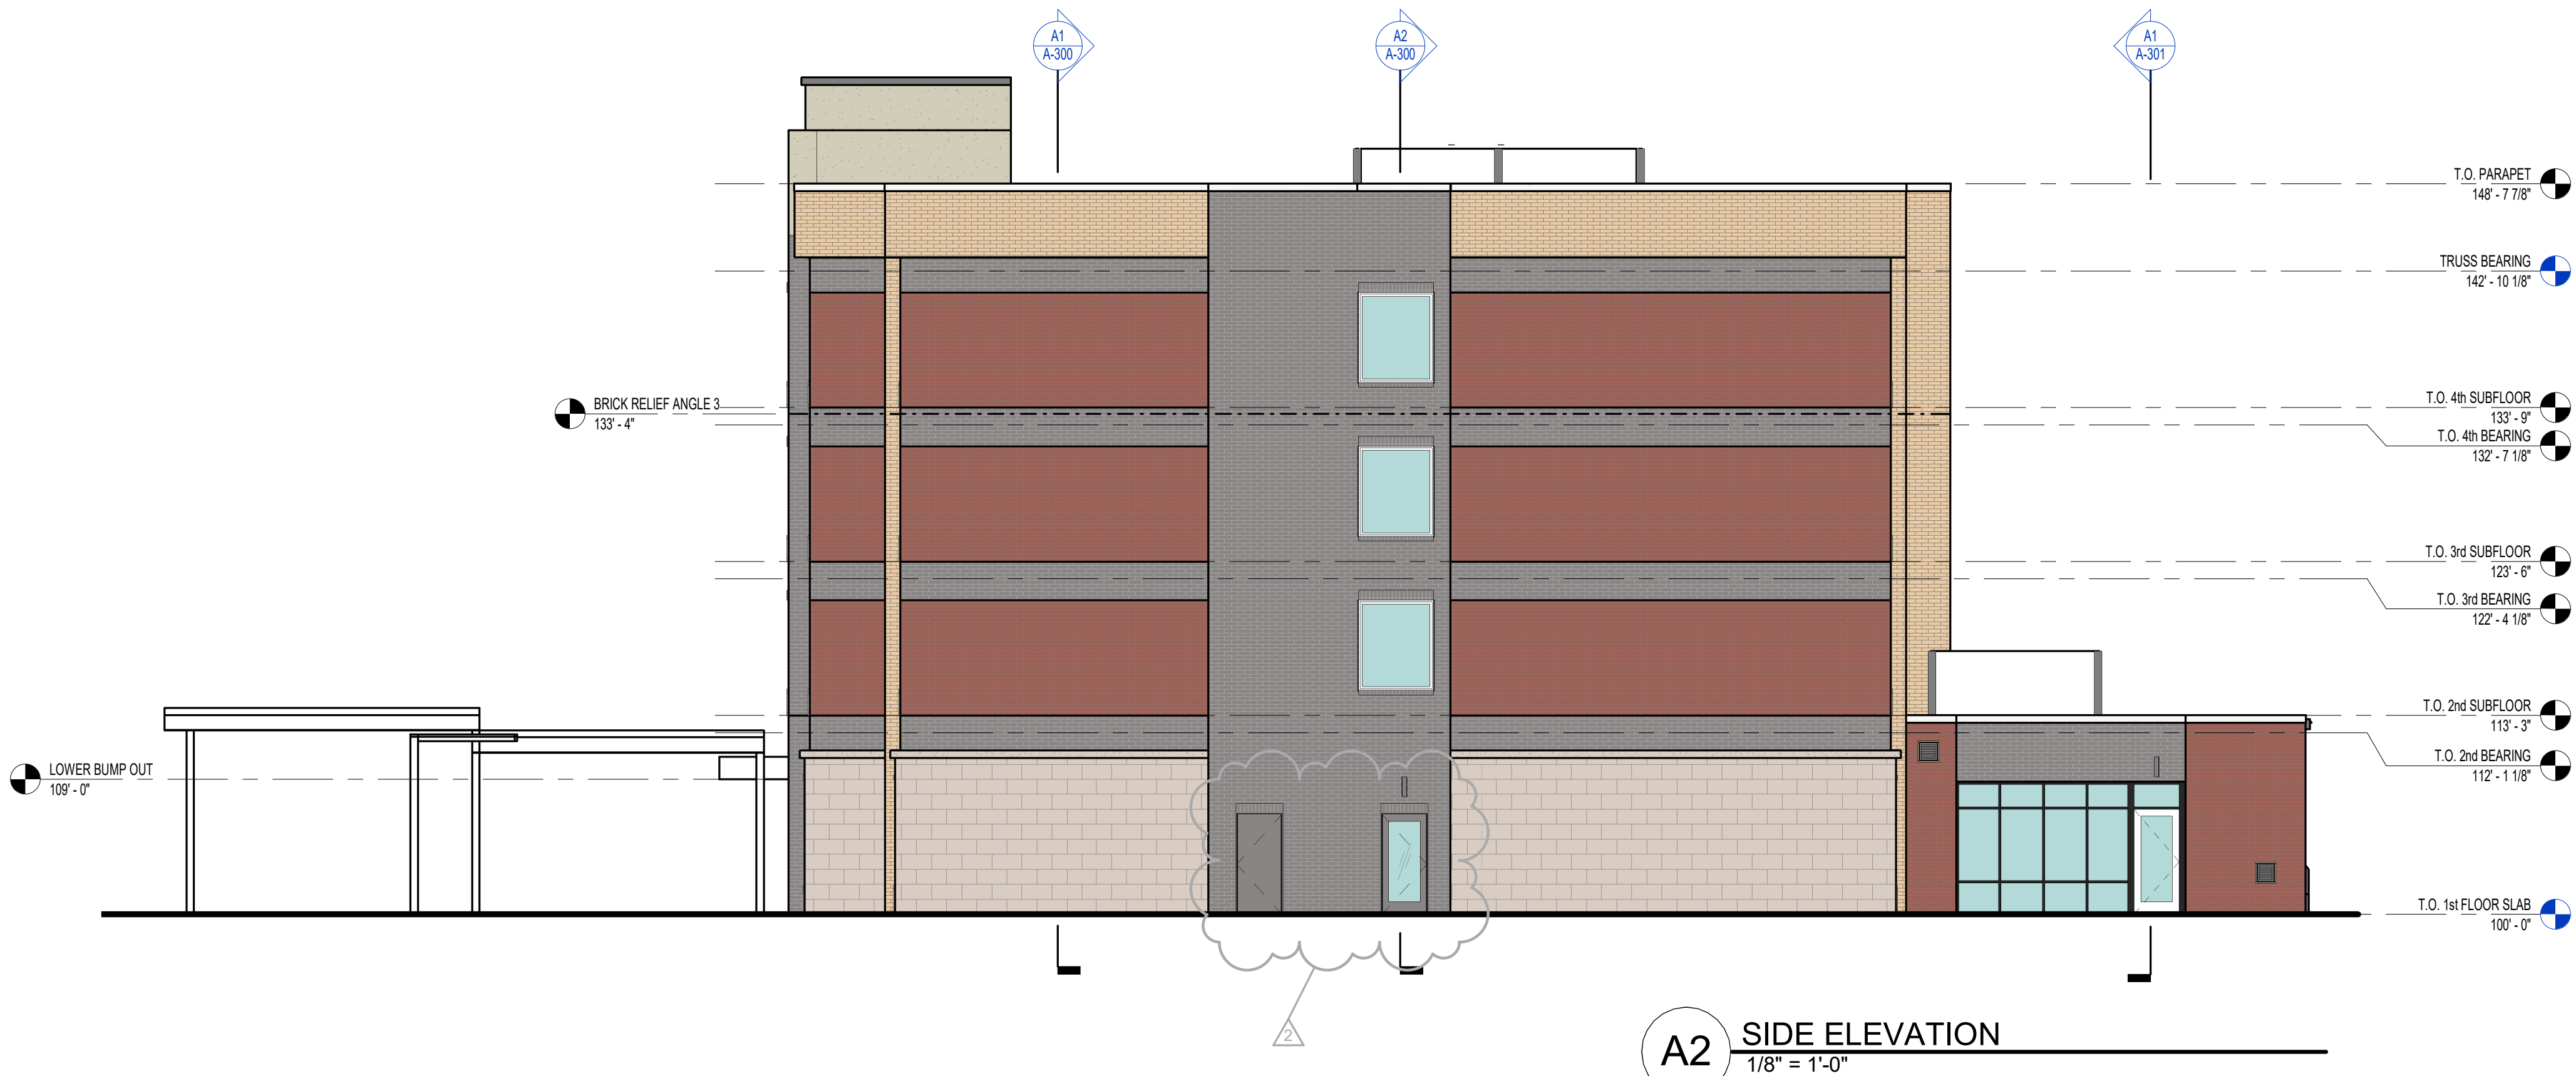

A2 SIDE ELEVATION  
1/8" = 1'-0"

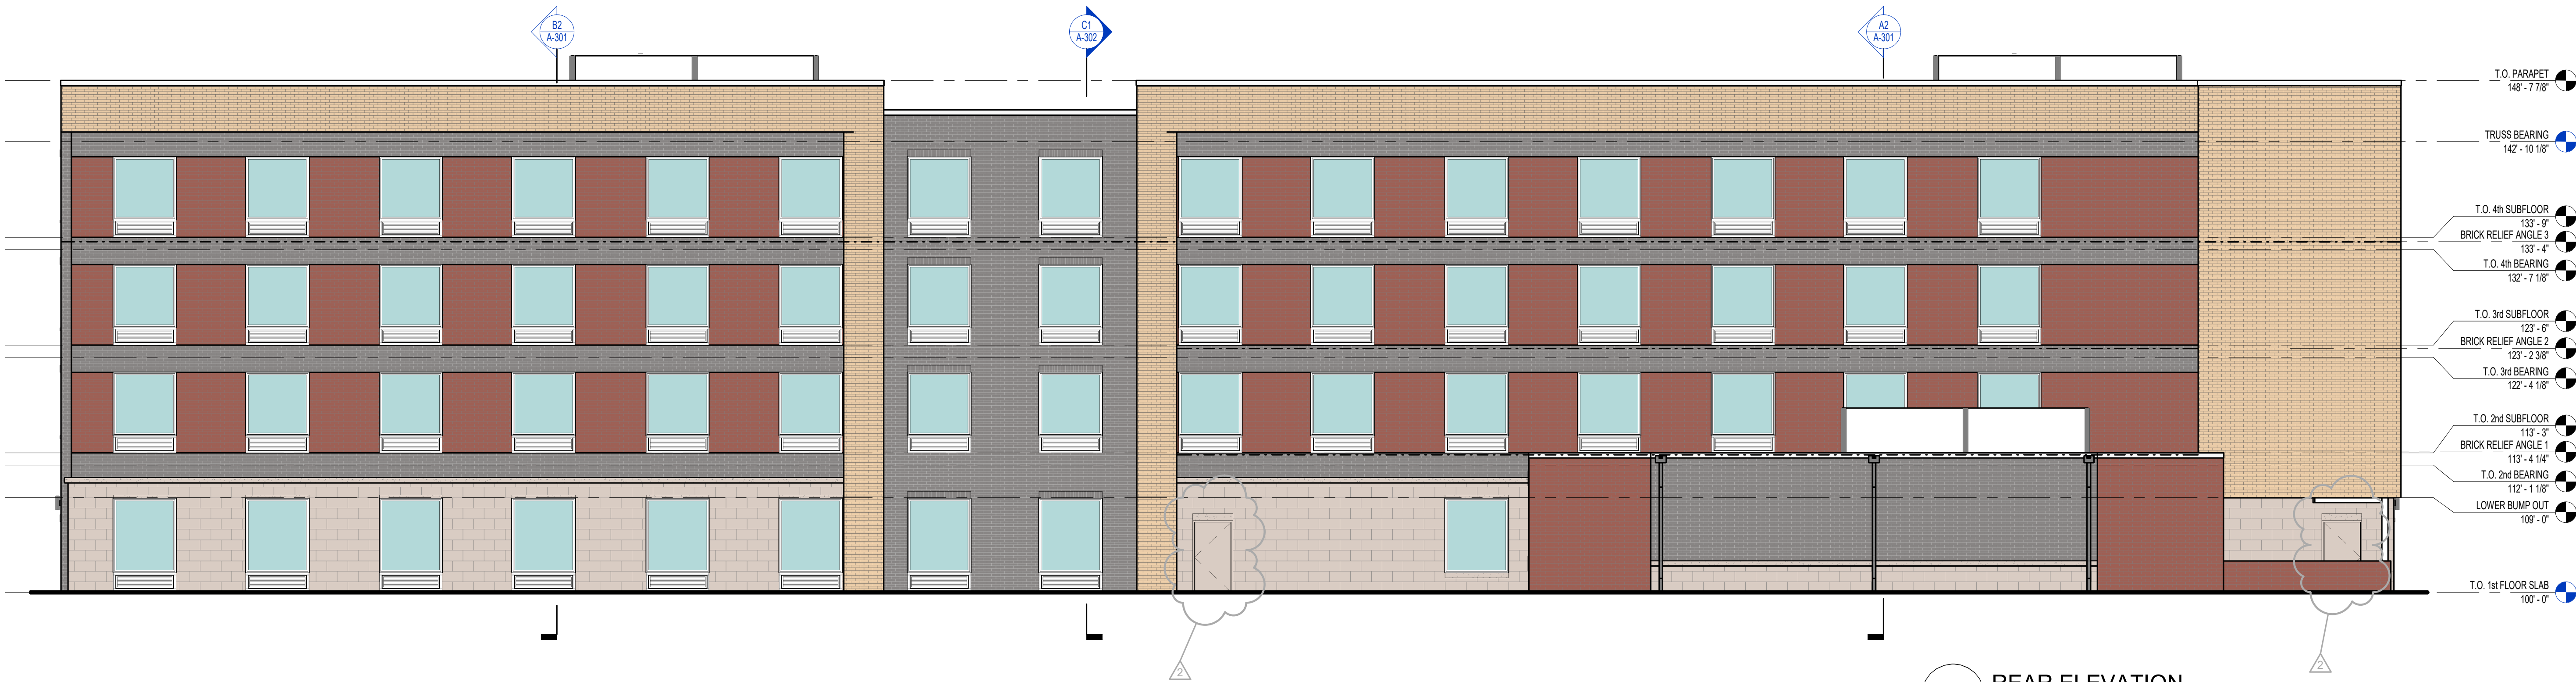

A1 REAR ELEVATION  
1/8" = 1'-0"

HOME2 SUITES BY HILTON

LEE'S SUMMIT, MO

SHEET TITLE  
EXTERIOR COLOR ELEVATIONS

PROJECT NUMBER: 22023

SHEET NUMBER:

A-202

RELEASED FOR CONSTRUCTION  
As Noted on Plan Review

Development Services Department  
Lee's Summit, Missouri  
09/11/2025

REFERENCE G-003 FOR GENERAL NOTES

MATERIAL LEGEND

|                                               |
|-----------------------------------------------|
| MA-1 - STONE - ROCK FACE, SILVERCREEK         |
| MA-2 - STONE SILL - SMOOTH FACE               |
| BR-1 - BRICK - RED, WILLIAMSBURG CHERRY CREEK |
| BR-3 - BRICK - GREY                           |
| EIFS-1 - TAN                                  |
| MTL-1 - METAL - DARK BRONZE                   |
| STCO - STUCCO - COLOR TO MATCH STONE          |
| --- BRICK RELIEF ANGLE LOCATION               |

PRINTS ISSUED

04/17/2024 - CITY SUBMISSION

REVISIONS:

2 06/14/2024 CITY & BRAND RESPONSE  
11 09/04/2025 ASI #2.8

rosemann  
& ASSOCIATES P.C.

ARCHITECTURE  
INTERIOR DESIGN  
ENGINEERING  
PLANNING


1526 Grand Boulevard  
Kansas City, MO 64108-1404

P: 816.472.1448

W: www.rosemann.com

© 2024 Rosemann & Associates, P.C.

DENVER ▲ KANSAS CITY ▲ ST. LOUIS ▲ ATLANTA

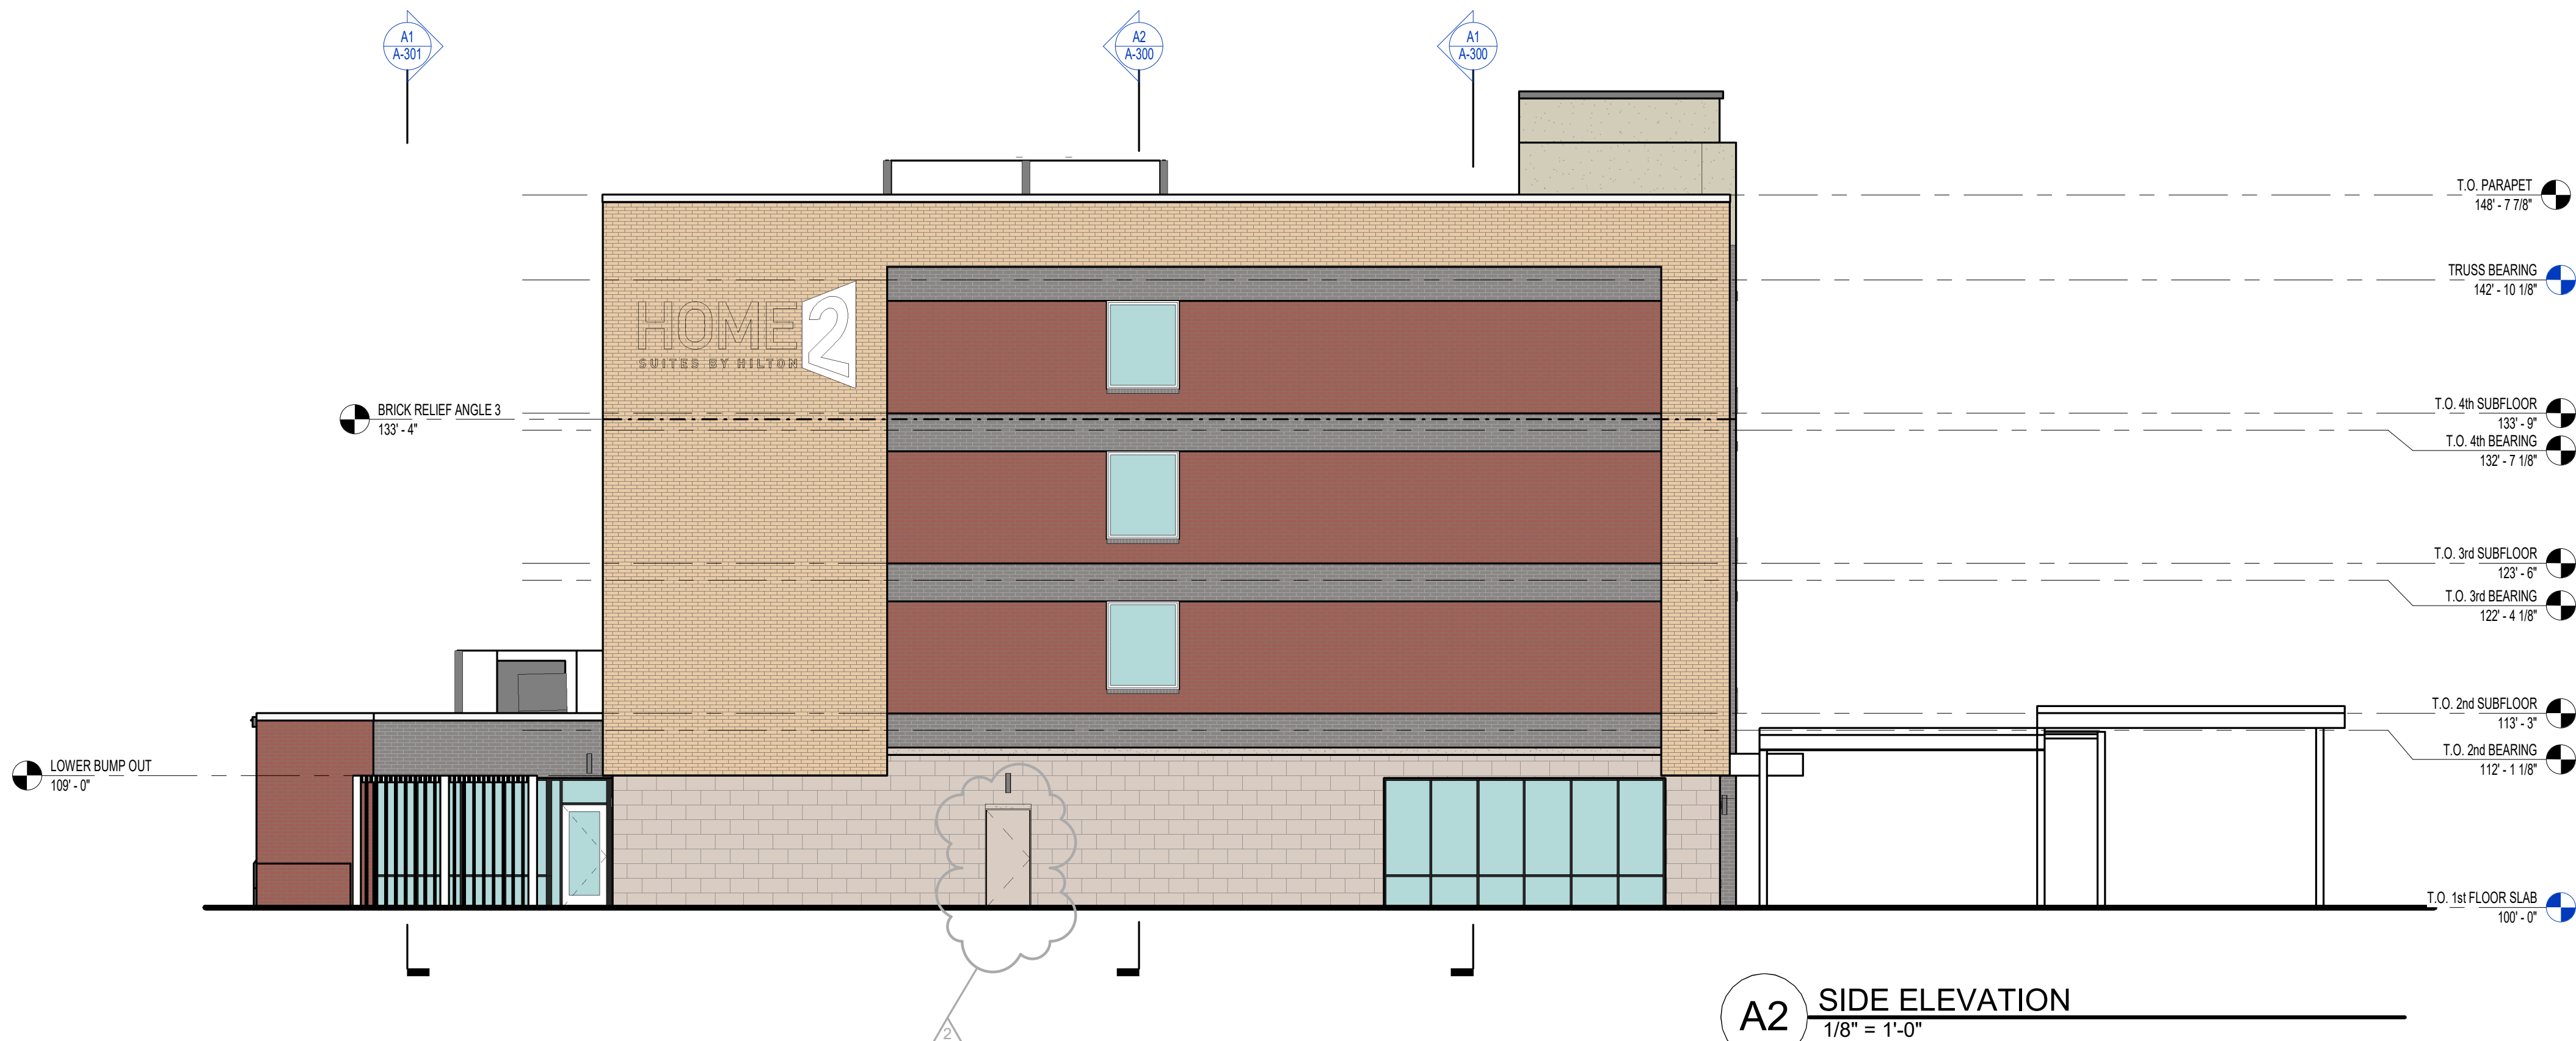

A2 SIDE ELEVATION  
1/8" = 1'-0"



A1 FRONT ELEVATION  
1/8" = 1'-0"

HOME2 SUITES BY HILTON

LEE'S SUMMIT, MO

SHEET TITLE  
EXTERIOR COLOR ELEVATIONS

PROJECT NUMBER: 22023

SHEET NUMBER:

A-203