



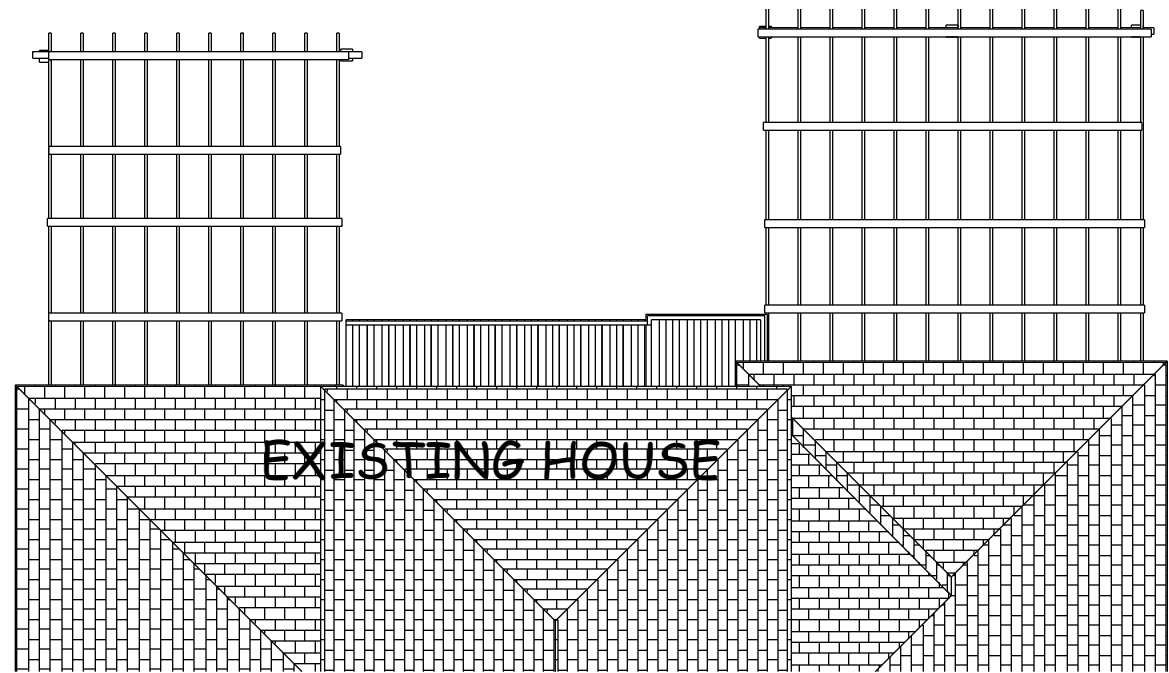


ROOF PLAN
1/8 = 1-0
ROOF PITCHES 5/12 MAIN FLOOR U.N.O.
ROOF PITCHES 8/12 SECOND FLOOR U.N.O.
RAFTERS 2 X 6 DF NO 2 @ 16" OC TYP.
HIPS AND RIDGES 2 X 8 DF NO 2 TYP.

RELEASE FOR CONSTRUCTION
AS NOTED FOR PLAN REVIEW
DEVELOPMENT SERVICES
LEE'S SUMMIT, MISSOURI
09/12/2025

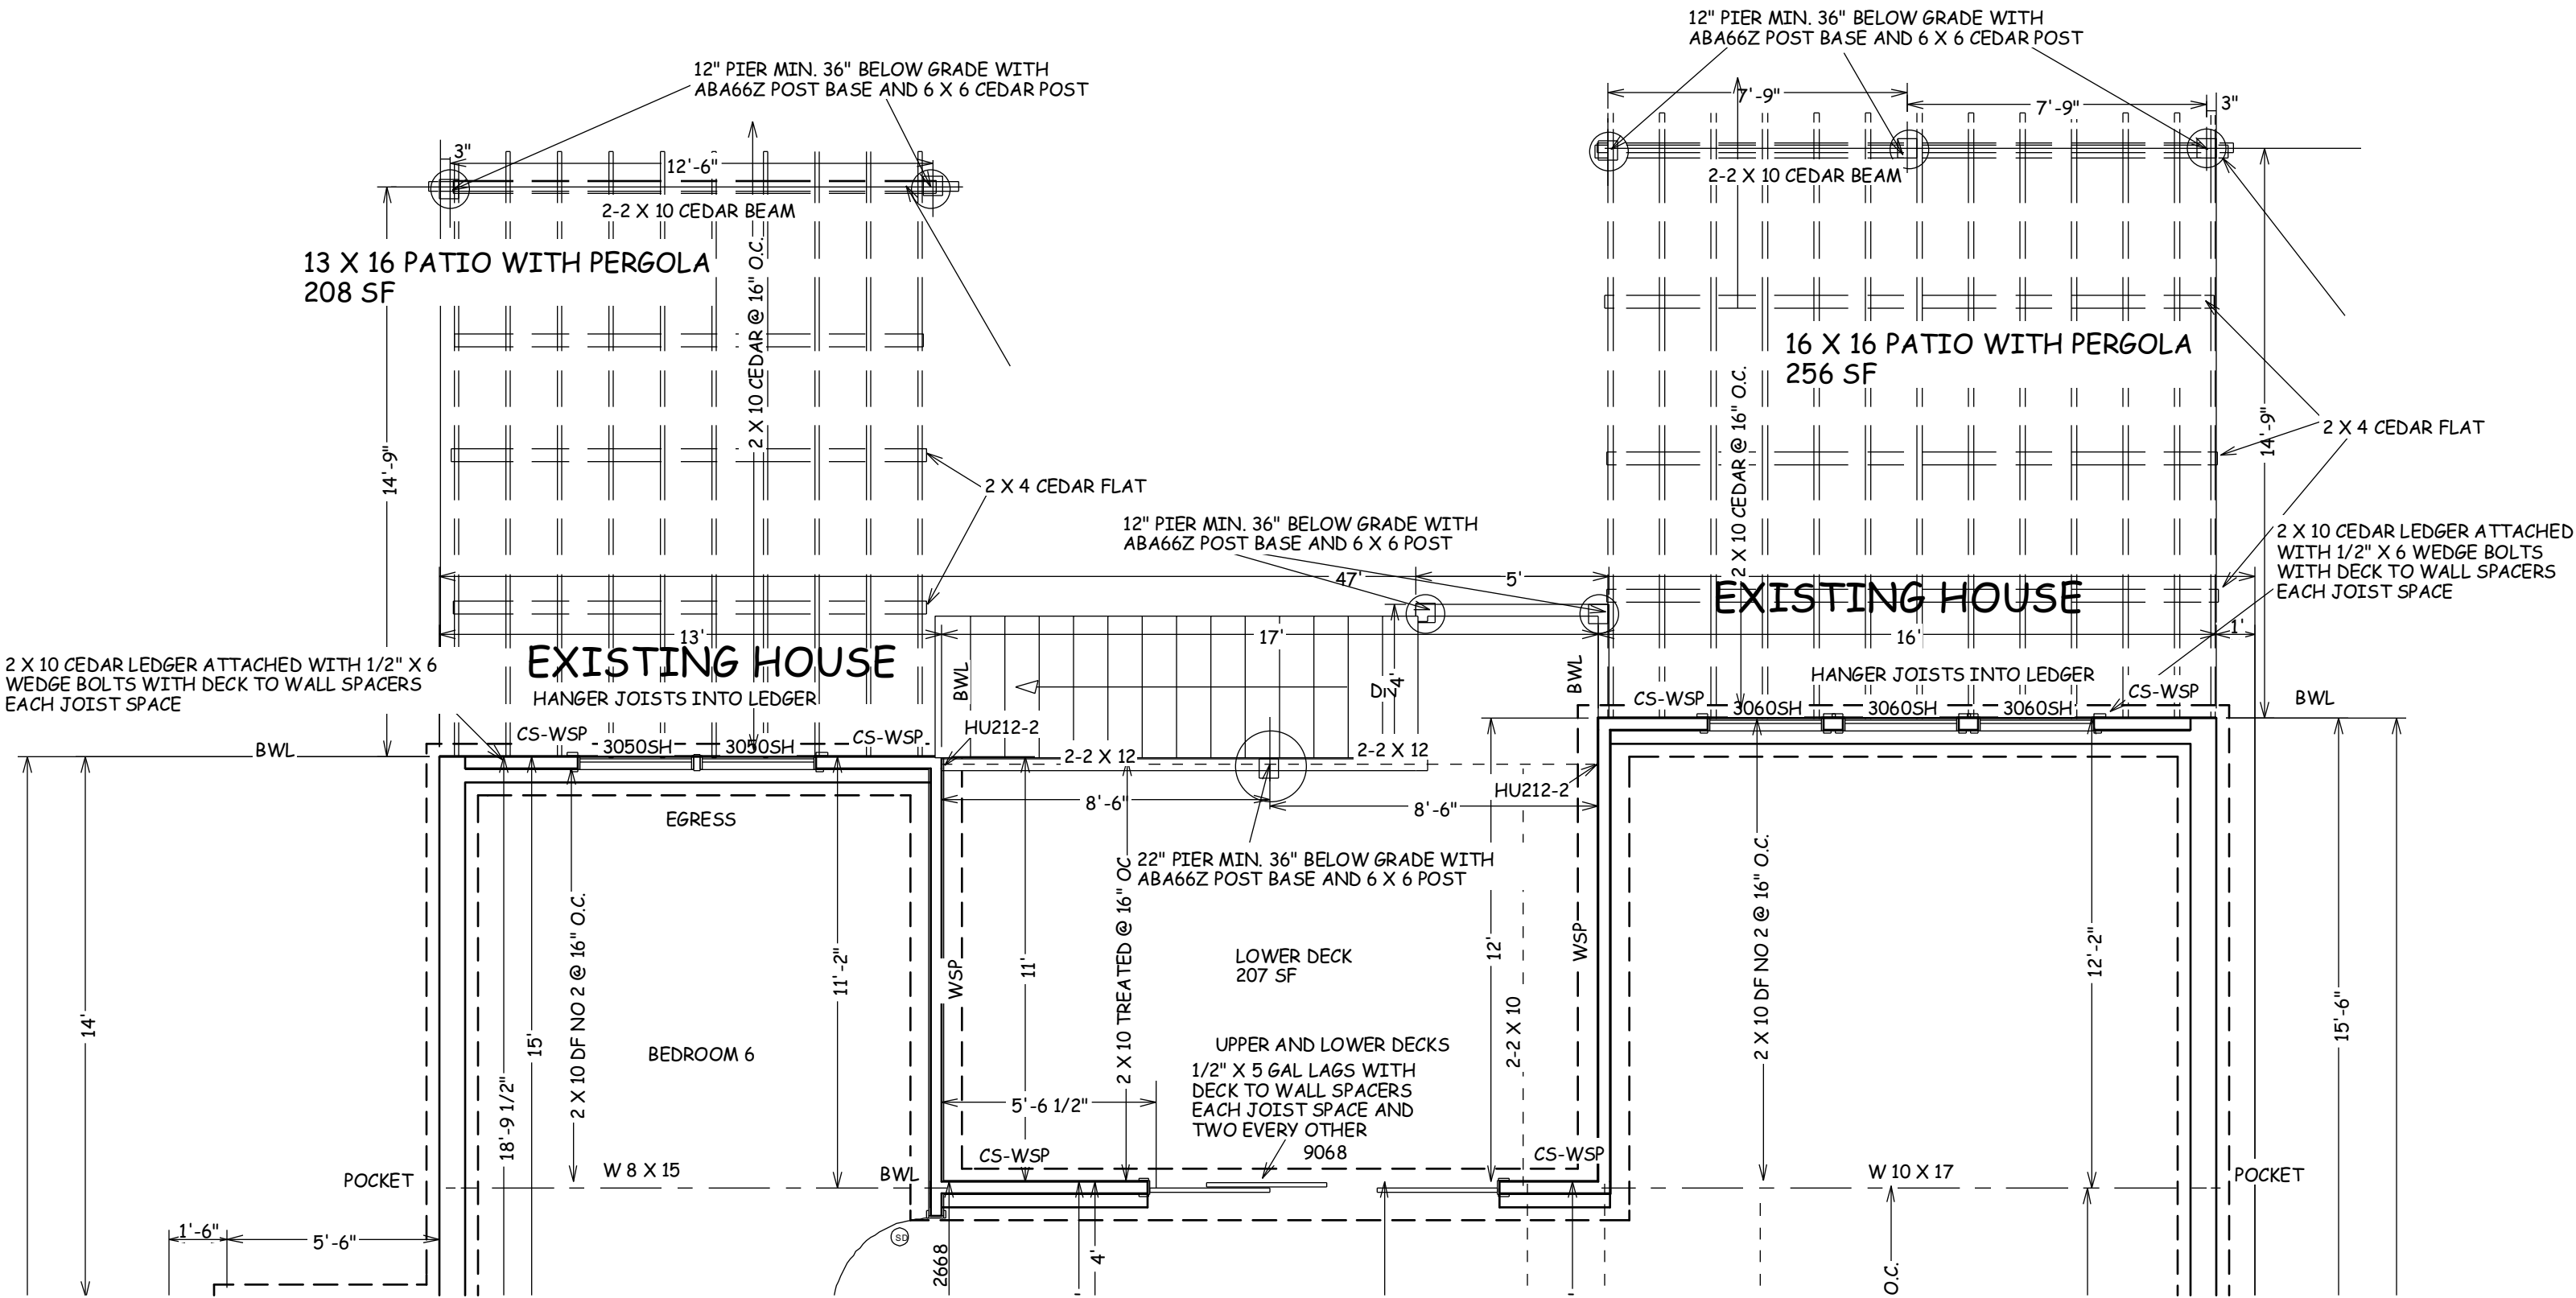


FOUNDATION PLAN
ADDED PERGOLAS

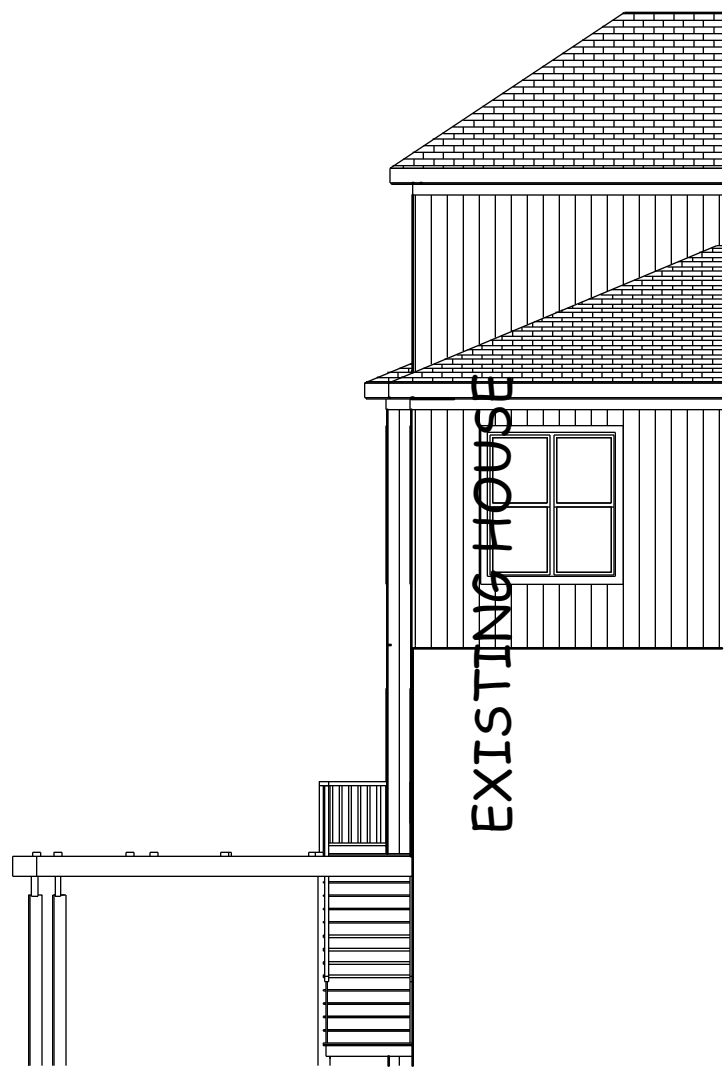

LEFT EL.
1/8 = 1-0



REAR EL.
1/8 = 1-0

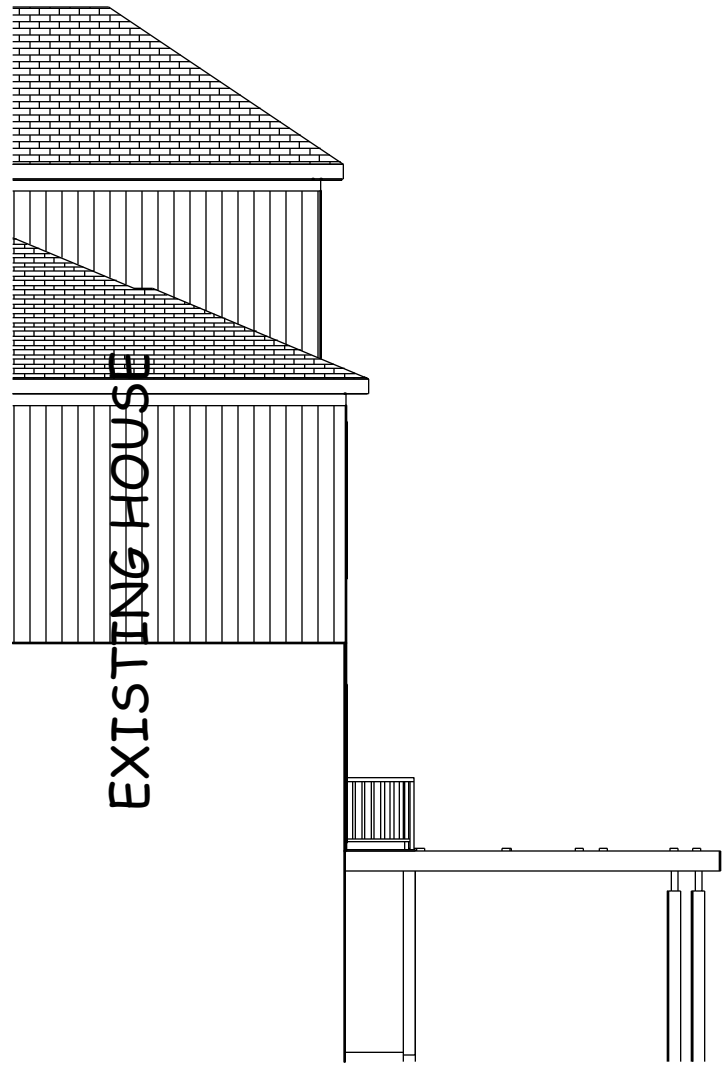

RIGHT EL.
1/8 = 1-0



TRUMARK HOMES LAURA ADDED PERGOLAS AND PATIOS BACK OF HOUSE LOT 152 WOODSIDE 2090 NW O'BRIAN RD LEE SUMMIT MO		BUILD IN ACCORDANCE WITH 2018 INTERNATIONAL RESIDENTIAL CODE AND LOCAL CODES.		W. LEE RHOAD AIA ARCHITECT 11871 SE STATE ROUTE H AGENCY MO 64401 LEERHOAD.COM 816-244-6588 LEERHOAD@GMAIL.COM	
SCALE 1/4" = 1-0					
DATE 9-5-25					
PLAN NO. 4415-PERG					
SHEET NO. 1 OF 1					