


AS GRADED PLOT PLAN

Ordered by: Elevate Design and Build
Description: Lot 149 Hook Farms Second Plat, Lee's Summit, MO.
Address: 2132 SW Wheatfield Drive
Lot Area: 10,752 Sq Ft.

RELEASE FOR CONSTRUCTION
AS NOTED FOR PLAN REVIEW
DEVELOPMENT SERVICES
LEE'S SUMMIT, MISSOURI
10/17/2025

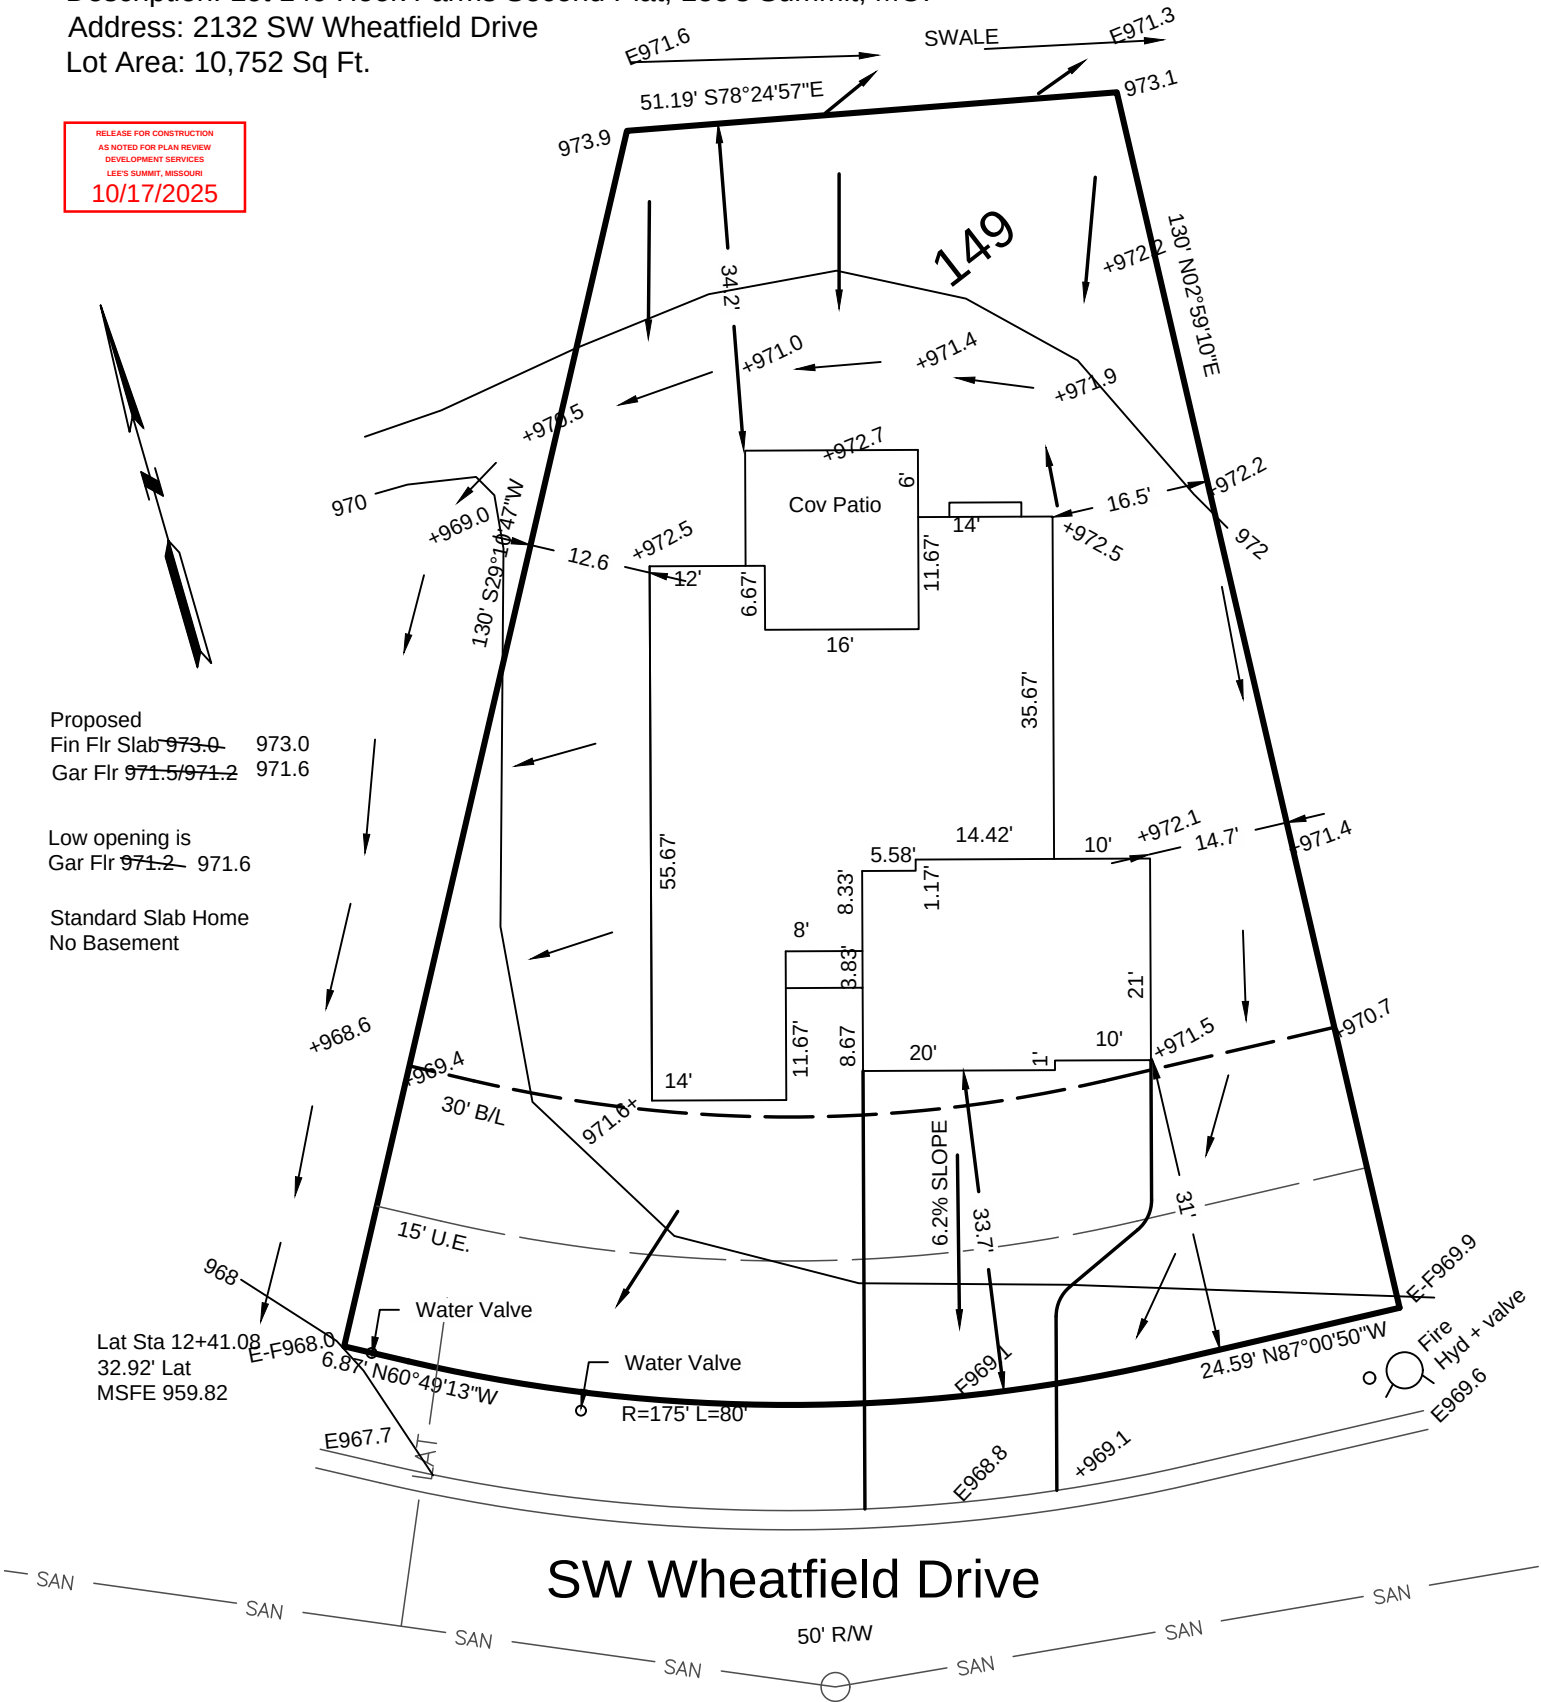

Proposed
Fin Flr Slab 973.0
Gar Flr 971.2


Low opening is
Gar Flr 971.2

Standard Slab Home
No Basement

MH Sta 12+97.32
Top 968.53
Inv 955.23

Elevations shown are as of 10-15-2025

→ = DRAINAGE PATTERN

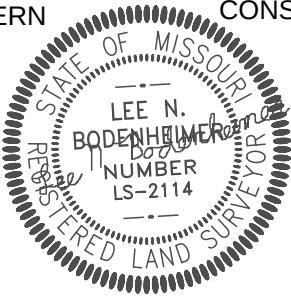

CONSTRUCTION ENGINEERING SERVICES, INC.
16810-C East 40 Highway
Independence, MO 64055
(816)478-2323
lee@engineeringkc.com
SCALE: 1"=20'
DATE: 02/26/2025 & 10-13-2025
JOB NO:19335 & 19617

LEE BODENHEIMER, L.S.
Land Surveyor