



AS GRADED PLOT PLAN

Ordered by:Elevate Design and Build
Description:Lot 143, Hook Farms 2nd Plat in Lee's Summit, MO
Address: 2618 SW Firefly Lane
Lot Area = 9750 sf

RELEASE FOR CONSTRUCTION
AS NOTED FOR PLAN REVIEW
DEVELOPMENT SERVICES
LEE'S SUMMIT, MISSOURI
10/17/2025

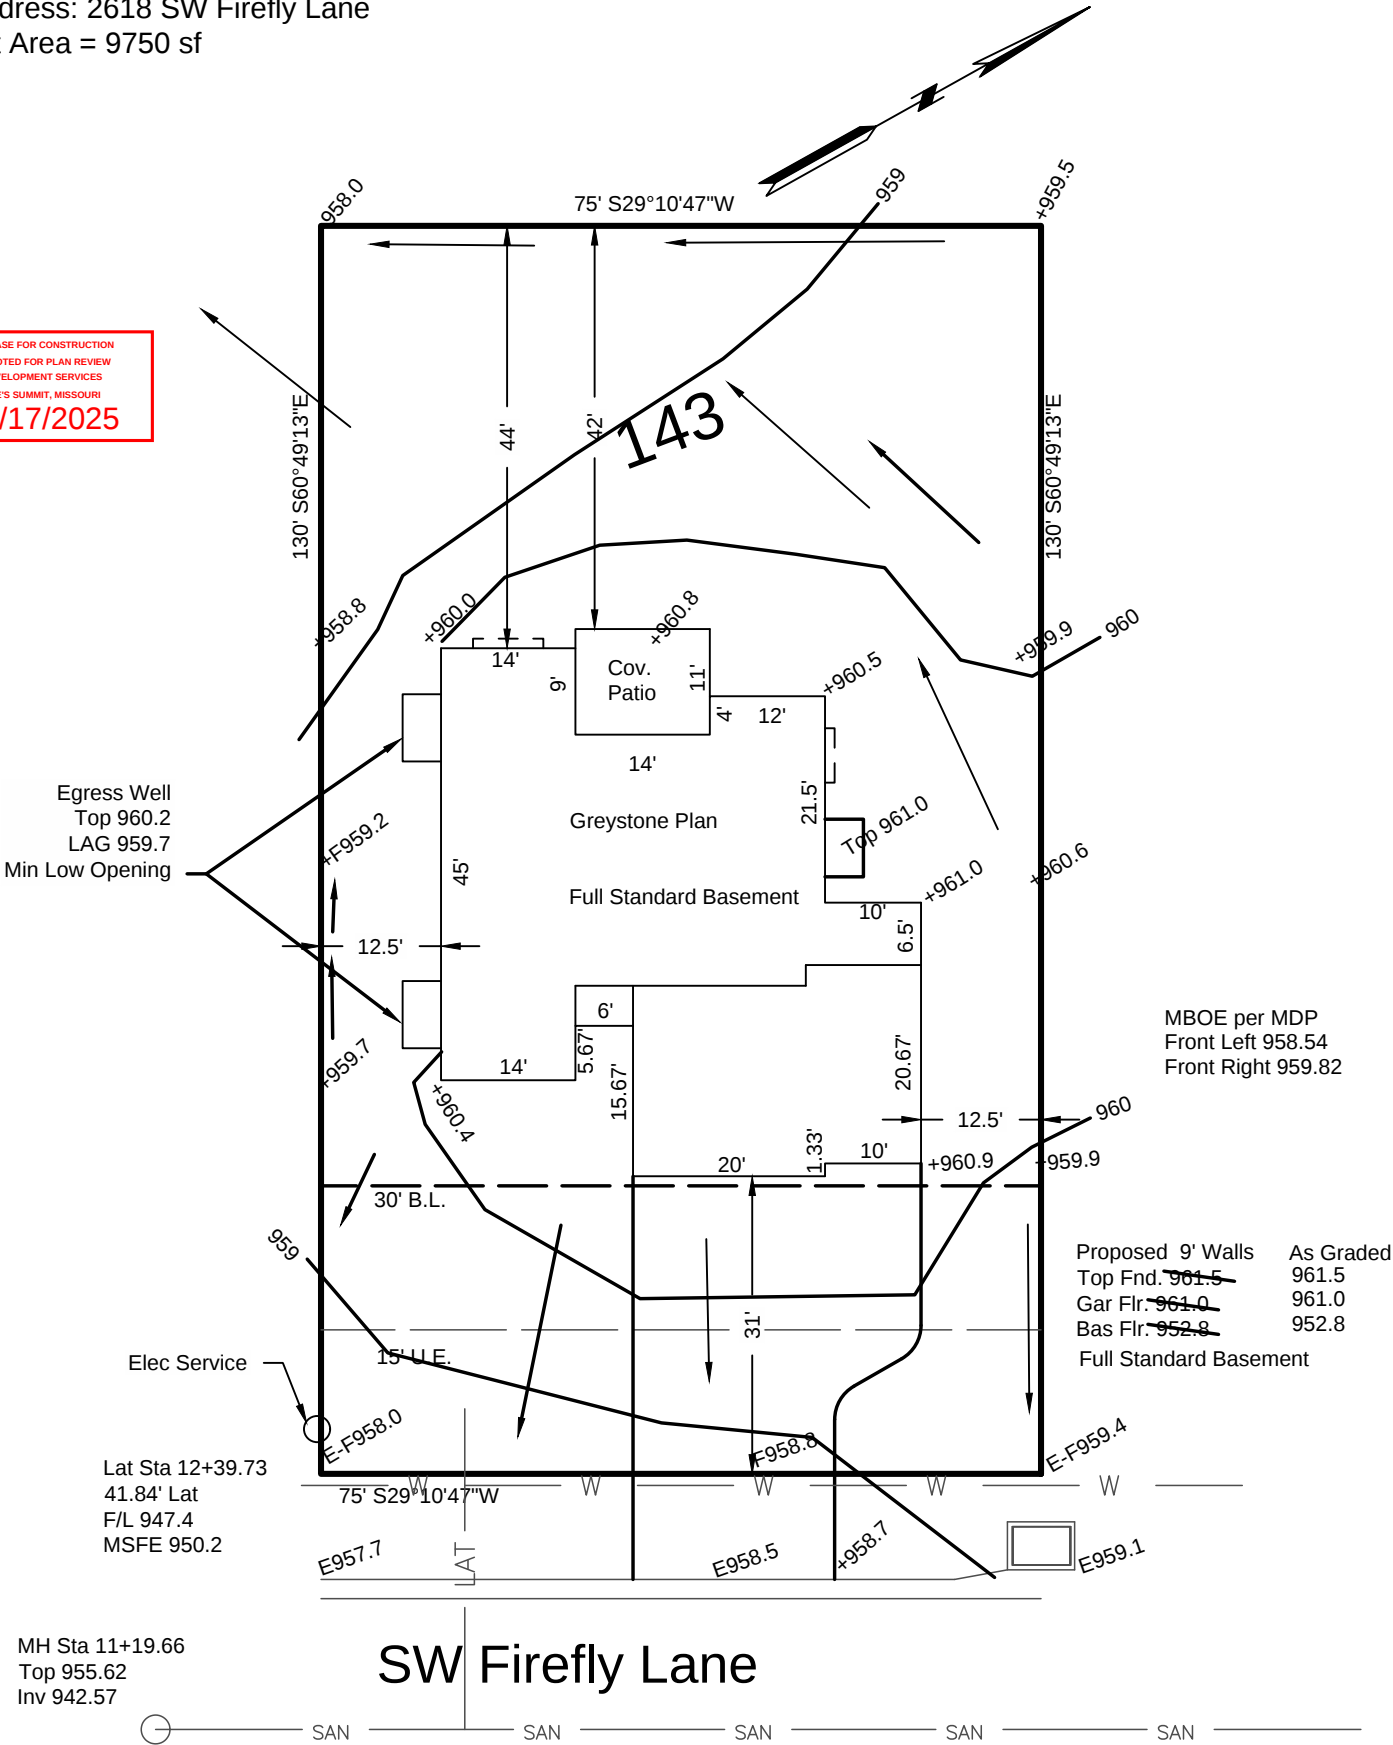

→ = DRAINAGE PATTERN

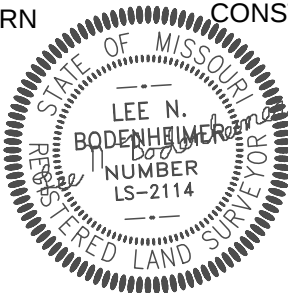

CONSTRUCTION ENGINEERING SERVICES, INC.
16810-C East 40 Highway
Independence, MO 64055
(816)478-2323
lee@engineeringkc.com
SCALE: 1"=20'
DATE: 02/05/2025 & 10-11-2025
JOB NO:19328 & 19616

LEE BODENHEIMER, L.S.
Land Surveyor