



Nabholz Construction - Lenexa
17300 W 116th Street
Lenexa, Kansas 66219
P: (913) 393-6500

Project: 08-25-3311 HCA LSMC CAMPUS EXPANSION
2100 SE BLUE PARKWAY
LEE'S SUMMIT, Missouri 64063

RFI #026: Pedestrian Bridge Footings

Status	Closed on 07/18/25		
To	Luke Arbanas (Nabholz Construction Corporation) <i>(Response Required)</i>	From	Max Franklin (Nabholz Construction Corporation)
Date Initiated	Jul 7, 2025	Due Date	Jul 14, 2025
Location	Civil Expansion	Project Stage	Pre-Construction
Cost Impact	TBD	Schedule Impact	TBD
Spec Section			
Drawing Number	S120, S211, C6.4, AS501	Reference	
Linked Drawings			
Copies To	Rick Fobair (Nabholz Construction Corporation), Max Franklin (Nabholz Construction Corporation), Ryan Grimes (Nabholz Construction Corporation), Travis Hilscher (LITHKO CONTRACTING LLC), Wayne Kufahl (Nabholz Construction Corporation), Lelan Olsen (Nabholz Construction Corporation)		
Priority	Medium		
Constraint			

Activity

Question	Question from Max Franklin Nabholz Construction Corporation on Monday, Jul 7, 2025 at 08:22 AM CDT Q: THROUGHOUT THE PLANS, THERE APPEARS TO BE NO DETAILS OR SECTIONS IDENTIFYING THE LENGTH AND WIDTH OF THE PEDESTRIAN BRIDGE FOOTINGS. CAN ARCHITECT PLEASE PROVIDE SECTION OR DETAIL DEFINING THESE DIMENSIONS. - NAB-MF-06.30.2025 Attachments PEDESTRIAN_BRIDGE_FTGSIZE_7.03.25.pdf
Official Response	Response from Luke Arbanas Nabholz Construction Corporation on Friday, Jul 18, 2025 at 08:32 AM CDT See the markups in the RFI document. The width of the foundations is to be 4'-0". The length of the foundation is to be 2'-0" on either side of grid lines BA and BC. SDL: Nishith Sardhara Dt: 07/14/2025 Provide the foundations 4'-0" wide. See the markups on detail 1/S211 for the length of the foundation. -SDL Attachments RFI 026 - Pedestrian_Bridge_Footings-2025.07.07-SDL.pdf

All Replies

Response from Luke Arbanas Nabholz Construction Corporation on Friday, Jul 18, 2025 at 08:32 AM CDT

See the markups in the RFI document. The width of the foundations is to be 4'-0". The length of the foundation is to be 2'-0" on either side of grid lines BA and BC.

SDL: Nishith Sardhara Dt: 07/14/2025

Provide the foundations 4'-0" wide. See the markups on detail 1/S211 for the length of the foundation. -SDL

Attachments

[RFI 026 - Pedestrian_Bridge_Footings-2025.07.07-SDL.pdf](#)



Nabholz Construction - Lenexa
17300 W 116th Street
Lenexa, Kansas 66219
P: (913) 393-6500

Project: 08-25-3311 HCA LSMC CAMPUS EXPANSION
2100 SE BLUE PARKWAY
LEE'S SUMMIT, Missouri 64063

RFI #026: Pedestrian Bridge Footings

Status	Open		
To	Luke Arbanas (Nabholz Construction Corporation) <i>(Response Required)</i>	From	Max Franklin (Nabholz Construction Corporation)
Date Initiated	Jul 7, 2025	Due Date	Jul 14, 2025
Location	Civil Expansion	Project Stage	Pre-Construction
Cost Impact	TBD	Schedule Impact	TBD
Spec Section			
Drawing Number	S120, S211, C6.4, AS501	Reference	
Linked Drawings			
Copies To	Max Franklin (Nabholz Construction Corporation), Travis Hilscher (LITHKO CONTRACTING LLC), Wayne Kufahl (Nabholz Construction Corporation), Lelan Olsen (Nabholz Construction Corporation)		
Priority	Medium		
Constraint			


Activity

Question	Question from Max Franklin Nabholz Construction Corporation on Monday, Jul 7, 2025 at 08:22 AM CDT Q: THROUGHOUT THE PLANS, THERE APPEARS TO BE NO DETAILS OR SECTIONS IDENTIFYING THE LENGTH AND WIDTH OF THE PEDESTRIAN BRIDGE FOOTINGS. CAN ARCHITECT PLEASE PROVIDE SECTION OR DETAIL DEFINING THESE DIMENSIONS. - NAB-MF-06.30.2025 Attachments PEDESTRIAN_BRIDGE_FTGSIZE_7.03.25.pdf
-----------------	---


Awaiting an Official Response

See the markups in the RFI document. The width of the foundations is to be 4'-0".
The length of the foundation is to be 2'-0" on either side of grid lines BA and BC.


SDL: Nishith Sardhara Dt: 07/14/2025

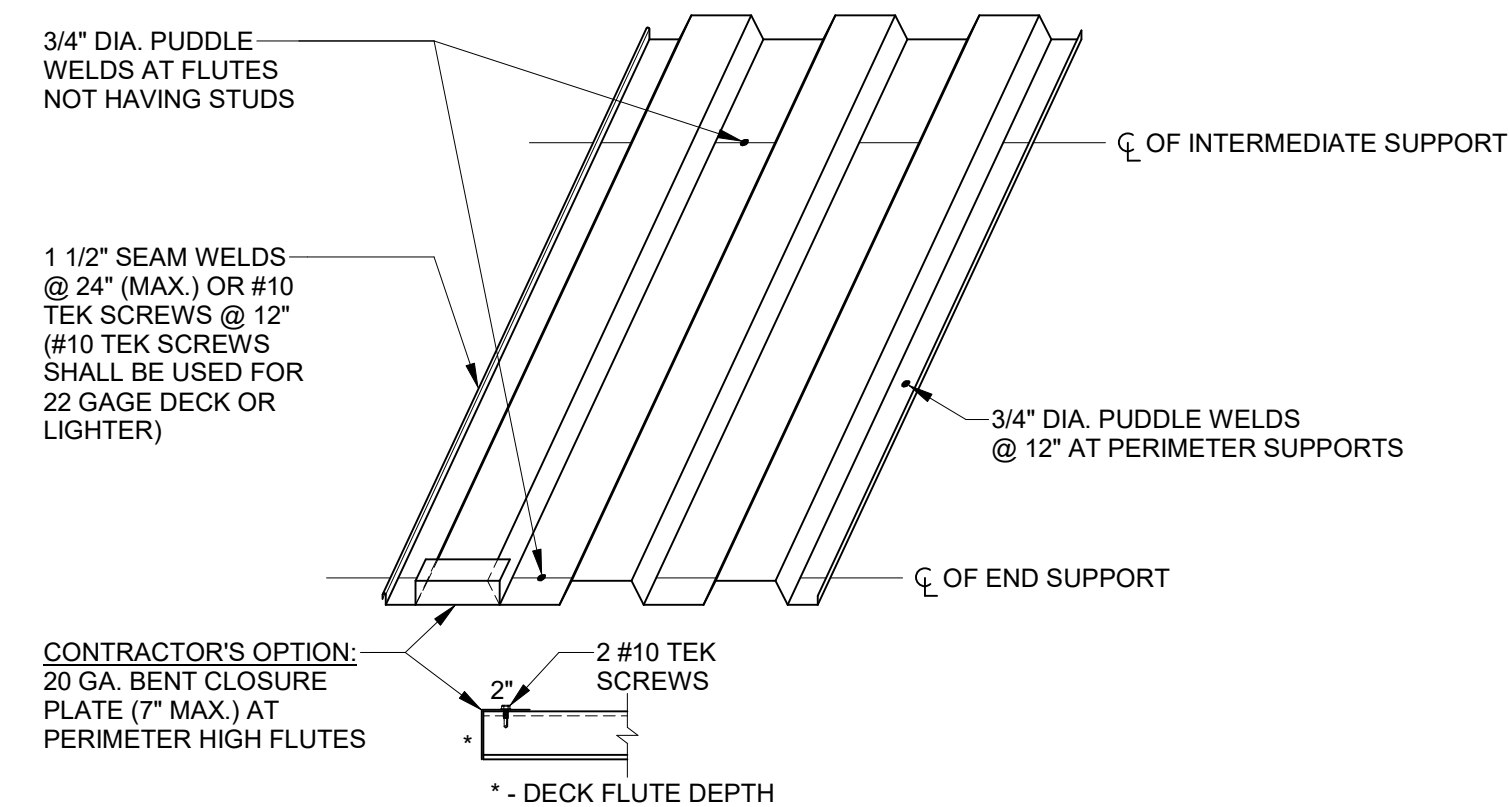


7 TYPICAL COMPOSITE DECK ATTACHMENT

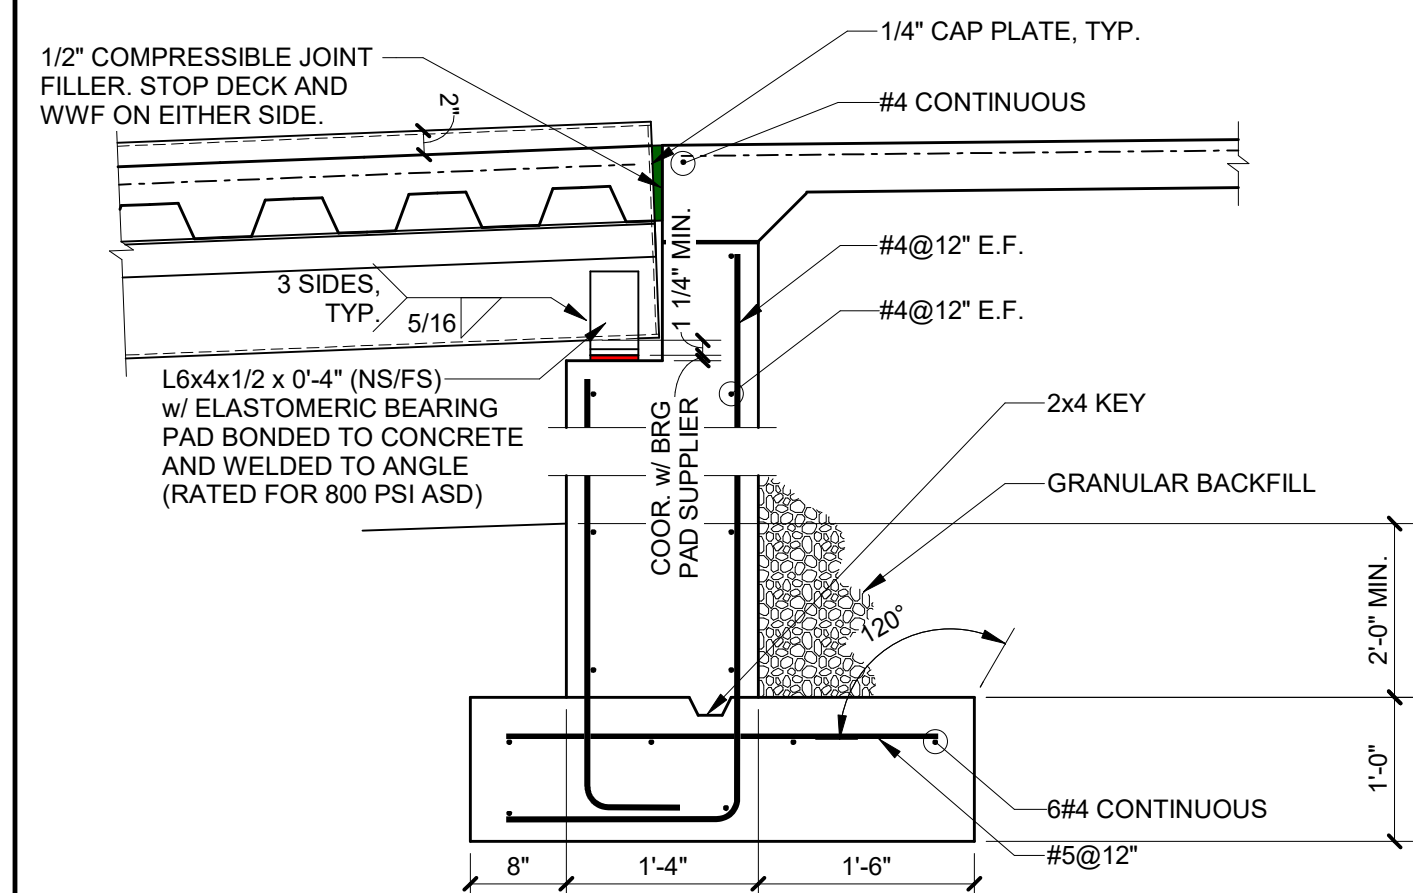


1 TYPICAL SECTION AT STEEL BEAM / RET. WALL

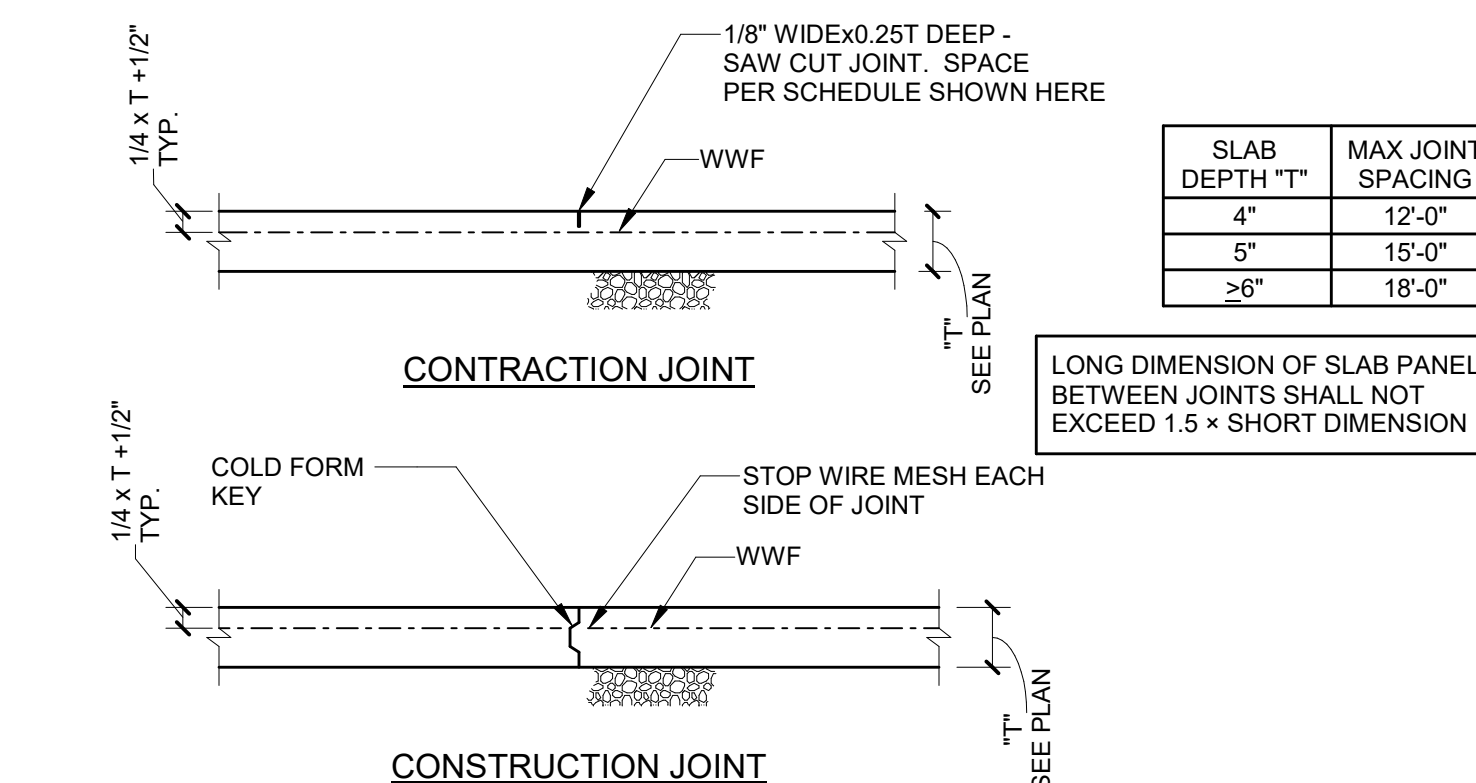


6 TYPICAL SLAB ON GROUND DETAILS

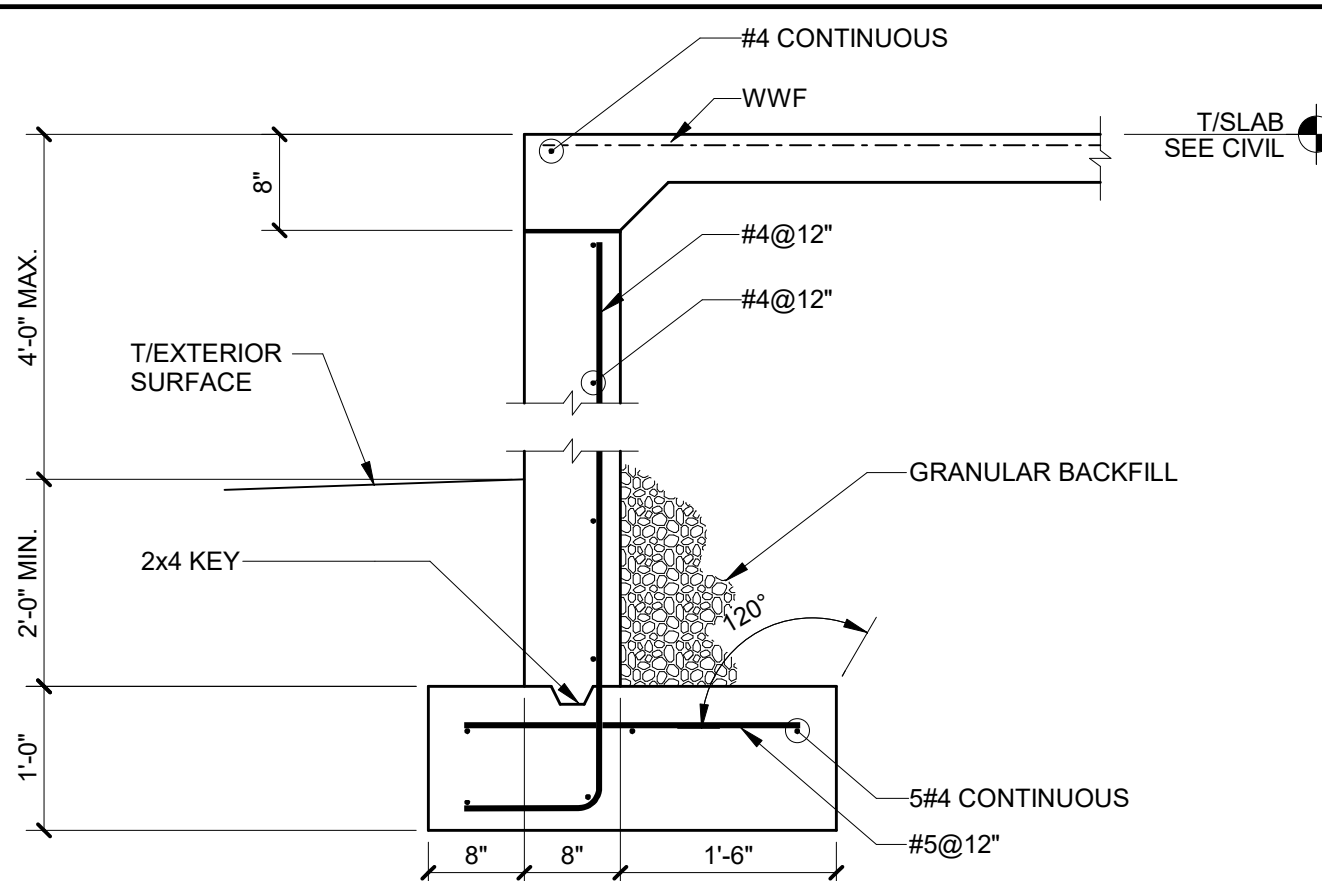


3 TYPICAL SECTION AT RETAINING WALL

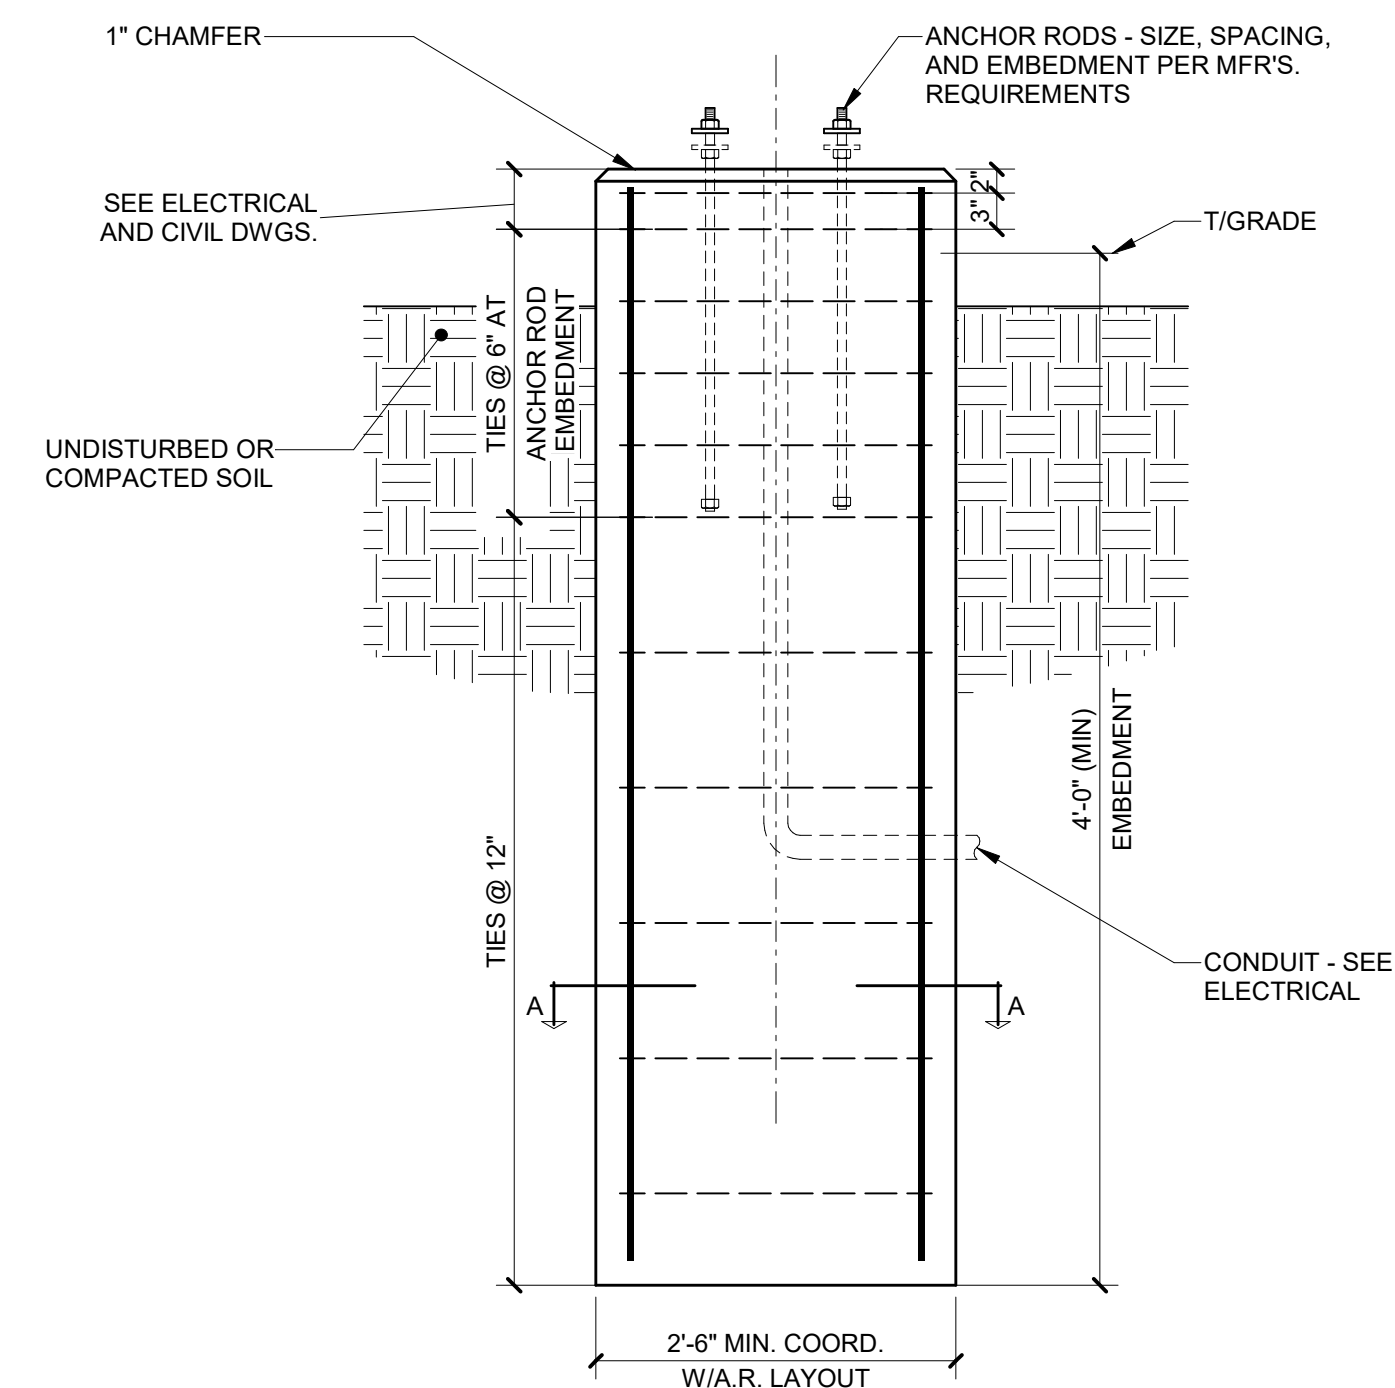


9 SITE LIGHT POLE FOUNDATION SECTION

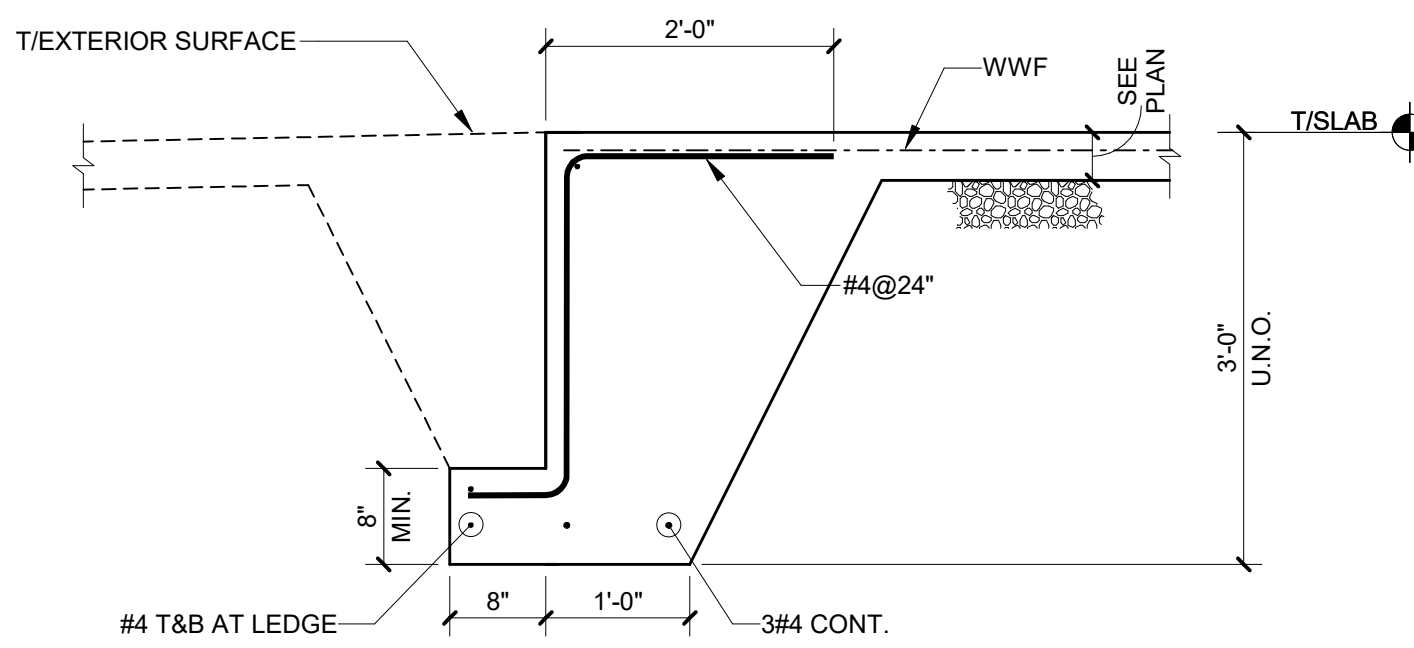


5 TYPICAL TURNED DOWN SLAB

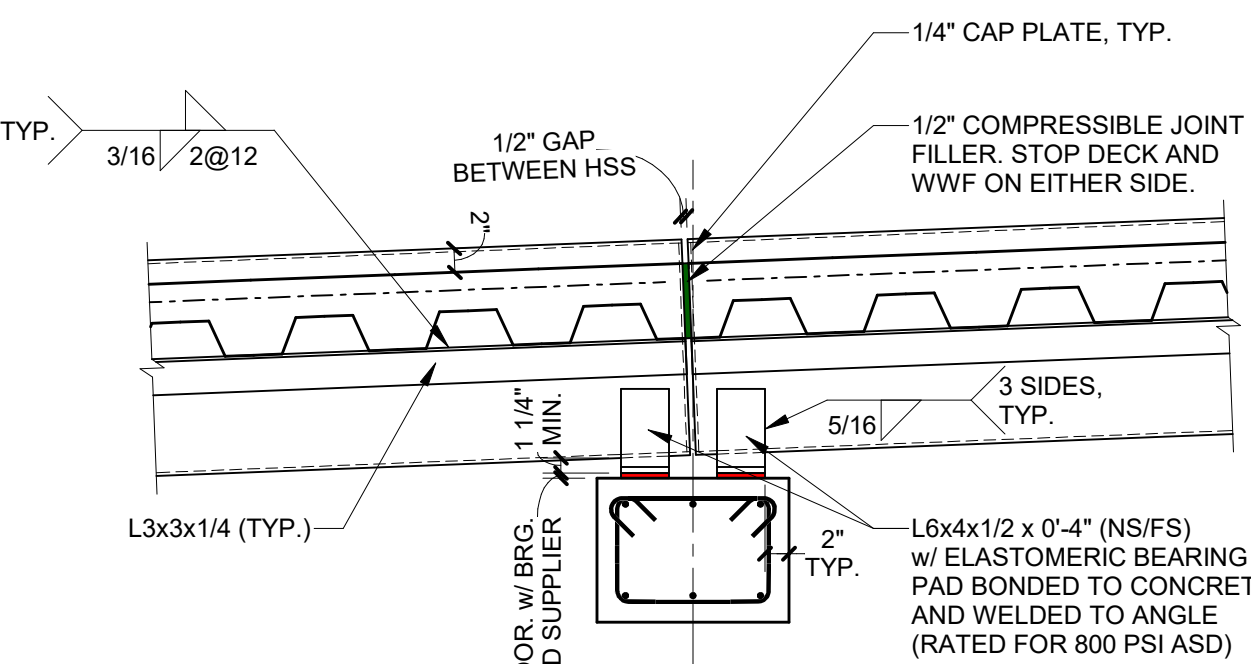


2 TYPICAL SECTION AT PEDESTRIAN BRIDGE

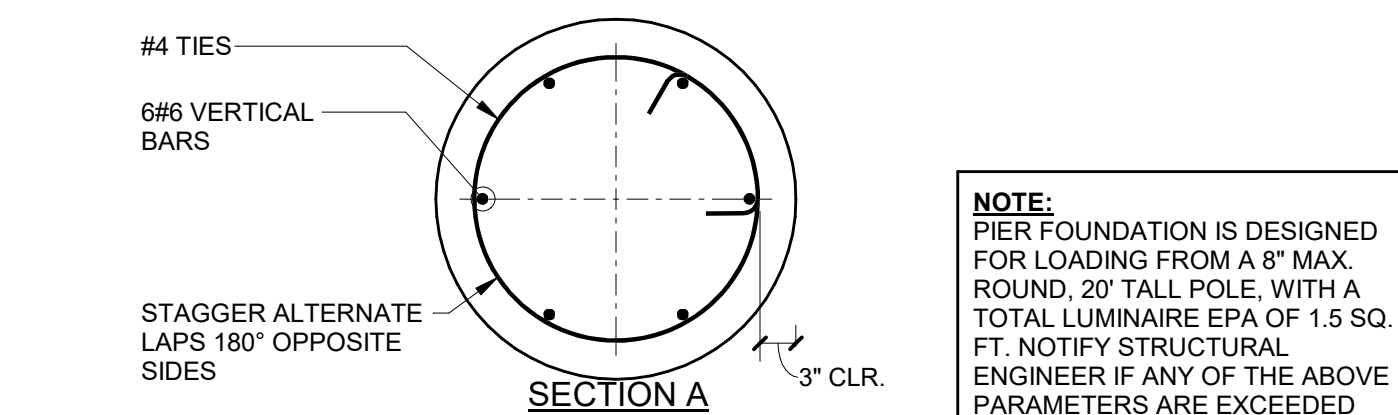

8 TYPICAL CONDUIT IN COMPOSITE SLAB DETAIL

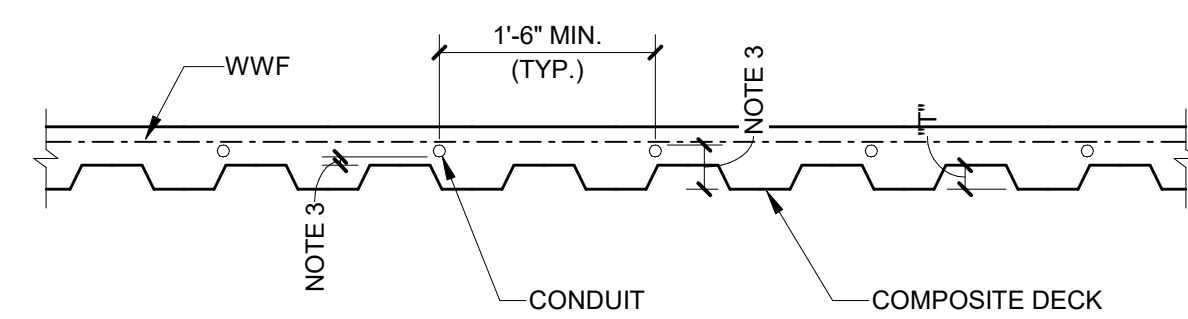

- NOTES:
1. OUTSIDE DIA. OF CONDUIT SHALL NOT EXCEED 1" NOR 1/3"
 2. CROSOVERS OF CONDUIT ARE NOT PERMITTED.
 3. MAINTAIN 3/4" MINIMUM CLEAR COVER TOP AND BOTTOM. DO NOT PLACE CONDUIT WITHIN DECK FLUTES.
 4. CONDUITS GROUPED TOGETHER NEAR JUNCTION BOXES SHALL BE REINFORCED AS SLAB OPENINGS.
 5. DO NOT PLACE CONDUIT WITHIN 3" CLEAR OF COMPOSITE BEAM SHEAR STUDS.

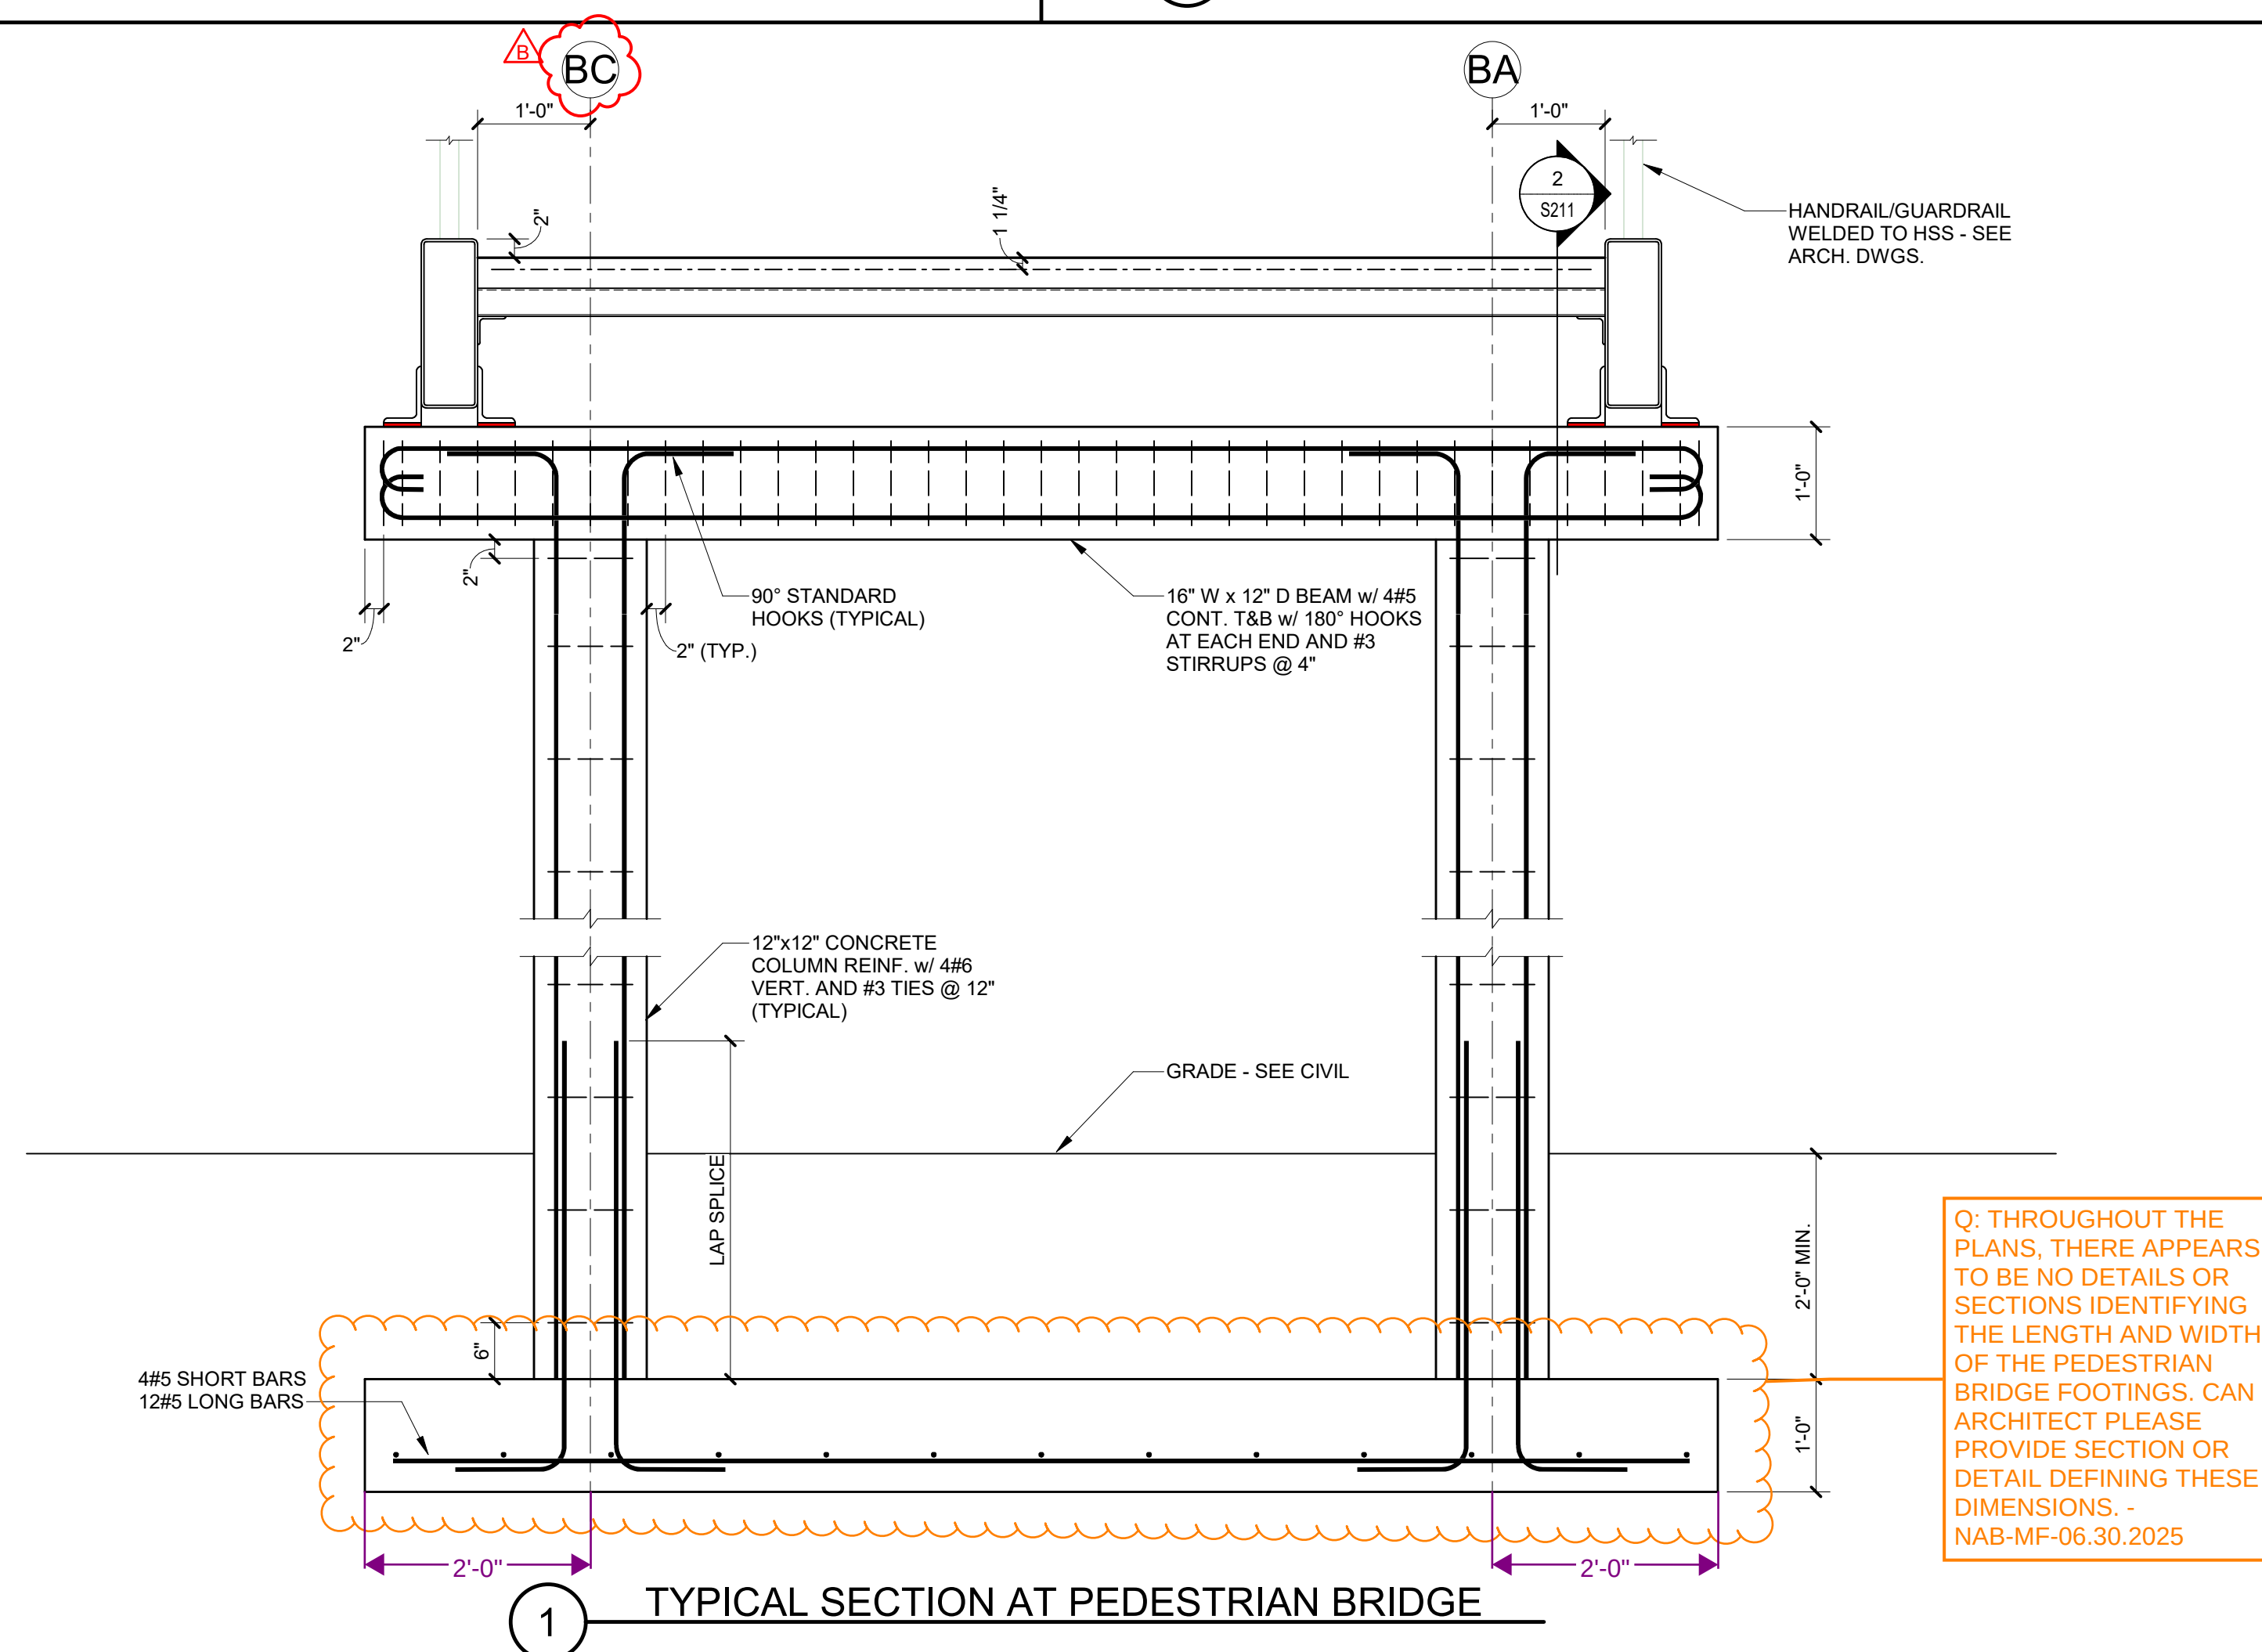

Q: THROUGHOUT THE PLANS, THERE APPEARS TO BE NO DETAILS OR SECTIONS IDENTIFYING THE LENGTH AND WIDTH OF THE PEDESTRIAN BRIDGE FOOTINGS. CAN ARCHITECT PLEASE PROVIDE SECTION OR DETAIL DEFINING THESE DIMENSIONS. -
NAB-MF-06.30.2025

Devenney Group Ltd., Architect

6900 East Camelback Road
Suite 500
Scottsdale, AZ 85251

T: 602.943.8950
www.devenneygroup.com

Consultant:



Structural Engineers

750 Old Hickory Blvd
Building 1, Suite 175
Brentwood, TN 37027

www.sdlal.com

615 320 1735

Project No. 24051.0



IF THESE PLANS DO NOT BEAR THE SEAL OF A REGISTRANT, THEY ARE TO BE CONSIDERED "PRELIMINARY" AND ARE NOT TO BE USED FOR CONSTRUCTION OR RECORDING. THESE PLANS ARE COPYRIGHTED AND ARE SUBJECT TO COPYRIGHT PROTECTION AS AN "ARCHITECTURAL WORK" UNDER SEC. 102 OF THE COPYRIGHT ACT, 17 U.S.O. AS AMENDED DECEMBER 1950 AND KNOWN AS ARCHITECTURAL WORKS COPYRIGHT PROTECTION ACT OF 1990. THE PROTECTION INCLUDES BUT IS NOT LIMITED TO THE OVERALL FORM AS WELL AS THE ARRANGEMENT AND SEQUENCE OF SPACES, ELEMENTS, PARTS, OR THE DESIGN, UNDER SUCH PROTECTION, UNAUTHORIZED USES OF THESE PLANS CAN LEGALLY RESULT IN THE CESSATION OF CONSTRUCTION OR BUILDINGS BEING SIZED AND/OR MONETARY COMPENSATION TO DEVENEY GROUP LTD.

MED SURG &
DIETARY
EXPANSION

HCA - LEE'S SUMMIT MEDICAL
CENTER
2100 SE BLUE PKWY
LEE'S SUMMIT, MO 64063

AUTHORITY HAVING JURISDICTION
CITY OF LEE'S SUMMIT BUILDING I
MISSOURI DHSS

FACILITY NUMBER
0972400009

AGENCY APPROVALS:
AGENCY


REVISIONS		
REV #	DESCRIPTION	DATE
B	DESIGN COORDINATION	2025/02/0

DATE: 2024/12/1
SCALE: 3/4" = 1'-0"
DRAWN:
REVIEWED: JL
JOB NUMBER: 6406..

PEDESTRIAN BRIDGE STRUCTURAL SECTIONS AND DETAILS

S211

P:\2024\20240037_Devenney - HCA Lee's Summit Medical Center - Med Surg Exp\dwg\Construction\20240037_GRA\dwg-C6.4 PEDESTRIAN BRIDGE PLAN & PROFILE Jan 31, 2025 willisard

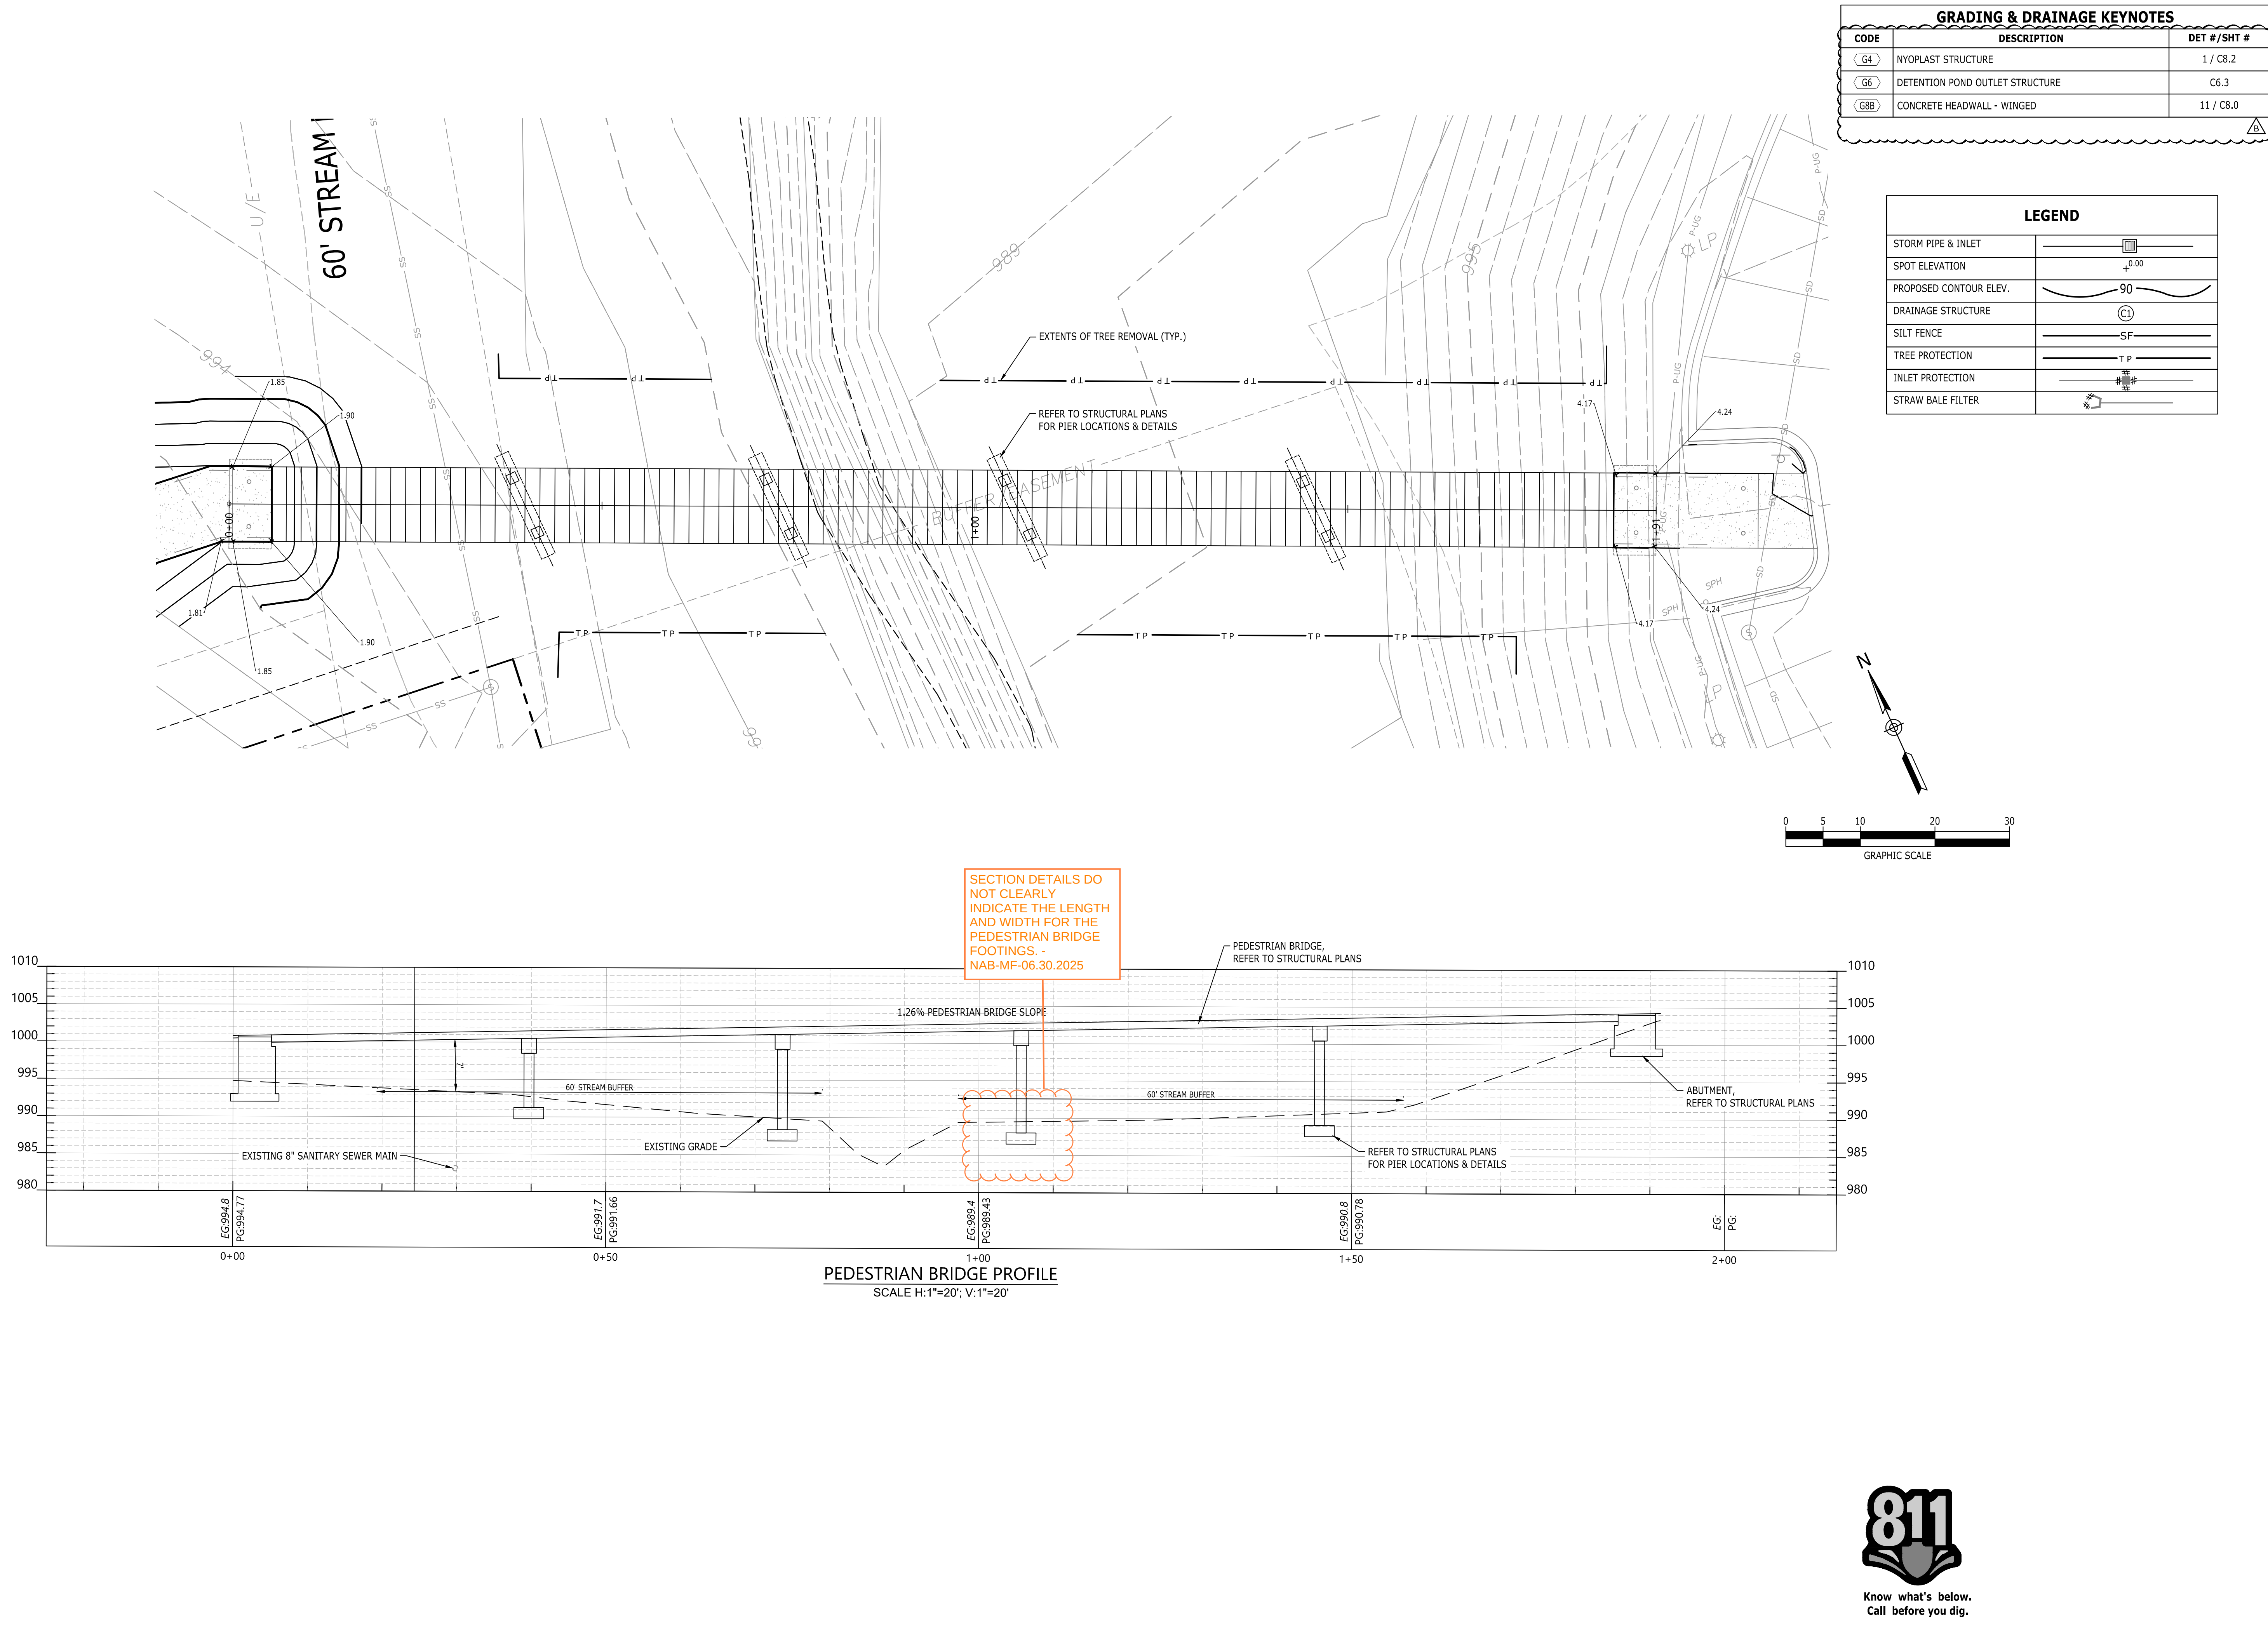

LEE'S SUMMIT
MEDICAL CENTER
2100 SE BLUE PARKWAY
LEE'S SUMMIT, MO 64063
816-282-5000

CONSTRUCTION DOCUMENTS
HCA LEE'S SUMMIT
MEDICAL CENTER
2000 SE SHENANDOAH DRIVE
LEE'S SUMMIT, MO. 64063
JACKSON COUNTY

NO.	DATE	DESIGN COORDINATION	DESCRIPTION
1	2025/02/05		

DRAWING TITLE
PEDESTRIAN BRIDGE
PLAN & PROFILE

PROJECT NUMBER
20240037

DRAWING NUMBER

C6.4

Devenney
GROUP

Devenney Group Ltd., Architects

6900 East Camelback Road
Suite 500
Scottsdale, AZ 85251


T: 602.943.8950

www.devenneygroup.com

Consultant:

Catalyst
DESIGN GROUP

1524 WILLIAMS DRIVE, SUITE 201, MURFREESBORO, TN 37129
(615) 622-7200 | WWW.CATALYST-DG.COM

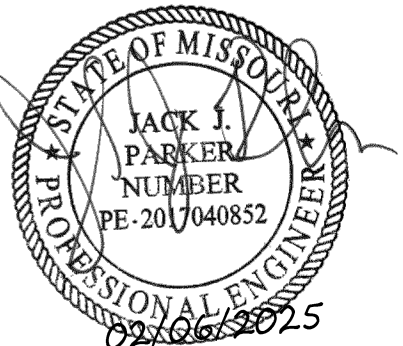

IF THESE PLANS DO NOT BEAR THE SEAL OF A REGISTRANT, THEY ARE TO BE CONSIDERED "PRELIMINARY" AND ARE NOT TO BE USED FOR CONSTRUCTION OR RECORDING. THESE PLANS ARE COPYRIGHTED AND ARE SUBJECT TO COPYRIGHT PROTECTION AS AN "ARCHITECTURAL WORK" UNDER SEC. 102 OF THE COPYRIGHT ACT, 17 U.S.C. 101-102, AS AMENDED (OCTOBER 1990) AND KNOWN AS ARCHITECTURAL WORKS COPYRIGHT PROTECTION ACT OF 1990. THE PROTECTION INCLUDES BUT IS NOT LIMITED TO THE OVERALL FORM AS WELL AS THE ARRANGEMENT AND COMPOSITION OF SPACES AND ELEMENTS OF THE DESIGN. UNDER SUCH PROTECTION, UNAUTHORIZED USE OF THESE PLANS CAN LEGALLY RESULT IN THE CESSATION OF CONSTRUCTION OR BUILDINGS BEING SEIZED AND/OR MONETARY COMPENSATION TO DEVENNEY GROUP LTD.

INPATIENT BED EXPANSION

HCA - LEE'S SUMMIT
MEDICAL CENTER
2100 SE BLUE PKWY
LEE'S SUMMIT, MO 64063

AUTHORITY HAVING JURISDICTION:
CITY OF LEE'S SUMMIT BUILDING DEPT.
MISSOURI DHSS

FACILITY NUMBER:
0972400099


AGENCY APPROVALS:
AGENCY

REVISIONS		
REV #	DESCRIPTION	DATE
B	DESIGN COORDINATION	2025/02/06

DATE: 2024/12/05
SCALE: 1:10
DRAWN: AP
REVIEWED: WB
JOB NUMBER: 6406.24

PEDESTRIAN BRIDGE
PLAN & PROFILE

C6.4

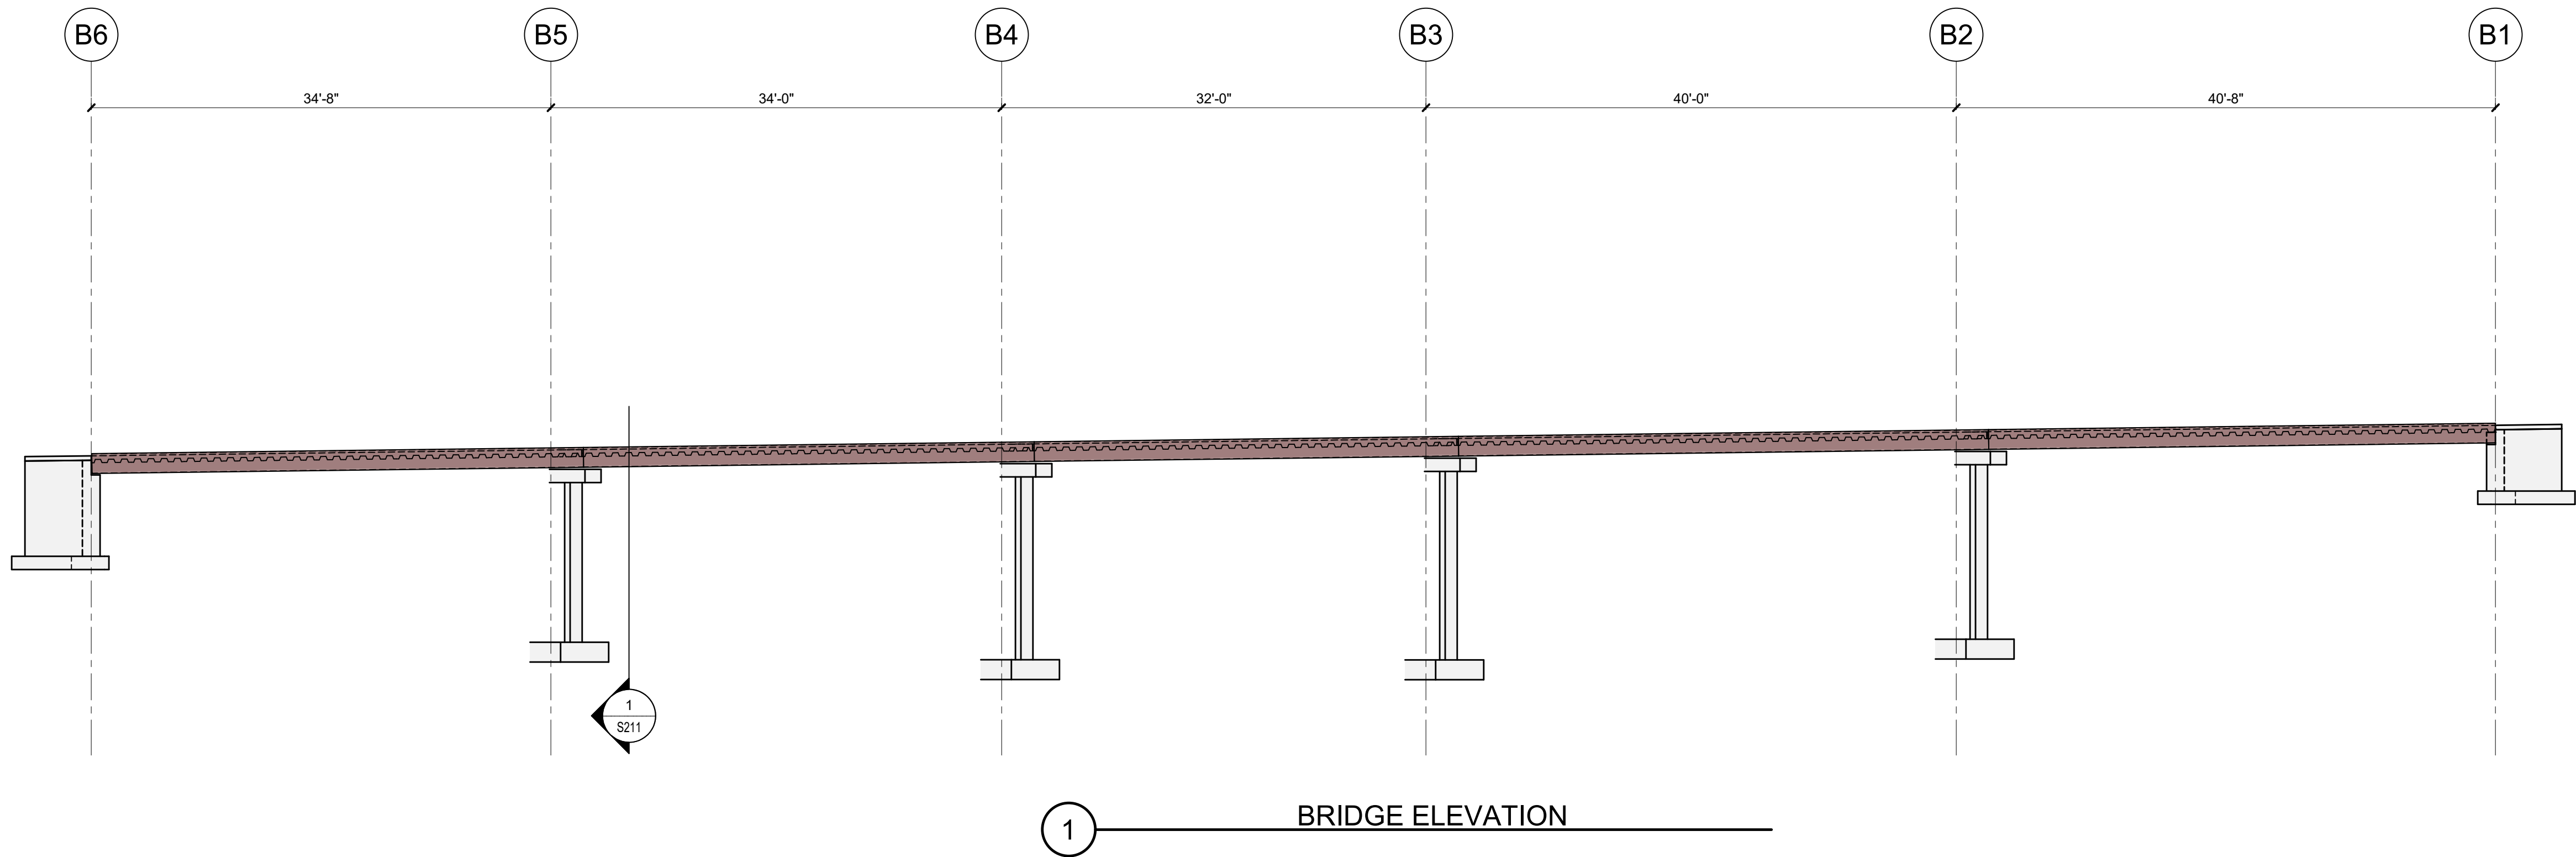

- NOTES:**
1. REFERENCE ELEVATION 1006.29' = 0'-0" (REFER TO CIVIL DRAWINGS)
 2. FOUNDATION ELEMENTS ARE CENTERED UNDER COLUMNS UNLESS NOTED OTHERWISE
 3. REFER TO ARCHITECTURAL AND CIVIL DRAWINGS FOR DIMENSIONS NOT SHOWN. COORDINATE ALL DIMENSIONS WITH ARCHITECTURAL AND CIVIL DRAWINGS
 4. TOP OF SLAB ELEVATIONS ARE APPROXIMATE. REFER TO CIVIL DRAWINGS FOR TOP OF SLAB ELEVATIONS AND SLOPES.



Devenney Group Ltd., Architects
6900 East Camelback Road
Suite 500
Scottsdale, AZ 85251
T: 602.943.8950
www.devenneygroup.com

Consultant:



Structural Engineers
750 Old Hickory Blvd.
Building 1, Suite 175
Brentwood, TN 37027
www.sdi-al.com
615 320 1735



IF THESE PLANS DO NOT BEAR THE SEAL OF A REGISTRANT, THEY ARE TO BE CONSIDERED "PRELIMINARY" AND ARE NOT TO BE USED FOR CONSTRUCTION OR RECORDING. THESE PLANS ARE COPYRIGHTED AND ARE SUBJECT TO COPYRIGHT PROTECTION AS AN "ARCHITECTURAL WORK" UNDER SEC. 102 OF THE COPYRIGHT ACT, 17 U.S.C. AS AMENDED DECEMBER 1990 AND KNOWN AS ARCHITECTURAL WORKS COPYRIGHT PROTECTION ACT OF 1990. THE PROTECTION INCLUDES BUT IS NOT LIMITED TO THE OVERALL FORM AS WELL AS THE ARRANGEMENT AND COMPOSITION OF SPACES AND ELEMENTS OF THE DESIGN. UNDER SUCH PROTECTION, UNAUTHORIZED USE OF THESE PLANS CAN LEGALLY RESULT IN THE CEASATION OF CONSTRUCTION OR BUILDINGS BEING SIZED AND/OR MONETARY COMPENSATION TO DEVENNEY GROUP LTD.

MED SURG & DIETARY EXPANSION

HCA - LEE'S SUMMIT MEDICAL CENTER
2100 SE BLUE PKWY
LEE'S SUMMIT, MO 64063

AUTHORITY HAVING JURISDICTION:
CITY OF LEE'S SUMMIT BUILDING DEPT.
MISSOURI DHSS

FACILITY NUMBER:
0972400009



AGENCY APPROVALS:
AGENCY

REVISIONS		
REV #	DESCRIPTION	DATE

DATE: 2024/12/05
SCALE: 1/8" = 1'-0"
DRAWN: JL
REVIEWED: JDP
JOB NUMBER: 6406.24

PEDESTRIAN BRIDGE
FOUNDATION AND
FRAMING PLANS


S120

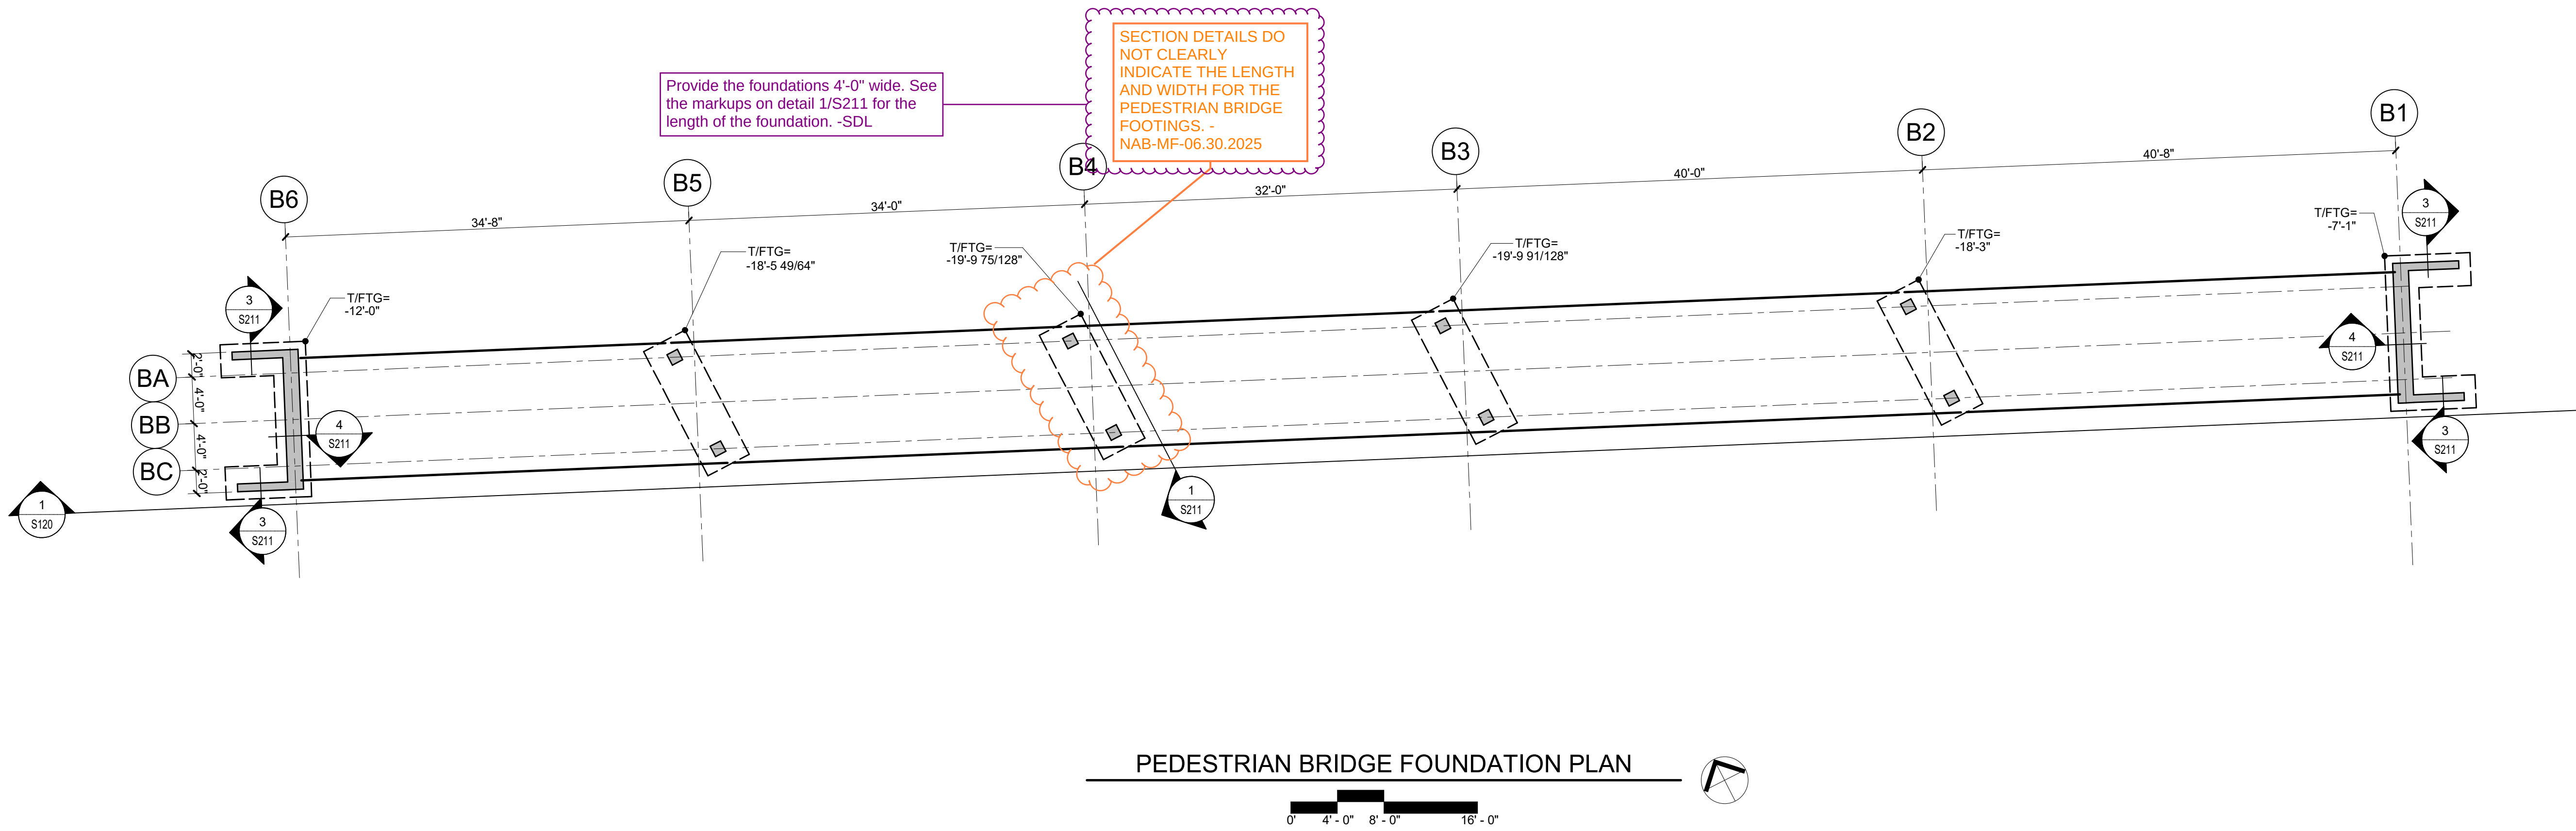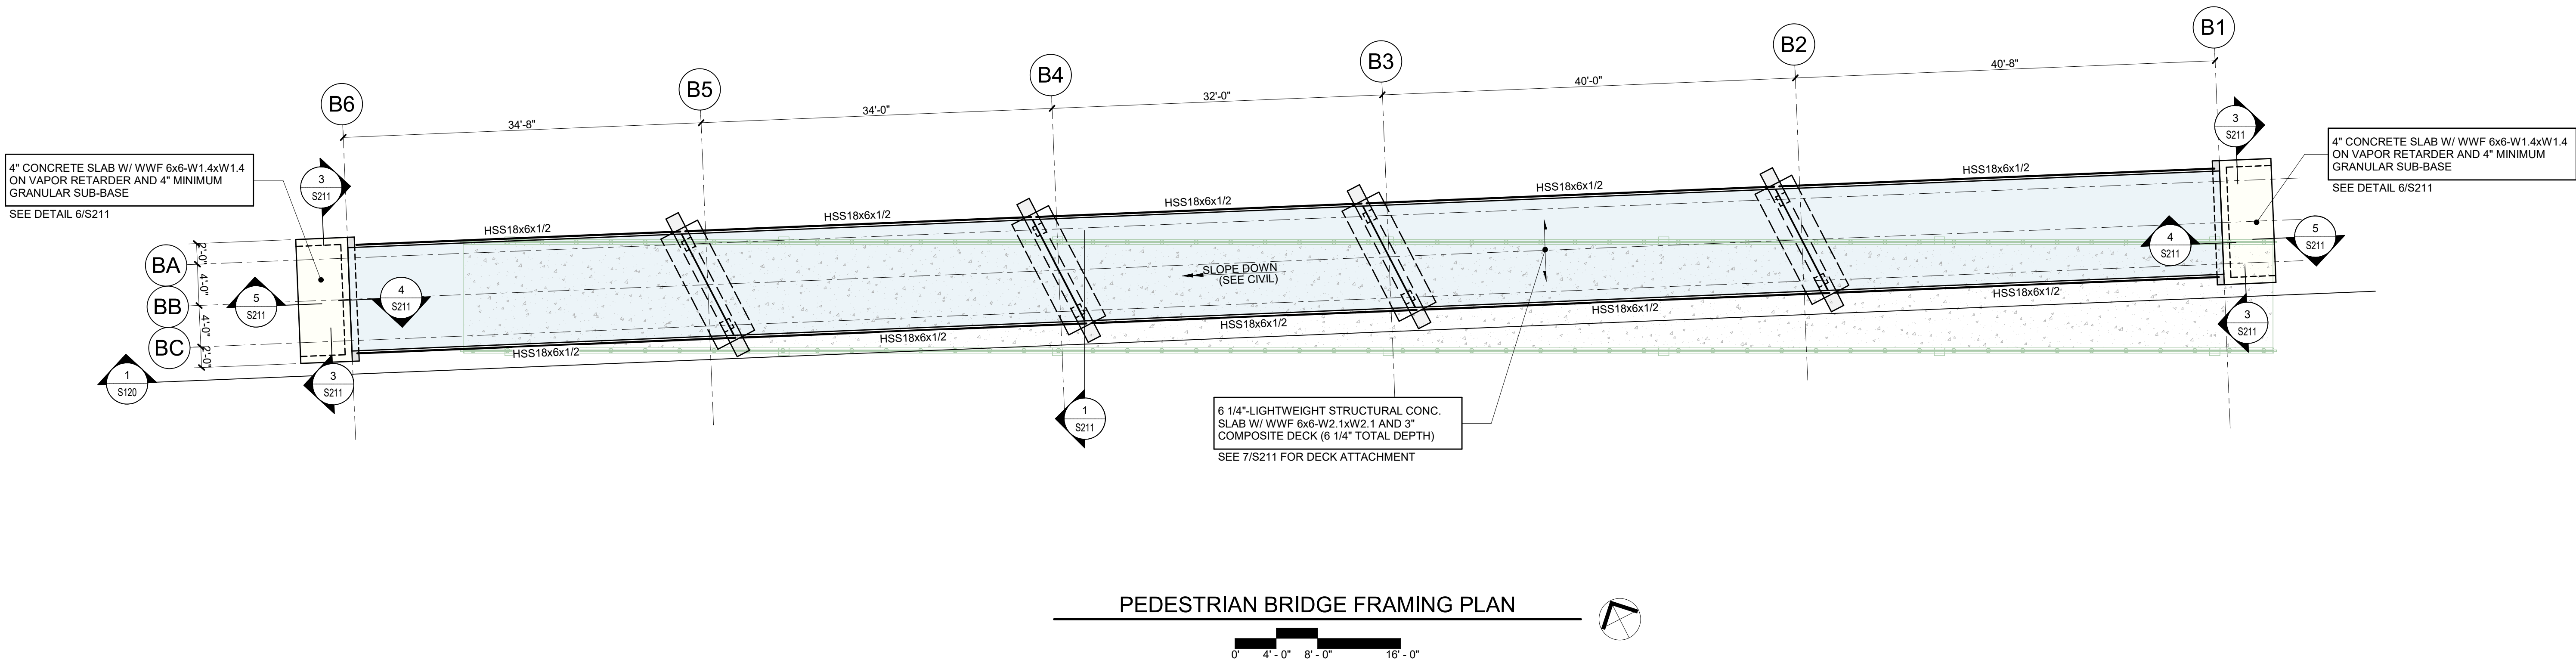



Devenney Group Ltd., Architects
6900 East Camelback Road
Suite 500
Scottsdale, AZ 85251
T: 602.943.8950
www.devenneygroup.com

Consultant:

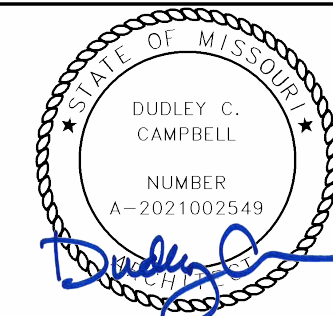

DATE SIGNED: 12.05.24

IF THESE PLANS DO NOT BEAR THE SEAL OF A REGISTRANT, THEY ARE TO BE CONSIDERED "PRELIMINARY" AND ARE NOT TO BE USED FOR CONSTRUCTION OR RECORDING. THESE PLANS ARE COPYRIGHTED AND ARE SUBJECT TO COPYRIGHT PROTECTION AS AN "ARCHITECTURAL WORK" UNDER SEC. 102 OF THE COPYRIGHT ACT, 17 U.S.C. AS AMENDED DECEMBER 1990 AND KNOWN AS ARCHITECTURAL WORKS COPYRIGHT PROTECTION ACT OF 1990. THE PROTECTION INCLUDES BUT IS NOT LIMITED TO THE OVERALL FORM AS WELL AS THE ARRANGEMENT AND COMPOSITION OF SPACES AND ELEMENTS OF THE DESIGN. UNDER SUCH PROTECTION, UNAUTHORIZED USE OF THESE PLANS CAN LEGALLY RESULT IN THE SEIZURE OF CONSTRUCTION OR BUILDINGS BEING SEIZED AND/OR MONETARY COMPENSATION TO DEVENNEY GROUP LTD.

MED SURG & DIETARY EXPANSION

HCA - LEE'S SUMMIT MEDICAL CENTER
2100 SE BLUE PKWY
LEE'S SUMMIT, MO 64063

AUTHORITY HAVING JURISDICTION:
CITY OF LEE'S SUMMIT BUILDING DEPT.
MISSOURI DHSS

FACILITY NUMBER:
0972400009


AGENCY APPROVALS:
AGENCY

REVISIONS		
REV #	DESCRIPTION	DATE

DATE: 2024/12/05
SCALE: As indicated
DRAWN:
REVIEWED:
JOB NUMBER: 6406.24


SITE DETAILS

AS501

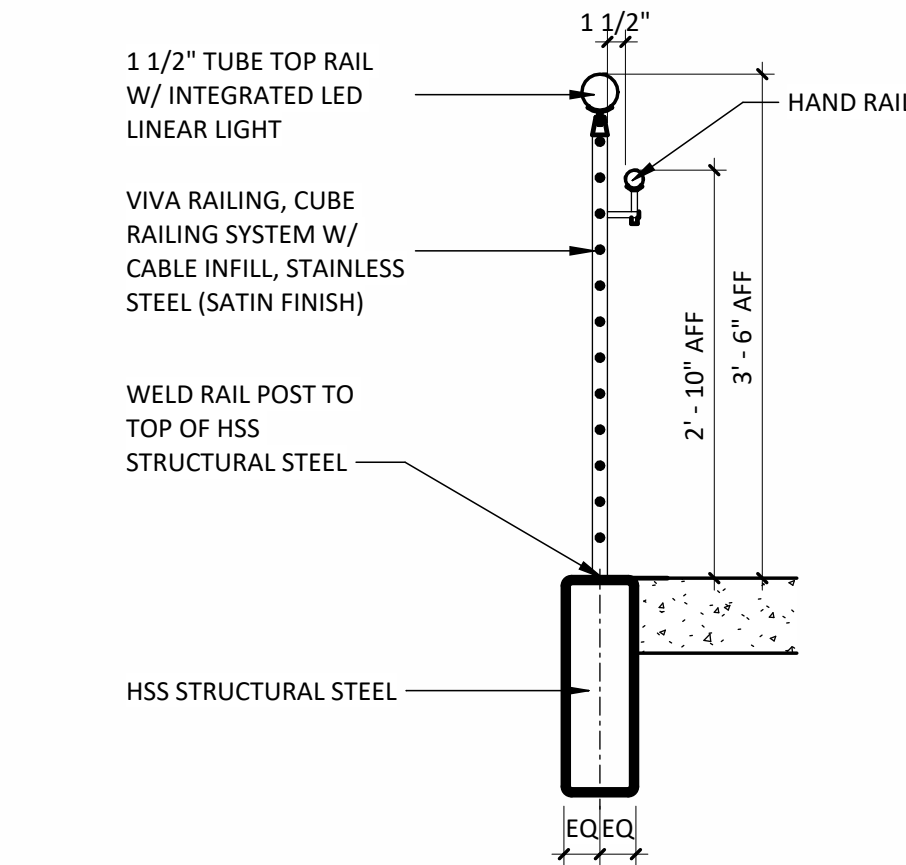

3 GUARDRAIL/HANDRAIL SECTION AT BRIDGE


3/4" = 1'-0"

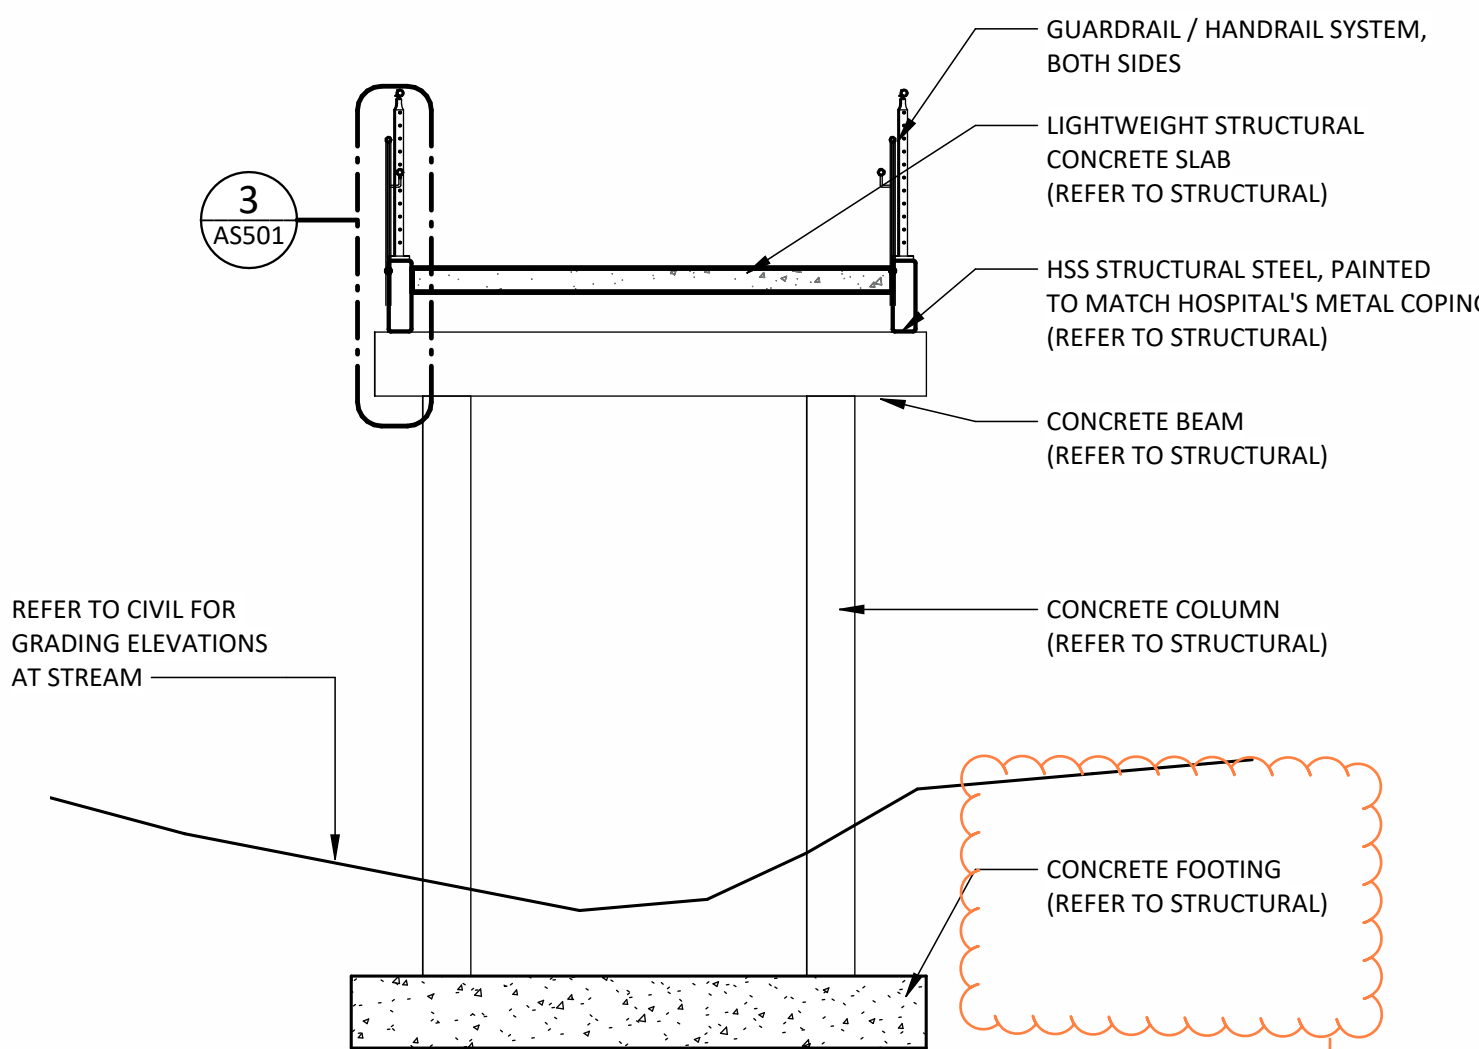

2 PEDESTRIAN BRIDGE SECTION

1/4" = 1'-0"

SECTION DETAIL REFERENCES THE STRUCTUAL DRAWINGS FOR DETAILS ON THE PEDESTRIAN BRIDGE FOOTINGS, HOWEVER, NO STRUCTURAL DETAILS DEFINE THE FOOTINGS LENGTH AND WIDTH. - NAB-MF-06.30.2025

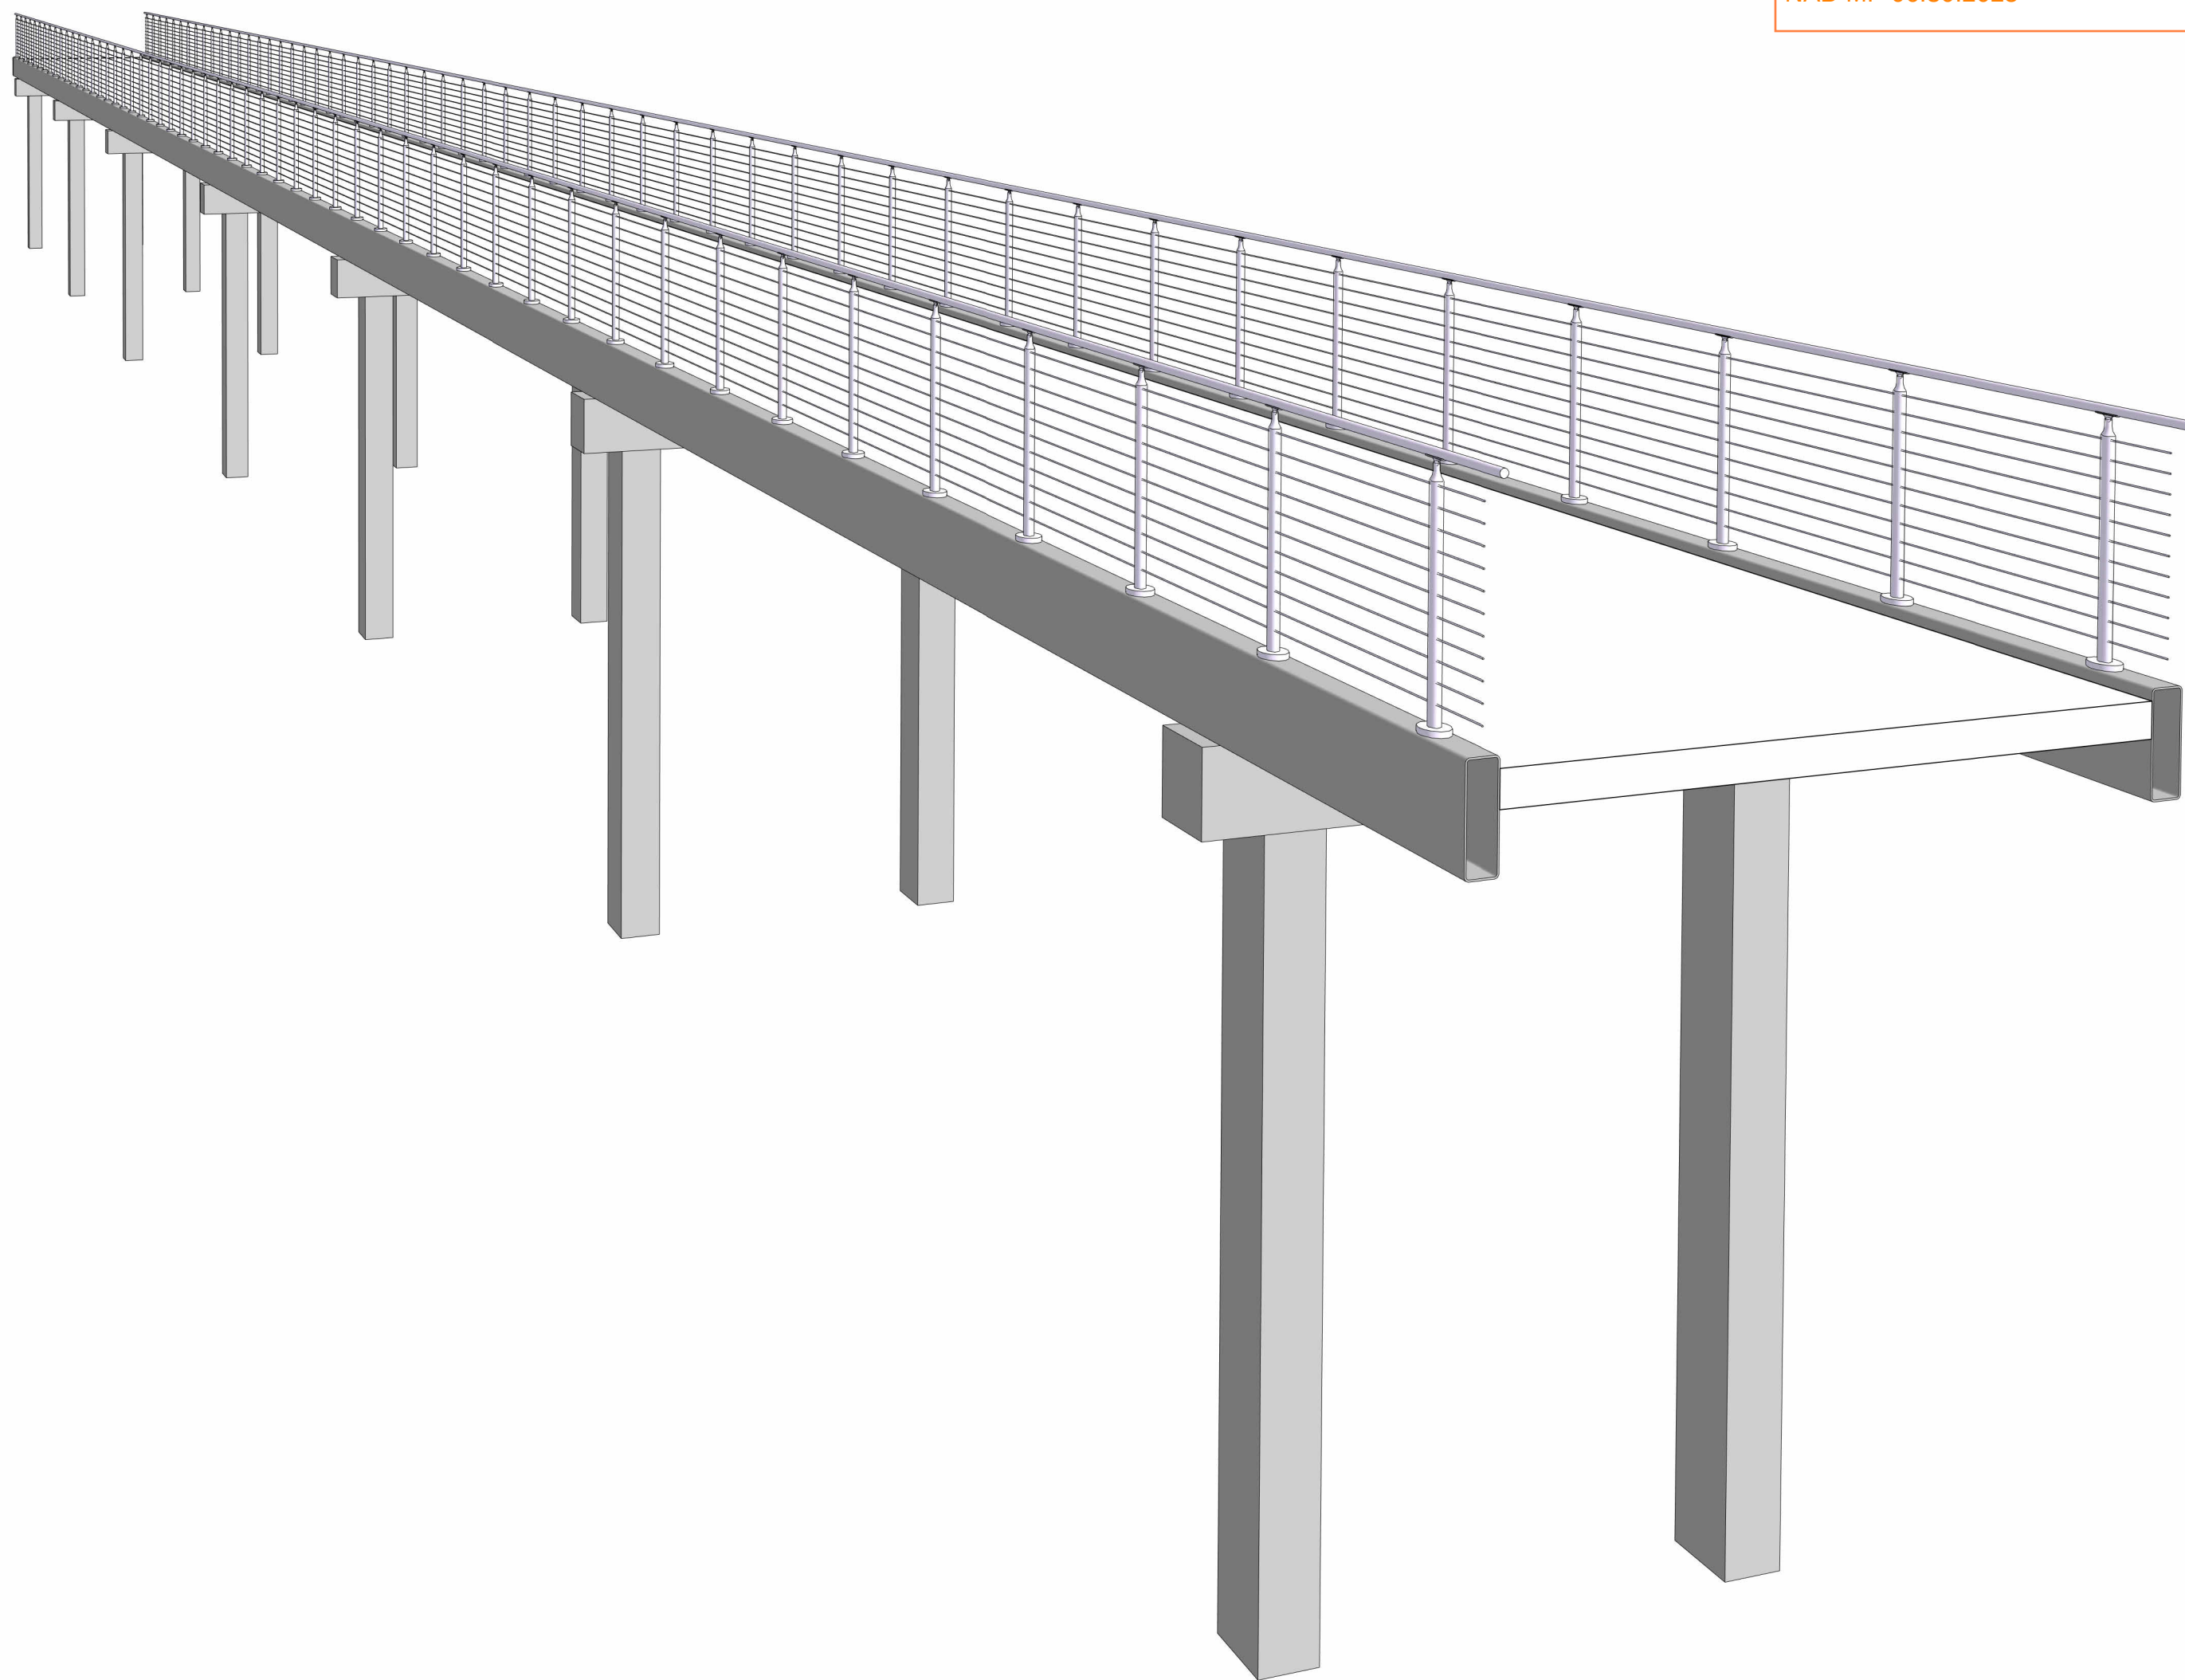

1 PEDESTRIAN BRIDGE

Autodesk Docs://6406.24-HCA- Lee's Summit Medical Center (LSMC)_rvt23/6406.24.0001 HCA - LSMC Med Surg & Dietary Expansion.rvt 12/16/2024 7:11:39 AM