



Nabholz Construction - Lenexa
17300 W 116th Street
Lenexa, Kansas 66219
P: (913) 393-6500

Project: 08-25-3311 HCA LSMC CAMPUS EXPANSION
2100 SE BLUE PARKWAY
LEE'S SUMMIT, Missouri 64063

RFI #050: Retaining Wall Elevations and Footing Steps

Revision	0	Status	Closed on 10/03/25
To	Lance Stadick (Nabholz Construction Corporation) (<i>Response Required</i>)	From	David Panto (Nabholz Construction Corporation)
Date Initiated	Sep 16, 2025	Due Date	Sep 23, 2025
Location	Civil Expansion	Project Stage	Pre-Construction
Cost Impact	TBD	Schedule Impact	TBD
Spec Section			
Drawing Number	C6.3	Reference	
Linked Drawings			
Copies To	Shannon Gould (LITHKO CONTRACTING LLC), Don Kelley (Nabholz Construction Corporation), David Panto (Nabholz Construction Corporation), Vince Praderio (LITHKO CONTRACTING LLC), Lance Stadick (Nabholz Construction Corporation)		
Priority			
Constraint			

Activity

Question

Question from David Panto Nabholz Construction Corporation on Monday, Sep 15, 2025 at 02:04 PM CDT

Can you confirm the retaining wall elevations and footing steps?

Drawing C6.3 shows the retaining wall on the west end to have elevations of TW: 996.50 and FG: 996.05 (i.e. wall height of 5-3/8"). On the east end the elevations are TW: 996.05 and FG: 996.05 (i.e. wall height same elevation as footing). At the tallest point, the retaining wall has an elevation of TW: 996.05 and FG: 993.05 (i.e. wall height of 3'-0"). Can you confirm these are the correct elevations?

Can you also confirm the locations for the footing steps as elevation changes?

Attachments

[retaining wall elevations and footing steps.pdf](#)

Official Response

Response from Luke Arbanas Nabholz Construction Corporation on Friday, Oct 3, 2025 at 09:43 AM CDT

CDG Response: Refer to attached mark up. Steps in the footer can be made as shown; however, since they are smaller sections that can be "stepped" due to the 3:1 slope, it may not be as constructible, contractor to confirm feasibility.

Attachments

[RFI-050-retaining_wall_elevations_and_footing_steps_CDG Response.pdf](#)

All Replies**Response from Luke Arbanas Nabholz Construction Corporation** on *Friday, Oct 3, 2025 at 09:43 AM CDT*

CDG Response: Refer to attached mark up. Steps in the footer can be made as shown; however, since they are smaller sections that can be "stepped" due to the 3:1 slope, it may not be as constructible, contractor to confirm feasibility.

Attachments[RFI-050-retaining_wall_elevations_and_footing_steps_CDG Response.pdf](#)



Nabholz Construction - Lenexa
17300 W 116th Street
Lenexa, Kansas 66219
P: (913) 393-6500

Project: 08-25-3311 HCA LSMC CAMPUS EXPANSION
2100 SE BLUE PARKWAY
LEE'S SUMMIT, Missouri 64063

RFI #050: Retaining Wall Elevations and Footing Steps

Revision	0	Status	Open
To	Luke Arbanas (Nabholz Construction Corporation) (Response Required) Lance Stadick (NABHOLZ CONSTRUCTION KANSAS) (Response Required)	From	David Panto (Nabholz Construction Corporation)
Date Initiated	Sep 16, 2025	Due Date	Sep 23, 2025
Location	Civil Expansion	Project Stage	Pre-Construction
Cost Impact	TBD	Schedule Impact	TBD
Spec Section			
Drawing Number	C6.3	Reference	
Linked Drawings			
Copies To	Shannon Gould (LITHKO CONTRACTING LLC), Don Kelley (Nabholz Construction Corporation), David Panto (Nabholz Construction Corporation), Vince Praderio (LITHKO CONTRACTING LLC), Lance Stadick (NABHOLZ CONSTRUCTION KANSAS)		
Priority			
Constraint			

Activity

Question

Question from David Panto Nabholz Construction Corporation on Monday, Sep 15, 2025 at 02:04 PM CDT

Can you confirm the retaining wall elevations and footing steps?

Drawing C6.3 shows the retaining wall on the west end to have elevations of TW: 996.50 and FG: 996.05 (i.e. wall height of 5-3/8"). On the east end the elevations are TW: 996.05 and FG: 996.05 (i.e. wall height same elevation as footing). At the tallest point, the retaining wall has an elevation of TW: 996.05 and FG: 993.05 (i.e. wall height of 3'-0"). Can you confirm these are the correct elevations?


Can you also confirm the locations for the footing steps as elevation changes?

Attachments

[retaining wall elevations and footing steps.pdf](#)

Awaiting an Official Response

CDG Response: Refer to attached mark up. Steps in the footer can be made as shown; however, since they are smaller sections that can be "stepped" due to the 3:1 slope, it may not be as constructible, contractor to confirm feasibility.

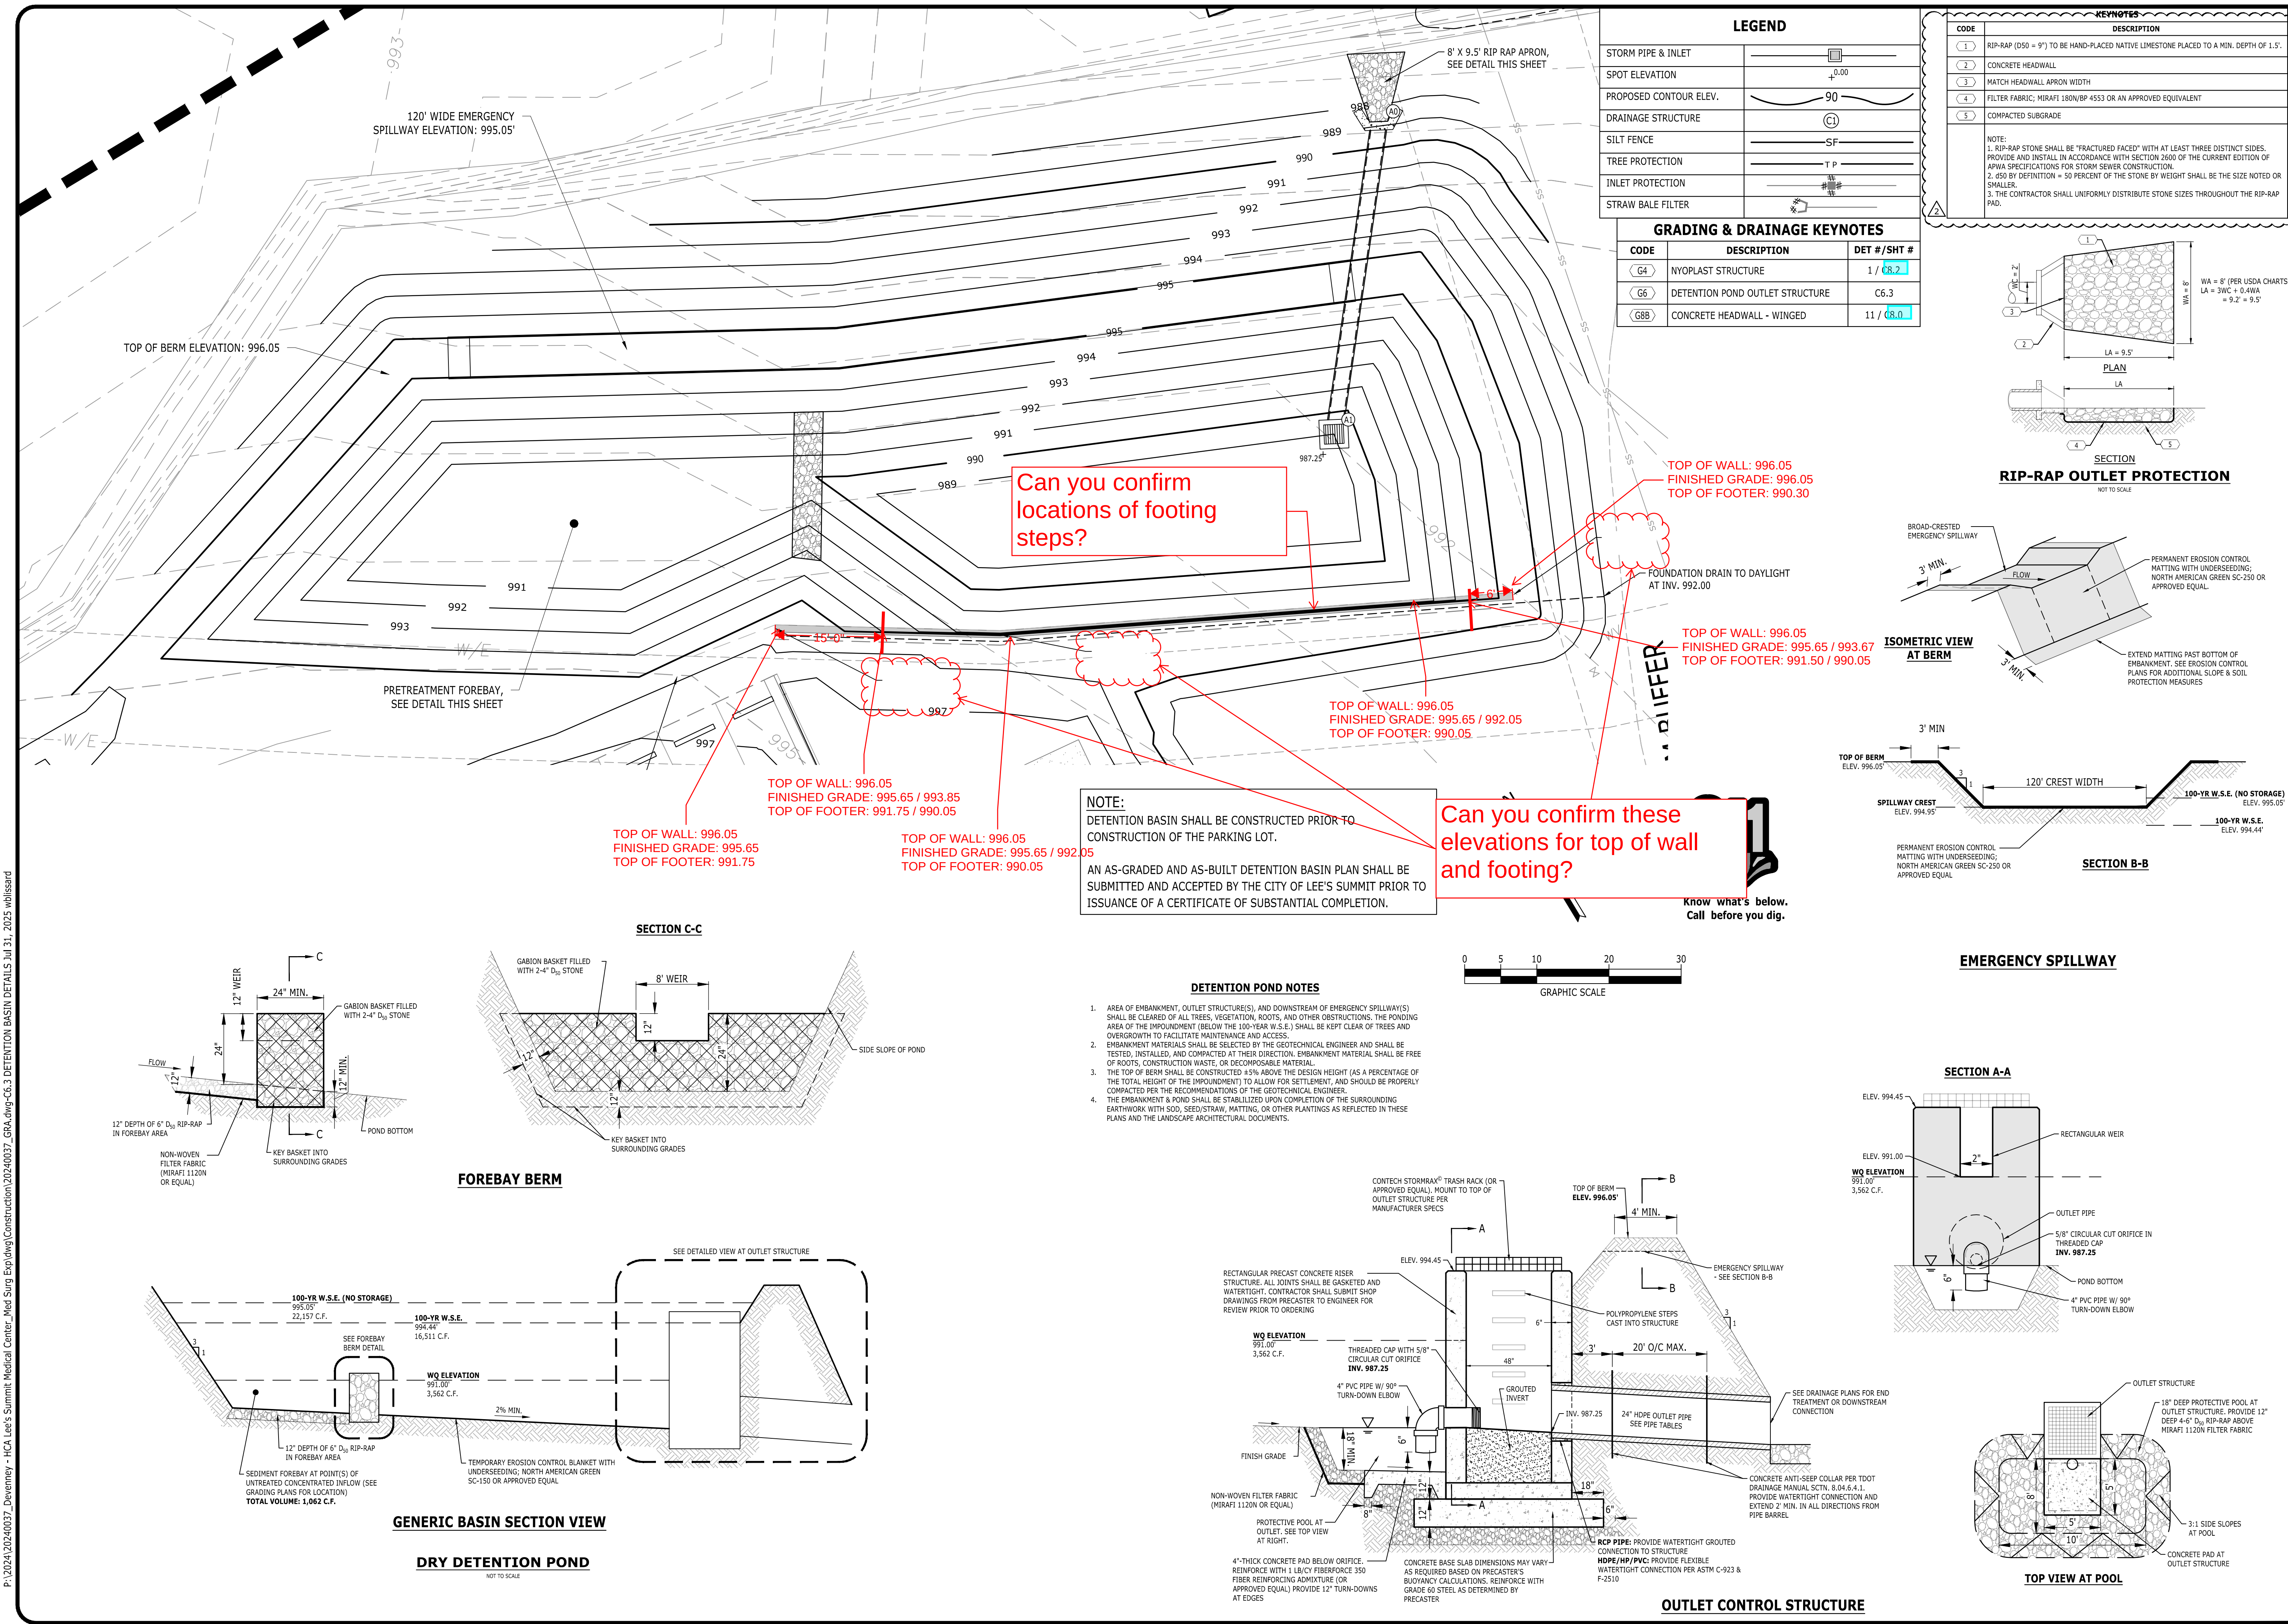

Catalyst
DESIGN GROUP

1524 WILLIAMS DRIVE, SUITE 201, MURFREESBORO, TN 37129
(615) 622-7200 | WWW.CATALYST-DG.COM

LEE'S SUMMIT
MEDICAL CENTER
2100 SE BLUE PARKWAY
LEE'S SUMMIT, MO 64063
816-282-5000

CONSTRUCTION DOCUMENTS

HCA LEE'S SUMMIT
MEDICAL CENTER
2000 SE SHENANDOAH DRIVE
LEE'S SUMMIT, MO 64063
JACKSON COUNTY

NO.	DATE	DESCRIPTION
1	07/25/2025	DESIGN COORDINATION
2	2025/07/06	DESIGN COORDINATION
3	2025/07/06	CITY - 2ND REVIEW

DRAWING TITLE

DETENTION BASIN
DETAILS

PROJECT NUMBER
20240037

DRAWING NUMBER
C6.3

Devenney
GRO P

Devenney Group Ltd., Architects

6900 East Camelback Road
Suite 500
Scottsdale, AZ 85251

T: 602.943.8950

www.devenneygroup.com

Consultant:

Catalyst
DESIGN GROUP

1524 WILLIAMS DRIVE, SUITE 201, MURFREESBORO, TN 37129
(615) 622-7200 | WWW.CATALYST-DG.COM

JACKSON COUNTY
PLANNING & ZONING
DEPARTMENT

PLANNING & ZONING
COMMISSION

OFFICIAL SEAL

IF THESE PLANS DO NOT BEAR THE SEAL OF A REGISTRANT, THEY ARE TO BE CONSIDERED "PRELIMINARY" AND ARE NOT TO BE USED FOR CONSTRUCTION OR RECORDING. THESE PLANS ARE COPYRIGHTED AND ARE SUBJECT TO COPYRIGHT PROTECTION AS AN "ARCHITECTURAL WORK" UNDER SEC. 102 OF THE COPYRIGHT ACT, 17 U.S.C. AS AMENDED (DECEMBER 1992) AND KNOWN AS ARCHITECTURAL WORKS COPYRIGHT PROTECTION ACT OF 1990. THE PROTECTION INCLUDES BUT IS NOT LIMITED TO THE OVERALL FORM AS WELL AS THE ARRANGEMENT AND COMPOSITION OF SPACES AND ELEMENTS OF THE DESIGN. UNDER SUCH PROTECTION, UNAUTHORIZED USE OF THESE PLANS CAN LEGALLY RESULT IN THE CESSATION OF CONSTRUCTION OR BUILDINGS BEING SEIZED AND/OR MONETARY COMPENSATION TO DEVENNEY GROUP, LTD.

INPATIENT BED
EXPANSION

HCA - LEE'S SUMMIT
MEDICAL CENTER
2100 SE BLUE PKWY
LEE'S SUMMIT, MO 64063

AUTHORITY HAVING JURISDICTION:
CITY OF LEE'S SUMMIT BUILDING DEPT.
MISSOURI DHSS

FACILITY NUMBER:
0972400009

AGENCY APPROVALS:
AGENCY

REVISIONS		
REV #	DESCRIPTION	DATE
A	CITY - 2ND REVIEW	2025/02/06
B	DESIGN COORDINATION	2025/02/06
2	DESIGN COORDINATION	2025/07/25

DATE: 2025/07/25
SCALE: 1:10
DRAWN: AP
REVIEWED: WB
JOB NUMBER: 6406.24

DETENTION BASIN
DETAILS

C6.3