



Nabholz Construction - Lenexa
17300 W 116th Street
Lenexa, Kansas 66219
P: (913) 393-6500

Project: 08-25-3311 HCA LSMC CAMPUS EXPANSION
2100 SE BLUE PARKWAY
LEE'S SUMMIT, Missouri 64063

RFI #055: Civil - Pedestrian bridge elevated walk confirmation

Revision	0	Status	Closed on 10/03/25
To	Luke Arbanas (Nabholz Construction Corporation)	From	David Panto (Nabholz Construction Corporation)
Date Initiated	Sep 22, 2025	Due Date	Oct 1, 2025
Location	Civil Expansion	Project Stage	Pre-Construction
Cost Impact	TBD	Schedule Impact	TBD
Spec Section			
Drawing Number	C5.1 & C8.2	Reference	
Linked Drawings			
Copies To	Shannon Gould (LITHKO CONTRACTING LLC), Don Kelley (Nabholz Construction Corporation), David Panto (Nabholz Construction Corporation), Vince Praderio (LITHKO CONTRACTING LLC)		
Priority	Medium		
Constraint			

Activity

Question	Question from David Panto Nabholz Construction Corporation on Monday, Sep 22, 2025 at 11:46 AM CDT <u>Can you confirm the elevated walks on the pedestrian bridge as described below?</u> We made a drawing from our understanding of what the west side of the pedestrian elevated walk would look like following detail 3 on C8.2 (see attached). <u>Please confirm if this is acceptable.</u> Due to the similar elevation from existing of the elevated walk on the east side, it is our understanding that we will be able to follow the turndown slab as shown on detail 3 on C8.2, so we did not create a drawing for this. Attachments pedestrian bridge elevated walk.pdf
Official Response	Response from Luke Arbanas Nabholz Construction Corporation on Friday, Oct 3, 2025 at 10:01 AM CDT CDG Response: Refer to the mark up on the sketches, it appears the top of footers can be raised in some areas based on proposed finished grade and the details' parameters. Attachments RFI-055-civil_-_pedestrian_bridge_elevated_walk_confirmation_CDG Response.pdf
All Replies	Response from Luke Arbanas Nabholz Construction Corporation on Friday, Oct 3, 2025 at 10:01 AM CDT CDG Response: Refer to the mark up on the sketches, it appears the top of footers can be raised in some areas based on proposed finished grade and the details' parameters. Attachments RFI-055-civil_-_pedestrian_bridge_elevated_walk_confirmation_CDG Response.pdf



RFI #055: Civil - Pedestrian bridge elevated walk confirmation

Revision	0	Status	Open
To	Luke Arbanas (Nabholz Construction Corporation)	From	David Panto (Nabholz Construction Corporation)
Date Initiated	Sep 22, 2025	Due Date	Oct 1, 2025
Location	Civil Expansion	Project Stage	Pre-Construction
Cost Impact	TBD	Schedule Impact	TBD
Spec Section			
Drawing Number	C5.1 & C8.2	Reference	
Linked Drawings			
Copies To	Shannon Gould (LITHKO CONTRACTING LLC), Don Kelley (Nabholz Construction Corporation), David Panto (Nabholz Construction Corporation), Vince Praderio (LITHKO CONTRACTING LLC)		
Priority	Medium		
Constraint			

Activity

Question

Question from David Panto Nabholz Construction Corporation on Monday, Sep 22, 2025 at 11:46 AM CDT

Can you confirm the elevated walks on the pedestrian bridge as described below?

We made a drawing from our understanding of what the west side of the pedestrian elevated walk would look like following detail 3 on C8.2 (see attached). Please confirm if this is acceptable.

Due to the similar elevation from existing of the elevated walk on the east side, it is our understanding that we will be able to follow the turndown slab as shown on detail 3 on C8.2, so we did not create a drawing for this.

Attachments

[pedestrian bridge elevated walk.pdf](#)

Awaiting an Official Response

CDG Response: Refer to the mark up on the sketches, it appears the top of footers can be raised in some areas based on proposed finished grade and the details' parameters.




Devenney Group Ltd., Architects
6900 East Camelback Road
Suite 500
Scottsdale, AZ 85251
T: 602.943.8950
www.devenneygroup.com

Consultant:



1524 WILLIAMS DRIVE, SUITE 201, MURFREESBORO, TN 37129
(615) 622-7200 | WWW.CATALYST-DG.COM

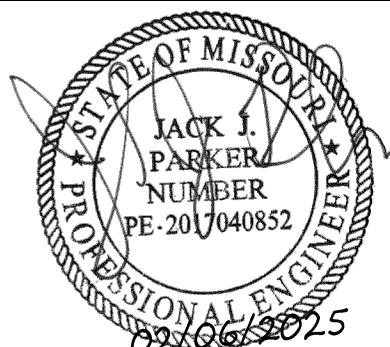

IF THESE PLANS DO NOT BEAR THE SEAL OF A REGISTRANT, THEY ARE TO BE CONSIDERED "PRELIMINARY" AND ARE NOT TO BE USED FOR CONSTRUCTION OR RECORDING. THESE PLANS ARE COPYRIGHTED AND ARE SUBJECT TO COPYRIGHT PROTECTION AS AN "ARCHITECTURAL WORK" UNDER SEC. 102 OF THE COPYRIGHT ACT, 17 U.S.C. AS AMENDED (OCTOBER 1990) AND KNOWN AS "ARCHITECTURAL WORKS COPYRIGHT PROTECTION ACT OF 1990." THE PROTECTION INCLUDES BUT IS NOT LIMITED TO THE OVERALL FORM AS WELL AS THE ARRANGEMENT AND COMPOSITION OF SPACES AND ELEMENTS OF THE DESIGN. UNDER SUCH PROTECTION, UNAUTHORIZED USE OF THESE PLANS CAN LEGALLY RESULT IN THE CESSATION OF CONSTRUCTION OR BUILDINGS BEING SEIZED AND/OR MONETARY COMPENSATION TO DEVENNEY GROUP, LTD.

INPATIENT BED EXPANSION

HCA - LEE'S SUMMIT
MEDICAL CENTER
2100 SE BLUE PKWY
LEE'S SUMMIT, MO 64063

AUTHORITY HAVING JURISDICTION:
CITY OF LEE'S SUMMIT BUILDING DEPT.
MISSOURI DHSS

FACILITY NUMBER:
0972400009


AGENCY APPROVALS:
AGENCY

REVISIONS		
REV #	DESCRIPTION	DATE
B	DESIGN COORDINATION	2025/02/06

DATE: 2024/12/05
SCALE: 1:30
DRAWN: AP
REVIEWED: WB
JOB NUMBER: 6406.24

DETAILED LAYOUT
PLAN

C5.1

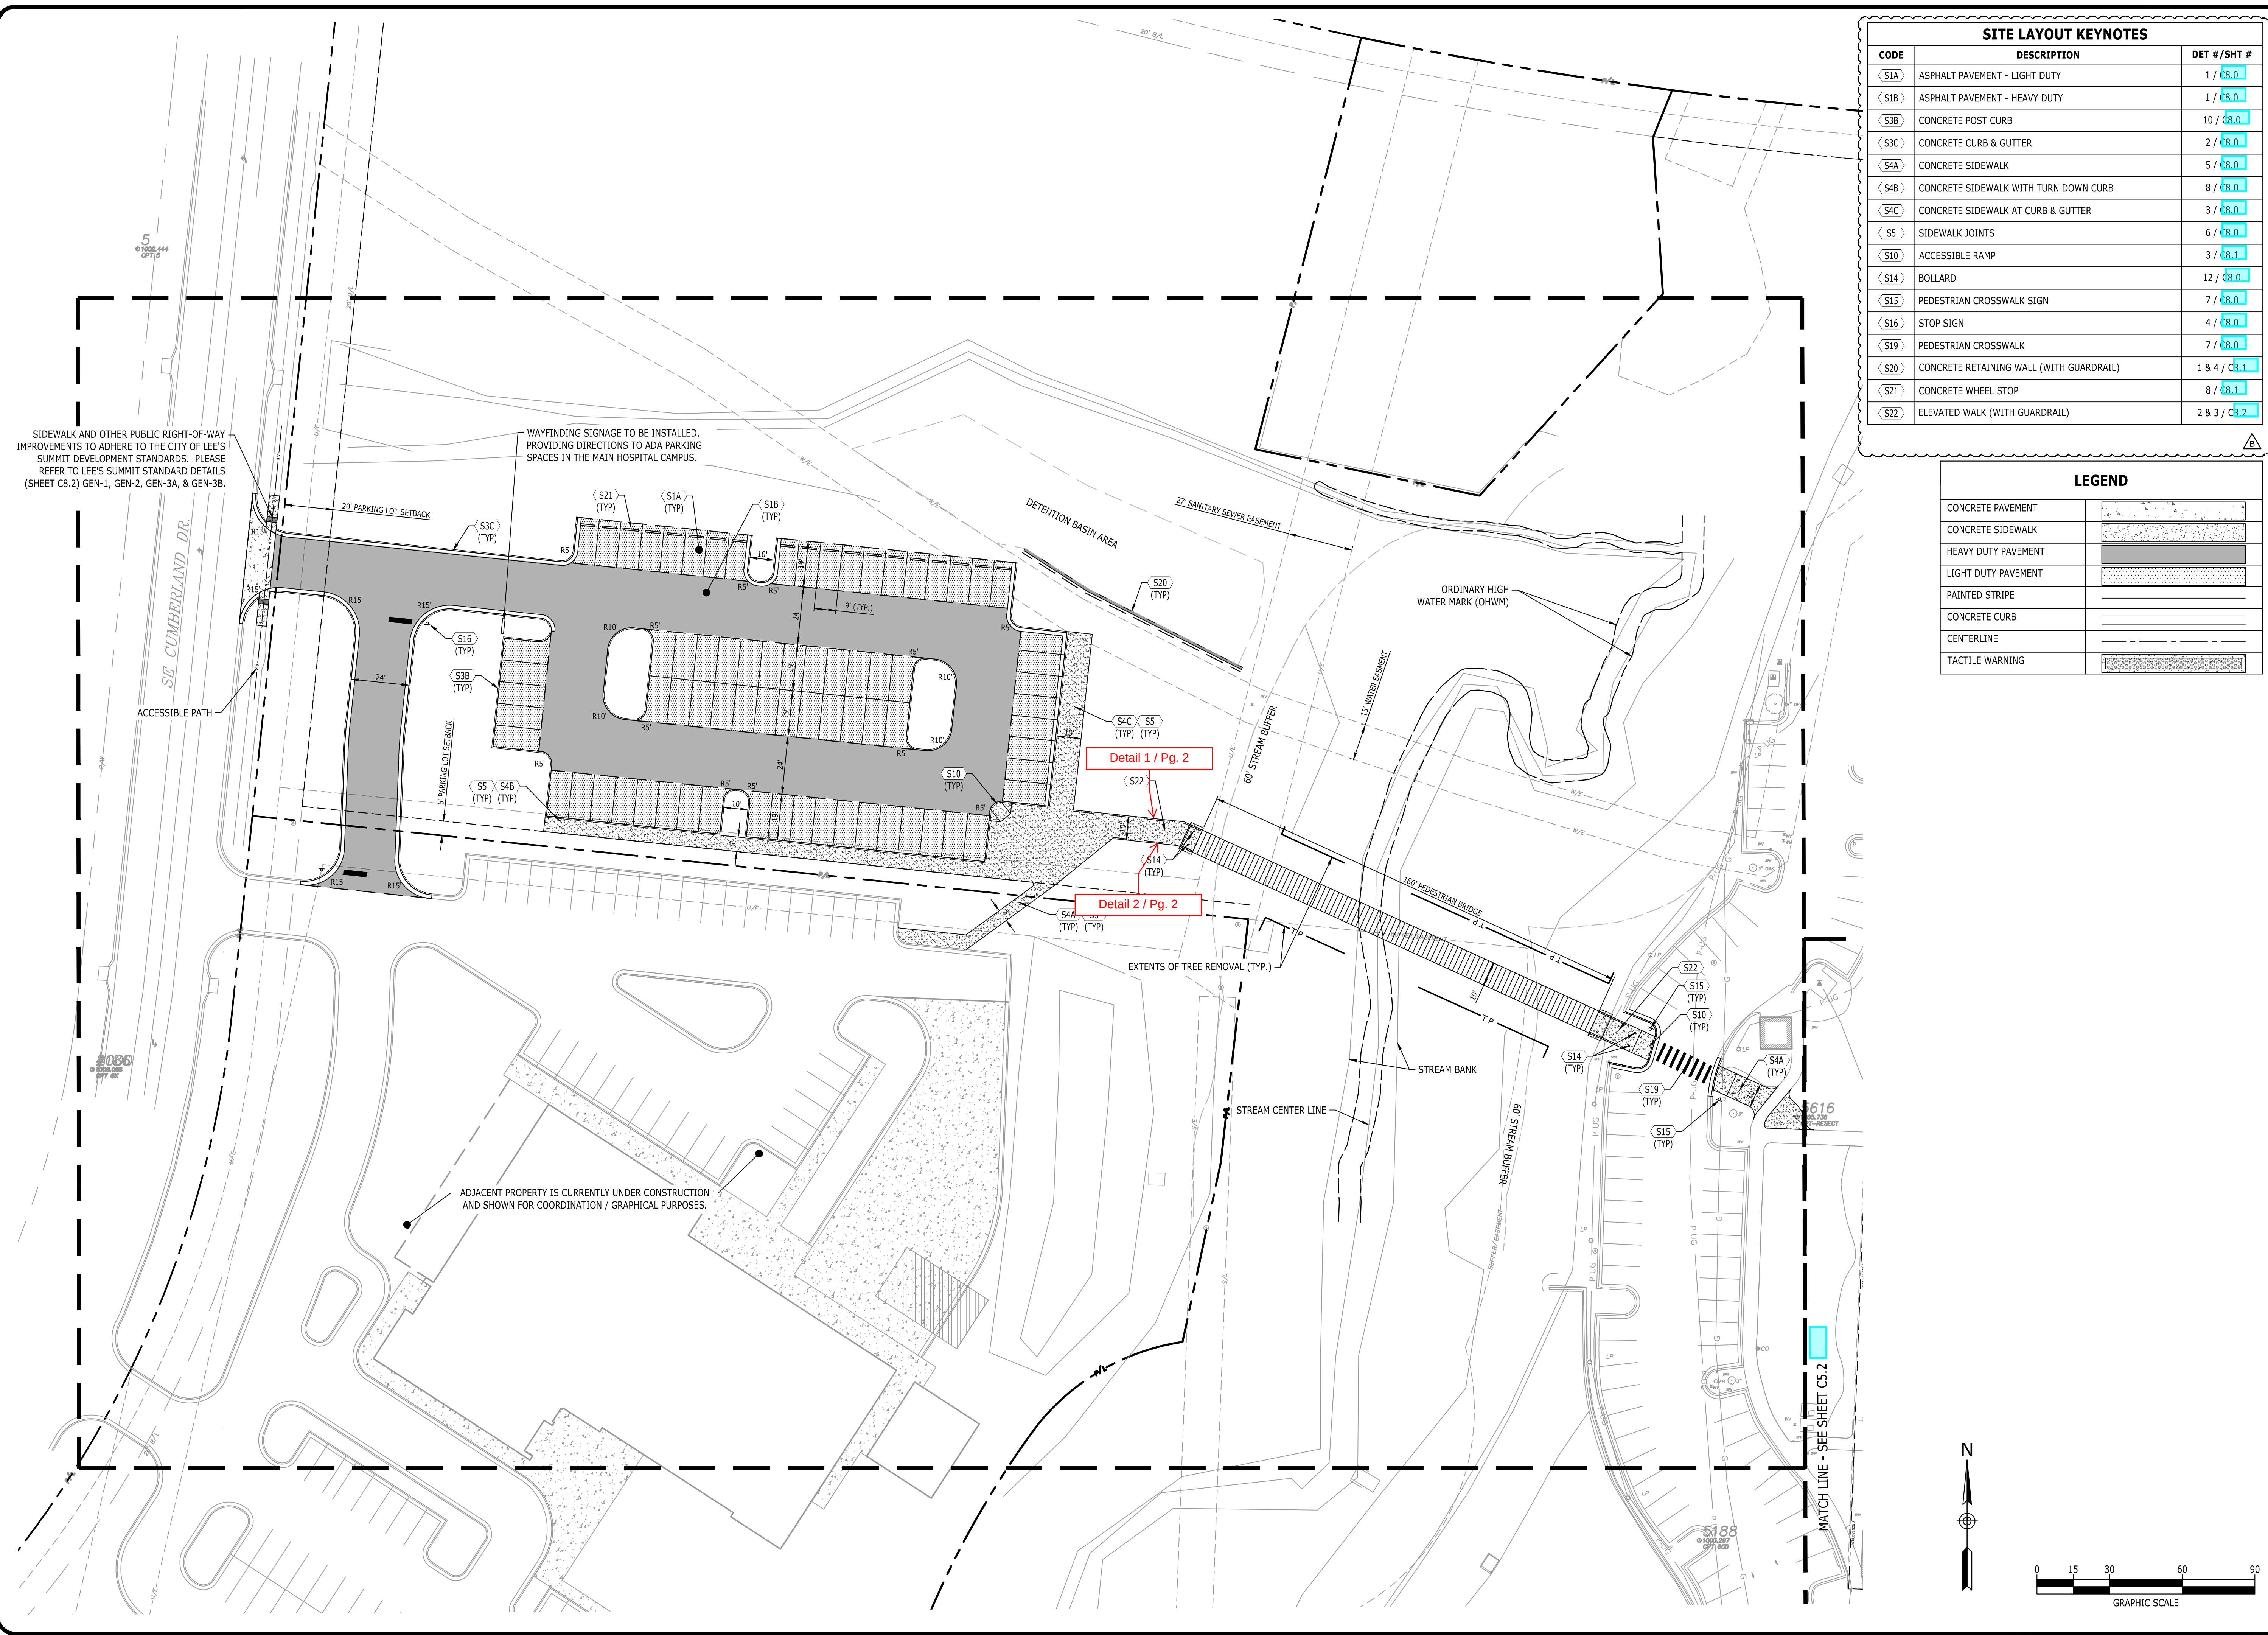

Catalyst
DESIGN GROUP
1524 WILLIAMS DRIVE, SUITE 201, MURFREESBORO, TN 37129
(615) 622-7200 | WWW.CATALYST-DG.COM

LEE'S SUMMIT
MEDICAL CENTER
2100 SE BLUE PARKWAY
LEE'S SUMMIT, MO 64063
816-282-5000

CONSTRUCTION DOCUMENTS
HCA LEE'S SUMMIT
MEDICAL CENTER
2000 SE SHENANDOAH DRIVE
LEE'S SUMMIT, MO. 64063
JACKSON COUNTY


NO.	DATE	DESIGN COORDINATION	DESCRIPTION
1	2025/02/05		
2			
3			
4			
5			
6			
7			
8			
9			
10			

DRAWING TITLE
DETAILED LAYOUT
PLAN
PROJECT NUMBER
20240037
DRAWING NUMBER
C5.1

P:\2024\20240037_Devenney - HCA Lee's Summit Medical Center_Med Surg Exp\dwg\Construction\20240037_LAY.dwg-C5.1 DETAILED LAYOUT PLAN Jan 31, 2025 wbsissard

West Side of Bridge
North Side of Sidewalk


Detail 1

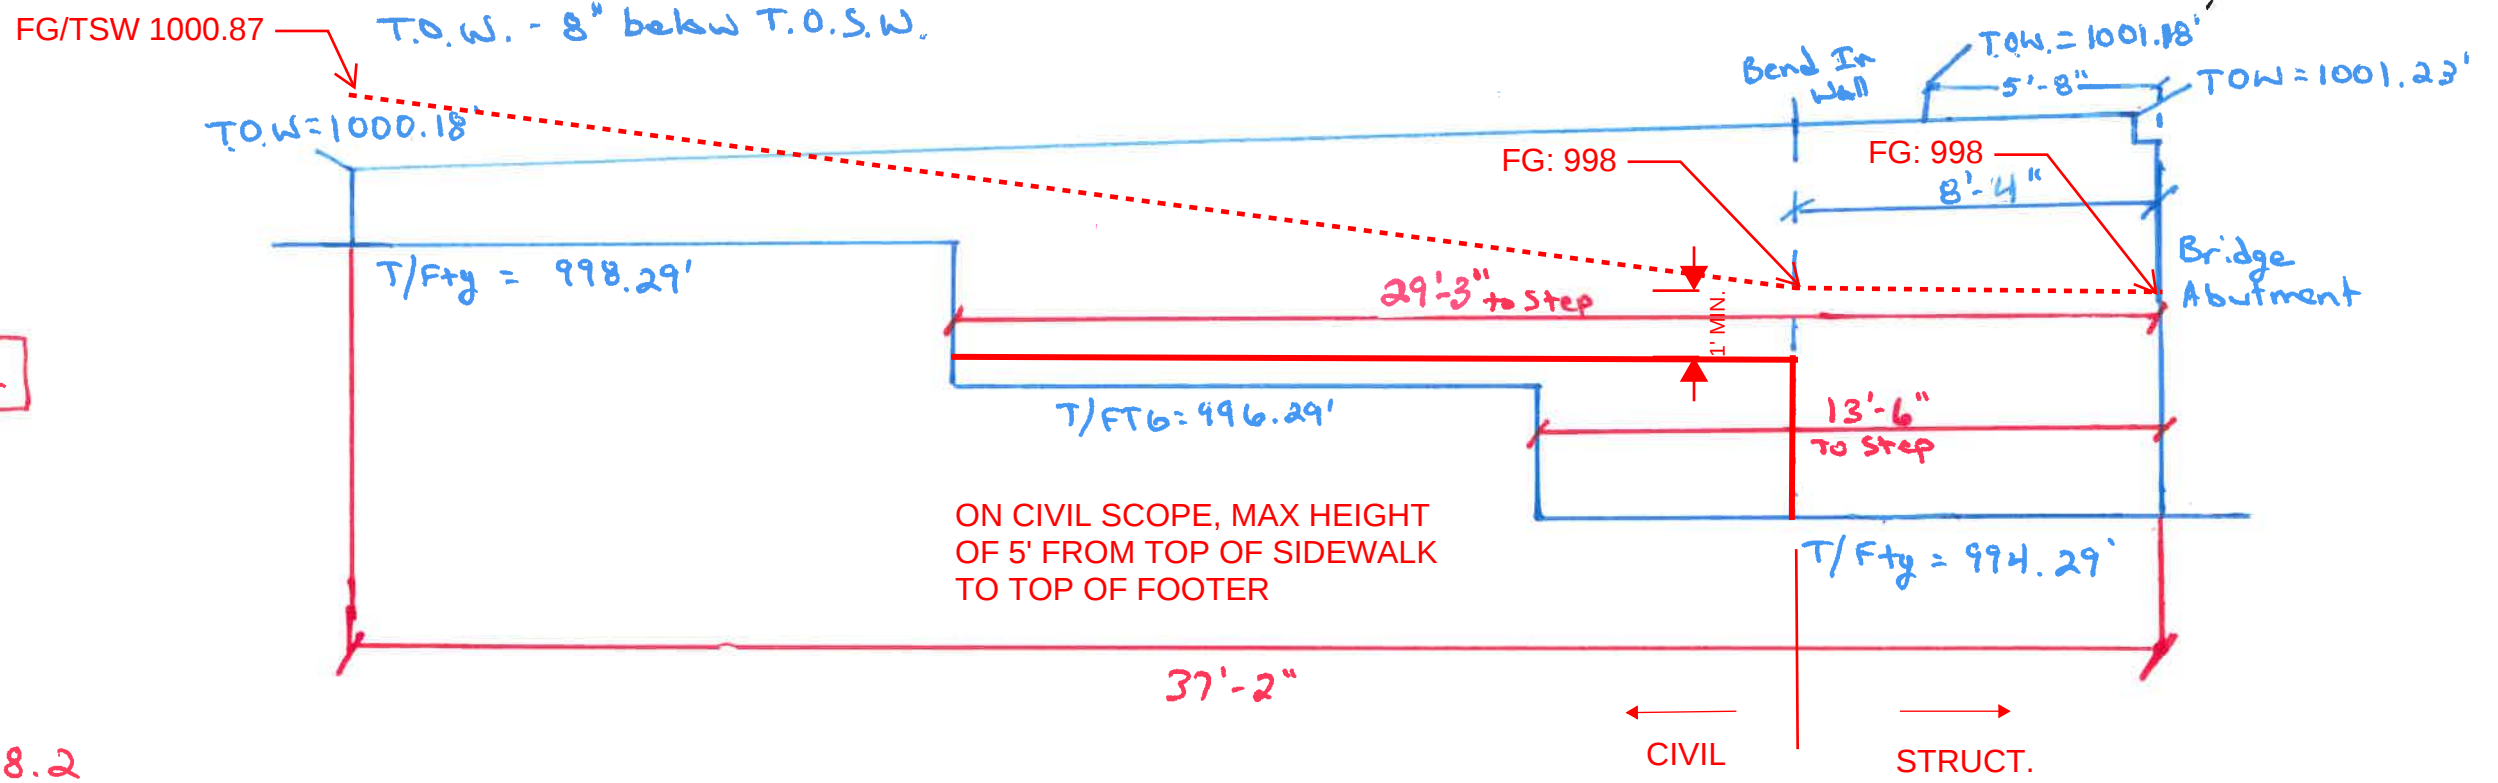

per detail 3 on pg. C8.2

West Side of Bridge
South Side of Sidewalk

Detail 2

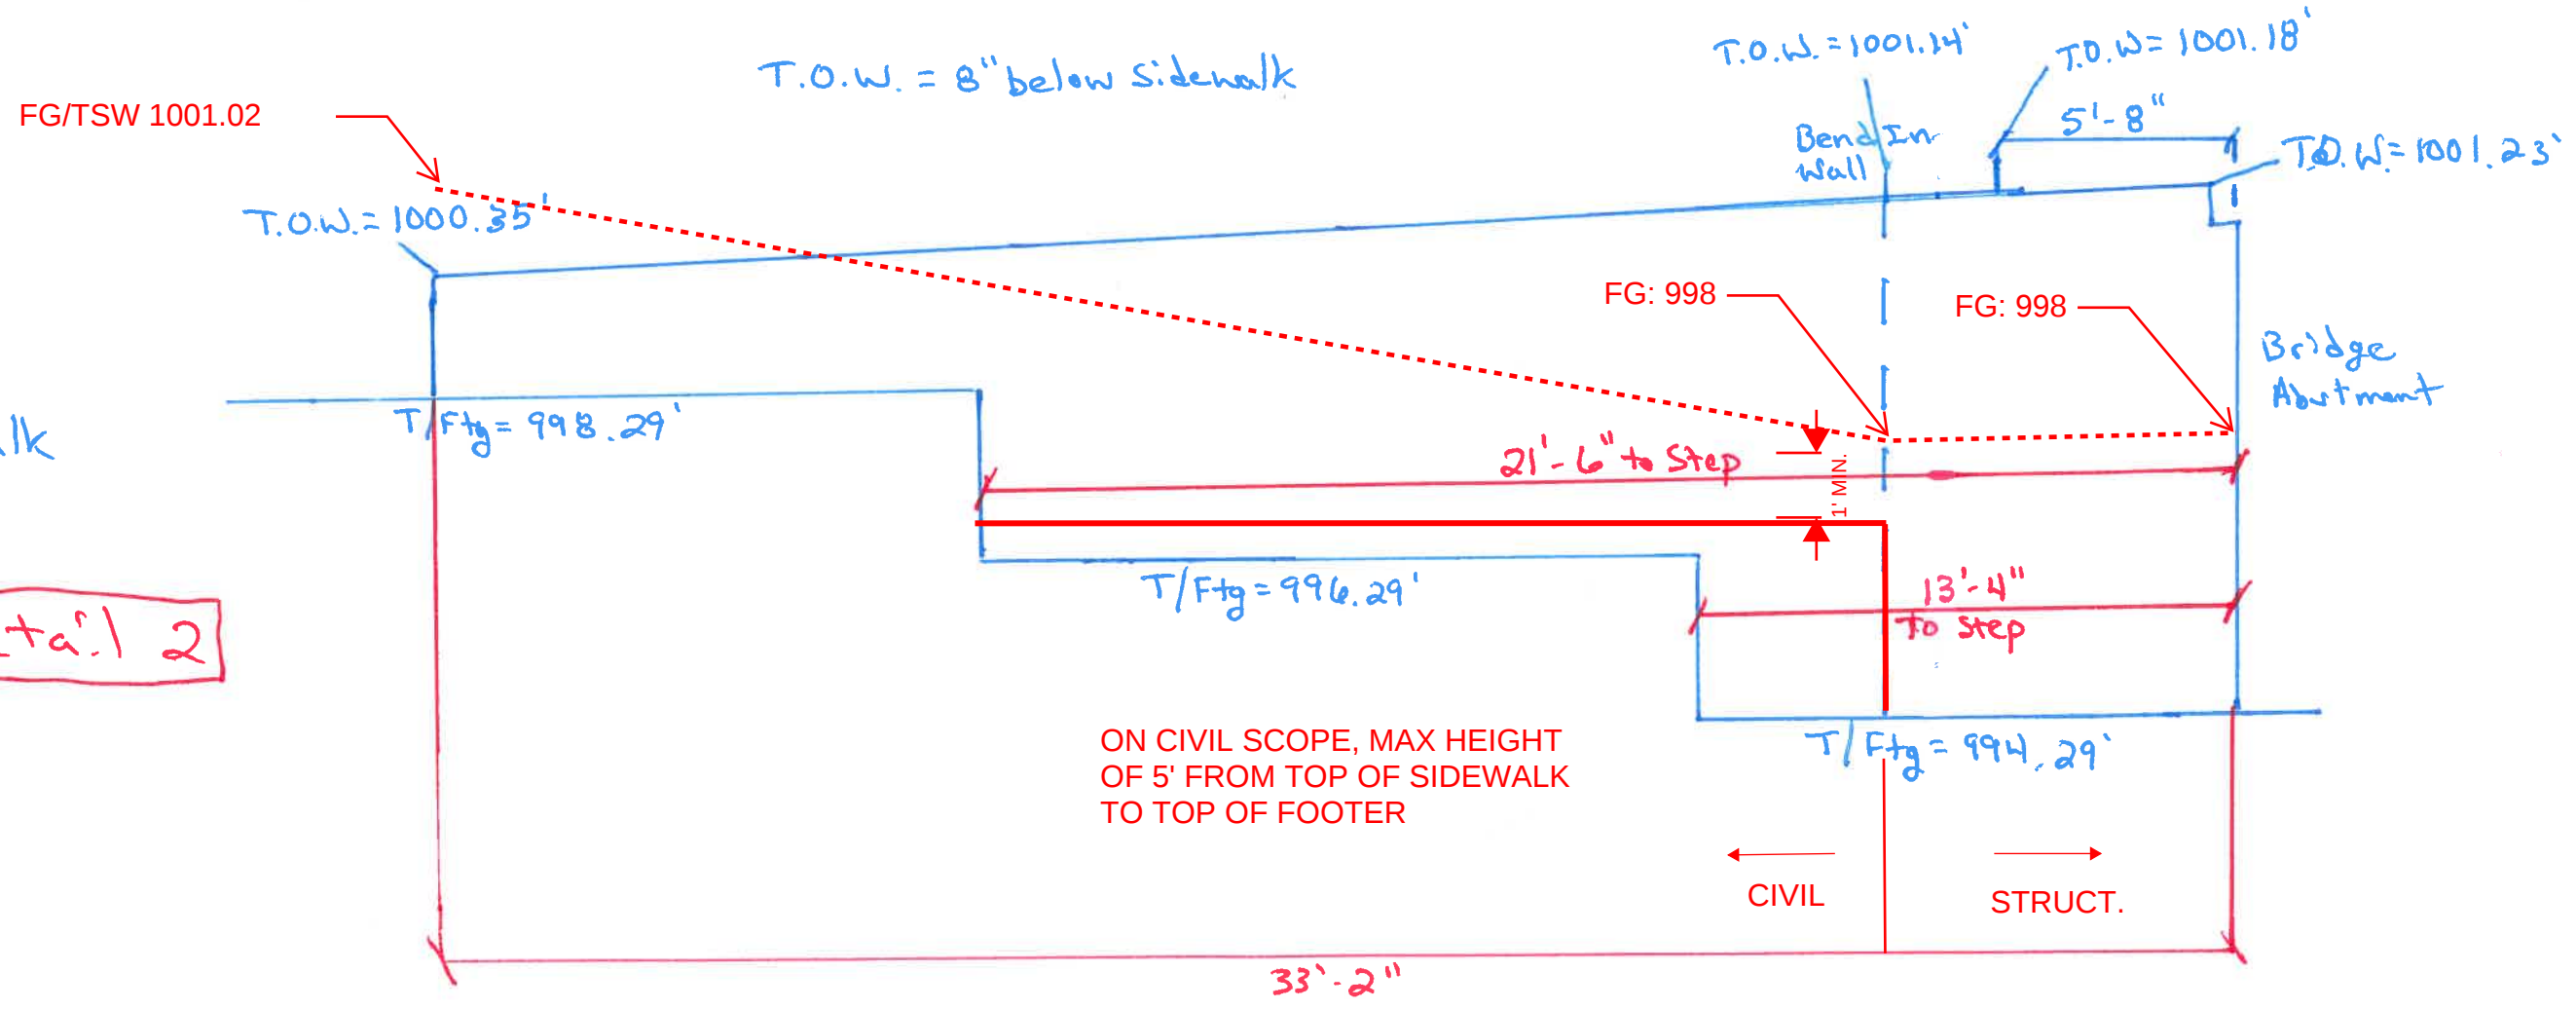

* Not to scale