



Nabholz Construction - Lenexa
17300 W 116th Street
Lenexa, Kansas 66219
P: (913) 393-6500

Project: 08-25-3311 HCA LSMC CAMPUS EXPANSION
2100 SE BLUE PARKWAY
LEE'S SUMMIT, Missouri 64063

RFI #026: Pedestrian Bridge Footings

Status	Open		
To	Luke Arbanas (Nabholz Construction Corporation) (<i>Response Required</i>)	From	Max Franklin (Nabholz Construction Corporation)
Date Initiated	Jul 7, 2025	Due Date	Jul 14, 2025
Location	Civil Expansion	Project Stage	Pre-Construction
Cost Impact	TBD	Schedule Impact	TBD
Spec Section			
Drawing Number	S120, S211, C6.4, AS501	Reference	
Linked Drawings			
Copies To	Max Franklin (Nabholz Construction Corporation), Travis Hilscher (LITHKO CONTRACTING LLC), Wayne Kufahl (Nabholz Construction Corporation), Lelan Olsen (Nabholz Construction Corporation)		
Priority	Medium		
Constraint			

Activity

Question

Question from Max Franklin Nabholz Construction Corporation on Monday, Jul 7, 2025 at 08:22 AM CDT

Q: THROUGHOUT THE PLANS, THERE APPEARS TO BE NO DETAILS OR SECTIONS IDENTIFYING THE LENGTH AND WIDTH OF THE PEDESTRIAN BRIDGE FOOTINGS. CAN ARCHITECT PLEASE PROVIDE SECTION OR DETAIL DEFINING THESE DIMENSIONS. - NAB-MF-06.30.2025

Attachments

[PEDESTRIAN_BRIDGE_FTGSIZE_7.03.25.pdf](#)

Awaiting an Official Response

See the markups in the RFI document. The width of the foundations is to be 4'-0".
The length of the foundation is to be 2'-0" on either side of grid lines BA and BC.

SDL: Nishith Sardhara Dt: 07/14/2025


Stanley D. Lindsey and Associates, Ltd.

Structural Engineer's review is only for general conformance with the structural Contract Documents. Corrections or comments made on the shop drawings during this review do not relieve the Contractor from compliance with the requirements of the Contract Documents and applicable laws, codes and regulations. The Contractor is responsible for: dimensions to be confirmed and correlated at the jobsite; information that pertains solely to the fabrication processes or to the means, methods, techniques, sequences and procedures of construction; coordination of the Work with all other trades; and performing all Work in a safe and satisfactory manner.

- | | |
|--|--|
| ☐ Limited Review – This submittal is for a deferred submittal item designed by specialty engineer. Structural Engineer's review is limited to the design criteria and loads imposed to the base structure only. | |
| ☐ Reviewed – No Exceptions Taken | ☐ Rejected – Revise and Resubmit |
| ☐ Reviewed – With Exceptions as Noted | ☐ Not Reviewed – Record Copy Only |
| ☐ Reviewed – With Exceptions as Noted, Submit Record Copy | ☒ RFI Response |

Date: 10/21/2025

Reviewer: Nishith Sardhara

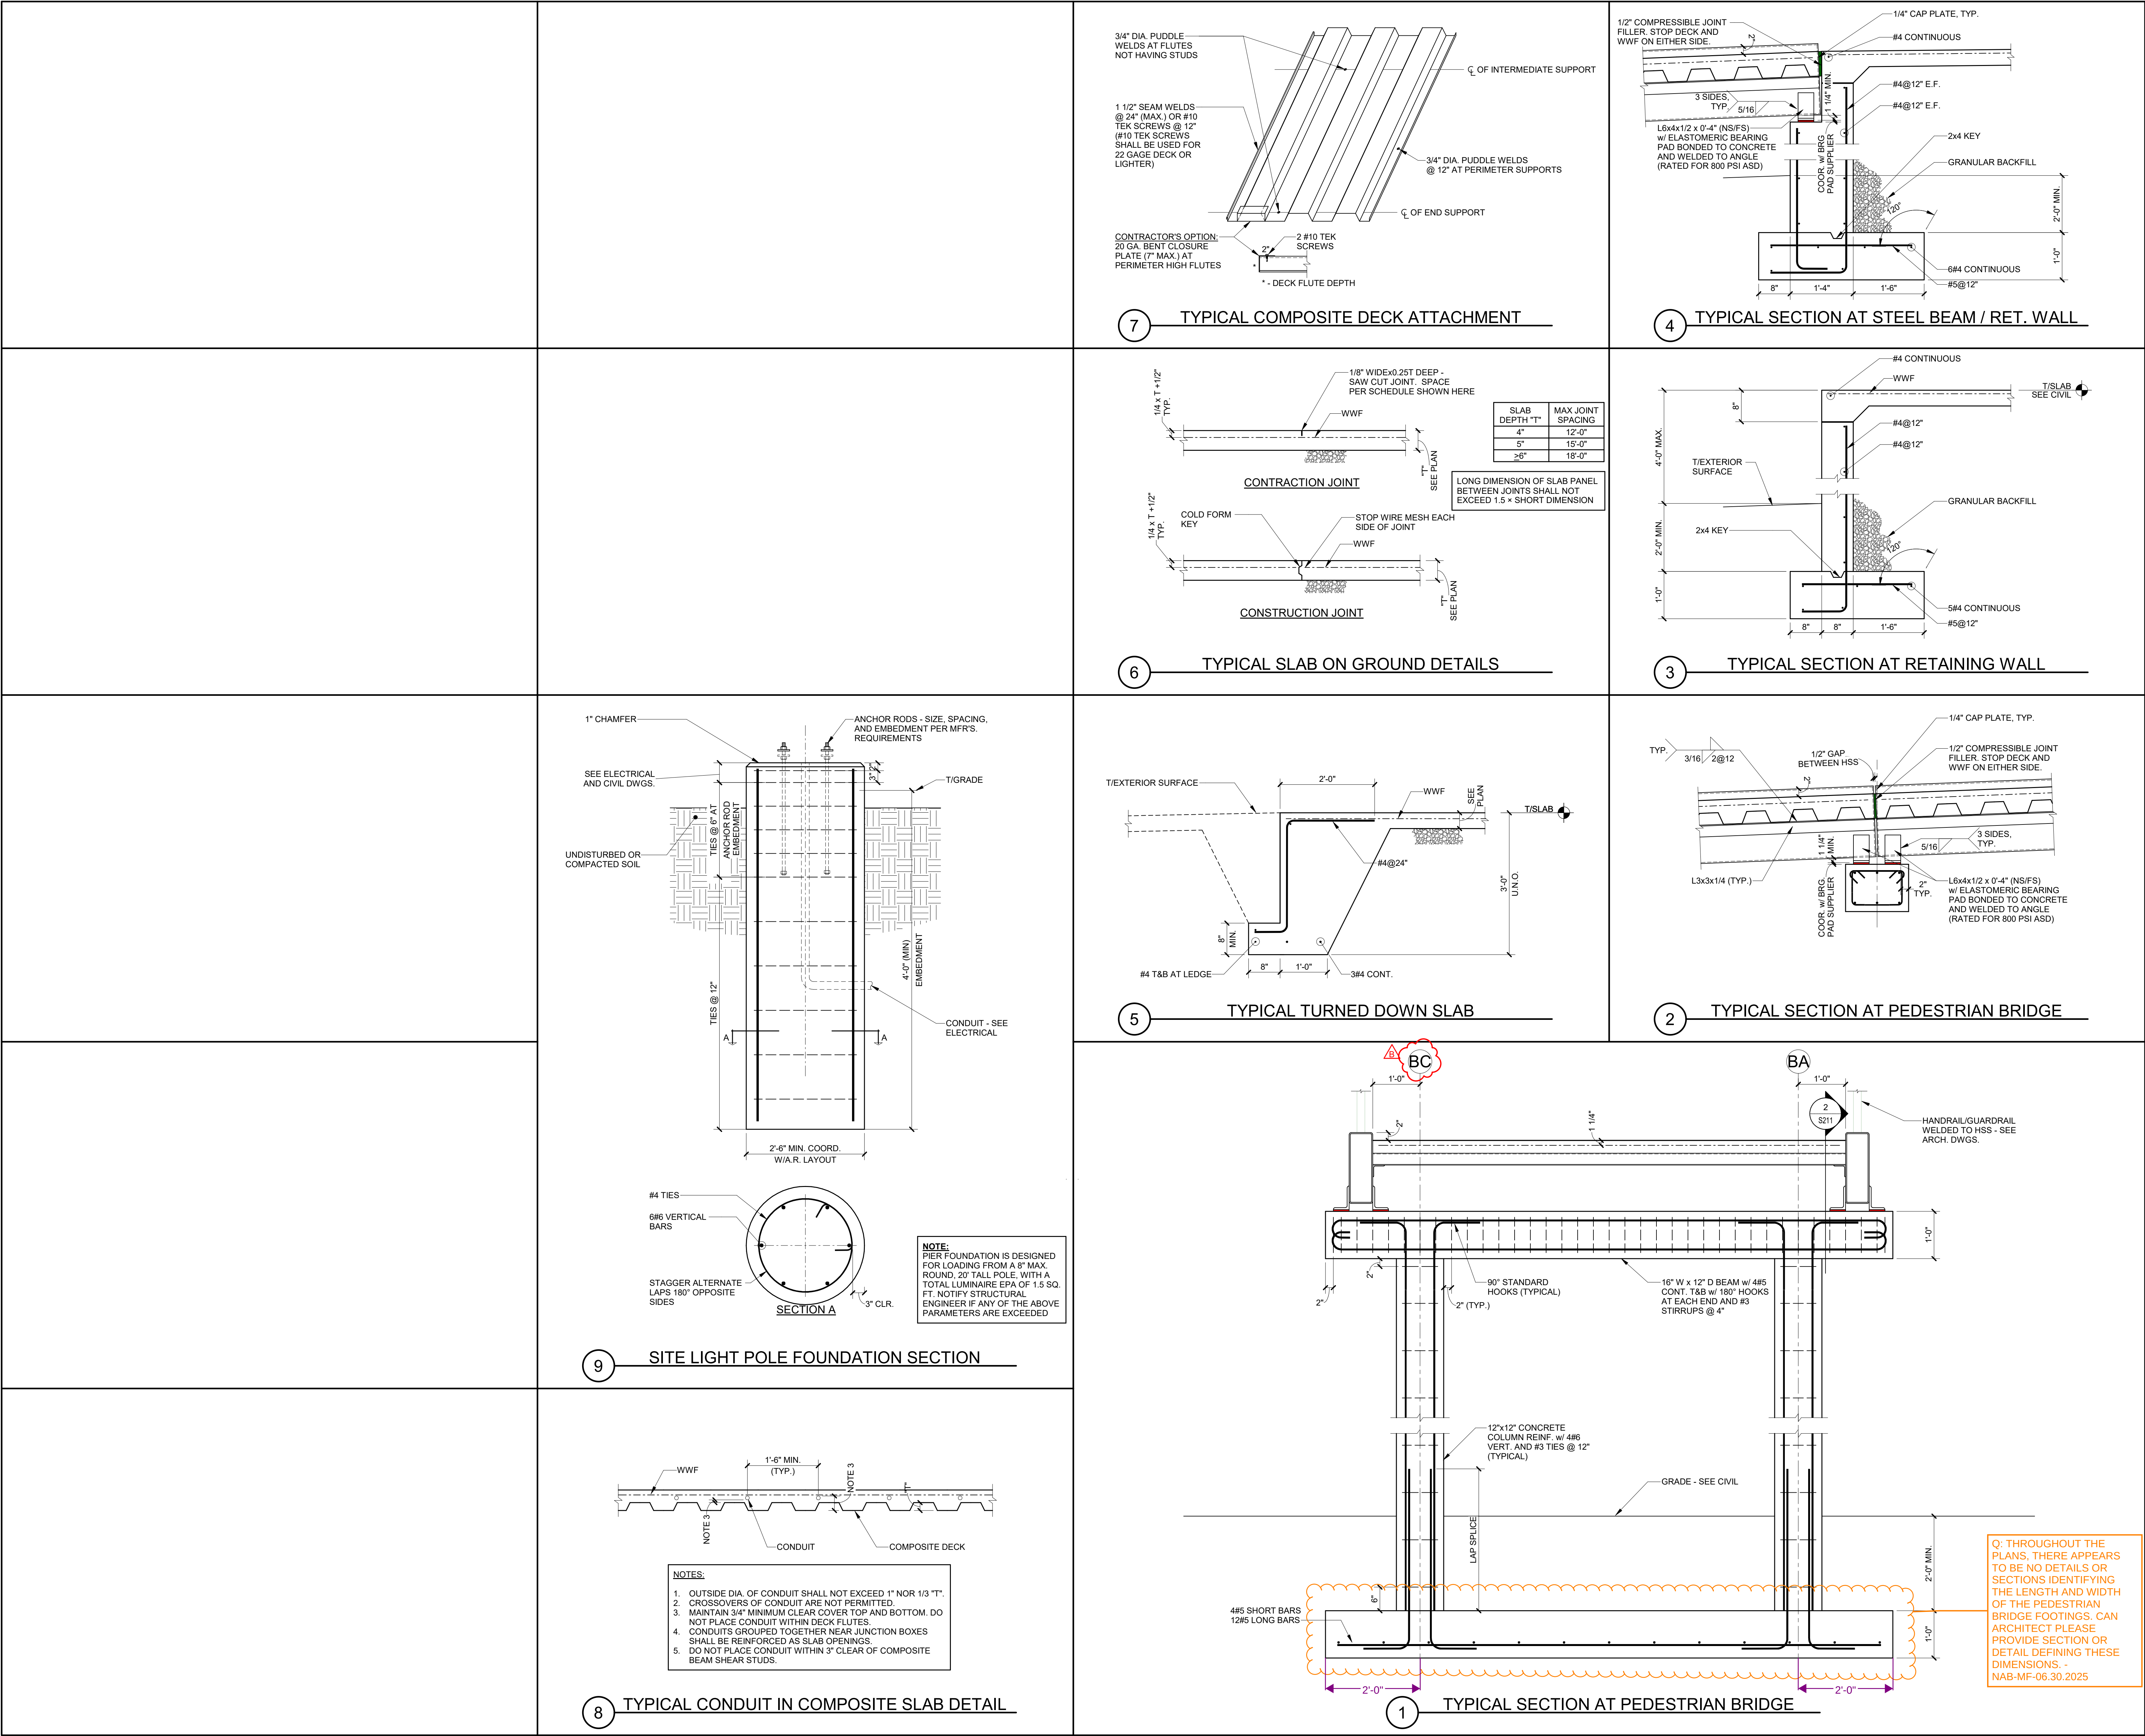

Devenney GROUP

Devenney Group Ltd., Architects

6900 East Camelback Road
Suite 500
Scottsdale, AZ 85251

T: 602.943.8950
www.devenneygroup.com


Consultant:

1966

SDI

Structural Engineers
750 Old Hickory Blvd.
Building 1, Suite 175
Brentwood, TN 37027
www.sdi-al.com
615 320 1735

Project No. 24051.00

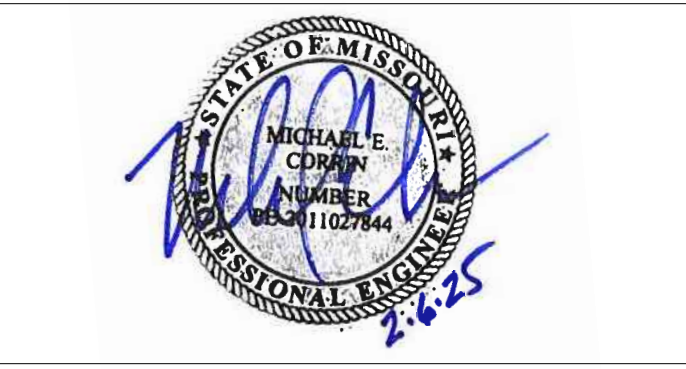

IF THESE PLANS DO NOT BEAR THE SEAL OF A REGISTERED PROFESSIONAL ENGINEER, THEY ARE TO BE CONSIDERED "PRELIMINARY" AND ARE NOT TO BE USED FOR CONSTRUCTION OR RECORDING. THESE PLANS ARE COPYRIGHTED AND ARE SUBJECT TO COPYRIGHT PROTECTION AS AN "ARCHITECTURAL WORK" UNDER SEC. 102 OF THE COPYRIGHT ACT, 17 U.S.C. AS AMENDED DECEMBER 1992 AND KNOWN AS ARCHITECTURAL WORKS COPYRIGHT PROTECTION ACT OF 1990. THE PROTECTION INCLUDES BUT IS NOT LIMITED TO THE OVERALL FORM AS WELL AS THE ARRANGEMENT AND COMPOSITION OF SPACES AND ELEMENTS OF THE DESIGN. UNDER SUCH PROTECTION, UNAUTHORIZED USE OF THESE PLANS CAN LEGALLY RESULT IN THE OBSTRUCTION OF CONSTRUCTION OR BUILDINGS BEING SEIZED AND/OR MONETARY COMPENSATION TO DEVENNEY GROUP LTD.

MED SURG & DIETARY EXPANSION

HCA - LEE'S SUMMIT MEDICAL CENTER
2100 SE BLUE PKWY
LEE'S SUMMIT, MO 64063

AUTHORITY HAVING JURISDICTION:
CITY OF LEE'S SUMMIT BUILDING DEPT.
MISSOURI DHSS

FACILITY NUMBER:
0972400009

AGENCY APPROVALS:
AGENCY


REVISIONS		
REV #	DESCRIPTION	DATE
B	DESIGN COORDINATION	2025/02/06

DATE: 2024/12/05
SCALE: 3/4" = 1'-0"
DRAWN: JL
REVIEWED: JDP
JOB NUMBER: 6406.24

PEDESTRIAN BRIDGE
STRUCTURAL SECTIONS AND
DETAILS

S211

Autodesk Docs / 6406.24 - HCA - Lee's Summit Medical Center (LSMC) - r23/2405100 Lee's Summit, MO - Med Surg_Bed_Expansion_SDI23.rvt
2/12/2025 5:10:15 PM
Notice of Alternate Billing or Payment Cycle: The Owner may plan to make payments on an alternative schedule. A written description of such billing or payment cycle applicable to the Project is available from the Owner or the Owner's designated agent upon request.

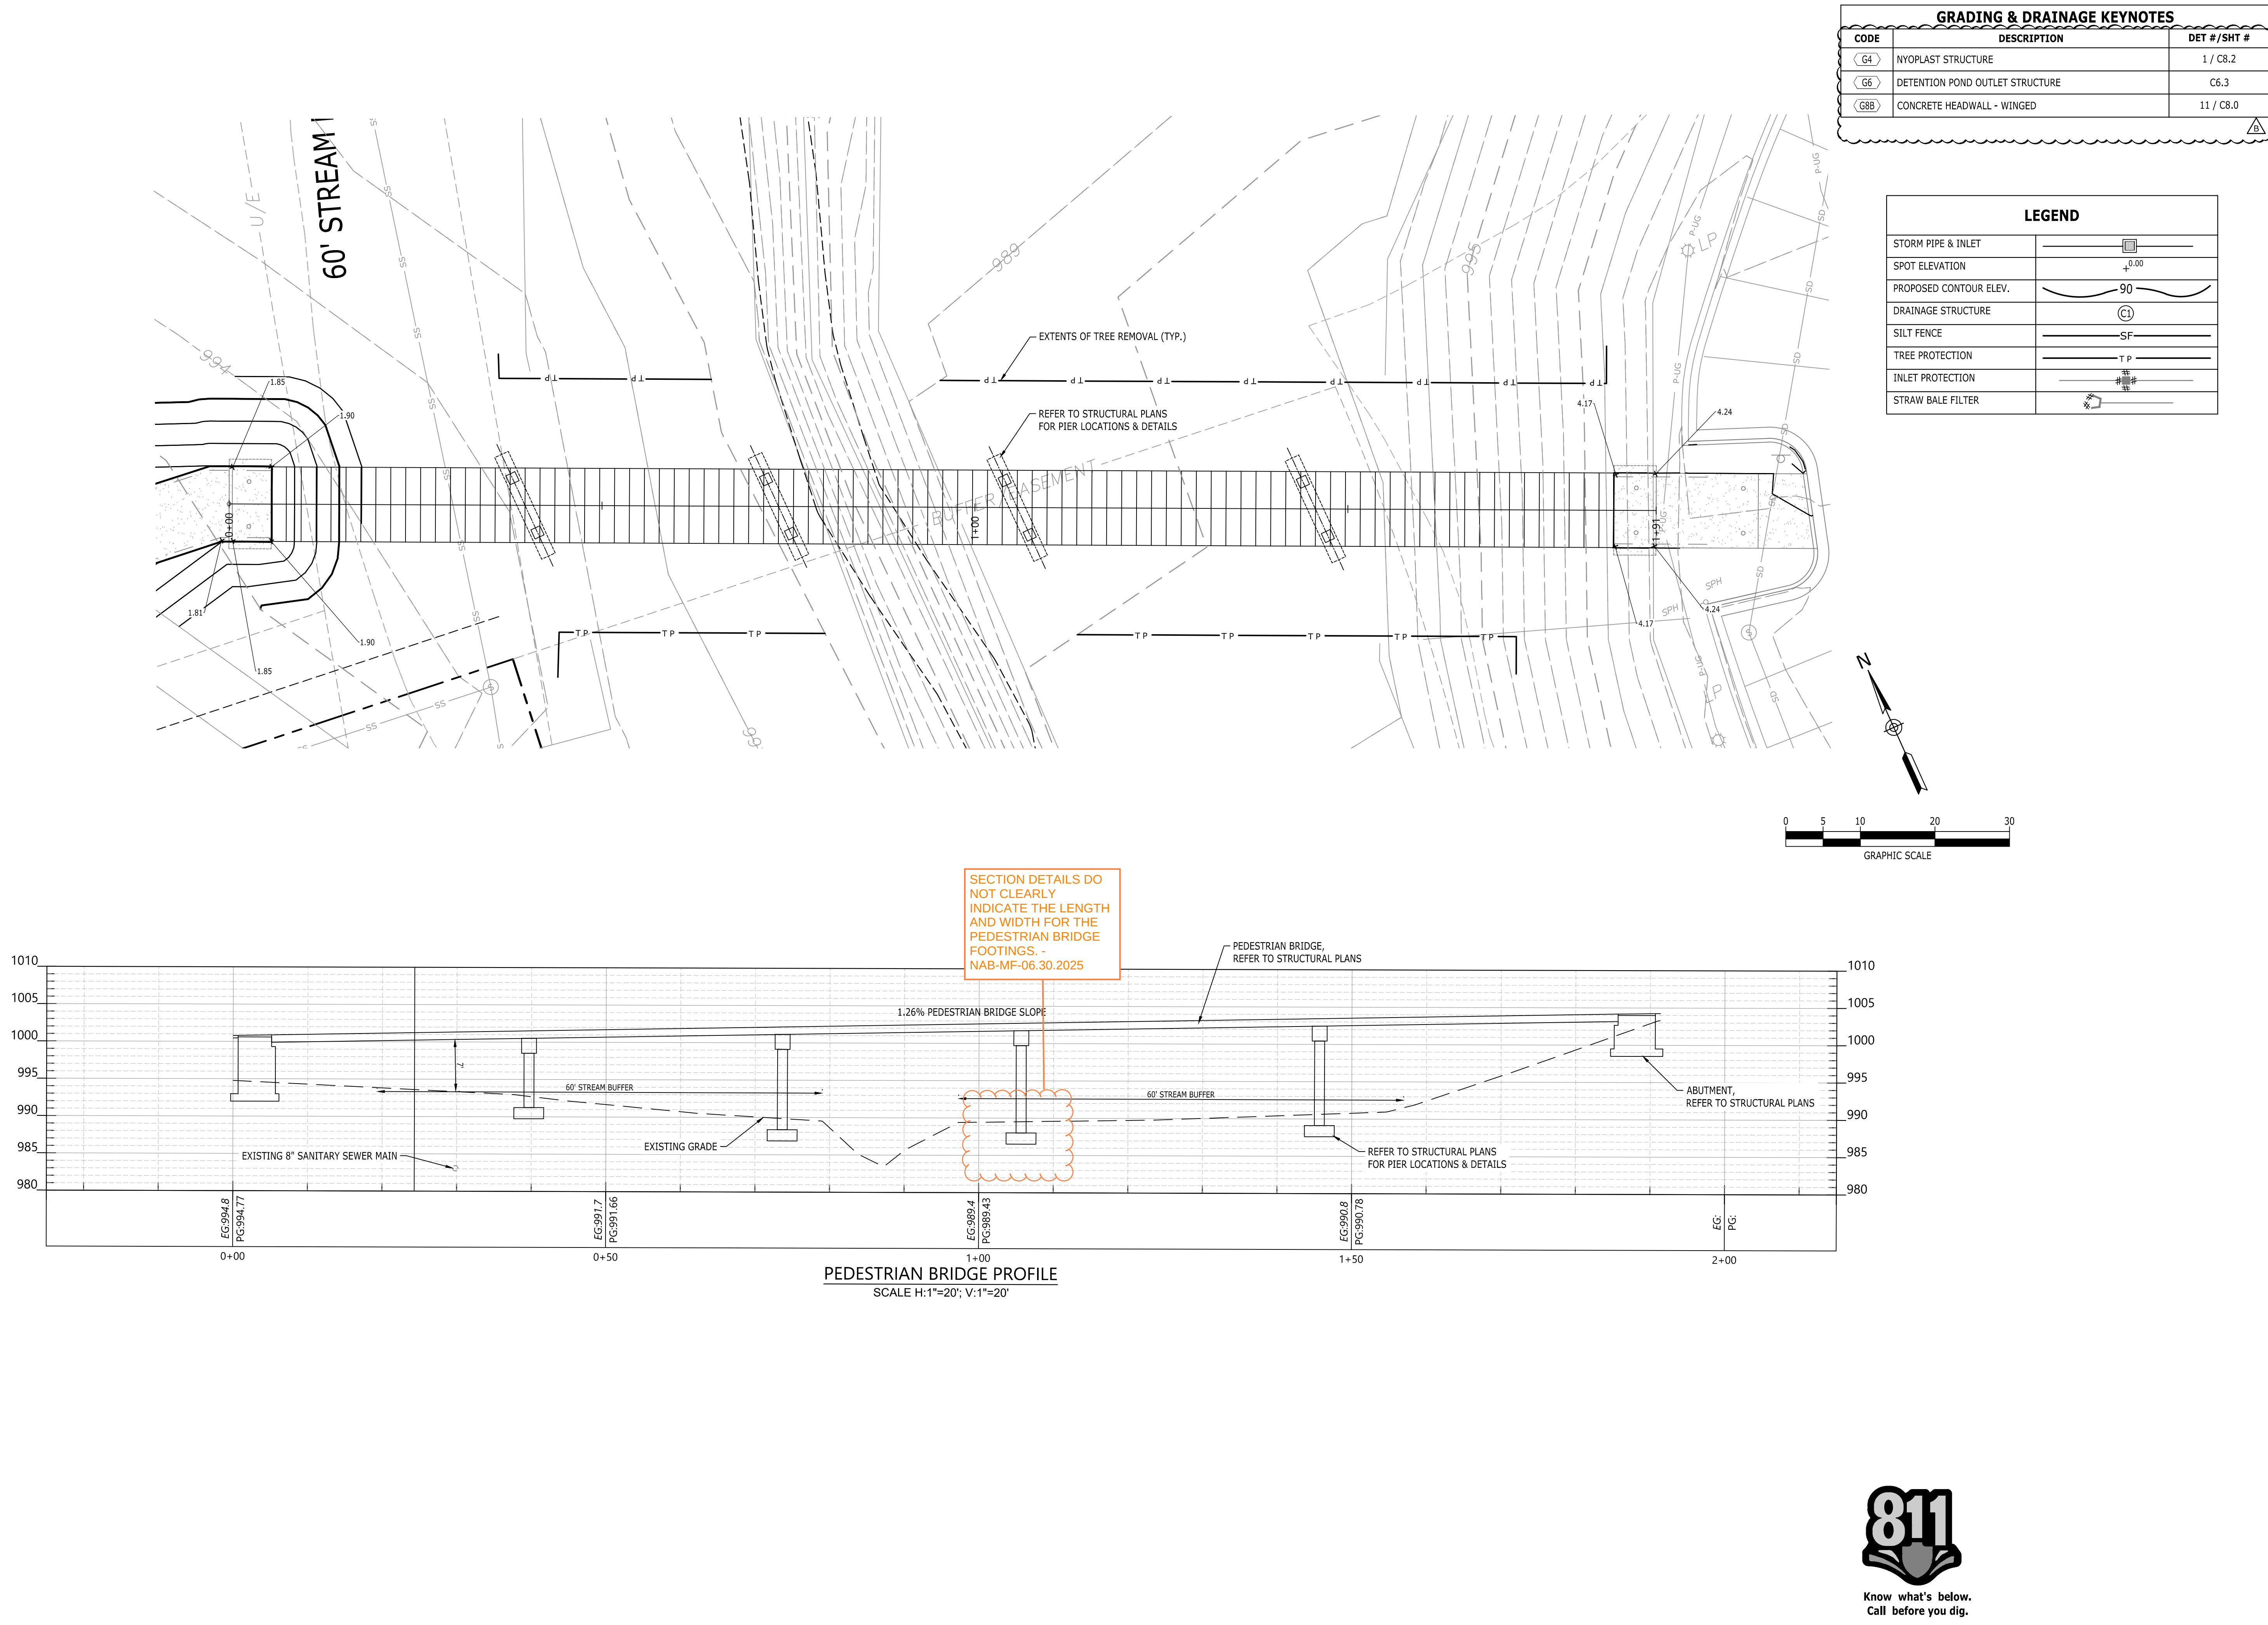

Catalyst
DESIGN GROUP
1524 WILLIAMS DRIVE, SUITE 201, MURFREESBORO, TN 37129
(615) 622-7200 | WWW.CATALYST-DG.COM

LEE'S SUMMIT
MEDICAL CENTER
2100 SE BLUE PARKWAY
LEE'S SUMMIT, MO 64063
816-282-5000

CONSTRUCTION DOCUMENTS
HCA LEE'S SUMMIT
MEDICAL CENTER
2000 SE SHENANDOAH DRIVE
LEE'S SUMMIT, MO. 64063
JACKSON COUNTY

NO.	DATE	DESIGN COORDINATION	DESCRIPTION
1	2025/02/05		

DRAWING TITLE
PEDESTRIAN BRIDGE
PLAN & PROFILE

PROJECT NUMBER
20240037

DRAWING NUMBER
C6.4

Devenney
GROUP
Devenney Group Ltd., Architects
6900 East Camelback Road
Suite 500
Scottsdale, AZ 85251
T: 602.943.8950
www.devenneygroup.com

Consultant:
Catalyst
DESIGN GROUP
1524 WILLIAMS DRIVE, SUITE 201, MURFREESBORO, TN 37129
(615) 622-7200 | WWW.CATALYST-DG.COM

IF THESE PLANS DO NOT BEAR THE SEAL OF A REGISTRANT, THEY ARE TO BE CONSIDERED "PRELIMINARY" AND ARE NOT TO BE USED FOR CONSTRUCTION OR RECORDING. THESE PLANS ARE COPYRIGHTED AND ARE SUBJECT TO COPYRIGHT PROTECTION AS AN "ARCHITECTURAL WORK" UNDER SEC. 102 OF THE COPYRIGHT ACT, 17 U.S.C. AS AMENDED (OCTOBER 1990 AND KNOWN AS ARCHITECTURAL WORKS COPYRIGHT PROTECTION ACT OF 1990. THE PROTECTION INCLUDES BUT IS NOT LIMITED TO THE OVERALL FORM AS WELL AS THE ARRANGEMENT AND COMPOSITION OF SPACES AND ELEMENTS OF THE DESIGN. UNDER SUCH PROTECTION, UNAUTHORIZED USE OF THESE PLANS CAN LEGALLY RESULT IN THE CESSATION OF CONSTRUCTION OR BUILDINGS BEING SEIZED AND/OR MONETARY COMPENSATION TO DEVENNEY GROUP LTD.

**INPATIENT BED
EXPANSION**

HCA - LEE'S SUMMIT
MEDICAL CENTER
2100 SE BLUE PKWY
LEE'S SUMMIT, MO 64063

AUTHORITY HAVING JURISDICTION:
CITY OF LEE'S SUMMIT BUILDING DEPT.
MISSOURI DHSS

FACILITY NUMBER:
0972400099


AGENCY APPROVALS:
AGENCY

REVISIONS		
REV #	DESCRIPTION	DATE
B	DESIGN COORDINATION	2025/02/06

DATE: 2024/12/05
SCALE: 1:10
DRAWN: AP
REVIEWED: WB
JOB NUMBER: 6406.24

PEDESTRIAN BRIDGE
PLAN & PROFILE

C6.4

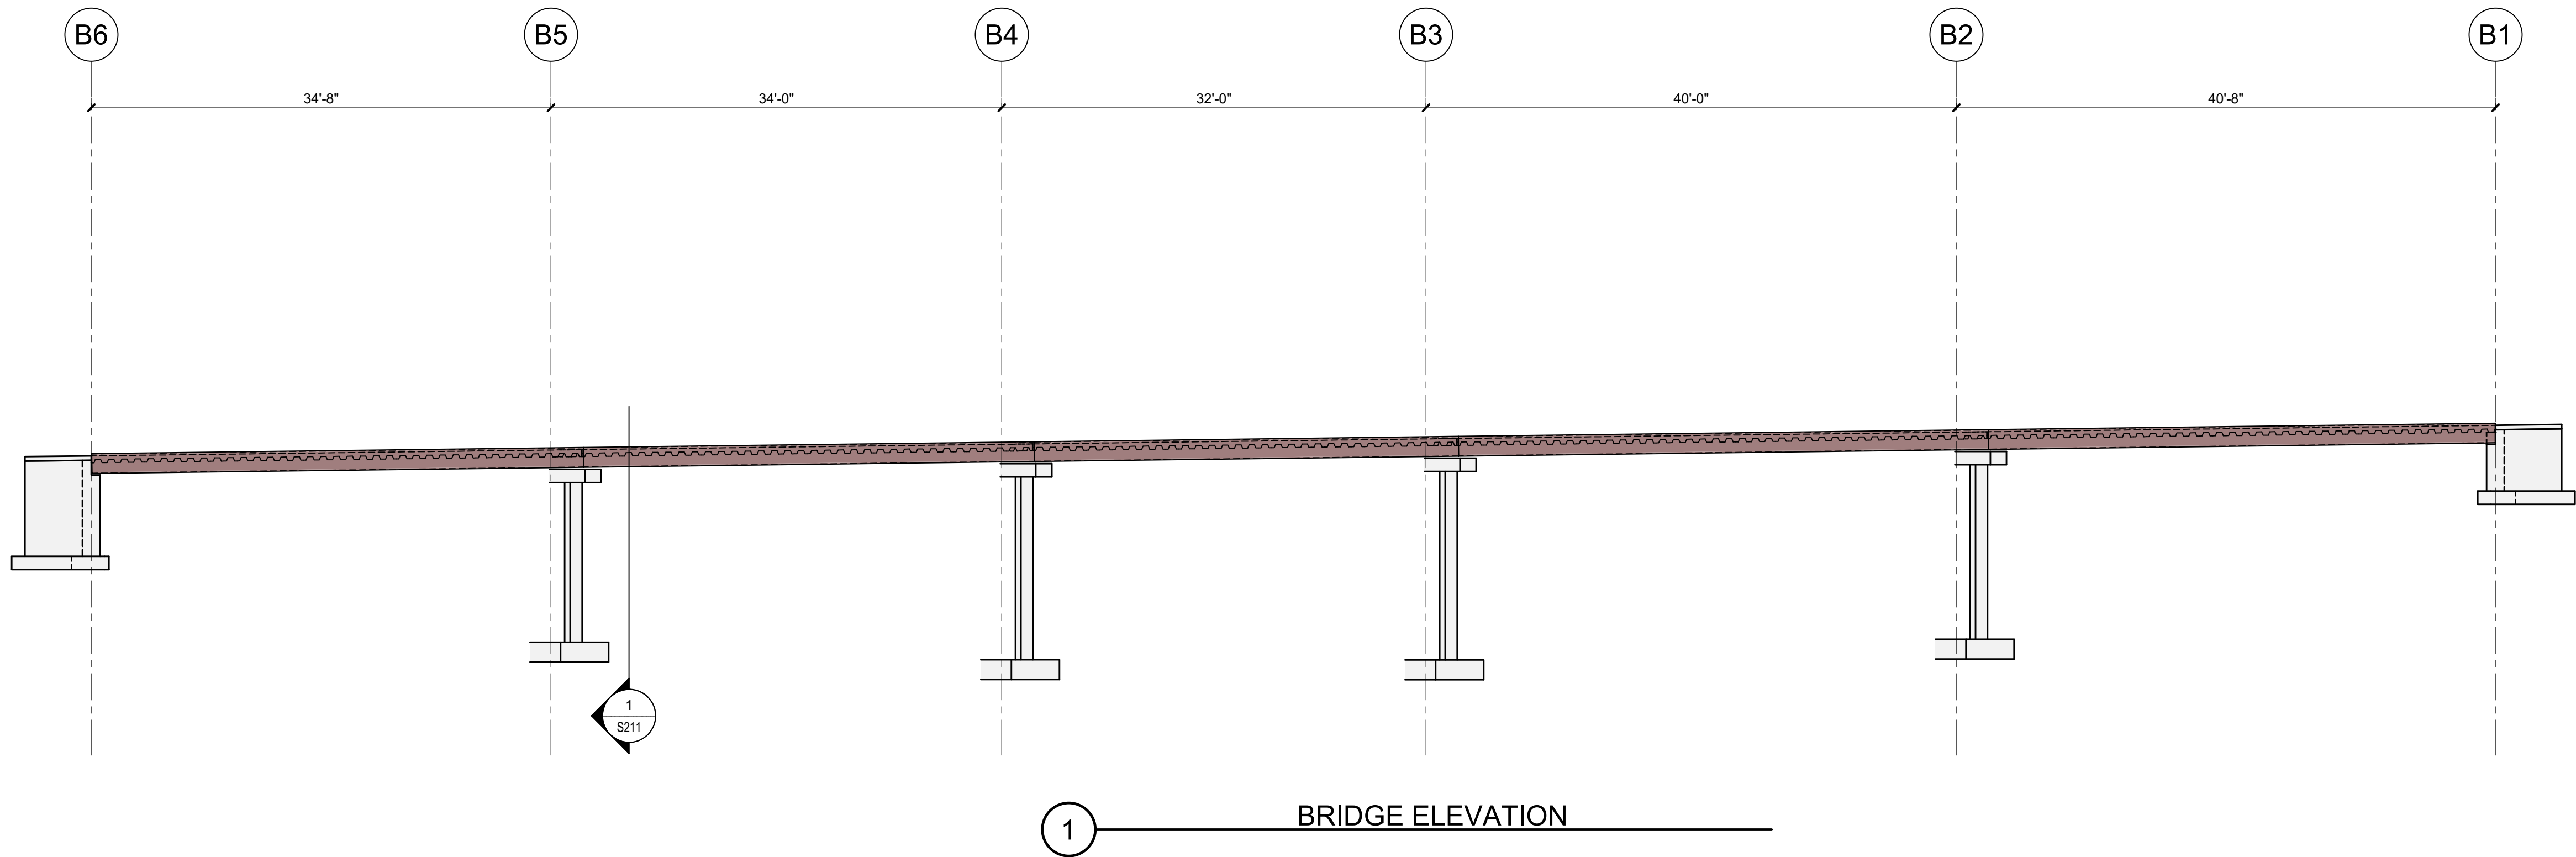

- NOTES:**
1. REFERENCE ELEVATION 1006.29' = 0'-0" (REFER TO CIVIL DRAWINGS)
 2. FOUNDATION ELEMENTS ARE CENTERED UNDER COLUMNS UNLESS NOTED OTHERWISE
 3. REFER TO ARCHITECTURAL AND CIVIL DRAWINGS FOR DIMENSIONS NOT SHOWN. COORDINATE ALL DIMENSIONS WITH ARCHITECTURAL AND CIVIL DRAWINGS
 4. TOP OF SLAB ELEVATIONS ARE APPROXIMATE. REFER TO CIVIL DRAWINGS FOR TOP OF SLAB ELEVATIONS AND SLOPES.



Devenney Group Ltd., Architects
6900 East Camelback Road
Suite 500
Scottsdale, AZ 85251
T: 602.943.8950
www.devenneygroup.com

Consultant:



Structural Engineers
750 Old Hickory Blvd.
Building 1, Suite 175
Brentwood, TN 37027
www.sdi-al.com
615 320 1735



IF THESE PLANS DO NOT BEAR THE SEAL OF A REGISTRANT, THEY ARE TO BE CONSIDERED "PRELIMINARY" AND ARE NOT TO BE USED FOR CONSTRUCTION OR RECORDING. THESE PLANS ARE COPYRIGHTED AND ARE SUBJECT TO COPYRIGHT PROTECTION AS AN "ARCHITECTURAL WORK" UNDER SEC. 102 OF THE COPYRIGHT ACT, 17 U.S.C. AS AMENDED DECEMBER 1990 AND KNOWN AS ARCHITECTURAL WORKS COPYRIGHT PROTECTION ACT OF 1990. THE PROTECTION INCLUDES BUT IS NOT LIMITED TO THE OVERALL FORM AS WELL AS THE ARRANGEMENT AND COMPOSITION OF SPACES AND ELEMENTS OF THE DESIGN. UNDER SUCH PROTECTION, UNAUTHORIZED USE OF THESE PLANS CAN LEGALLY RESULT IN THE CESSION OF CONSTRUCTION OR BUILDINGS BEING SIZED AND/OR MONETARY COMPENSATION TO DEVENNEY GROUP LTD.

MED SURG & DIETARY EXPANSION

HCA - LEE'S SUMMIT MEDICAL CENTER
2100 SE BLUE PKWY
LEE'S SUMMIT, MO 64063

AUTHORITY HAVING JURISDICTION:
CITY OF LEE'S SUMMIT BUILDING DEPT.
MISSOURI DHSS

FACILITY NUMBER:
0972400009



AGENCY APPROVALS:
AGENCY

REVISIONS		
REV #	DESCRIPTION	DATE

DATE: 2024/12/05
SCALE: 1/8" = 1'-0"
DRAWN: JL
REVIEWED: JDP
JOB NUMBER: 6406.24

PEDESTRIAN BRIDGE
FOUNDATION AND
FRAMING PLANS


S120

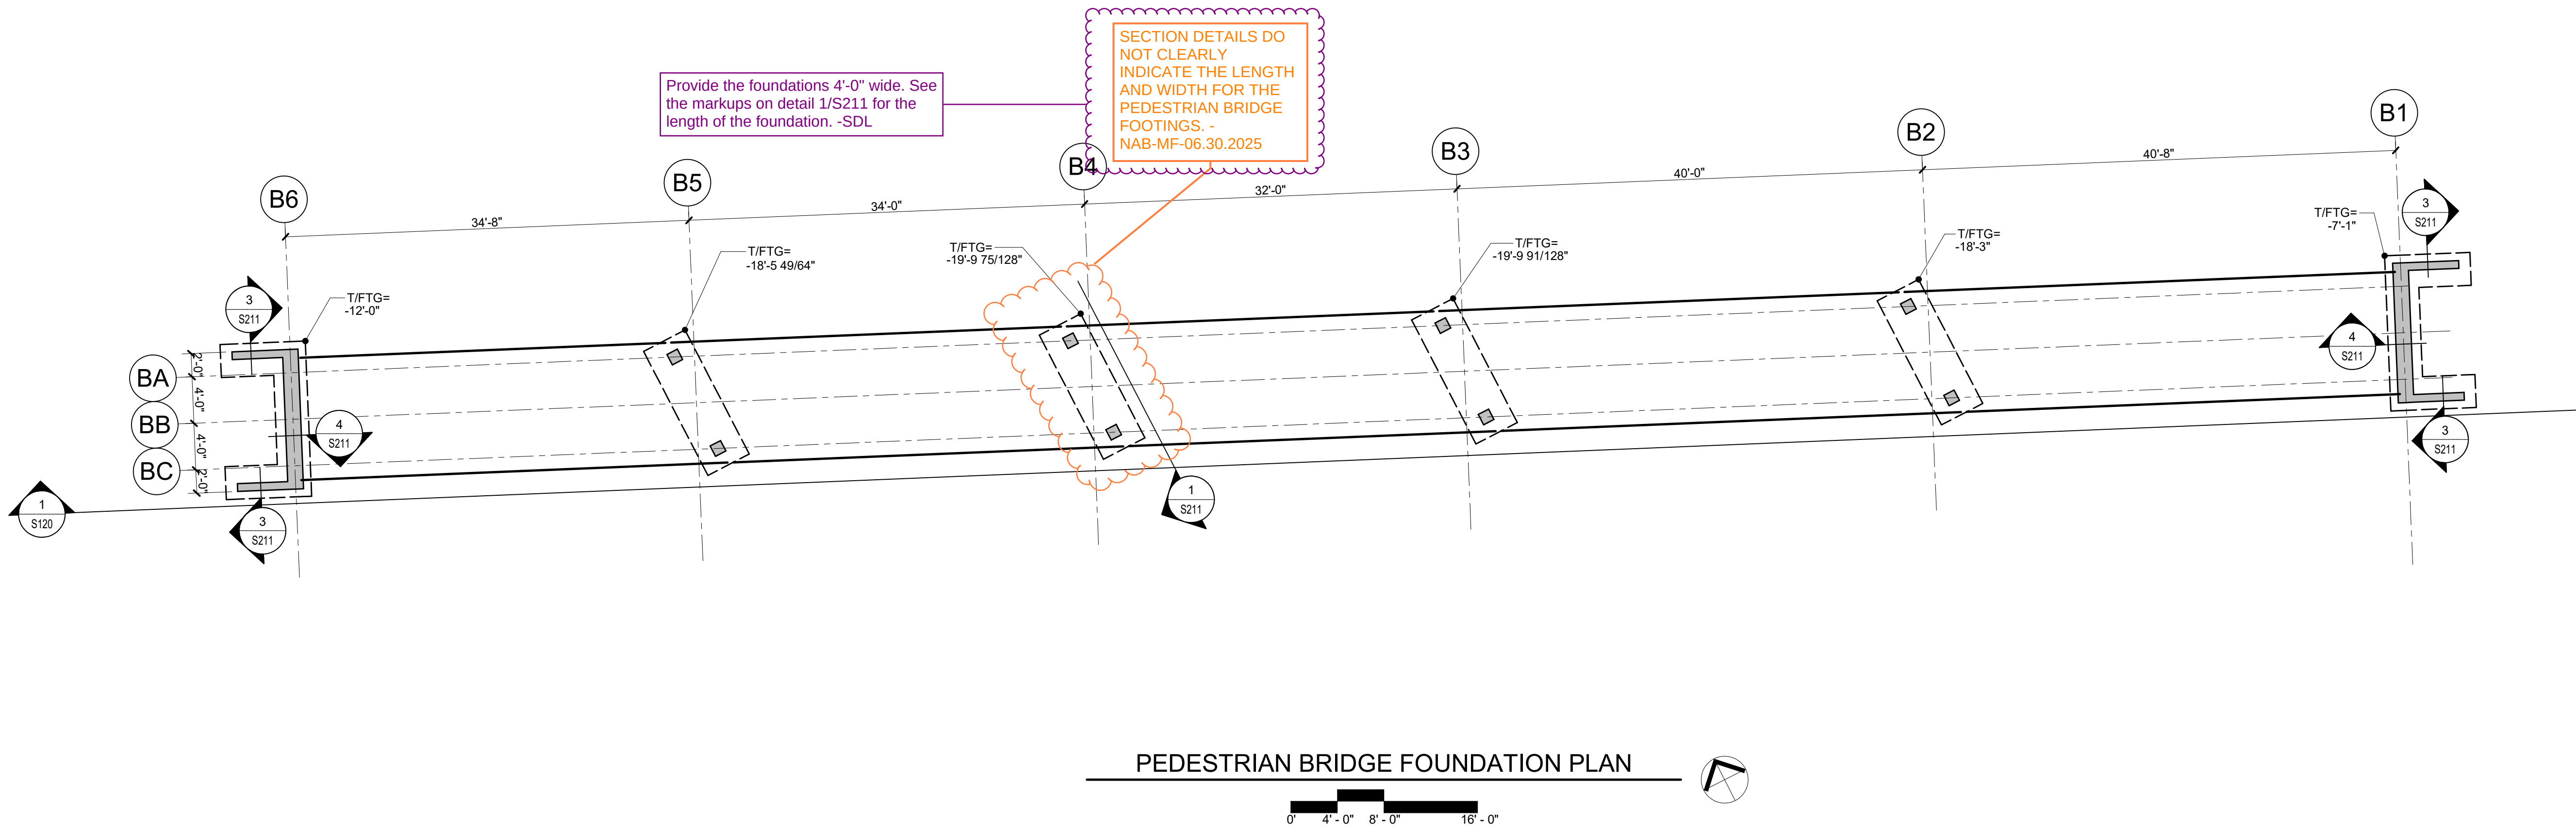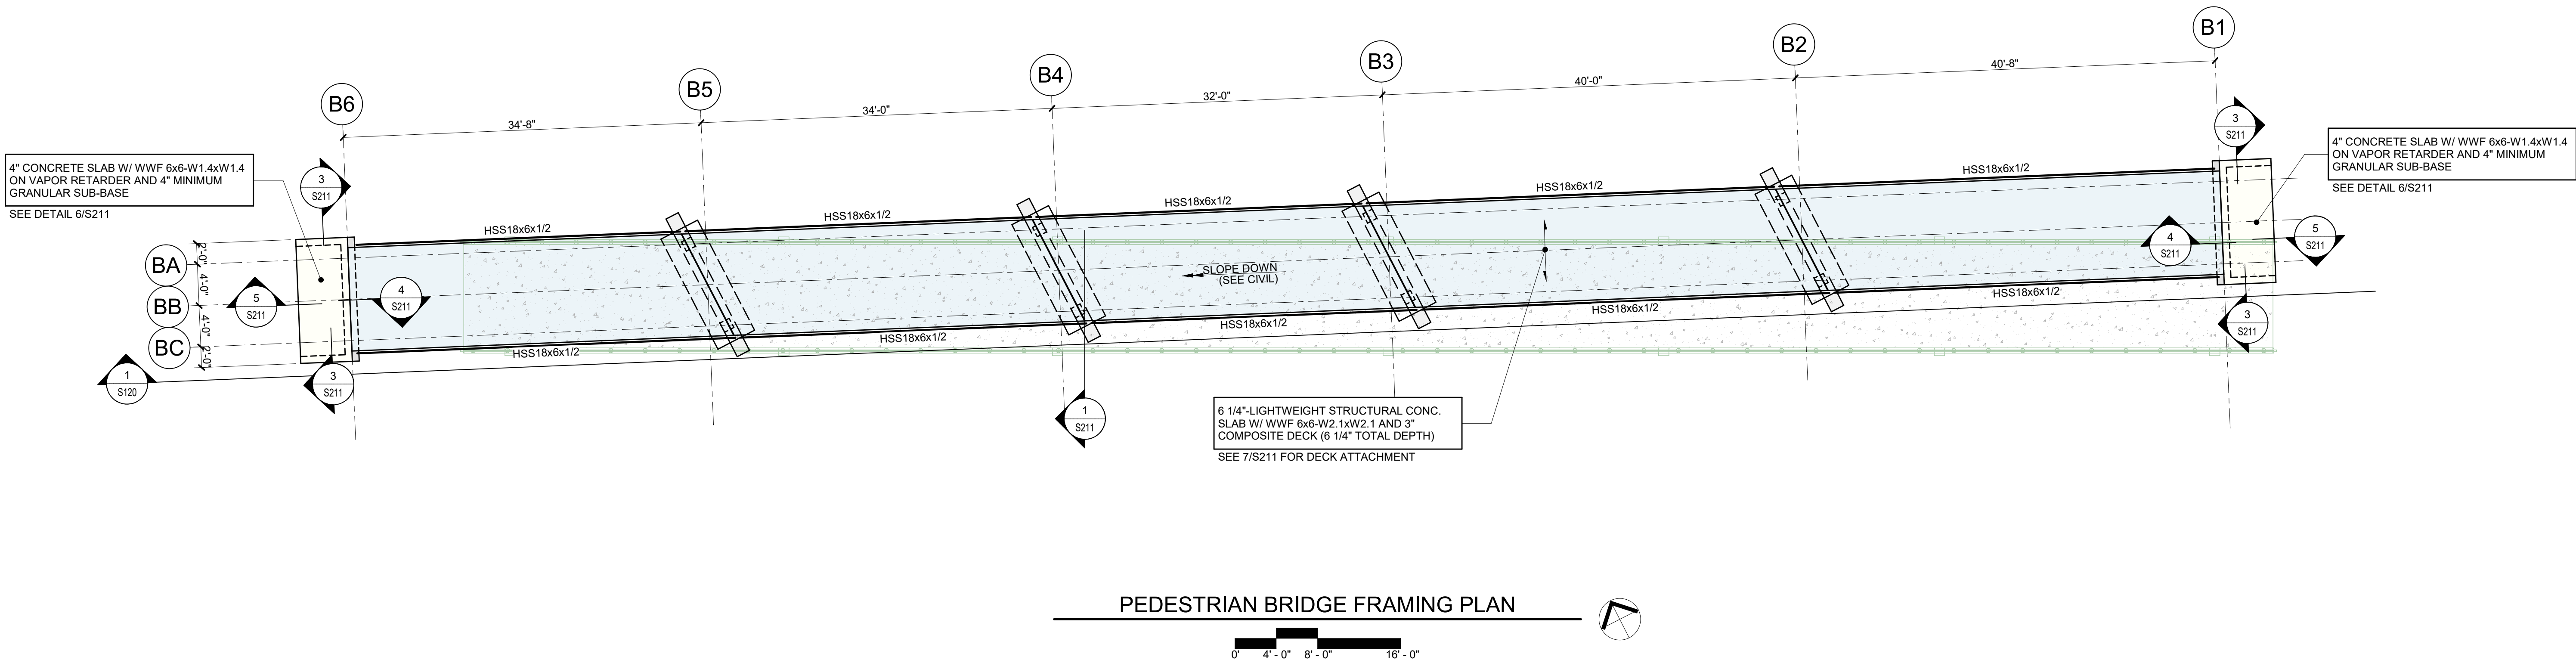



Devenney Group Ltd., Architects
6900 East Camelback Road
Suite 500
Scottsdale, AZ 85251
T: 602.943.8950
www.devenneygroup.com

Consultant:

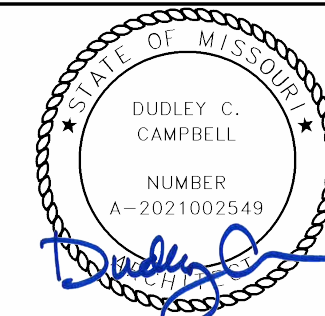

DATE SIGNED: 12.05.24

IF THESE PLANS DO NOT BEAR THE SEAL OF A REGISTRANT, THEY ARE TO BE CONSIDERED "PRELIMINARY" AND ARE NOT TO BE USED FOR CONSTRUCTION OR RECORDING. THESE PLANS ARE COPYRIGHTED AND ARE SUBJECT TO COPYRIGHT PROTECTION AS AN "ARCHITECTURAL WORK" UNDER SEC. 102 OF THE COPYRIGHT ACT, 17 U.S.C. AS AMENDED DECEMBER 1990 AND KNOWN AS ARCHITECTURAL WORKS COPYRIGHT PROTECTION ACT OF 1990. THE PROTECTION INCLUDES BUT IS NOT LIMITED TO THE OVERALL FORM AS WELL AS THE ARRANGEMENT AND COMPOSITION OF SPACES AND ELEMENTS OF THE DESIGN. UNDER SUCH PROTECTION, UNAUTHORIZED USE OF THESE PLANS CAN LEGALLY RESULT IN THE SEIZURE OF CONSTRUCTION OR BUILDINGS BEING SEIZED AND/OR MONETARY COMPENSATION TO DEVENNEY GROUP LTD.

MED SURG & DIETARY EXPANSION

HCA - LEE'S SUMMIT MEDICAL CENTER
2100 SE BLUE PKWY
LEE'S SUMMIT, MO 64063

AUTHORITY HAVING JURISDICTION:
CITY OF LEE'S SUMMIT BUILDING DEPT.
MISSOURI DHSS

FACILITY NUMBER:
0972400009


AGENCY APPROVALS:
AGENCY

REVISIONS		
REV #	DESCRIPTION	DATE


DATE: 2024/12/05
SCALE: As indicated
DRAWN:
REVIEWED:
JOB NUMBER: 6406.24

SITE DETAILS

AS501

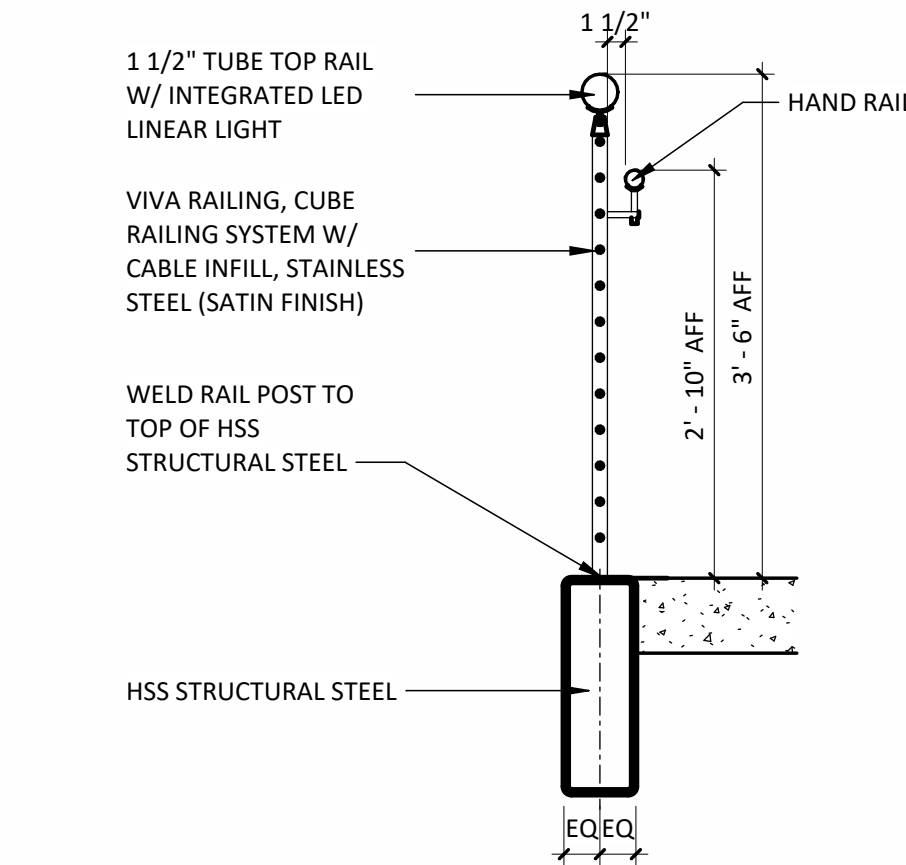


3 GUARDRAIL/HANDRAIL SECTION AT BRIDGE
3/4" = 1'-0"

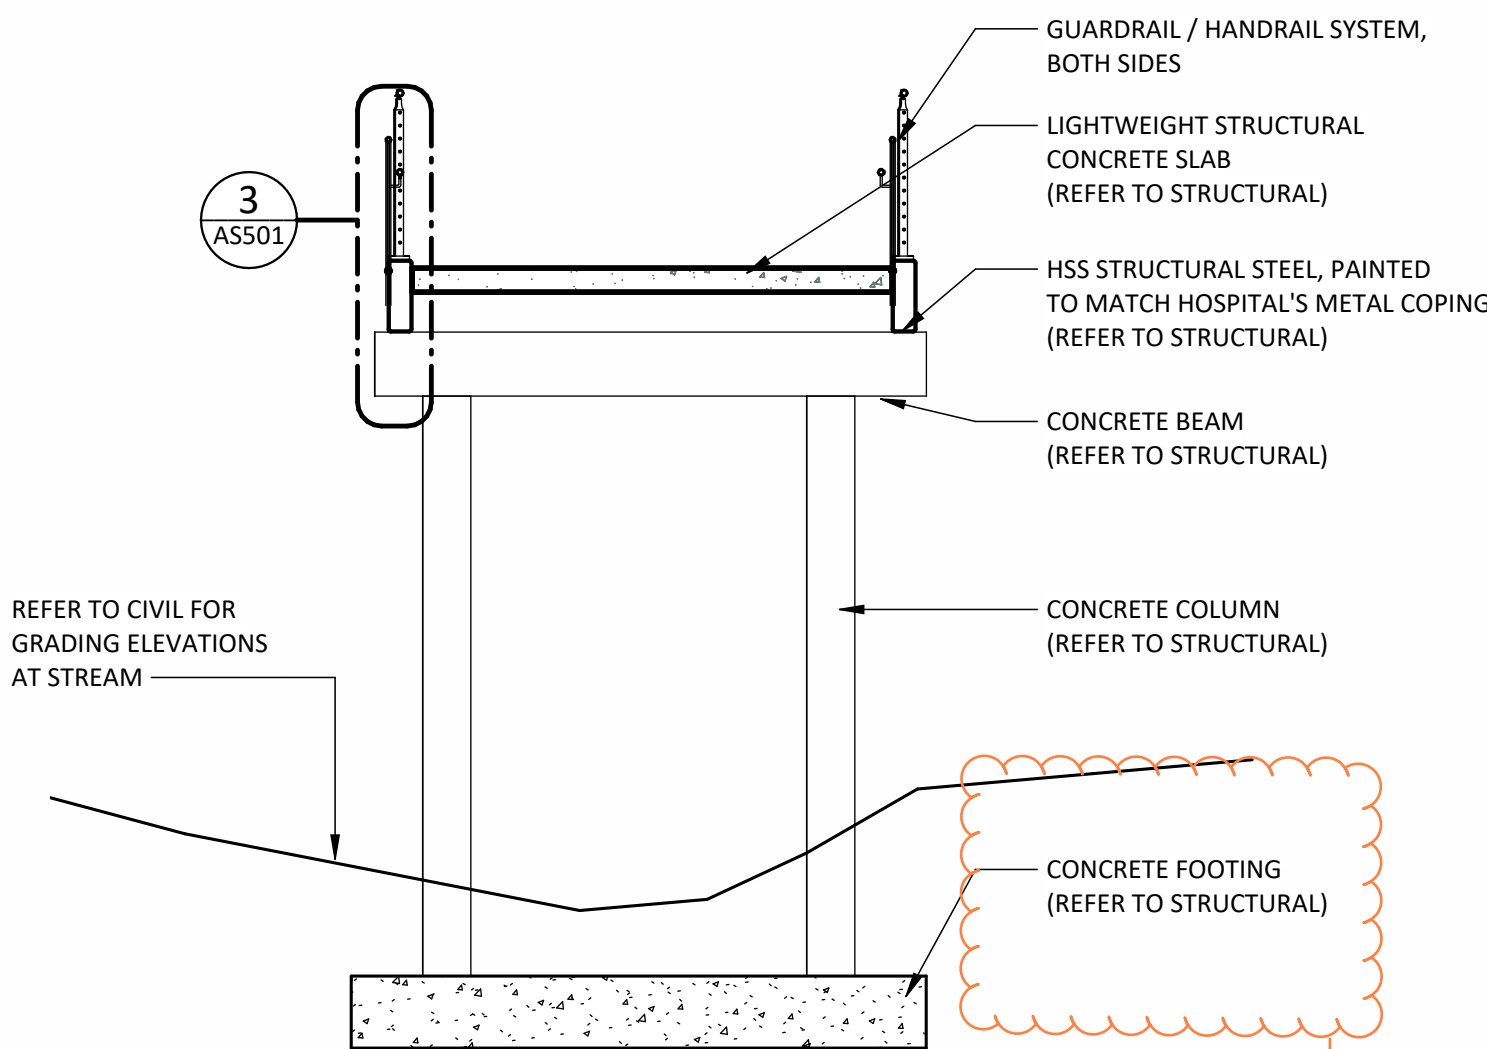

2 PEDESTRIAN BRIDGE SECTION
1/4" = 1'-0"

SECTION DETAIL REFERENCES THE STRUCTUAL DRAWINGS FOR DETAILS ON THE PEDESTRIAN BRIDGE FOOTINGS, HOWEVER, NO STRUCTURAL DETAILS DEFINE THE FOOTINGS LENGTH AND WIDTH. - NAB-MF-06.30.2025

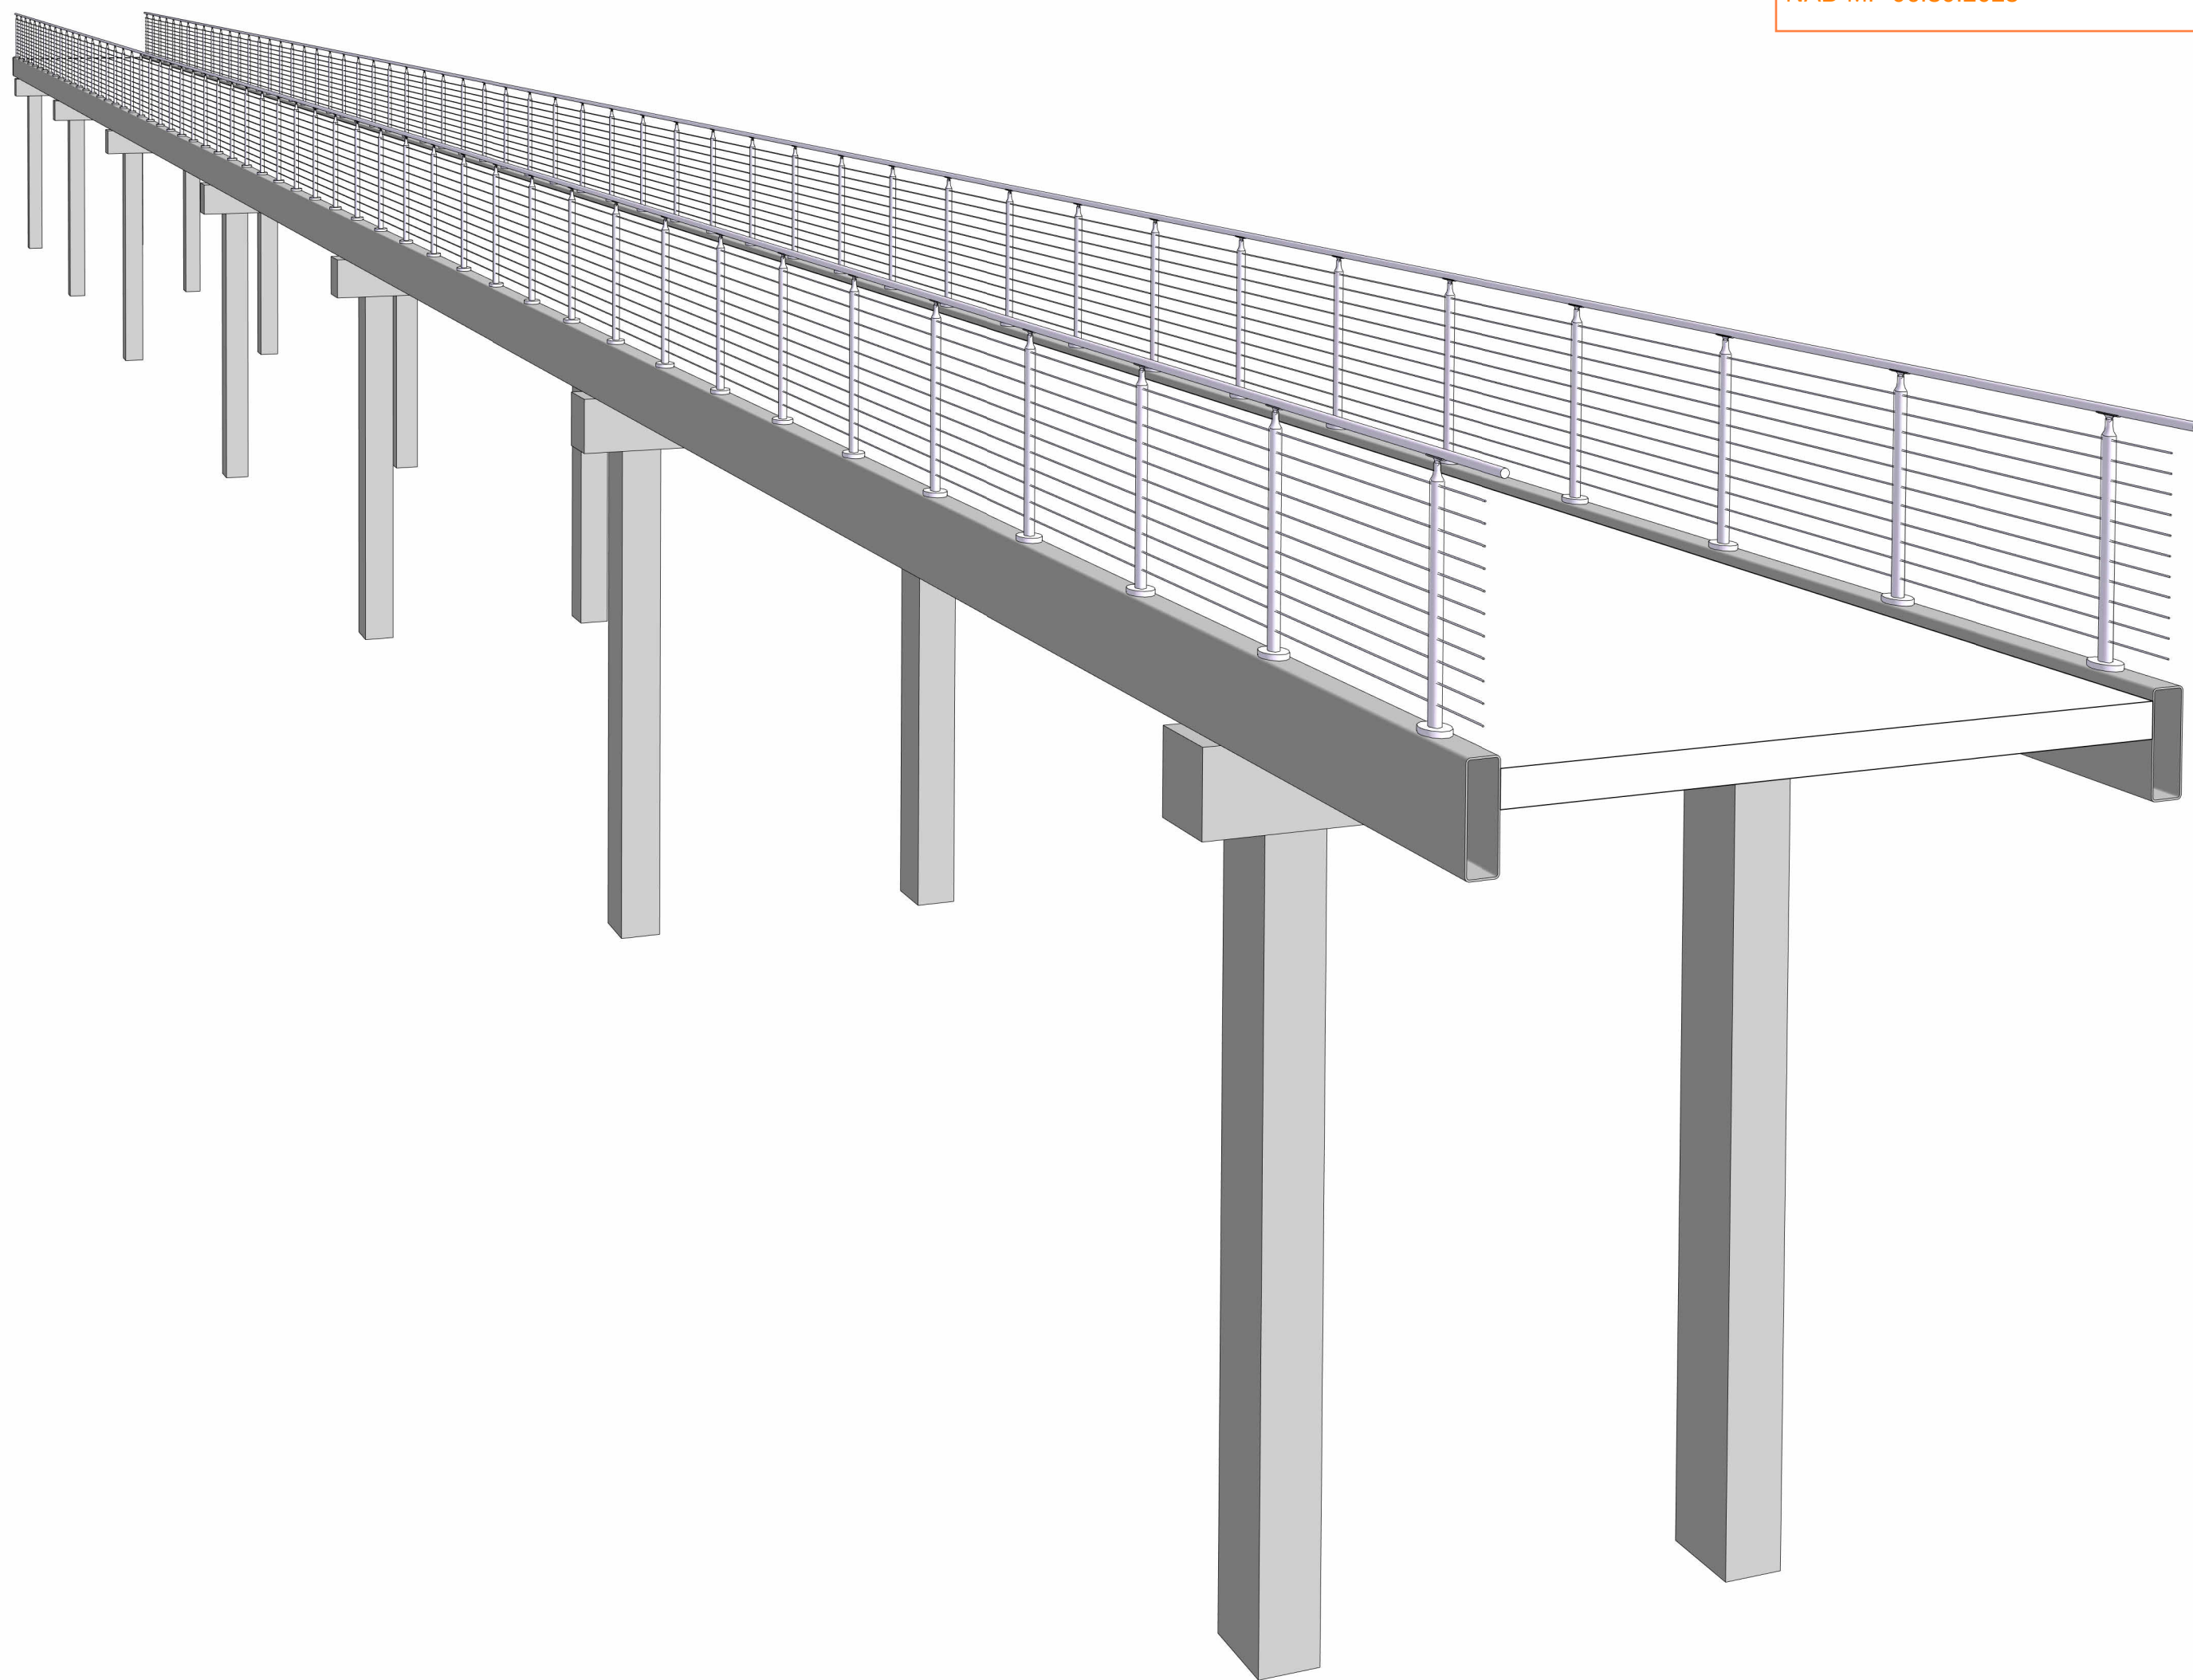

1 PEDESTRIAN BRIDGE