



SteelFab Texas, Inc.
304 Central Expressway South
Allen, Texas 75013
P: 972-562-7720

Project: 33616-SFTX HCA Lee's Summit
210 SE Blue Pkwy
Lee's Summit, Missouri 64063

RFI #8: Continuous Deck over Girders

Status	Open		
To	Ryan Ewing (SteelFab TX, Inc.)	From	New Mill Docs (NEW MILL BLDG SYSTEMS-INDIANA)
Date Initiated	Mar 4, 2025	Due Date	Mar 7, 2025
Location			
Cost Impact	Schedule Impact		
Spec Section			
Drawing Number	Reference		
Linked Drawings			
Received From			
Copies To			

Activity

Question

Question from New Mill Docs NEW MILL BLDG SYSTEMS-INDIANA on Monday, Mar 3, 2025 at 06:28 PM CST

1. Please confirm that we can run decking continuous across the girders without opening them up as shown below. If we must follow the detail below, the field will need to rip the deck at all girders.

Attachments

[33616 HCA - Lee's Summit - Deck over beams RFI 1.pdf](#)

Awaiting an Official Response

The deck is required to have its low flute centered on the girder to avoid following the referenced detail.

SDL: Nishith Sardhara
Dt: 03/12/2025

Stanley D. Lindsey and Associates, Ltd.

Structural Engineer's review is only for general conformance with the structural Contract Documents. Corrections or comments made on the shop drawings during this review do not relieve the Contractor from compliance with the requirements of the Contract Documents and applicable laws, codes and regulations. The Contractor is responsible for: dimensions to be confirmed and correlated at the jobsite; information that pertains solely to the fabrication processes or to the means, methods, techniques, sequences and procedures of construction; coordination of the Work with all other trades; and performing all Work in a safe and satisfactory manner.

- | | |
|--|--|
| ☐ Limited Review – This submittal is for a deferred submittal item designed by specialty engineer. Structural Engineer's review is limited to the design criteria and loads imposed to the base structure only. | |
| ☐ Reviewed – No Exceptions Taken | ☐ Rejected – Revise and Resubmit |
| ☐ Reviewed – With Exceptions as Noted | ☐ Not Reviewed – Record Copy Only |
| ☐ Reviewed – With Exceptions as Noted, Submit Record Copy | ☒ RFI Response |

Date: 10/21/2025

Reviewer: Nishith Sardhara



NEW MILLENNIUM

A Steel Dynamics Company


Request for Information

To: SteelFab **Attn:** Ryan Ewing **Date:** 3/3/25

From: Yancey Vaughan **New Mill Job #:** 2125-0048 **Ph Number:** 540-798-2749

RE: 33616 HCA – Lee's Summit **Total Pages:** 1

1. Please confirm that we can run decking continuous across the girders without opening them up as shown below. If we must follow the detail below, the field will need to rip the deck at all girders.

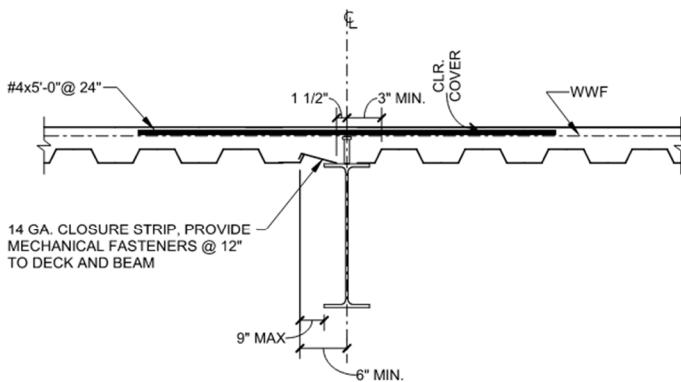

6 TYPICAL CLOSURE DETAIL

Response:

Thank you,
Yancey Vaughan – New Millennium – Project Manager