



Nabholz Construction - Lenexa
17300 W 116th Street
Lenexa, Kansas 66219
P: (913) 393-6500

Project: 08-25-3320 HCA LSMC DIETARY EXPANSION
2100 SE BLUE PARKWAY
LEE'S SUMMIT, Missouri 64063

RFI #049: Canopy Concrete Pedestal Dimension and Cladding

Revision	0	Status	Open
To	Luke Arbanas (Nabholz Construction Corporation) (<i>Response Required</i>) Lance Stadick (NABHOLZ CONSTRUCTION KANSAS) (<i>Response Required</i>)	From	David Panto (Nabholz Construction Corporation)
Date Initiated	Sep 12, 2025	Due Date	Sep 19, 2025
Location	Exterior Building>South>West End	Project Stage	Pre-Construction
Cost Impact	TBD	Schedule Impact	TBD
Spec Section			
Drawing Number	S201	Reference	
Linked Drawings			
Copies To	Don Kelley (Nabholz Construction Corporation), David Panto (Nabholz Construction Corporation), Vince Praderio (LITHKO CONTRACTING LLC), Lance Stadick (NABHOLZ CONSTRUCTION KANSAS)		
Priority			
Constraint			

Stanley D. Lindsey and Associates, Ltd.

Structural Engineer's review is only for general conformance with the structural Contract Documents. Corrections or comments made on the shop drawings during this review do not relieve the Contractor from compliance with the requirements of the Contract Documents and applicable laws, codes and regulations. The Contractor is responsible for: dimensions to be confirmed and correlated at the jobsite; information that pertains solely to the fabrication processes or to the means, methods, techniques, sequences and procedures of construction; coordination of the Work with all other trades; and performing all Work in a safe and satisfactory manner.

☐ Limited Review – This submittal is for a deferred submittal item designed by specialty engineer. Structural Engineer's review is limited to the design criteria and loads imposed to the base structure only.

☐ Reviewed – No Exceptions Taken

☐ Rejected – Revise and Resubmit

☐ Reviewed – With Exceptions as Noted

☐ Not Reviewed – Record Copy Only

☐ Reviewed – With Exceptions as Noted, Submit Record Copy

☒ RFI Response

Date: 10/21/2025

Reviewer: Nishith Sardhara

Activity

Question

Question from David Panto Nabholz Construction Corporation on Friday, Sep 12, 2025 at 12:59 PM CDT

Can you let us know the dimensions for the canopy column concrete pedestals?

Drawing S201, Detail 12 show the concrete pedestal, on detail 9 it shows 1' - 3" please provide clarification on concrete pedestals dimension. We checked AE450 (Details 8 and 9) and we could see that the pedestal will get aluminum composite metal wall paneling that will be 1'-6" x 1'-6", but we did not see the dimensions for the concrete pedestal. Please advise.

Can you also confirm that the aluminum composite metal wall paneling will be installed instead of the EIFS called out in S201?

Attachments

[canopy concrete pedestal dimensions.pdf](#)


Awaiting an Official Response

REFER TO THE MARKUPS AND THE COMMENTS ON THE LAST SHEET.

SDL: NISHITH SARDHARA

DT: 09/23/2025

Drawing S201

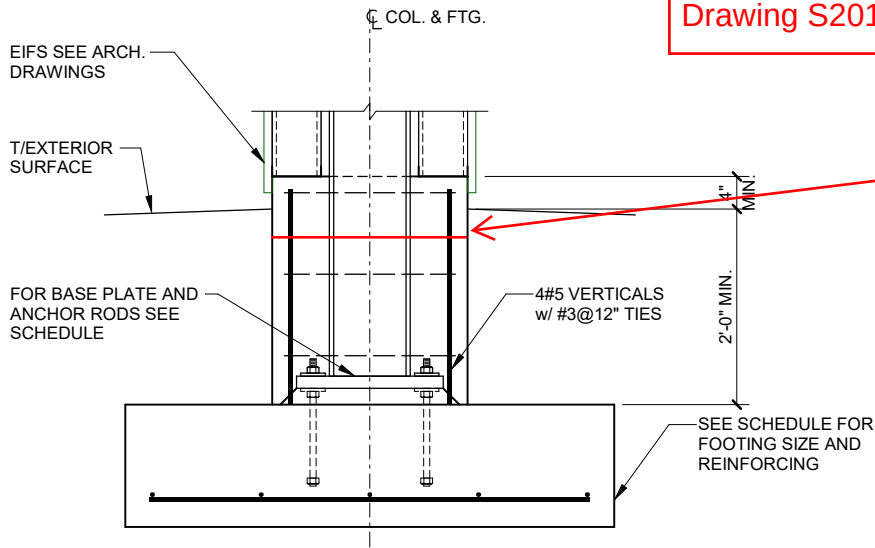


Can you tell us this dimension?

12

SECTION AT CANOPY COLUMN

Drawing AE450

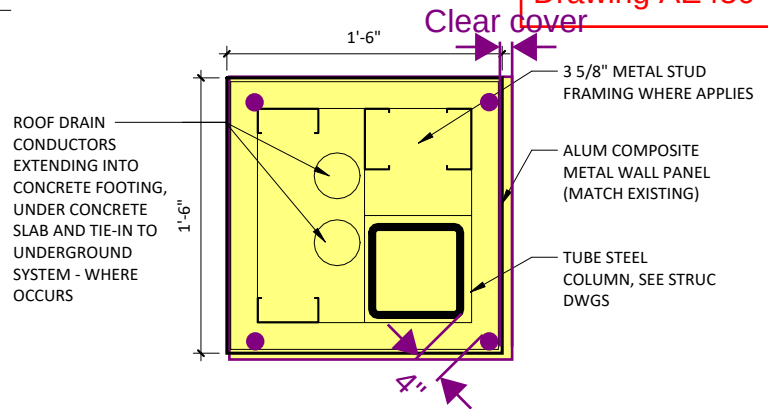


8

CANOPY COLUMN

1 1/2" = 1'-0"

THE ARCHITECT TO CONFIRM THE DIMENSION OF THE PEDESTAL REQUIRED UNDERNEATH THE METAL STUD FRAMING. PROVIDE 4#5 BARS IN THE PEDESTAL PER DETAIL 12/S201. THE CLEARANCE BETWEEN THE STEEL COLUMN AND BAR SHOULD BE AT LEAST 4". PROVIDE THE EXTERIOR CLEAR COVER PER S011.

SDL: NISHITH SARDHARA
DT: 09/23/2025

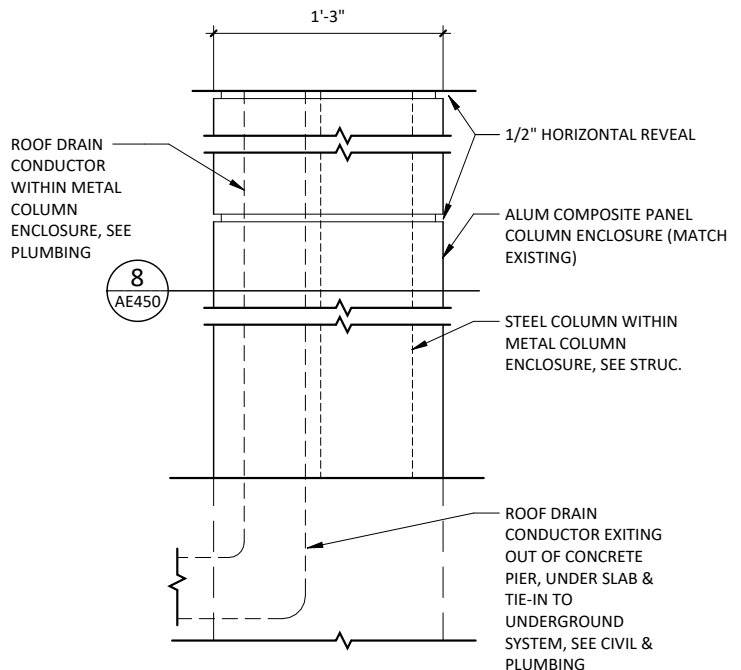

9

CANOPY COLUMN ELEVATION

1 1/2" = 1'-0"