


RELEASE FOR CONSTRUCTION
AS NOTED ON PLANS REVIEW
DEVELOPMENT SERVICES
LEE'S SUMMIT, MISSOURI
11/24/2025 8:29:34

X=###.## = Actual asbuilt ground shots
taken on November 3, 2025

Contours shown are asbuilt.

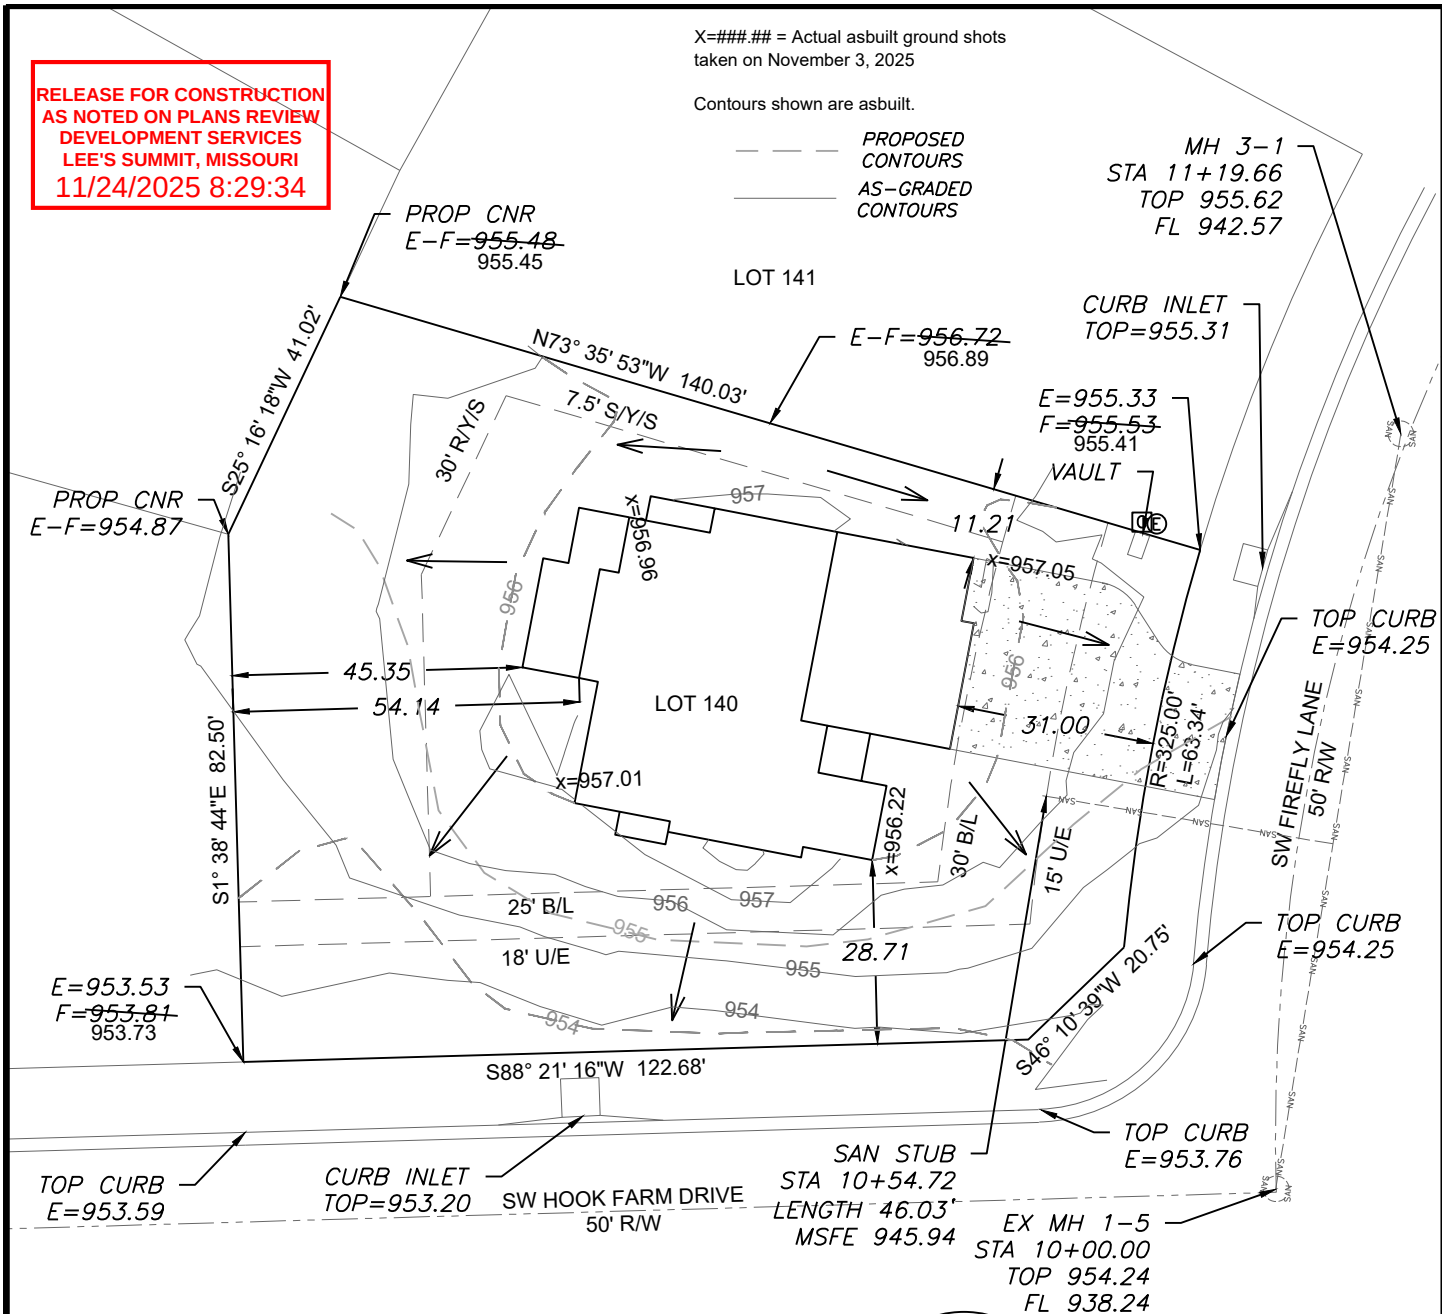

LEGEND

- Gas Meter
- Telephone or Fiber-Optic Pedestal
- Cable TV Pedestal
- Electric Pedestal
- Light Pole
- Mailbox
- Fire Hydrant
- Water Valve

PROPOSED HOUSE



TOP FOUNDATION = 957.75
GARAGE FLOOR = 956.75
TOP FOOTING = 948.75
BASEMENT FLOOR = 949.08
DRIVE SLOPE = 7.4%

E = EXISTING ELEVATION
F = PROPOSED FINAL ELEVATION
G = ADJACENT GRADE AT EGRESS
U/E = UTILITY EASEMENT
B/L = BUILDING LINE
S/Y/S = SIDE YARD SETBACK
R/Y/S = REAR YARD SETBACK

NOTES

- BUILDER TO VERIFY ALL BUILDING ELEVATIONS AND DIMENSIONS.
- THIS PLOT PLAN DOES NOT CONSTITUTE A BOUNDARY SURVEY.
- THE EASEMENTS SHOWN ON THIS PLOT PLAN ARE TO BE SHOWN ON THE FINAL PLAT. OTHER EASEMENTS MAY EXIST.

AS-GRADED PLOT PLAN IS
REQUIRED PRIOR TO SODDING.

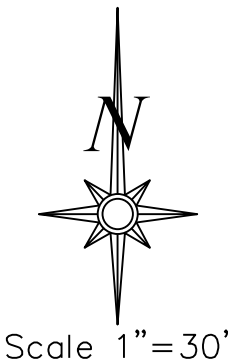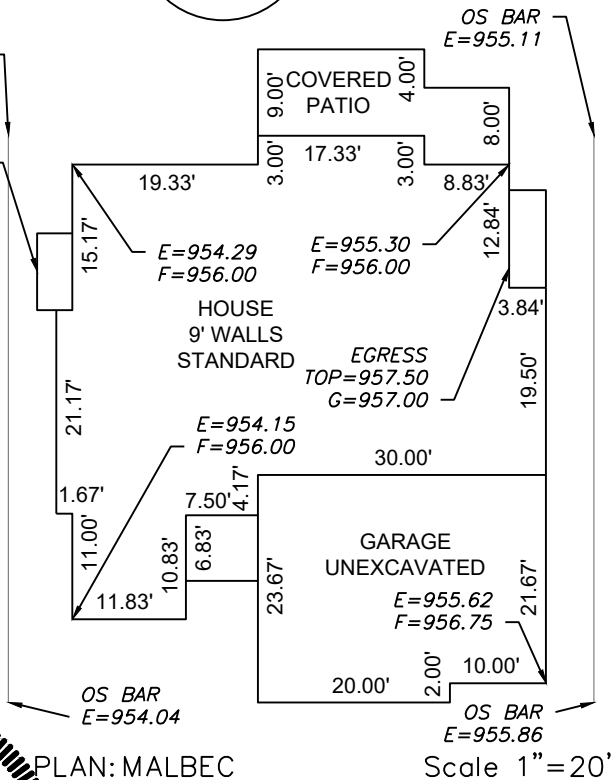

LOT INFORMATION

14,052 SQ. FT.
MSFE = 945.94
MBOE (FRONT LEFT) = 954.41
MBOE (FRONT RIGHT) = 955.85
ADDRESS
2630 SW FLY LANE

LEGAL DESCRIPTION

LOT 140, HOOK FARMS SECOND
PLAT, A SUBDIVISION AS
RECORDED IN LEE'S SUMMIT,
JACKSON COUNTY, MISSOURI.


PLAN: MALBEC

Scale 1"=20'

ENGINEERING
ENGINEERING & SURVEYING
SOLUTIONS

50 SE 30TH STREET
LEE'S SUMMIT, MO 64082
P:(816) 623-9888 F:(816) 623-9849
WWW.ENGINEERING SOLUTIONS KCC.COM

THIS DRAWING IS NOT VALID UNLESS THE SIGNATURE, DATE AND SEAL OF
THE ENGINEER WHO SUPERVISED THE PREPARATION OF THIS DRAWING HAS
BEEN AFFIXED HERETO.

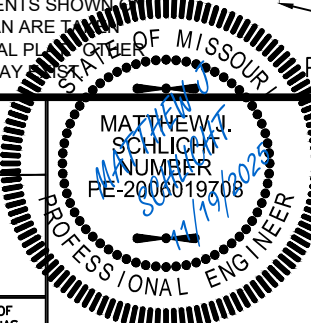

AS-GRADED PLOT PLAN - LOT 140

HOOK FARMS SECOND PLAT
LEE'S SUMMIT, JACKSON COUNTY, MISSOURI

SAB CONSTRUCTION, LLC
200 NW COMMERCE COURT
LEE'S SUMMIT, MO 64086

PROJECT NO.	FILE NAME	DATE	SHEET	OF
1	LOT 140, HOOK FARMS	5/16/25	1	1