


RELEASE FOR CONSTRUCTION
AS NOTED ON PLANS REVIEW
DEVELOPMENT SERVICES
LEE'S SUMMIT, MISSOURI
11/24/2025 4:36:28

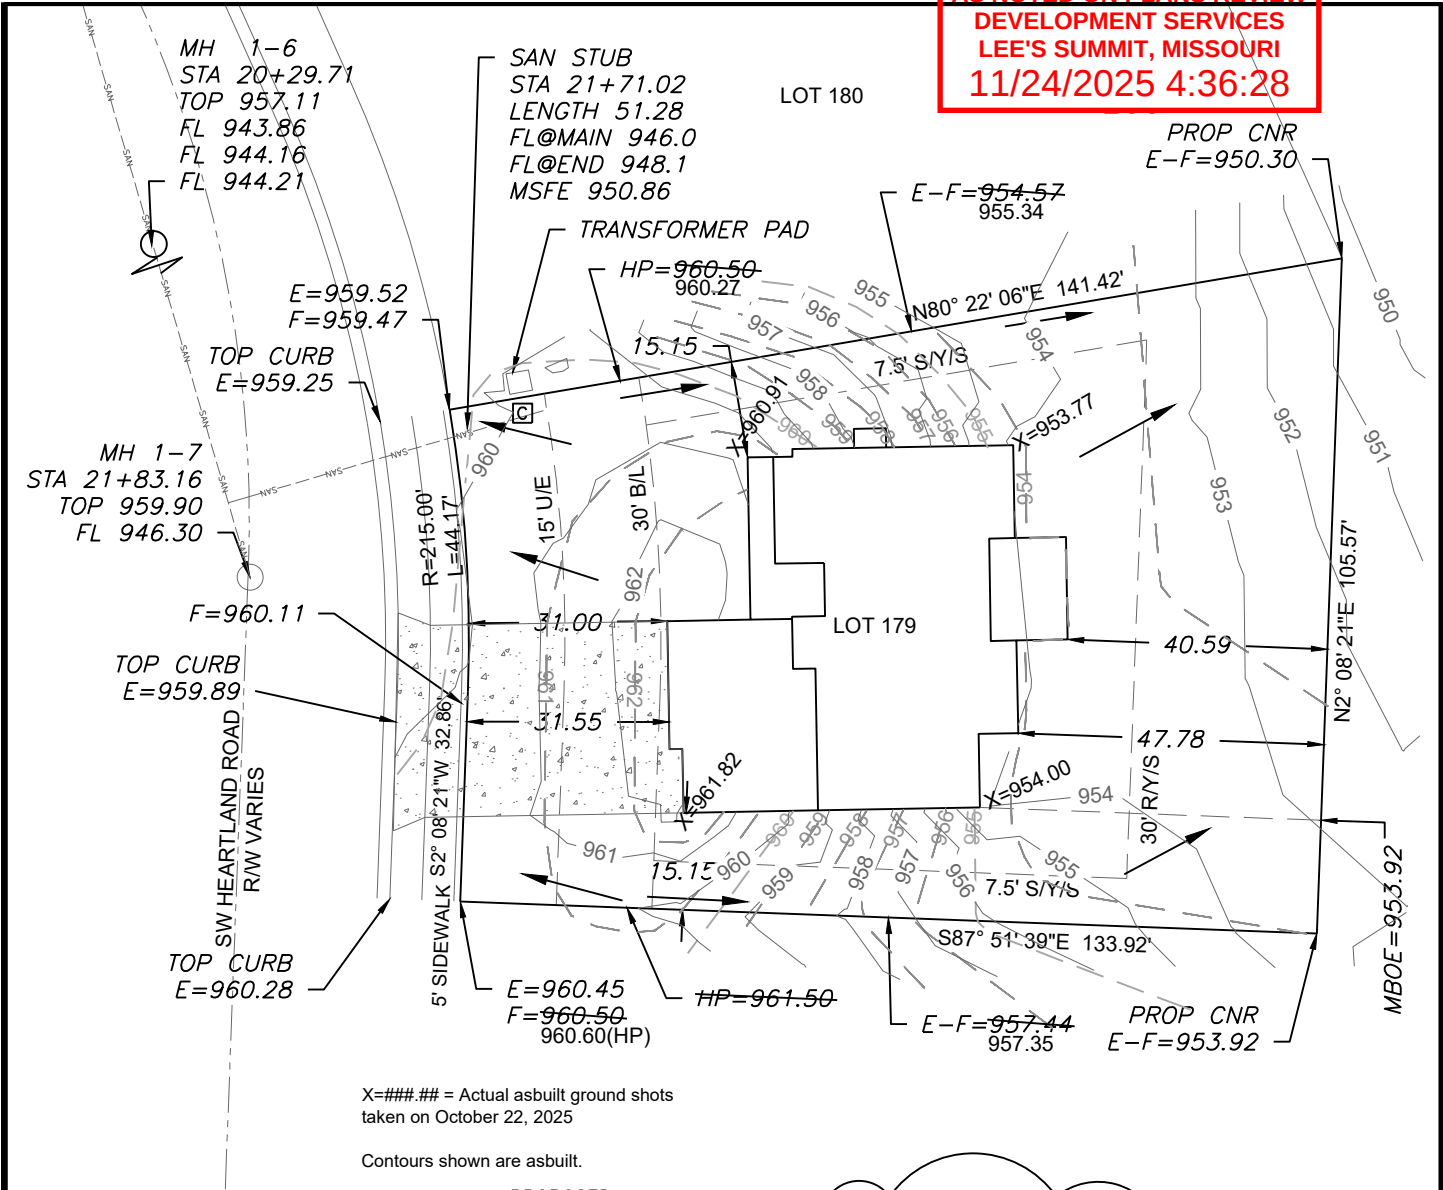

X=###.## = Actual asbuilt ground shots
taken on October 22, 2025

Contours shown are asbuilt.

--- PROPOSED
CONTOURS
--- AS-GRADED
CONTOURS

AS-GRADED PLOT PLAN IS
REQUIRED PRIOR TO SODDING.

LEGEND

- Gas Meter
- Telephone or Fiber-Optic Pedestal
- Cable TV Pedestal
- Electric Pedestal
- Light Pole
- Mailbox
- Fire Hydrant
- Water Valve



PROPOSED HOUSE

TOP FOUNDATION = 963.50
GARAGE FLOOR = 962.50
TOP FOOTING = 954.50
BASEMENT FLOOR = 954.83
DRIVE SLOPE = 7.6%

E = EXISTING ELEVATION
F = PROPOSED FINAL ELEVATION
G = ADJACENT GRADE AT EGRESS
U/E = UTILITY EASEMENT
B/L = BUILDING LINE
S/Y/S = SIDE YARD SETBACK
R/Y/S = REAR YARD SETBACK

NOTES

- BUILDER TO VERIFY ALL BUILDING ELEVATIONS AND DIMENSIONS.
- THIS PLOT PLAN DOES NOT CONSTITUTE A BOUNDARY SURVEY.
- THE EASEMENTS SHOWN ON THIS PLOT PLAN ARE TAKEN FROM THE FINAL PLAT. OTHER EASEMENTS MAY EXIST.

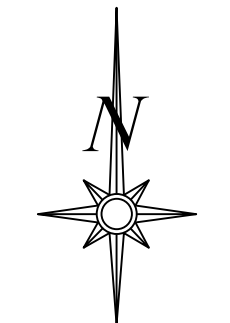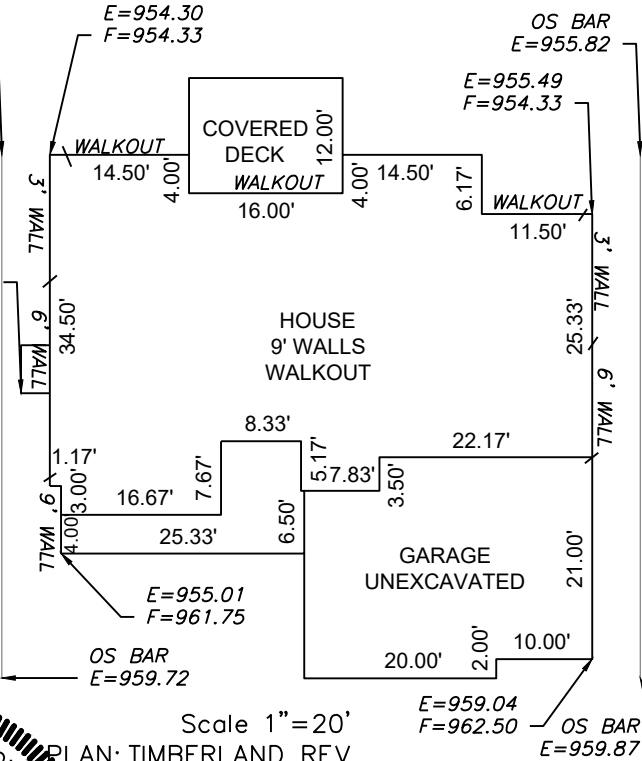


Scale 1"=30'

LOT INFORMATION

12,337 SQ. FT.
REAR LEFT MBOE = 951.68
REAR RIGHT MBOE = 954.38
MSFE = 950.86
ADDRESS
2829 SW HEARTLAND ROAD
LEGAL DESCRIPTION
LOT 179, THE RETREAT AT HOOK FARMS SECOND PLAT, LEE'S SUMMIT, JACKSON COUNTY, MISSOURI.

Scale 1"=20'
PLAN: TIMBERLAND REV.

ENGINEERING SOLUTIONS
ENGINEERING & SURVEYING
50 SE 30TH STREET
LEE'S SUMMIT, MO 64082
P: (816) 623-9888 F: (816) 623-9849
WWW.ENGINEERINGSSOLUTIONSKCC.COM

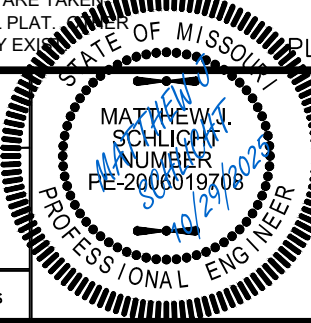

AS-GRADED PLOT PLAN - LOT 179

THE RETREAT AT HOOK FARMS SECOND PLAT
LEE'S SUMMIT, JACKSON COUNTY, MISSOURI

NEW MARK HOMES
P.O. BOX 12025
PARKVILLE, MISSOURI 64152

PROJECT NO.	FILE NAME	DATE	SHEET	OF
1	LOT 179, RETREAT AT HOOK FARMS	2/4/25	1	1

THIS DRAWING IS NOT VALID UNLESS THE SIGNATURE, DATE AND SEAL OF THE ENGINEER WHO SUPERVISED THE PREPARATION OF THIS DRAWING HAS BEEN AFFIXED HERETO.