

Table 8.6.5.2.2 Suspended or Floor-Mounted Obstructions in Light Hazard Occupancies Only (SSU/SSP)

Horizontal Distance (A)	Minimum Vertical Distance Below Deflector (B)
6 in. (150 mm) or less	3 (75)
More than 6 in. (150 mm) to 9 in. (225 mm)	4 (100)
More than 9 in. (225 mm) to 12 in. (300 mm)	6 (150)
More than 12 in. (300 mm) to 15 in. (375 mm)	8 (200)
More than 15 in. (375 mm) to 18 in. (450 mm)	9½ (240)
More than 18 in. (450 mm) to 24 in. (600 mm)	12½ (315)
More than 24 in. (600 mm) to 30 in. (750 mm)	15½ (395)
More than 30 in. (750 mm)	18 (450)

For SI units, 1 in. = 25.4 mm.
Note: For A and B, refer to Figure 8.6.5.2.2.

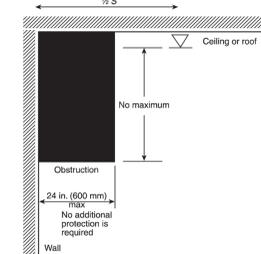


FIGURE 8.6.5.1.2(a) Obstructions Against Walls (SSU/SSP)

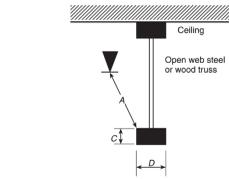


FIGURE 8.6.5.1.2(b) Obstruction Against Wall (SSU/SSP)

FIGURE 8.6.5.1.2(c) Obstructions Against Walls (SSU/SSP)

FIGURE 8.6.5.2.1(a) Positioning of Sprinkler to Avoid Obstruction to Discharge (SSU/SSP)

FIGURE 8.6.5.2.1(b) Positioning of Sprinkler to Avoid Obstruction to Discharge (SSU/SSP)

FIGURE 8.6.5.2.1(c) Positioning of Sprinkler to Avoid Obstruction to Discharge (SSU/SSP)

FIGURE 8.6.5.2.1(d) Positioning of Sprinkler to Avoid Obstruction to Discharge (SSU/SSP)

FIGURE 8.6.5.2.1(e) Positioning of Sprinkler to Avoid Obstruction to Discharge (SSU/SSP)

FIGURE 8.6.5.2.1(f) Positioning of Sprinkler to Avoid Obstruction to Discharge (SSU/SSP)

FIGURE 8.6.5.2.1(g) Positioning of Sprinkler to Avoid Obstruction to Discharge (SSU/SSP)

FIGURE 8.6.5.2.1(h) Positioning of Sprinkler to Avoid Obstruction to Discharge (SSU/SSP)

NFPA 13 - OBSTRUCTION CODES:

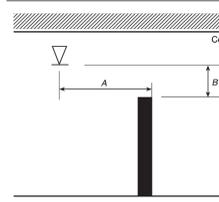


FIGURE 8.6.5.1.2.2 Suspended or Floor-Mounted Obstruction in Light Hazard Occupancies Only (SSU/SSP)

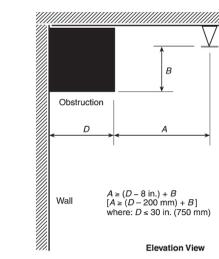


FIGURE 8.6.5.1.2(b) Obstruction Against Wall (SSU/SSP)

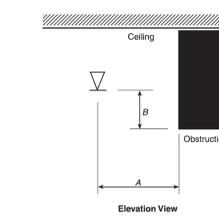


FIGURE 8.6.5.1.2(a) Positioning of Sprinkler to Avoid Obstruction to Discharge (SSU/SSP)

FIGURE 8.6.5.1.2(b) Positioning of Sprinkler to Avoid Obstruction to Discharge (SSU/SSP)

FIGURE 8.6.5.1.2(c) Positioning of Sprinkler to Avoid Obstruction to Discharge (SSU/SSP)

FIGURE 8.6.5.1.2(d) Positioning of Sprinkler to Avoid Obstruction to Discharge (SSU/SSP)

FIGURE 8.6.5.1.2(e) Positioning of Sprinkler to Avoid Obstruction to Discharge (SSU/SSP)

FIGURE 8.6.5.1.2(f) Positioning of Sprinkler to Avoid Obstruction to Discharge (SSU/SSP)

FIGURE 8.6.5.1.2(g) Positioning of Sprinkler to Avoid Obstruction to Discharge (SSU/SSP)

FIGURE 8.6.5.1.2(h) Positioning of Sprinkler to Avoid Obstruction to Discharge (SSU/SSP)

FIGURE 8.6.5.1.2(i) Positioning of Sprinkler to Avoid Obstruction to Discharge (SSU/SSP)

FIGURE 8.6.5.1.2(ak) Positioning of Sprinkler to Avoid Obstruction to Discharge (SSU/SSP)

FIGURE 8.6.5.1.2(al) Positioning of Sprinkler to Avoid Obstruction to Discharge (SSU/SSP)

FIGURE 8.6.5.1.2(am) Positioning of Sprinkler to Avoid Obstruction to Discharge (SSU/SSP)

FIGURE 8.6.5.1.2(an) Positioning of Sprinkler to Avoid Obstruction to Discharge (SSU/SSP)

FIGURE 8.6.5.1.2(ao) Positioning of Sprinkler to Avoid Obstruction to Discharge (SSU/SSP)

8.6.6 Clearance to Storage (Standard Pendent and Upright Spray Sprinklers).

8.6.6.1 The clearance between the deflector and the top of storage shall be 18 in. (450 mm) or greater.
8.6.6.2 The 18 in. (450 mm) dimension shall not limit the height of shelving on a wall or shelving against a wall in accordance with 8.6.6, 8.7.6, 8.8.6, and Section 8.9.

8.6.6.2.1 Where shelving is installed on a wall and is not directly below sprinklers, the shelves, including storage thereon, shall be permitted to extend above the level of a plane located 18 in. (450 mm) below ceiling sprinkler deflectors.








8.6.6.2.2 Shelving, and any storage thereon, directly below the sprinklers shall not extend above a plane located 18 in. (450 mm) below the ceiling sprinkler deflectors.

8.6.6.3 Where other standards specify greater clearance to storage minimums, they shall be followed.

Table 8.6.5.1.2 Positioning of Sprinklers to Avoid Obstructions to Discharge (Standard Spray Upright/Standard Spray Pendent (SSU/SSP))






Distance from Sprinklers to Side of Obstruction (A)	Maximum Allowable Distance of Deflector Above Bottom of Obstruction (B)
Less than 1 ft (300 mm)	0 (0)
1 ft (300 mm) to less than 1 ft 6 in. (450 mm)	2½ (65)
1 ft 6 in. (450 mm) to less than 2 ft (600 mm)	3½ (90)
2 ft (600 mm) to less than 2 ft 6 in. (750 mm)	5½ (140)
2 ft 6 in. (750 mm) in. to less than 3 ft (900 mm)	7½ (190)
3 ft (900 mm) to less than 3 ft 6 in. (1.1 m)	9½ (240)
3 ft 6 in. (1.1 m) to less than 4 ft (1.2 m)	12 (300)
4 ft (1.2 m) to less than 4 ft 6 in. (1.4 m)	14 (350)
4 ft 6 in. (1.4 m) to less than 5 ft (1.5 m)	16½ (420)
5 ft (1.5 m) to less than 5 ft 6 in. (1.7 m)	18 (450)
5 ft 6 in. (1.7 m) to less than 6 ft (1.8 m)	20 (510)
6 ft (1.8 m) to less than 6 ft 6 in. (2.0 m)	24 (600)
6 ft 6 in. (2.0 m) to less than 7 ft (2.1 m)	30 (750)
7 ft (2.1 m) to less than 7 ft 6 in. (2.3 m)	35 (875)

For SI units, 1 in. = 25.4 mm; 1 ft = 0.3048 m.
Note: For A and B, refer to Figure 8.6.5.1.2(a).

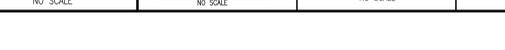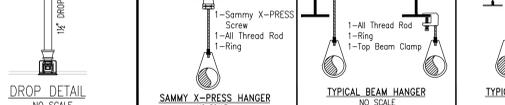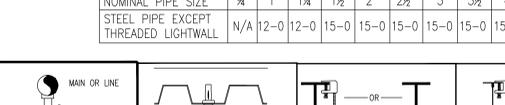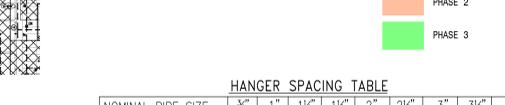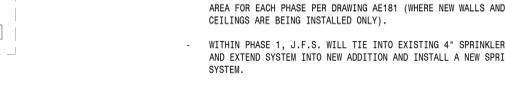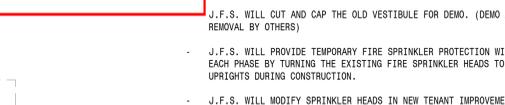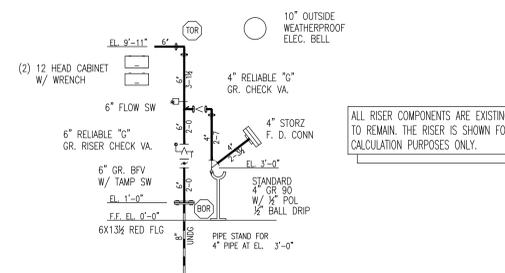

PROJECT DATA	
PROJECT NAME	HCA - LEE'S SUMMIT MEDICAL CENTER - EMERGENCY DEPARTMENT EXPANSION
ADDRESS	2100 SE BLUE PKWAY LEE'S SUMMIT, MO 64063
BRIEF PROJECT DESCRIPTION	THIS PROJECT INCLUDES THE FOLLOWING COMPONENT: •LEVEL 1: - NEW CONSTRUCTION AND RENOVATION TO EXPAND THE EXISTING ED DEPARTMENT WITH ADDITIONAL EXAM ROOMS AND STAFF SUPPORT SPACES. MAJOR AND MINOR RENOVATION OF EXISTING SPACES TO ALLOW FOR A COHESIVE LOOK THROUGH OUT THE EMERGENCY DEPARTMENT.
PROJECT SCOPE AREAS (GROSS)	LEVEL 1 - EMERGENCY DEPARTMENT 11,990 SF RENOVATION
TOTAL PROJECT AREA (GROSS)	11,990 (SF)
CONSTRUCTION TYPE (HOSPITAL)	I-A
Fire Sprinklers	Full Per NFPA 13
Fire Alarms Provided	
Emergency Lighting Provided	
Fire Resistance Rating Requirements for Building Elements	
Building Element	TYPE I-A CONSTRUCTION (HOSPITAL)
Primary Structural Frame	3a,b Hours
Bearing walls: Exterior	3 Hours
Bearing walls: Interior	3a Hours
Nonbearing walls and partitions: Exterior	Varies by distance from property line. See IBC table 602.
Nonbearing walls and partitions: Interior	0 Hours
Floor construction and associated secondary members	2 Hours
Roof construction and associated secondary members	1 1/2b Hours
Governing Codes (Local)	Life Safety, Building Code, & Accessibility Review - City of Lee's Summit, MO
Governing Codes (Jurisdictional)	Missouri Dept. of Health and Senior Services 2014 Guidelines for Design and Construction of Health Care Facilities The following 2012 National Fire Codes (NFPA) a. NFPA 70 National Electrical Code b. NFPA 101 Life Safety Code c. 2012 Supplements

a. Roof Supports: Fire-resistance ratings of primary structural frame and bearing walls are permitted to be reduced by 1 hour where supporting roof only. b. Except in Group F-1, H, M and S-1 occupancies, fire protection of structural members shall not be required, including protection of roof framing and decking where every part of the roof construction is 20 feet or more above any floor immediately below. Fire-retardant-treated wood members shall be allowed to be used for such unprotected members. c. In all occupancies, heavy timber complying with section 2304.11 shall be allowed where 1-hour or less fire-resistance rating is required.

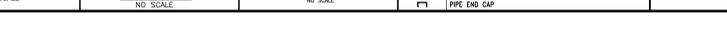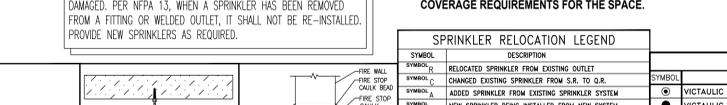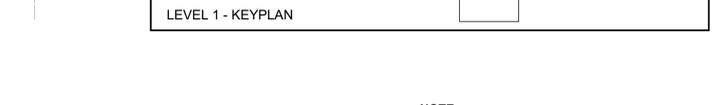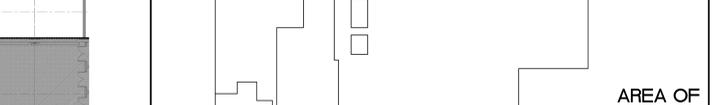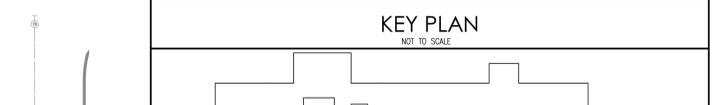









GENERAL NOTES:

ALL FITTINGS CONFORM TO SECTION 2-4 OF NFPA PAMPHLET 13.
VALVES ON CONNECTIONS TO WATER SUPPLIES, SECTIONAL CONTROL VALVES AND OTHER VALVES IN SUPPLY PIPES TO SPRINKLERS SHALL BE SUPERVISED OPEN BY AN APPROVED METHOD.
IT IS THE OWNERS RESPONSIBILITY TO PROVIDE ADEQUATE HEAT TO KEEP THE SPRINKLER SYSTEM FROM FREEZING.
ALL ELECTRICAL WIRING OF ALARM BELLS, FLOW SWITCHES AND TAMPER SWITCHES (IF REQUIRED) TO BE DONE BY OTHERS.
THE SPRINKLER SYSTEM TO BE INSTALLED IN ACCORDANCE WITH NFPA 13.
HANGERS TO BE SPACED TO MEET NFPA REQUIREMENTS
PER NFPA 13, SECTION 8.6.3.2.4, WITHIN SMALL ROOMS AS DEFINED IN SECTION 3.3.20, SPRINKLERS SHALL BE PERMITTED TO BE LOCATED NOT MORE THAN 9 FT. FROM ANY SINGLE WALL, AND SPRINKLER SPACING LIMITATIONS OF SECTION 8.6.5 AND AREA LIMITATIONS OF TABLE 8.6.2.2.1(a) SHALL NOT BE EXCEEDED. JFS MAY MODIFY HEADS SHOWN ON THIS DRAWING TO COMPLY WITH THIS RULE.
c = CENTER LINE OF PIPE BELOW TOP OF STEEL
EL = CENTER LINE OF PIPE ABOVE FINISHED FLOOR

DESIGN CRITERIA:
BUILDING CODE: SEE PROJECT DATA
OCCUPANCY: SEE PROJECT DATA
TYPE OF CONSTRUCTION: SEE PROJECT DATA
AREA OF ADDITION: SEE PROJECT DATA
PER NFPA 13, 2016 EDITION:
SYSTEM TYPE: WET (EXISTING)
EXAM ROOMS, CORRIDOR, NURSES STATION
LIGHT HAZARD
0.10 GPM/ FT. FOR 1500 SQ. FT. (REDUCED TO 1163 SQ. FT. - AREA REDUCTION FOR O.R.)
MAXIMUM 225 S.F. SPRINKLER SPACING
100 GPM HOSE ALLOWANCE
+50 GPM HOSE FOR HYDRANT AFTER BACKFLOW

WATER FLOW DATA:
DATE: 08-29-25
STATIC: 82 PSI
RESIDUAL: 60 PSI W/2100 GPM FLOWING
LOCATION: 2100 SE BLUE PARKWAY
LEE'S SUMMIT, MO 64063
INFO FROM: LEE'S SUMMIT WATER UTILITIES


CONSTRUCTION:
STEEL BEAM CONSTRUCTION
PLAN NOTES:
1. ALL CEILING HEIGHTS TO BE 9'-0" UNLESS NOTED OTHERWISE. ALL ALL SOFFITS TO BE 8'-0" UNLESS NOTED OTHERWISE.
2. SPRINKLERS WILL BE CENTERED IN CEILING TILES WHERE POSSIBLE YET NEVER ANY CLOSER THAN 6 INCHES FROM THE EDGE OF CEILING GRID.
3. ALL GROUVED PIPING IS TO BE SCH. 10 PIPE, ASTM A-796 WITH ROLLED GROUVED ENDS. FITTINGS ARE TO BE IRON GROUVED OR WELDED STEEL OUTLETS.
4. ALL THREADED PIPING IS TO BE "SCHEDULE 40" PIPE, WITH THREADED DUCTILE IRON FITTINGS.

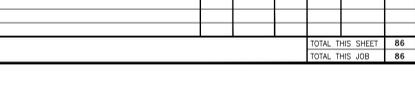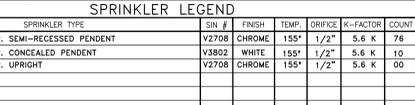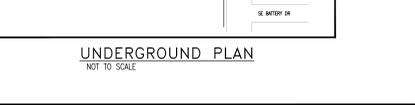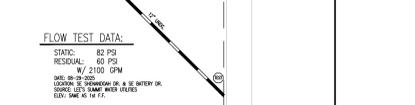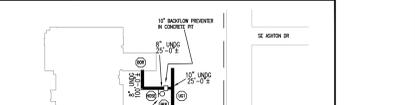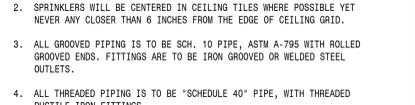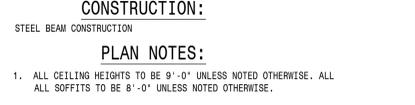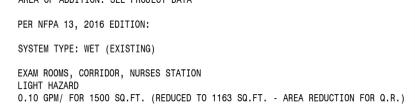

THIS AREA IS SHOWN FOR CALCULATION PURPOSES ONLY

RELEASED FOR CONSTRUCTION
As Noted on Plan Review
Lee's Summit Fire Department
Lee's Summit, Missouri
11/25/2025

SCOPE OF WORK:
PROJECT IS TO BE PHASED WITH 3 TOTAL PHASES
J.F.S. WILL CUT AND CAP THE OLD VESTIBULE FOR DEMO. (DEMO AND REMOVAL BY OTHERS)
J.F.S. WILL PROVIDE TEMPORARY FIRE SPRINKLER PROTECTION WITHIN EACH PHASE BY TURNING THE EXISTING FIRE SPRINKLER HEADS TO UPRIGHTS DURING CONSTRUCTION.
J.F.S. WILL MODIFY SPRINKLER HEADS IN NEW TENANT IMPROVEMENT AREA FOR EACH PHASE PER DRAWING AE181 (WHERE NEW WALLS AND CEILING ARE BEING INSTALLED ONLY).



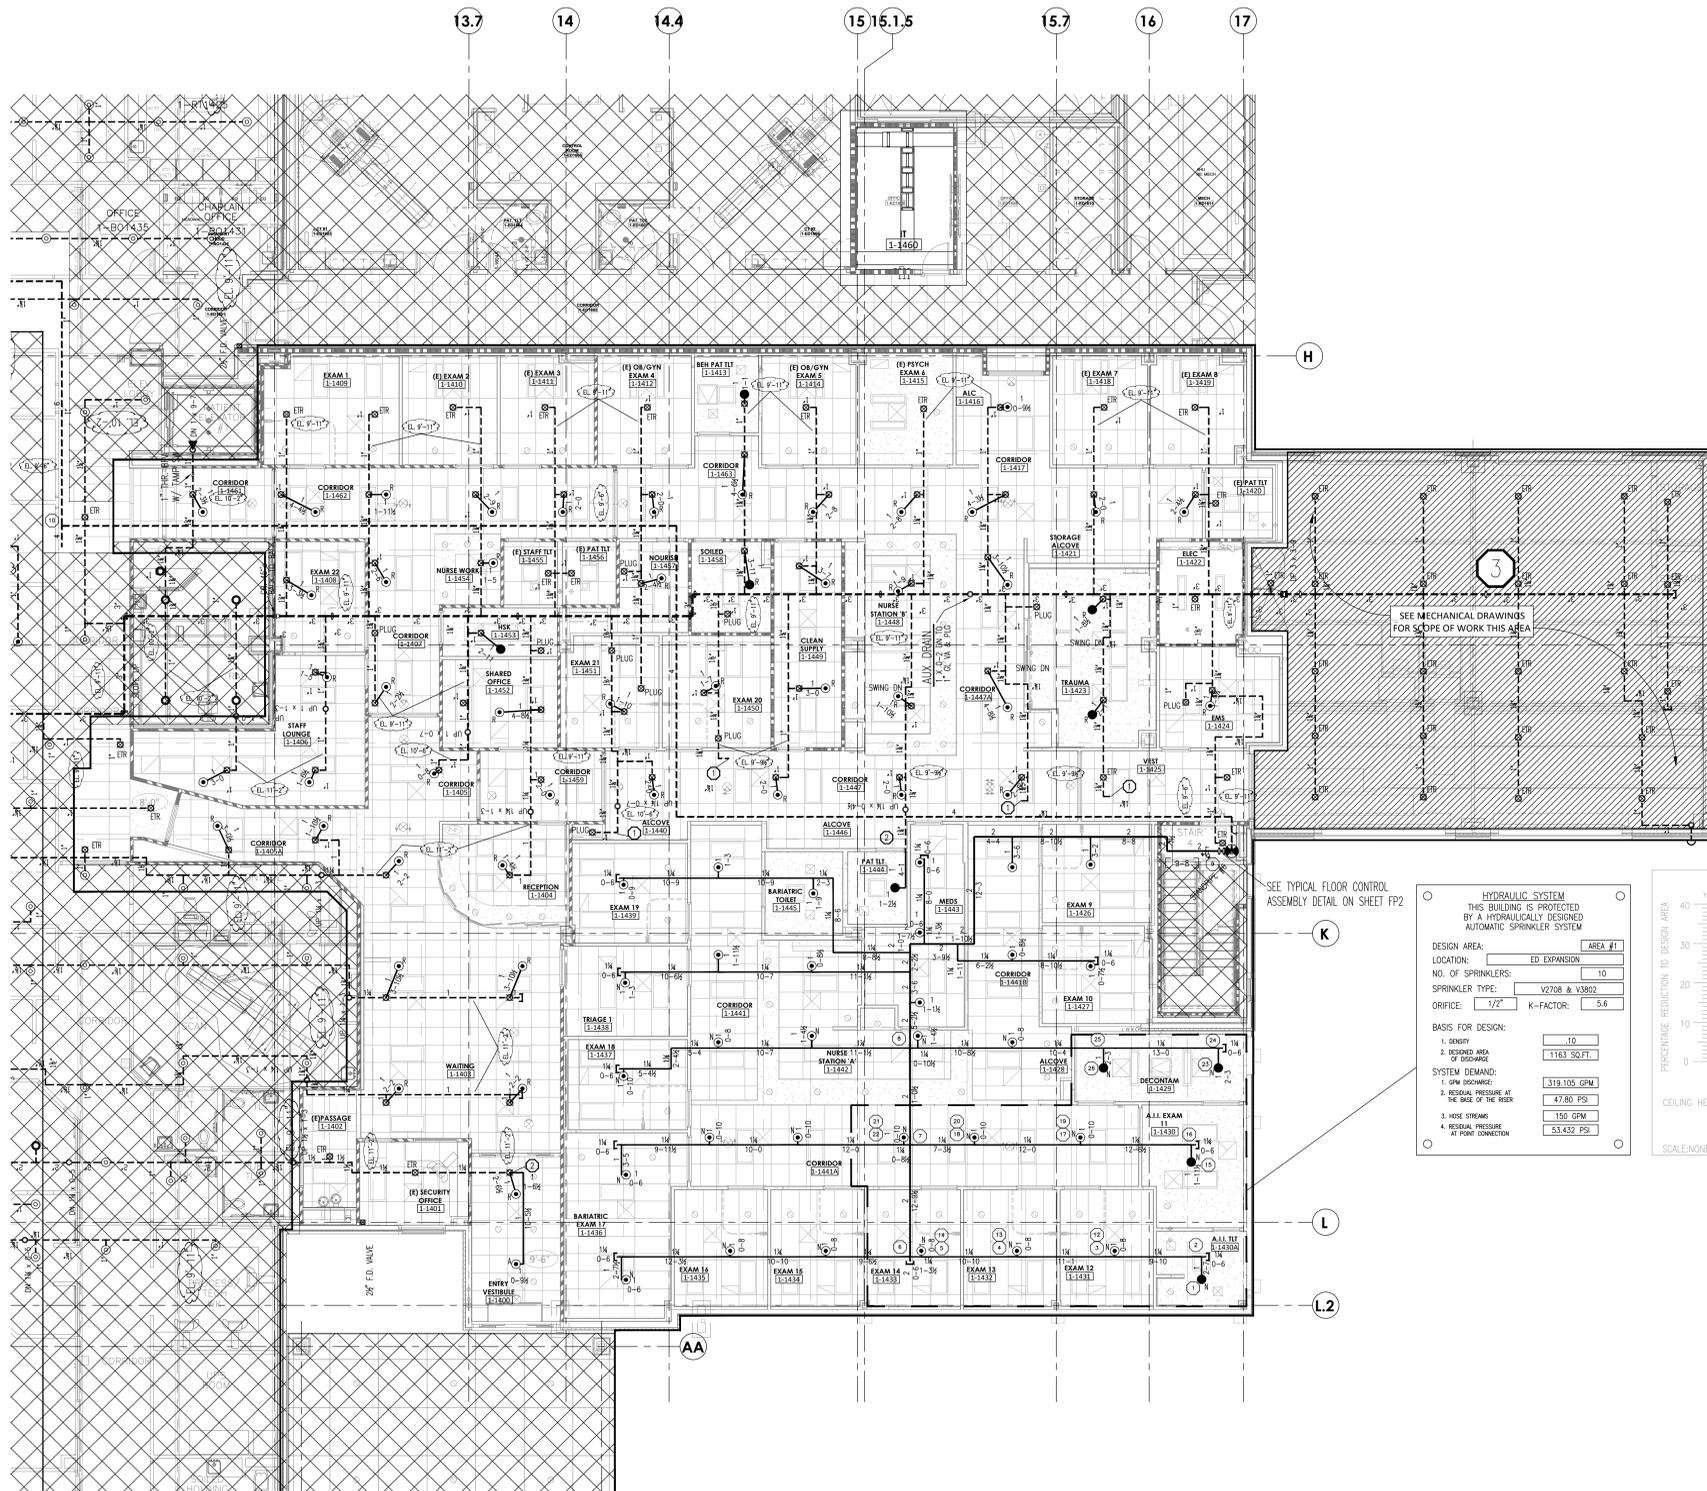


1ST FIRST FLOOR PARTIAL PLAN
 NORTH
 SCALE 1/8"=1'-0"

HANGER SPACING TABLE

NOMINAL PIPE SIZE	3/4"	1"	1 1/4"	1 1/2"	2"	2 1/2"	3"	3 1/2"	4"
STEEL PIPE EXCEPT THREADED LIGHTWALL	N/A	12-0	12-0	15-0	15-0	15-0	15-0	15-0	15-0

SPRINKLERS ARE PERMITTED TO BE RELOCATED AND RE-INSTALLED WHEN THE SPRINKLER BEING REMOVED FROM THE SYSTEM REMAINS ATTACHED TO THE ORIGINAL FITTING OR WELDED OUTLET. PROVIDED CARE HAS BEEN TAKEN TO ENSURE THE SPRINKLER HAS NOT BEEN DAMAGED. PER NFPA 13, WHEN A SPRINKLER HAS BEEN REMOVED FROM A FITTING OR WELDED OUTLET, IT SHALL NOT BE RE-INSTALLED. PROVIDE NEW SPRINKLERS AS REQUIRED.

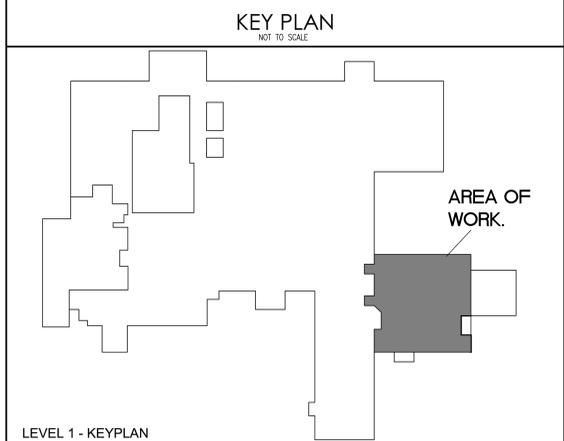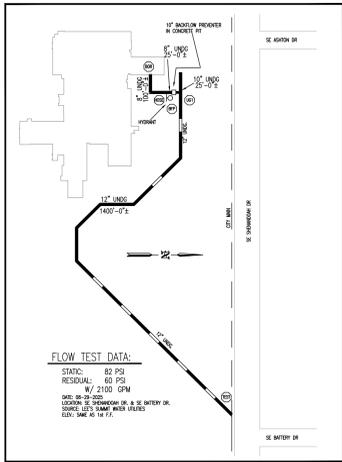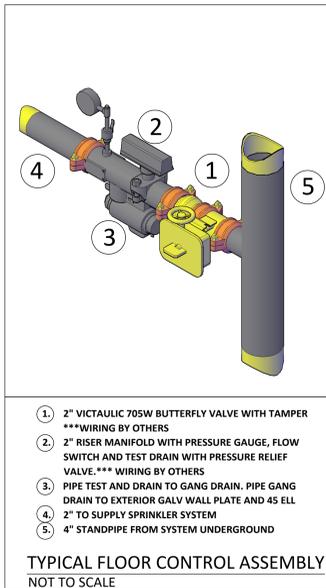


HYDRAULIC SYSTEM
 THIS BUILDING IS PROTECTED BY A HYDRAULICALLY DESIGNED AUTOMATIC SPRINKLER SYSTEM

DESIGN AREA:	AREA #1
LOCATION:	ED EXPANSION
NO. OF SPRINKLERS:	10
SPRINKLER TYPE:	V2708 & V3802
ORIFICE:	1/2" K-FACTOR: 5.8

BASIS FOR DESIGN:

1. DENSITY:	.10
2. DESIGN AREA OF DISCHARGE:	1163 SQ.FT.
SYSTEM DEMAND:	
1. LOW DISCHARGE:	319.105 GPM
2. RESIDUAL PRESSURE AT THE BASE OF THE RISER:	47.80 PSI
3. HOSE STREAM:	150 GPM
4. RESIDUAL PRESSURE AT POINT CONNECTION:	53.432 PSI

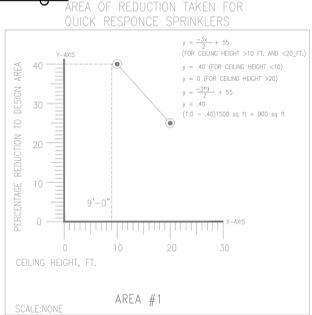

SCOPE OF WORK:

- PROJECT IS TO BE PHASED WITH 3 TOTAL PHASES
- J.F.S. WILL CUT AND CAP THE OLD VESTIBULE FOR DEMO. (DEMO AND REMOVAL BY OTHERS)
- J.F.S. WILL PROVIDE TEMPORARY FIRE SPRINKLER PROTECTION WITHIN EACH PHASE BY TURNING THE EXISTING FIRE SPRINKLER HEADS TO UPRIGHTS DURING CONSTRUCTION.
- J.F.S. WILL MODIFY SPRINKLER HEADS IN NEW TENANT IMPROVEMENT AREA FOR EACH PHASE PER DRAWING A-E11 (WHERE NEW WALLS AND CEILING ARE BEING INSTALLED ONLY).
- WITHIN PHASE 1, J.F.S. WILL TIE INTO EXISTING 4" SPRINKLER MAIN AND EXTEND SYSTEM INTO NEW ADDITION AND INSTALL A NEW SPRINKLER SYSTEM.

INSTALLATION NOTES:

- REMOVE BRANCHLINE TO THIS FITTING AND PLUG THE FITTING. THIS WILL ALLOW FOR A MORE IDENTIFIABLE AREA OF SYSTEM SEPARATION FOR SERVICING OF THE SYSTEM.
- REMOVE BRANCHLINE TO THIS FITTING AND USE THE REMAINING FITTING TO CONNECT NEW PIPE FOR RELOCATION OF SPRINKLER. THIS WILL ALLOW FOR A MORE IDENTIFIABLE AREA OF SYSTEM SEPARATION.
- SPRINKLERS TO BE ADDED FOR ALL NEW DUCTWORK OVER 48" THAT REQUIRE SPRINKLER PROTECTION BENEATH THEM.

PLAN NOTES:

- ALL CEILING HEIGHTS TO BE 9'-0" UNLESS NOTED OTHERWISE. ALL ALL SUPPORTS TO BE 8'-0" UNLESS NOTED OTHERWISE.
- SPRINKLERS WILL BE CENTERED IN CEILING TILES WHERE POSSIBLE YET NEVER ANY CLOSER THAN 6 INCHES FROM THE EDGE OF CEILING GRID.
- ALL GROOVED PIPING IS TO BE SCH. 40 PIPE, ASTM A-795 WITH ROLLED GROOVED ENDS. FITTINGS ARE TO BE IRON GROOVED OR WELDED STEEL OUTLETS.
- ALL THREADED PIPING IS TO BE SCHEDULE 40" PIPE, WITH THREADED DUCTILE IRON FITTINGS.

NOTE:

THE DRAWING INDICATES A "SCHEMATIC LAYOUT" OF THE SPRINKLER HEADS AND SHOWS THE INTENT OF THE DESIGN. EXACT LOCATIONS SHALL BE COORDINATED WITH OTHER TRADES. FIELD VERIFIED, AND INSTALLED TO MEET NFPA 13 COVERAGE REQUIREMENTS FOR THE SPACE.

SPRINKLER RELOCATION LEGEND

SYMBOL	DESCRIPTION
(Symbol)	RELOCATED SPRINKLER FROM EXISTING OUTLET
(Symbol)	CHANGED EXISTING SPRINKLER FROM S.R. TO Q.R.
(Symbol)	ADDED SPRINKLER FROM EXISTING SPRINKLER SYSTEM
(Symbol)	NEW SPRINKLER BEING INSTALLED FROM NEW SYSTEM


LEGEND

SYMBOL	DESCRIPTION
(Symbol) <td>POINT OF CONNECTION</td>	POINT OF CONNECTION
(Symbol) <td>NEW SPRINKLER LINE</td>	NEW SPRINKLER LINE
(Symbol) <td>EXISTING SPRINKLER LINE</td>	EXISTING SPRINKLER LINE
(Symbol) <td>RISER LOCATION</td>	RISER LOCATION
(Symbol) <td>PIPE END CAP</td>	PIPE END CAP

SPRINKLER LEGEND

SYMBOL	SPRINKLER TYPE	SIN #	FINISH	TEMP.	ORIFICE	K-FACTOR	COUNT
(Symbol)	VICTALIC Q.R. SEMI-RECESSED PENDENT	V2708	CHROME	155°	1/2"	5.8 K	76
(Symbol)	VICTALIC Q.R. CONCEALED PENDENT	V3802	WHITE	155°	1/2"	5.8 K	10
(Symbol)	VICTALIC Q.R. UPRIGHT (TO BE USED FOR TEMP. PROTECTION)	V2708	CHROME	155°	1/2"	5.8 K	00

TOTAL THIS SHEET: 86
 TOTAL THIS JOB: 86

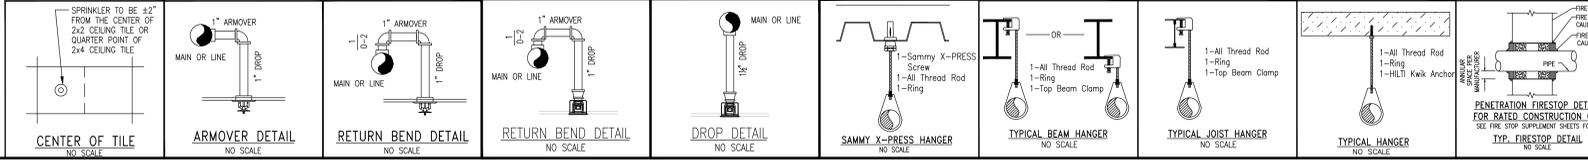

JAYHAWK
 FIRE SPRINKLER CO., INC.
 1200 W. 12TH ST., SUITE 100
 OMAHA, NEBRASKA 68101
 PHONE: (402) 733-7777
 FAX: (402) 733-7777
 CONSTRUCTION DIVISION
 JUDITH COOPER, PROJECT MANAGER
 KANSAS CITY, MISSOURI 64106

HCA LEES SUMMIT MEDICAL CENTER
EMERGENCY DEPARTMENT EXPANSION
 2100 SE BLUE PARKWAY
 LEES SUMMIT, MISSOURI 64063

WARREN KTD, LLC
 1000 W. 12TH ST., SUITE 100
 OMAHA, NEBRASKA 68101
 PHONE: (402) 733-7777
 FAX: (402) 733-7777
 WALTER A. WARREN
 NUMBER E-24557
 PROFESSIONAL ENGINEER
 WARREN KTD, LLC

ISSUE DATE: 10/29/2025
 PROJECT NUMBER: CA
 APPROVAL: APPROVAL
 DRAWING NUMBER: FP-2
FP-2
 FIRE PROTECTION
 PARTIAL FIRST FLOOR
 SPRINKLER LAYOUT
 2 OF 2