


C:\Users\mmurach\Documents\138-25-25 MFP R25\_murachKDEQU.rvt

12/4/2025 1:44:29 PM

- DRAWING INTERPRETATION NOTES:**
- EXISTING LINETYPE: THIN (LIGHT) SOLID LINES REPRESENT ITEMS THAT ARE EXISTING TO REMAIN OR ARE FURNISHED BY OTHERS.
  - DEMOLITION LINETYPE: THICK (DARK) DASHED LINES REPRESENT EXISTING ITEMS TO BE REMOVED.
  - RELEVANT EXISTING CONDITIONS SHOWN ARE BASED ON RECORD DRAWINGS AND FIELD OBSERVATION(S). NOT ALL EXISTING ITEMS ARE SHOWN, OR COULD BE FIELD VERIFIED. ONCE AREAS OBSCURED FROM VIEW ARE EXPOSED, VERIFY THAT CONDITIONS ARE AS INDICATED ON THIS DRAWING. BEFORE PROCEEDING WITH WORK, NOTIFY THE ENGINEER IF CONDITIONS DIFFER FROM WHAT IS SHOWN.
- PLUMBING PIPING DEMOLITION NOTES:**
- THE OWNER SHALL HAVE FIRST RIGHT OF REFUSAL UPON REMOVAL OF ALL SALVAGED ITEMS. OTHERWISE, REMOVE ALL DEMOLISHED ITEMS FROM THE SITE.
  - REMOVE ALL PIPING, AS INDICATED BY THE DEMOLITION LINETYPE. REMOVE ALL ASSOCIATED ANCILLARY ITEMS, SUCH AS PIPE HANGERS, SUPPORTS, INSULATION, VALVES, CONTROLS, ETC. - NOT UTILIZED FOR NEW WORK.
  - REMOVE PIPING BACK TO TIE-IN POINTS WHERE INDICATED.
  - REMOVE PIPING BACK TO CAPPED LOCATIONS WHERE INDICATED. INSULATE CAPPED PIPES SAME AS NEW. DEAD LEGS SHALL NOT BE PERMITTED.

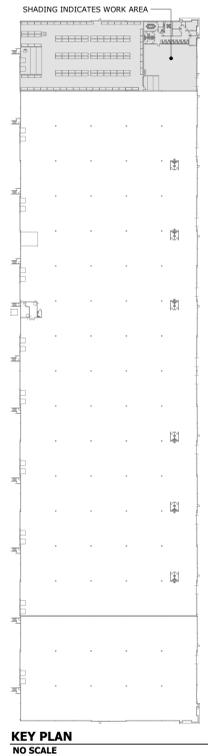

PROJECT:

TENANT IMPROVEMENTS FOR:  
**SONNY'S**  
2201 NE TOWN CENTRE BOULEVARD  
LEE'S SUMMIT, MISSOURI 64064


MARK:	ISSUE:	DATE:
	ISSUED	08/15/2025
	REVISION 2	12/04/2025

PROJECT #:	016-0402
DRAWN BY:	PTA, INC.
CHECKED BY:	JSC

The Foundation Architecture, LLC and their Consultants shall be deemed the authors and owners of their respective instruments of service and shall retain all copyright, title, and other intellectual property rights. The instruments of service shall not be used for future projects or otherwise in the future for any purpose, without the prior written agreement of The Foundation Architecture, LLC. Any unauthorized use of the instruments of service shall be the Owner's sole risk and without liability to The Foundation Architecture, LLC and their Consultants.

DRAWING TITLE:  
**FIRST FLOOR PLUMBING DEMOLITION PLAN**

SHEET #:  
**P1.01**

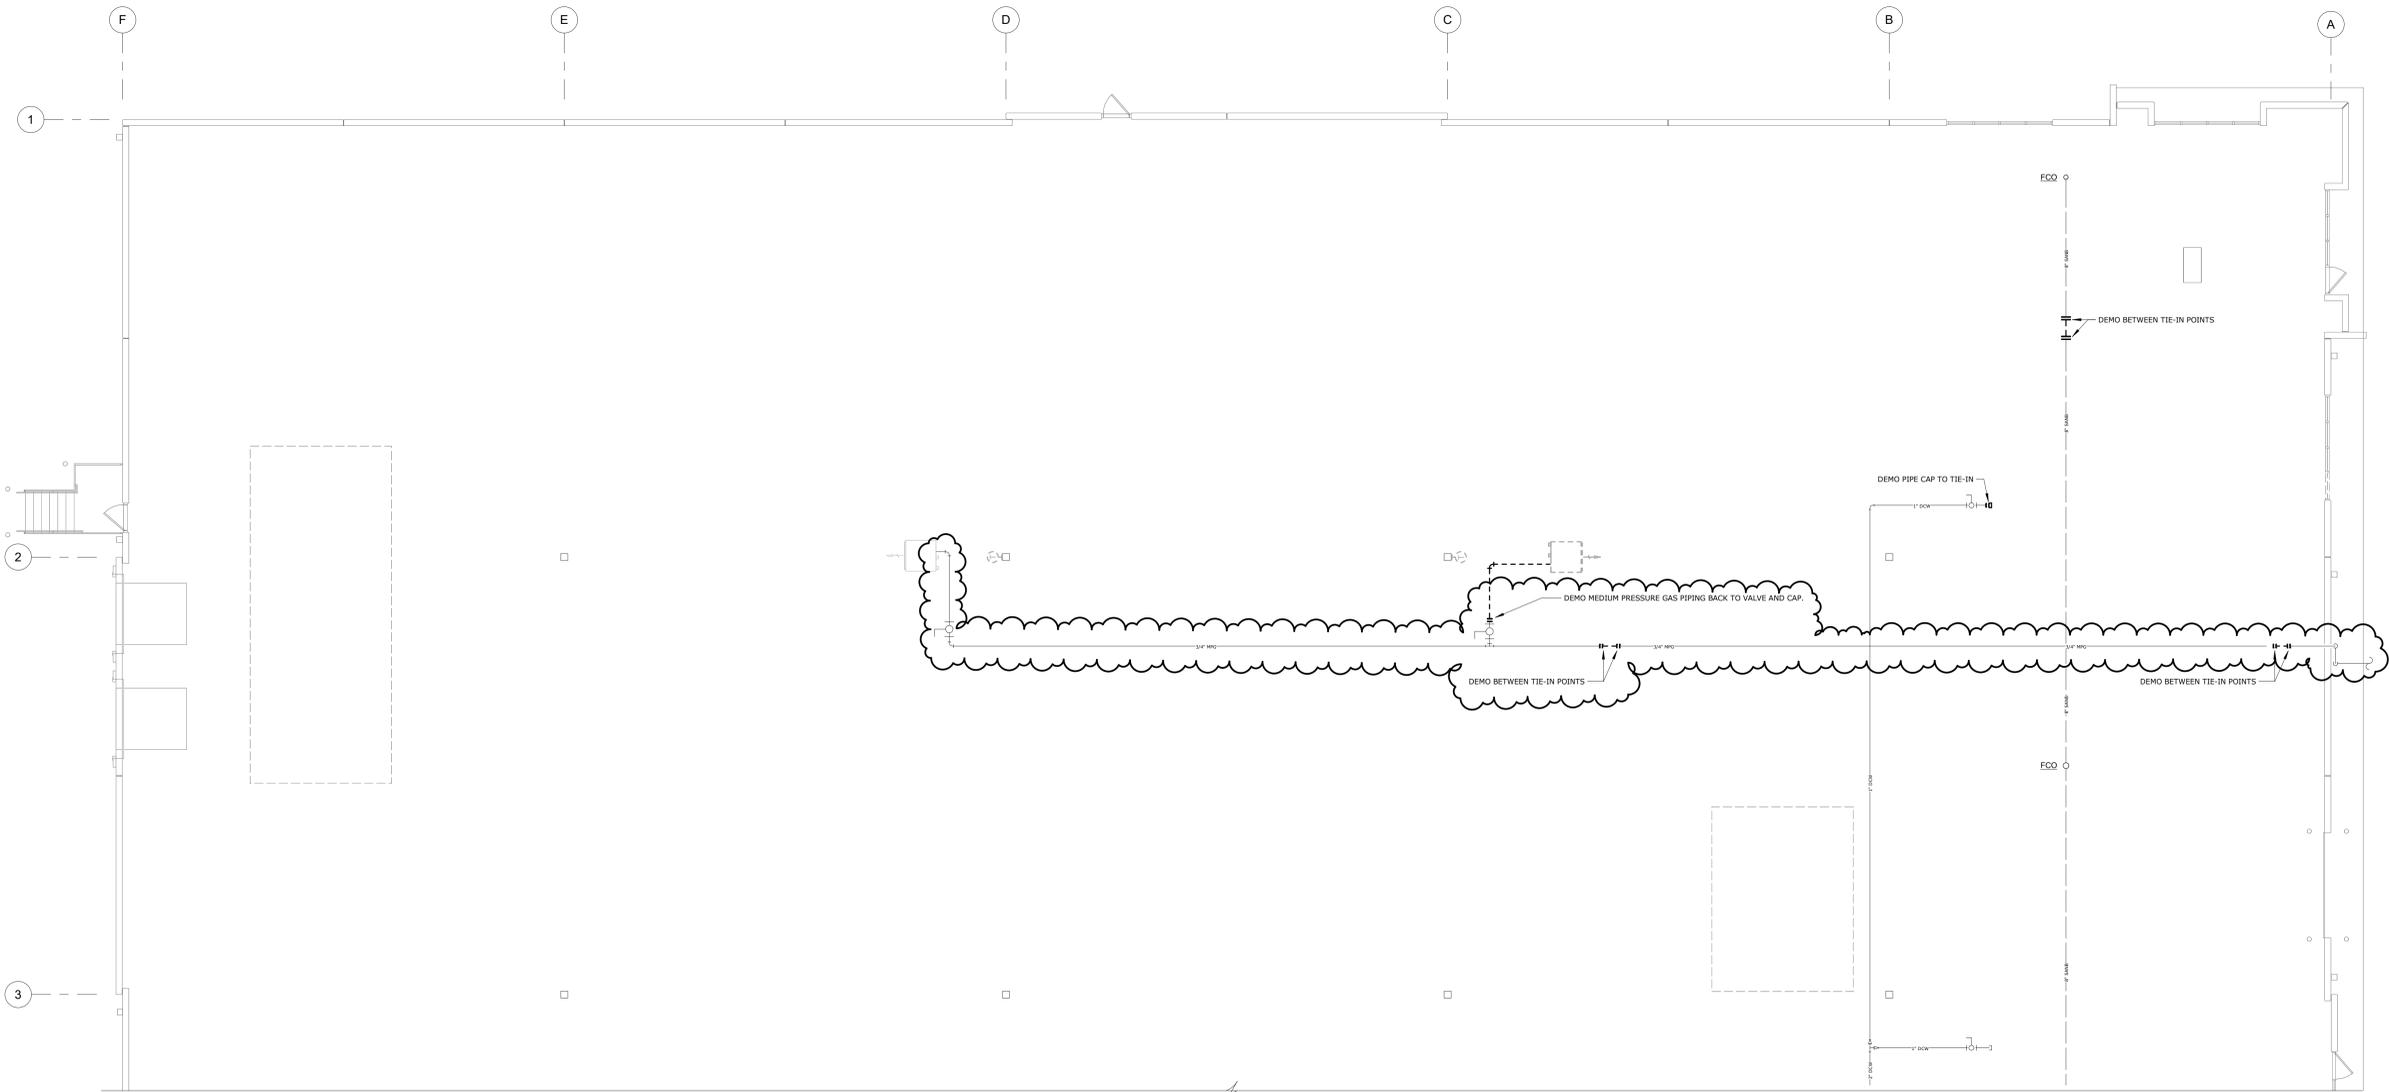

**FIRST FLOOR - PLUMBING DEMOLITION PLAN**  
SCALE: 1/8" = 1'-0"