

PREPARED BY:



SCHLAGEL & ASSOCIATES, P.A.

**PERGOLA PARK 6TH PLAT**  
**STREET, STORMWATER, MASTER DRAINAGE**  
**PLAN**  
 --- LEE'S SUMMIT, MISSOURI



EARTHWORK SUMMARY	
CUT	6,074
FILL	0
NET	6,074 CY CUT

**EARTHWORK NOTE:**  
 EARTHWORK CALCULATIONS DESIGNED TO FINISH GRADE WITH A COMPACTION FACTOR OF 1.15


- NOTE:**
- (thick solid line) DENOTES PROPOSED MAJOR CONTOUR
  - (thin solid line) DENOTES PROPOSED MINOR CONTOUR
  - - - (dashed line) DENOTES EXISTING MAJOR CONTOUR
  - - - (thin dashed line) DENOTES EXISTING MINOR CONTOUR
  - (dotted line) DENOTES AS-BUILT MAJOR CONTOUR
  - - - (dotted line) DENOTES AS-BUILT MINOR CONTOUR

**RECORD DRAWING**


The information provided on this drawing conforms to construction records; it is not intended for construction, implementation or recording purposes; and it is solely based on information obtained by Schlagel and Associates.

"100.00 100.10", "1.00% 1.15% slope", or "8-inch HDPE PVC pipe" are all typical examples of revisions that indicate that design data has been replaced with "as-built" information. All other data is as designed and has not been field verified.

Date: 1/15/26  
 Certified by: BAL  
 Title: Design Engineer  
 Firm: Schlagel and Associates, P.A.

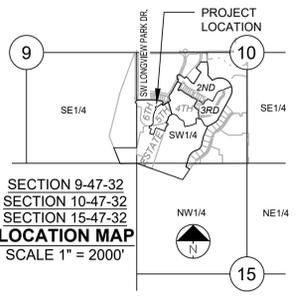

SECTION 9-47-32  
 SECTION 10-47-32  
 SECTION 15-47-32  
**LOCATION MAP**  
 SCALE 1" = 2000'

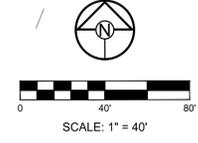

SCALE: 1" = 40'

**NOTES:**  
 ALL CONSTRUCTION ON THIS PROJECT SHALL CONFORM TO THE CITY OF LEE'S SUMMIT TECHNICAL SPECIFICATIONS.  
 THE CONTRACTOR IS RESPONSIBLE FOR VERIFYING ALL EXISTING UTILITY LOCATIONS PRIOR TO EXCAVATION.

**MISSOURI GEOGRAPHIC REFERENCE SYSTEM BENCHMARK:**

BM JA-148, IS A STAMPED KC METRO DISK SET IN CONCRETE LOCATED 2 MILES WEST OF THE INTERSECTION OF HIGHWAY 50 AND 3RD ST. IT IS 44 FT NORTH OF THE CENTER OF 3RD ST. AND 102.5 FT WEST OF THE CENTER OF THE EXIT FROM THE ADJACENT PARKING LOT.  
 ELEV. 935.18

**PROJECT BENCHMARK:**

CHISELED "SQUARE" ON STORM CURB INLET AT NORTHWEST INTERSECTION OF SW. TOWER PARK DRIVE AND SW. LONGVIEW BOULEVARD.

NORTHING: 998893.4148  
 EASTING: 2803318.5413  
 ELEV. 1004.09

**SURVEY NOTES**

The bases of bearing and coordinates are base on the Missouri Coordinate System of 1983, West Zone (2003 Adjustment) with a Grid Factor of 0.9999020.

REVISION DATE	DESCRIPTION
11-8-24	CITY COMMENTS
12-4-24	CITY COMMENTS
1-15-26	AS-BUILTS

DRAWN BY:	CHECKED BY:	DATE PREPARED:	PROJ. NUMBER:
BAL	MAB	8-19-24	24-041

**MASTER DRAINAGE PLAN - GRADING PLAN**  
 SHEET  
**3**

SW CORNER, SW 1/4  
 SEC. 10-47-32  
 CORP OF ENGINEERS 3"  
 ALUMINUM MONUMENT

PREPARED BY:



SCHLAGEL & ASSOCIATES, P.A.

**PERGOLA PARK 6TH PLAT  
 STREET, STORMWATER, MASTER DRAINAGE  
 PLAN**  
 --- LEE'S SUMMIT, MISSOURI



**LOT TYPE TABLE**

LOT #	BASEMENT TYPE
134	STANDARD
135	STANDARD
136	STANDARD
137	STANDARD
138	STANDARD
139	STANDARD
140	STANDARD
141	STANDARD
142	STANDARD
143	STANDARD
144	STANDARD
145	STANDARD

**DRAINAGE NOTE:**

INDIVIDUAL LOT OWNER(S) SHALL NOT CHANGE OR OBSTRUCT THE DRAINAGE FLOW LINES ON THE LOTS INCLUDED IN THE MASTER DRAINAGE PLAN, UNLESS SPECIFIC APPLICATION IS MADE AND APPROVED BY THE CITY ENGINEER.

**NOTE:**

THE CONTRACTOR IS RESPONSIBLE FOR VERIFYING ALL EXISTING UTILITY LOCATIONS PRIOR TO EXCAVATIONS.


- \_\_\_\_\_ DENOTES PROPOSED MAJOR CONTOUR
- \_\_\_\_\_ DENOTES PROPOSED MINOR CONTOUR
- \_\_\_\_\_ DENOTES EXISTING MAJOR CONTOUR
- \_\_\_\_\_ DENOTES EXISTING MINOR CONTOUR
- \_\_\_\_\_ DENOTES AS-BUILT MAJOR CONTOUR
- \_\_\_\_\_ DENOTES AS-BUILT MINOR CONTOUR

**RECORD DRAWING**

The information provided on this drawing conforms to construction records; it is not intended for construction, implementation or recording purposes; and it is solely based on information obtained by Schlagel and Associates.

"100.00 100.10", "1.00% 1.15% slope", or "8-inch HDPE PVC pipe" are all typical examples of revisions that design data has been replaced with "as-built" information. All other data is as designed and has not been field verified.

Date: 1/15/26  
 Certified by: BAL  
 Title: Design Engineer  
 Firm: Schlagel and Associates, P.A.

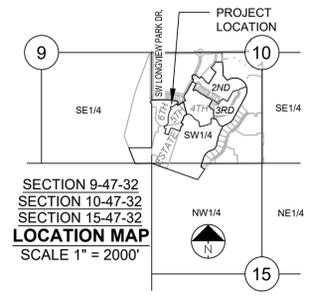

**MISSOURI GEOGRAPHIC REFERENCE SYSTEM BENCHMARK:**

BM JA-148, IS A STAMPED KC METRO DISK SET IN CONCRETE LOCATED 2 MILES WEST OF THE INTERSECTION OF HIGHWAY 50 AND 3RD ST. IT IS 44 FT NORTH OF THE CENTER OF 3RD ST. AND 102.5 FT WEST OF THE CENTER OF THE EXIT FROM THE ADJACENT PARKING LOT.  
 ELEV. 935.18

**PROJECT BENCHMARK:**

CHISELED "SQUARE" ON STORM CURB INLET AT NORTHWEST INTERSECTION OF SW. TOWER PARK DRIVE AND SW. LONGVIEW BOULEVARD.

NORTHING: 998893.4148  
 EASTING: 2803318.5413  
 ELEV. 1004.09


**SURVEY NOTES**

The bases of bearing and coordinates are base on the Missouri Coordinate System of 1983, West Zone (2003 Adjustment) with a Grid Factor of 0.9999020.

**NOTES:**

- ALL CONSTRUCTION ON THIS PROJECT SHALL CONFORM TO THE CITY OF LEE'S SUMMIT TECHNICAL SPECIFICATIONS.
- THE CONTRACTOR IS RESPONSIBLE FOR VERIFYING ALL EXISTING UTILITY LOCATIONS PRIOR TO EXCAVATION.

SW CORNER, SW 1/4  
 SEC. 10-47-32  
 CORP OF ENGINEERS 3"  
 ALUMINUM MONUMENT

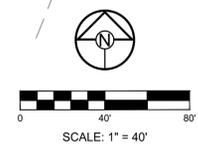

REVISION DATE	DESCRIPTION
11-8-24	CITY COMMENTS
12-4-24	CITY COMMENTS
1-15-26	AS-BUILTS


  

DRAWN BY:	CHECKED BY:	DATE PREPARED:	PROJ. NUMBER:
BAL	MAB	8-19-24	24-041

**MASTER DRAINAGE PLAN - LOT INFO**

SHEET

4


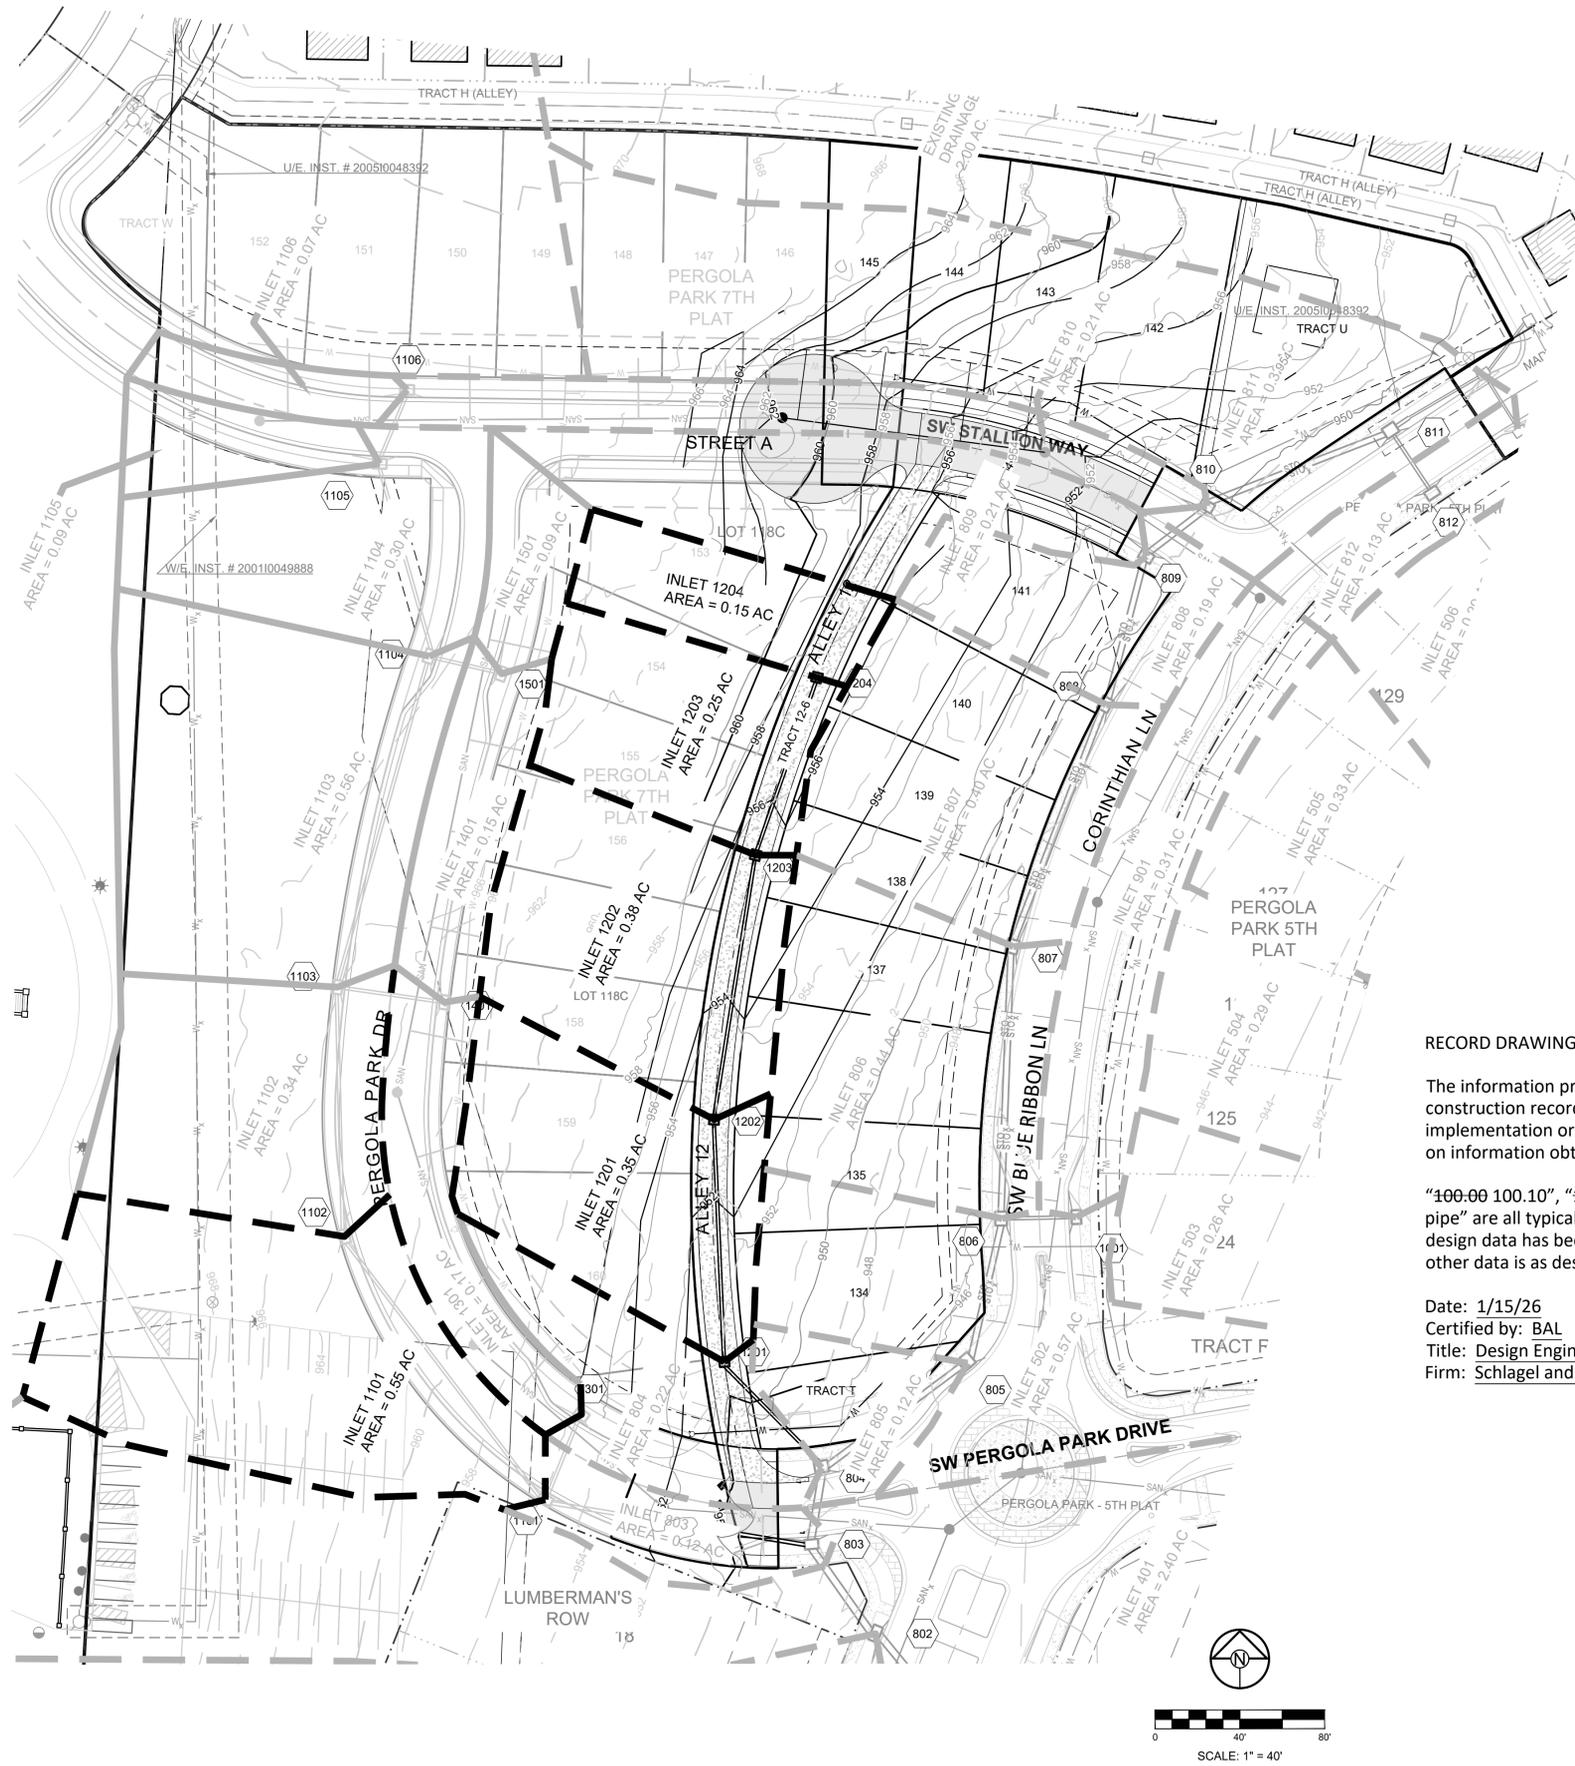


**RECORD DRAWING**

The information provided on this drawing conforms to construction records; it is not intended for construction, implementation or recording purposes; and it is solely based on information obtained by Schlager and Associates.

"100-00 100.10", "1.00% 1.15% slope", or "8-inch HDPE PVC pipe" are all typical examples of revisions that indicate that design data has been replaced with "as-built" information. All other data is as designed and has not been field verified.

Date: 1/15/26  
 Certified by: BAL  
 Title: Design Engineer  
 Firm: Schlager and Associates, P.A.

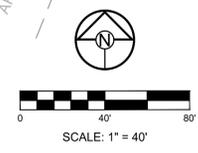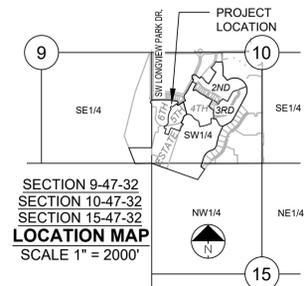

**NOTES:**

- ALL CONSTRUCTION ON THIS PROJECT SHALL CONFORM TO THE CITY OF LEE'S SUMMIT TECHNICAL SPECIFICATIONS.
- THE CONTRACTOR IS RESPONSIBLE FOR VERIFYING ALL EXISTING UTILITY LOCATIONS PRIOR TO EXCAVATION.

**MISSOURI GEOGRAPHIC REFERENCE SYSTEM BENCH MARK:**

BM JA-148, IS A STAMPED KC METRO DISK SET IN CONCRETE LOCATED 2 MILES WEST OF THE INTERSECTION OF HIGHWAY 50 AND 3RD ST. IT IS 44 FT NORTH OF THE CENTER OF 3RD ST. AND 102.5 FT WEST OF THE CENTER OF THE EXIT FROM THE ADJACENT PARKING LOT.  
 ELEV. 935.18


**PROJECT BENCHMARK:**

CHISELED "SQUARE" ON STORM CURB INLET AT NORTHWEST INTERSECTION OF SW. TOWER PARK DRIVE AND SW. LONGVIEW BOULEVARD.  
 NORTHING: 998893.4148  
 EASTING: 2803318.5413  
 ELEV. 1004.09

**SURVEY NOTES**

The bases of bearing and coordinates are base on the Missouri Coordinate System of 1983, West Zone (2003 Adjustment) with a Grid Factor of 0.9999020.

PREPARED BY:

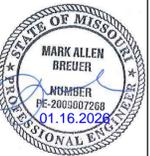

SCHLAGEL & ASSOCIATES, P.A.

**PERGOLA PARK 6TH PLAT  
 STREET, STORMWATER, MASTER DRAINAGE  
 PLAN**

--- LEE'S SUMMIT, MISSOURI

REVISION DATE	DESCRIPTION
11-8-24	CITY COMMENTS
12-4-24	CITY COMMENTS
1-15-26	AS-BUILTS

**MASTER DRAINAGE PLAN - DRAINAGE MAP**

SHEET

I:\PROJECTS\2024\24-04-04\13.0 Design\3.0 DWG Plans\6.0 SS\24-04-04-04-13.0 Design\3.0 DWG Plans\6.0 SS\DRAINAGE.dwg, DRAINAGE MAP, 1:1

**PERGOLA PARK 6TH PLAT**  
**STREET, STORMWATER, MASTER DRAINAGE**  
**PLAN**  
 --- LEE'S SUMMIT, MISSOURI

REVISION DATE	DESCRIPTION
11-8-24	CITY COMMENTS
12-4-24	CITY COMMENTS
1-15-26	AS-BUILTS
6-19-24	DATE PREPARED
24-04-1	PROJ. NUMBER

DRAWN BY: BAL  
 CHECKED BY: MAB  
 DATE PREPARED: 6-19-24  
 PROJ. NUMBER: 24-04-1

MASTER DRAINAGE PLAN - DRAINAGE CALCULATIONS

SHEET **6**

**Schlagel & Associates, P.A.**  
 Project Name: PERGOLA PARK 5TH PLAT  
 Project #: 19-002  
 Time: 11/27/2024 14:28  
 City: LEE'S SUMMIT  
 Curb Type: B  
 Design Storm: 10  
 "K" Value: 1.00  
 "F" Factor: 1.00

Runoff Calculations										Pipe Properties																		
Inlet #	Area (acres)	"C" Value	Cumul. Area (acres)	Cumul. CxA	Tc	Intensity	Runoff To Inlet	Cumul. Runoff	Pipe Cap.	Pipe Vel.	Up Piped Inlet 1	Up Piped Inlet 2	Up Area (acres)	Up CxA	Up Inlet	Down Inlet	Pipe Type	"n"	Pipe Size	Length	Slope %	Drop In Inlet	FL Up	FL Down	Inlet Top	HGL Elev.		
EXISTING LINE 400																												
401	2.40	0.66	46.76	30.86	5.7	7.13	11.29	220.00	220.20	9.27	501		3.38	2.23	401	400	RCP	0.013	66	53.87	0.43	0.50	927.98	927.75	936.98	933.27	DS TAILWATER @ STR #400	931.52
402	0.04	0.66	40.98	27.05	5.4	7.24	0.19	195.88	286.92	12.08			0.00	0.00	402	401	RCP	0.013	66	279.37	0.73	0.50	930.42	928.38	941.97	935.25		940.44
403	0.07	0.66	40.94	27.02	5.3	7.27	0.34	196.43	300.36	12.64	601		0.90	0.59	403	402	RCP	0.013	66	68.66	0.80	0.50	931.17	930.62	944.37	936.00		942.80
404	0.06	0.66	39.97	26.38	5.1	7.32	0.29	193.18	270.74	11.40	701		1.41	0.93	404	403	RCP	0.013	66	119.40	0.65	1.00	932.35	931.57	948.40	937.14		945.61
405	38.50	0.66	38.50	25.41	5.0	7.35	186.84	186.84	251.06	15.79			0.00	0.00	405	404	RCP	0.013	54	92.89	1.63	N/A	934.86	933.35	947.96	940.04		#VALUE!
EXISTING LINE 600																												
601	0.36	0.66	0.90	0.59	5.1	7.33	1.74	4.35	19.45	11.00			0.00	0.00	601	403	HDPE	0.012	18	36.00	2.92	0.50	936.02	934.97	944.39	937.04		943.11
602	0.54	0.66	0.54	0.36	5.0	7.35	2.62	2.62	13.70	11.16			0.00	0.00	602	601	HDPE	0.012	15	55.86	3.83	N/A	938.53	936.39	946.23	939.31		943.46
EXISTING LINE 700																												
701	1.14	0.66	1.41	0.93	5.1	7.32	5.51	6.82	9.26	7.54			0.00	0.00	701	404	PEP	0.012	15	102.48	1.75	0.50	941.69	939.90	949.19	943.04		943.33
702	0.27	0.66	0.27	0.18	5.0	7.35	1.31	1.31	7.10	5.79			0.00	0.00	702	701	PEP	0.012	15	33.00	1.03	N/A	942.48	942.14	949.13	943.04		949.26
EXISTING LINE 500																												
501	1.06	0.66	3.38	2.23	6.2	7.01	4.90	15.64	28.10	5.73			0.00	0.00	501	401	PEP	0.012	30	35.50	0.40	0.45	931.12	930.98	936.98	933.39		936.26
502	0.57	0.66	2.32	1.53	6.0	7.05	2.65	10.79	24.51	7.80			0.00	0.00	502	501	PEP	0.012	24	65.53	1.00	0.50	932.23	931.57	937.83	933.63		936.94
503	0.26	0.66	1.75	1.16	5.9	7.08	1.22	8.18	24.51	7.80			0.00	0.00	503	502	PEP	0.012	24	51.05	1.00	0.50	933.24	932.73	939.40	934.46		937.28
504	0.29	0.66	1.49	0.98	5.7	7.13	1.37	7.02	12.47	7.05			0.00	0.00	504	503	PEP	0.012	18	78.60	1.20	0.50	934.68	933.74	940.30	935.94		938.68
505	0.33	0.66	1.20	0.79	5.5	7.20	1.57	5.70	11.38	6.44			0.00	0.00	505	504	PEP	0.012	18	88.86	1.00	0.50	936.07	935.18	941.62	935.52		939.52
506	0.29	0.66	0.87	0.57	5.3	7.28	1.39	4.18	7.34	5.98			0.00	0.00	506	505	PEP	0.012	15	87.96	1.10	0.50	937.54	936.57	942.92	935.55		940.76
507	0.58	0.66	0.58	0.38	5.0	7.35	2.81	2.81	7.00	5.70			0.00	0.00	507	506	PEP	0.012	15	86.70	1.00	N/A	938.90	938.04	943.98	939.71		941.32
EXISTING LINE 800																												
801	0.51	0.66	9.07	5.50	6.6	6.89	1.02	37.90	66.70	9.44	1801		1.57	0.80	801	800	RCP	0.013	36	243.24	1.00	2.50	930.93	928.50	944.84	934.84		934.84
802	1.38	0.51	7.21	4.55	6.5	6.93	4.88	31.54	68.55	9.70			0.00	0.00	802	801	PEP	0.012	36	83.38	0.90	0.50	934.18	933.43	944.41	936.39		937.24
803	0.12	0.66	5.83	3.85	6.3	6.96	0.55	26.79	51.09	7.23	1101		2.32	1.53	803	802	PEP	0.012	36	51.75	0.50	0.50	934.94	934.68	948.20	936.95		937.84
804	0.22	0.66	3.39	2.24	6.2	6.99	1.01	15.64	31.42	6.40	1201		1.43	0.94	804	803	PEP	0.012	30	36.23	0.50	0.50	935.62	935.44	948.20	938.21		938.21
805	0.12	0.66	1.74	1.15	6.0	7.05	0.56	8.10	31.42	6.40			0.00	0.00	805	804	PEP	0.012	30	84.51	0.50	0.50	936.55	936.12	946.57	938.35		938.35
806	0.40	0.66	1.62	1.07	5.8	7.10	1.88	7.59	31.42	6.40	1001		0.31	0.20	806	805	PEP	0.012	30	69.15	0.50	0.50	937.39	937.05	945.85	938.86		938.86
807	0.40	0.66	0.91	0.60	5.5	7.20	1.90	4.32	31.42	6.40			0.00	0.00	807	806	PEP	0.012	30	127.94	0.50	0.50	938.53	937.89	947.25	939.62		939.62
808	0.19	0.66	0.51	0.34	5.2	7.30	0.91	2.46	31.42	6.40			0.00	0.00	808	807	PEP	0.012	30	121.88	0.50	0.50	939.64	939.03	948.73	940.45		940.45
809	0.32	0.66	0.32	0.21	5.0	7.35	1.55	1.55	31.42	6.40			0.00	0.00	809	808	PEP	0.012	30	72.14	0.50	0.50	940.50	940.14	950.54	941.13		941.13
810	0.21	0.66	0.21	0.14	5.0	7.35	1.02	1.02	31.42	6.40			0.00	0.00	810	809	PEP	0.012	30	37.09	0.50	0.50	941.19	941.00	950.13	941.70		941.70
811	2.32	0.66	2.63	1.74	5.1	7.31	11.19	12.69	31.42	6.40			0.00	0.00	811	810	PEP	0.012	30	93.67	0.50	1.25	942.15	941.69	948.43	944.11		944.11
812	0.13	0.66	0.13	0.09	5.0	7.35	0.63	0.63	4.95	4.03			0.00	0.00	812	811	PEP	0.012	15	35.50	0.50	N/A	943.88	943.40	948.43	944.15		944.15
EXISTING LINE 1000																												
1001	0.31	0.66	0.31	0.20	5.0	7.35	1.50	1.50	4.95	4.03			0.00	0.00	1001	806	PEP	0.012	15	35.00	0.50	N/A	938.82	938.64	945.85	939.60		939.60
EXISTING LINE 1100																												
1101	0.55	0.66	2.32	1.53	6.2	7.01	2.54	10.73	30.11	17.04	1301		0.17	0.11	1101	803	PEP	0.012	18	127.32	7.00	3.00	945.35	936.44	954.50	947.74		947.74
1102	0.34	0.66	1.60	1.06	6.0	7.06	1.58	7.45	25.45	14.40			0.00	0.00	1102	1101	PEP	0.012	18	155.72	5.00	0.50	956.14	948.35	961.72	957.97		957.97
1103	0.56	0.66	1.26	0.83	5.8	7.12	2.63	5.92	10.50	8.55	1401		0.15	0.10	1103	1102	PEP	0.012	15	117.18	2.25	0.50	959.28	956.64	964.38	961.05		961.05
1104	0.30	0.66	0.55	0.36	5.3	7.26	1.44	2.64	7.01	6.70	1501		0.09	0.06	1104	1103	PEP	0.012	15	161.35	1.00	0.50	961.39	959.78	966.89	962.17		962.17
1105	0.09	0.66	0.16	0.11	5.1	7.32	0.43	0.77	9.90	8.06			0.00	0.00	1105	1104	PEP	0.012	15	93.36	2.00	0.50	963.76	961.89	969.80	964.30		964.30
1106	0.07	0.66	0.07	0.05	5.0	7.35	0.34	0.34	7.00	5.70			0.00	0.00	1106	1105	PEP	0.012	15	37.07	1.00	N/A	964.63	964.26	969.53	964.90		964.90
EXISTING LINE 1200																												
1201	0.65	0.66	1.43	0.94	5.6	7.19	3.08	6.78	30.11	17.04			0.00	0.00	1201	804	PEP	0.012	18	67.70	7.00	0.50	941.36	936.62	950.33	942.59		942.59
1202	0.38	0.66	0.78	0.51	5.4	7.23	1.81	3.72	21.29	12.05			0.00	0.00	1202	1201	PEP	0.012	18	113.91	3.50	0.50	945.85	941.86	952.68	946.73		946.73
1203	0.25	0.66	0.40	0.26	5.2	7.30	1.20	1.93	11.06	9.02			0.00	0.00	1203	1202	PEP	0.012	15	125.72	2.50	0.50	949.49	946.35				

GUTTER SPREAD AND INLET CAPACITY CALCULATIONS - LUMBERMAN'S ROW

DESIGN STORM 10 CURB TYPE "A" = LAZY BACK  
 "K" FACTOR 1.00 CURB TYPE "B" = HIGH BACK

RUNOFF CALCULATIONS											INLET DESIGN						GUTTER DESIGN					
INLET #	COMPOSITE "C"	AREA	INLET Tc	INTENSITY	RUNOFF	UPSTREAM INLET	UPSTREAM INLET	UPSTREAM INLET	UPSTREAM INLET	BYPASS FROM UPSTREAM INLET	TOTAL RUNOFF	STREET GRADE	STREET CROSS SLOPE	CURB TYPE	INLET LENGTH	EFFECTIVE LENGTH	INLET INTERCEPTION	BYPASS TO DOWNSTREAM INLET	STREET GRADE	STREET CROSS SLOPE	DEPTH AT CURB	SPREAD OF FLOW
EXISTING LINE 400																						
401	0.66	2.40	5	7.35	11.64	801	802	803		0.79	12.43	SUMP	2.08	A	8	6.4	17.92	0.00	SUMP	2.08	< 0.21	< 10.50
402	0.66	0.04	5	7.35	0.19	403				0.02	0.21	3.24	2.08	A	6	4.8	0.20	0.00	3.24	2.08	0.06	3.48
403	0.66	0.07	5	7.35	0.34	404				0.01	0.35	3.24	2.08	A	6	4.8	0.33	0.02	3.24	2.08	0.08	4.12
404	0.66	0.06	5	7.35	0.29					0.00	0.29	3.24	2.08	A	6	4.8	0.28	0.01	3.24	2.08	0.07	3.88
EXISTING LINE 500																						
501	0.66	1.06	5	7.35	5.14	402	502			1.09	6.24	SUMP	2.08	A	6	4.8	13.44	0.00	SUMP	2.08	< 0.21	< 10.50
502	0.66	0.57	5	7.35	2.77	804	503	806	901	0.84	3.61	1.95	2.08	A	6	4.8	2.52	1.09	1.95	2.08	0.20	10.05
503	0.66	0.26	5	7.35	1.26	504				0.33	1.59	1.49	2.08	A	4	3.2	1.33	0.26	1.49	2.08	0.15	7.89
504	0.66	0.29	5	7.35	1.41	505				0.40	1.81	1.49	2.08	A	4	3.2	1.48	0.33	1.49	2.08	0.16	8.25
505	0.66	0.33	5	7.35	1.60	506				0.41	2.01	1.49	2.08	A	4	3.2	1.61	0.40	1.49	2.08	0.17	8.57
506	0.66	0.29	5	7.35	1.41	507				0.63	2.03	1.49	2.08	A	4	3.2	1.63	0.41	1.49	2.08	0.17	8.60
507	0.66	0.58	5	7.35	2.81					0.00	2.81	1.13	2.08	A	4	3.2	2.19	0.63	1.13	2.08	0.20	10.14
EXISTING LINE 800																						
801	0.51	0.29	5	7.35	1.09	1601	1801			0.25	1.34	1.12	2.08	A	6	4.8	1.25	0.08	1.12	2.08	0.15	7.80
802	0.51	0.51	5	7.35	1.91	1701				0.12	2.04	1.12	2.08	A	6	4.8	1.82	0.21	1.12	2.08	0.18	9.05
803	0.66	0.12	5	7.35	0.58	1101				1.61	2.19	3.00	2.08	A	6	4.8	1.70	0.49	3.00	2.08	0.15	7.81
804	0.66	0.22	5	7.35	1.07	1301	1201			0.67	1.74	3.00	2.08	A	6	4.8	1.43	0.31	3.00	2.08	0.14	7.20
805	0.66	0.12	5	7.35	0.58					0.00	0.58	3.00	2.08	A	6	4.8	0.55	0.03	3.00	2.08	0.09	4.94
806	0.66	0.40	5	7.35	1.94	807				0.23	2.17	1.28	2.08	A	6	4.8	1.90	0.27	1.28	2.08	0.18	9.04
807	0.66	0.40	5	7.35	1.94	808				0.07	2.01	1.28	2.08	A	6	4.8	1.78	0.23	1.28	2.08	0.17	8.80
808	0.66	0.19	5	7.35	0.92	809				0.24	1.16	1.28	2.08	A	6	4.8	1.09	0.07	1.28	2.08	0.14	7.25
809	0.66	0.32	5	7.35	1.55					0.00	1.55	2.75	2.08	A	6	4.8	1.32	0.24	2.75	2.08	0.14	7.03
810	0.66	0.21	5	7.35	1.02	1106				0.00	1.02	2.75	2.08	A	6	4.8	0.92	0.10	2.75	2.08	0.12	6.08
811	0.66	2.32	5	7.35	11.25	810				0.10	11.35	SUMP	2.08	A	6	4.8	16.80	0.00	SUMP	2.08	< 0.21	< 10.50
812	0.66	0.13	5	7.35	0.63					0.00	0.63	SUMP	2.08	A	6	4.8	16.80	0.00	SUMP	2.08	< 0.21	< 10.50
EXISTING LINE 1000																						
1001	0.66	0.31	5	7.35	1.50					0.00	1.50	1.28	2.08	A	6	4.8	1.38	0.12	1.28	2.08	0.15	7.94
LINE 1100																						
1101	0.66	0.55	5	7.35	2.67	1102				0.77	3.44	6.02	2.08	A	6	4.8	1.83	1.61	6.02	2.08	0.16	8.09
1102	0.66	0.34	5	7.35	1.65	1103				0.59	2.24	6.02	2.08	A	6	4.8	1.47	0.77	6.02	2.08	0.13	6.97
1103	0.66	0.56	5	7.35	2.72	1104				0.15	2.87	1.80	2.08	A	6	4.8	2.28	0.59	1.80	2.08	0.19	9.40
1104	0.66	0.30	5	7.35	1.46	1105				0.01	1.46	1.80	2.08	A	6	4.8	1.31	0.15	1.80	2.08	0.14	7.41
1105	0.66	0.09	5	7.35	0.44					0.00	0.44	1.50	2.08	A	6	4.8	0.43	0.01	1.50	2.08	0.09	5.04
1106	0.66	0.07	5	7.35	0.34					0.00	0.34	1.50	2.08	A	6	4.8	0.34	0.00	1.50	2.08	0.09	4.64
LINE 1200																						
1201	0.66	0.35	5	7.35	1.70	1202				0.49	2.19	2.45	2.08	A	4	3.2	1.64	0.55	2.45	2.08	0.16	8.08
1202	0.66	0.38	5	7.35	1.84	1203				0.20	2.05	2.45	2.08	A	4	3.2	1.56	0.49	2.45	2.08	0.15	7.90
1203	0.66	0.25	5	7.35	1.21	1204				0.07	1.28	2.45	2.08	A	4	3.2	1.08	0.20	2.45	2.08	0.13	6.71
1204	0.66	0.15	5	7.35	0.73					0.00	0.73	2.45	2.08	A	4	3.2	0.66	0.07	2.45	2.08	0.10	5.52
LINE 1300																						
1301	0.66	0.17	5	7.35	0.82	1401				0.03	0.86	6.02	2.08	A	6	4.8	0.73	0.12	6.02	2.08	0.09	5.01
FUTURE LINE 1400																						
1401	0.66	0.15	5	7.35	0.73	1501				0.01	0.74	1.80	2.08	A	6	4.8	0.70	0.03	1.80	2.08	0.11	5.84
FUTURE LINE 1500																						
1501	0.66	0.09	5	7.35	0.44					0.00	0.44	1.80	2.08	A	6	4.8	0.43	0.01	1.80	2.08	0.09	4.89
EXISTING LINE 1600																						
1601	0.51	0.47	5	7.35	1.76	1701				0.25	2.01	1.12	2.08	A	6	6	1.81	0.21	1.12	2.08	0.18	9.01
1602	0.51	0.84	5	7.35	3.15	1603				1.47	4.62	1.12	2.08	A	6	6	3.53	1.09	1.12	2.08	0.24	12.13
1603	0.51	1.22	5	7.35	4.57	1604				0.85	5.43	1.12	2.08	A	6	6	3.95	1.47	1.12	2.08	0.26	12.85
1604	0.51	0.96	5	7.35	3.60	1605				0.47	4.07	1.12	2.08	A	6	6	3.21	0.85	1.12	2.08	0.23	11.58
1605	0.51	0.80	5	7.35	3.00					0.00	3.00	1.12	2.08	A	6	6	2.53	0.47	1.12	2.08	0.21	10.39
EXISTING LINE 1700																						
1701	0.51	0.59	5	7.35	2.21					0.00	2.21	1.12	2.08	A	6	6	1.96	0.25	1.12	2.08	0.18	9.32
EXISTING LINE 1800																						
1801	0.51	0.20	5	7.35	0.75	1601				0.21	0.96	1.12	2.08	A	6	6	0.92	0.04	1.12	2.08	0.13	6.94
1802	0.51	0.86	5	7.35	3.22	1602				1.09	4.31	1.12	2.08	A	6	6	3.36	0.96	1.12	2.08	0.24	11.83
1803	0.51	0.51	5	7.35	1.91	1802				0.96	2.87	1.12	2.08	A	6	6	2.44	0.43	1.12	2.08	0.20	10.22

- NOTES:  
 1. CAPACITY OF INLETS ON GRADE DETERMINED USING ROUTINE OUTLINED ON PGS 56-95 TO 56-97, SECTION 5600 APWA  
 2. CAPACITY OF SUMP INLETS CALCULATED USING FIGURE 5604-21, SECTION 5600 APWA  
 3. MANNINGS "n" VALUE FOR COMBINED ASPHALT PAVEMENT AND CONCRETE CURB - 0.014

EXISTING STORM  
PROPOSED 6TH PLAT  
FUTURE STORM  
EXISTING STORM

RECORD DRAWING

The information provided on this drawing conforms to construction records; it is not intended for construction, implementation or recording purposes; and it is solely based on information obtained by Schlager and Associates.

"100-00 100.10", "1.00% 1.15% slope", or "8-inch HDPE PVC pipe" are all typical examples of revisions that indicate that design data has been replaced with "as-built" information. All other data is as designed and has not been field verified.

Date: 1/15/26  
 Certified by: BAL  
 Title: Design Engineer  
 Firm: Schlager and Associates, P.A.



PREPARED BY:



SCHLAGEL & ASSOCIATES, P.A.

PERGOLA PARK 6TH PLAT  
STREET, STORMWATER, MASTER DRAINAGE  
PLAN  
---- LEE'S SUMMIT, MISSOURI

REVISION DATE	DESCRIPTION
11-8-24	CITY COMMENTS
12-4-24	CITY COMMENTS
1-15-26	AS-BUILTS

DRAWN BY: BAL	CHECKED BY: MAB	DATE PREPARED: 8-19-24	PROJ. NUMBER: 24-041
---------------	-----------------	------------------------	----------------------

MASTER DRAINAGE PLAN - DRAINAGE CALCS CONT.  
 SHEET  
**7**