




**Accepted
Master Drainage Plan**

This as-graded Master Drainage Plan (MDP) has been reviewed for accuracy. It is accepted for basic conformance to the approved MDP and may be used for the review of individual lot grading (plot) plans.

EARTHWORK SUMMARY	
CUT	6,074
FILL	0
NET	6,074 CY CUT

EARTHWORK NOTE:
EARTHWORK CALCULATIONS DESIGNED TO FINISH GRADE WITH A COMPACTION FACTOR OF 1.15

- NOTE:**
THE CONTRACTOR IS RESPONSIBLE FOR VERIFYING ALL EXISTING UTILITY LOCATIONS PRIOR TO EXCAVATIONS.
- _____ DENOTES PROPOSED MAJOR CONTOUR
 - _____ DENOTES PROPOSED MINOR CONTOUR
 - _____ DENOTES EXISTING MAJOR CONTOUR
 - _____ DENOTES EXISTING MINOR CONTOUR
 - _____ DENOTES AS-BUILT MAJOR CONTOUR
 - _____ DENOTES AS-BUILT MINOR CONTOUR

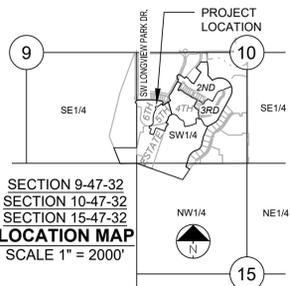


RECORD DRAWING

The information provided on this drawing conforms to construction records; it is not intended for construction, implementation or recording purposes; and it is solely based on information obtained by Schlager and Associates.

“100.00 100.10”, “1.00% 1.15% slope”, or “8-inch HDPE PVC pipe” are all typical examples of revisions that indicate that design data has been replaced with “as-built” information. All other data is as designed and has not been field verified.

Date: 1/15/26
 Certified by: BAL
 Title: Design Engineer
 Firm: Schlager and Associates, P.A.

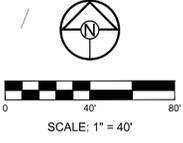

NOTES:

ALL CONSTRUCTION ON THIS PROJECT SHALL CONFORM TO THE CITY OF LEE'S SUMMIT TECHNICAL SPECIFICATIONS.

THE CONTRACTOR IS RESPONSIBLE FOR VERIFYING ALL EXISTING UTILITY LOCATIONS PRIOR TO EXCAVATION.

MISSOURI GEOGRAPHIC REFERENCE SYSTEM BENCHMARK:

BM JA-148, IS A STAMPED KC METRO DISK SET IN CONCRETE LOCATED 2 MILES WEST OF THE INTERSECTION OF HIGHWAY 50 AND 3RD ST. IT IS 44 FT NORTH OF THE CENTER OF 3RD ST. AND 102.5 FT WEST OF THE CENTER OF THE EXIT FROM THE ADJACENT PARKING LOT.

ELEV. 935.18

PROJECT BENCHMARK:

CHISELED "SQUARE" ON STORM CURB INLET AT NORTHWEST INTERSECTION OF SW. TOWER PARK DRIVE AND SW. LONGVIEW BOULEVARD.

NORTHING: 998893.4148
 EASTING: 2803318.5413
 ELEV. 1004.09

SURVEY NOTES

The bases of bearing and coordinates are base on the Missouri Coordinate System of 1983, West Zone (2003 Adjustment) with a Grid Factor of 0.9999020.

**PERGOLA PARK 6TH PLATING
 STREET, STORMWATER, MASTER DRAINAGE
 PLAN
 --- LEE'S SUMMIT, MISSOURI**

REVISION DATE	DESCRIPTION
11-8-24	CITY COMMENTS
12-4-24	CITY COMMENTS
1-15-26	AS-BUILTS

DRAWN BY:	CHECKED BY:	DATE PREPARED:	PROJ. NUMBER:
BAL	MAB	8-19-24	24-041

MASTER DRAINAGE PLAN - GRADING PLAN

SHEET

3

I:\PROJECTS\2024\24-04-0413.0 Design\3.0 DWG Plans\6.0 SS\24-041-SS-GRAD.dwg, GRADING PLAN, 1:1

SW CORNER, SW 1/4 SEC. 10-47-32 CORP OF ENGINEERS 3" ALUMINUM MONUMENT



**Accepted
Master Drainage Plan**

This as-graded Master Drainage Plan (MDP) has been reviewed for accuracy. It is accepted for basic conformance to the approved MDP and may be used for the review of individual lot grading (plot) plans.

LOT TYPE TABLE

LOT #	BASEMENT TYPE
134	STANDARD
135	STANDARD
136	STANDARD
137	STANDARD
138	STANDARD
139	STANDARD
140	STANDARD
141	STANDARD
142	STANDARD
143	STANDARD
144	STANDARD
145	STANDARD

DRAINAGE NOTE:
INDIVIDUAL LOT OWNER(S) SHALL NOT CHANGE OR OBSTRUCT THE DRAINAGE FLOW LINES ON THE LOTS INCLUDED IN THE MASTER DRAINAGE PLAN, UNLESS SPECIFIC APPLICATION IS MADE AND APPROVED BY THE CITY ENGINEER.


NOTE:
THE CONTRACTOR IS RESPONSIBLE FOR VERIFYING ALL EXISTING UTILITY LOCATIONS PRIOR TO EXCAVATIONS.

- _____ DENOTES PROPOSED MAJOR CONTOUR
- _____ DENOTES PROPOSED MINOR CONTOUR
- _____ DENOTES EXISTING MAJOR CONTOUR
- _____ DENOTES EXISTING MINOR CONTOUR
- _____ DENOTES AS-BUILT MAJOR CONTOUR
- _____ DENOTES AS-BUILT MINOR CONTOUR

RECORD DRAWING
The information provided on this drawing conforms to construction records; it is not intended for construction, implementation or recording purposes; and it is solely based on information obtained by Schlager and Associates.

"100.00 100.10", "1.00% 1.15% slope", or "8-inch HDPE PVC pipe" are all typical examples of revisions that indicate that design data has been replaced with "as-built" information. All other data is as designed and has not been field verified.

Date: 1/15/26
 Certified by: BAL
 Title: Design Engineer
 Firm: Schlager and Associates, P.A.

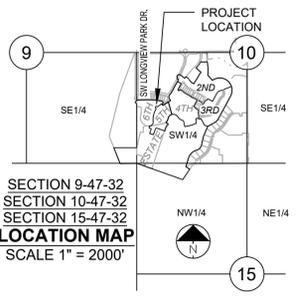

MISSOURI GEOGRAPHIC REFERENCE SYSTEM BENCHMARK:
 BM JA-148, IS A STAMPED KC METRO DISK SET IN CONCRETE LOCATED 2 MILES WEST OF THE INTERSECTION OF HIGHWAY 50 AND 3RD ST. IT IS 44 FT NORTH OF THE CENTER OF 3RD ST. AND 102.5 FT WEST OF THE CENTER OF THE EXIT FROM THE ADJACENT PARKING LOT.
 ELEV. 935.18

PROJECT BENCHMARK:
 CHISELED "SQUARE" ON STORM CURB INLET AT NORTHWEST INTERSECTION OF SW. TOWER PARK DRIVE AND SW. LONGVIEW BOULEVARD.
 NORTHING: 998893.4148
 EASTING: 2803318.5413
 ELEV. 1004.09

NOTES:
 ALL CONSTRUCTION ON THIS PROJECT SHALL CONFORM TO THE CITY OF LEE'S SUMMIT TECHNICAL SPECIFICATIONS.
 THE CONTRACTOR IS RESPONSIBLE FOR VERIFYING ALL EXISTING UTILITY LOCATIONS PRIOR TO EXCAVATION.

SURVEY NOTES
 The bases of bearing and coordinates are base on the Missouri Coordinate System of 1983, West Zone (2003 Adjustment) with a Grid Factor of 0.9999020.




**PERGOLA PARK 6TH PLAT
 STREET, STORMWATER, MASTER DRAINAGE
 PLAN
 --- LEE'S SUMMIT, MISSOURI**

REVISION DATE	DESCRIPTION
11-8-24	CITY COMMENTS
12-4-24	CITY COMMENTS
1-15-26	AS-BUILTS

MASTER DRAINAGE PLAN - LOT INFO

I:\PROJECTS\2024\24-04-113.0 Design\3.0 DWG Plans\6.0 SS\24-04-113-GRAD.dwg, LOT INFO, 11

SW CORNER, SW 1/4
 SEC. 10-47-32
 CORP OF ENGINEERS 3"
 ALUMINUM MONUMENT

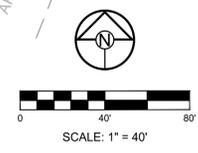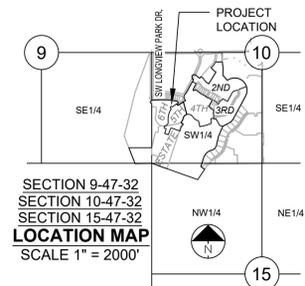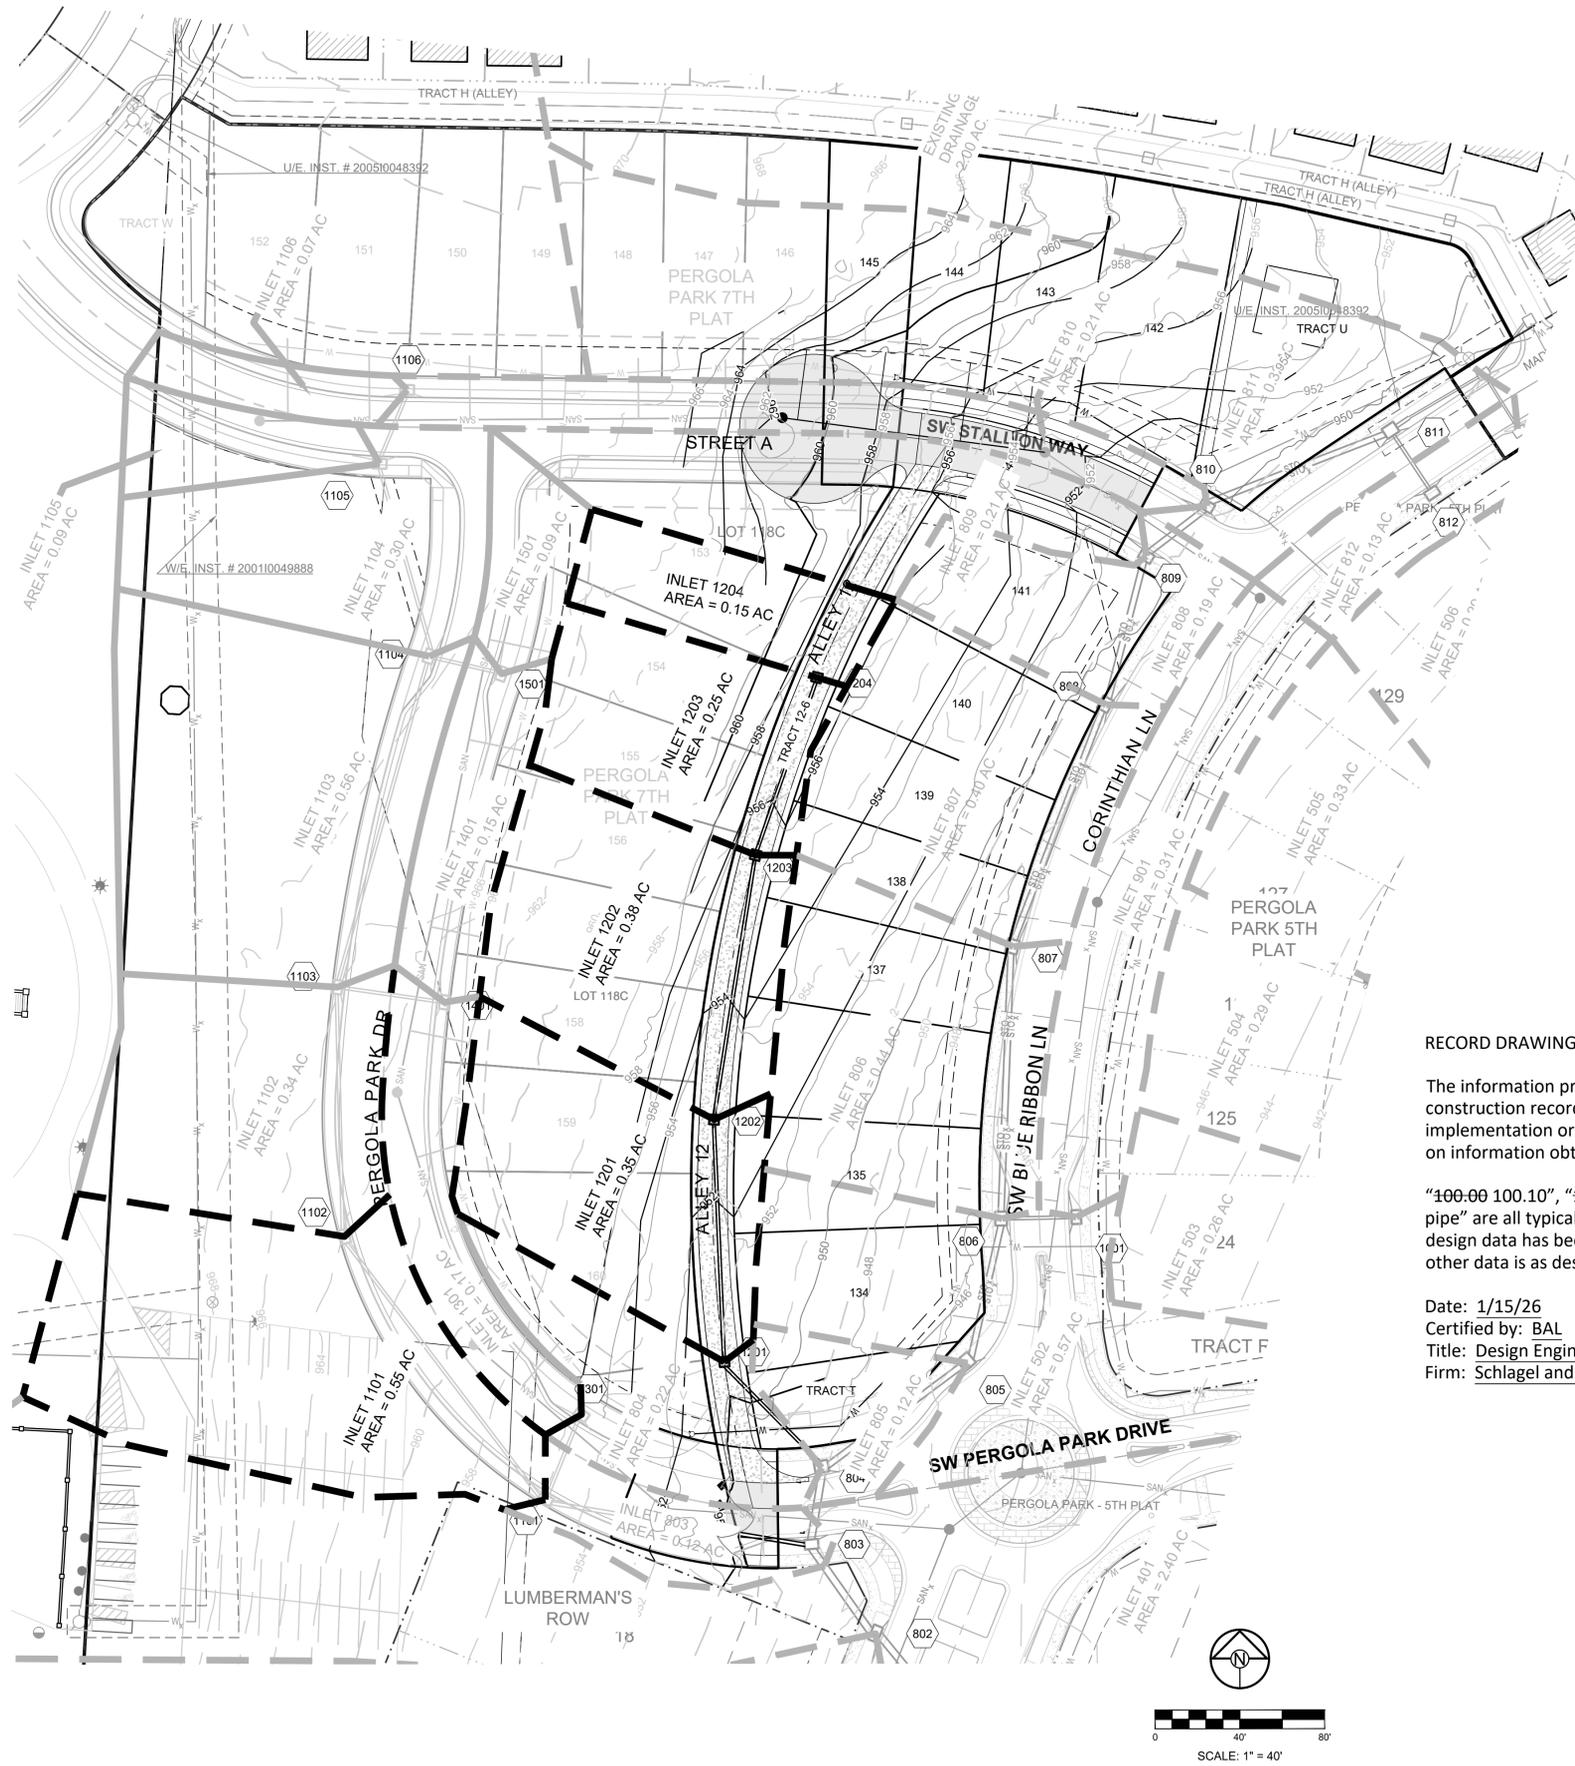

RECORD DRAWING

The information provided on this drawing conforms to construction records; it is not intended for construction, implementation or recording purposes; and it is solely based on information obtained by Schlager and Associates.

"100-00 100.10", "1-00% 1.15% slope", or "8-inch HDPE PVC pipe" are all typical examples of revisions that indicate that design data has been replaced with "as-built" information. All other data is as designed and has not been field verified.

Date: 1/15/26
 Certified by: BAL
 Title: Design Engineer
 Firm: Schlager and Associates, P.A.

NOTES:

- ALL CONSTRUCTION ON THIS PROJECT SHALL CONFORM TO THE CITY OF LEE'S SUMMIT TECHNICAL SPECIFICATIONS.
- THE CONTRACTOR IS RESPONSIBLE FOR VERIFYING ALL EXISTING UTILITY LOCATIONS PRIOR TO EXCAVATION.

MISSOURI GEOGRAPHIC REFERENCE SYSTEM BENCH MARK:

BM JA-148, IS A STAMPED KC METRO DISK SET IN CONCRETE LOCATED 2 MILES WEST OF THE INTERSECTION OF HIGHWAY 50 AND 3RD ST. IT IS 44 FT NORTH OF THE CENTER OF 3RD ST. AND 102.5 FT WEST OF THE CENTER OF THE EXIT FROM THE ADJACENT PARKING LOT.
 ELEV. 935.18

PROJECT BENCHMARK:

CHISELED "SQUARE" ON STORM CURB INLET AT NORTHWEST INTERSECTION OF SW. TOWER PARK DRIVE AND SW. LONGVIEW BOULEVARD.

NORTHING: 998893.4148
 EASTING: 2803318.5413
 ELEV. 1004.09

SURVEY NOTES

The bases of bearing and coordinates are base on the Missouri Coordinate System of 1983, West Zone (2003 Adjustment) with a Grid Factor of 0.9999020.

**Accepted
Master Drainage Plan**

This as-graded Master Drainage Plan (MDP) has been reviewed for accuracy. It is accepted for basic conformance to the approved MDP and may be used for the review of individual lot grading (plot) plans.

SCHLAGEL
 ENGINEERS PLANNERS SURVEYORS LANDSCAPE ARCHITECTS
 14920 West 107th Street • Lenexa, Kansas 66215
 (913) 492-5158 • Fax: (913) 492-8400
 WWW.SCHLAGELASSOCIATES.COM
 Missouri State Certificate of Authority
 #E2002003690-F #LAC2001005237 #LS200200869-F

PREPARED BY:

 MARK ALLEN BREUER
 LICENSE NUMBER PE-2003607268
 EXPIRES 01.16.2026

SCHLAGEL & ASSOCIATES, P.A.

**PERGOLA PARK 6TH PLAT
STREET, STORMWATER, MASTER DRAINAGE
PLAN
--- LEE'S SUMMIT, MISSOURI**

REVISION DATE	DESCRIPTION
11-8-24	CITY COMMENTS
12-4-24	CITY COMMENTS
1-15-26	AS-BUILTS

MASTER DRAINAGE PLAN - DRAINAGE MAP

SHEET

I:\PROJECTS\2024\24-04-13.0 Design\3.0 DWG Plans\6.0 SS\24-04-13-SS-DRAINAGE.dwg, DRAINAGE MAP, 1:1

**Accepted
Master Drainage Plan**

This as-graded Master Drainage Plan (MDP) has been reviewed for accuracy. It is accepted for basic conformance to the approved MDP and may be used for the review of individual lot grading (plot) plans.



PREPARED BY:



SCHLAGEL & ASSOCIATES, P.A.

**PERGOLA PARK 6TH PLAT
STREET, STORMWATER, MASTER DRAINAGE
PLAN
--- LEE'S SUMMIT, MISSOURI**

Schlagel & Associates, P.A.																											
Project Name: PERGOLA PARK 5TH PLAT															Curb Type: B												
Project #: 19-002															City: LEE'S SUMMIT												
Time: 11/27/2024 14:28																											
Design Storm: 10																											
"K" Value: 1.00																											
"F" Factor: 1.00																											
Runoff Calculations																											
Inlet #	Area (acres)	"C" Value	Cumul. Area (acres)	Cumul. CxA	Tc	Intensity	Runoff To Inlet	Cumul. Runoff	Pipe Cap.	Pipe Vel.	Up Piped Inlet 1	Up Piped Inlet 2	Up Area (acres)	Up CxA	Up Inlet	Down Inlet	Pipe Type	"n"	Pipe Size	Length	Slope %	Drop In Inlet	FL Up	FL Down	Inlet Top	HGL Elev.	
EXISTING LINE 400																											
401	2.40	0.66	46.76	30.86	5.7	7.13	11.29	220.00	220.20	9.27	501		3.38	2.23	401	400	RCP	0.013	66	53.87	0.43	0.50	927.98	927.75	936.98	933.27	931.52
EXISTING LINE 600																											
601	0.36	0.66	0.90	0.59	5.1	7.33	1.74	4.35	19.45	11.00			0.00	0.00	601	403	HDPE	0.012	18	36.00	2.92	0.50	936.02	934.97	944.39	937.04	937.04
EXISTING LINE 700																											
701	1.14	0.66	1.41	0.93	5.1	7.32	5.51	6.82	9.26	7.54			0.00	0.00	701	404	PEP	0.012	15	102.48	1.75	0.50	941.69	939.90	949.19	943.04	943.04
EXISTING LINE 500																											
501	1.06	0.66	3.38	2.23	6.2	7.01	4.90	15.64	28.10	5.73			0.00	0.00	501	401	PEP	0.012	30	35.50	0.40	0.45	931.12	930.98	936.98	933.39	933.39
EXISTING LINE 800																											
801	0.29	0.66	1.75	1.16	5.9	7.08	1.22	8.18	24.51	7.80			0.00	0.00	801	502	PEP	0.012	24	51.05	1.00	0.50	933.24	932.73	939.40	934.46	934.46
EXISTING LINE 1000																											
1001	0.31	0.66	0.31	0.20	5.0	7.35	1.50	1.50	4.95	4.03			0.00	0.00	1001	806	PEP	0.012	15	35.00	0.50	N/A	938.82	938.64	945.85	939.60	939.60
EXISTING LINE 1100																											
1101	0.55	0.66	2.32	1.53	6.2	7.01	2.54	10.73	30.11	17.04			0.00	0.00	1101	803	PEP	0.012	18	127.32	7.00	3.00	945.35	936.44	954.50	947.74	947.74
EXISTING LINE 1200																											
1201	0.65	0.66	1.43	0.94	5.6	7.19	3.08	6.78	30.11	17.04			0.00	0.00	1201	804	PEP	0.012	18	67.70	7.00	0.50	941.36	936.62	950.33	942.59	942.59
EXISTING LINE 1300																											
1301	0.17	0.66	0.17	0.11	5.0	7.35	0.83	0.83	12.12	9.88			0.00	0.00	1301	1101	PEP	0.012	15	43.48	3.00	N/A	949.66	948.35	954.89	950.08	950.08
EXISTING LINE 1400																											
1401	0.15	0.66	0.15	0.10	5.0	7.35	0.73	0.73	4.95	4.03			0.00	0.00	1401	1103	PEP	0.012	15	51.01	0.50	N/A	960.03	959.78	964.36	960.54	960.54
EXISTING LINE 1500																											
1501	0.09	0.66	0.09	0.06	5.0	7.35	0.44	0.44	4.95	4.03			0.00	0.00	1501	1104	PEP	0.012	15	35.13	0.50	N/A	962.07	961.89	966.94	962.50	962.50
EXISTING LINE 1600																											
1601	0.47	0.51	4.29	2.19	6.1	7.04	1.69	15.40	31.99	10.18			0.00	0.00	1601	1600	RCP	0.013	24	219.15	2.00	3.00	935.29	930.91	947.22	937.04	937.04
EXISTING LINE 1700																											
1701	0.59	0.51	0.59	0.30	5.0	7.35	2.21	2.21	7.00	5.70			0.00	0.00	1701	1604	PEP	0.012	15	74.21	1.00	N/A	943.69	942.94	949.77	944.40	944.40
EXISTING LINE 1800																											
1801	0.20	0.51	1.57	0.80	5.4	7.23	0.74	5.79	11.38	6.44			0.00	0.00	1801	801	PEP	0.012	18	126.83	1.00	0.50	938.70	937.43	946.33	939.83	939.83
EXISTING LINE 1900																											
1901	0.51	0.51	0.51	0.26	5.0	7.35	1.91	1.91	7.00	5.70			0.00	0.00	1901	1802	PEP	0.012	15	74.45	1.00	N/A	941.19	940.44	945.56	941.84	941.84

Schlagel & Associates, P.A.																											
Project Name: PERGOLA PARK 5TH PLAT															Curb Type: B												
Project #: 19-002															City: LEE'S SUMMIT												
Time: 11/27/2024 14:28																											
Design Storm: 100																											
"K" Value: 1.25																											
"F" Factor: 1.00																											
Runoff Calculations																											
Inlet #	Area (acres)	"C" Value	Cumul. Area (acres)	Cumul. CxA	Tc	Intensity	Runoff To Inlet	Cumul. Runoff	Pipe Cap.	Pipe Vel.	Up Piped Inlet 1	Up Piped Inlet 2	Up Area (acres)	Up CxA	Up Inlet	Down Inlet	Pipe Type	"n"	Pipe Size	Length	Slope %	Drop In Inlet	FL Up	FL Down	Inlet Top	HGL Elev.	
EXISTING LINE 400																											
401	2.40	0.66	46.76	30.86	5.7	10.02	19.84	386.54	220.20	9.27	501		3.38	2.23	401	400	RCP	0.013	66	53.87	0.43	0.50	927.98	927.75	936.98	933.88	931.52
EXISTING LINE 600																											
601	0.36	0.66	0.90	0.59	5.1	10.29	3.06	7.64	19.45	11.00			0.00	0.00	601	403	HDPE	0.012	18	36.00	2.92	0.50	936.02	934.97	944.39	943.11	943.11
EXISTING LINE 700																											
701	1.14	0.66	1.41	0.93	5.1	10.28	9.67	11.96	9.26	7.54			0.00	0.00	701	404	PEP	0.012	15	102.48	1.75	0.50	941.69	939.90	949.19	943.33	943.33
EXISTING LINE 500																											
501	1.06	0.66	3.38	2.23	6.2	9.86	8.62	27.49	28.10	5.73			0.00	0.00	501	401	PEP	0.012	30	35.50	0.40	0.45	931.12	930.98	936.98	936.26	936.26
EXISTING LINE 800																											
801	0.29	0.66	1.49	0.98	5.7	10.03	2.40	12.33	12.47	7.05			0.00	0.00	801	502	PEP	0.012	24	51.05	1.00	0.50	933.24	932.73	939.40	938.58	938.58
EXISTING LINE 1000																											
1001	0.31	0.66	0.31	0.20	5.0	10.32	2.64	2.64	4.95	4.03			0.00	0.00	1001	806	PEP	0.012	15	35.00	0.50	N/A	938.82	938.64	945.85	939.60	939.60
EXISTING LINE 1100																											
1101	0.55	0.66	2.32	1.53	6.2	9.85	4.47	18.86	30.11	17.04			0.00	0.00	1101	803	PEP	0.012	18	127.32	7.00	3.00	945.35	936.44	954.50	947.74	947.74
EXISTING LINE 1200																											
1201	0.65	0.66	1.43	0.94	5.6	10.10	5.41	11.91	30.11	17.04			0.00	0.00	1201	804	PEP	0.012	18	67.70	7.00	0.50	941.36	936.62	950.33	942.59	942.59
EXISTING LINE 1300																											
1301	0.17	0.66	0.17	0.11	5.0	10.32	1.45	1.45	12.12	9.88			0.00	0.00	1301	1101	PEP	0.012	15	43.48	3.00	N/A	949.66	948.35	954.89	950.22	950.22
EXISTING LINE 1400																											
1401	0.15	0.66	0.15	0.10	5.0	10.32	1.28	1.28	4.95	4.03			0.00	0.00	1401	1103	PEP	0.012	15	51.01	0.50	N/A	960.03	959.78	964.36	961.07	961.07
EXISTING LINE 1500																											
1501	0.09	0.66	0.09	0.06	5.0	10.32	0.77	0.77	4.95	4.03			0.00	0.00	1501	1104	PEP	0.012	15	35.13	0.50	N/A	962.07	961.89	966.94	962.50	962.50
EXISTING LINE 1600																											
1601	0.47	0.51	4.29	2.19	6.1	9.90	2.97	27.08	31.99	10.18			0.00	0.00	1601	1600	RCP	0.013	24	219.15	2.00	3.00	935.29	930.91	947.22	937.34	937.34
EXISTING LINE 1700																											
1701	0.59	0.51	0.59	0.30	5.0	10.32	3.88	3.88	7.00	5.70			0.00	0.00	1701	1604	PEP	0.012	15	74.21	1.00	N/A	943.69	942.94	949.77	944.66	944.66
EXISTING LINE 1800																											
1801	0.20	0.51	1.57	0.80	5.4	10.16	1.29	10.16	11.38	6.44			0.00	0.00	1801	801	PEP	0.012	18	126.83	1.00	0.50	938.70	937.43	946.33	940.26	940.26
EXISTING LINE 1900																											
1901	0.51	0.51	0.51	0.26	5.0	10.32	3.36	3.36	7.00	5.70			0.00	0.00	1901	1802	PEP	0.012	15	74.45	1.00	N/A	941.19	940.44	945.56	942.08	942.08

RECORD DRAWING

The information provided on this drawing conforms to construction records; it is not intended for construction, implementation or recording purposes; and it is solely based on information obtained by Schlagel and Associates.

"100-00 100.10", "1-00% 1.15% slope", or "8-inch HDPE PVC pipe" are all typical examples of revisions that indicate that design data has been replaced with "as-built" information. All other data is as designed and has not been field verified.

Date: 1/15/26
 Certified by: BAL
 Title: Design Engineer
 Firm: Schlagel and Associates, P.A.

REVISION DATE	DESCRIPTION
11-8-24	CITY COMMENTS
12-4-24	CITY COMMENTS
1-15-26	AS-BUILTS
8-19-24	DATE PREPARED
24-04-1	PROJ. NUMBER

MASTER DRAINAGE PLAN - DRAINAGE CALCS

SHEET 6

