

**PREMIER**  
BUILDING SUPPLY OF KANSAS CITY

20300 W 207TH St  
Spring Hill, KS 66083  
Phone: 913 686 1812  
www.premierbuildingsupply.com

Customer: Clayton Properties  
Job Name: Farmhouse  
Wildflower Transitional Car GL  
Address: 1153 SE CRONIN ST. LEE'S SUMMIT, MO  
Salesperson: Kyle Clifford  
Designer: Kyle Clifford

Date: 6/17/2025 Job #: Scale: NTS

**ROOF TRUSS PLACEMENT DIAGRAM**

**RELEASE FOR CONSTRUCTION  
AS NOTED ON PLANS REVIEW  
DEVELOPMENT SERVICES  
LEE'S SUMMIT, MISSOURI  
02/18/2026 11:37:12**

**EVERSTEAD  
SHOP DRAWINGS/SUBMITTAL REVIEW**

SUBMITTAL WAS REVIEWED FOR DESIGN CONFORMITY AND GENERAL CONFORMANCE TO CONTRACT DOCUMENTS ONLY. THE CONTRACTOR IS RESPONSIBLE FOR CONFIRMING AND CORRELATING DIMENSIONS AT JOBSITE FOR TOLERANCE, CLEARANCE, QUANTITIES, FABRICATION, COORDINATION OF HIS OR HER WORK WITH OTHER TRADES, AND FULL COMPLIANCE WITH CONTRACT DOCUMENTS.


STATUS:  
**APPROVED AS NOTED**  
02/09/2026  
REVIEWED BY:  
**HCJ**

ENGINEER, EVERSTEAD ENGINEERING & DESIGN LLC.

**TRUSS LAYOUT APPROVED FOR THE ADDRESS LISTED**

1 - SDWC 15600 REQUIRED AT ALL BEARING LOCATIONS (u.n.o.)  
ALL TRUSS TO TRUSS CONNECTIONS = "NAILED" (u.n.o.)

1 - SDWC 15600 NECESARIO EN TODO LOS PUNTOS DE APOYO (u.n.o.)  
TODAS LAS CONEXIONES DE TRUSS A TRUSS = "CLAVADAS" (u.n.o.)

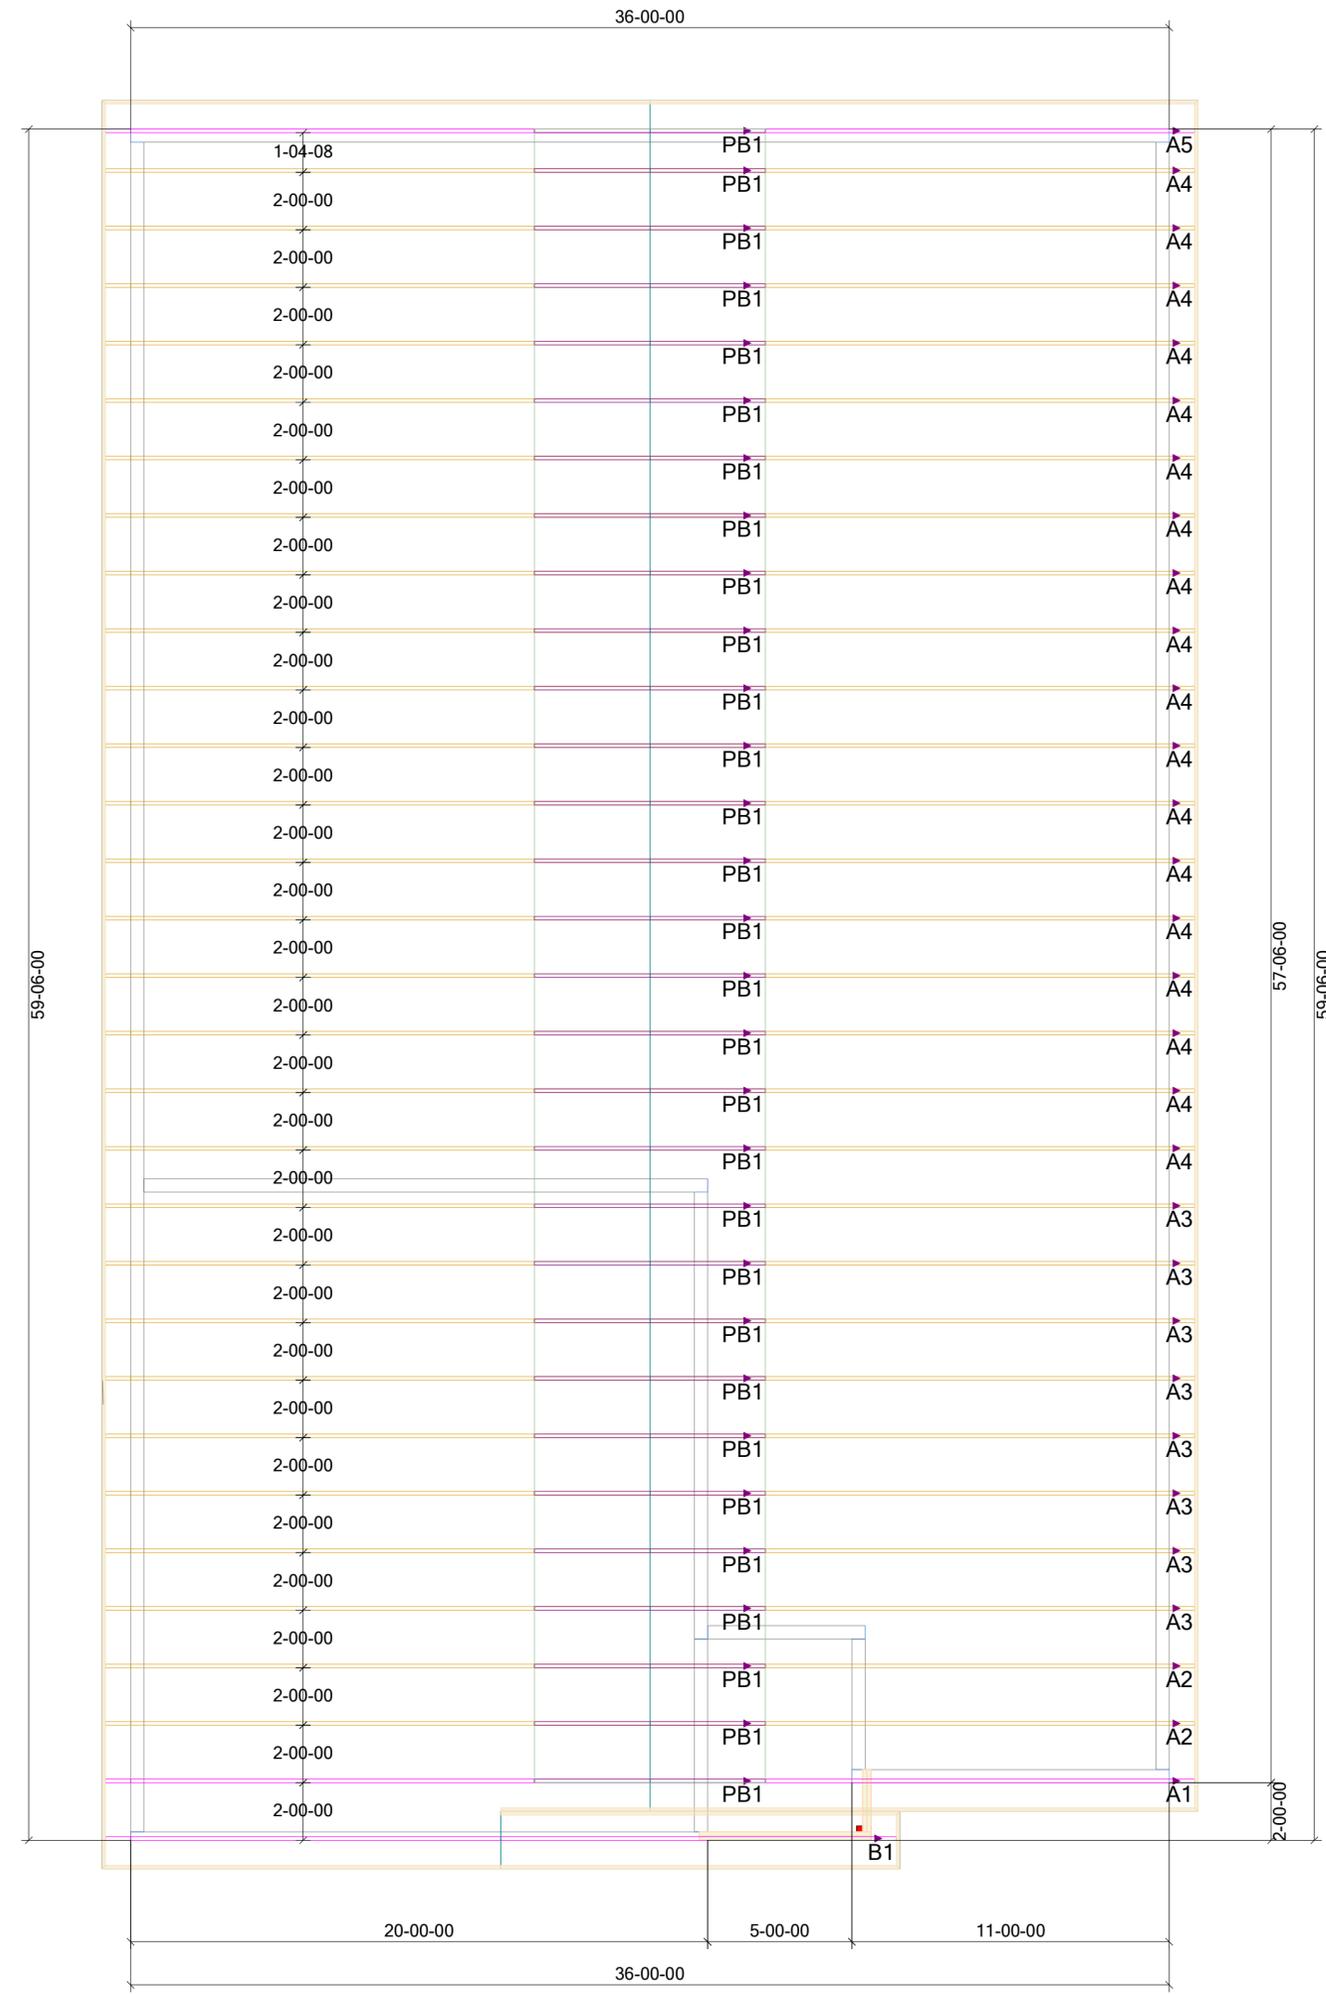

◀ - EL EXTREMO IZQUIERDO DE LOS TRUSSES (VEA LOS PERFILES)

TODAS LAS DIMENSIONES PARA LAS TRUSSES SON DE FUERA DE LA MADERA (u.n.o.)  
ESTABLECER LOS TRUSSES NIVELADAS CON LA ESTRUCTURA (u.n.o.)

◀ - LEFT END OF TRUSS (SEE TRUSS PROFILES)

ALL ROOF TRUSS DIMENSIONS ARE FROM OUTSIDE EDGE OF STUD (u.n.o.)  
SET ROOF TRUSSES FLUSH WITH FRAMING (u.n.o.)

**WARNING:** Trusses must be handled with care to prevent damage and injury.

This truss placement diagram is to be used only as an installation aid; it is not a structural diagram. These trusses are designed as individual building components to be incorporated into the building design at the the specification of the building designer. See individual design sheets for each truss design identified on the placement drawing.

Professional advice should be sought regarding handling, installation, temporary and permanent bracing before erecting trusses. Temporary and permanent bracing is required during installation of trusses to prevent possible collapse.

For general guidance regarding bracing, consult "BCSI-06" available jointly from WTCA & TPI.

Premier Building Supply must be notified of any issues requiring a back charge prior to any work being done. Premier Building Supply reserves the right to use it's service staff in lieu of being back charged.

**ALL PLATE HEIGHTS ARE 09-01-02**