

Built-in cover page

101400-001-1:Shop Drawings



Status	Open Submitted
Spec section	101400 EXTERIOR SIGNAGE
Manager	Ryan Schelin (Je Dunn Construction Company (013735))
Responsible contractor	Ryan Schelin (Je Dunn Construction Company (013735))
Reviewers step 01	Ryan Schelin (Je Dunn Construction Company (013735))

515 E. Locust St, Suite 301
Des Moines, IA 50309
tel 515.698.4400
fax 515.288.3049

Reviewed by JE Dunn: [Ryan Schelin](#)

Date: [02/24/2026](#) 1:02:20 PM

Job: [LSMC ED Expansion](#)

Submittal ID: [101400-001-R1](#)

Bid Package: [100% CD's](#)

Comments: [Reviewed - Submitted for Approval](#)



- Reviewed
- Revise and Resubmit
- Submit Specified Item
- Not Reviewed by General Contractor
- Review Not Required by the Contract Documents
- Furnish as Corrected
- Rejected


This review is only for general conformance with the design concept and the information given in the Construction Documents. Corrections or comments made on the shop drawings during this review do not relieve the contractor from compliance with the requirements of the plans and specifications. Review of a specific item shall not include review of an assembly of which the item is a component. The contractor is responsible for: dimensions to be confirmed and correlated at the jobsite; information that pertains solely to the fabrication processes or to the means, methods, techniques, sequences and procedures of construction; coordination of the Work in a safe and satisfactory manner

Signed Jvelazquez




Date 3/3/2026

Provide as part of deferred submittal.

Resubmit for record only.

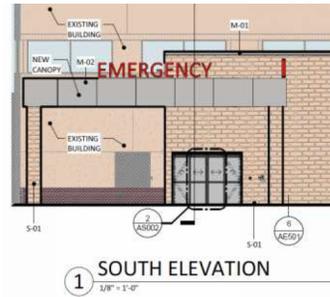

Reference RFI-098 - RS JE Dunn

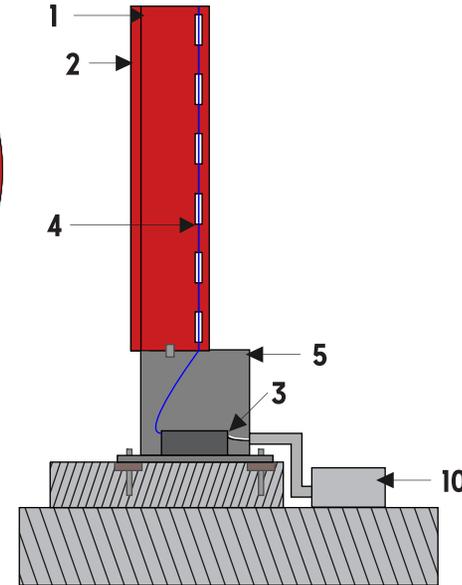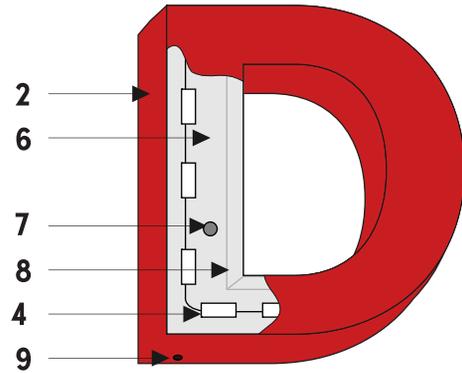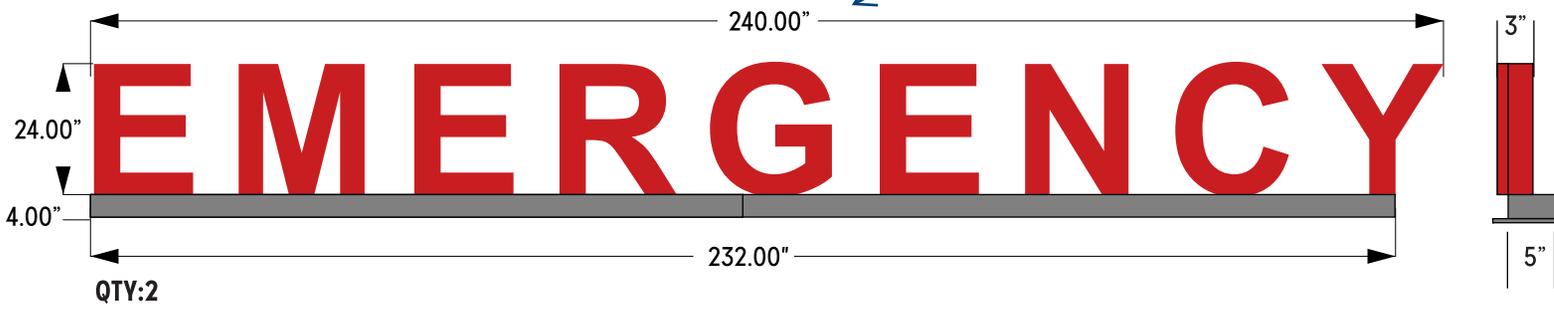

DESCRIPTION



- 1 - 3" DEEP FACE LIT CHANNEL LETTERS
- 2 - RED TRIM AND RETURNS
- 3 - POWER SUPPLY (60W/12V)
- 4 - RED LED ILLUMINATION
- 5 - CUSTOM RACEWAY MOUNTED W/ 1/4" TOGGLE -2" ANGLE W/ ACM SKIN
- 6 - ACM BACK & RED ACRYLIC FACE
- 7 - PASS THROUGH GROMMET
- 8 - CLINCHED/WELDED SEAM
- 9 - DRAIN HOLE
- 10 - JUNCTION BOX TO HAVE 15A-110V POWER PROVIDED BY CUSTOMER

COLORS



EXTERIOR SIGNAGE
 #8633 - HCA EXTERIOR CANOPY

CUSTOMER TO PROVIDE VECTOR ARTWORK

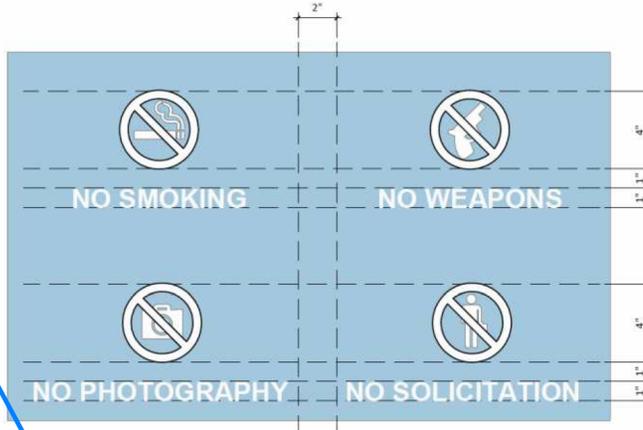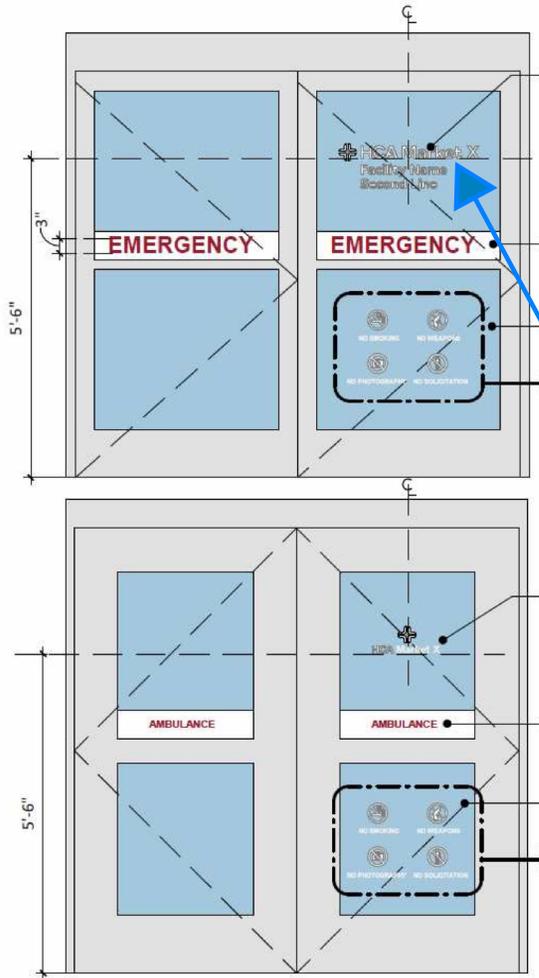

3 DOOR VINYL DETAIL
3" = 1'-0"




Match existing HCA facility information

2 REGULATORY PANEL AT ENTRY AND AMBULANCE (BASIS OF DESIGN)
1/2" = 1'-0"

DESCRIPTION

- 1 - HIGH PERFORMANCE ORACAL 751 VINYL FIRST SURFACE

COLORS

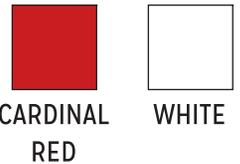

EXTERIOR SIGNAGE

#8633 - HCA EXTERIOR CANOPY

JAN 2026 - PAGE 2/3