

DRAWING INDEX	
SHEET NUMBER	DRAWING TITLE
C000	COVER SHEET
C200	SANITARY SEWER PLAN AND PROFILE
C201	SANITARY SEWER SERVICE CONNECTION DETAILS 1
C202	SANITARY SEWER NOTES AND DETAILS 2

SANITARY SEWER LINE CONNECTION

PROJECT NO. XXXXXXXX

LONGVIEW CAMPGROUND

1499 SW COUNTY PARK RD

SECTION 9, T47N, R32W

LEE'S SUMMIT, JACKSON COUNTY, MISSOURI 64081




RELEASED FOR CONSTRUCTION
As Noted on Plan Review

 Development Services Department
 Lee's Summit, Missouri
 03/13/2026


SANITARY SEWER QUANTITIES:	
160 LF	4" SERVICE LINE SDR26 PVC
1 EA	4"x15" SERVICE LINE CUT-IN WYE
3 EA	4"x4" SERVICE LINE CUT-IN WYE
1 EA	4" CLEANOUT W/ UTILITY BOX
1 EA	4"x45" BEND
1 LUMP SUM	PREPARATION OF AS BUILT DRAWINGS

DATE:	NO:	REVISIONS:
2-02-2026	1	REVISED PER CITY COMMENTS

PROJECT NUMBER	CLDPIR-XXXX-XXXX
DRAWN BY:	CB
CHECKED BY:	RO
APPROVED BY:	RO
DATE:	12/16/2025
SCALE:	NOT TO SCALE

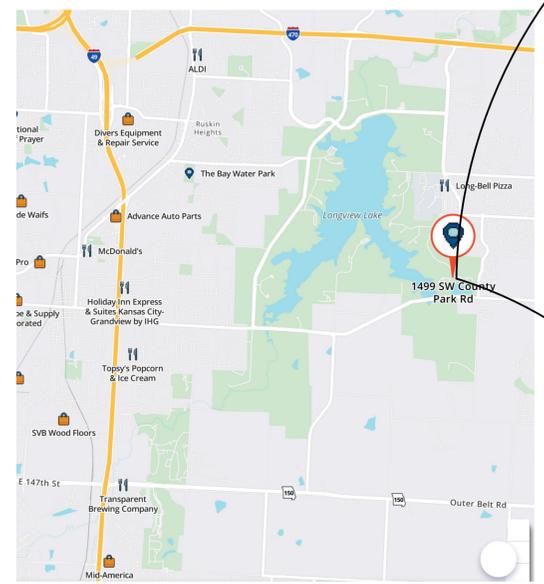

VICINITY MAP

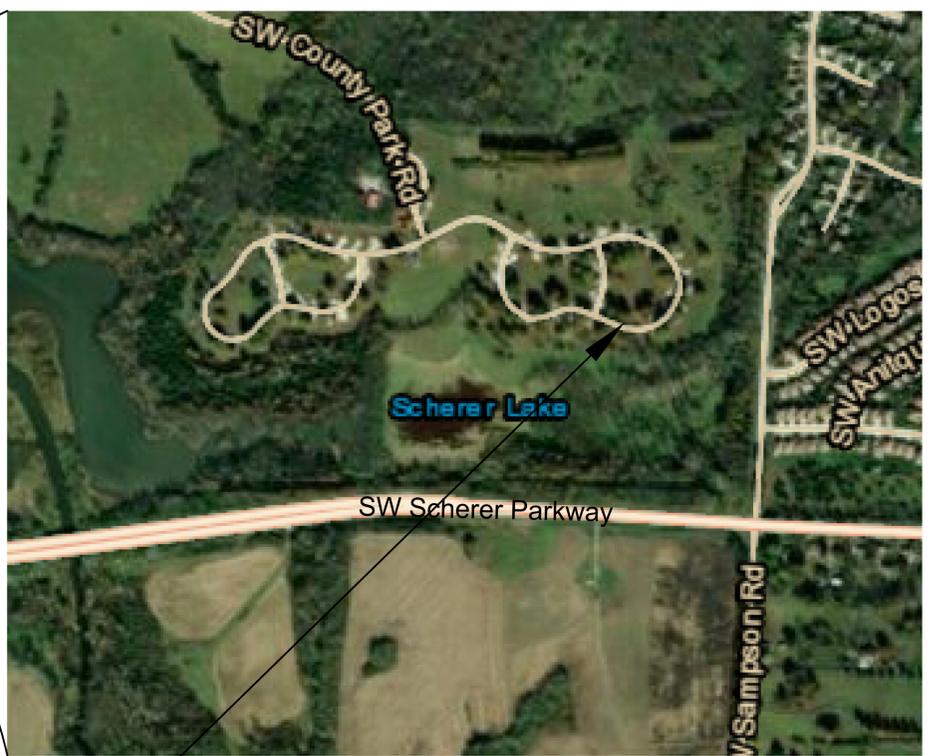

LOCATION MAP

PROJECT LOCATION

DATE _____
NAME _____

EROSION CONTROL

DATE DECEMBER 4, 2025
DR. RAYMOND A. OKUAGU, PE, SE

CERTIFICATION BLOCK

DATE DECEMBER 4, 2025
DR. RAYMOND A. OKUAGU, PE, SE

REVIEWED BY:

DATE _____
CITY OF LEE'S SUMMIT MISSOURI

AS-BUILT CERTIFICATION

THE POLICY OF THE "PLAN PREPARATION CRITERIA AND PROCEDURE" (PLANS CRITERIA) AND POLICY DOCUMENT NO. 88054 "AS-BUILT DRAWINGS FOR STREAM BUFFER BUILT BY PERMIT STIPULATE THE FOLLOWING REGARDING "AS-BUILT" DRAWINGS:

- DRAWINGS ARE TO BE PROVIDED WITHIN THIRTY (30) CALENDAR DAYS AFTER THE DATE THE "REQUEST FOR AS-BUILTS" LETTER IS ISSUED BY THE CITY TO THE PERMITTEE/CONTRACTOR
- DRAWINGS MUST BE ACCEPTED BY THE CITY BEFORE ANY SERVICE CONNECTIONS WILL BE ALLOWED.
- DRAWINGS ARE PART OF THE PERMIT OBLIGATIONS MAKING THEM THE FINAL AS-BUILT DOCUMENTS.

(ENGINEER'S SIGNATURE)

DATE

DEVELOPER'S CERTIFICATION

I HAVE REVIEWED THESE PLANS AND UNDERSTAND WHAT IS PROPOSED. THE WORK WILL BE ACCOMPLISHED IN ONE CONTRACT WITH A WORK BREAKDOWN AS FOLLOWS:

- SANITARY SEWER IMPROVEMENTS
- _____

ANY INCIDENTAL WORK NOT SPECIFICALLY PERMITTED (I.E. FINAL CLEANUP) WILL BE COMPLETED BY THE GENERAL CONTRACTOR.
THIS EROSION CONTROL PLAN HAS BEEN PLACED IN THE CITY'S FILE FOR THIS PROJECT. THE PLAN APPEARS TO FULFILL THE MISSOURI DEPARTMENT OF NATURAL RESOURCES OF THE CITY. I UNDERSTAND THAT ADDITIONAL EROSION CONTROL MEASURES MAY BE NEEDED IF UNFORESEEN EROSION PROBLEMS ARISE OR IF THE SUBMITTED PLAN DOES NOT FUNCTION AS INTENDED. THE REQUIREMENTS OF THIS PLAN SHALL RUN WITH THE LAND AND BE THE OBLIGATION OF THE LAND OWNER UNTIL SUCH TIME AS THE PLAN IS PROPERLY COMPLETED, MODIFIED, OR VOIDED.

(OWNER'S SIGNATURE)

DATE

ENGINEER'S CERTIFICATION

I CERTIFY THAT THE PROJECT HAS BEEN DESIGNED AND THESE PLANS PREPARED TO MEET OF EXCEED THE DESIGN CRITERIA OF LEE'S SUMMIT MISSOURI IN CURRENT USAGE, EXCEPT AS INDICATED BELOW:

- EXCEPTION:
- NONE _____
 - _____
 - _____

(ENGINEER'S SIGNATURE)

DATE



UTILITY CONTACTS

- TIME WARNER CABLE.....816-743-2482
- K.C.P. & L. COMPANY.....816-420-4803
- SPIRE.....1-800-509-4400
- AT&T TELEPHONE COMPANY.....1-800-252-1133
- CHARTER (TIME WARNER CABLE).....913-601-2504
- UTILITY LOCATION MARKING.....1-800-DIG-RITE
- GOOGLE FIBER.....1-415-736-6597
- WATER/SEWER CUSTOMER SERVICE:816-969-1900
- EMERGENCY SERVICE (AFTER HOURS):.....816-969-7407
- NON-EMERGENCY DISPATCH (PUBLIC WORKS):.816-969-7390

FILE NUMBER:
XXX

PRCOM20261050

- NOT FOR CONSTRUCTION
- REVIEWED FOR CONSTRUCTION




RELEASED FOR CONSTRUCTION



As Noted on Plan Review

Development Services Department
Lee's Summit, Missouri

03/13/2026


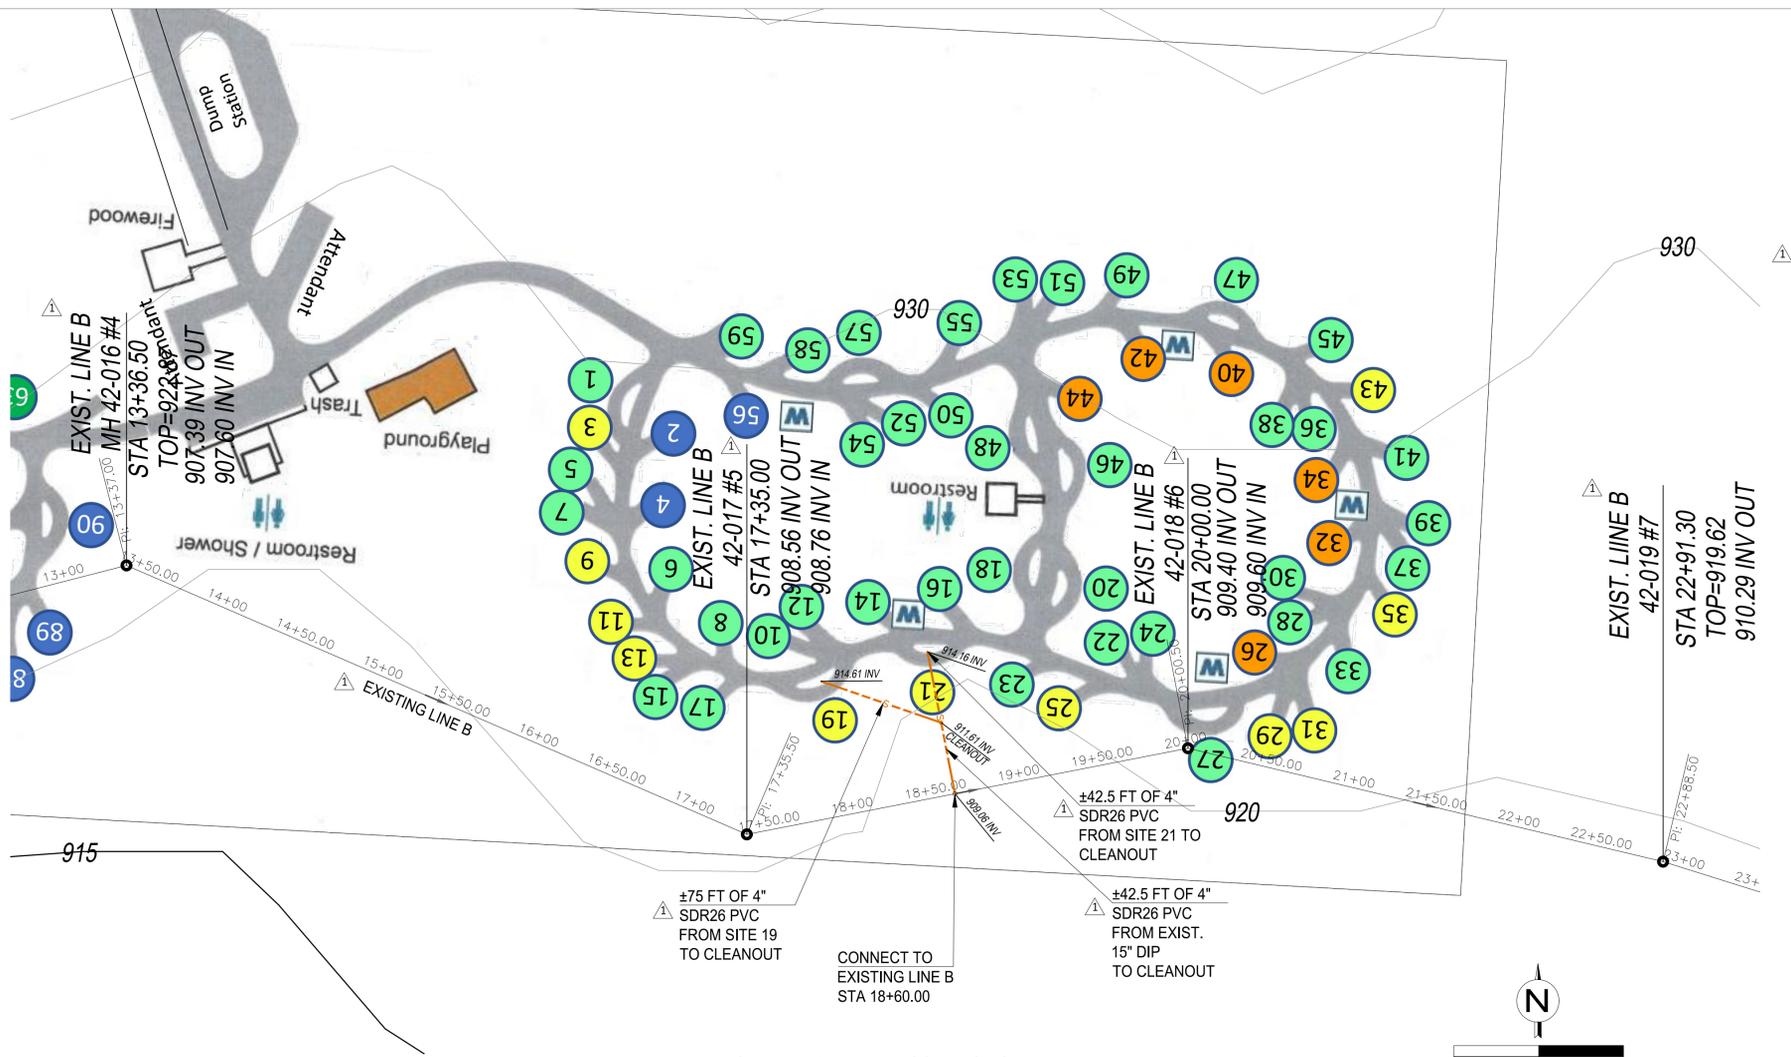


PLAN: SANITARY LATERAL CONNECTION

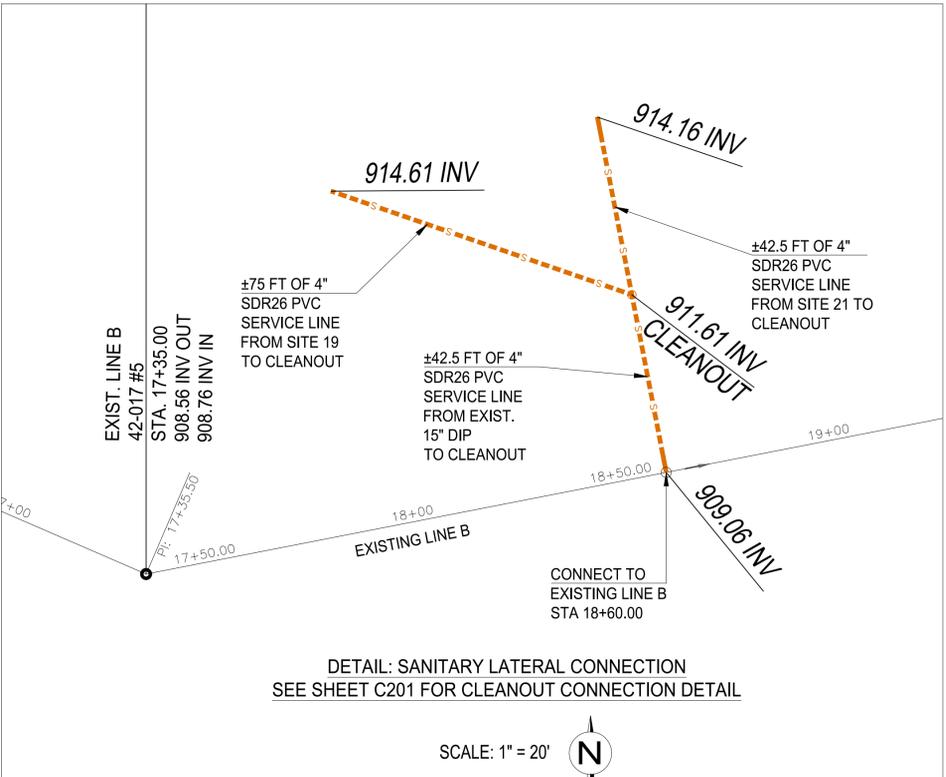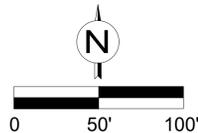

DETAIL: SANITARY LATERAL CONNECTION
SEE SHEET C201 FOR CLEANOUT CONNECTION DETAIL

SCALE: 1" = 20'

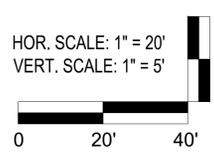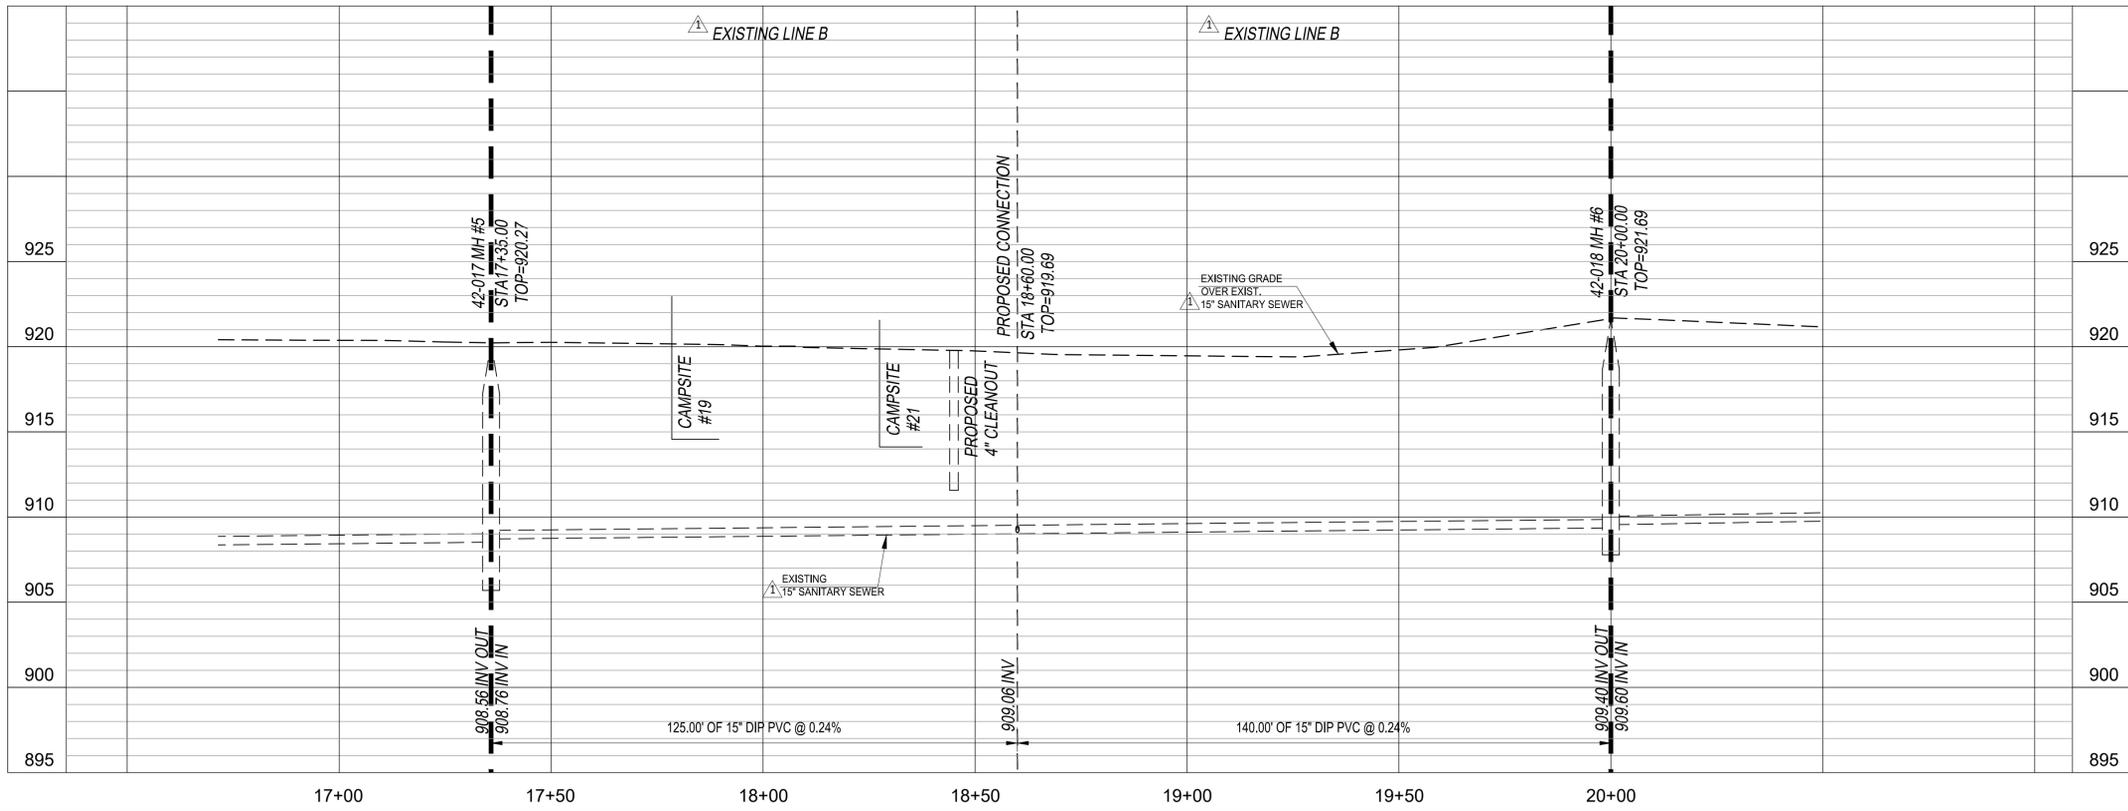

DATE:	NO:	REVISIONS:
2-02-2026	1	REVISED PER CITY COMMENTS



SANITARY SEWER PROFILE
LONGVIEW CAMPGROUND
 1499 SW COUNTY PARK RD PROJECT NO. XXX
 Lee's Summit, Missouri 64081



DRAWN BY: CB
 CHECKED BY: RO
 APPROVED BY: RO
 DATE: 12/16/2025
 SCALE: NOT TO SCALE

C200

RELEASED FOR CONSTRUCTION
 As Noted on Plan Review
 Development Services Department
 Lee's Summit, Missouri
 03/13/2026

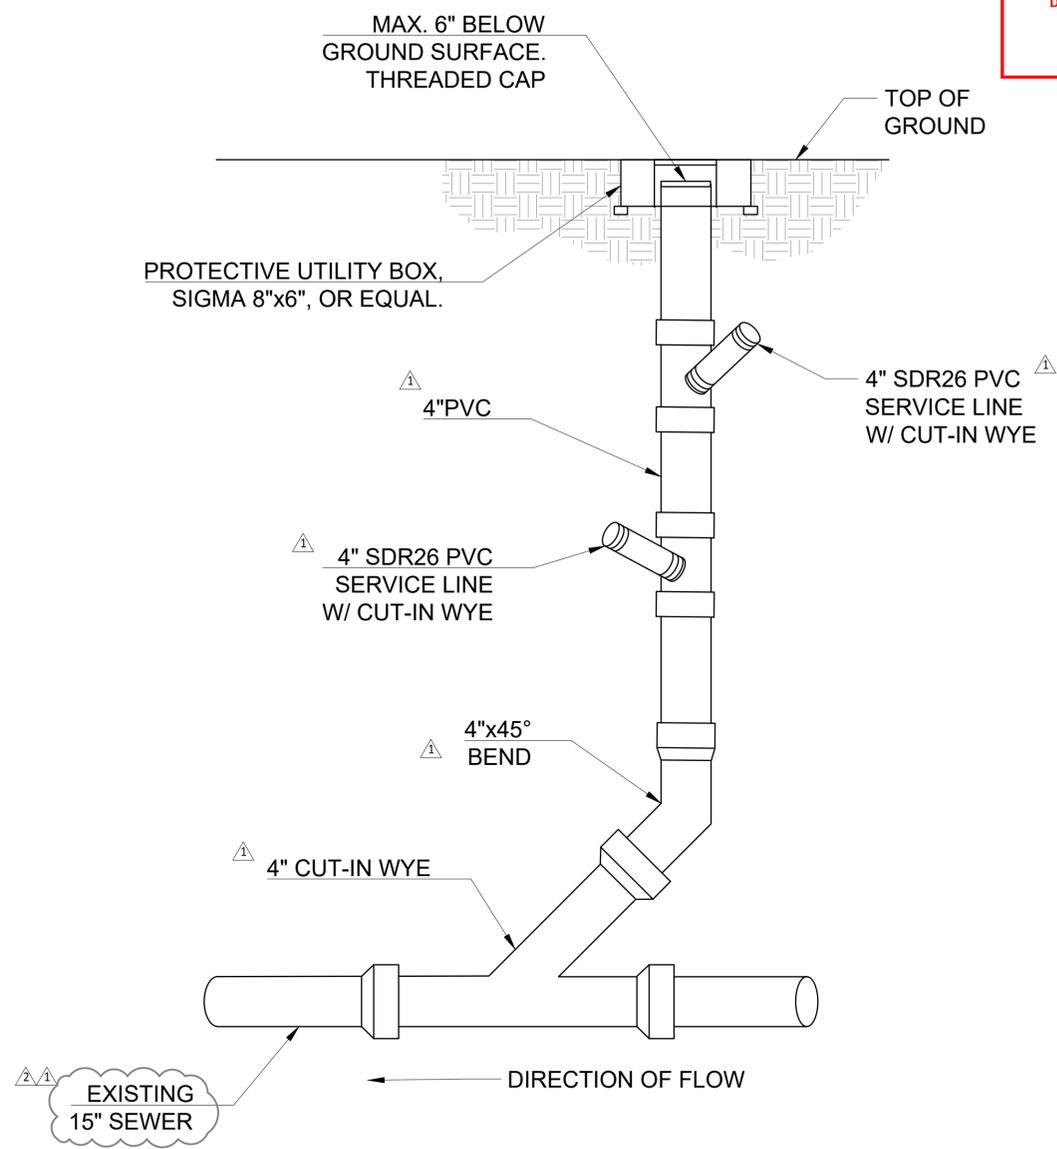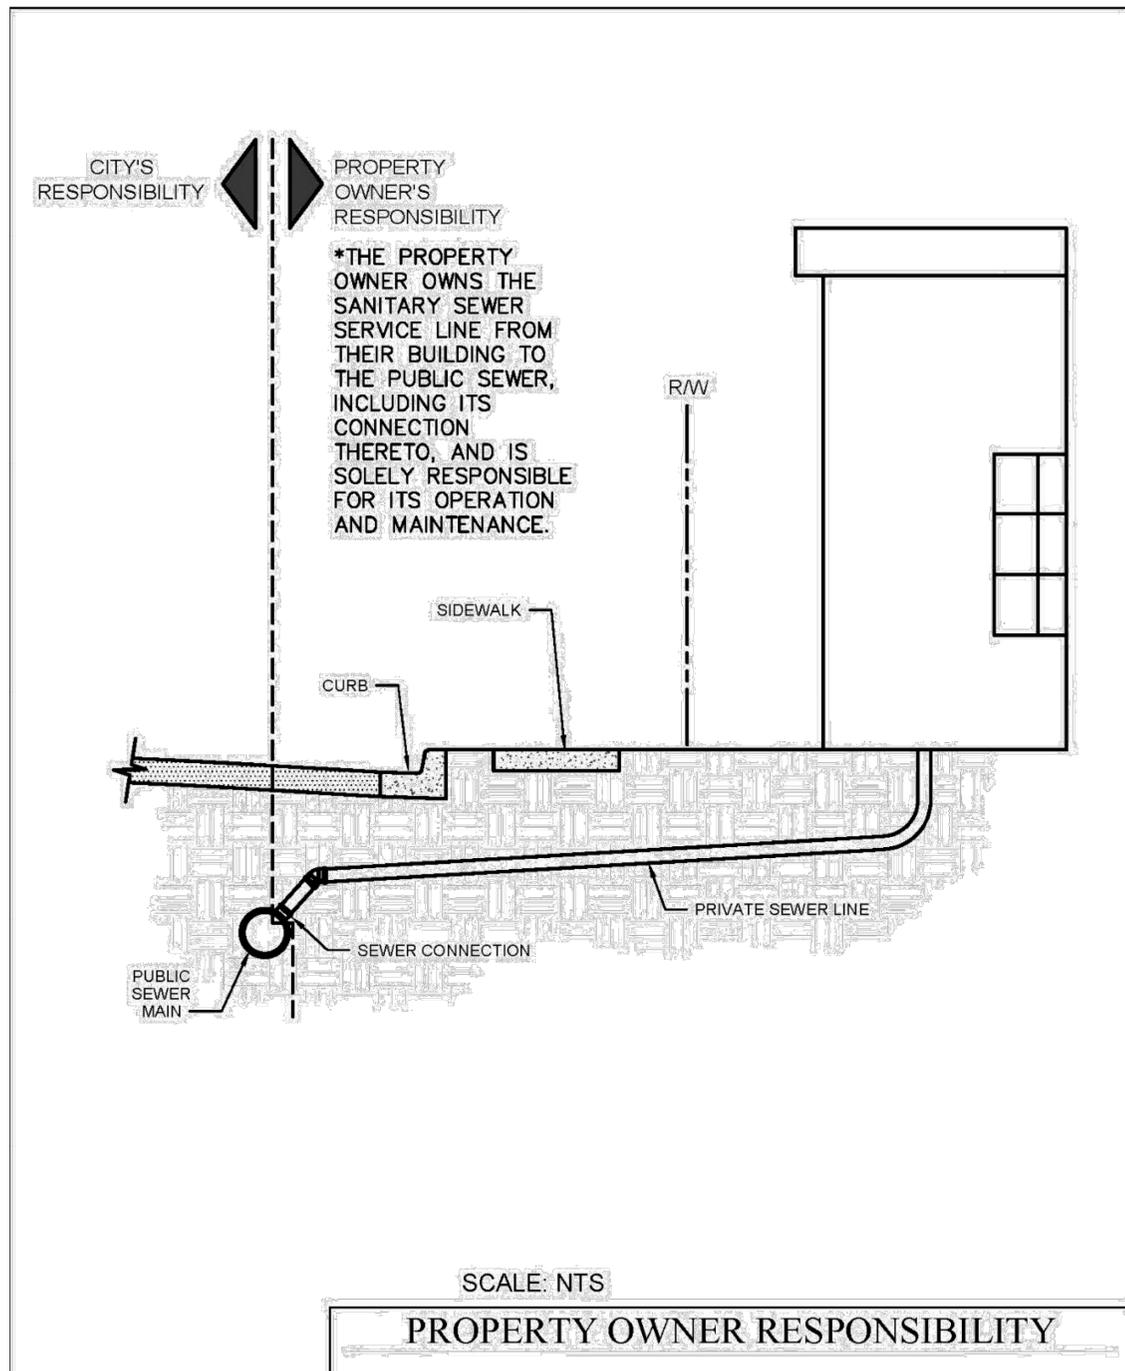

SEWER SERVICE AND CLEANOUT DETAIL

FILE NUMBER:
XXXX

DATE:	NO:	REVISIONS:
2-02-2026	1	REVISED PER CITY COMMENTS
2-12-2026	2	REVISED PER CITY COMMENTS

**SANITARY SEWER SERVICE CONNECTION
 DETAILS 1**
 LONGVIEW CAMPGROUND
 1499 SW COUNTY PARK RD PROJECT NO. XXX
 Lee's Summit, Missouri 64081



DRAWN BY: CB
 CHECKED BY: RO
 APPROVED BY: RO
 DATE: 12/16/2025
 SCALE: NOT TO SCALE

C201

