

20300 W 207TH St.
Spring Hill, KS
66083

PREMIER
BUILDING SUPPLY OF KANSAS CITY
Phone: 913.686.1812
www.premierbuildingsupply.com

Customer:
Clayton Properties

Job Name:
Honeydew Farmhouse 2Car

Address:
{{ADDRESS}} 1340 SE Windbreak Dr. LSMO 64082

Plan Name:
Honeydew

Elevation:
Farmhouse 2Car

Salesperson:
Kyle Clifford

Designer:
Enter designer name

Date: 1/12/2026 Job #: Enter Job# Scale: NTS

**ROOF TRUSS PLACEMENT
DIAGRAM**

**RELEASE FOR CONSTRUCTION
AS NOTED ON PLANS REVIEW
DEVELOPMENT SERVICES
LEE'S SUMMIT, MISSOURI
03/17/2026 4:31:30**

EVERSTEAD
SHOP DRAWINGS/SUBMITTAL REVIEW

SUBMITTAL WAS REVIEWED FOR DESIGN CONFORMITY AND GENERAL CONFORMANCE TO CONTRACT DOCUMENTS ONLY. THE CONTRACTOR IS RESPONSIBLE FOR CONFIRMING AND CORRELATING DIMENSIONS AT JOISTS FOR TOLERANCE, CLEARANCE, QUANTITIES, FABRICATION, COORDINATION OF HIS OR HER WORK WITH OTHER TRADES, AND FULL COMPLIANCE WITH CONTRACT DOCUMENTS.


STATUS:
APPROVED AS NOTED
03/12/2026
REVIEWED BY:
HCJ

ENGINEER: EVERSTEAD ENGINEERING & DESIGN LLC

TRUSS LAYOUT APPROVED FOR THE ADDRESS LISTED

1 - SDWC 15600 REQUIRED AT ALL BEARING LOCATIONS (u.n.o.)
ALL TRUSS TO TRUSS CONNECTIONS = "NAILED" (u.n.o.)
1 - SDWC 15600 NECESARIO EN TODO LOS PUNTOS DE APOYO (u.n.o.)
TODAS LAS CONEXIONES DE TRUSS A TRUSS = "CLAVADAS" (u.n.o.)

HANGER	SCHEDULE	QTY
● LUS24	LUS24	0
● LUS26	LUS26	0
● HUS26	HUS26	0
● HHUS26-2	HHUS26-2	0
● HGUS26-2	HGUS26-2	0
● HHUS28-2	HHUS28-2	0
● THJA26	THJA26	0
● TJC37	TJC37	0
● THJU26	THJU26	0
● HUS28	HUS28	0
● HUS28-2	HUS28-2	0
● HHUS210-2	HHUS210-2	0
● HHUS28-2	HHUS28-2	0
● LUS28	LUS28	0
● SUL24	SUL24	0
● SUL26	SUL26	0
● SUR24	SUR24	0
● SUR26	SUR26	0
● THA422	THA422	0
● THA426	THA426	0
● THAC422	THAC422	0
● THAC426	THAC426	0
● THASL29	THASL29	0
● THASR29	THASR29	0
● HANGER1	HANGER1	0
● HANGER2	HANGER2	0
● SDWC15600	SDWC15600	0

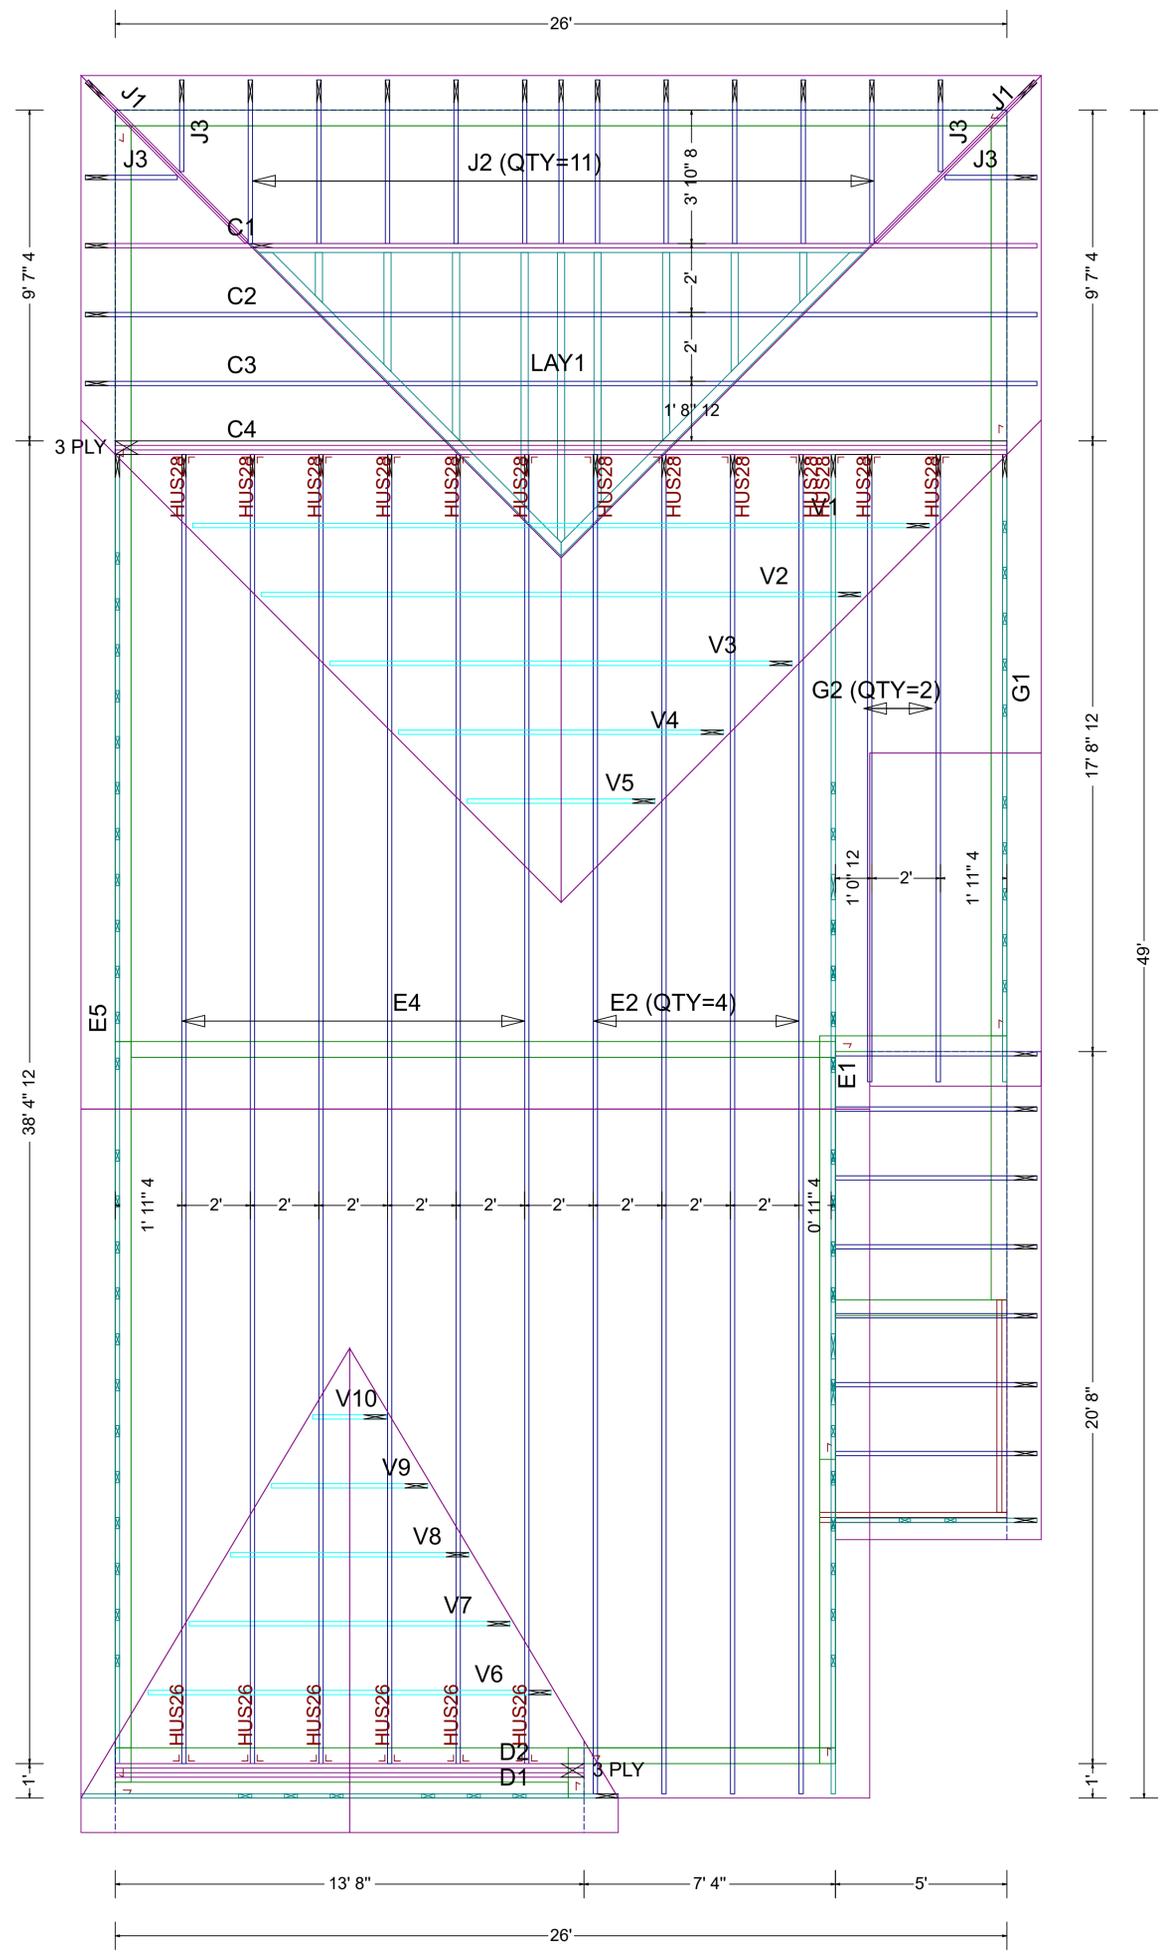

NOTE

IT IS THE RESPONSIBILITY OF THE BUILDING DESIGN OR ARCHITECT TO PROVIDE AN APPROPRIATE CONNECTION FOR TRUSSES TO SUPPORTING STRUCTURE PER REACTIONS SHOWN ON TRUSS ENGINEERING. SPECIAL CONSIDERATIONS FOR MECHANICAL EQUIPMENT AND/OR PLUMBING (AND THEIR CONNECTIONS) IN TRUSS SPACE MUST BE DIAGRAMMED BY BUILDER ON APPROVED TRUSS LAYOUT PRIOR TO FABRICATION. THIS COMPANY IS A TRUSS MANUFACTURER WHOSE RESPONSIBILITIES ARE LIMITED TO THOSE DESCRIBED IN THE WTCA 1-1995 "DESIGN RESPONSIBILITIES." ACCORDINGLY, IT DISCLAIMS ANY RESPONSIBILITIES AND/OR LIABILITY FOR THE CONSTRUCTION DESIGN, DRAWINGS, DOCUMENTS INCLUDING THE INSTALLATION AND BRACING OF TRUSSES MANUFACTURED BY THIS COMPANY.

WARNING

CONVENTIONAL FRAMING, ERECTION AND/OR PERMANENT BRACING IS NOT THE RESPONSIBILITY OF THE TRUSS DESIGNER, PLATE MANUFACTURER, OR TRUSS MANUFACTURER. PERSONS ERECTING TRUSSES ARE CAUTIONED TO SEEK PROFESSIONAL ADVICE REGARDING ERECTION BRACING WHICH IS ALWAYS REQUIRED TO PREVENT TOPPLING AND DOMINOING DURING ERECTION AND PERMANENT BRACING WHICH MAY BE REQUIRED IN SPECIFIC APPLICATIONS. SEE "BRACING WOOD TRUSSES COMMENTARY AND RECOMMENDATIONS" (BCSI 1-03) FOR FURTHER INFORMATION.

TRUSSES SHALL BE INSTALLED IN A STRAIGHT AND PLUMB POSITION. WHERE NO SHEATHING IS APPLIED DIRECTLY TO THE TOP AND/OR BOTTOM CHORDS, THEY SHALL BE BRACED AS SPECIFIED ON THE ENGINEERED DESIGN. TRUSSES SHALL BE HANDLED WITH REASONABLE CARE DURING ERECTION TO PREVENT DAMAGE OR PERSONAL INJURY.

X - EL EXTREMO IZQUIERDO DE LOS TRUSSES (VEA LOS PERFILES)
TODAS LAS DIMENSIONES PARA LAS TRUSSES SON DE FUERA DE LA MADERA (u.n.o.)
ESTABLECER LOS TRUSSES NIVELADAS CON LA ESTRUCTURA (u.n.o.)

X - LEFT END OF TRUSS (SEE TRUSS PROFILES)

ALL ROOF TRUSS DIMENSIONS ARE FROM OUTSIDE EDGE OF STUD (u.n.o.)
SET ROOF TRUSSES FLUSH WITH FRAMING (u.n.o.)

WARNING:
Trusses must be handled with care to prevent damage and injury.
This truss placement diagram is to be used only as an installation aid; it is not a structural diagram. These trusses are designed as individual building components to be incorporated into the building design at the specification of the building designer. See individual design sheets for each truss design identified on the placement drawing.

Professional advice should be sought regarding handling, installation, temporary and permanent bracing before erecting trusses. Temporary and permanent bracing is required during installation of trusses to prevent possible collapse.

For general guidance regarding bracing, consult "BCSI-06" available jointly from WTCA & TPI.

Premier Building Supply must be notified of any issues requiring a back charge prior to any work being done. Premier Building Supply reserves the right to use it's service staff in lieu of being back charged.