


PROCESSED 2015 2160

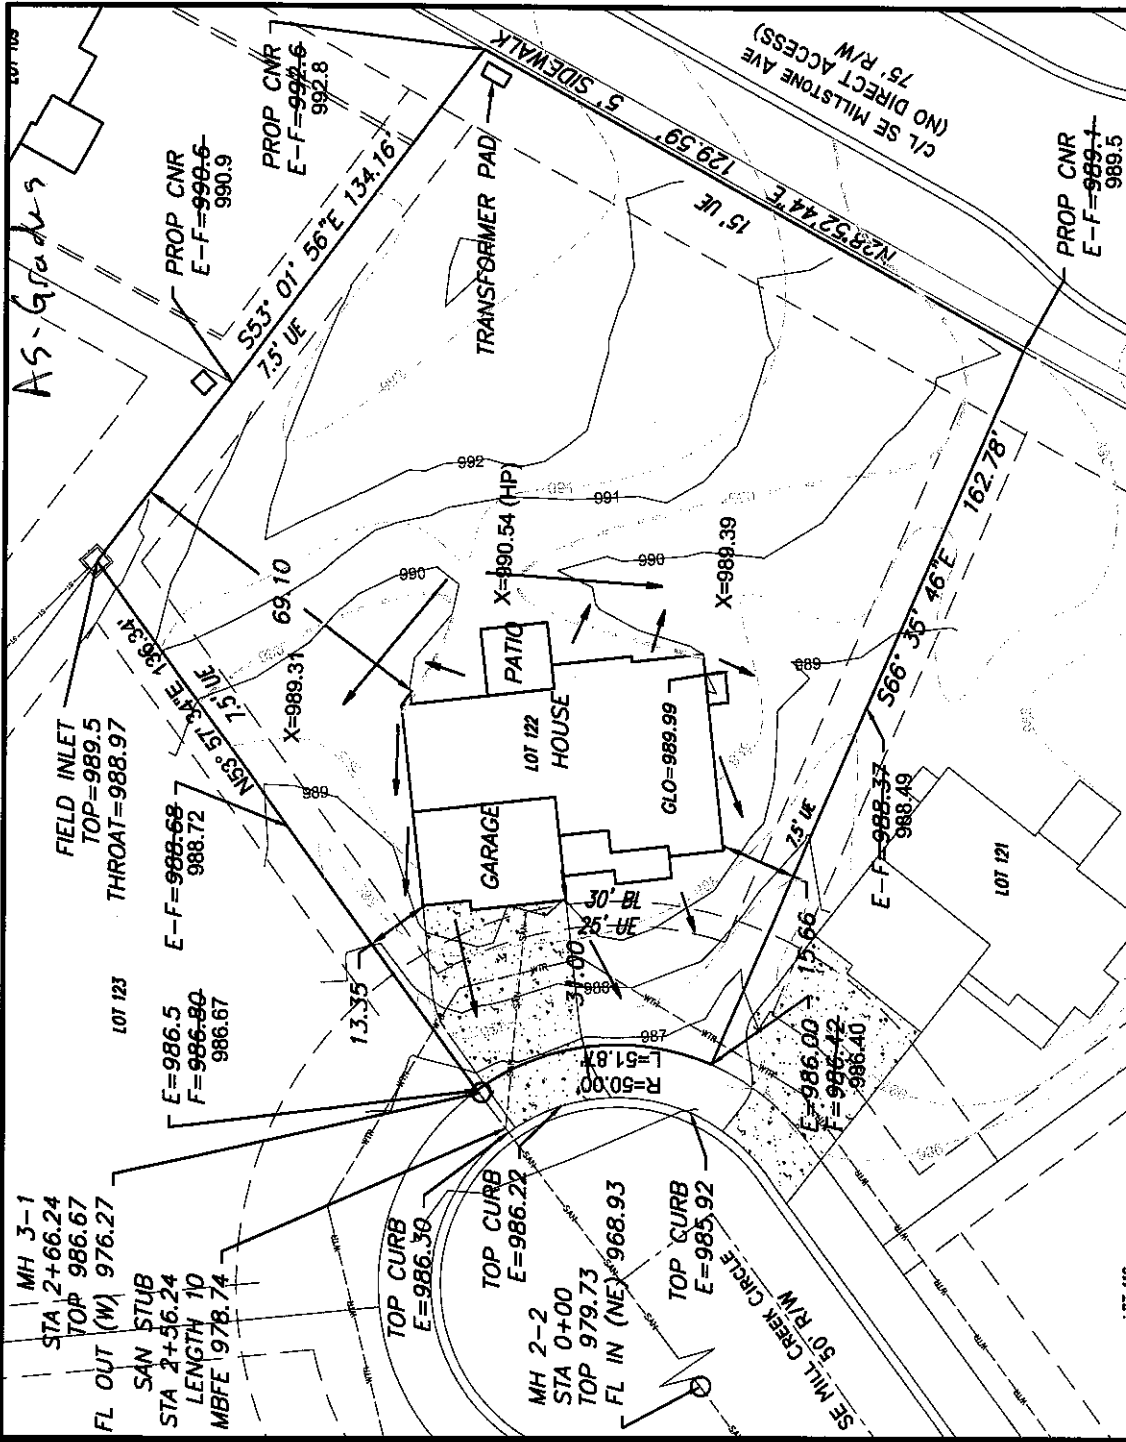

5/13/16
JRF

X=#### = Actual asbuilt ground shots taken on May 10, 2016.

Contours shown are asbuilt.

LEGEND

- Gas Meter
- Telephone or Fiber-Optic Pedestal
- Cable TV Pedestal
- Electric Pedestal
- Light Pole
- Mailbox
- Fire Hydrant
- Water Valve


PROPOSED HOUSE

- TOP FOUNDATION = 990.72
- GARAGE FLOOR = 988.72
- TOP FOOTING = 981.72
- BASEMENT FLOOR = 982.06

- E = EXISTING ELEVATION
- F = PROPOSED FINAL ELEVATION
- G = ADJACENT GRADE AT EGRESS
- GLO = GRADE AT LOWEST OPENING
- U.E. = UTILITY EASEMENT
- B.L. = BUILDING LINE

NOTES

1. BUILDER TO VERIFY ALL BUILDING ELEVATIONS AND DIMENSIONS.

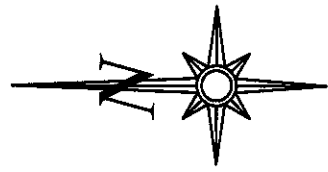


Scale 1" = 40'

LOT INFORMATION

24,380.63 SQ. FT.
MBFE = 978.74
ADDRESS
413 SE MILL CREEK CIR

LEGAL DESCRIPTION

DRIVEWAY SLOPE = 6.0 %
EXTENDED LOT AREA = 24,888.49 SQ. FT.
NOTE : DECK APPROVAL WILL BE REQUIRED PRIOR TO (FUTURE) DECK CONSTRUCTION

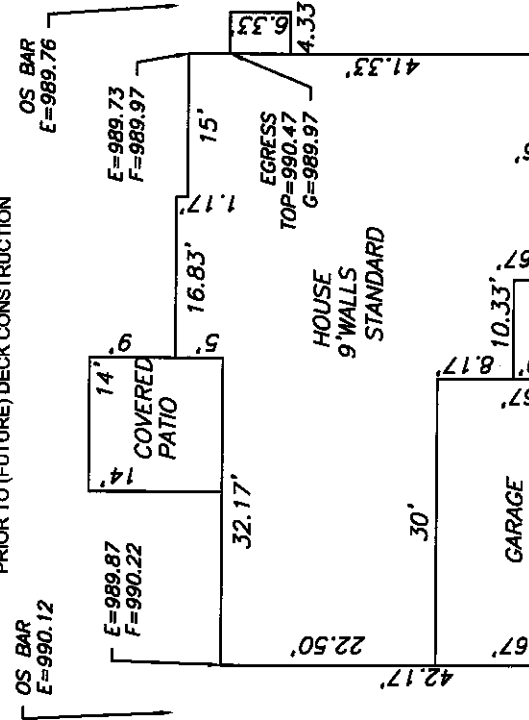

EGRESS
TOP=990.47
G=989.97

HOUSE
9' WALLS
STANDARD

GARAGE

COVERED PATIO