

CONSTRUCTION STAKE PLOT PLAN

ORDERED BY: TRUMARK HOMES


DESCRIPTION: LOT 1440 WINTERSET VALLEY, 12TH PLAT, LEES SUMMIT, MO.

1920 NW THOREAU DR.

AS-GRADED PLOT PLAN IS
REQUIRED PRIOR TO SODDING

APPROVED: Kim Bowman DATE: 12/13/19
PRINT NAME: KIM BOWMAN
The approval is issued in reliance upon information submitted by the applicant. Any permit issued pursuant to this approval may be suspended or revoked whenever the permit is issued in error or on the basis of incorrect information supplied, or in violation of any ordinance or regulation. Approved plans shall not be changed, modified or altered without authorization. The issuance or granting of a permit or approval of plans shall not be construed to be a permit for, or an approval of, any violation of any of the provisions of the ordinance of the City of Lees Summit, Missouri.


PROPOSED:
WALKOUT BASEMENT
TOP FDN 921.7
GAR FLR 932.3/932.0
BAS FLR 924.0
NOTE: GARAGE FLOOR
SLOPES. IT IS 932.3 AT
BACK OF GARAGE AND
932.0 AT FRONT

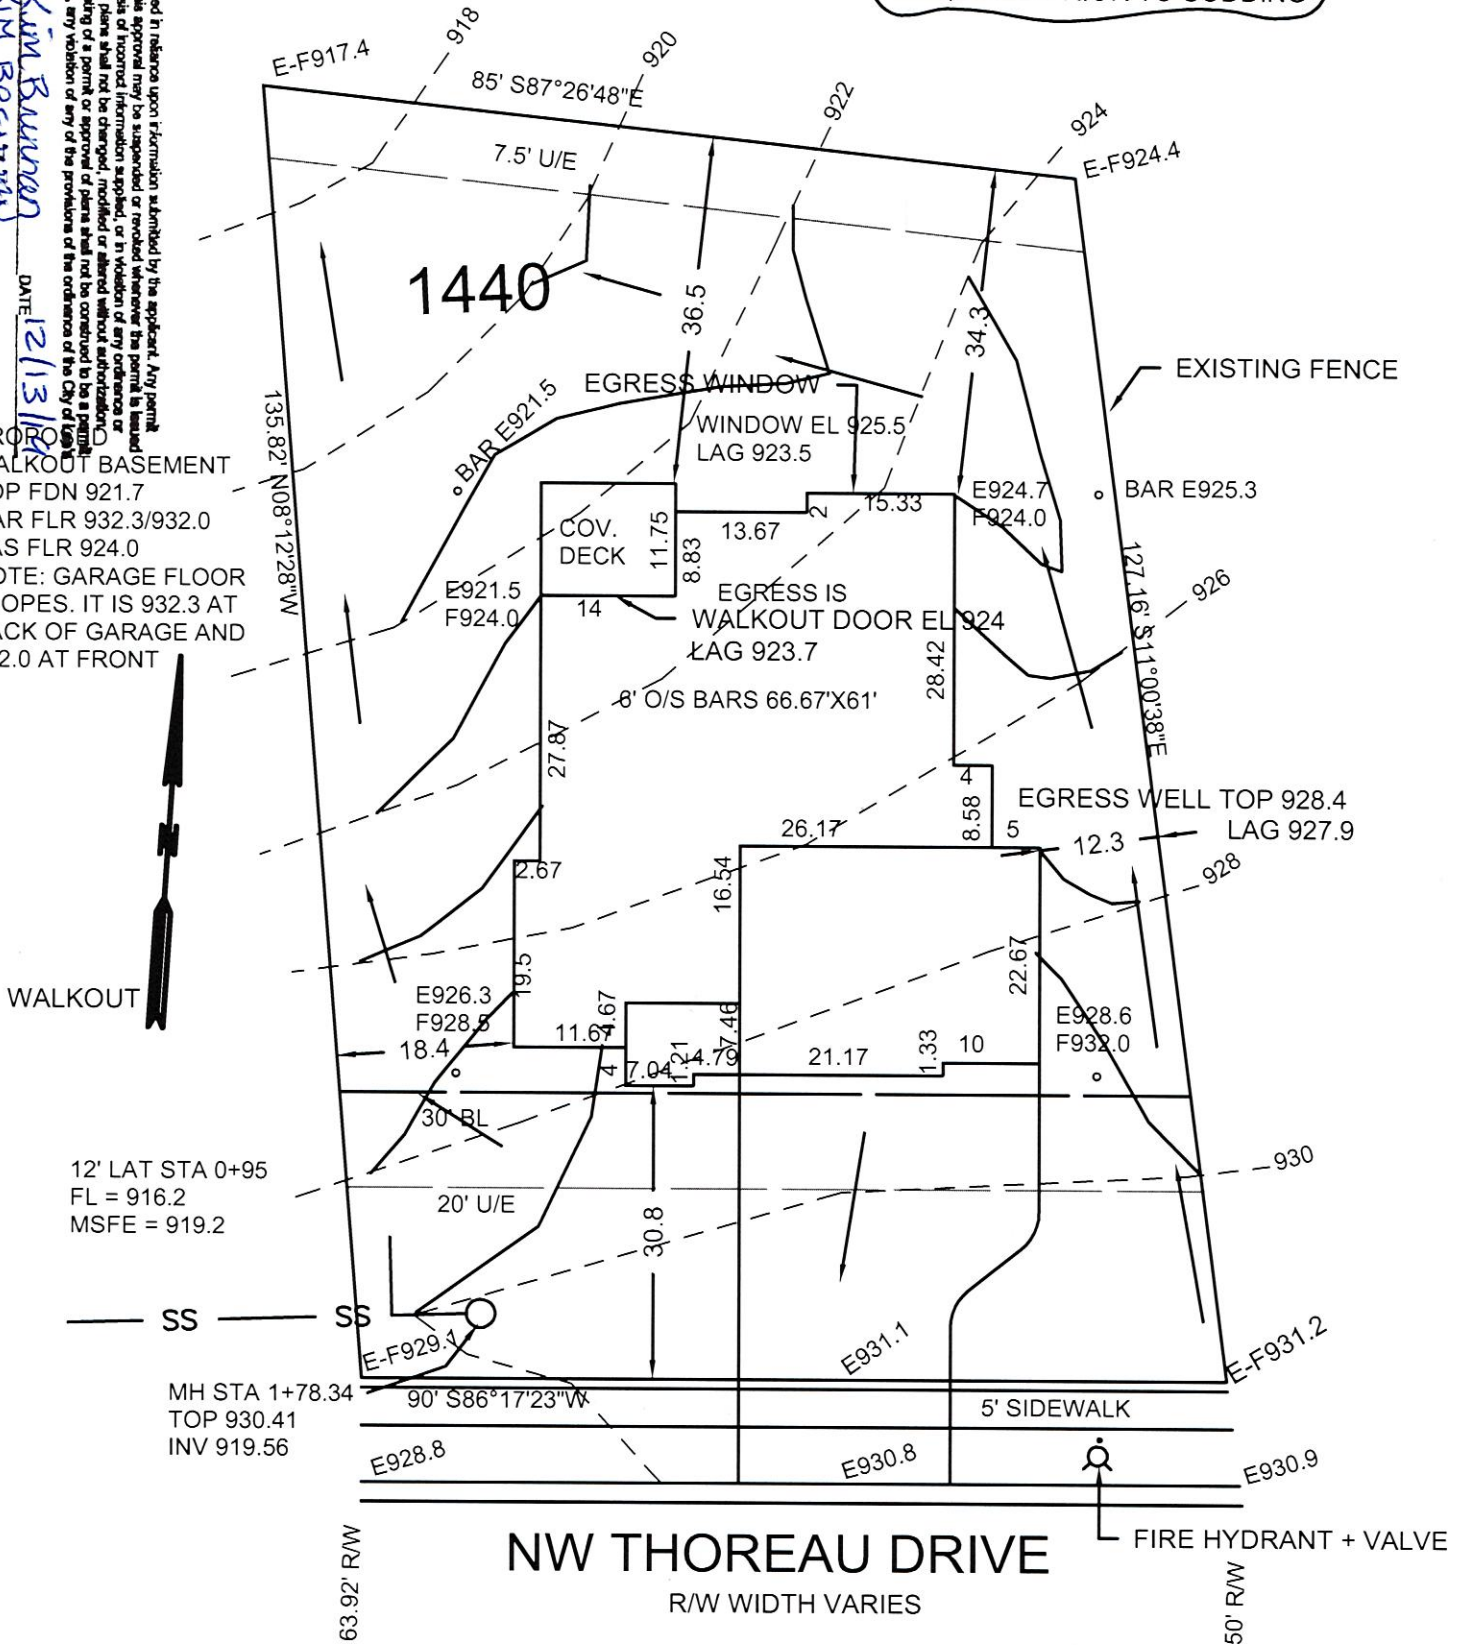

This plot plan is not an "as-built" survey as the house was staked prior to being built and cannot be used in place of a "Surveyors Real Property Report". This plot plan was prepared for use before and during foundation construction only and should not be used to establish property lines for fences or other structures. House staked as shown on this plot plan. House dimensions may have been assumed and contractor must check house dimensions shown and compare to the final house plans. Contractor to verify all elevations at job site. Builder must make final decision as to cuts and foundation heights at the job site, any floor elevations shown are shown as a guide only. Sanitary sewer and lateral elevations cannot be verified at time of staking, and it may be necessary to verify sanitary sewer elevation and location (BY DIGGING UP THE SEWER LATERAL) prior to excavation for foundation. Underground utilities and un-platted easements may not be shown. This does not constitute a boundary survey and builder must check to make sure description shown is correct with the deed for the property. It is recommended that no work be done until building permits are obtained and plot plan has been verified by local building codes authorities to comply with all setback and other restrictions.

→ = DRAINAGE PATTERN

CONSTRUCTION ENGINEERING SERVICES, INC.

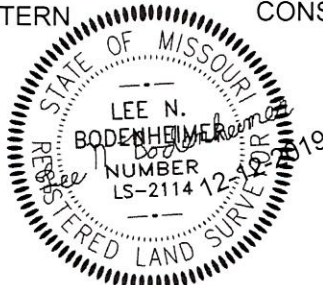

16810-C East 40 Highway
Independence, MO 64055
(816)478-2323
lee@engineeringkc.com
SCALE: 1"=20'
DATE: 11/15/2019
JOB NO: 16786

LEE BODENHEIMER, L.S.
Land Surveyor