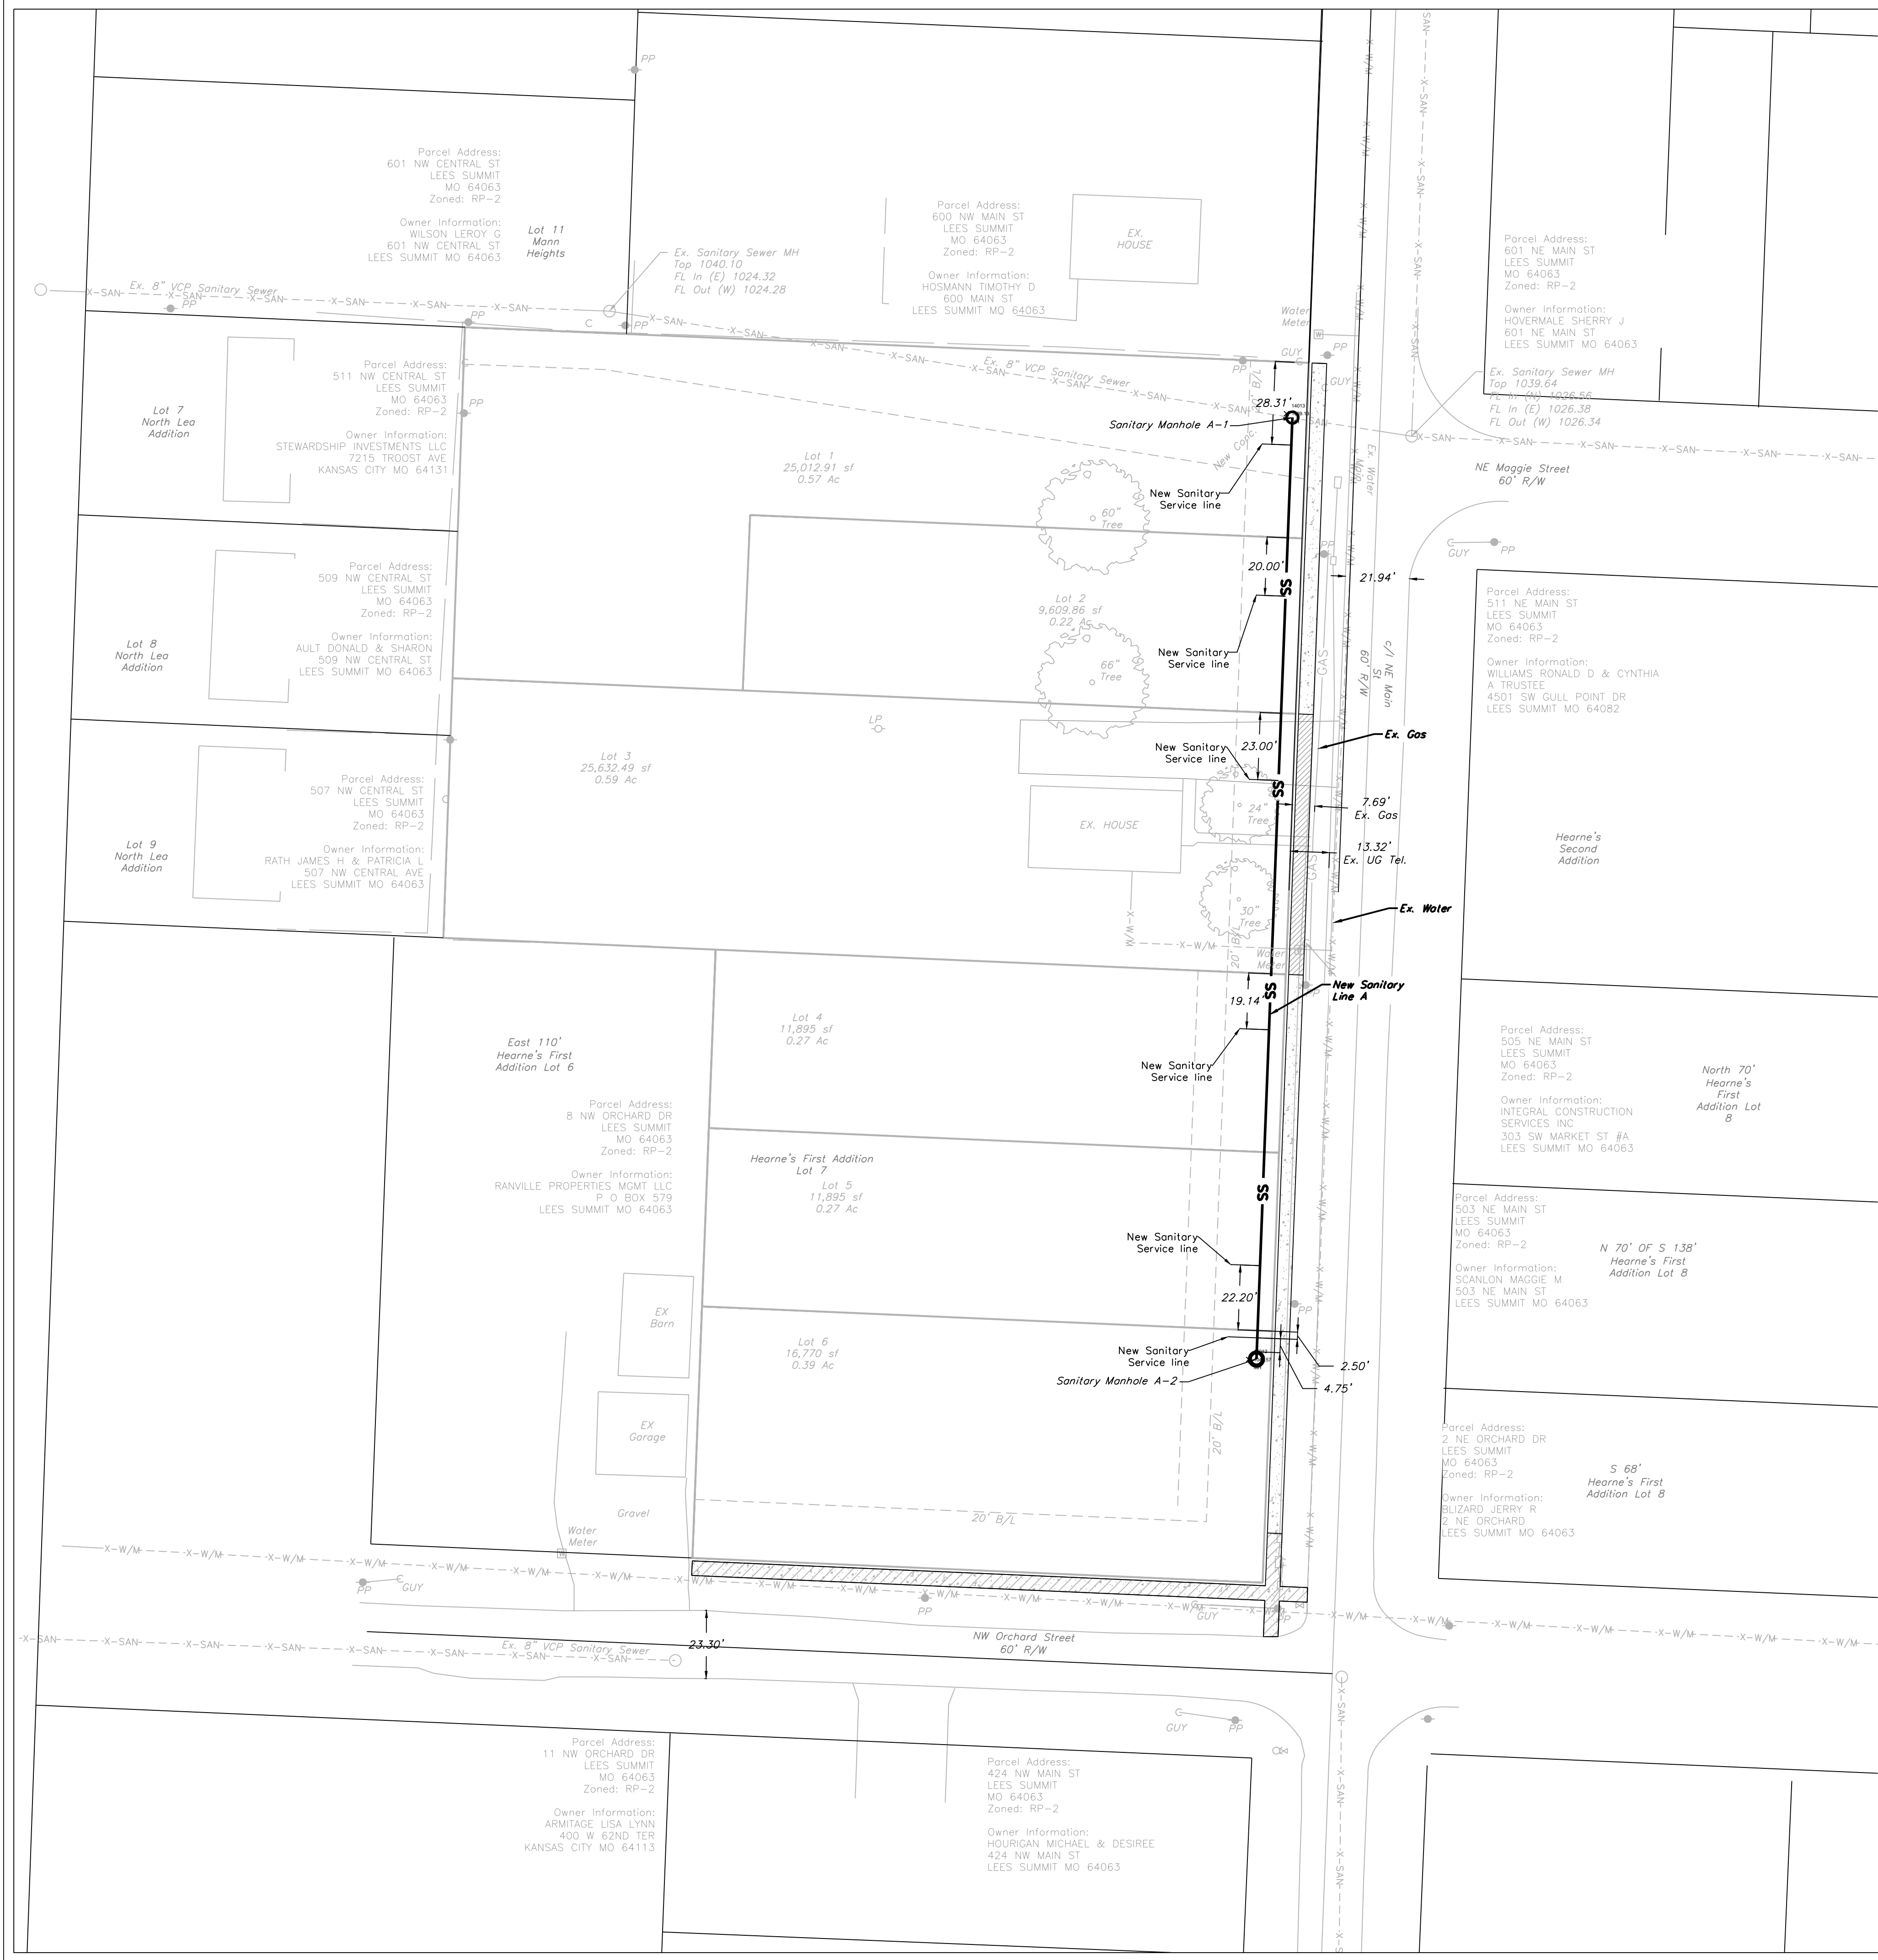


GENERAL NOTE:
1 ~ ALL CONSTRUCTION SHALL CONFORM TO THE CITY OF LEE'S SUMMIT DESIGN AND CONSTRUCTION MANUAL AS ADOPTED BY ORDINANCE 5813.
2 ~ TRENCH CHECKS SHALL BE INSTALL AT ALL SANITARY WYES LOCATION.

Existing Underground Power	—UGP— UGP—
Existing Conc. Curb & Gutter	=====
Existing Fence	—X— X— X—
Existing Gas Main	— G — G —
Existing Water Main	—X-W/M— —X-W/M—
Existing Storm Sewer	—X-STM— —X-STM—
Existing Sanitary Sewer	—X-SAN— —X-SAN—
Existing Underground Telephone	—UGT— UGT—
Existing Overhead Power	—OHE—
Existing Fiber Optic Cable	—FOC—
Proposed Storm Sewer	—ST— ST— ST—
Proposed Sanitary Sewer	—SS— SS— SS—
Proposed Water	—W— W— W—

"AS-BUILT"
900.10
~~900.00~~ Indicates data replaced with "As-Built" information. All other data is as designed and has not been field verified.

ENGINEERING
ENGINEERING & SURVEYING
SOLUTIONS

50 SE 30TH STREET
LEE'S SUMMIT, MO 64082
P: (816) 623-9888 F: (816) 623-9849

Professional Registration
Missouri
Engineering 2005002186-D
Surveying 2005008319-D
Kansas
Engineering E-1695
Surveying LS-218
Oklahoma
Engineering 6254
Nebraska
Engineering CA2821

MAIN ORCHARD
Section 6, Township 47 North, Range 31 West
Lee's Summit, Jackson County, Missouri



Project: 510 NW MAIN ST
LS MO
Issue Date: December 11, 2019

Sanitary Sewer General Layout
Construction Plans for:
MAIN ORCHARD
Section 6, Township 47 North, Range 31 West
Lee's Summit, Jackson County, Missouri


Matthew J. Schlicht
MO PE 2006019708
KS PE 19071
OK PE 25226
NE PE E-14335

REVISIONS
12-27-19 City Comments
1-13-20 Revised

C. 401

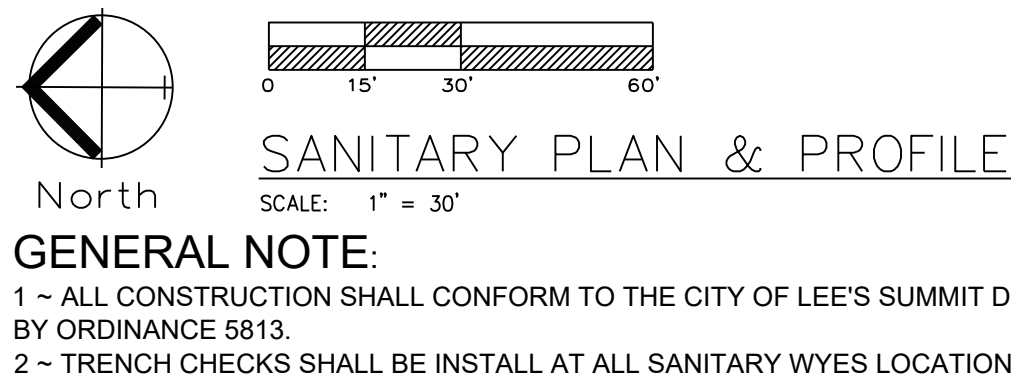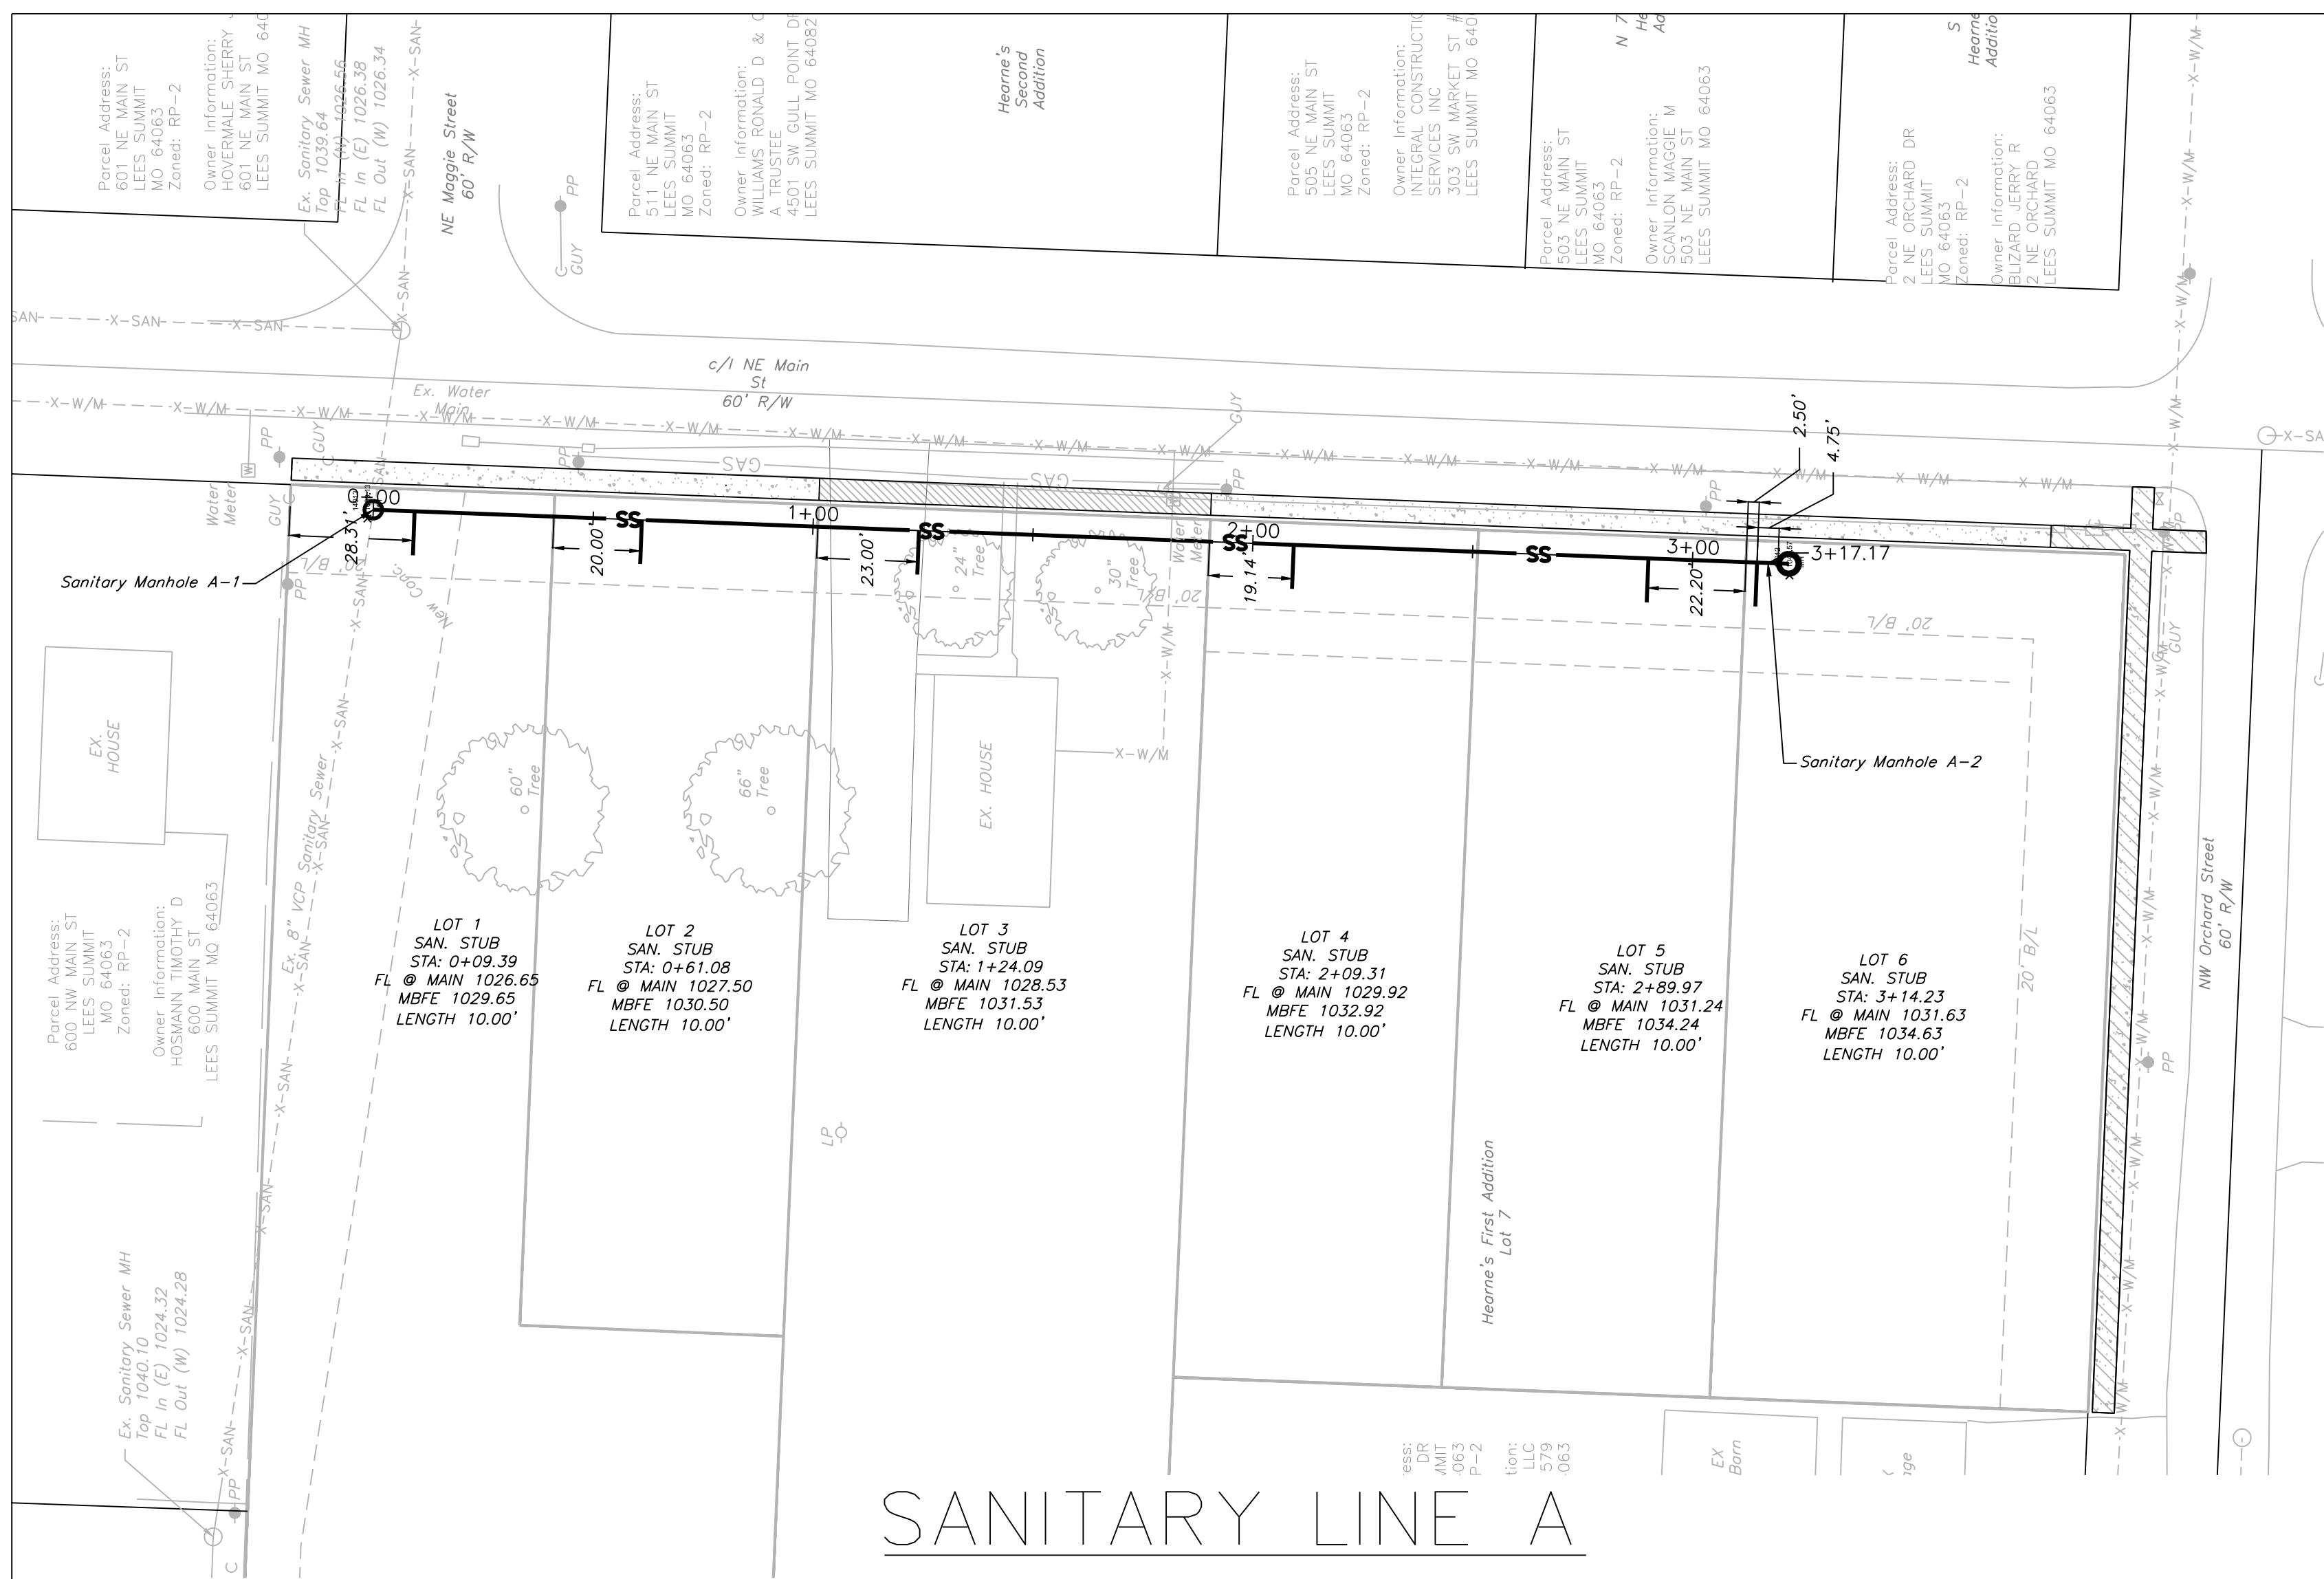


SANITARY LINE A

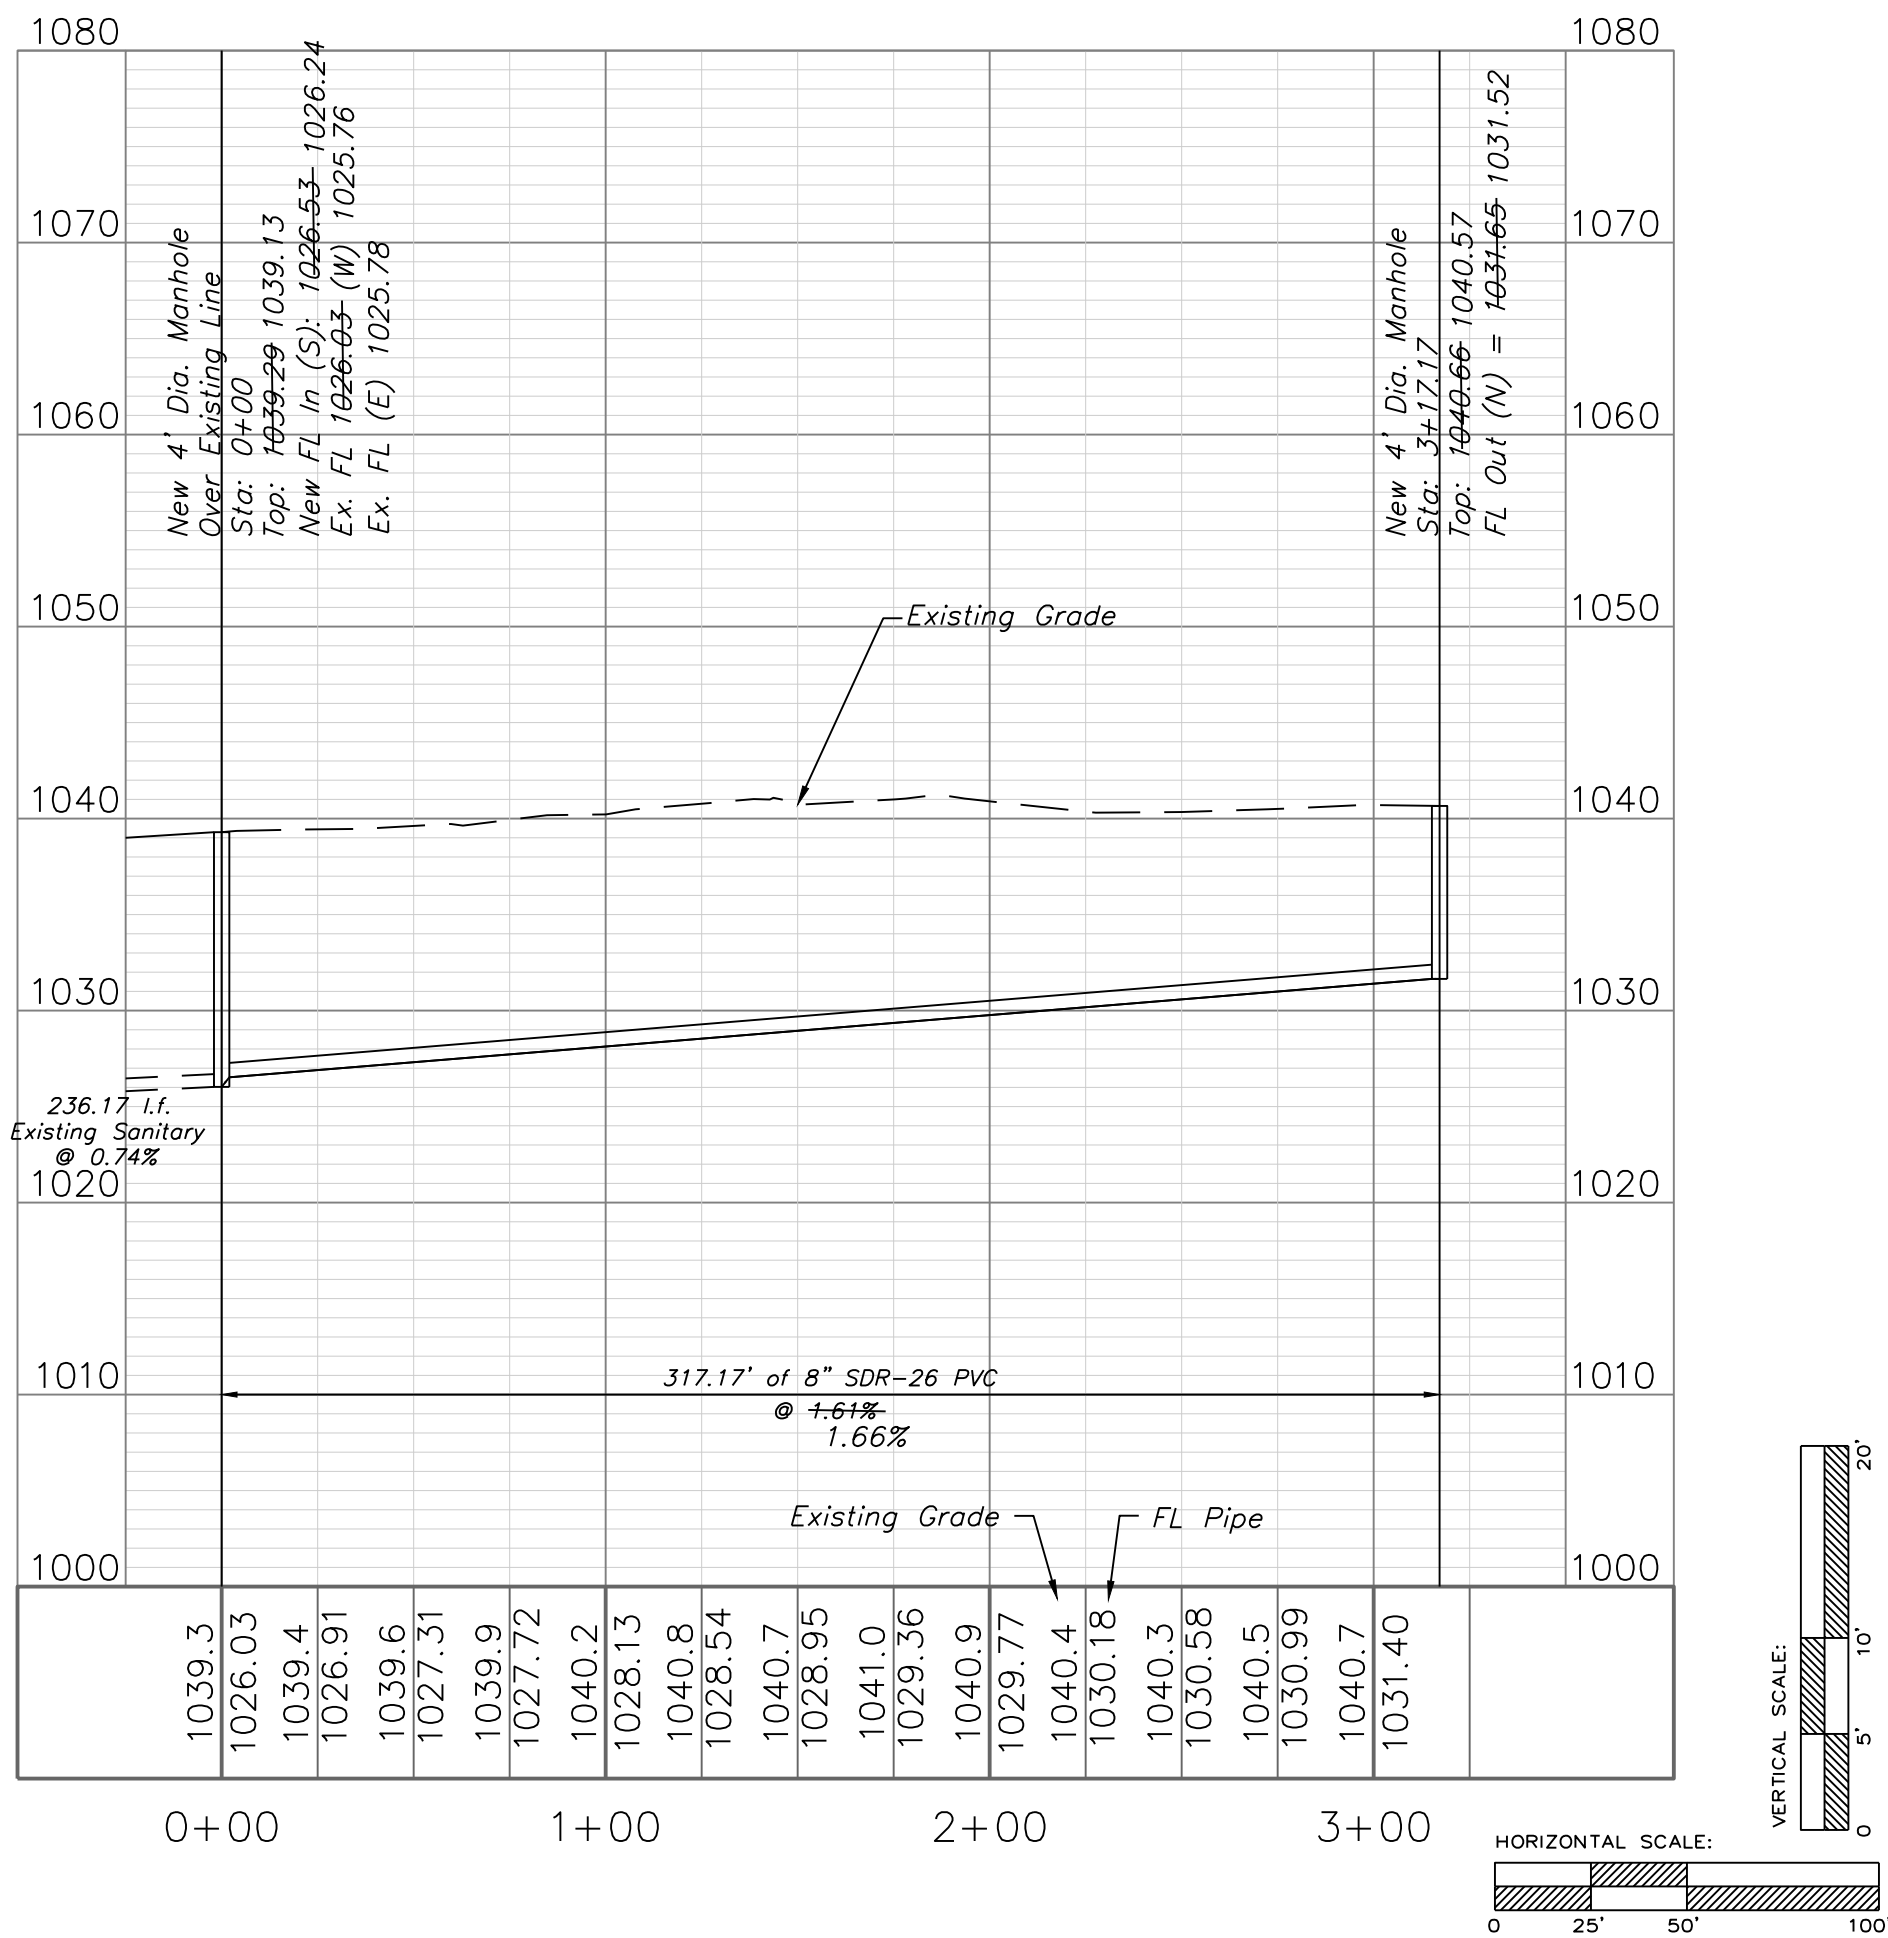

"AS-BUILT"

900.10
900.00 Indicates data replaced with "As-Built" information. All other data is as designed and has not been field verified.

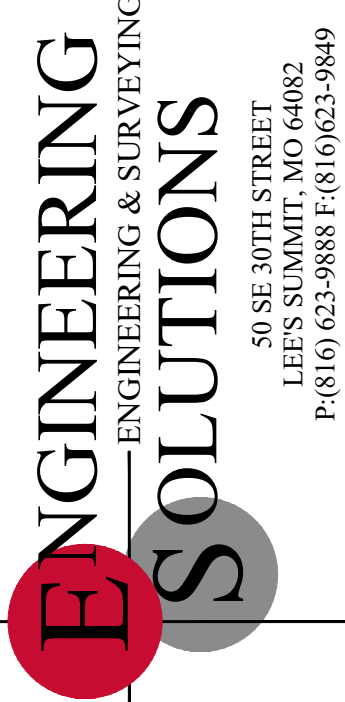

Professional Registration
Missouri
Engineering 2005002186-D
Surveying 2005008319-D
Kansas
Engineering E-1695
Surveying LS-218
Oklahoma
Engineering 6284
Nebraska
Engineering CA2821






MAIN ORCHARD
Section 6, Township 47 North, Range 31 West
Lee's Summit, Jackson County, Missouri

Project:
510 NW MAIN ST
LS MO
Issue Date:
December 11, 2019

Sanitary Plan and Profile
Construction Plans for:
MAIN ORCHARD
Section 6, Township 47 North, Range 31 West
Lee's Summit, Jackson County, Missouri

Matthew J. Schlicht
MO PE 2006019708
KS PE 19071
OK PE 25226
NE PE E-14335

REVISIONS
12-27-19 City Comments
1-13-20 Revised

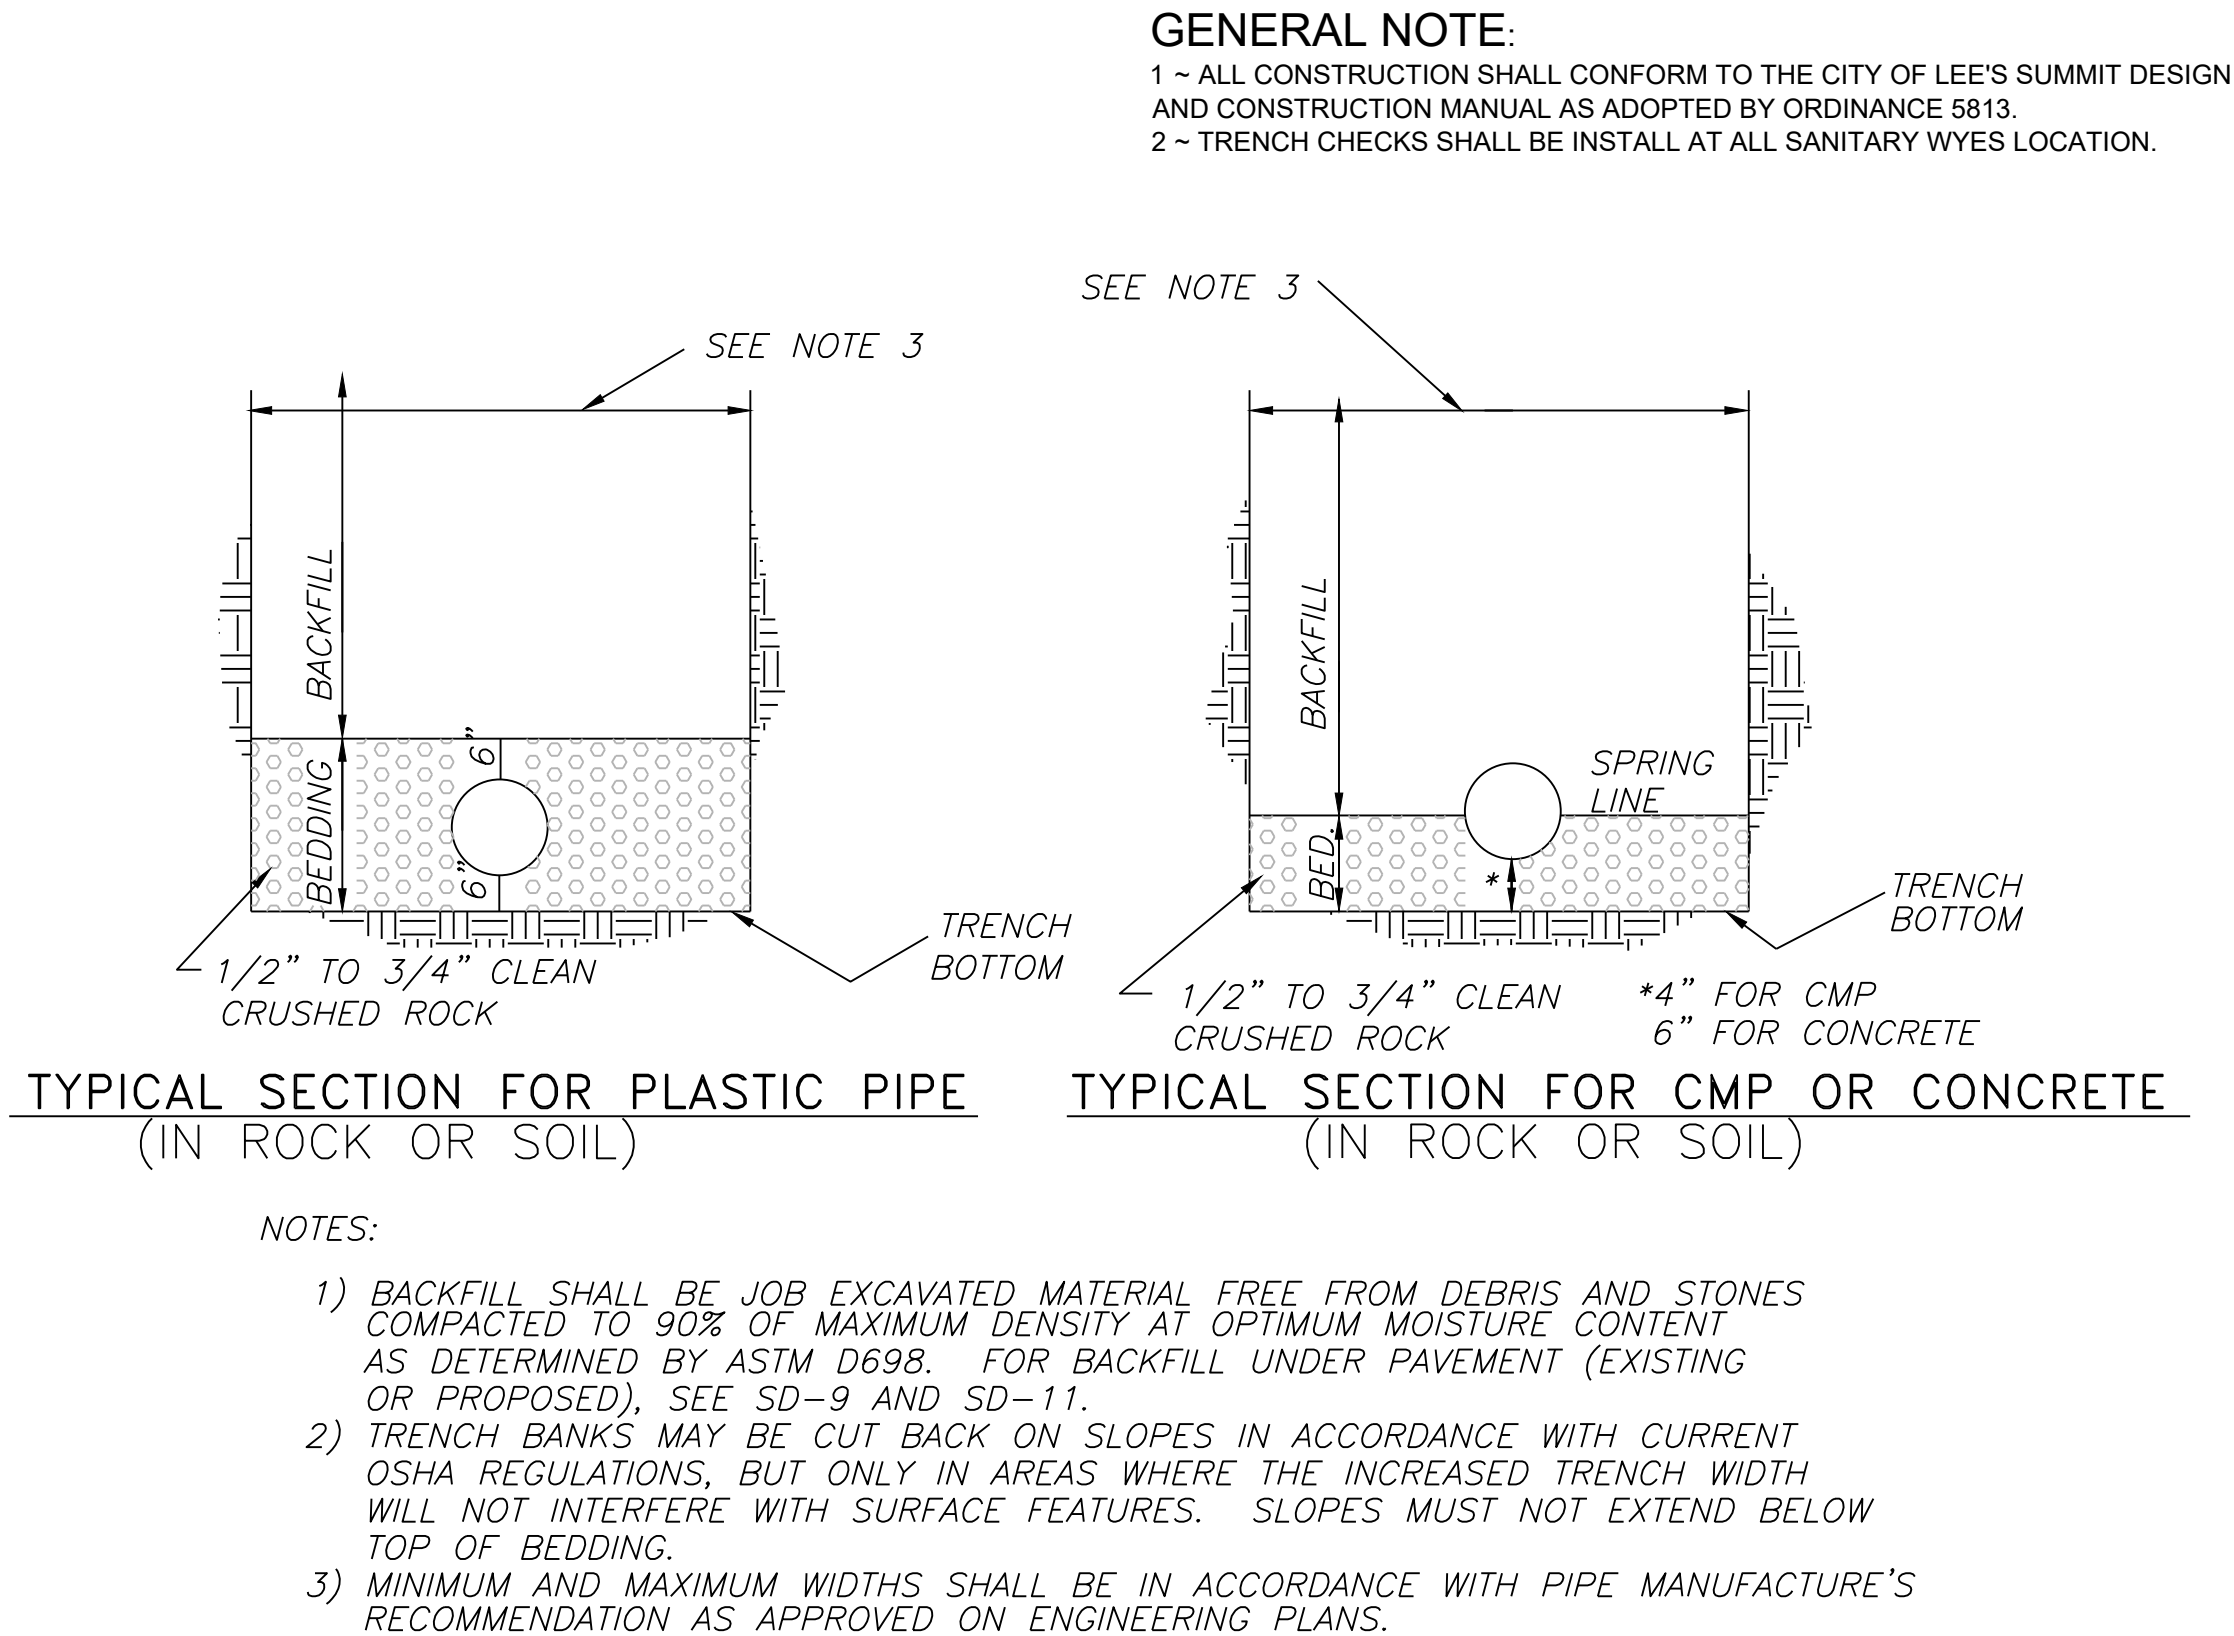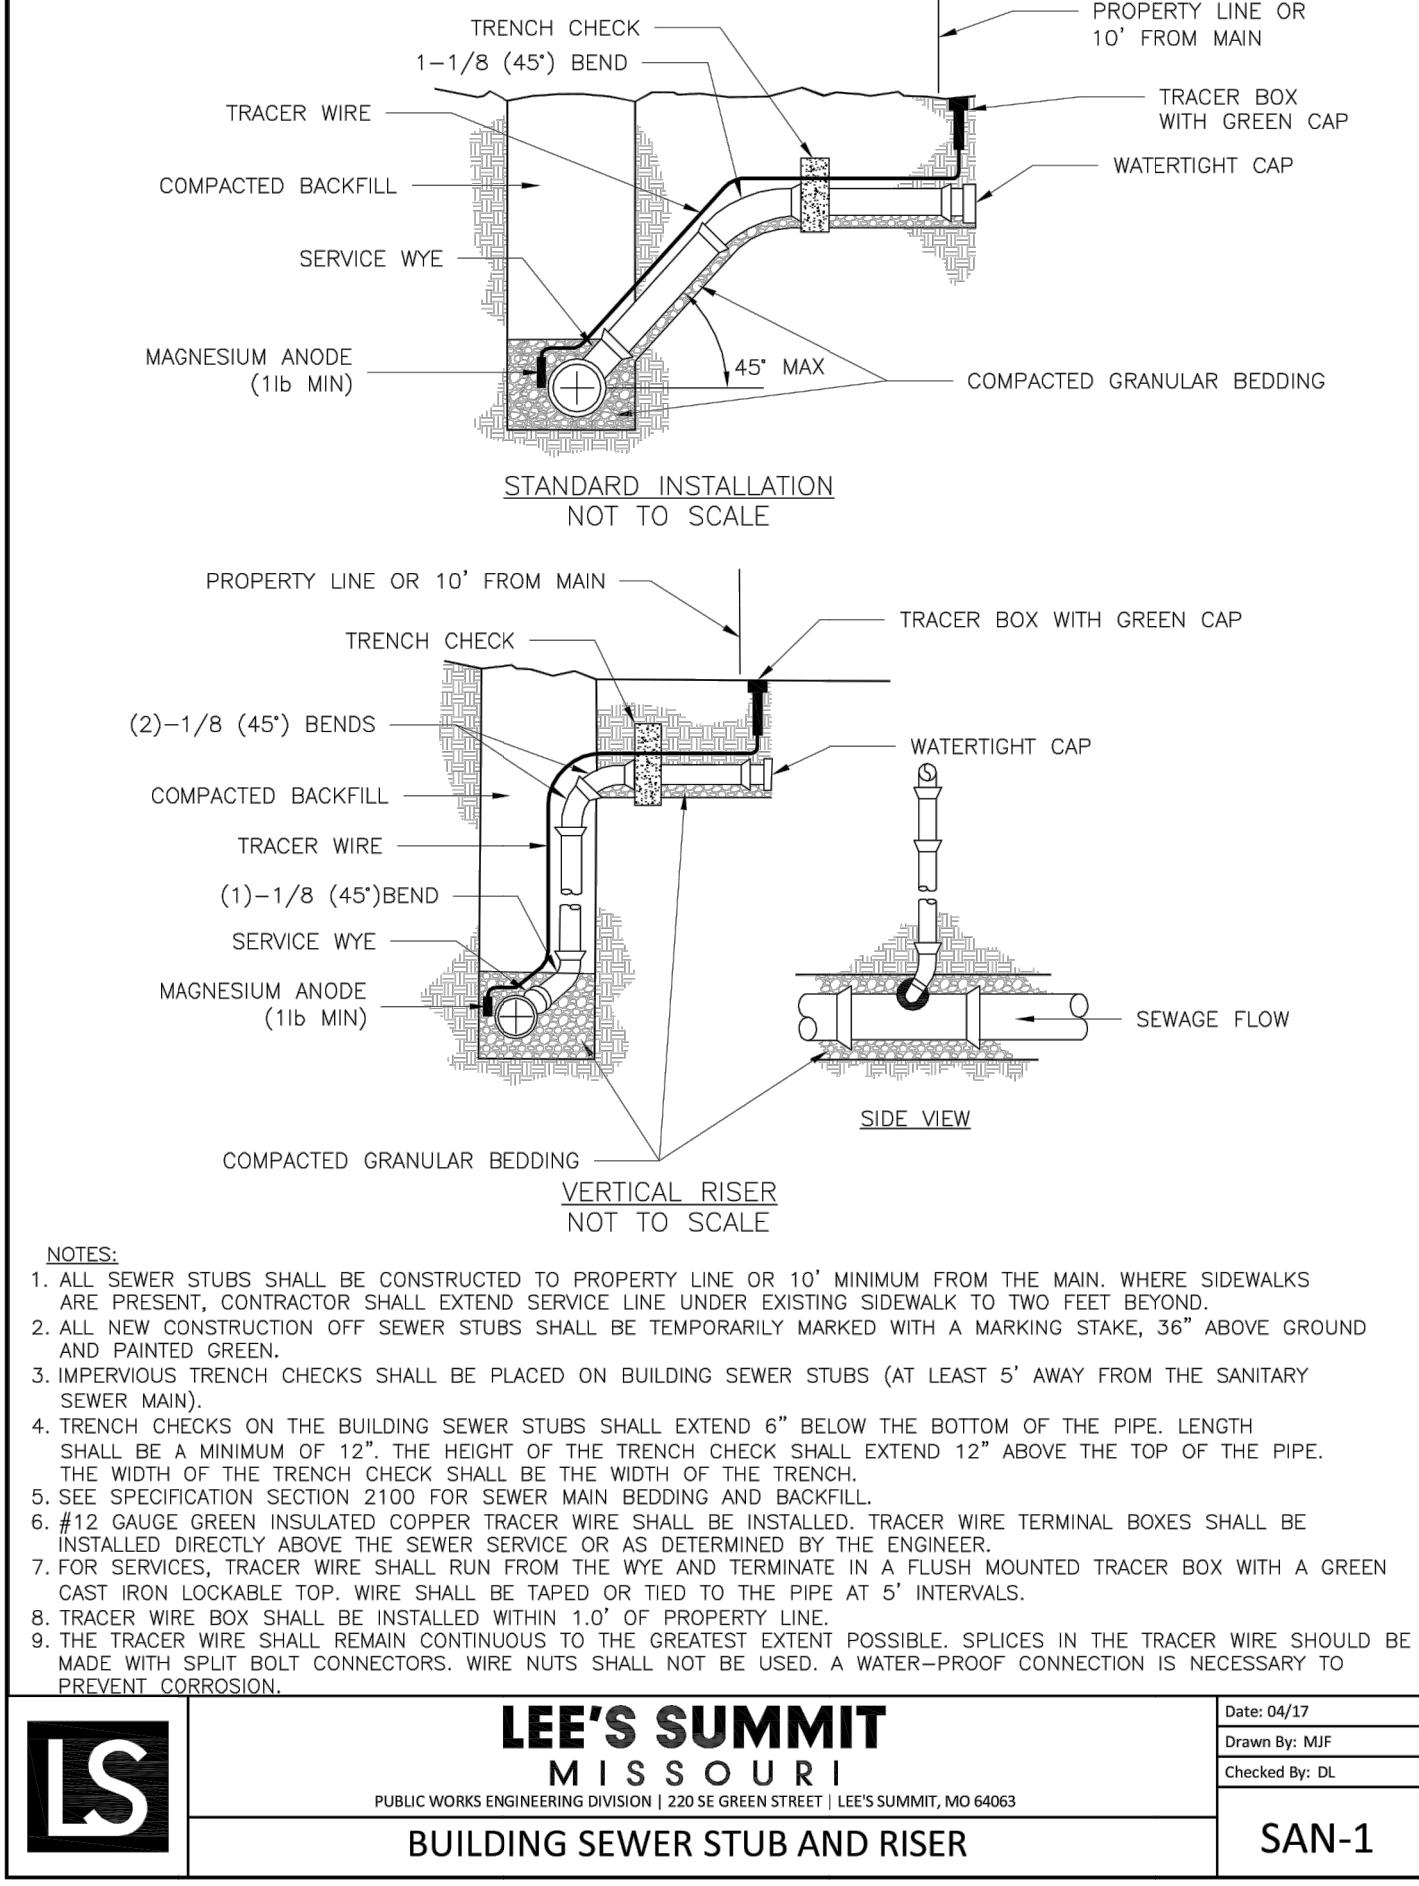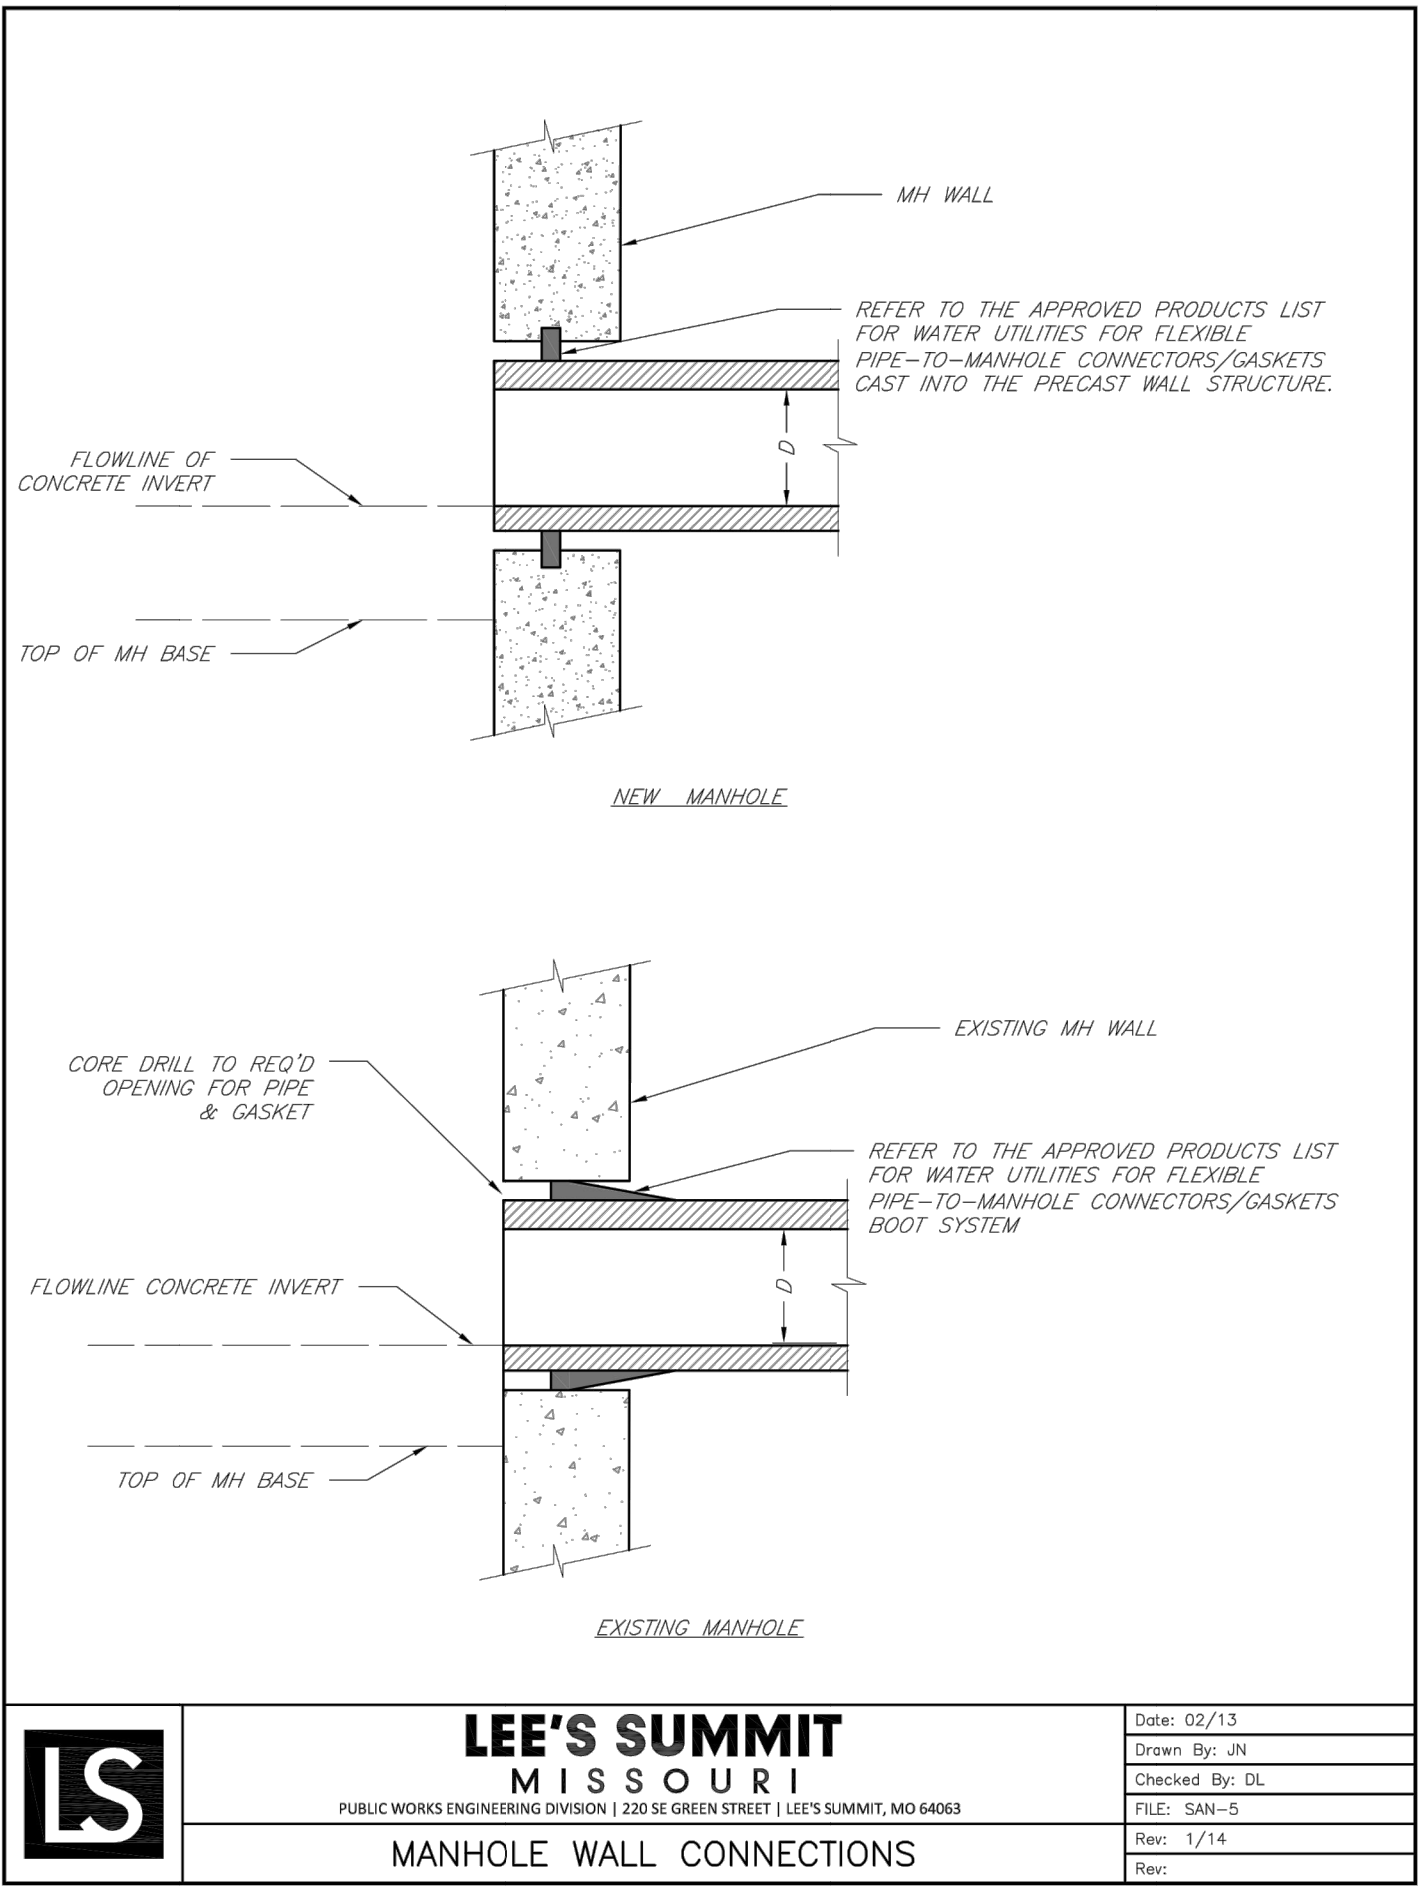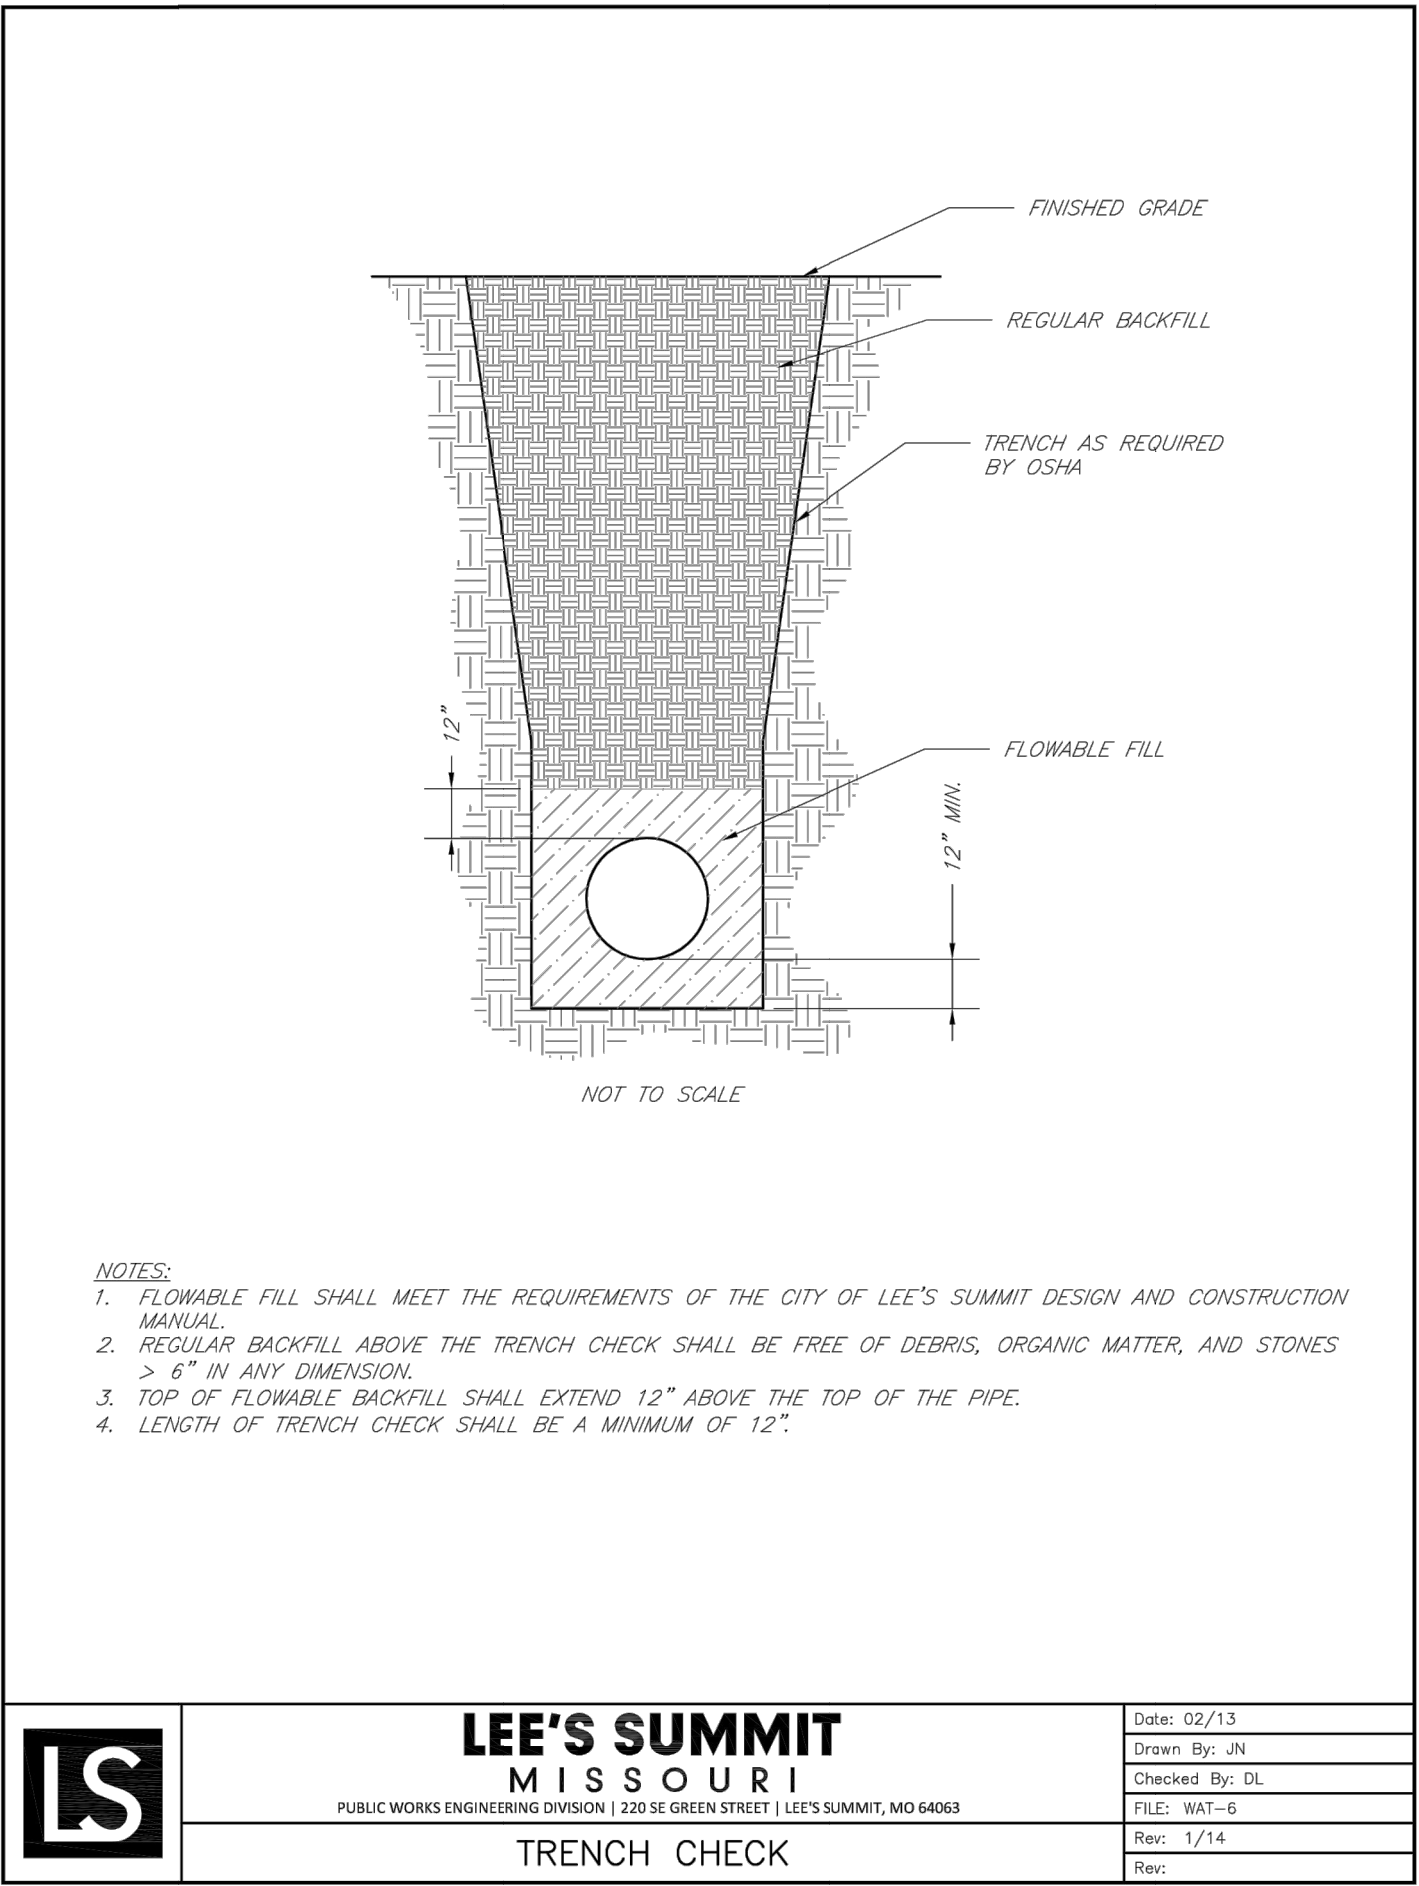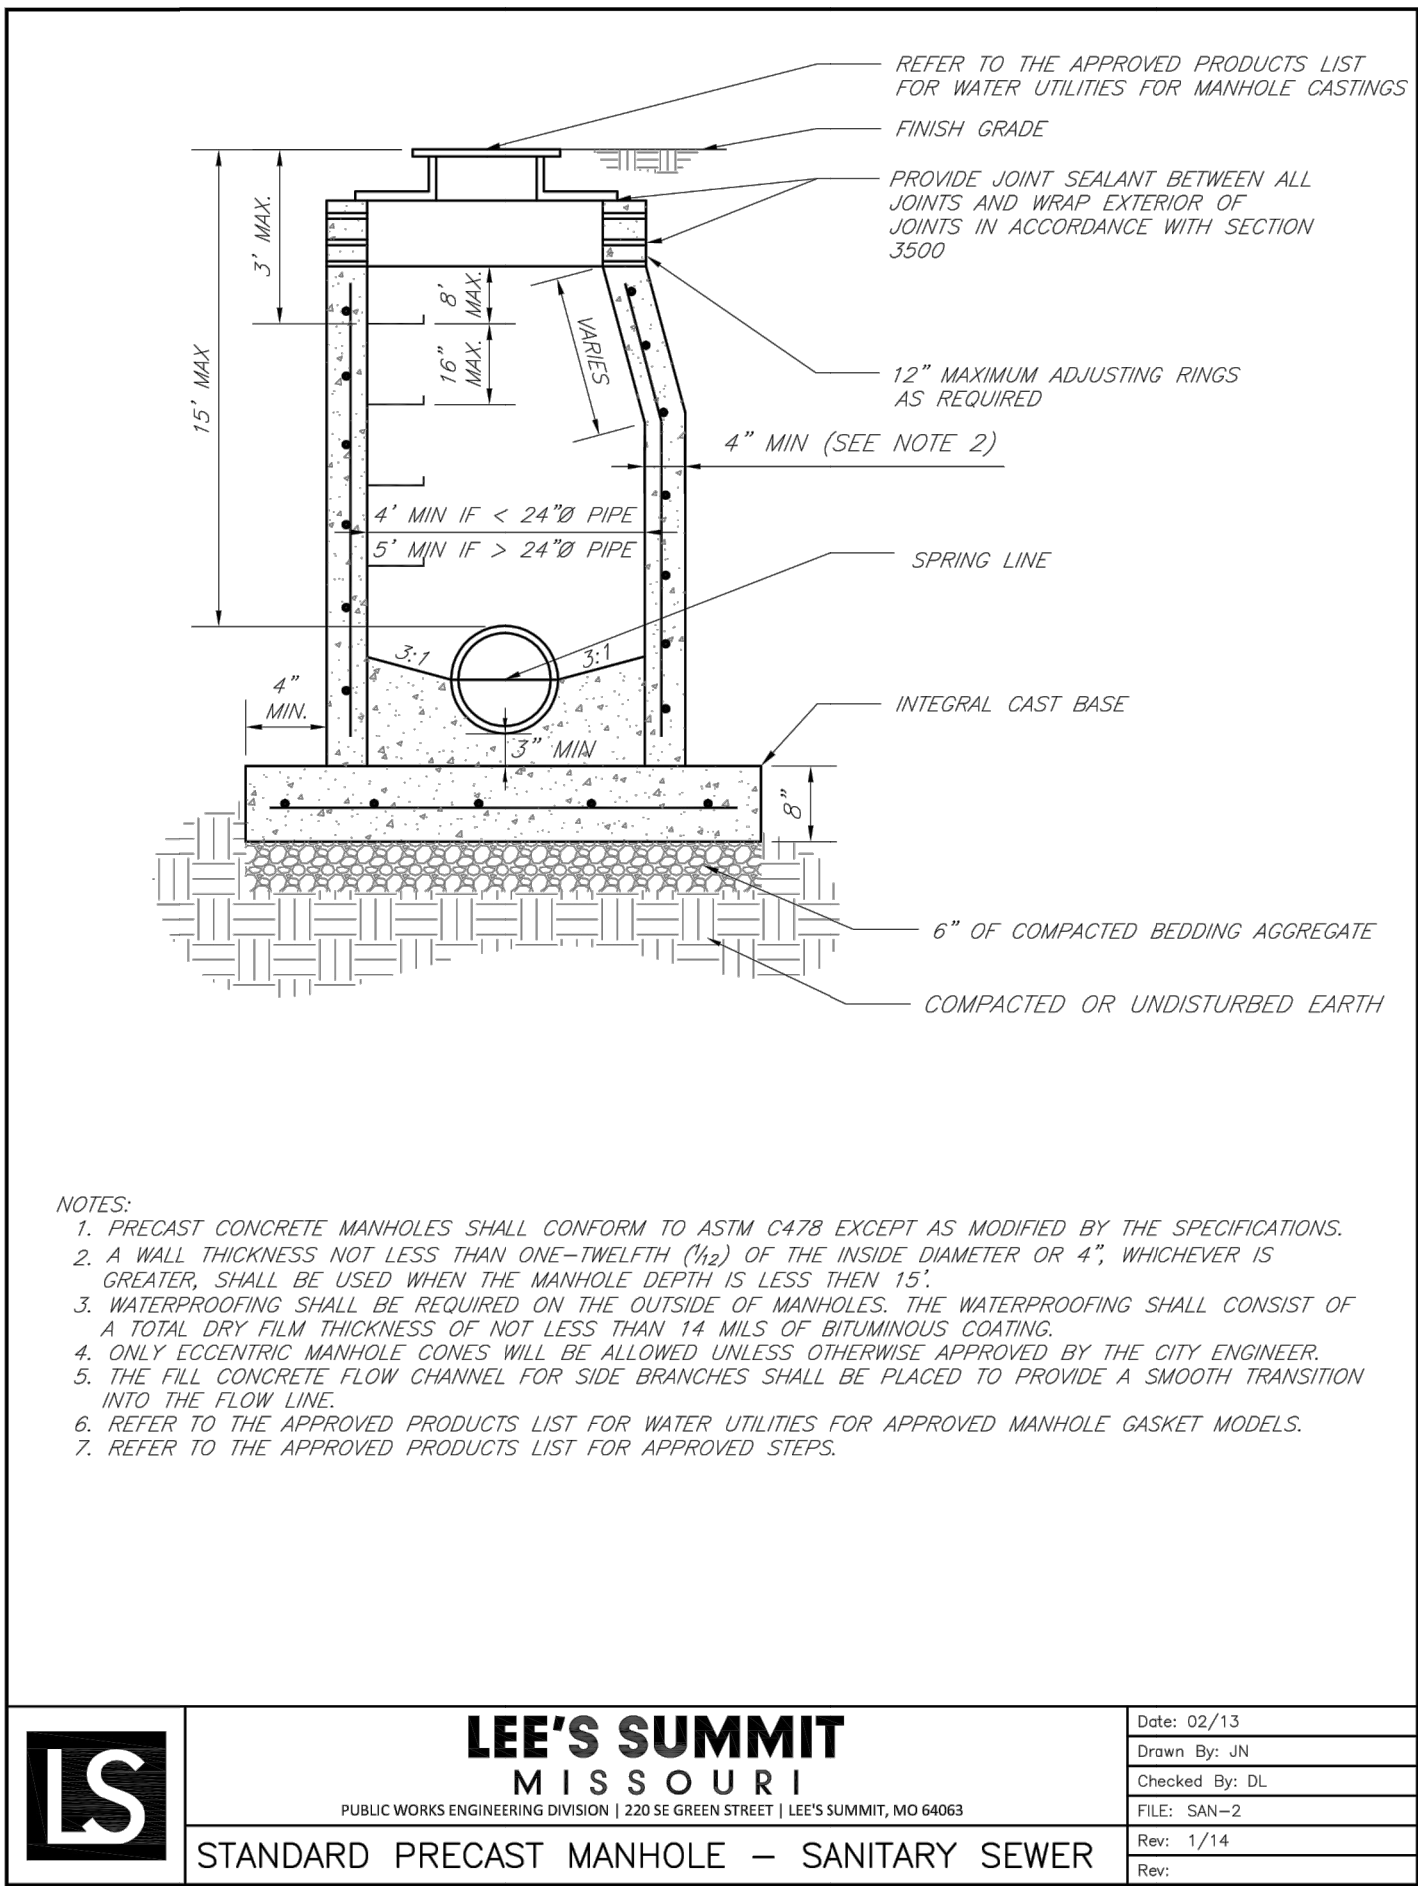

UNDERGROUND PIPE INSTALLATION

"AS-BUILT"

900.10
~~900.00~~ Indicates data replaced with "As-Built" information. All other data is as designed and has not been field verified.