


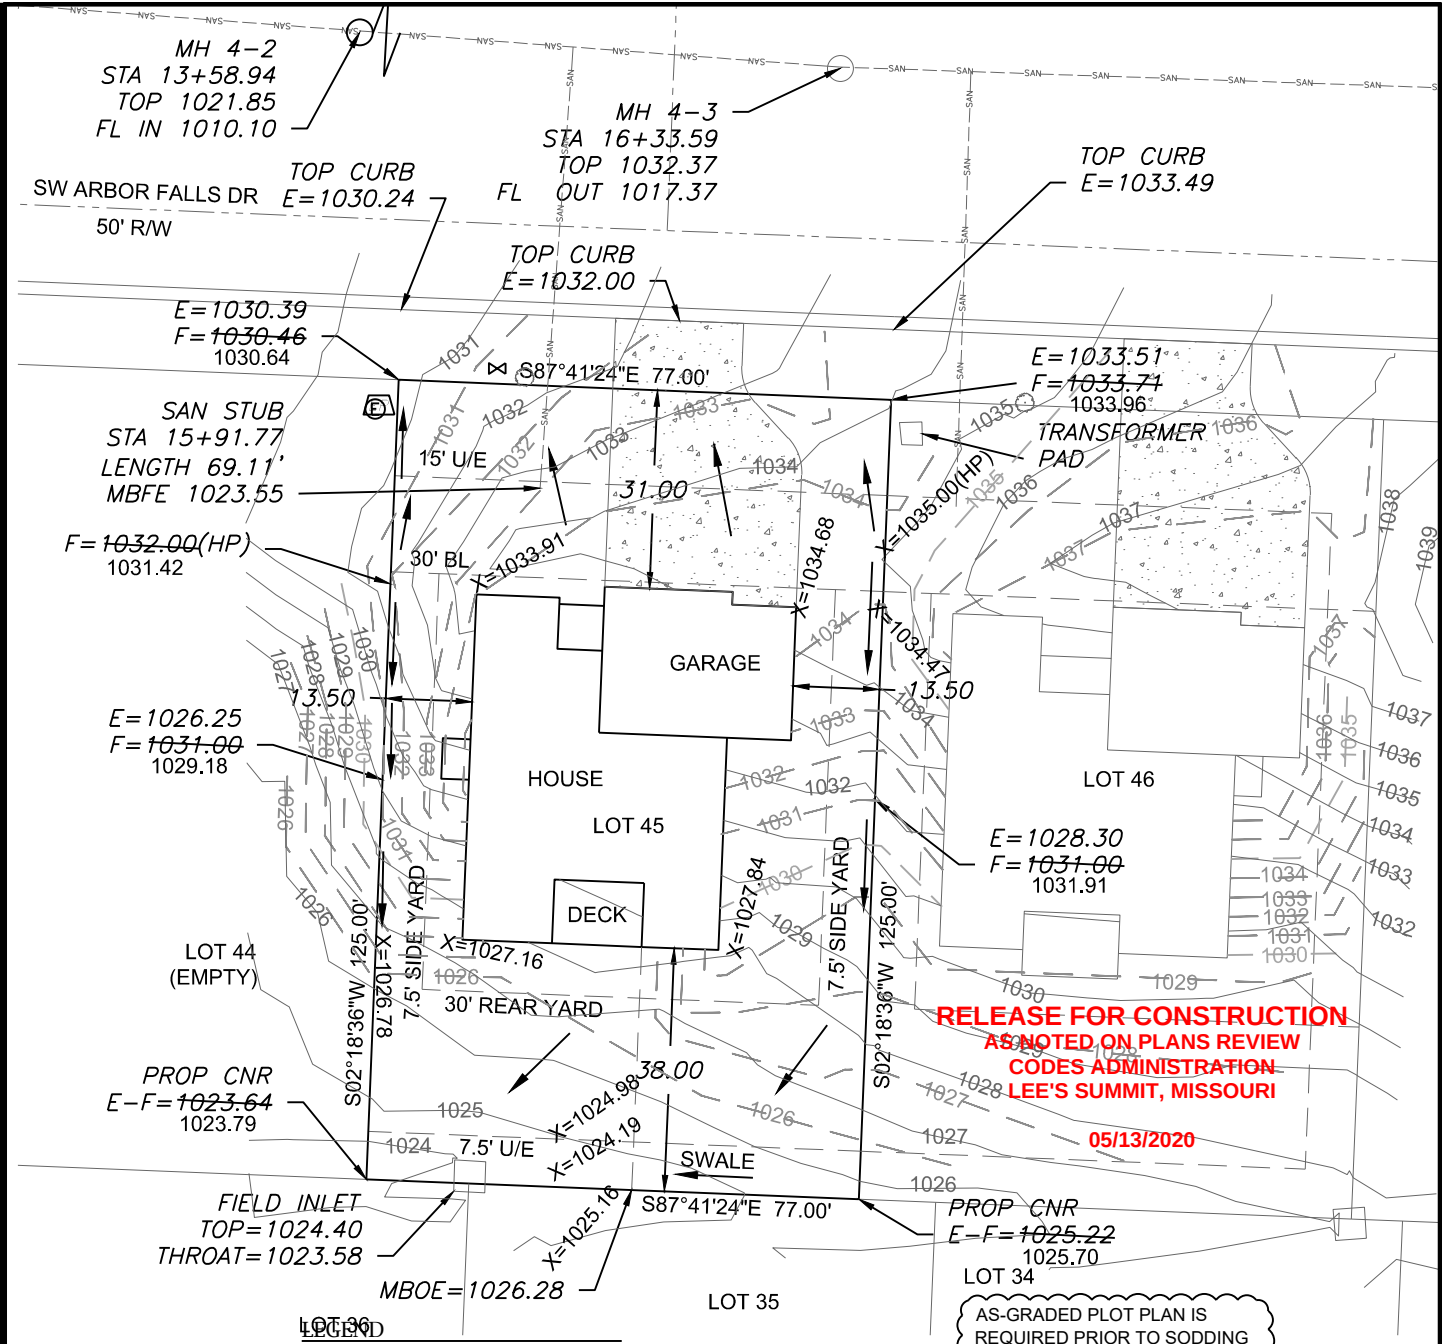

RELEASE FOR CONSTRUCTION
AS NOTED ON PLANS REVIEW
CODES ADMINISTRATION
LEE'S SUMMIT, MISSOURI
05/13/2020

AS-GRADED PLOT PLAN IS
REQUIRED PRIOR TO SODDING

LEGEND

- Gas Meter
- Telephone or Fiber-Optic Pedestal
- Cable TV Pedestal
- Electric Pedestal
- Light Pole
- Mailbox
- Fire Hydrant
- Water Valve

PROPOSED HOUSE

TOP FOUNDATION = 1036.05
GARAGE FLOOR = 1034.55
TOP FOOTING = 1027.05
BASEMENT FLOOR = 1027.38

E = EXISTING ELEVATION
F = PROPOSED FINAL ELEVATION
G = ADJACENT GRADE AT EGRESS
U/E = UTILITY EASEMENT
B/L = BUILDING LINE
S/Y/S = SIDE YARD SETBACK
R/Y/S = REAR YARD SETBACK

NOTES


1. BUILDER TO VERIFY ALL BUILDING ELEVATIONS AND DIMENSIONS.
2. THIS PLOT PLAN DOES NOT CONSTITUTE A BOUNDARY SURVEY.
3. THE EASEMENTS SHOWN ON THIS PLOT PLAN ARE TAKEN FROM THE FINAL PLAT. OTHER EASEMENTS MAY EXIST.

DRIVEWAY SLOPE = 7.4%

EXTENDED LOT AREA = 10,472.0 SQFT
DRIVEWAY APPROACH = 221.75 SQFT
DRIVEWAY AREA = 908.25 SQFT
SIDEWALK AREA = N/A

PROPOSED CONTOURS
AS-GRADED CONTOURS
X-###.## = Actual asbuilt ground shots taken on May 1, 2020.

Contours shown are asbuilt.

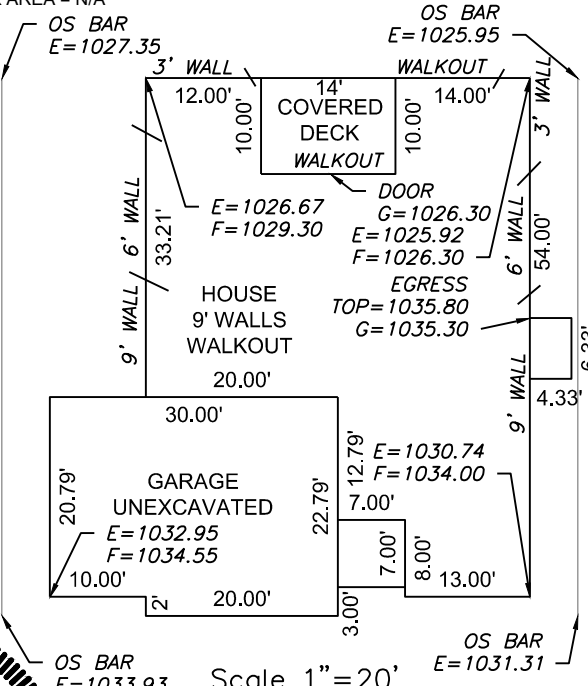

MH 4-2
STA 13+58.94
TOP 1021.85
FL IN 1010.10

MH 4-3
STA 16+33.59
TOP 1032.37
FL OUT 1017.37

TOP CURB
E=1033.49

SW ARBOR FALLS DR
50' RW
TOP CURB
E=1030.24

TOP CURB
E=1032.00

E=1030.39
F=1030.46
1030.64

SAN STUB
STA 15+91.77
LENGTH 69.11'
MBFE 1023.55

F=1032.00(HP)
1031.42

E=1026.25
F=1031.00
1029.18

LOT 44
(EMPTY)

PROP CNR
E-F=1023.64
1023.79

FIELD INLET
TOP=1024.40
THROAT=1023.58

MBOE=1026.28

LOT 35

PROP CNR
E-F=1025.22
1025.70

LOT 34

LOT 46

E=1028.30
F=1031.00
1031.91

LOT 36

LOT 37

LOT 38

LOT 74

LOT 75

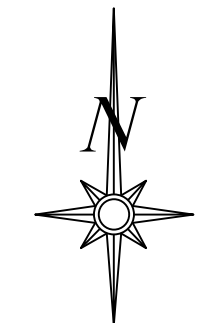

Scale 1"=30'

LOT INFORMATION

9,625 SQ. FT.
MBOE =1027.07 (LT)
MBOE =1025.36 (RT)
MBFE =1023.55
ADDRESS
1515 SW ARBOR FALLS DRIVE


LEGAL DESCRIPTION

LOT 45, HAWTHORNE RIDGE 1ST PLAT, A SUBDIVISION AS RECORDED IN LEE'S SUMMIT, JACKSON COUNTY, MISSOURI.

ENGINEERING & SURVEYING
SOLUTIONS

50 SE 30TH STREET
LEE'S SUMMIT, MO 64082
P:(816) 623-9888 F:(816)623-9849
WWW.ENGINEERINGSSOLUTIONKCC.COM

THIS DRAWING IS NOT VALID UNLESS THE SIGNATURE, DATE AND SEAL OF THE ENGINEER WHO SUPERVISED THE PREPARATION OF THIS DRAWING HAS BEEN AFFIXED HERETO.

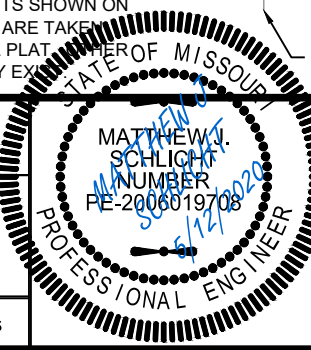

AS-GRADED PLOT PLAN - LOT 45

HAWTHORN RIDGE 1ST PLAT
LEE'S SUMMIT, JACKSON COUNTY, MISSOURI

SUMMIT HOMES
120 SE 30TH ST
LEE'S SUMMIT, MO 64082

PROJECT NO.	FILE NAME	DATE	SHEET	OF
1	LOT 45 & 46, HAWTHORN RIDGE	8/9/19	1	1