
## INTERIOR TENANT IMPROVEMENT 910-W NORTHWEST BLUE PARKWAY, LEE'S SUMMIT, MO 64086

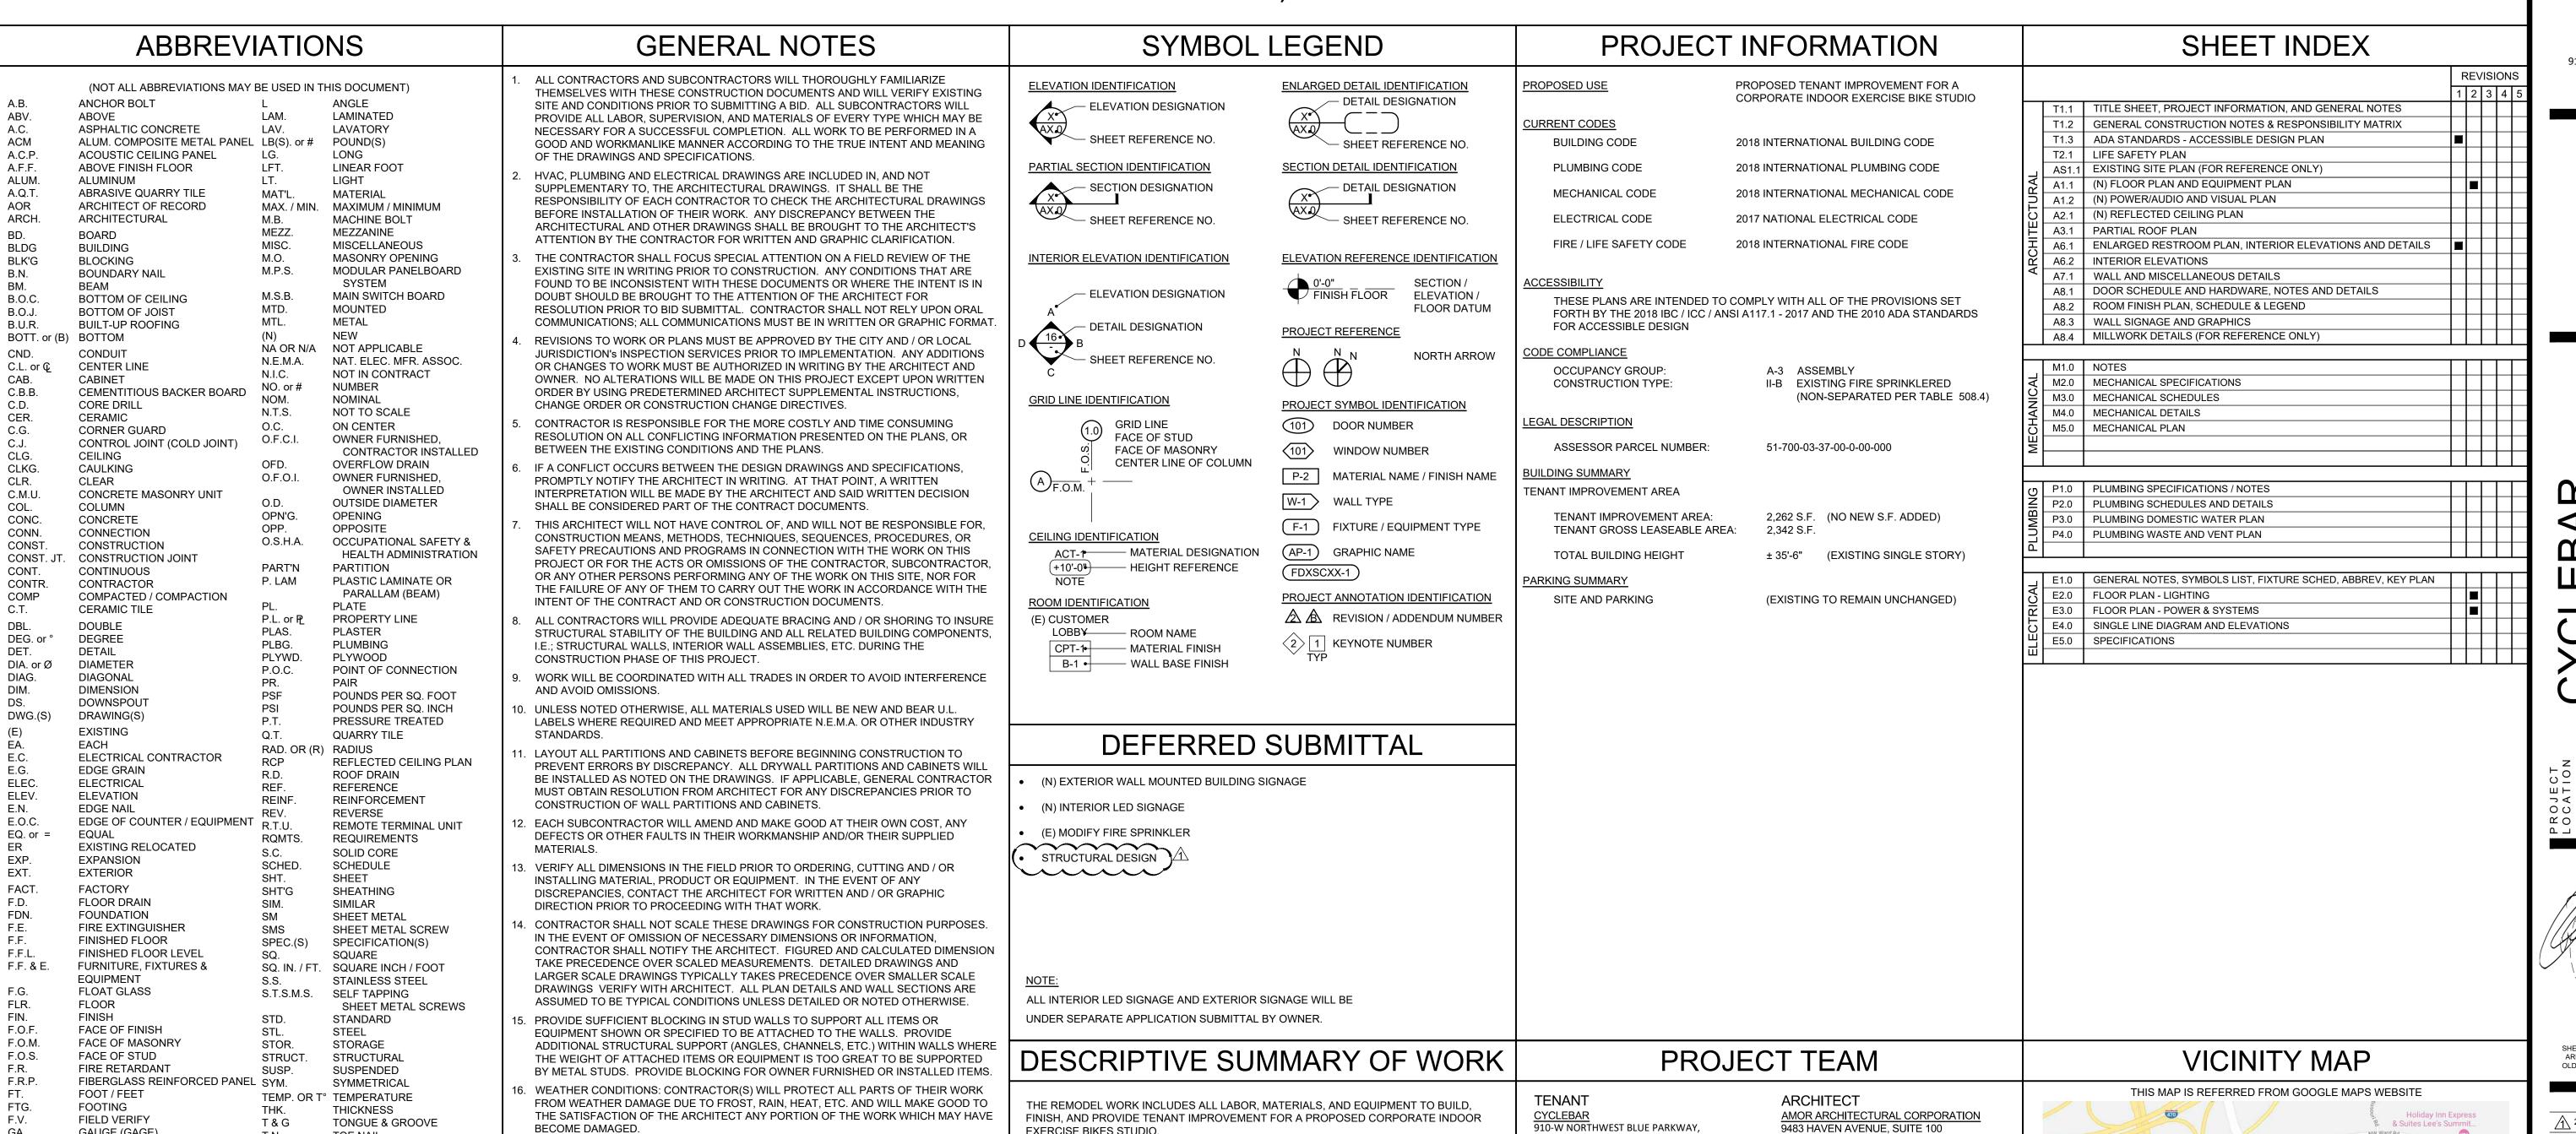

LEE'S SUMMIT, MO 64086

PHONE: 720.378.3062

& ELECTRICAL

PHONE:

EMAIL:

DUNHAM ENGINEERING

MINNEAPOLIS, MN 55402

CONTACT: RACHEL HILTON

EMAIL: rachel.hilton@cyclebar.com

MECHANICAL, PLUMBING

50 SOUTH STREET, SUITE 1100

CONTACT: CULLEN MURTAUGH

(612) 465-7550

(612) 465-7551

PROJECT MANAGER

Cullen.Murtaugh@dunhameng.com

RANCHO CUCAMONGA, CA 91730

(909) 259-9971

(909) 944-8409

PROJECT MANAGER

jreynoso@amorarch.com

kenny@spsurfacing.org

michael@crowdtunes.com

Starbucks 😝

9921 CARMEL MOUNTAIN ROAD, SUITE 248

CONTACT: MICHAEL CASSARA

PHONE: (310) 775-5242

CONTACT: JOSE REYNOSO

APPROVED VENDOR

SPORTS PRO SURFACING

CONTACT: KENNY FLAKE

PHONE: (713) 805-8296

SAN DIEGO, CA 92129

EMAIL:

EMAIL:

EXERCISE BIKES STUDIO.

**NEW FIXTURES** 

**NEW PARTITION WALLS** 

COORDINATION AND INSTALLATION INCLUDED.

(E) RESTROOM ADD (N) FINISHES

NEW FINISHES (PAINT, FLOORING, GRAPHICS, ETC.)

THE WORK SHALL INCLUDE ALL ITEMS REQUIRED AS SHOWN ON THE DRAWINGS.

ALL MECHANICAL EQUIPMENT AND SYSTEMS, ALL ELECTRICAL SYSTEMS, AND

EQUIPMENT ARE TO BE INCLUDED FOR A COMPLETE OPERATING SYSTEM WITH



Architectura Corporation

RANCHO CUCAMONGA, CA 91730

P. 909.259.9971 | F. 909.944.8409 www.AmorArch.com WEST COAST | CENTRAL | EAST COAST



910-W NORTHWEST BLUE PARKWAY, LEE'S SUMMIT. MO 64086 PHONE: 720.378.3062 rachel.hilton@cyclebar.com

CONSULTANT

 $\mathbb{C}$ STAMP AMOR NUMBER A-2012004034

SHEETS BEARING THIS SEAL AND WET SIGNATURE ARE AUTHENTICATED. RESPONSIBILITY FOR ALI OLDER PLANS, SPECIFICATIONS OR INSTRUMENTS

REVISIONS 2020-04-13 PLAN CHECK CORRECTION 2020-05-26 FIELD COORDINATION DATE 2020.05.29 PROJECT NUMBER A2276

ue Parkway

FLASHED IN SUCH A MANNER AS TO MAKE THEM WATERPROOF.

FLUSH AND OCCUR AT CENTERLINE OF DOORS TYPICALLY.

. SITE SAFETY: EACH CONTRACTOR WILL ABIDE BY LOCAL AREA STANDARDS AND

RELATED O.S.H.A. STANDARDS FOR THE PROTECTION AND SAFETY FOR THEIR

PRE / ACTUAL / POST CONSTRUCTION PHASES OF THIS PROJECT.

END OF EACH WORKING DAY.

PAINT (UNLESS NOTED OTHERWISE).

EMPLOYEES ON SITE. THIS ARCHITECT WILL BE HELD HARMLESS BY CYCLEBAR AND

GENERAL CONTRACTOR AND RELATED AWARDED TRADES ON THIS PROJECT FOR

ACCIDENTS OR INJURIES CAUSED OR ACCRUED ON THIS PROPERTY DURING THE

CONTRACTORS WILL BE RESPONSIBLE FOR REMOVAL AND ACCOUNT FOR QUANTITY

19. TRANSITION OF DIFFERENT FLOORING MATERIALS AT DOORWAYS SHALL SHALL BE

20. PAINT ALL WALL SURFACES, DOOR FRAMES, WINDOW FRAMES, BULKHEADS AND

OF DEBRIS ACCUMULATED BY EACH TRADE. HOWEVER, EACH TRADE WILL KEEP THE

CEILINGS IN ROOMS WHERE INDICATED ON ROOM FINISH SCHEDULE. PAINT BEHIND

ALL MOVEABLE ITEMS ADJACENT TO WALLS RECEIVING PAINT AND RELOCATE ITEMS.

ALL NEW PAINTING SHALL INCLUDE (1) ONE COAT PRIMER AND (2) TWO COATS OF

21. ALL WEATHER - EXPOSED SURFACES SHALL HAVE A WEATHER RESISTIVE BARRIER TO

PROTECT THE INTERIOR WALL COVERING AND EXTERIOR OPENINGS SHALL BE

JOB SITE CLEAN AND SAFE AT ALL TIMES, ALONG W/ A BROOM / VACUUM FINISH AT THE

GAUGE (GAGE)

**GYPSUM WALLBOARD** 

**GENERAL CONTRACTOR** 

**GLUE-LAMINATED BEAM** 

GRAB BAR

GALVANIZED

**HOSE BIBB** 

**HUB DRAIN** 

**HARDWARE** 

HEADER

HANGER

H HORIZONTAL

IN EXAMPLE

INSULATION

INTERIOR

**INVERTED** 

JOINT

**JOIST** 

INCH / INCHES

HEIGHT

HDR.

HDW.

HGR.

HGT. or H

HORIZ.

INSUL

JT. OR JNT.

**HOLLOW CORE** 

**HOLLOW METAL** 

**INSIDE DIAMETER** 

HIGH STRENGTH BOLT

GALVANIZED IRON

T.N.

T.O.B.

T.O.C.

T.O.F.

T.O.P.

T.O.PL.

T.O.S.

T.O.W.

U.N.O.

T.S.

TYP.

U.L.

V.I.F.

V.T.R.

V.W.C.

W/C

WD.

W.R.

WT.

WWF.

WWM.

W/ or W/O

TOE NAIL

TOP OF BEAM

TOP OF CURB

TOP OF FOOTING

TOP OF PARAPET

TOP OF SHEATHING

VERIFY IN FIELD

WITH, WITHOUT

WATER CLOSET

WATER HEATER

WATER RESISTANT

WELDED WIRE FABRIC

WELDED WIRE MESH

WALK-IN BOX

WOOD

WEIGHT

VENT THROUGH ROOF

VINYL WALL COVERING

UNLESS NOTED OTHERWISE

UNDERWRITERS LABORATORY

TOP OF PLATE

TOP OF SLAB

TOP OF WALL

TYPICAL

VERT. OR (V) VERTICAL

50'-9 1/2"

(E) ADJACENT TENANT

"VACANT" (N.I.C.)

(EQ-1)

( AF-1 )( AV-1 )

(MW-8)

SALES AREA /

50'-9 1/2"

**√** W-2

< W-6 │

14

CYCLE THEATER 108

**45 EXERCISE BIKES** 

38'-3 1/2"

- SEE REFLECTED CEILING PLAN FOR SOFFIT AND LIGHTING INFORMATION.
- NOTIFY ARCHITECT IMMEDIATELY OF ANY INCONSISTENCIES OR DISCREPANCIES WITH PLANS IN RELATION TO EXISTING FIELD CONDITIONS.
- WRITTEN DIMENSIONS TAKE PRECEDENCE OVER SCALE ON THE CONSTRUCTION DOCUMENTS. DO NOT EVER SCALE DRAWINGS.
- DIMENSIONS ARE FROM THE FACE OF FINISHED WALL (GWB) TO FACE OF FINISHED WALL (GWB), UNLESS OTHERWISE NOTED ON PLANS.
- ALL MANUFACTURED ARTICLES, MATERIALS AND EQUIPMENT SHALL BE APPLIED, INSTALLED, CONNECTED, ERECTED, CLEANED AND CONDITIONED IN ACCORDANCE WITH THE MANUFACTURER'S WRITTEN SPECIFICATIONS AND/OR INSTRUCTIONS.
- 6. ALL WORK SHALL BE EXECUTED IN A MANNER ACCEPTABLE TO THE ARCHITECT, OWNER, AND LANDLORD UNLESS NOTED OTHERWISE. THE GENERAL CONTRACTOR SHALL PROVIDE AND PAY ALL LABOR, MATERIALS EQUIPMENTS, TOOLS, CONSTRUCTION EQUIPMENT, MACHINERY, TRANSPORTATION AND OTHER SERVICES AND FACILITIES NECESSARY FOR PROPER AND TIMELY EXECUTION OF WORK.
- 7. THE CONTRACTOR WARRANT TO THE OWNER AND TO THE ARCHITECT THAT ALL MATERIALS AND EQUIPMENT FURNISHED UNDER THE CONTRACT ARE NEW UNLESS OTHERWISE SPECIFIED, AND THAT ALL WORKS SHALL BE AS SPECIFIED AND FREE OF
- 8. ALL OUTSIDE CORNERS AT DRYWALL PARTITION AND FURRING TO HAVE METAL CORNER BEADS SPACKLE AND SMOOTH.

(E) HALLWAY (N.I.C.)

W-2

W-2

(MW-6)

COMMUNITY

AREA

102

(E) ADJACENT

TENANT

"NOTHING BUNDT CAKES"

(N.I.C.)

( W-6 |

- 9. PROVIDE DIAGONAL BRACING TO STRUCTURE ABOVE ALL NEW DOORS, GLAZING HEADS AND JAMBS AS REQUIRED TO MAKE ASSEMBLY RIGID.
- 10. THE GENERAL CONTRACTOR (G.C.) IS RESPONSIBLE FOR THE FINAL CLEAN UP OF THE AREA OF WORK AND AREA AFFECTED BY CONSTRUCTION; TO INCLUDE BUT NOT LIMITED TO FLOORS, MILLWORK, FIXTURES, ETC. FOLLOWING THE INSTALLATION OF
- 11. THE GENERAL CONTRACTOR SHALL COORDINATE THE LOCATIONS FOR THE WALL MOUNTED TELEVISIONS AND GRAPHIC SIGNAGE TO PROVIDE BLOCKING FOR
- 12. ALL WET / PLUMBING WALLS ARE TO BE PROVIDED w/ MOISTURE RESISTANT GYPSUM BOARD. PROVIDE CEMENT BACKER BOARD WHEN TILE IS IN USED.

MEN'S RESTROOM

105 W-5

9

(PL-2)

**─ W-4** 

103

W-1

8'-0"

104

(E) ADJACENT

TENANT

(N.I.C.)

WOMEN'S RESTROOM 106

105

**HALLWAY** 107

( FM-2 )

FM-1

(MW-4)

BE-2

W-4

- 13. ALL PLUMBING WALLS ARE TO BE 6" METAL STUD FRAMING. PROVIDE REQUIRED BLOCKING FOR WALL MOUNTED FIXTURES, GRAB BARS, SHELVING, CABINETRY, ETC.
- 14. THERE SHALL BE NO PENETRATIONS TO A DEMISING WALL, U.O.N. IF PENETRATIONS ARE TO BE NOTED, THEN ALL PENETRATIONS INCLUDING CONDUITS, PIPES,
- DUCTWORK, ETC. SHALL BE UL RATED PER CURRENT CODE REQUIREMENTS. 15. NO PLUMBING IS ALLOWED IN DEMISING WALLS. FURRED OUT AS REQUIRED.
- 16. ALL (E) DEMISING WALLS FOR TENANT SEPARATION ARE NOT TO BE DISTURBED OR MODIFIED IN ANY WAY.

## WALL TYPES

- W-0 (E) INTERIOR WALL TO REMAIN
- W-1 (E) EXTERIOR WALL TO REMAIN
- W-2 (E) DEMISING WALL TO REMAIN
- (N) 6" x 20GA. METAL STUDS @ 16" O.C. w/ 5/8" GYPSUM BD. ON EACH SIDE ADD ADDITIONAL 5/8" GYPSUM BOARD ON THEATER SIDE
- W-4 (N) 3 5/8" x 20GA. METAL STUDS @ 12" O.C. w/ 5/8" GYPSUM BD. ON EACH SIDE  $\frac{8}{4}$ (N) DEMISING WALL 6" X 20GA. METAL STUDS @ 16" O.C. W/ (1) LAYER OF
- (N) DEMISING WALL 6" X 20GA. INICIAL STODE & 10 0.0. W, (1) E. L. E. (16 )

  W-5 > 5/8" TYPE 'X' GYPSUM BD. ON ADJACENT TENANT SIDE (BY OTHERS) AND

  A7.1 (1) LAYER OF 5/8" TYPE 'X' GYP. BD. ON CYCLEBAR SIDE, FULL HEIGHT.
- (N) SOUND WALL, 3 5/8" x 20GA. METAL STUDS @ 12" O.C. w/ (2) 5/8" GYPSUM (20) BD. ON ONE SIDE, 2 1/2" AIR GAP, AND (1) 5/8" GYPSUM BD. ON DEMISING WALLA7.1
- PROVIDE 5/8" WATER AND MOLD RESISTANT GYPSUM BOARD WHERE PLUMBING WALLS OCCUR, TYP.
- PROVIDE 5/8" TYPE "X" GYP. BOARD WHERE DEMISING WALLS OCCUR, TYP. ALL WALLS TO RECEIVE 5/8" GYP. BOARD, (U.N.O.).

### LEGEND

- 1 DAY PROGRAMMABLE THERMOSTAT, MOUNT T-STAT AT 48" A.F.F., SENSOR AT 96" A.F.F.
- FIRE EXTINGUISHER UNIT. MOUNT HANDLE AT 48" A.F.F. MAX.
- ELECTRICAL PANEL
- SEE DOOR SCHEDULE ON SHEET A8.1
- REMOTE DETECTOR TEST STATION, MOUNTED 84" A.F.F. REMOTE DETECTOR TEST STATION,

MOUNTED 84" A.F.F. ABOVE T-STAT

## **EQUIPMENT LIST**

REF	QT	Г	ESCRIPTION				
AF-1	1	SUBWOOFER TBD					
AV-1	1	AV EQUIPMENT TBD					
BE-1	2	SEATING BENCH	SEATING BENCH 60" L x 20" W x 17" H MOVABLE				
BE-2	1	ADA SEATING BENCH 60" L x 20" W x 17" H FLOOR MOU					
EQ-1	45	EXERCISE BIKE					
EQ-2	1	INSTRUCTION STATION ACCESSORY					
MW-1	1	FRONT DESK CUT SHEET 1 ON SHEET A8.4					
MW-2	1	CABINET CUT SHEET 2 ON SHEET A8.4					
MW-3	1	SHOE CUBBY CUT SHEET 3 ON SHEET A8.4					
MW-4	1	REFRIGERATION STATION CUT SHEET 4 ON SHEET A8.4					
MW-5	1	TOWEL BOX CUT SHEET 5 ON SHEET A8.4					
MW-6	1	LOCKER CABINET CUT SHEET 6 ON SHEET A8.4					
MW-7	-						
MW-8	1	SLAT WALL	VALL 96" L x 96" H				
MW-9	8	MIRROR 48" x 72" H PER PIECE					
PL-1	1	MOP BASIN w/ BACKFLOW PREVENTER TBD					
PL-2	1	ELEC. TANK WATER HEATER 30 GALLON SEE DETA		SEE DETAIL 9/A8.4			
PL-3	1	WASHER	4.5 CU. FT. CAPACITY	STACKED			
PL-4	1	DRYER	7.3 CU. FT.	STACKED			

## KEYNOTES

TBD

TBD

1 (E) DOOR TO REMAIN. SEE DOOR AND HARDWARE NOTES

ADA COMPLIANT WATER DISPENSER

HIGH LOW DRINKING FOUNTAIN TBD

- 2 (E) FIXED STOREFRONT WINDOW TO REMAIN
- 3 (N) DOOR AND FRAME. SEE DOOR SCHEDULE
- 4 (N) TRANSITION STRIP. SEE FINISH SCHEDULE
- (N) TRAINER'S PLATFORM. ALL FRAMING MUST RUN PARALEL TO WALL  $\angle$ TO RUN ELECTRICAL TO INSTRUCTION STATION
- 6 (N) WALL-MOUNTED FIRE EXTINGUISHER UNIT. MOUNT HANDLE AT +4'-0" AFF. MAX.
- PROVIDE (N) THERMOSTAT @ +4'-0" MAX. A.F.F.
- 8 (N) ELECTRICAL PANEL. SEE ELECTRICAL DRAWINGS
- 9 (N) FLOOR DRAIN. SEE PLUMBING DRAWINGS
- 10 PROVIDE REMOTE DETECTOR TEST STATION, MOUNTED 84" A.F.F. ABOVE T-STAT
- SENSOR @ 96" HIGH
- 12 PROVIDE (N) OCCUPANCY SIGNAGE PER  $\begin{pmatrix} 4 \\ T1.3 \end{pmatrix}$
- [13] ADD (N) MULL-IT-OVER TRIM CLOSURE PIECES AT END WALL PLATE, OR EQUAL.
- 14 (E) STRUCTURAL COLUMN TO REMAIN 15 (N) DOOR UNDER SEPARATE SUBMITTAI



Architectural Corporation 9483 HAVEN AVENUE, SUITE 100

RANCHO CUCAMONGA, CA 91730

P. 909.259.9971 | F. 909.944.8409 www.AmorArch.com WEST COAST | CENTRAL | EAST COAST



PHONE: 720.378.3062 rachel.hilton@cyclebar.com

910-W NORTHWEST BLUE PARKWAY,

LEE'S SUMMIT, MO 64086

CONSULTANT

SEE DETAIL 12/A8.1

SEE DETAIL 4/T1.3

STAMP

SHEETS BEARING THIS SEAL AND WET SIGNATURE ARE AUTHENTICATED. RESPONSIBILITY FOR ALL OLDER PLANS, SPECIFICATIONS OR INSTRUMENTS
ARE DISCLAIMED.


REVISIONS 2020-05-26 FIELD COORDINATION DATE 2020.05.29 PROJECT NUMBER

SHEET NUMBER

(N) FLOOR PLAN AND EQUIPMENT PLAN

42'-9 1/2"

1/4" = 1'-0"

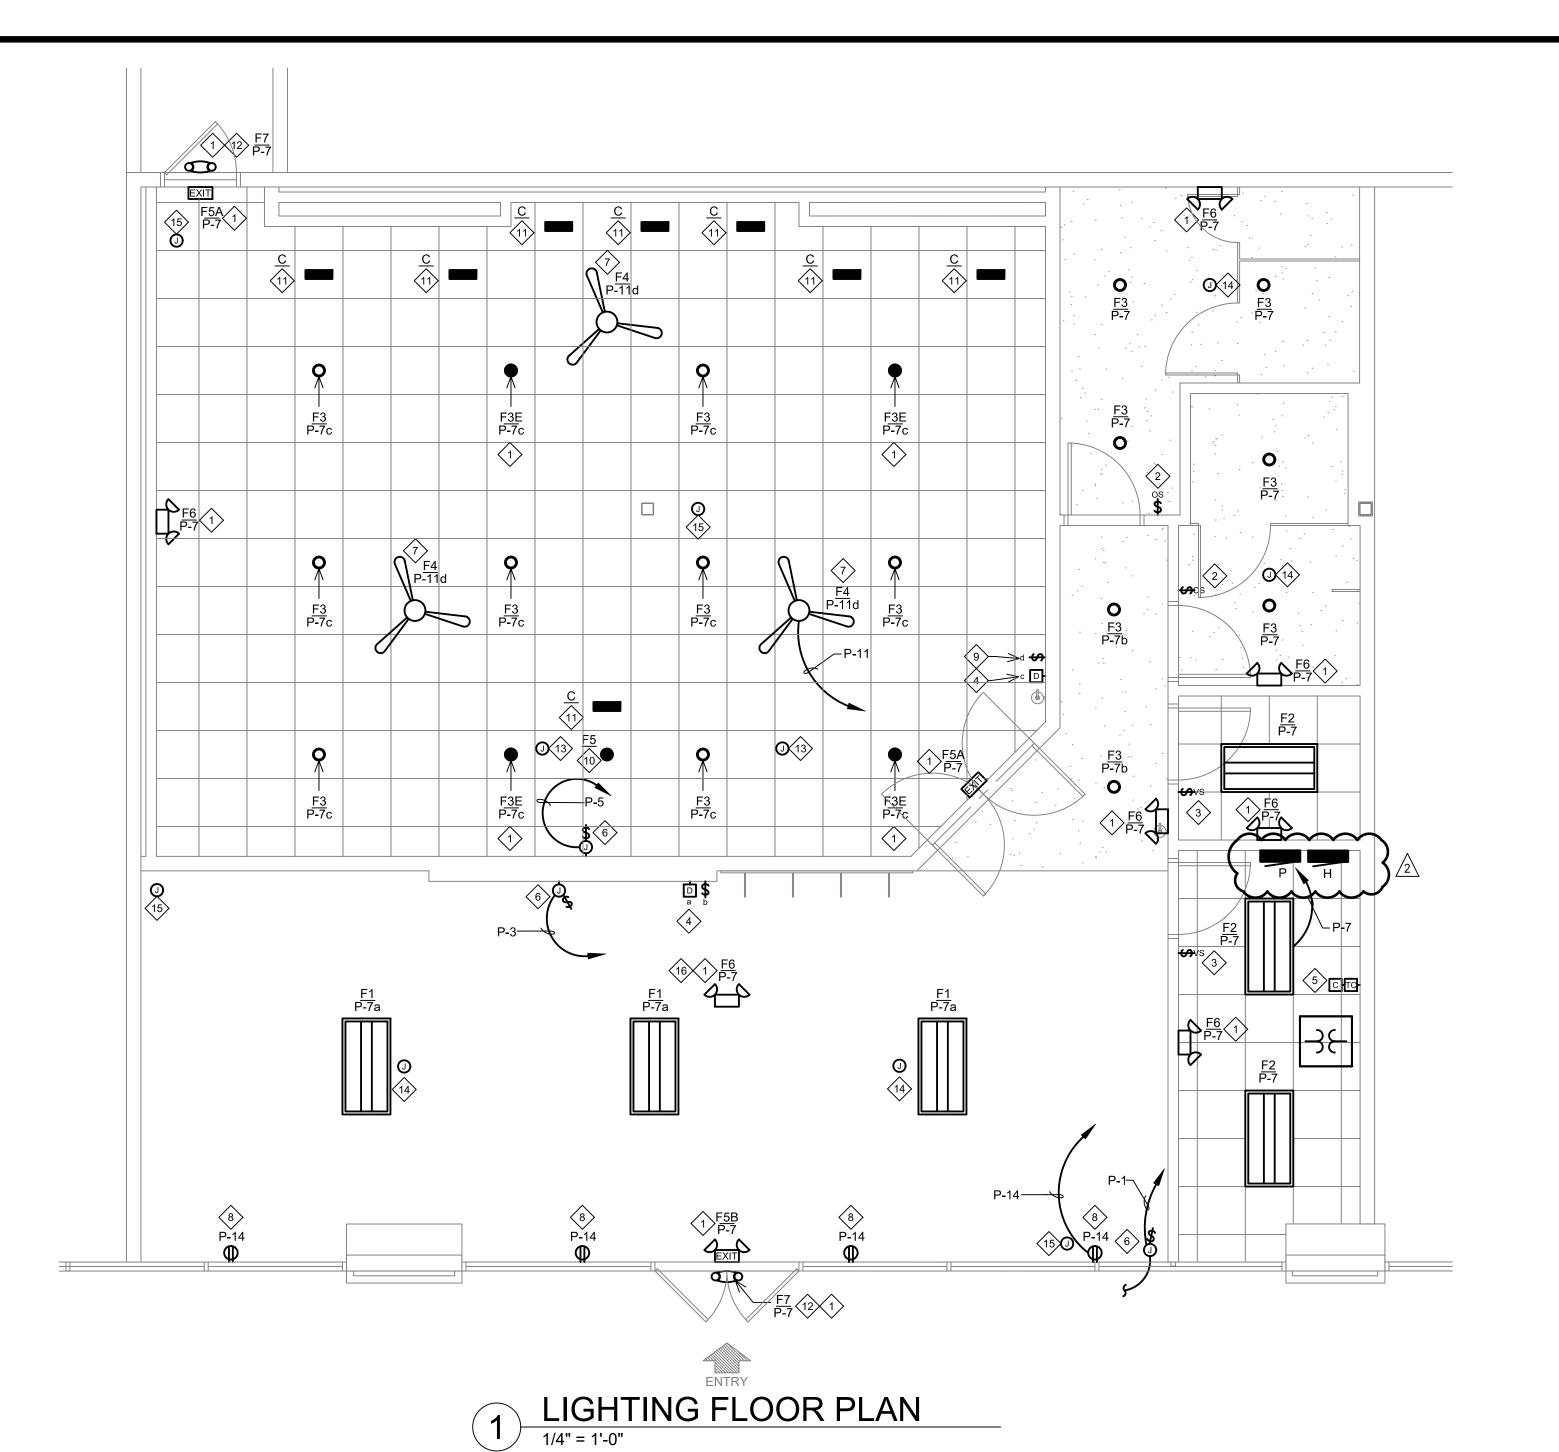

#### **GENERAL NOTES:**

- A. REFER TO ARCHITECTURAL REFLECTED CEILING PLAN FOR EXACT LOCATIONS OF LUMINAIRES.
- B. EACH LUMINAIRE SHALL BE STRUCTURALLY SUPPORTED; DO NOT USE CONDUIT FOR SUPPORT FOR EITHER FIXTURES OR BOXES.
- . USE FLEXIBLE METAL CONDUIT (GREENFIELD) FOR CONNECTION OF LAY-IN FIXTURES.
- D. PROVIDE GROUND CONDUCTOR IN ALL CONDUIT RUNS.
- THOUGH WIRING OF FIXTURES SHALL NOT BE PERMITTED UNLESS SPECIFICALLY ILLUSTRATED.
- EACH LUMINAIRE SHALL HAVE ITS OWN BOX UNLESS OTHERWISE ILLUSTRATED.
- G. VERIFY LOCATION OF WALL MOUNTED EMERGENCY LUMINAIRES TO AVOID CONFLICT WITH WOOD TRIM
- I. REFER TO ARCHITECTURAL FOR EXACT LOCATION OF LUMINAIRES COORDINATE WITH ARCHITECT FOR LOCATION OF LUMINAIRES AND DEVICES BEFORE ROUGH-IN.

#### **KEY NOTES:**

- $\langle 1 \rangle$  provide unswitched hot to all exit, emergency, and night LIGHTS TO BYPASS SWITCH CONTROLS. THIS MUST BE IN ADDITION TO SWITCHED HOT.
- PROVIDE LUTRON MAESTRO WALL MOUNTED OCCUPANCY SENSOR MS-A102-O. INSTALL PER MANUFACTURER'S INSTALLATION
- (3) PROVIDE LUTRON MAESTRO WALL MOUNTED VACANCY SENSOR MS-A102-V. INSTALL PER MANUFACTURER'S INSTALLATION
- 4 PROVIDE LUTRON DIVA 0-10V DIMMER DVTV-WH WITH POWER PACK PP-DV.
- (5) PROVIDE 2 CHANNEL INTERMATIC ASTRONOMIC TIME CLOCK MODEL NO. ET8215C WITH 0-2 HOUR SPRING WOUND TIMER AND 4 POLE LIGHTING CONTACTOR. CONNECT SIGN, INTERIOR LIGHTING AND SHOW WINDOW RECEPTACLES.
- (6) PROVIDE JUNCTION BOX WITH DISCONNECT SWITCH IN CONCEALED LOCATION FOR CONNECTION TO SIGN LIGHTING. LOCATE DISCONNECT SWITCH IN CONCEALED ACCESSIBLE LOCATION PER NEC 600.6. E.C. SHALL MAKE FINAL CONNECTION TO SIGN AND CONTROL VIA TIME CLOCK. COORDINATE WITH SIGN VENDOR PRIOR TO ROUGH-IN.
- 7> PROVIDE FAN RATED JUNCTION BOX AND SEISMIC APPROVED HARDWARE ON ROOF TRUSSES.
- $\langle 8 \rangle$  provide show window receptacle within 18" of the top OF THE WINDOW PER NEC 210.62.
- PROVIDE ENVIROFAN SPEED CONTROL MODEL NO. 105FR FOR CONTROL OF CEILING FANS.
- (10) NEW RECESSED 3 WATT LED DOWNLIGHT PROVIDED AND INSTALLED BY OTHERS. CONNECTED AND CONTROLLED VIA A/V
- (11) NEW RECESSED 3 WATT LED WALL WASH PROVIDED AND INSTALLED BY OTHERS. CONNECTED AND CONTROLLED VIA A/V
- (12) VERIFY IF THERE IS ADEQUATE GENERAL & EMERGENCY LIGHTING PRESENT. IF NOT COORDINATE WITH LANDLORD AND PROVIDE
- (13) PROVIDE JUNCTION BOX MOUNTED TO UNISTRUT WITH SPEAKER CABLE FROM EACH SPEAKER LOCATION BACK TO A/V RACK WITH A 15' WHIP AT THE A/V RACK. COORDINATE EXACT LOCATION OF SPEAKERS WITH A/V VENDOR PRIOR TO ROUGH-IN. SEE SHEET E3.0 FOR A/V RACK LOCATION.
- (14) PROVIDE JUNCTION BOX FOR SURFACE/PENDANT MOUNTED SPEAKER WITH SPEAKER CABLE FROM EACH SPEAKER LOCATION BACK TO A/V RACK. PROVIDE A 15' WHIP AT THE A/V RACK. SEE SHEET E3.0 FOR A/V RACK LOCATION.
- (15) PROVIDE (1) CAT6 PLENUM RATED CABLE FOR EACH CAMERA LOCATION. THE CABLE SHALL RUN FROM EACH CAMERA BACK TO THE A/V RACK WITH A 15' WHIP LEFT AT EACH CAMERA LOCATION AND A 15' WHIP PROTRUDING FROM THE A/V CUT IN RING AT THE PLATFORM.
- (16) PENDANT MOUNT FIXTURE AT 11'0" A.F.F.

Architectural


Corporation 9483 HAVEN AVENUE, SUITE 100 RANCHO CUCAMONGA, CA 91730 P. 909.259.9971 | F. 909.944.8409 www.AmorArch.com



910 NW BLUE PARKWAY, LEE'S SUMMIT, MO 64086 PHONE: 720.378.3062 rachel.hilton@cyclebar.com

CONSULTANT


0420758-076-00

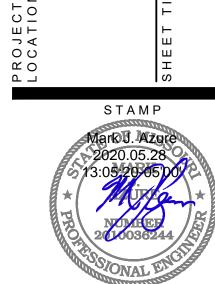

	REVISIONS
◬	2020-05-26 FIELD COORDINATION
$\overline{\Delta}$	
$\Delta$	
	DATE 2020.04.10

SHEET NUMBER

PROJECT NUMBER

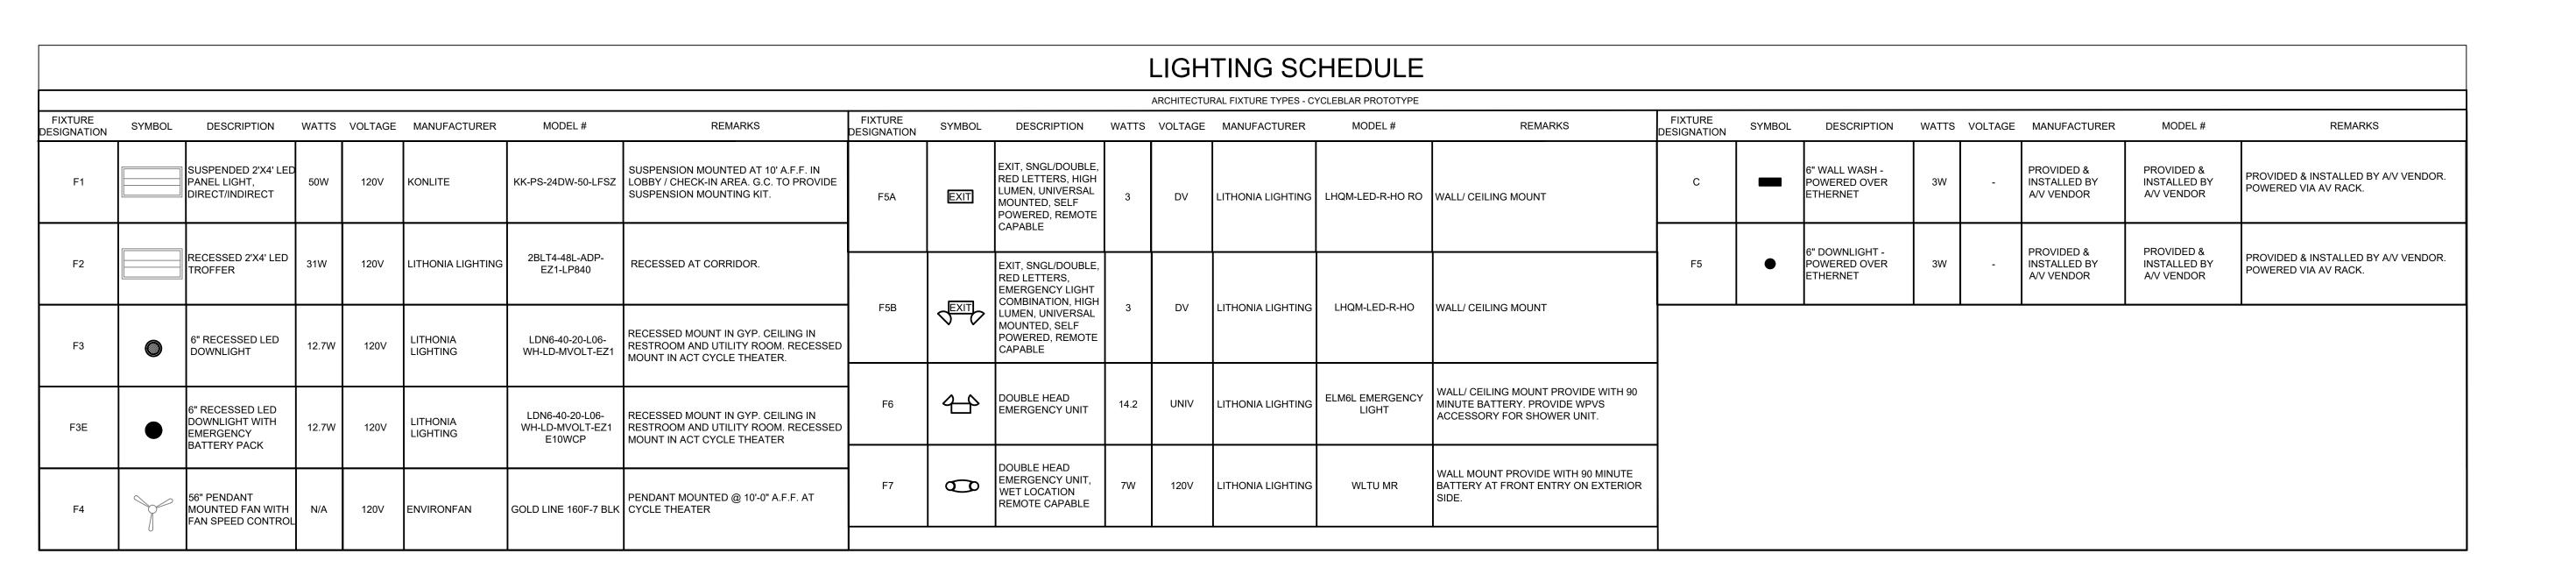


MECHANICA	MECHANICAL EQUIPMENT SCHEDULE										
ITEM NO	DESCRIPTION	MCA	KW	VOLTS	PHASE	DISCONNECT	BKR	PNL-CKT	WIRE	GROUND	NOTES
RTU-1	ROOF TOP UNIT	12.0		480	3	30A/3P NON-FUSED	15A/3P	H-7,9,11	3/4"C. 3 #12	1#12	1,2,3,4,6
RTU-2	ROOF TOP UNIT	28.0		480	3	30A/3P NON-FUSED	30A/3P	H-2,4,6	3/4"C. 3#10	1#10	1,2,3,4,6
EF-1	EXHAUST FAN	-	0.137	120	1	20A/1P MOTOR RTD. SW.	20A/1P	P-7	1/2"C. 2 #12	1 #12	1,5
EF-2	EXHAUST FAN	-	0.137	120	1	20A/1P MOTOR RTD. SW.	20A/1P	P-7	1/2"C. 2 #12	1 #12	1,5
EF-3	DRYER BOOSTER FAN	-	0.083	120	1	20A/1P MOTOR RTD. SW.	20A/1P	P-35	1/2"C. 2 #12	1 #12	1
WH-1	WATER HEATER	-	6.000	480	1	LOCK OFF DEVICE	20A/2P	H-8,10	3/4"C. 2 #12	1 #12	1

1. VERIFY REQUIREMENTS OF EQUIPMENT.

MOTOR/EQUIPMENT SCHEDULE NOTE (NOT ALL NOTES MAY BE USED)

- 2. PROVIDED DUCT SMOKE DETECTOR IN MAIN RETURN DUCT. DUCT SMOKE DETECTOR TO SHUT DOWN UNIT UPON ALARM CONDITION.
- 3. VERIFY NAMEPLATE RATING ON UNIT AS IT MAY DIFFER FROM LOADS SHOWN HERE.
- 4. PROVIDE CONNECTION TO MECHANICAL CONTRACTOR PROVIDED CONTROLS AS REQUIRED.
  5. CONTROL VIA LIGHT SWITCH LOCATED IN ROOM. COORDINATE WITH MECHANICAL CONTRACTOR.
- 6. PROVIDE GFI SERVICE RECEPTACLE WITH WEATEHRPROOF IN-USE COVER. CIRCUIT AS SHOWN.

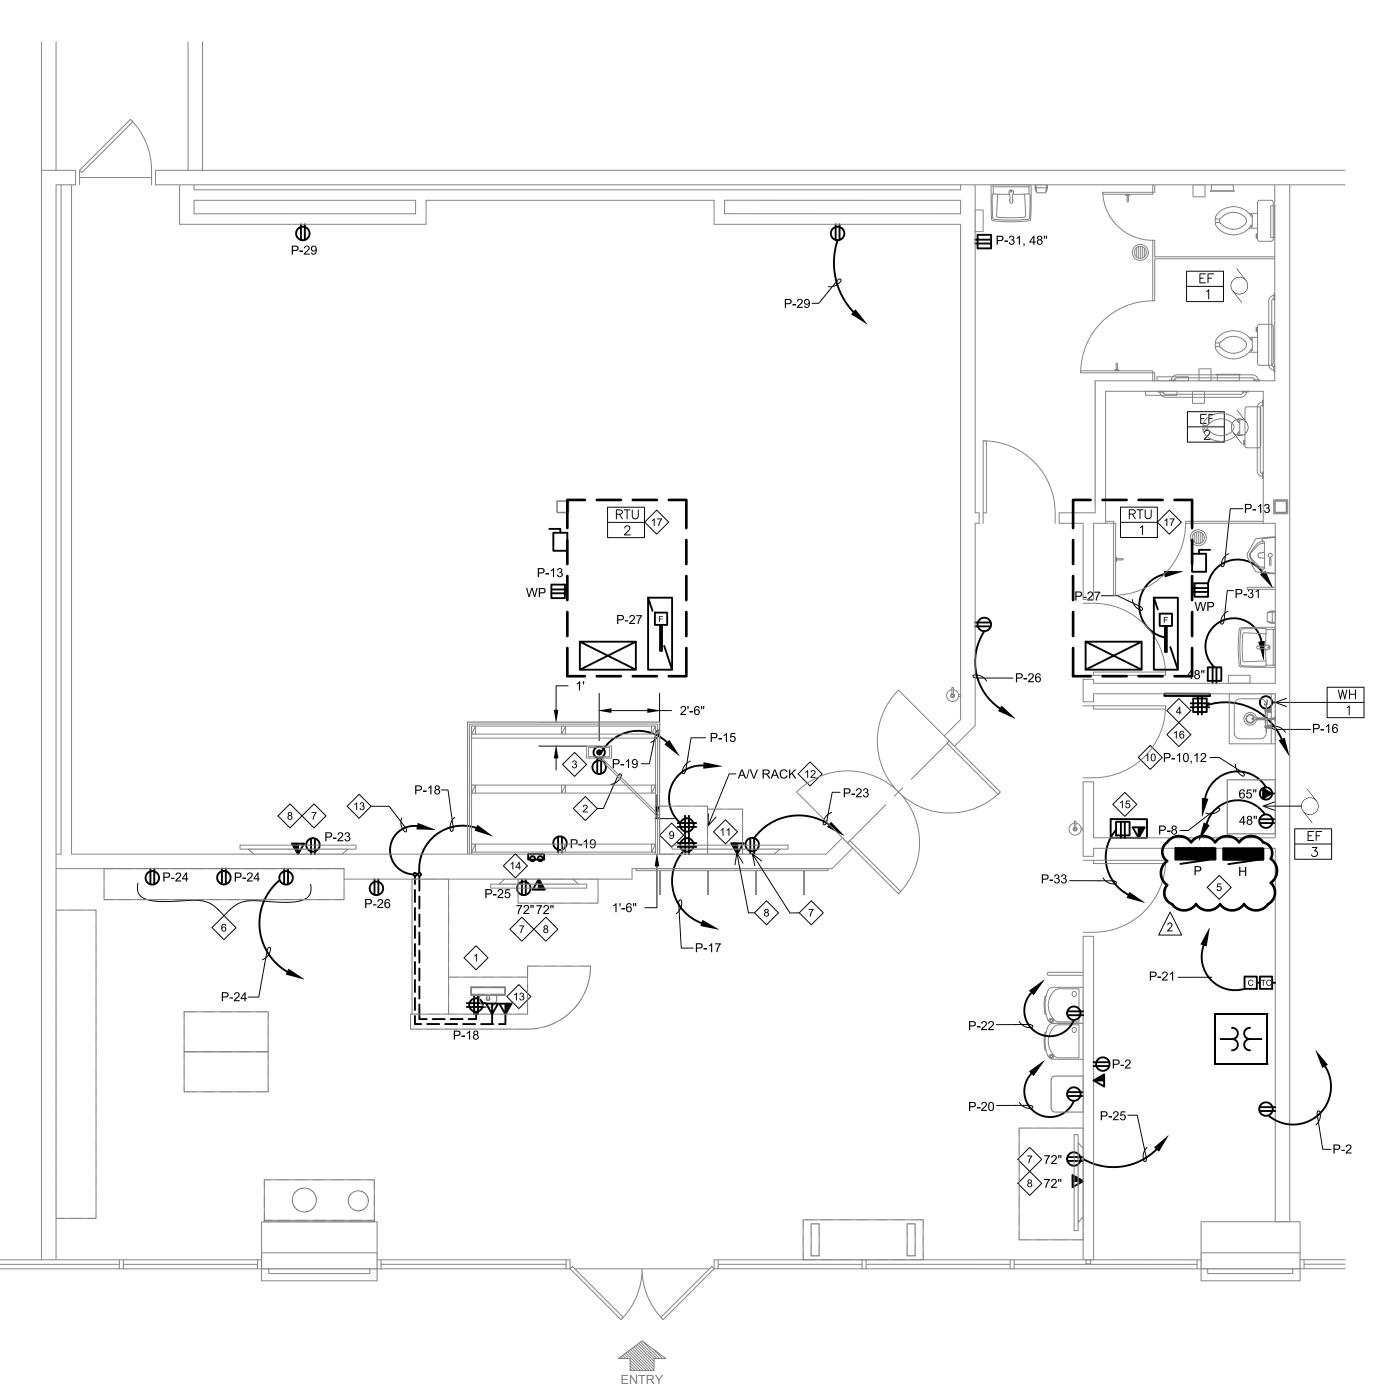

# 1 POWER FLOOR PLAN

#### **GENERAL NOTES:**

- A. ALL WIRING SHALL BE #12 THHN MINIMUM FOR DRY LOCATIONS.
- B. ALL ELECTRICAL MATERIAL, DEVICES, AND EQUIPMENT SHALL BEAR "U.L." LABELS AND SHALL BE INSTALLED PER THE "N.E.C." AND PER THE LOCAL INSPECTION BUREAU'S REQUIREMENTS. ALL MATERIAL, DEVICES, AND EQUIPMENT SHALL BE GROUNDED PER "N.E.C."
- C. ALL CONTRACTORS SHALL VERIFY ALL REQUIREMENTS OF EQUIPMENT PRIOR TO COMMENCING WITH THE WORK.
- ). COORDINATE MOUNTING HEIGHTS AND OUTLET LOCATIONS WITH TENANT PRIOR TO ROUGH—IN.
- VERIFY METHOD OF CONNECTIONS TO ALL EQUIPMENT WITH TENANT PRIOR TO ROUGH—IN.
- PROVIDE MATCHING RECEPTACLE FOR ALL EQUIPMENT SUPPLIED WITH CORD AND PLUG. INSTALL CORD & PLUG ON EQUIPMENT WHICH WAS SHIPPED SEPARATELY. FURNISH AND INSTALL CORD & PLUG ON EQUIPMENT WHICH REQUIRES CORD & PLUG.
- G. INTERIOR BUILDING CONDUIT RUNS SHALL BE CONCEALED AT ALL TIMES (IN WALL, COUNTER, CEILING OR FLOOR). EXTERIOR BUILDING CONDUIT RUNS SHALL BE RIGID GRC. OR EQUAL. ELECTRICAL CONTRACTOR TO FIELD VERIFY EXACT REQUIREMENTS AND TO INSURE COMPLETE ELECTRICAL INSTALLATION MEETS ALL APPLICABLE CODES AND REGULATIONS
- . THIS CONTRACTOR IS RESPONSIBLE FOR PROVIDING THROUGH PENETRATION PROTECTION DEVICES AND FIRESTOPPING DEVICES AT ALL PIPES, LINE WIRING, DUCTWORK OR OTHER COMPONENTS THIS CONTRACTOR INSTALLS WHICH PENETRATE RATED WALLS OR FLOOR/CEILING ASSEMBLIES.
- I. COORDINATE COLOR OF RECEPTACLES AND COVER PLATE WITH ARCHITECT, ALL COVER PLATES IN THE CYCLE STUDIO SHALL BE PAINTED BLACK.
- J. THIS CONTRACTOR SHALL PROVIDE AND INSTALL EQUIPMENT REQUIRED FOR TEMPORARY ELECTRIC SERVICE SUFFICIENT FOR ALL NEW CONSTRUCTION.
- K. ALL KITCHEN, BATH AND SINK COUNTERTOP AND EXTERIOR WEATHERPROOF OUTLETS SHALL BE G.F.I. (GROUND FAULT INTERRUPT) TYPE. ALL DEVICES MOUNTED AT COUNTERTOP LEVEL OR AS MAY OTHERWISE BE REQUIRED. SHALL BE MOUNTED IN A FASHION SO THAT THE BOTTOM OF THE DEVICE TRIM, COVER PLATE, ETC... CAN BE FASTENED CLEAR OF ANY TRIM SUCH AS BACK SPLASHES, SIDEBOARDS, ETC. ANY REQUIRED RELOCATION OF DEVICES SHALL BE AT THE EXPENSE OF THIS CONTRACTOR.
- L. ALL EXTERIOR WIRING SHALL BE IN RIGID CONDUIT OR SCHEDULE 40 P.V.C. CONDUITS.
- M. VERIFY ALL EQUIPMENT LOADS, LOCATIONS AND PANELBOARD SCHEDULES PRIOR TO ROUTING CONDUITS, PULLING WIRE AND INSTALLING BREAKERS AND ELECTRICAL DEVICES.
- N. CODE AND REGULATIONS COMPLY WITH STATE AND LOCAL CODES, UTILITY COMPANY REGULATIONS AND THE LATEST EDITIONS OF: THE UNIFORM CODES (BUILDING, PLUMBING AND MECHANICAL) NATIONAL FIRE CODES OF THE NATIONAL FIRE PROTECTION ASSOCIATION (NFPA). FINAL INTERPRETATIONS WILL BE MADE BY THE LOCAL INSPECTION AUTHORITY.

#### KEY NOTES:

- PROVIDE QUAD RECEPTACLE AND DATA WITHIN RECEPTION DESK AT 24" A.F.F. FOR P.O.S. EQUIPMENT. POWER AND DATA CABLES SHALL BE RUN FROM WALL BEHIND DESK AND THEN INTO DESK MILLWORK TO LOCATIONS AS SHOWN. COORDINATE WITH MILLWORK VENDOR PRIOR TO ROUGH—IN.
- PROVIDE 1-1/2" FLEX CONDUIT FOR LOW VOLTAGE

  CONNECTIONS, IN AS STRAIGHT OF LINE AS POSSIBLE, FROM 18


  OFF OF THE BACK WALL AT THE A/V RACK LOCATION TO THE

  FLOOR BOX AT THE TRAINERS INSTRUCTION STATION . SEE

  ARCHITECTURAL DETAILS FOR EXACT LOCATION AND ADDITIONAL INFORMATION.
- PREPACKAGED FLOOR BOX KIT PROVIDED BY OTHERS AT RAISED PLATFORM WITH A DEDICATED DUPLEX RECEPTACLE AND SEPARATION FOR LOW VOLTAGE CONNECTIONS. SEE ARCHITECTURAL SHEETS AND DETAIL 16/A8.1 FOR ADDITIONAL INFORMATION.
- 42"x16"x3/4" FIRE RETARDANT AC GRADE PLYWOOD TELEPHONE BOARD. EXTEND 1" CONDUIT FROM LANDLORD DEMARCATION POINT TO CYCLEBAR TELEPHONE BOARD LOCATION.
- 5 EXISTING ELECTRICAL PANELS AND SUSPENDED TRANSFORMER TO REMAIN. SEE RISER DIAGRAM AND PANEL SCHEDULE ON SHEET E4.0 FOR ADDITIONAL INFORMATION.
- 6 PROVIDE COMBO USB/RECEPTACLE AT CHECK—IN MOUNTED AT 48"
  A.F.F. TO BOTTOM OF UNIT. LEVITON T56631 ONE 120V PLUG, TWO
  USB PORTS, REFER TO DETAIL 2 ON THIS SHEET.
- TV RECEPTACLE AND DATA. VERIFY LOCATION AND MOUNTING HEIGHT WITH TENANT REPRESENTATIVE.
- 8 PROVIDE (2) CAT6A PLENUM RATED ETHERNET CABLES FROM TV LOCATION TO A/V RACK.
- 9 PROVIDE (2) DEDICATED QUAD RECEPTACLES FOR A/V RACK.
- 208V 10 ELECTRIC DRYER AT LOCATION SHOWN, PROVIDE 1"C. 3#10, 1#10 GRD.
- BALANCED XLR PATCH CABLE FROM SUBWOOFER TO A/V RACK.
- 12 A/V RACK SUPPLIED AND INSTALLED BY A/V CONTRACTOR.
- 13 POS TERMINAL PROVIDE (3) CAT6 CABLES TO A/V RACK.
- G.C. PROVIDED AV CABLING PROTRUDING FROM WALL VIA DOUBLE GANG PLASTER RING. PROVIDE 15' OF SLACK OF AV CABLING AT EACH END. LABEL CABLES CORRECTLY. E.C. TO STUB TWO (2) 1 1/2" CONDUITS 6" ABOVE CEILING FOR CABLING PATHWAY.
- CABLE MODEM LOCATION PROVIDE (2) CAT6 CABLES TO A/V
- (2) CAT-6 DATA LINES FROM TELEPHONE BOARD BACK TO AV RACK. TERMINATED AND LABELED BY G.C.
- PROVIDE AND INSTALL THE FOLLOWING: DUCT SMOKE DETECTOR IN **RETURN** MAIN DUCT AND REMOTE TEST STATION WITH VISIBLE AND AUDIBLE ALARM. SMOKE DETECTOR SHALL SHUT DOWN HVAC UNIT UPON DETECTION OF SMOKE. COORDINATE FINAL LOCATION OF REMOTE TEST STATION WITH AHJ.

#### IOTF·

ALL COVER PLATES, OUTLETS, AND SWITCHES IN THE CYCLE THEATER SHALL BE FACTORY BLACK ALL OTHERS TO BE FACTORY BRIGHT WHITE.

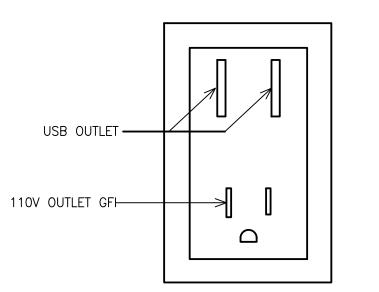

2 USB/OUTLET COMBO DETAIL
NO SCALE



Architectural Corporation

9483 HAVEN AVENUE, SUITE 100

RANCHO CUCAMONGA, CA 91730 P. 909.259.9971 | F. 909.944.8409 www.AmorArch.com



910 NW BLUE PARKWAY, LEE'S SUMMIT, MO 64086 PHONE: 720.378.3062 rachel.hilton@cyclebar.com


CONSULTANT

urham Tifle BlocksIMO - MissourIMO - Missouri\_Vert\_Tifle\_Block.sf

0420758-076-00

EST BLUE PARKWAY, AIT, MO 64086

> 910-W NORTHW LEE'S SUMI

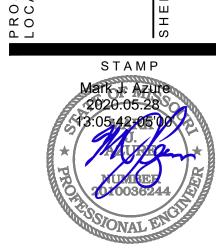

	REVISIONS
◬	2020-05-26 FIELD COORDINATION
Δ	
Δ	
	DATE 2020.04.10
	PROJECT NUMBER A2276

**E3.0** 

SHEET NUMBER