



RECORD DRAWING


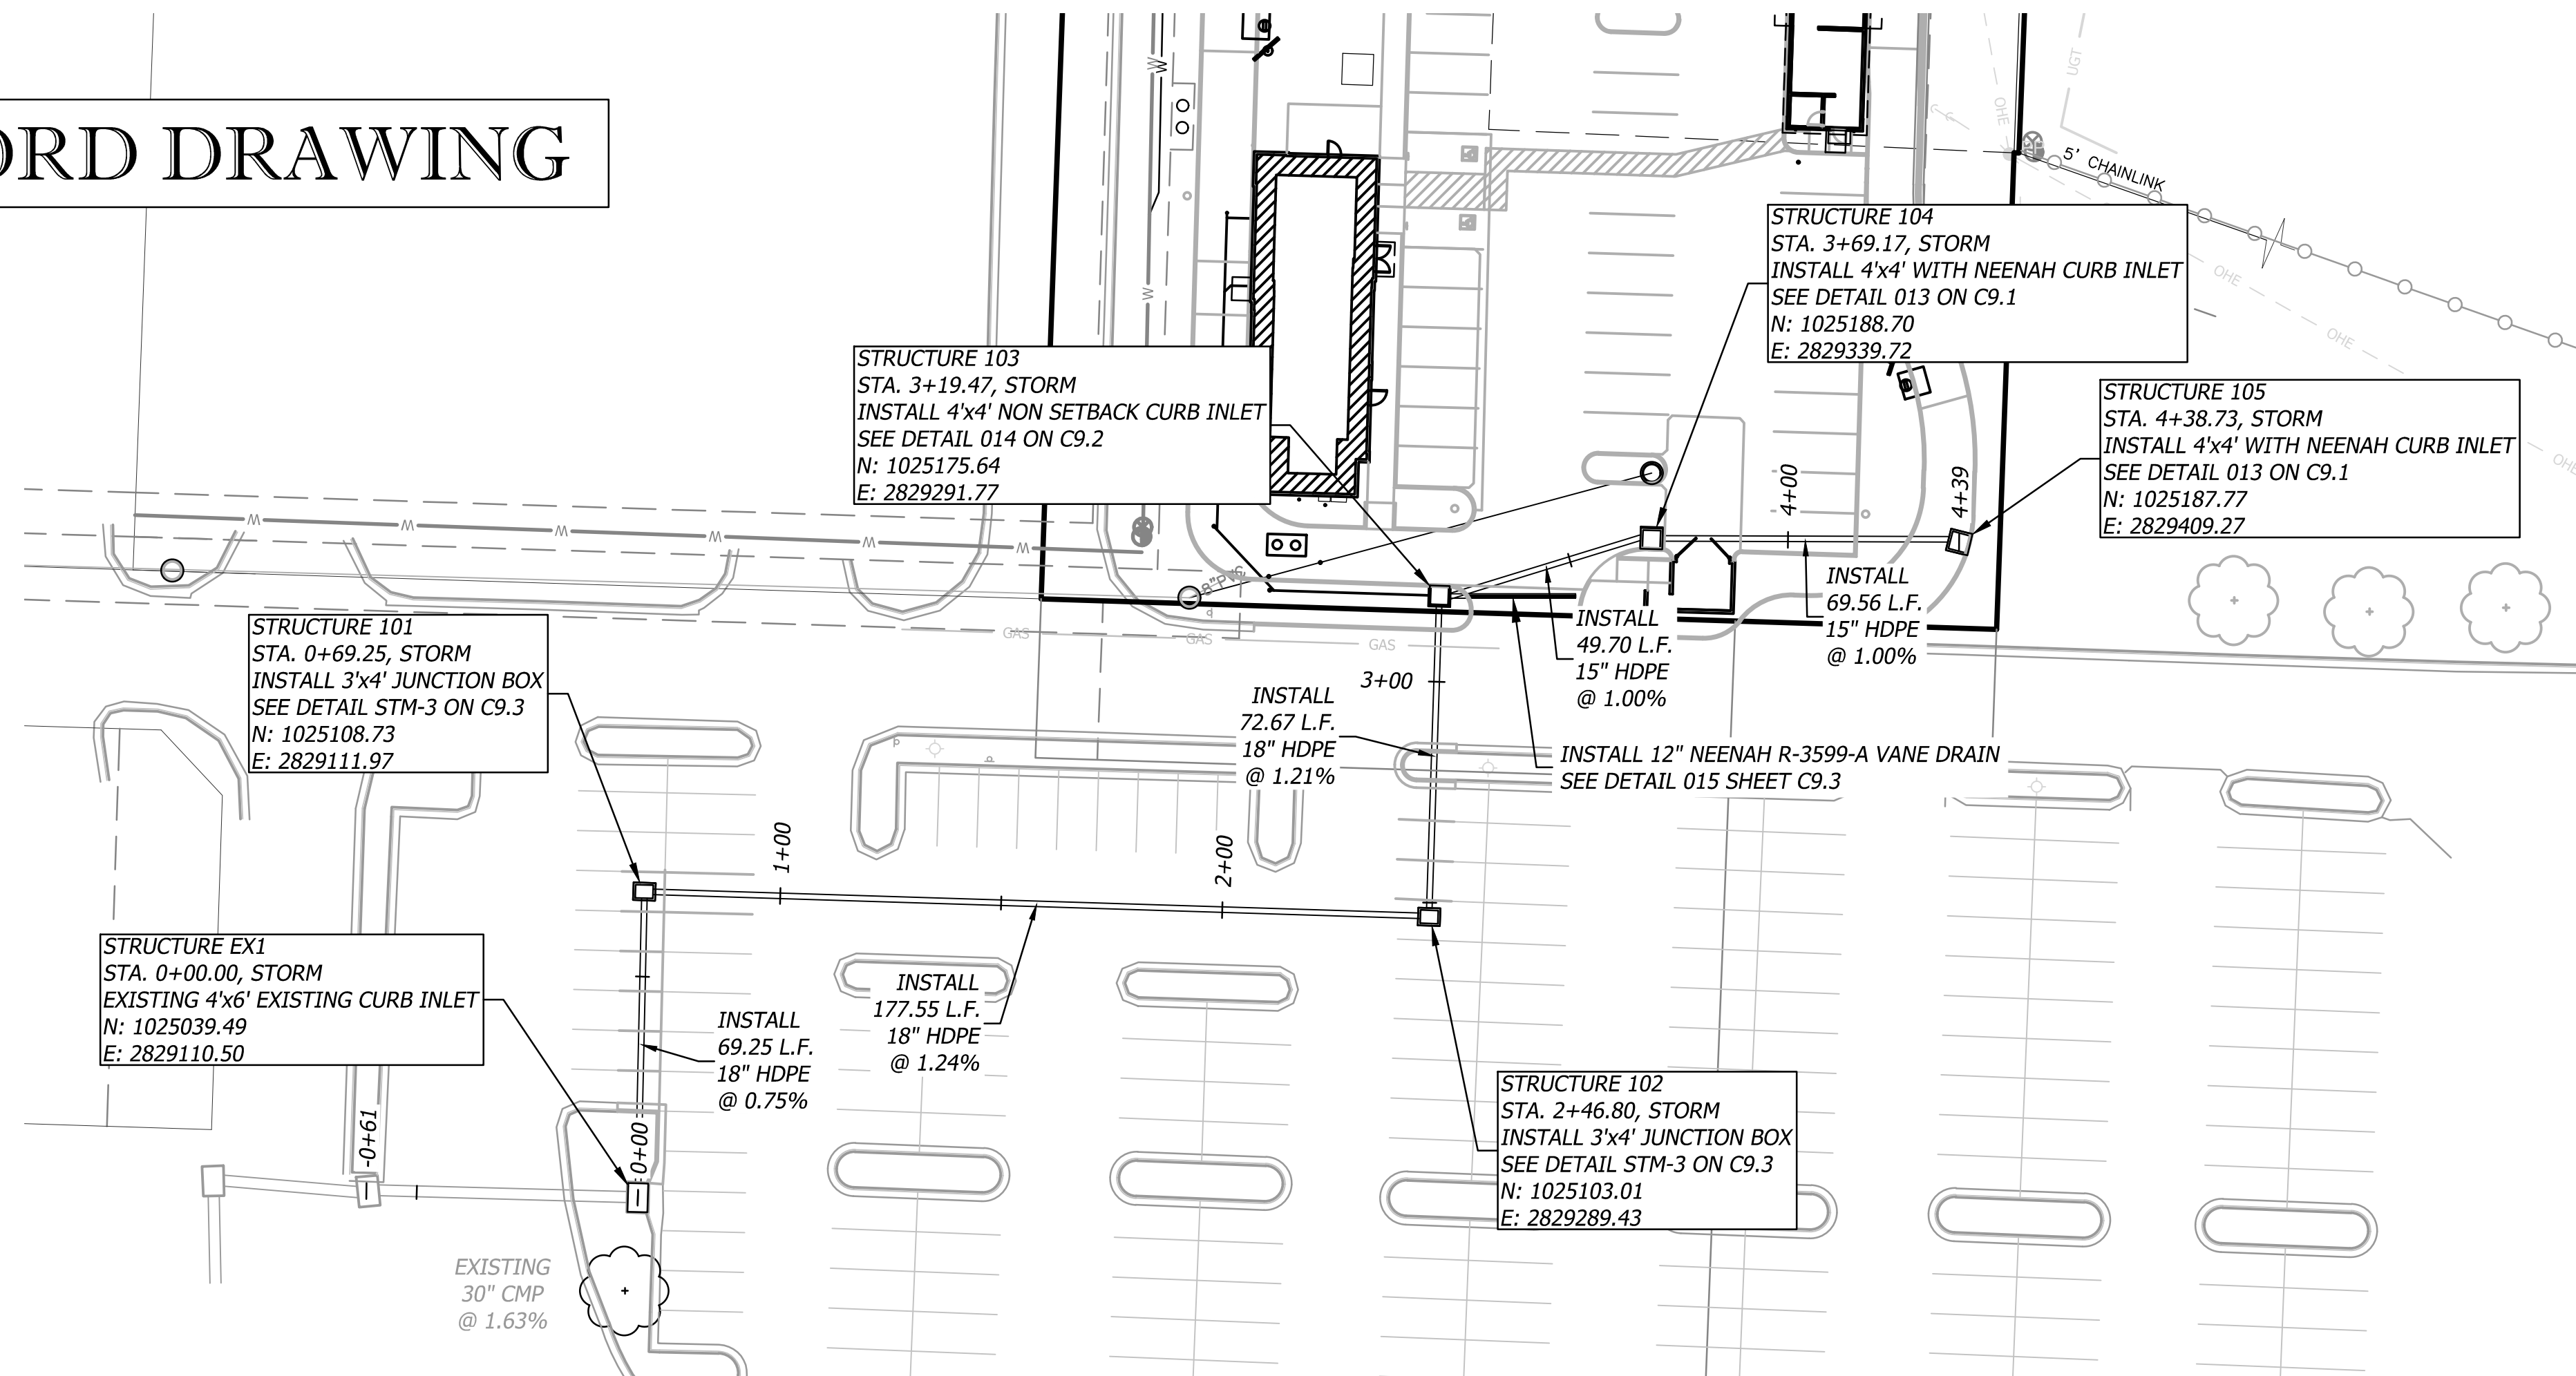


STORM NOTE
ALL NORTHINGS, EASTINGS, AND ALIGNMENT STATIONING FOR STORM STRUCTURES ARE TO CENTER OF STRUCTURE UNLESS STATED OTHERWISE.

AS-BUILT CERTIFICATION
ELEVATIONS WERE PROVIDED BY THE CONTRACTOR. THE REMAINING UTILITIES WERE CONSTRUCTED IN SUBSTANTIAL CONFORMITY WITH THIS DRAWING. NO AS-BUILT SURVEY WAS PERFORMED.
DATED: APRIL 10, 2020

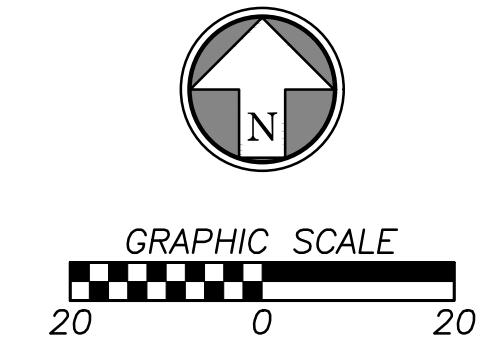

STORM 100

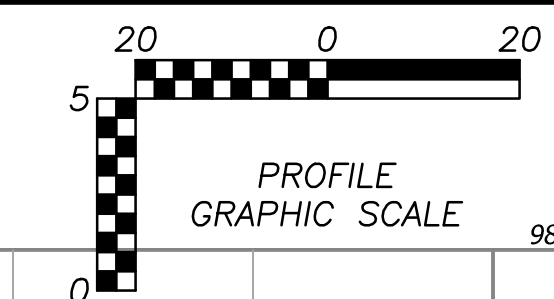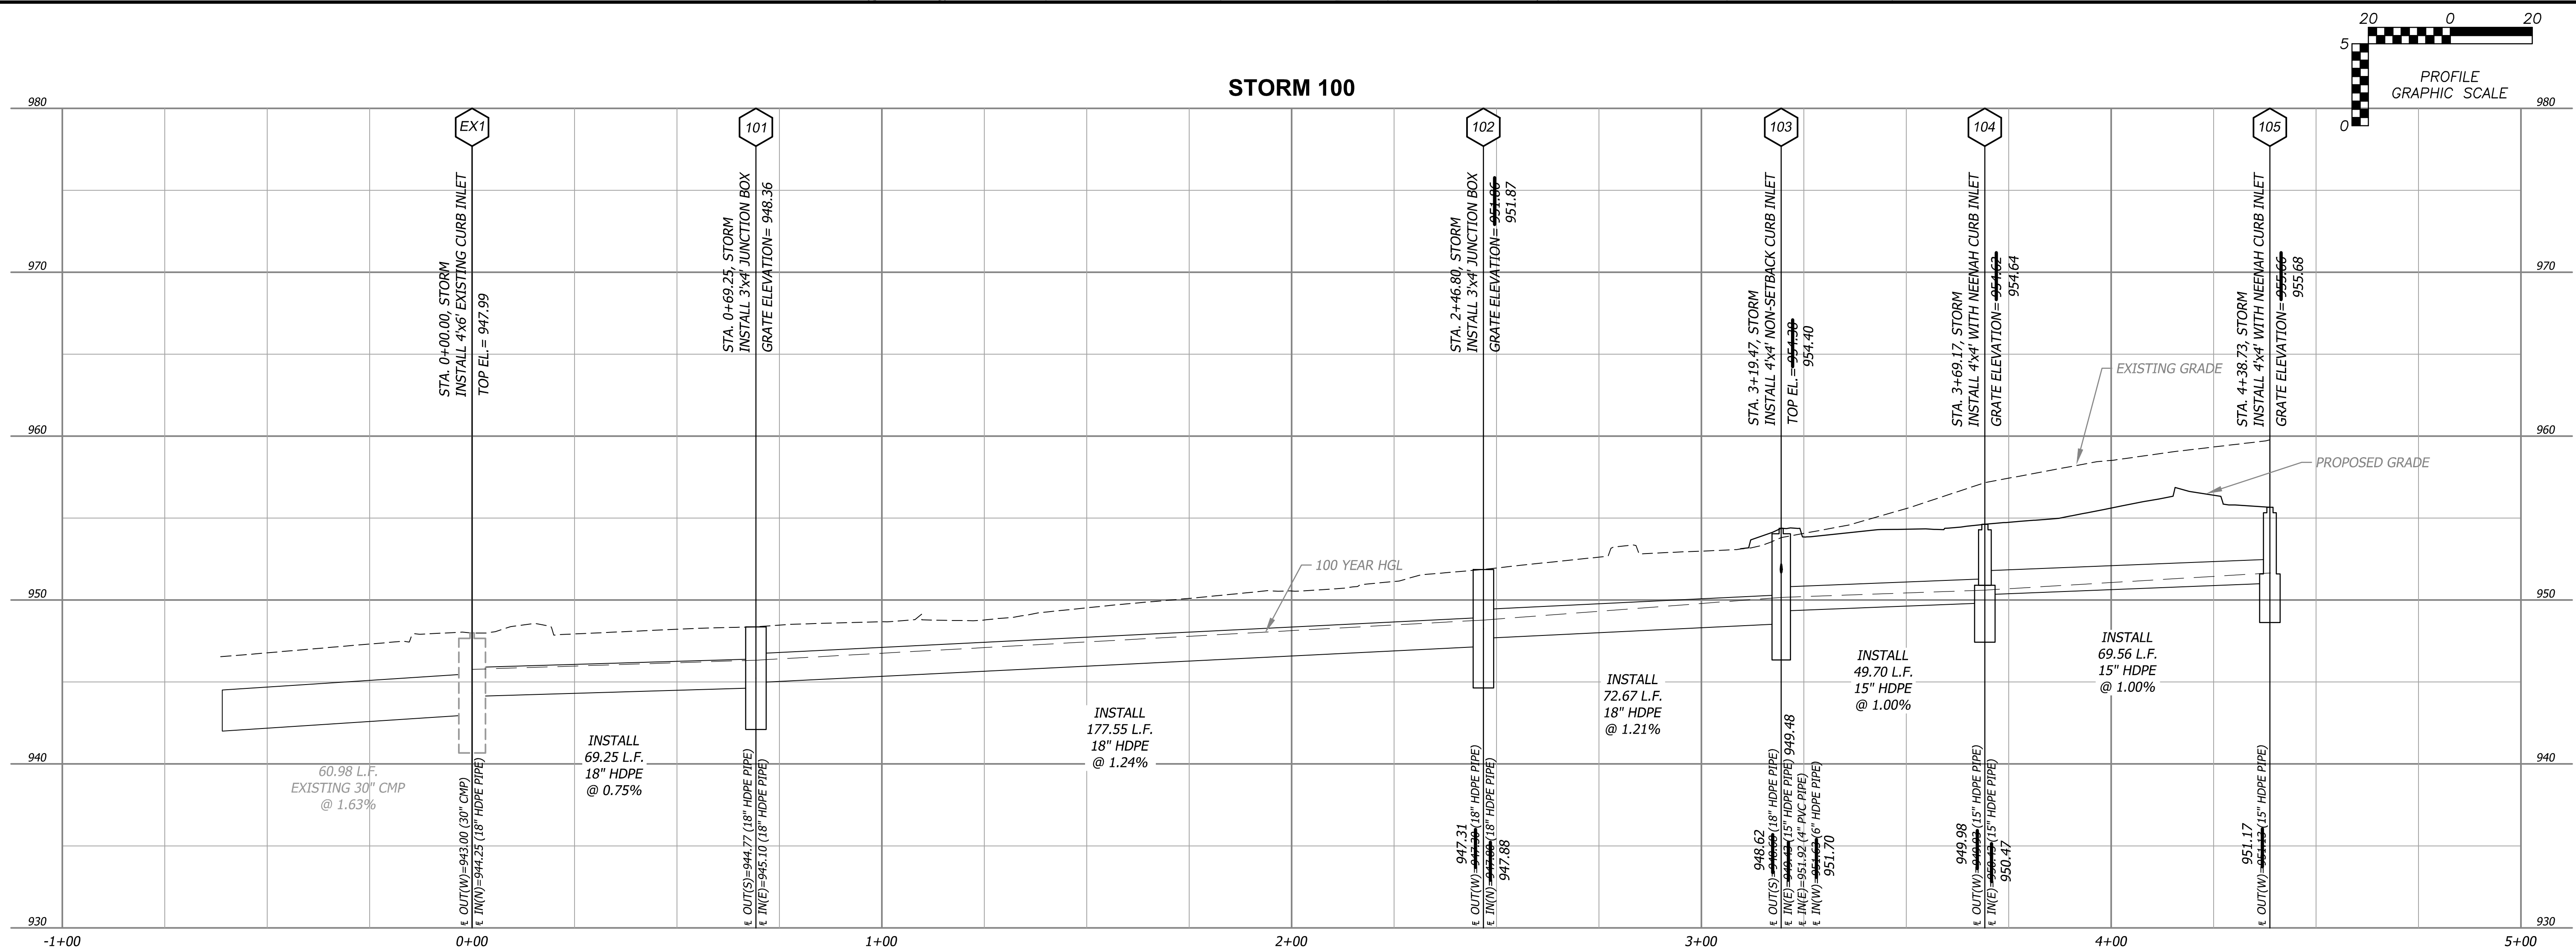

<p>BHC RHODES Civil Engineering • Surveying • Utilities 7101 College Blvd., Suite 400 Overland Park, Kansas 66210 P: (913) 663-1900 F: (913) 663-1633 BHC is a trademark of Fluigent Homestead & Company, P.A. Certificate of Authority Number: MO# E-1355-F</p>													
<p>Prepared For: FIRST STREET DEVELOPMENT 4455 E CAMELBACK ROAD BUILDING C 241 PHOENIX, ARIZONA 85018 602-714-3099</p>	<p>TACO BELL 851 NE WOODS CHAPEL RD LEE'S SUMMIT, MISSOURI FINAL DEVELOPMENT PLAN PLAN AND PROFILE</p>												
<p>Design: MGG Drawn: MGG Checked: MSS Issue Date: 04/23/2019 Project Number: 026040.08</p>	<p>C7.0</p>												
<table border="1"> <tr> <th>Rev.</th> <th>Date</th> <th>Description</th> </tr> <tr> <td> </td> <td> </td> <td> </td> </tr> <tr> <td> </td> <td> </td> <td> </td> </tr> <tr> <td> </td> <td> </td> <td> </td> </tr> </table>	Rev.	Date	Description										<p>By: _____ App: _____</p>
Rev.	Date	Description											