

ORDERED BY: BE HOME, LLC


PROPERTY ADDRESS: 4700 NE POCONO CIRCLE

DESCRIPTION: Lot 33, MONTICELLO 2ND PLAT, a subdivision in Lee's Summit, Jackson County, Missouri.

LAND SURVEY COMPANY


Quality since 1959
P.O. BOX 528, GRANDVIEW, MISSOURI 64030
PHONE: (816) 966-0839 FAX: (816) 763-1761

Final Grading As-Built

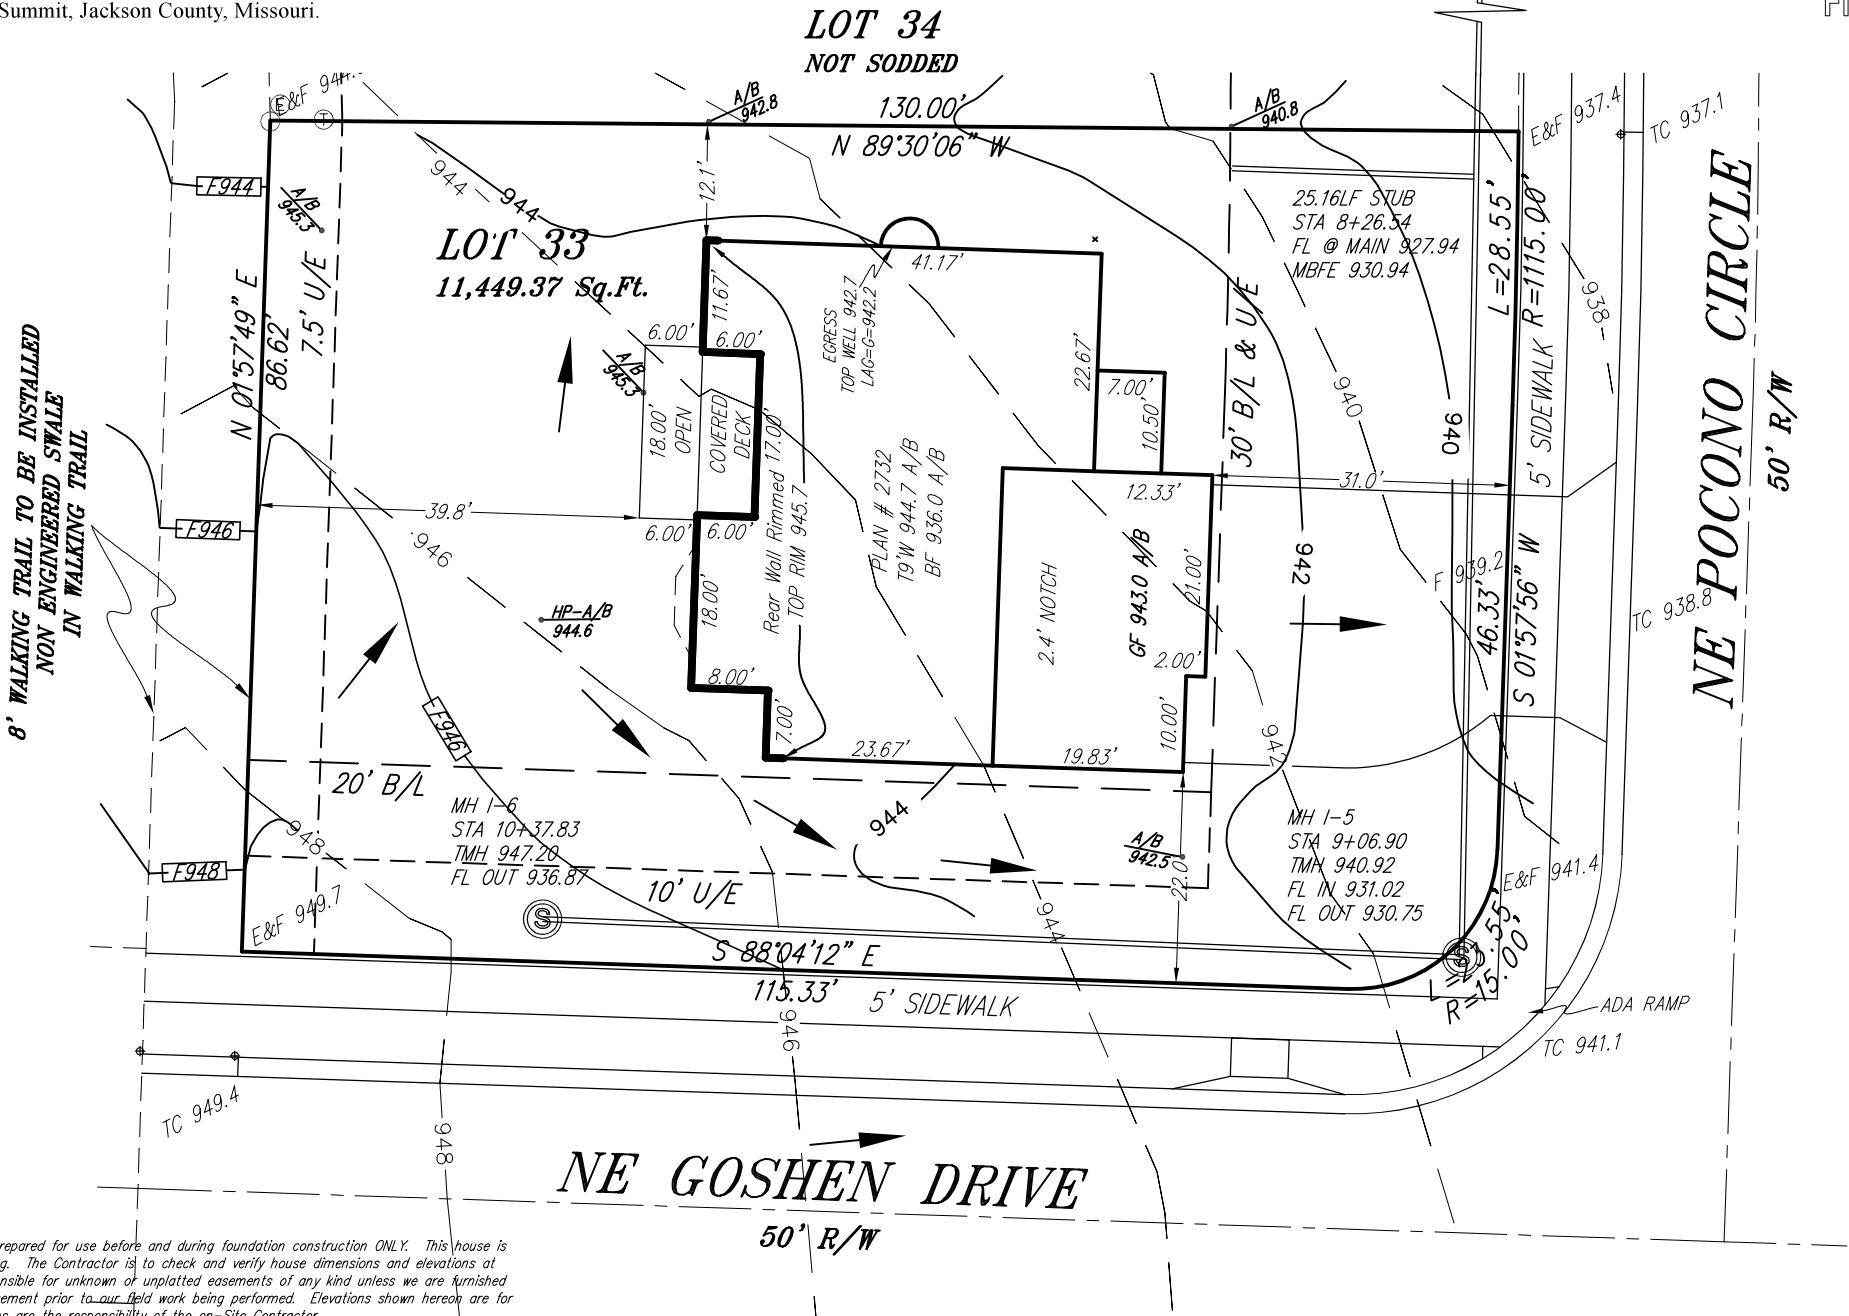

NOTE:
AS-GRADED PLOT PLAN
IS REQUIRED PRIOR TO SODDING.

NOTE:
RIM BACK OF HOUSE

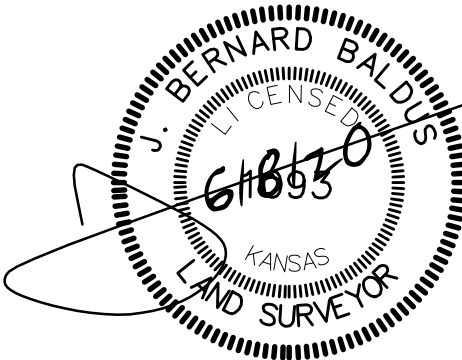

RELEASE FOR CONSTRUCTION
AS NOTED ON PLANS REVIEW
CODES ADMINISTRATION
LEE'S SUMMIT, MISSOURI
Go Ahead: 3/3/19
Final: 3/6/19
Rev: 19.0319
As Graded 6/8/20

Attention: This Plot Plan was prepared for use before and during foundation construction ONLY. This house is staked as shown on this drawing. The Contractor is to check and verify house dimensions and elevations at the job site. We are not responsible for unknown or unplatted easements of any kind unless we are furnished with the description of said easement prior to our field work being performed. Elevations shown hereon are for a guide only, and final elevations are the responsibility of the on-Site Contractor. Unless otherwise noted, THIS IS NOT AN AS-BUILT SURVEY and we can not guarantee the construction of anything shown on this "Plan." Boundary and Improvement Surveys and "As-Built" Grading Certifications serve the purpose of showing "Actual" construction.