


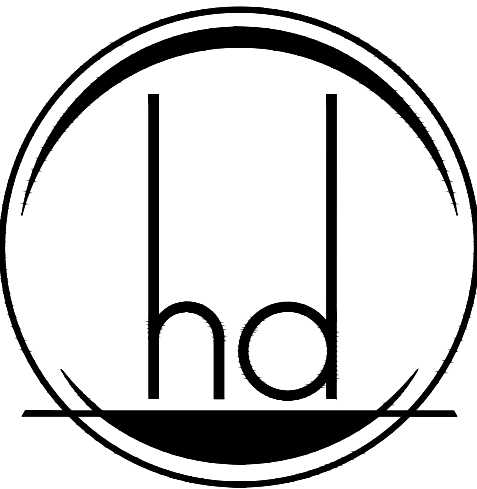

HEREFORD · DOOLEY
ARCHITECTS

1720 WEST END AVE · SUITE 300
NASHVILLE · TENNESSEE · 37203
P · 615 · 244 · 7399
F · 615 · 244 · 6697
WWW.HDARCHITECTS.COM

LICENSE NUMBER: 123456789101112

217026.00
CLIENT PROJECT NUMBER: 123456789

LEE'S SUMMIT M.O.B.
2100 SE Blue Parkway, Lee's Summit, MO 64083
Lee's Summit Medical Center
2100 SE Blue Parkway, Lee's Summit, MO 64083

CONSTRUCTION
DOCUMENTS

02/15/2019
1 ADDENDUM 01 03-09-2019
2 REVISION 1 05-17-2019

STORM PROFILE



C6.4

RODRIGUEZ MECHANICAL
CONTRACTORS, INC. AS-BUILT BY:
PHOENIX ENGINEERING
& SURVEYING, LLC
3855 S. NORTHERN BLVD.
INDEPENDENCE, MO 64052
(816) 743-9000

AS-BUILT
AS-BUILTS PREPARED USING CONTRACTOR
PROVIDED INFORMATION & FIELD SURVEY

INFORMATION PROVIDED ON THIS DRAWING DEPICTS
AS-CONSTRUCTED CONDITIONS OF WORK PERFORMED BY
RODRIGUEZ MECHANICAL CONTRACTORS, INC. NOR PHOENIX
ENGINEERING AND SURVEYING, LLC IN ANY WAY EXPRESS
OR IMPLIED WARRANTY FOR THE DESIGN OR THE
ENGINEERING OF THE AS-CONSTRUCTED IMPROVEMENTS
SHOWN HEREON.

PROFESSIONAL'S SEAL:

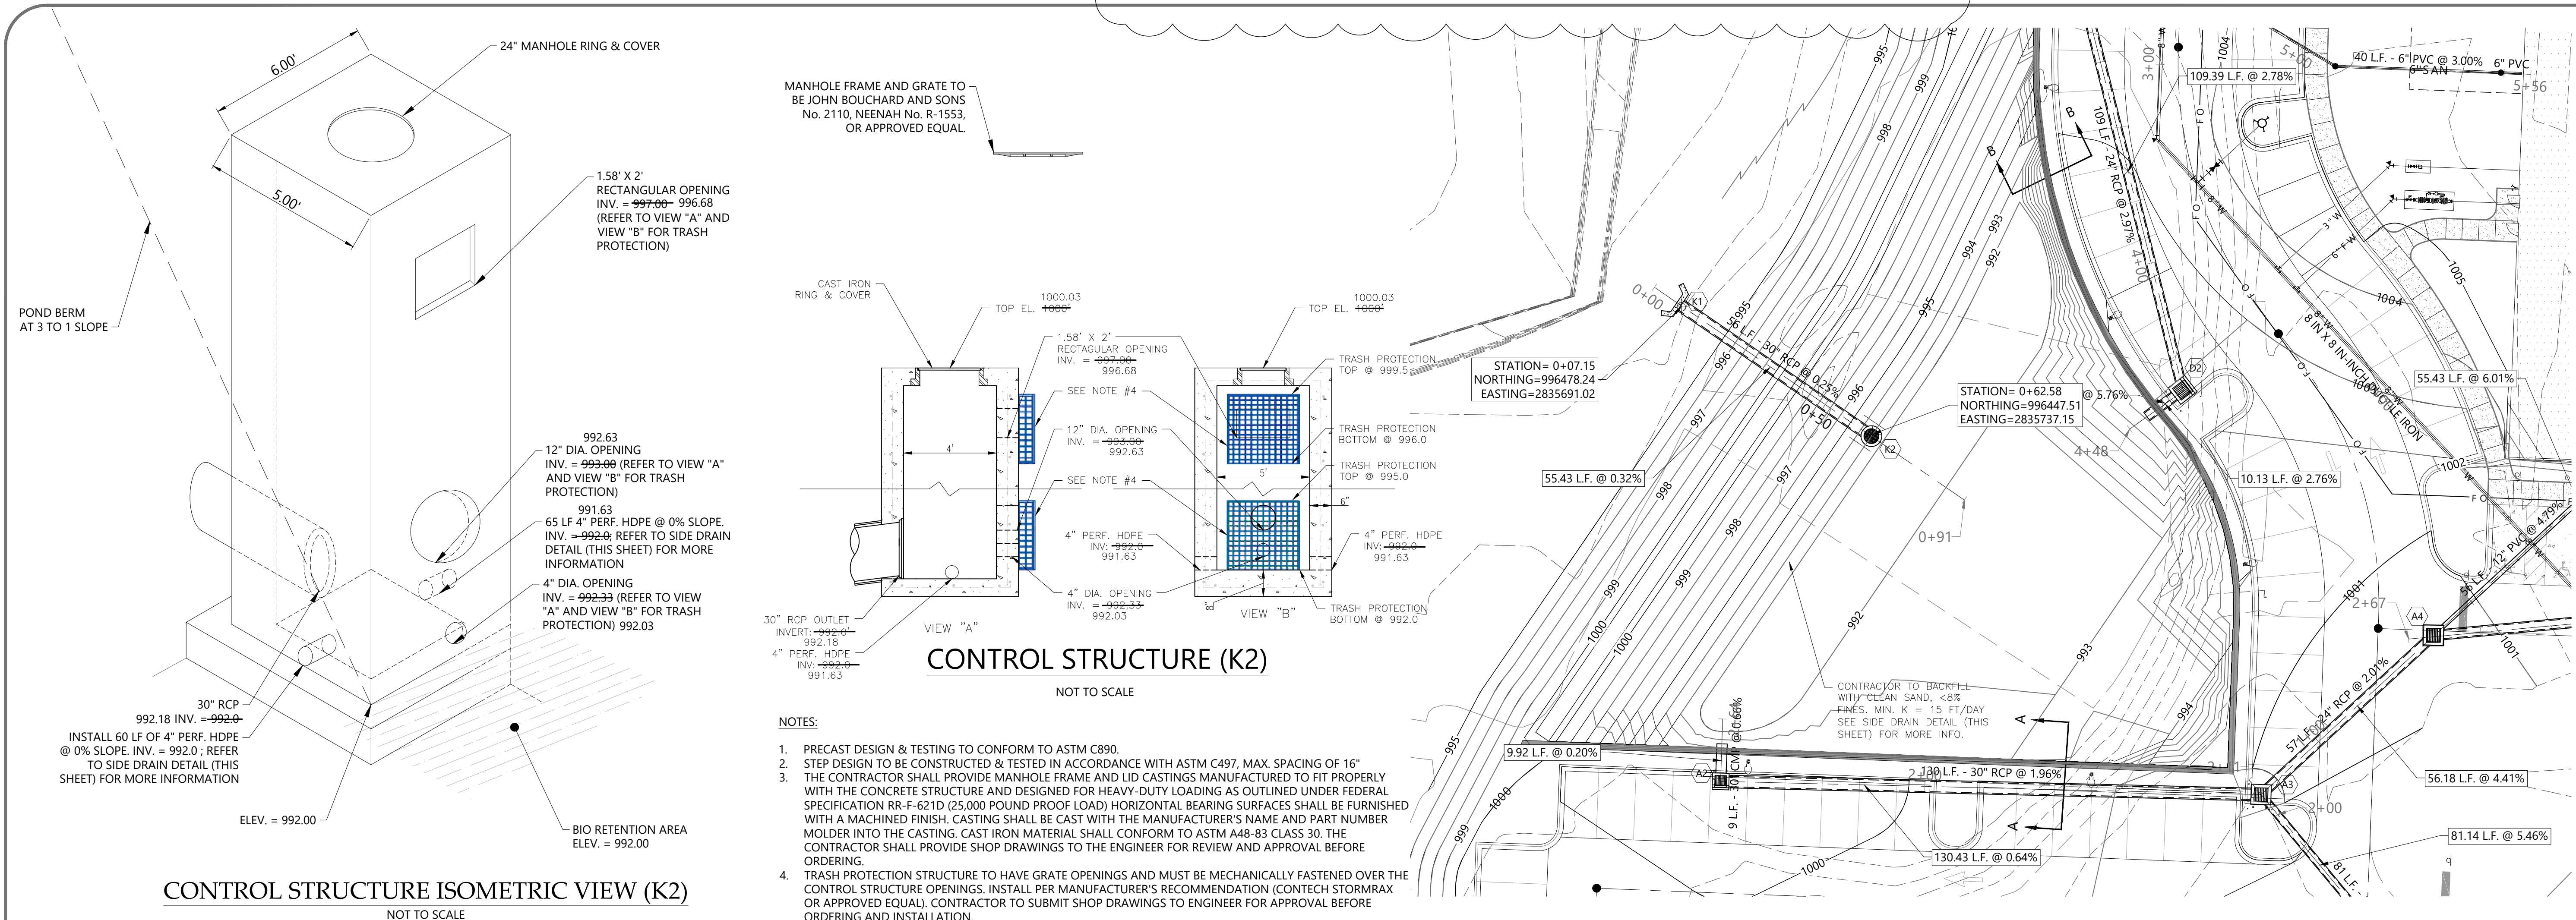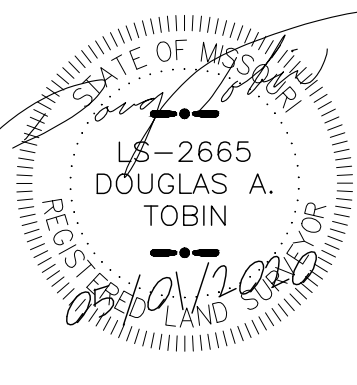


1615 EDGEWATER DRIVE, STE 200
ORLANDO, FLORIDA 32804
T 407.975.1273
F 407.975.1278
www.smeinc.com

George Huddleston, P.E. 2017035508
Edward Browder, PLA 2016001073

LEE'S SUMMIT
MEDICAL CENTER
2100 SE BLUE PARKWAY
LEE'S SUMMIT, MO 64083
816.282.5000

LEE'S SUMMIT MEDICAL CENTER
MEDICAL OFFICE BUILDING
LEE'S SUMMIT, MISSOURI

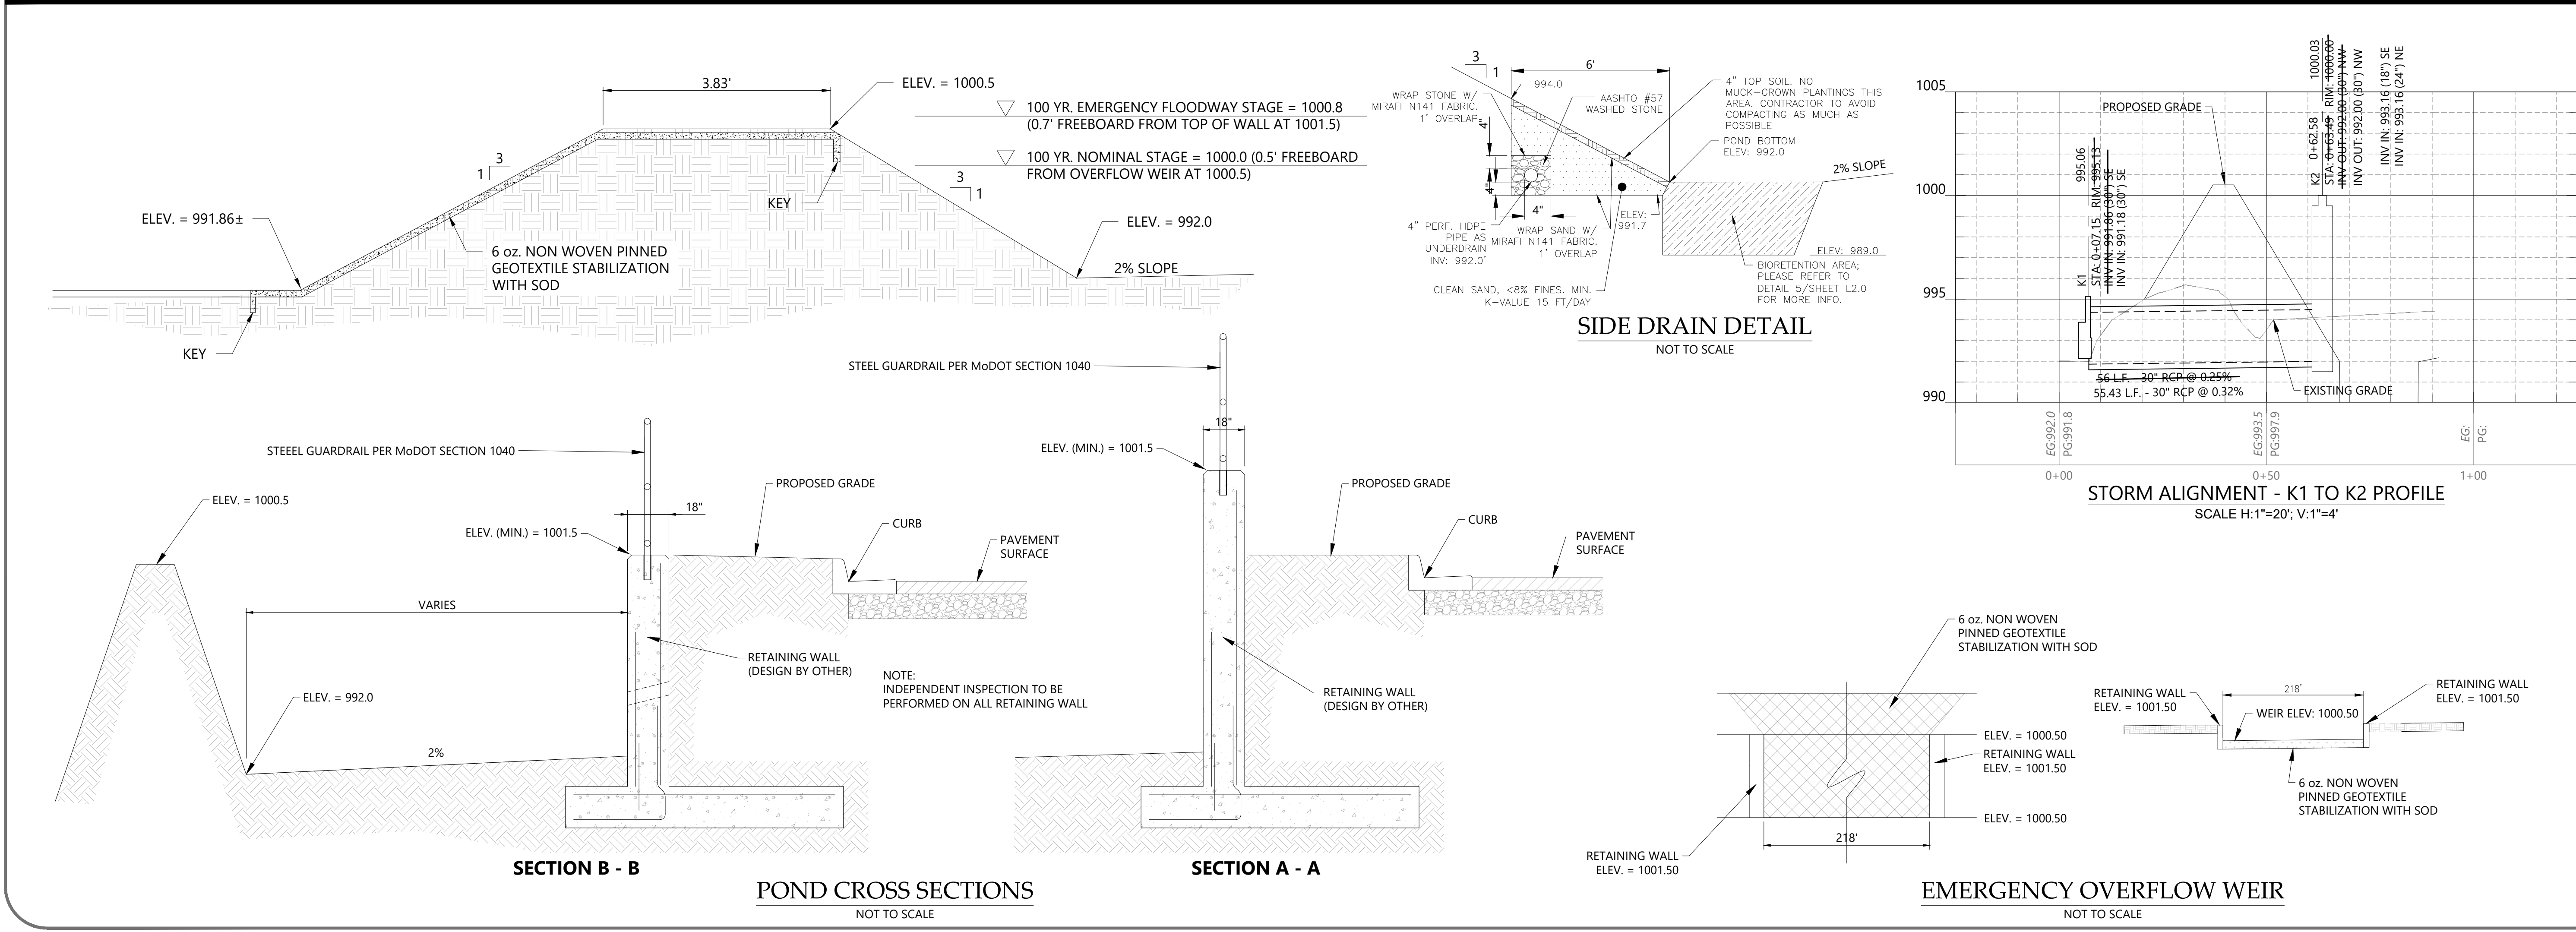

NO.	DATE	DESCRIPTION	BY	CHK	APV
1	02/15/2019	Construction Documents	MCV	QVE	GBH

PROJECT NUMBER
527116043
DRAWING NUMBER
C6.4
DRAWING NAME
STORM PROFILE