
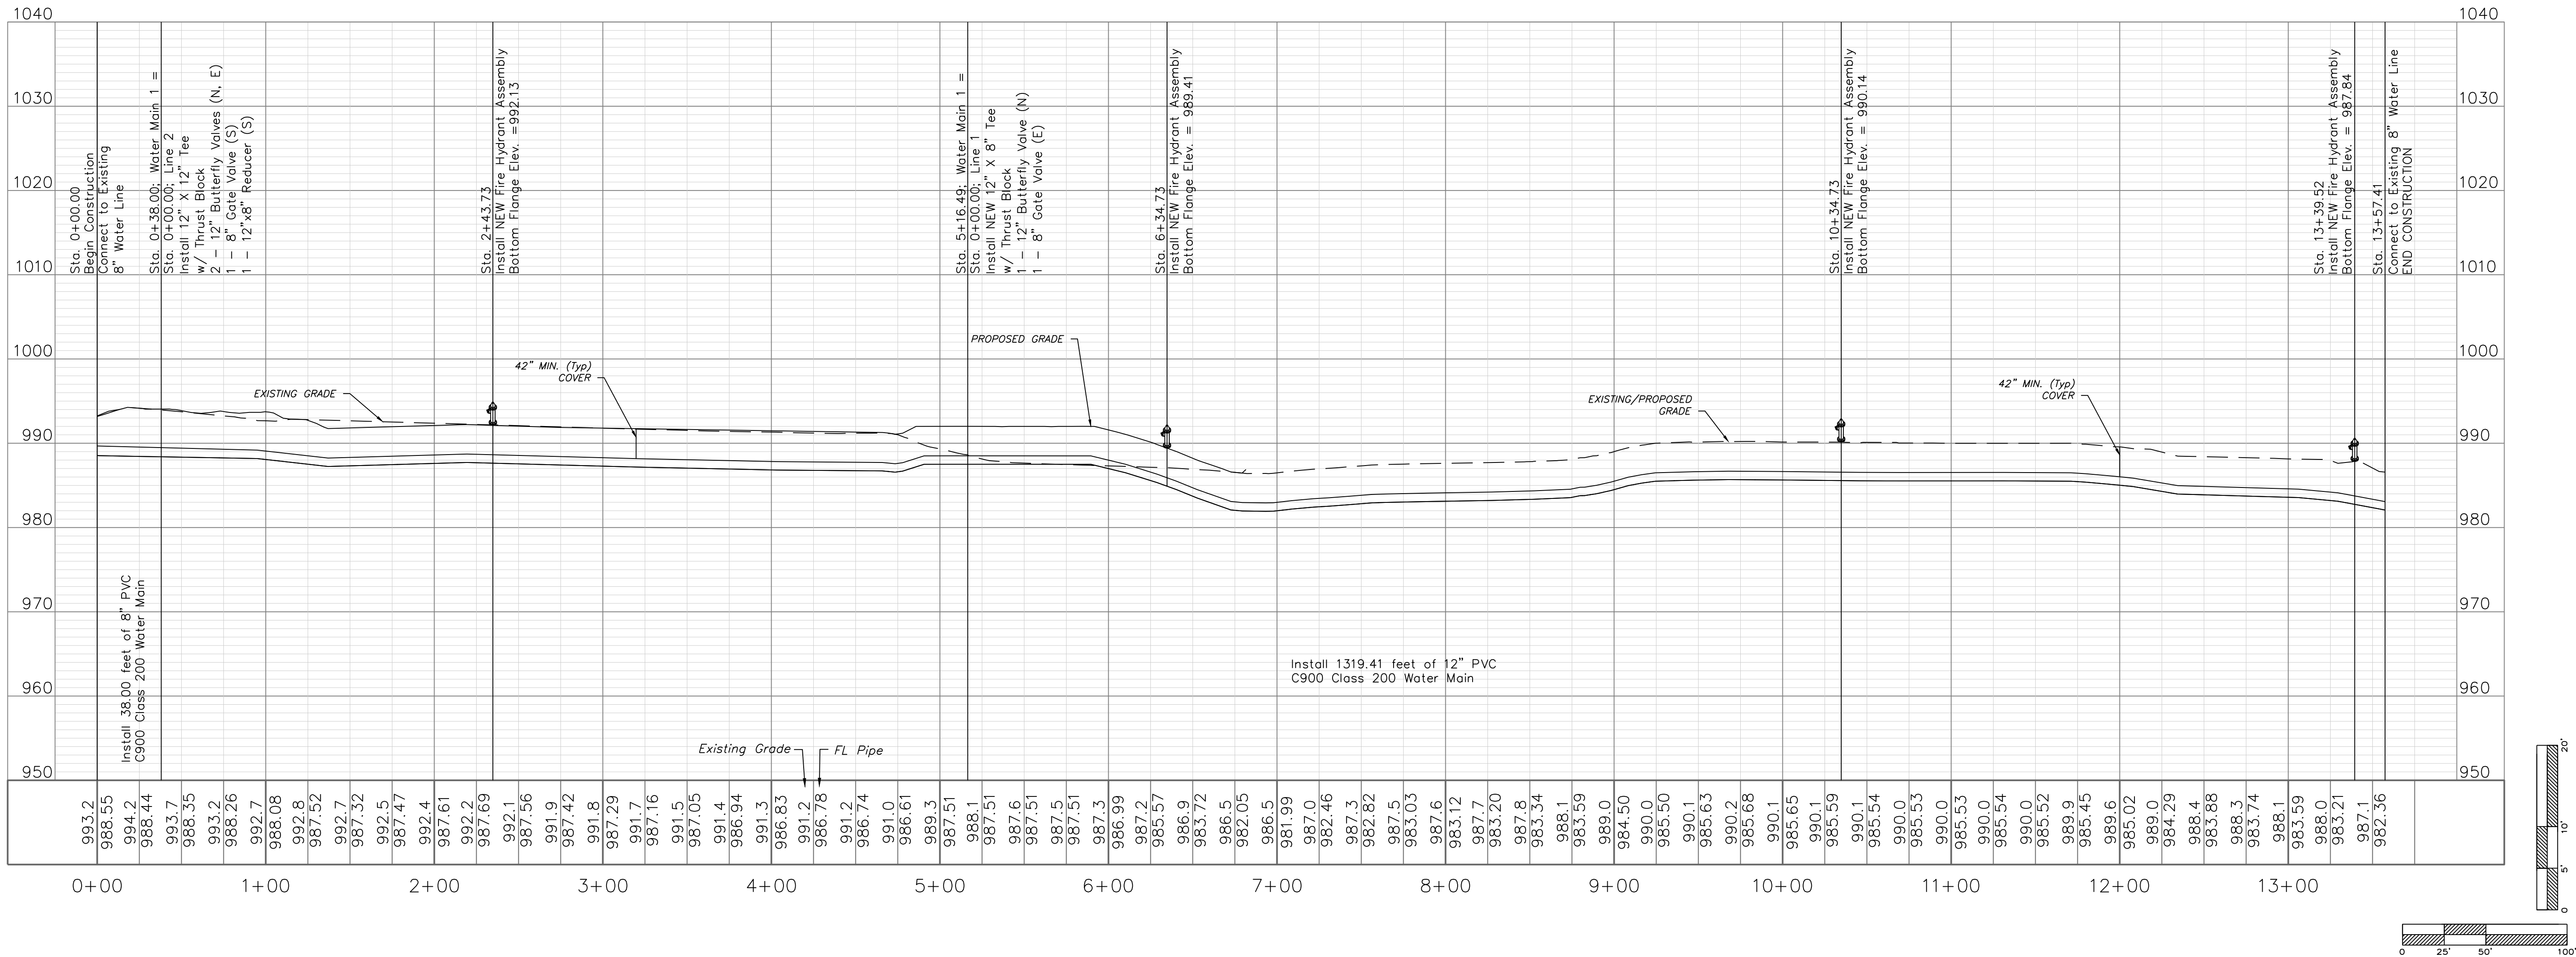


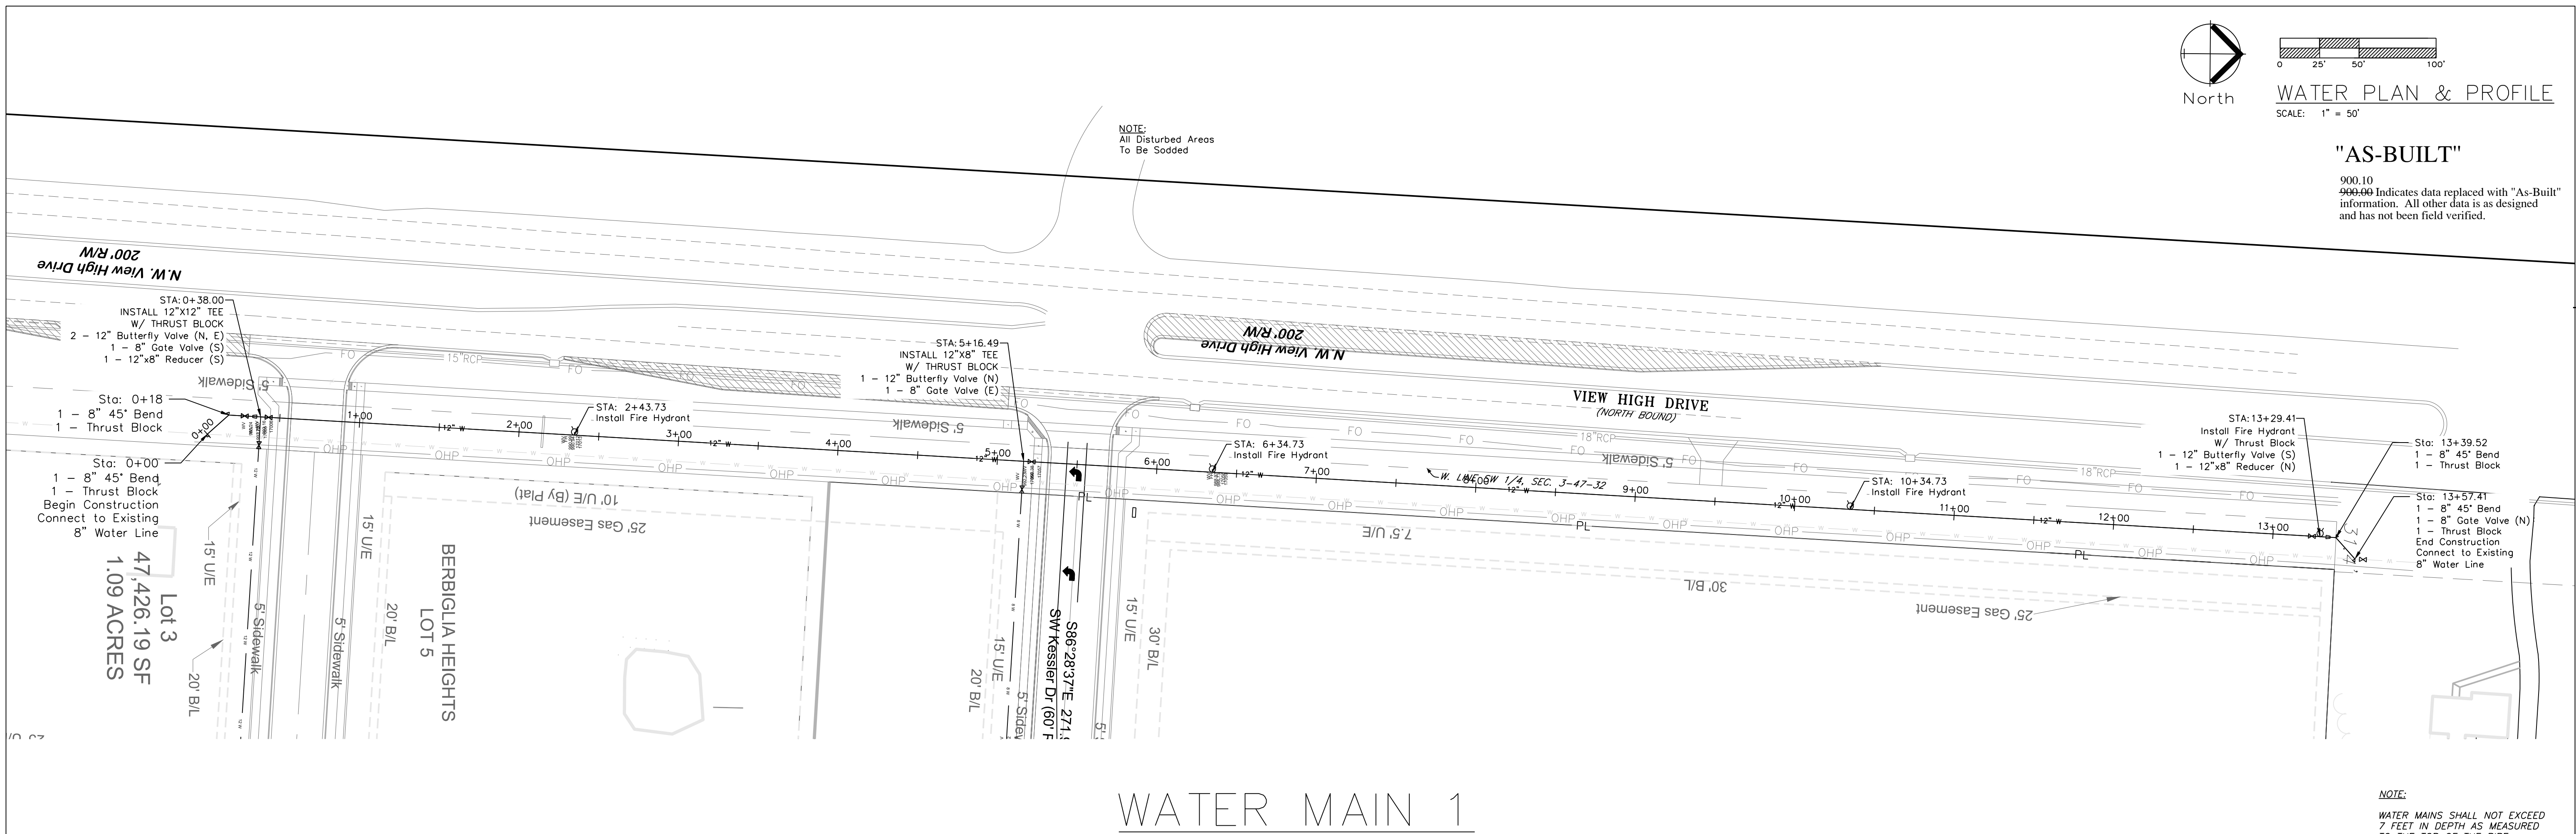

ENGINEERING SOLUTIONS
ENGINEERING & SURVEYING
50 SE 30TH STREET
LEE'S SUMMIT, MO 64082
P: (816) 623-9888 F: (816) 623-9849

Professional Registration
Missouri
Engineering 2005002188-D
Surveying 2005008192-D
Kansas
Engineering E-1696
Surveying LS-218
Oklahoma
Engineering 6254
Nebraska
Engineering CA2821




Water Line Plan and Profile
Construction Plans for:
Village at View High
Lee's Summit, Jackson County, Missouri



Project:
View High Project
Issue Date:
November 22, 2019

Matthew J. Schlicht
MO PE 2006019708
KS PE 19071
OK PE 55526

REVISIONS
11/22/19 As-Built


C. 502

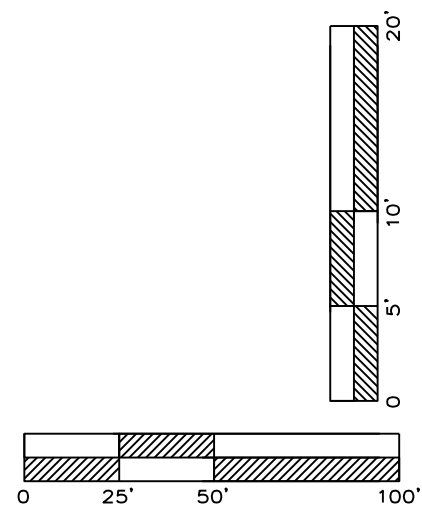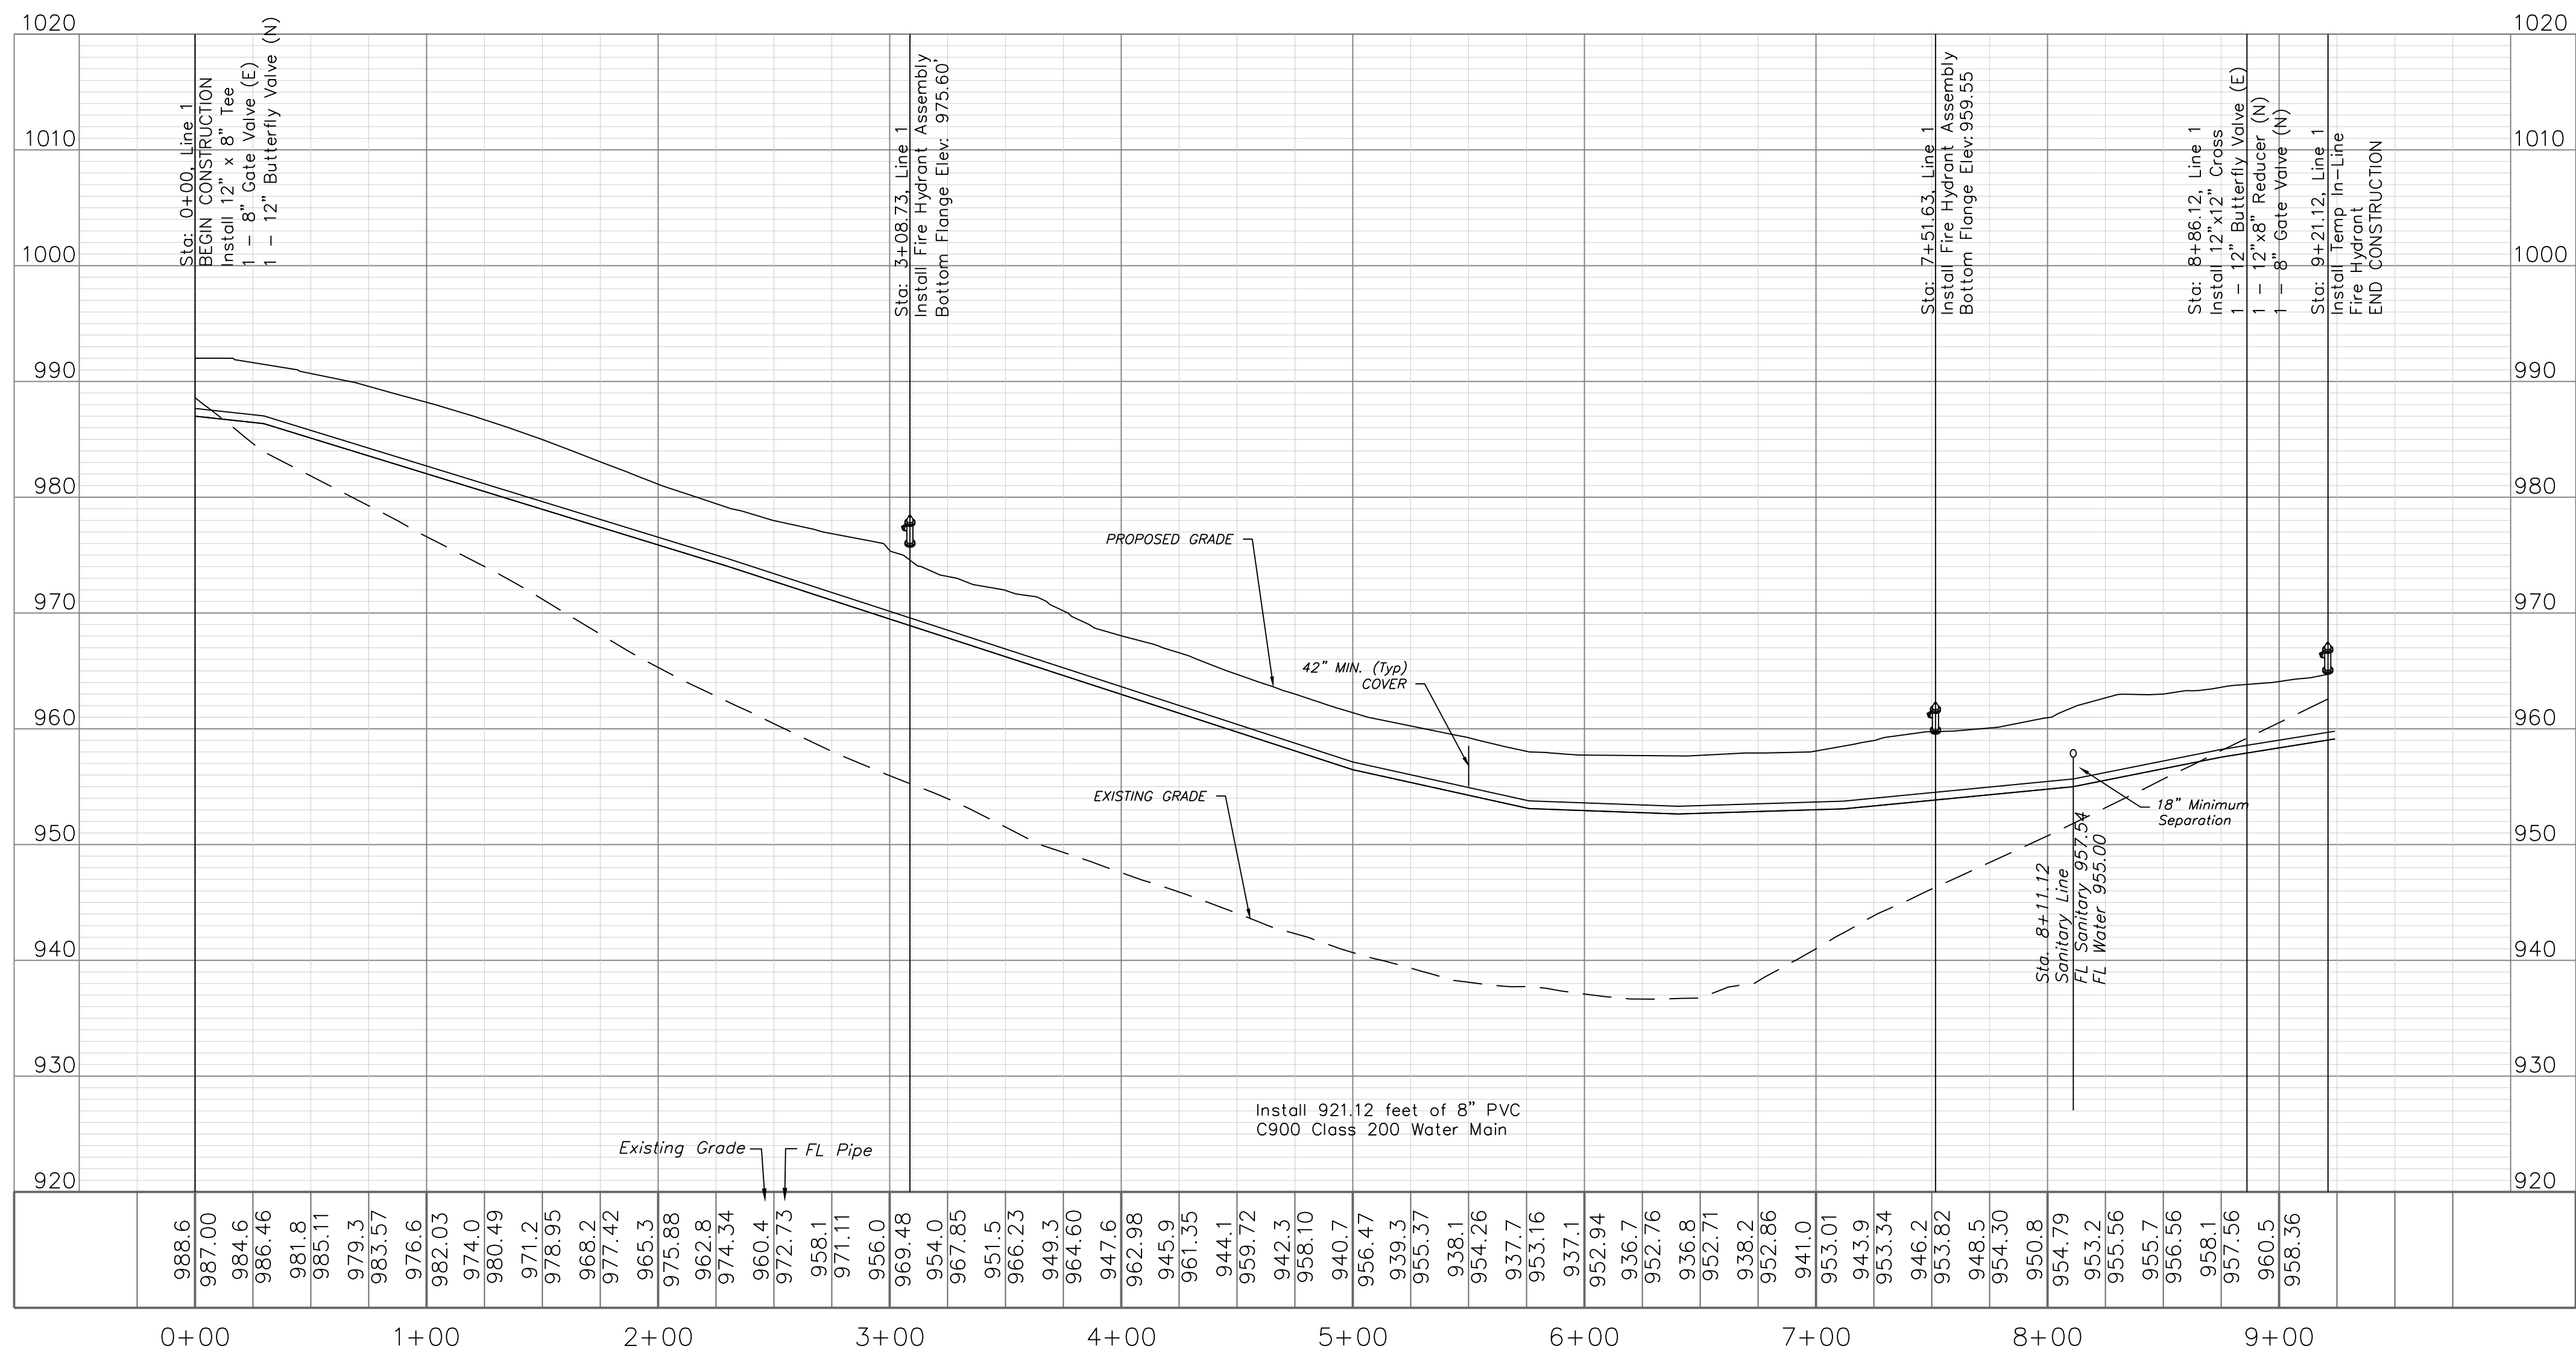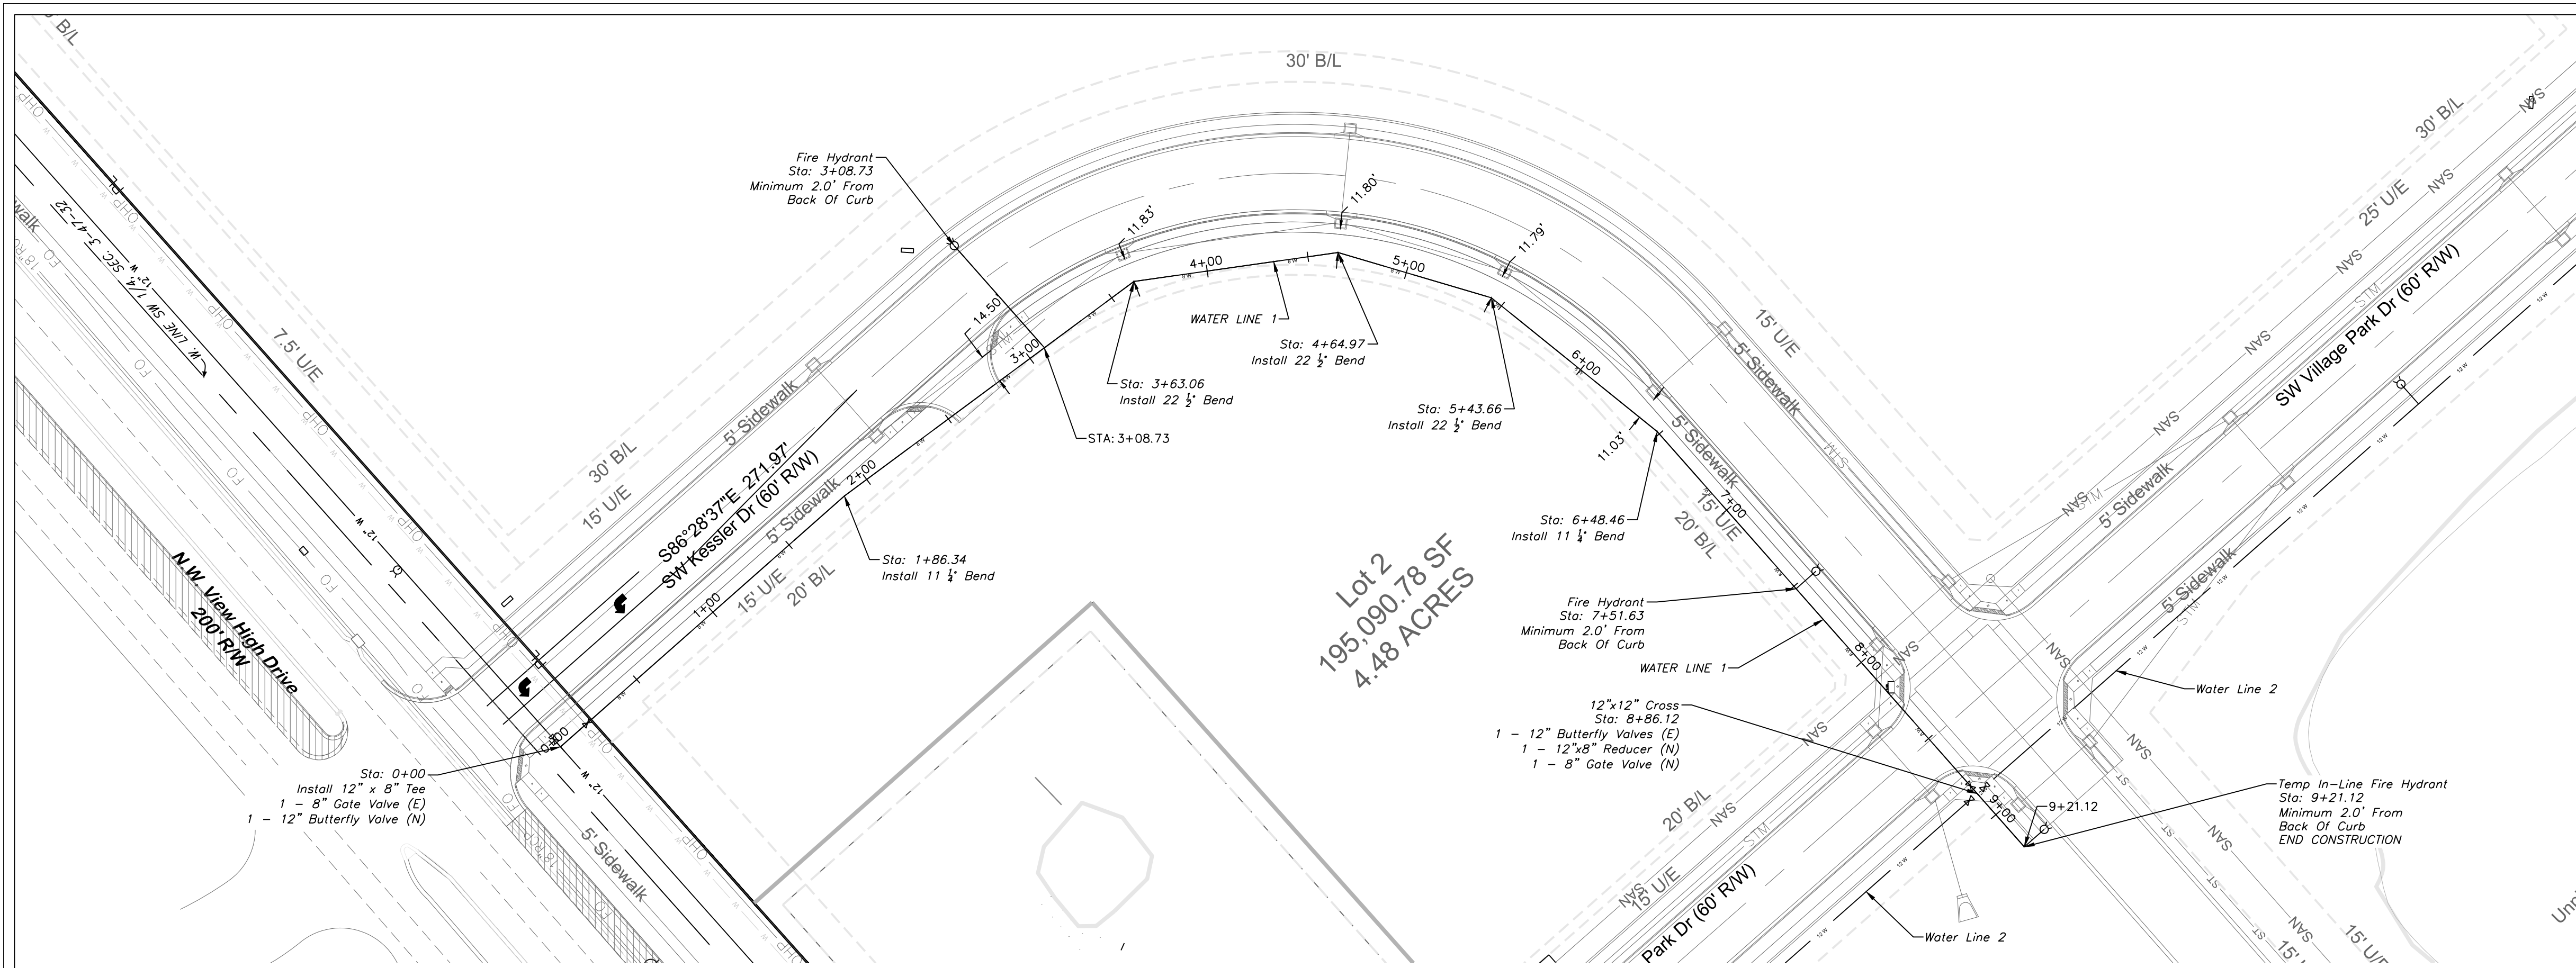

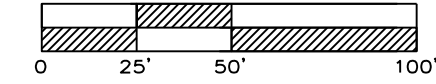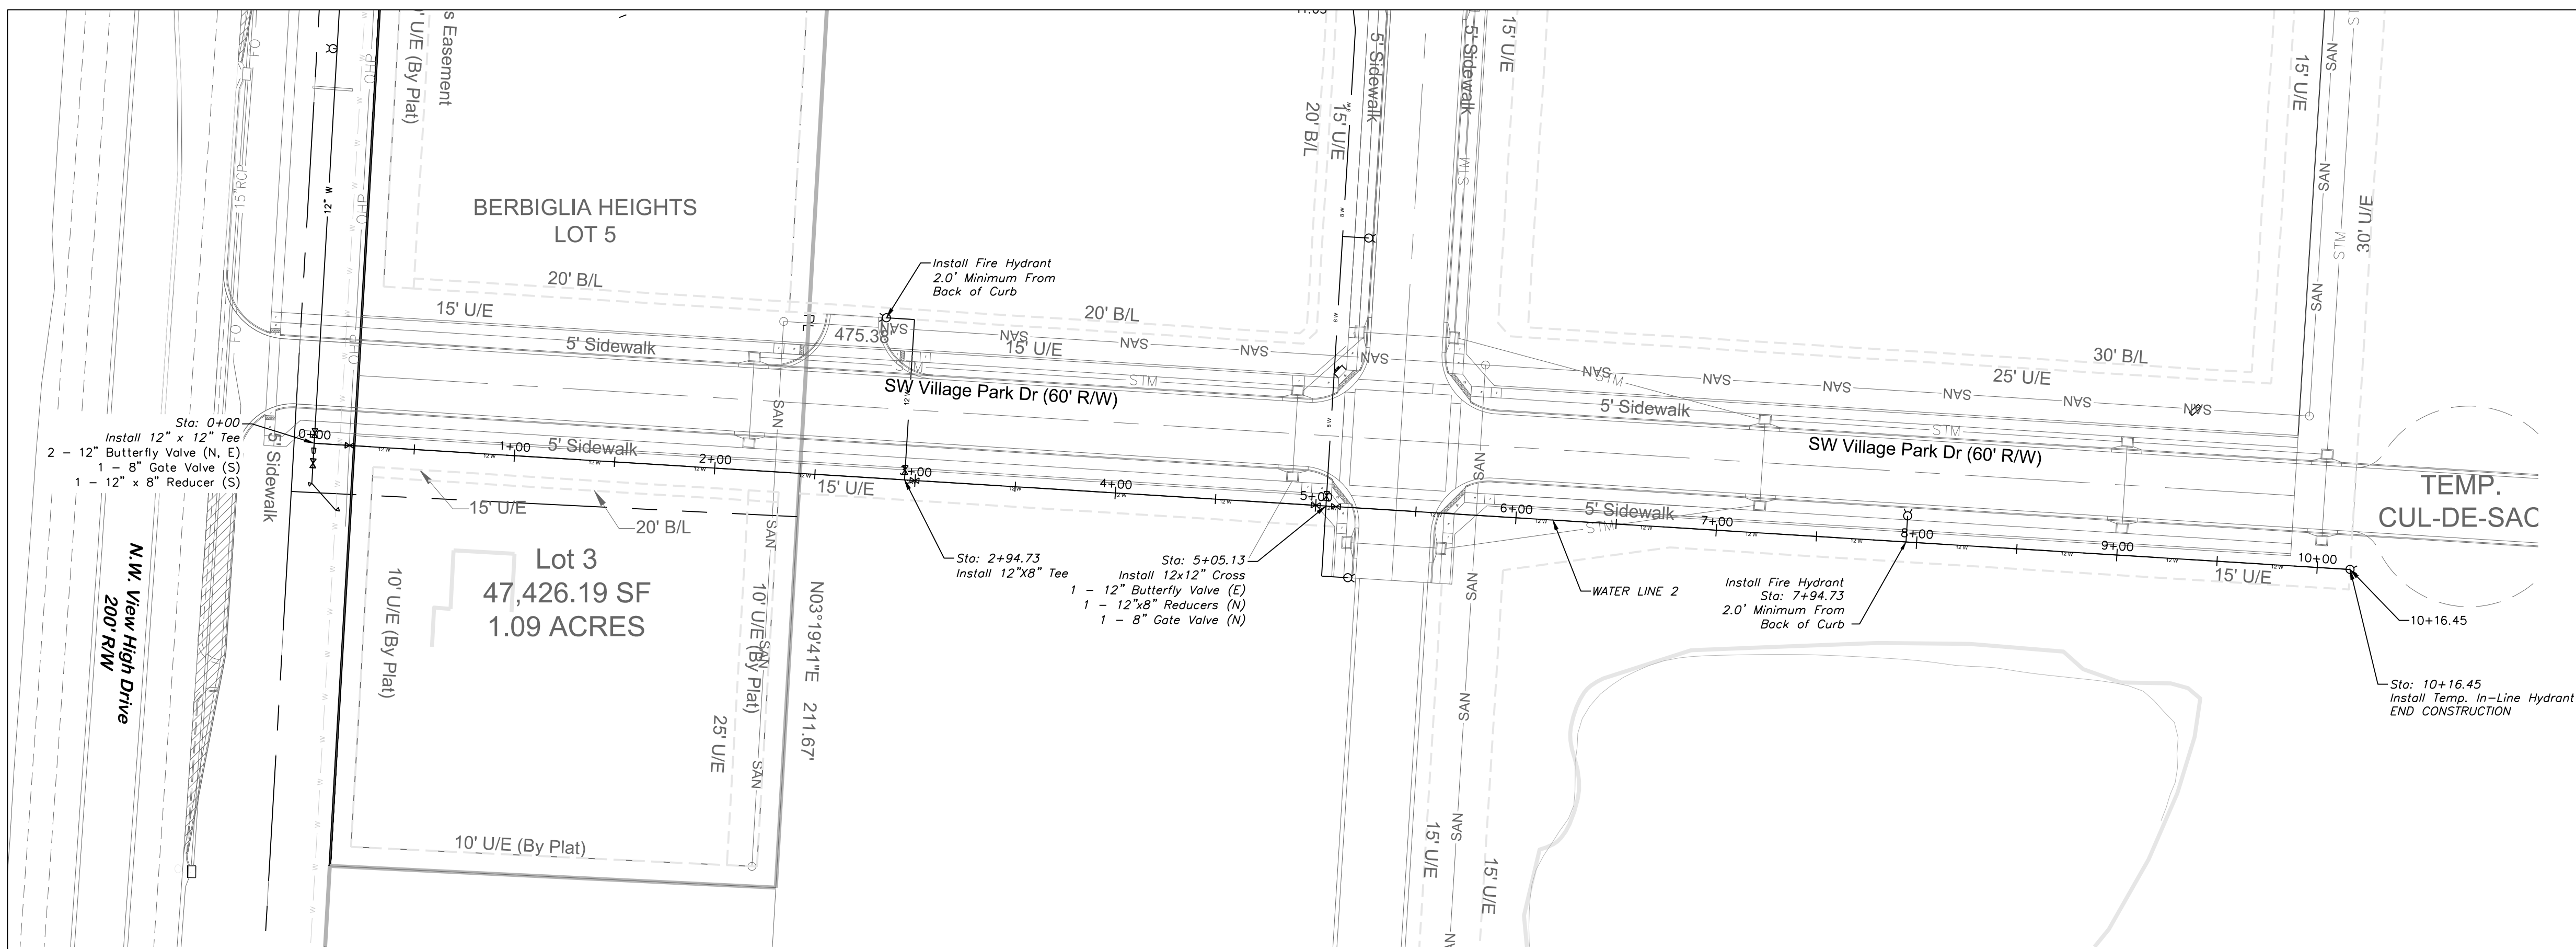


WATER PLAN & PROFILE
SCALE: 1" = 50'

WATER LINE 2

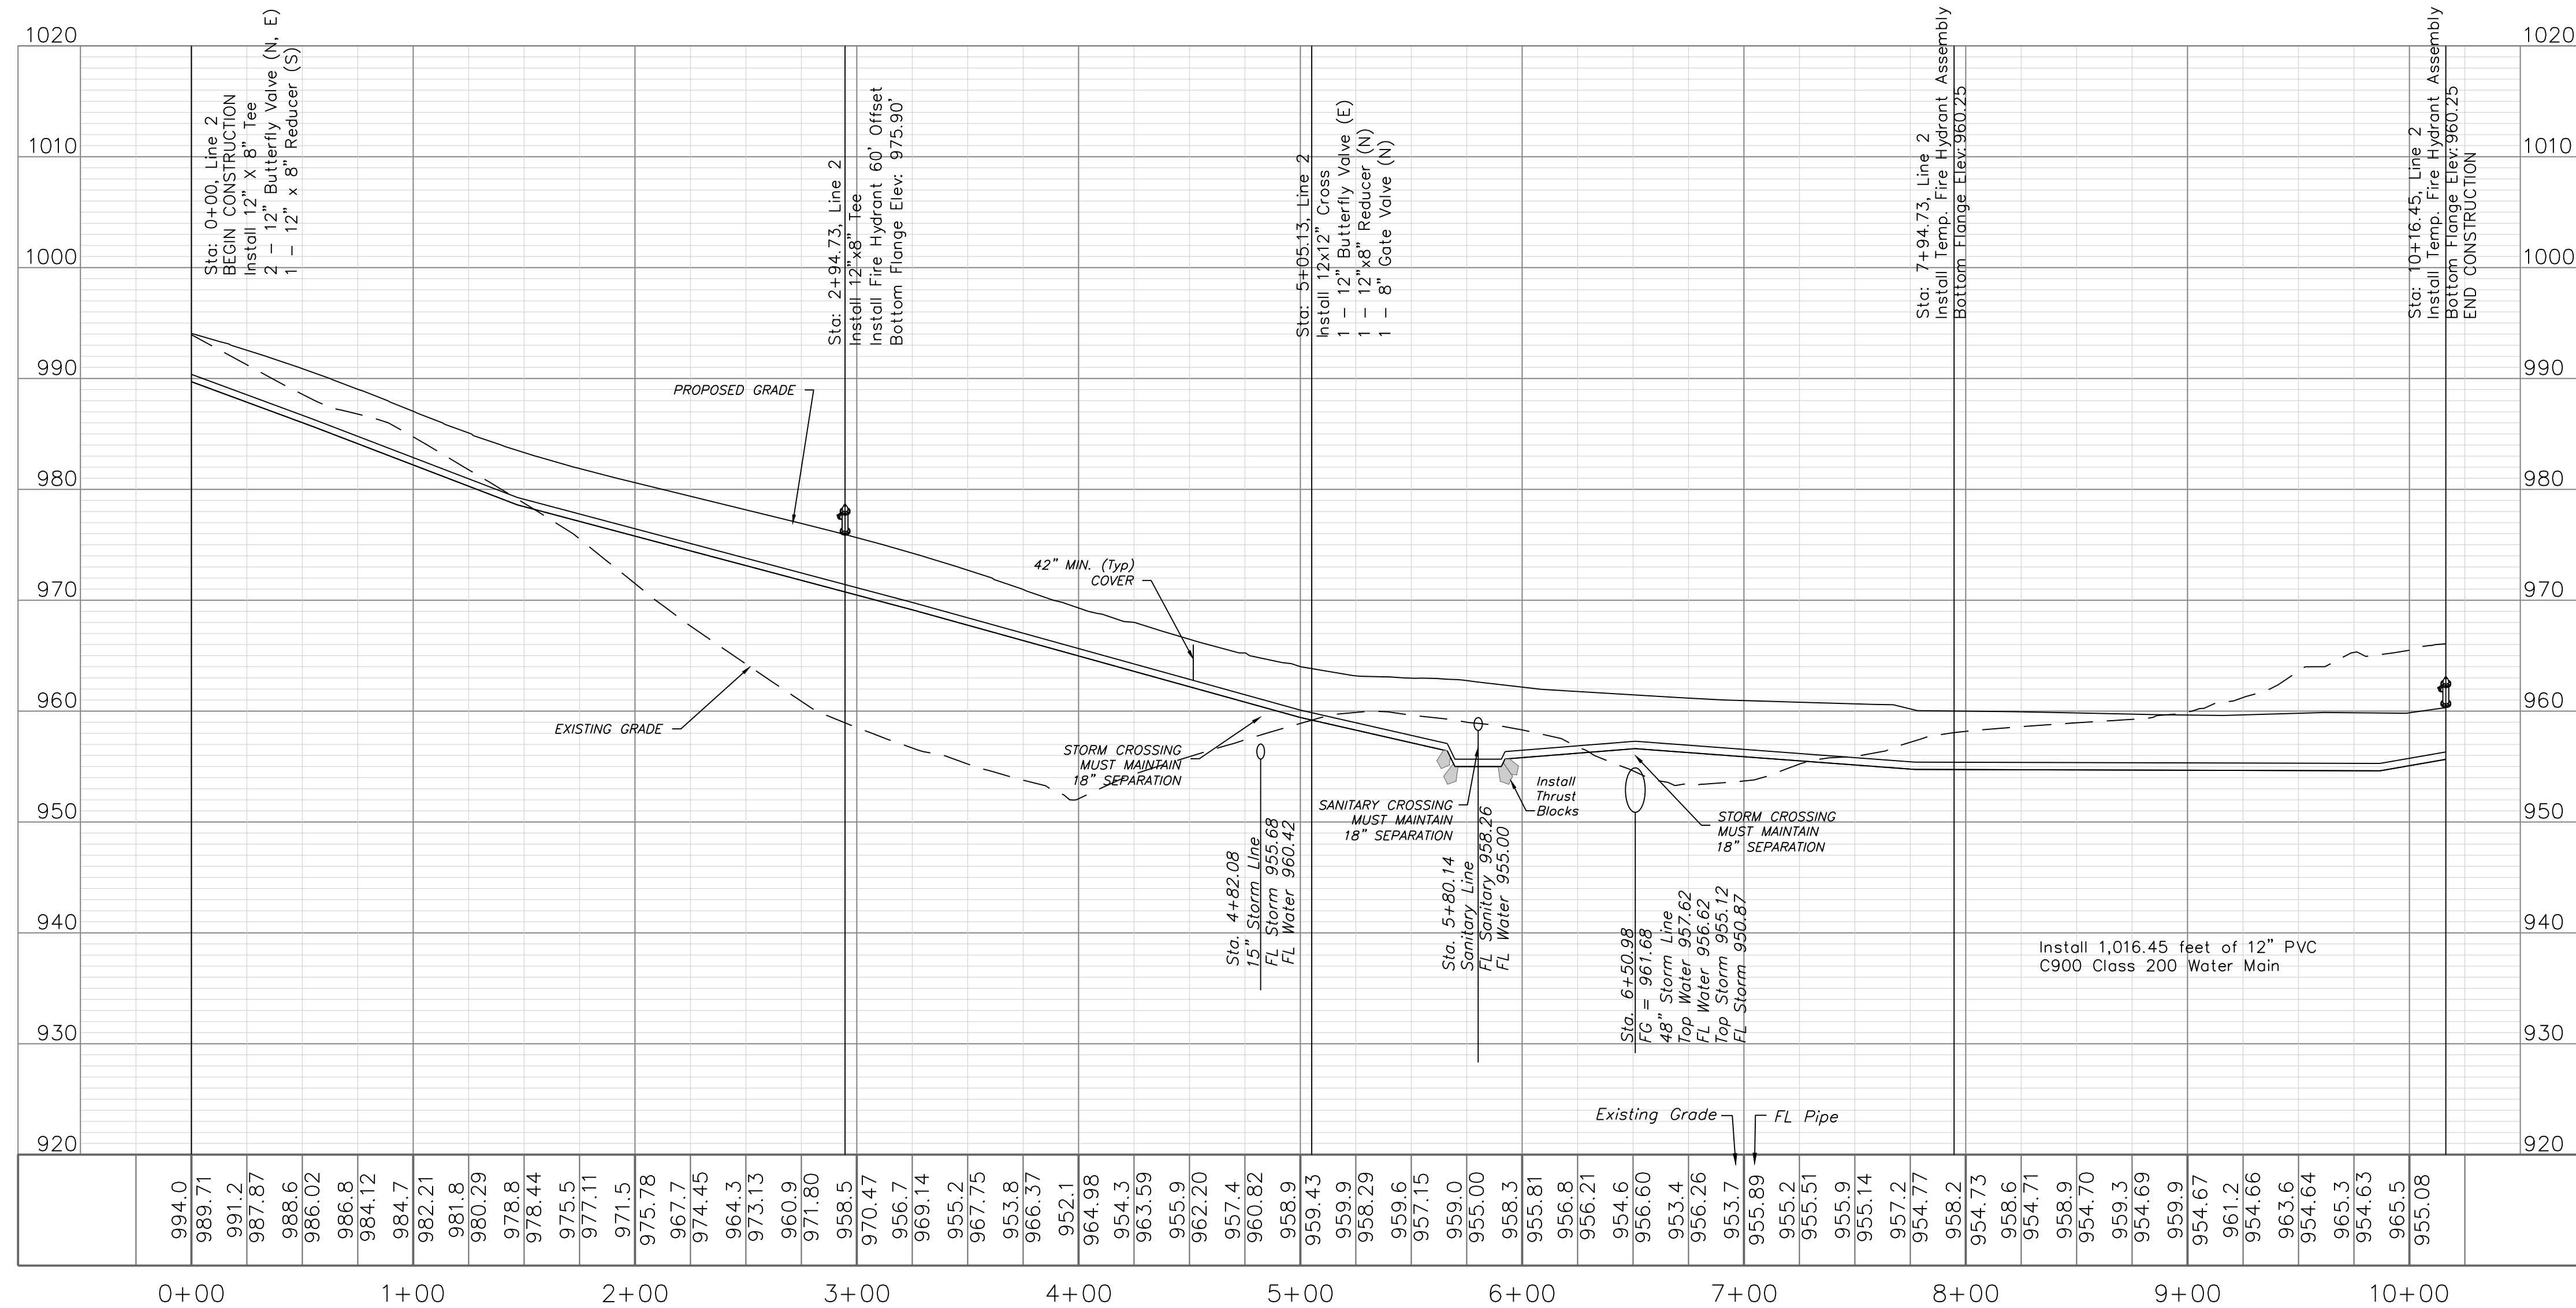

NOTE:
WATER MAINS SHALL NOT EXCEED
7 FEET IN DEPTH AS MEASURED
TO THE TOP OF THE PIPE.

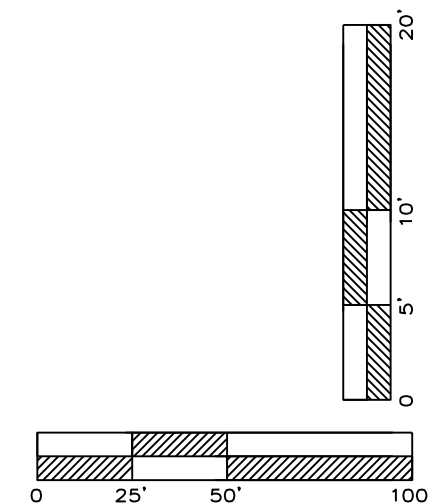

"AS-BUILT"

900.10
900.00 Indicates data replaced with "As-Built"
information. All other data is as designed
and has not been field verified.

Water Line Plan and Profile
Construction Plans for:
Village at View High
Lee's Summit, Jackson County, Missouri

Project:
View High Project
Issue Date:
November 22, 2019







Village At View High
Lee's Summit, Jackson County, Missouri



Professional Registration
Missouri
Engineering 2005002186-D
Surveying 2005003192-D
Kansas
Engineering E-1696
Surveying LS-218
Oklahoma
Engineering 6254
Nebraska
Engineering CA2821

Matthew J. Schlicht
MO PE 2006019708
KS PE 19071
OK PE 25226

REVISIONS
11/22/19 As-Built

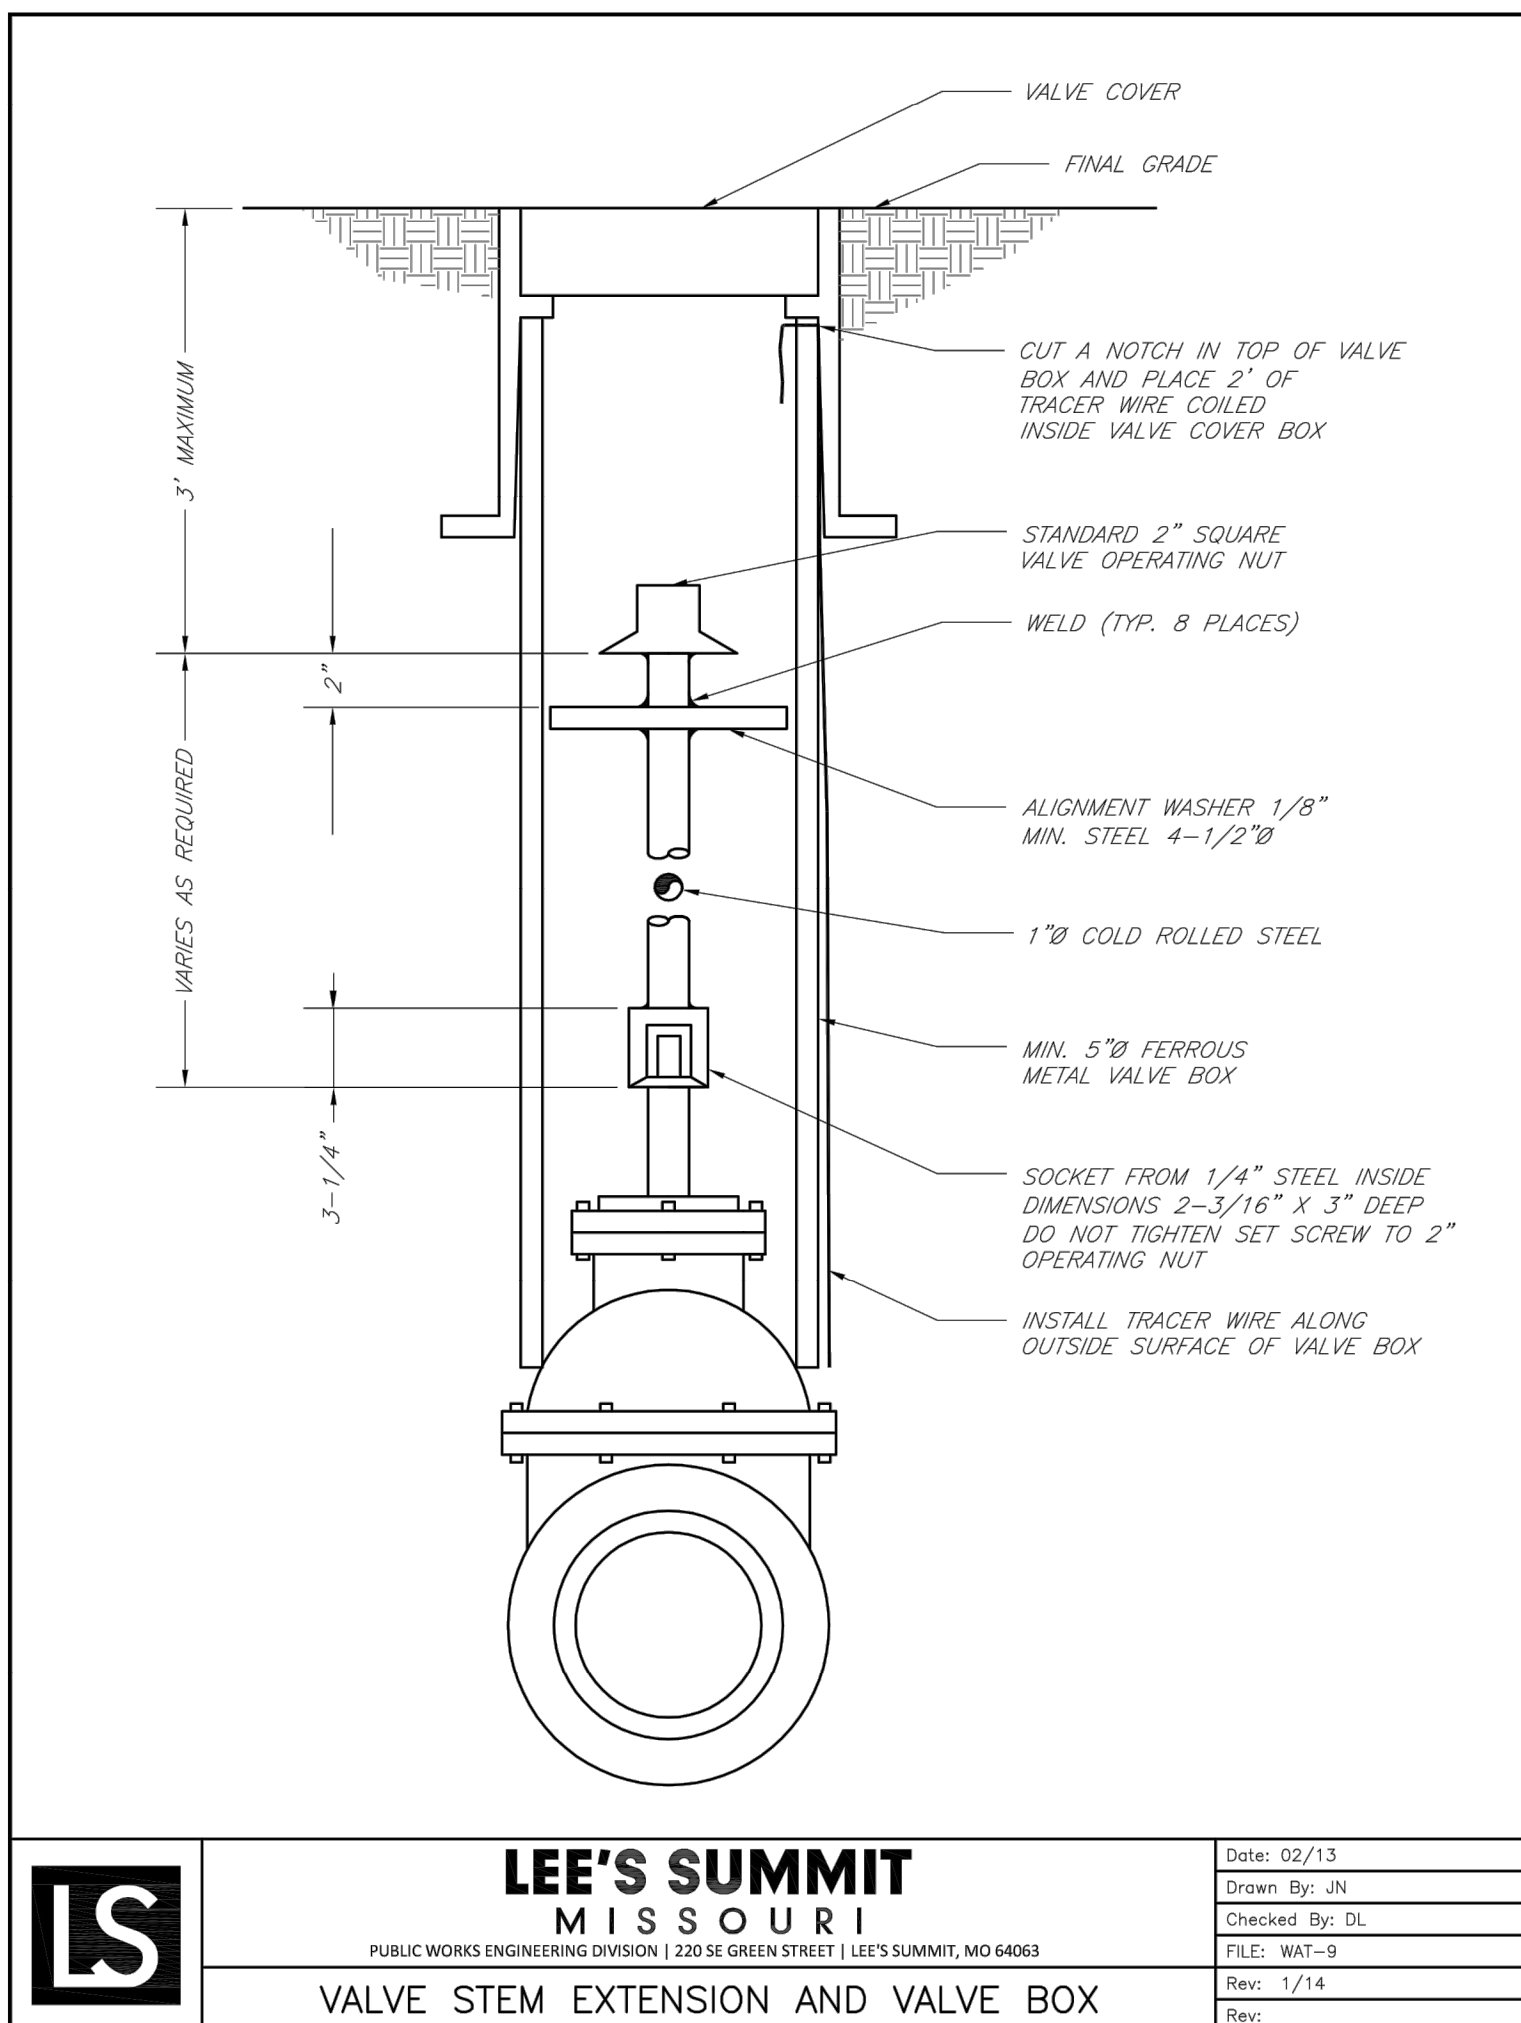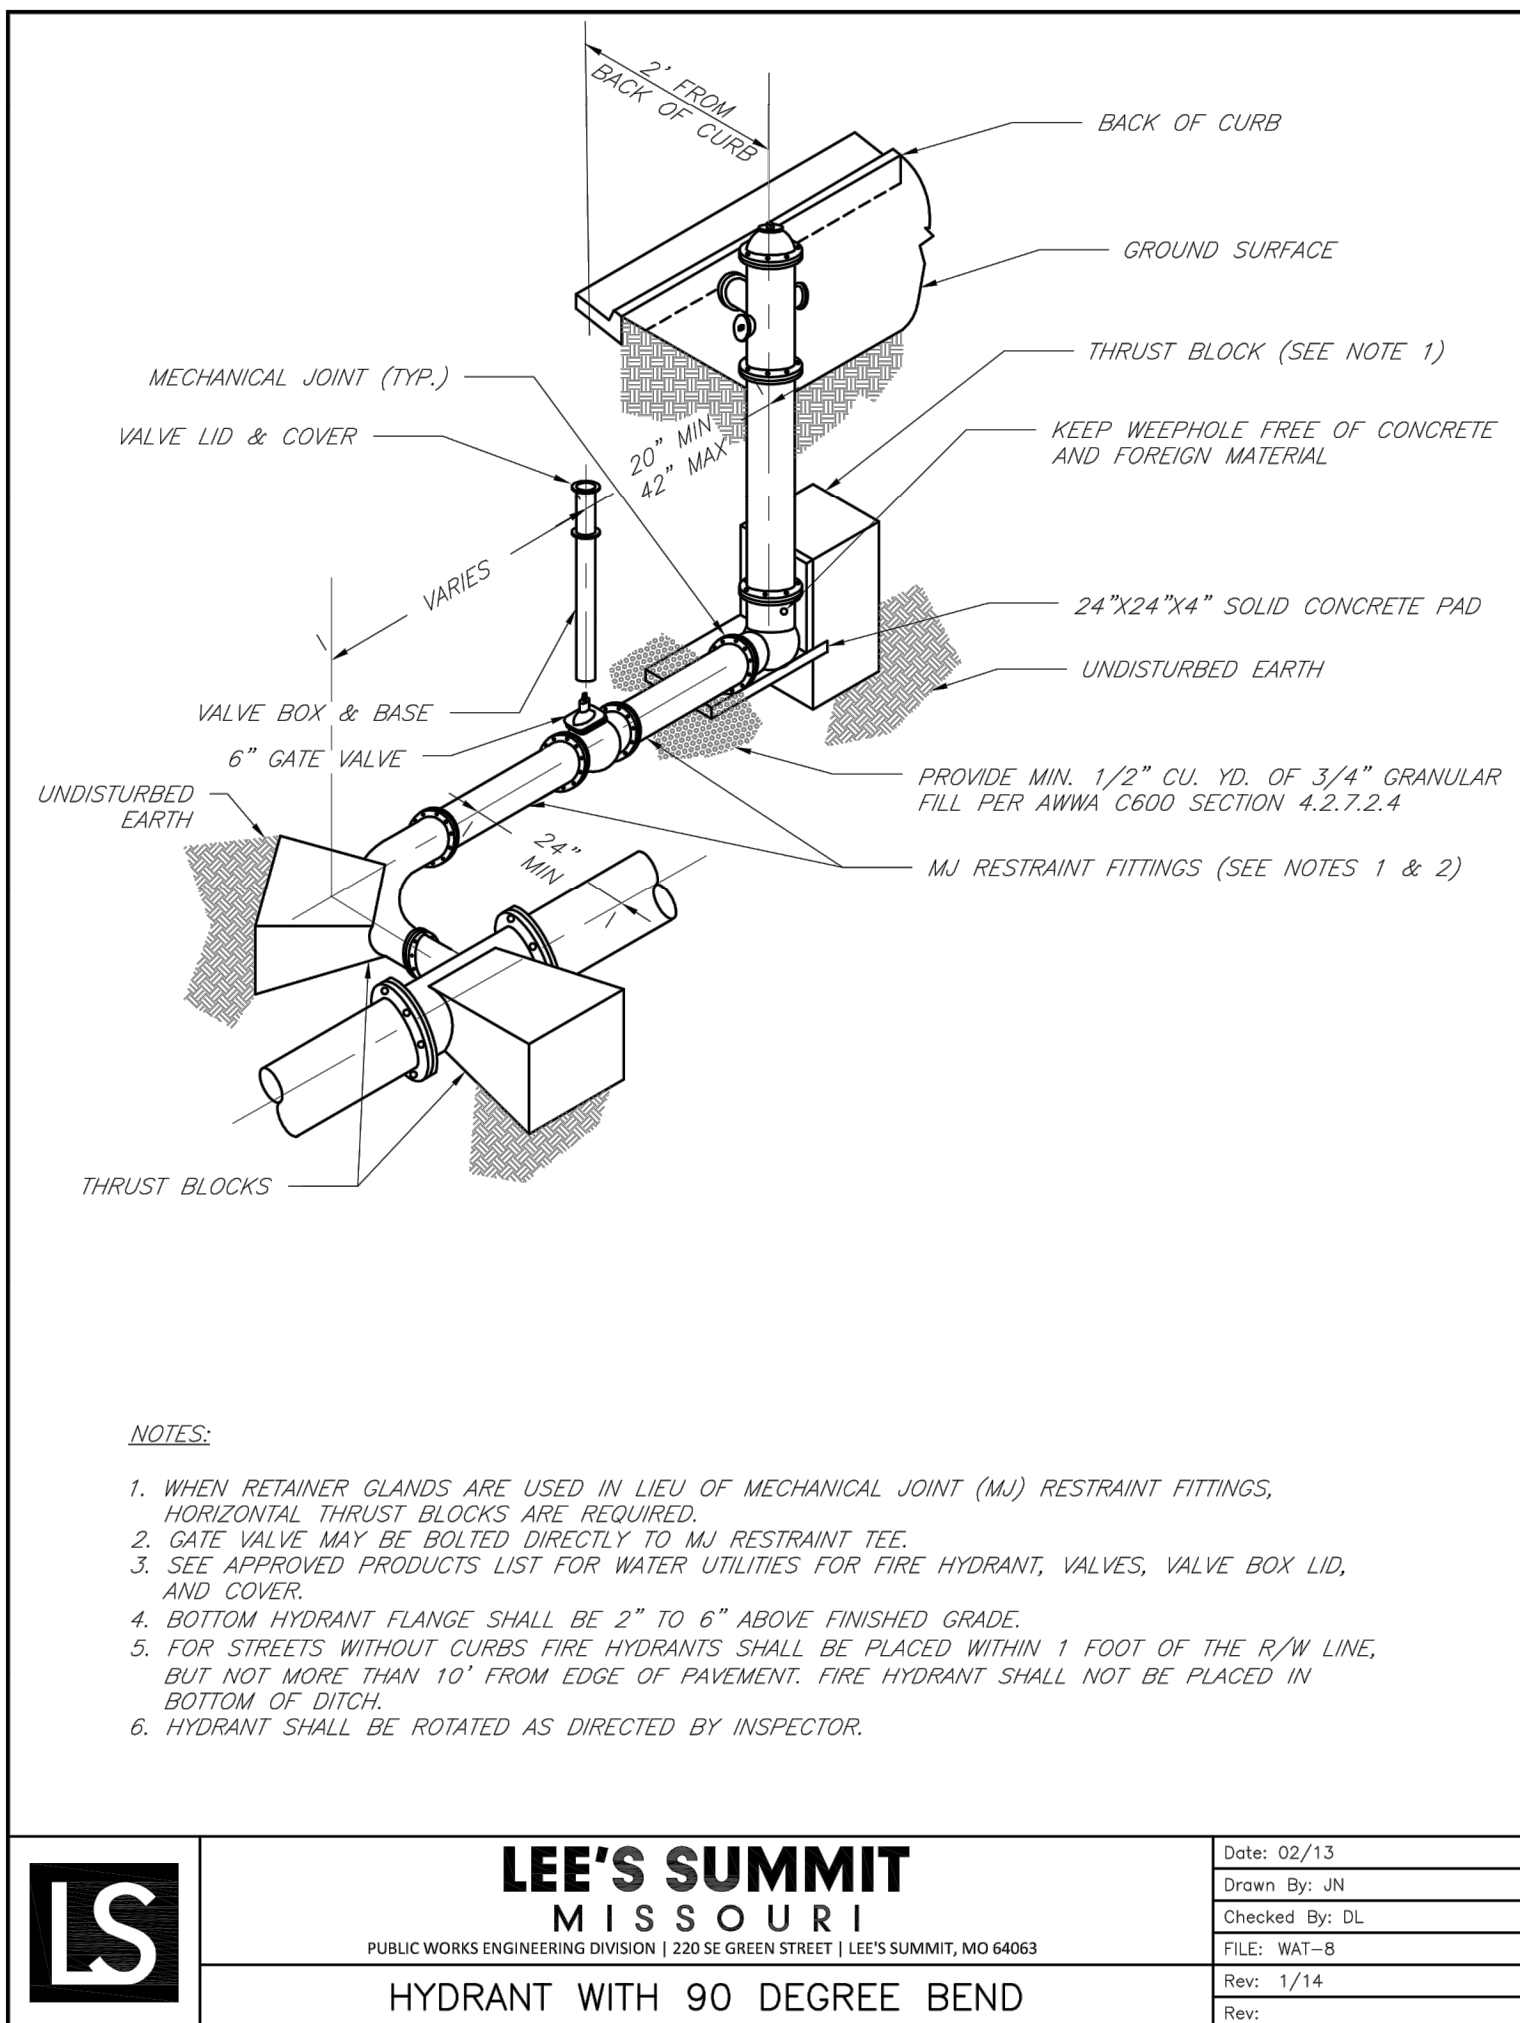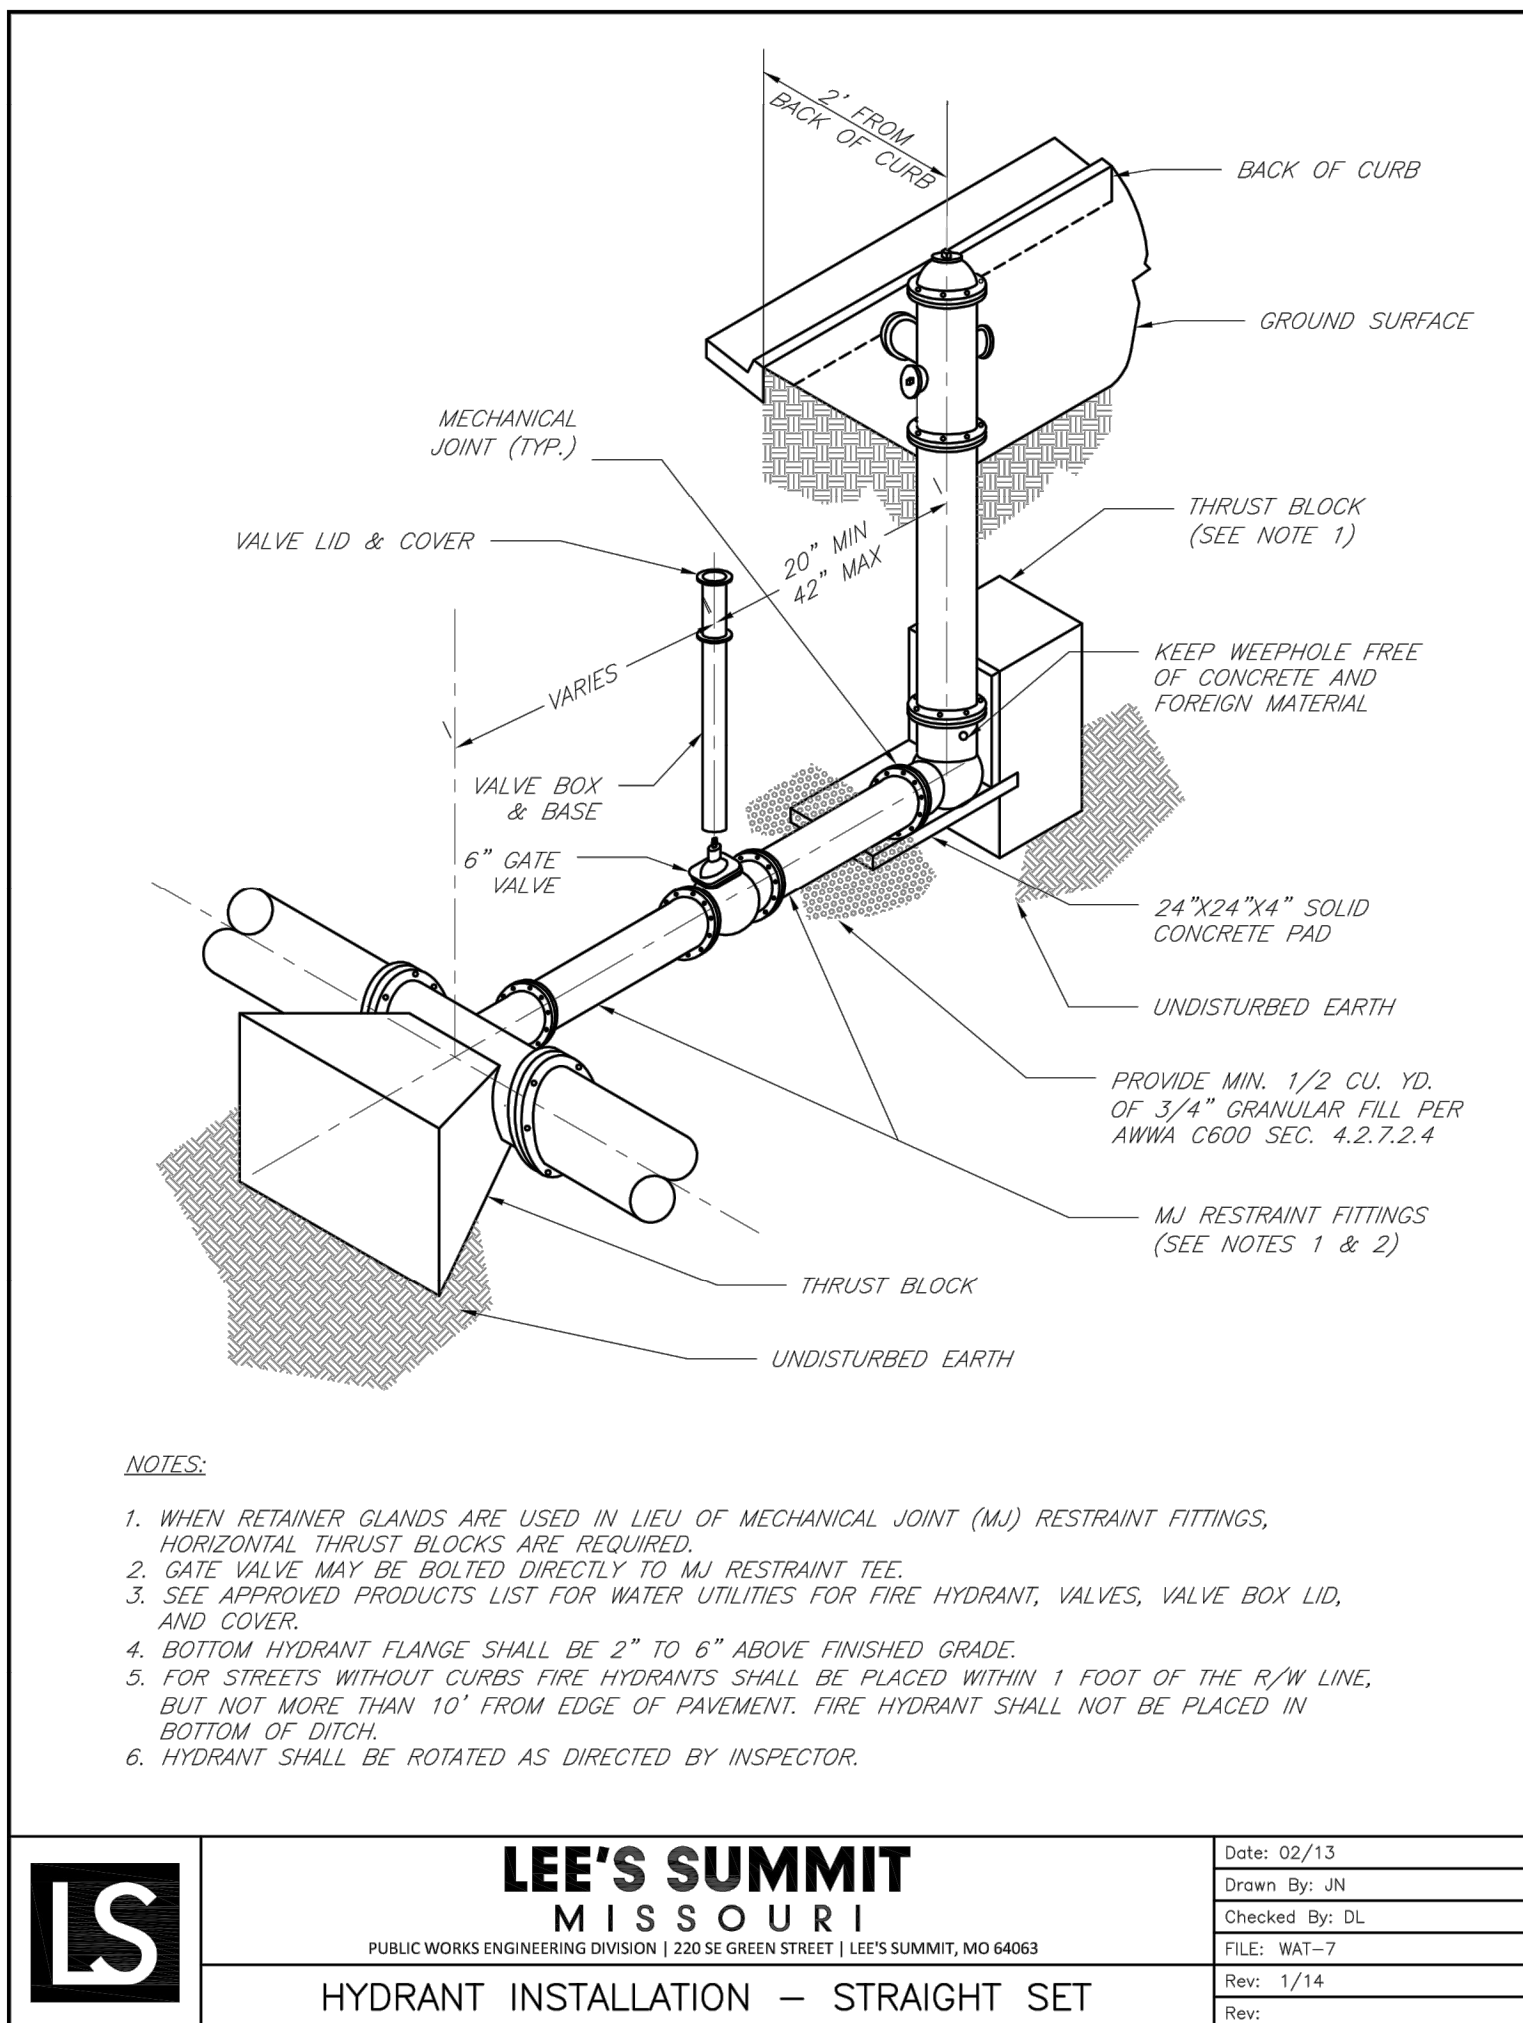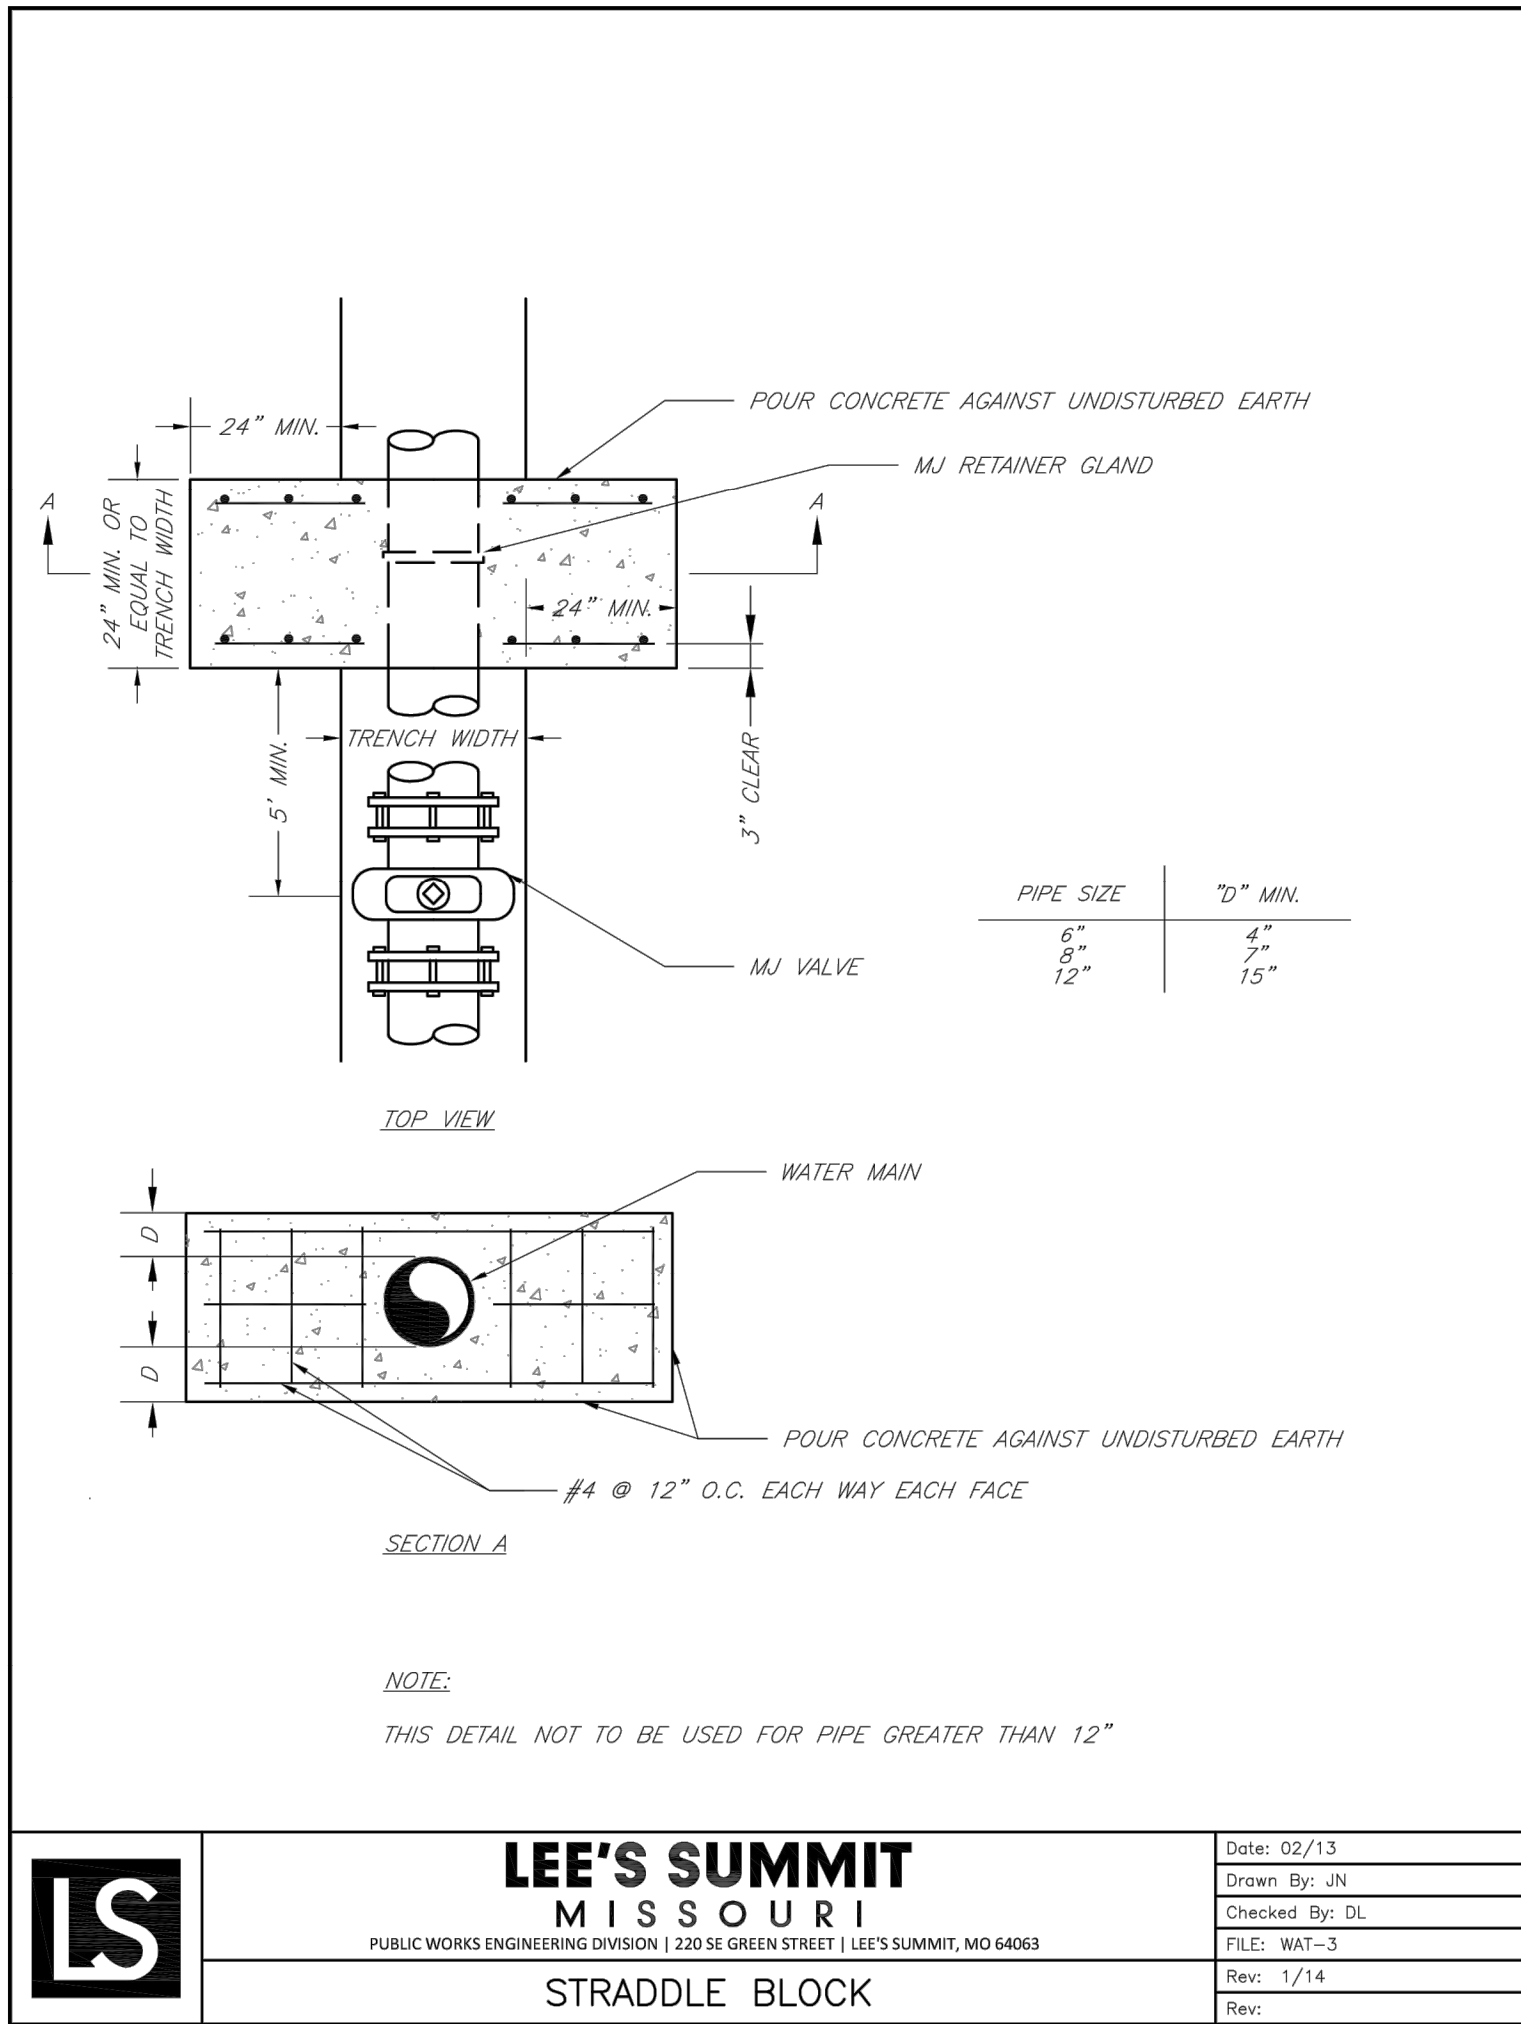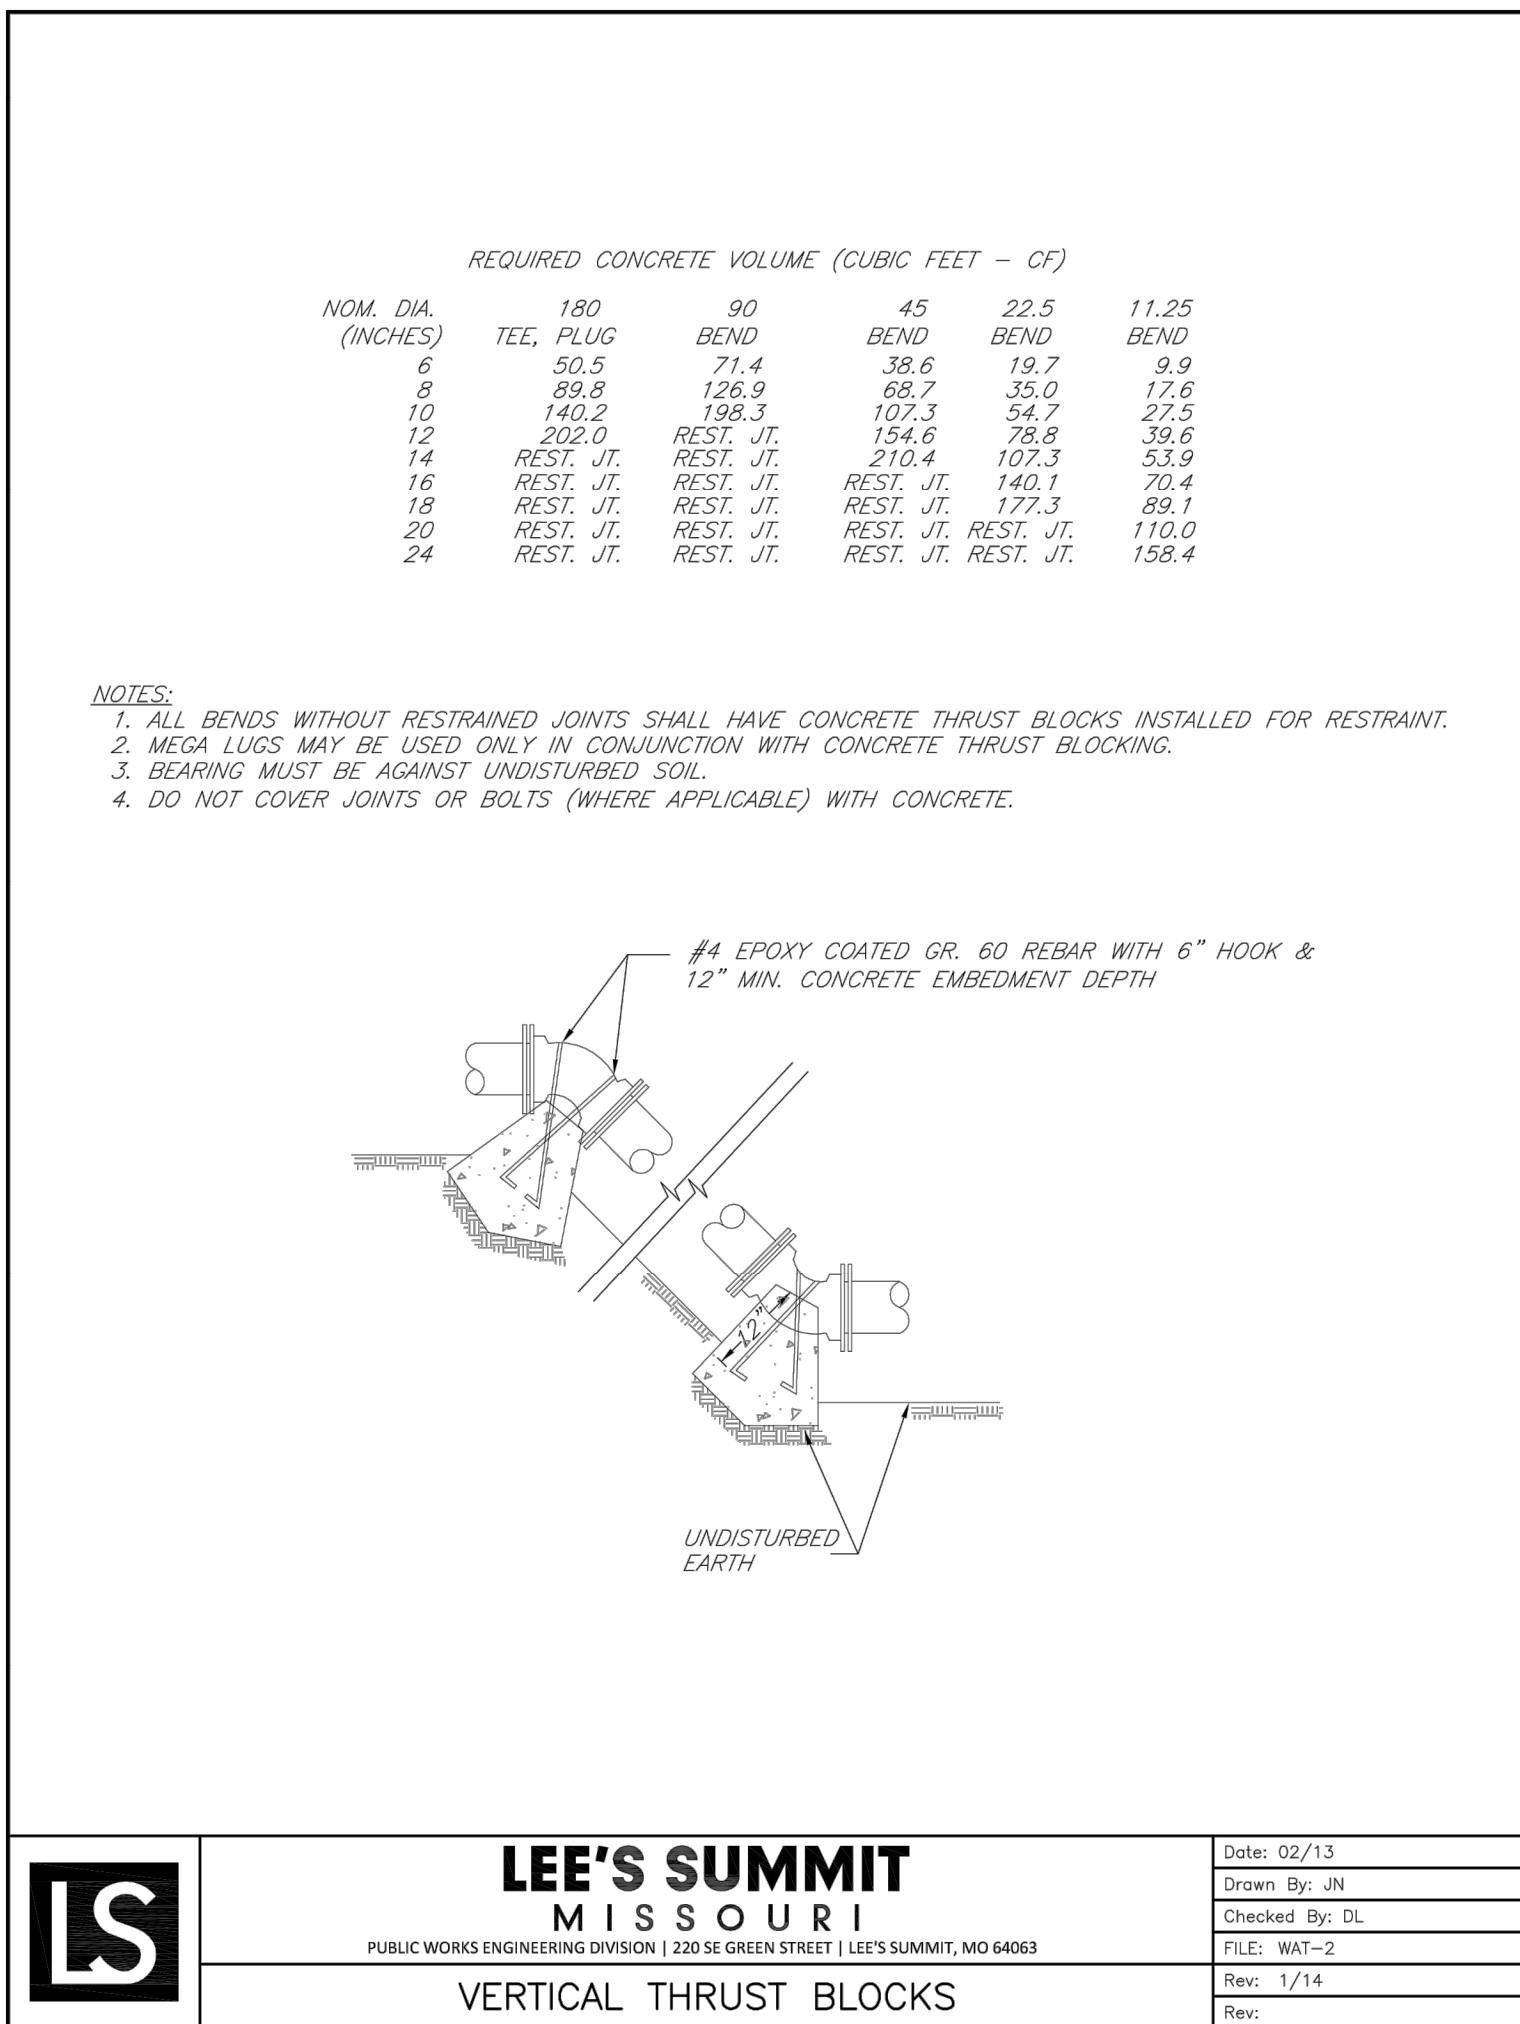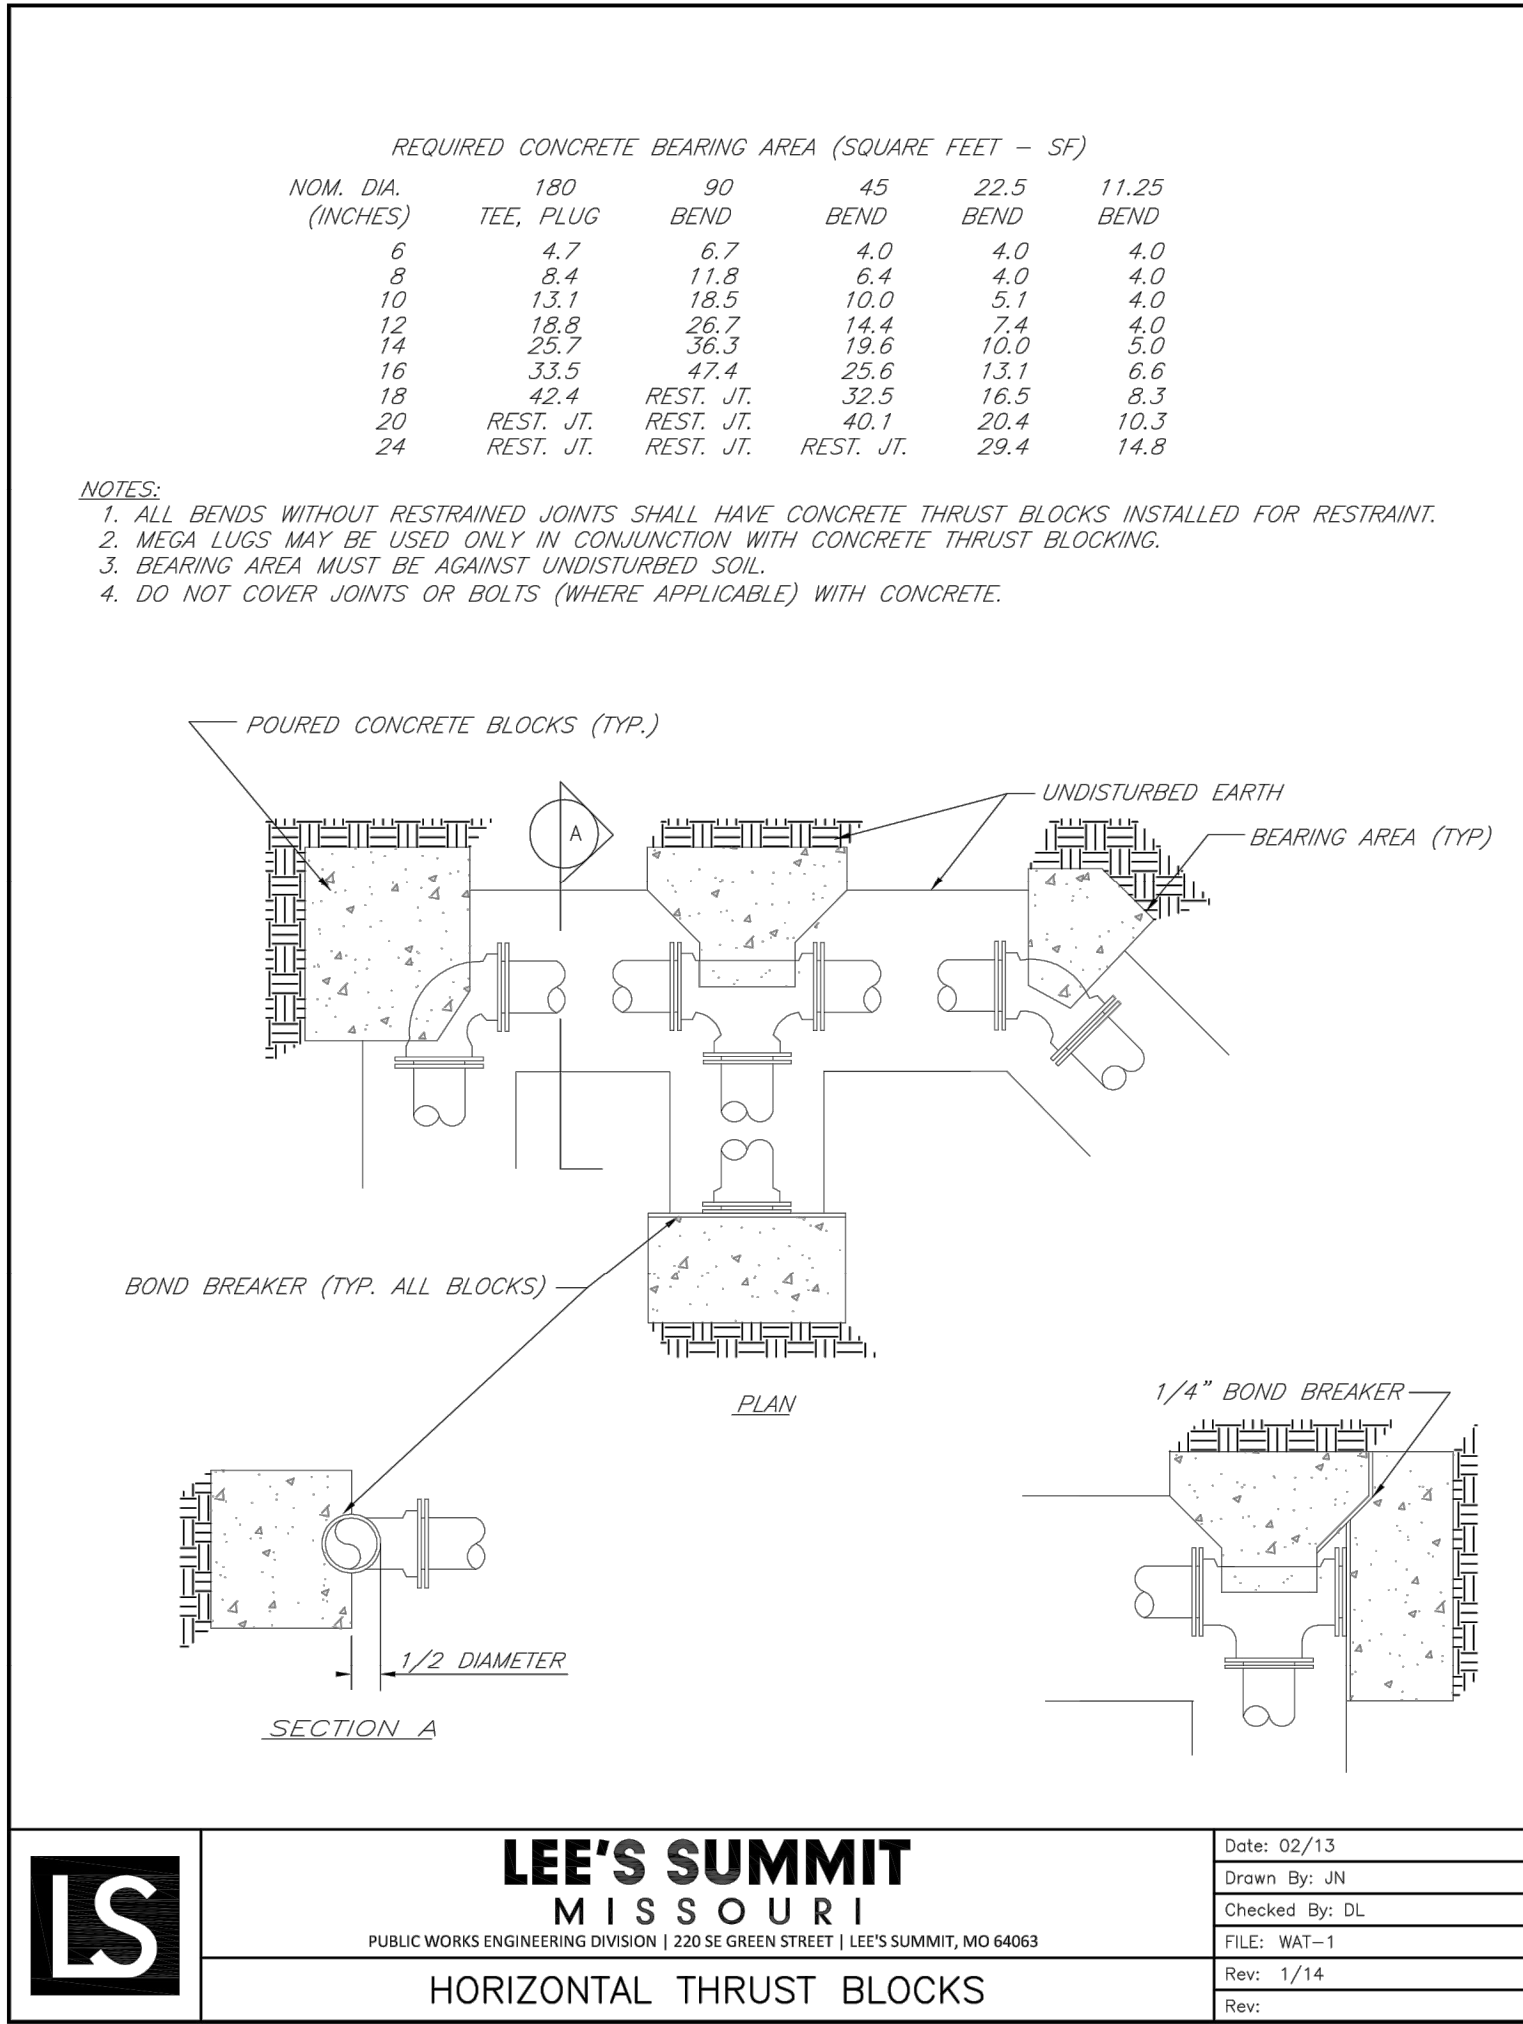

"AS-BUILT"

900.10
~~900.00~~ Indicates data replaced with "As-Built" information. All other data is as designed and has not been field verified.