



**LEE'S SUMMIT
MISSOURI**

**RELEASE FOR LAWN SPRINKLER SYSTEM
IN CITY OF LEE'S SUMMIT RIGHT OF WAY
(RESIDENTIAL)**

In consideration for the City of Lee's Summit's permission to extend a Lawn Irrigation System into the City's right of way at (legal description of the property):

Lot No. 103 Plat Title PERDOLA PARK Address: 3221 SW MARY ST.

County: JACKSON State: MISSOURI

I, Troy Bellah, the undersigned, successors, and assigns do hereby release and forever discharge the City of Lee's Summit, its employees and/or agents from and against any and all liability, claims and demands for any use arising out of, relating to, or being in any way connected with work or service by the City, its employees or agents within the City's right of way for any purpose whatsoever.

NOW THEREFORE, the Undersigned hereby declares that said property described above shall be held, sold and conveyed subject to the release herein and said release shall run with the real property and be binding on all parties having any part thereof, their heirs, successors and assigns.

IN WITNESS WHEREOF, this release has been read, signed and sealed this 17th day of AUGUST, 20 20.

By: [Signature]
Troy Bellah
Printed or Typed Name

INDIVIDUAL ACKNOWLEDGMENT

STATE OF MISSOURI
COUNTY OF JACKSON

ON THIS, The 17 day of August, 20 20, before me, a Notary Public, personally appeared: _____
proved to me on the basis of satisfactory evidence to be the person(s) whose name(s) subscribed to the within instrument, and acknowledged that _____ he/she/they executed the same for the purposes stated therein and no other.

WITNESS my hand and official seal in the County and State aforesaid, the day and year first above written.

/s/ [Signature]
Notary Public Signature

Sherry Price
Printed or Typed Name

My Commission Expires:
4/29/2022



SHERRY L. PRICE
My Commission Expires
April 29, 2022
Jackson County
Commission #16533721

PLOT PLAN

DESCRIPTION: As Provided By: CLIENT


Lot 103, PERGOLA PARK – 4TH PLAT, a subdivision in Lee's Summit, Jackson County, Missouri.

LAWN SPRINKLER SYSTEM

TRI-COUNTY PLUMBING = INSTALLER
VALUATION = \$ 2,750.00

ADDRESS: 3221 SW Mary St

GARAGE FLOOR=948.5
TOP FOUNDATION=953.5
BASEMENT FLOOR=944.8
TOP EGRESS WELL=952.5
EGRESS WELL LAG=952.3
MBOE FRONT PER MDP=952.0
MBOE REAR PER MDP=947.6
MSFE PER ASBUILT=941.9
STANDARD BASEMENT

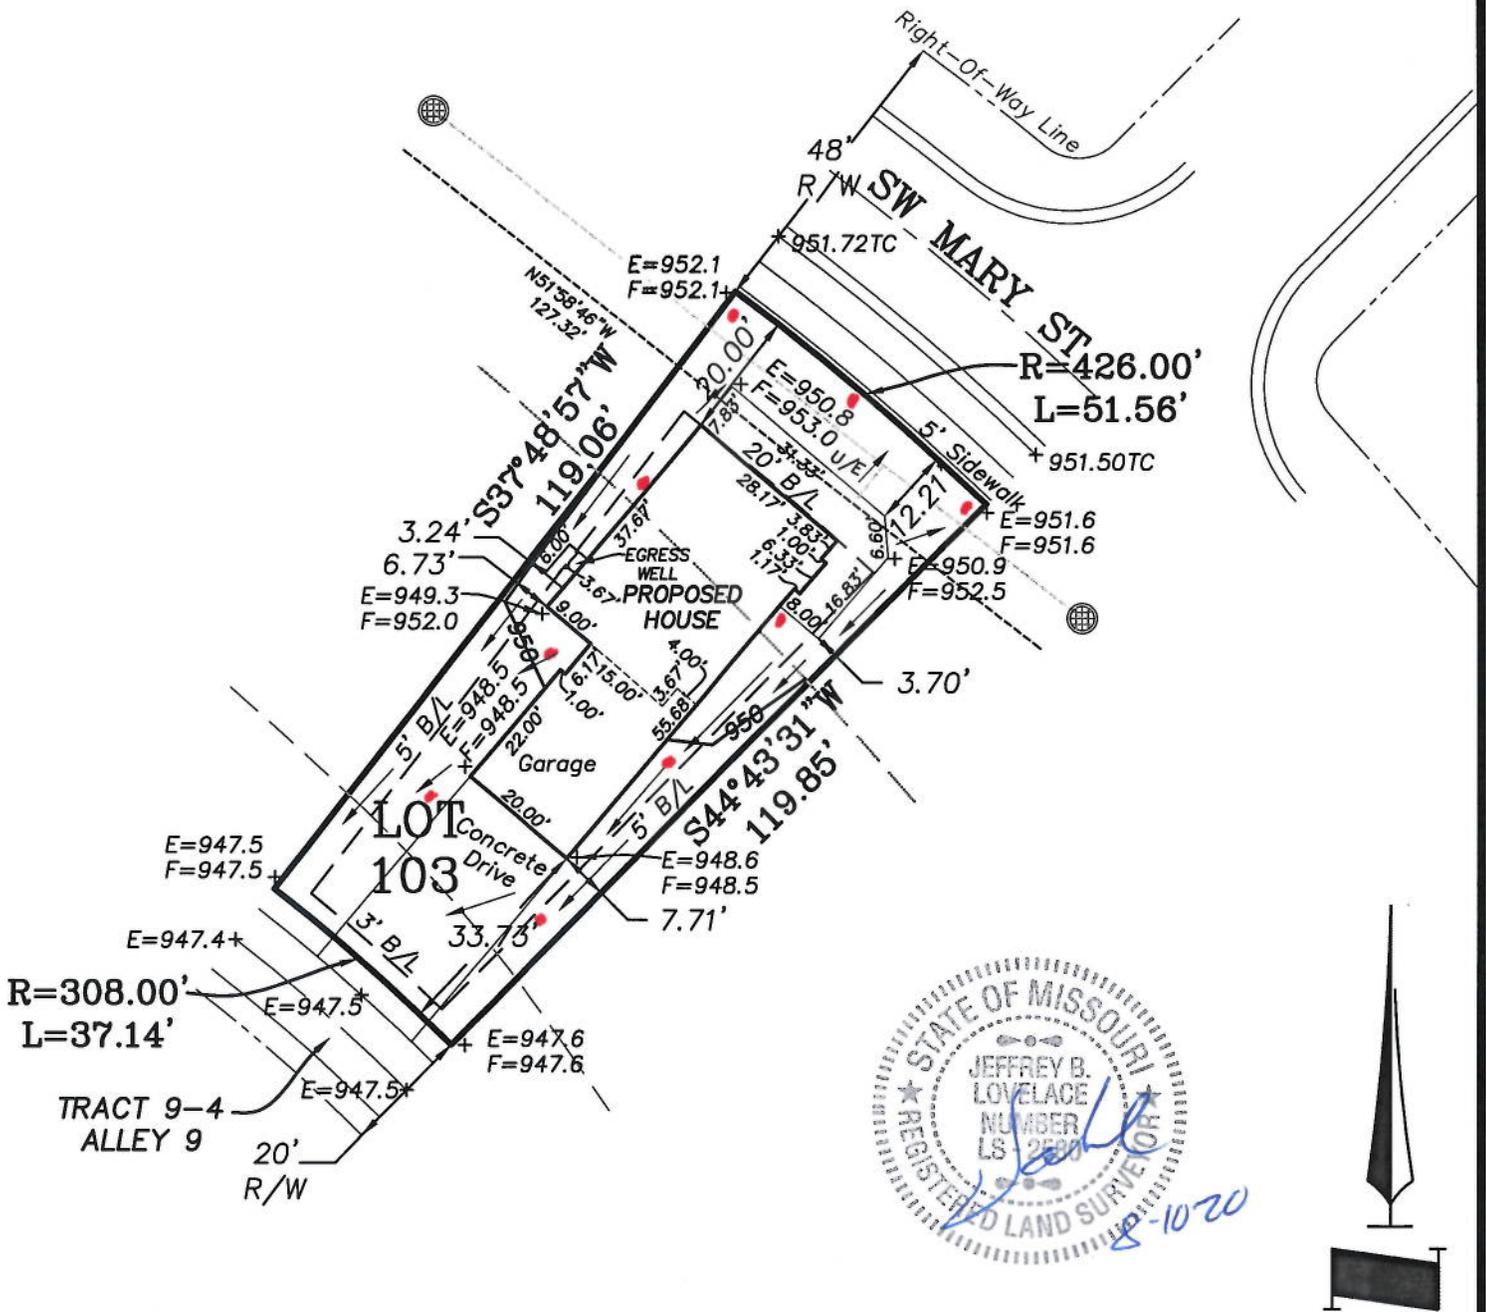

NOTES:

1. LEGAL DESCRIPTION OF PROPERTY PROVIDED BY CONTRACTOR. THIS PLOT PLAN DOES NOT CONSTITUTE OR REPRESENT A BOUNDARY SURVEY. THE CONTRACTOR AND/OR OWNER SHALL BE RESPONSIBLE FOR VERIFICATION OF PROPERTY BOUNDARY, PROPERTY CORNERS, DEED DESCRIPTIONS AND LOCATIONS OF PROPOSED HOUSE WITH RESPECT TO PROPERTY LINES.
2. EASEMENTS, BUILDING LINES AND SET-BACKS TAKEN FROM RECORDED PLAT ONLY.
3. CONTRACTOR TO VERIFY LOCATION AND DEPTH OF SANITARY SEWER SERVICE PRIOR TO CONSTRUCTION.
4. CONTRACTOR TO VERIFY ALL DIMENSIONS, ELEVATIONS AND LOCATIONS PRIOR TO CONSTRUCTION.
5. CONTRACTOR TO VERIFY CONDITION OF ALL FILL PRIOR TO CONSTRUCTION.
6. GRADES ARE SUGGESTED GRADES ONLY. FINAL GRADING AND ELEVATIONS SHALL BE CONTRACTORS RESPONSIBILITY.
7. THIS IS A REPRESENTATION OF THE STRUCTURE AS STAKED BY THIS COMPANY.

Ordered By: BELLAH HOMES P.O. BOX 346 Lees Summit, Mo 64063	
LOVELACE & ASSOCIATES, LLC LAND SURVEYING AND PLANNING SERVICES 929 SE 3rd St. Lee's Summit, MD. 64063/816-347-9997	
Drawn by: J. Smith, Jr. Checked by: J. Lovelace	SCALE: 1" = 30'
DATE: 08/10/2020	JOB NO. 20151