

# STARBUCKS AND FUTURE MEDICAL OFFICE SHELL

155 S.W. MO-150 HWY  
LEE'S SUMMIT, MO 64802

RELEASE FOR  
CONSTRUCTION  
AS NOTED ON PLANS REVIEW  
DEVLOPMENT SERVICES  
LEE'S SUMMIT, MISSOURI  
08/26/2020

**CASCO**  
12 Sunnen Drive, Suite 100, St. Louis, MO 63143 T: 314.821.1100


**MIDLAND**  
GENERAL CONTRACTORS INCORPORATED

Starbucks & Medical Office

155 S.W. MO-150 HWY  
LEE'S SUMMIT, MO 64802

No.	Description	Owner Review	Date
1	OWNER REVISION 3		07/26/20

CASCO DIVERSIFIED CORPORATION  
ARCHITECTURAL  
CERTIFICATE OF AUTHORITY  
#000529 12/31/21

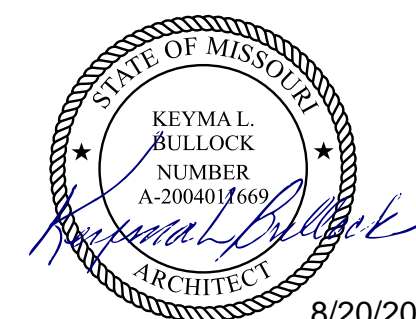

PROFESSIONAL OF RECORD  
BULLOCK, KEYMAL L.  
License NO. 200401669  
Expiration Date 12/31/20

Drawn By/Checked By: MS/MSD

Project Number 320488

Permit Date 06-17-20

TITLE SHEET

T1.0

## ABBREVIATIONS

AFF	ABOVE FINISHED FLOOR	INSUL	INSULATE
AC	ACOUSTICAL	INT	INTERIOR
A/C	AIR CONDITIONING	JST	JOIST
ALT	ALTERNATE	JT	JOINT
AL	ALUMINUM	JNT	JOINT
ALUM	ALUMINUM	LH	LEFT HAND
AB	ANCHOR BOLT	LF	LINEAL FOOT
ARCH	ARCHITECTURAL	LT	LENGTH
BSMT	BASEMENT	L	LINTEL
BRG	BEARING	LL	LIVE LOAD
BM	BENCH MARK	MFR	MANUFACTURER
BEL	BELOW	MAS	MASONRY
BLK	BLOCK	MO	MASONRY OPENING
BLKG	BLOCKING	MAX	MAXIMUM
BD	BOARD	MECH	MECHANICAL
BW	BOTH WAYS	MED	MEDIUM
BOT	BOTTOM	MBR	MODIFIED BITUMEN ROOFING
BF	BOTTOM OF FOOTING	MET	METAL
BOF	BOTTOM OF FOOTING	MTL	METAL
BRK	BRICK	M	METER(S)
BUDG	BUILDING	MWK	MILLWORK
BUR	BUILT-UP ROOFING	MIN	MINIMUM
CAB	CABINET	MISC	MISCELLANEOUS
CLG	CEILING	MT	MOUNTED(ING)
CL	CENTER LINE	NOM	NOMINAL
C/O	CENTER OF	N	NORTH
CC	CENTER TO CENTER	NIC	NOT IN CONTRACT
CLR	CLEAR	NTS	NOT TO SCALE
COL	COLUMN	ON	ON CENTER(S)
CONC	CONCRETE	OPG	OPENING
CNU	CONCRETE MASONRY UNIT	OPH	OPPOSITE HAND
CONST	CONSTRUCTION	OD	OUTSIDE DIAMETER
CONTR	CONTRACTOR	OO	OUT TO OUT
CONT	CONTINUOUS	OA	OVERALL
CNTR	COUNTER	OH	OVERHEAD
CFL	COUNTER FLASHING	PNT	PAINT(ED)
CISK	COUNTERSUNK	PTD	PAINTED
CRS	COURSE(S)	PRNG	PARKING
CF	CUBIC FOOT	PLAM	PLASTIC LAMINATE
CY	CUBIC YARD	PL	PLATE
DEM	DEMOLISH, DEMOLITION	PWD	PLYWOOD
DTL	DETAIL	PVC	POLYVINYL CHLORIDE
DIAG	DIAGONAL	PSI	POUNDS PER SQUARE FT.
DIAM	DIAMETER	PT	POUNDS PER SQUARE IN.
DIM	DIMENSION	PL	PRESSURE TREATED
DR	DOOR	PL	PROPERTY LINE
DS	DOWN SPOUT	REM	REMOVE
D	DRAIN	RET	RETURN
DWG	DRAWING	RH	RIGHT HAND
DF	DRINKING FOUNTAIN	RD	ROOF DRAIN
E	EAST	RFG	ROOFING
EIFS	EXTERIOR INSULATION AND FINISH SYSTEM	RM	ROOM
ELEC	ELECTRICAL	RMO	ROUGH OPENING
EW	ELECTRIC WATER COOLER	SMT	SEALANT
ELEV	ELEVATION	SNT	SEALANT
ELEV	ELEVATOR	SEC	SECTION
EMER	EMERGENCY	SECT	SECTION
EQ	EQUAL	SHTHG	SHEATHING
EXIST	EXISTING	SHT	SHEET
EXP	EXPOSED	SIM	SIMILAR
EXT	EXTERIOR	SC	SOLID CORE
FOF	FACE OF FINISH	S	SOUTH
FO	FACE OF	SF	SQUARE FOOT
FOM	FACE OF MASONRY	SI	SQUARE INCH
FOS	FACE OF STUDS	SY	SQUARE YARD
FIN	FINISHED	STD	STANDARD
FFE	FINISHED FLOOR ELEV.	STO	STORAGE
FFL	FINISHED FLOOR LINE	SUS	SUSPENDED
FE	FIRE EXTINGUISHER	SYM	SYMMETRY(CAL)
FEC	FIRE EXTINGUISHER CABINET	TEL	TELEPHONE
FT	FIRE TREATED	TV	TELEVISION
FLG	FLASHING	THK	THICKNESS
FLR	FLOOR	T&G	TONGUE & GROOVE
FD	FLOOR DRAIN	TM	TOP OF MASONRY
FTG	FOOTING	TS	TOP OF STEEL
FDN	FOUNDATION	TOS	TOP OF STEEL
FNDN	FOUNDATION	TW	TOP OF WALL
FUR	FURRED(ING)	TOW	TOP OF WALL
GALV	GALVANIZED	TYP	TYPICAL
GC	GENERAL CONTRACT(OR)	UDN	UNLESS OTHERWISE NOTED
GL	GLASS, GLAZING	UNO	UNLESS NOTED OTHERWISE
GP	GYPSUM, GYP, GYPSUM	VERT	VERTICAL
GWB	GYPSUM WALL BOARD	VSCT	WAINSCOT
HTG	HEATING	WC	WATER CLOSET
HVAC	HEATING/VENTILATING/AIR COND.	WWF	WELDED WIRE FABRIC
HT	HEIGHT	W	WIDTH, WIDE
HC	HOLLOW CORE	WIN	WINDOW
HMI	HOLLOW METAL	WO	WITHOUT
HOR	HORIZONTAL	WO	WITHOUT
HBS	HOSE BIBB	WO	WOOD
INS	INSULATE(D)(ION)		

## VICINITY MAP



BUILDING RENOVATION

LOT 1, RAINTREE 150 CENTER

A SUBDIVISION IN LEE'S SUMMIT, JACKSON COUNTY, MISSOURI,  
AS SHOWN ON PLAT ENTITLED MINOR PLAT OF RAINTREE 150 CENTER,  
RECORDED APRIL 21, 2004 IN PLAT BOOK 181, PAGE 12 OF THE  
JACKSON COUNTY, MISSOURI RECORDER OF DEEDS OFFICE

FINAL DEVELOPMENT PLAN



CONSTRUCTION NOTES

- GRADING:
- ALL CONTOURS SHOWN ON THESE PLANS ARE BASED ON U.S.G.S. DATA.
  - ALL GRADING SHALL BE IN ACCORDANCE WITH THE REQUIREMENTS OF THE CITY OF LEE'S SUMMIT.
  - IT SHALL BE THE RESPONSIBILITY OF THE CONTRACTOR TO RESTORE THE GRADE TO THE DESIGN ELEVATIONS.
  - NO SLOPES SHALL BE GRADED STEEPER THAN 3:1 (HORIZONTAL : VERTICAL), AND SHALL BE SEEDED AND MULCHED.
  - ONLY THE DESIGNATED CONSTRUCTION ACCESS ROUTE MAY BE USED TO MOVE EQUIPMENT IN AND OUT. NO OTHER ACCESS POINT WILL BE PERMITTED.
  - ALL SILTATION MEASURES MUST BE IN PLACE BEFORE ANY OPERATIONS THAT DISTURB THE NATURAL GRADE COMMENCES. THIS INCLUDES GRUBBING OR STUMP REMOVAL. THE CITY OF LEE'S SUMMIT SHALL BE NOTIFIED UPON COMPLETION OF ALL SILTATION AND EROSION FACILITIES AND SHALL INSPECT AND APPROVE SUCH FACILITIES PRIOR TO THE COMMENCEMENT OF ANY CLEARING OR GRADING ACTIVITIES.
  - SILTATION AND EROSION CONTROL FACILITIES MUST BE MAINTAINED THROUGHOUT THE ENTIRE CONSTRUCTION PERIOD. THIS INCLUDES REMOVAL OF MUD FROM SILTATION BASINS AND REPLACEMENT OF THE CITY OF LEE'S SUMMIT APPROVED EROSION CONTROL DEVICES. MUD SHALL NOT BE PERMITTED TO MIGRATE OFF THE SITE. DAMAGE OR FAILURE OF SILTATION AND EROSION CONTROL FACILITIES SHALL BE REPAIRED. DAMAGE OR FAILURE OF SILTATION AND EROSION CONTROL FACILITIES SHALL BE REPAIRED IMMEDIATELY BUT NOT LONGER THAN 24 HOURS AFTER NOTIFICATION. IF PROPOSED MEASURES FAIL TO ADEQUATELY PROTECT THE ADJOINING PROPERTY ADDITIONAL FACILITIES SHALL BE INSTALLED AS DIRECTED.
  - THE ENGINEER SHALL NOT BE RESPONSIBLE FOR THE MEANS, METHODS, TECHNIQUES, SEQUENCES OR PROCEDURES OF CONSTRUCTION SELECTED BY THE CONTRACTOR TO PROTECT OFF-SITE PROPERTY FROM EROSION OR SILTATION. THE ENGINEER SHALL NOT BE LIABLE FOR DAMAGE CAUSED BY EROSION OR SILTATION DUE TO DEFECTIVE SILTATION CONTROL DEVICES.
  - MUD WILL NOT BE PERMITTED TO BE CARRIED OFF SITE ONTO PUBLIC STREETS. A TEMPORARY WASH FACILITY SHALL BE PROVIDED TO REMOVE MUD FROM VEHICLE TIRES BEFORE ENTERING THE PUBLIC STREETS.
  - MEASURES SHALL BE TAKEN TO CONTROL DUST AS NECESSARY.
  - IT SHALL BE THE GRADING CONTRACTOR'S RESPONSIBILITY TO NOTIFY THE SOILS ENGINEER OF WORK IN PROGRESS AND TO COMPLY WITH SPECIFICATIONS SET BY THE SOILS ENGINEER WITH REGARD TO COMPACTION, SURFACE PREPARATION AND PLACEMENT OF FILL.
  - ALL STUMPS, LIMBS, AND OTHER DEBRIS ARE TO BE REMOVED FROM THE SITE.
  - ALL DRAINAGE SWALES SHALL BE SODDED.
  - ALL FILL AREAS, INCLUDING TRENCH BACKFILLS, UNDER BUILDINGS, PROPOSED STORM AND SANITARY SEWER LINES, PUBLIC RIGHT-OF-WAY, AND PAVED AREAS, SHALL BE COMPACTED TO 90% OF MAXIMUM DENSITY AS DETERMINED BY THE MODIFIED AASHTO T-180 COMPACTION TEST", (A.S.T.M. D- 1557) UNLESS OTHERWISE REQUIRED IN THE SOILS REPORT FOR THIS PROJECT.

TABLE OF ABBREVIATIONS

NOTE: NOT ALL ABBREVIATIONS USED

AI	AREA INLET	N	NORTH
ASPH	ASPHALT	NE	NORTHEAST
ATG	ADJUST TO GRADE	NW	NORTHWEST
BC	BOTTOM OF CURB ELEVATION	PB	PLAT BOOK
BFP	BACKFLOW PREVENTER	PERM	PERMANENT
BLDG	BUILDING	PG	PAGE
BM	BENCHMARK	PGS	PAGES
BOT	BOTTOM	PL	PROPERTY LINE
BS	BOTTOM OF SLOPE ELEVATION	PR	PROPOSED
BW	BOTTOM OF WALL ELEVATION	PVC	POLYVINYL CHLORIDE
C	CURB	PVMT	PAVEMENT
CMP	CORRUGATED METAL PIPE	R	RADIUS
CO	CLEAN OUT	RCP	REINFORCED CONCRETE PIPE
CONC	CONCRETE	REC	RECORD
DB	DEED BOOK	ROW	RIGHT OF WAY
DIP	DUCTILE IRON PIPE	R/W	RIGHT OF WAY
DS	DOWNSPOUT	S	SOUTH
E	EAST	SE	SOUTHEAST
ELEV	ELEVATION	SF	SQUARE FEET
EM	ELECTRIC METER	SURV	SURVEY
EOP	EDGE OF PAVEMENT	SW	SOUTHWEST
ESMT	EASEMENT	TBR	TO BE REMOVED
EX	EXISTING	TC	TOP OF CURB ELEVATION
FF	FINISHED FLOOR ELEVATION	TFP	TRANSFORMER PAD
FL	FLOW LINE ELEVATION	TS	TOP OF SLOPE ELEVATION
FO	FIBER OPTIC	TW	TOP OF WALL ELEVATION
GEN	GENERATOR	TYP	TYPICAL
GTI	GRATE TOP INLET	UGFO	UNDERGROUND FIBER OPTIC LINE
HC	HANDICAPPED	UIP	USE IN PLACE
HHE	ELECTRIC HAND HOLE	VCP	VITRIFIED CLAY PIPE
HHTS	TRAFFIC SIGNAL HAND HOLE	W	WEST
HHSL	SIGNAL LIGHT HAND HOLE		
ICVR	IRRIGATION CONTROL VALVE RECLAIMED		
MAX	MAXIMUM		
MH	MANHOLE		
MIN	MINIMUM		
MSD	METROPOLITAN ST. LOUIS SEWER DISTRICT		

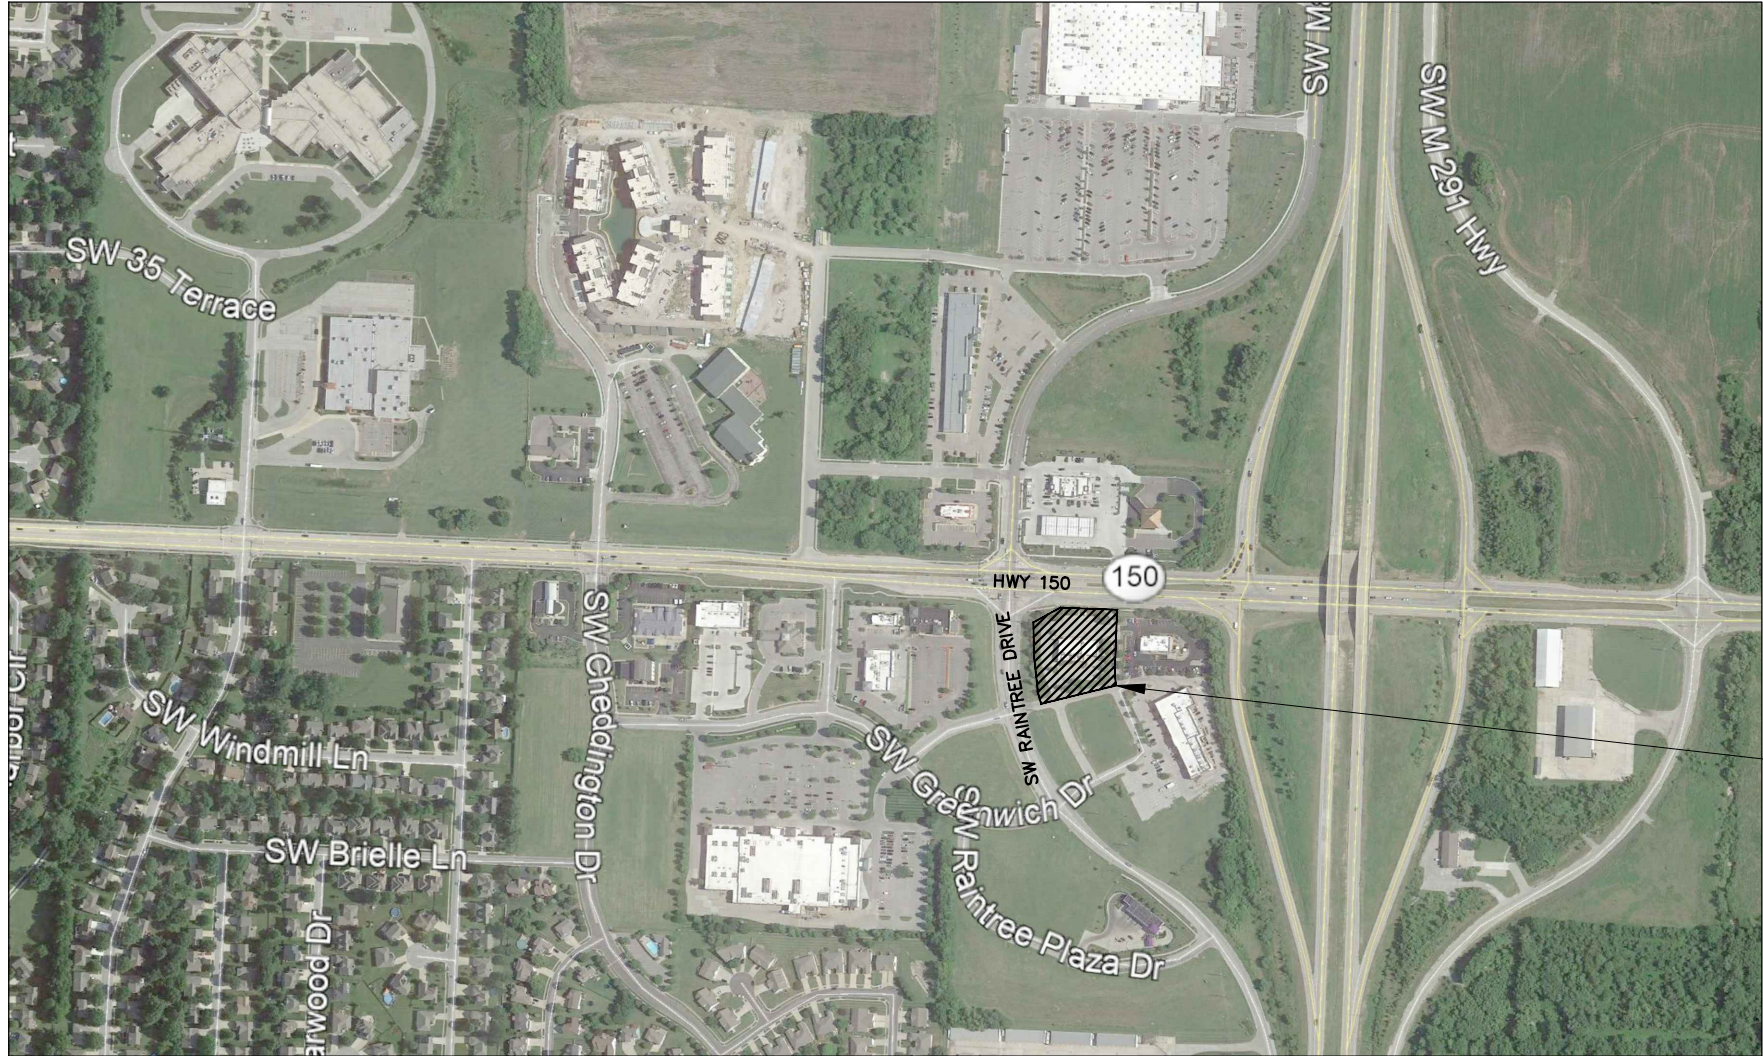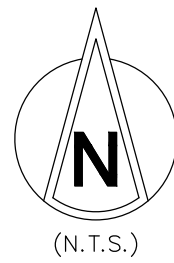

PERTINENT INFORMATION

PROPERTY ADDRESS:	155 SW M-150 HIGHWAY
ZIP CODE:	64082
MUNICIPALITY:	CITY OF LEE'S SUMMIT
STATE:	MISSOURI
TOTAL SITE AREA:	1.405 ACRES (61,187± SF)
AREA OF DISTURBANCE:	0.499 ACRES (21,741± SF)
CURRENT ZONING:	CP-2 CORRIDOR DEVELOPMENT OVERLAY DISTRICT
INTENDED USE:	CP-2 CORRIDOR DEVELOPMENT OVERLAY DISTRICT
PARCEL ID:	70-820-03-02-00-0-00-000

SHEET INDEX

- C0.0 - COVER
- C1.0 - DEMOLITION PLAN
- C2.0 - SITE & UTILITY PLAN
- C3.0 - GRADING PLAN
- C4.0 - SITE DETAILS
- C4.1 - SITE DETAILS
- C4.2 - SITE DETAILS
- C5.0 - EROSION & SEDIMENT CONTROL PLAN
- C5.1 - EROSION & SEDIMENT CONTROL DETAILS

EXISTING	LEGEND OF SYMBOLS	PROPOSED
	UTILITY POLE	
	GUY WIRE	
	TREE	
	ELECTRIC LINE (OVERHEAD)	
	TELEPHONE LINE (OVERHEAD)	
	ELECTRIC LINE (UNDERGROUND)	
	FIBER OPTIC CABLE	
	TELEPHONE LINE (UNDERGROUND)	
	WATER LINE	
	GAS LINE	
	CABLE LINE	
	SANITARY LINE	
	STORM LINE	
	FORCE MAIN	
	MANHOLE WITH STORM SEWER	
	INLET WITH MANHOLE COVER	
	GRATE TOP INLET	
	MANHOLE WITH SANITARY SEWER	
	STORM STRUCTURE NUMBER	
	SANITARY STRUCTURE NUMBER	
	LIGHT	
	FIRE HYDRANT	
	GAS VALVE	
	GAS METER	
	CLEAN OUT	
	WATER VALVE	
	WATER METER	
	CONTOUR	
	SPOT ELEVATION	
	SPOT ELEVATION AT TOP OF CURB	
	SPOT ELEVATION AT BOTTOM OF CURB	
	SPOT ELEVATION AT FLOWLINE OF GUTTER	
	SPOT ELEVATION AT TOP OF WALL	
	SPOT ELEVATION AT BOTTOM OF WALL	
	SPOT ELEVATION AT TOP OF BANK	
	SPOT ELEVATION AT BOTTOM OF BANK	
	STREET SIGN	
	FENCE	

PROJECT CONTACTS

DEVELOPERS:  
EQUITY  
4653 TRUENAM BOULEVARD  
HILLIARD, OH 43026  
(614) 586-3303  
NPALMER@EQUITY.NET

MIDLAND PROPERTIES OF ILLINOIS, LLC  
716 WINDSOR ROAD  
LOVES PARK, IL 61111  
(815) 988-9600  
BRENT@MIDLANDGENERALCONTRACTORS.COM

BUILDING DESIGN:  
CASCO DIVERSIFIED CORPORATION  
12 SUNNEN DR., SUITE 100  
ST. LOUIS, MO 63143  
(314) 821-1100

CIVIL ENGINEER:  
CASCO CIVIL  
12 SUNNEN DR., SUITE 100  
ST. LOUIS, MO 63143  
(314) 821-1100  
TOM.BUERK@CASCOCORP.COM

ELECTRIC:  
KANSAS CITY POWER & LIGHT  
(888) 471-5275

STORM:  
LEE'S SUMMIT PUBLIC WORKS  
220 SE GREEN  
LEE'S SUMMIT, MO 64063  
(816) 969-1800

GAS:  
SPIRE  
(816) 756-5252

SANITARY & WATER:  
LEE'S SUMMIT WATER UTILITIES  
12 SE HAMBLIN ROAD  
LEE'S SUMMIT, MO 64081  
(816) 969-1900

FIRE DEPARTMENT:  
LEE'S SUMMIT FIRE STATION 5  
3650 SW WINDEMERE ROAD  
LEE'S SUMMIT, MO 64062  
PHONE

CONSTRUCTION NOTE

ALL CONSTRUCTION SHALL CONFORM TO THE CITY OF LEE'S SUMMIT DESIGN AND CONSTRUCTION MANUAL

LAND DISTURBANCE NOTE

THE CONTRACTOR SHALL CONTACT THE CITY'S DEVELOPMENT SERVICES ENGINEERING INSPECTORS 48 HOURS PRIOR TO ANY LAND DISTURBANCE WORK: (816) 969-1200

FLOOD ZONE NOTE

ACCORDING TO THE FIRM FLOOD INSURANCE RATE MAP 29095C0532G DATED JANUARY 20, 2017, THIS DEVELOPMENT IS LOCATED IN FLOOD ZONE X. FLOOD ZONE X IS DETERMINED TO BE AN AREA OF MINIMAL FLOOD HAZARD, OUTSIDE THE 0.2% ANNUAL CHANCE FLOOD HAZARD.

TITLE DESCRIPTION

LOT 1, RAINTREE 150 CENTER, A SUBDIVISION IN LEE'S SUMMIT, JACKSON COUNTY, MISSOURI, AS SHOWN ON PLAT ENTITLED MINOR PLAT OF RAINTREE, 150 CENTER, RECORDED APRIL 21, 2004 IN PLAT BOOK 181, PAGE 12 OF THE JACKSON COUNTY, MISSOURI RECORDER OF DEEDS OFFICE.

THIS SURVEY AND LEGAL DESCRIPTION ARE THE SAME AS THAT SHOWN ON A TITLE REPORT PREPARED BY FIRST AMERICAN TITLE INSURANCE COMPANY, FILE NO.: NCS-401470620A-NC, FIRST AMENDMENT, EFFECTIVE DATE: EFFECTIVE DATE: JUNE 26, 2019.

SIGN NOTE

ALL PROPOSED SIGNS SHALL COMPLY WITH THE UDO REQUIREMENTS, AND SIGNS WILL BE APPROVED BY SEPARATE APPLICATION.

OIL AND GAS NOTE

THERE ARE NO OIL AND/OR GAS WELLS PRESENT WITHIN THE SUBJECT PROPERTY PER THE ENVIRONMENTAL REPORT PREPARED BY SOLID GROUND ENVIRONMENTAL DATED MAY 12, 2020.

SURVEY NOTE

THE TOPOGRAPHIC INFORMATION IN THIS PLAN SET IS BASED OFF A SURVEY PROVIDED BY AYLETT SURVEYING & ENGINEERING ON MAY 13, 2020 AND A BOUNDARY SURVEY PROVIDED BY COMMERCIAL DUE DILIGENCE SERVICES ON MARCH 25, 2020.

ACTUAL FIELD CONDITIONS ARE TO BE VERIFIED PRIOR TO COMMENCEMENT OF WORK.

BUILDING RENOVATION

155 SW M-150 HIGHWAY

LEE'S SUMMIT, MO 64082

CONSTR. DOC. & REVISIONS

No.	Description	Date
DP	Development Plan Response	06-17-20
CC	City Comments	06-30-20
DP2	Development Plan Response 2	07-15-20
O3	Owner Revision 3	07-20-20
4	Clarification	07-31-20
6	Owner Revision	08-20-20

CASCO DIVERSIFIED CORPORATION  
CERTIFICATE OF AUTHORITY  
#000613 12/31/21



PROFESSIONAL OF RECORD

Buerk III, Thomas E.  
License NO. PE-2018000174  
Expiration Date 12/31/20

Drawn By/Checked By: MEB/TEB

Project Number 320488


Permit Date 06-17-20

COVER




CALL BEFORE YOU  
DIG - DRILL - BLAST  
1-800-344-7483  
MISSOURI ONE-CALL SYSTEM, INC.

C0.0

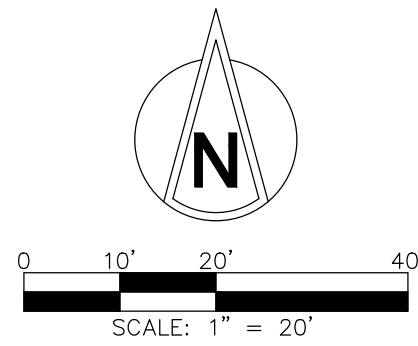

# SW HIGHWAY 150

VARIABLE WIDTH PUBLIC RIGHT OF WAY

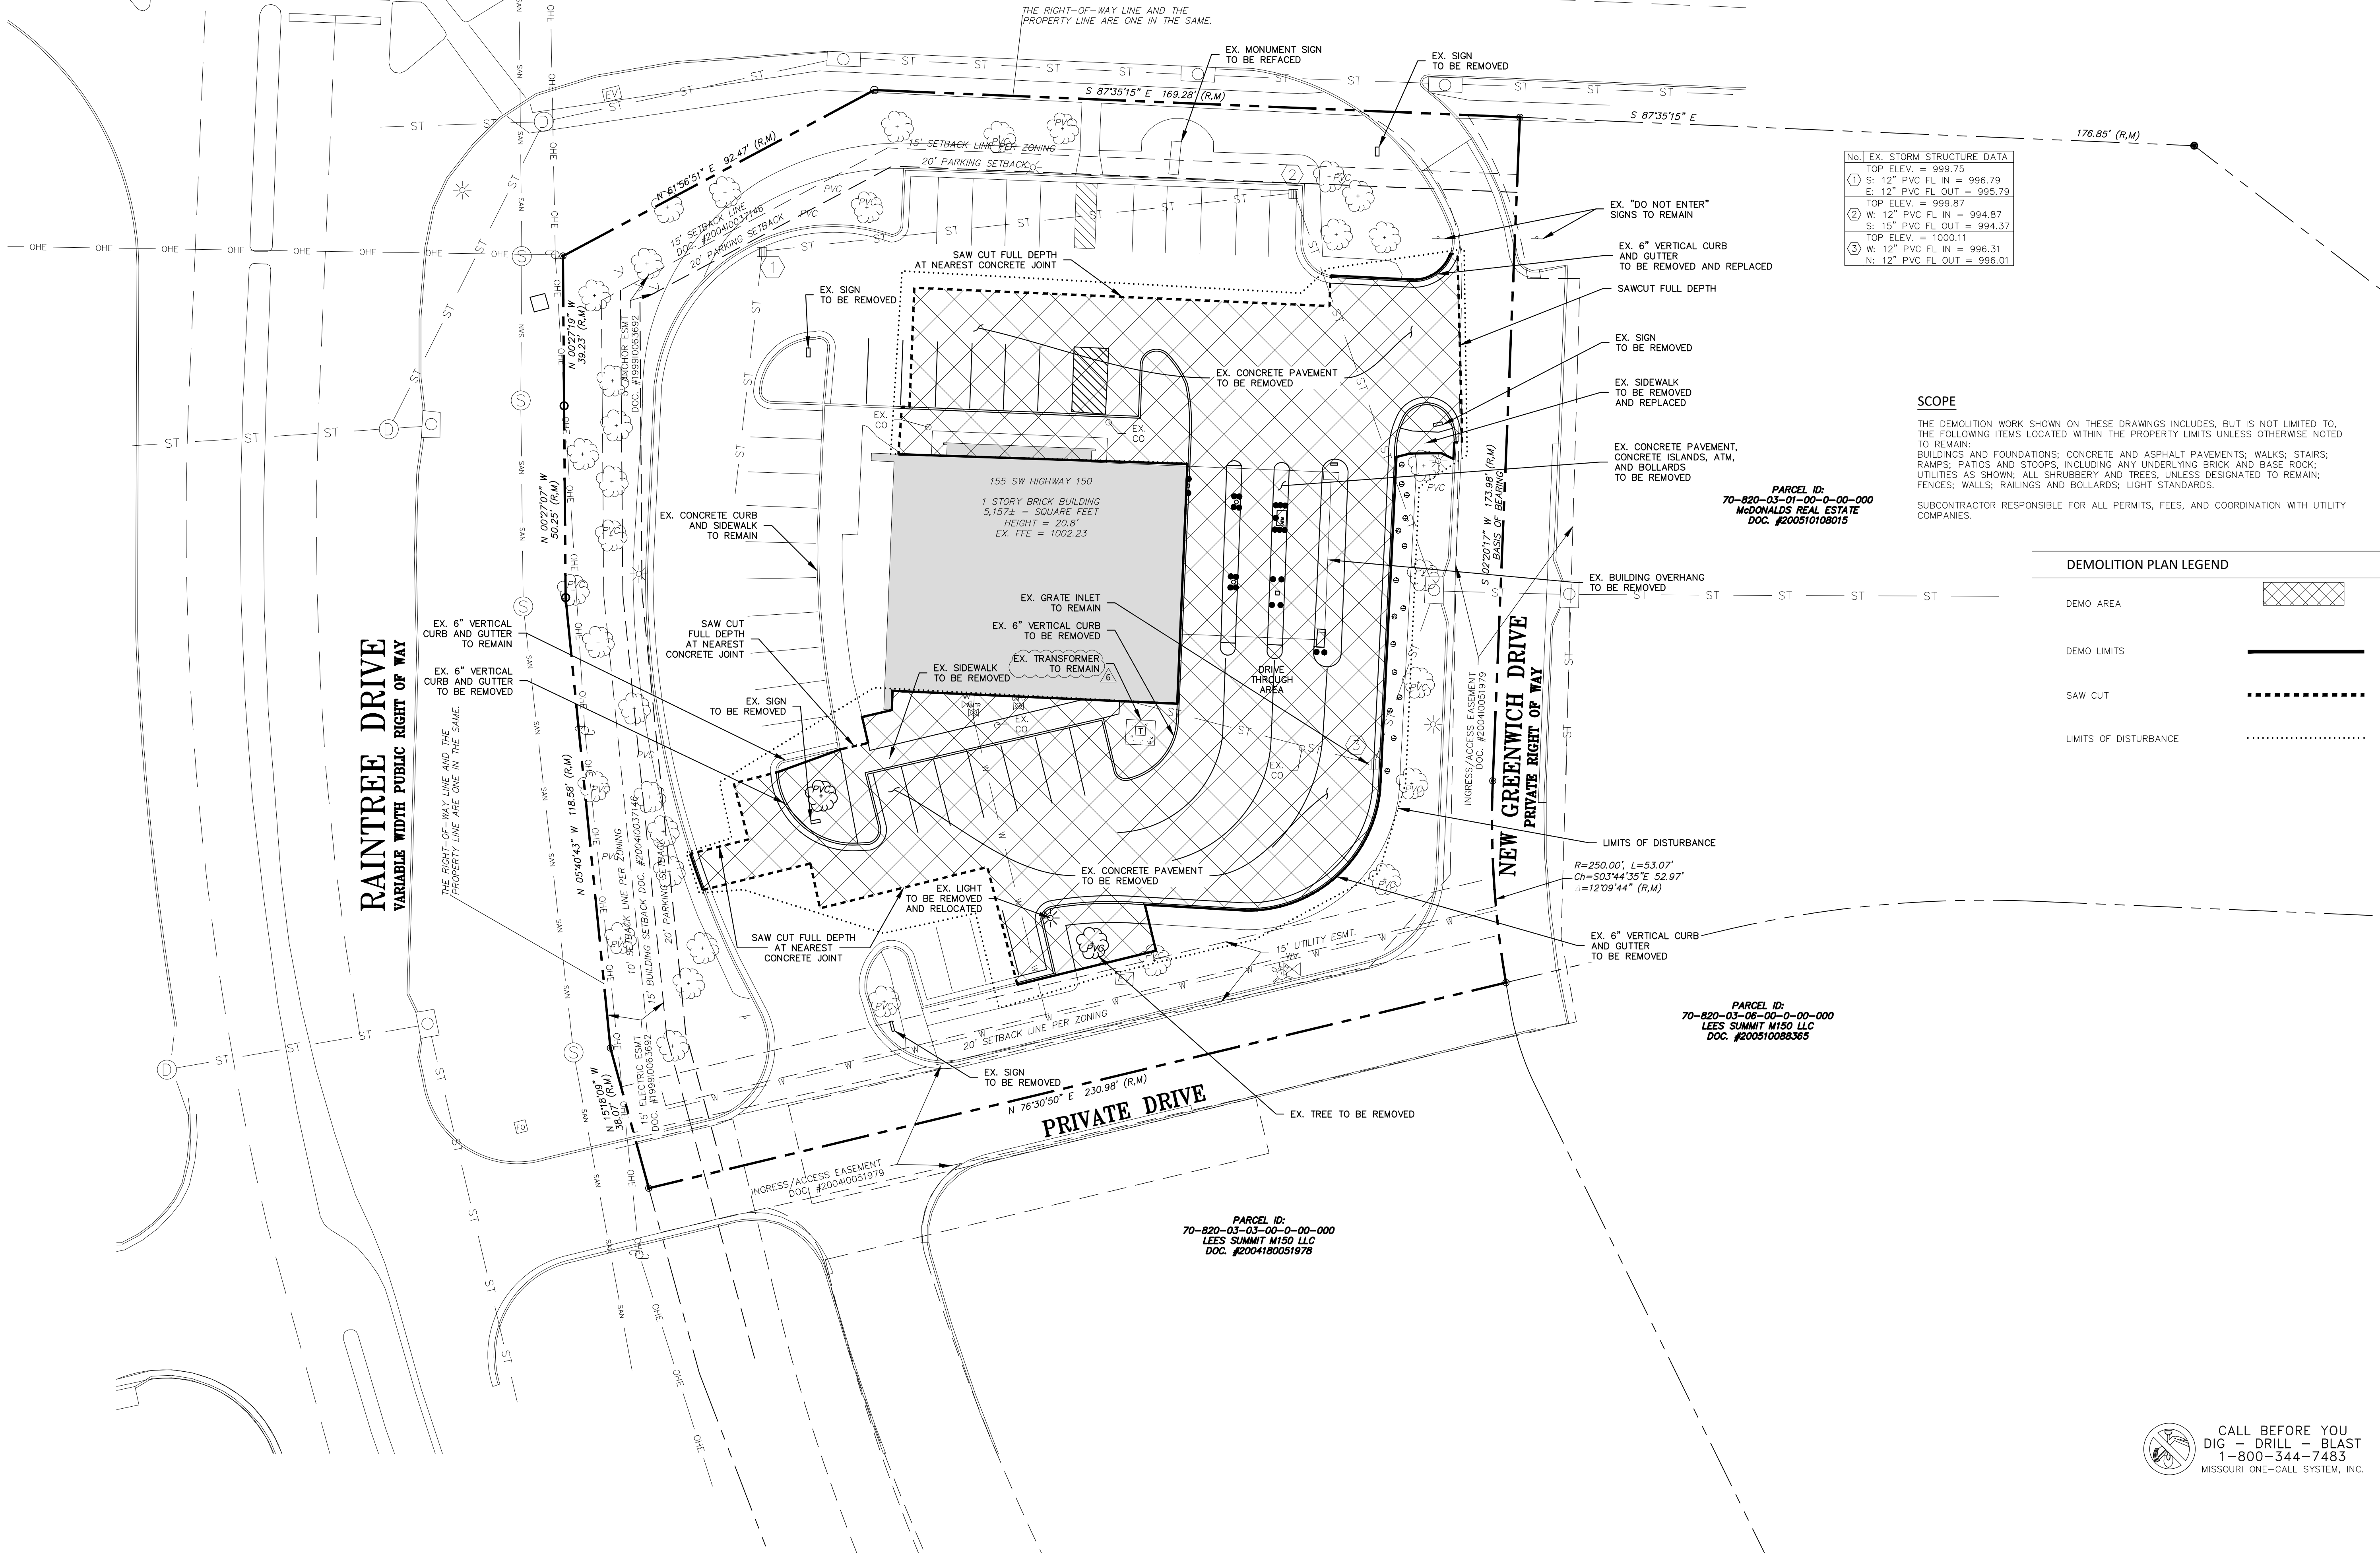

No.	EX. STORM STRUCTURE DATA
1	TOP ELEV. = 999.75 S: 12" PVC FL IN = 996.79 E: 12" PVC FL OUT = 995.79 TOP ELEV. = 999.87
2	W: 12" PVC FL IN = 994.87 S: 15" PVC FL OUT = 994.37 TOP ELEV. = 1000.11
3	W: 12" PVC FL IN = 996.31 N: 12" PVC FL OUT = 996.01

## SCOPE

THE DEMOLITION WORK SHOWN ON THESE DRAWINGS INCLUDES, BUT IS NOT LIMITED TO, THE FOLLOWING ITEMS LOCATED WITHIN THE PROPERTY LIMITS UNLESS OTHERWISE NOTED TO REMAIN:  
BUILDINGS AND FOUNDATIONS; CONCRETE AND ASPHALT PAVEMENTS; WALKS; STAIRS; RAMPS; PATIOS AND STOOPS, INCLUDING ANY UNDERLYING BRICK AND BASE ROCK; UTILITIES AS SHOWN; ALL SHRUBBERY AND TREES, UNLESS DESIGNATED TO REMAIN; FENCES; WALLS; RAILINGS AND BOLLARDS; LIGHT STANDARDS.

SUBCONTRACTOR RESPONSIBLE FOR ALL PERMITS, FEES, AND COORDINATION WITH UTILITY COMPANIES.

## DEMOLITION PLAN LEGEND

DEMO AREA	
DEMO LIMITS	
SAW CUT	
LIMITS OF DISTURBANCE	

BUILDING RENOVATION  
155 SW M-150 HIGHWAY  
LEE'S SUMMIT, MO 64082

## CONSTR. DOC. & REVISIONS

No.	Description	Date
DP	Development Plan Response	06-17-20
CC	City Comments	06-30-20
DP2	Development Plan Response 2	07-15-20
O3	Owner Revision 3	07-20-20
4	Clarification	07-31-20
6	Owner Revision	08-20-20

CASCO DIVERSIFIED CORPORATION  
CERTIFICATE OF AUTHORITY  
#000613 12/31/21



08-20-20

PROFESSIONAL OF RECORD  
Buerk III, Thomas E.  
License NO. PE-2018000174  
Expiration Date 12/31/20


Drawn By/Checked By: MEB/TEB  
Project Number 320488  
Permit Date 06-17-20



CALL BEFORE YOU  
DIG - DRILL - BLAST  
1-800-344-7483  
MISSOURI ONE-CALL SYSTEM, INC.

## DEMOLITION PLAN

C1.0

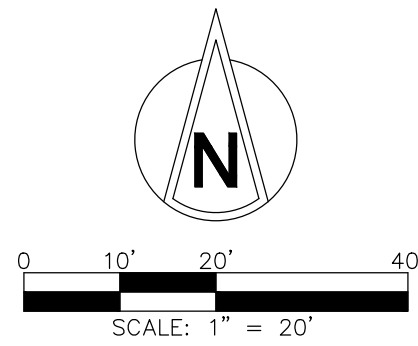

PAVEMENT LEGEND	
EX. CONCRETE PAVEMENT	
PR. CONCRETE PAVEMENT	
EX. CONCRETE SIDEWALK	
PR. CONCRETE SIDEWALK	
SAW CUT	

WATER METER NOTE

PROPOSED 2" WATER LINE TO STUB IN FROM EXISTING 8" WATER MAIN LINE. PROPOSED 2" WATER LINE TO ROUTE TO PROPOSED 1.5" WATER METER, THEN ROUTE FROM WATER METER TO ENTER BUILDING VIA 2" WATER LINE.

WATER LINE NOTE

CONTRACTOR TO VERIFY EXISTING WATER LINE AND WATER MAIN LOCATION PRIOR TO CONSTRUCTION.

PROPOSED 2" WATER LINE AND PROPOSED 3/4" HOSE BIB LINE SHALL BE TYPE "K" SOFT COPPER, COMPLYING WITH ASTM B 88, IN ACCORDANCE TO CITY OF LEE'S SUMMIT, MISSOURI STANDARD SPECIFICATIONS, SECTION 3900 WATER MAINS, PARAGRAPH 3901.R.

DOWNSPOUT NOTE

4" PVC STORM PIPE FROM PROPOSED DOWNSPOUT TO DISCHARGE AT FLOWLINE EQUAL TO CURB FLOWLINE. MIN 2% SLOPE.

NOTE:

SHELL GENERAL CONTRACTOR TO VERIFY FINAL LOCATIONS OF ALL DRIVE-THRU EQUIPMENT WITH TENANT DRAWINGS.

SITE DATA:

ADDRESS:	155 SW M-150 HWY LEE'S SUMMIT, MO 64082
SITE AREA:	1.405 ACRES
CURRENT ZONING:	CP-2 CORRIDOR DEVELOPMENT OVERLAY DISTRICT
PROPOSED ZONING:	CP-2 CORRIDOR DEVELOPMENT OVERLAY DISTRICT
PARKING REQ'D:	MEDICAL OFFICE: 5 SPACES PER 1,000 SF OF GFA. 2,451 SF/1,000 = 2.5 x 5 = 12 SPACES RESTAURANT (FAST FOOD AND SIT-DOWN): 14 SPACES PER 1,000 SF OF GFA. 2,218 SF/1,000 = 2.2 x 14 = 31 SPACES
TOTAL SPACES REQ'D:	43 SPACES
HC SPACES REQ'D:	1 STANDARD + 1 VAN ACCESSIBLE
PARKING PROVIDED:	38 SPACES + 2 HC SPACES = 40 SPACES
IMPERVIOUS AREA:	0.821 ACRES (35,777± SF)
FLOOR AREA RATIO:	4,669 SF / 61,187 SF = 0.076

CONSTR. DOC. & REVISIONS

No.	Description	Date
1	Development Plan Response	06-17-20
2	City Comments	06-30-20
3	DP2 Development Plan Response 2	07-15-20
4	Owner Revision 3	07-20-20
5	Clarification	07-31-20
6	Owner Revision	08-20-20

CASCO DIVERSIFIED CORPORATION  
CERTIFICATE OF AUTHORITY  
#0006113 12/31/21





PROFESSIONAL OF RECORD  
Buerk III, Thomas E.  
License NO. PE-2018000174  
Expiration Date 12/31/20


Drawn By/Checked By: MEB/TEB  
Project Number 320488  
Permit Date 06-17-20

SITE & UTILITY PLAN

C2.0

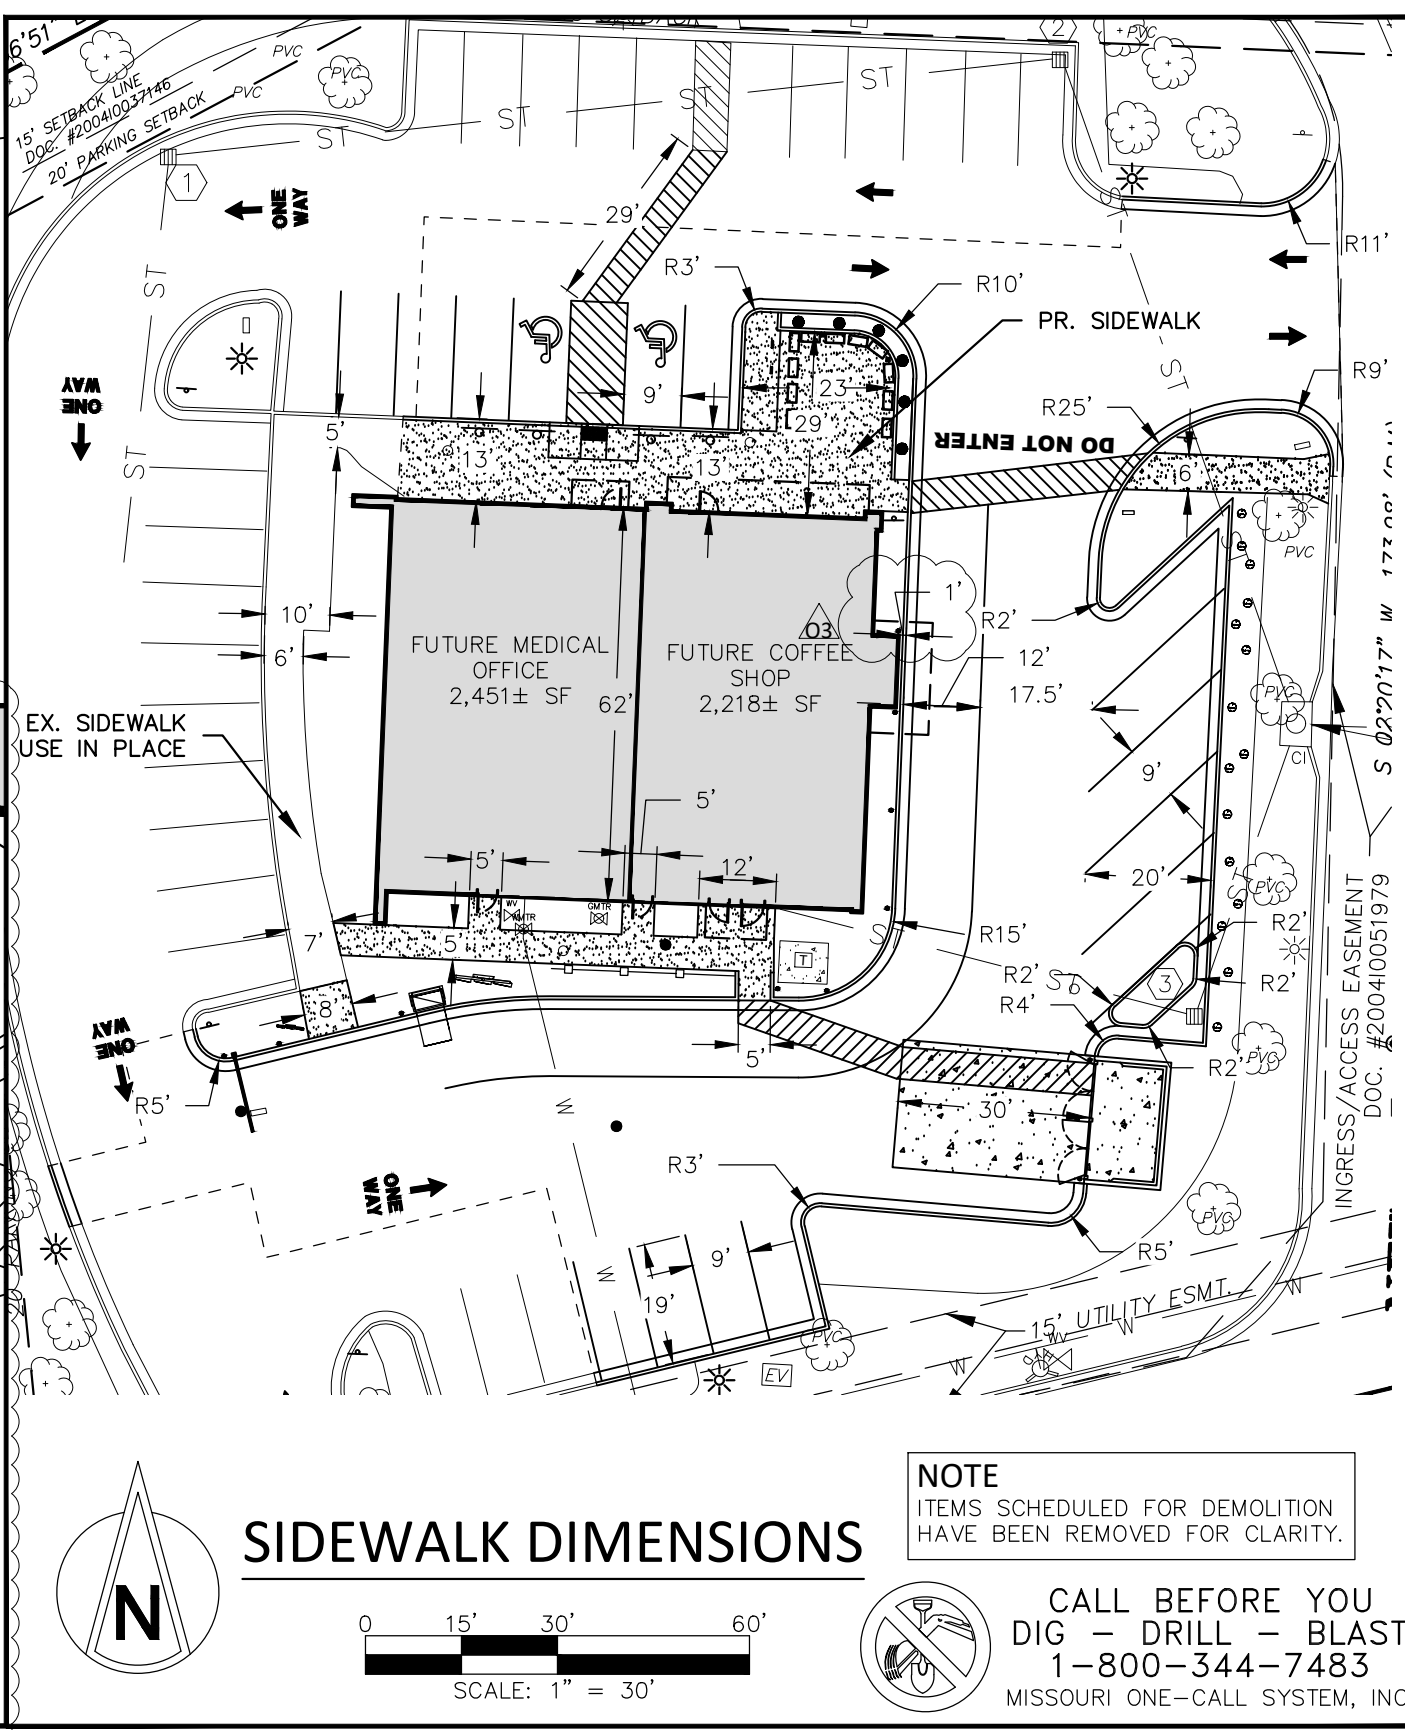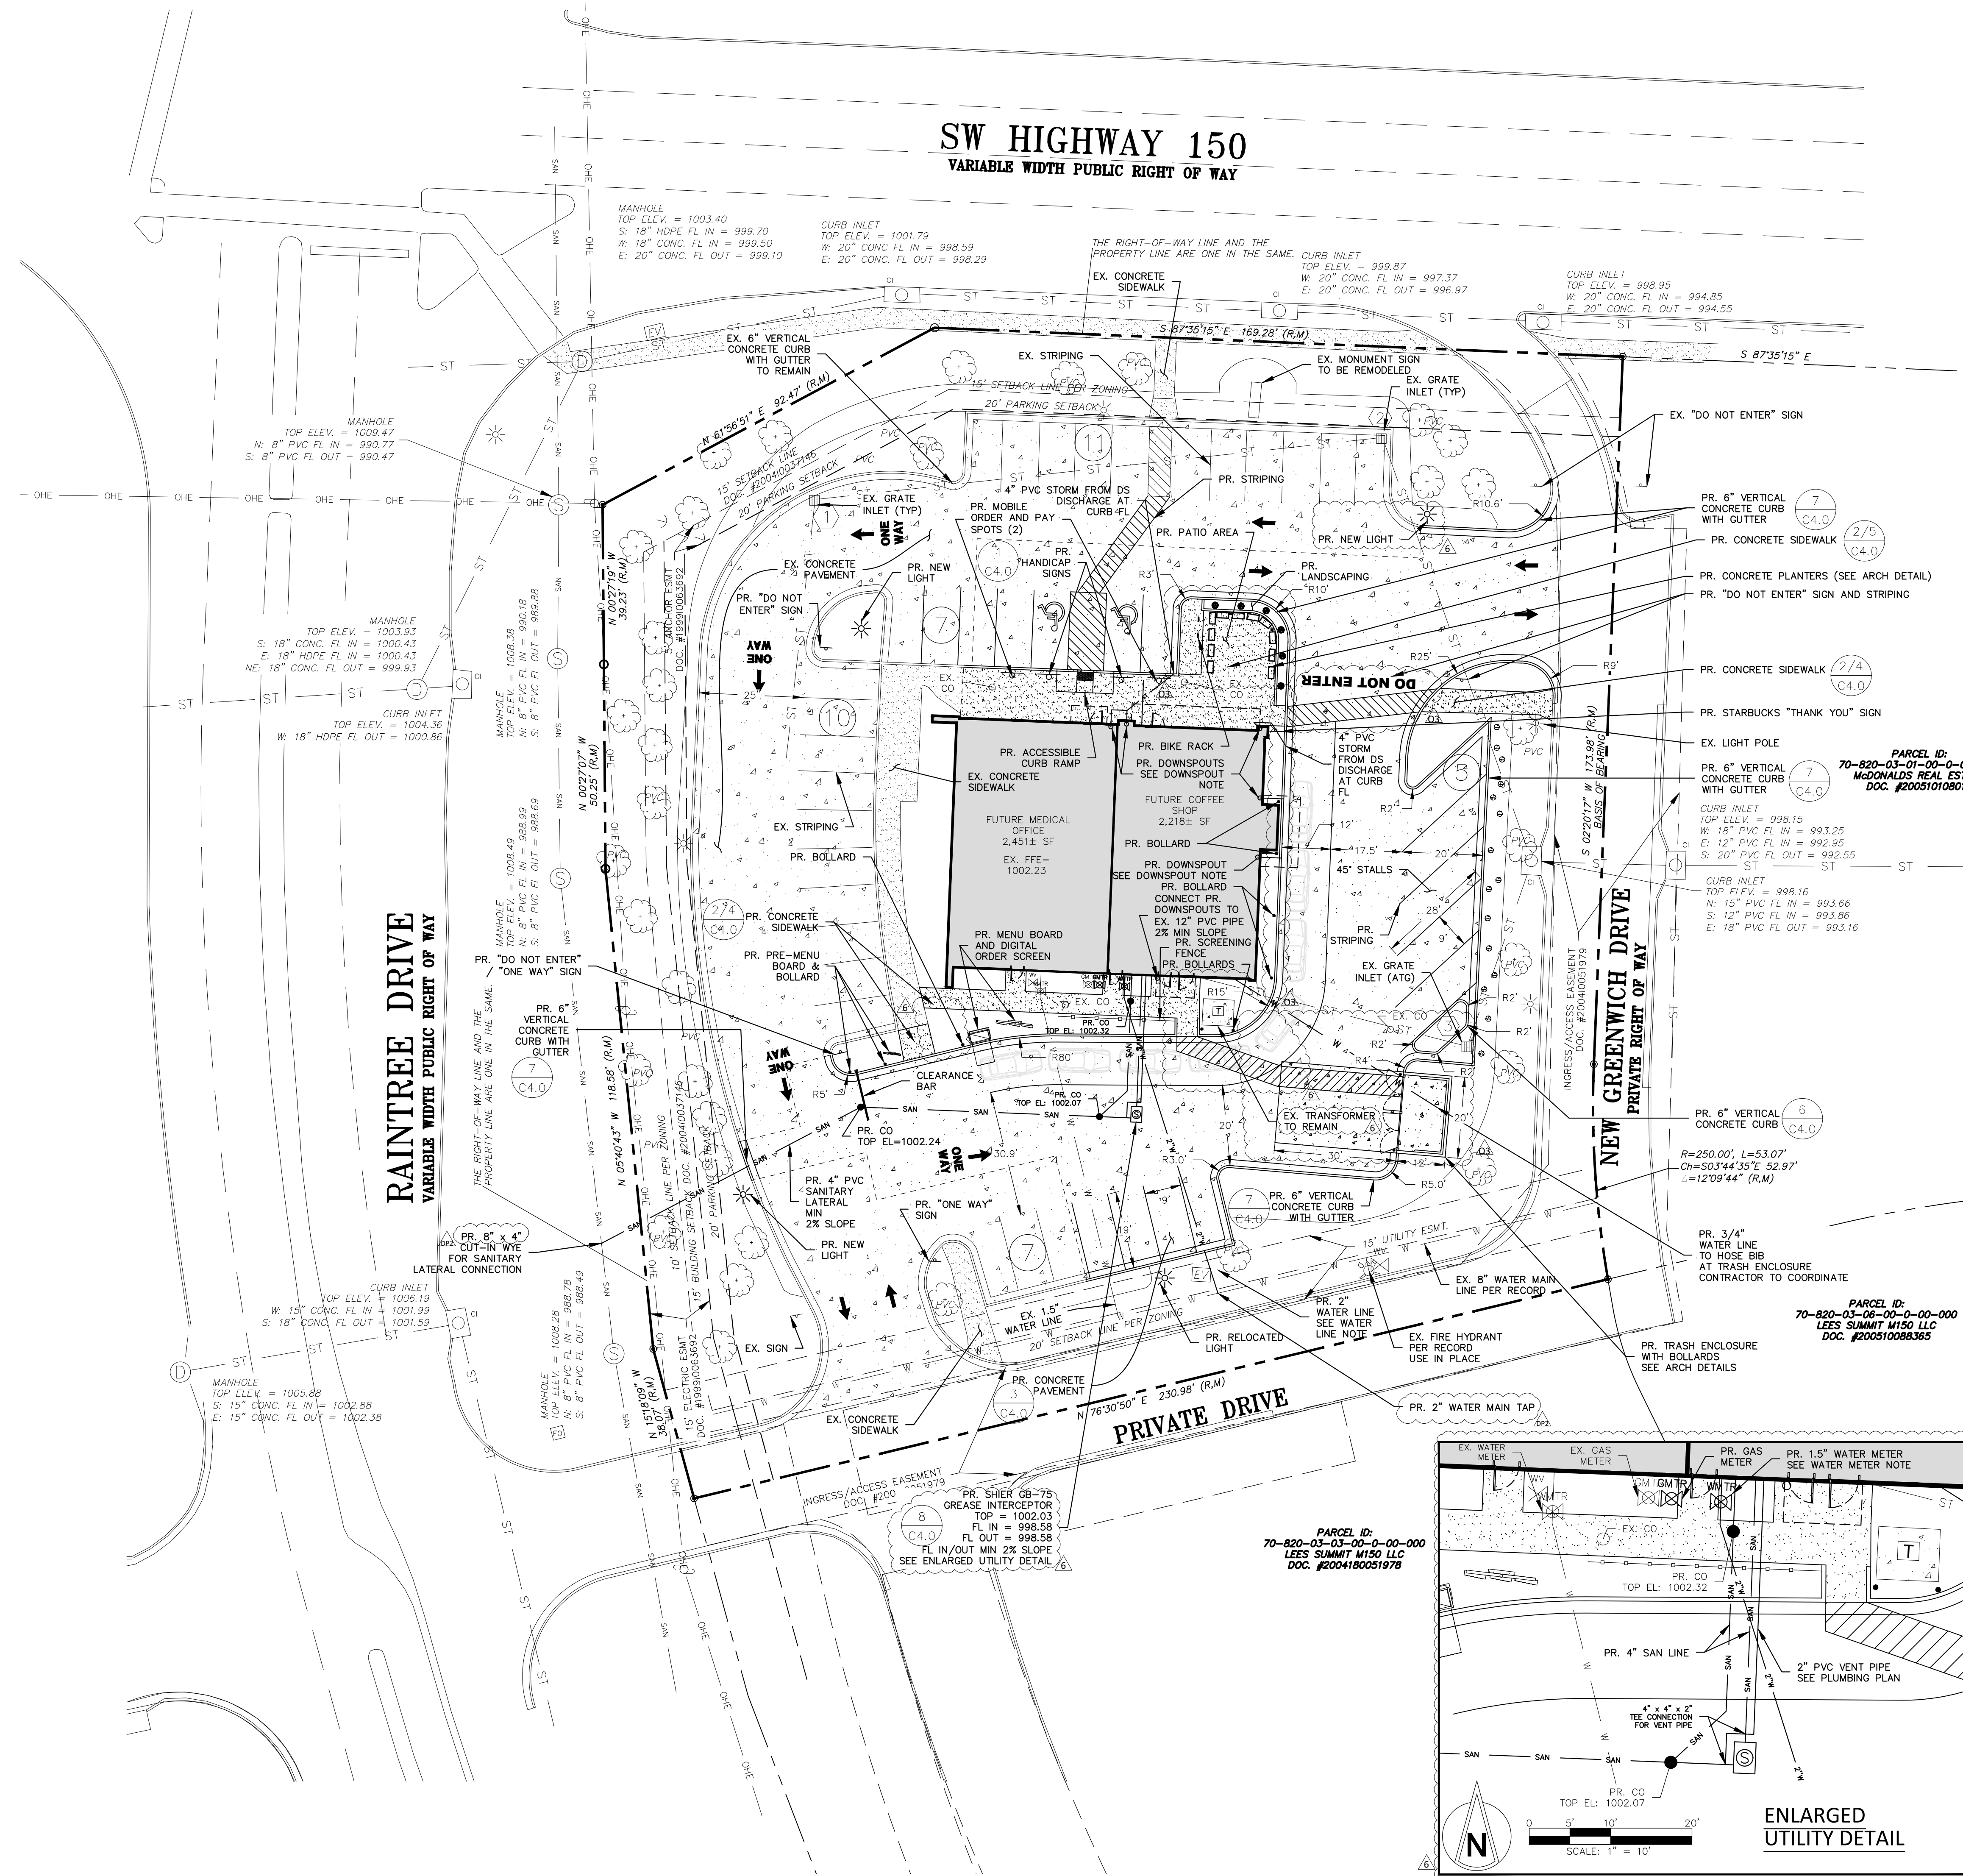


SIDEWALK DIMENSIONS

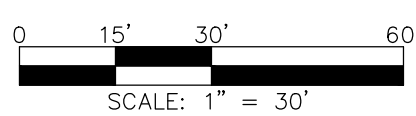

NOTE  
ITEMS SCHEDULED FOR DEMOLITION  
HAVE BEEN REMOVED FOR CLARITY.

CALL BEFORE YOU  
DIG - DRILL - BLAST  
1-800-344-7483  
MISSOURI ONE-CALL SYSTEM, INC.

BUILDING RENOVATION  
155 SW M-150 HIGHWAY  
LEE'S SUMMIT, MO 64082

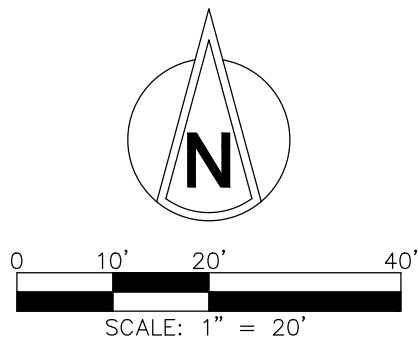

SW HIGHWAY 150  
VARIABLE WIDTH PUBLIC RIGHT OF WAY

RAINTREE DRIVE  
VARIABLE WIDTH PUBLIC RIGHT OF WAY

NEW GREENWICH DRIVE  
PRIVATE RIGHT OF WAY

PRIVATE DRIVE

NO.	EX. STORM STRUCTURE DATA
1	TOP ELEV. = 999.75 S: 12" PVC FL IN = 996.79 E: 12" PVC FL OUT = 995.79
2	TOP ELEV. = 999.87 W: 12" PVC FL IN = 994.87 S: 15" PVC FL OUT = 994.37
3	TOP ELEV. = 1000.11 W: 12" PVC FL IN = 996.31 N: 12" PVC FL OUT = 996.01

PARCEL ID:  
70-820-03-01-00-00-000  
McDONALDS REAL ESTATE  
DOC. #200510108015

PARCEL ID:  
70-820-03-06-00-00-000  
LEES SUMMIT M150 LLC  
DOC. #200510088365

PARCEL ID:  
70-820-03-03-00-00-000  
LEES SUMMIT M150 LLC  
DOC. #2004180051978

NOTE  
ITEMS SCHEDULED FOR DEMOLITION  
HAVE BEEN REMOVED FOR CLARITY.



CALL BEFORE YOU  
DIG - DRILL - BLAST  
1-800-344-7483  
MISSOURI ONE-CALL SYSTEM, INC.

CONSTR. DOC. & REVISIONS

No.	Description	Date
DP	Development Plan Response	06-17-20
CC	City Comments	06-30-20
DP2	Development Plan Response 2	07-15-20
O3	Owner Revision 3	07-20-20
4	Clarification	07-31-20
6	Owner Revision	08-20-20

CASCO DIVERSIFIED CORPORATION  
CERTIFICATE OF AUTHORITY  
#0061613 12/31/21



PROFESSIONAL OF RECORD  
Buerk III, Thomas E.  
License NO. PE-2018000174  
Expiration Date 12/31/20

Drawn By/Checked By: MEB/TEB  
Project Number 320488  
Permit Date 06-17-20

GRADING PLAN

C3.0




BUILDING RENOVATION

155 SW M-150 HIGHWAY  
LEE'S SUMMIT, MO 64082

CONSTR. DOC. & REVISIONS		
No.	Description	Date
DP	Development Plan Response	06-17-20
CC	City Comments	06-30-20
DP2	Development Plan Response 2	07-15-20
O3	Owner Revision 3	07-20-20
4	Clarification	07-31-20
6	Owner Revision	08-20-20

CASCO DIVERSIFIED CORPORATION  
CERTIFICATE OF AUTHORITY  
#000613 12/31/21

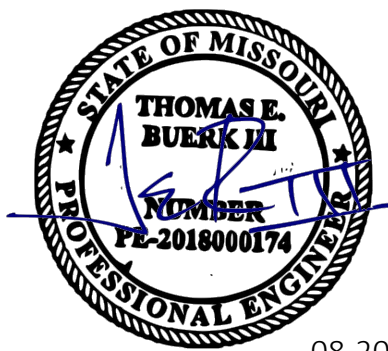


08-20-20  
PROFESSIONAL OF RECORD  
Buerk III, Thomas E.  
License NO. PE-2018000174  
Expiration Date 12/31/20



Drawn By/Checked By: MEB/TEB  
Project Number 320488  
Permit Date 06-17-20

SITE DETAILS

C4.2

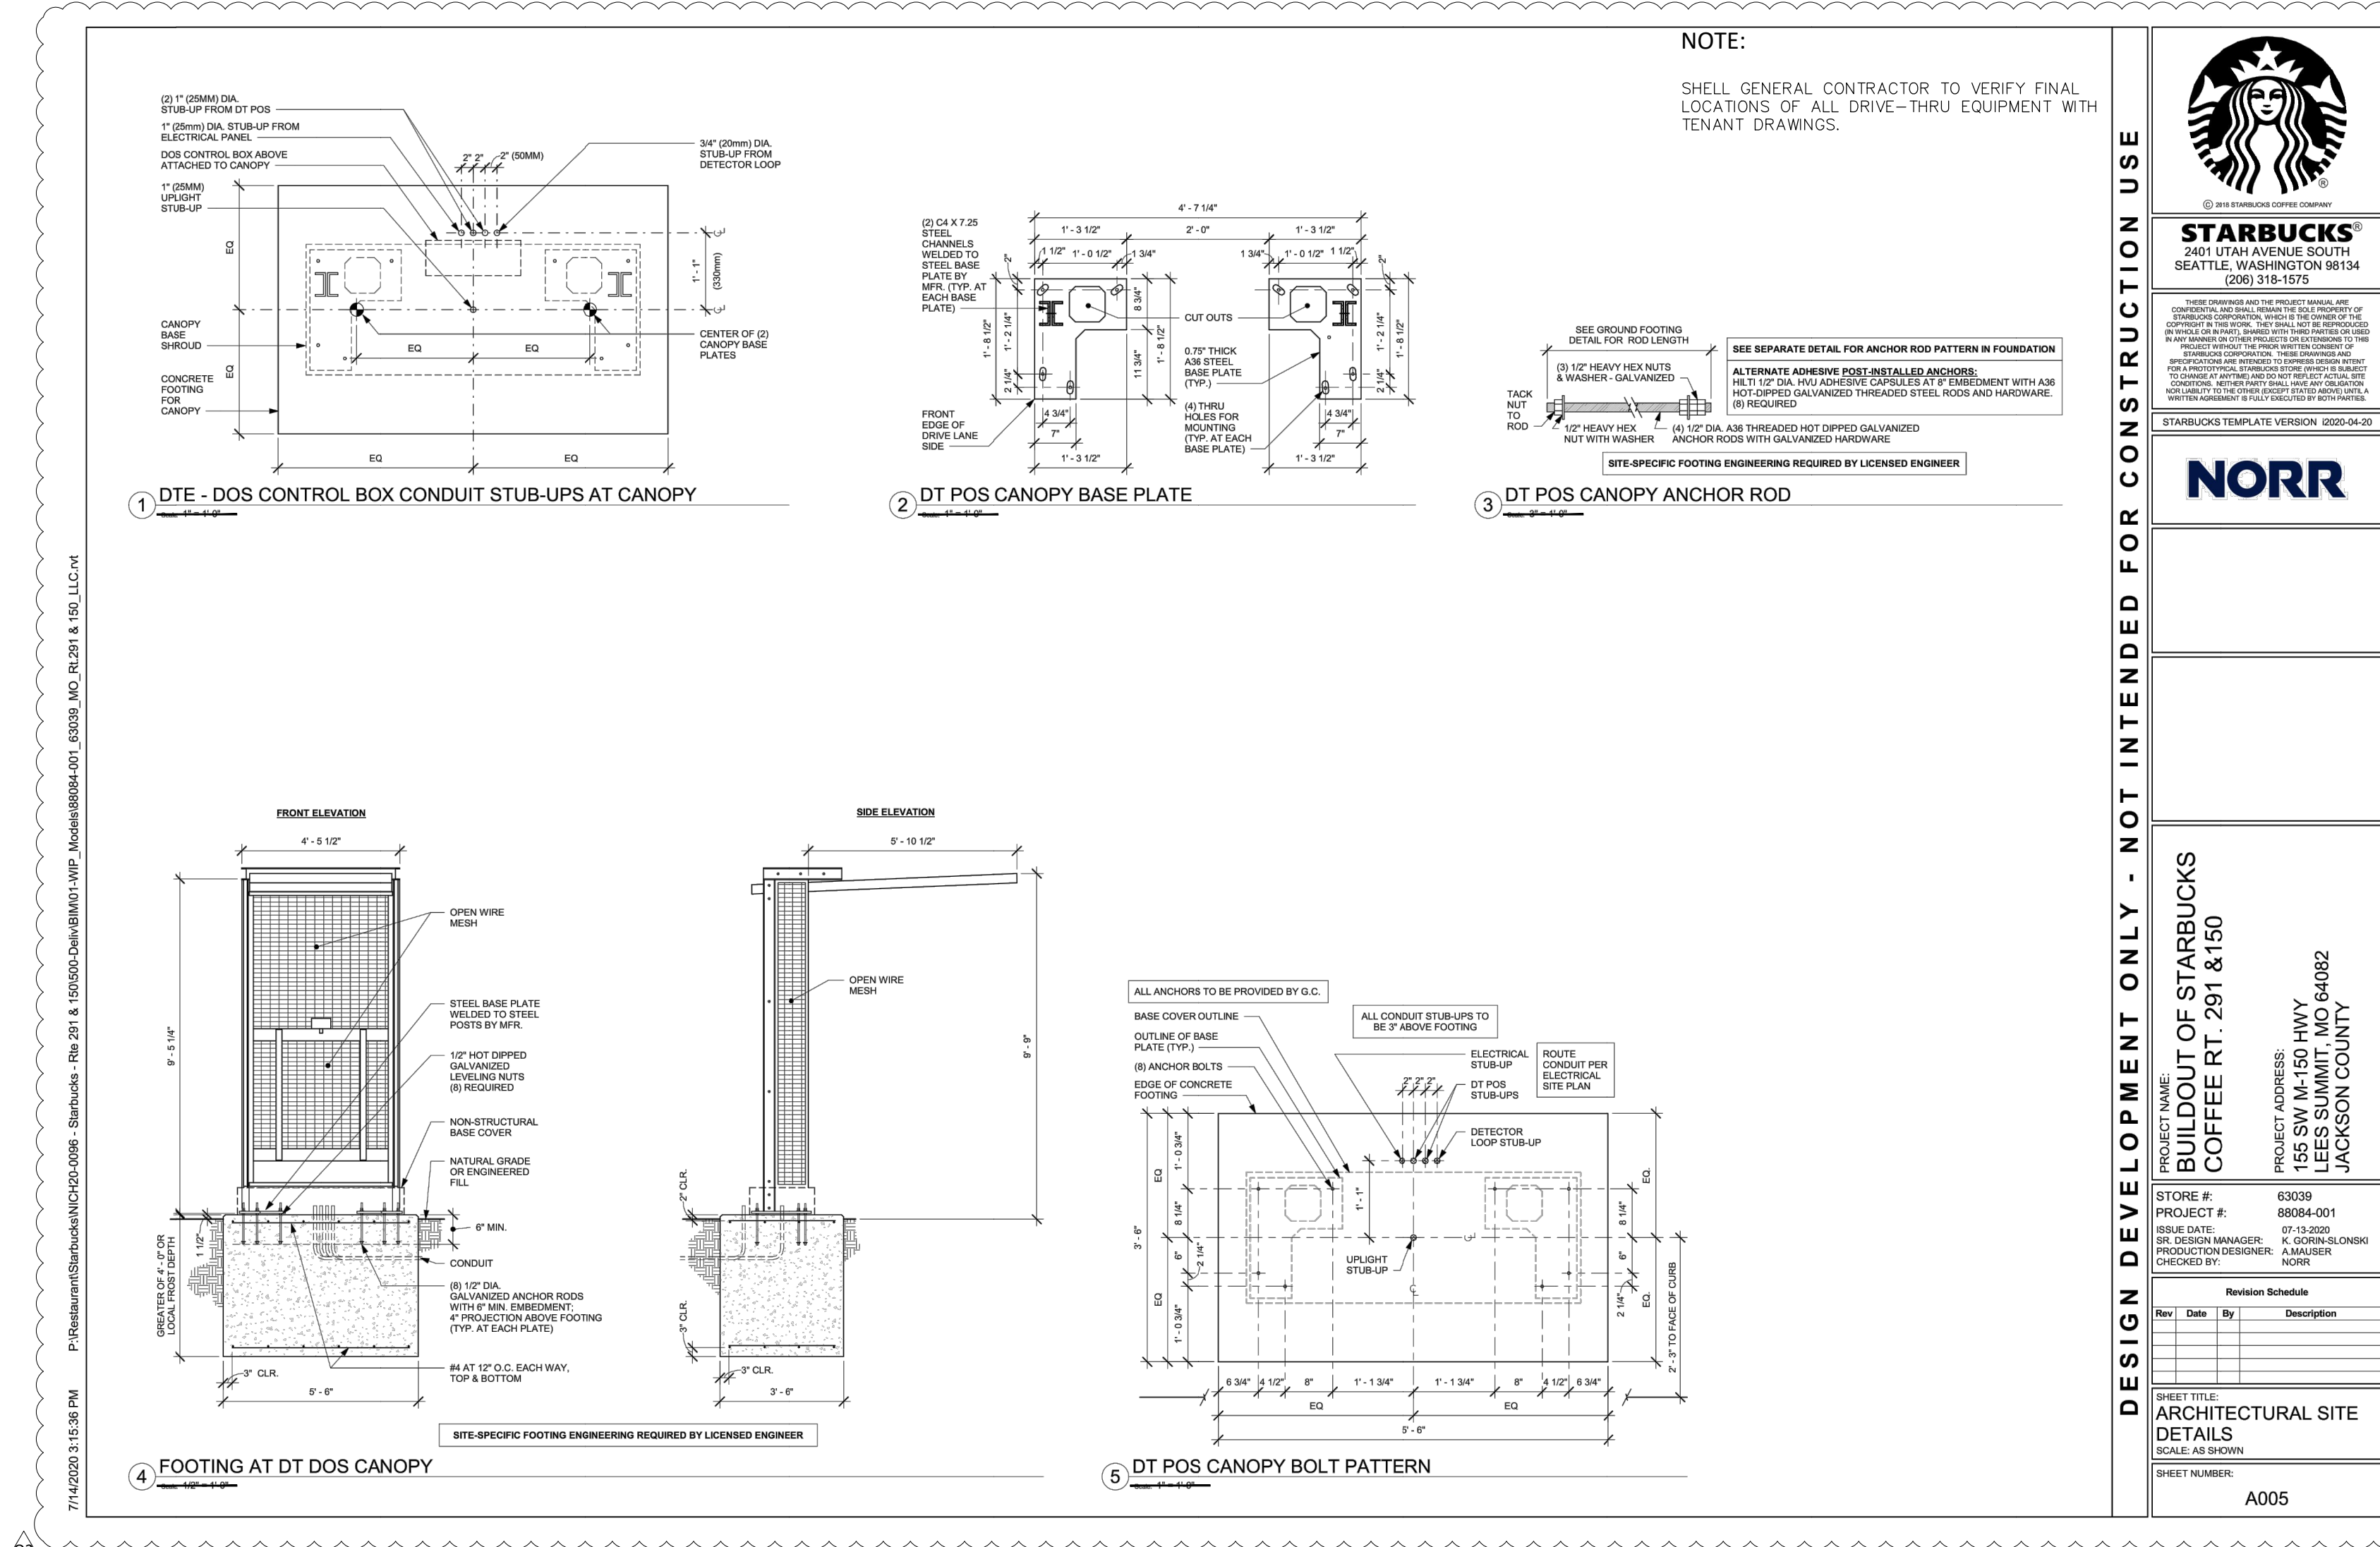

7/14/2020 2:15:36 PM P:\Restaurant\Starbucks\ARCHD-005 - Starbucks - RT291 & 150\505-Casco\BIM\1-WIP\_Model\88064-001\_20032\_M0\_01\_291 & 150\_LLC.rvt

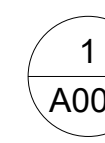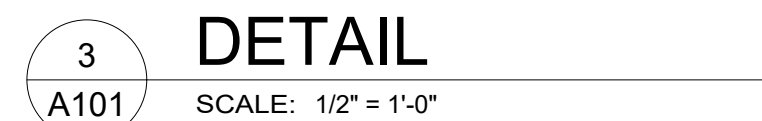

# SITE PLAN

SCALE: 1/16" = 1'-0"


ARCHITECTURAL SITE PLAN KEYNOTES			
1	TRASH ENCLOSURE TO ACCOMMODATE MIN. 2 DUMPSTERS (ONE FOR RECYCLING) W/ HOSE B/B.	11	IRRIGATED PLANTERS. REFER TO CIVIL AND LANDSCAPE DRAWINGS.
2	LANDSCAPING TO BE LOW PROFILE, NO HIDING PLACES, 30" MAXIMUM HEIGHT; RE: LANDSCAPE PLANS.	12	DRIVE THRU WINDOW
3	PATIO.	13	DRIVE THRU MENU BOARD, RE: DETAIL 9/A504A.
4	SITE ACCESS.	14	DRIVE THRU ORDER SCREEN AND CANOPY, RE: DETAIL 9/A504A & 5/A505
5	UPDATED EXISTING MONUMENT SIGN, BY OWNER.	15	PREVIEW MENU BOARD, RE: DETAIL 2 & 8/A504A.
6	BIKE RACK. RE: 14/A506	16	NON-ILLUMINATED PROTECTIVE BOLLARD AND FOOTING, SEE DETAIL 13A/A506.
7	HANDICAPPED PARKING AND SIGN	17	CLEARANCE BAR, SEE DETAIL 6/A504.A
8	ACCESSIBLE CURB RAMP	18	DIRECTIONAL SIGNAGE. RE: 1.2 & 3/A505
9	ACCESSIBLE PATH OF TRAVEL. REFER TO CIVIL DRAWINGS	19	REFER TO CIVIL DRAWINGS FOR PAVING.
10	DRIVE-THRU EQUIPMENT INCLUDING VEHICLE DETECTION LOOP, WIRELESS COMMUNICATION, AND MONITORS.	20	NOT USED
		21	PARKING, DRIVE-THRU AND DIRECTIONAL STRIPING. REFER TO CIVIL DRAWINGS
		22	SITE LIGHTING. REFER TO ELECTRICAL DRAWINGS.
		23	NOT USED
		24	TALL SCREEN TO COVER UTILITY METERS, RE: DETAIL 1/A506.
		25	PROTECTIVE BOLLARDS AND FOOTING AT DRIVE-THRU LANE. SHOULD BE ILLUMINATED WHEN IN LANDSCAPE STRIP. SEE DETAIL 13B/A506.
		26	EXISTING GAS SERVICE
		27	EXISTING TRANSFORMER. REFER TO CIVIL DRAWINGS.
		28	MOBIL ORDER PARKING SIGN
		29	EXISTING WATER METER AND CLEAN OUT
		30	EXISTING IRRIGATION VAULT

## DEMOLITION PLAN KEYED NOTES

- EXISTING DRIVE-THRU CONSTRUCTION TO BE REMOVED IN ITS ENTIRETY. STRUCTURAL STEEL COLUMNS WITHIN THE BUILDING WALL TO REMAIN. DRIVE THRU EQUIPMENT, CURBS AND BOLLARDS TO BE REMOVED IN THEIR ENTIRETY. COORDINATE WITH CIVIL.
- EXISTING WALL MOUNTED DRIVE-THRU EQUIPMENT, WINDOW SYSTEM AND STUD WALL TO BE REMOVED IN THEIR ENTIRETY TO THE BOTTOM OF THE STEEL ROOF BEAMS AS REQUIRED FOR NEW CONSTRUCTION. REMOVE ALCOVE FOR VACUUM TUBE AND INFILL TO MATCH ADJACENT CONSTRUCTION. REFER TO A101 FOR ADDITIONAL INFORMATION.
- EXISTING BRICK VENEER TO BE REMOVED IN ITS ENTIRETY FROM THE ENTIRE EAST AND NORTH WALLS U.N.O.. EXISTING EXTERIOR SHEATHING TO REMAIN. REPLACE ANY EXISTING EXTERIOR SHEATHING AND INSULATION THAT IS UNSOUND OR IN DISREPAIR. INFILL VOIDS TO MATCH ADJACENT EXISTING CONSTRUCTION. PREPARE WALL TO RECEIVE NEW FLUID APPLIED AIR AND MOISTURE BARRIER SYSTEM.
- SAW CUT EXISTING BRICK VENEER TO PROVIDE A CLEAN JOINT AT NEW EXTERIOR FINISH MATERIAL.
- EXISTING BRICK VENEER STUD WALL AND WINDOWS TO REMAIN. G.C. TO PROTECT DURING CONSTRUCTION. TUCKPOINT AS REQUIRED. REFER TO A101 FOR ADDITIONAL INFORMATION.
- EXISTING STOREFRONT AND VESTIBULE CONSTRUCTION TO BE REMOVED IN ITS ENTIRETY TO THE BOTTOM OF THE STEEL ROOF BEAMS AS REQUIRED FOR NEW CONSTRUCTION. STRUCTURAL STEEL COLUMNS TO REMAIN.
- EXISTING CANOPY TO BE REMOVED IN ITS ENTIRETY.
- EXISTING H.M. DOOR AND FRAME TO BE REMOVED IN ITS ENTIRETY.
- SAW CUT EXISTING BRICK VENEER AS REQUIRED TO PROVIDE OPENING FOR NEW H.M. DOOR. PROVIDE SHORING AS REQUIRED UNTIL NEW LINTEL IS INSTALLED.
- ALL EXISTING INTERIOR CEILINGS, LIGHT FIXTURES, DUCTWORK, AND DIFFUSERS TO BE REMOVED COMPLETELY. REFER TO ELECTRICAL AND MECHANICAL FOR ADDITIONAL INFORMATION.
- ALL EXISTING PARTITIONS AND DOORS AND MILLWORK TO BE REMOVED COMPLETELY UNLESS NOTED INCLUDING ANY OUTLETS, SWITCHES, ETC. REFER TO MEP DRAWINGS FOR ADDITIONAL INFORMATION.
- ALL EXISTING FLOORING TO BE REMOVED COMPLETELY. SCRAPE OR GRIND FLOORS TO REMOVE ANY EXISTING ADHESIVES OR REMAINING SUBSTRATES. PATCH, GRIND OR FLOAT FLOORS AS REQUIRED TO ENSURE FLUSH TRANSITION. PREPARE FLOOR AS REQUIRED FOR NEW FINISHES. G.C. TO ENSURE THAT FLOOR SLOPES NO MORE THAN 1/8 INCH PER 10 FEET.
- EXISTING WALL TO REMAIN. PATCH AND REPAIR GYP. BD. AS REQUIRED.
- EXISTING STUD WALL AND BRICK VENEER CONSTRUCTION TO BE REMOVED UP TO 10'-0"± A.F.F. TO ACCOMMODATE NEW STOREFRONT. REFER TO A201 FOR EXTENT OF STOREFRONT.
- EXISTING ROOF HATCH AND LADDER TO REMAIN.
- SAW CUT AND REMOVE EXISTING SLAB AND FOUNDATION AS REQUIRED FOR NEW CONSTRUCTION. REFER TO A101 AND STRUCTURAL DRAWINGS FOR ADDITIONAL INFORMATION.
- DEMOLISH ALL PLUMBING FIXTURES. REMOVE SUPPLY AND RETURN LINES COMPLETELY. CAP LINES UNDER CONC. SLAB.
- MODIFY EXISTING EXTERIOR STUD WALL TO CREATE NEW PARAPET HEIGHT ALONG FUTURE MEDICAL OFFICE. SEE A201 FRONT ELEVATION. COORDINATE EXTENT OF DEMOLITION WITH NEW FINISHED PARAPET HEIGHT OF 19'-6".
- DEMOLISH ALL RTU'S, CURBS, DUCTWORK, DIFFUSERS, BACK TO THE EXISTING ROOF OPENING TYP. INFILL OPENINGS WITH FRAMING, METAL DECK, INSULATION, AND ROOF MEMBRANE TO BE FLUSH WITH EXISTING METAL DECK.
- EXISTING FLAGPOLE TO BE REMOVED. PATCH AND REPAIR BRICK AS REQUIRED TO MATCH ADJACENT FINISH.
- EXISTING HOSE BIB TO REMAIN
- EXISTING GAS SERVICE AND METER TO REMAIN

## GENERAL NOTES

- FIELD VERIFY ALL DRAWINGS AND DIMENSIONS WITH EXISTING CONDITIONS.
- CONTRACTOR IS RESPONSIBLE FOR MAINTAINING REQUIRED FIRE-RATING AND FIRE-PROOFING IN ALL INSTANCES.
- CONTRACTOR TO PROVIDE FIRE EXTINGUISHERS AS REQUIRED. PROVIDE BLOCKING AS REQUIRED. VERIFY QUANTITY AND LOCATIONS WITH LOCAL OFFICIALS.
- G.C. TO REMOVE ALL DEBRIS AND/OR RECYCLABLE MATERIALS. DO NOT STORE ON SITE ONCE REMOVED FROM BUILDING.
- REFER TO PLUMBING DRAWINGS FOR REUSE AND DEMOLITION OF EXISTING PLUMBING.
- CONTRACTOR IS TO REMOVE AND PROPERLY DISPOSE OF EXISTING KITCHEN AND BATHROOM, SYSTEMS (CAPTIVEAIRE), THIS INCLUDES EXISTING EXHAUST FANS, MAKE UP AIR UNIT AND THEIR DUCTS, CONTROLS, AND GAS LINES. CONTRACTOR IS TO CAP THE ROOF CURBS WEATHER TIGHT AFTER EQUIPMENT REMOVAL. CONTRACTOR IS TO VERIFY LOCATION OF ALL LINES AND EQUIPMENT PRIOR TO DEMOLITION.
- EXISTING GAS LINES TO THE ROOF TOP UNITS AND WATER HEATER ARE TO BE PRESERVED FOR FUTURE USE. GAS LINES TO KITCHEN EQUIPMENT ARE TO BE REMOVED AND CAPPED AT LINE BRANCHES, WITH A SHUT OFF VALVE.
- WATER HEATER EXHAUST, INTAKE, GAS PIPING SHALL REMAIN AS IS AND SHOULD BE PROTECTED DURING CONSTRUCTION.
- CONTRACTOR SHALL INFILL AND SEAL ALL EXISTING FLOOR SINKS AND TROUGHS PER CODE, AND CAP AND SEAL ALL ASSOCIATED VENTS AT FLOOR LEVEL.
- ANY EXISTING CLEAN OUT SHOULD BE PRESERVED WHEN POSSIBLE, OR CONVERTED FROM A WALL TO A FLOOR CLEAN OUT.
- ALL FLOOR DRAINS AND ASSOCIATED VENTS SHOULD BE CAPPED AND SEALED PER CODE. ONLY THE FLOOR DRAIN IN THE JANITORS CLOSET SHALL REMAIN.
- CONTRACTOR IS TO REMOVE ALL EXISTING WATER LINES THAT ARE NOT BEING REUSED SEE PLUMBING DRAWINGS.

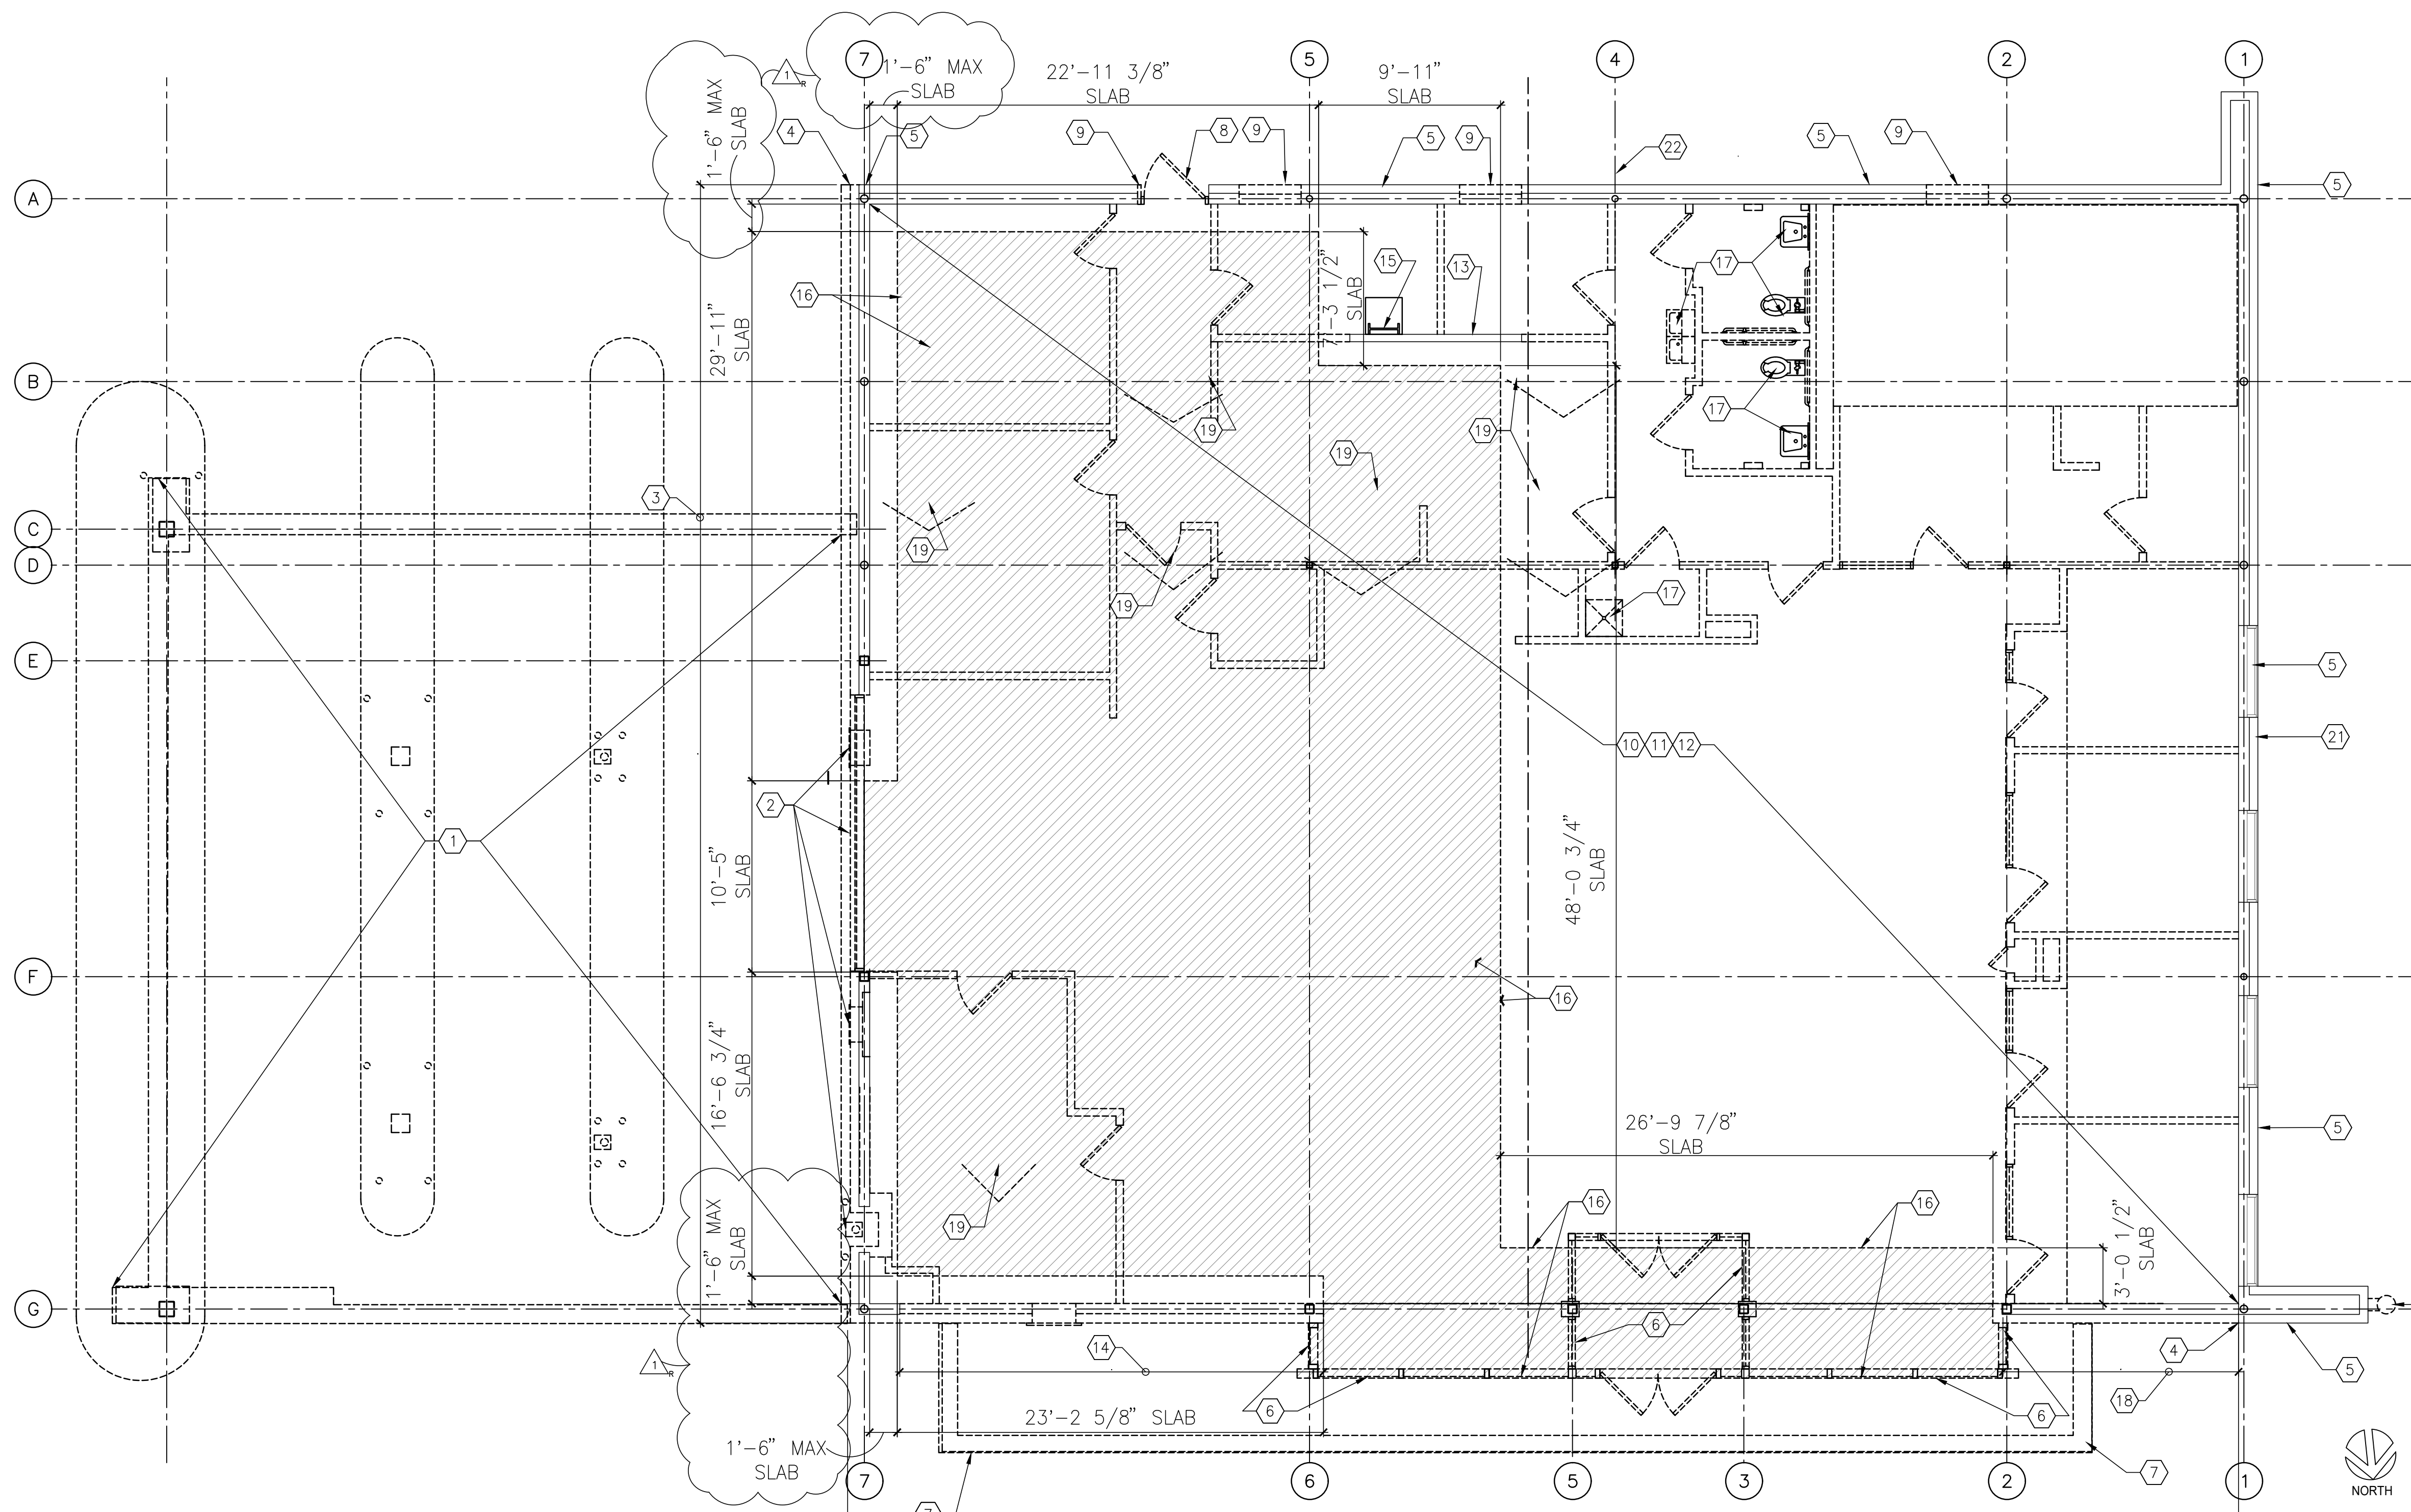


1  
D101

DEMOLITION PLAN  
SCALE: 3/16" = 1'-0"

CONSTR. DOC. & REVISIONS	
No.	Description
1	Owner Review
2	Owner Review
3	OWNER REVISION

CASCO DIVERSIFIED CORPORATION  
ARCHITECTURAL  
CERTIFICATE OF AUTHORITY  
#000329 12/31/21

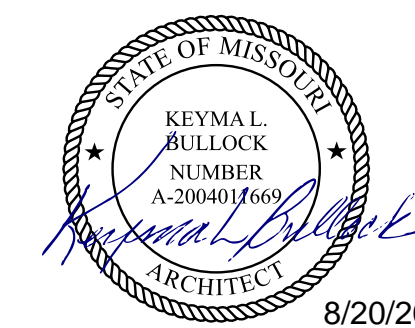

PROFESSIONAL OF RECORD  
BULLOCK, KEYMAL L.  
License NO. 200401669  
Expiration Date 12/31/20

Drawn By/Checked By: MS/MSD  
Project Number 320488


Permit Date 06-17-20

DEMOLITION  
PLAN

D101

No.	Description	Date
1	Owner Review	05/13/20
2	Owner Review	06/04/20
3	City Comments	06/30/20
4	OWNER REVISION 3	07/20/20

CASCO DIVERSIFIED CORPORATION  
ARCHITECTURAL  
CERTIFICATE OF AUTHORITY  
#000329 12/31/21

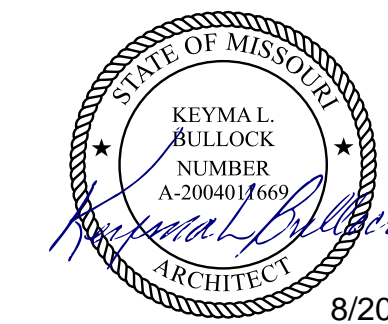

PROFESSIONAL OF RECORD  
BULLOCK, KEYMAL L.  
License NO. 200401669  
Expiration Date 12/31/20

Drawn By/Checked By: RMT/MSD

Project Number 320488

Permit Date 06-17-20

## FLOOR PLAN

# A101

## GENERAL NOTES


1. FIELD VERIFY ALL DRAWINGS AND DIMENSIONS WITH EXISTING CONDITIONS.
2. UNLESS NOTED OTHERWISE, ALL FLOOR PLAN WALL DIMENSIONS ARE TO FACE OF FINISHED WALL TO FACE OF FINISHED WALL.
3. UNLESS NOTED OTHERWISE, ALL EXTERIOR DIMENSIONS ARE TO THE FACE OF FINISH OR ROUGH OPENING.
4. UNLESS NOTED OR SHOWN OTHERWISE, DOORS ARE TO BE LOCATED 4-1/2" OFF OF THE ADJACENT FINISHED WALL SURFACE.
5. ALL WOOD CONSTRUCTION ASSOCIATED WITH THIS WORK SHALL BE FIRE RETARDANT TREATED (FRT). ALL NEW FRAMING AT STOREFRONT AND ABOVE CEILING SHALL BE NON-COMBUSTIBLE.
6. CONTRACTOR IS RESPONSIBLE FOR MAINTAINING REQUIRED FIRE-RATING AND FIRE-PROOFING SYSTEMS IN ALL INSTANCES.
7. CONTRACTOR TO VERIFY WITH FIRE DEPARTMENT THE QUANTITY OF LOCATION OF FIRE EXTINGUISHERS REQUIRED FOR UNFINISHED SHELL SPACE.
8. SUBCONTRACTORS SHALL BE RESPONSIBLE FOR THE CLEAN-UP OF THE BUILDING FOR THEIR RESPECTIVE TRADE AT THE COMPLETION OF WORK EACH DAY. AT ALL TIMES REMOVE WASTE MATERIAL, TRASH AND DEBRIS AND LEGALLY DISPOSE OF.
9. PROVIDE LOW PROFILE THRESHOLD AT ALL EXTERIOR DOORS. THRESHOLD HEIGHT 1/2" H. MAX., TYPICAL.
10. SEE STRUCTURAL DRAWINGS FOR ADDITIONAL INFORMATION.
11. STREET ADDRESS NUMBERS SHALL BE PLACED ON THE BUILDING WHERE DIRECTED BY THE FIRE DEPARTMENT, WITH LETTER HEIGHT AND COLOR TO BE DICTATED BY THE FIRE DEPARTMENT. THE LETTERS SHALL BE ARABIC NUMBERS OR ALPHABET LETTERS A MINIMUM OF 4" HIGH WITH MINIMUM STROKE WIDTH OF 0.5 INCH AND SHALL CONTRAST WITH THEIR BACKGROUND.

## WALL TYPE LEGEND

1. EXISTING EXTERIOR BRICK VENEER ON METAL STUD WALL TO REMAIN. PATCH EXISTING GYP. BD. AS REQUIRED. EXTEND METAL STUD AND BRICK VENEER TO NEW PARAPET HEIGHT SHOWN ON EXTERIOR ELEVATIONS AT SIM. STUD SIZE AND BRICK TO MATCH EXISTING.
2. MODIFIED EXTERIOR WALL (EIFS): NEW EIFS ON EXISTING METAL STUD AND EXISTING SHEATHING TO REMAIN. PATCH EXISTING INTERIOR GYP. BD. AS REQUIRED.
3. MODIFIED EXTERIOR WALL(SIDING): NEW FIBER CEMENT SIDING AND 7/8" METAL FURRING ON EXISTING METAL STUD AND EXISTING SHEATHING TO REMAIN. PATCH EXISTING INTERIOR GYP. BD. AS REQUIRED.
4. EXISTING INTERIOR WALL: EXISTING INTERIOR GYP. BOARD ON METAL STUD WALL TO REMAIN. PATCH EXISTING GYP. BD. AS REQUIRED.
5. NEW DEMISING WALL - UL DESIGN U419 (6" METAL STUDS): (2) LAYERS 5/8" TYPE "X" GYP. BD. (MOISTURE RESISTANT AT WET LOCATIONS) ON BOTH SIDES OF 6" (20 GA.) METAL STUDS AT 16" O.C. TO UNDERSIDE OF DECK. PROVIDE SOUND ATTENUATION INSULATION BETWEEN STUDS. SEE REFER TO DETAIL 10/A502 AND SHT. G-100 FOR ADDITIONAL INFORMATION.
6. NEW INTERIOR WALL: (1) LAYERS 5/8" TYPE "X" GYP. BD. (MOISTURE RESISTANT AT WET LOCATIONS) ON BOTH SIDES OF 5 5/8" (20 GA.) METAL STUDS AT 16" O.C. TO UNDERSIDE OF DECK. PROVIDE SOUND ATTENUATION INSULATION BETWEEN STUDS. REFER TO 8/A502 FOR ADDITIONAL INFORMATION.
6. NEW EXTERIOR WALL: NEW FIBER CEMENT SIDING AND 7/8" METAL FURRING ON NEW SHEATHING AND NEW 6" METAL STUD @ 16" O.C. REFER TO 3/A302 FOR ADDITIONAL INFORMATION.



## FLOOR PLAN KEYED NOTES

1. EXISTING ROOF ACCESS LADDER AND HATCH.
2. EXISTING GAS SERVICE AND METER TO REMAIN. REFER TO PLUMBING SHEETS FOR ADDITIONAL INFORMATION.
3. EXISTING WINDOW TO REMAIN
4. ELECT. METER & DISCONNECT
5. ELECT. PANELS
6. PROVIDE 1/2" PLYWOOD BLOCKING FOR FLY FAN ABOVE DOOR
7. CANOPY ABOVE SHOWN DASHED RE:10/A501
8. CANOPY DOWN SPOUT TIE IN TO STORM SYSTEM
9. WALL SCONCE/EMERGENCY LIGHT (TYP) REFER TO ELECTRICAL DWGS.
10. DRIVE -THRU WINDOW. RE:A504
11. EQUIPMENT SCREEN FENCE RE:1/A506
12. NON-ILLUMINATED PROTECTIVE BOLLARD & FOOTING, TYP., RE: 13A/A506
13. ILLUMINATED BOLLARD & FOOTING, TYP. OF (6) RE: 13B/A506
14. DRIVE THRU SIGN REFER TO SITE PLAN
15. CONCRETE SIDEWALK, CURB AND CURB CUTS BY CIVIL
16. PARKING LOT PAVEMENT AND STRIPING BY CIVIL
17. HOSE BIB. RE: 1/A502
18. NEW GAS METER
19. EXISTING WATER METER VAULT
20. EXISTING CLEAN OUT
21. EXISTING DOWNSPOUT
22. RELOCATED IRRIGATION VAULT

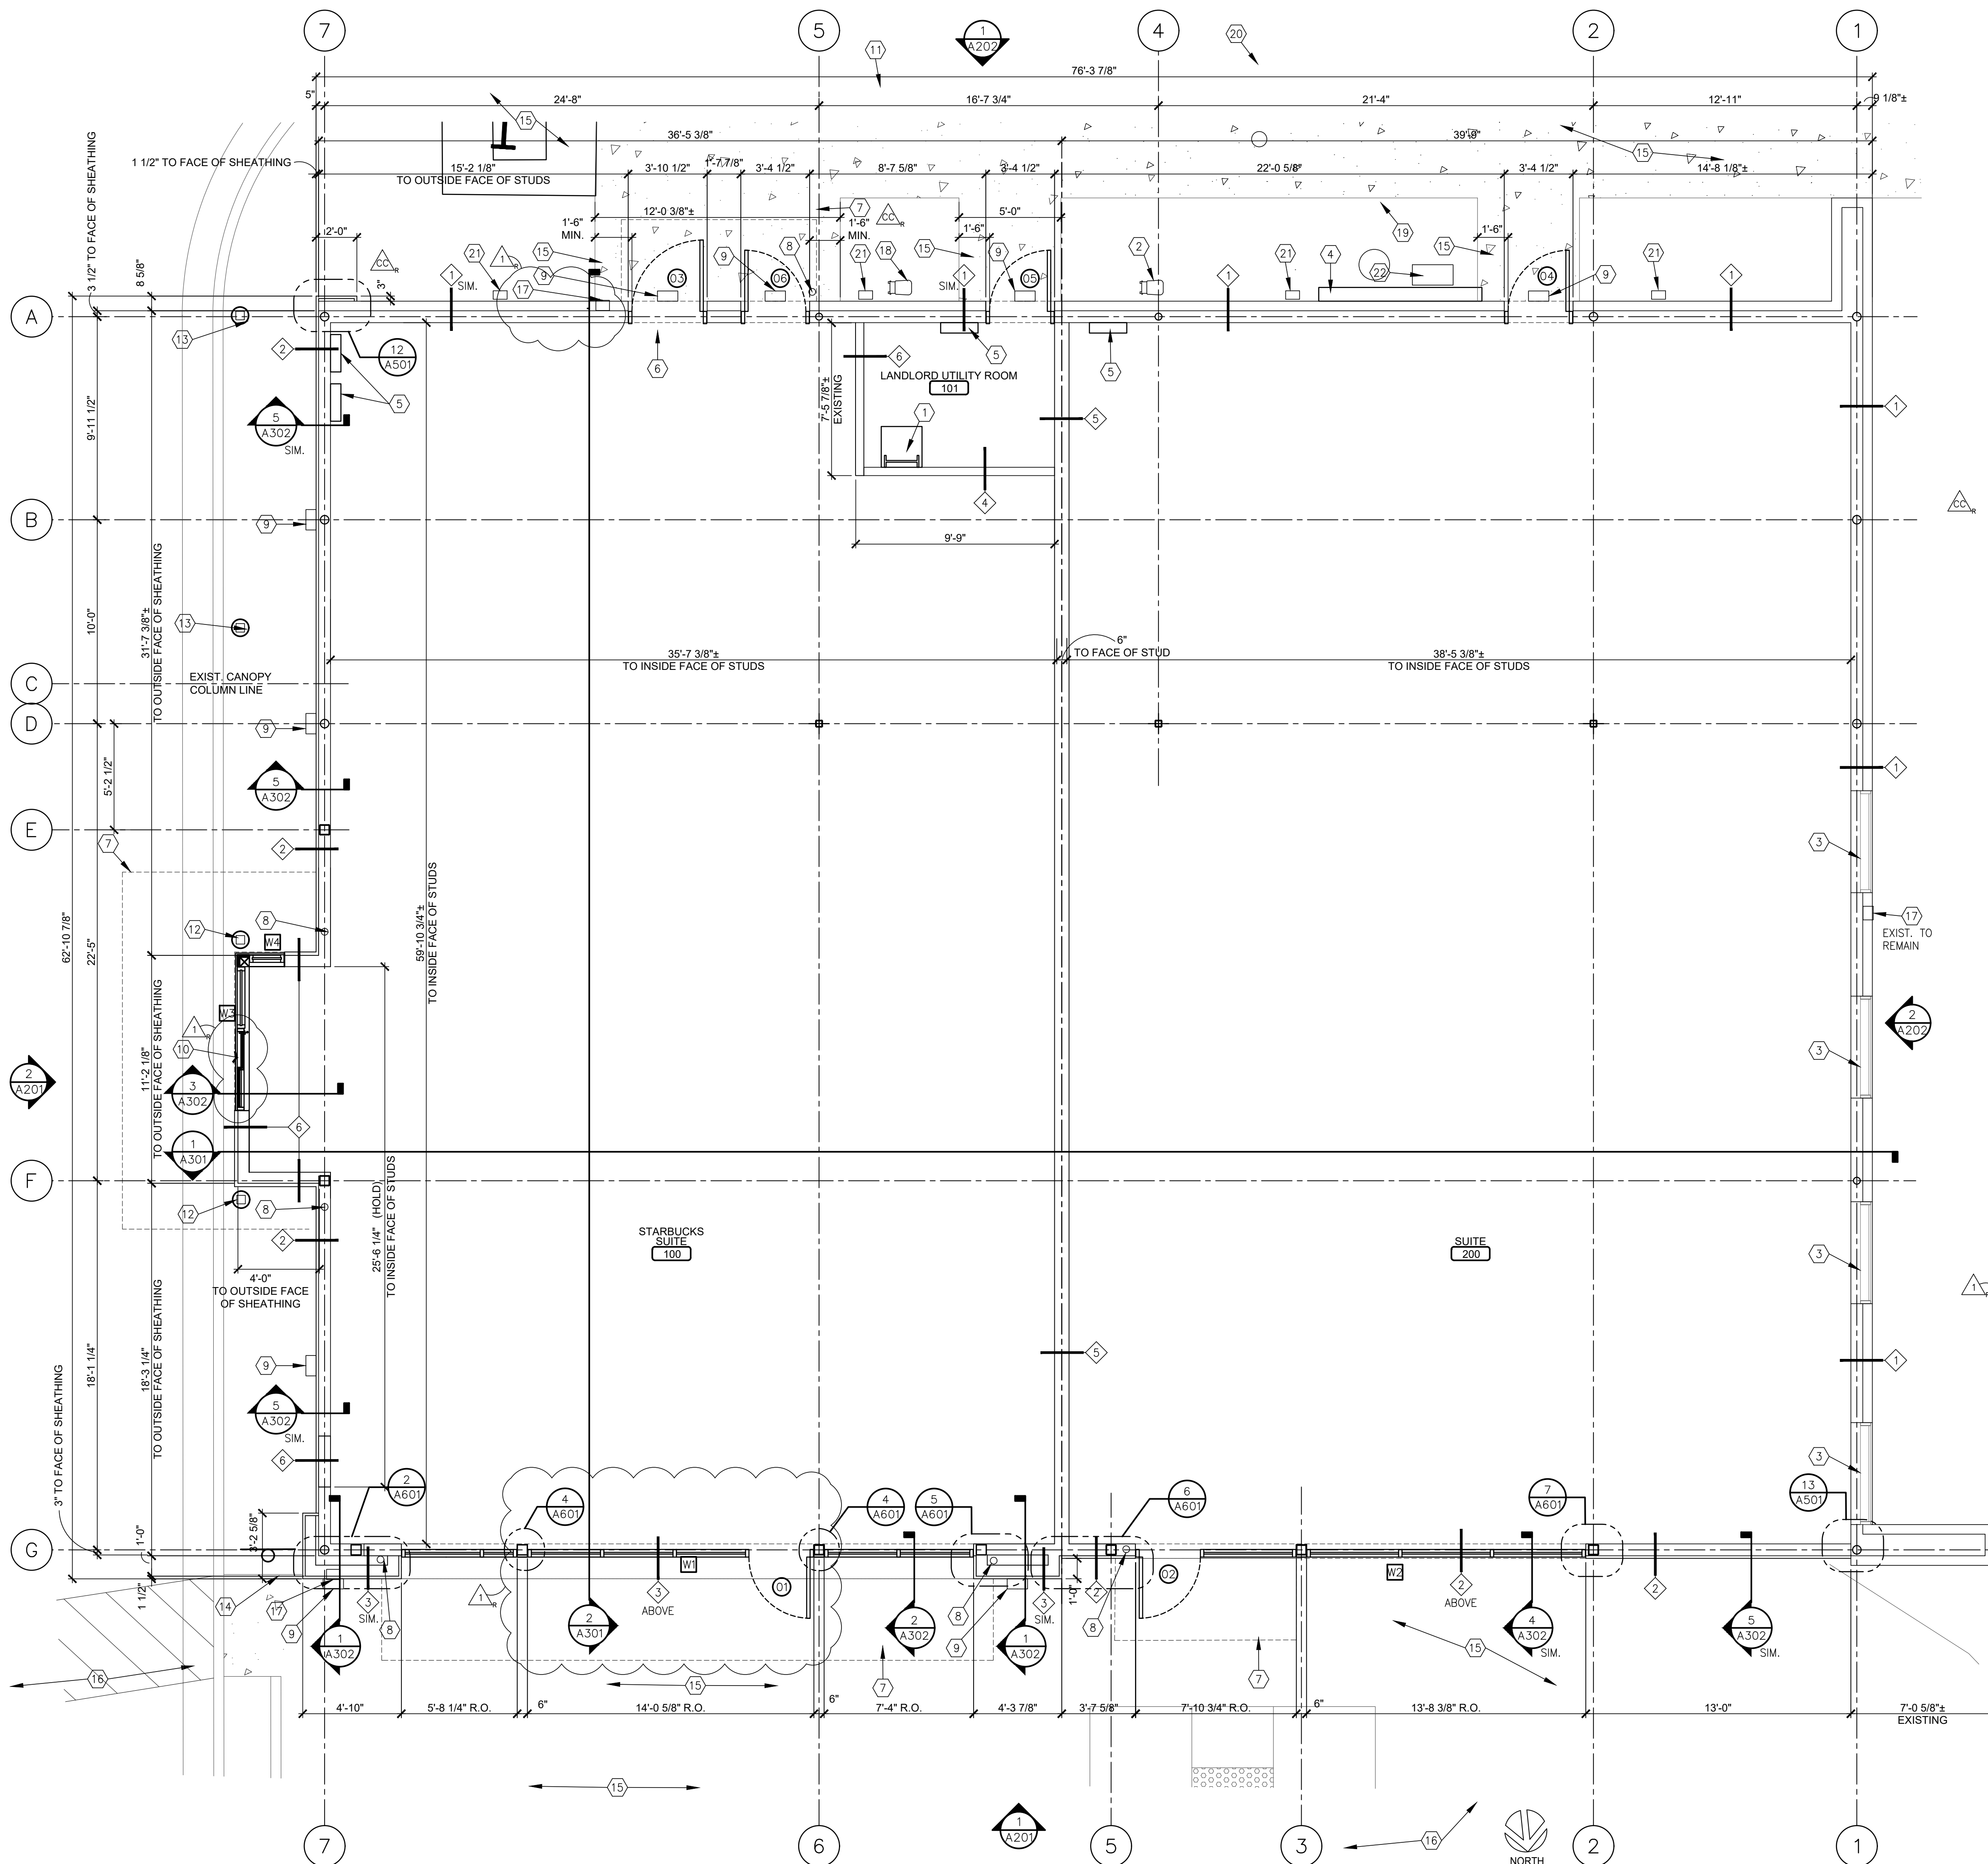

1  
A101 FLOOR PLAN  
SCALE: 1/4" = 1'-0"


1. CONSIDERATION WILL NOT BE GRANTED FOR ANY ALLEGED MISUNDERSTANDINGS OF THE AMOUNT OF WORK TO BE PERFORMED. TENDER OF PROPOSAL SHALL CONVEY FULL AGREEMENT TO THE ITEMS AND CONDITIONS INDICATED ON THE DRAWINGS. SHOULD THE CONTRACTOR FIND DISCREPANCIES OR OMISSIONS IN THE CONTRACT DOCUMENTS OR BE IN DOUBT AS TO THE INTENT THEREOF, THE CONTRACTOR SHALL OBTAIN WRITTEN CLARIFICATION FROM THE ARCHITECT AND/OR THE OWNER'S REPRESENTATIVE PRIOR TO THE SUBMITTING HIS PROPOSAL FOR WORK.
2. CONTRACTOR WILL ENSURE POSITIVE DRAINAGE OF THE ROOF TO DRAINS AND SCUPPERS WITHOUT PONDING.

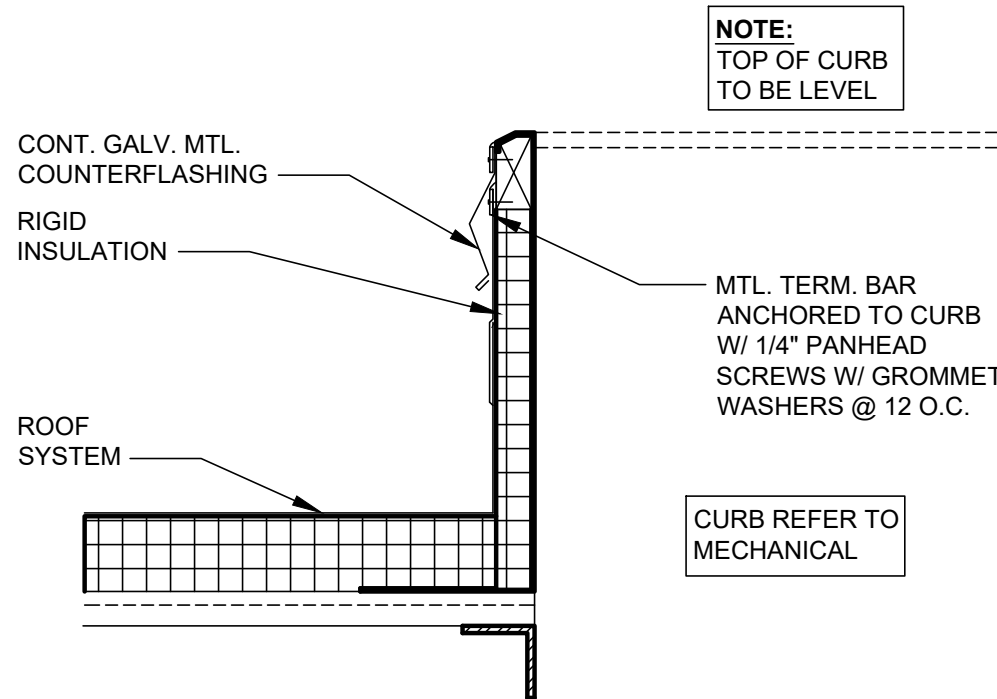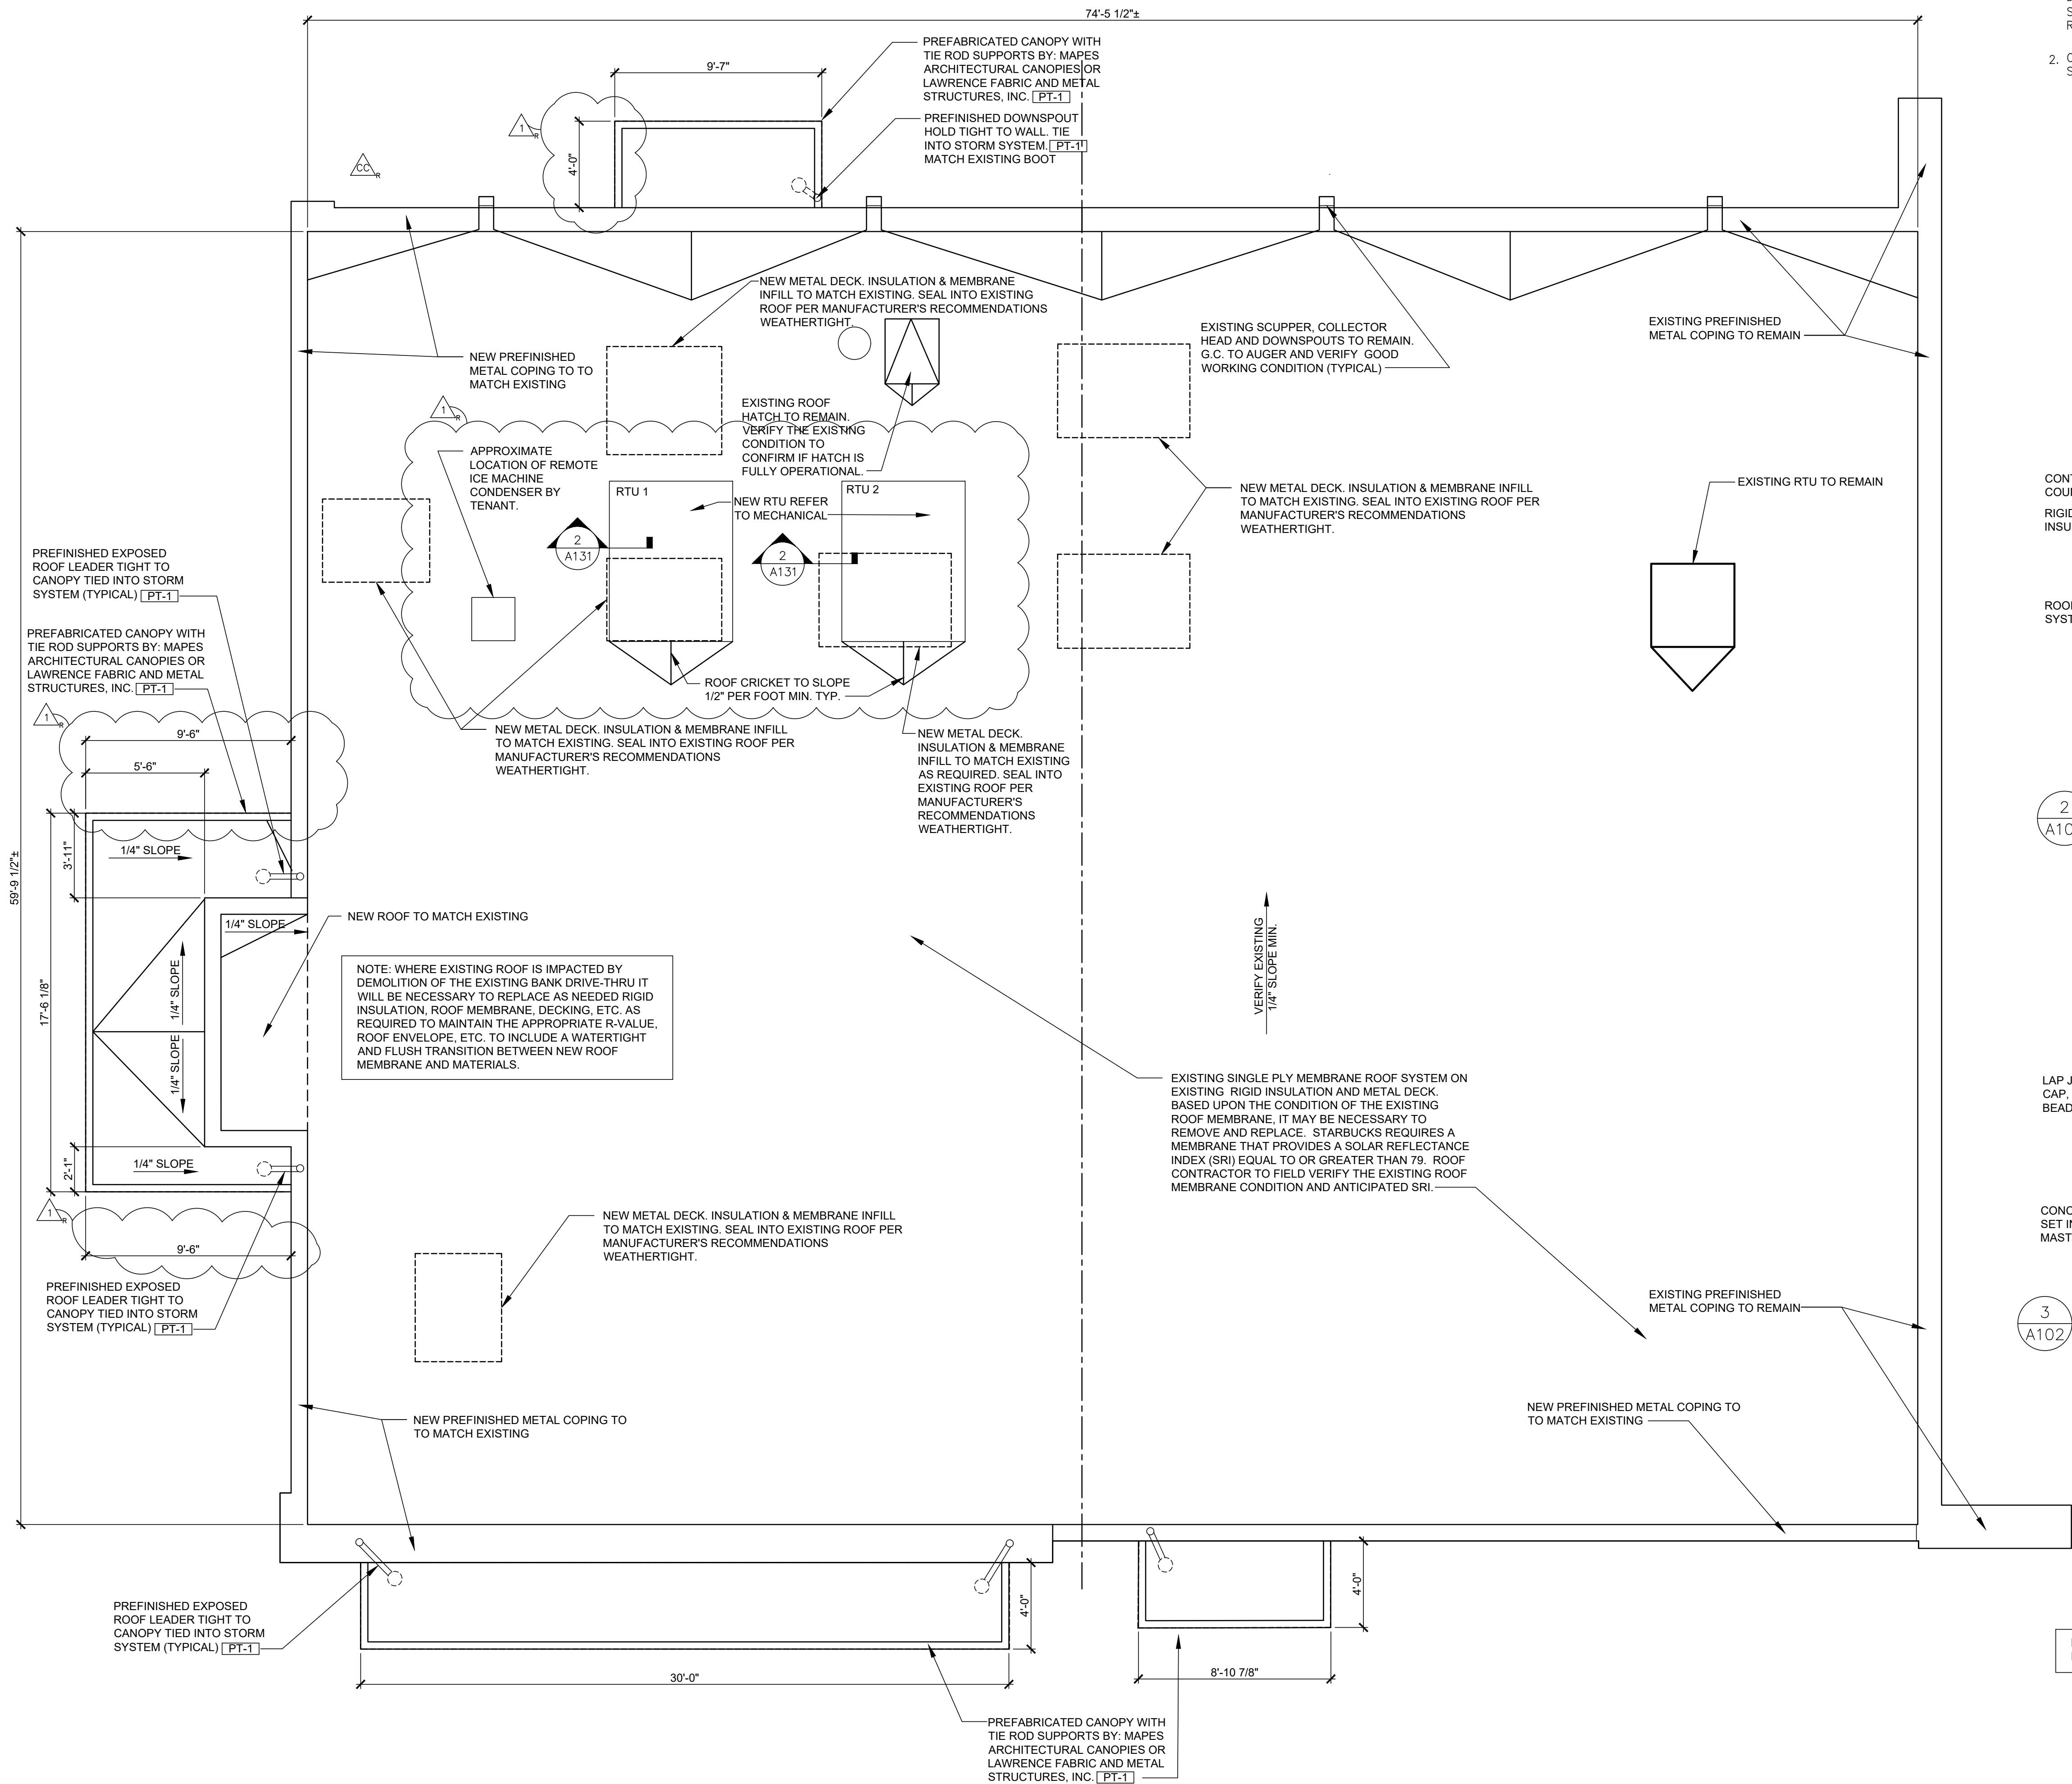

2  
A102

DETAIL @ ROOF CURB

SCALE: 1-1/2" = 1'-0"

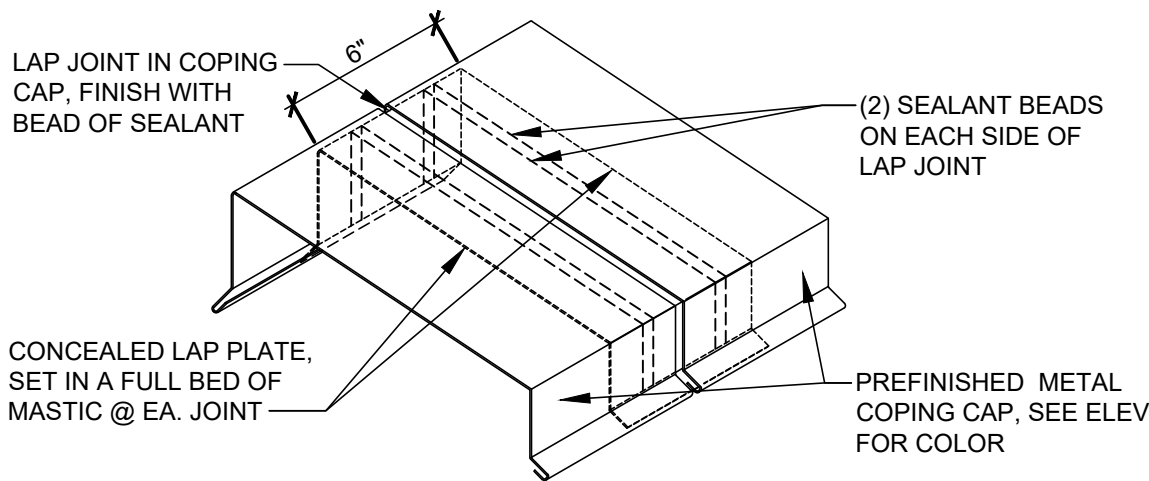

3  
A102

TYPICAL COPING LAP JOINT

SCALE: 1-1/2" = 1'-0"

CONSTR. DOC. & REVISIONS		
No.	Description	Date
-	Owner Review	05/12/20
CC	City Comments	06/30/20
1	OWNER REVISION 3	07/20/20
-	-	-
-	-	-
CASCO DIVERSIFIED CORPORATION  
ARCHITECTURAL  
CERTIFICATE OF AUTHORITY  
#000329 12/31/21




**PROFESSIONAL OF RECORD**  
BULLOCK, KEYMA L.  
License NO. 2004011669  
Expiration Date 12/31/20

Drawn By/Checked By:	RMT/MSD
Project Number	320488
Permit Date	06-17-20

Material Legend			
Precast base: B-1	Manf.	Color: Match Cement fiber finish CF-1	Description: Base
Cement fiber siding: CF-1	Manf. Nichiha	Color: Siding: Composite wall panel Vintagewood - Redwood	Description: Front and (Street) End Wall  Refer To Notes
E.I.F.S.: EIFS-1	Manf. StoCorp	Color: StoTherm Essence - Sto 32121 48 - C2 Standard Medium Finish	Description: Main Field
Paint: PT-1 PT-2	Manf. Sherwin Williams Sherwin Williams	Color: Black Galv. Metal Painted Match Adjacent finish	Description: Canopy Curb and H.M. Door
Metal: PFM-1	Manf. Metal Era	Color: Match Existing	Description: Prefinished For Metal Coping
Storefront: SF-1	Manf. Kawneer	Color: Kawneer #29 Black Anodized	Description: Storefront Framing
Aluminum Soffit system: SF-1	Manf. Armstrong	Color: Armstrong "Metal Works" linear 7160 Color - Flat Black	Description: Canopy soffit panels
Material Notes: Install per manufacturers instruction and recommendations. Use manufacturer certified installer. Provide all trim and accessories as required to provide a complete installation.			

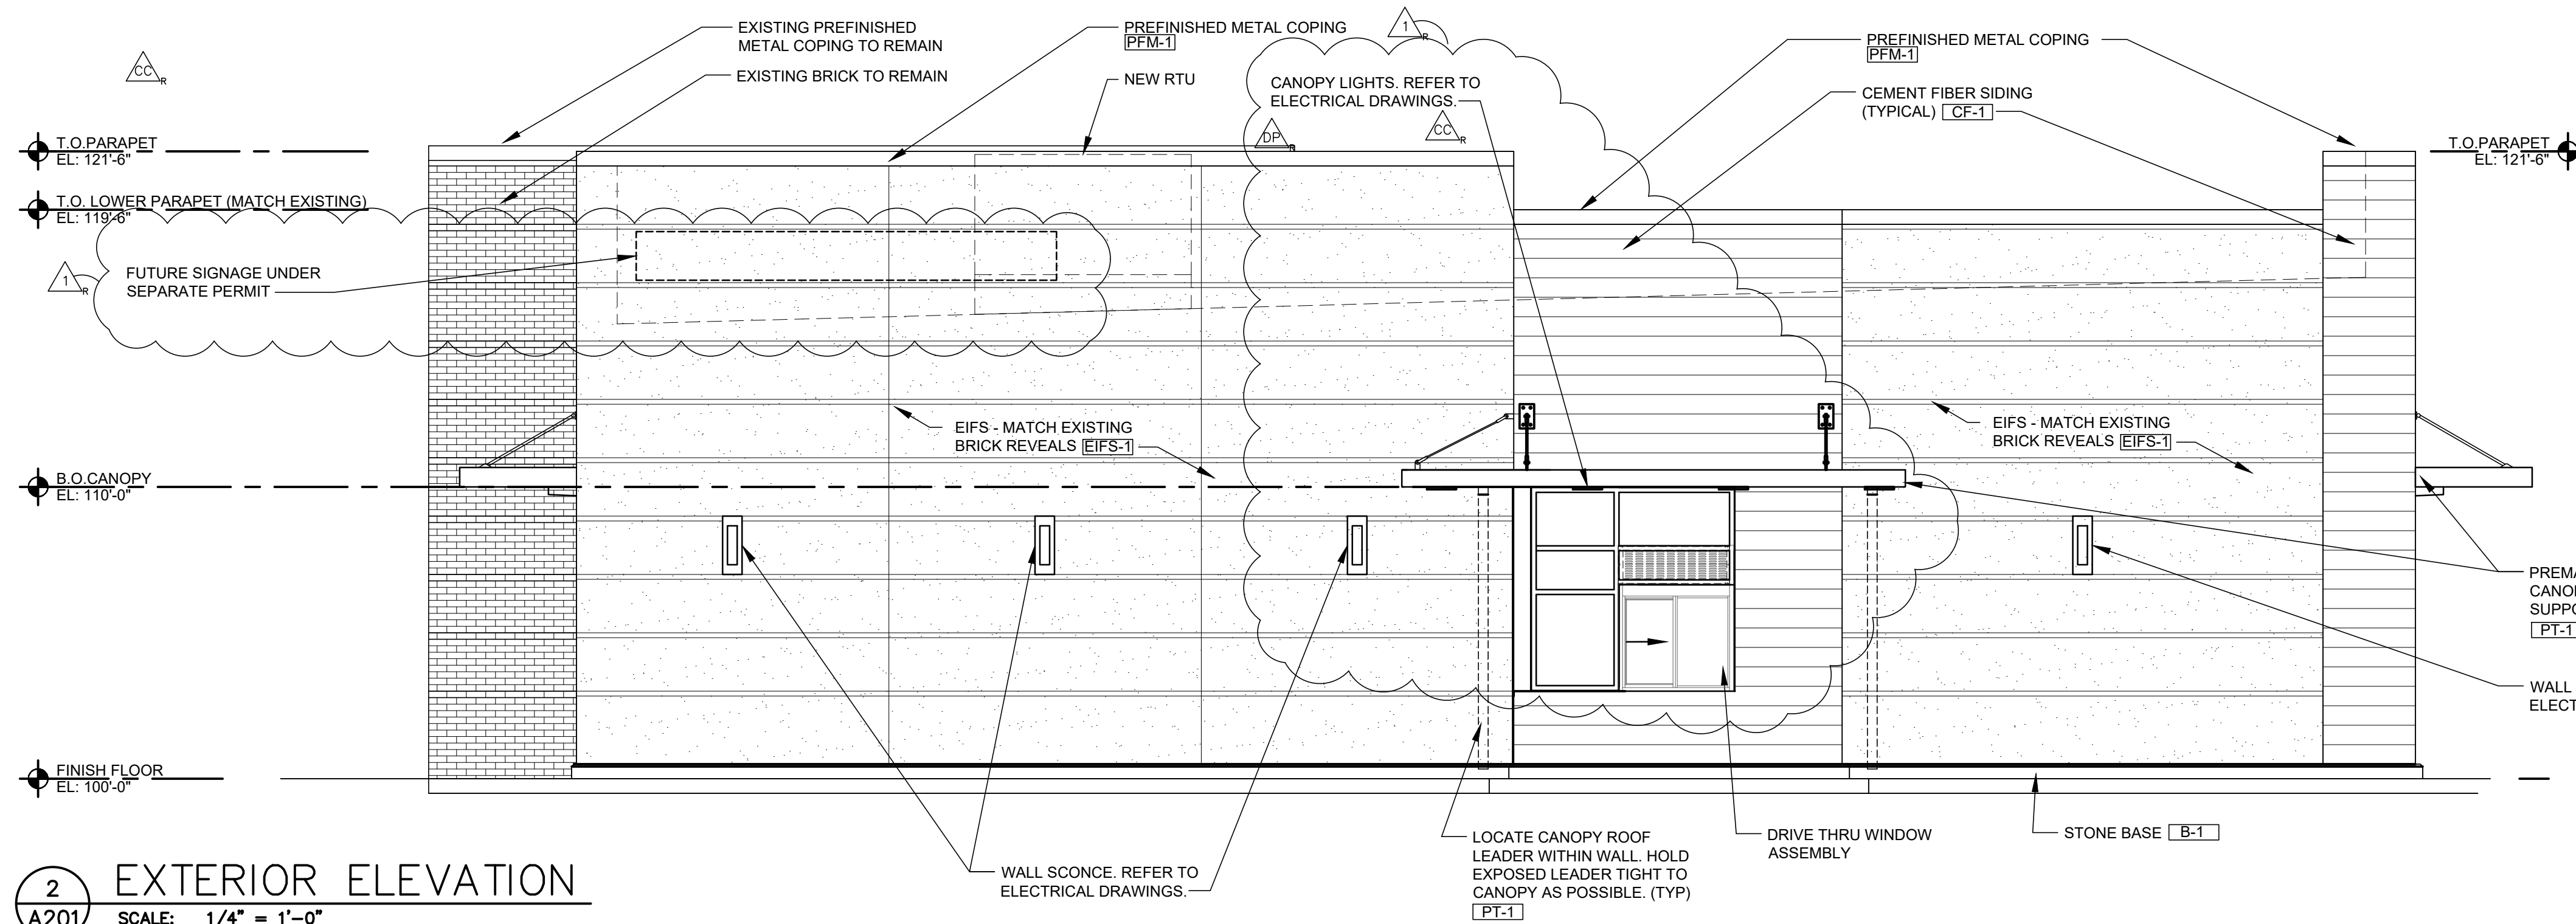

NOTE:  
AT FIBER CEMENT BOARD, APPLY LIQUID  
APPLIED AIR/MOISTURE BARRIER TO  
EXTERIOR SHEATHING BEFORE  
INSTALLATION OF METAL FURRING. APPLY  
LIQUID APPLIED AIR/MOISTURE BARRIER TO  
FURRING BEFORE INSTALLATION OF FIBER  
CEMENT BOARD TRIM, COLOR OF SUBSTRATE  
AND FURRING TO BE "FLAT BLACK".

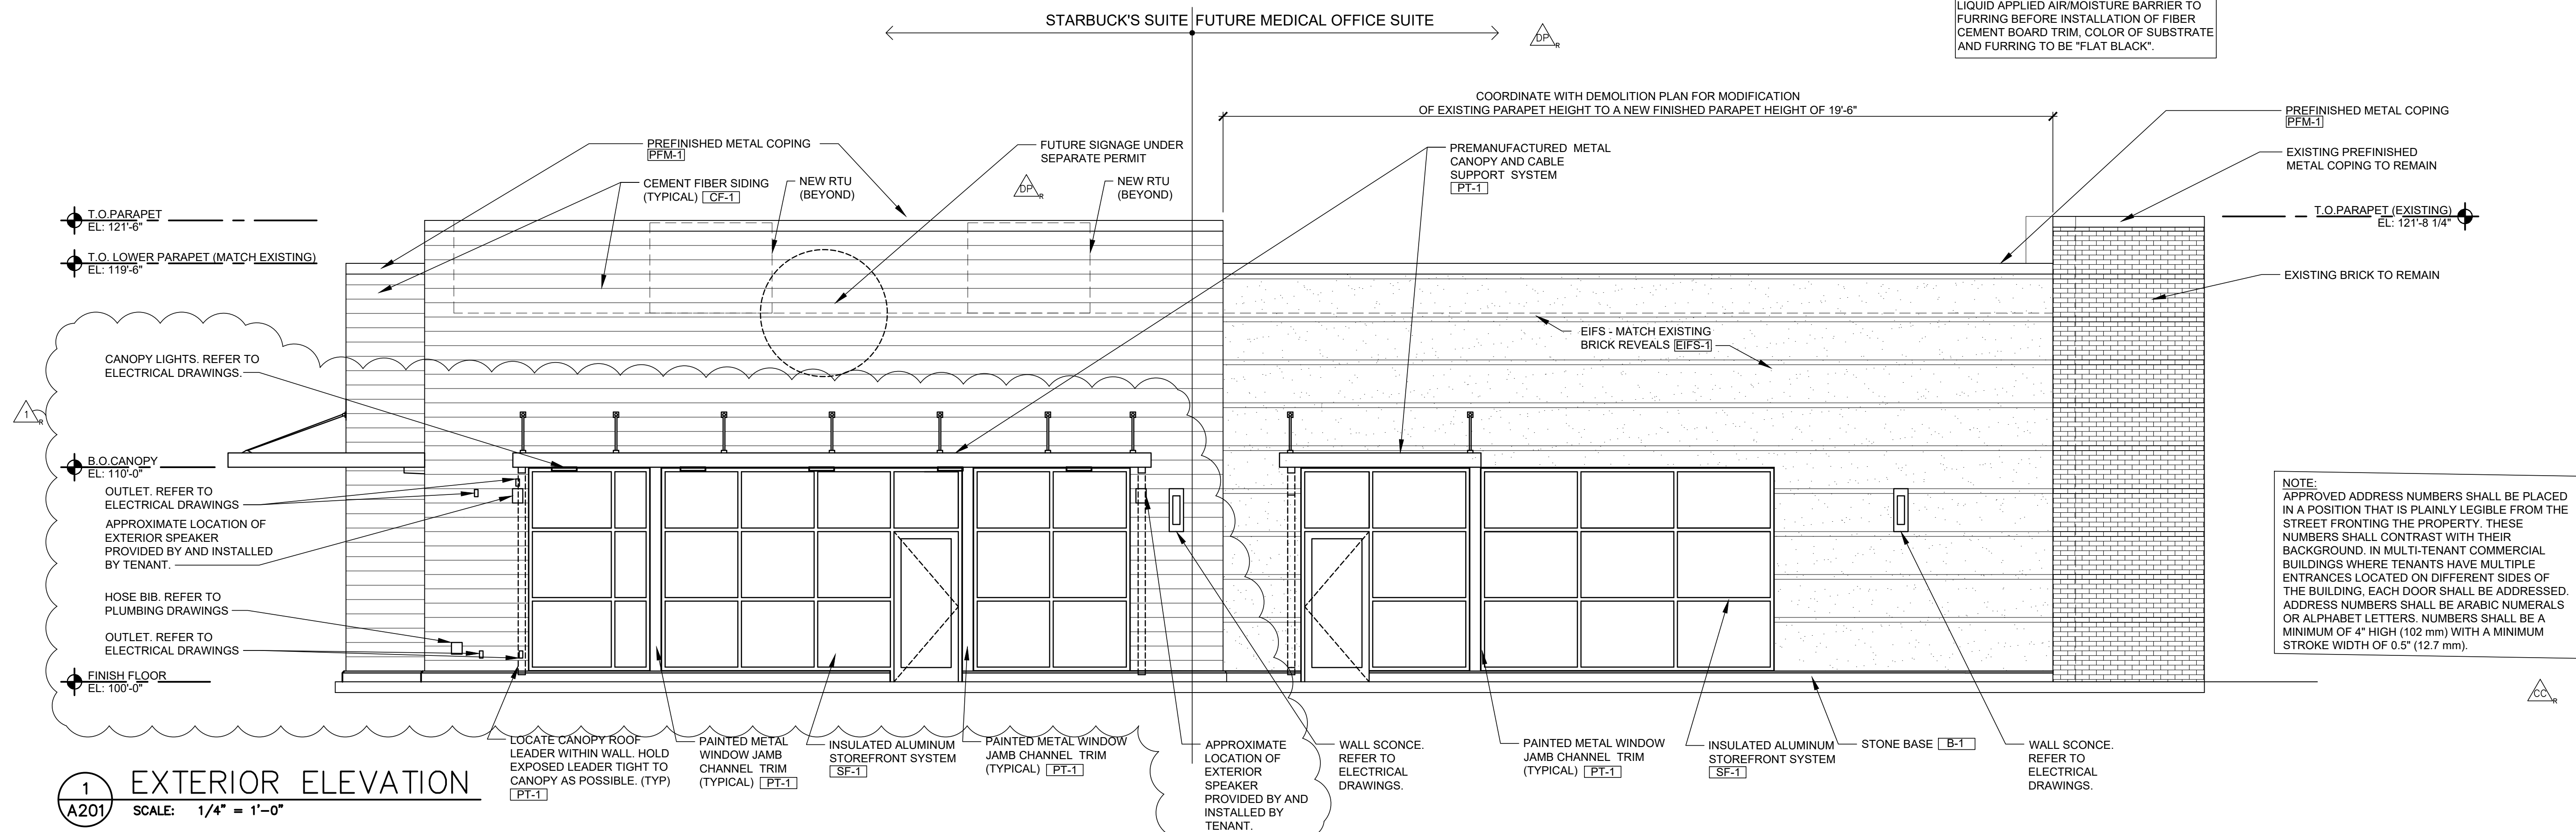


NOTE:  
APPROVED ADDRESS NUMBERS SHALL BE PLACED  
IN A POSITION THAT IS PLAINLY LEGIBLE FROM THE  
STREET FRONTING THE PROPERTY. THESE  
NUMBERS SHALL CONTRAST WITH THEIR  
BACKGROUND. IN MULTI-TENANT COMMERCIAL  
BUILDINGS WHERE TENANTS HAVE MULTIPLE  
ENTRANCES LOCATED ON DIFFERENT SIDES OF  
THE BUILDING, EACH DOOR SHALL BE ADDRESSED.  
ADDRESS NUMBERS SHALL BE ARABIC NUMERALS  
OR ALPHABET LETTERS. NUMBERS SHALL BE A  
MINIMUM OF 4" HIGH (102 mm) WITH A MINIMUM  
STROKE WIDTH OF 0.5" (12.7 mm).

CONSTR. DOC. & REVISIONS

No.	Description	Date
1	OWNER REVIEW	05/12/20
2	FINAL DEVELOPMENT PLAN	05/27/20
3	OWNER REVIEW 2	06/04/20
4	DEVELOPMENT PLAN RESPONSE	06/17/20
5	CC CITY COMMENTS	06/30/20
6	OWNER REVISION 3	07/20/20

CASCO DIVERSIFIED CORPORATION  
ARCHITECTURAL  
CERTIFICATE OF AUTHORITY  
#000329 12/31/21

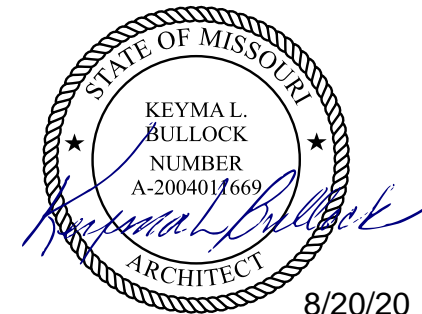

PROFESSIONAL OF RECORD  
BULLOCK KEYMAL  
License NO. 200401669  
Expiration Date 12/31/20


Drawn By/Checked By: RMT/MSD  
Project Number 320488

Permit Date 06-17-20

EXTERIOR  
ELEVATIONS


A201

Material Legend			
Precast base: B-1	Manf. 	Color: Match Cement fiber finish CF-1	Description: Base
Cement fiber siding: CF-1	Manf. Nichiha	Color: Siding: Composite wall panel Vintagewood - Redwood	Description: Front and (Street) End Wall  Refer To Notes
E.I.F.S.: EIFS-1	Manf. StoCorp	Color: StoTherm Essence - Sto 32121 48 - C2 Standard Medium Finish	Description: Main Field
Paint: PT-1 PT-2	Manf. Sherwin Williams Williams	Color: Black Galv. Metal Painted Match Adjacent finish	Description: Canopy Curb and H.M. Door
Metal: PFM-1	Manf. Metal Era	Color: Match Existing	Description: Prefinished For Metal Coping
Storefront: SF-1	Manf. Kawneer	Color: Kawneer #29 Black Anodized	Description: Storefront Framing
Aluminum Soffit system: SF-1	Manf. Armstrong	Color: Armstrong "Metal Works" linear 7160 Color - Flat Black	Description: Canopy soffit panels
Material Notes:  Install per manufacturers instruction and recommendations. Use manufacturer certified installer. Provide all trim and accessories as required to provide a complete installation.			

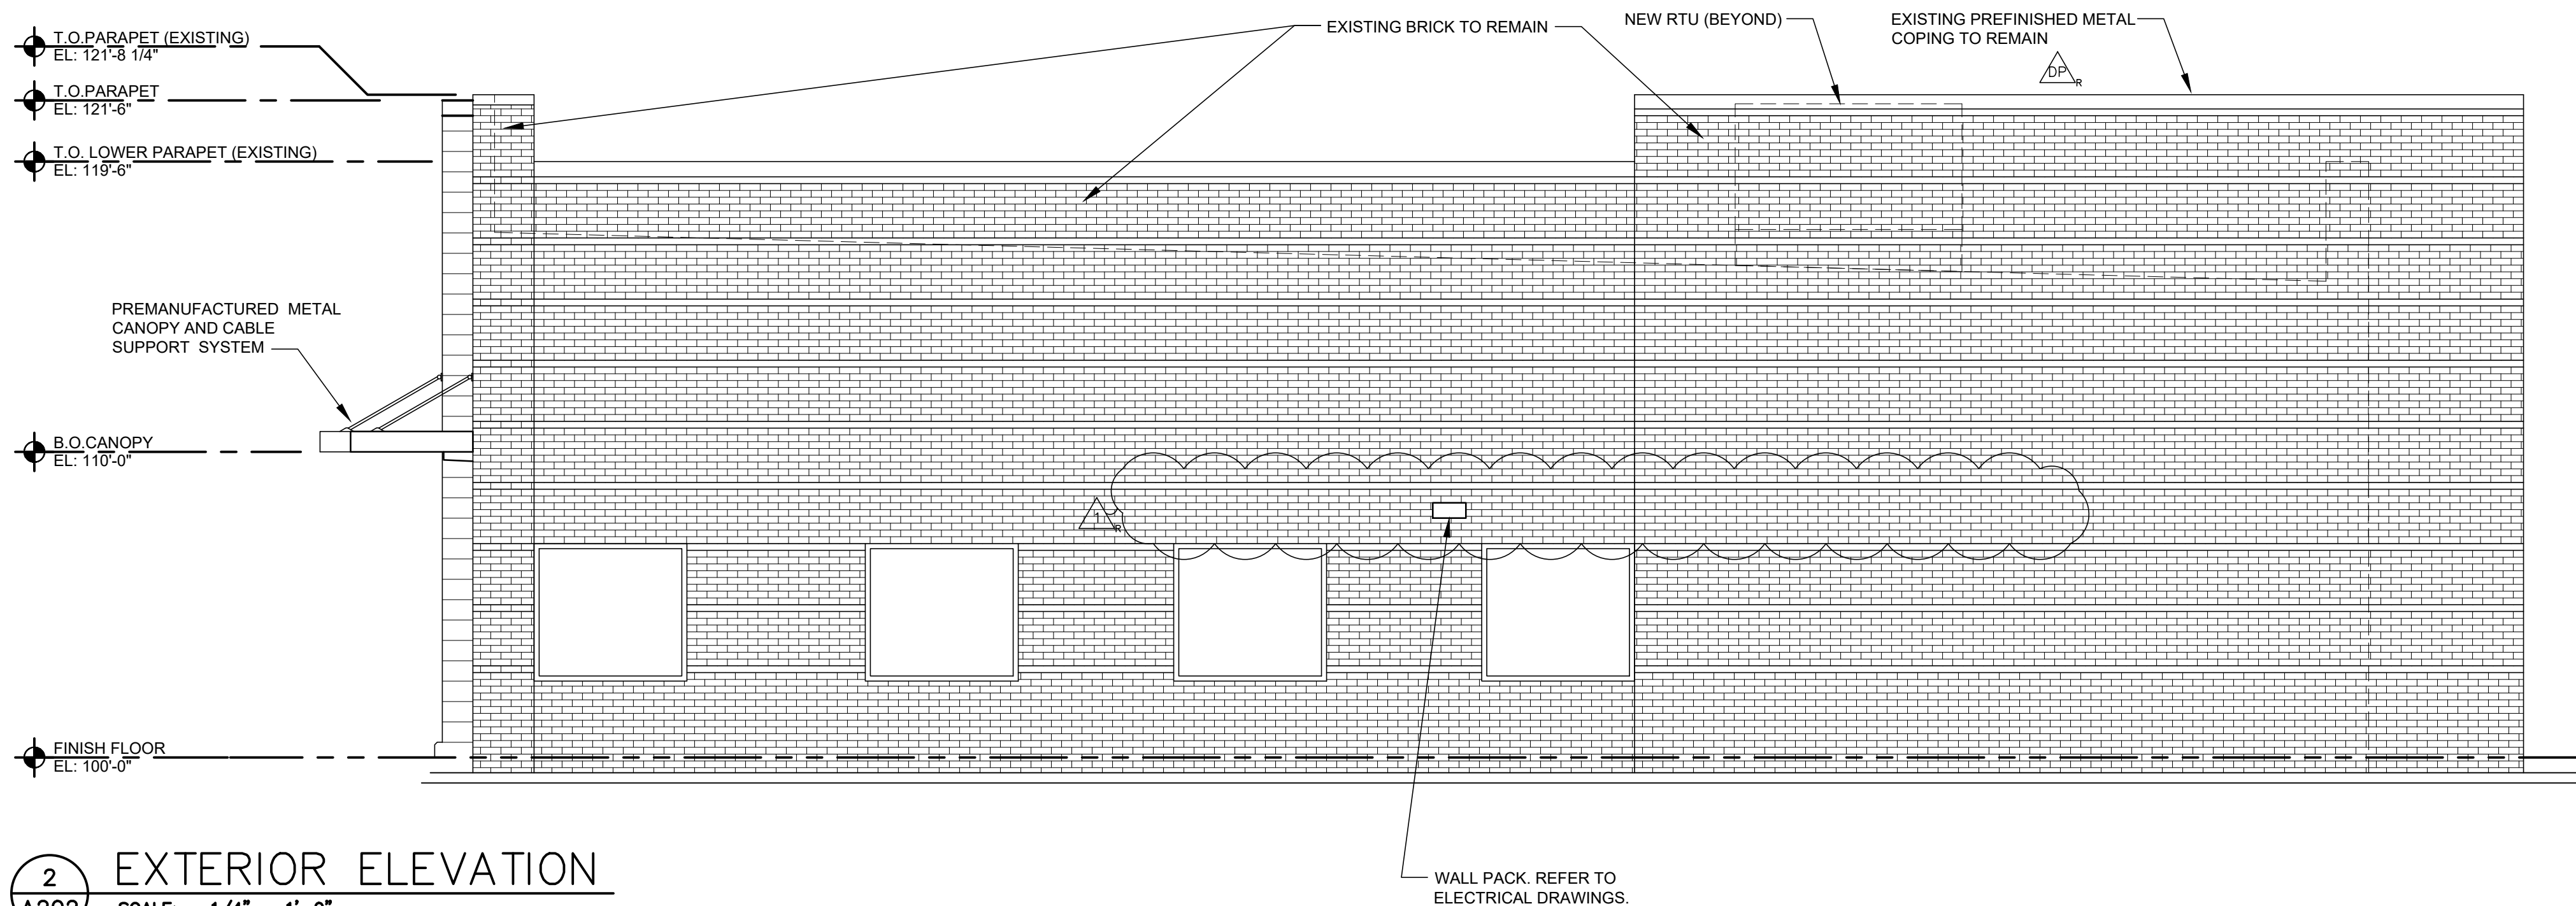

NOTE:  
AT FIBER CEMENT BOARD, APPLY LIQUID  
APPLIED AIR/MOISTURE BARRIER TO  
EXTERIOR SHEATHING BEFORE  
INSTALLATION OF METAL FURRING. APPLY  
LIQUID APPLIED AIR/MOISTURE BARRIER TO  
FURRING BEFORE INSTALLATION OF FIBER  
CEMENT BOARD TRIM. COLOR OF SUBSTRATE  
AND FURRING TO BE "FLAT BLACK".

2  
A202  
EXTERIOR ELEVATION  
SCALE: 1/4" = 1'-0"

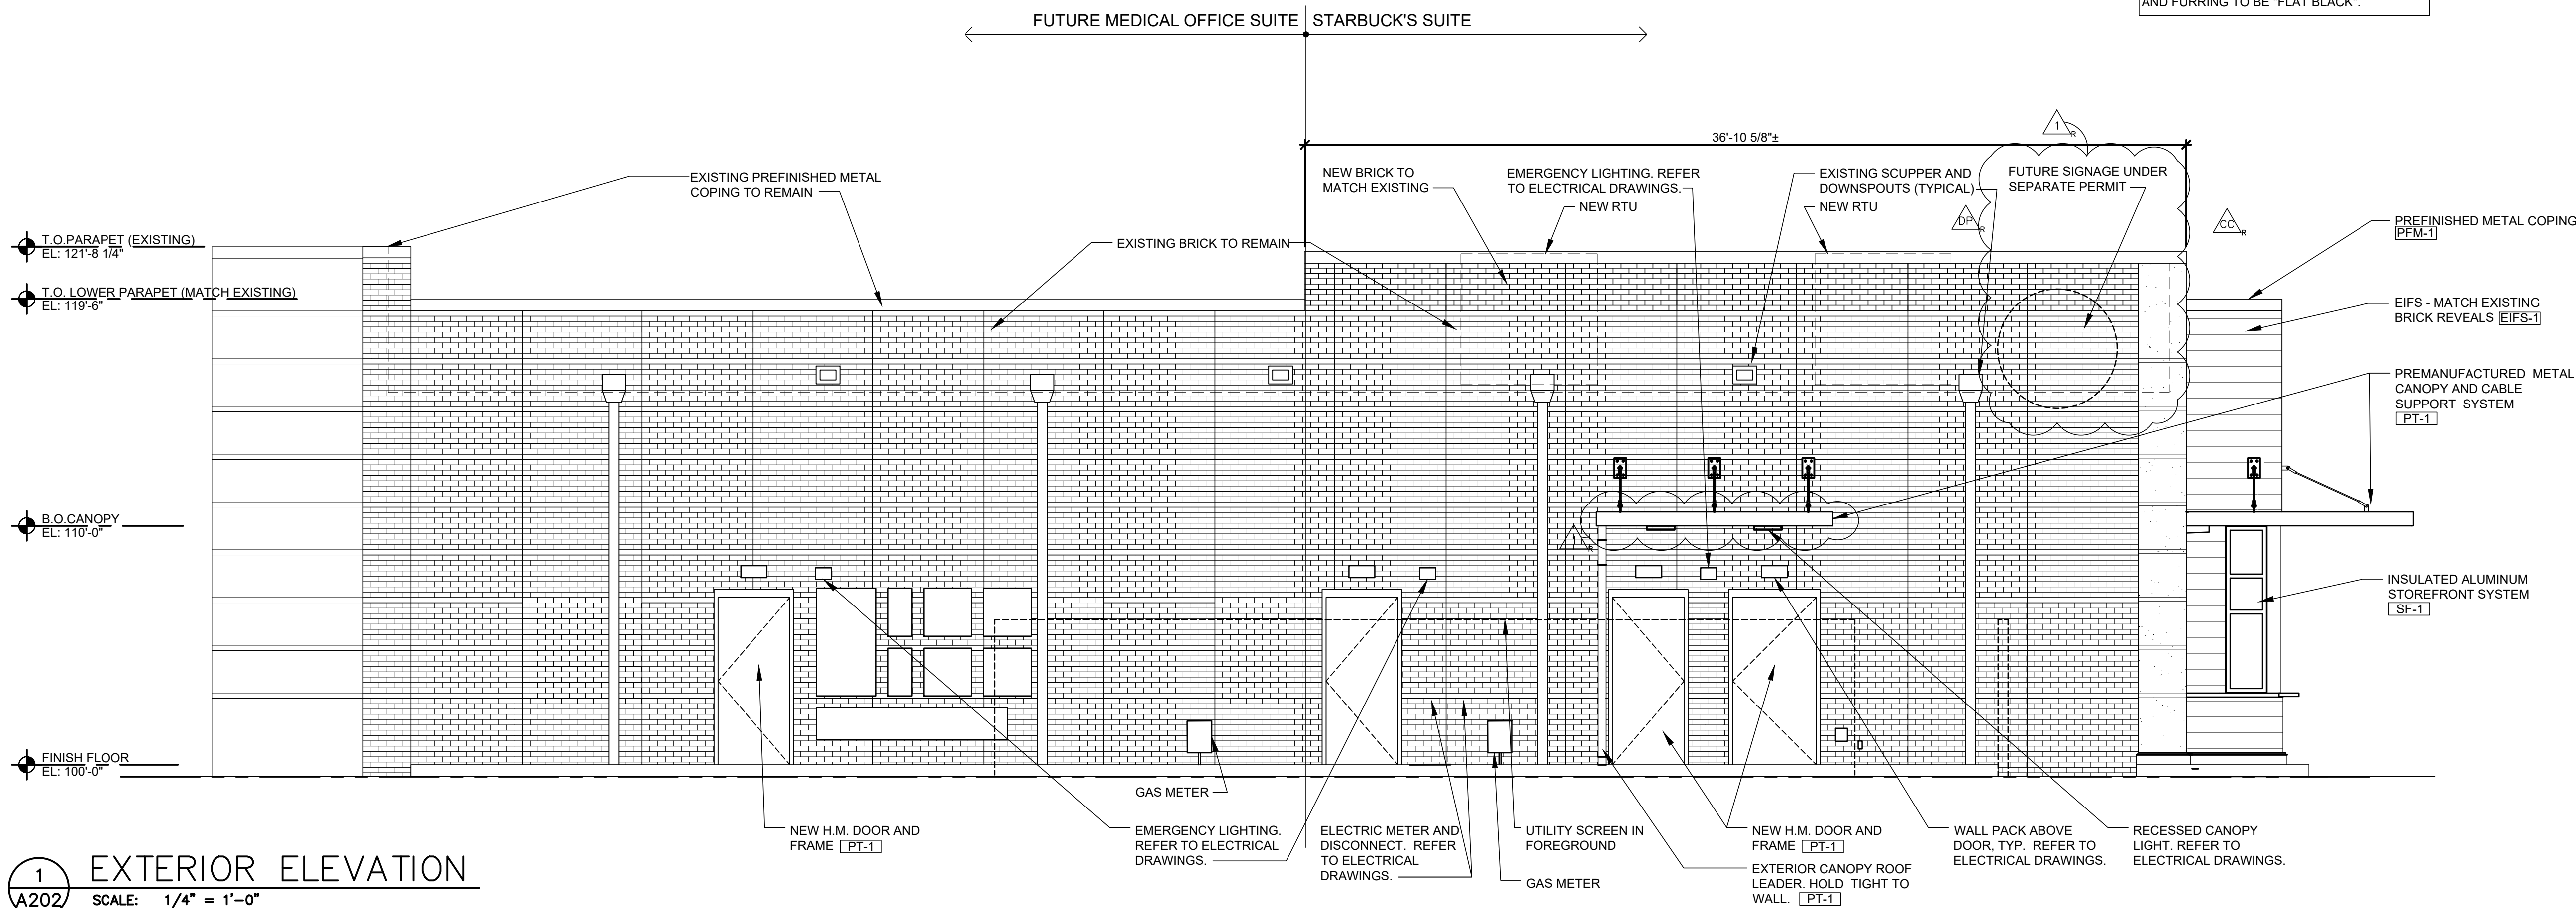


1  
A202  
EXTERIOR ELEVATION  
SCALE: 1/4" = 1'-0"

CONSTR. DOC. & REVISIONS

No.	Description	Date
1	Owner Review	05/12/20
2	Final Development Plan	05/17/20
3	Owner Review 2	06/04/20
4	DEVELOPMENT PLAN RESPONSE	06/11/20
5	City Comments	06/30/20
6	OWNER REVISION 3	07/20/20

CASCO DIVERSIFIED CORPORATION  
ARCHITECTURAL  
CERTIFICATE OF AUTHORITY  
#000329 12/31/21

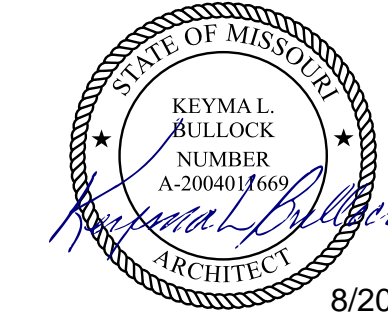

PROFESSIONAL OF RECORD  
BULLOCK, KEYMA L.  
License NO. 2004011669  
Expiration Date 12/31/20

Drawn By/Checked By: RMT/MSD  
Project Number 320488

Permit Date 06-17-20

EXTERIOR  
ELEVATIONS

A202



1  
A504.B




2  
A504.E



3  
A504.F


4  
A504.

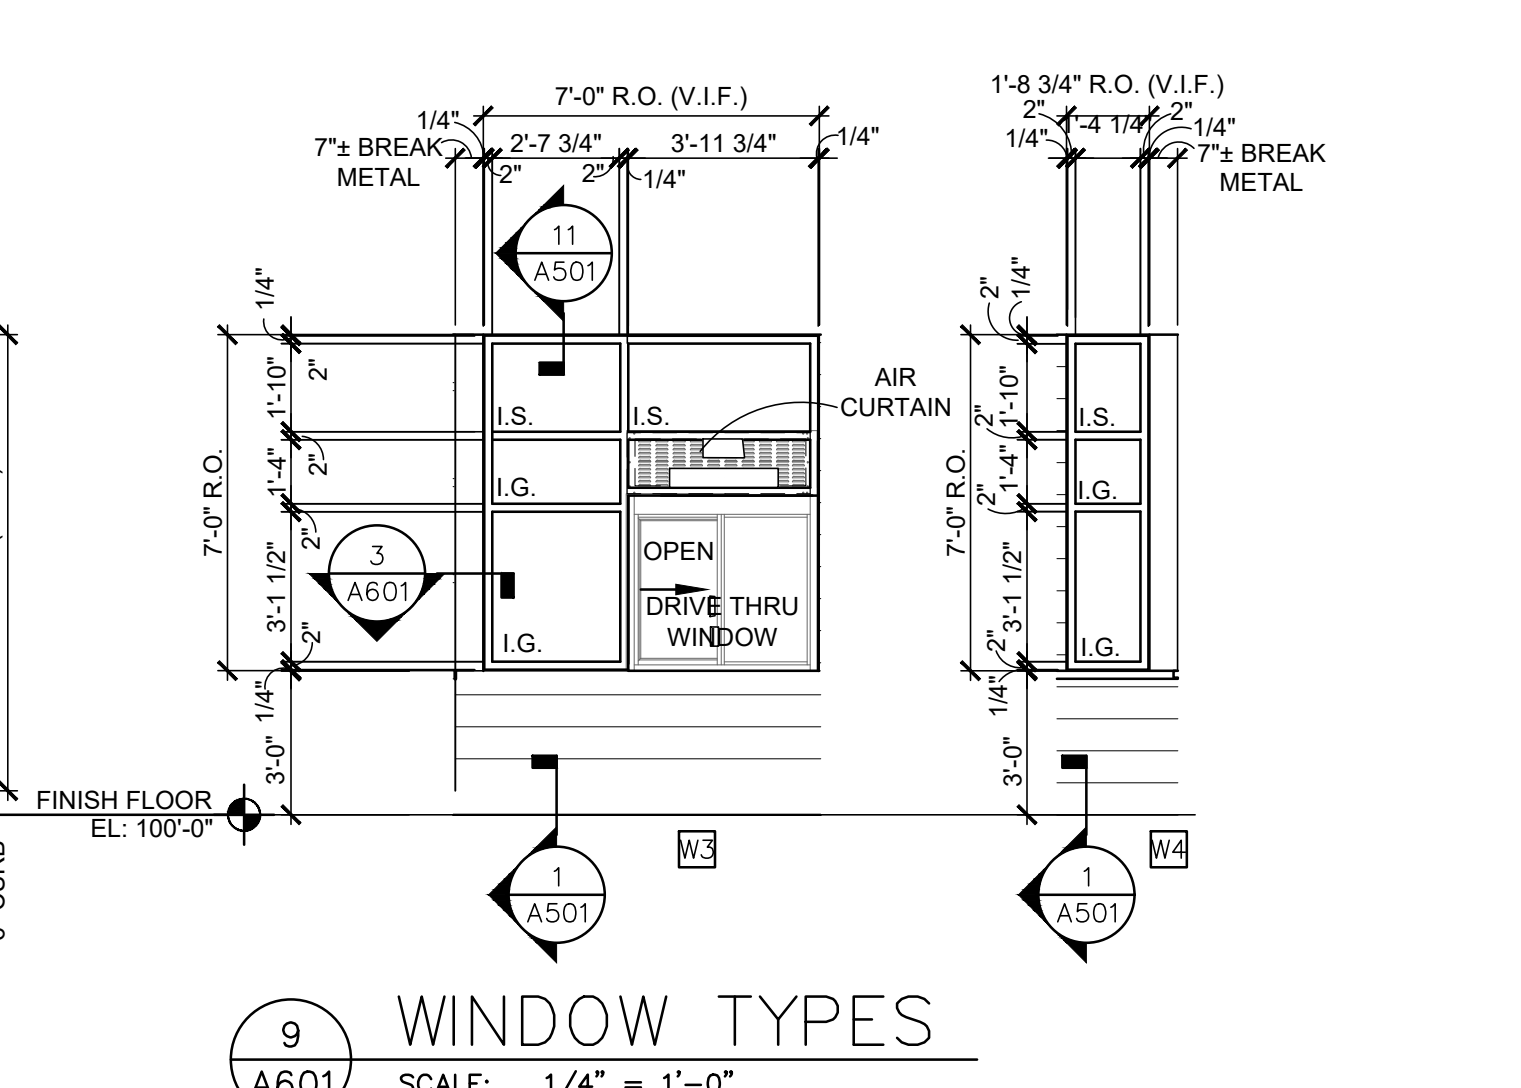

NO.	ITEM	DESCRIPTION	MANUFACTURER
3	HANGING DEVICES	TH2314/MPB91 HINGE MACPRO BEARING 4.5 x 4.5	McKINNEY
1	SECURING DEVICES	1/2" x 7-1/2" CORE COGNATE "A" KEYWAY	FALCON LOCK
1	SECURING DEVICES	I/O 200L-031C AUTO LOCKING DOOR ALARM, IC;	SUR-LOCK
		NO CTRL INCLUDES MORTISE CYLINDER -	
		PANIC HARDWARE	
1	CLOSING DEVICES	89116 DOOR CLOSER 8916 AF39	DORMA
1	PROTECTIVE TRIM UNITS	K1050 B4E KICKPLATE 8 x 34	ROCKWOOD
1	ACCESSORIES	1379A WEATHER STRIP 17" 36" X 84"	NATIONAL GUARD
1	ACCESSORIES	1000 DOOR SWEEP 1000 1536	PIRMO
1	MISCELLANEOUS ITEMS	DS1000 DOOR SCOP	SECURITY PRODUCTS

## LANDLORD UTILITY AND FUTURE MEDICAL OFFICE SHELL DOOR SCHEDULE




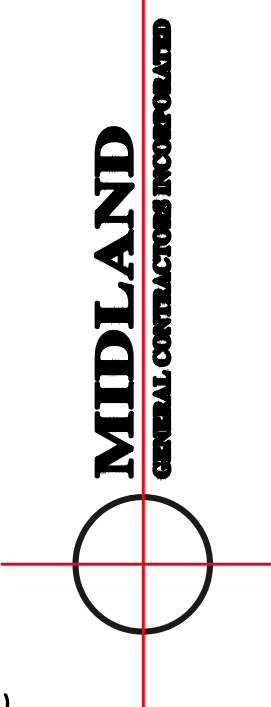

Starbucks & Medical Office  
155 S.W. MO-150 HWY  
LEE'S SUMMIT, MO 64802

CONSTR. DOC. & REVISIONS		
No.	Description	Date
1	Owner Review	05/12/20
2	Revision 1	07/09/20
3	Revision 3	07/20/20

CASCO DIVERSIFIED CORPORATION  
ENGINEERING  
CERTIFICATE OF AUTHORITY  
#000613 12/31/20

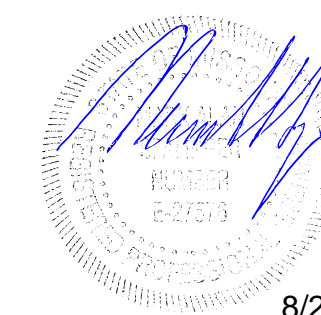


MARK A. SPALINGER  
License Number: E-275376  
Expiration Date: 12/31/21


Drawn By/Checked By: BWT/NDM  
Project Number 320488

Permit Date 06-17-20

## FOUNDATION PLAN

# S101

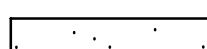
- FOUNDATION NOTES:**
- FOR GENERAL NOTES SEE DRAWING S001.
  - FOR FOUNDATION DETAILS SEE SHEET S301.
  - REFERENCE SLAB ELEVATION SHALL BE ELEVATION 0'-0".
  - COORDINATE EXTENT OF SLAB INFILL WITH SHEET D101.
  -  NEW 5" SLAB. SEE FOUNDATION NOTE SHEET S001.

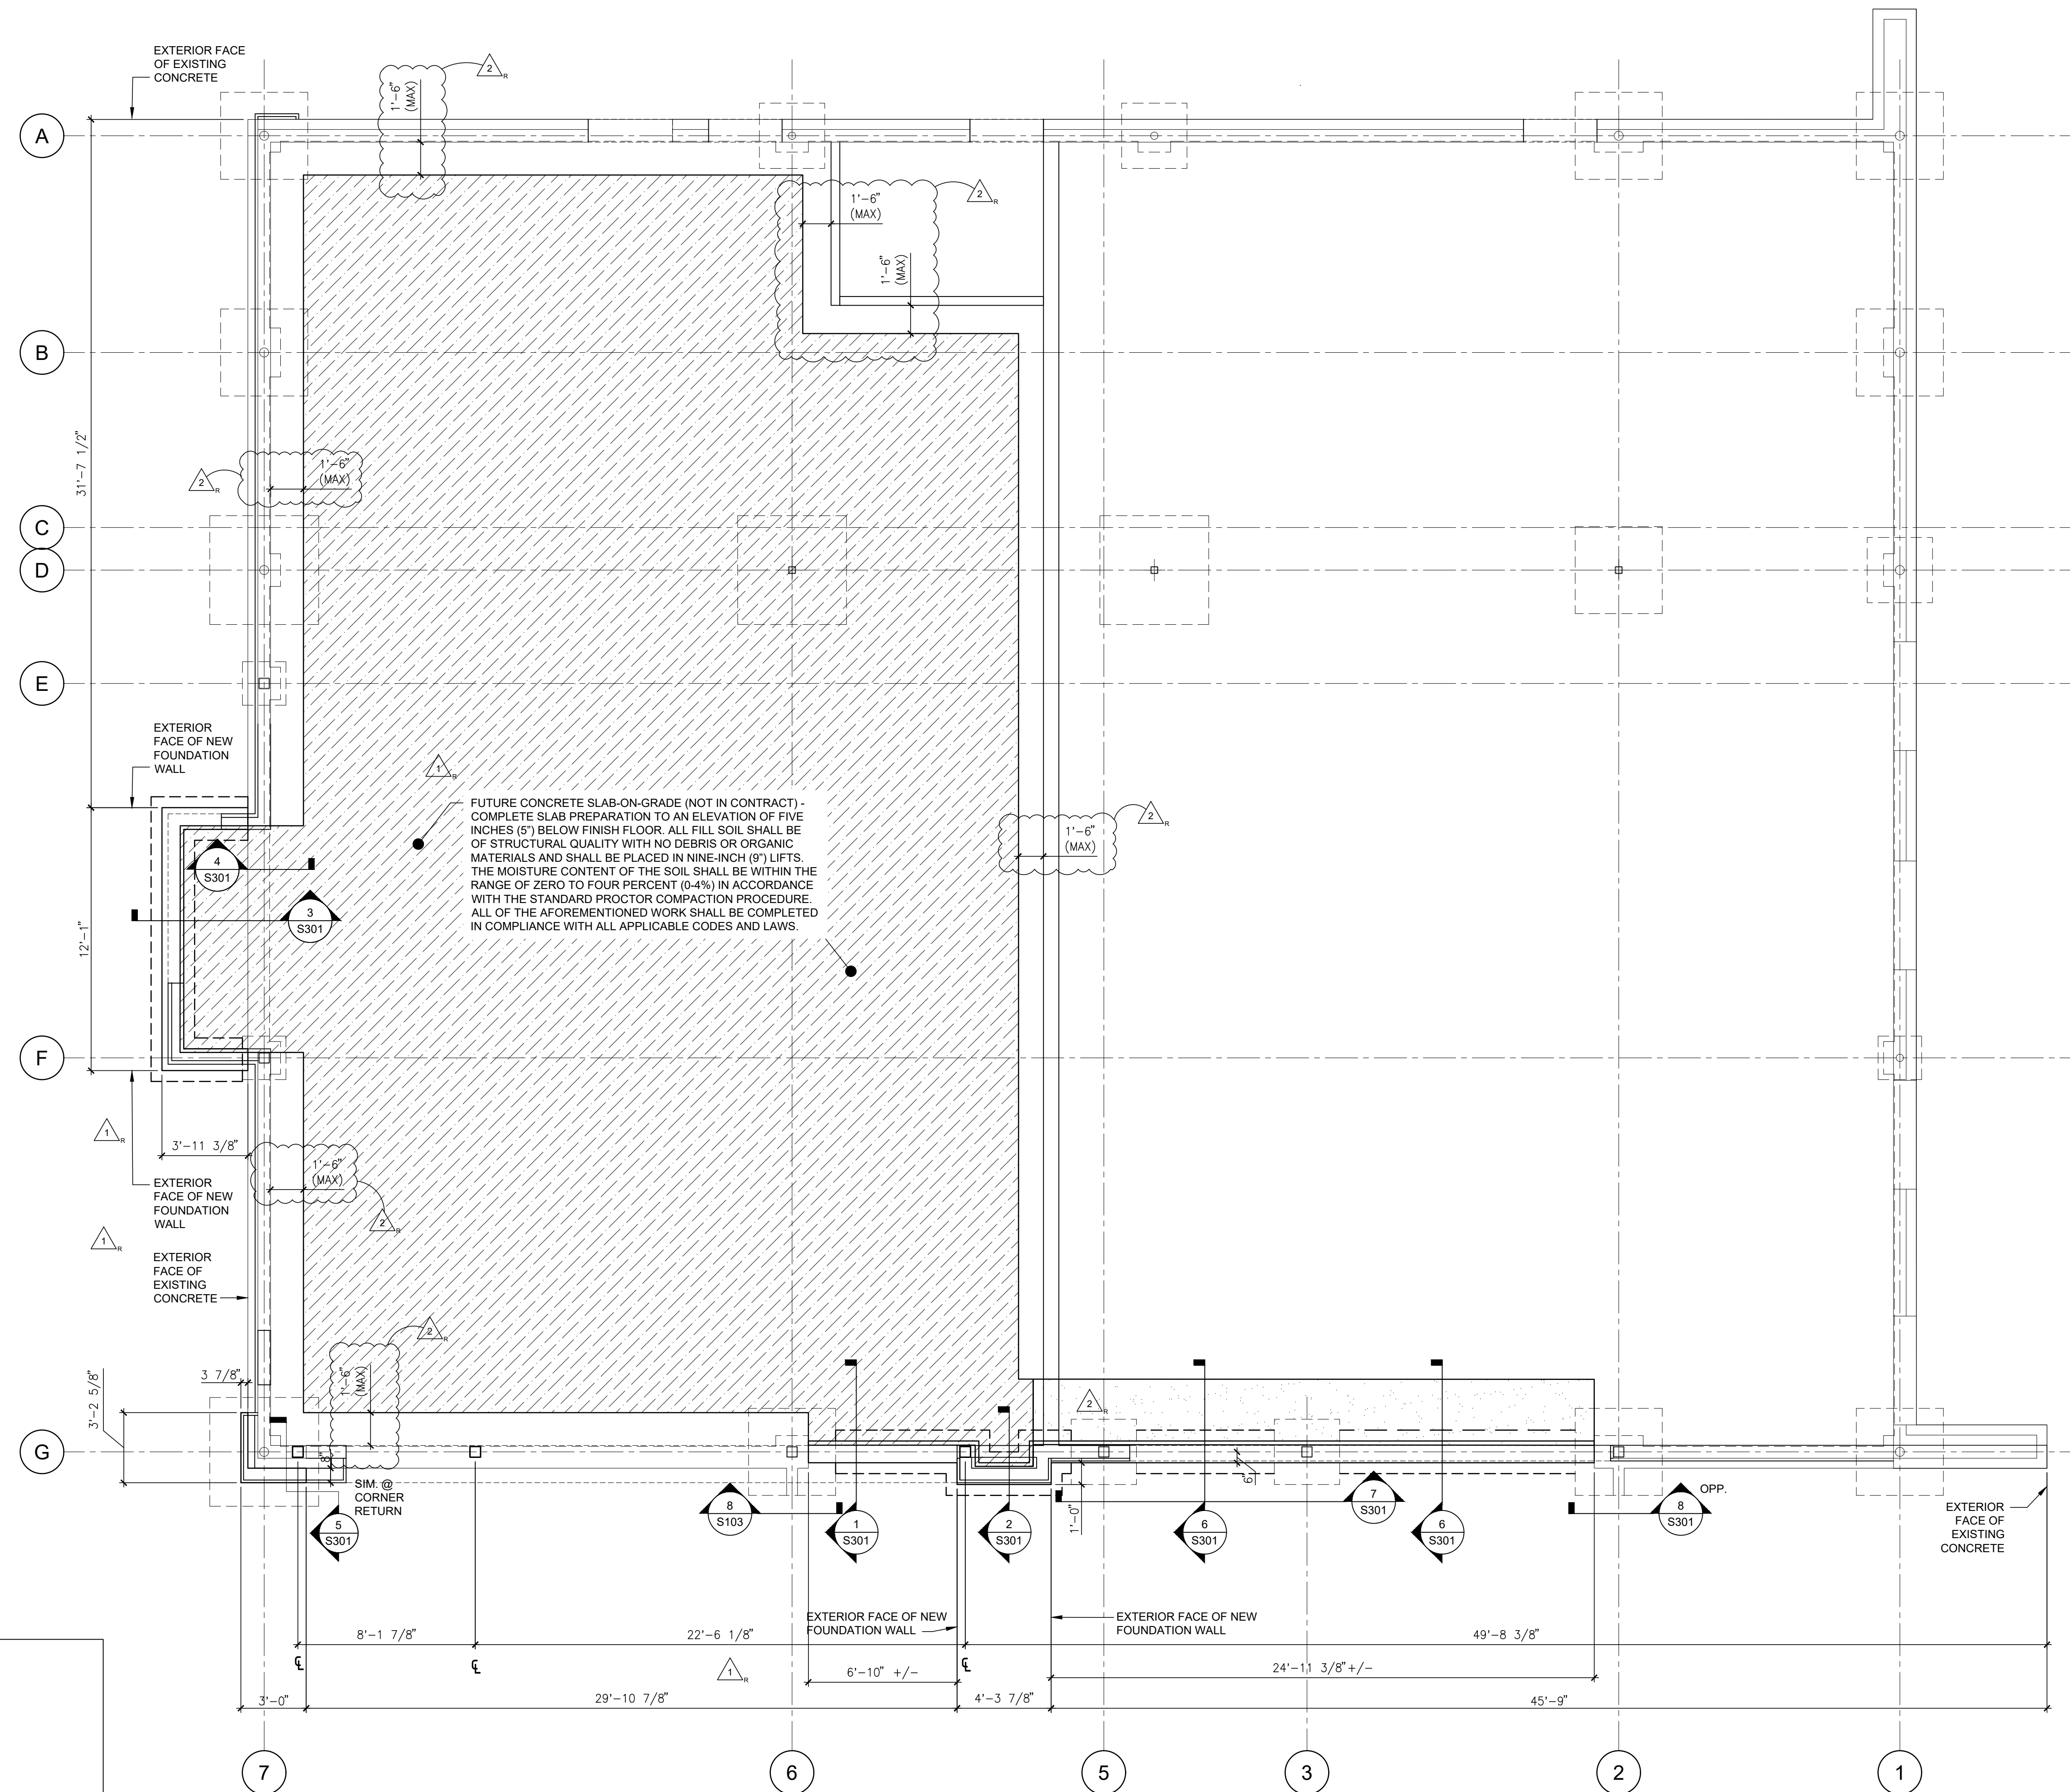

1  
S101

## FOUNDATION PLAN

SCALE: 1/4" = 1'-0"

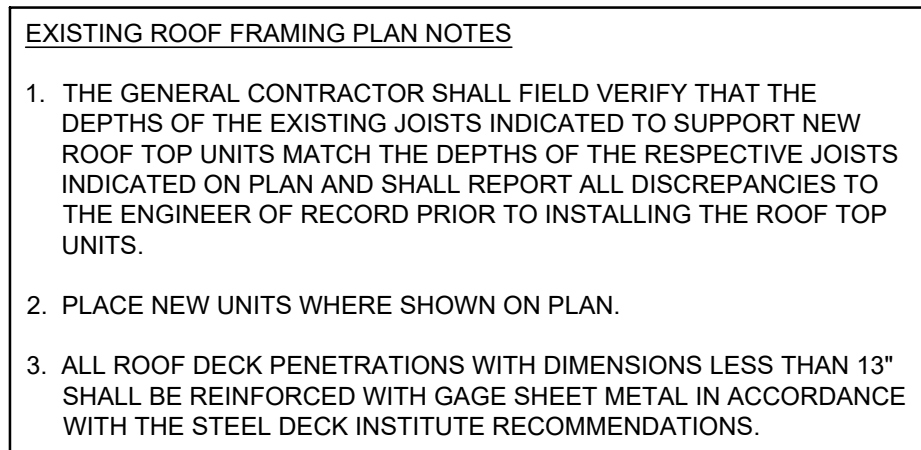

1  
S201

SCALE: 1/4" = 1'-0'

No.	Description	Date
1	Owner Review	05/12/20
2	Clarifications	07/09/20
3	Owner Review	07/20/20
5	Clarifications	08/06/20

CASCO DIVERSIFIED CORPORATION  
PROFESSIONAL ENGINEERING  
CERTIFICATE OF AUTHORITY #000613  
EXP. 12/31/21



PROFESSIONAL OF RECORD  
MICHAEL C. GRAPPERHAUS  
License NO.: PE-2008019543  
Expiration Date: 12/31/20

Drawn By/Checked By: BAM/MCG

Project Number 320488

Permit Date 06-17-20

MECHANICAL  
PLAN AND  
SPECIFICATIONS

M101

## SPECIFICATIONS

### GENERAL MECHANICAL CONDITIONS

TENANT SHALL FURNISH SELECTED MECHANICAL EQUIPMENT, ACCESSORIES AND CONTROLS AS SCHEDULED AND AS SPECIFIED. THE MECHANICAL SUBCONTRACTOR(S) SHALL BE RESPONSIBLE FOR DELIVERY COORDINATION, RECEIVING, STORING, SETTING, STARTUP AND INSTALLING ALL TENANT FURNISHED EQUIPMENT AS WELL AS THE ONE YEAR PARTS AND LABOR WARRANTY FROM THE DATE OF STORE OPENING.

#### A. SCOPE

- PROVIDE ALL LABOR, MATERIALS AND EQUIPMENT NECESSARY TO PROPERLY INSTALL AIR CONDITIONING SYSTEMS WHERE SHOWN ON DRAWINGS AND AS SCHEDULED.
- PROVIDE EQUIPMENT AS SPECIFIED TOGETHER WITH ALL NECESSARY DUCTS, GRILLES, REGISTERS, CONTROLS, PIPING, LOW VOLTAGE FANS, CONTROL WIRING, HANGERS, STANDS, EQUIPMENT SUPPORTS, FLASHING AT EQUIPMENT, DUCT AND PIPE INSULATION, UNLESS OTHERWISE NOTED.
- RELATED WORK BY OTHERS:

- PAINTING EXCEPT AS HEREIN SPECIFIED.
- LINE VOLTAGE WIRING AND CONDUIT.
- ELECTRICAL SUPPLY CONNECTION TO EQUIPMENT.

- B. ALL WORK SHALL CONFORM TO ALL FEDERAL, STATE AND LOCAL CODES AND ANY LANDLORD REQUIREMENTS AS SPECIFIED IN THE EXECUTED LEASE AGREEMENT. CONTRACTOR SHALL VERIFY AND COORDINATE SCOPE OF WORK WITH TENANT AND LANDLORD.

- C. THE CONTRACTOR SHALL EXAMINE THE PREMISES AND VERIFY THE EXISTING CONDITIONS UNDER WHICH HE WILL BE OBLIGATED TO OPERATE IN PERFORMING HIS PART OF THE WORK OR THAT WILL IN ANY MANNER AFFECT THE WORK UNDER CONTRACT. NO ADDITIONAL COMPENSATION SHALL BE PROVIDED FOR CONDITIONS FOUND DURING THE EXECUTION OF CONTRACTED WORK. THE CONTRACTOR SHALL COOPERATE WITH ALL OTHER TRADES SO THAT THE INSTALLATION OF ALL EQUIPMENT MAY BE PROPERLY COORDINATED. CONTRACTOR SHALL BRING TO THE ATTENTION OF THE CONSTRUCTION MANAGER ANY DISCREPANCIES BETWEEN FIELD CONDITIONS AND DESIGN DOCUMENTS.

- D. ALL EQUIPMENT FURNISHED SHALL FIT THE SPACE AVAILABLE, WITH CONNECTIONS, ETC., IN THE REQUIRED LOCATIONS AND WITH ADEQUATE SPACE FOR OPERATING AND SERVICING. SHOULD A CONFLICT EXIST BETWEEN THE DRAWINGS AND THE SPECIFICATIONS, THE CONTRACTOR SHALL PROMPTLY NOTIFY THE CONSTRUCTION MANAGER WHOSE DECISION SHALL BE FINAL. NO ALLOWANCE WILL BE MADE, SUBSEQUENTLY, IN THIS CONNECTION ON BEHALF OF THE CONTRACTOR AFTER AWARD OF THE CONTRACT.

- E. ALL MECHANICAL EQUIPMENT SHALL CONFORM WITH THE REQUIREMENTS OF THE STATE MECHANICAL CODE, THE STATE BUILDING CODE, THE STATE ENERGY CODE, NFPA 90A, 96.101 AND ALL APPLICABLE LOCAL CODES AND ORDINANCES.

- F. DRAWINGS FOR MECHANICAL WORK ARE DIAGRAMMATIC SHOWING THE GENERAL LOCATION, TYPE, LAYOUT AND EQUIPMENT REQUIRED. THE DRAWINGS SHALL NOT BE SCALED FOR EXACT MEASUREMENTS. REFER TO MANUFACTURER'S STANDARD INSTALLATION DRAWINGS FOR EQUIPMENT CONNECTIONS AND INSTALLATION REQUIREMENTS AS REQUIRED. FURNISH AND INSTALL DUCTWORK, CONNECTIONS, ACCESSORIES, OFFSETS AND MATERIALS NECESSARY TO FACILITATE THE SYSTEMS FUNCTIONING AS INDICATED BY THE DESIGN AND THE EQUIPMENT INDICATED. CONTRACTOR SHALL OBTAIN ALL NECESSARY PERMITS AND PAY ANY ASSOCIATED FEES.

- G. THE CONTRACTOR SHALL INSTALL ALL PIPING, DUCTWORK, FIXTURES AND EQUIPMENT AS REQUIRED TO CONFORM THE STRUCTURE, AVOID OBSTRUCTIONS, PRESERVE CEILING HEIGHTS AND HEADROOM AND MAKE ALL EQUIPMENT REQUIRING MAINTENANCE OR REPAIR ACCESSIBLE.

- H. THE CONTRACTOR SHALL INSTALL MECHANICAL SYSTEMS AS SHOWN, NOTED AND SPECIFIED. EQUIPMENT MAY NOT BE SUBSTITUTED UNLESS WRITTEN APPROVAL BY THE ENGINEER OR TENANT'S REPRESENTATIVE IS OBTAINED. ANY UNAUTHORIZED CHANGES SHALL BE REMOVED AT CONTRACTOR'S EXPENSE IF DEEMED NECESSARY BY ENGINEER OR TENANT'S REPRESENTATIVE. CONTRACTOR SHALL BE RESPONSIBLE FOR ANY REQUIRED CHANGE TO RELATED WORK CAUSED BY THE SUBSTITUTION OF ANY ITEMS OF MATERIALS OR EQUIPMENT AT NO ADDITIONAL COST TO THE OWNER.

### HVAC UNITS

- A. CONTRACTOR SHALL COORDINATE THE DELIVERY, RECEIVING, STORAGE, RIGGING, HOISTING, INSTALLATION AND START UP OF HEATING AND COOLING UNITS INCLUDING ALL ACCESSORIES AS SCHEDULED AND AS INDICATED ON THE DRAWINGS.

- B. HVAC UNITS SHALL BE FURNISHED COMPLETE WITH CASING, REFRIGERATION SYSTEM, HEATING SECTION (AS SCHEDULED ON DRAWINGS), FANS, MOTORS AND DRIVES, FILTERS, AUTOMATIC CONTROLS, AND OPTIONS AND ACCESSORIES AS SCHEDULED ON DRAWINGS.

#### C. TEMPERATURE CONTROLS.

- HVAC UNITS SHALL BE FURNISHED WITH FACTORY INSTALLED AND TESTED COMPONENTS TO PROVIDE TWO STAGES OF COOLING, TWO STAGES OF HEATING (WHERE APPLICABLE), ANTI-RECYCLE TIMER, FIVE (5) MINUTE COMPRESSOR STAGING RELAY, AND OTHER ITEMS AS SCHEDULED ON DRAWINGS.

#### D. SEQUENCE OF OPERATION

##### 1. OCCUPIED HOURS.

- UNIT OUTDOOR AIR DAMPER SHALL OPEN TO ITS MINIMUM POSITION AND UNIT SUPPLY FAN SHALL OPERATE CONTINUOUSLY.
- UNIT COMPRESSOR(S) SHALL CYCLE OR HEAT EXCHANGER SHALL STAGE TO MAINTAIN SPACE SETPOINT.

- UNIT ECONOMIZER CYCLE SHALL BE INITIATED UPON A SIGNAL FROM OUTDOOR AND RETURN AIR TEMPERATURE AND ENTHALPY SENSORS. OUTDOOR AIR DAMPER, RETURN AIR DAMPER, AND UNIT COMPRESSOR(S) SHALL CYCLE TO MAINTAIN SPACE SETPOINT. ECONOMIZER CYCLE SHALL OVER RIDE CO2 MONITORING SYSTEM.

##### 2. UNOCCUPIED HOURS.

- UNIT OUTDOOR AIR DAMPER SHALL REMAIN CLOSED AND UNIT SUPPLY FAN SHALL CYCLE ON A SIGNAL FROM SPACE SENSOR.
- UNIT COMPRESSOR(S) SHALL CYCLE OR HEAT EXCHANGER SHALL STAGE WITH UNIT SUPPLY FAN TO MAINTAIN SPACE SETPOINT.

##### 3. SMOKE ALARM (WHERE REQUIRED).

- UNIT OUTDOOR AIR DAMPER SHALL CLOSE AND UNIT SUPPLY FAN SHALL STOP ON A SIGNAL FROM DUCT SMOKE DETECTOR. DUCT SMOKE DETECTOR SHALL SEND A SIGNAL TO REMOTE ALARM DEVICE.

### EXECUTION

- A. ALL OUTSIDE AIR INTAKES SHALL BE A MINIMUM OF 10'-0" AWAY FROM EXHAUST DISCHARGE OPENINGS AND PLUMBING VENT STACKS.

- B. PROVIDE UL APPROVED FIRE DAMPERS FOR ALL PENETRATIONS THROUGH FIRE RATED WALLS, PARTITIONS, CEILINGS, AND FLOORS. INSTALL FIRE DAMPERS AS PER MANUFACTURER'S DIRECTIONS AND AS PER UL GUIDELINES.

- C. SUPPLY, RETURN AND POSITIVE PRESSURE EXHAUST DUCTWORK SHALL BE SEALED IN ACCORDANCE WITH SMACNA SEAL CLASS "C".

- D. CORE-DRILL OR SAW-CUT EXISTING WALLS, ROOF, ETC. AS REQUIRED FOR PIPING OR DUCTWORK AND FIRE-STOP OPENING AROUND PIPE OR DUCTWORK. VERIFY LOCATION OF STRUCTURAL BEAMS, JOISTS, ETC. BEFORE DRILLING OR CUTTING. NOTIFY ARCHITECT OF ANY DISCREPANCIES.

- E. WHEREVER FOUNDATION WALLS, OUTSIDE WALLS, ROOFS, ETC. ARE CUT FOR INSTALLATION OF SYSTEMS, THEY SHALL BE PATCHED TO MATCH EXISTING CONSTRUCTION AND SEALED WEATHER TIGHT. WORK SHALL BE PERFORMED BY CRAFTSMEN SKILLED IN THEIR RESPECTIVE TRADES.

- F. PROVIDE 3 SETS OF PLEATED DISPOSABLE FILTERS. ONE SET TO BE USED UNTIL COMPLETION OF CONSTRUCTION PHASE. INSTALL ONE SET AT COMPLETION OF CONSTRUCTION PHASE AND DELIVER ONE SET TO OWNER AND LABEL EACH SET OF FILTERS TO DENOTE THEIR RESPECTIVE HVAC UNITS.

- G. PROVIDE TWO OPERATION AND MAINTENANCE MANUALS BOUND IN 8-1/2" X 11" PAGE BINDERS, TITLED "OPERATION AND MAINTENANCE MANUAL". SUBDIVIDE BINDER CONTENTS WITH PAGE DIVIDERS BY SYSTEM AND EQUIPMENT. INCLUDE ALL SHOP DRAWINGS, AS-BUILT DRAWINGS AND WARRANTIES. SUBMISSION OF THESE DOCUMENTS SHALL BE WITHIN 90 DAYS OF SYSTEM ACCEPTANCE, PER ENERGY CODE, AND A REQUIREMENT FOR FINAL PAYMENT.

### TESTING, ADJUSTING, BALANCING AND INSPECTION

- A. WORK SHALL BE PERFORMED AFTER THE COMPLETE INSTALLATION AND STARTUP OF ALL EQUIPMENT, DUCT SYSTEMS AND TEMPERATURE AND ENERGY MANAGEMENT CONTROLS AND COMPLETED PRIOR TO TURNOVER FOR THE START OF STOCKING.

- B. CONTRACTOR SHALL SUBMIT TEST AND BALANCE REPORT TO GENERAL CONTRACTOR FOR SUBMITTAL TO TENANT'S PROJECT MANAGER AND LOCAL CODE AUTHORITY (IF REQUIRED).


- C. TESTING AND BALANCING CONTRACTOR SHALL ALSO INSPECT THE COMPLETED AND OPERATIONAL HVAC EQUIPMENT, DUCT SYSTEMS AND TEMPERATURE AND ENERGY MANAGEMENT CONTROLS PRIOR TO TURNOVER OF THE STORE FOR THE START OF STOCKING. TESTING AND BALANCING CONTRACTOR SHALL SUBMIT THE COMPLETED TENANT'S HVAC FIELD INSPECTION REPORT TO THE GENERAL CONTRACTOR FOR SUBMITTAL TO TENANT'S PROJECT MANAGER FOR REVIEW.

## KEYED NOTES

- NEW GAS METER BY UTILITY. CONTRACTOR SHALL VERIFY THAT NEW GAS METER IS REGULATED FOR 7" W.C. PRESSURE, AND HAS A MINIMUM CAPACITY OF 534 CFH. GAS PIPING IS SIZED BASED ON SCHEDULE 40 METALLIC PIPE, 7" W.C. INLET PRESSURE, 0.5" W.C. PRESSURE DROP, 0.80 SPECIFIC GRAVITY, OVER A TOTAL DEVELOPED LENGTH OF 50'-0". AS PER THE 2015 INTERNATIONAL FUEL GAS CODE, TABLE 402.4(2), ANY DISCREPANCIES IN THIS INFORMATION SHOULD BE IMMEDIATELY BROUGHT TO THE ATTENTION OF THE CONSTRUCTION MANAGER AND/OR PROJECT ENGINEER. FIELD VERIFY EXTENT OF WORK PRIOR TO INSTALLATION OF PIPING.
- CONTRACTOR SHALL EXTEND NEW 1-1/4" GAS RISER UP TO ROOF OUTSIDE OF BUILDING, TIGHT TO WALL. PROVIDE AN APPROVED GAS SHUT-OFF AT 48" ABOVE FINISHED GRADE.
- UTILITY SHALL BE RESPONSIBLE FOR SPLITTING GAS SERVICE.
- CONTRACTOR TO EXTEND AND CONNECT NEW GAS PIPING TO NEW HVAC UNIT, AS INDICATED. SEE DETAIL ON SHEET M201.
- CONTRACTOR SHALL INSTALL NEW CONTRACTOR PROVIDED HVAC UNIT AND CONTRACTOR PROVIDED ROOF CURB AS INDICATED ON PLANS, SCHEDULE AND NOTES. PROVIDE NEW ROOF OPENINGS AND STRUCTURAL SUPPORT, AS SHOWN ON STRUCTURAL DRAWINGS. PROVIDE FULL SIZE DUCT DROP/SLIPS 2'-0" BELOW STRUCTURE FOR FUTURE CONNECTION BY TENANT.
- PROVIDE FULL SIZE CONDENSATE TRAP/LINE. TERMINATE IN A CODE APPROVED LOCATION. SEE DETAIL ON SHEET M201.
- FURNISH AND INSTALL DUCT SMOKE DETECTOR (SYSTEM SENSOR #D4120) IN RETURN AIR DROP FROM UNIT. WIRE DUCT SMOKE DETECTOR TO BUILDING FIRE ALARM CONTROL PANEL OR FURNISH AND INSTALL A REMOTE AUDIBLE/VISUAL ALARM DEVICE WITH A REMOTE TEST SWITCH (SYSTEM SENSOR #RTS2-AOS) LOCATED IN AN APPROVED LOCATION. FIELD VERIFY EXACT REQUIREMENTS. CONTRACTOR SHALL TEST SYSTEM TO INSURE PROPER FUNCTION PRIOR TO TENANT OCCUPYING SPACE.
- MOUNT THERMOSTAT TO COLUMN, AS SHOWN, AT 48" ABOVE FINISHED FLOOR. NOTE: THERMOSTAT TO BE USED FOR STARTUP PURPOSES ONLY, AND WILL BE REPLACED BY TENANT'S ENERGY MANAGEMENT SYSTEM. SEE SCHEDULE SHEET 201 FOR FURTHER DETAIL.
- EXISTING GAS METER TO REMAIN AND BE REUSED BY FUTURE TENANT. TEMPORARILY CAP STUB-IN FOR FUTURE CONNECTION. FUTURE TENANT IS ESTIMATED TO REQUIRE 250 CFH OF GAS.
- TAP OFF GAS LINE OF SIZE SHOWN. DROP BELOW ROOF AND BRING TO FUTURE TENANT SPACE AND CAP. PIPE IS SIZED TO SUPPLY 130 CFH OF GAS PER TENANT SPECIFICATIONS.


## SYMBOLS LEGEND

—NG—	NEW NATURAL GAS STUB-IN
	NEW GAS METER
	EQUIPMENT/FIXTURE DESIGNATION
	KEYED NOTE
	REVISION NUMBER
TYP.	TYPICAL
F.V.	FIELD VERIFY
	THERMOSTAT
	SMOKE DETECTOR

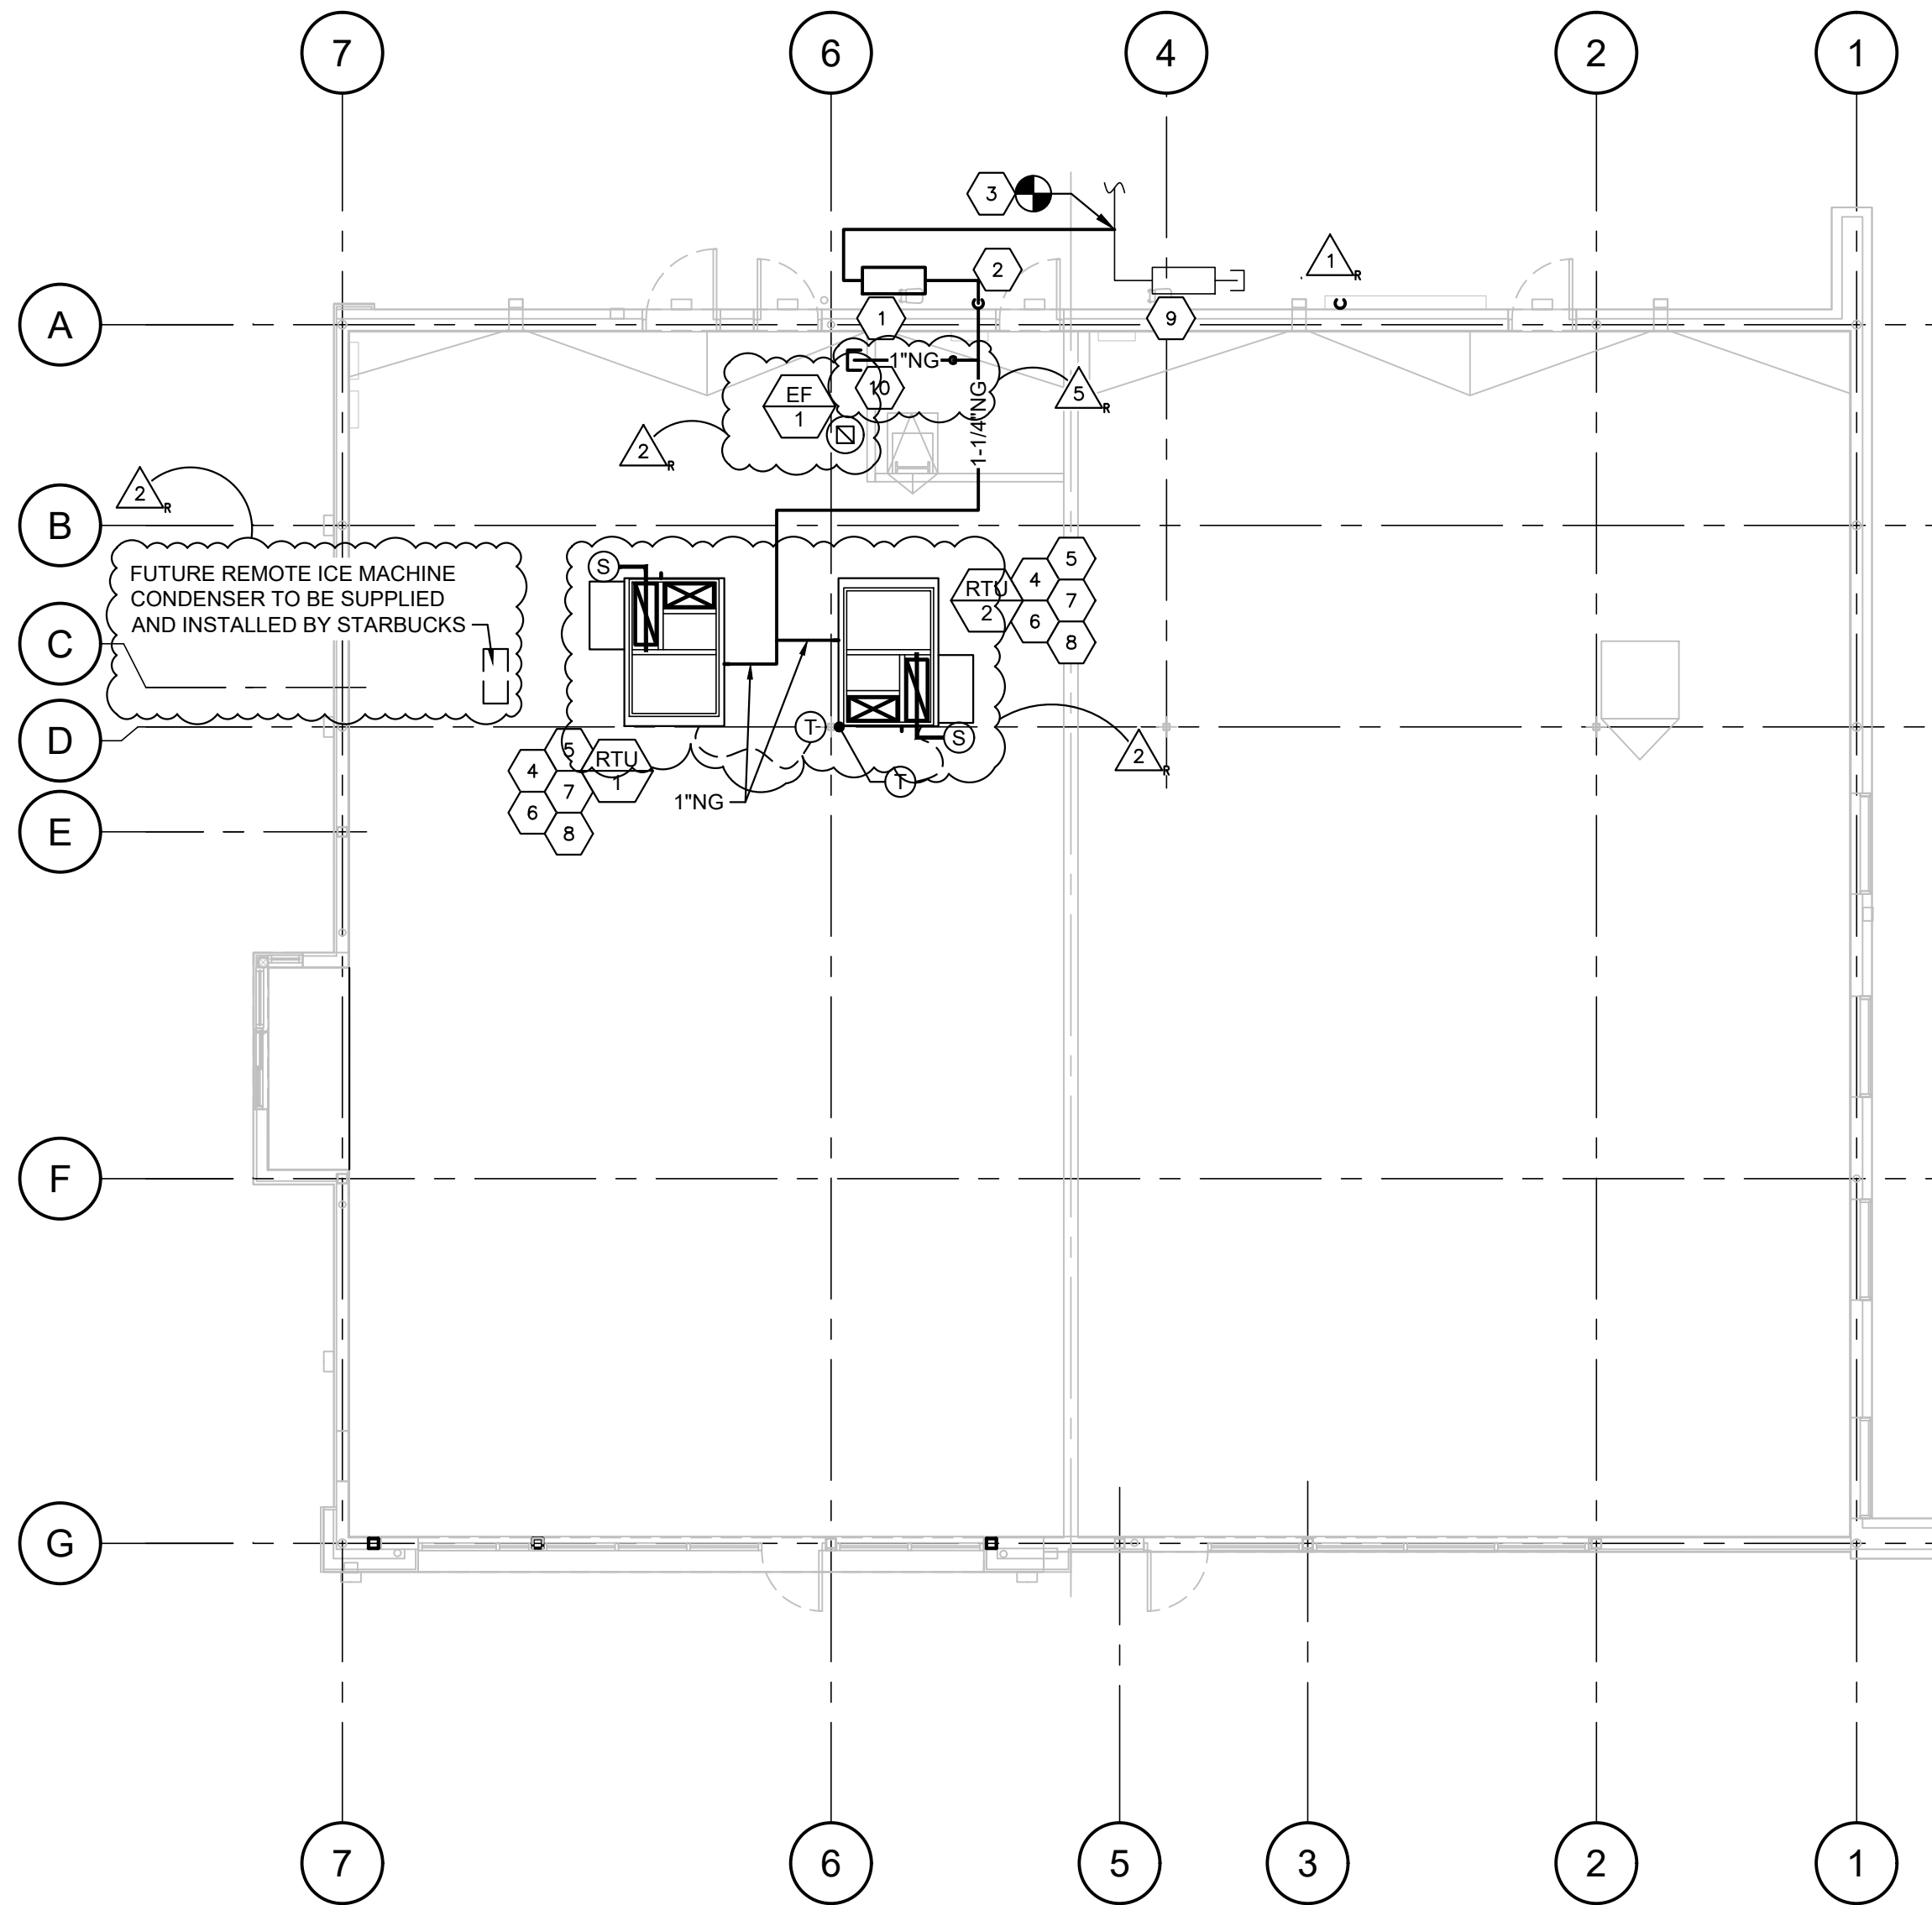


## MECHANICAL PLAN


SCALE: 1/8" = 1'-0"

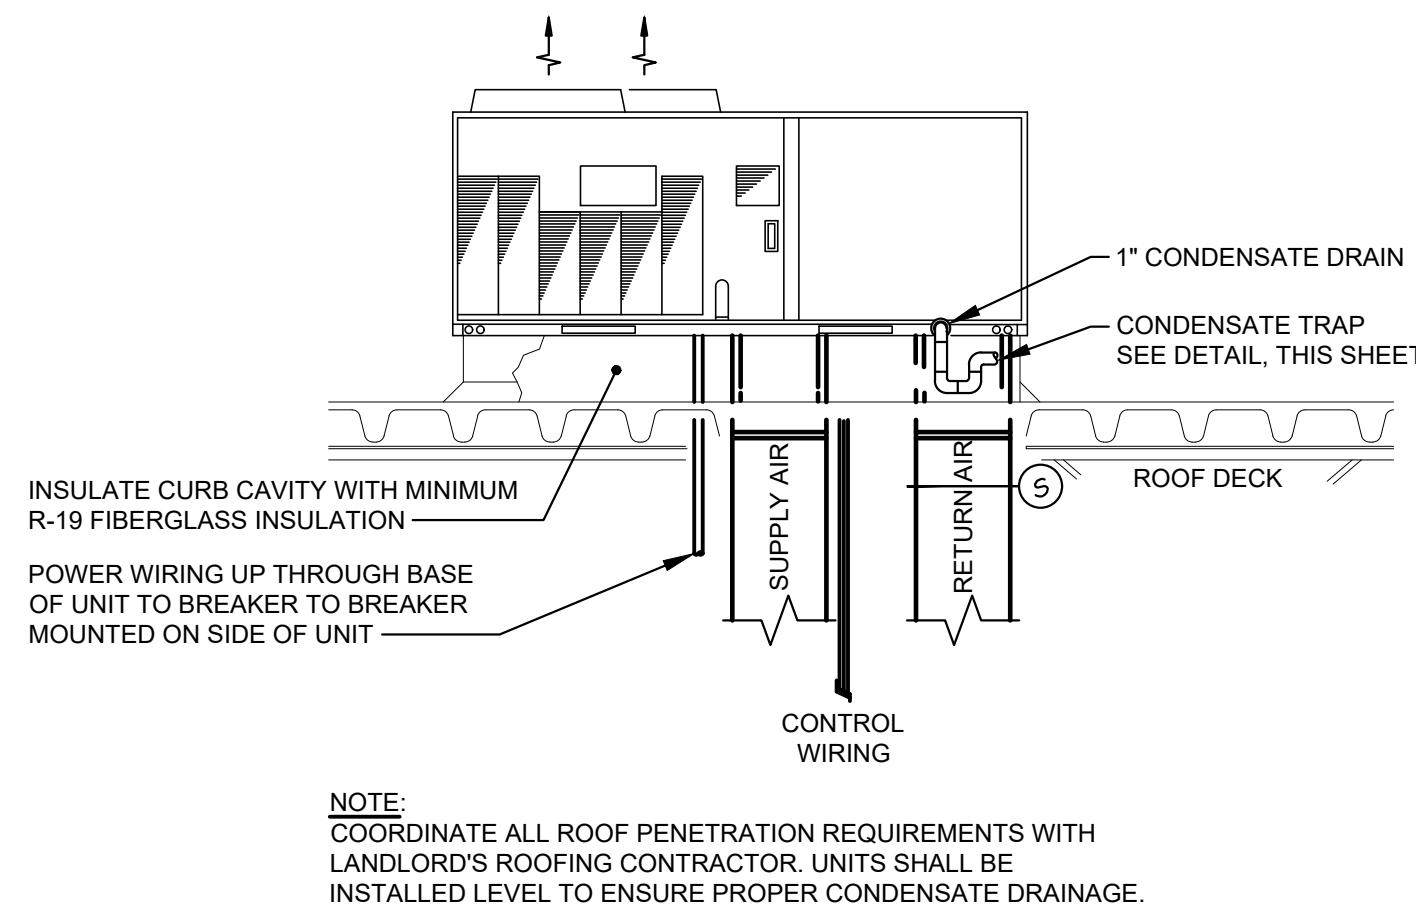

1 TYPICAL ROOFTOP UNIT INSTALLATION  
MP2.0 SCALE NOT TO SCALE

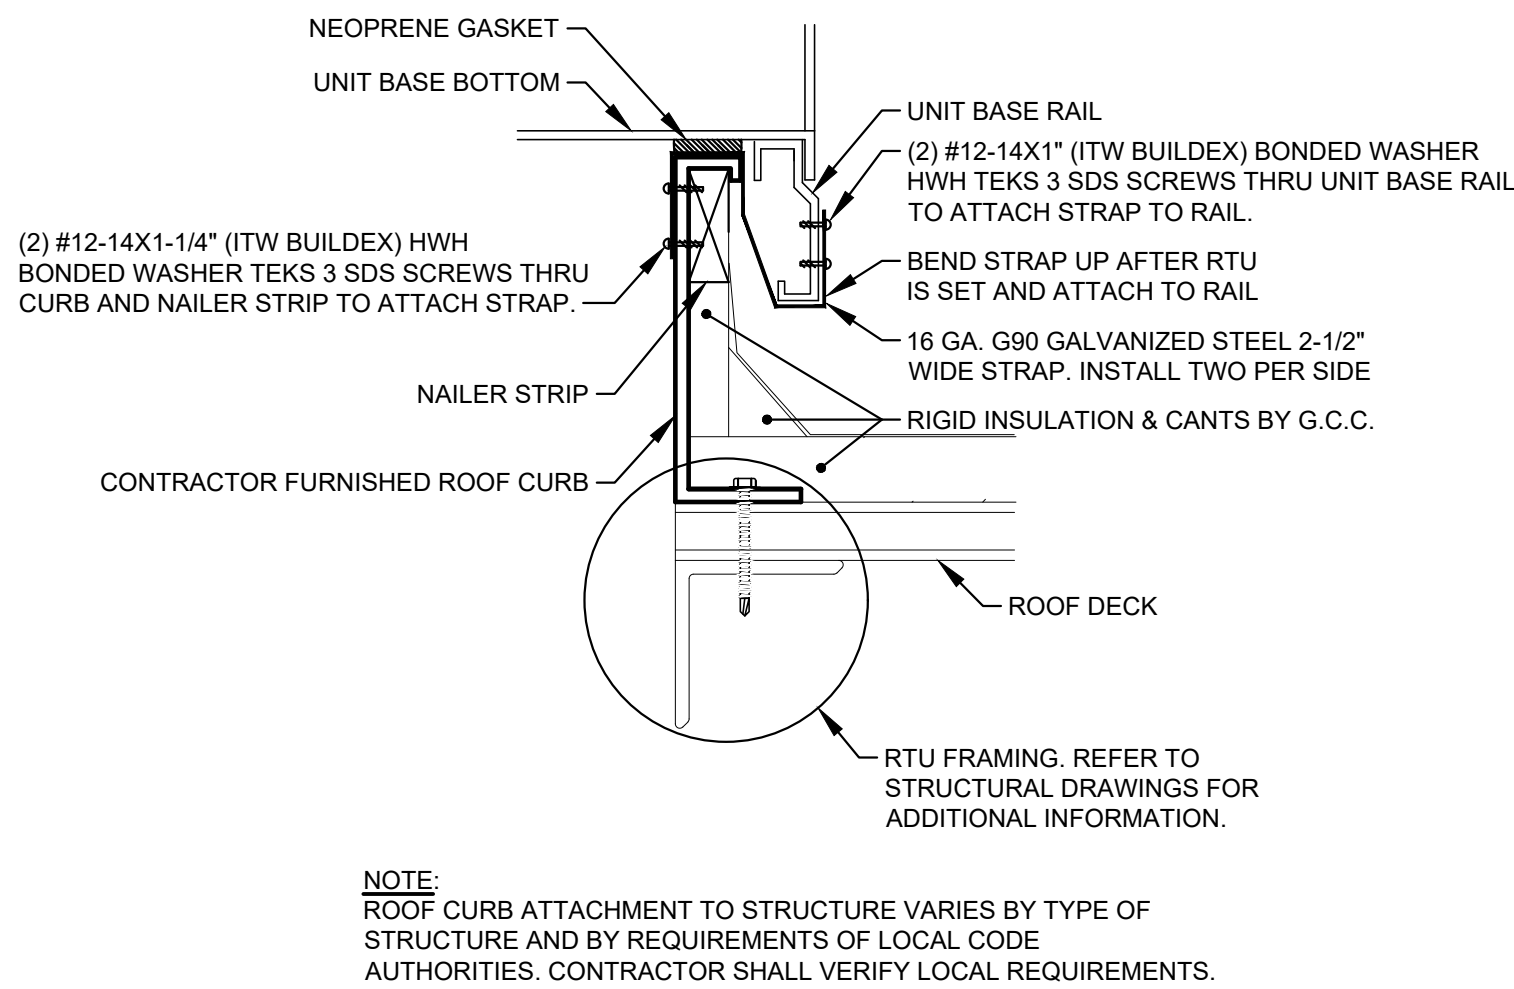


3 ROOFTOP UNIT CURB ATTACHMENT  
MP2.0 SCALE NOT TO SCALE

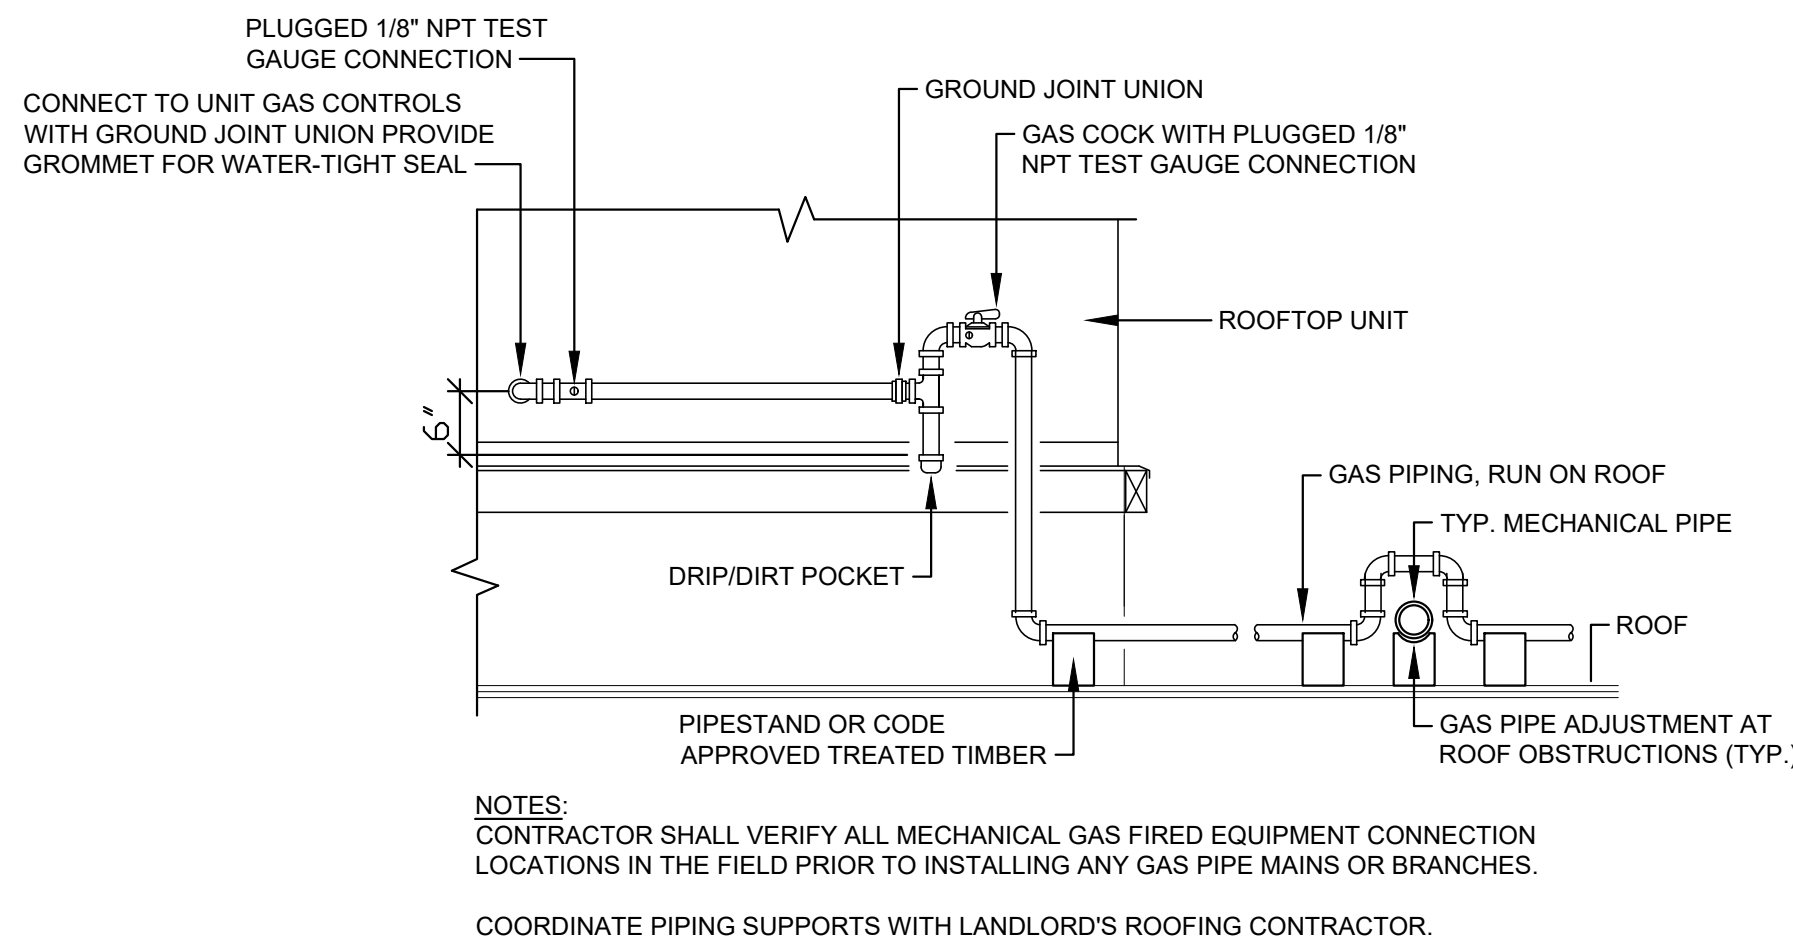

5 ROOFTOP UNIT GAS PIPING DETAIL  
MP2.0 SCALE NOT TO SCALE

ROOFTOP UNIT SCHEDULE (gas heat/elec. cool)																				
MARK	MFR./MODEL	DISCHARGE	TONS	ESP	CFM	OUTSIDE AIR CFM (MAX.)	ENTERING CONDITIONS	GROSS COOLING CAPACITY (MBH)		(S)EER	FUEL TYPE	HEATING CAPACITY (MBH)		SSE %	ELECTRICAL DATA			MCA/MOCP	APRX. UNIT WEIGHT (LBS.)	OPTIONS/ ACCESSORIES
								TOTAL	SENSIBLE			INPUT	OUTPUT		VOLTS	PHASE	FREQ.			
RTU-1	CARRIER 48HCE11A2	VERTICAL	10.0	1.00	4,000	1000	80.4°F DB 65.8°F WB @ 96.4°F AMBIENT	116.1	93.8	12.0 EER	NATURAL GAS	224	184	82	208	3	60	54.0 / 60	1,427	1, 2, 3, 4, 5, 6, 7, 8, 9, 10.
RTU-2	CARRIER 48HCE08A2	VERTICAL	7.5	1.00	3,000	750	80.4°F DB 65.8°F WB @ 96.4°F AMBIENT	90.2	73.5	12.0 EER	NATURAL GAS	180	148	82	208	3	60	41.0 / 50	1,228	1, 2, 3, 4, 5, 6, 7, 8, 9, 10.
OPTIONS/ACCESSORIES:																				
1) FACTORY INSTALLED MEDIUM STATIC BELT DRIVE.																				
2) FACTORY INSTALLED, FIELD WIRED DUAL ENTHALPY ECONOMIZER W/ BAROMETRIC RELIEF AND HOODS.																				
3) FACTORY INSTALLED LOUVERED HAIL GUARDS.																				
4) FACTORY INSTALLED, FIELD WIRED NON-FUSED DISCONNECT (REFER TO ELECTRICAL DRAWINGS FOR ADDITIONAL INFORMATION).																				
5) FACTORY INSTALLED, FIELD WIRED NON-POWERED CONVENIENCE OUTLET (REFER TO ELECTRICAL DRAWINGS FOR ADDITIONAL INFORMATION).																				
6) FACTORY FURNISHED, FIELD INSTALLED THRU THE BASE ELECTRICAL & THRU THE CURB GAS KIT.																				
7) FACTORY FURNISHED, FIELD INSTALLED FLUE EXTENSION KIT.																				
8) CONTRACTOR FURNISHED, FIELD INSTALLED SLOPED ROOF CURB.																				
9) TENANT FURNISHED, FIELD INSTALLED/WIRED 7-DAY PROGRAMMABLE THERMOSTAT, WITH NIGHT SETBACK AND AUTO-CHANGEOVER (HONEYWELL RTH8500D OR EQUIVALENT).																				
10) CONTRACTOR FURNISHED, THREE (3) SETS OF PLEATED FILTERS (REFER TO SPECIFICATIONS ON SHEET M101 FOR ADDITIONAL INFORMATION).																				
NOTE:																				
CONTRACTOR SHALL BE RESPONSIBLE FOR ALL STARTUP AND WARRANTY WORK. VERIFY ELECTRICAL POWER PRIOR TO INSTALLING UNITS. FAILURE TO DO SO SHALL RESULT IN CONTRACTOR FURNISHING CORRECT UNITS OR POWER AT NO ADDITIONAL COST TO TENANT.																				
EQUIVALENT UNITS MAY BE PROVIDED. ACCEPTABLE ALTERNATIVE MANUFACTURERS ARE TRANE AND LENNOX.																				

EXHAUST FAN SCHEDULE													
MARK	MFR./MODEL	CFM	RPM	ESP	DRIVE	SONES (MAX)	ELECTRICAL DATA				NOTES	SERVICE	
							VOLTS	PHASE	FREQ.	HP			
EF-1	GREENHECK G-090-VG	500	1405	0.31	DIRECT	6.2	115	1	60	1/10	1, 2.	RESTROOMS/OVENS	
NOTES: 1) PROVIDE WITH FACTORY ROOF CURB AND BACKDRAFT DAMPER. 2) PROVIDE WITH SPEED CONTROLLER.													

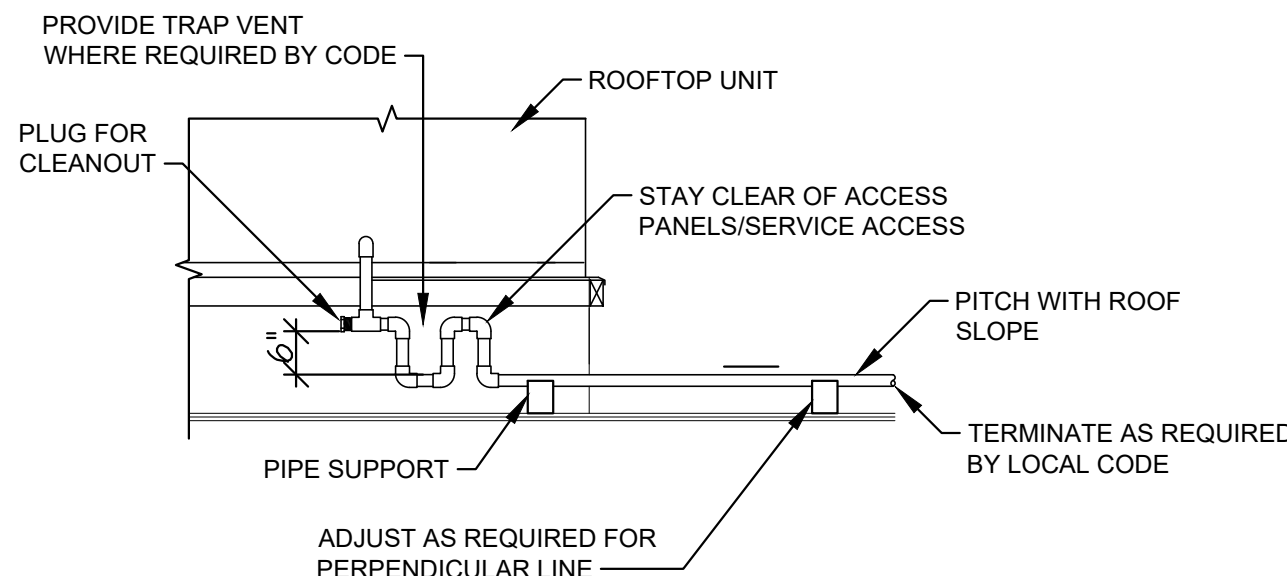

4 ROOFTOP UNIT CONDENSATE PIPING DETAIL  
MP2.0 SCALE NOT TO SCALE

RELEASE FOR CONSTRUCTION AS NOTED ON PLANS REVIEW PERMISSIBLE SERVICES MISSOURI 08/26/2020

CASCO

12 Summit Drive, Suite 100, St. Louis, MO 63143

MIDLAND

Starbucks & Medical Office

155 S.W. MO-150 HWY

LEE'S SUMMIT, MO 64802

CONSTR. DOC. & REVISIONS

No.	Description	Date
1	Owner Review	05/12/20
2	Owner Revision 3	07/20/20

CASCO DIVERSIFIED CORPORATION  
PROFESSIONAL ENGINEERING  
CERTIFICATE OF AUTHORITY #000613  
EXP. 12/31/21

Michael C. Grapperhaus  
Professional Engineer  
PE-2008019543  
8/20/20

PROFESSIONAL OF RECORD  
MICHAEL C. GRAPPERHAUS  
License NO.: PE-2008019543  
Expiration Date: 12/31/20


Drawn By/Checked By: BAM/MCG

Project Number 320488

Permit Date 06-17-20

MECHANICAL SCHEDULES AND DETAILS

M201

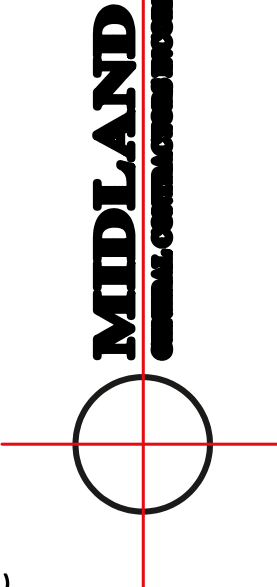


Starbucks & Medical Office

155 S.W. MO-150 HWY  
LEE'S SUMMIT, MO 64802

CONSTR. DOC. & REVISIONS

No.	Description	Date
1	Owner Review	05/12/20
2	Clarifications	07/09/20
3	Owner Revisions	07/20/20
4	Clarifications	07/31/20
5	Clarifications	08/06/20

CASCO DIVERSIFIED CORPORATION  
PROFESSIONAL ENGINEERING  
CERTIFICATE OF AUTHORITY #000613  
EXP. 12/31/21

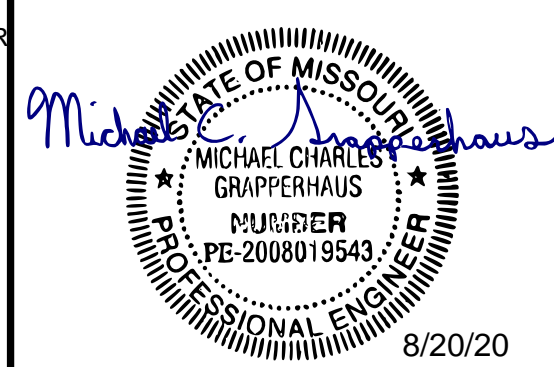

PROFESSIONAL OF RECORD  
MICHAEL C. GRAPPERHAUS  
License NO.: PE-2008019543  
Expiration Date: 12/31/20

Drawn By/Checked By: BAM/MCG  
Project Number 320488

Permit Date 06-17-20

PLUMBING  
PLAN

P101

## SPECIFICATIONS

### GENERAL CONDITIONS

- THE GENERAL AND SPECIAL CONDITIONS OF THE ARCHITECTURAL SPECIFICATIONS SHALL BE INCLUDED AS PART OF THESE DOCUMENTS.
- ALL MATERIALS SHALL BE NEW, UNUSED, AND THE BEST OF THEIR RESPECTIVE KINDS AND FREE FROM DEFECTS.
- THE CONTRACTOR SHALL PAY ALL FEES, GIVE ALL NOTICES, FILE ALL NECESSARY DRAWINGS AND OBTAIN ALL PERMITS AND CERTIFICATES OF APPROVAL REQUIRED IN CONNECTION WITH ALL WORK UNDER THIS CONTRACT. ALL WORK SHALL BE FURNISHED AND INSTALLED IN FULL ACCORDANCE WITH ALL LOCAL LAWS, ORDINANCES, RULES AND REGULATIONS.
- DRAWINGS ARE DIAGRAMMATIC ONLY, INTENDING TO SHOW GENERAL RUNS AND LOCATIONS OF THE WORK AND ARE NOT INTENDED TO BE RIGID IN SPECIFIC DETAIL.
- THE CONTRACTOR SHALL BE HELD TO HAVE EXAMINED THE SITE FOR HIS WORK BEFORE HAVING SUBMITTED HIS PROPOSAL. NO ADDITIONAL COMPENSATION WILL BE ALLOWED FOR CONDITIONS FOUND DURING THE COURSE OF THE CONTRACT.
- THE CONTRACTOR SHALL VERIFY ALL MEASUREMENTS AT THE SITE AND BE RESPONSIBLE FOR THE CORRECTNESS OF THE SAME.
- THE CONTRACTOR SHALL COORDINATE THE INSTALLATION OF HIS WORK WITH LIGHTING PLANS, REFLECTED CEILING PLANS, SPRINKLER PLANS AND ALL OTHER TRADES.
- THE INSTALLATION OF ALL EQUIPMENT AND MATERIALS REQUIRING ACCESS SHALL BE MADE IN SUCH MANNER AS TO MAKE THE EQUIPMENT AND MATERIALS READILY ACCESSIBLE FOR OPERATION, MAINTENANCE AND REPAIRS.
- STORAGE OF CONSTRUCTION EQUIPMENT AND MATERIALS SHALL BE ONLY IN DESIGNATED SPACES.
- CONSTRUCTION DEBRIS AND RUBBISH GENERATED BY THE CONTRACTOR SHALL BE REMOVED FROM PREMISES AS OFTEN AS NECESSARY OR AS DIRECTED TO MAINTAIN A CLEAN AND WORKABLE AREA.
- ALL WORK AND EQUIPMENT SHALL BE FULLY GUARANTEED FOR ONE (1) YEAR FROM THE DATE OF FINAL PAYMENT AND ACCEPTANCE.
- ALL WORK AND EQUIPMENT WITHIN THE CONTRACT AREA FURNISHED AND INSTALLED UNDER THIS CONTRACT SHALL BE CLEANED TO THE SATISFACTION OF THE OWNER BEFORE TURNING SAME OVER TO THE OWNER.
- CONNECT NEW WORK TO EXISTING IN A NEAT AND APPROVED MANNER.
- ALL DESIGN SHALL INCORPORATE CURRENT ASHRAE METHODS.

### PLUMBING SPECIFICATIONS

- SUPPLY PIPING SHALL BE TYPE "L" COPPER INSTALLED WITH LEADLESS SOLDER. CONDENSATE PIPING ON ROOF SHALL BE COPPER OR PVC. COLD WATER SUPPLY PIPING SHALL BE INSULATED WITH A MINIMUM 1/2" FIBERGLASS WITH VAPOR PROOF ALL SERVICE JACKET OR EQUIVALENT CLOSED CELL FOAM INSULATION, AS ALLOWED BY LOCAL CODES, FOR INSTALLATION IN RETURN AIR PLENUMS. NATURAL GAS PIPE 2" AND SMALLER SHALL BE THREADED SCHEDULE 40 THICKNESS (ANSI B36-10) BLACK STEEL FINISHED WITH RUST INHIBITIVE PRIMER AND PAINT.
- HANGERS, SUPPORTS AND SLEEVES
  - THE CONTRACTOR SHALL BE RESPONSIBLE FOR ALL PIPING SUPPORTS, HANGERS AND METHODS FOR ATTACHMENT TO WALLS AND PARTITIONS.
  - ALL DRAIN, WASTE, HOT AND COLD WATER AND NATURAL GAS PIPING EXPOSED, ABOVE GRADE AND IN FURRED AREAS, SHALL BE SUPPORTED IN PLACE WITH SECURELY FASTENED SOLID PIPE HANGERS NOT OVER 8'-0" APART, AND AT EACH CHANGE IN DIRECTION (5'-0" ON CAST IRON PIPE).
  - PIPE HANGERS SHALL BE INSTALLED AROUND THE OUTSIDE OF INSULATION WITH VAPOR BARRIERS, AND INSULATION SHALL BE PROTECTED AGAINST CRUSHING BY SHEET METAL JACKET OF PROPER AREA AND WEIGHT.
  - ALL WATER PIPING RUNNING THROUGH FLOORS OR WALLS SHALL BE ISOLATED FROM THE PENETRATION WITH A SLEEVE. MAINTAIN THE FIRE RATING OF ALL WALL AND FLOOR PENETRATIONS BY USE OF APPROVED FIRE STOP MATERIALS.
  - SLEEVES THROUGH WALLS SHALL BE CUT SO AS TO BE FLUSH WITH THE FINISHED SURFACE OF THE WALL, IN EACH CASE, AND SHALL BE MADE WATERTIGHT.
- CONTRACTOR SHALL VERIFY ALL DIMENSIONS, SPACES AND CONDITIONS PRIOR TO FABRICATION AND INSTALLATION OF EQUIPMENT AND MATERIAL.
- CONTRACTOR SHALL GUARANTEE ALL WORK FREE FROM DEFECTS OF WORKMANSHIP AND/OR MATERIAL FOR A PERIOD OF ONE (1) YEAR FROM DATE OF ACCEPTANCE.
- DIELECTRIC UNIONS SHALL BE PROVIDED WHEREVER DISSIMILAR METALS ARE JOINED.

## KEYED NOTES

- EXTEND NEW 4" SANITARY LINE TO CONNECTION WITH SANITARY BY CIVIL. SEE CIVIL FOR INVERT ELEVATION, YARD CLEANOUT, AND CONTINUATION BEYOND 5'-0" FROM THE EXTERIOR FACE OF THE BUILDING.
- EXTEND NEW 4" SANITARY STUB 5'-0" INSIDE THE BUILDING SHELL. CONTRACTOR SHALL TEMPORARILY CAP SANITARY STUB-IN FOR FUTURE CONNECTION BY TENANT.
- EXTEND NEW 2" DOMESTIC WATER FROM NEW WATER METER (SEE CIVIL FOR LOCATION). ROUTE RISER TIGHT TO INSIDE OF EXTERIOR WALL, AND EXTEND PIPING UP TO 14'-0" ABOVE FINISHED FLOOR.
- PROVIDE BALL SHUT-OFF VALVE IN CEILING SPACE AND TEMPORARILY CAP 2" WATER LINE WITHIN 5'-0" INSIDE THE BUILDING SHELL FOR FUTURE CONNECTION BY TENANT. DO NOT ROUTE WATER PIPING ABOVE ELECTRICAL EQUIPMENT - VERIFY IN FIELD.
- INSTALL HOSE BIBB (HB-1) AT 24" ABOVE GRADE. PROVIDE 3/4" CW LINE TO HB-1.
- HB-1: HOSE BIB / WALL HYDRANT: WOODFORD # B65 ANTI-CONTAMINATION, NON-FREEZE WITH COVER PLATE. PROVIDE IN FINISH MOST CLOSELY MATCHED TO EXTERIOR WALL COLOR. ENSURE LANDLORD HAS KEYS TO REMOVE COVER PLATE AT PROJECT COMPLETION.
- HB-2: HOSE BIB / YARD HYDRANT: WOODFORD #Y2 AUTOMATIC DRAINING, FREEZELESS YARD HYDRANT WITH BACKFLOW PREVENTER FOR FUTURE CONNECTION BY TENANT. INSTALL PER MANUFACTURER'S INSTRUCTIONS AT FRONT CORNER OF DUMPSTER ENCLOSURE, CLEAR OF ANY CONFLICTS WITH TRAFFIC OR GATE OPERATION (SEE CIVIL AND/OR FIELD VERIFY). ENSURE PROPER INSULATION, BURY DEPTH, ETC. FOR LOCAL CONDITIONS IS PROVIDED. POSITION UNIT SO THAT HOSE ATTACHMENT FACES AWAY FROM DUMPSTER ENCLOSURE WITHOUT IMPEDING OPERATION OF FLOW LEVER.
- MAINTAIN EXISTING HOSE BIBB FOR FUTURE TENANT.
- EXTEND NEW 4" GREASE WASTE LINE TO CONNECTION WITH GREASE LINE BY CIVIL. SEE CIVIL FOR INVERT ELEVATION, YARD CLEANOUT, AND CONTINUATION BEYOND 5'-0" FROM THE EXTERIOR FACE OF THE BUILDING.
- EXTEND NEW 4" GREASE WASTE STUB 5'-0" INSIDE THE BUILDING SHELL. CONTRACTOR SHALL TEMPORARILY CAP SANITARY STUB-IN FOR FUTURE CONNECTION BY TENANT.
- PROVIDE NEW 4" VENT THRU ROOF FOR CONNECTION BY FUTURE TENANT. SEAL ANY EXISTING, UNUSED VENTS THRU ROOF AIRWEATHER-TIGHT.

## SYMBOLS LEGEND

--GW--	NEW GREASE WASTE STUB-IN
--SS--	NEW SANITARY STUB-IN
G	NEW NATURAL GAS STUB-IN
CW	NEW WATER STUB-IN (WITH GATE VALVE)
M	NEW GAS METER
⬢	EQUIPMENT/FIXTURE DESIGNATION
⬢	KEYED NOTE
Δ	REVISION NUMBER
TYP.	TYPICAL
F.V.	FIELD VERIFY

## CIVIL ENGINEERING DESIGN COORDINATION NOTICE


NOTICE TO ALL PARTIES HAVING AN INTEREST IN THIS CONSTRUCTION PROJECT

- CONTRACTORS RELYING ON DOCUMENTS NOT COORDINATED WITH THE CIVIL ENGINEERING WORK SHALL DO SO AT THEIR OWN RISK.
- COORDINATION WITH THE CIVIL ENGINEERING DOCUMENTS HAS BEEN COMPLETED ONLY AS SHOWN BELOW.

CIVIL ENGINEERING CONSULTANT IS: CASCO CIVIL  
ST. LOUIS, MO


CIVIL SHT. DWG. NO.	CIVIL SHEET DWG. TITLE	REV. NO.	REV. DATE	REV. NO.	REV. DATE	REV. NO.	REV. DATE
C0.0	COVER						
C1.0	DEMOLITION PLAN						
C2.0	SITE AND UTILITY PLAN						
C3.0	GRADING PLAN						
C4.0	SITE DETAILS						
C5.0	EROSION & SEDIMENT CONTROL PLAN						
C5.1	EROSION & SEDIMENT CONTROL DETAILS						
COORDINATION CHECKED BY		INITIAL	DATE	INITIAL	DATE	INITIAL	DATE
DISCIPLINE:							

GREASE INTERCEPTOR NOTES:  
1. SEE CIVIL DRAWINGS FOR EXACT LOCATION.  
2. ALL WORK PERTAINING TO GREASE INTERCEPTOR AND SAMPLING PORT SHALL BE COORDINATED WITH CIVIL. THIS SHALL INCLUDE, BUT IS NOT LIMITED TO: PURCHASE, LOCATION (INCLUDING FIT IN SPECIFIED AREA), INSTALLATION, FLOW LINES, AND PIPING CONNECTIONS.

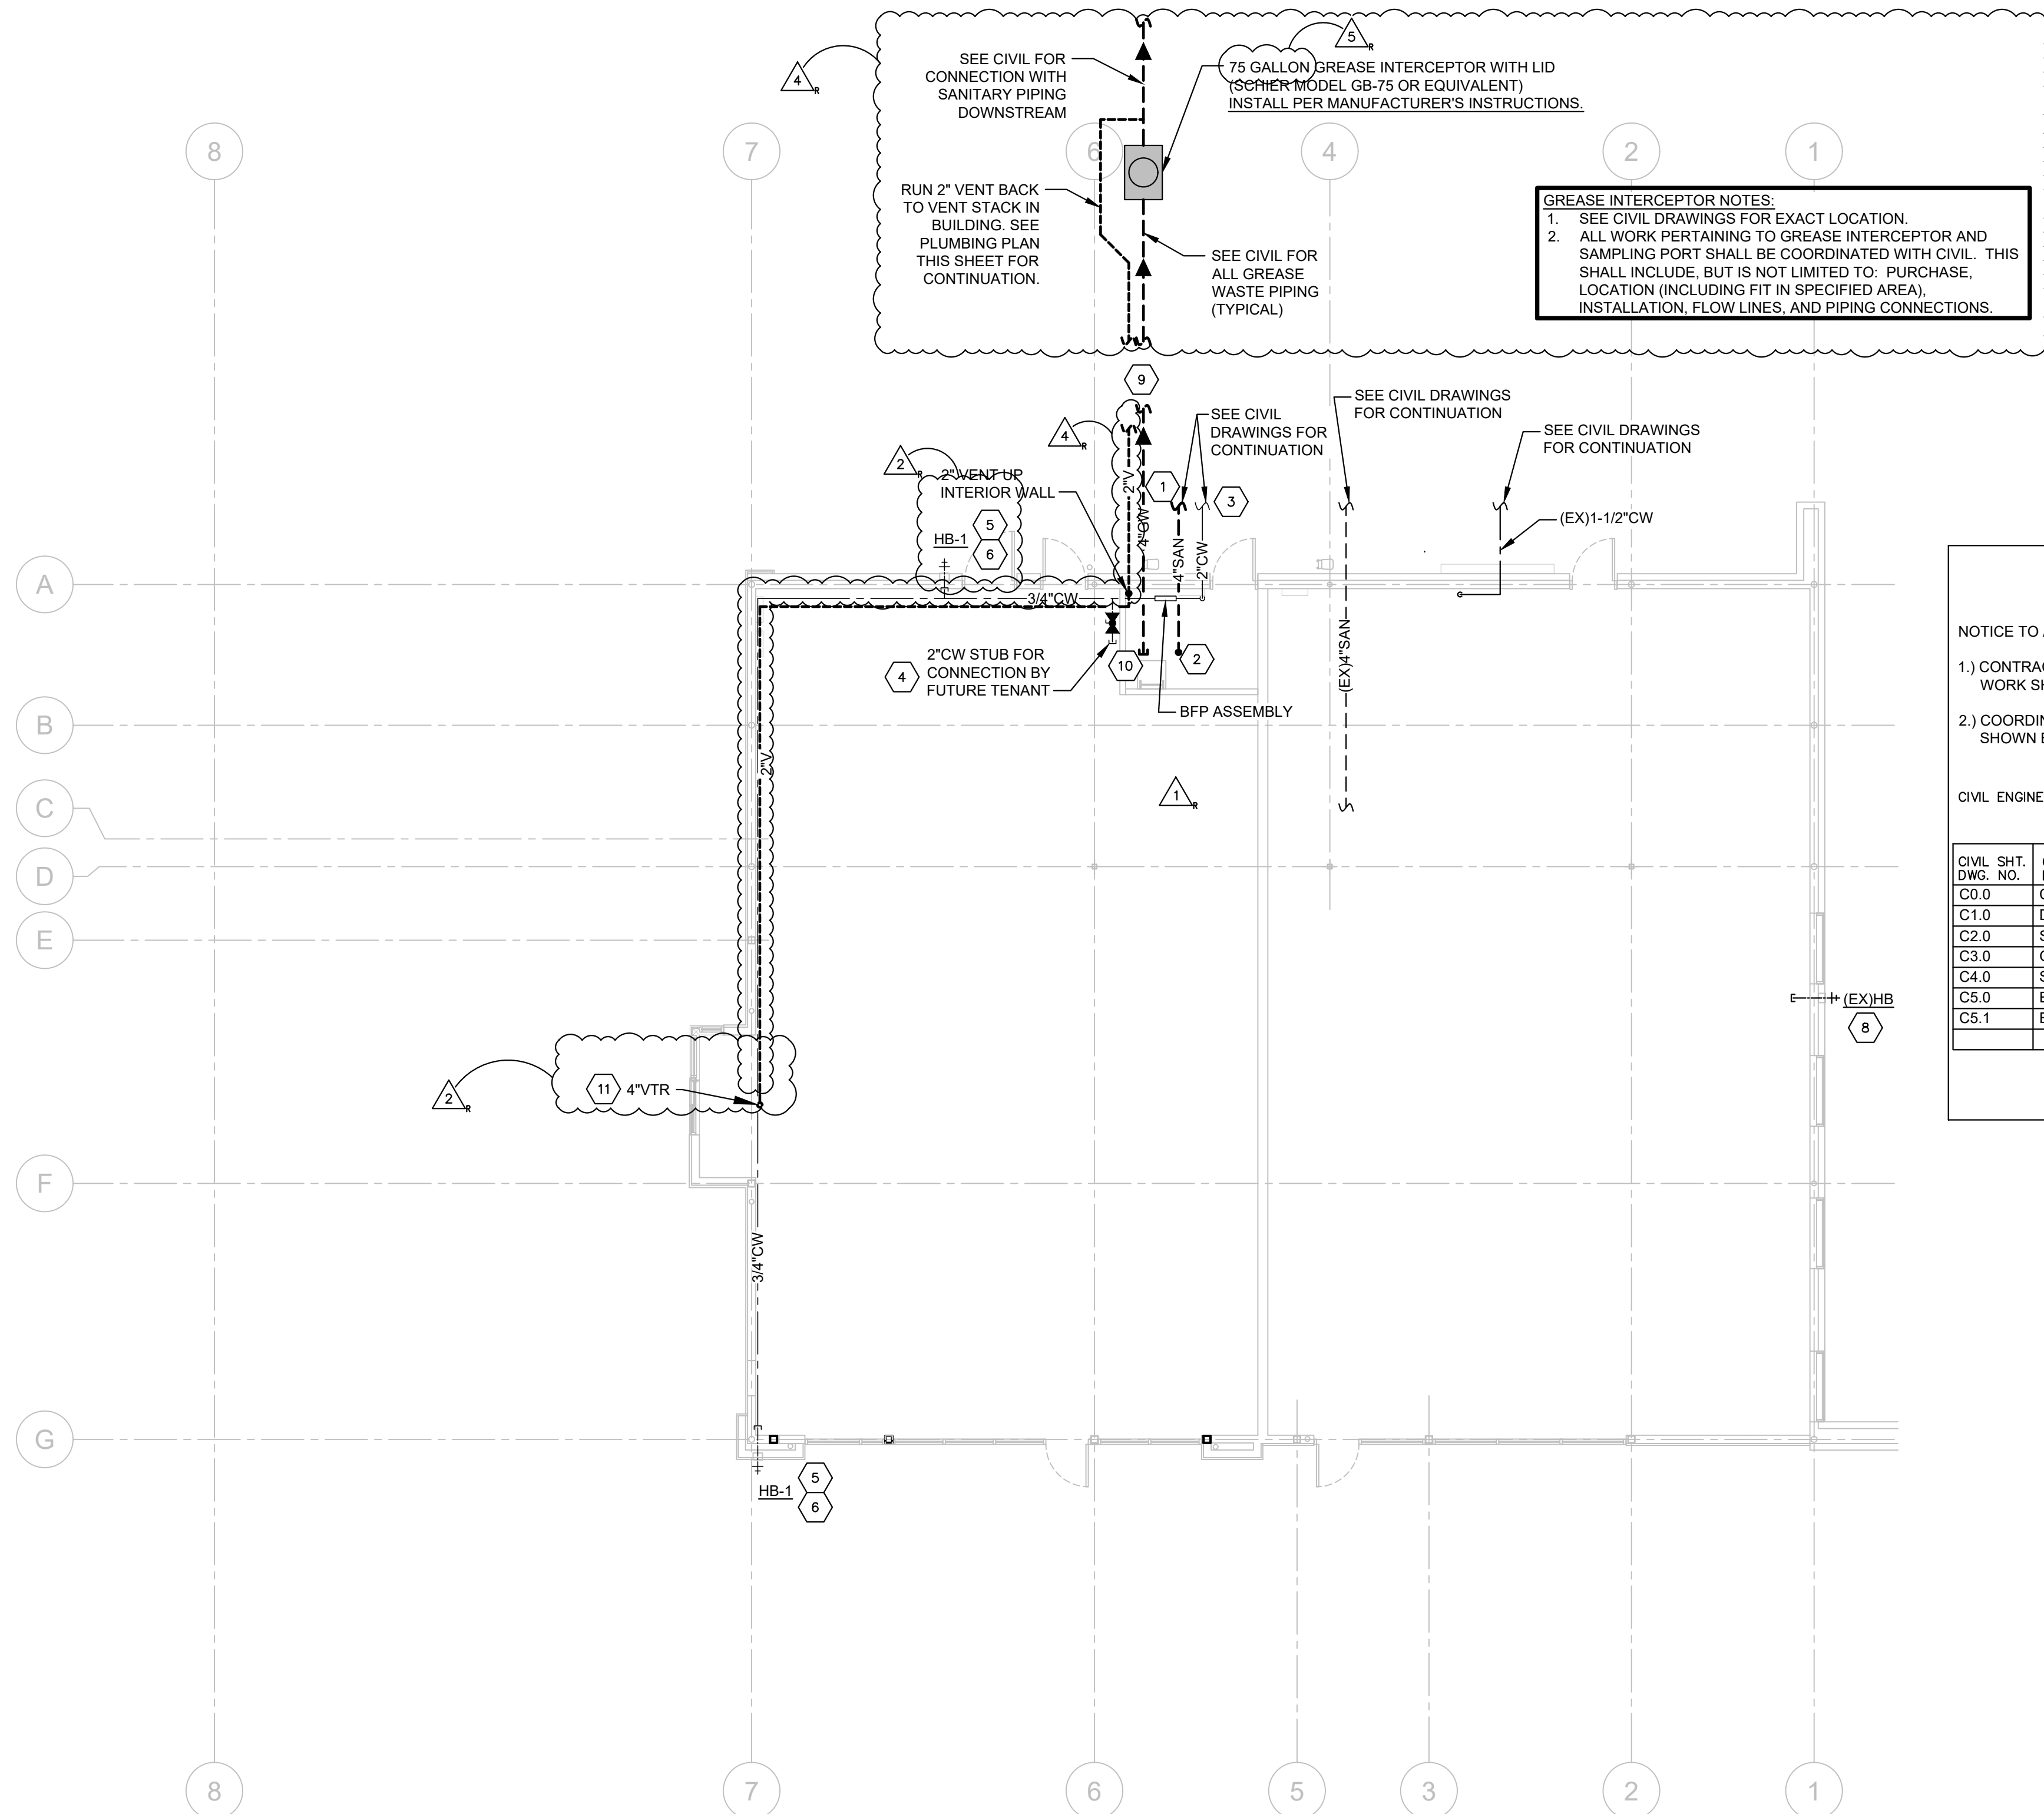


## PLUMBING PLAN

SCALE: 1/8" = 1'-0"

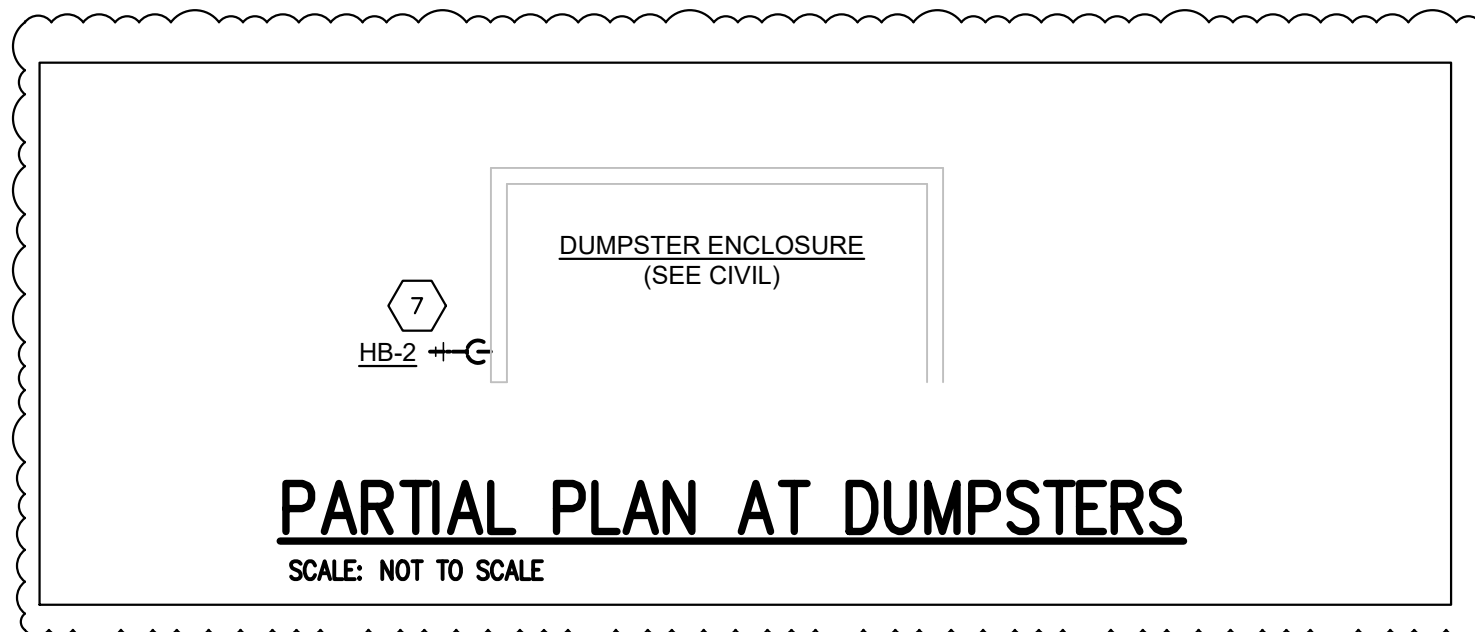

## PARTIAL PLAN AT DUMPSTERS


SCALE: NOT TO SCALE

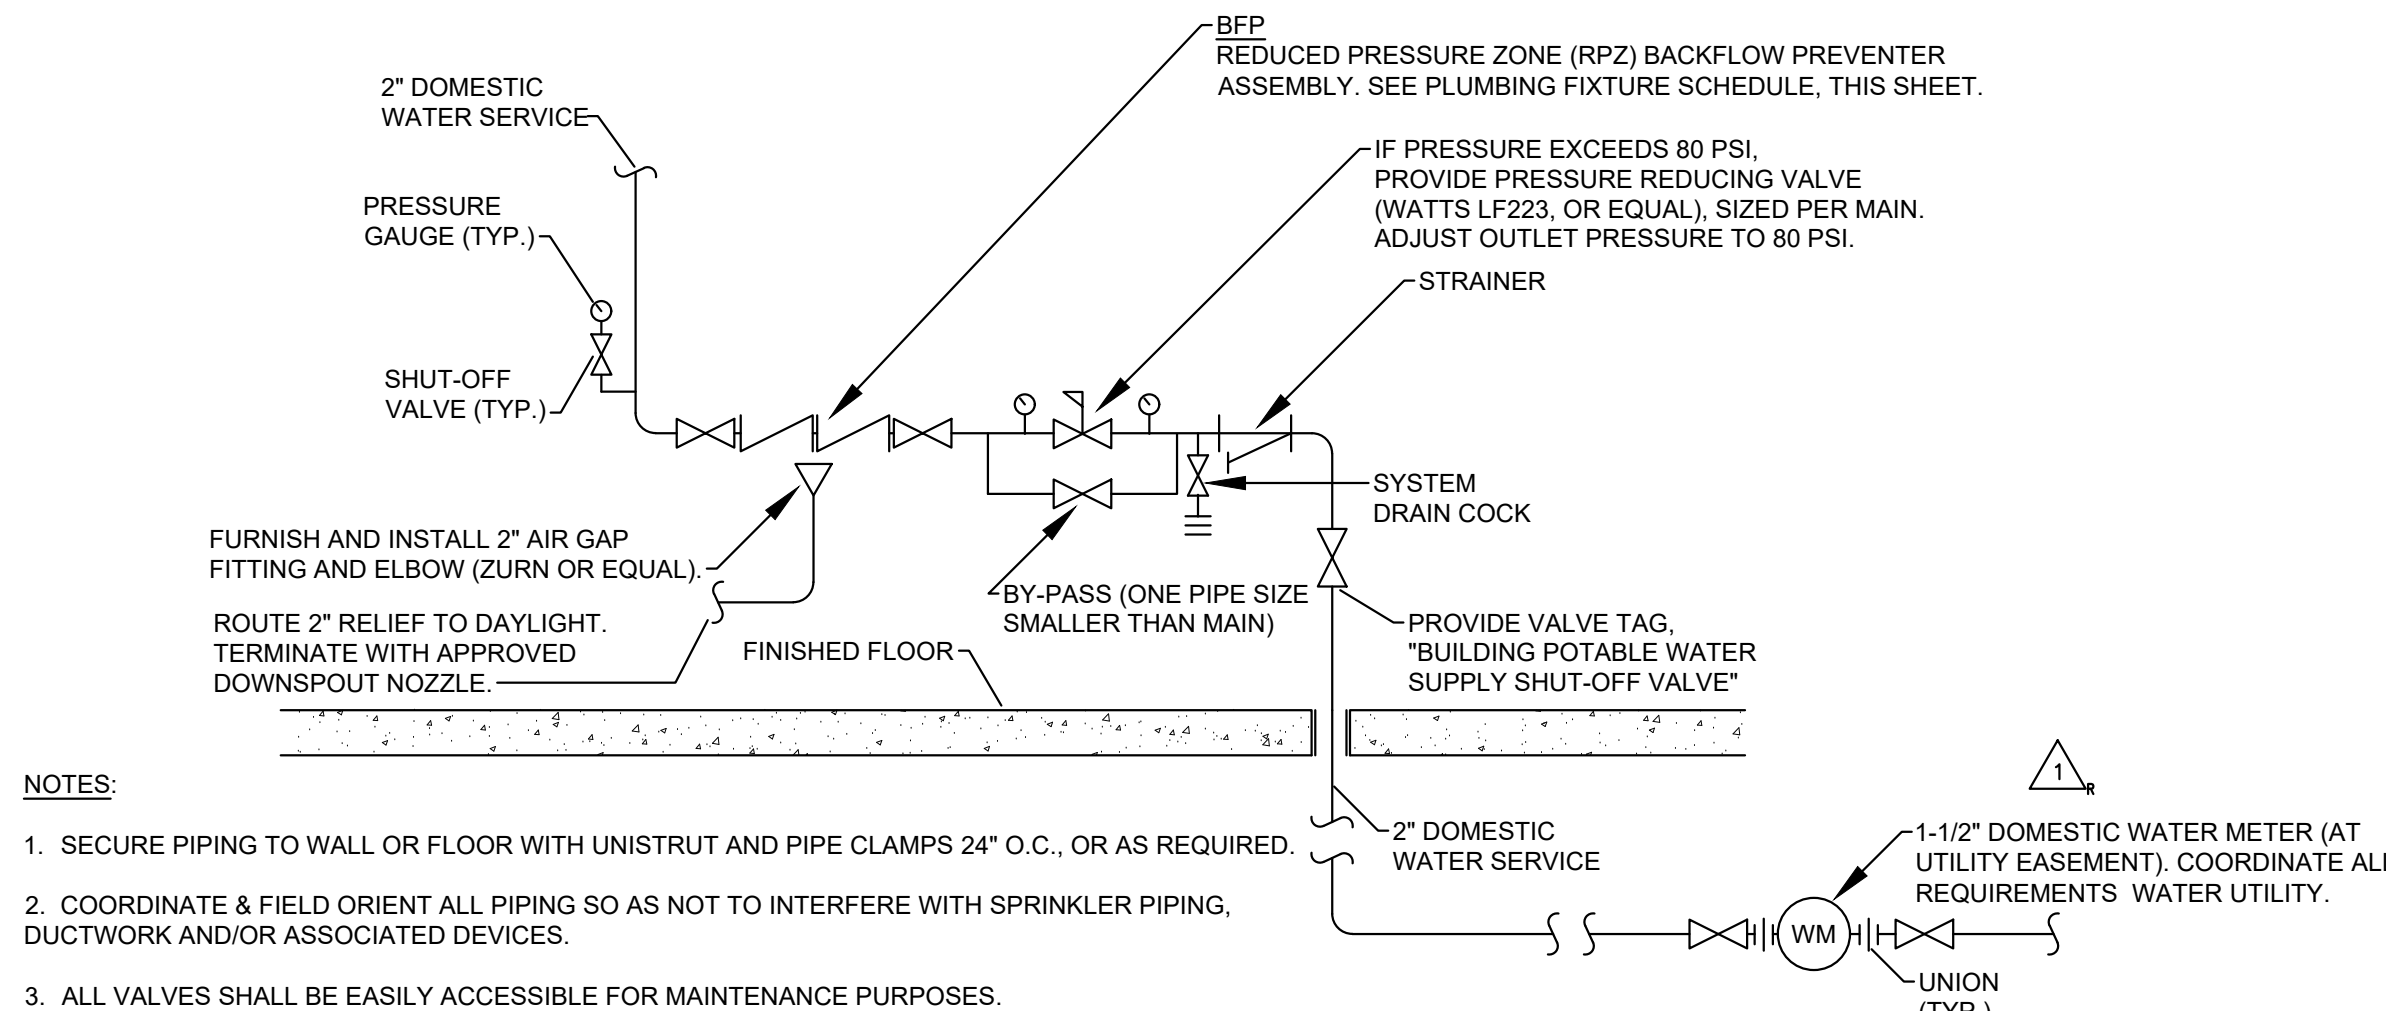

## DOMESTIC WATER SERVICE ENTRANCE

SCALE: NOT TO SCALE




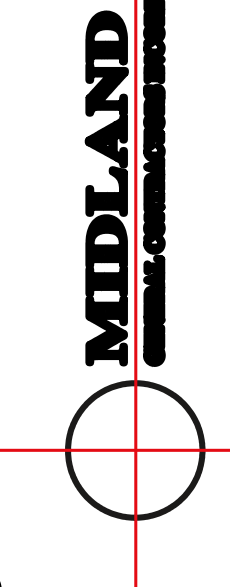

Starbucks & Medical Office  
155 S.W. MO-150 HWY  
LEE'S SUMMIT, MO 64802

No.	Description	Date
1	Owner Review	05/12/20
2	Owner Review 2	06/04/20
3	DEVELOPMENT PLAN RESPONSE	06/17/20
4	Owner Review 3	07/20/20
5	Owner Review 4	08/20/20
6	Owner Review 5	
7	Owner Review 6	

CASCO DIVERSIFIED  
CORPORATION PROFESSIONAL  
ENGINEERING CERTIFICATE OF  
AUTHORITY #000613  
EXP. 12/31/21

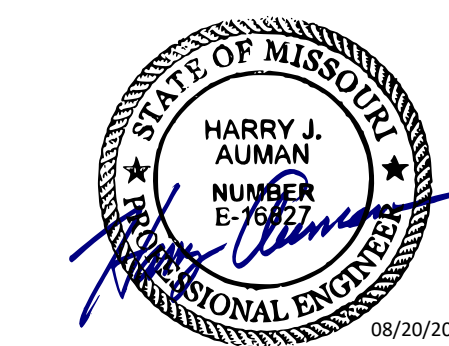


HARRY J. AUMAN  
LIC. #E16827  
EXP. 12/31/20

Drawn By/Checked By: EAV/DAW  
Project Number 320488

Permit Date 06-17-20

SITE  
PHOTOMETRICS

E102

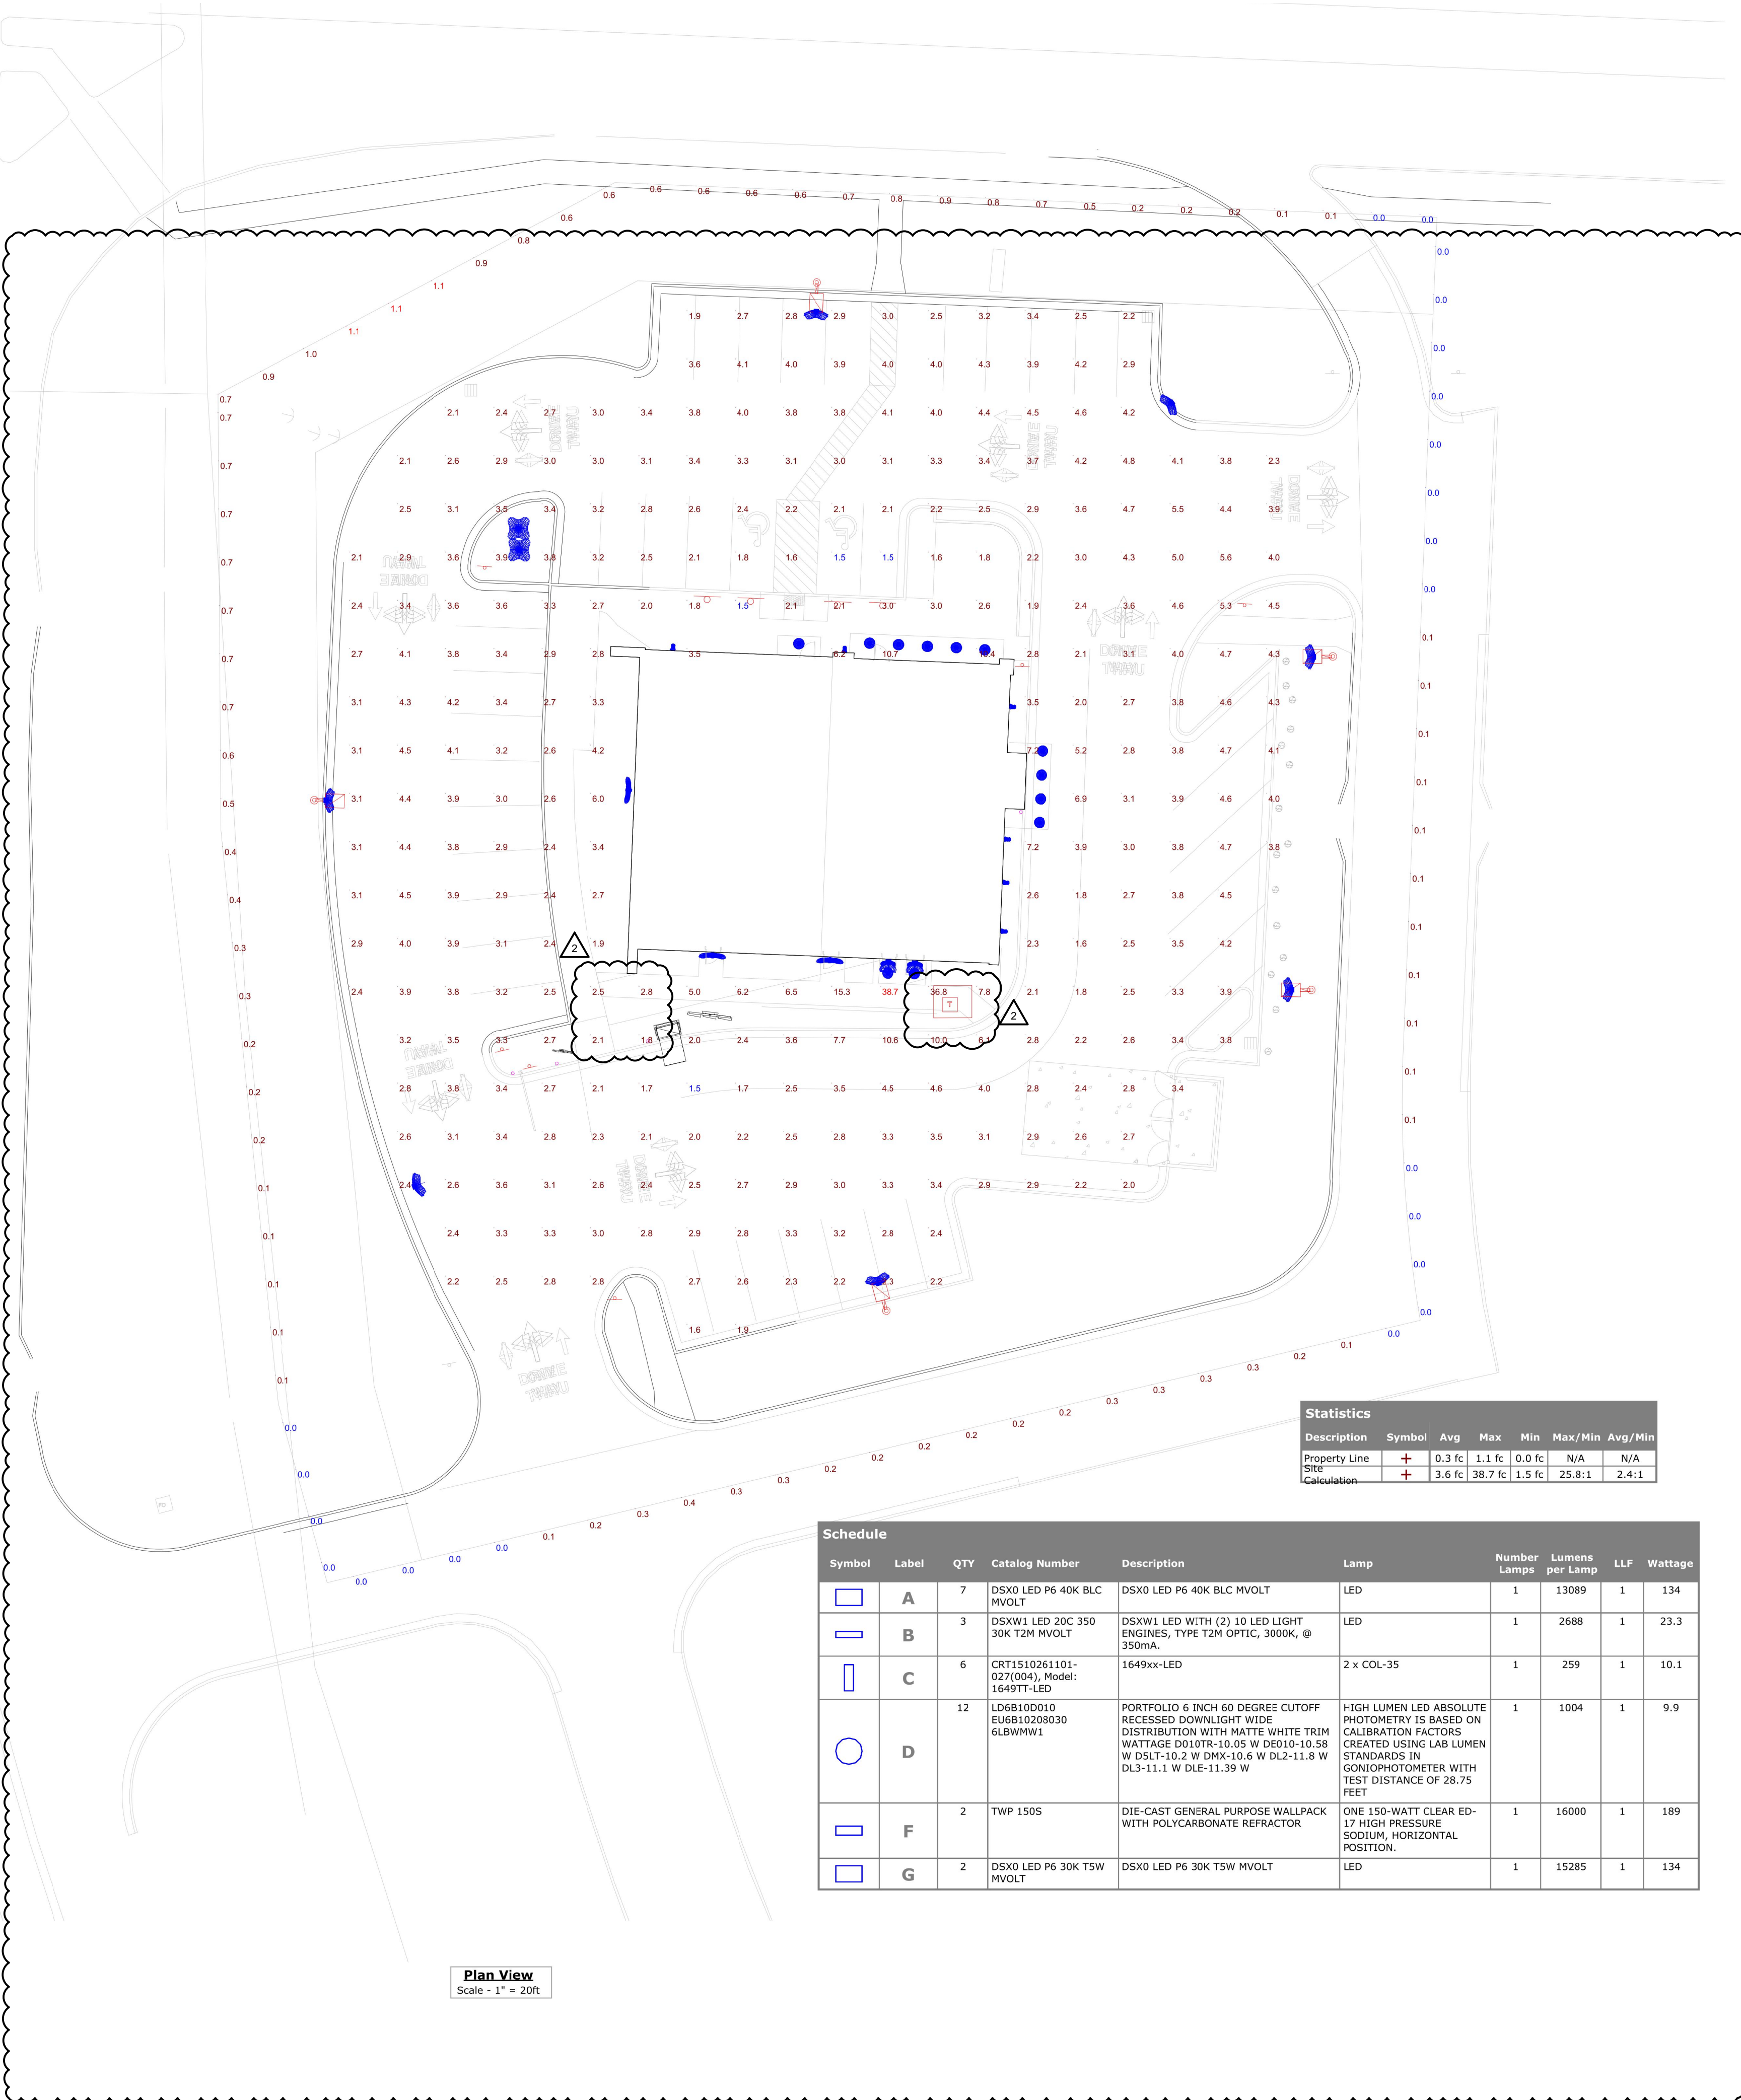

Statistics							
Description	Symbol	Avg	Max	Min	Max/Min	Avg/Min	
Property Line	+	0.3 fc	1.1 fc	0.0 fc	N/A	N/A	
Site	+	3.6 fc	38.7 fc	1.5 fc	25.8:1	2.4:1	
Calculation							

Symbol	Label	QTY	Catalog Number	Description	Lamp	Number Lamps	Lumens per Lamp	LLF	Wattage
	A	7	DSX0 LED P6 40K BLC MVOLT	DSX0 LED P6 40K BLC MVOLT	LED	1	13089	1	134
	B	3	DSXW1 LED 20C 350 30K T2M MVOLT	DSXW1 LED WITH (2) 10 LED LIGHT ENGINES, TYPE T2M OPTIC, 3000K, @ 350mA.	LED	1	2688	1	23.3
	C	6	CRT1510261101-027(004), Model: 1649TT-LED	1649xx-LED	2 x COL-35	1	259	1	10.1
	D	12	LD6B10D010 EU6B10208030 6LBWWW1	PORTFOLIO 6 INCH 60 DEGREE CUTOFF RECESSED DOWNLIGHT WIDE DISTRIBUTION WITH MATTE WHITE TRIM WATTAGE D010TR-10.05 W D010-10.58 W D5LT-10.2 W DMX-10.6 W DL2-11.8 W DL3-11.1 W DLE-11.39 W	HIGH LUMEN LED ABSOLUTE PHOTOMETRY IS BASED ON CALIBRATION FACTORS CREATED USING LAB LUMEN STANDARDS IN GONIOPHOTOMETER WITH TEST DISTANCE OF 28.75 FEET	1	1004	1	9.9
	F	2	TWP 150S	DIE-CAST GENERAL PURPOSE WALLPACK WITH POLYCARBONATE REFRACTOR	ONE 150-WATT CLEAR ED-17 HIGH PRESSURE SODIUM, HORIZONTAL POSITION.	1	16000	1	189
	G	2	DSX0 LED P6 30K TSW MVOLT	DSX0 LED P6 30K TSW MVOLT	LED	1	15285	1	134

## Sheet Notes

- ELECTRICAL UTILITY SEE DETAIL 1/E301.
- FUTURE BUILDING SIGNS MOUNT J-BOX INSIDE BUILDING AND PROVIDE 3/4" MC THROUGH WALL FOR POWER SUPPLY OF FUTURE BUILDING SIGNAGE. COORDINATE EXACT LOCATION AND REQUIREMENTS WITH ARCHITECTURAL ELEVATIONS AND TENANT INFILL DRAWINGS.
- DRIVE THRU WINDOW MOUNT 36" ON THE INSIDE AFF AND 42" ON THE OUTSIDE MEASURED FROM DRIVE-THRU LANE. COORDINATE LOCATION WITH GENERAL CONTRACTOR PRIOR TO INSTALLATION.
- HOLIDAY LIGHTING PROVIDE EXTERIOR J-BOX ON ROOF-SIDE FACE OF PARAPET ABOVE ROOF FLASHING WITH 3/4" EMPTY CONDUIT DOWN INSIDE WALL TO CEILING WITH PULL STRING LABELED HOLIDAY LIGHTING.
- FLY FAN MOUNT BOTTOM OF FIXTURE AT 7'-6" AFF. ROUTE 1/2" C CONDUIT WITH LABELED PULL STRING TO PANEL "SBA". FEEDER TO BE PROVIDED BY TENANT'S GENERAL CONTRACTOR.
- RTU - FACTORY INSTALLED, FIELD WIRED NON-FUSED DISCONNECT AND GFI, WEATHERPROOF RECEPTACLE.
- RETRIEVE EXISTING 4"C FOR TELEPHONE AND DATA SERVICES. EXTEND TO AND CONNECT NEW CONDUIT WITH EXISTING. PROVIDE (2) PULL STRINGS WITH LABELS.
- PATIO FAN VERIFY MOUNTING HEIGHT AND LOCATION WITH TENANT CONSTRUCTION MANAGER PRIOR TO ROUGH-IN.

B


C

D

E

F

G

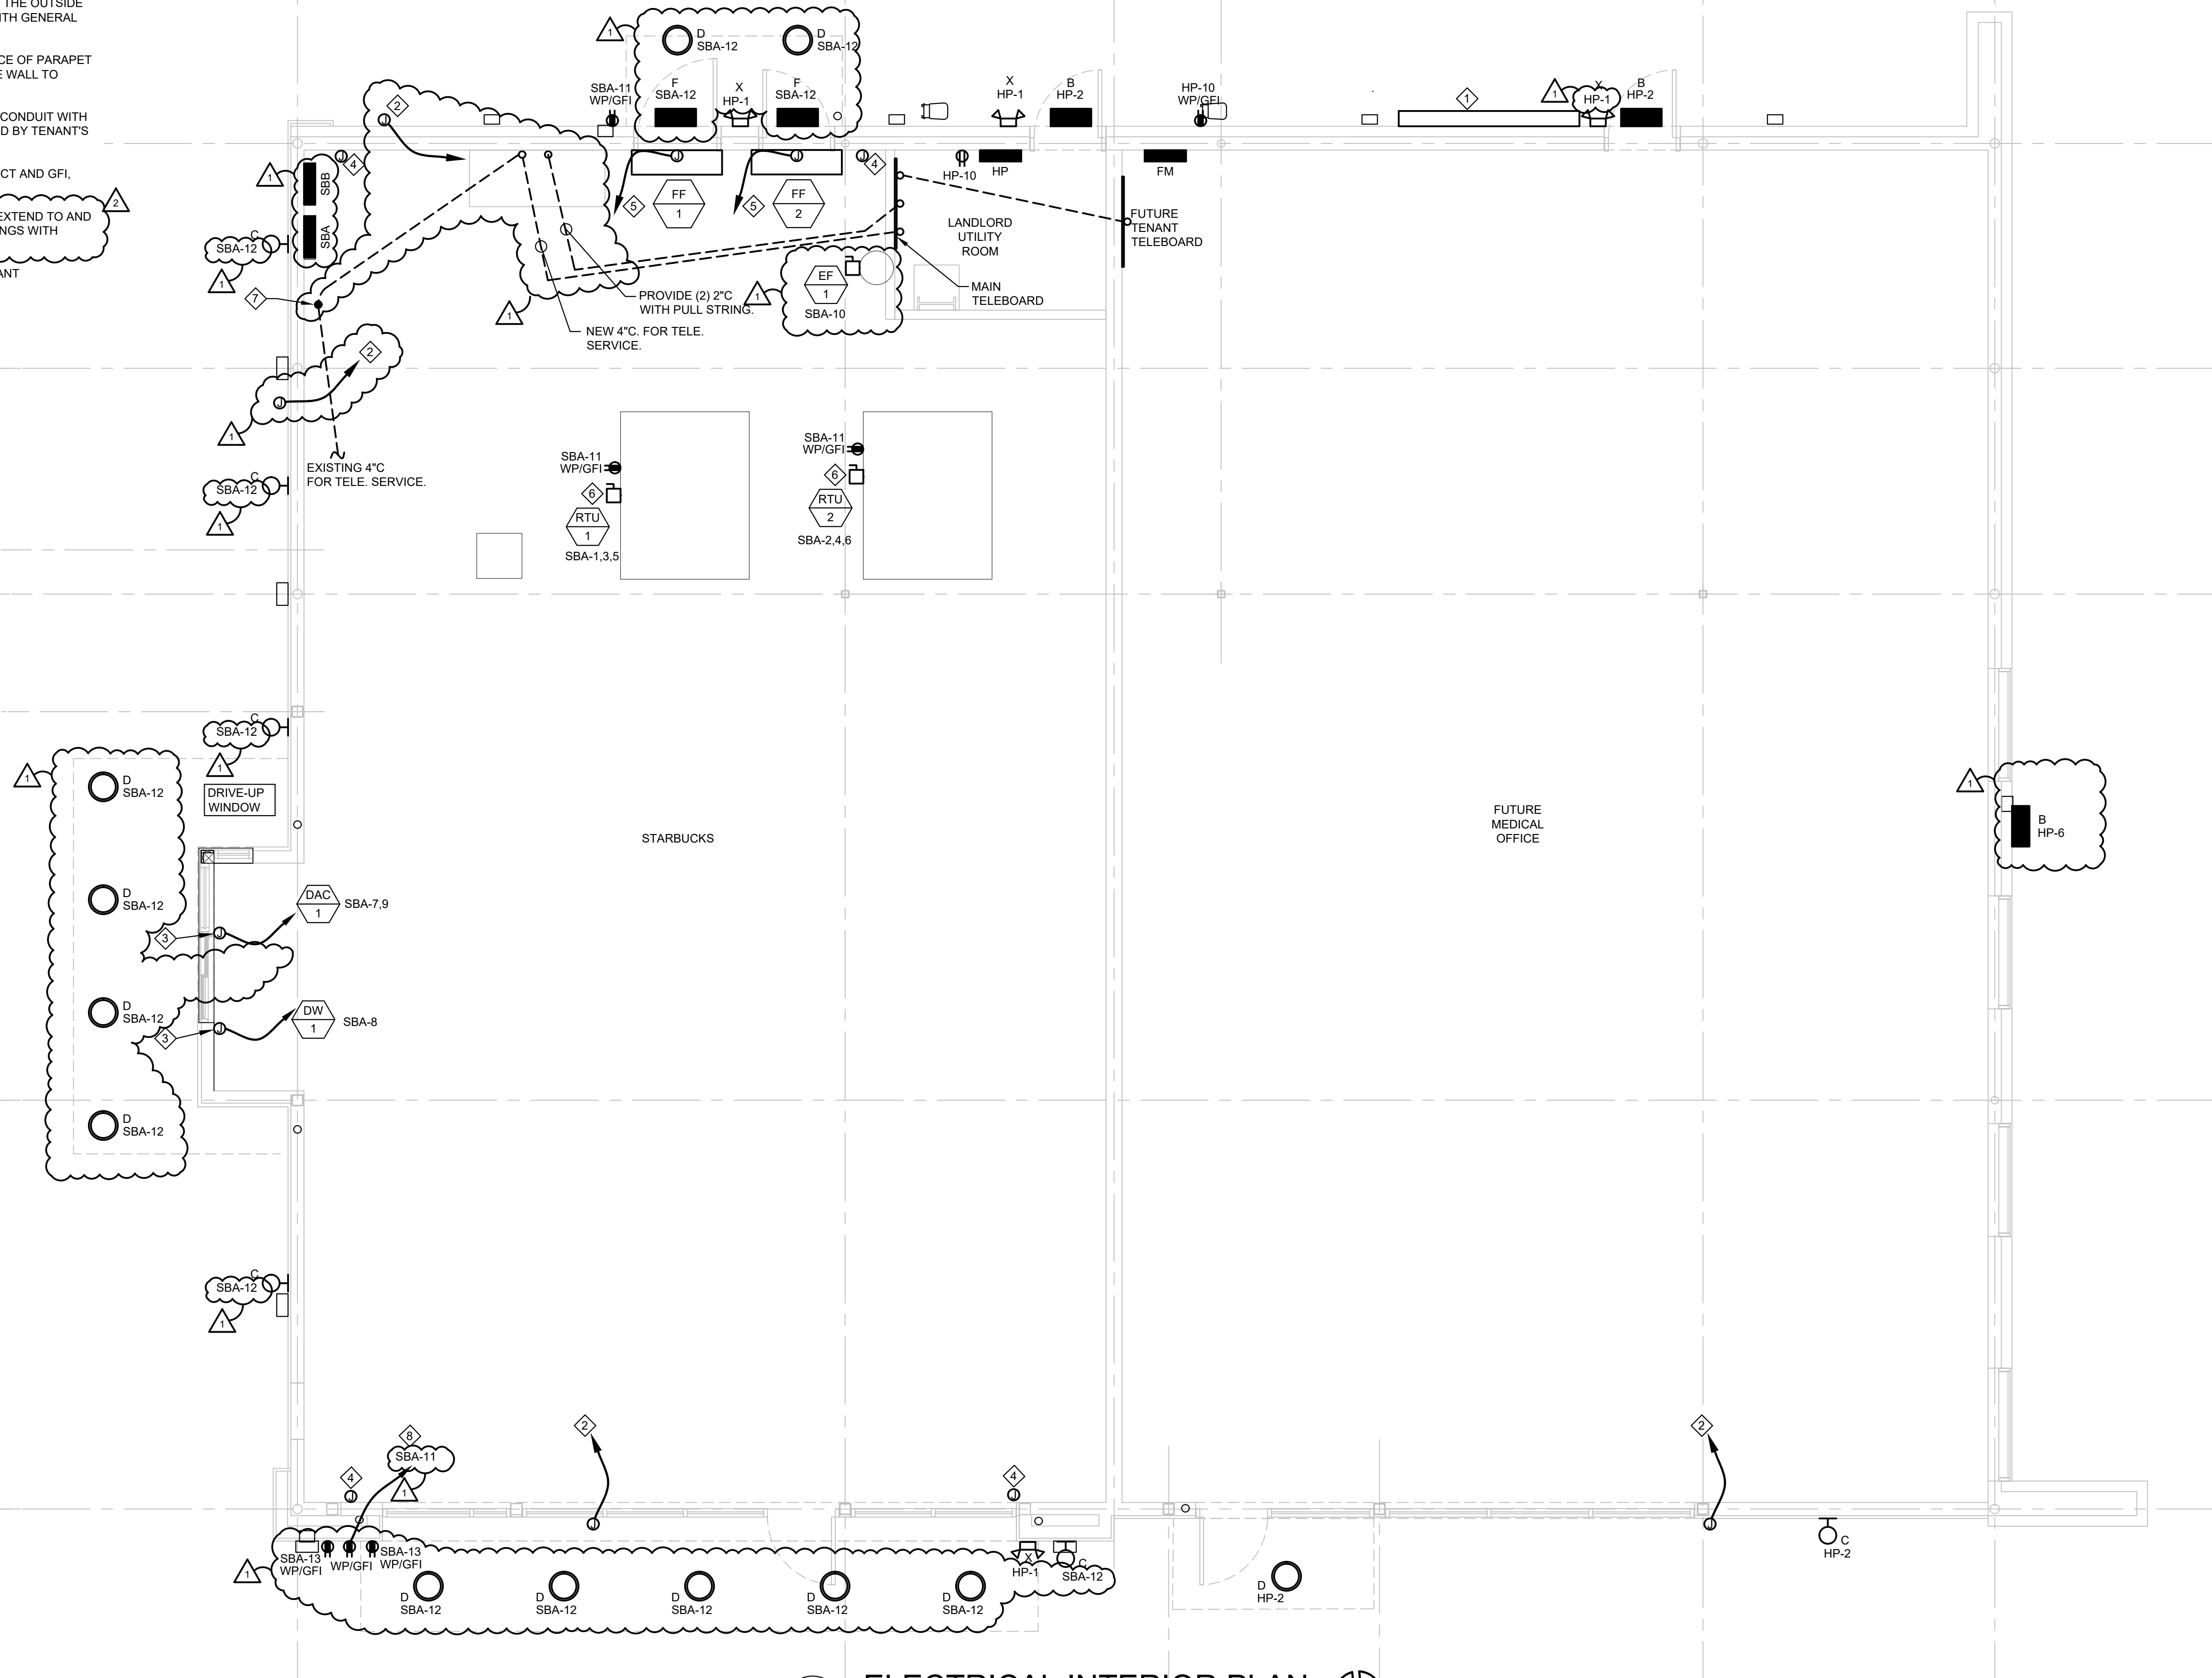

1  
E201

## ELECTRICAL INTERIOR PLAN

SCALE: 1/4" = 1'-0"



### CONSTR. DOC. & REVISIONS

No.	Description	Date
1	Owner Review	05/12/20
2	Owner Review 2	06/04/20
3	Owner Review 3	07/20/20
4	Revision 1	08/06/20
5	Revision 2	
6	Revision 3	
7	Revision 4	
8	Revision 5	

CASCO DIVERSIFIED  
CORPORATION PROFESSIONAL  
ENGINEERING CERTIFICATE OF  
AUTHORITY #000613  
EXP. 12/31/21



HARRY J. AUMAN  
LIC. #E16827  
EXP. 12/31/20


Drawn By/Checked By: EAV/DAW

Project Number 320488

Permit Date 06-17-20

## ELECTRICAL INTERIOR PLAN

# E201

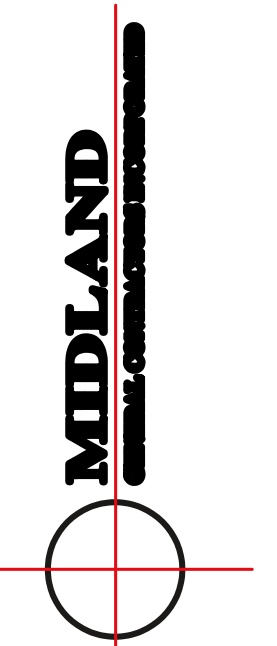

Starbucks & Medical Office  
155 S.W. MO-150 HWY  
LEE'S SUMMIT, MO 64802

No.	Description	Date
1	Owner Review	05/12/20
2	Owner Revision 2	06/04/20
3	Owner Revision 3	07/20/20
6	Owner Revision 6	08/20/20

CASCO DIVERSIFIED  
CORPORATION PROFESSIONAL  
ENGINEERING CERTIFICATE OF  
AUTHORITY #000613  
EXP. 12/31/21




HARRY J. AUMAN  
LIC. #E16827  
EXP. 12/31/20

Drawn By/Checked By: EAV/DAW  
Project Number 320488

Permit Date 06-17-20

ELECTRICAL  
ONE-LINE AND  
DETAILS


E301

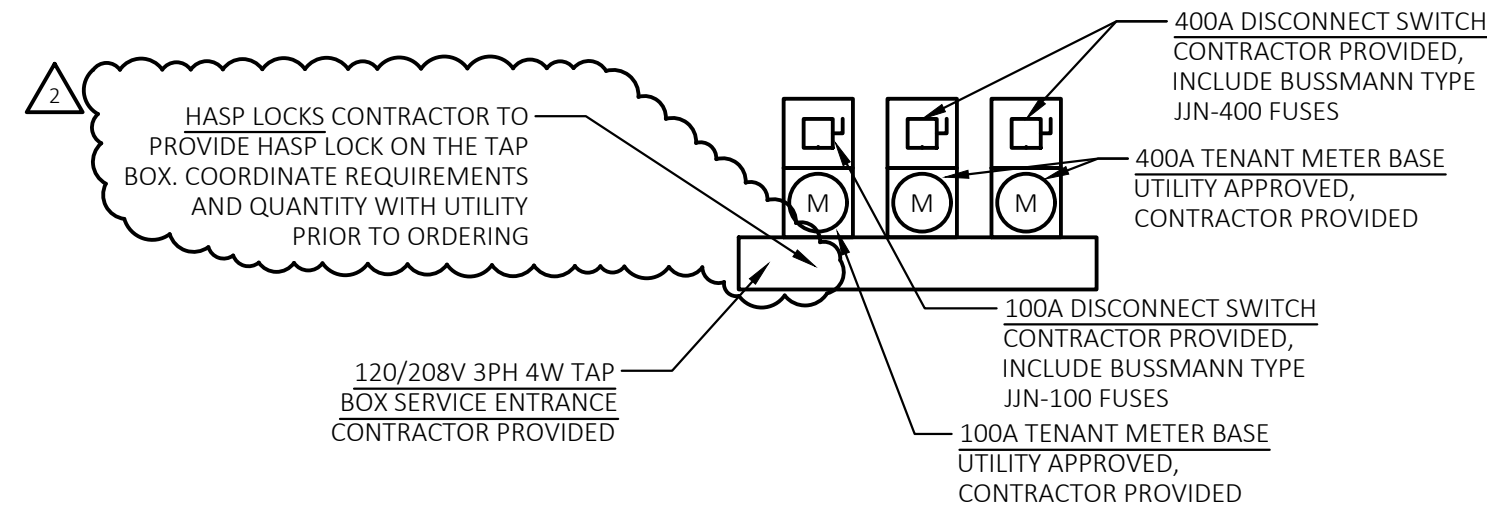

2  
E301  
ENLARGED SERVICE ENTRANCE  
SCALE: NOT TO SCALE


GENERAL GROUNDING NOTES

- FULL SIZE GROUND MEANS THAT GROUND CONNECTOR SIZE SHALL BE AS SHOWN ON SERVICE EQUIPMENT ON THE POWER RISER DIAGRAM.
- AFTER GROUNDING SYSTEM IS INSTALLED, GROUND RESISTANCE SHALL BE MEASURED, TO ASSURE THAT GROUND VALUE OF 15 OHM MAXIMUM RESISTANCE IS ACHIEVED. IF NOT, ADDITIONAL GROUNDING SHALL BE PROVIDED TO MEET THE SPECIFIC VALUE.
- ALL CONNECTIONS TO GROUND RODS SHALL BE EXOTHERMIC WELD CONNECTIONS
- WHERE LOCATED OUTSIDE OF BUILDING, TOP OF GROUND ROD SHALL BE 12" (MINIMUM) BELOW GRADE. PROVIDE NON-METALIC INSPECTION WELL WITH REMOVABLE COVER.
- GROUND CONNECTOR SHALL BE LOCATED WITHIN OR NEAR BOTTOM OF CONCRETE FOUNDATION OR FOOTING THAT IS IN DIRECT CONTACT WITH THE EARTH, AND SHALL CONSIST OF AT LEAST 20 FEET OF ONE OR MORE STEEL REINFORCING BARS OR RODS OF NOT LESS THAN 1/2 INCH DIAMETER OR OF AT LEAST 20 FEET OF BARE COPPER CONDUCTOR.
- SEE THE RISER DIAGRAM DETAIL 1/E301 FOR THE SIZE OF THE MAIN BONDING JUMPER AND BARE COPPER GROUNDING ELECTRODE CONDUCTORS.
- NOT ALL GROUNDING OPTIONS MAY APPLY. CONTRACTOR TO VERIFY AVAILABLE GROUNDING METHODS.

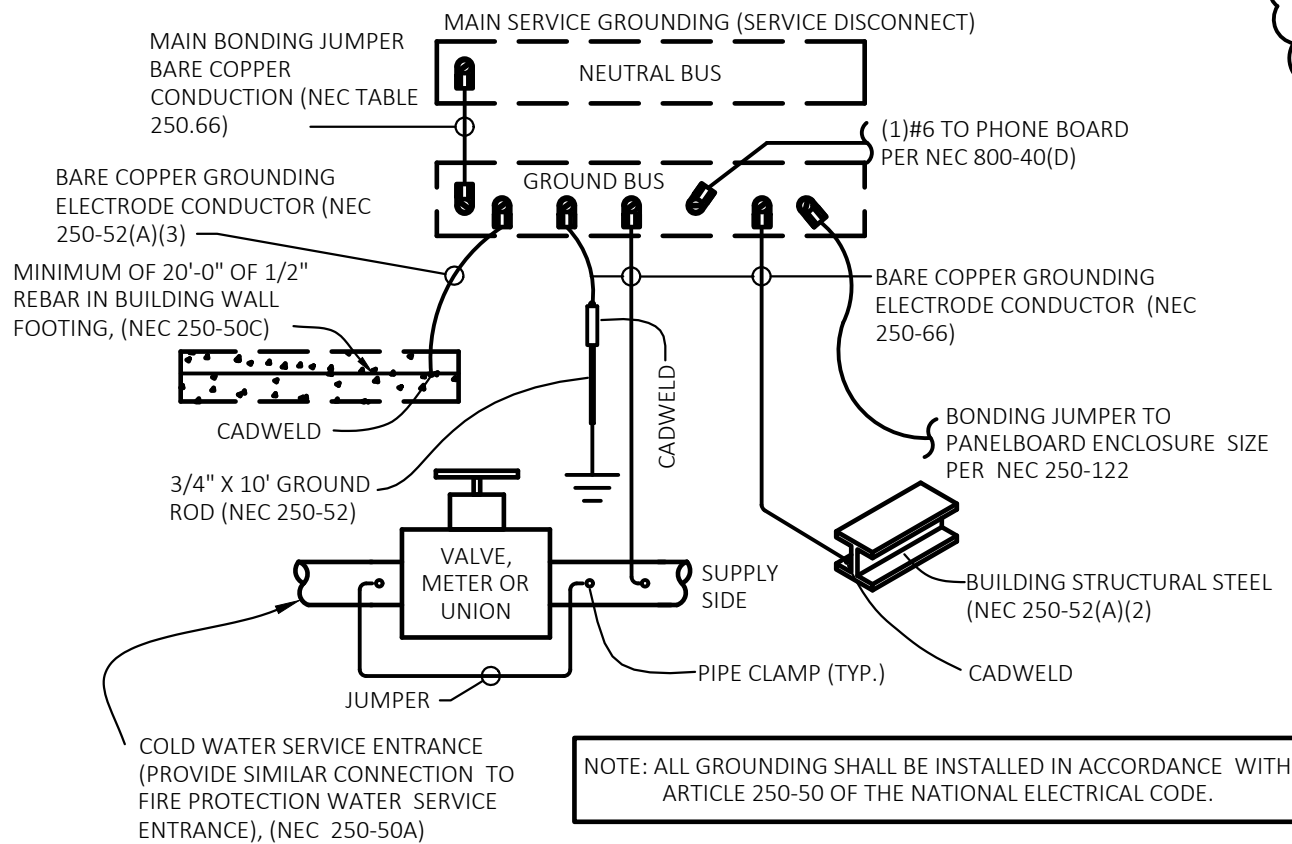


3  
E301  
GROUNDING DETAIL  
SCALE: NOT TO SCALE

ELECTRICAL SYMBOLS (NOT ALL SYMBOLS ARE USED)	
LIGHTNING	CONDUIT
CKT. A LP-1a FIXT. TYPE SWITCH WALL SCONCE CANOPY LIGHT WALL PACK POLE LIGHT EXTERIOR 90 MIN BATTERY BACK-UP EMERGENCY HEADS	( ) CONDUIT CONCEALED IN WALLS OR CEILING (---) CONDUIT UNDER GROUND (LP-1,3) HOME RUN (#1/0 CU.) GROUND
MISCELLANEOUS	GENERAL
○ JUNCTION BOX MOUNT ON WALL AT 18" AFF UNO ▼ TELEPHONE WALL BOX 18" AFF UNO STUB 3/4" CONDUIT UP INTO ACCESSIBLE CEILING AREA WITH INSULATED BUSHING, PROVIDE PULL WIRE ▼ PHONE/DATA WALL BOX 18" AFF UNO STUB 3/4" CONDUIT UP INTO ACCESSIBLE CEILING AREA WITH INSULATED BUSHING, PROVIDE PULL WIRE ▼ DATA WALL BOX 18" AFF UNO STUB 3/4" CONDUIT UP INTO ACCESSIBLE CEILING AREA WITH INSULATED BUSHING, PROVIDE PULL WIRE ☑ CEILING MOUNTED PHONE BOX ⊙ MOTOR	RTU 1 EQUIPMENT CALL OUT ⬠ ELECTRICAL KEYED NOTE DESIGNATION △ REVISION SYMBOL POWER AND CONTROLS ■ PANELBOARD □ DISCONNECT SWITCH RECEPTACLES ⌚ DUPLEX RECEPTACLE 16" AFF TO BOTTOM, UNO. ⌚ GFCI DUPLEX RECEPTACLE 16" AFF TO BOTTOM, UNO ⌚ SPECIAL RECEPTACLE

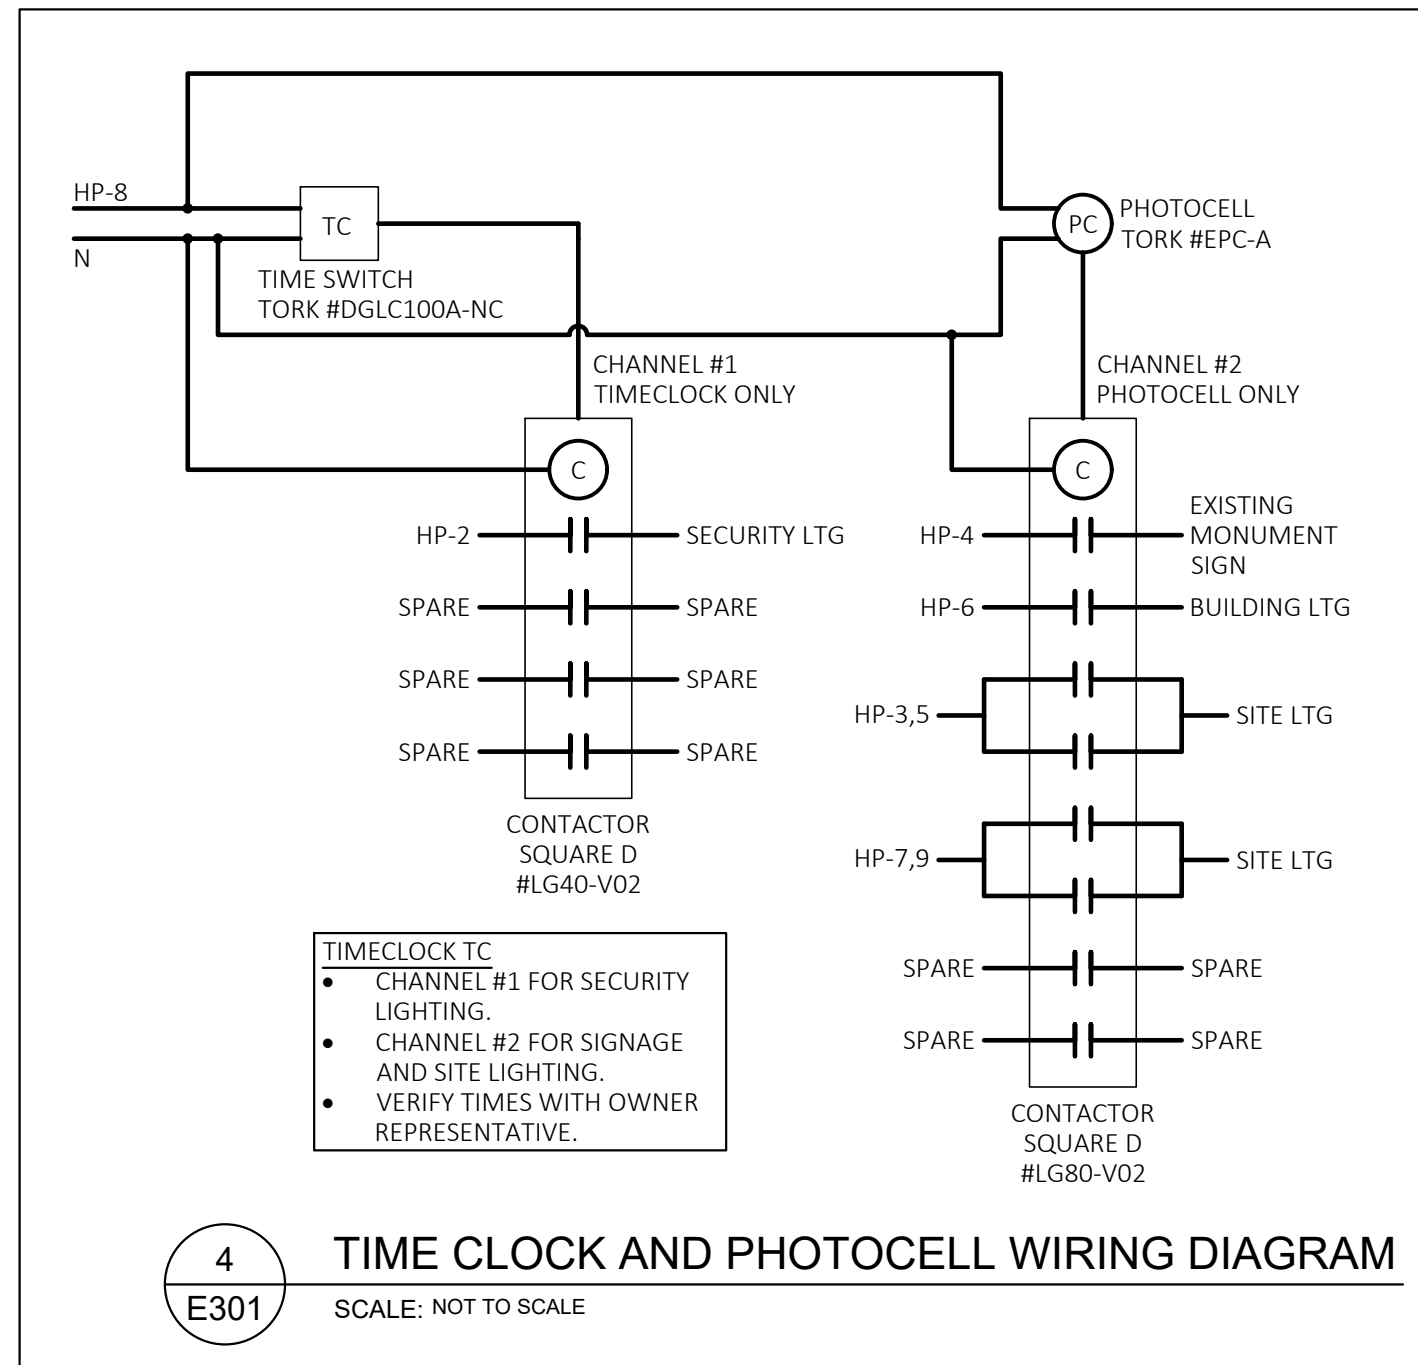

4  
E301  
TIME CLOCK AND PHOTOCELL WIRING DIAGRAM  
SCALE: NOT TO SCALE

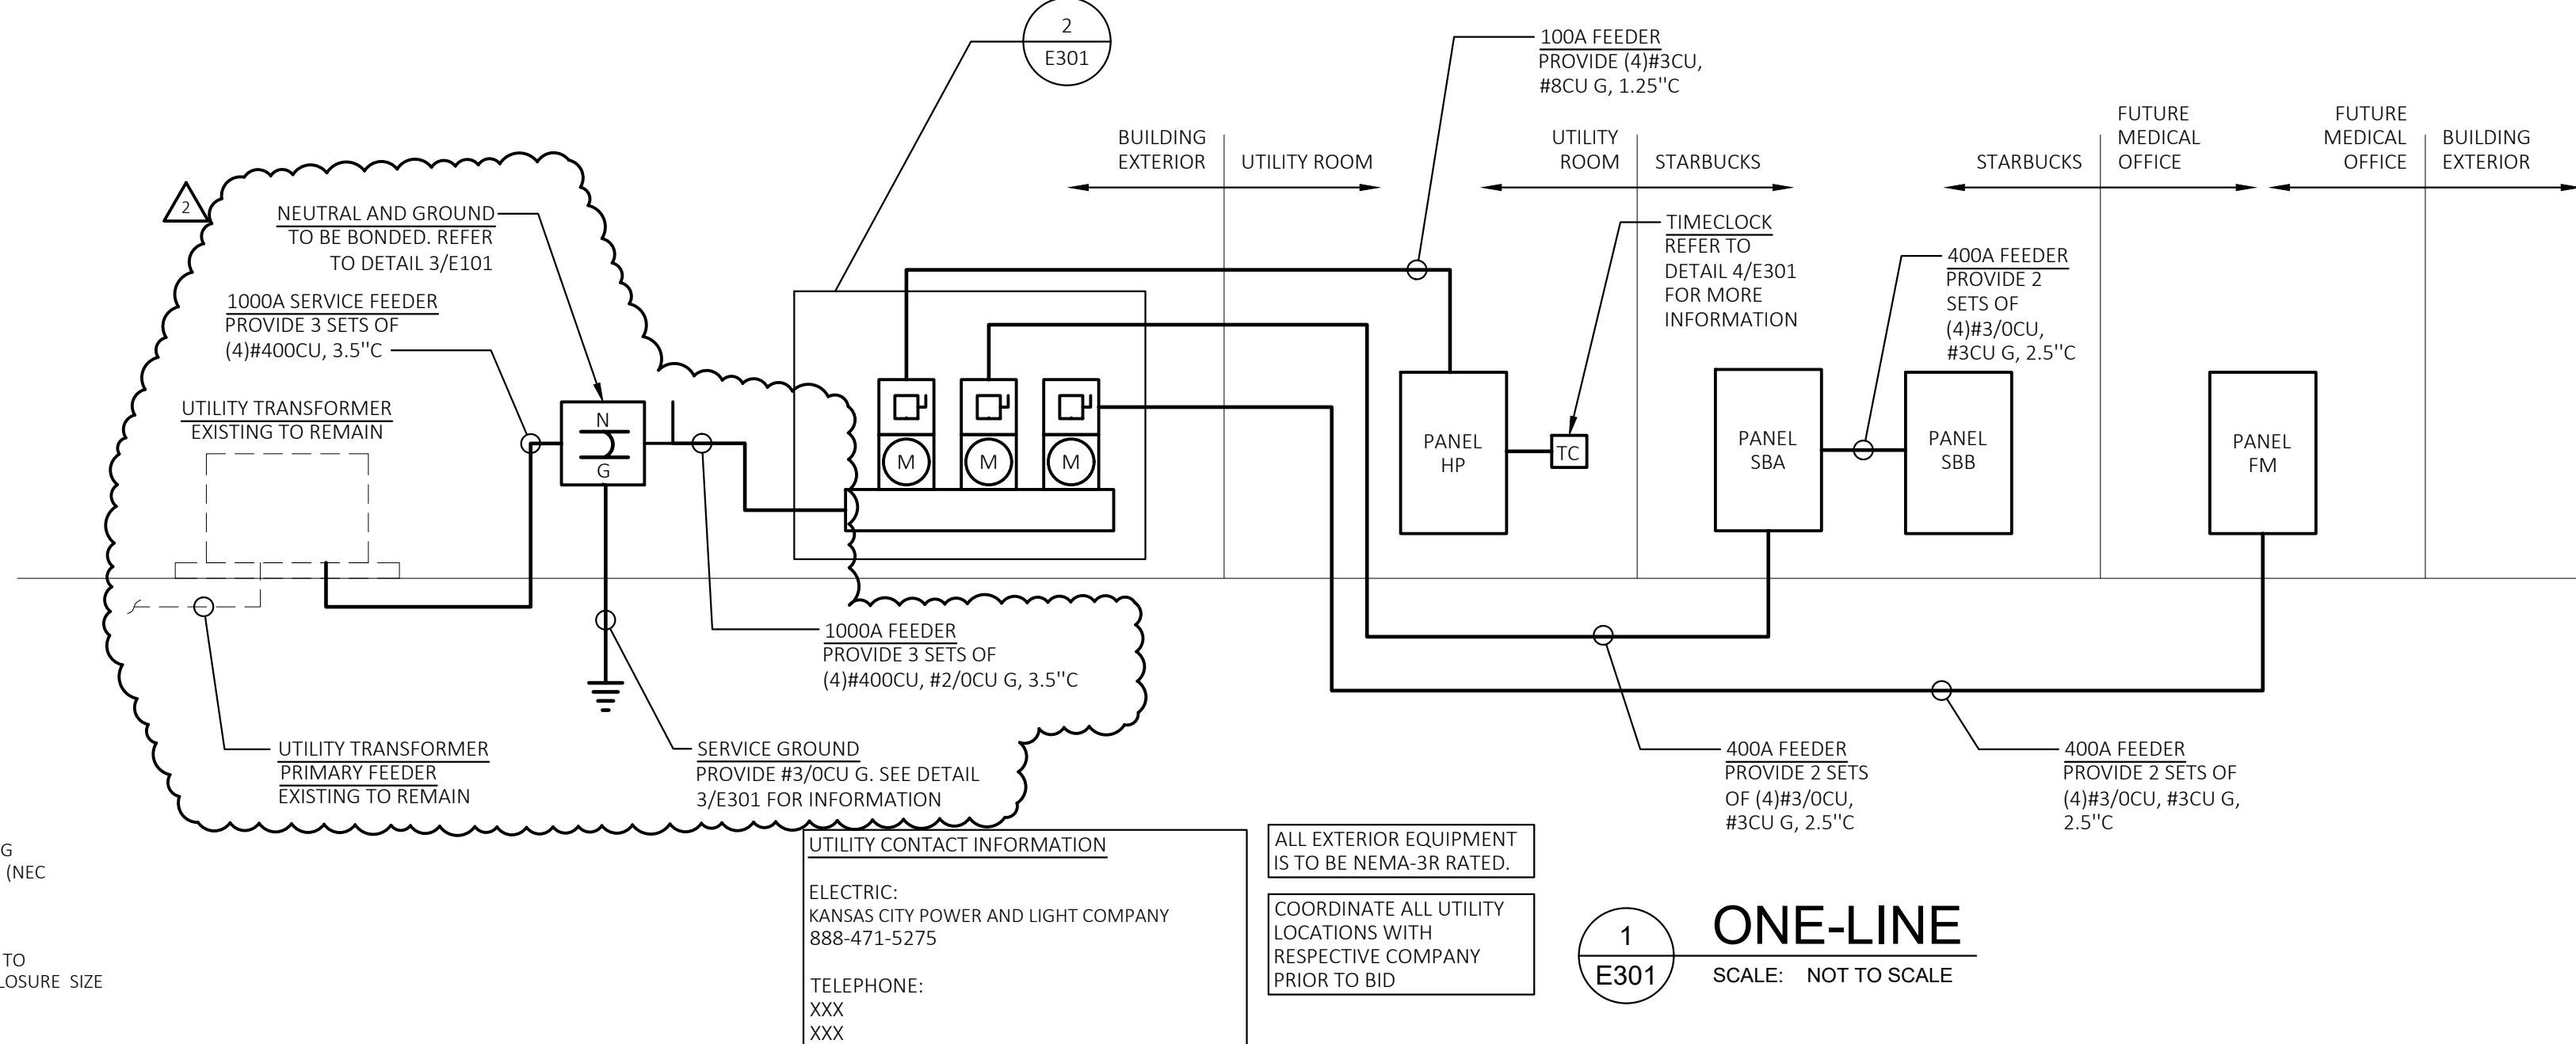

1  
E301  
ONE-LINE  
SCALE: NOT TO SCALE


LIGHTING FIXTURE SCHEDULE						
PLAN MARK	MANUFACTURER	CATALOG NO.	LAMP DATA		REMARKS AND MOUNTING HEIGHT TO BOTTOM OF LIGHT FIXTURE	WATTS PER FIXTURE
			** NO.	WATTAGE & LAMPS		
A	LITHONIA	DSX0 LED-P6-40K-BLC-208-RPA--DDB		LED FURNISHED WITH FIXTURE	13" W x 28" L x 7" H HEAD MOUNTED ON A EXISTING 28" TALL ROUND POLE, 70 CRI, 4000K, 13090 LUMENS, WET LOCATION LISTED. COORDINATE POLE DRILL HOLES WITH THE EXISTING POLES	134
B	LITHONIA	DSXW1 LED-20C-530-30K-T2M-INVOLT-DDBXD		LED FURNISHED WITH FIXTURE	14" W x 7" H x 10" D WALL PACK, 70CRI, 3000K, 3887 LUMENS, SURFACE MOUNTED 8'-0" AFF TO BOTTOM OF FIXTURE UNLESS OTHERWISE NOTED	36
C	HINKLEY LIGHTING, INC.	1649SK-LED		LED FURNISHED WITH FIXTURE	9" W x 24" H x 4" D WALL SCONCE, 70CRI, 2700K, 900 LUMENS, SURFACE MOUNTED 8'-0" AFF TO BOTTOM OF FIXTURE UNLESS OTHERWISE NOTED	11
D	PORTFOLIO	LD6B-15-D010-EU6B-1020-80-30-6LB-W-1-MB		LED FURNISHED WITH FIXTURE	7" W x 6" H DOWN LIGHT MOUNTED WITHIN THE CANOPY 10'-0" AFF UNLESS NOTED OTHERWISE	11
F	LITHONIA	TWP-150S-TB-LPI		HIGH PRESSURE SODIUM	17" W x 16" H x 8" D WALL PACK, 18,000 LUMENS, SURFACE MOUNTED 8'-0" AFF TO BOTTOM OF FIXTURE UNLESS OTHERWISE NOTED	150
G	LITHONIA	HEAD: DSX0 LED-P6-40K-T5W-208-RPA--DDB POLE: RTS-25-5-5-9B-T20-DM28AS-DDBXD		LED FURNISHED WITH FIXTURE	13" W x 28" L x 7" H HEAD MOUNTED ON A EXISTING 28" TALL ROUND POLE, 70 CRI, 4000K, 136704 LUMENS, WET LOCATION LISTED. COORDINATE POLE DRILL HOLES WITH THE EXISTING POLES	134 HEADS: 2 POLE: 1
X	LITHONIA	AFF-OEL-DOBTD-XD-UVOLT-LTP-SDRT-WT-CWD		LED FURNISHED WITH FIXTURE	7" W x 10" H x 4" D EXTERIOR EMERGENCY LIGHT, SURFACE MOUNT WITH BOTTOM OF FIXTURE AT 8'-0" AFF. LITHIUM ION PHOSPHATE BATTERY, OUTPUTS FOR 90 MINUTES AFTER LOSS OF POWER. LISTED FOR COLD WEATHER AND WET LOCATION	12
** LAMPS: LED; I - INCANDESCENT; F - FLUORESCENT; CF - COMPACT FLUORESCENT; MH - METAL HALIDE						
NOTE: A. PRIOR TO THE INSTALLATION OF ALL EXIT SIGNS AND EMERGENCY LIGHTS, THE ELECTRICAL CONTRACTOR SHALL VERIFY WITH THE GC AND FIRE DEPARTMENT INSPECTOR THE FINAL APPROVED LOCATIONS. B. LIGHT FIXTURE QUANTITIES ARE APPROXIMATE CONTRACTOR IS RESPONSIBLE FOR VERIFYING FIXTURE COUNT						

EQUIPMENT SCHEDULE							
PLAN MARK	EQUIPMENT SERVED	LOAD	VOLT/ PHASE	FED BY	DISC BY	MCA	REMARKS
RTU 1	ROOF TOP UNIT	19.45KVA	208/3	SBA	EC	54.0A	60A (3)#4,#8G 1" C
RTU 2	ROOF TOP UNIT	15.20KVA	208/3	SBA	EC	42.2A	50A (3)#6,#8G 3/4" C
FF 1	FLY FAN	0.77KVA	120/1	SBA	EC	6.4A	20A 1/2" C W/ PULL STRINGS
DAC 1	DRIVE-THRU AIR CURTAIN	7.07KVA	208/1	SBA	EC	34.0A	40A (2)#8,#10G 3/4" C
DW 1	DRIVE-THRU WINDQW	0.96KVA	120/1	SBA	EC	8.0A	15A (2)#12,#12G 1/2" C
EF 1	EXHAUST FAN	0.12KVA	120/1	SBA	EC	1.0A	20A (2)#12,#12G 1/2" C

ABBREVIATIONS (NOTE: NOT ALL ABBREVIATIONS ARE USED)			
AFF	ABOVE FINISHED FLOOR	DIM	DIMMER
AL	ALUMINUM	DISC SW	DISCONNECT SWITCH
AMP	AMPERE	DP	DOUBLE POLE
ATS	AUTO-TRANSFER-SWITCH	DT	DOUBLE THROW
BFG	BELOW FINISHED GRADE	DPP	DISTRIBUTION POWER PANEL
BLDG	BUILDING	EC	EMPTY CONDUIT
CB	CIRCUIT BREAKER	EF	EXHAUST FAN
CKT	CIRCUIT	EM	EMERGENCY
CLG	CEILING	EWG	ELECTRIC WATER COOLER
C OND OR "C"	CONDUIT	EXIST'G	EXISTING
CONN	CONNECT	FL	FLOOR
CONT	CONTRACTOR	FLUOR	FLUORESCENT
CU	COPPER	GFCI	GROUND FAULT CURRENT INTERRUPTER
C/T	CURRENT TRANSFORMER	GND OR (G)	GROUND
IG	ISOLATED GROUND	JB	JUNCTION BOX
MCB	MAIN CIRCUIT BREAKER	MDP	MAIN DISTRIBUTION PANEL
MLO	MAIN LUG ONLY	MTD HT	MOUNTING HEIGHT
NF	NON FUSED	NIC	NOT IN CONTRACT
RTU	ROOF TOP UNIT	SW	SWITCH
UG	UNDER GROUND	UNO	UNLESS NOTED OTHERWISE
WP	WEATHER-PROOF	XFMR	TRANSFORMER

No.	Description	Date
1	Owner Review	05/12/20
2	Owner Review	06/04/20
3	Owner Revision	07/20/20

CASCO DIVERSIFIED  
CORPORATION PROFESSIONAL  
ENGINEERING CERTIFICATE OF  
AUTHORITY #000613  
EXP. 12/31/21

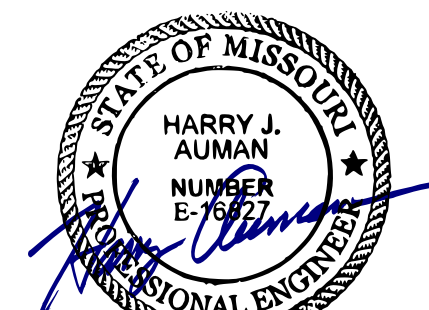

Drawn By/Checked By: EAV/DAW  
Project Number 320488  
Permit Date 06-17-20

ELECTRICAL  
PANEL  
SCHEDULES  
E302

UT. XFRM FAULT CALC		320488 LOAD.xlsm
SERVICE ENTRANCE		CALCULATION
VOLTAGE (L-L):	208V	I-FLA=[RATED KVA * 1000]/
PHASE (PH):	3	[V-L*SQRT(PHASE)]
AMPS:	1000A	I-FLA= 1,388A
FULL LOAD KVA:	360KVA	
TRANSFORMER:	500KVA	M=100%/Z= 80.6
IMPEDANCE (%Z):	1.2%Z	I-SC=I-FLA*M= 10 KA
CALCULATION IS BASED ON ESTIMATED TRANSFORMER SIZE WITH %Z FROM BUSSMANN SPD. CONTRACTOR SHALL CONTACT UTILITY AND VERIFY I-SC AVAILABLE AT SECONDARY OF TRANSFORMER. CONTACT ENGINEER FOR RE-CALCULATION IF LARGER THAN CALCULATED.		

MOTOR LOAD FAULT CALC				320488 LOAD.xlsm
STARTING I-SC:	10 KA	CALCULATION		
MOTOR LOAD (KVA):	42KVA	I-SC(ML)=I-ML*6= 697A		
MOTOR LOAD (A):	116A	I-SC=I-SC+I-SC(ML)= 11 KA		

LL METER CENTER FEEDER FAULT CALC		320488 LOAD.xlsm
STARTING I-SC:	11 KA	IMPEDANCE BASED ON 3 SINGLE CONDUCTORS IN NON-MAGNETIC CONDUIT (WORSE CASE)
VOLTAGE (L-L):	208V	
PHASE (PH):	3	CALCULATION
FEEDER SIZE:	400	
FEEDER MATERIAL:	CU	$f = \frac{[\text{SQRT}(\text{PHASE}) * L * I\text{-}S\text{-}C]}{[Q * C * V\text{-}LL]}$
PARALLEL SETS (Q):	3 SETS	f= 0.079
FEEDER LENGTH (L):	65FT	M=1/(1+f)= 0.926
FEET PER OHMS (C):	24,297 FT/OHMS	I-SC=I-SC*M= 10 KA
NOTE: CALCULATION BASED ON BUSSMANN SPD		

SBA & SBB FEEDER FAULT CALC		320488 LOAD.xlsm
STARTING I-SC:	10 KA	IMPEDANCE BASED ON 3 SINGLE CONDUCTORS IN NON-MAGNETIC CONDUIT (WORSE CASE) CALCULATION
VOLTAGE (L-L):	208V	
PHASE (PH):	3	
FEEDER SIZE:	3/0	
FEEDER MATERIAL:	CU	$f = \frac{\sqrt{[Q(PH \cdot L)] \cdot I_{SC}}}{[Q \cdot C \cdot V - LL]}$
PARALLEL SETS (Q):	2 SETS	
FEEDER LENGTH (L):	60FT	$f = 0.178$
FEET PER OHMS (C):	13,923 FT/OHMS	$M = \frac{1}{(1+f)} = 0.849$
		$I-SC = I-SC \cdot M = 8 \text{ KA}$
NOTE: CALCULATION BASED ON BUSSMANN SPD		

FM FEEDER FAULT CALC		320488 LOAD.xlsm	
STARTING I-SC:	10 KA	IMPEDANCE BASED ON 3 SINGLE CONDUCTORS IN NON-MAGNETIC CONDUIT (WORSE CASE)	
VOLTAGE (L-L):	208V		
PHASE (PH):	3		
FEEDER SIZE:	3/0	CALCULATION	
FEEDER MATERIAL:	CU	$f = \frac{[\text{SQRT}(\text{PHASE}) * L * I\text{-}S\text{-}C]}{[Q * C * V\text{-}LL]}$	
PARALLEL SETS (Q):	2 SETS		
FEEDER LENGTH (L):	30FT	$f = 0.089$	
FEET PER OHMS (C):	13,923 FT/OHMS	$M = \frac{1}{(1+f)} = 0.918$	
		$I\text{-}S\text{-}C = I\text{-}S\text{-}C * M = 9 \text{ KA}$	
NOTE: CALCULATION BASED ON BUSSMANN SPD			

HP FEEDER FAULT CALC		320488 LOAD.xlsm
STARTING I-SC:	10 KA	IMPEDANCE BASED ON 3 SINGLE CONDUCTORS IN NON-MAGNETIC CONDUIT (WORSE CASE)  CALCULATION  $f = \frac{[\sqrt{(\text{PHASE}) * L * I\text{-}S\text{-}C]}{[Q * C * V\text{-}LL]}$  $f = 0.515$  $M = \frac{1}{(1 + f)} = 0.660$  $I\text{-}SC = I\text{-}SC * M = 7 \text{ KA}$
VOLTAGE (L-L):	208V	
PHASE (PH):	3	
FEEDER SIZE:	3	
FEEDER MATERIAL:	CU	
PARALLEL SETS (Q):	1 SETS	
FEEDER LENGTH (L):	30FT	
FEET PER OHMS (C):	4,811 FT/OHMS	
NOTE: CALCULATION BASED ON BUSSMANN SPD		

MOUNT: SURFACE				120/208	3-PHASE, 4W	PANEL	FM	CAPACITY: 400A				INT CAP: 200KA				NOTE
LOCATION: FUTURE MEDICAL OFFICE								DEMAND LOAD: A				AV. FAULT: 9KA				
CKT	LTG	REC	HVAC	MISC	NP	DESCRIPTION	AMP POLE	AMP POLE	DESCRIPTION	LTG	REC	HVAC	MISC	NP	CKT	
1						SPARE	20	1	A	20	1				2	
3						SPARE	20	1	B	20	1				4	
5						SPARE	20	1	C	20	1				6	
7						SPARE	20	1	A	20	1				8	
9						SPARE	20	1	B	20	1				10	
11						SPARE	20	1	C	20	1				12	
13						SPARE	20	1	A	20	1				14	
15						SPARE	20	1	B	20	1				16	
17						SPARE	20	1	C	20	1				18	
19						SPARE	20	1	A	20	1				20	
21						SPARE	20	1	B	20	1				22	
23						SPARE	20	1	C	20	1				24	
25						SPARE	20	1	A	20	1				26	
27						SPARE	20	1	B	20	1				28	
29						SPARE	20	1	C	20	1				30	
31						SPARE	20	1	A	20	1				32	
33						SPARE	20	1	B	20	1				34	
35						SPARE	20	1	C	20	1				36	
37						SPARE	20	1	A	20	1				38	
39						SPARE	20	1	B	20	1				40	
41						SPARE	20	1	C	20	1				42	
43						SPARE	20	1	A	20	1				44	
45						SPARE	20	1	B	20	1				46	
47						SPARE	20	1	C	20	1				48	
49						SPARE	20	1	A	20	1				50	
51						SPARE	20	1	B	20	1				52	
53						SPARE	20	1	C	20	1				54	
55						SPARE	20	1	A	20	1				56	
57						SPARE	20	1	B	20	1				58	
59						SPARE	20	1	C	20	1				60	
61						SPARE	20	1	A	20	1				62	
63						SPARE	20	1	B	20	1				64	
65						SPARE	20	1	C	20	1				66	
67						SPARE	20	1	A	20	1				68	
69						SPARE	20	1	B	20	1				70	
71						SPARE	20	1	C	20	1				72	
73						SPARE	20	1	A	20	1				74	
75						SPARE	20	1	B	20	1				76	
77						SPARE	20	1	C	20	1				78	
79						SPARE	20	1	A	20	1				80	
81						SPARE	20	1	B	20	1				82	
83						SPARE	20	1	C	20	1				84	

PHASE BALANCE				LOAD TYPE	CONNECTED	DEMAND	DEMAND FORMULA	TOTAL LOAD	
Φ	LOAD	%	RECEPTACLE	LIGHTING	0.0 KVA	0.0 KVA	LOAD X 125% NEC 210.19 CONTINUOUS	CONNECTED	DEMAND
A	0.0 KVA	####	HVAC		0.0 KVA	0.0 KVA	10KVA + 50% REMAINDER NEC 220.44	0.0 KVA	0.0KVA
B	0.0 KVA	####	MISC		0.0 KVA	0.0 KVA	LOAD X 80% (USED MCA IN CALCULATION)	0.0A	0.0A
C	0.0 KVA	####	NP		0.0 KVA	0.0 KVA	LOAD X 100% NEC 210.19 NON-CONT.	FILENAME:	
					0.0 KVA	0.0 KVA	0 NONCOINCIDENTAL LOADS NEC 220.60	320488 LOAD.xlsm	

NOTES:  
A. AIC RATING: STANDARD 10,000 AIC CIRCUIT BREAKERS. SERIES RATED AT 200,000 AMPS WITH BUSSMANN JJJN-400 FUSES.

MOUNT: SURFACE				120/208	3-PHASE, 4W	PANEL	HP	CAPACITY: 100A				INT CAP: 200KA				NOTE
LOCATION: LANDLORD UTILITY ROOM								DEMAND LOAD: 12A				AV. FAULT: 7KA				
CKT	LTG	REC	HVAC	MISC	NP	DESCRIPTION	AMP POLE	AMP POLE	DESCRIPTION	LTG	REC	HVAC	MISC	NP	CKT	
1	0.1					EGRESS EMERG. LTG	20	1	A	20	1				2	TC
3	0.4						20	2	B	20	1				4	TC
5	0.4					SITE LIGHTING	20	2	C	20	1				6	TC
7	0.2					SITE LIGHTING	20	2	A	20	1				8	
9	0.2						20	2	B	20	1				10	
11						SPARE	20	1	C	20	1				12	
13						SPARE	20	1	A	20	1				14	
15						SPARE	20	1	B	20	1				16	
17						SPARE	20	1	C	20	1				18	
19						SPARE	20	1	A	20	1				20	
21						SPARE	20	1	B	20	1				22	
23						SPARE	20	1	C	20	1				24	
25						SPARE	20	1	A	20	1				26	
27						SPARE	20	1	B	20	1				28	
29						SPARE	20	1	C	20	1				30	
31						SPARE	20	1	A	20	1				32	
33						SPARE	20	1	B	20	1				34	
35						SPARE	20	1	C	20	1				36	
37						SPARE	20	1	A	20	1				38	
39						SPARE	20	1	B	20	1				40	
41						SPARE	20	1	C	20	1				42	

PHASE BALANCE			LOAD TYPE	CONNECTED	DEMAND	DEMAND FORMULA	TOTAL LOAD	
Φ	LOAD	%	LIGHTING	2.9 KVA	3.6 KVA	LOAD X 125% NEC 210.19 CONTINUOUS	CONNECTED	DEMAND
			RECEPTACLE	0.4 KVA	0.4 KVA	10KVA + 50% REMAINDER NEC 220.44	3.4 KVA	4.2KVA
			HVAC <td>0.0 KVA</td> <td>0.0 KVA</td> <td>LOAD X 80% (USED MCA IN CALCULATION)</td> <td>9.6A</td> <td>11.6A</td>	0.0 KVA	0.0 KVA	LOAD X 80% (USED MCA IN CALCULATION)	9.6A	11.6A
			MISC <td>0.2 KVA</td> <td>0.2 KVA</td> <td>LOAD X 100% NEC 210.19 NON-CONT.</td> <td colspan="2">FILENAME:</td>	0.2 KVA	0.2 KVA	LOAD X 100% NEC 210.19 NON-CONT.	FILENAME:	
A	0.7 KVA	16%	HVAC	0.0 KVA	0.0 KVA	0 NONCOINCIDENTAL LOADS NEC 220.60	320488	LOAD.xlsnm
B	2.6 KVA	63%	MISC	0.2 KVA	0.2 KVA			
C	0.9 KVA	21%	NP	0.0 KVA	0.0 KVA			