**LEGEND:** 

# CHIPMAN RD NE1/4 1ST 1.99 MI. MGRS BM JA-136

LOCATION MAP

SCALE 1" = 2000'

## **UTILITY CONTACTS:**

MISSOURI DEPARTMENT OF TRANSPORTATION (MODOT) Steve Holloway 600 NE Colbern Road Lee's Summit, MO 64086 (816) 607-2186

MISSOURI GAS ENERGY (MGE) Brent Jones 3025 SE Clover Drive Lee's Summit, MO 64082 (816) 399-9633 brent.jones@spireenergy.com

KANSAS CITY POWER & LIGHT COMPANY (KCP&L) Ron Dejarnette 1300 SE Hamblin Road

Lee's Summit. MO 64081 Office: (816) 347-4316 Cell: (816) 810-5234 ron.dejarnette@kcpl.com

CITY OF LEES SUMMIT PUBLIC WORKS Dena Mezger 220 SE Green Street Lee's Summit, MO 64063

(816) 969-1800 AT&T Mark Manion or Marty Loper

**COMCAST CABLE** Barbara Brown 3400 W. Duncan Road Blue Springs, MO 64015

(816) 275-2341 or (816) 275-1550

500 E. 8th Street, Room 370

Kansas City, MO 64106

(816) 795-2255 PUBLIC WATER SUPPLY DISTRICT

Mark Schaufler 220 SE Green Street Lee's Summit, MO 64063 (816) 969-1900

#### **SUMMARY OF QUANTITIES** QUANTITY UNITS CONNECT TO EXISTING MANHOLE EA STANDARD 4' DIA. MANHOLE EA LF 8" PVC SDR-26 6" PVC SDR-26 8" X 6" WYE CONNECTION EA EXTRA DEPTH IN MANHOLE VF EROSION CONTROL LS 14 BONDS LS ROCK EXCAVATION (ESTIMATED-NO BORINGS AVAILABLE) CY CLEAR AND GRUB LS COMPACTION TESTING LS PREBLAST SURVEY (IF REQUIRED) LS

# SANITARY MAIN EXTENSION PLANS WINTERSET VALLEY, 13TH PLAT

## IN THE CITY OF LEE'S SUMMIT JACKSON COUNTY, MISSOURI

#### GENERAL NOTES:

- ALL CONSTRUCTION TO FOLLOW THE CITY OF LEE'S SUMMIT DESIGN AND CONSTRUCTION MANUAL AS
- ALL WORKMANSHIP AND MATERIALS SHALL BE SUBJECT TO THE INSPECTION AND APPROVAL OF THE ENGINEERING DEPARTMENT OF THE CITY OF LEE'S SUMMIT, MISSOURI.
- LINEAL FOOT MEASUREMENTS SHOWN ON THE PLANS ARE HORIZONTAL MEASUREMENTS, NOT SLOPE MEASUREMENTS. ALL PAYMENTS SHALL BE MADE ON HORIZONTAL MEASUREMENTS.
- NO GEOLOGICAL INVESTIGATION HAS BEEN PERFORMED ON THE SITE.
- THE UTILITY LOCATIONS SHOWN ON THESE PLANS ARE TAKEN FROM UTILITY COMPANY RECORDS AND APPARENT FIELD LOCATIONS. THE CONTRACTOR SHALL VERIFY THE LOCATION AND DEPTH OF ALL UTILITIES
- EXCAVATION ON PUBLIC RIGHT OF WAY DO SO ONLY AFTER GIVING NOTICE TO, AND OBTAINING INFORMATION FROM, UTILITY COMPANIES. STATE LAW REQUIRES 48 HOURS ADVANCE NOTICE. THE
- SIGNED SHOP DRAWINGS SHALL BE PROVIDED TO THE CITY INSPECTOR UPON REQUEST.
- WITHOUT PERMISSION OF THE OWNER, UNLESS SHOWN OTHERWISE
- CLEARING AND GRUBBING OPERATIONS AND DISPOSAL OF ALL DEBRIS THEREFROM SHALL BE PERFORMED BY THE CONTRACTOR IN STRICT ACCORDANCE WITH ALL LOCAL CODES AND ORDINANCES.
- ALL WASTE MATERIAL RESULTING FROM THE PROJECT SHALL BE DISPOSED OF OFF-SITE BY THE CONTRACTOR, OR AS DIRECTED BY THE OWNER.
- 11. ALL EXCAVATIONS SHALL BE UNCLASSIFIED. NO SEPARATE PAYMENT WILL BE MADE FOR ROCK
- 12. THE CONTRACTOR SHALL CONTROL THE EROSION AND SILTATION DURING ALL PHASED OF CONSTRUCTION AND SHALL KEEP THE STREETS CLEAN OF MUD AND DEBRIS.
- 13. ALL MANHOLES, CATCH BASINS, UTILITY VALVES AND METER PITS TO BE ADJUSTED OR REBUILT TO GRADE
- 14. THE CONTRACTOR SHALL CONTACT DEVELOPMENT SERVICES INSPECTIONS AT: 816-969-1800 TO OBTAIN A DEVELOPMENT SERVICES CONSTRUCTION PERMIT. A MINIMUM 48 HOUR NOTICE SHALL BE GIVEN PRIOR TO
- THE CONTRACTOR SHALL CONTACT THE CITY'S EROSION CONTROL SPECIALIST AT: 816-969-1800 PRIOR TO ANY LAND DISTURBANCE.
- 16. THE CONTRACTOR SHALL CONTACT THE RIGHT OF WAY INSPECTOR AT 816-969-1800 PRIOR TO ANY LAND DISTURBANCE ACTIVITIES WITHIN THE RIGHT OF WAY. THESE ACTIVITIES MAY REQUIRE A PERMIT.
- 17. THE CONTRACTOR SHALL PROVIDE AND MAINTAIN ALL TRAFFIC HANDLING MEASURES NECESSARY TO ENSURE THAT THE GENERAL PUBLIC IS PROTECTED AT ALL TIMES. TRAFFIC CONTROL SHALL CONFORM TO THE MANUAL ON UNIFORM TRAFFIC CONTROL DEVICES (MUTCD-LATEST EDITION).

PREPARED AND SUBMITTED BY:

**Sheet List Table** 

COVER

**GENERAL LAYOUT** 

**GRADING PLAN** 

LINE A AND B PLAN AND PROFILE

SANITARY DETAILS

SANITARY DETAILS



SCHLAGEL & ASSOCIATES, P.A.

APPROVED BY

CITY ENGINEER APPROVED FOR ONE YEAR FROM THIS DATE

### OWNER/DEVELOPER:

GALE COMMUNITIES, INC. DAVID GALE 400 SW LONGVIEW BLVD, STE 109 LEE'S SUMMIT, MO 64081 p 816.645.2336

DGALE@GALECOMMUNITIES.COM

- **UTILITIES**: EXISTING UTILITIES HAVE BEEN SHOWN TO THE GREATEST EXTENT POSSIBLE BASED UPON INFORMATION PROVIDED TO THE ENGINEER. THE CONTRACTOR IS RESPONSIBLE FOR CONTACTING THE RESPECTIVE UTILITY COMPANIES AND FIELD LOCATING UTILITIES PRIOR TO CONSTRUCTION AND IDENTIFYING ANY POTENTIAL CONFLICTS. ALL CONFLICTS SHALL IMMEDIATELY BE BROUGHT TO THE ATTENTION OF THE
- THE CONTRACTOR SHALL BE RESPONSIBLE FOR COORDINATING ANY REQUIRED UTILITY RELOCATIONS. UTILITIES DAMAGED THROUGH THE NEGLIGENCE OF THE CONTRACTOR SHALL BE REPAIRED AT THE
- CONTRACTOR'S EXPENSE. CONTRACTOR SHALL VERIFY FLOW-LINES AND STRUCTURE TOPS PRIOR TO CONSTRUCTION, AND SHALL NOTIFY ENGINEER OF ANY DISCREPANCIES. PROVIDE SHOP DRAWINGS FOR ALL PRECAST AND MANUFACTURED UTILITY STRUCTURES FOR REVIEW BY THE ENGINEER PRIOR TO CONSTRUCTION OF THE
- UTILITY SEPARATION: WATERLINES SHALL HAVE A MINIMUM OF 10 FEET HORIZONTAL AND 2 FEET VERTICAL SEPARATION FROM ALL SANITARY AND STORM SEWER LINES. IF MINIMUM SEPARATIONS CAN NOT BE OBTAINED, A CONTINUOUS CASING PIPE MUST BE USED ON THE WATER LINE AND EXTEND NO LESS THAN 10 FEET IN EACH DIRECTION FROM THE CROSSING OF THE SANITARY OR STORM SEWER LINE IN CONFLICT.
- PAYMENT FOR TRENCHING, BACKFILLING, PIPE EMBEDMENT, FLOWABLE FILL, BACKFILL MATERIALS, CLEAN UP, SEEDING, SODDING AND ANY OTHER ITEMS NECESSARY FOR THE CONSTRUCTION OF THE UTILITY LINE SHALL BE INCLUDED IN THE CONTRACT PRICE FOR THE UTILITY INSTALLATION.
- THE CONTRACTOR SHALL BE RESPONSIBLE FOR CONTACTING RESPECTIVE UTILITY COMPANIES 48-HOURS IN ADVANCE FOR THE INSPECTION OF ANY PROPOSED UTILITY MAIN EXTENSION OR SERVICE LINE OR SERVICE CONNECTION TO ANY EXISTING MAIN.
- TRENCH SPOILS SHALL BE NEATLY PLACED ONSITE ADJACENT TO THE TRENCH, AND COMPACTED TO PREVENT SATURATION AND EXCESS SEDIMENT RUNOFF. UNSUITABLE MATERIALS, EXCESS ROCK AND SHALE, ASPHALT, CONCRETE, TREES, BRUSH ETC. SHALL BE PROPERLY DISPOSED OF OFFSITE. MATERIALS MAY BE WASTED ONSITE AT THE DIRECTION OF THE OWNER OR HIS APPOINTED REPRESENTATIVE.

## CONFORMING TO CONSTRUCTION RECORDS.

AJC 10.29.2020 DATE

#### MISSOURI GEOGRAPHIC REFERENCE SYSTEM **BENCH MARK:**

BM JA-136, LOCATED AT INTERSECTION OF SW OLDHAM PARKWAY AND SW WARD ROAD, 61 FT SOUTH OF CL OF OLDHAM PARKWAY AND 28.9 FT EAST OF THE EAST EDGE OF WARD ROAD.

ELEV. 993.11'

### PROJECT BENCH MARK:

SANITARY MANHOLE H2 AT NW CORNER OF LOT 1153 WINTERSET VALLEY 1ST PLAT, APPROX. 39' RT. OF CL OF NW PEALE BLVD.

ELEV.935.45'

TRENCH CHECKS TO BE INSTALL ON

SUMMIT STANDARDS.

ALL SANITARY SEWER SERVICE LINES IN ACCORDANCE WITH CITY OF LEES


13TH ISION


COVER

SHEET

OF 6



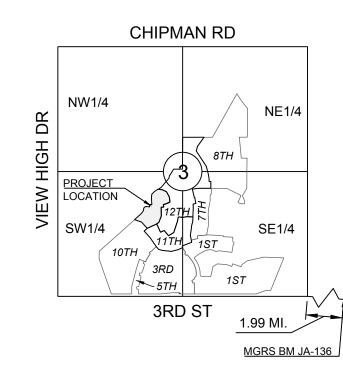

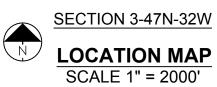

### MISSOURI GEOGRAPHIC REFERENCE SYSTEM **BENCH MARK:**

BM JA-136, LOCATED AT INTERSECTION OF SW OLDHAM PARKWAY AND SW WARD ROAD, 61 FT SOUTH OF CL OF OLDHAM PARKWAY AND 28.9 FT EAST OF THE EAST EDGE OF WARD ROAD.

ELEV. 993.11'


#### PROJECT BENCH MARK:

SANITARY MANHOLE H2 AT NW CORNER OF LOT 1153 WINTERSET VALLEY 1ST PLAT, APPROX. 39' RT. OF CL OF NW PEALE BLVD.


ELEV.935.45'


#### **GENERAL NOTES:**

- 1. ALL WYES ARE STATIONED USING MAIN LINE STATIONS.
- 2. M.S.F.E DENOTES MINIMUM SEWERABLE FLOOR ELEVATION.
- 3. THE CONTRACTOR IS RESPONSIBLE FOR VERIFYING ALL EXISTING UTILITY LOCATIONS PRIOR TO EXCAVATIONS.
- 4. ALL SERVICE LINES ARE TO BE 90° TO THE MAIN UNLESS OTHERWISE NOTED.
- 5. ALL SANITARY SEWER MANHOLES ARE 4' DIAMETER UNLESS OTHERWISE NOTED:

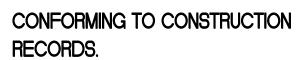


AJC	10.29.20
RY	DATE

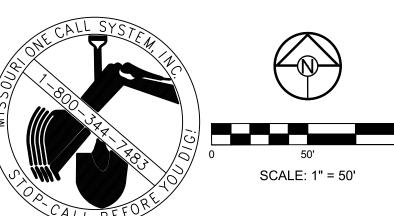

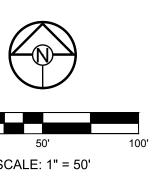

SCHL



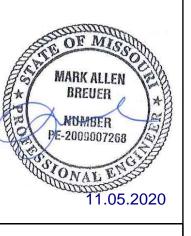


ND AUDUBC MISSOURI EY, 13TH I WINTERSET VASANITARY MAIN

GENERAL

LAYOUT

SHEET

OF 6

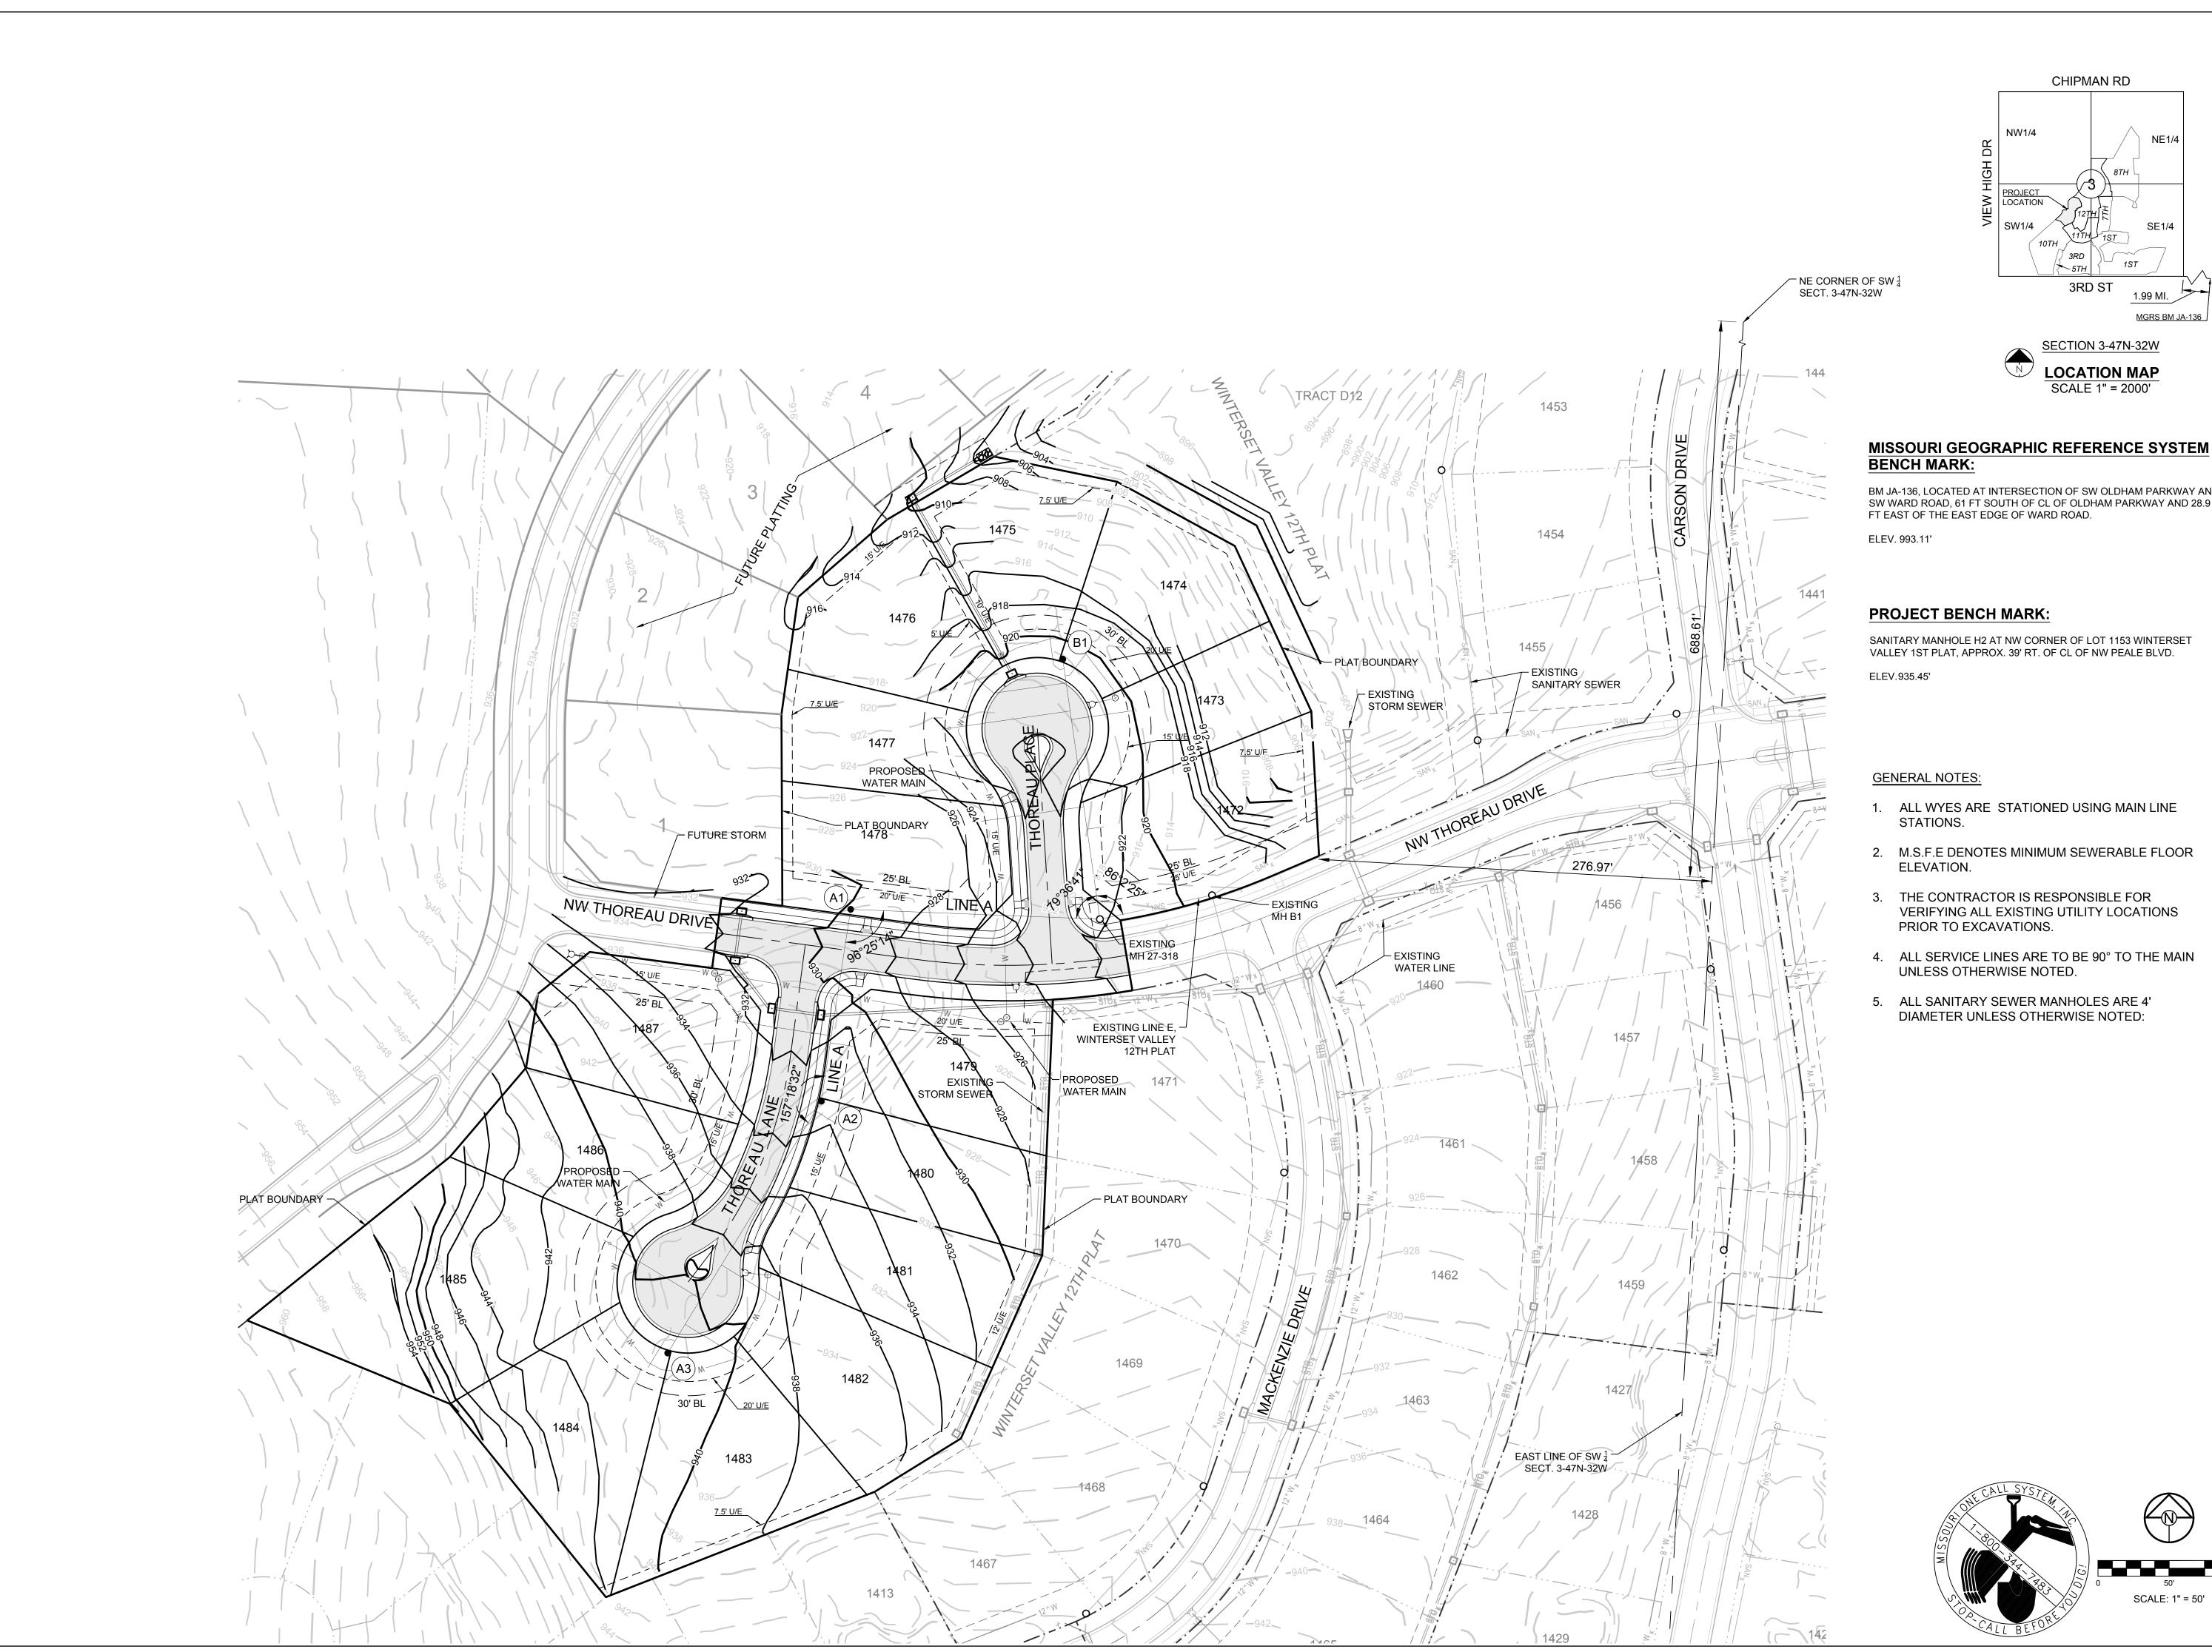

SCHLAGEL Froineers Planner





MARK ALLEN BREUER

11.05.2020

MUMBER PE-2009007268

1.99 MI.

MGRS BM JA-136

CHIPMAN RD

₹<u>5TH</u>

3RD ST

SCALE 1" = 2000'

BM JA-136, LOCATED AT INTERSECTION OF SW OLDHAM PARKWAY AND SW WARD ROAD, 61 FT SOUTH OF CL OF OLDHAM PARKWAY AND 28.9 FT EAST OF THE EAST EDGE OF WARD ROAD.

#### **PROJECT BENCH MARK:**

SANITARY MANHOLE H2 AT NW CORNER OF LOT 1153 WINTERSET VALLEY 1ST PLAT, APPROX. 39' RT. OF CL OF NW PEALE BLVD.

- 1. ALL WYES ARE STATIONED USING MAIN LINE
- 2. M.S.F.E DENOTES MINIMUM SEWERABLE FLOOR
- 3. THE CONTRACTOR IS RESPONSIBLE FOR VERIFYING ALL EXISTING UTILITY LOCATIONS PRIOR TO EXCAVATIONS.
- 4. ALL SERVICE LINES ARE TO BE 90° TO THE MAIN UNLESS OTHERWISE NOTED.
- 5. ALL SANITARY SEWER MANHOLES ARE 4' DIAMETER UNLESS OTHERWISE NOTED:





**GRADING PLAN** 


SHEET


SCALE: 1" = 50'

3 OF 6

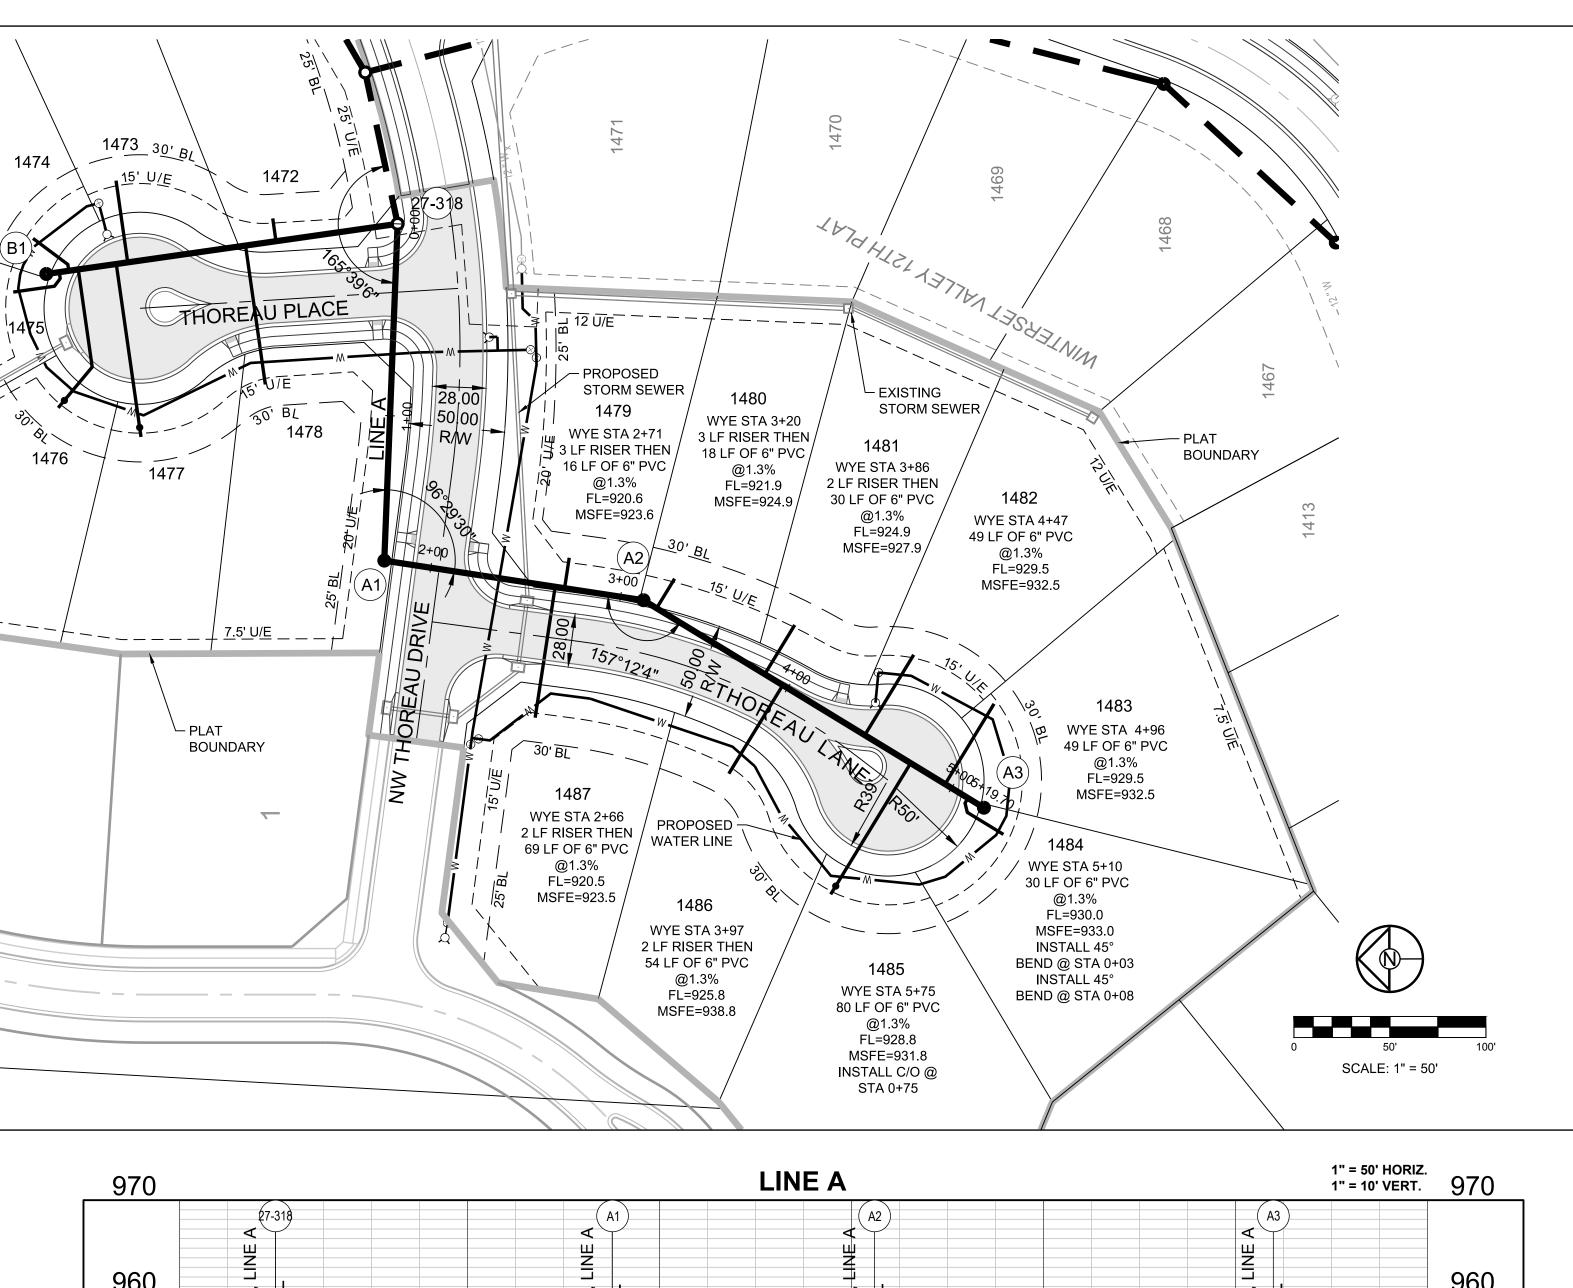

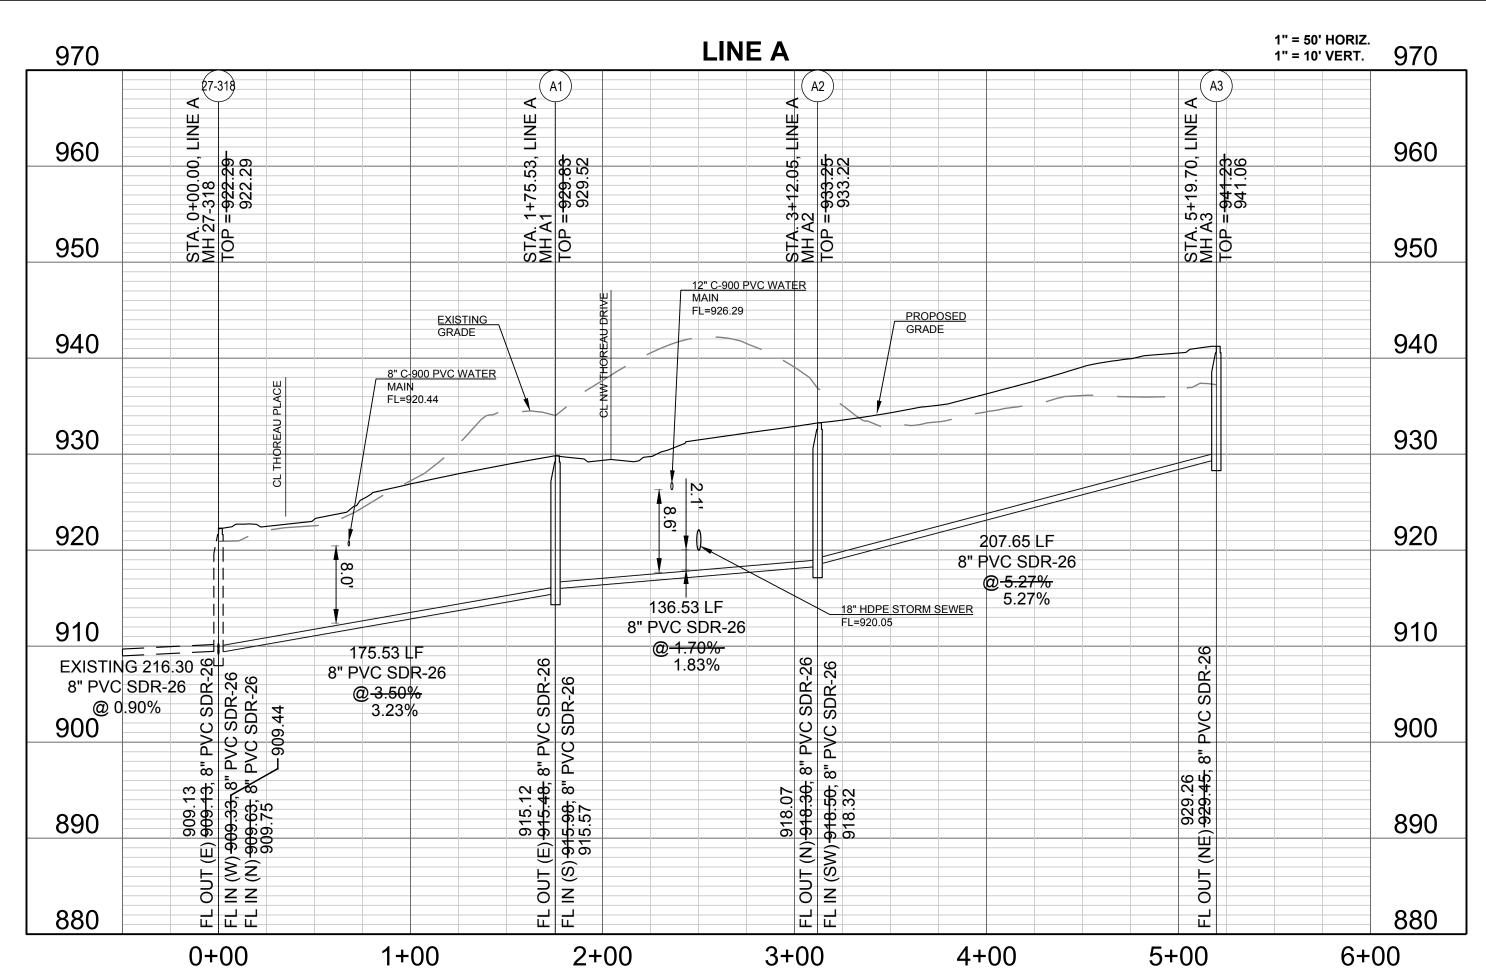

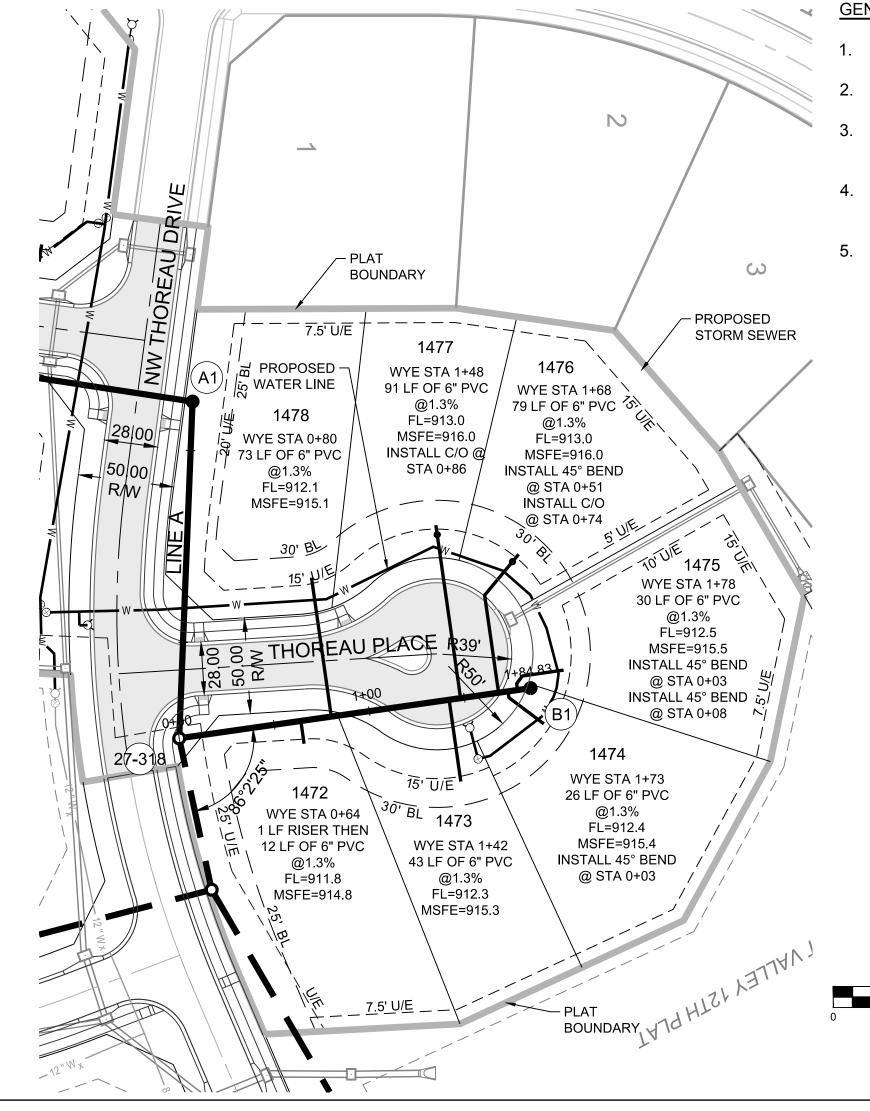

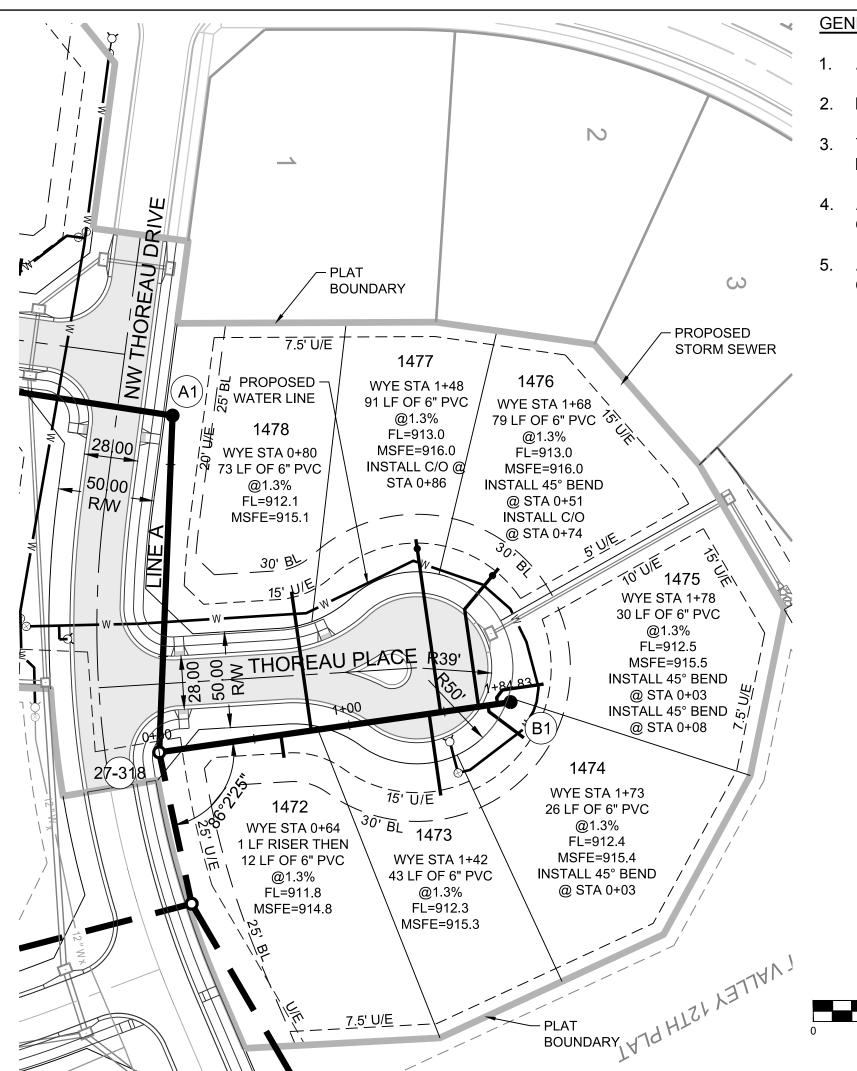

#### **GENERAL NOTES:**

- 1. ALL WYES ARE STATIONED USING MAIN LINE STATIONS.
- M.S.F.E DENOTES MINIMUM SEWERABLE FLOOR ELEVATION.
- 3. THE CONTRACTOR IS RESPONSIBLE FOR VERIFYING ALL EXISTING UTILITY LOCATIONS PRIOR TO EXCAVATIONS.
- 4. ALL SERVICE LINES ARE TO BE 90° TO THE MAIN UNLESS OTHERWISE NOTED.
- 5. ALL SANITARY SEWER MANHOLES ARE 4' DIAMETER UNLESS OTHERWISE NOTED:

#### MISSOURI GEOGRAPHIC REFERENCE SYSTEM **BENCH MARK:**


BM JA-136, LOCATED AT INTERSECTION OF SW OLDHAM PARKWAY AND SW WARD ROAD, 61 FT SOUTH OF CL OF OLDHAM PARKWAY AND 28.9 FT EAST OF THE EAST EDGE OF WARD ROAD.

ELEV. 993.11'

#### PROJECT BENCH MARK:

SANITARY MANHOLE H2 AT NW CORNER OF LOT 1153 WINTERSET VALLEY 1ST PLAT, APPROX. 39' RT. OF CL OF NW PEALE BLVD.

ELEV.935.45'

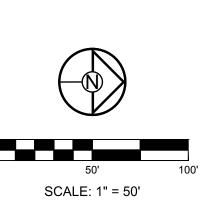



SCHI

MARK ALLEN

BREUER


MUMBER

PE-2009007268

MONALEY

13TH ISION

11.05.2020

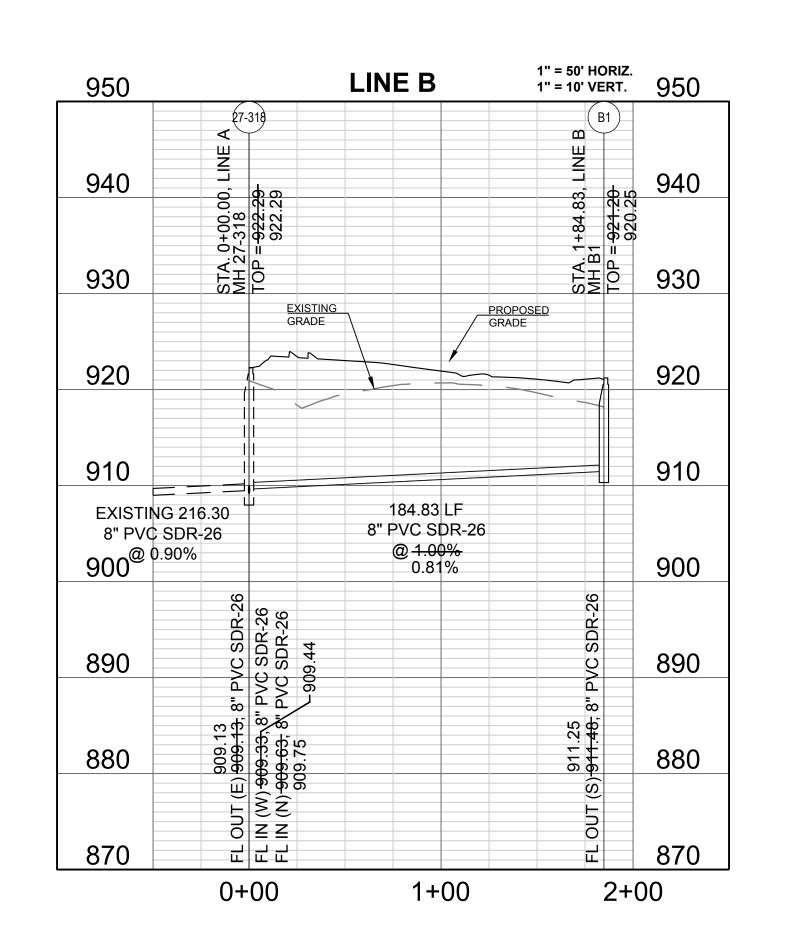

Structure Table		
Structure Name	Structure Northing	Structure Easting
A1	1001846.1664	2804886.1633
A2	1001711.2051	2804865.5496
A3	1001533.9185	2804757.4392
B1	1002022.2077	2805035.4318

CONFORMING TO CONSTRUCTION RECORDS.

AJC 10.29.2020 BY DATE

LINE A AND B PLAN AND PROFILE


OF 6


SHEET

**LEE'S SUMMIT** 

MISSOURI

hecked By: DL

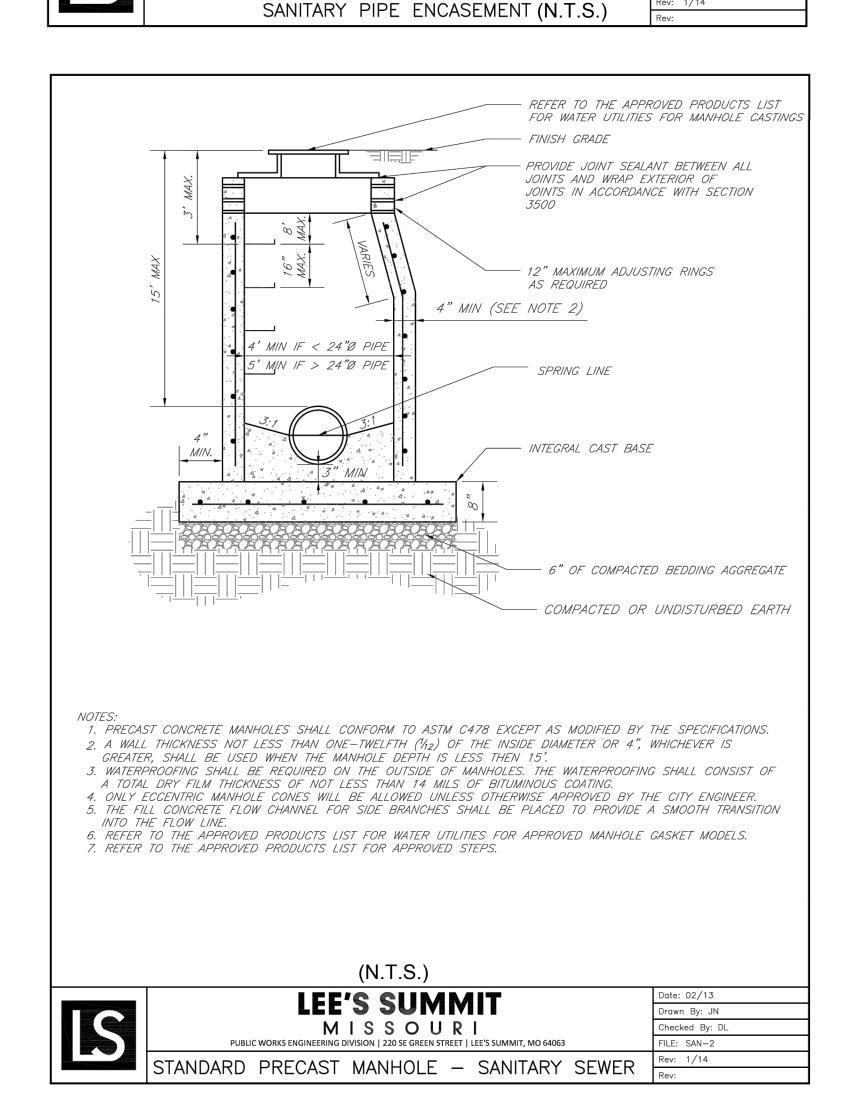

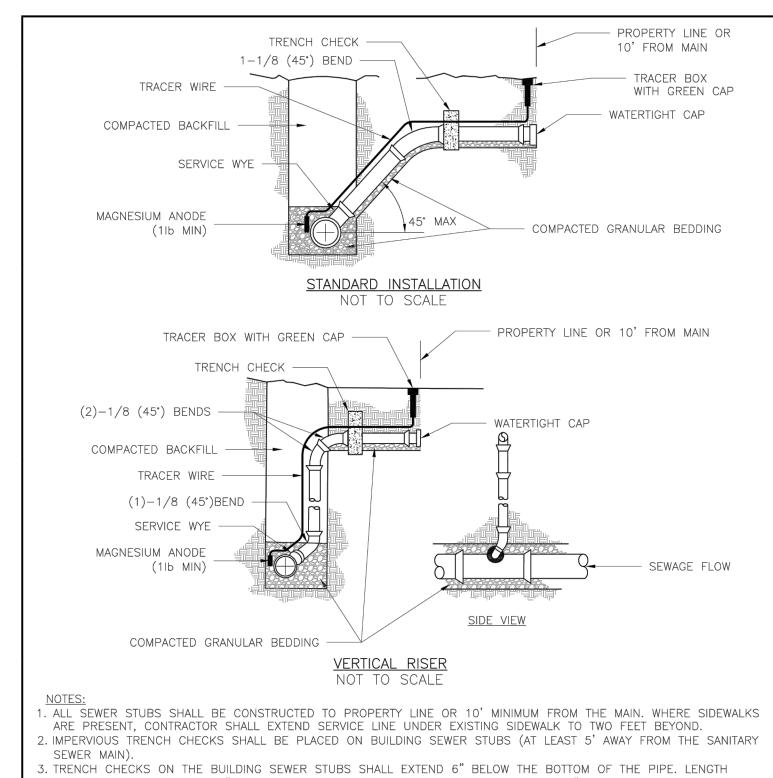



SHALL BE A MINIMUM OF 12". THE HEIGHT OF THE TRENCH CHECK SHALL EXTEND 12" ABOVE THE TOP OF THE PIPE. THE WIDTH OF THE TRENCH. 4. SEE SPECIFICATION SECTION 2100 FOR SEWER MAIN BEDDING AND BACKFILL


5. #12 GAUGE GREEN INSULATED COPPER TRACER WIRE SHALL BE INSTALLED. TRACER WIRE TERMINAL BOXES SHALL BE INSTALLED DIRECTLY ABOVE THE SEWER SERVICE OR AS DETERMINED BY THE ENGINEER. 6. FOR SERVICES, TRACER WIRE SHALL RUN FROM THE WYE AND TERMINATE IN A FLUSH MOUNTED TRACER BOX WITH A GREEN CAST IRON LOCKABLE TOP. WIRE SHALL BE TAPED OR TIED TO THE PIPE AT 5' INTERVALS. TRACER WIRE BOX SHALL BE INSTALLED WITHIN 1.0' OF PROPERTY LINE.


8. THE TRACER WIRE SHALL REMAIN CONTINUOUS TO THE GREATEST EXTENT POSSIBLE. SPLICES IN THE TRACER WIRE SHOULD BE MADE WITH SPLIT BOLT CONNECTORS. WIRE NUTS SHALL NOT BE USED. A WATER-PROOF CONNECTION IS NECESSARY TO PREVENT CORROSION.

	LEE'S SUMMIT	Date: 12/13
	LEE 3 30 MINIT	Drawn By: SC
S	MISSOURI	Checked By: DL
	PUBLIC WORKS ENGINEERING DIVISION   220 SE GREEN STREET   LEE'S SUMMIT, MO 64063	FILE: SAN-1
	BUILDING SEWER STUB AND RISER (N.T.S.	Rev: 10/15
	BUILDING SEWER STUD AND RISER (IN.1.3.)	Rev: 12/15

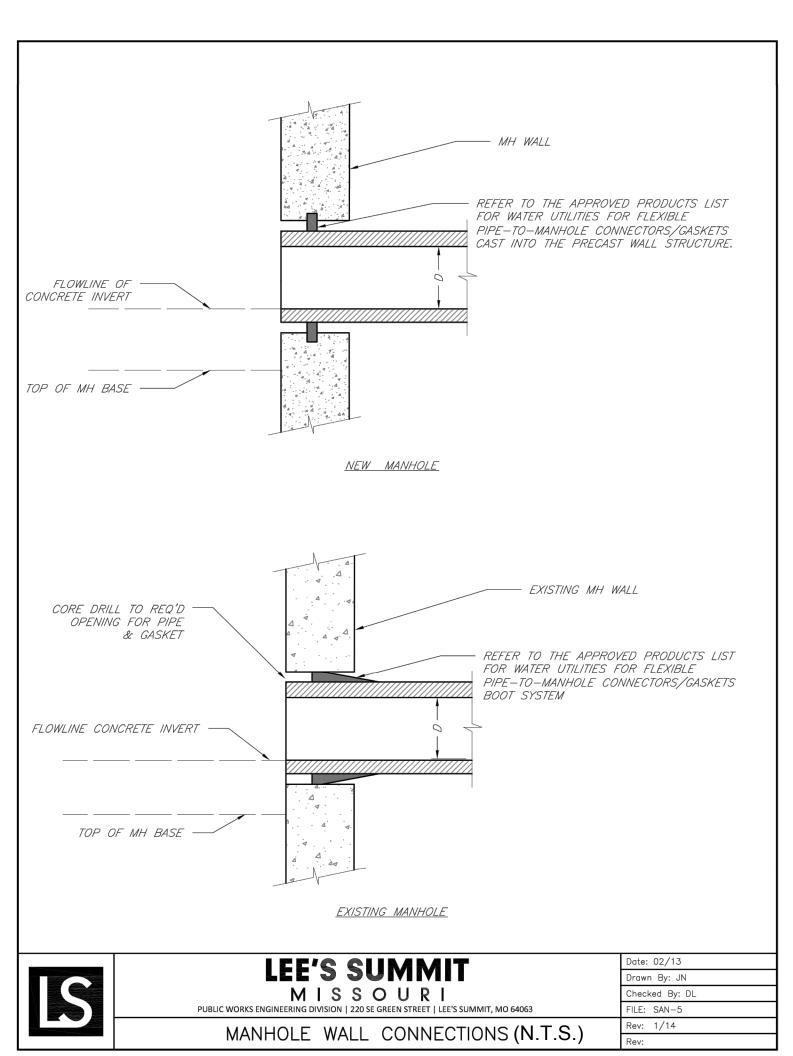

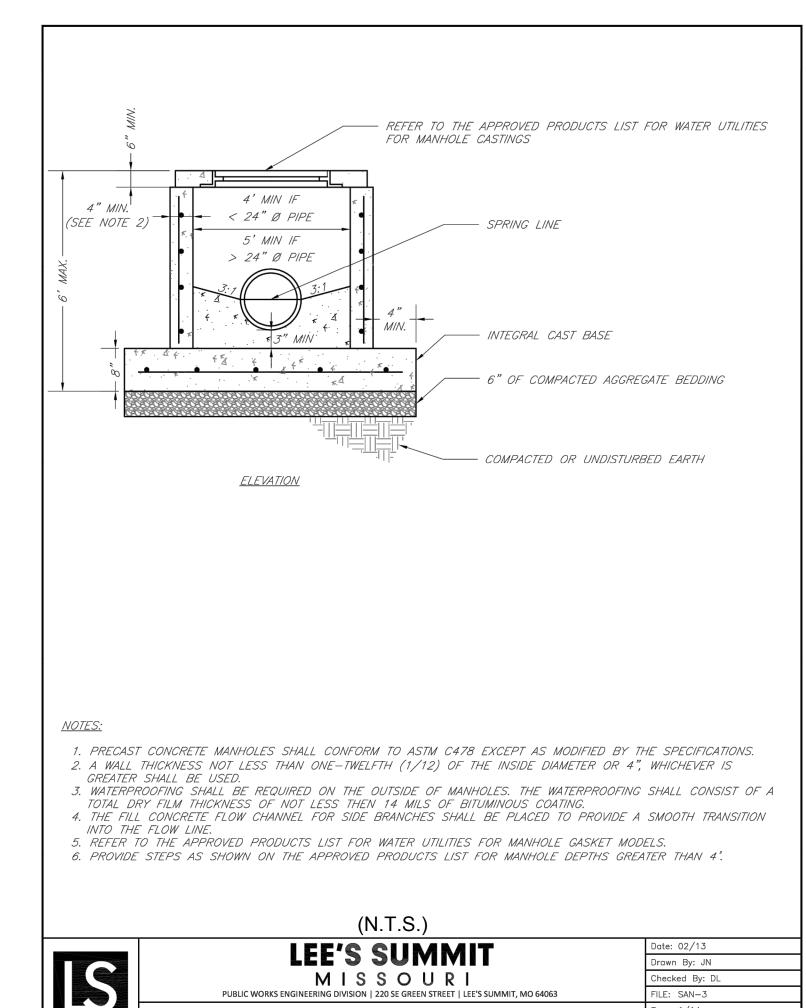

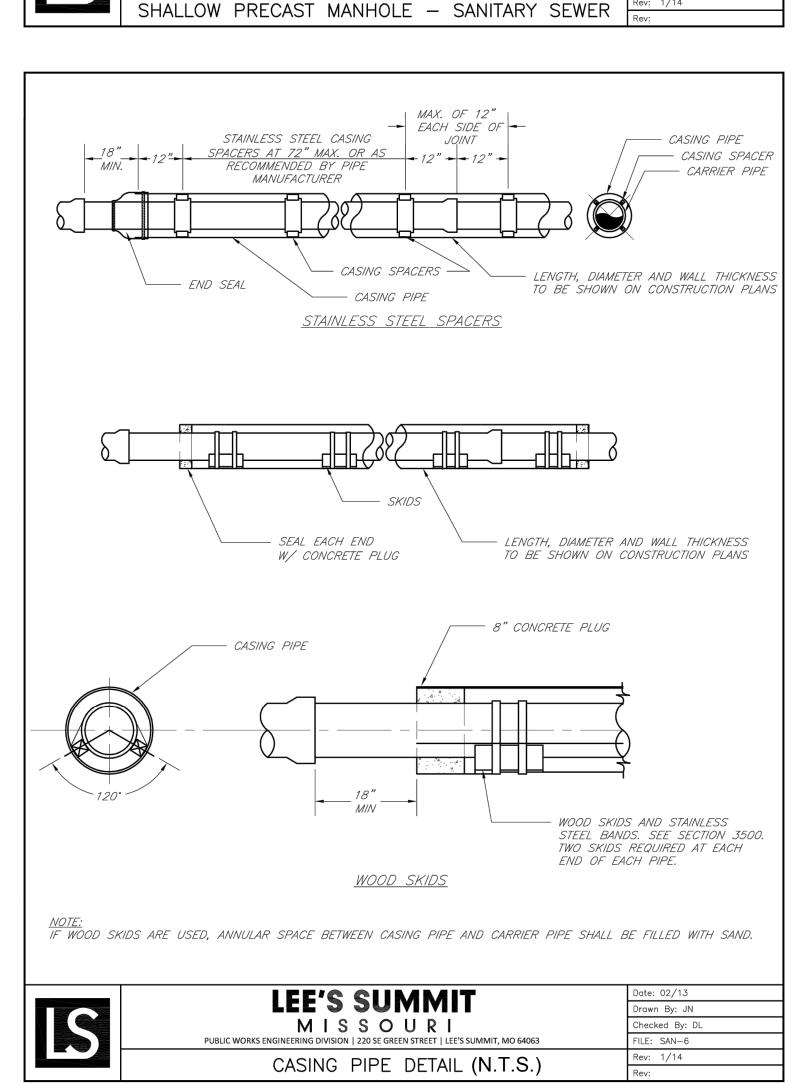

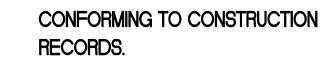

ΒY DATE OF 6

SHEET

SANITARY

**DETAILS** 

BREUER


MOMBER

PE-2009007268

13TH ISION

1.05.2020

10.29.2020

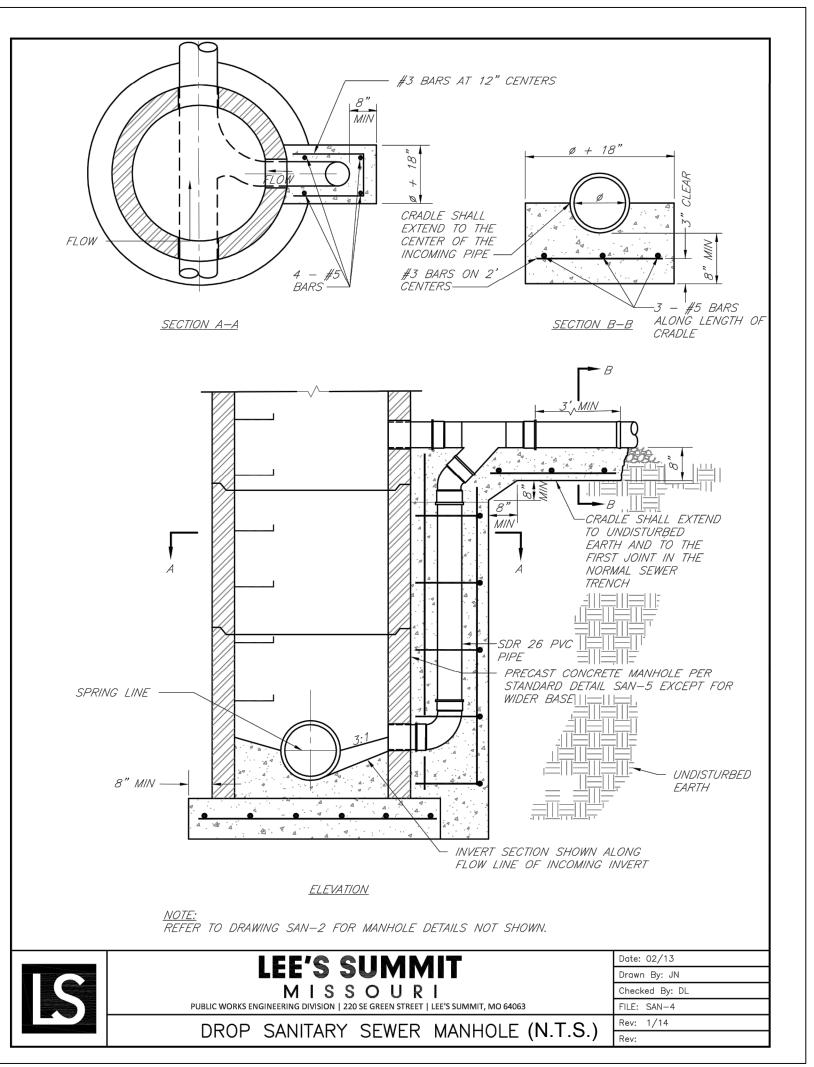

EY, 13TH PLAT (TENSION PLANS WINTERSET VALL SANITARY MAIN EX

MARK ALLEN BREUER

SANITARY DETAILS

SHEET

OF 6

CONFORMING TO CONSTRUCTION RECORDS. 10.29.2020 DATE