

RELEASE FOR CONSTRUCTION
AS NOTED ON PLANS REVIEW
DEVELOPMENT SERVICES
LEE'S SUMMIT, MISSOURI

11/13/2020


AS-BUILT PLOT PLAN

DESCRIPTION: As Provided By: CLIENT

Lot 107, PERGOLA PARK - 4TH PLAT, a subdivision in Lee's Summit, Jackson County, Missouri.

ADDRESS: 3205 SW Mary St

GARAGE FLOOR=948.0
 TOP FOUNDATION=951.7
 BASEMENT FLOOR=943.0
 TOP EGRESS WELL=950.5
 EGRESS WELL LAG=950.2
 FRONT MBOE PER MDP=950.5
 REAR MBOE PER MDP=946.9
 MSFE PER ASBUILT=936.8
 STANDARD BASEMENT

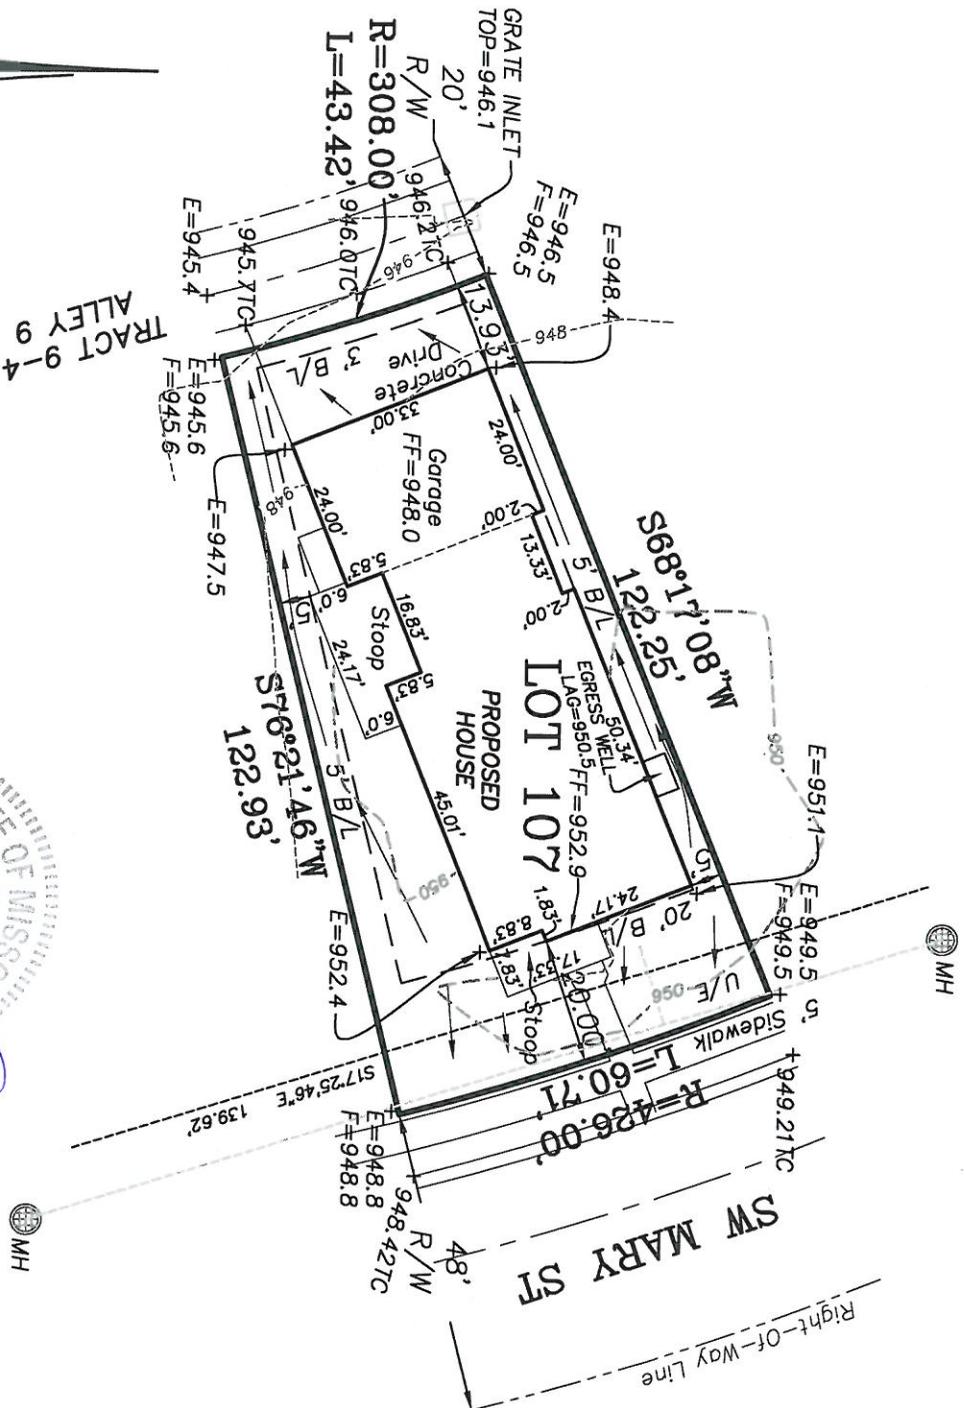

STATE OF MISSOURI
 JEFFREY B. LOVELACE
 LICENSE NUMBER LS-2590
 11-12-2020

NOTES:

1. LEGAL DESCRIPTION OF PROPERTY PROVIDED BY CONTRACTOR. THIS PLOT PLAN DOES NOT CONSTITUTE OR REPRESENT A BOUNDARY SURVEY. THE CONTRACTOR AND/OR OWNER SHALL BE RESPONSIBLE FOR VERIFICATION OF PROPERTY BOUNDARY, PROPERTY CORNERS, DEED DESCRIPTIONS AND LOCATIONS OF PROPOSED HOUSE WITH RESPECT TO PROPERTY LINES.
2. EASEMENTS, BUILDING LINES AND SET-BACKS TAKEN FROM RECORDED PLAT ONLY.
3. CONTRACTOR TO VERIFY LOCATION AND DEPTH OF SANITARY SEWER SERVICE PRIOR TO CONSTRUCTION.
4. CONTRACTOR TO VERIFY ALL DIMENSIONS, ELEVATIONS AND LOCATIONS PRIOR TO CONSTRUCTION.
5. CONTRACTOR TO VERIFY CONDITION OF ALL FILL PRIOR TO CONSTRUCTION.
6. FINAL GRADING AND ELEVATIONS SHALL BE CONTRACTORS RESPONSIBILITY.
7. THIS IS A REPRESENTATION OF THE STRUCTURE AS STAKED BY THIS COMPANY.

Ordered By: BELLAH HOMES P.O. BOX 346 Lees Summit, Mo 64063	
LOVELACE & ASSOCIATES, LLC LAND SURVEYING AND PLANNING SERVICES Lee's Summit, MO, 64063/816-347-9997 929 SE 3rd St.	
Drawn by: J. Smith, Jr. Checked by: J. Lovelace	SCALE: 1" = 30' DATE: 11/12/2020
JOB NO. 20040-5	