


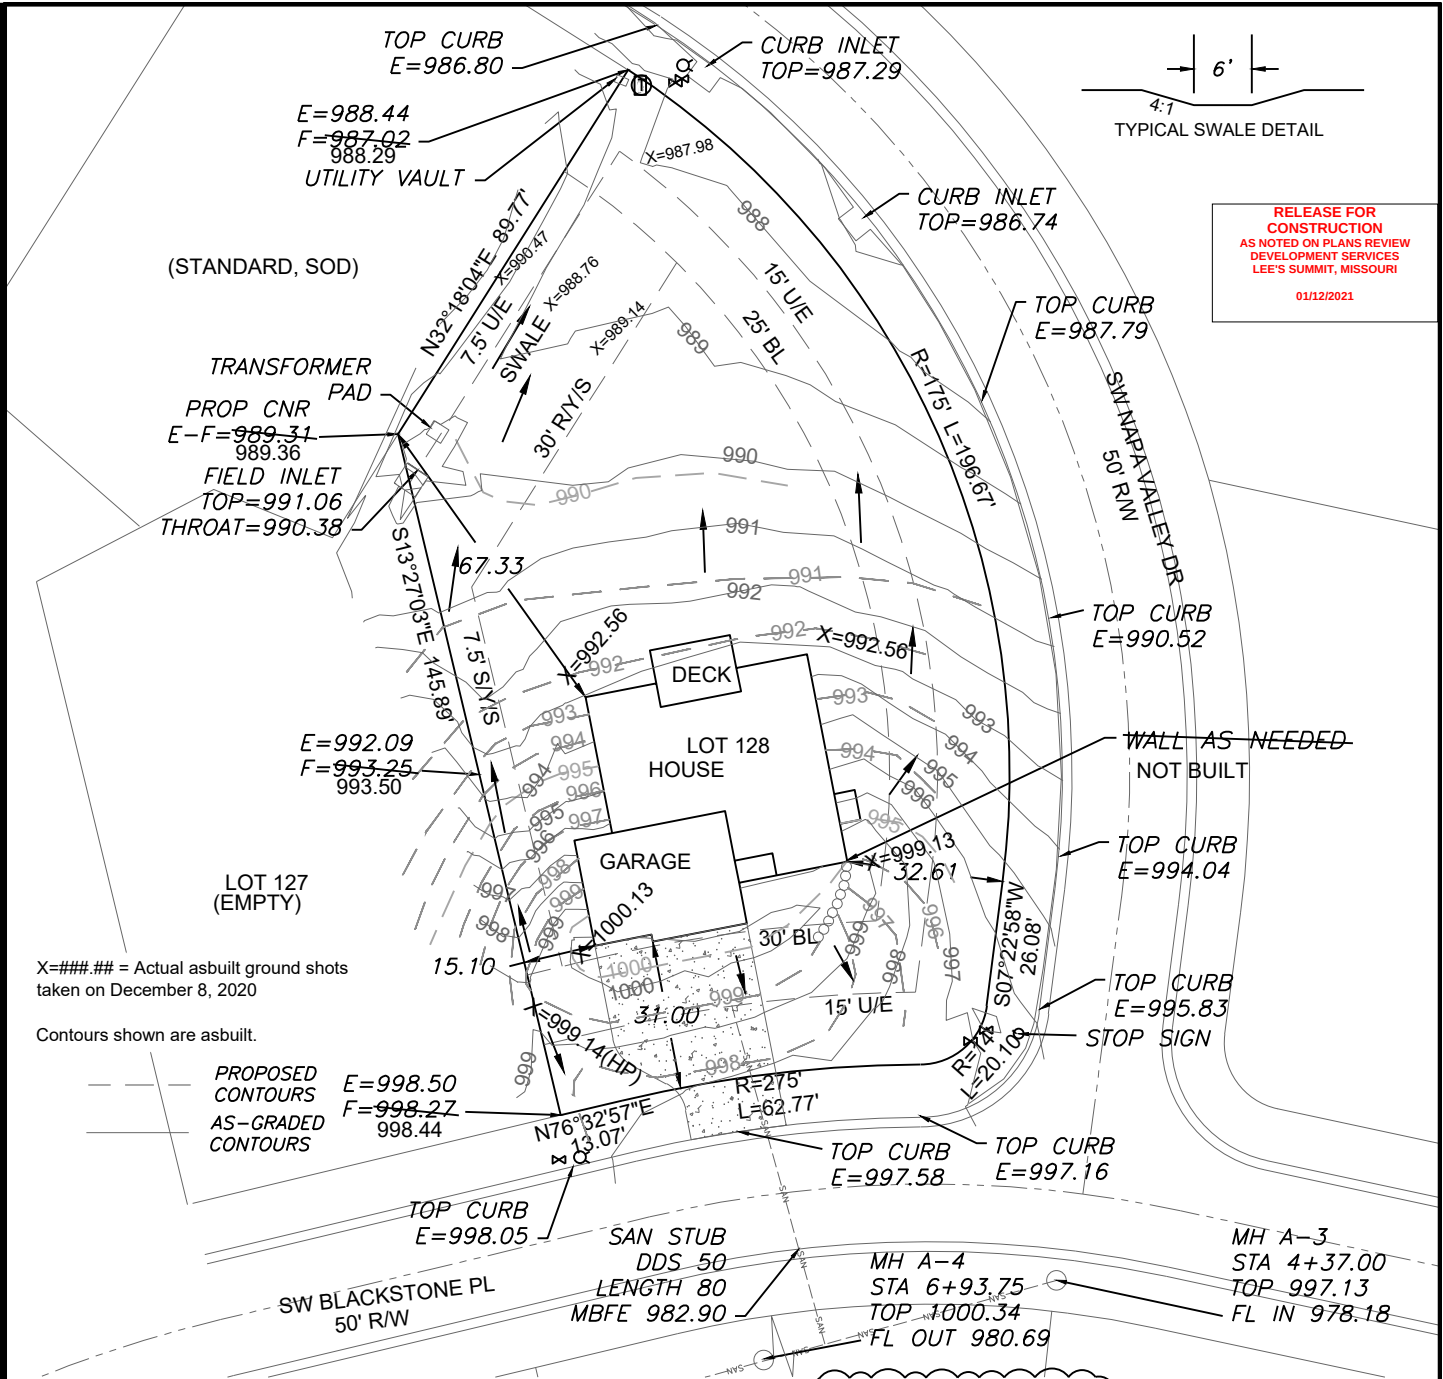

X=###.## = Actual asbuilt ground shots taken on December 8, 2020

Contours shown are asbuilt.

PROPOSED CONTOURS
AS-GRADED CONTOURS

LEGEND

- Gas Meter
- Telephone or Fiber-Optic Pedestal
- Cable TV Pedestal
- Electric Pedestal
- Light Pole
- Mailbox
- Fire Hydrant
- Water Valve

PROPOSED HOUSE

TOP FOUNDATION = 1001.75
GARAGE FLOOR = 1000.25
TOP FOOTING = 992.75
BASEMENT FLOOR = 993.08


E = EXISTING ELEVATION
F = PROPOSED FINAL ELEVATION
G = ADJACENT GRADE AT EGRESS
U/E = UTILITY EASEMENT
B/L = BUILDING LINE
S/Y/S = SIDE YARD SETBACK
R/Y/S = REAR YARD SETBACK

NOTES


- BUILDER TO VERIFY ALL BUILDING ELEVATIONS AND DIMENSIONS.
- THIS PLOT PLAN DOES NOT CONSTITUTE A BOUNDARY SURVEY.
- THE EASEMENTS SHOWN ON THIS PLOT PLAN ARE TAKEN FROM THE FINAL PLAT. OTHER EASEMENTS MAY EXIST.

AS-GRADED PLOT PLAN IS REQUIRED PRIOR TO SODDING

DRIVEWAY SLOPE = 7.9%

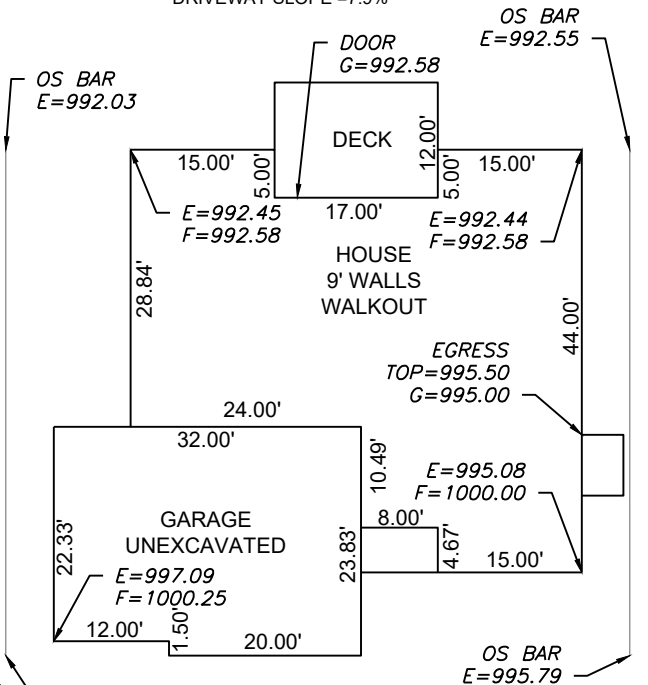

Scale 1"=20'

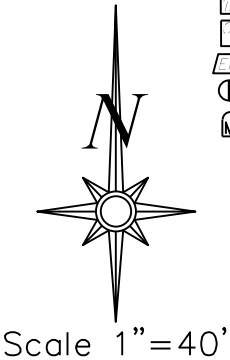


LOT INFORMATION

19,173.9 SQ. FT.
MBOE = 991.82
100 Y WSEL 989.82
MBFE 982.90
ADDRESS
1606 SW BLACKSTONE PLACE

LEGAL DESCRIPTION

LOT 128, NAPA VALLEY 3RD PLAT, A SUBDIVISION AS RECORDED IN LEE'S SUMMIT, JACKSON COUNTY, MISSOURI.

ENGINEERING SOLUTIONS
ENGINEERING & SURVEYING
50 SE 30TH STREET
LEE'S SUMMIT, MO 64082
P:(816) 623-9888 F:(816) 623-9849
WWW.ENGINEERINGSOLUTIONKCC.COM

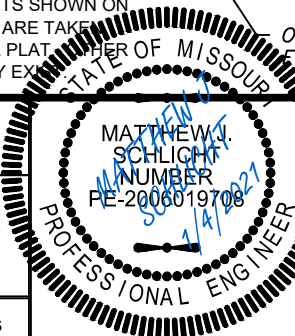

AS-GRADED PLOT PLAN - LOT 128

NAPA VALLEY 3RD PLAT
LEE'S SUMMIT, JACKSON COUNTY, MISSOURI

KEVIN HIGDON CONSTRUCTION
PO BOX 847
LEE'S SUMMIT, MO 64083

PROJECT NO.	FILE NAME	DATE	SHEET	OF
1	LOT 128, NAPA VALLEY	4/3/20	1	1

THIS DRAWING IS NOT VALID UNLESS THE SIGNATURE, DATE AND SEAL OF THE ENGINEER WHO SUPERVISED THE PREPARATION OF THIS DRAWING HAS BEEN AFFIXED HERETO.