

## TENANT IMPROVEMENT

# HomeGoods


Summit Orchards, Lot 4B

492 NW Chipman Rd
Lee's Summit, MO 64086



# Permit/ Construction Set

November 08, 2019

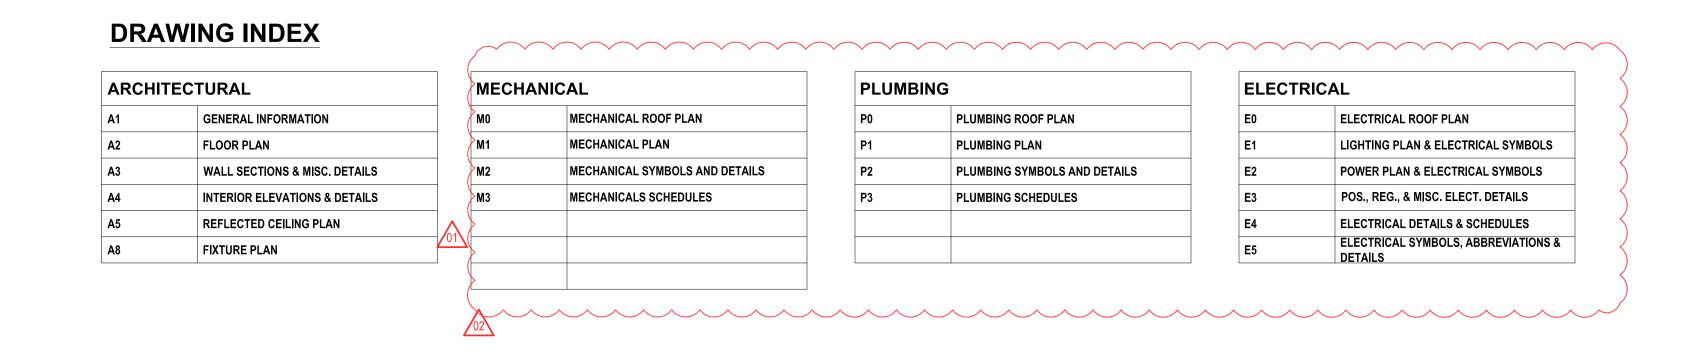



### **ARCHITECT**

SLAGGIE ARCHITECTS, INC. 4600 MADISON AVENUE, SUITE 350 KANSAS CITY, MISSOURI 64112 PHONE: (816) 756-1958 FAX: (816) 756-1795

### **MEP ENGINEER**

SMITH & BOUCHER 25501 WEST VALLEY PARKWAY OLATHE, KS. 66061 PHONE: (913) 344-0033

#### **CODE REVIEW** ALL WORK UNDER THIS CONTRACT SHALL COMPLY WITH THE PROVISIONS OF THE SPECIFICATIONS AND DRAWINGS, AND SHALL SATISFY ALL APPLICABLE CODES, ORDINANCES AND REGULATIONS OF ALL GOVERNING BODIES INVOLVED. PROJECT INFORMATION SUMMARY LAVATORIES: EXIT ACCESS TRAVEL DISTANCE (TABLE 1017.2) : FLOOR AREA ALLOWANCES PER OCCUPANT (TABLE 1004.5) OCCUPANCY TYPE MERCANTILE: AREA OCCUPANT LOAD PER RM. CALCULATED OCC. OCCUPANCY M MAX. DISTANCE ALLOWED (WITH SPRINKLER SYSTEM): 250'-0" BUILDING OCCUPANCY: GROUP M - MERCANTILE GROUP B - BUSINESS NON-SEPARATED OCCUPANCIES: OCCUPANCY B MAX. DISTANCE ALLOWED (WITH SPRINKLER SYSTEM): 300'-0" TOTAL:332 OCC. GROUP S-1 - (MODERATE HAZARD STORAGE) MERCANTILE SALES FLOOR 17,893 S.F 60 SF / OCC 298 OCCUPACNY S-1 MAX. DISTANCE ALLOWED (WITH SPRINKLER SYSTEM). 250'-0" MALE: 149 OCC. REQUIRED: 149 / 750 = .198 FEMALE: 149 OCC. REQUIRED: 149 / 750 = .198 BUILDING CONSTRUCTION CLASS: TYPE IIB BUSINESS 3,337S.F 150 SF / OCC 23 MAX. TRAVEL DISTANCE PROVIDED: OCCUPANCY TYPE BUSINESS: 1 PER 40 FOR THE FIRST 80 AND 1 PER 80 FOR THE REMAINDER S1 MODERATE BUILDING PROTECTED BY AUTOMATIC SPRINKLER SYSTEM: TOTAL: 28 OCC. HAZARD STORAGE 1,908 S.F. 300 SF / OCC 6 PLUMBING FIXTURES (TABLE 2902.1): MALE: 14 OCC, REQUIRED: 14 / 40 = .35 FEMALE: 14 OCC, REQUIRED: 14 / 40 = .35 BUILDING IS PROTECTED BY AUTOMATIC FIRE ALARM SYSTEM (NFPA 70 AND NFPA 72): YES WATER CLOSETS: LOCKER ROOM 100 S.F. 50 SF / OCC 5 OCCUPANCY TYPE: STORAGE OCCUPANCY TYPE MERCANTILE: 1 PER 100 TOTAL: 6 TOTAL OCCUPANT LOAD APPLICABLE CODES: TOTAL: 332 OCC. REQUIRED: 3 / 100 = .03 MALE: 3 OCC. **GENERAL NOTES** MALE: 149 OCC. REQUIRED: 149 / 500 = .298 REQUIRED: 3 / 100 = .03 FEMALE: 3 OCC. INTERNATIONAL BUILDING CODE FEMALE: 149 OCC. REQUIRED: 149 / 500 = .298 TOTAL REQUIRED: EGRESS WIDTH REQUIREMENTS (SECTION 1005): MECHANICAL CODE: INTERNATIONAL MECHANICAL CODE 2018 EDITION THE WORK INCLUDES THE FURNISHING OF ALL LABOR, MATERIALS, EQUIPMENT AND OCCUPANCY TYPE BUSINESS: MALE: .58 (1) INTERNATIONAL PLUMBING CODE 2018 EDITION PLUMBING CODE: SERVICES NECESSARY FOR AND REASONABLY INCIDENTAL TO THE COMPLETION, IN 1 PER 25 FOR THE FIRST 50 AND 1 PER 50 FOR THE REMAINDER FEMALE: .58 (1) NATIONAL ELECTRIC CODE 0.3 INCH PER OCCUPANT = (0.3) X 116 (OCC) = 34.8" PLACE OF ALL WORK AS ILLUSTRATED AND DESCRIBED IN DRAWINGS AND OUTLINE TOTAL: 28 OCC. OTHER MEANS OF EGRESS: 0.2 INCH PER OCCUPANT = (0.2) X 216 (OCC) = 43" PROVIDED: FIRE CODE INTERNATIONAL FIRE CODE 2018 EDITION SPECIFICATIONS AS PREPARED BY TJX. ALL SUCH WORK IS TO BE DONE BY THE MALE: 14 OCC, REQUIRED: 14 / 25 = .56 MALE: 2 GAS CODE: INTERNATIONAL FUEL GAS CODE 2018 EDITION GENERAL CONTRACTOR UNLESS OTHERWISE NOTED. EGRESS WIDTH PROVIDED WITH STAIRS = 67.2" > 34.8" REQUIRED FEMALE: 14 OCC, REQUIRED: 14 / 25 = .56 ACCESSIBLE AND USABLE BUILDINGS ANSI A117.1 FEMALE: 2 EGRESS WIDTH PROVIDED AT EXIT DOORS = 119.6" > 43" REQUIRED AND FACILITIES OCCUPANCY TYPE: STORAGE CONTRACTOR SHALL VERIFY ALL DIMENSIONS AND CONDITIONS SHOWN ON DRINKING FOUNTAINS: 1 PER 100 DRAWINGS AT THE JOB SITE, AND SHALL NOTIFY TJX IN WRITING OF ANY OMISSIONS, TOTAL: 6 MERCANTILE / SALES: 332 / 1000 = .33 DISCREPANCIES, AND/OR CONFLICTS PRIOR TO SUBMITTAL OF BID OR BE NUMBER OF EXITS PER SPACE (SECTION 1006.3.2): MALE: 3 OCC. REQUIRED: 3 / 100 = .03 OFFICE, CUSTOMER SERVICE: 28 / 100 = .28 FIRE-RESISTANCE - BUILDING ELEMENTS (TABLE 601) RESPONSIBLE FOR THE SAME. FEMALE: 3 OCC. REQUIRED: 3 / 100 = .03 RECEIVING STOCK / STORAGE: 6 / 1000 = .006 EXITS REQUIRED: 1 TO 500 OCCUPANTS 2 EXITS REQUIRED TOTAL REQUIRED: .616 (1) TOTAL REQUIRED: FOR TYPE IIB CONSTRUCTION: 3. ALL WORK IS TO CONFORM TO THE REQUIREMENTS OF THE LOCAL AND STATE CODES. PRIMARY STRUCTURAL FRAME: MALE 88 (1) TOTAL PROVIDED: COORDINATE WITH THE OUTLINE SPECIFICATIONS. ACTUAL EXITS PROVIDED OCCUPANT LOAD (FOR EXITING) BEARING WALLS (EXTERIOR AND INTERIOR): 0 HRS FEMALE: .88 (1) 332 OCCUPANTS REQUIRED SERVICE SINK: NONBEARING WALLS - EXTERIOR: PER TABLE 602 PROVIDED: 4. THE CONTRACTOR SHALL BE RESPONSIBLE FOR SECURING ALL REQUIRED BUILDING REQUIRED: 1 NONBEARING WALLS - INTERIOR: MALE: 2 PERMITS AND FOR INSURING THAT ALL WORK CONFORMS TO APPLICABLE BUILDING PROVIDED: 1 FLOOR CONSTRUCTION: FEMALE: 2 0 HRS ROOF CONSTRUCTION: WHERE COLOR AND DESIGN SELECTIONS ARE REQUIRED, THE CONTRACTOR SHALL SUBMIT SAMPLES TO TJX FOR APPROVAL AND SELECTION. SHOP DRAWINGS SHALL BE SUBMITTED TO TJX FOR APPROVAL PRIOR TO FABRICATION OF ANY WORK SPECIFIED HEREIN. THE CONTRACTOR SHALL BE RESPONSIBLE FOR ALL FIELD DIMENSIONS AND PROPER INSTALLATION OF SAID WORK. UNLESS OTHERWISE NOTED, IN THE TJX OUTLINE SPECIFICATIONS, NO SUBSTITUTIONS. 3. THE GENERAL CONTRACTOR SHALL HAVE DIRECT CONTROL AND MANAGEMENT OF ALL CONSTRUCTION OPERATORS AND BE RESPONSIBLE FOR THE SATISFACTORY OVERALL PERFORMANCE OF ALL HIS SUPPLIERS AND SUBCONTRACTORS AS WELL AS ALL ASSIGNED CONTRACTORS. 39"-41" THE GENERAL CONTRACTOR IS TO RECEIVE, HANDLE, (STORE IF NECESSARY) AND BE 42" MIN RESPONSIBLE FOR ALL MATERIALS PROVIDED BY OTHERS. ALL MATERIALS SHALL BE ACCOUNTED FOR UPON RECEIPT. ANY MISSING OR DAMAGED PARTS SHALL BE REPORTED TO TJX IMMEDIATELY. 10. ALL WORK IS TO BE NEW EXCEPT WHERE INDICATED AS EXISTING. 11. ALL WOOD TO BE FIRE RETARDANT. RATINGS TO MEET REQUIREMENTS OF LOCAL, STATE, AND FEDERAL 12. GENERAL CONTRACTOR TO TURN OVER THE PROJECT IN COMPLETE OPERATING CONDITION. 13. THE CONTRACTOR IS RESPONSIBLE FOR TURNING OVER THE PREMISES IN A CLEAN CONDITION READY FOR TJX TO BEGIN OPERATIONS. THIS INCLUDES, BUT IS NOT LIMITED TO, CLEANING ALL WINDOWS (INSIDE AND OUT), MIRRORS, AND REMOVAL OF DUST FROM SURFACES AND FINAL VACUUMING OF CARPETS. 14. THE REFLECTED CEILING PLAN SHALL DICTATE LOCATION OF ALL EQUIPMENT AND LIGHTING. TJX PROJECT MANAGER IS TO BE INFORMED OF ALL CONFLICTS AND PROPOSED RESOLUTIONS. TJX PROJECT MANAGER HAS THE RIGHT TO FINAL APPROVAL OF PROPOSALS. 5. FLOORING CONTRACTORS SHALL BE RESPONSIBLE FOR PROPER PREPARATION AND INSTALLATION OF NEW FLOORING FINISHES. PREPARATION INCLUDES ADEQUATE CURING TIME FOR THE MASTIC TO REACH PROPER TACKINESS TO SET NEW FLOORING FINISHES. REFER TO TJX SPECIFICATION MANUAL FOR REQUIREMENTS FOR 16. FOR PURPOSES OF CLARITY, REFERENCES TO "C" REFERS TO THE CRITERIA PROJECT LOCATION **Location Map** ADA Restroom Fixture Standards **SYMBOLS ABBREVIATIONS** -----/--HOMEGOODS DETAIL IDENTIFICATION DRAWING NUMBER DRAWING NUMBER ABOVE FINISHED CEILING **MIRROR** ABOVE FINISHED FLOOR ROOM NUMBER MATERIAL ALUMINUM MAXIMUM DOOR NUMBER MECHANICAL BY OTHERS MANUFACTURER BULLETIN BOARD MINIMUM **ELEVATION NUMBER** BOARD MISCELLANEOUS BLDG BUILDING MTD MOUNTED BLOCK METAL BLOCKING **ELEVATION NUMBER** NOT APPLICABLE CEILING HEIGHT FINISH NUMBER N.I.C. NOT IN CONTRACT CASH REGISTER N.T.S. NOT TO SCALE CABINET A REVISION NUMBER NAT.FIN.WD NATURAL FINISHED WOOD CLEAR CLR COL COLUMN COL.LACQ COLORED LACQUER O.C. o/c ON CENTER **──** BROKEN DIM. LINE CONST CONSTRUCTION **OUTSIDE DIMENSION** CONT CONTINUOUS OPENING CR.PL. CHROMIUM PLATE OPPOSITE NOT TO SCALE DIAMETER DIMENSION PLUS OR MINUS ANGLE DITTO THE SAME- REPEAT PARTIAL DOOR PARTITION DETAIL PLWD PLYWOOD DRAWING POL POLISHED DRAWER POL.PL.Gl POLISHED PLATE GLASS P.O.S. POINT OF SALE CENTERLINE ELEC ELECTRIC PAINTED EQUAL NO./# NUMBER ELEVATION EWC ELECTRIC WATER COOLER Life Safety Plan Site Plan RIGHT HAND PL PLATE EXISTING REINFORCED EXTERIOR REMV REMOVEABLE REQ'D REQUIRED REVISION FULL SIZE ROOM FINISH APPROVED VENDOR LIST FIXTURE ITEMS SUPPLIED BY HOMEGOODS AND INSTALLED BY G.C. FLOOR FITTING ROOM SHOPPING CENTER **LEGEND** \*\*Long Lead Time Possible\*\* HomeGoods - Landlord Build-to-Suit SQUARE FEET GENERAL CONTRACTOR SERVICE SINK Note: When contacting vendors, please indicate that you are working on a TJX project to ensure national account pricing/supply. (Outline Specifications #180) GARMENT HANGER SECTION - MAXIMUM TRAVEL DISTANCE SIMILAR GROUND FAULT INTERRUPT SLIDING DOORS Floor Mounted Carriage Bumper Slatwall Column Corner Guard SPECIFICATION 16 - ELECTRICAL MAXIMUM TRAVEL DISTANCE Wind Mill Woodwork, Inc. Eliason Easy Swing Armstrong World Industries MAPEI Corp. GYPSUM BOARD Wall Bumper GYP.BD. STANDARD Slatwall System Acoustical Ceiling System 200 Balsam Road Door Division 2500 Industrial Drive 1144 East Newport Center Dr. HVAC Equipment/ General light Fixtures, 3. Cup Dispenser DGS Retail Sheboygan Fall, WI 53085 9229 Shaver Road Armstrong World Industries Lancaster, PA 17603 Deerfield Beach, FL 33442 — DIRECTION OF OCCUPANT FLOW STAINLESS STEE 1201 Kirk Street 800-548-7528 (Sales) Kalamazoo, MI 49003 2500 Industrial Drive 1-800-426-2734 HANGRAIL Sanitary Napkin Dispenser Safety Switches, GE Lighting control panel THROUGH ELEMENT Diffusers/Grilles/Heaters/ STRUC STRUCTURAL Elk Grove Village, IL 60007 800-828-3655 Lancaster, PA 17603 (Order/Cust. Serv.) HEAVY DUTY Processing Room Fans Sanitary Napkin Disposal SUSP 08 - DOORS & GLASS 800-442-4212 (847) 364-5900 SUSPENDED 40 Hudson Road HDW HARDWARE Johnson Controls/York NUMBER OF OCCUPANTS 11 - EQUIPMENT Vestibule Mat Jimmy Guard (6 Week Lead Time) 6. Toilet Paper Dispenser Canton, MA 02021 5005 York Drive HDWD HARDWOOD \_ ADVANCING **Automatic Door Operators** Don-Jo Mfg., Inc. Wood Accent Wall The Matworks 800-244-6980 Norman, OK 73069 HGT HEIGHT 7. Paper Towel Dispenser 70 Pratt Junction Road 11900 Old Baltimore Pike Dock Seals and Bumpers 202 Restroom Floor Tile Light Valance/Molding Stanley Automatic Doors T.R. TIME RECORDER 405-419-6543 (8 Week Lead Time) ROOM / SPACE AREA (SQ FT) HORIZ HORIZONTAL P.O. Box 929 Beltsville, MD 20705 /Focal Wall Molding/Focal Wall 65 Scott Swamp Road Architectural Systems, Inc. Frommelt Dock & Door Deodorant Holder (8 Week Lead Time) TELEPHONE Sterling, MA 01564 150 West 25th Street 8th Floor 301-837-1202 Kit/Restroom Mirror Molding Farmington, CT 06032 35R Holden Street Door Alarm Soap Dispenser TYP TYPICAL OCCUPANT LOAD FACTOR (SQ FT / 860-679-6445 978-422-3377 New York, New York 10001 Winchester, MA 01890 DGS Retail Inc. HVAC Controls American Sentinel Group INSIDE DIMENSION Toilet Partitions 60 Maple Street (8 Week Lead Time) 212-206-1730 800-243-3302 PERSON) 10. Toilet Seat Cover Dispenser 75 Barker Street Novar Controls Compactor & Security Door Global Steel Products INTERIOR Mansfield, MA 02048 Pembroke, MA 02359 5 Paradise Drive 11. Restroom Trash Receptacle Restroom Wall Tile Doors, Door Frames, and Door Hardware PTR Baler & Compactor Co. 2171 Liberty Hill Road Hand Dryer 508-337-2990 VERTICAL 781-826-9589 — NUMBER OF CALCULATED OCCUPANTS Havre de Grace, MD 21078 (4 Week Lead Time) DH Pace National Accounts Eastanolles, GA 30538 EXCEL (XLERATOR) 2207 East Ontario Street 12. Permanent Chrome Rail 216-682-1600 LEFT-HAND 1300 East Plano Parkway 706-827-2700 1901 E 119th St Olathe, KS 66061 Philadelphia, PA 19134 L.H. 888-994-4128 800-348-1235 13. Plugmold for Lamp Gondolas and Sales Floor Walls Plano, TX 75074 LANDLORD Corner Guards Primary Contact 215-533-5100 TOTAL NUMBER OF OCCUPANTS (4 Week Lead Time) WALL COVERING Nancy Taylor - Project Manager 800-486-5724 Parterre Flooring Systems ATR Sales, Inc. Power Poles LAMD.PLAS. LAMINATED PLASTIC Conveyors WOOD 500 Research Drive 41 Talbot Road 417-831-5585 x 5102 Coiling Service Door 15. LP Bench Wallcovering tjxdoors@dhpace.com Metro Door, Inc. Wilmington, MA 01887 Northboro, MA 01532 as distributed by: CAPACITY OF EXIT ELEMENT 508-393-8529 1201 North Church Street D.L. Couch Wallcovering 617-800-5315 Pin Lock Box Secondary Contact Deluxe Systems, Inc. Mark Lyons - General Manager Hazleton, PA 18201 3900 South Memorial Drive 50 Strafello Drive 17. Baby Changing Table P.O. Box 570 417-831-5585 x 5101 Brian Niemeyer Wallcovering — EXIT WIDTH (DECIMAL FEET) Avon Industrial Park New Castle, IN 47362 Surface Materials 800-669-3667 x653 tjxdoors@dhpace.com Avon, MA 02322 800-433-0790 6655 Parkland Blvd. FE 10 POUND. A:B:C FIRE EXTINGUISHER 508-588-4410 (4 Week Lead Time) Solon, OH 44139 (8 Week Lead Time) 440-248-0000 (4 Week Lead Time)



SLAGGIE ARCHITECTS, INC. ©2018

Kansas City, Missouri • Omaha, Nebraska

888-756-1958

slaggie.com


Construction / Permit Set November 8, 2019

General Information


Project #:

Add-02 Tenant Comments 12-18-19

180902-02

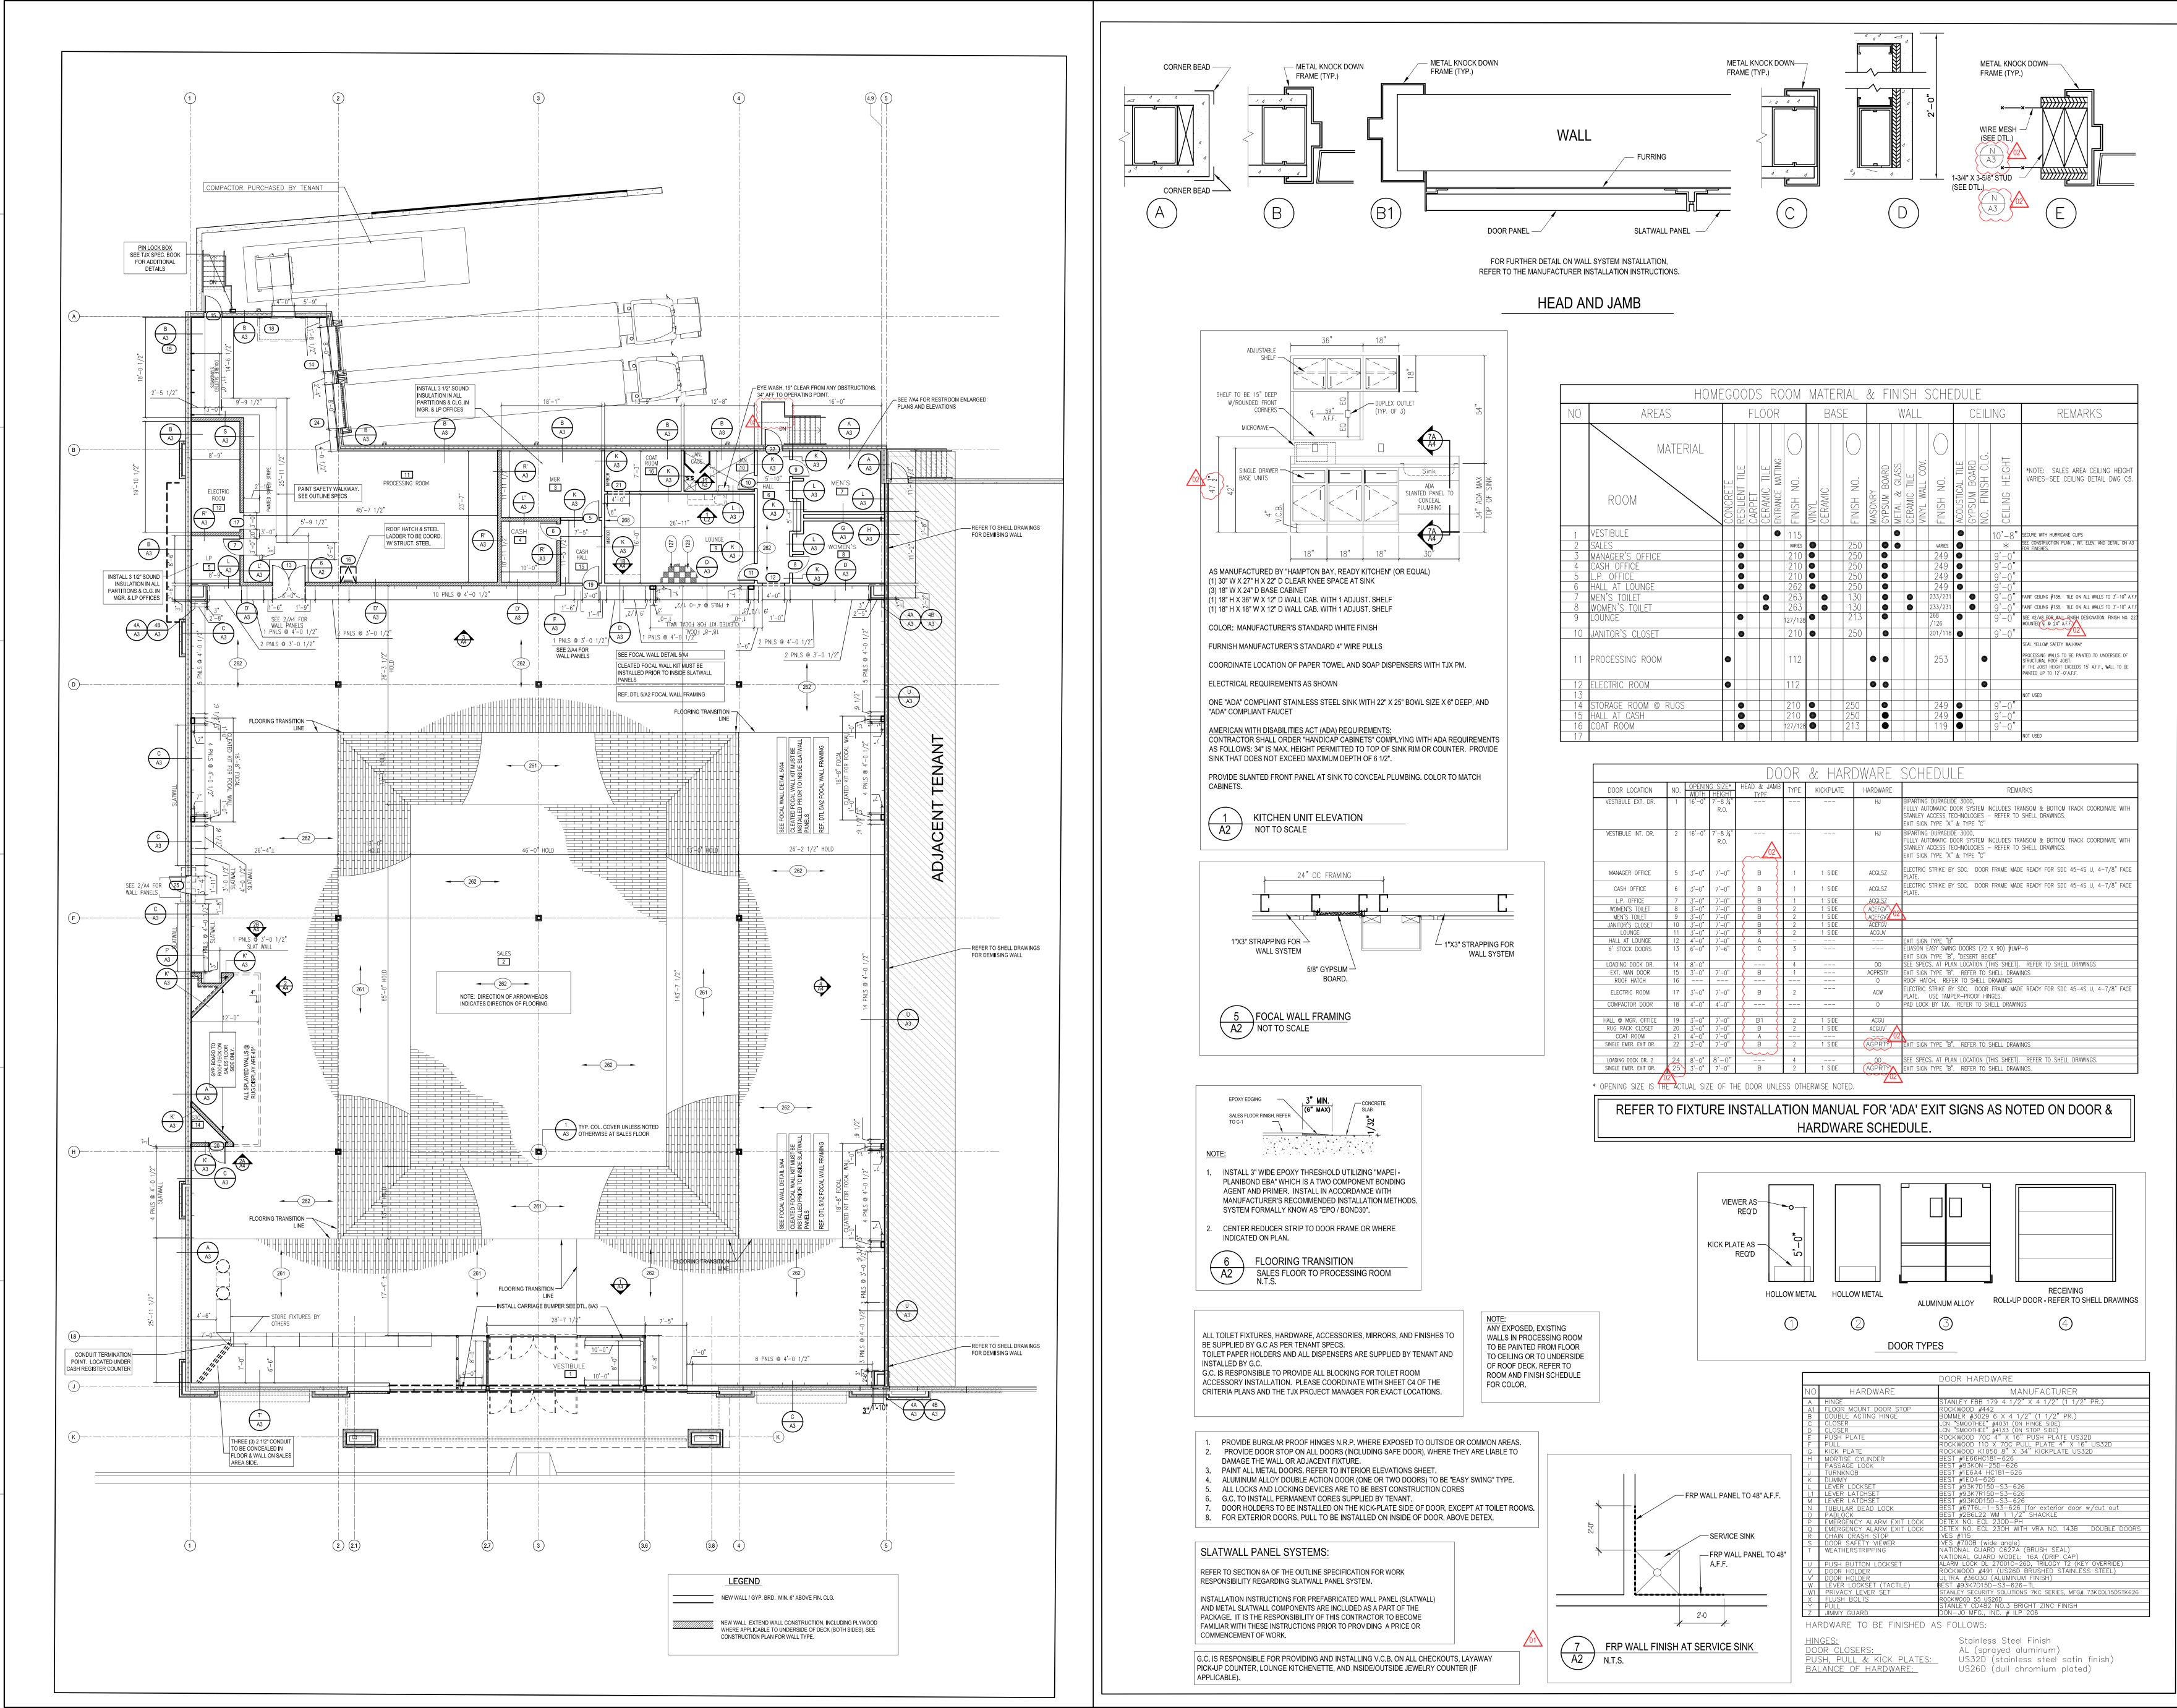



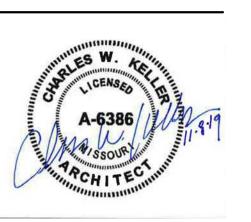




Revisions:

01 Add-01 City Comments 11-18-19
02 Add-02 Tenant Comments 12-18-19


Construction / Permit Set

November 8, 2019

Floor Plan

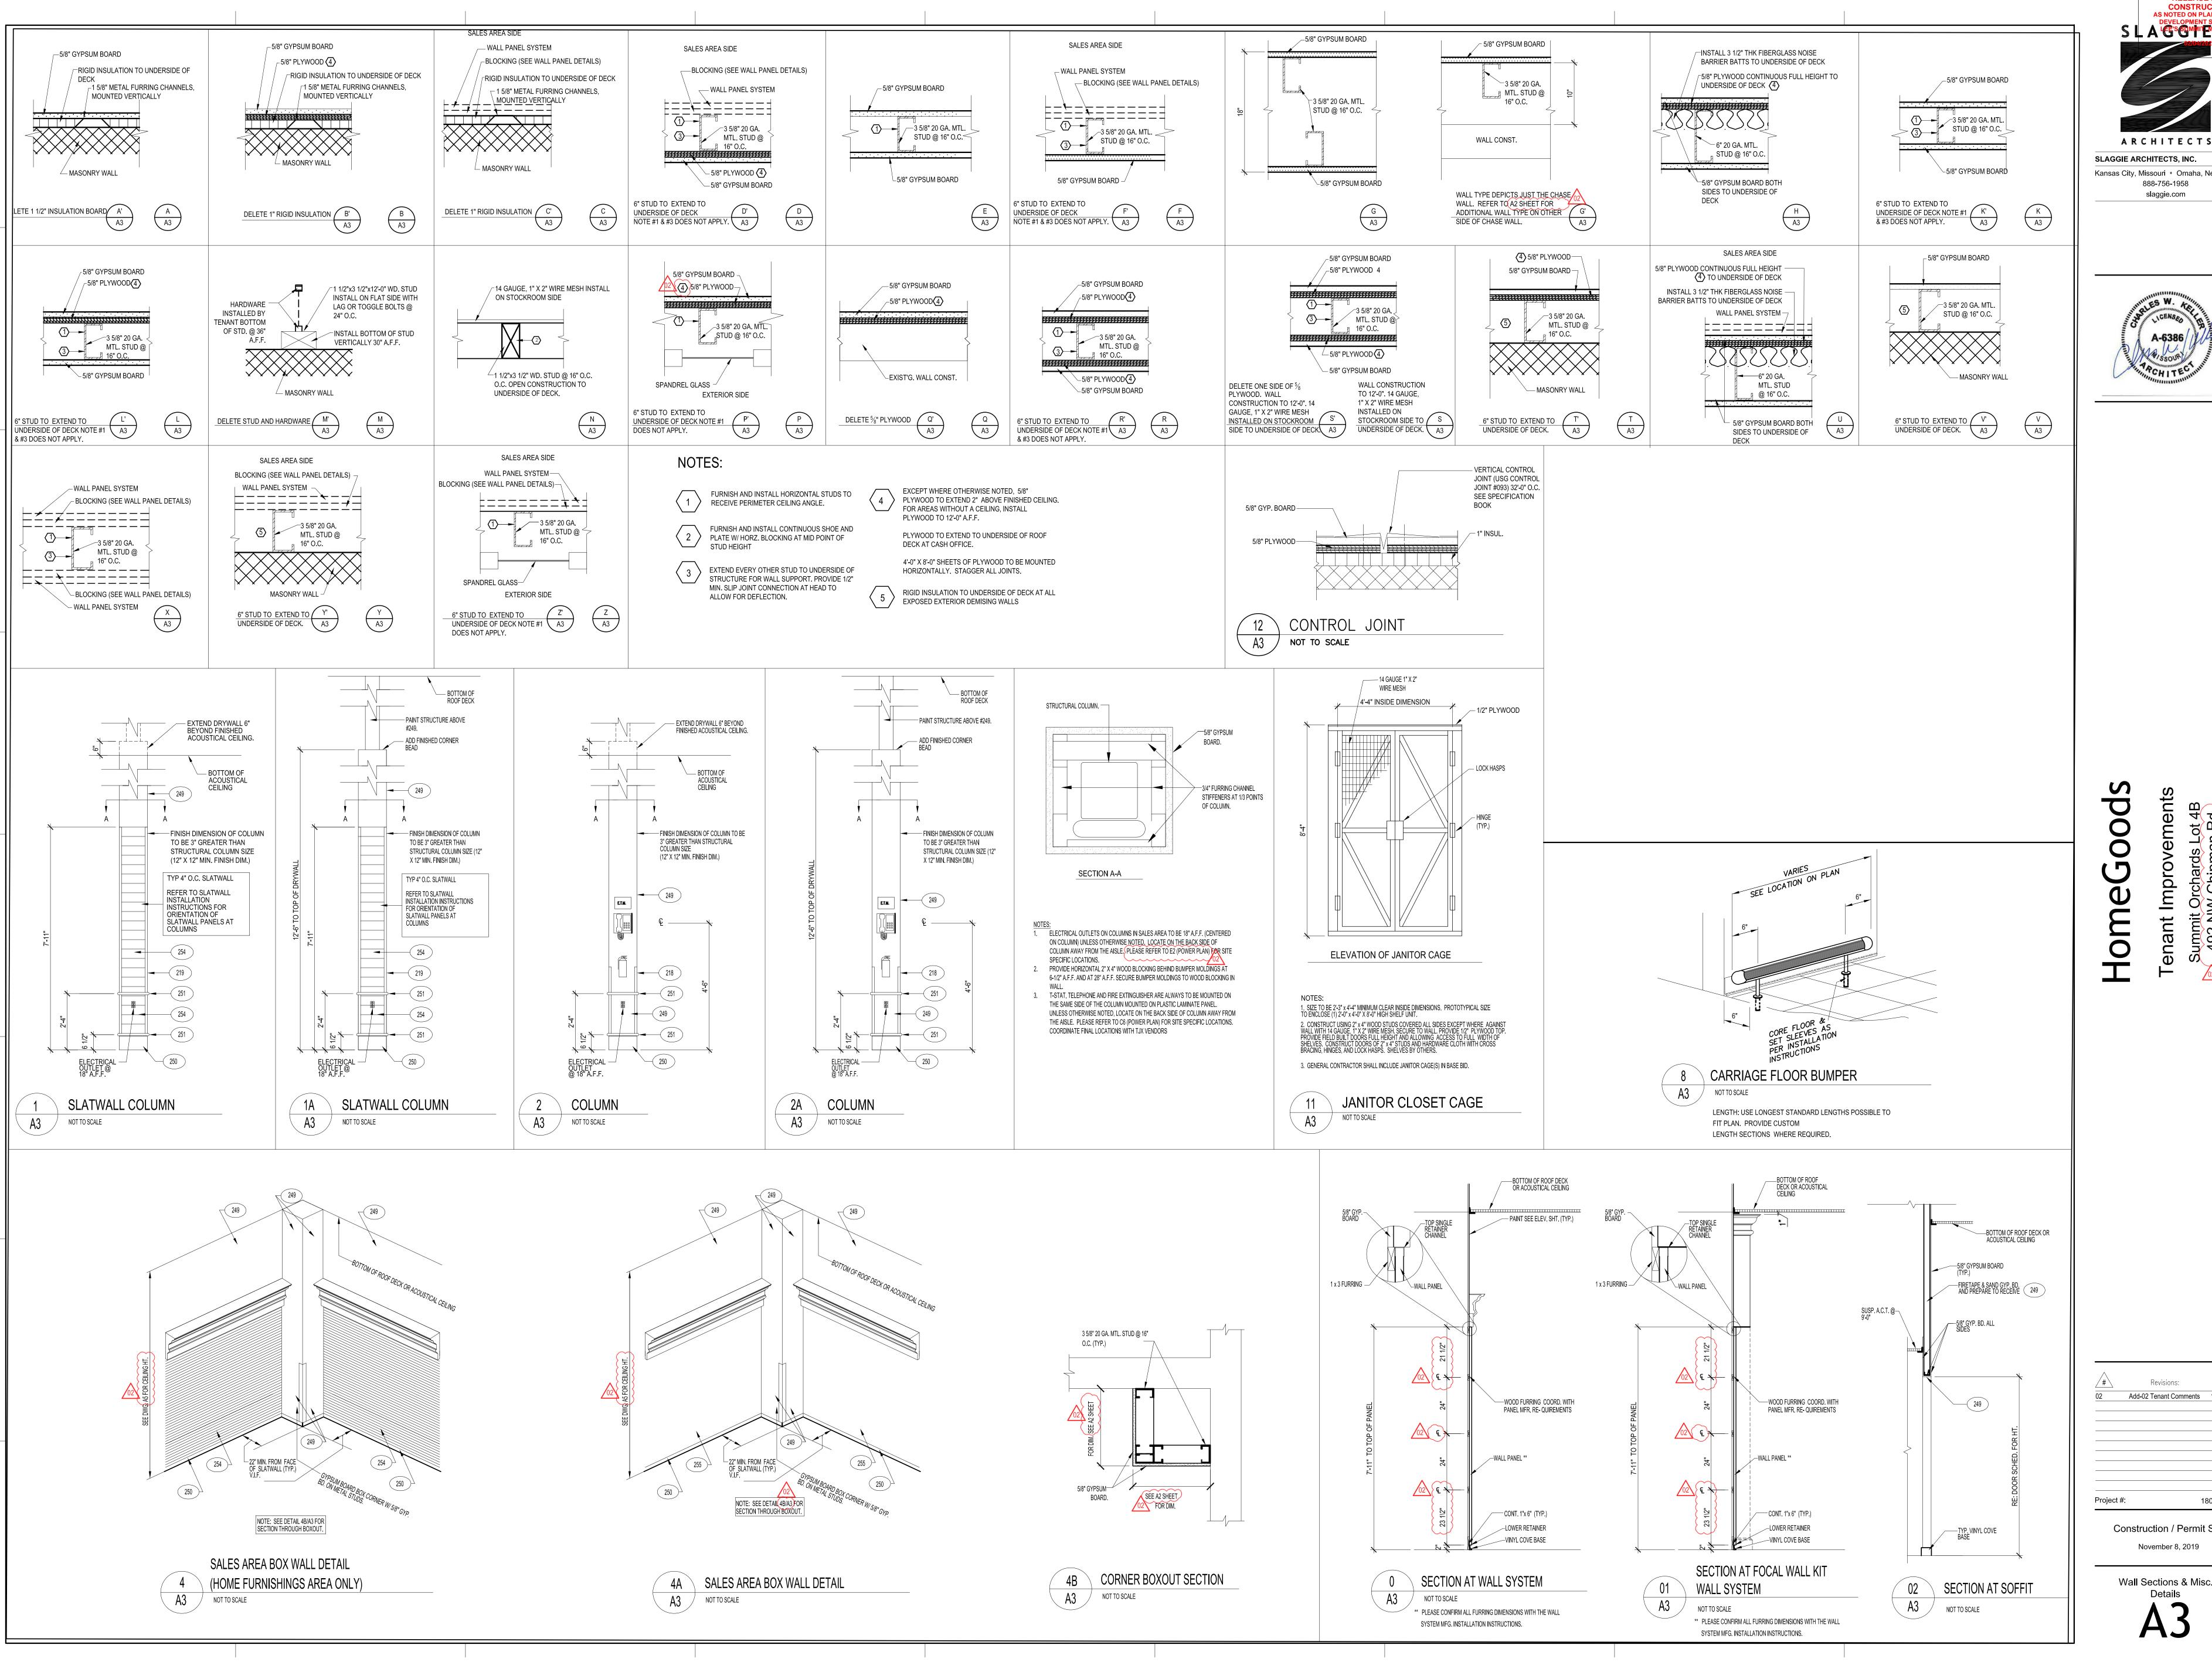


RELEASE FOR CONSTRUCTION AS NOTED ON PLANS REVIEW S A LE'S SIM IN MISSOURI ARCHITECTS SLAGGIE ARCHITECTS, INC. ©2018 Kansas City, Missouri • Omaha, Nebraska 888-756-1958

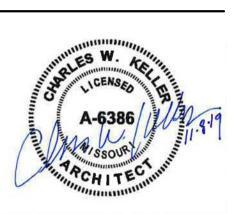




180902-02 Construction / Permit Set November 8, 2019

Details

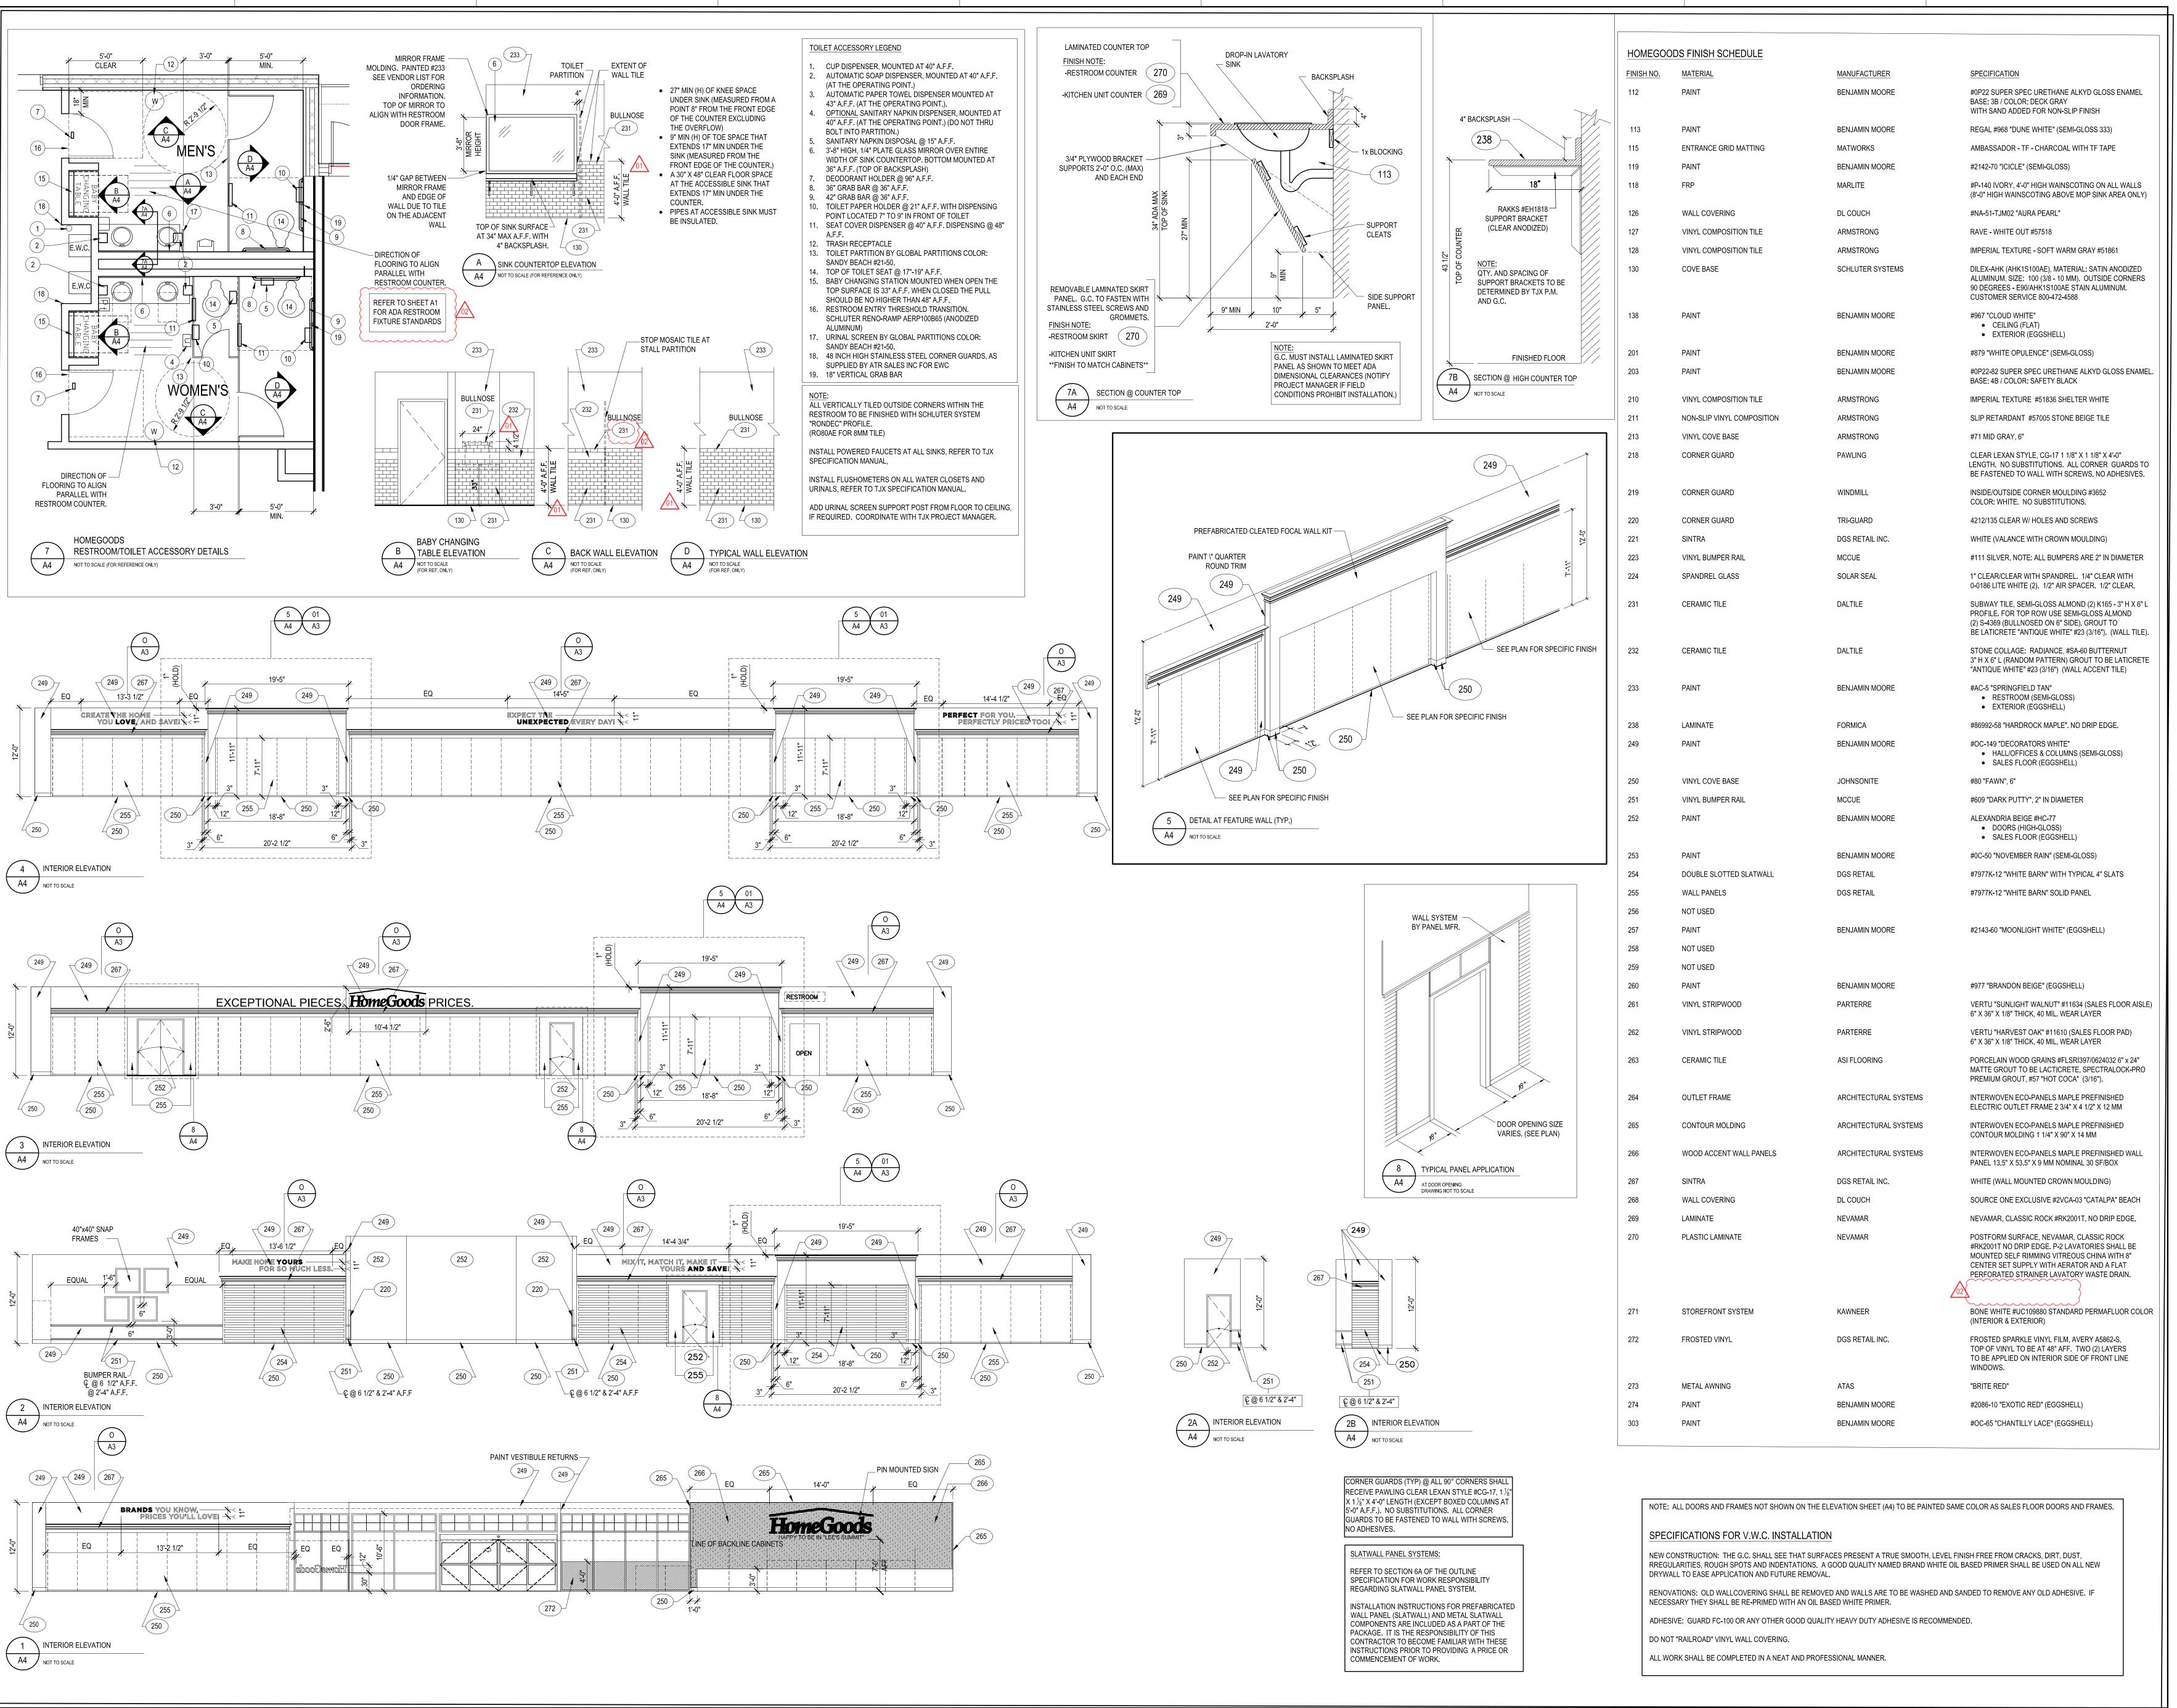



SLAGGIE ARCHITECTS, INC. ©2018 Kansas City, Missouri • Omaha, Nebraska 888-756-1958 slaggie.com

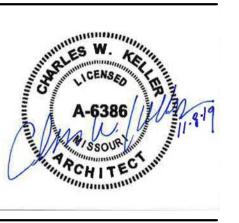


Add-01 City Comments 11-18-19 Add-02 Tenant Comments 12-18-19

180902-02

Construction / Permit Set November 8, 2019

Wall Sections & Misc.

Details

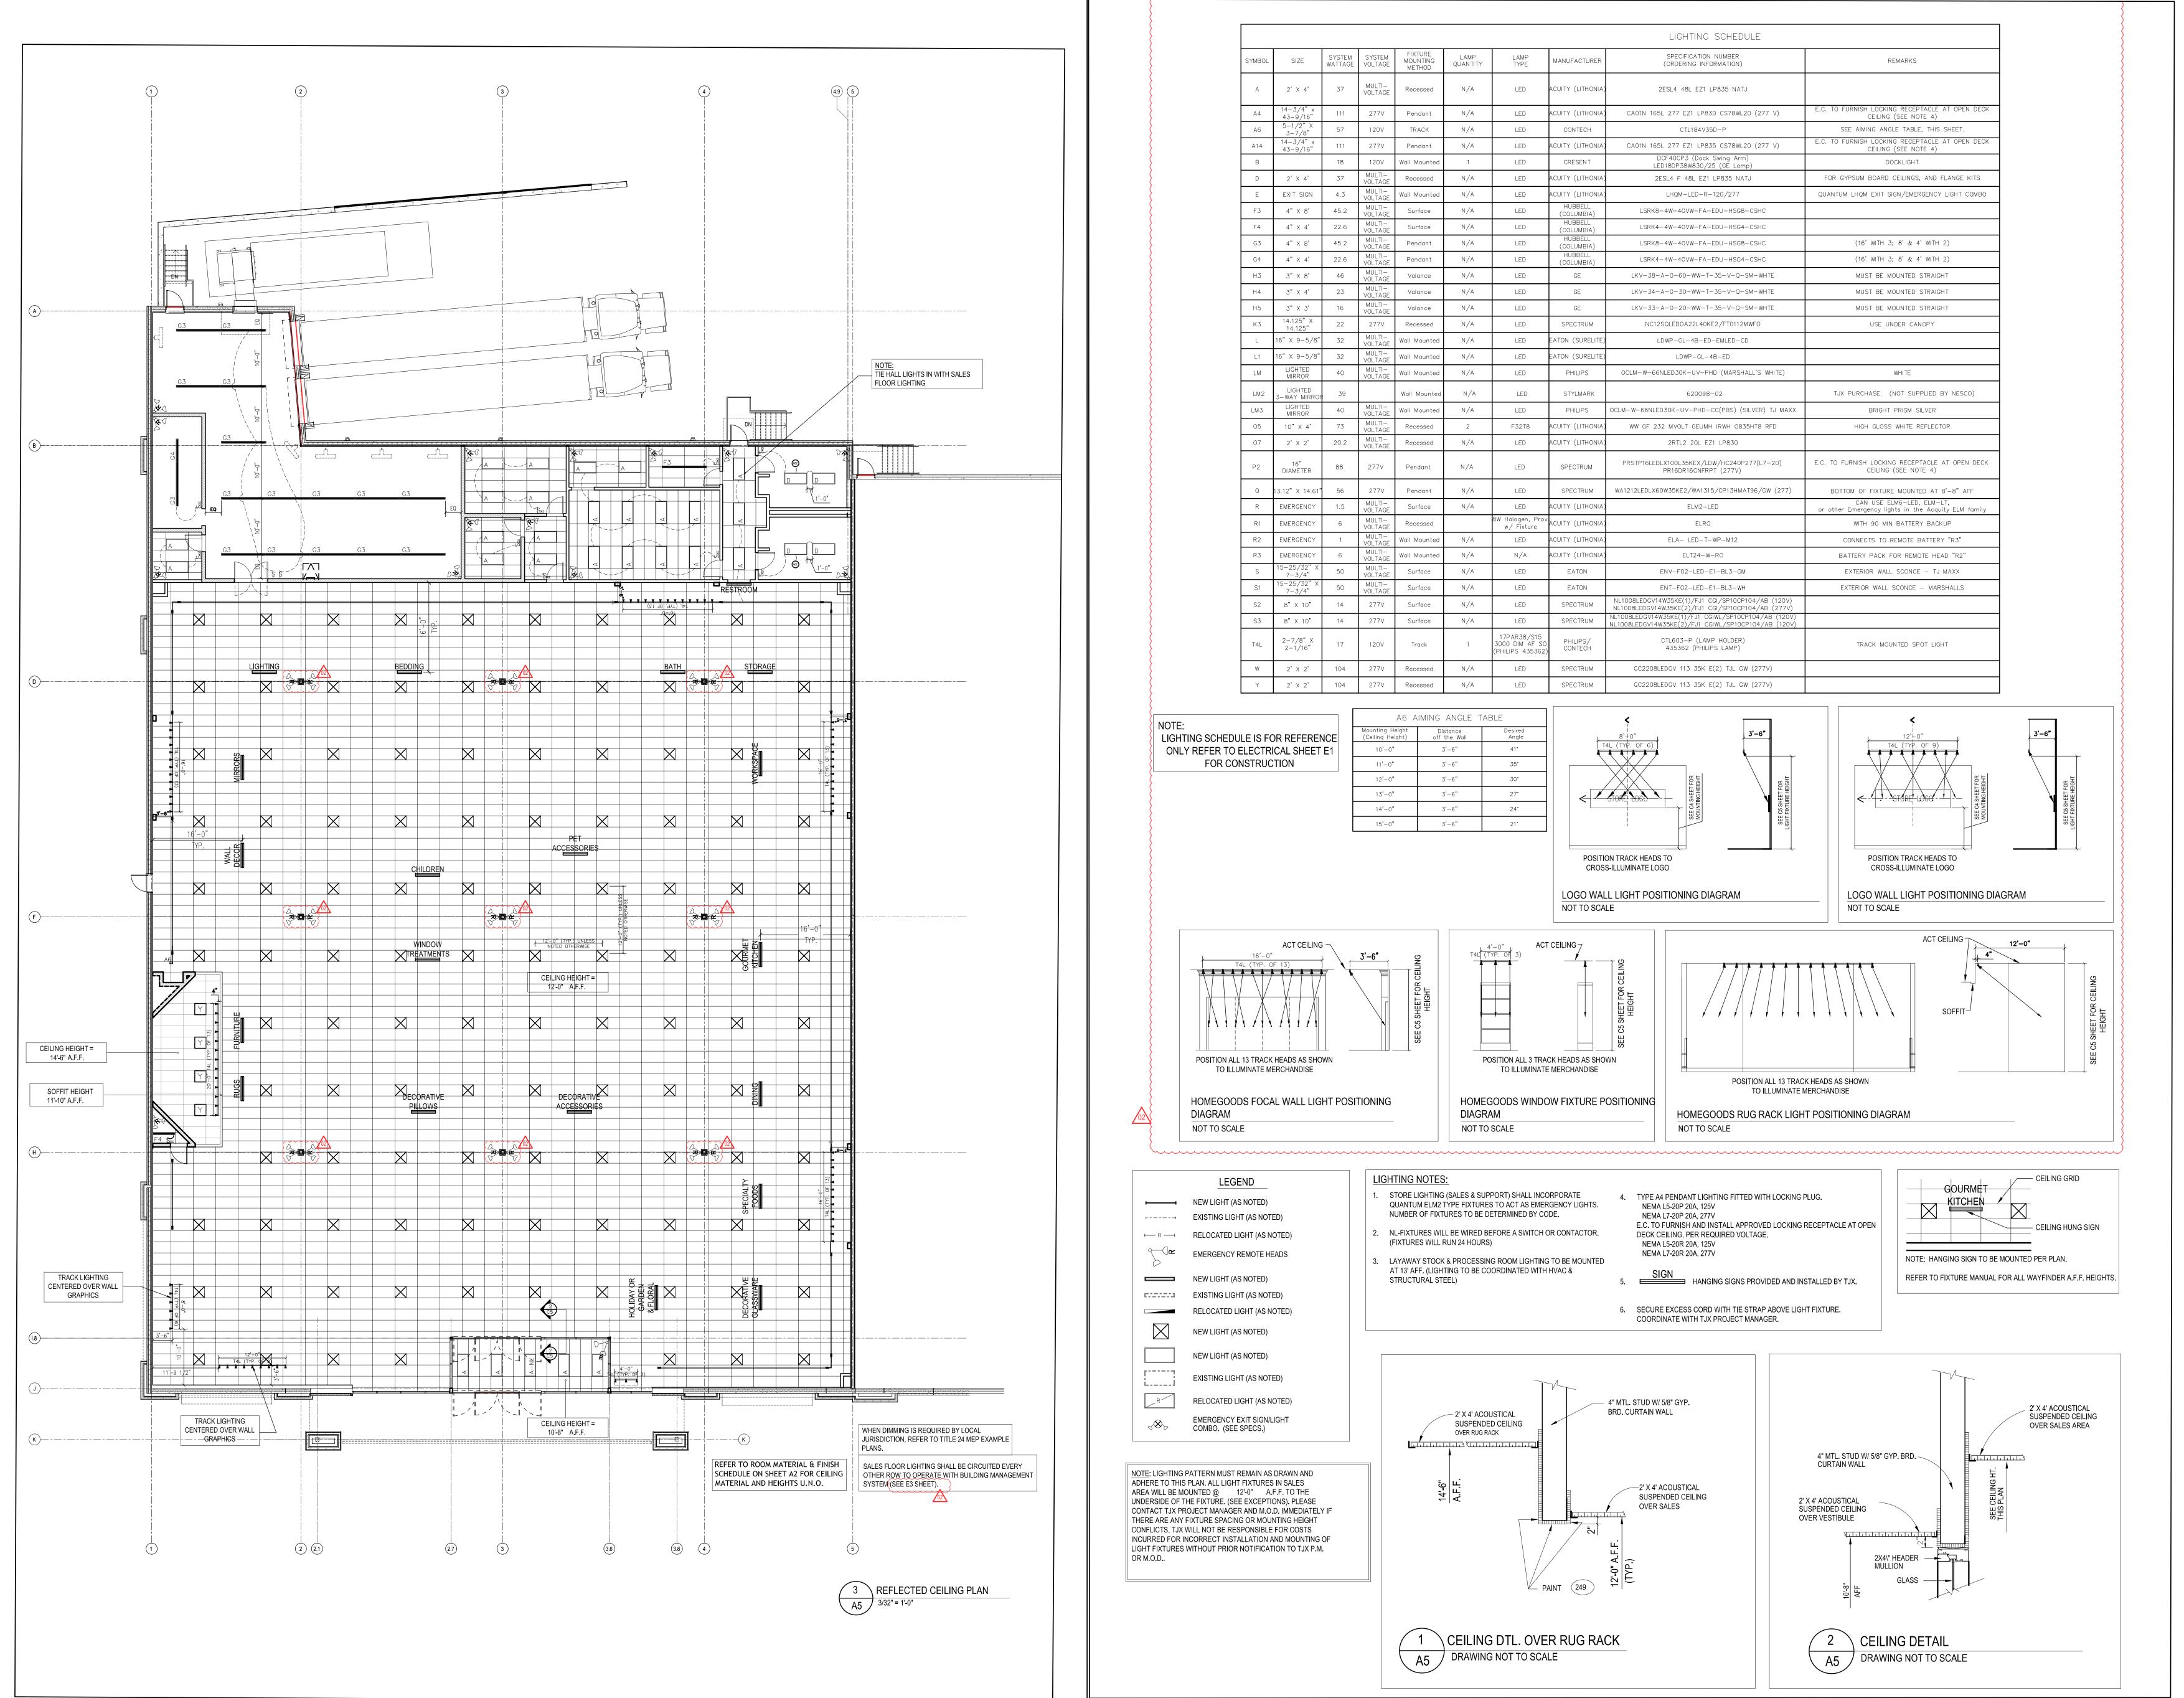




RELEASE FOR





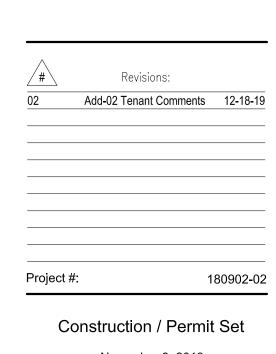


November 8, 2019

Reflected Ceiling

Plan

A5

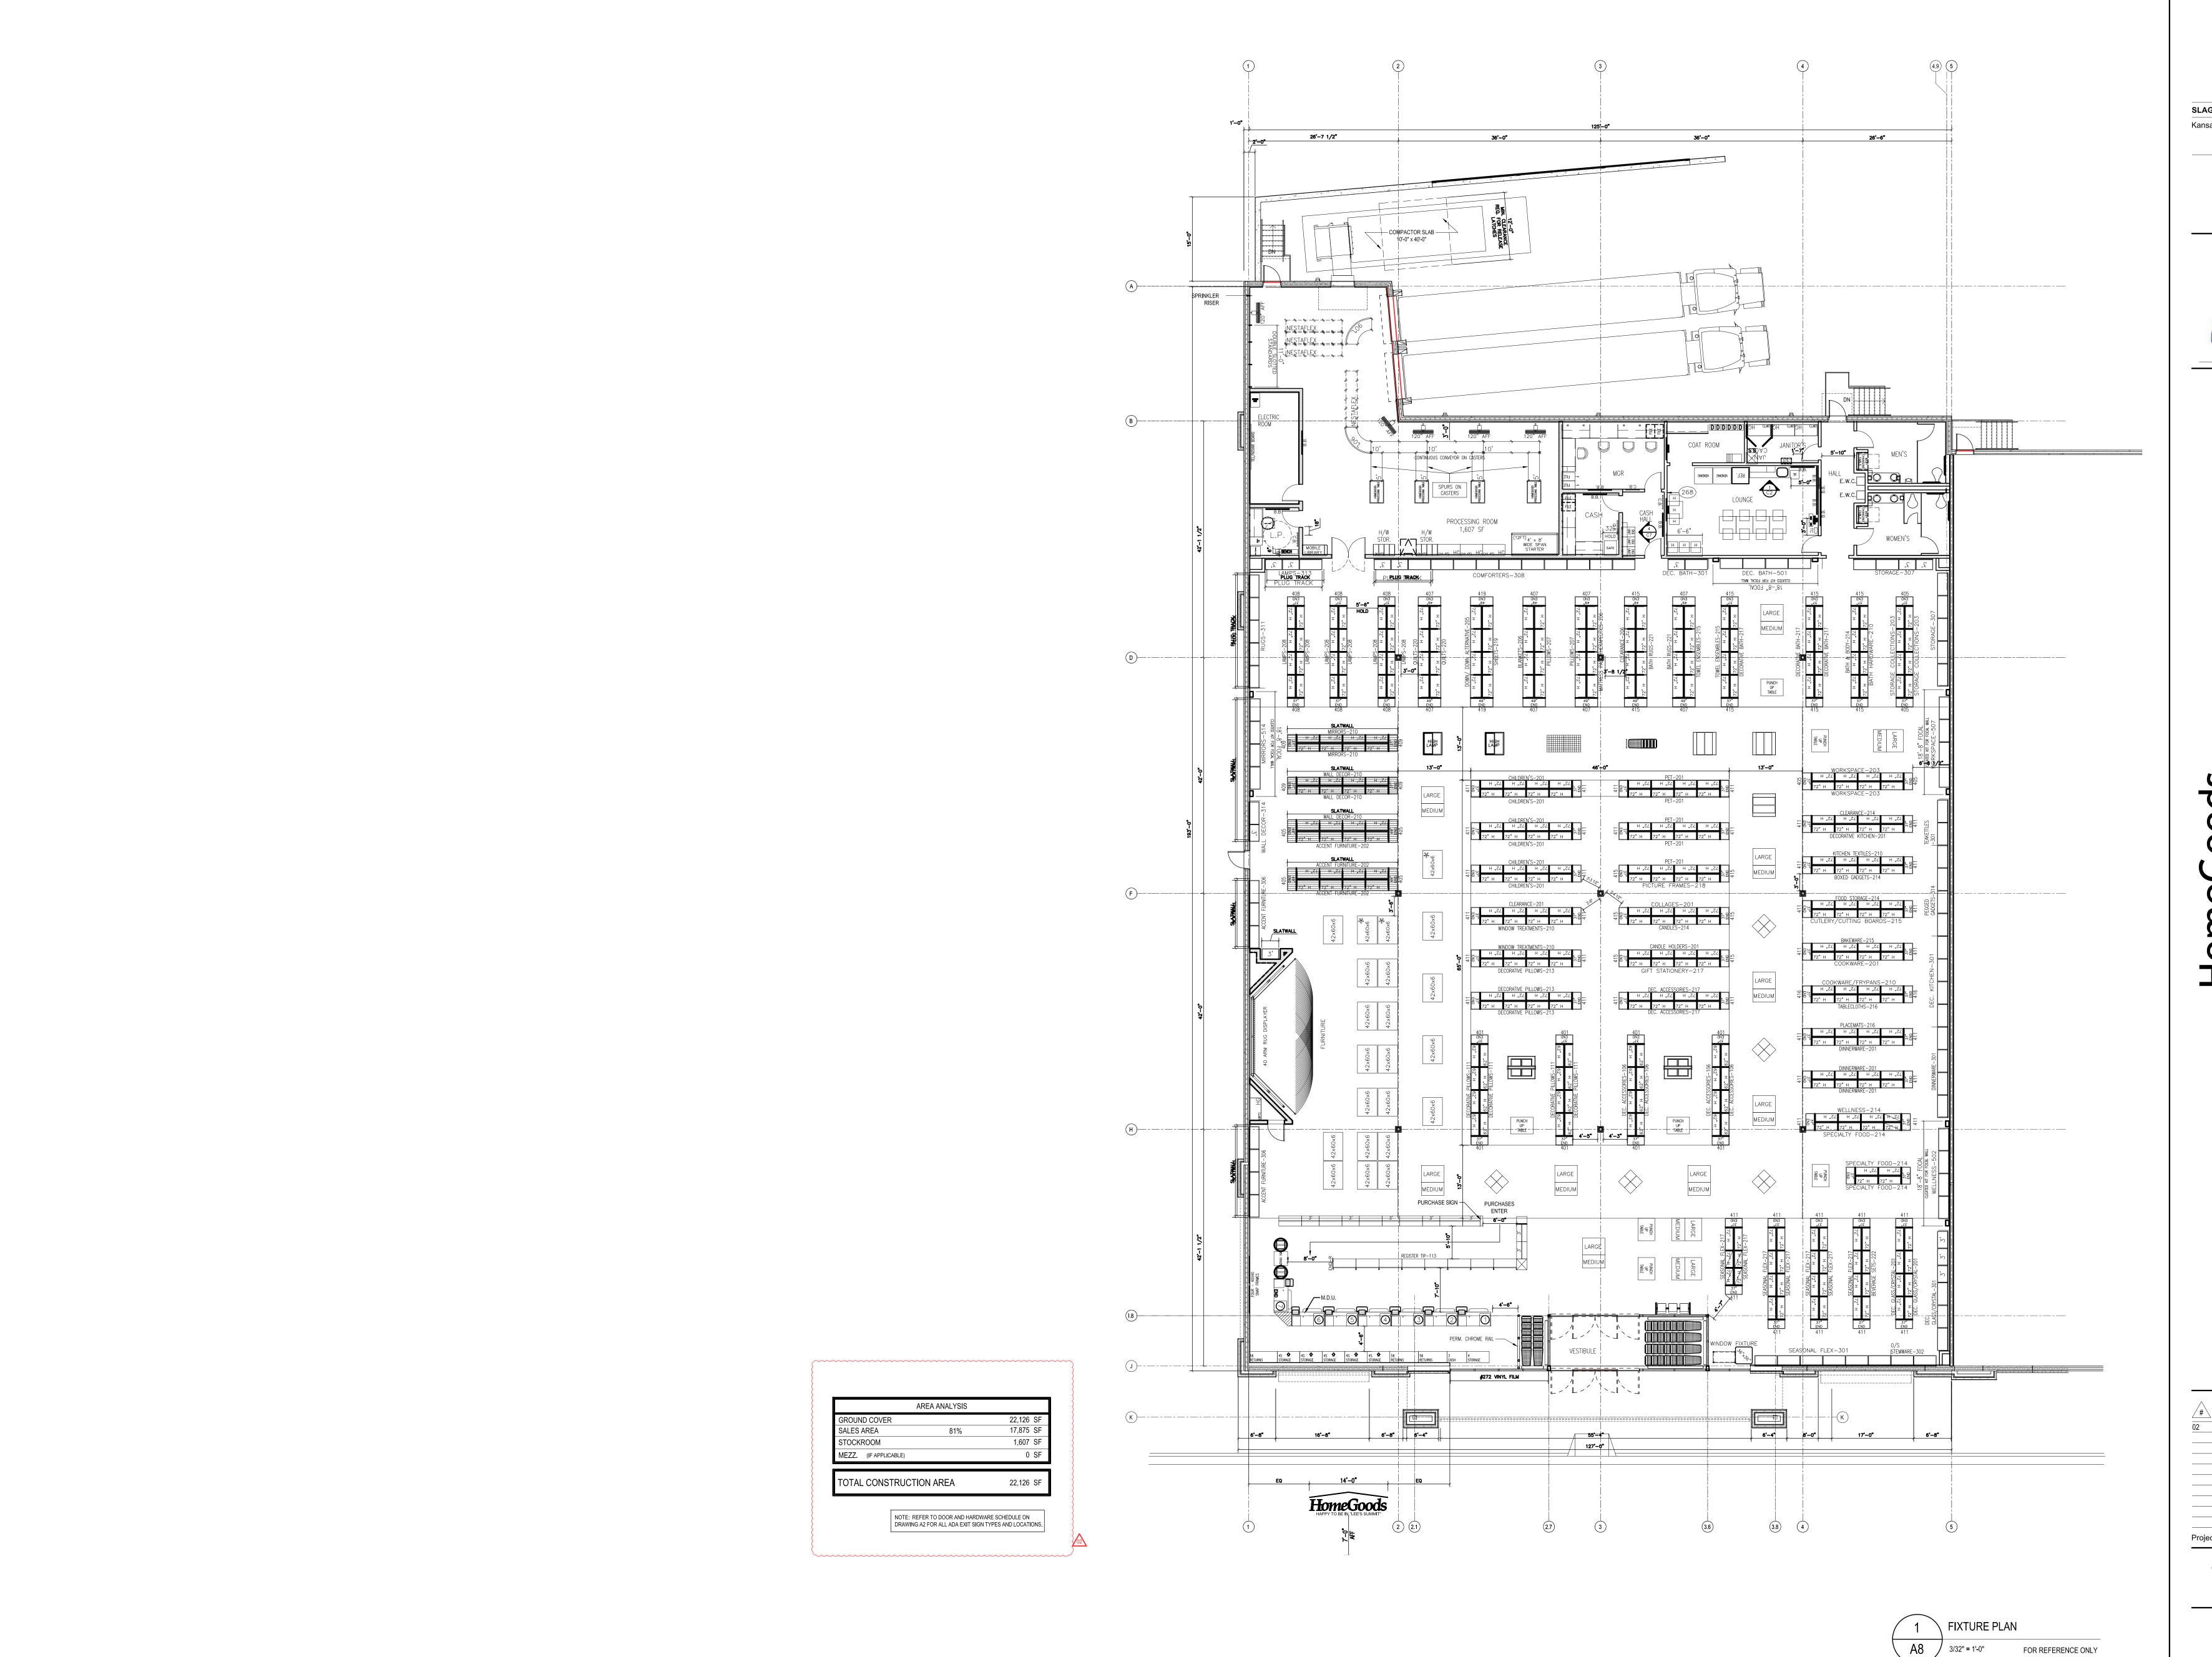



slaggie.com





Summit Orchards Lot 4B 492 NW Chipman Rd Lee's Summit, MO 64086


Revisions:

02 Add-02 Tenant Comments 12-18-19

Project #: 180902-02

Construction / Permit Set
November 8, 2019

Fixture Plan

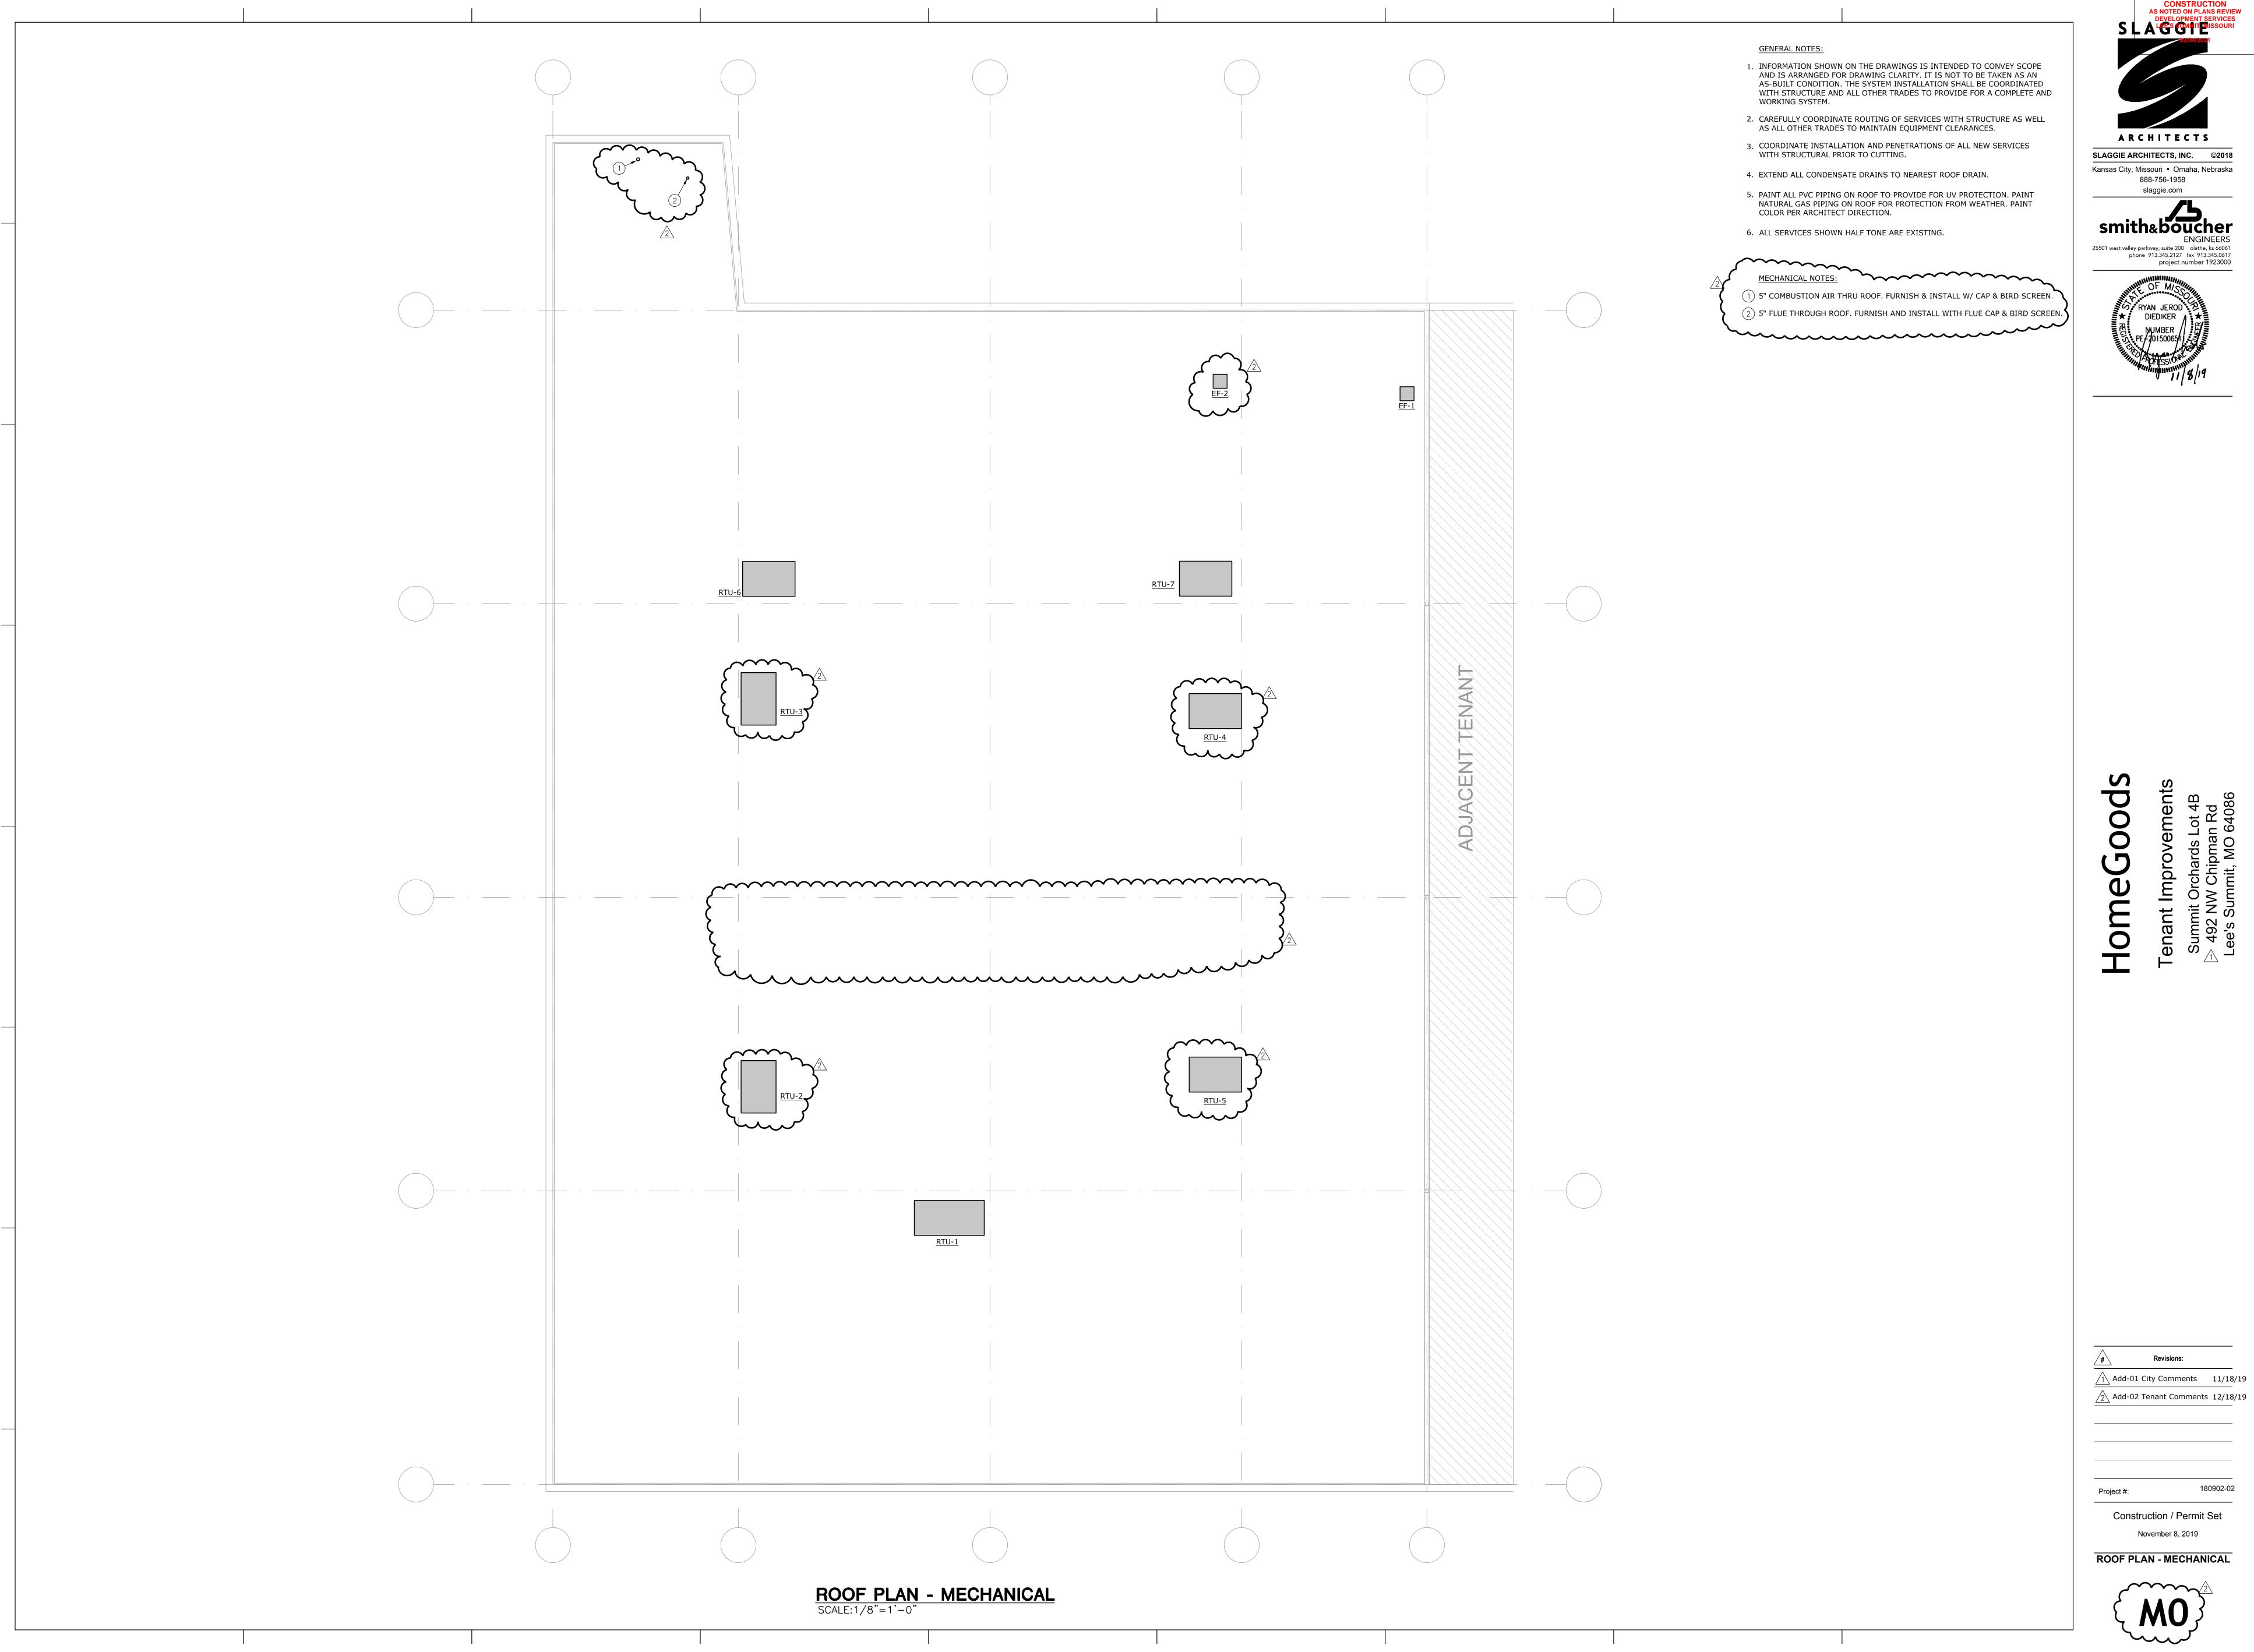


RELEASE FOR CONSTRUCTION
AS NOTED ON PLANS REVIEW

ARCHITECTS SLAGGIE ARCHITECTS, INC. ©2018

> 888-756-1958 slaggie.com

smith&boucher 25501 west valley parkway, suite 200 olathe, ks 66061 phone 913.345.2127 fax 913.345.0617 project number 1923000

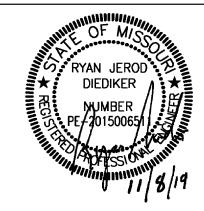

Construction / Permit Set November 8, 2019

**ROOF PLAN - MECHANICAL** 



#### **GENERAL NOTES:**

- 1. INFORMATION SHOWN ON THE DRAWINGS IS INTENDED TO CONVEY SCOPE AND IS ARRANGED FOR DRAWING CLARITY. IT IS NOT TO BE TAKEN AS AN AS-BUILT CONDITION. THE SYSTEM INSTALLATION SHALL BE COORDINATED WITH STRUCTURE, CEILINGS, WALLS, AND ALL OTHER TRADES TO PROVIDE FOR A COMPLETE AND WORKING SYSTEM.
- 2. ALL DUCTWORK IS SHOWN DIAGRAMMATICALLY AND DOES NOT INCLUDE ALL OFFSETS, DROPS, AND RISES. CAREFULLY COORDINATE DUCT ROUTING WITH STRUCTURE AS WELL AS ALL OTHER TRADES TO MAINTAIN EQUIPMENT CLEARANCES, EQUIPMENT ACCESSIBILITY, DESIRED CEILING HEIGHTS, AND AESTHETICS. THE CONTRACTOR SHALL
- 3. COORDINATE ALL DUCT PENETRATIONS WITH STRUCTURAL PRIOR TO CUTTING FLOORS OR BEARING WALLS.

INCLUDE ANY NEEDED OFFSETS AND CHANGES OF DIRECTION IN THE

- 4. WALL MOUNTED DEVICES SUCH AS THERMOSTATS, TEMPERATURE SENSORS, HUMIDITY SENSORS, AND PRESSURE SENSORS ARE SHOWN ON PLANS FOR CLARITY AND GENERAL REFERENCE OF LOCATIONS. LOCATIONS SHOW ARE NOT TO BE CONSIDERED THE EXACT MOUNTING LOCATION. COORDINATE THE INSTALLATION OF ALL WALL MOUNTED DEVICES WITH THE ARCHITECTURAL ELEVATIONS AND OTHER TRADES WALL MOUNTED DEVICES. GROUP THE INSTALLATION OF ALL THE DEVICES TO THE EXTENT POSSIBLE AND LOCATED DEVICES SUCH THAT THEY DO NOT CONFLICT WITH MILL WORK, TELEVISIONS, FURNITURE,
- THEY DO NOT CONFLICT WITH MILL WORK, TELEVISIONS, FURNITU TEACHING BOARDS, AND OTHER SIMILAR OBSTRUCTIONS.


  5. PROVIDE FIRESTOPPING AT PENETRATIONS OF ALL RATED WALLS.
- 6. FURNISH ALL EXPOSED DUCTWORK IN FINISHED SPACES WITH PAINTABLE FINISH.

REFER TO CODE PLANS FOR LOCATIONS OF RATED WALLS.

- DUCT SIZES SHOWN ARE SHEET METAL DIMENSIONS. WHERE DUCT LINER IS REQUIRED, DUCT SIZES ARE NOT REQUIRED TO BE INCREASED TO ACCOUNT FOR LINER.
- 8. ALL SERVICES SHOWN WITH HALF TONE LINE WEIGHT ARE EXISTING.
- 9. REFER TO NOVAR DRAWINGS FOR SENSOR LOCATIONS.

#### PLAN NOTES:

- 10"x10" EXHAUST DUCT UP TO ROOF EXHAUST FAN,  $\overline{\text{EF-1}}$ .
- (2) 10"x10" EXHAUST DUCT UP TO ROOF EXHAUST FAN, <u>EF-2</u>.
- 3 FURNISH AND INSTALL TPI MODEL CACU 24-W CIRCULATOR FAN. REFER TO DETAIL ON E2 FOR MORE INFORMATION.
- 4 5" DUCT UP THROUGH ROOF W/CAP & BIRD SCREEN FOR COMBUSTION AIR.
- 5 4" EXHAUST FLUE UP THROUGH ROOF.
- (6) MOUNTING ANGLE OF DIFFUSER TO BE 15° BELOW HORIZONTAL. REFER TO DETAILS ON M5.
- 7 CONNECT CONCENTRIC DIFFUSER TO RTU ON ROOF PER MANUFACTURER'S RECOMMENDATIONS.

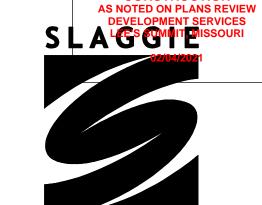


RELEASE FOR CONSTRUCTION

ARCHITECTS

SLAGGIE ARCHITECTS, INC. ©2018

Kansas City, Missouri • Omaha, Nebraska
888-756-1958
slaggie.com

smith&boucher
ENGINEERS
25501 west valley parkway, suite 200 olathe, ks 66061
phone 913.345.2127 fax 913.345.0617
project number 1923000

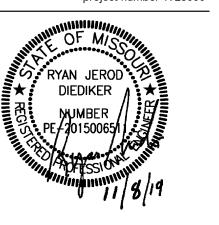

Tenant Improvem
Summit Orchards Lot

Revisions:

Add-01 City Comments 11/18/19

Add-02 Tenant Comments 12/18/19

Add-03 Tenant Comments 01/10/20


Project #:

Construction / Permit Set

November 8, 2019

MECHANICAL PLAN

**M1** 

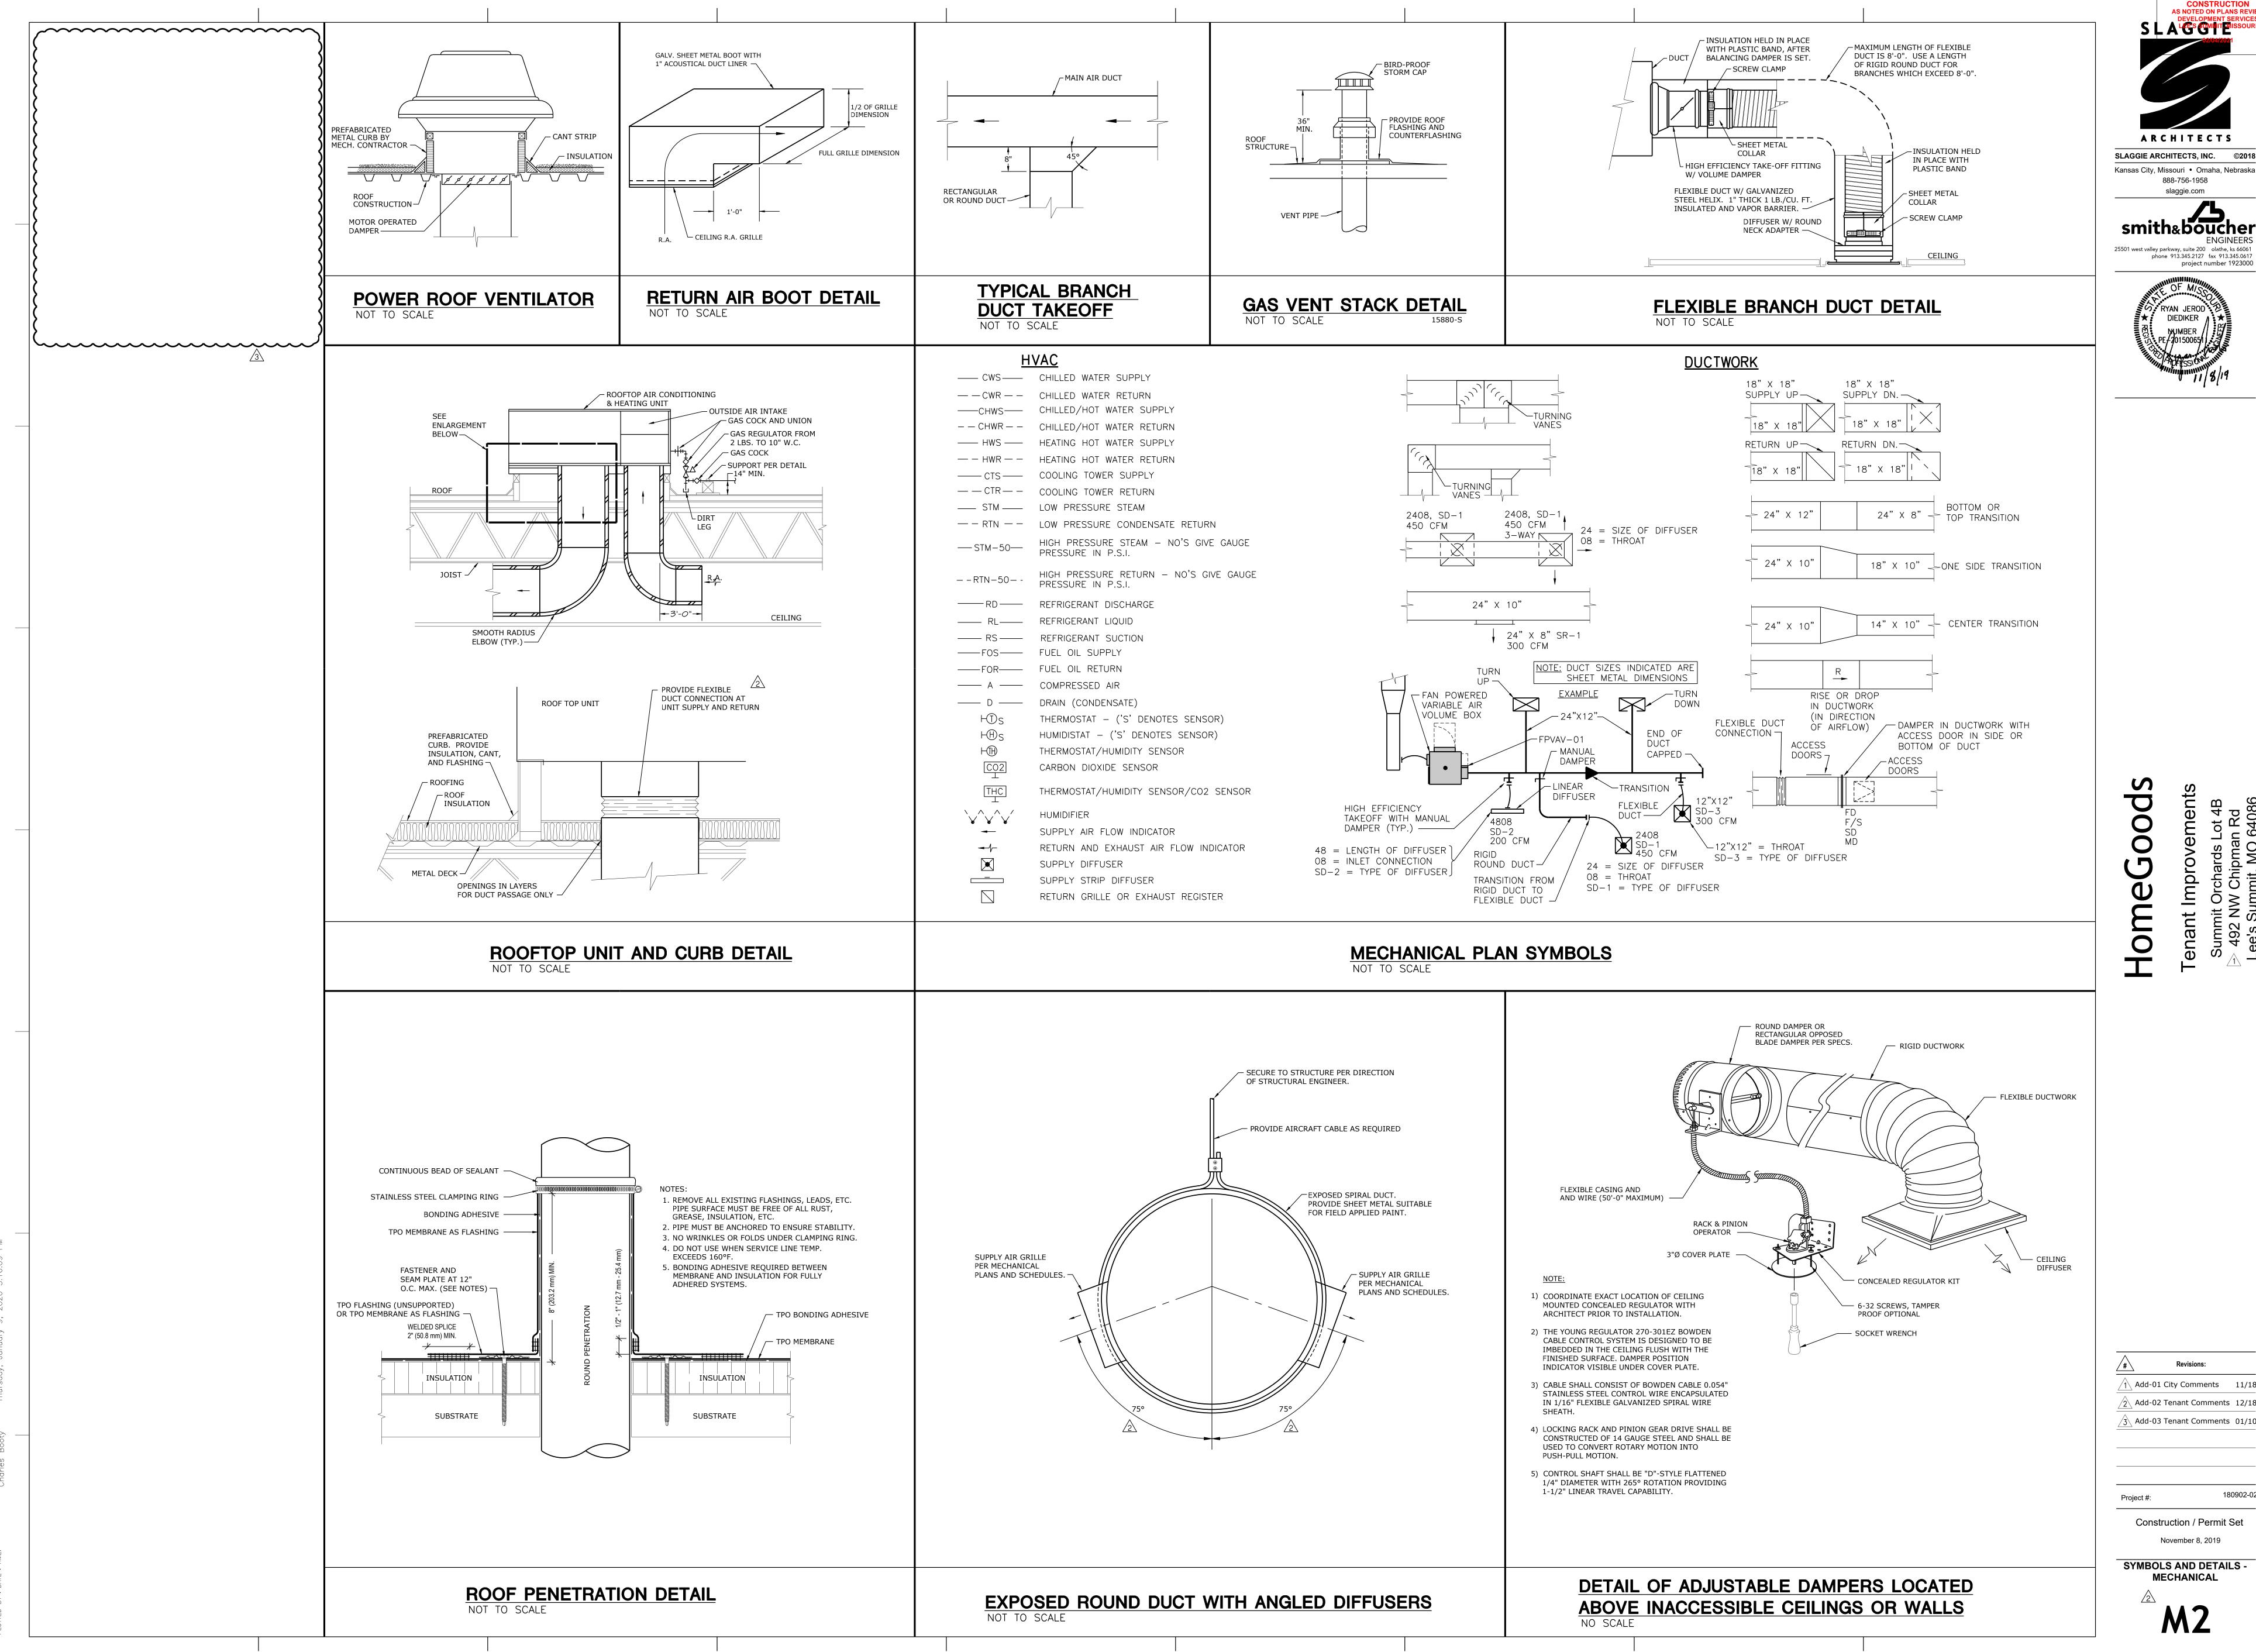

CONSTRUCTION AS NOTED ON PLANS REVIEW S L A LES COMMIT MISSOURI ARCHITECTS SLAGGIE ARCHITECTS, INC. ©2018 Kansas City, Missouri • Omaha, Nebraska

smith&boucher phone 913.345.2127 fax 913.345.0617



Add-01 City Comments 11/18/19 Add-02 Tenant Comments 12/18/19 Add-03 Tenant Comments 01/10/20

Construction / Permit Set

November 8, 2019

**SYMBOLS AND DETAILS -**

**M2** 

AND ASSURE PROPER FUNCTION OF CONTROLS. BALANCING CONTRACTOR SHALL BE AN INDEPENDENT CERTIFIED TEST AND BALANCE CONTRACTOR, WITH NEBB OR AABC CERTIFICATION. SUBMIT COMPLETED AND CERTIFIED TEST AND BALANCE REPORT TO OWNER'S REPRESENTATIVE. BALANCE ALL SYSTEMS TO WITHIN 5% OF AIR FLOWS INDICATED ON THE DRAWINGS, AND REPORT ALL DISCREPANCIES TO HVAC INSTALLER FOR CORRECTION. MARK FINAL BALANCE POSITIONS ON DAMPERS WITH PERMANENT MARKER.

A. CONTRACTORS AND SUB-CONTRACTORS SHALL CAREFULLY REVIEW THE CONSTRUCTION DOCUMENTS. INFORMATION REGARDING THE COMPLETE WORK IS DISPERSED THROUGHOUT THE DOCUMENT SET AND CANNOT BE ACCURATELY DETERMINED WITHOUT REFERENCE TO THE COMPLETE . COORDINATE WITH THE WORK OF OTHER SECTIONS, EQUIPMENT FURNISHED BY OTHERS, REQUIREMENTS OF THE OWNER, AND WITH THE

CONSTRAINTS OF THE EXISTING CONDITIONS OF THE PROJECT SITE PROVIDE DUCT RISES AND DROPS AS REQUIRED FOR FIELD INSTALLATION AND TRADE COORDINATION. NOTIFY ARCHITECT OF ANY DISCREPANCIES . DRAWINGS FOR HVAC WORK ARE DIAGRAMMATIC, SHOWING THE GENERAL LOCATION, TYPE, LAYOUT, AND EQUIPMENT REQUIRED. THE DRAWINGS SHALL NOT BE SCALED FOR EXACT MEASUREMENT. REFER TO ARCHITECTURAL DRAWINGS FOR DIMENSIONS. REFER TO MANUFACTURER'S STANDARD INSTALLATION DRAWINGS FOR EQUIPMENT CONNECTIONS AND INSTALLATION REQUIREMENTS. PROVIDE DUCTWORK, CONNECTIONS ACCESSORIES, OFFSETS, AND MATERIALS NECESSARY FOR A COMPLETE

ALL WORK SHALL COMPLY WITH STATE AND LOCAL CODE REQUIREMENTS AS APPROVED AND AMENDED BY THE GOVERNING CITY. PURCHASE ALL PERMITS ASSOCIATED WITH THE WORK. OBTAIN ALL INSPECTIONS . CONTRACTOR SHALL FIELD VERIFY THE EXACT LOCATIONS AND SIZES OF INDICATE ALL EXISTING UTILITIES.

ALL UTILITIES, INCLUDING THE DEPTHS OF ALL BELOW GRADE SANITARY SEWERS, PRIOR TO START OF WORK. THIS DRAWING IS NOT INTENDED TO CONTRACTOR SHALL BE FAMILIAR WITH LANDLORD'S STANDARDS, RULES AND REGULATIONS. ALL LANDLORD'S CRITERIA SHALL BE COMPLIED WITH AND INCLUDED IN THIS BID. CONTRACTOR SHALL VERIFY AND COORDINATE ALL UTILITY CONNECTION POINTS, INCLUDING SIZES AND INVERTS WITH EXISTING FIELD CONDITION PRIOR TO START OF WORK. MAKE ALL UTILITY CONNECTION AND INSTALLATION IN FULL ACCORDANCE WITH ALL UTILITY REGULATIONS. PROVIDE ALL ADDITIONAL APPURTENANCES AS REQUIRED BY UTILITY COMPANY. THE COMPLETED INSTALLATION SHALL BE IN ACCORDANCE WITH ALL APPLICABLE INDUSTRY STANDARDS OF GOOD PRACTICE AND SAFETY, AND THE MANUFACTURER'S STRICTEST RECOMMENDATIONS FOR EQUIPMENT AND PRODUCT APPLICATION AND

MAINTAIN ALL MANUFACTURER'S RECOMMENDED SERVICE CLEARANCES FOR ALL FIXTURES AND EQUIPMENT. ALL HORIZONTAL FIRE PROTECTION SPRINKLER PIPING AND ALL ABOVE GRADE EXPOSED SHALL BE INSTALLED AS HIGH AS POSSIBLE. SPRINKLER CONTRACTOR SHALL COORDINATE SPRINKLER SYSTEM WITH DUCTWORK AND LIGHTS. ALL COSTS ASSOCIATED WITH RAISING SPRINKLER PIPING WHERE THE ARCHITECTURAL DESIGN CAN NOT BE ACCOMPLISHED SHALL BE THE RESPONSIBILITY OF THE SPRINKLER CONTRACTOR. CONTRACTOR SHALL COORDINATE TIMES TO WORK IN SPECIFIC AREAS OF

THE EXISTING BUILDING WITH THE BUILDING MANAGER. SLEEVE AND SEAL ALL PIPE PENETRATIONS OF WALLS AND FLOORS. APPLY INTUMESCENT FIRE SAFING COMPOUND AT PENETRATIONS OF FIRE-RATED WALLS AND FLOORS, MAINTAINING INTEGRITY AND RATING OF FIRE SEPARATION. SLEEVES THROUGH FLOORS SHALL EXTEND 2" ABOVE LOOR, BE GROUTED INTO PLACE AND WATER PROOFED. PIPING THROUGH EXTERIOR WALLS SHALL BE SLEEVED AND SEALED WEATHER TIGHT WITH

M. ROOF TOP EQUIPMENT SHALL BE TAGGED WITH 2-1/2" HIGH PERMANENT LETTERS TO IDENTIFY SPACE SERVED. N. EXHAUST FANS / DUCTS AND ROOF VENTS SHALL TERMINATE A MINIMUM  $\parallel$ OF 15'-0" FROM OUTSIDE AIR INTAKES. D. USE OF COMBUSTIBLE MATERIALS IS NOT ALLOWED IN THE RETURN AIR PLENUM. MATERIALS USED IN THE PLENUM SHALL HAVE FLAME SPREAD RATING NOT TO EXCEED 25, AND SMOKE DEVELOPED RATING NOT TO EXCEED 50 WHEN TESTED IN ACCORDANCE WITH ASTM E 84. ALL EXPOSED WIRING IN THE PLENUM SHALL BE PLENUM RATED.

SEAL ROOF CURB TO MAINTAIN ROOFING WARRANTY. . CONTRACTOR TO DETERMINE IF ANY STRUCTURAL ELEMENTS SUCH AS REBAR OR POST TENSION CABLE EXIST IN FLOORS, WALLS OR ROOFS BY INSPECTION COORDINATED WITH THE LANDLORD'S TENANT COORDINATOR OR STRUCTURAL ENGINEER AND BY USE OF X-RAY WHEN REQUIRED PRIOR TO ANY CUTTING OR CORE DRILLING. IF SUCH ELEMENTS EXIST, REPORT THIS IMMEDIATELY TO THE ARCHITECT AND THE LANDLORD'S TENANT COORDINATOR FOR RESOLUTION PRIOR TO CUTTING OR DRILLING . VISIT SITE PRIOR TO BIDDING AND FIELD VERIFY EXISTING CONDITIONS. TAKE INTERFERENCES INTO CONSIDERATION.

DUCTWORK SHALL BE INSTALLED TIGHT TO UNDERSIDE OF ROOF STRUCTURE AS HIGH AS POSSIBLE TO AVOID OBSTRUCTIONS. PAINT INTERIOR OF ALL DUCTS VISIBLE THROUGH DIFFUSERS/GRILLES SPRINKLER CONTRACTOR SHALL COORDINATE SPRINKLER SYSTEM WITH DUCTWORK AND LIGHTS.

'. ALL ABANDONED HVAC EQUIPMENT SHALL BE REMOVED AND PROPERLY DISPOSED. CAP AND INSULATE ALL UNUSED ROOF OPENINGS. W. REPLACE ALL HVAC FILTERS JUST PRIOR TO STORE GRAND OPENING.

NOVAR INTERFACE SUMMARY (REFER TO TJX SPECIFICATIONS FOR DETAIL INFORMATION.)

NOVAR SYSTEM NOTES

GENERAL CONTRACTOR 1.1. PROVIDE 4'X8' PLYWOOD BACKBOARD IN ELECTRIC ROOM FOR NOVAR TO MOUNT THEIR EQUIPMENT. PHONE AND ETHERNET JACKS FOR THE NOVAR CONTROLLER WILL ALSO BE LOCATED

ON THIS BOARD BY SEPARATE TJX VENDOR.

MECHANICAL CONTRACTOR 2.1. HORIZONTALLY MOUNT 2X4 J-BOX WITH CONDUIT (WIREMOLD IF EXPOSED IN FINISHED AREAS) AT LOCATIONS DESIGNATED ON NOVAR CONTROLS SITE SPECIFIC PLANS. THE J-BOXES ARE SHALL BE MOUNTED 60" AFF EXCEPT IN FITTING ROOM LOCATIONS WHERE J-BOXES SHALL BE MOUNTED 84" AFF. ON SALES FLOOR J-BOXES SHALL BE MOUNTED ON BACK SIDE OF

COLUMNS WHEN VIEWED FROM FRONT OF STORE. 2.2. PROVIDE PERMANENT STRANDED 18/8 AWG NON SHIELDED CABLE (18/10 IF THE RTU IS EQUIPMED WITH A CO2 SENSOR) FROM EACH ROOFTOP UNIT TO THE NOVAR ETM (T-STAT) LOCATION SHOWN ON THE NOVAR PLAN THAT SUPERSEDÉS ANY

MECHANICAL PLAN LOCATIONS. ALL CONTROL DEVICES SHALL BE

APPROPRIATELY IDENTIFIED AND PERMANENTLY ATTACHED. 2.3. TEMPORARY THERMOSTATS SHALL BE INSTALLED AT THE ETM LOCATIONS AND THE ROOFTOP UNITS STARTED.

2.4. HVAC EQUIPMENT SHALL HAVE HAD MANUFACTURER'S RECOMMENDED STARTUP PROCEDURE PERFORMED AND BE OPERATIONAL IN ALL MODES BEFORE ARRIVAL OF NOVAR CONTROLS REPRESENTATIVE FOR FINAL NOVAR INSTALLATION.

2.5. IN COLD WEATHER THE CONTRACTOR SHALL PROVIDE TEMPORARY THERMOSTAT TO OPERATE THE HEATERS IN 2.6. BASEBOARD HEATERS SHALL BE FACTORY EQUIPPED WITH

INTEGRAL THERMOSTATS AND INSTALLED IN ALL OFFICES,

LOUNGE, RESTROOMS, AND SECURITY OFFICES WITH AT LEAST

ONE EXTERIOR WALL WHEN LOCATED IN CLIMATE ZONES 4 AND

5. THE CIRCUITING FOR BASEBOARD HEATING SHALL BE THROUGH GE RELAY PANEL. 2.7. ELECTRIC VESTIBULE HEATERS SHALL BE FACTORY EQUIPPED WITH LOW VOLTAGE CONTROLS, INCLUDING BUT NOT LIMITED TO THE FOLLOWING: POWER CONTACTORS, LOW VOLTAGE TRANSFORMER, AND TWO WIRE FIELD TERMINATION CONTROL

. <u>ELECTRICAL CONTRACTOR</u>

3.1. PROVIDE THREE PHASE CIRCUIT BREAKER (20 AMPS) FOR THE VERIS WATTS TRANSDUCER. THIS BREAKER MAY BE INSTALLED IN A LIGHTING DISTRIBUTION PANEL IF THE PANEL IS OF THE SAME VOLTAGE AS THE MAIN DISTRIBUTION PANEL.

3.2. INSTALL NOVAR PROVIDED CURRENT TRANSFORMERS (CTS). 3.3. CONNECT ALL CT WIRING TO THE VERIS WATTS TRANSDUCER.

3.4. MOUNT AND POWER THE VERIS WATTS TRANSDUCER. 3.5. PROVIDE BMS# (20 AMP, 1 POLE BREAKER AND BMS#2 (20 AMP, 1 POLE BREAKER) POWER SUPPLY. THESE BREAKERS MUST ORIGINATE FROM THE SAME PHASE.

3.6. THE INSTALLATION PROGRAMMING, AND LABELING OF THE GE SOFTWIRE PANEL IS THE RESPONSIBILITY OF THE GENERAL CONTRACTOR & GENERAL CONTRACTOR'S AGENTS.

TJX GROUP OF COMPANIES HAS A NATIONAL ACCOUNT AGREEMENT WITH YORK. AIR CONDITIONING UNITS ARE OWNER FURNISHED. THE INSTALLING CONTRACTOR IS RESPONSIBLE FOR COORDINATING AND ACCEPTING THE EQUIPMENT. VERIFYING PROPER QUANTITIES, PROVIDING TEMPORARY STORAGE, LABOR, PROPER INSTALLATION, <u>AND</u> ONE YEAR LABOR

FOR COMPLETE INFORMATION ON THE OWNER FURNISHED HVAC EQUIPMENT CONTACT YORK NATIONAL ACCOUNTS AT PHONE: (800)481-9738, FAX: (866) 406-9675.

YORK NATIONAL ACCOUNT

FOR ALL OTHER INQUIRIES CONTACT DAN BILANCIA. NATIONAL ACCOUNT PRODUCT SPECIALIST AT (405)419-6537 FAX: (866)406-9675 OR EMAIL: dan.bilancia@jci.com.

STANDARD LEADTIME FOR YORK RTU HVAC EQUIPMENT IS FOUR (4)

NOTE: ORDERING PROCEDURES YORK NATIONAL ACCOUNTS DEPARTMENT WILL ORDER EQUIPMENT AND COORDINATE SHIPMENT WITH THE SUCCESSFUL HVAC CONTRACTOR. THE HVAC CONTRACTOR WILL BE RESPONSIBLE FOR DELIVERY COORDINATION, RECEIVING AND INSTALLATION AS DESCRIBED IN THE SPECIFICATIONS.

WEEKS MANUFACTURING PLUS ONE (1) WEEK TRANSPORTATION DEPENDING ON THE LOCATION IN THE 48 STATES. ANY NON-STANDARD OPTION MAY ADD TO THE STANDARD MANUFACTURING LEADTIME AND WILL BE CONFIRMED AT PLACEMENT OF \*HVAC EQUIPMENT WITH FACTORY TECHNICOAT COATING OF CONDENSER

COILS WILL HAVE AN ELEVEN WEEK LEADTIME.

NOTE: EQUIPMENT START-UP INSTRUCTION

YORK IS RESPONSIBLE FOR STARTUP AND COMMISSIONING OF THE ROOFTOP UNITS.

U	NIT HEATER SCHEDUL	.E - GAS			
DES	IGNATION	GCUH-1			
HEA	TER TYPE	TUBULAR			
LOC	ATION	PROCESSING			
MOL	INTING	WALL			
MAN	IUFACTURER	STERLING			
MOE	DEL	TF-200			
	CFM	3200			
Υ	VENT SIZE (IN)	5			
JNIT DATA	HEATER INPUT (MBH)	200			
Z	HEATER OUTPUT (MBH)	166			
	VOLTAGE/PHASE	120/1			
	PANEL & CIRCUIT				
. DA	WIRE & CONDUIT				
CTRL	OVERCURRENT DEVICE				
ELEC./CTRL. DATA	DISCONNECT				
ᆸ	CONTROL	NOTE 1			
REF	ERENCE DRAWING/DETAIL	M1			
REM	ARKS	2			

NOTES: 1: PROVIDE CONTROL THROUGH NOVAR CONTROLLER TEMPERATURE SENSOR AND CONTROL RELAYS.

FA	N SCHEDULE				
	GNATION	EF-1	EF-2		
SERV	/ICE	RESTROOM	LOUNGE		
MAN	UFACTURER	YORK	YORK		
FAN	TYPE	DOWNBLAST	DOWNBLAST		
MOD	EL	EVD13Q	EVD10R		
WEIG	GHT (LBS)	40	29		
	CFM	650	220		
	STATIC PRESSURE	0.5	0.5		
UNIT DATA	FAN RPM	1177	1217		
	BRAKE HORSEPOWER	314 W	0.038		
	MOTOR HORSEPOWER	1/4	1/12		
	DRIVE	DIRECT	DIRECT		
	SONES	4.7	3.9		
TA	VOLTAGE/PHASE	120/1	120/1		
L DA	PANEL & CIRCUIT	AL-10	AL-12		
IRO	WIRE & CONDUIT	(2)#12, #12G., 1/2"C.	(2)#12, #12G., 1/2"C.		
NO.	OVERCURRENT DEVICE	15A-1P CB	15A-1P CB		
ELECTRL./CONTROL DATA	DISCONNECT	30A-1P NF	30A-1P NF		
ECT	CONTROL	NOTE 1	NOTE 1		
E	DAMPER TYPE	PARALLEL BLADE	PARALLEL BLADE		
REFE	RENCE DRAWING/DETAIL	MO	MO		
REMA	ARKS	2	2, 3		

1: COORDINATE WITH CONTROL CONTRACTOR FOR VOLTAGE REQUIRED.

2: PROVIDE WITH FAN SPEED CONTROLER 3: FAN TO BE CONTROLLED BY WALL MOUNTED TOGGLE ON/OFF SWITCH IN LOUNGE AREA.

SERVICE	INSULATION
CASINGS, HOUSINGS AND PLENUMS	2", 6 LB. FIBERGLASS BOARD, GCVB
CONCEALED DUCTWORK AS FOLLOWS:	1-1/2", 1.5 LB. RIGID FIBERGLASS BLANKET, VAPOR BARRIER FACED,
ALL ROUND SUPPLY AIR AND UNLINED BRANCH TAKE-OFFS FOR ROUND DUCTS	WITH HEAVY DUTY FOIL-SCRIM-KRAFT FACING.
AND IN-LINE TRANSITIONS.	
EXHAUST AIR BETWEEN ISOLATION DAMPER AND PENTRATION OF BUILDING EXTERIOR	
RELIEF AIR	

1: SEE DUCTWORK SCHEDULE FOR ITEMS THAT ARE TO BE LINED.

2: EXPOSED, LOW PRESSURE, ROUND AND FLAT OVAL SUPPLY AIR DUCTWORK IS NOT INSULATED.

RC	OOFTOP UNIT SCHEDULE - GA	SHEAT						
DES	IGNATION	RTU-1	RTU-2	RTU-3	RTU-4	RTU-5	2 RTU-6	RTU-7
MAN	UFACTURER	YORK	YORK	YORK	YORK	YORK	YORK	YORK
MOD	DEL NO.	ZJ150N18R4D5HCA1R1	ZJ120N18R4D5HCA1R2	ZJ120N18R4D5HCA1R2	ZJ120N18R4D5HCA1R2	ZJ120N18R4D5HCA1R2	ZJ078N12R4B5HCA1R2	ZT061N08R4B5HCA1R1
	CFM	5000	4000	4000	4000	4000	2600	1760
	TOTAL COOLING CAPACITY (MBH)	170.8	108	108	108	108	80.4	52.4
	SENSIBLE COOLING CAPACITY (MBH)	121.3	81.3	81.3	81.3	81.3	58.8	37.7
CAPACITY	ENT. AIR (DB/WB)	80/67	80/67	80/67	80/67	80/67	80/67	80/67
AP.	LVG. AIR (DB/WB)	57.5/56.1	58.1/57.0	58.1/57.0	58.1/57.0	58.1/57.0	59.1/57.2	58.2/56.6
	MINIMUM E.E.R.	12.0	12.0	12.0	12.0	12.0	11.8	14
	HEATING INPUT (MBH)	180	180	180	180	180	120	80
	HEATING OUTPUT (MBH)	144	144	144	144	144	96	65
	OUTSIDE AIR CFM	800	850	950	900	750	300	200
	TOTAL S.P. (IN. W.C.)	1.0	1.0	1.0	1.0	1.0	1.0	1.0
	FAN BRAKE HP	5.10	2.95	2.95	2.95	2.95	1.97	1.12
⋖	FAN MOTOR HP	5.75	3.5	3.5	3.5	3.5	2.0	1.50
DATA	NO. OF COMPRESSORS	2	2	2	2	2	2	2
UNIT	STAGES OF COOLING	2	2	2	2	2	2	2
)	SMOKE DETECTORS	YES, NOTE 3	YES, NOTE 3	YES, NOTE 3	YES, NOTE 3	YES, NOTE 3	YES, NOTE 3	YES, NOTE 3
	RECEPTACLE	NOTE 4	NOTE 4	NOTE 4	NOTE 4	NOTE 4	NOTE 4	NOTE 4
	POWERED RELIEF	NO	YES	YES	YES	YES	NO	NO
	ECONOMIZER OPERATION	YES	YES	YES	YES	YES	YES	YES
	TYPE	2" MERV 13	2" MERV 13	2" MERV 13	2" MERV 13	2" MERV 13	2" MERV 13	2" MERV 13
FILT	MIN. SQ. FT. AREA							
	VOLTAGE/PHASE	480/3	480/3	480/3	480/3	480/3	480/3	480/3
	MINIMUM CIRCUIT AMPACITY	41.3	29.2	29.2	29.2	29.2	18.5	14.6
Ä.	MAXIMUM OVERCURRENT PROTECTION	50	35	35	35	35	20	20
ELECT./CONT	PANEL & CIRCUIT	AH-19,21,23	AH-25,27,29	AH-31,33,35	AH-37,39,41	AH-20,22,24	AH-26,28,30	AH-32,34,36
ECT	WIRE & CONDUIT	(3)#6, #10G., 3/4" C.	(3)#10, #10G., 1/2" C.	(3)#12, #12G., 1/2" C.	(3)#12, #12G., 1/2" C.			
П	OVERCURRENT DEVICE	50A/3P CB	35A/3P CB	35A/3P CB	35A/3P CB	35A/3P CB	20A/3P CB	20A/3P CB
	DISCONNECT	60A/3P NF	60A/3P NF	60A/3P NF	60A/3P NF	60A/3P NF	30A/3P NF	30A/3P NF
	CONTROL SEQUENCE	RE: DRAWINGS	RE: DRAWINGS	RE: DRAWINGS	RE: DRAWINGS	RE: DRAWINGS	RE: DRAWINGS	RE: DRAWINGS
REF	ERENCE DRAWING/DETAIL	MO	MO	MO	MO	MO	MO	MO

NOTE 1, 2, 5,

1: PROVIDE WITH SINGLE POINT POWER CONNECTION.

2: FURNISH WITH FACTOR INSTALLED ROOF CURB, ETHALPY ECONOMIZER CONTROLLER, BURGLAR BARS, AND HAIL GUARD KIT.

3: FURNISH WITH FACTOR INSTALLED SMOKE DETECTOR IN RETURN AIR DUCT SECTION. FIRE ALARM CONTRACTOR TO CONNECT TO FIRE ALARM CONTROL PANEL AS REQUIRED.

NOTE 1, 2, 5,

4: FACTORY PROVIDED GFI / WP RECEPTACLE, UNPOWERED. CONTRACTOR TO FIELD WIRE PER PLANS. 5: PROVIDE UNIT WITH MOTORIZED ACTUATOR ON RELIEF AIR DAMPER FOR INTERCONNECTION TO HONEYWELL JADE ECONOMIZER CONTROL

NOTE 1, 2, 5,

SERVICE	DUCT	DUCT		OTHER REQUIREMENTS			
	MATERIAL	SHAPE	CLASSIFICATION	SEAL CLASS	LEAKAGE CLASS	1	
SUPPLY AIR DUCTS CONNECTED TO RTU	GALVANIZED STEEL	RECTANGULAR	2" WG POSITIVE	В	12	1", 3LB DENSITY LINER	
						PAINTABLE WHERE EXPOSED	
	GALVANIZED STEEL	ROUND/FLAT OVAL	4" WG POSITIVE	В	3	PAINTABLE WHERE EXPOSED	
		(EXPOSED)	SPIRAL SEAM/FLAT OVAL				
RETURN AIR AND TRANSFER AIR DUCTWORK	GALVANIZED STEEL	RECTANGULAR	2" WG NEGATIVE	В	12	1", 3LB DENSITY LINER	
						PAINTABLE WHERE EXPOSED	
GENERAL EXHAUST DUCTS TO THE INLET OF THE FAN	GALVANIZED STEEL	RECTANGULAR	2" WG NEGATIVE	B - RECTANGULAR	12 - RECTANGULAR	PAINTABLE WHERE EXPOSED	
		OR ROUND		A - ROUND	3 - ROUND		

1: SEE DUCTWORK INSULATION SCHEDULE FOR REQUIREMENTS ON DUCT INSULATION

GRILL	RILLE, REGISTER & DIFFUSER SCHEDULE								
PLAN MARK	MANUFACTURER	MODEL NUMBER	SERVICE	MOUNT TYPE	VOLUME DAMPER	MATERIAL	COLOR	REMARKS	
SD-1	TUTTLE & BAILEY	S1200	SUPPLY	LAY-IN	NOTE 1, 2	STEEL	WHITE		
SD-2	TUTTLE & BAILEY	T64 3	SUPPLY	SIDEWALL	NOTE 3	STEEL	PAINTABLE		
CD-1	RUSKIN (	01-510-22	SUPPLY	CONCENTRIC	YES	ALUMINUM	WHITE		
RG-1	TUTTLE & BAILEY	CRE500	RETURN	LAY-IN/SURFACE	NO	STEEL	WHITE		
EG-1	TUTTLE & BAILEY	CRE500	EXHAUST	LAY-IN/SURFACE	YES	STEEL	WHITE		


1: FURNISH WITH VOLUME DAMPER IN BRANCH DUCTWORK AT THE TAP LOCATION. 2: FURNISH WITH REMOTE DAMPER ACTUATOR FOR INACCESSIBLE CEILING APPLICATIONS.

3: FURNISH WITH OPPOSED BLADE DAMPER.

AS NOTED ON PLANS REVIEW ARCHITECTS SLAGGIE ARCHITECTS, INC. ©2018 Kansas City, Missouri • Omaha, Nebraska

RELEASE FOR CONSTRUCTION

888-756-1958 slaggie.com smith&boucher 25501 west valley parkway, suite 200 olathe, ks 66061 phone 913.345.2127 fax 913.345.0617 project number 1923000

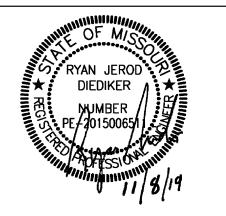


1\ Add-01 City Comments 11/18/19 Add-02 Tenant Comments 12/18/19

Add-03 Tenant Comments 01/10/20

Construction / Permit Set

November 8, 2019

**SCHEDULES - MECHANICAL** 

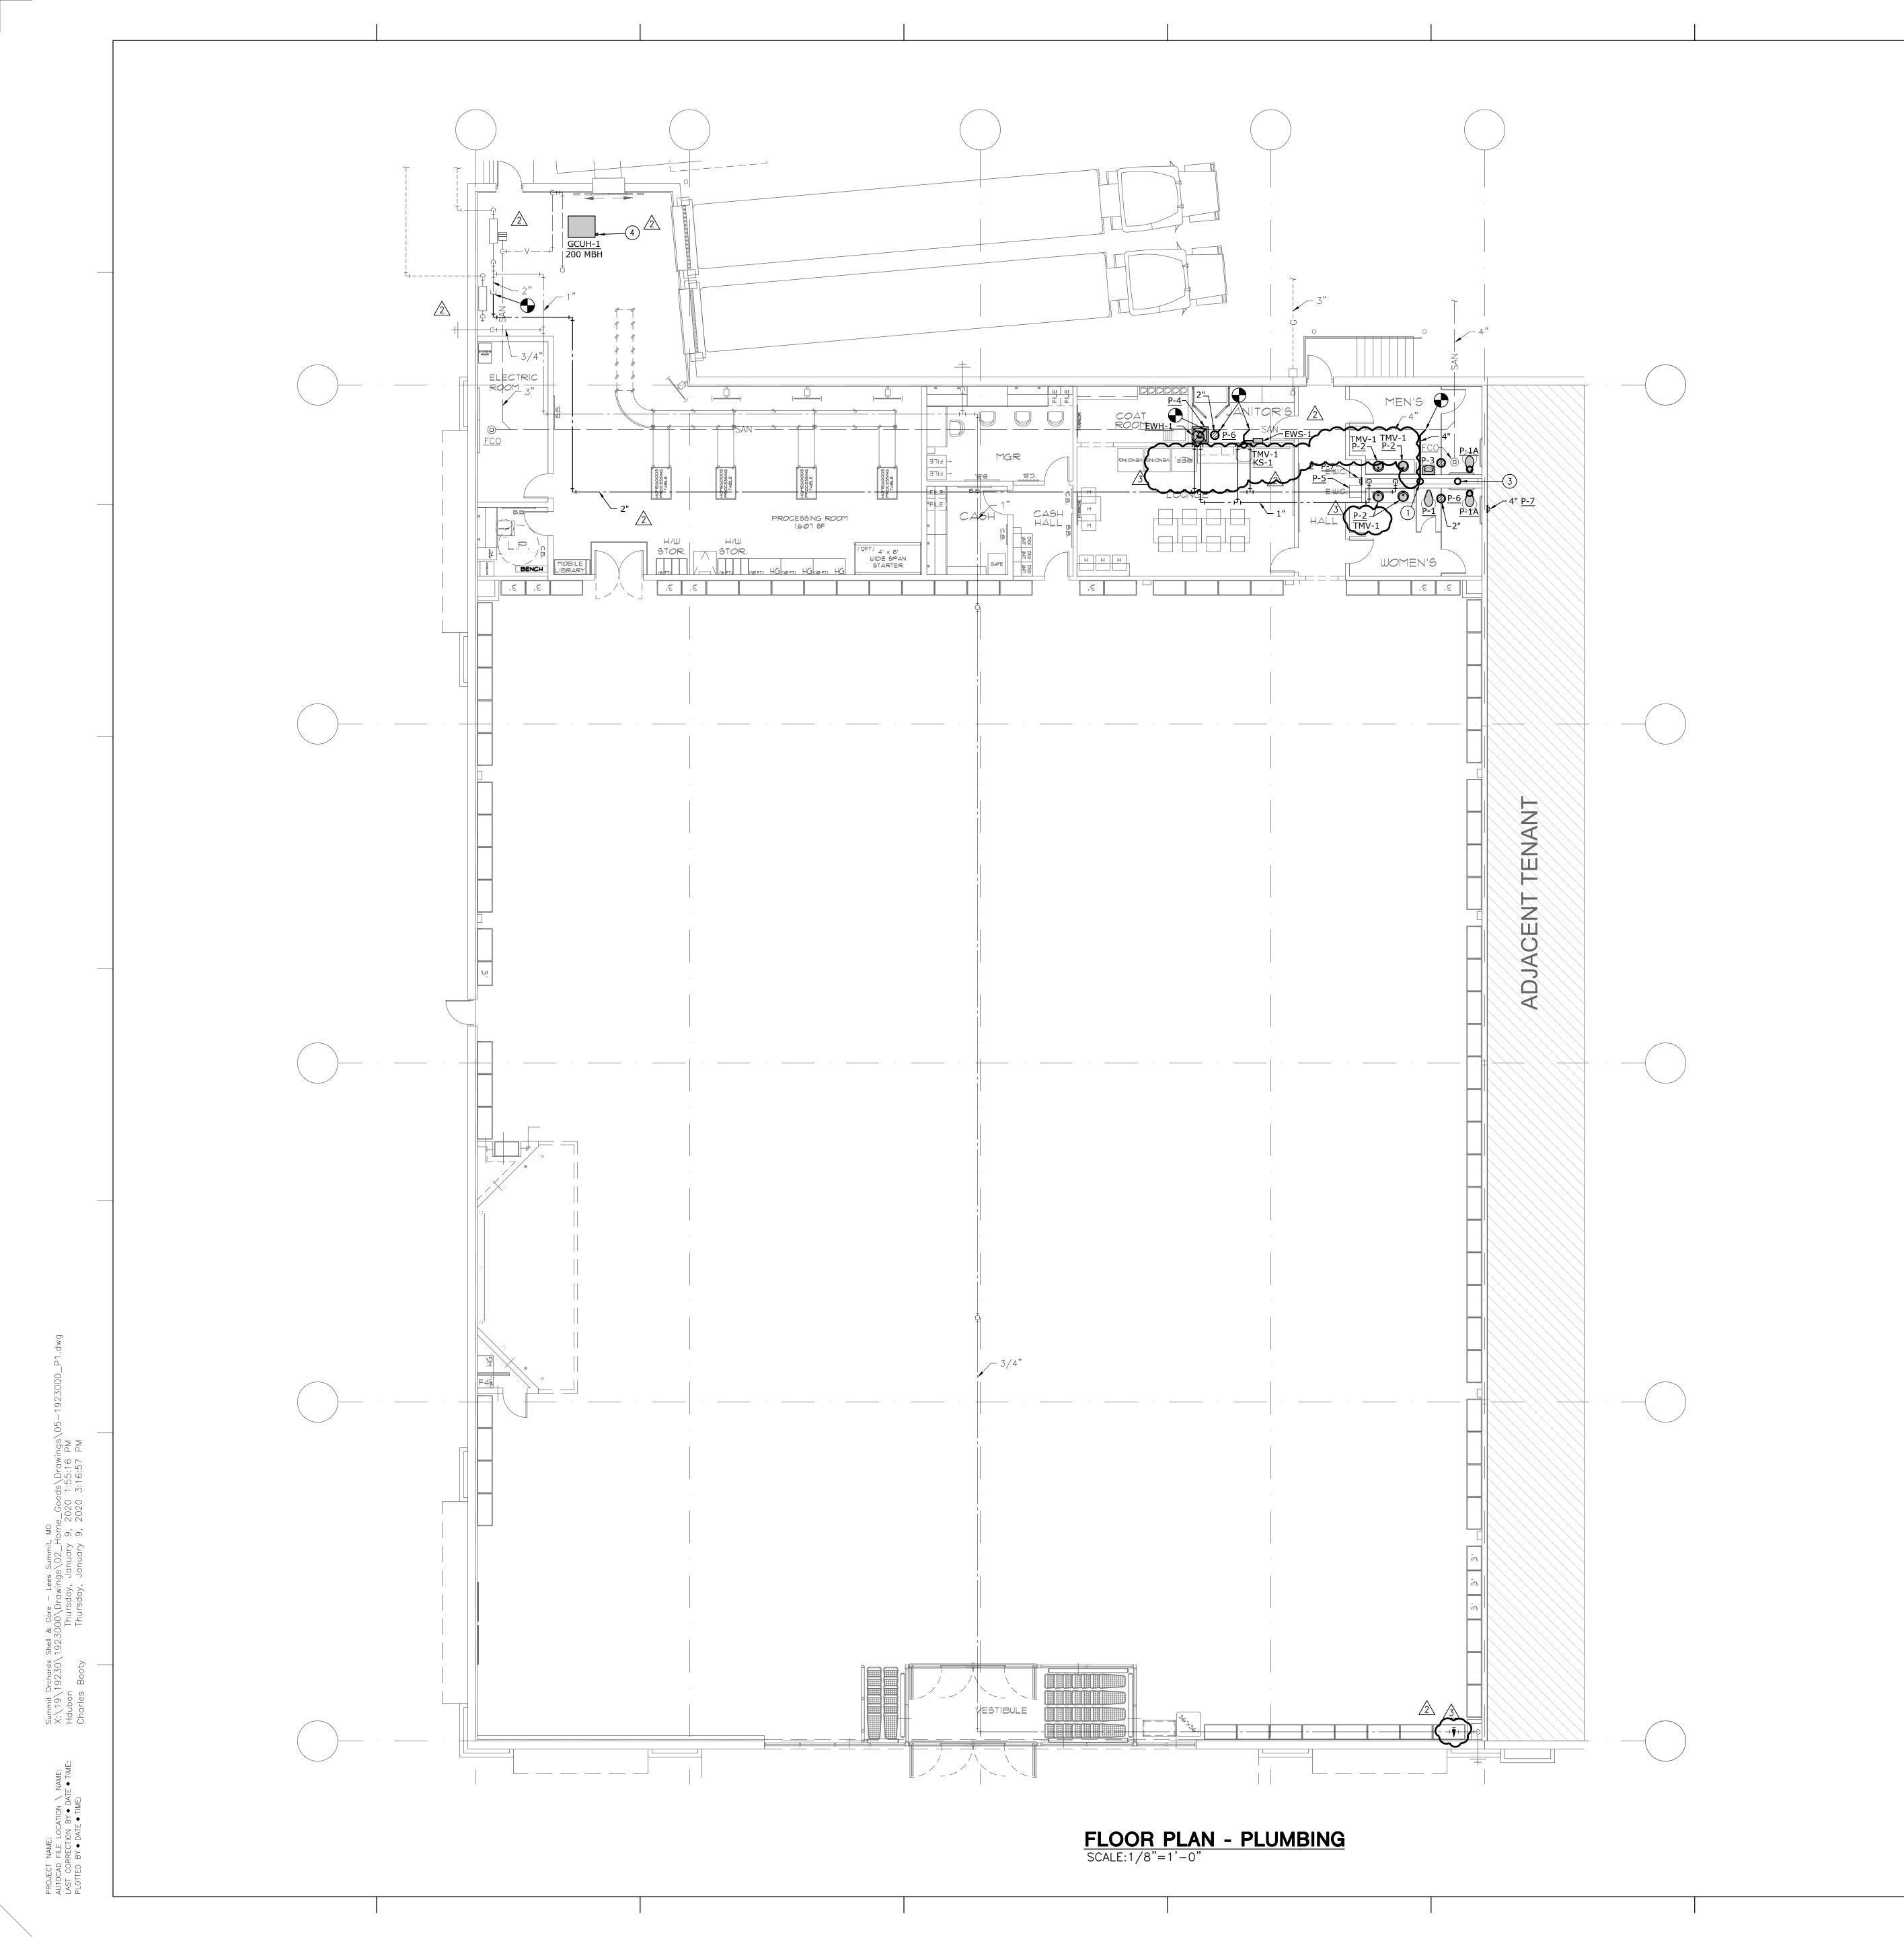

#### **GENERAL NOTES:**

- 1. INFORMATION SHOWN ON THE DRAWINGS IS INTENDED TO CONVEY SCOPE AND IS ARRANGED FOR DRAWING CLARITY. IT IS NOT TO BE TAKEN AS AN AS-BUILT CONDITION. THE SYSTEM INSTALLATION SHALL BE COORDINATED WITH STRUCTURE, CEILINGS, WALLS, AND ALL OTHER TRADES TO PROVIDE FOR A COMPLETE AND WORKING
- 2. CAREFULLY COORDINATE PIPE ROUTING WITH NEW AND EXISTING STRUCTURE AS WELL AS ALL OTHER TRADES TO MAINTAIN
- 3. COORDINATE ALL PIPING PENETRATIONS WITH STRUCTURAL PRIOR TO CORE DRILLING.

EQUIPMENT CLEARANCES AND DESIRED CEILING HEIGHTS.

- 4. PROVIDE SHUT OFF VALVES ABOVE ACCESSIBLE CEILING OR OTHER ACCESSIBLE LOCATION FOR ALL BRANCH PIPING AND INDIVIDUAL CONNECTIONS TO PLUMBING FIXTURES. WHERE STOPS ARE PROVIDED FOR INDIVIDUAL FIXTURES SHUT OFF VALVES ARE ALSO REQUIRED AT THE BRANCH CONNECTION. PLUMBING STOPS ARE NOT CONSIDERED A SUBSTITUTE FOR SHUT OFF VALVES.
- 5. AVOID ROUTING ANY PIPING THROUGH IT ROOMS OR ELECTRIC ROOMS. IN THE EVENT IT IS ABSOLUTELY NECESSARY, COORDINATE THE EXACT LOCATION SUCH THAT IT IS NOT DIRECTLY ABOVE ANY PANELS OR EQUIPMENT.
- 6. PROVIDE FIRESTOPPING AT PENETRATIONS OF ALL RATED WALLS. REFER TO CODE PLANS FOR LOCATIONS OF RATED WALLS.
- 7. ALL HOT WATER RECIRC BALANCE DEVICES SHALL BE 1 GPM CIRCUIT SETTERS UNLESS OTHERWISE NOTED.
- 8. REFER TO RISER DIAGRAM FOR ADDITIONAL PLUMBING INFORMATION.
- 9. ALL SERVICES SHOWN WITH HALF TONE LINE WEIGHT ARE EXISTING.


#### PLAN NOTES:

- (1) 4" SAN UP INTO CHASE.
- (2) 2" SAN UP TO 1-1/2" VENT.
- (3) 3" VENT THROUGH ROOF.
- 4 1-1/4" GAS PIPE DOWN FROM ROOF.
- (5) NOT USED.

RELEASE FOR CONSTRUCTION
AS NOTED ON PLANS REVIEW

ARCHITECTS SLAGGIE ARCHITECTS, INC. ©2018 Kansas City, Missouri • Omaha, Nebraska 888-756-1958 slaggie.com

smith&boucher 25501 west valley parkway, suite 200 olathe, ks 66061

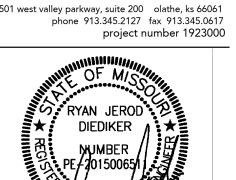




Add-02 Tenant Comments 12/18/19

3 Add-03 Tenant Comments 01/10/20

Construction / Permit Set November 8, 2019


PLUMBING PLAN

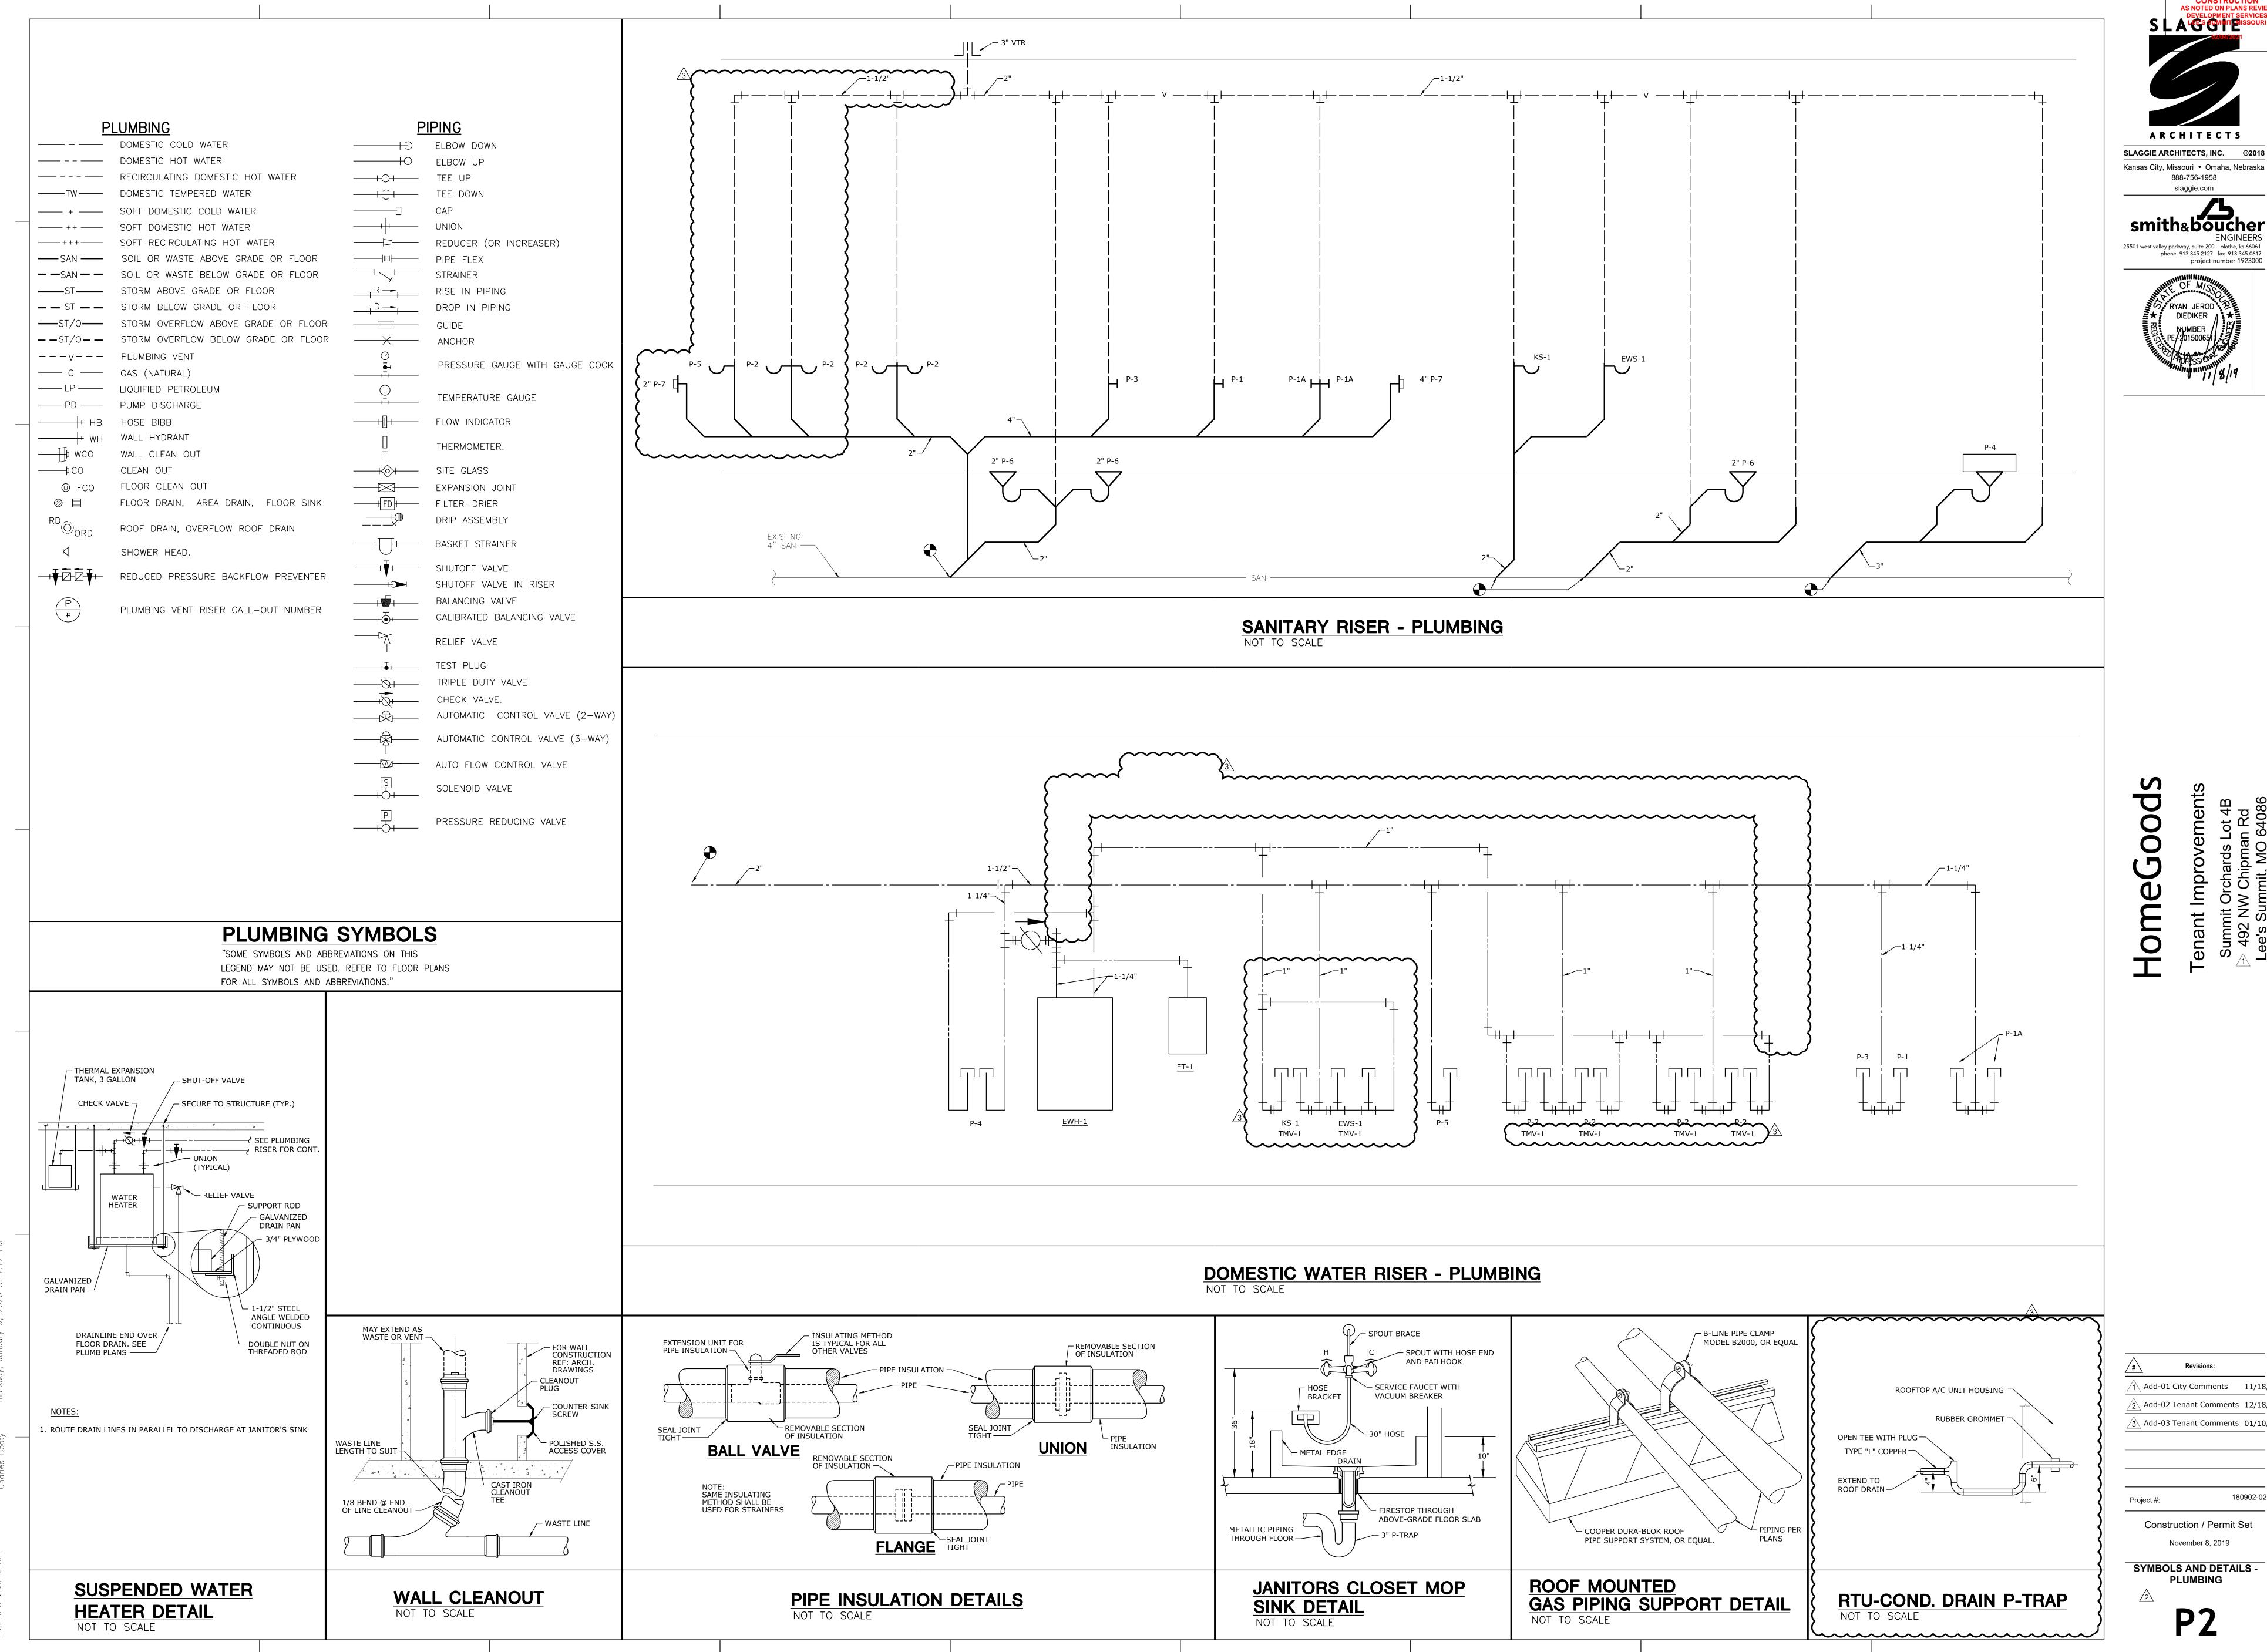

RELEASE FOR CONSTRUCTION
AS NOTED ON PLANS REVIEW S L A LES COMMIT MISSOURI ARCHITECTS

888-756-1958 slaggie.com

smith&boucher phone 913.345.2127 fax 913.345.0617 project number 1923000

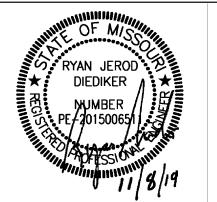

Add-01 City Comments 11/18/19 Add-02 Tenant Comments 12/18/19 Add-03 Tenant Comments 01/10/20

Construction / Permit Set

November 8, 2019 SYMBOLS AND DETAILS -**PLUMBING** 

**P2** 

- A. ALL DOMESTIC HOT AND COLD WATER PIPING WITHIN THE BUILDING SHALL BE COPPER
- B. COPPER PIPING INSTALLED UNDERGROUND SHALL BE SOFT TEMPER TYPE "K" AND INSTALLED WITHOUT JOINTS.
- C. ALL OTHER COPPER PIPING SHALL BE HARD TEMPER TYPE "L". ALL COPPER PIPING SHALL CONFORM TO ASTM-B-88 REQUIREMENTS. SERVICE PIPING OF CAST IRON OF DUCTILE IRON PIPE SHALL CONFORM TO USASI, AWWA AND FEDERAL SPECIFICATIONS.
- D. FITTINGS FOR USE WITH TYPE "K" AND "L" COPPER PIPING SHALL BE WROUGHT COPPER SOLDER-JOINT. UNIONS SHALL BE GROUND JOINT TYPE AND SHALL BE INSTALLED WHERE NECESSARY TO PROVIDE EASE OF DISCONNECTION OF THE PIPING SYSTEM. PRESS FITTINGS
- E. WHEN A CONNECTION BETWEEN COPPER PIPE AND FERROUS PIPE IS NECESSARY, SAID CONNECTION SHALL BE MADE BY USING BRASS CONVERTER FITTING.

FOR COPPER WATER PIPING ARE ACCEPTABLE WHERE PERMITTED BY GOVERNING CODES.

- F. DRAINS INDICATED ON THE DRAWINGS AND AT LOW POINTS IN CONNECTION WITH THE HOT AND COLD WATER DISTRIBUTION SYSTEM SHALL CONSIST OF 1/2" FAUCET WITH HOSE THREADS. DRAINS SHALL BE INSTALLED AT LOW POINTS IN THE HOT AND COLD WATER PIPING
- 1.2 VALVES FOR DOMESTIC WATER
- A. FOR PIPING 1/2" 2": MILWAUKEE BA-150 BALL VALE, BRONZE, TEFLON SEATS AND PACKING, 400 LBS W.O.G., SOLDER END.
- 1.3 SOIL, WASTE, DRAIN AND VENT PIPING

AND ALL PIPING SHALL GRADE TO DRAIN.

- A. UNDERGROUND SOIL, WASTE, DRAIN AND VENT PIPE AND FITTINGS, THROUGHOUT THE BUILDING BELOW THE BASE SLAB TO THE LOCATIONS NOTED OUTSIDE OF THE BUILDING, SHALL BE COATED HUB-AND- SPIGOT SERVICE WEIGHT CAST IRON. SCHEDULE 40 PVC SOLID PLASTIC PIPE MAY BE USED WHERE PERMITTED BY GOVERNING CODES. NO-HUB PIPE WILL NOT BE PERMITTED UNDERGROUND.
- B. SOIL, WASTE, DRAIN, VENT PIPE, AND FITTINGS ABOVE GROUND INSIDE OF THE BUILDING SHALL BE SERVICE WEIGHT HUB-AND- SPIGOT OR NO-HUB CAST IRON PIPE. SCHEDULE 40 PVC SOLID PLASTIC PIPE MAY BE USED WHERE PERMITTED BY GOVERNING CODES. PVC PIPING RUN IN RETURN AIR PLENUM SPACE SHALL BE INSTALLED WITH A 1 HOUR RATED COVERING OVER ALL PIPE, FITTINGS AND VALVES.
- C. CHANGES IN PIPE SIZE ON SOIL, WASTE, AND DRAIN LINES SHALL BE MADE WITH REDUCING FITTINGS. CHANGES IN DIRECTION IN DRAINAGE PIPING SHALL BE MADE BY THE APPROPRIATE USE OF 45 DEGREE Y'S, LONG OR SHORT SWEEP QUARTER BENDS, SIXTH, EIGHTH, OR SIXTEENTH BENDS, OR BY A COMBINATION OF THESE OR EQUIVALENT FITTINGS. SINGLE AND DOUBLE SANITARY TEES AND SHORT QUARTER BENDS MAY BE USED IN DRAINAGE LINES ONLY WHERE THE DIRECTION OF FLOW IS FROM THE HORIZONTAL TO THE VERTICAL. QUARTER BENDS MAY BE USED IN SOIL AND WASTE LINES ON THE DISCHARGE FROM WATER CLOSETS IN SLAB ON GRADE AREAS.
- D. SEWER LINES SHALL BE LOCATED IN GENERAL AS SHOWN ON THE DRAWINGS. THE EXACT LOCATIONS SHALL BE DETERMINED BY THE CONTRACTOR IN SUCH A MANNER AS TO MAINTAIN PROPER CLEARANCES AND SUFFICIENT SLOPE TO INSURE DRAINAGE.
- E. HORIZONTAL SOIL, WASTE, AND DRAIN PIPES SHALL BE GIVEN A GRADE OF NOT LESS THAN 1/4" PER FOOT FOR SIZES UP TO 3" UNLESS OTHERWISE SHOWN ON THE DRAWINGS OR APPROVED IN WRITING BY THE ENGINEER. HORIZONTAL SOIL, WASTE, AND DRAIN PIPES SHALL BE GIVEN A GRADE OF NOT LESS THAN 1/8" PER FOOT FOR SIZES 4" AND LARGER WHEN FIRST APPROVED BY THE ADMINISTRATIVE AUTHORITY.
- F. VENTS SHALL BE AIR AND WATER TIGHT.
- G. VENT CONNECTIONS SHALL BE INSTALLED ON ALL FIXTURES AND EQUIPMENT CONNECTED TO SOIL AND WASTE SYSTEMS AND ALL FLOOR DRAINS SHALL BE VENTED OR CONNECTED TO A VENTED LINE AS SHOWN ON THE DRAWINGS AND AS REQUIRED BY CODE.
- H. RISERS SHALL BE INSTALLED ABSOLUTELY PLUMB AND STRAIGHT. BRANCHES SHALL BE RUN IN STRAIGHT LINES AND PITCH UNIFORMLY TO MAINS.
- I. RISERS, BRANCHES AND MAINS SHALL BE CONCEALED IN THE CONSTRUCTION EXCEPT WHERE SHOWN OTHERWISE. BRANCHES FOR CLOSETS SHALL BE FINISHED AT THE WALL LINE WITH PROPER FLANGE TO RECEIVE THE FIXTURE WHEN SET, AND THEY SHALL BE TRUE AND LEVEL SO THAT CLOSET BASE WILL HAVE FULL BEARING ON THE WALL.
- J. ALL SOIL AND VENT STACKS SHALL OFFSET WHERE REQUIRED TO MISS OBSTRUCTIONS AND AS REQUIRED TO CLEAR FLOOR BEAMS AND SPANDREL BEAMS AT FLOOR LINES AND HUG WALL CONSTRUCTION ABOVE FLOOR.
- K. PROHIBITED FITTINGS. THE DRILLING AND TAPPING OF BUILDING DRAINS, SOIL, WASTE OR VENT PIPE AND THE USE OF SADDLE HUBS OR BANDS IS PROHIBITED. ANY FITTING OR CONNECTION WHICH HAS AN ENLARGEMENT CHAMBER OR RECESS WITH A LEDGE, SHOULDER OR REDUCTION OF THE PIPE AREA THAT OFFERS AN OBSTRUCTION TO THE FLOW IS
- L. PROHIBITED CONNECTIONS. NO FIXTURES, DEVICES OR CONSTRUCTION SHALL BE INSTALLED WHICH WOULD ALLOW A BACKFLOW CONNECTION BETWEEN A DISTRIBUTION SYSTEM OF WATER FOR DRINKING AND DOMESTIC PURPOSES TO THE DRAINAGE SYSTEM, SOIL OR WASTE PIPING SO AS TO PERMIT OR MAKE POSSIBLE THE BACKFLOW OF SEWAGE OR WASTE INTO THE WATER SYSTEM.
- 1.4 WATER HAMMER ARRESTORS
- A. WATER HAMMER ARRESTORS SHALL BE PROVIDED FOR ALL QUICK CLOSING VALVES INCLUDING BUT NOT LIMITED TO DRINKING FOUNTAINS, DISHWASHERS, FAUCETS, FLUSHOMETER VALVES, ICE MAKERS, SELF-CLOSING VALVES, SPRING LOADED VALVES, AND WASHING MACHINES AND AS REQUIRED BY THE LOCAL INSPECTION AUTHORITY HAVING JURISDICTION.
- B. WATER HAMMER ARRESTORS SHALL BE INSTALLED PER MANUFACTURES SPECIFICATIONS AND SHALL CONFORM TO ASSE 1010 AND PER STANDARD PDI-WH-201.
- C. WATER HAMMER ARRESTOR SHALL BE SIOUX CHIEF MODEL OR APPROVED EQUAL. AIR CHAMBERS ARE NOT PERMITTED.

#### PLUMBING REQUIREMENTS

WITH ALL APPLICABLE ADA INSTALLATION REQUIREMENTS.

- PROVIDING NEW MATERIALS, FITTINGS AND ACCESSORIES NECESSARY FOR A COMPLETE FUNCTIONING PLUMBING SYSTEM. ALL WORK SHALL BE IN ACCORDANCE WITH LOCAL CODES AND/OR ORDINANCES AND IS SUBJECT TO
- HOOK-UP CHARGES, PERMITS AND ALL OTHER EXPENSES RELATED TO A COMPLETE AND FUNCTIONING PLUMBING SYSTEM ARE INCLUDED AS A PART
- WORK REQUIRED FOR THE PROJECT. THE DRAWINGS FOR PLUMBING WORK ARE DIAGRAMMATIC, SHOWING THE GENERAL LOCATION, TYPE, FIXTURES AND EQUIPMENT REQUIRED. THE DRAWINGS SHALL NOT BE SCALED FOR EXACT | MEASUREMENTS. REFER TO MANUFACTURER'S STANDARD ROUGH-IN DRAWINGS FOR PLUMBING FIXTURE INSTALLATION REQUIREMENTS. COMPLY
- BY OTHERS, AND WITH THE CONSTRAINTS OF THE EXISTING CONDITIONS OF THE PROJECT SITE.
- BUILDING LINES AND SUPPORTED AND ANCHORED AS REQUIRED TO FACILITATE EXPANSION AND CONTRACTION. ALL PIPING SHALL BE CONCEALED EXCEPT IN UNFINISHED SPACES. INSTALL AS REQUIRED TO OTHER WORK SUCH AS DUCTS AND ELECTRICAL CONDUIT. AT ALL PIPING MATERIAL TO PREVENT CORROSION.
- PROVIDE ALL FITTINGS, ACCESSORIES, OFFSETS, AND MATERIALS NECESSARY TO FACILITATE THE PLUMBING SYSTEM'S FUNCTIONING AS INDICATED BY THE DESIGN AND THE EQUIPMENT INDICATED.
- FIXTURES/EQUIPMENT FURNISHED BY OTHERS: PLUMBING CONTRACTOR SHALL PROVIDE UTILITY CONNECTIONS REQUIRED SUCH AS WATER, GAS, SUPPLIES, WASTE OUTLET. TRAPS. ETCETERAS AT ALL PLUMBING TYPE FIXTURES OR EQUIPMENT FURNISHED BY OWNER, GENERAL CONTRACTOR, EQUIPMENT SUPPLIER, ETCETERA. INCLUDED ARE STOP VALVES, ESCUTCHEONS, AND
- SANITARY SEWER PIPING: PROVIDE ALL DRAINS AND PIPING WITHIN THE PROJECT SPACE WITH CONNECTION TO THE EXISTING DRAINAGE SYSTEMS ON-SITE. SANITARY DRAINAGE PIPING ABOVE FLOOR SHALL BE ABS/PVC PLASTIC PIPE, WITH SOLVENT WELD FITTINGS, OR HUBLESS CAST-IRON PIPE AND FITTINGS AND CONNECTIONS. SANITARY DRAINAGE PIPING BELOW GRADE SHALL BE ABS/PVC PLASTIC PIPE WITH SOLVENT WELD FITTINGS, OR SERVICE-WEIGHT HUB AND SPIGOT TYPE CAST-IRON WITH NEOPRENE GASKET JOINT SYSTEM. NO ABS/PVC PLASTIC PIPING IS ALLOWED WITHIN THE
- CEILING VOIDS IF USED FOR NON-DUCTED RETURN AIR PLENUM. ALL DRAINAGE PIPING SHALL BE UNIFORMLY PITCHED AT 1/4" PER FOOT FOR PIPE SIZES 3" AND SMALLER AND 1/8" PER FOOT FOR PIPE SIZES 4" AND LARGER, UNLESS OTHERWISE REQUIRED BY EXISTING CONDITIONS, OR INDICATED ON THE DRAWINGS.
- CEILING VOIDS IF USED FOR NON-DUCTED RETURN AIR PLENUMS. THE VENT SYSTEM SHALL BE CARRIED THROUGH THE ROOF WITH APPROPRIATE
- CONDENSATE AND INDIRECT DRAIN PIPING: TYPE M COPPER TUBING UP TO 1" ID, TYPE DWV COPPER TUBING AND FITTINGS FOR 1-1/4" AND LARGER
- STORM WATER PIPING: PROVIDE ALL STORM DRAINS AND PIPING WITHIN THE PROJECT SPACE WITH CONNECTION TO THE EXISTING STORM SYSTEMS AND CONNECTIONS. STORM PIPING BELOW GRADE SHALL BE ABS/PVC SPIGOT TYPE CAST-IRON WITH NEOPRENE GASKET JOINT SYSTEM. NO ABS/PVC PLASTIC PIPING IS ALLOWED WITHIN THE CEILING VOIDS IF USED FOR NON-DUCTED RETURN AIR PLENUMS. ALL STORM PIPING SHALL I UNIFORMLY PITCHED AT A MINIMUM OF 1/8" PER FOOT UNLESS OTHERWISE
- CLEANOUTS: PROVIDE CLEANOUTS AT THE END OF EACH HORIZONTAL RUN, AND AT THE BASE OF ALL VERTICAL STORM, WASTE AND DRAIN PIPES. CLEANOUTS SHALL BE OF THE SAME SIZE AS THE PIPES THEY SERVE, CONFORMING TO CODE REQUIREMENTS. PROVIDE SUITABLE WALL OR FLOOR CLEANOUTS WITH ACCESSORIES TO OBSCURE FROM VIEW.
- WATER DISTRIBUTION PIPING: LAYOUT WATER PIPING SO THAT THE ENTIRE SYSTEM CAN BE DRAINED. ABOVE GRADE HOT AND COLD WATER PIPING SHALL BE 1/2" MINIMUM TYPE L COPPER TUBING WITH WROUGHT COPPER FITTINGS AND SWEAT CONNECTIONS. BELOW GRADE HOT AND COLD WATER PIPING SHALL BE 1/2" MINIMUM TYPE K COPPER TUBING WITH WROUGHT COPPER FITTINGS, AND SWEAT CONNECTIONS. PROVIDE WATER HAMMER ARRESTERS AT EACH FIXTURE OR GROUP OF FIXTURES AS REQUIRED. INSTALL CHROME PLATED BRASS ESCUTCHEON PLATES AT ALL PENETRATIONS THROUGH FINISHED SURFACES (INCLUDING CABINET INTERIORS). USE LEAD FREE OR TIN-ANTIMONY SOLDER, 95/5 FOR ALL SWEAT FITTINGS OF
- PIPE INSULATION: RIDGE ONE—PIECE FIBERGLASS PIPE INSULATION WITH LONGITUDINAL JOINTS AND BUTT STRIPS FOR TRANSVERSE JOINTS. JACKETING SHALL CONFORM TO ASTM C 1136, TYPE I, MAXIMUM VAPOR TEMPERATURE WITH A MINIMUM R-VALVE OF R4.
- PROVIDE INSULATION THICKNESS AS INDICATED: DOMESTIC COLD WATER PIPING 1" AND SMALLER: 1/2" THICKNESS. DOMESTIC COLD WATER PIPING 1-1/4" - 2": 3/4" THICKNESS. PLUMBING VENT PIPING WITHIN 6 FEET OF ROOF OUTLET: 1" THICKNESS. STORM WATER PIPING: 1" THICKNESS. OVERFLOW STORM WATER PIPING: 1" THICKNESS.
- WATER AND WASTE PIPING BELOW HANDICAP LAVATORIES/SINKS.
- ELASTOMERIC PIPE INSULATION WITH REQUIREMENTS COMPLYING WITH ASTM C 518, SELF-SEALING, WITH A MAXIMUM VAPOR TRANSMISSION RATING OF 0.20 PERM WHEN TESTED ACCORDING TO ASTM E 96. THERMAL CONDUCTIVITY (K VALVE) SHALL NOT EXCEED 0.27 BTU/IN./HR. \* FT2 \* "F AT 75"F MEAN TEMPERATURE WITH A MINIMUM R-VALUE OF R3.7. AND INSULATION AND JACKET SHALL BE RATED FOR OPERATING TEMPERATURES FROM 40°F TO
- PROVIDE INSULATION THICKNESS AS INDICATED: DOMESTIC COLD WATER PIPING 2" AND SMALLER: 1/2" THICKNESS. DOMESTIC HOT WATER PIPING 2" AND SMALLER: 1/2" THICKNESS. SANITARY PIPING 2" AND SMALLER: 1/2" THICKNESS.
- SHUTOFF VALVES WITH UNIONS SHALL BE PROVIDED FOR SERVICE TO EACH PLUMBING FIXTURE OR OTHER EQUIPMENT ITEM, TO FACILITATE ISOLATION FOR REPAIR OR REPLACEMENT. PIPE LINE VALVES SHALL BE EQUAL TO CRANE SERIES #9200, QUARTER TURN BALL VALVE. CONSTRUCTION — TWO PIECE, BRONZE BODY, FULL PORTED, CHROME PLATED BRASS BALL, REPLACEABLE "TEFLON OR TFE" SEATS AND SEALS. RATING — 150 PSI WSP. 600 PSI WOG. CONNECTIONS - SOLDER OR THREADED ENDS TO MATCH PIPING. STANDARDS COMPLIANCE — BRONZE OR BRASS VALVES: MSS-SP-110. WHEN SHUTOFF VALVE ARE PLACE IN THE CEILING THE VALVES WILL BE LOCATED AT A MAXIMUM OF 12" ABOVE THE CEILING, AND
- NOTHING SHALL BE PLACE BETWEEN THE CEILING ACCESS AND THE VALVES.
- OPENINGS TO EXCLUDE DIRT UNTIL FIXTURES ARE INSTALLED AND FINAL WILL PERMIT. SET FIXTURES LEVEL AND IN PROPER ALIGNMENT. INSTALL SUPPLIES IN PROPER ALIGNMENT WITH FIXTURES. INSTALL SILICONE
- REPAIR EXISTING PLUMBING SYSTEM COMPONENTS DAMAGED BY
- TEST WATER SYSTEM UNDER 150 PSIG HYDROSTATIC PRESSURE, FOR FOUR (4) HOURS MINIMUM. WHEN TESTING INDICATES MATERIALS OR WORKMANSHIP IS DEFICIENT, REPLACE OR REPAIR AS REQUIRED, AND REPEAT TEST UNTIL STANDARDS ARE ACHIEVED.
- PROVIDE A COMPLETE GAS PIPING SYSTEM TO SERVE GAS FIRED HVAC EQUIPMENT AS NOTED ON THE DRAWINGS. PROVIDE EITHER THREADED STEEL OR MALLEABLE IRON PIPE WITH MALLEABLE FITTINGS OR WELDED STEEL. PROVIDE ALL UNIONS, SHUT-OFF VALVES AND DIRT LEGS REQUIRED BY NFPA-54 AND GOVERNING LOCAL CODES AND AT EACH GAS APPLIANCE CONNECTION. PROVIDE ALL TESTS, METERS, INSPECTIONS, HANGERS AND

- THE WORK INCLUDES MODIFICATION TO THE EXISTING PLUMBING SYSTEM AND
- OF THIS SECTION.
- THE INTENT OF THE DRAWINGS IS TO INDICATE THE GENERAL EXTENT OF
- COORDINATE WITH THE WORK OF OTHER SECTIONS, EQUIPMENT FURNISHED
- PIPING SYSTEMS GENERAL: ALL PIPING SHALL BE RUN PARALLEL TO MEET ALL CONSTRUCTION CONDITIONS AND TO ALLOW FOR INSTALLATION OF CONNECTIONS BETWEEN FERROUS PIPING AND NONFERROUS PIPING, PROVIDE AN ISOLATING DIELECTRIC UNION. ALL HANGERS SHALL BE COMPATIBLE WITH
- CHROME PLATED BRASS TUBING WITH COMPRESSION FITTINGS.

- SANITARY VENT PIPING: PROVIDE A COMPLETE SYSTEM OF ABS/PVC PLASTIC PIPE, WITH SOLVENT WELD FITTINGS, OR STANDARD WEIGHT CAST IRON NO-HUB PIPE AND FITTINGS. NO ABS/PVC PIPING IS ALLOWED WITHIN THE
- ON-SITE. STORM PIPING ABOVE FLOOR SHALL BE ABS/PVC PLASTIC PIPE, WITH SOLVENT WELD FITTINGS, OR HUBLESS CAST—IRON PIPE AND FITTINGS PLASTIC PIPE. WITH SOLVENT WELD FITTINGS. OR SERVICE—WEIGHT HUB AND
- REQUIRED BY EXISTING CONDITIONS, OR INDICATED ON THE DRAWINGS.

COPPER PIPING.

- REQUIREMENTS COMPLYING WITH ASTM C 547, SELF-SEALING ADHESIVE LAP TRANSMISSION RATING OF 0.02 PERM WHEN TESTED ACCORDING TO ASTM E 96, PROCEDURE A. (K VALVE) 0.25 BTU/IN./HR. \* FT2 \* °F AT 75°F MEAN
- CONDENSATE PIPING: 1/2" THICKNESS. DOMESTIC HOT WATER PIPING 2" AND SMALLER: 1" THICKNESS.
- PIPE INSULATION: FLEXIBLE, ONE PIECE, EXPANDED CLOSED-CELL
- CONDENSATE PIPING: 1/2" THICKNESS.
- ACCESS PANELS SHALL BE PROVIDED WHERE CONCEALED CONTROL DEVICES, VALVES, ETCETERA ARE CONCEALED WITHIN WALLS. WHERE ACCESS FOR ADJUSTMENT AND MAINTENANCE IS POSSIBLE THROUGH LAY-IN SUSPENDED CEILINGS, ACCESS PANELS ARE NOT REQUIRED. INSTALLATION: THOROUGHLY CLEAN ITEMS BEFORE INSTALLATION. CAP PIPE
- CONNECTIONS HAVE BEEN MADE. PROCEED AS RAPIDLY AS CONSTRUCTION SEALANT BETWEEN FIXTURES AND ADJACENT MATERIAL, FOR SANITARY JOINT, AND OMIT ESCUTCHEONS.
- CONSTRUCTION OPERATIONS AND RESTORE TO ORIGINAL CONDITIONS.
- TEST SANITARY DRAINAGE AND VENT SYSTEM BY FILLING WITH WATER, WITH ALL POINTS IN THE SYSTEM BEING SUBJECT TO PRESSURE OF AT LEAST 10' OF WATER. WATER LEVEL SHALL REMAIN STATIONARY FOR A PERIOD OF ONE HOUR, WITHOUT ANY PIPE OR JOINT LEAKAGE. IF TESTING INDICATES DEFICIENTS REPLACE OR REPAIR AS REQUIRED, AND REPEAT TEST UNTIL STANDARDS ARE ACHIEVED.
- EQUIPMENT CONNECTIONS REQUIRED FOR A COMPLETE AND OPERATING

MARK	MANUFACTURER / MODEL	DESCRIPTION	MANUFACTURER / MODEL	DESCRIPTION	NOTE	cw	HW	SAN	VENT
P-1	AMERICAN STANDARD	WATER CLOSET SHALL BE A WALL HUNG SIPHON JET FLUSH WITH CHAIR CARRIER.	SLOAN	FLUSH VALVE SHALL BE BATTERY POWERED FLUSHOMETER 1.6/1.1 GPM WITH	3,4	1"		4"	2"
	AFWALL		OPTIMA	15 SECOND SHUTOFF.				1	
	2257.101		ECOS 8111-1.6/1.1						
				<u>3</u>					
			OLSONITE 95SSCT	SEAT, LESS COVER					
P-1A	AMERICAN STANDARD	ADA WATER CLOSET SHALL BE A WALL HUNG SIPHON JET FLUSH WITH CHAIR CARRIER.	SLOAN	FLUSH VALVE SHALL BE BATTERY POWERED FLUSHOMETER 1.6/1.1 GPM WITH	3,4	1"		4"	2"
	AFWALL		OPTIMA	15 SECOND SHUTOFF. COORDINATE HEIGHT OF FLUSH VALVE WITH ADA GRAB BAR.					
	2257.101		ECOS 8111-1.6/1.1						
				3					
			OLSONITE 95SSCT	SEAT, LESS COVER					
P-2	AMERICAN STANDARD	16"x10"x5-5/8" WHITE VITREOUS CHINA, SELF RIMMING, DROP-IN BOWL.	SLOAN	BATTERY POWERED, DECK MOUNTED, LOW INTEGRATED BASE BODY FAUCET. 0.35GPM.	1,2,3,4,5	1/2"	1/2"	2"	1-1/2"
	AQUALYN		OPTIMA						
	476.028		EBF-650						
P-3	AMERICAN STANDARD	ADA URINAL SHALL BE WALL HUNG WASHOUT TYPE, TOP SPUD	SLOAN	0.5GPF, BATTERY POWERED FLUSHOMETER.	4	3/4"		2"	1-1/2"
	WASHBROOK FLOWISE		OPTIMA					1	
	6590.001		G2-8186.5						
P-4	MUSTEE	MOP SERVICE BASIN SHALL BE 24"x24"x10" BASIN WITH INTEGRAL STRAINER AND DRAIN.	MUSTEE	WALL MOUNTED FAUCET WITH VACUUM BREAKER, WALL BRACE AND PAIL HOOK,		1/2"	1/2"	3"	2"
	63M		63.600A	#65.700 HOUSEHOLD BRACKET AND 65.600 MOP HANGER.					
P-5	OASIS	DOUBLE BI-LEVEL WALL HUNG ELECTRIC WATER FOUNTAIN. MOUNT PER ADA REQUIRED HEIGHT.				1/2"		2"	1-1/2"
	VERSACOOLER II							1	
	PG8ACSL				<u> </u>				
KS-1	ELKAY	18 GAUGE, 304 STAINLESS STEEL, SINGLE BASIN, ADA COMPLIANT DROP-IN SINK WITH 1.5GPM AERATOR	KOHLER	1.5GPM CHROME THREE HOLE, SINGLE HANDLE FAUCET	1,2,3	1/2"	1/2"	2"	1-1/2"

K-15171-F-CP

GUARDIAN

NOTES:	
1: PROVIDE WITH ALL MOUNTING HARDWARE AS REQUIRED.	

LUSTERTONE

LRAD172055

JAY R. SMITH

5509QT

PRECISION PLUMBING

PRODUCTS

SYMMONS

7-225-CK-MS

GUARDIAN

PLUMBING FIXTURE SCHEDULE

MARK | MANUFACTURER / MODEL

- 2: PROVIDE WITH CHROME PLATED DRAIN, GRID STAINER, TAILPIECE, AND TRAP.
- 3: PROVIDE STAINLESS STEEL BRAIDED HOSE WITH KEYED STOP.
- 4: PROVIDE CAULK AROUND FIXTURE CONNECTION TO FLOOR/WALL. COLOR BY ARCHITECT / ID.

TRAP PRIMER VALVE. DU-U DISTRIBUTION UNIT

SET AT 105°F, ASSE 1070

WITH A FULL 2-YEAR WARRANTY.

5: TRAP AND INSULATION TO BE TRUE BRO #103 E-2 OR EQUAL.

SERVICE	PIPE SIZE	INSULATION	
DOMESTIC COLD WATER	1/2" - 2"	1/2" FIBERGLASS, ASJ	
DOMESTIC HOT WATER			
RECIRCULATING HOT WATER	ALL	1" FIBERGLASS, ASJ	
TEMPERED WATER			
EXPOSED FIXTURE WASTETRAPS AND DOMESTIC HOT AND COLD WATER	ALL	TRUBRO LAV AGUARD MOLDED PROTECTIVE PIPE COVER OVER	
AT HANDICAPPED ACCESSIBLE SINKS AND LAVATORIES	ALL	1/2" FIBERGLASS INSULATION	

LEAD FREE THERMOSTATIC MIXING VALVES INCLUDED WITH A BUILT-IN COLD WATER BY-

PASS, ROUGH BRONZE FINISH, SOLID BI-METAL THERMOSTAT, LOCKING TEMPERATURE

AND DIAL THERMOMETER. PERFORMANCE: UNIT SHALL HAVE A FLOW RANGE OF 0.5-GPM

TO 5-GPM WITH A MAXIMUM PRESSURE LOSS OF 20-PSI AND COME WITH A FULL 1-YEAR

REGULATOR WITH LIMIT STOP FACTORY SET FOR 90 DEGREES, INTREGRAL CHECK

1: FOR ALL EXPOSED PIPING PROVIDE PAINTABLE PVC JACKET. (EXCLUDES MECHANICAL SPACES)

VARRANTY

2: IF PEX PIPING IS USED, IT STILL REQUIRES INSULATION

DC	DOMESTIC WATER EXPANSION TANK SCHEDULE						
DES	GNATION	ET-1					
	MANUFACTURER	AMTROL					
TINO	MODEL	ST-12-C					
	SERVICE	DOM. HOT WATER					
	MIN. TEMP. (°F)	40					
	MAX. TEMP. (°F)	120					
	LINE PRESSURE (PSIG)	60					
ΙTΑ	MAX. PRESSURE (PSIG)	125					
UNIT DATA	TANK SIZE (GAL)	6.4					
N N	ACCEPTANCE (GAL)	0.5					
	HEIGHT (IN.)	18					
	DIAMTER (IN.)	12					
	WEIGHT (LBS.)	26					
REF	ERENCE DRAWING/DETAIL	P1					
REM	REMARKS						

DESCRIPTION

NON-FREEZE, VACUUM BREAK, 1/4-TURN KEY HANDLE, STAINLESS STEEL BOZ WITH NICKEL BRONZE COVER

WALL MOUNTED EYE WASH WITH STAINLESS STEEL BOWL, 1/2" U.S. MADE CHROME PLATED BRASS STAY OPEN BALL

VALVE, POWDER COATED CAST ALUMINIUM FLAG HANDLE AND WALL BRACKET. UNIT SHALL HAVE (2) POLYPROYLENE

GS PLUS' SPRAY HEADS WITH INTREGRAL "FLIP-TOP" DUST COVERS, FILTERS AND 1.8-GPM FLOW CONTROL ORIFICES

MOUNTED ON A CHROME PLATED BRASS EYEWASH ASSEMBLY. UNIT SHALL INLCUDED ANSI COMPLIANT SIGN. UNIT

BE FULLY FACTORY ASSEMBLED AND HYDROSTATICALLY TESTED TO MEET OR EXCEED ANSI Z358.1 - 2009, AND COME

THERMOSTATIC MIXING VALVE IN WALL CABINET. MOUNT IN ACCESSIBLE LOCATION BELOW SINK,

ES	IGNATION	EWH-1
	MANUFACTURER	STATE WATER HEATERS
	MODEL	PCE 20 10MSA
ΥŢ	SERVICE	DOM. HOT WTR
UNIT DATA	CAPACITY (GALLONS)	20
Z	RECOVERY @ 80°F RISE (GPH)	23
	OUTLET TEMP. (°F)	120
	INPUT (KW)	4.5
7	VOLTS/PHASE	208/1
Z Z	PANEL & CIRCUIT	AL-82,84
ELEC./CONTROL	WIRE & CONDUIT	(2)#10, #10G., 3/4"C.
C.	OVERCURRENT DEVICE	30A-2P CB
屲	DISCONNECT	30A-2P NF
REF	ERENCE DRAWING/DETAIL	P1

2: REFER TO PLANS FOR OUTLET SIZE.

PRAIN SCHEDULE								
MARK	MANUFACTURER/ MODEL	DESCRIPTION	REMARK					
P-6	WADE 1100A	CAST IRON FLOOR DRAIN WITH ADJUSTABLE TOP AND 6" NICKEL BRONZE VANDAL RESISTANT SCREWS. PROVIDE WITH TRAP SEAL DEVICE.	1,2					
P-7	WADE	ALL CLEANOUTS TO BE BRASS FINISH. WALL CLEANOUTS TO BE CHROME FINISH.	1,2					

1: COORDINATEL ALL LOCATIONS WITH (BUT NOT EXCLUDING) EQUIPMENT, HOUSE-KEEPING PADS, MILLWORK, AND STRUCTURAL.

ARCHITECT! SLAGGIE ARCHITECTS, INC. ©2018 Kansas City, Missouri • Omaha, Nebraska


PIPING CONNECTIONS

3/4"

1/2"

**RELEASE FOR** CONSTRUCTION **AS NOTED ON PLANS REVIEW** 


888-756-1958 slaggie.com phone 913.345.2127 fax 913.345.0617 project number 1923000

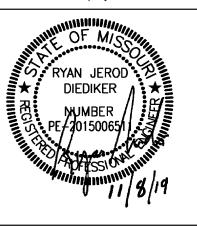

1\ Add-01 City Comments 11/18/19 Add-02 Tenant Comments 12/18/19 Add-03 Tenant Comments 01/10/20

180902-02 Project #: Construction / Permit Set November 8, 2019

SCHEDULES - PLUMBING

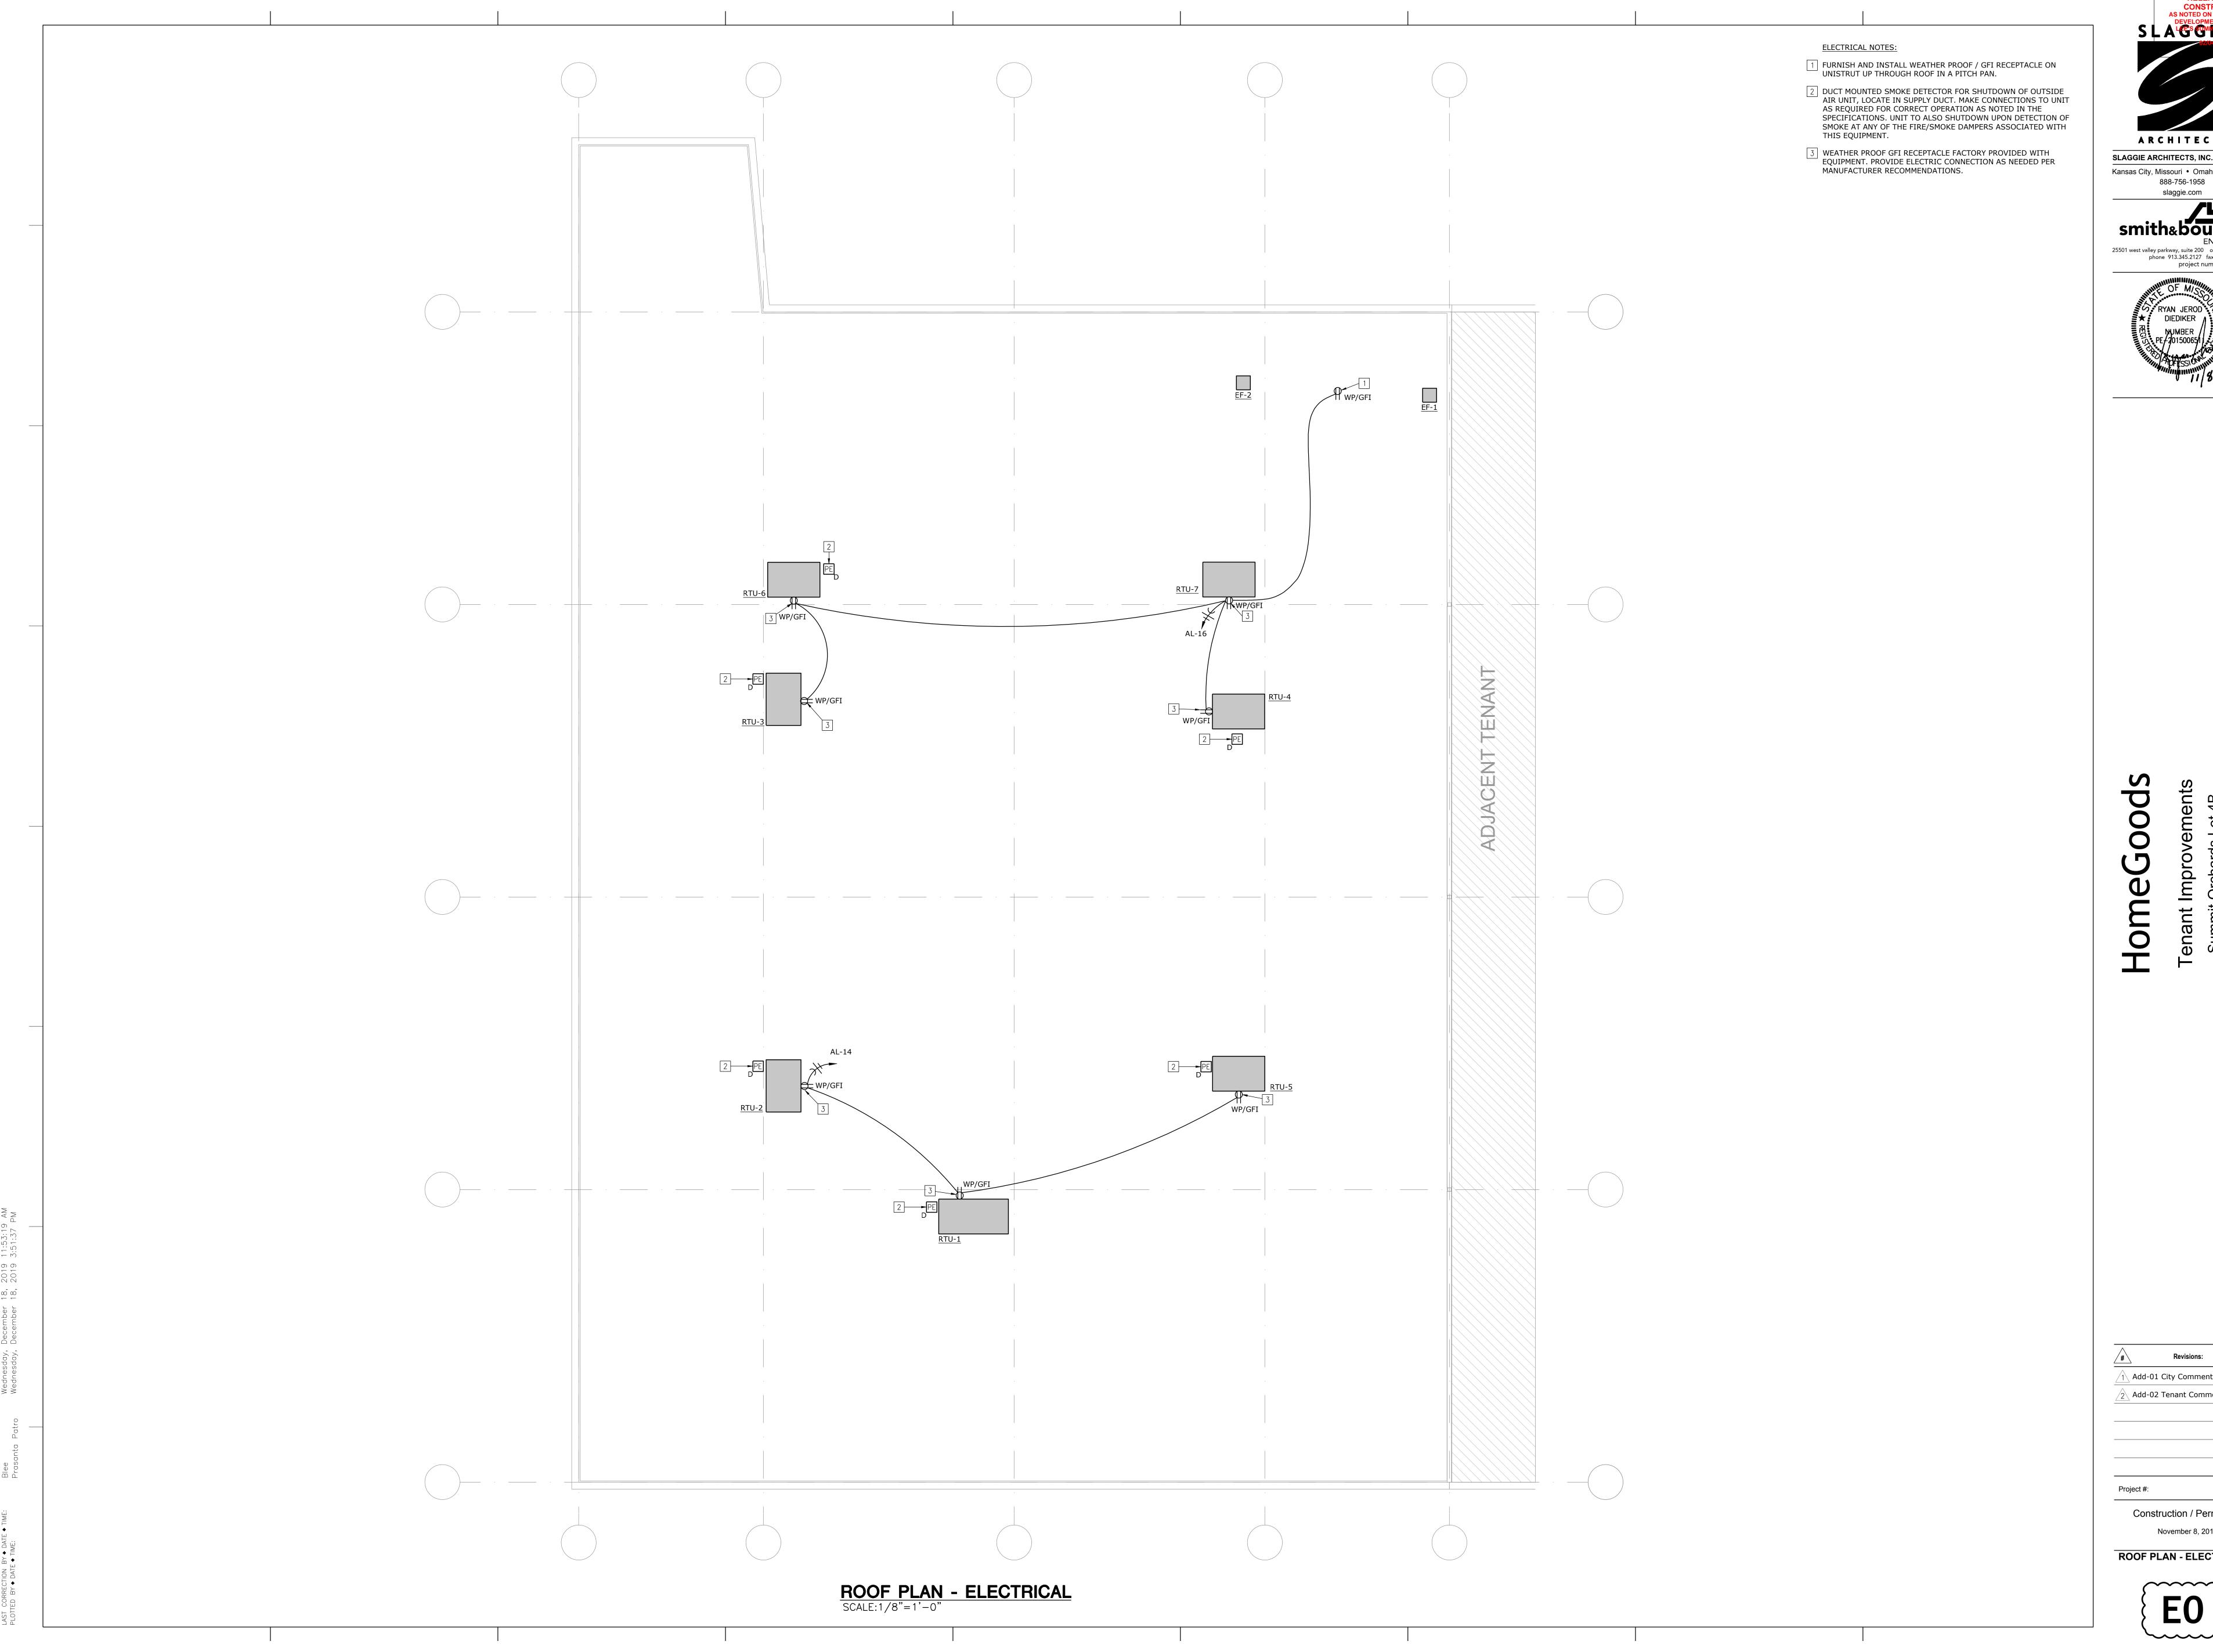



ARCHITECTS SLAGGIE ARCHITECTS, INC. ©2018 Kansas City, Missouri • Omaha, Nebraska

25501 west valley parkway, suite 200 olathe, ks 66061 phone 913.345.2127 fax 913.345.0617 project number 1923000




Add-02 Tenant Comments 12/18/19

Construction / Permit Set November 8, 2019

**ROOF PLAN - ELECTRICAL** 



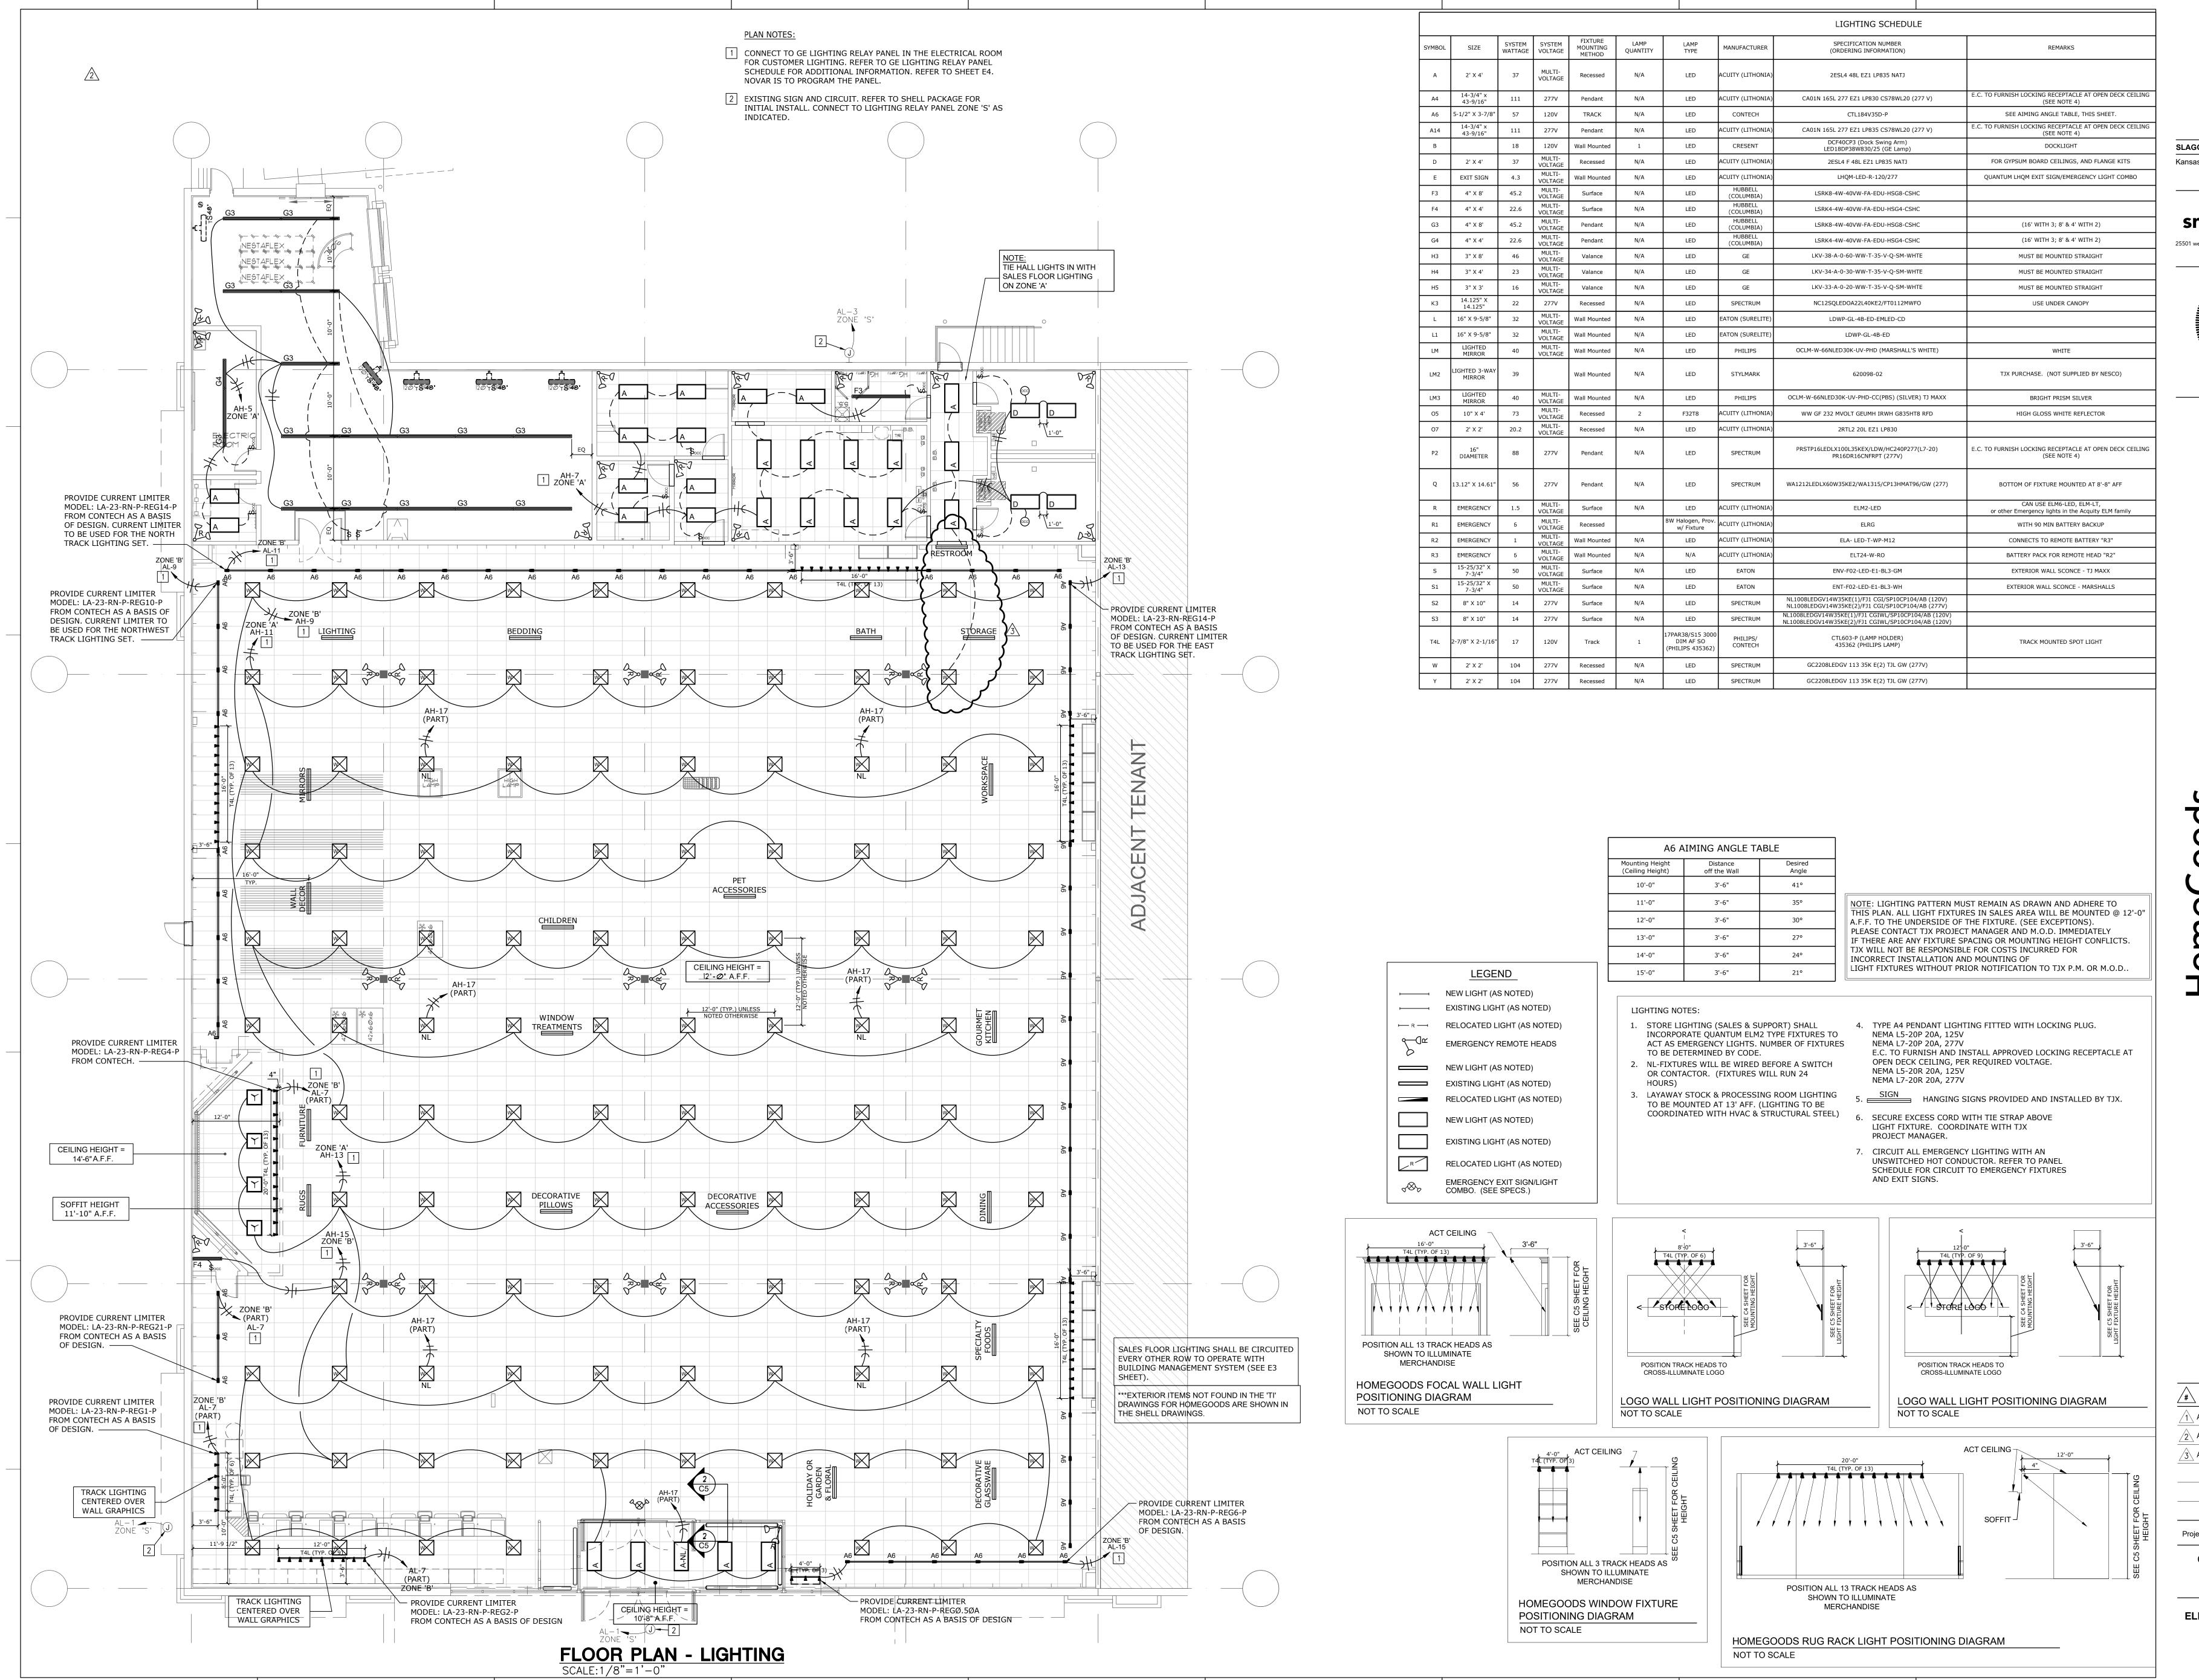




ARCHITECTS

SLAGGIE ARCHITECTS, INC. ©2018

Kansas City, Missouri • Omaha, Nebraska
888-756-1958
slaggie.com

smith&boucher
ENGINEERS
25501 west valley parkway, suite 200 olathe, ks 66061
phone 913.345.2127 fax 913.345.0617
project number 1923000

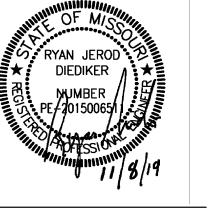

HomeGoods
Tenant Improvements

Revisions:

1 Add-01 City Comments 11/18/19

2 Add-02 Tenant Comments 12/18/19


3 Add-03 Tenant Comments 01/10/20

Project #: 180902-02

Construction / Permit Set
November 8, 2019

LIGHTING PLAN & ELECTRICAL SYMBOLS

E1

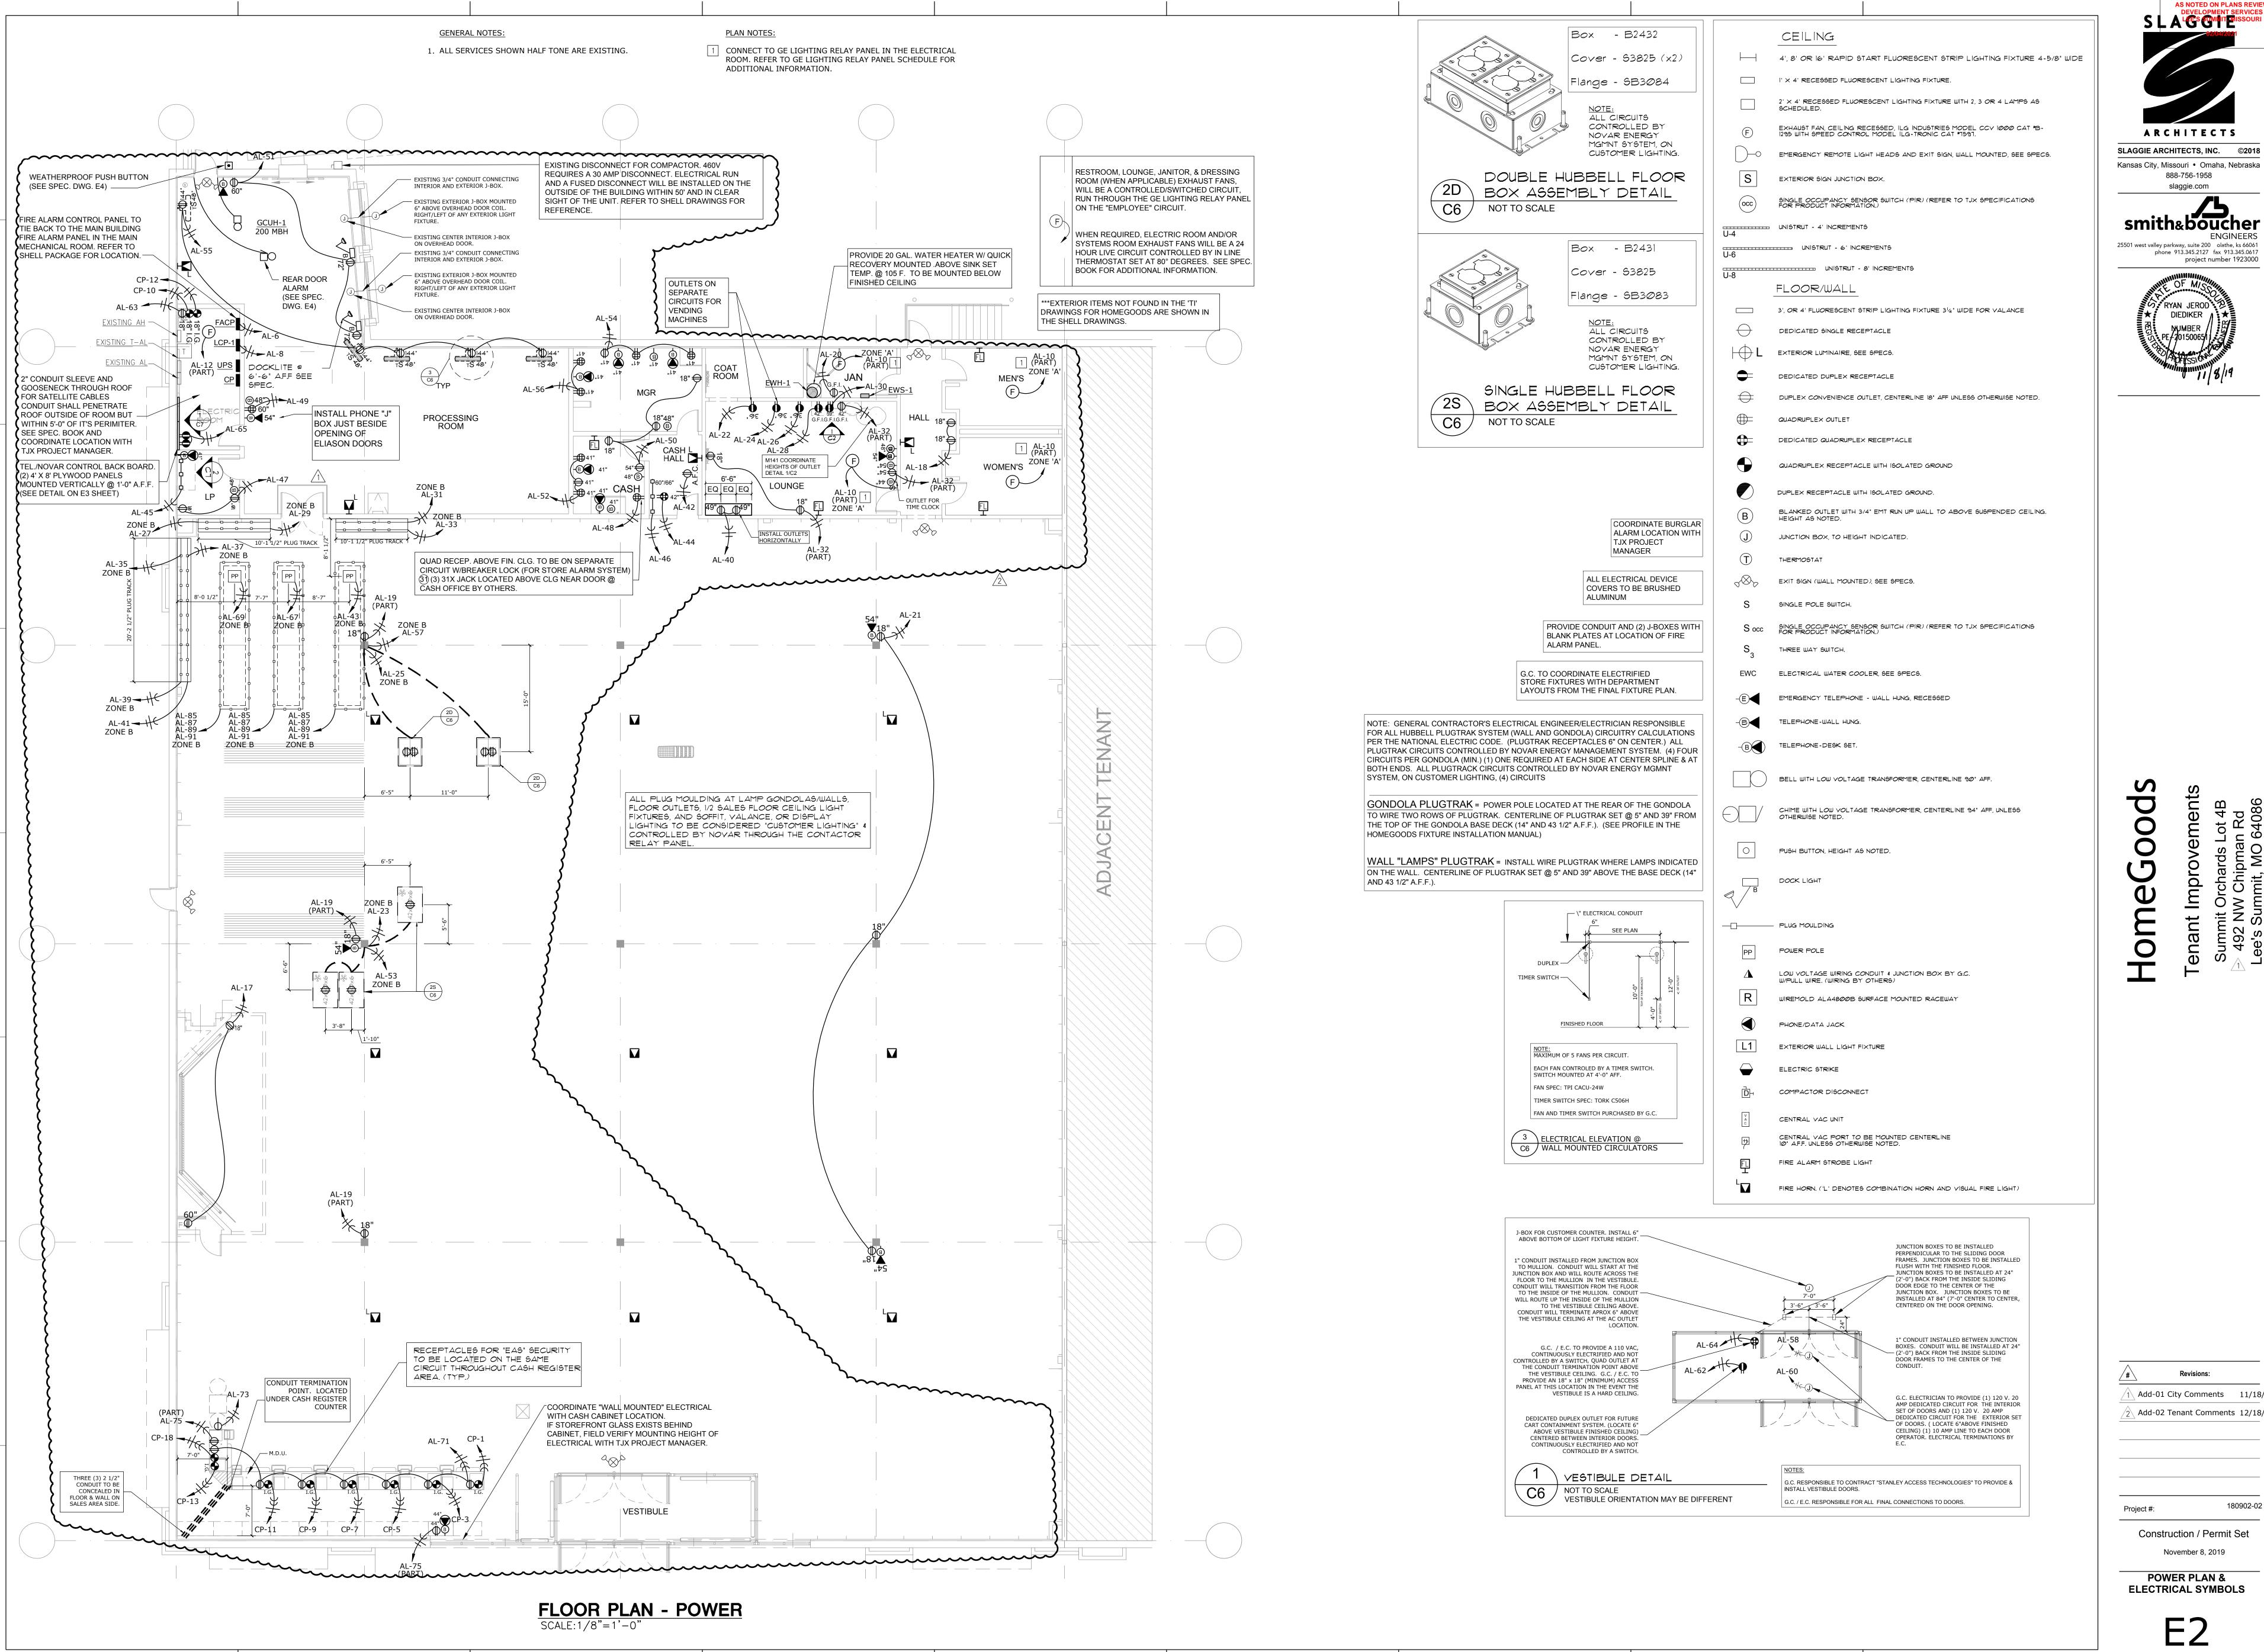




ARCHITECTS SLAGGIE ARCHITECTS, INC. ©2018

slaggie.com smith&boucher

888-756-1958

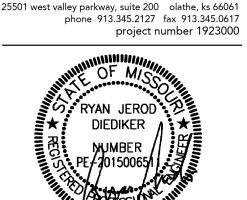

Add-01 City Comments 11/18/19 Add-02 Tenant Comments 12/18/19

180902-02 Project #:

Construction / Permit Set November 8, 2019

POWER PLAN & **ELECTRICAL SYMBOLS** 


NOT TO SCALE

NOT TO SCALE

CONSTRUCTION **AS NOTED ON PLANS REVIEW** ARCHITECT! 888-756-1958

**RELEASE FOR** 

SLAGGIE ARCHITECTS, INC. ©2018 Kansas City, Missouri • Omaha, Nebraska slaggie.com 25501 west valley parkway, suite 200 olathe, ks 6606 phone 913.345.2127 fax 913.345.0617 project number 1923000

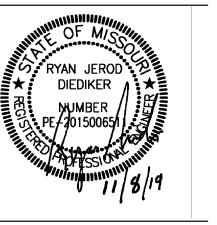


Add-01 City Comments 11/18/19 Add-02 Tenant Comments 12/18/19

Construction / Permit Set

November 8, 2019

P.O.S., REG., & MISC. ELECT. **DETAILS** 

NOT TO SCALE

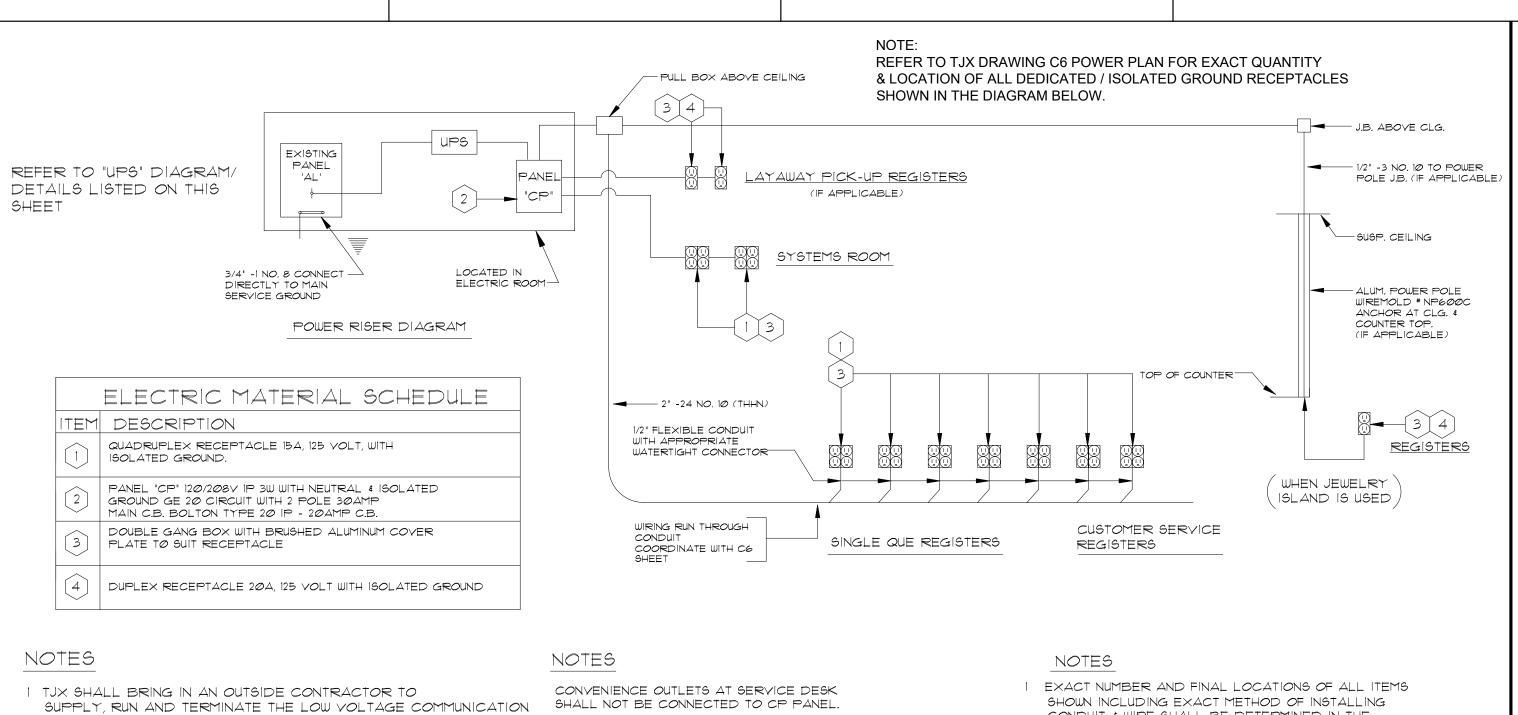

WIRING. THIS INCLUDES THE LOW VOLTAGE WIRING FOR REGISTERS POS AS WELL AS THE CABLE FOR THE TIME CLOCK, ACS AND MANAGERS OFFICE TO LAYAWAY CABLES.

2 CABLES TO BE RUN IN ONE PIECE FROM REGISTER TO REGISTER

3 ALL LOW VOLTAGE WIRING TO BE INSTALLED ABOVE HUNG CLG. AND SHALL BE KEPT A MINIMUM OF 5'-O" FROM FLUORESCENT LIGHTING FIXTURES

4 CONTRACTOR IS RESPONSIBLE FOR CONDUIT AND PULL STRINGS.

P.O.S. A.C. WIRING TEST FOR INSULATED-ISOLATED GROUND

TO TEST DISCONNECT I.G. GROUND AT MAIN ENTRANCE AND CHECK ALL OUTLETS FROM:

GROUND TO BOX----NO CONTINUITY GROUND TO NEUTRAL ----- NO CONTINUITY - NO VOLTAGE GROUND TO HOT-----NO YOLTAGE WITH I.G. GROUND HOOKED BACK UP AT MAIN PANEL

I.G. GROUND TO BE TAGGED OR LABELED AT MAIN ENTRANCE. GROUND TO BOX----NO CONTINUITY GROUND TO NEUTRAL-----CONTINUITY-@ VOLTAGE GROUND TO HOT-----120 YOLTS

CONDUIT & WIRE SHALL BE DETERMINED IN THE FIELD WITH TJX REPRESENTATIVE.

2 ALL WIRING SHALL BE TYPE "THW" OR "THHN" COPPER


RUN IN CONDUIT. 3 PROVIDE A SEPARATE NEUTRAL AND GROUND CONDUCTOR FOR EACH 120 VOLT CIRCUIT PROVIDED FROM PANEL "CP" PANEL "CP" SHALL BE USED TO SUPPLY ONLY REGISTER EQUIP. 4 ALL GROUND CONNECTORS SHALL BE ISOLATED (PURE-GROUND ONLY) AND SHALL NOT BE GROUNDED TO ANY


METAL ENCLOLSURES 5 THE ELECTRICAL CONTRACTOR SHALL LABEL ALL PANELS, RECEPTACLES, SWITCHES, ETC., TO IDENTIFY

VOLTAGES AND FUNCTION. 6 PROVIDE RED NAMEPLATE STENCIL AS FOLLOWS: "FOR COMPUTER EQUIPMENT ONLY - NOT FOR GENERAL USE"

### P.O.S. CASH REGISTER 120 VOLT WIRING

NOT TO SCALE

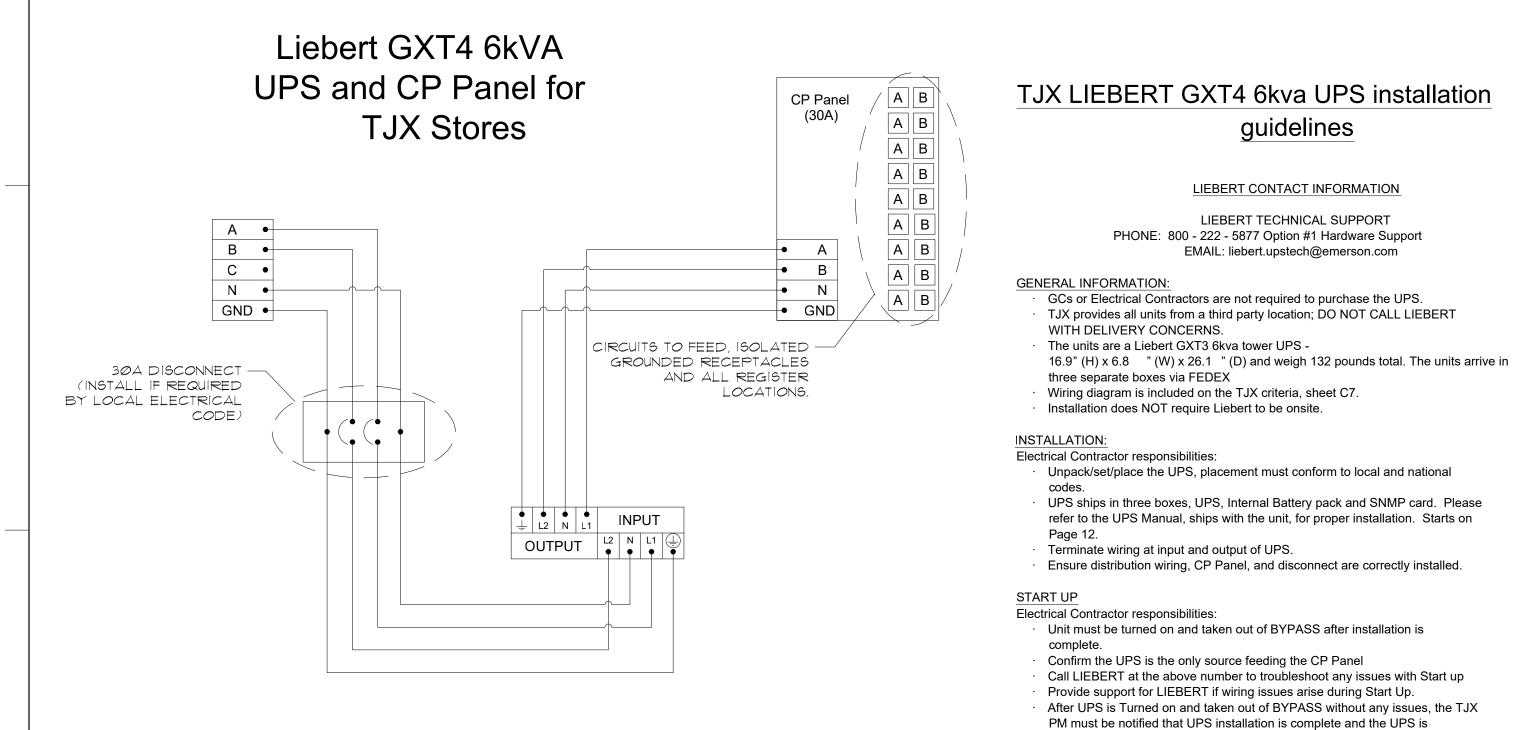

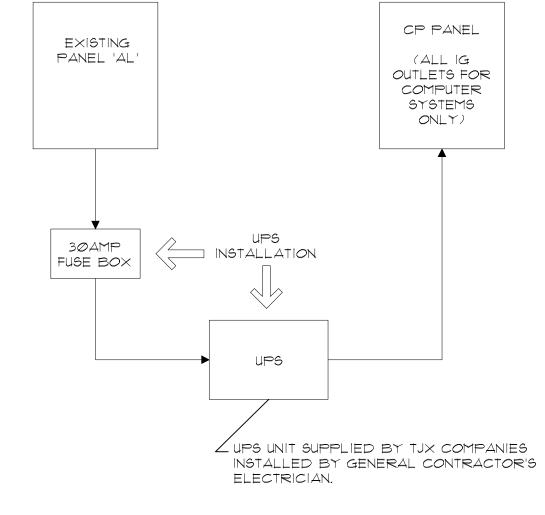

NOTES:

1. LIEBERT RECOMMENDED WIRE SIZE, INCLUDING GROUND WIRE, @ 15° COPPER WIRE IS 10AWG (4mm). MAXIMUM WIRE ACCEPTED BY TERMINAL BLOCK IS 8AWG (6mm).

2. LIEBERT RECOMMENDS INSTALLING A UL489 APPROVED BREAKER UPSTREAM OF UNIT.

3. THE INSTALLER MUST PROVIDE CIRCUIT BREAKER PROTECTION ACCORDING TO LOCAL CODES. THE UTILITY DISCONNECT SHOULD BE WITHIN SIGHT OF THE UPS OR HAVE AN APPROPRIATE LOCK OUT. MAINTAIN SERVICE SPACE AROUND THE UPS OR USE FLEXIBLE CONDUIT.

4. THE INSTALLER MUST PROVIDE OUTPUT DISTRIBUTION PANELS, CIRCUIT BREAKER PROTECTION, OR EMERGENCY DISCONNECTS ACCORDING TO LOCAL CODES.

5. OUTPUT CIRCUITS MUST NOT SHARE A COMMON.

6. CP PANEL WILL SERVICE ALL REGISTER POWER, BLADE SERVER, IDF, AND BMS POWER ONLY. NO OTHER CIRCUIT TO BE FED FROM CP.

> BMS I NOVAR PANEL BMS 2 NOVAR RELAY PANEL

> > BMS 3 GE RELAY PANEL

functional without issues.

\*\*\* ALL DELIVERY QUESTIONS SHOULD \*\*\* BE DIRECTED TO TJX SYSTEMS IMPLEMENTATION AT 508-475-8105

UPS DIAGRAM

REG Ø1 REG Ø2 REG Ø3 REG Ø4 REG Ø5 REG 06

> \*\* CIRCUIT NEEDED ONLY WHEN REQUESTED BY SYSTEMS FOR REMOTE COMPUTER EQUIPMENT CONNECTION AND IG OUTLET.

REG Ø7

BMS 1

BMS 3

30 AMP CP PANEL

COMPUTER EQUIPMENT ONLY

LAYREG 40

LAYREG 41

JWLREG 50

JWLREG 51

SYSTEMS 1

SYSTEMS 2

BMS 2

CO IDF | \*\*

REAR DOOR ALARM CONTROL

A. FURNISH AND INSTALL A REAR DOOR ALARM CONTROL SYSTEM AT THE STOCK ROOM DOOR TO THE EXTERIOR  $(3'-0" \times 6'-8")$ . PROVIDE 120 VOLT CIRCUIT (UNSWITCHED) AND A LOW VOLTAGE TRANSFORMER (24V/50 VA) U.L. APPROVED, ABOVE THE HEAD OF THE DOOR (WITHIN 10'-0"). ALARM SHALL BE ACTIVATED BY DOOR CONTACTORS WHEN DOOR IS OPEN POSITION AND SHALL PRODUCE A CONTINUOUS CHIME TONE.

B. DOOR ALARM SYSTEM SHALL BE WHEELOCK 38GV29 FROM GRAINGER INDUSTRIES MODEL #CH121092 WITH WEATHERPROOF PUSH BUTTON.

TYPICAL CP PANEL NOT TO SCALE

_IG	HTING RELAY PANEL - "L	CP-1"			
RELAY#	RELAY AREA DESCRIPTION	CIRCUIT	LOCAL OVERRIDE	ZONE	NOTES
1	EMPLOYEE LIGHTING - SALES NORTH HALF #1	AH-9	N/A	В	1
2	EMPLOYEE LIGHTING - SALES SOUTH HALF #1	AH-13	N/A	А	1
3	CUSTOMER LTG	AH-15	N/A	В	1
4	EMPLOYEE LTG	AH-11	N/A	A	1
5	PROCESSING ROOM LTG	AH-5	N/A	A	1
6	EMPLOYEE LIGHTING - OFFICES	AH-7	N/A	Α	1
7	ECUH-1 (UNIT HEATER)	AH-8	N/A	Α	1
8	EXTERIOR SIGN - FRONT	AL-1	N/A	S	1
9	EXTERIOR SIGN - SIDE	AL-1	N/A	S	1
10	EXTERIOR SIGN - REAR	AL-3	N/A	S	1
11	CUSTOMER LIGHTING - SOUTH WEST TRACK	AL-7	N/A	В	1
12	CUSTOMER LIGHTING - NORTH WEST TRACK	AL-9	N/A	В	1
13	CUSTOMER LIGHTING - NORTH TRACK	AL-11	N/A	В	1
14	CUSTOMER LIGHTING - EAST TRACK	AL-13	N/A	В	1
15	CUSTOMER LIGHTING - SOUTH EAST TRACK	AL-15	N/A	В	1
16	QUAD FLOOR BOX	AL-23	N/A	В	1
17	QUAD FLOOR BOX	AL-25	N/A	В	1
18	REC - PLUG MOULD NW SET 1	AL-27	N/A	В	1
19	REC - PLUG MOULD NW SET 2	AL-29	N/A	В	1
20	REC - PLUG MOULD NE SET 1	AL-31	N/A	В	1
21	REC - PLUG MOULD NE SET 2	AL-33	N/A	В	1
22	REC - PLUG MOULD W SET 1	AL-35	N/A	В	1
23	REC - PLUG MOULD W SET 2	AL-37	N/A	В	1
24	REC - PLUG MOULD W SET 3	AL-39	N/A	В	1
25	REC - PLUG MOULD W SET 4	AL-41	N/A	В	1
26	POWER POLE #1	AL-43	N/A	В	1
27	REC FLOOR BOX	AL-53	N/A	В	1
28	WALL MOUNTED FANS	AL-55	N/A	A	1
29	REC FLOOR BOX	AL-57	N/A	В	1
30	REC - GONDOLA WEST SET 1	AL-85	N/A	В	1
31	REC - GONDOLA WEST SET 2	AL-87	N/A	В	1
32	REC - GONDOLA WEST SET 3	AL-89	N/A	В	1
33	REC - GONDOLA WEST SET 4	AL-91	N/A	В	1
34	REC - GONDOLA MIDDLE SET 1	AL-93	N/A	В	1
35	REC - GONDOLA MIDDLE SET 2	AL-95	N/A	В	1
36	REC - GONDOLA MIDDLE SET 3	AL-97	N/A	В	1
37	REC - GONDOLA MIDDLE SET 4	AL-99	N/A	В	1
38	REC - GONDOLA EAST SET 1	AL-101	N/A	В	1
39	REC - GONDOLA EAST SET 1	AL-103	N/A	В	1
40	REC - GONDOLA EAST SET 1	AL-105	N/A N/A	В	1 1
41	REC - GONDOLA EAST SET 1	AL-103	N/A N/A	В	1
42	EXHAUST FANS 1 & 2	AL-107 AL-10	N/A N/A	A	1
43	EBUH-1	AL-10	N/A N/A	A A	1 1
	EBUH-2	AL-68 AL-70	N/A N/A	A A	
44	EBUH-3	AL-70 AL-72	N/A N/A	A A	1
45					1
46	EBUH-4	AL-74	N/A	Α	1
47	EBUH-5	AL-76	N/A	Α	1
48	GCUH-1	AL-80	N/A	Α	1

BASIS OF DESIGN IS AN GE RELAY PANEL SYSTEM. ALL PRODUCT SUBSTITUTIONS SUBMITTED MUST BE APPROVED BY BRAND. ALL RELAYS TO BE RATED FOR 20A (MINIMUM) - NORMALLY CLOSED. SEVEN DAY TIME CLOCK INCLUDING SKIP-A-DAY CAPABILITY.

NOVAR WILL PROGRAM THE GE LIGHTSWEEP SOFTWARE AS PART OF THE COMMISIONING PROCESS AND TO BE PART OF THE BMS SYSTEM.

INSTALL PHOTOCELL AS NEEDED FACING NORTH ON TOP OF THE ROOF. REFER TO SHELL PACKAGE FOR OTHER EXTERIOR LIGHTING IN THE REAR AND NOT LOCATED HERE.

. COORDINATE SCHEDULED ON/OFF WITH ZONES: A,B,C,D,S

PANEL CP MAIN BUS AMPS: 30 A MAIN BREAKER: 30 A VOLTAGE: 208Y/120 V PHASES/WIRES: 1 PH / 3 W	М	C: ECTIONS OUNTING DCATION	G:	22,000 / 1-24 SF SURFA	PACE		EQUIP. & ISO. GRND. BUSSES
CIRCUIT DESCRIPTION	POLES	AMPS	CKT NO	CKT NO	AMPS	POLES	CIRCUIT DESCRIPTION
REG 01	1	20	1	2	20	1	SPARE
REG 02	1	20	3	4	20	1	SPARE
REG 03	1	20	5	6	20	1	SPARE
REG 04	1	20	7	8	20	1	SPARE
REG 05	1	20	9	10	20	1	SYSTEMS 1
REG 06	1	20	11	12	20	1	SYSTEMS 2
REG 07	1	20	13	14	20	1	SPARE
BMS #1 - NOVAR PANEL	1	20	15	16	20	1	BMS #2 - NOVAR RELAY PANEL
BMS #3 - GE RELAY PANEL	1	20	17	18	20	1	DEDICATED QUAD - FRONT DESK
SPARE	1	20	19	20	20	1	SPARE
SPARE	1	20	21	22	20	1	SPARE
SPARE	1	20	23	24	20	1	SPARE


	PANEL AH  MAIN BUS AMPS: 600 A  MAIN BREAKER: 600 A  VOLTAGE: 480Y/277 V  PHASES/WIRES: 3 PH / 4 W	M	C: ECTIONS DUNTIN DCATIOI	G:	22,000 1 - 42 S out o			EQUIPMENT GROUND BUS	
ZONE	CIRCUIT DESCRIPTION	POLES	AMPS	CKT NO	CKT NO	AMPS	POLES	CIRCUIT DESCRIPTION	
	LTG - EXIT SIGNS	1	20	1	2	30	3	TRASH COMPACTOR	
	LTG - EMERGENCY	1	20	3	4				
Α	LTG - PROCESSING, LP RM		20	5	6				
Α	LTG - NORTH EASTERN ROOMS		20	7	8	15		ECUH-1 (UNIT HEATER)	
В	LTG - SALES NORTH HALF #1	1	20	9	10			PREPARED SPACE	
Α	LTG - SALES NORTH HALF #2	1	20	11	12			PREPARED SPACE	
Α	LTG - SALES SOUTH HALF #1		20	13	14		1	PREPARED SPACE	
В	LTG - SALE SOUTH HALF #2, VEST		20	15	16		1	PREPARED SPACE	
	LTG -SALES NIGHT LIGHTS		20	17	18			PREPARED SPACE	
	RTU-1		50	19	20	35	3	RTU-5	
				21	22				
				23	24				
	RTU-2	3	35	25	26	20	3	RTU-6	
				27	28				
				29	30				
	RTU-3	3	35	31	32	20	3	RTU-7	
				33	34				
				35	36				
	RTU-4	4 3	35	37	38	70	3	45 KVA TRANSFORMER	
				39	40			PANEL 'AL'	
				41	42				

M/	AIN BUS AMPS: AIN BREAKER: DLTAGE: HASES/WIRES:	150 A 208Y/120 V 3 PH / 4 W	MC	CTIONS OUNTING OCATION	G:	22,000 2 - 62 S SURFA	SPACE		EQUIPMENT GROUND E
	CIRCUIT DES	CRIPTION	POLES	AMPS	CKT NO	CKT NO	AMPS	POLES	CIRCUIT DESCRIPTION
		DING SIGNAGE		20	1	2	20	1	OVERHEAD DOOR 1 (E)
	(E)LTG - BUILI	DING SIGNAGE		20	3	4	20	1	OVERHEAD DOOR 2 (E)
	LTG SOUTH	SPARE I WEST TRACK		20 20	5 7	6 8	20 15	1	FIRE ALARM CONTROL PANEL LTG CNTRL PNL (LCP-1)
		HWEST TRACK		20	9	10	15	1	EF-1 & EF-2
		NORTH TRACK		20	11	12	20	1	SPARE
	LTG	- EAST TRACK	1	20	13	14	20	1	ROOF RECEPTACLE NORTH
		H EAST TRACK		20	15	16	20	1	ROOF RECEPTACLE SOUTH
	REC - RUG ARE	-A & STORAGE HALF COLUMN		20 20	17 19	18 20	20 20	1	REC - HALL DRINKING FOUNTA REC - JANITOR
		HALF COLUMN		20	21	22	20	1	REC - JANITOR  REC - LOUNGE VENDING #1
		EX FLOOR BOX		20	23	24	20	1	REC - LOUNGE VENDING #2
	REC - QUA	AD FLOOR BOX	1	20	25	26	20	1	REC - DED. OUTLET NORTH W
	REC - PLUG MC			20	27	28	20	1	REC - DED. OUTLET NORTH W
	REC - PLUG MC			20	29	30	20	1	REC - DED. OUTLET NORTH W
	REC - PLUG MO			20 20	31 33	32 34	20 20	1	REC - GENERAL + TIME CLK SPARE
		OULD W SET 1		20	35	36	20	1	SPARE
		OULD W SET 2		20	37	38	20	1	SPARE
	REC - PLUG M	OULD W SET 3	1	20	39	40	20	1	REC - SOUTH WALL HORIZON
		OULD W SET 4		20	41	42	20	1	REC - CASH HALL ABOVE CEI
		OWER POLE #1  C - LP OFFICE		20 20	43 45	44 46	20 20	1	REC - CASH HALL - QUAD REC - CASH HALL PLUG MOUL
F	REC - LP OFFICE			20	47	48	20	1	REC - CASH - ABOVE CEILING
	C - PROCESS R			20	49	50	20	1	REC - GEN. CASH & MGR ROC
RE	C - PROC. RM - [	DOCK LTG/GEN	1	20	51	52	20	1	REC - CASH - WEST WALL
		EC FLOOR BOX		20	53	54	20	1	REC - MGR ROOM - NORTH W
F	REC - WALL MNT			20	55	56	20	1	REC - MGR ROOM - WEST WA
		C - FLOOR BOX TOP UNITS 1-4		20 20	57 59	58 60	20 20	1	VESTIBULE INTERIOR DOOR VESTIBULE EXTERIOR DOOR
		TOP UNITS 5-7		20	61	62	20	1	REC - (FUTURE) VESTIBULE (
C -	ELECTRICAL RO			20	63	64	20	1	REC - QUAD VESTIBULE CEILI
<b>)</b> -	REC TELEPHON	E BACKBOARD	1	20	65	66	20	1	VESTIBULE SPARE
		OWER POLE #2		20	67	68	15	1	EBUH-1 (UNIT HEATER)
		OWER POLE #3 C - REGISTERS		20 20	69 71	70 72	15 15	1	EBUH-2 (UNIT HEATER) EBUH-3 (UNIT HEATER)
FC	- DEDICATED RI			20	73	74	15	1	EBUH-4 (UNIT HEATER)
		END C.O. AREA		20	75	76	15_	1	ERUH-5 (UNIT HEATER)
		UPS	2	30	77	78	20	1	SPARE
					79	80	20		GOUN-1 (UNIT HEATER-GAS)
P	ANEL 'CP' - ISOL	ATED GROUND	2	30	81 83	82 84	30	2	EWH-1 (WATER HEATER)
	REC - GONDOL	A WEST SET 1	1	20	85	86	20	1	SPARE
	REC - GONDOL			20	87	88	20	1	SPARE
	REC - GONDOL	A WEST SET 3	1	20	89	90	20	1	SPARE
	REC - GONDOL			20	91	92	20	1	SPARE
	REC - GONDOLA			20	93	94	20	1	SPARE
	REC - GONDOLA REC - GONDOLA			20 20	95 97	96 98	20 20	1	SPARE SPARE
	REC - GONDOLA			20	99	100	20	1	SPARE
		LA EAST SET 1		20	101	102	20	1	SPARE
	REC - GONDO	LA EAST SET 1	1	20	103	104	20	1	SPARE
		LA EAST SET 1		20	105	106	20	1	SPARE
	REC - GONDO	LA EAST SET 1		20	107	108	20	1	SPARE
		SPARE SPARE		20 20	109 111	110 112	20 20	1	SPARE SPARE
		SPARE		20	113	114	20	1	SPARE
		SPARE		20	115	116	20	1	SPARE
	PRE	PARED SPACE	1		117	118		1	PREPARED SPACE
		PARED SPACE			119	120		1	PREPARED SPACE
		PARED SPACE			121	122		1	PREPARED SPACE
	PRE	PARED SPACE PARED SPACE			123 125	124 126		1	PREPARED SPACE PREPARED SPACE
					125	126		4	DDEDABED ODAGE



RELEASE FOR CONSTRUCTION **AS NOTED ON PLANS REVIEW** 

25501 west valley parkway, suite 200 olathe, ks 66061 phone 913.345.2127 fax 913.345.0617 project number 1923000

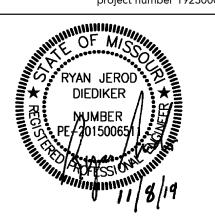

po

Add-01 City Comments 11/18/19 Add-02 Tenant Comments 12/18/19 3\ Add-03 Tenant Comments 01/10/20

Project #:

Construction / Permit Set November 8, 2019


ELECTRICAL DETAILS AND **SCHEDULES** 

## **ELECTRICAL SYMBOLS AND ABBREVIATIONS**

FIRE ALARM STROBE LIGHT

FIRE HORN. ('L' DENOTES COMBINATION HORN AND VISUAL FIRE LIGHT)

"SOME SYMBOLS AND ABBREVIATIONS ON THIS LEGEND MAY NOT BE USED. REFER TO FLOOR PLANS FOR ALL SYMBOLS AND ABBREVIATIONS."

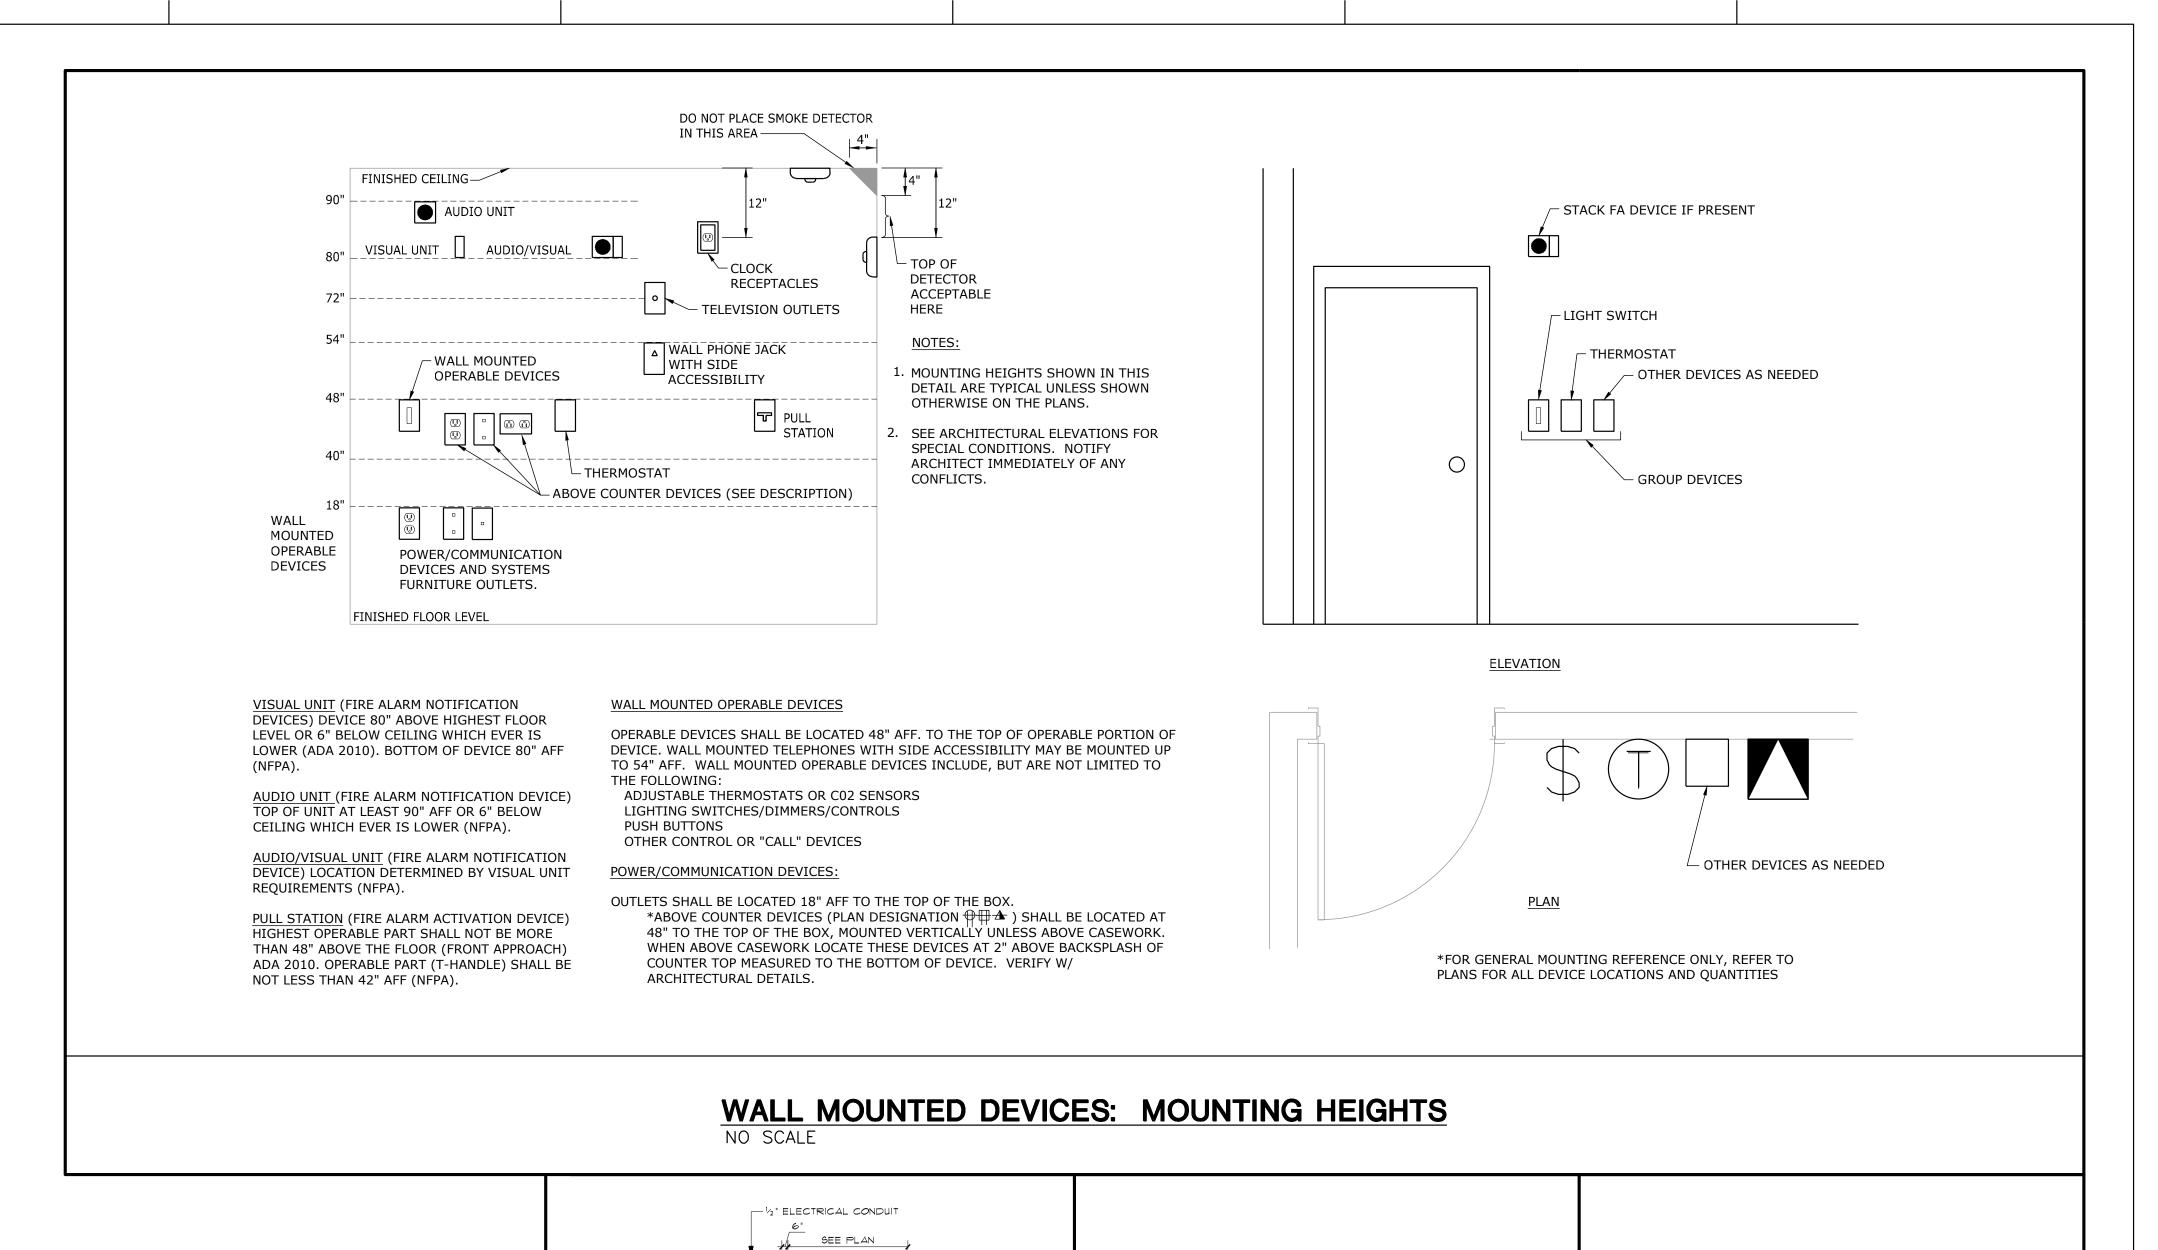

DUPLEX -


FINISHED FLOOR


SWITCH MOUNTED AT 4'-0' AFF.

FAN SPEC: TPI CACU-24W

TIMER SWITCH -

LOC NOT TO SCALE

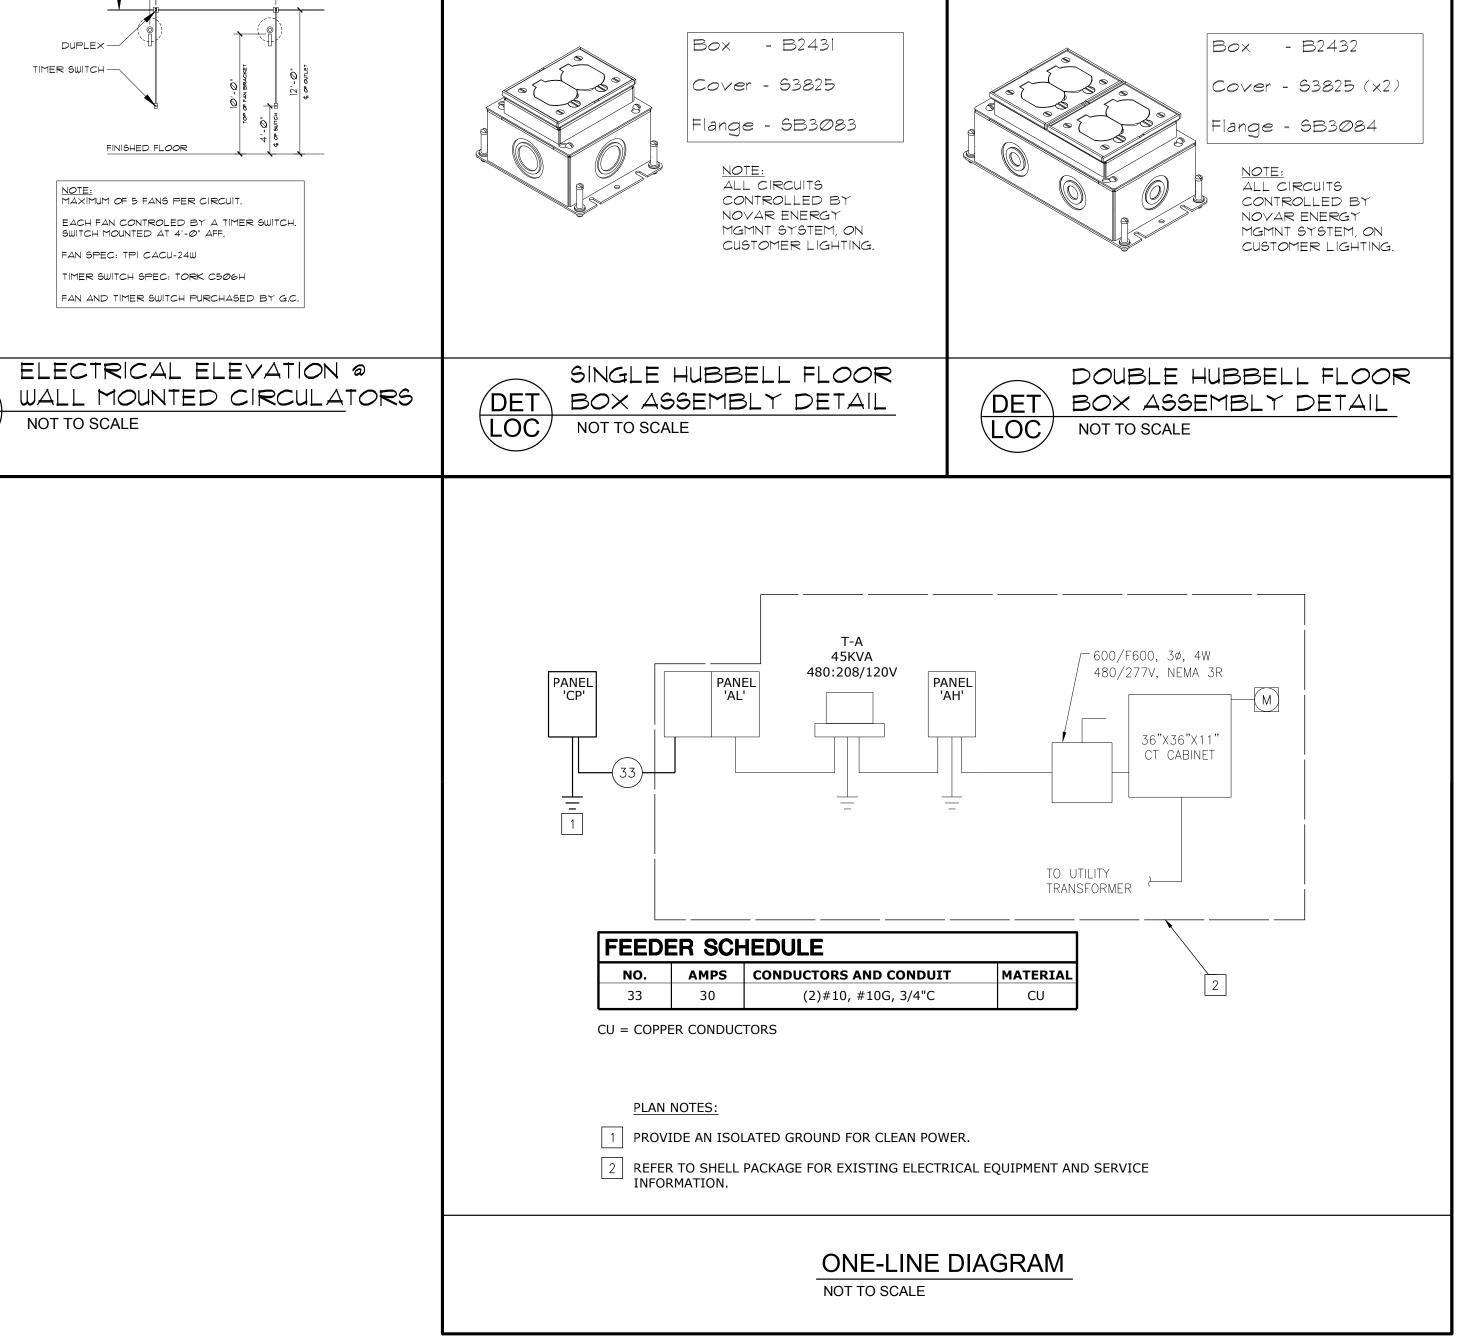

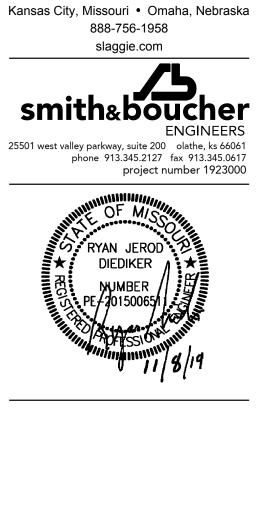

RELEASE FOR CONSTRUCTION AS NOTED ON PLANS REVIEW

S L A LES COMMIT MISSOURI

ARCHITECTS


SLAGGIE ARCHITECTS, INC. ©2018

0

Add-01 City Comments 11/18/19 Add-02 Tenant Comments 12/18/19

Construction / Permit Set November 8, 2019

**ELECTRICAL SYMBOLS, ABBREVIATIONS & DETAILS** 

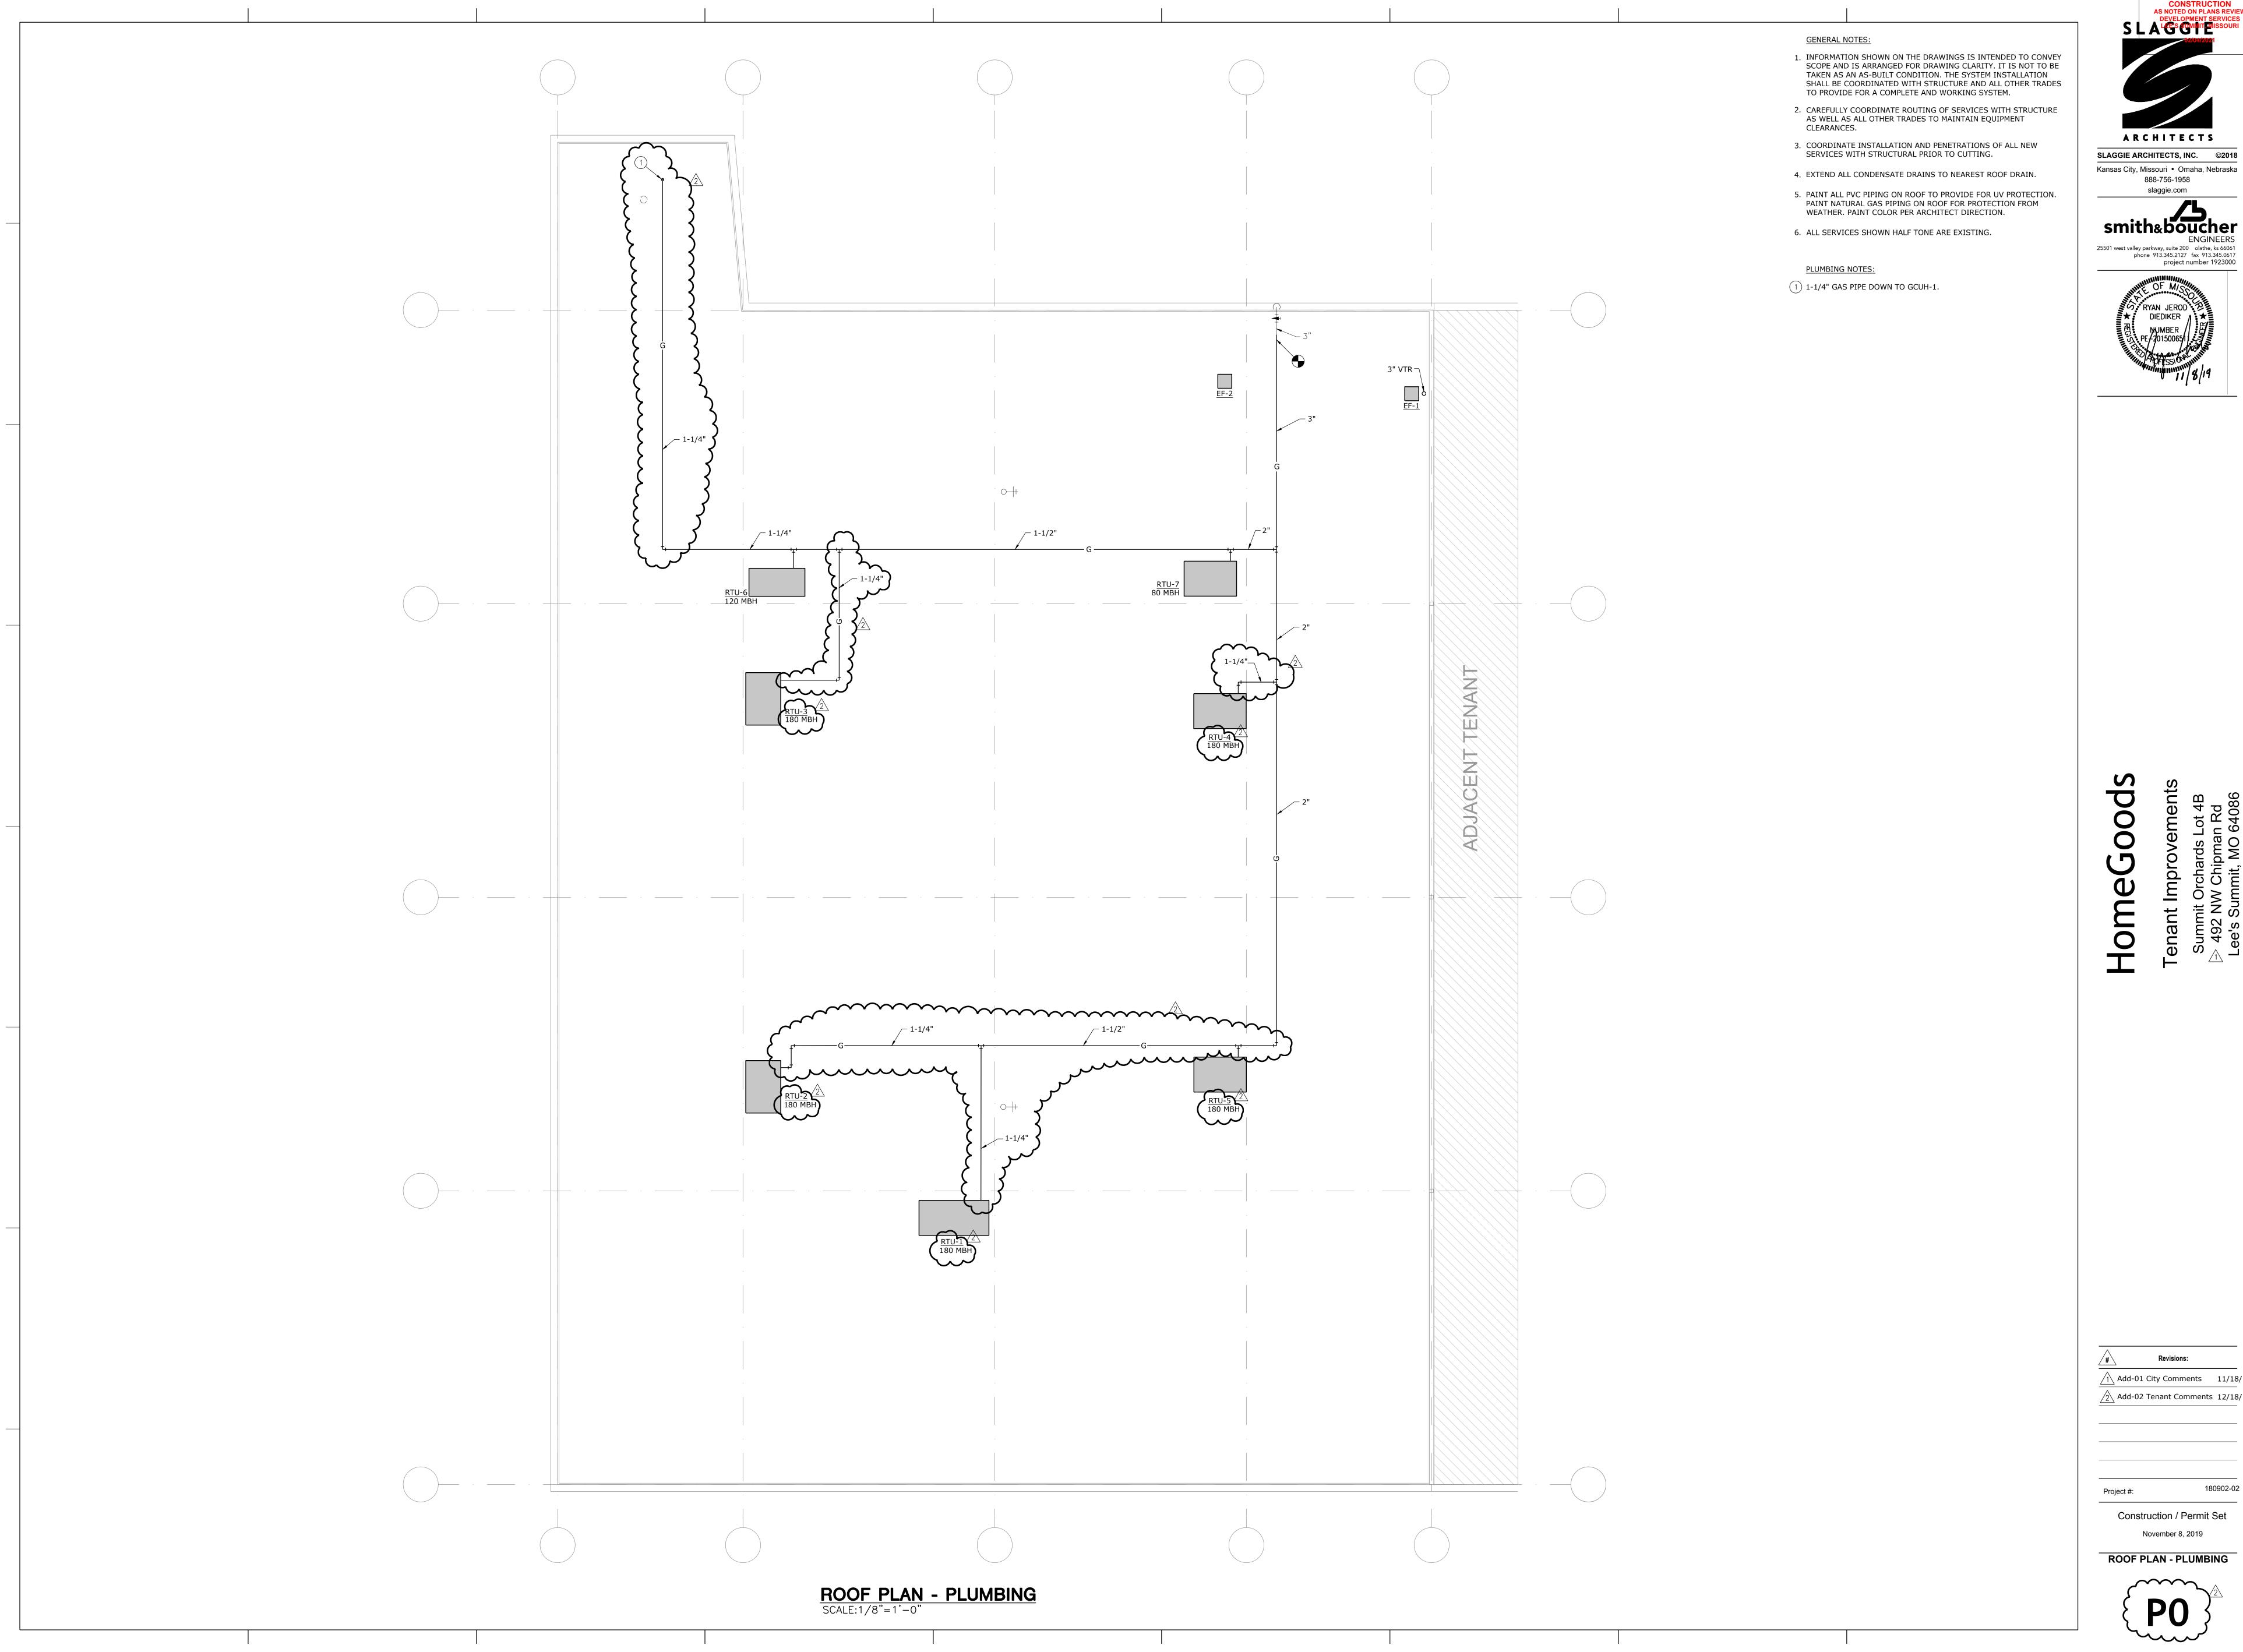


RELEASE FOR
CONSTRUCTION
AS NOTED ON PLANS REVIEW
DEVELOPMENT SERVICES
A LES COMMITTAMISSOURI

ARCHITECTS SLAGGIE ARCHITECTS, INC. ©2018

> 888-756-1958 slaggie.com

smith&boucher 25501 west valley parkway, suite 200 olathe, ks 66061 phone 913.345.2127 fax 913.345.0617 project number 1923000

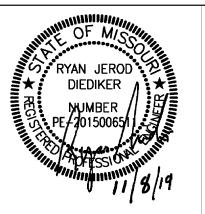

Add-02 Tenant Comments 12/18/19

Construction / Permit Set

November 8, 2019 ROOF PLAN - PLUMBING