




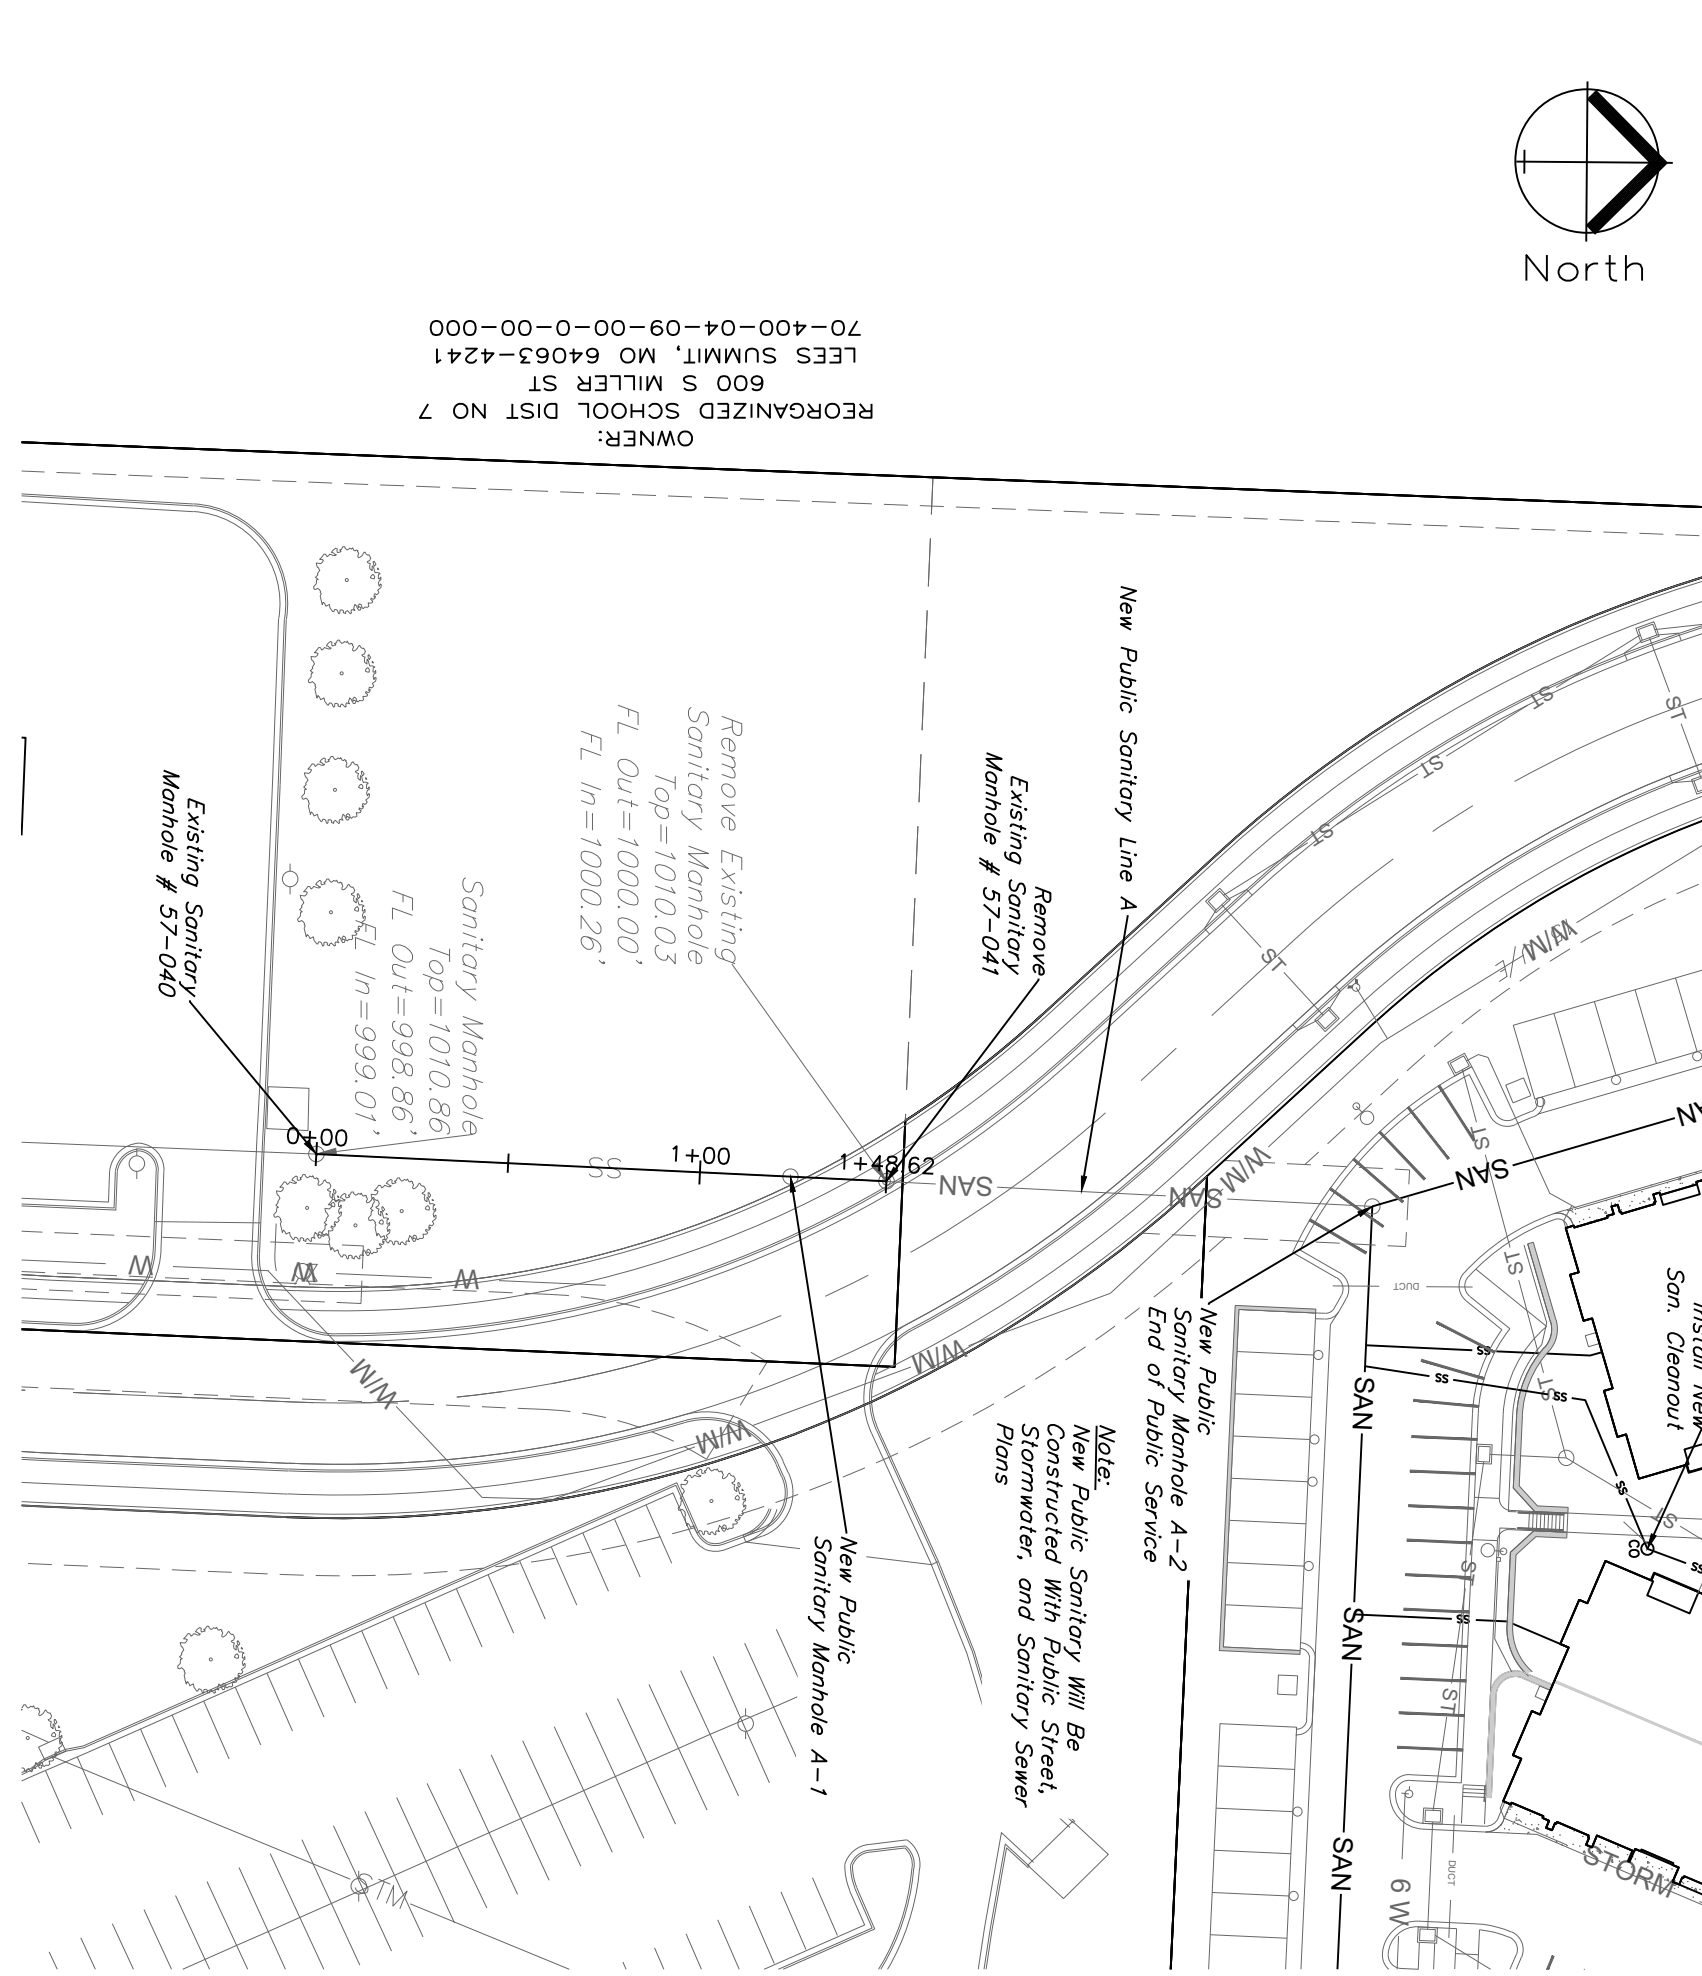

SANITARY SEWER PLAN & PROFILE
SCALE: 1" = 50'

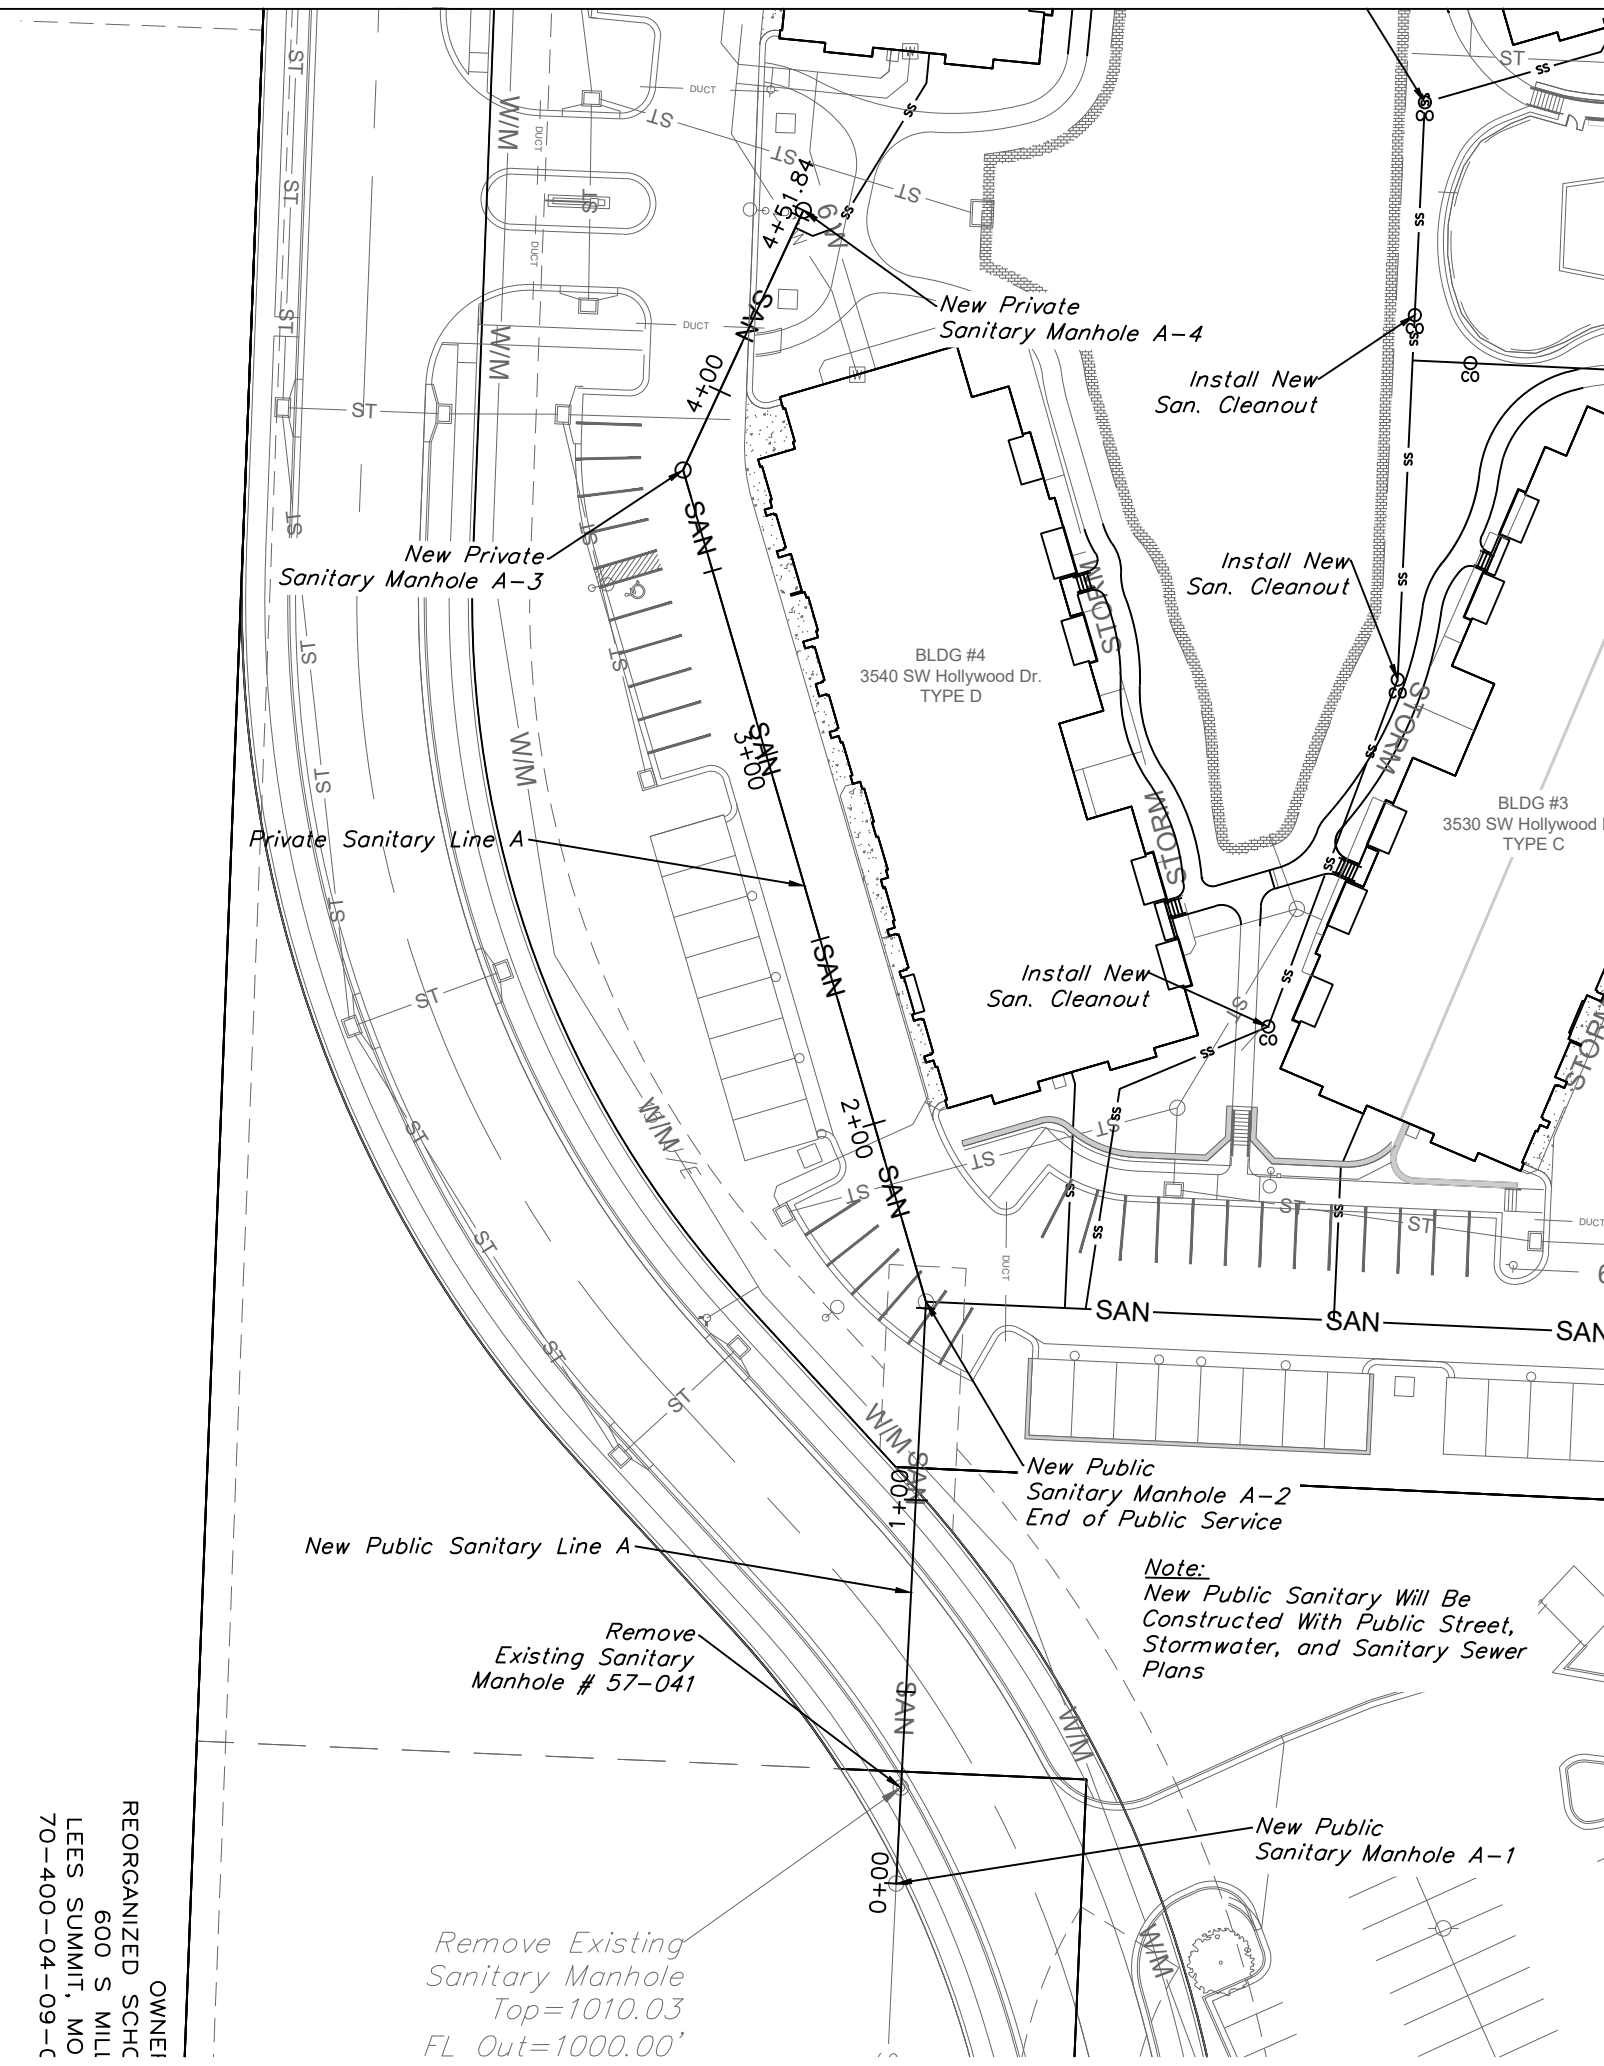



SANITARY SEWER PLAN & PROFILE
SCALE: 1" = 50'

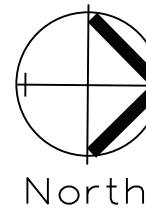



LEGEND

○ CLEANOUT SYMBOL
CO

EXISTING SANITARY

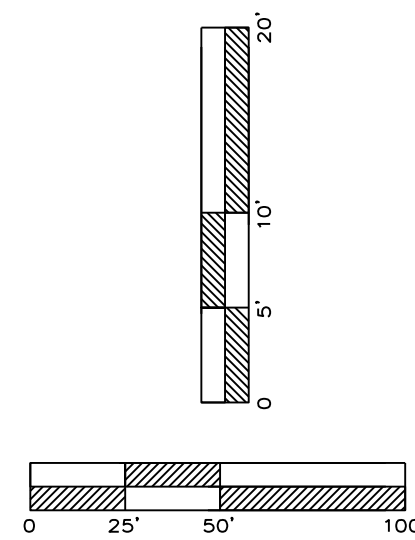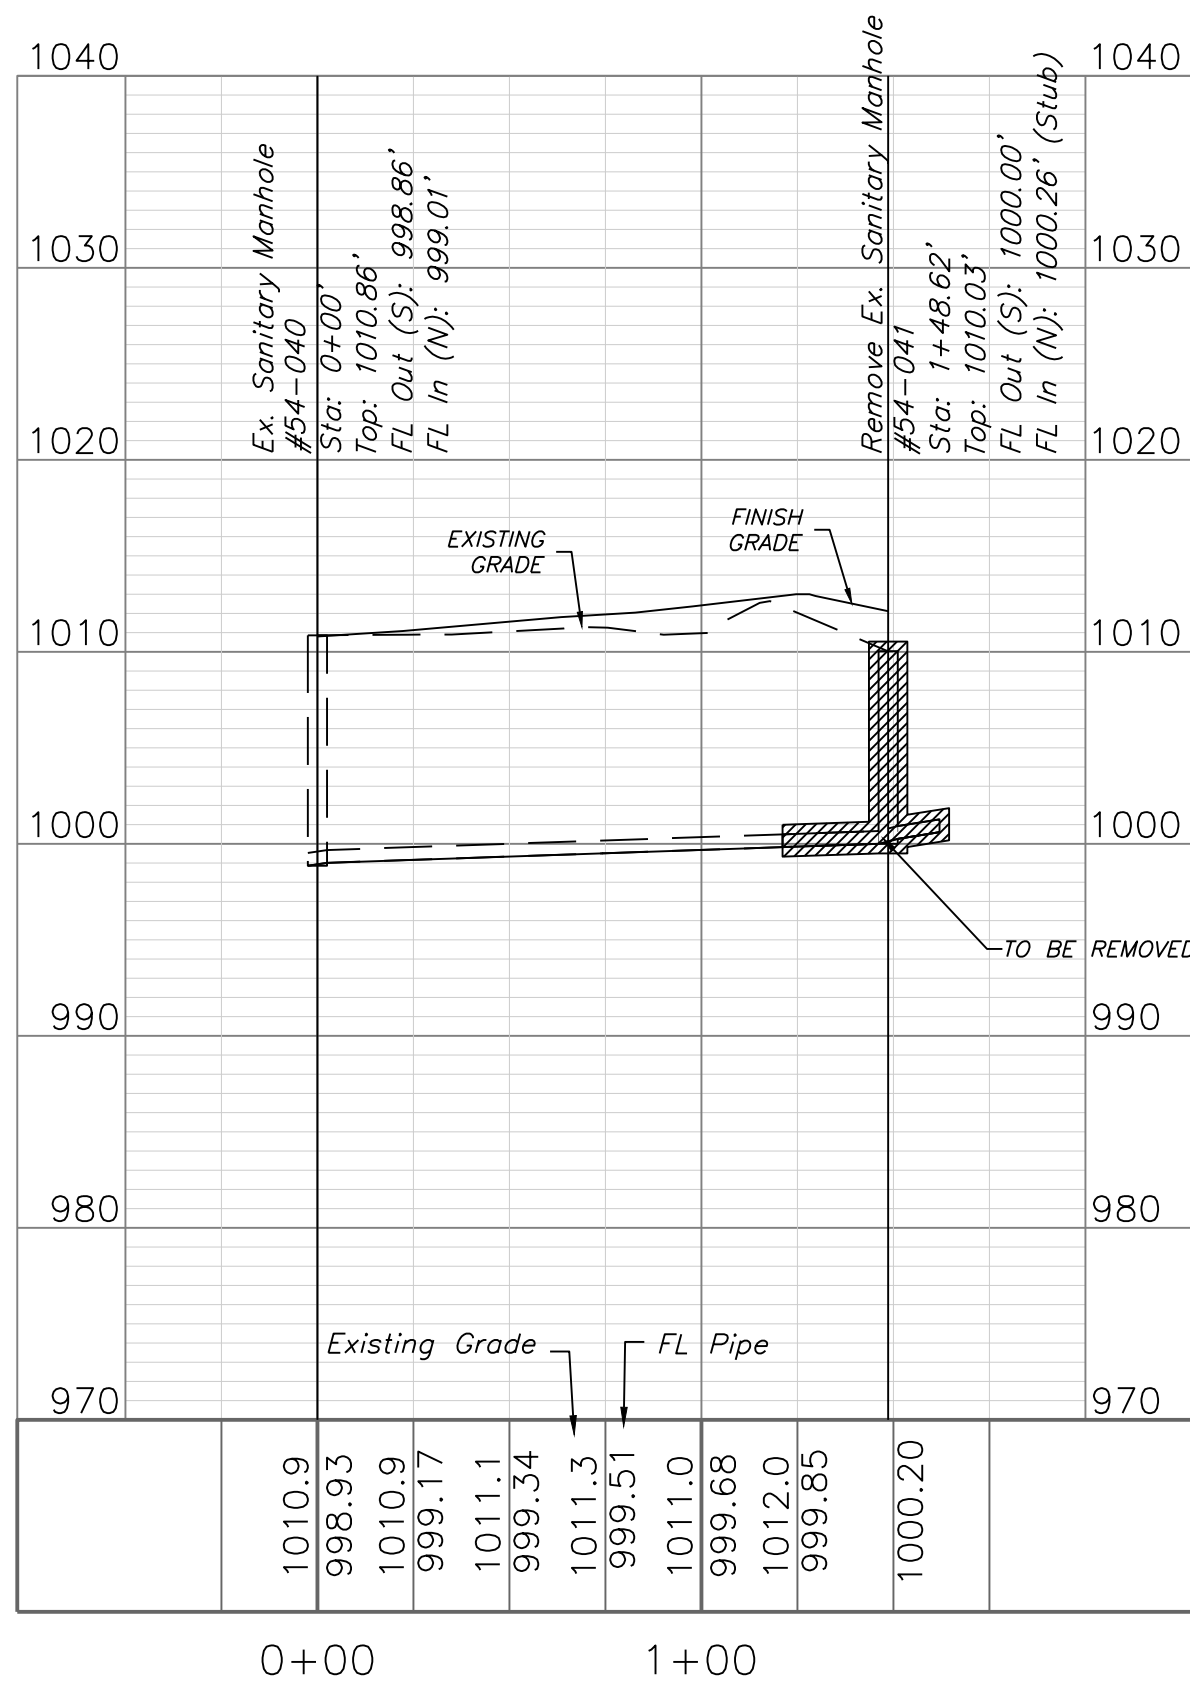


SANITARY LINE A

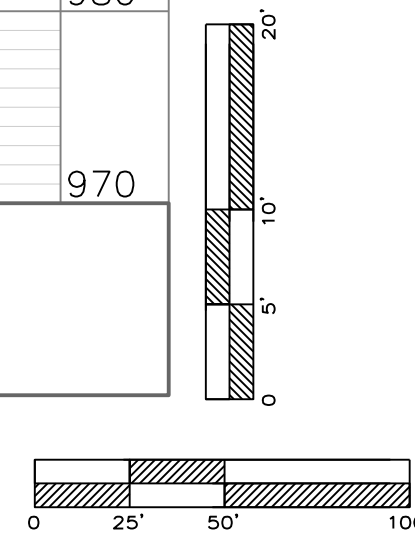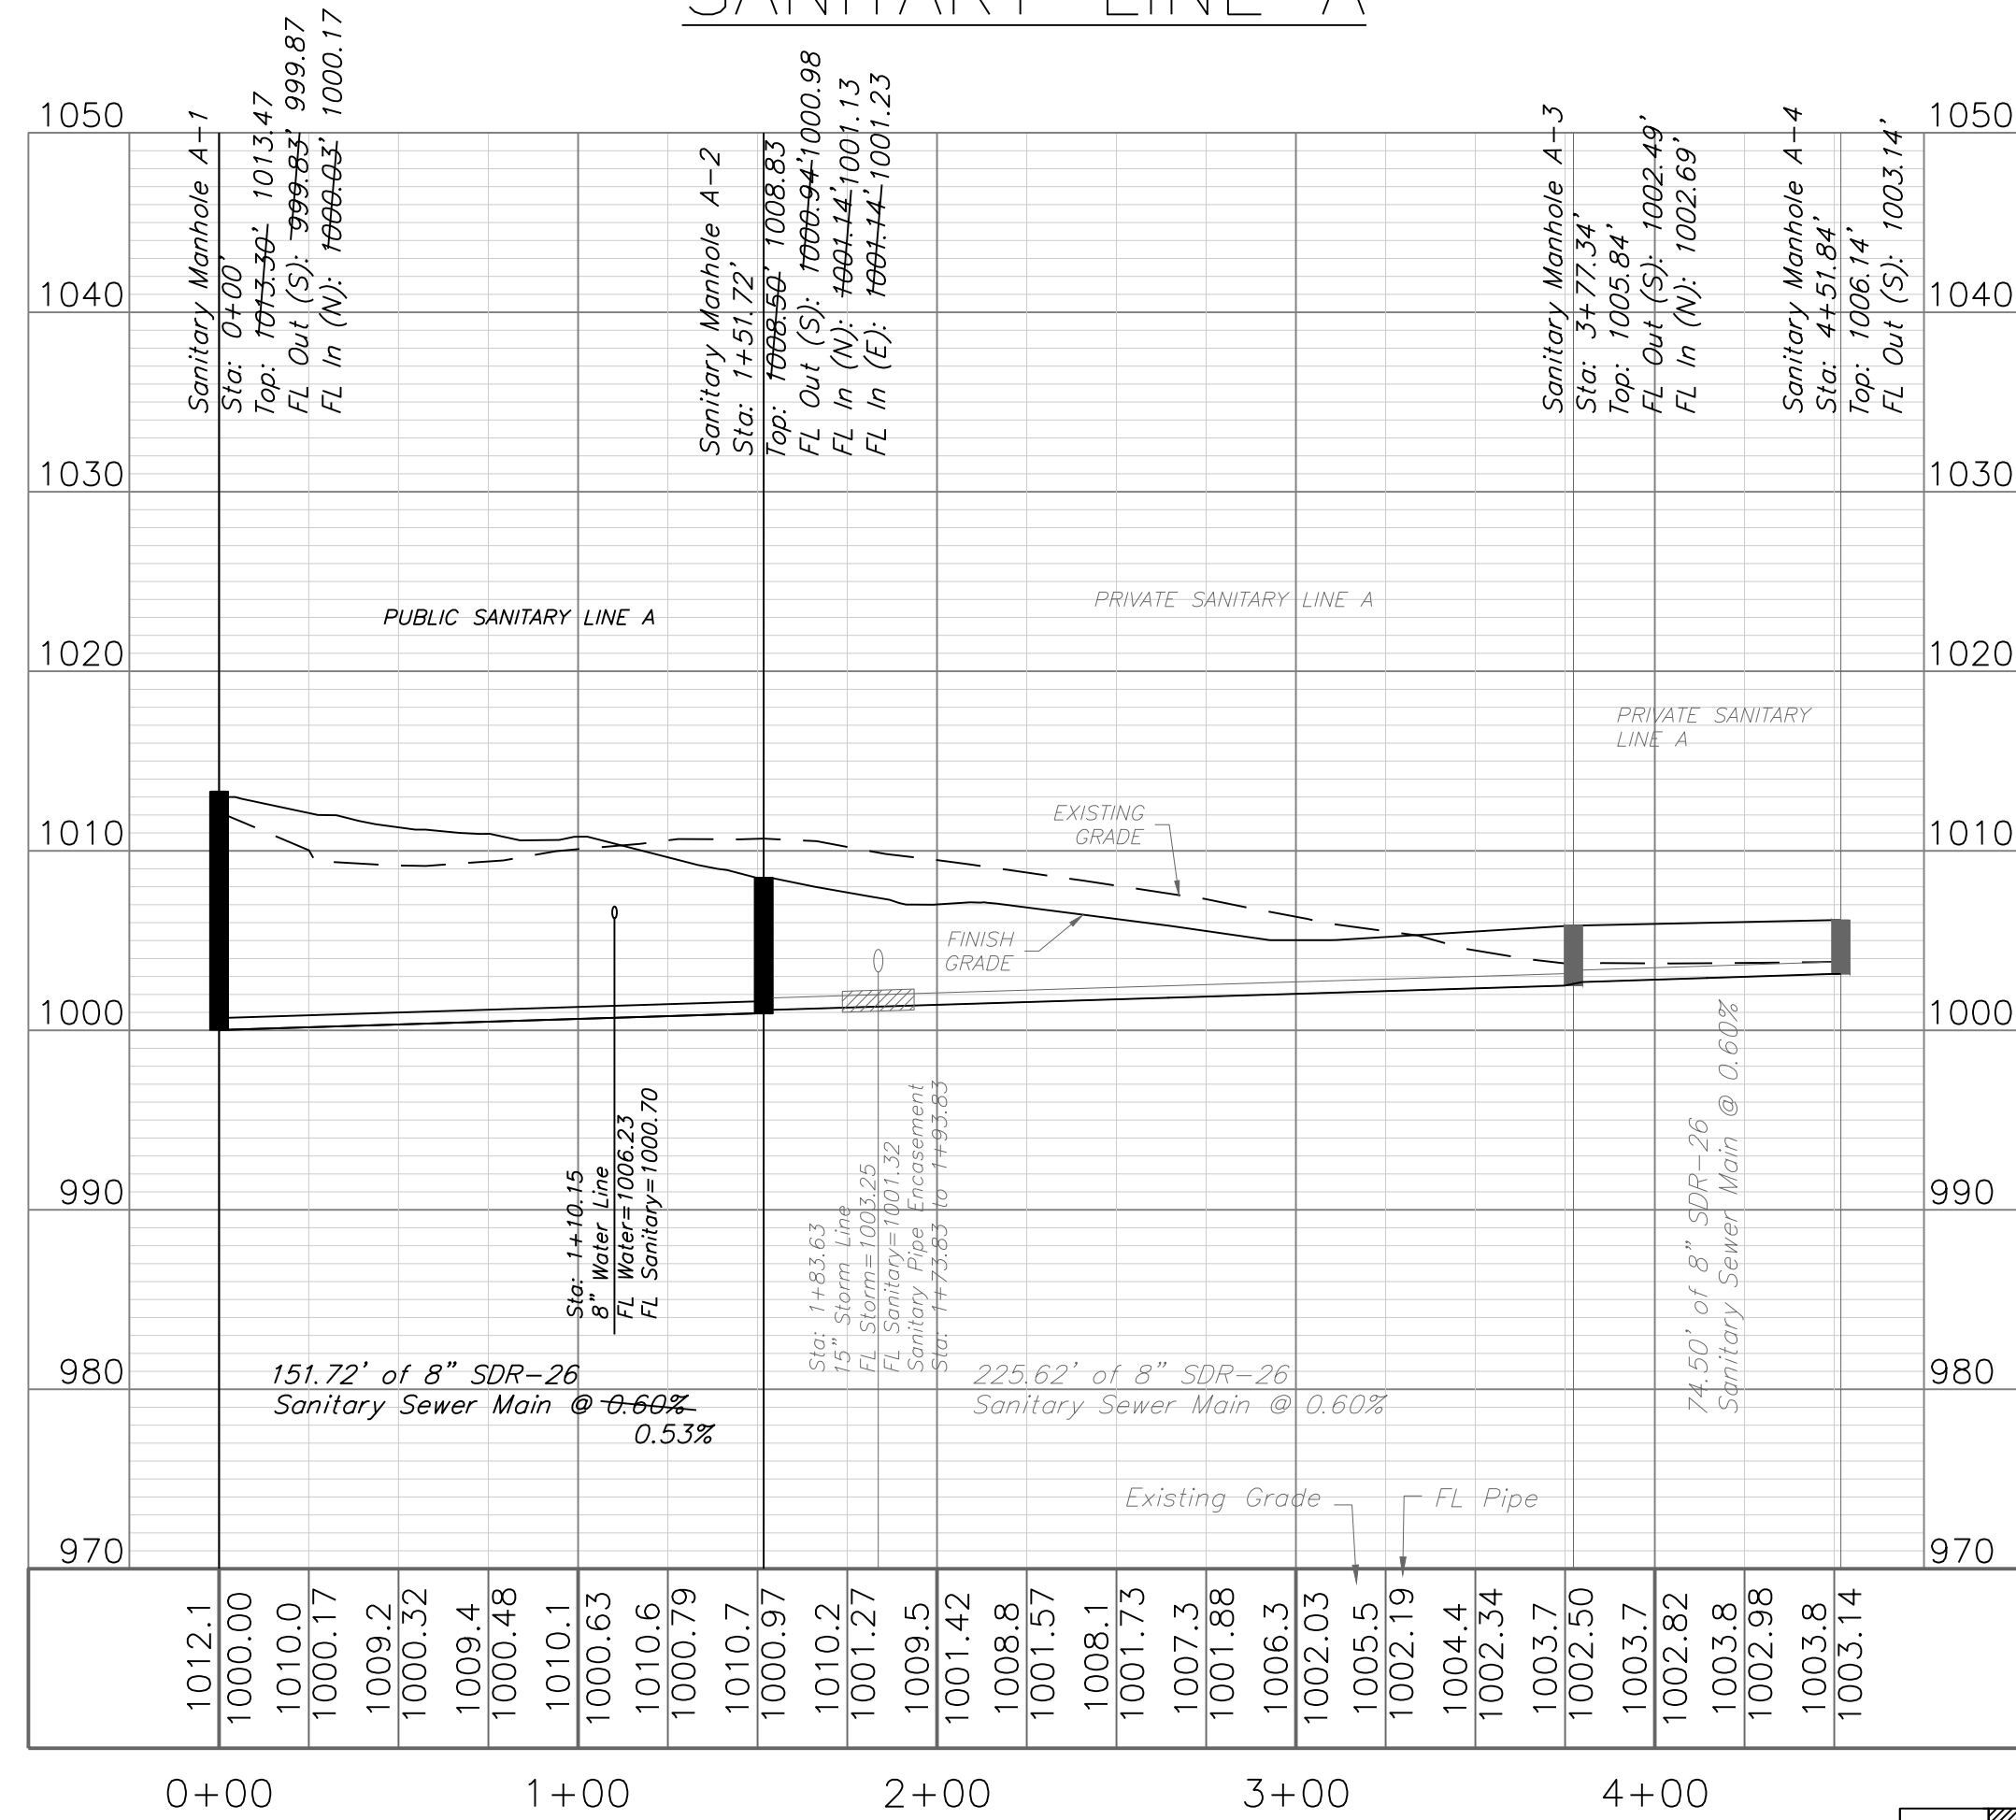

"AS-BUILT"

900.10
900.00 Indicates data replaced with "As-Built" information. All other data is as designed and has not been field verified.

SANITARY SEWER PLAN & PROFILE
Street and Grading Construction Plans for:
THE RESIDENCES AT ECHELON
Lee's Summit, Jackson County, Missouri

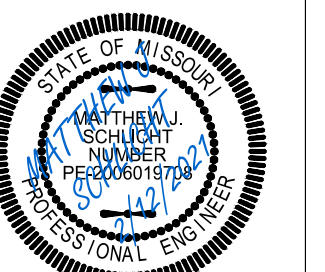

Matthew J. Schlicht
MO PE 2006019708
KS PE 19071
OK PE 25226

REVISIONS

2/12/2021 As-Built

C. 400

THE RESIDENCES AT ECHELON
Lee's Summit, Jackson County, Missouri

Project:
Echelon
Issue Date:
February 10, 2017

Professional Registration
Missouri
Engineering 200502188-D
Surveying 2005050518-D
Kansas
Engineering E-1695
Surveying LS-218
Oklahoma
Engineering 6254
Nebraska
Engineering CA2821

ENGINEERING
ENGINEERING & SURVEYING
SOLUTIONS
50 SE 30TH STREET
LEES SUMMIT, MO 64082
P: (816) 623-9888 F: (816) 623-9849