

ARCHITECTURE



225 Broadmoor Street
Overland Park, KS 66223

d Architecture, LLC

ate Certificate of Authority Number:
1234





ne - Gregory D. Highbarger
ense -Missouri - 007530

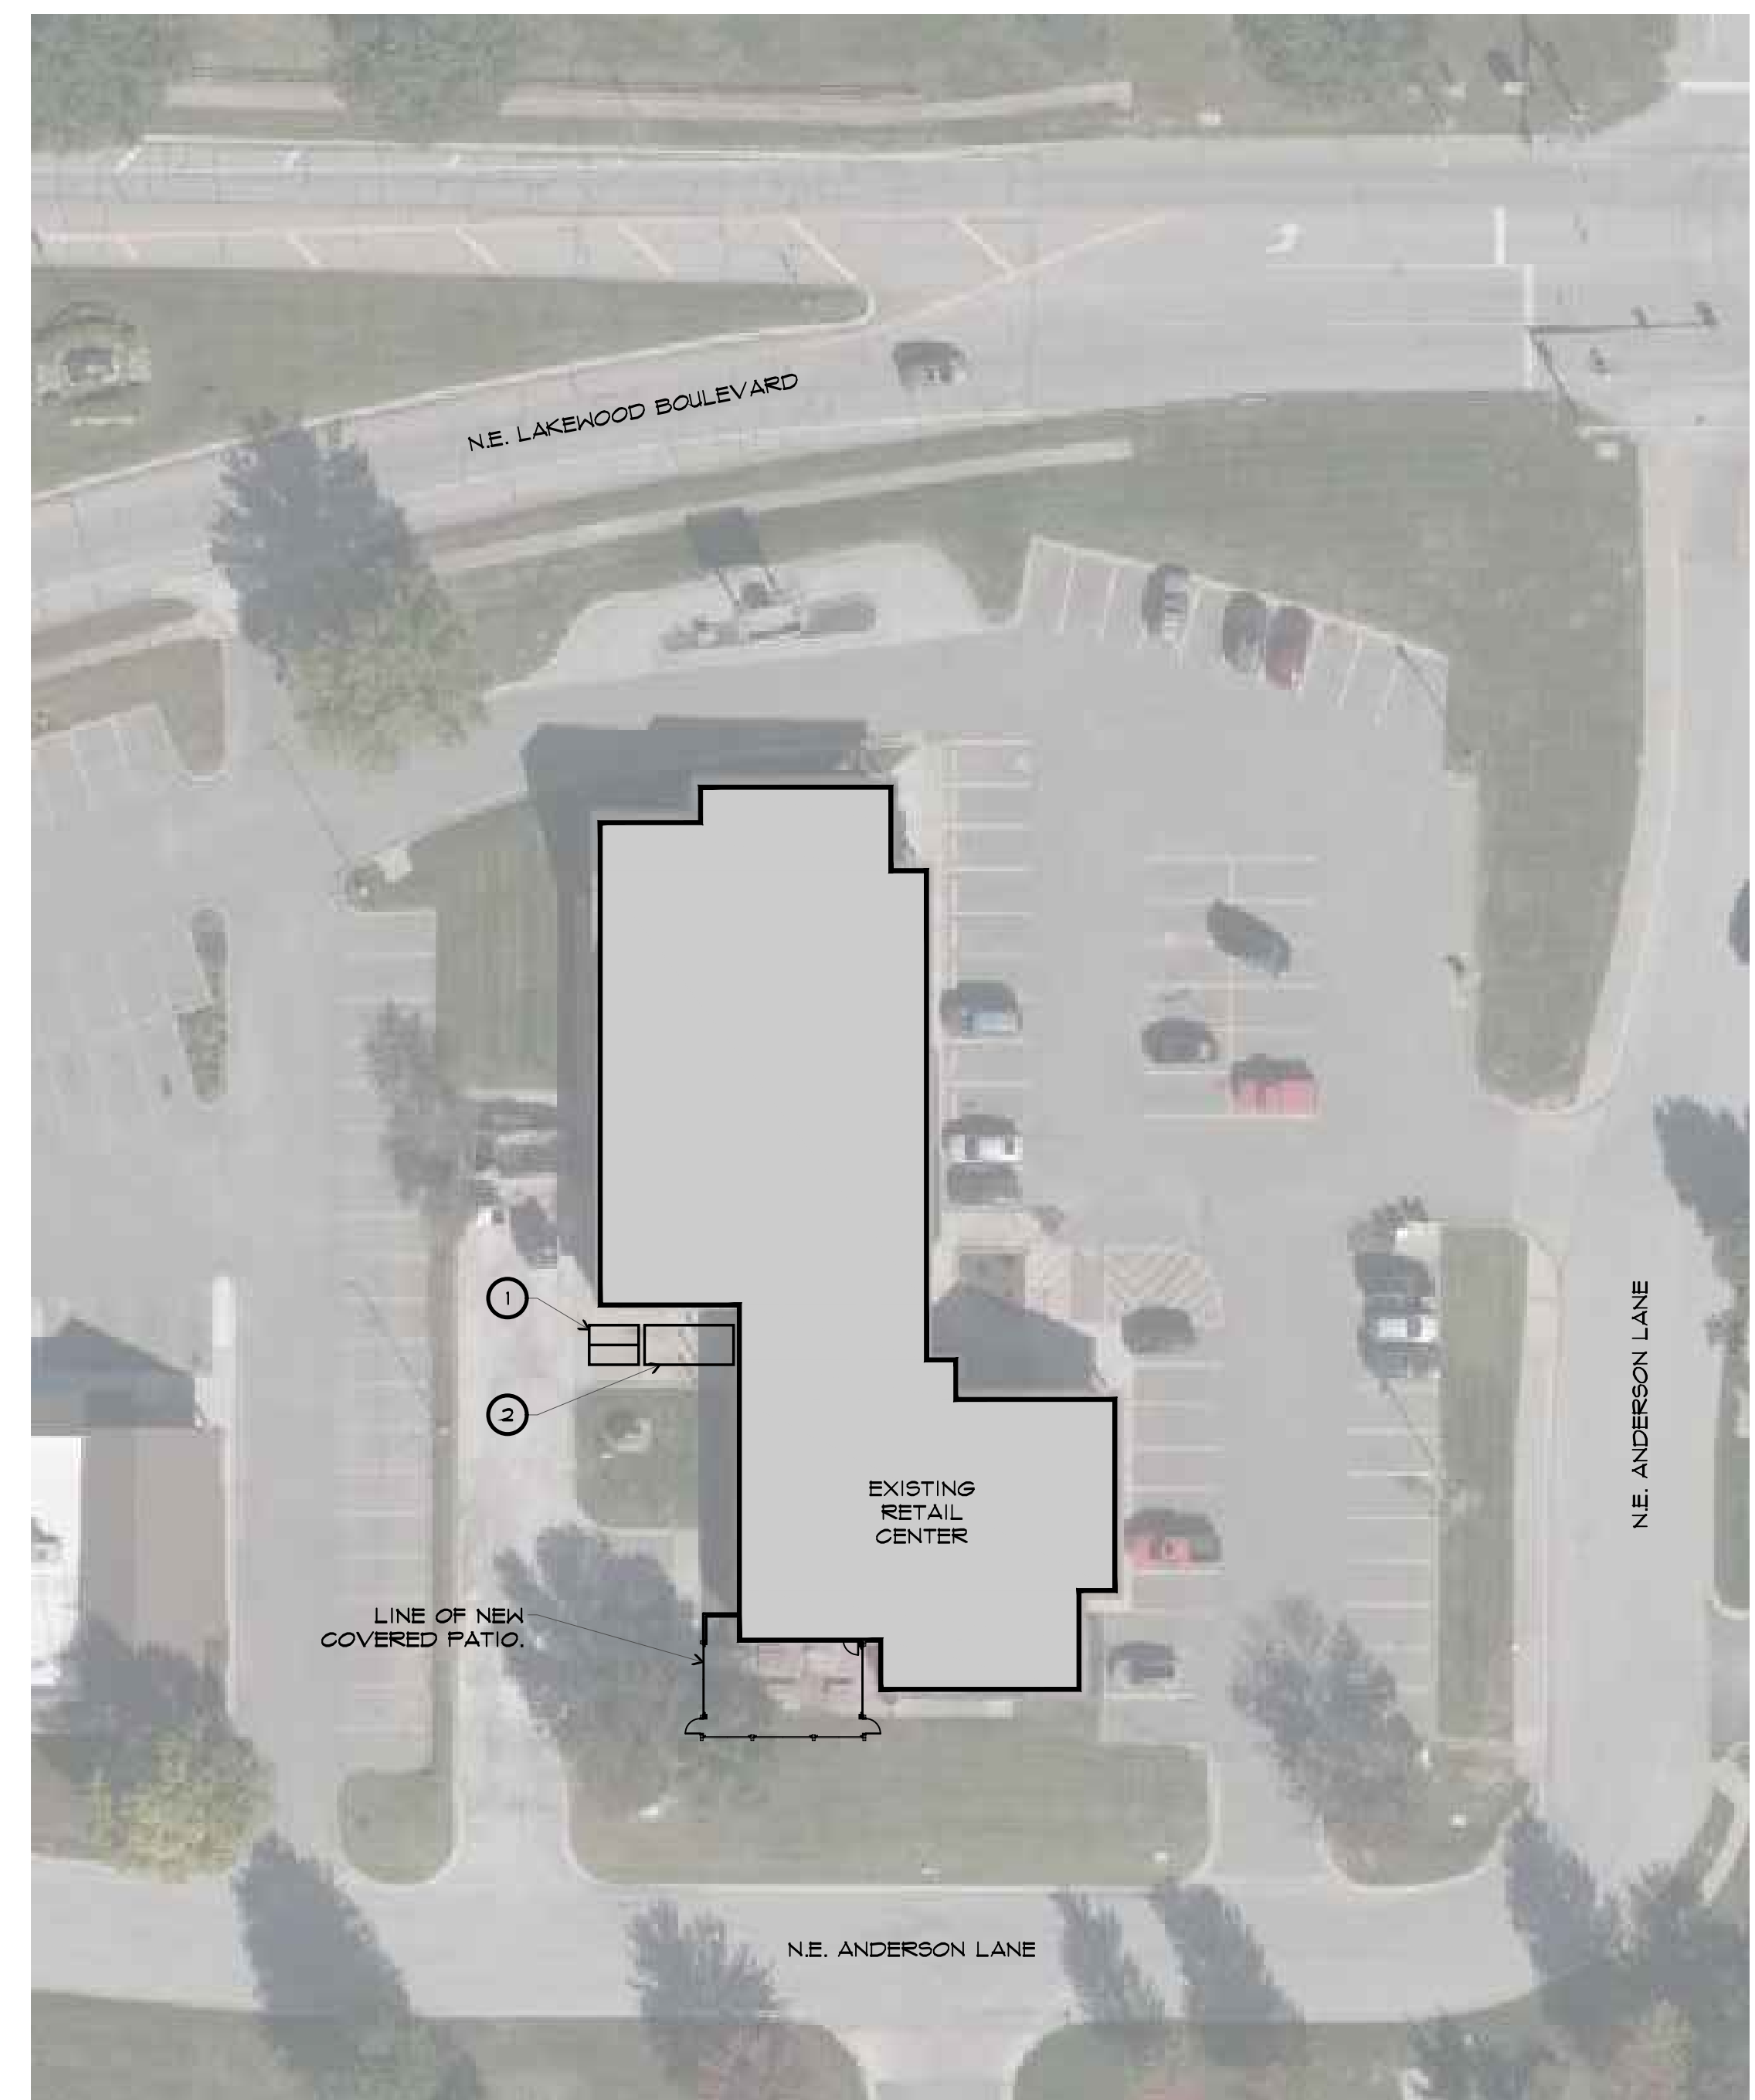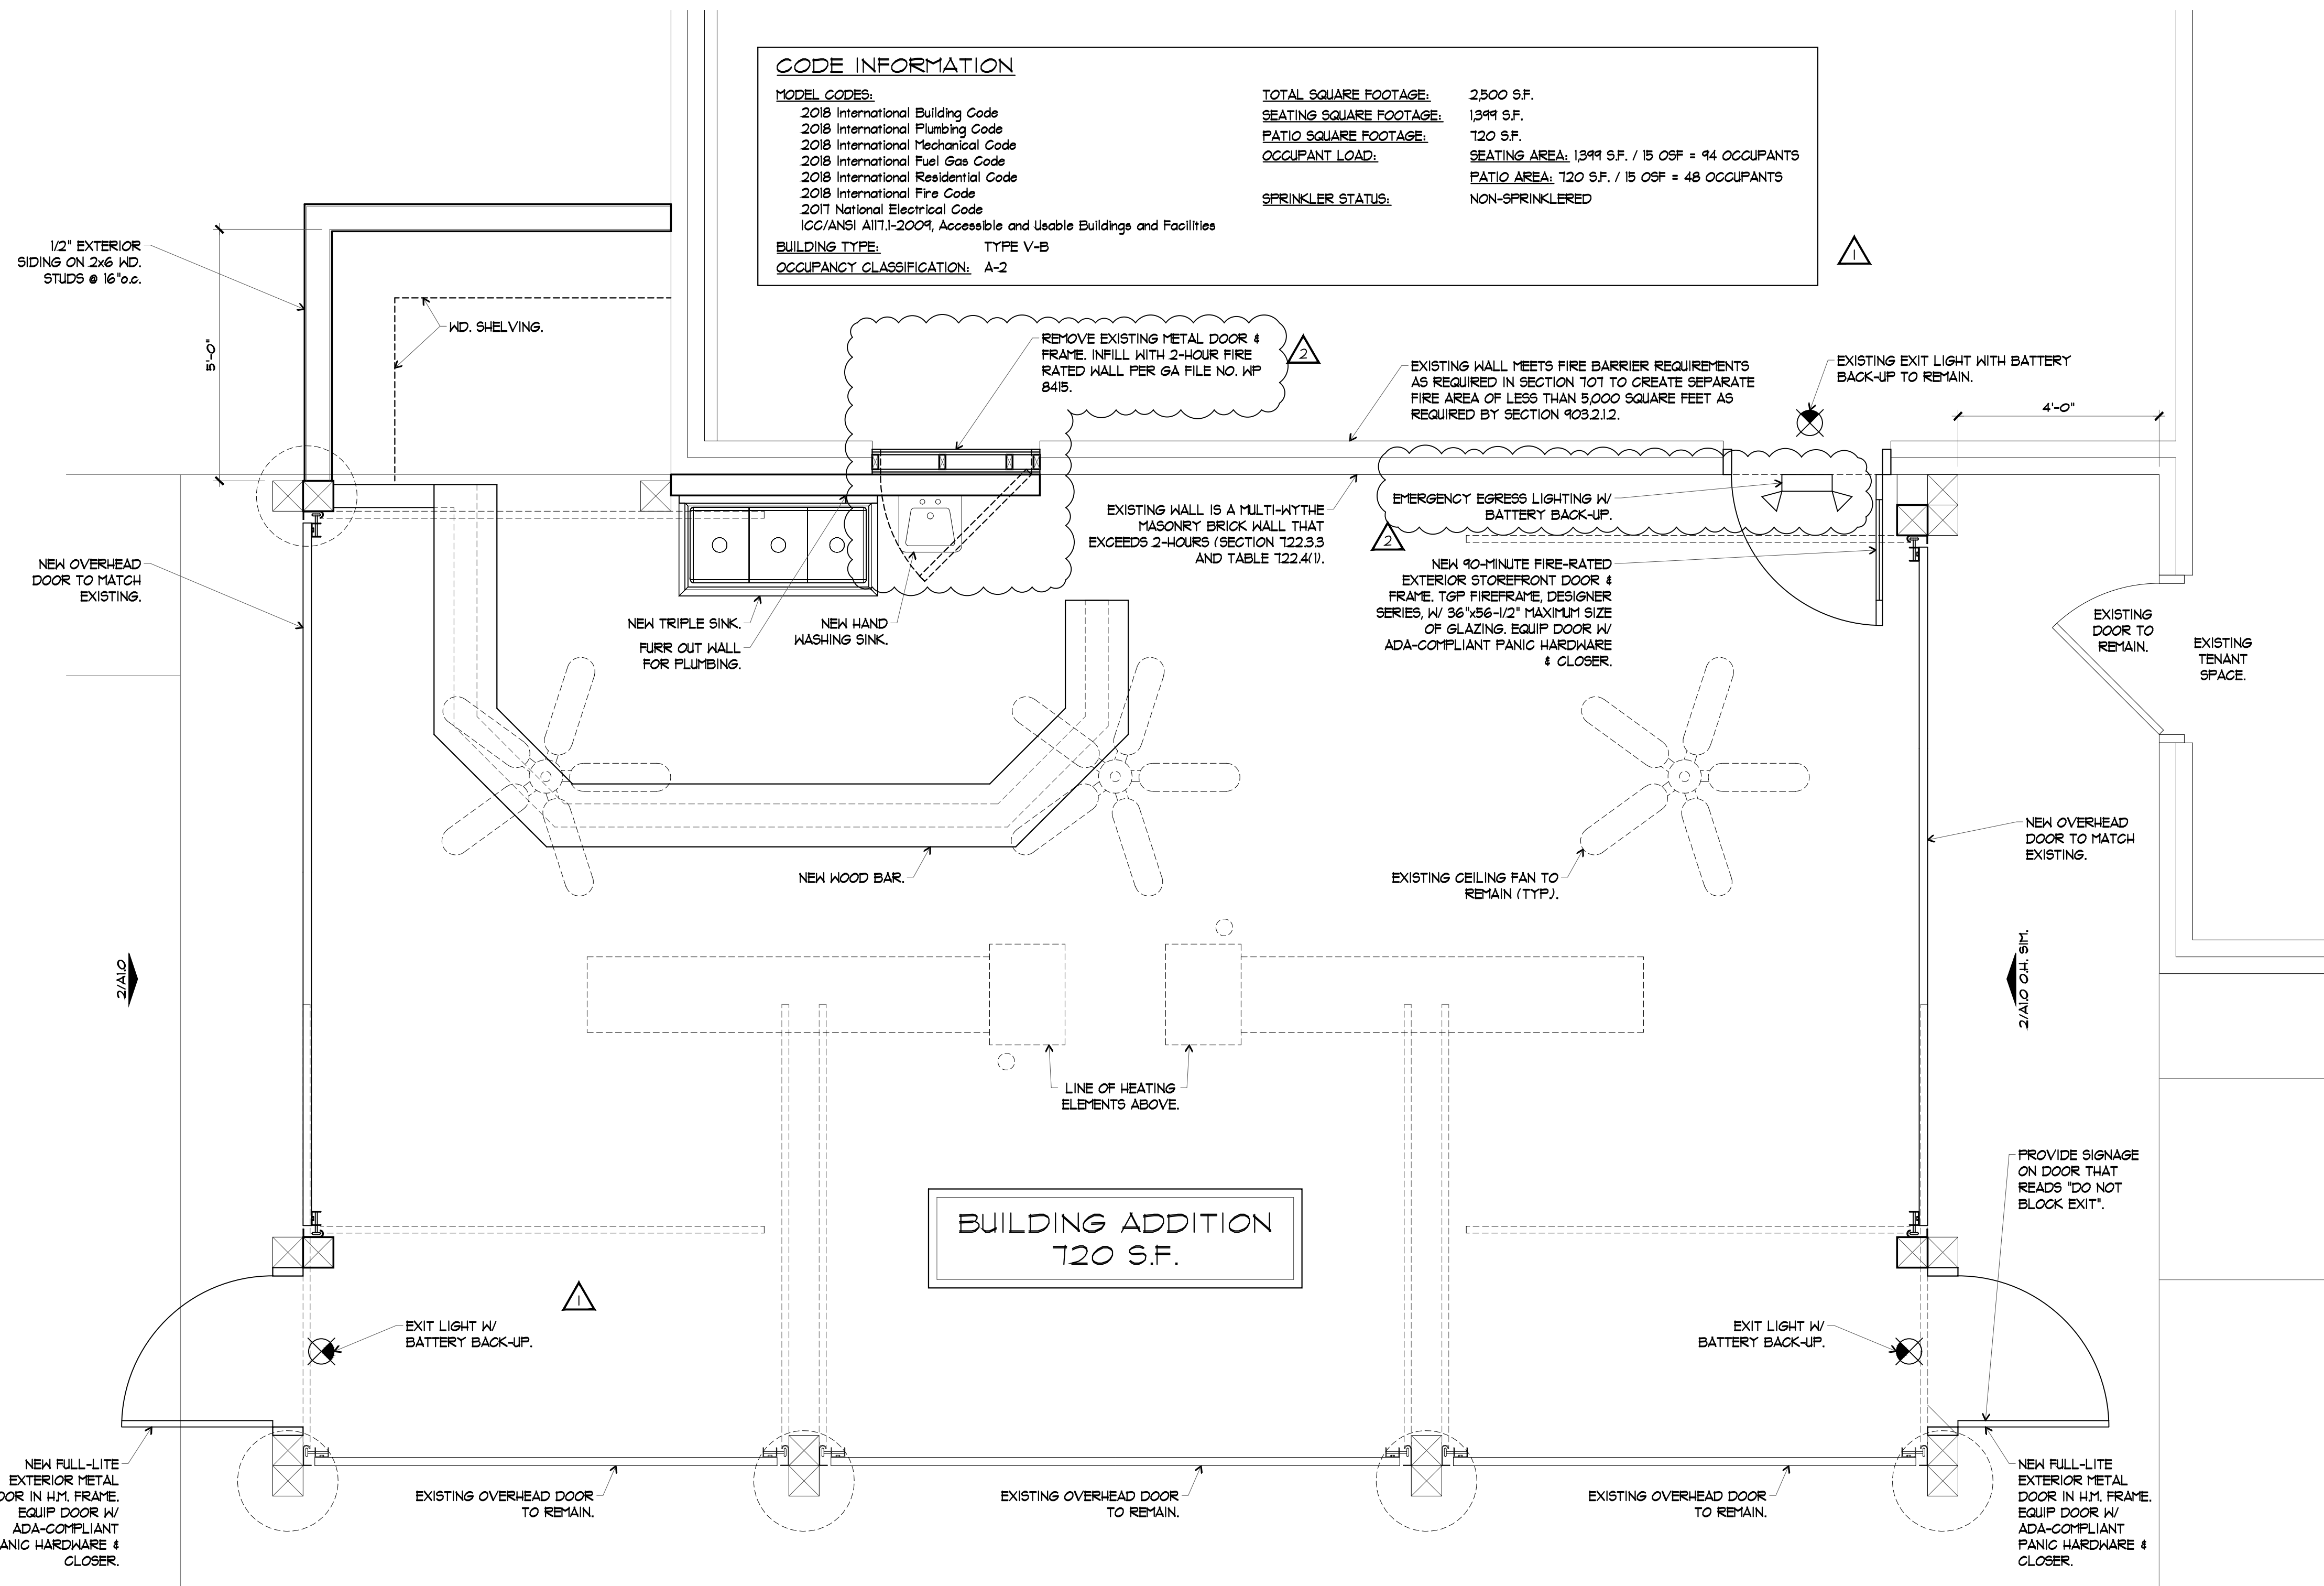

KEYED NOTES:

1. OWNER HAS INSTALLED 8'X10' ACCESSORY STRUCTURE FOR BUSINESS STORAGE.
2. NEW 8'X18'X8' TALL PRE-ENGINEERED INSULATED METAL PANEL WALK-IN COOLER INSTALLED PER MANUFACTURER'S RECOMMENDATIONS & TIED INTO EXISTING UTILITIES AS REQUIRED BY CODE.

4 FLOOR PLAN
1/2" = 1'-0" NORTH

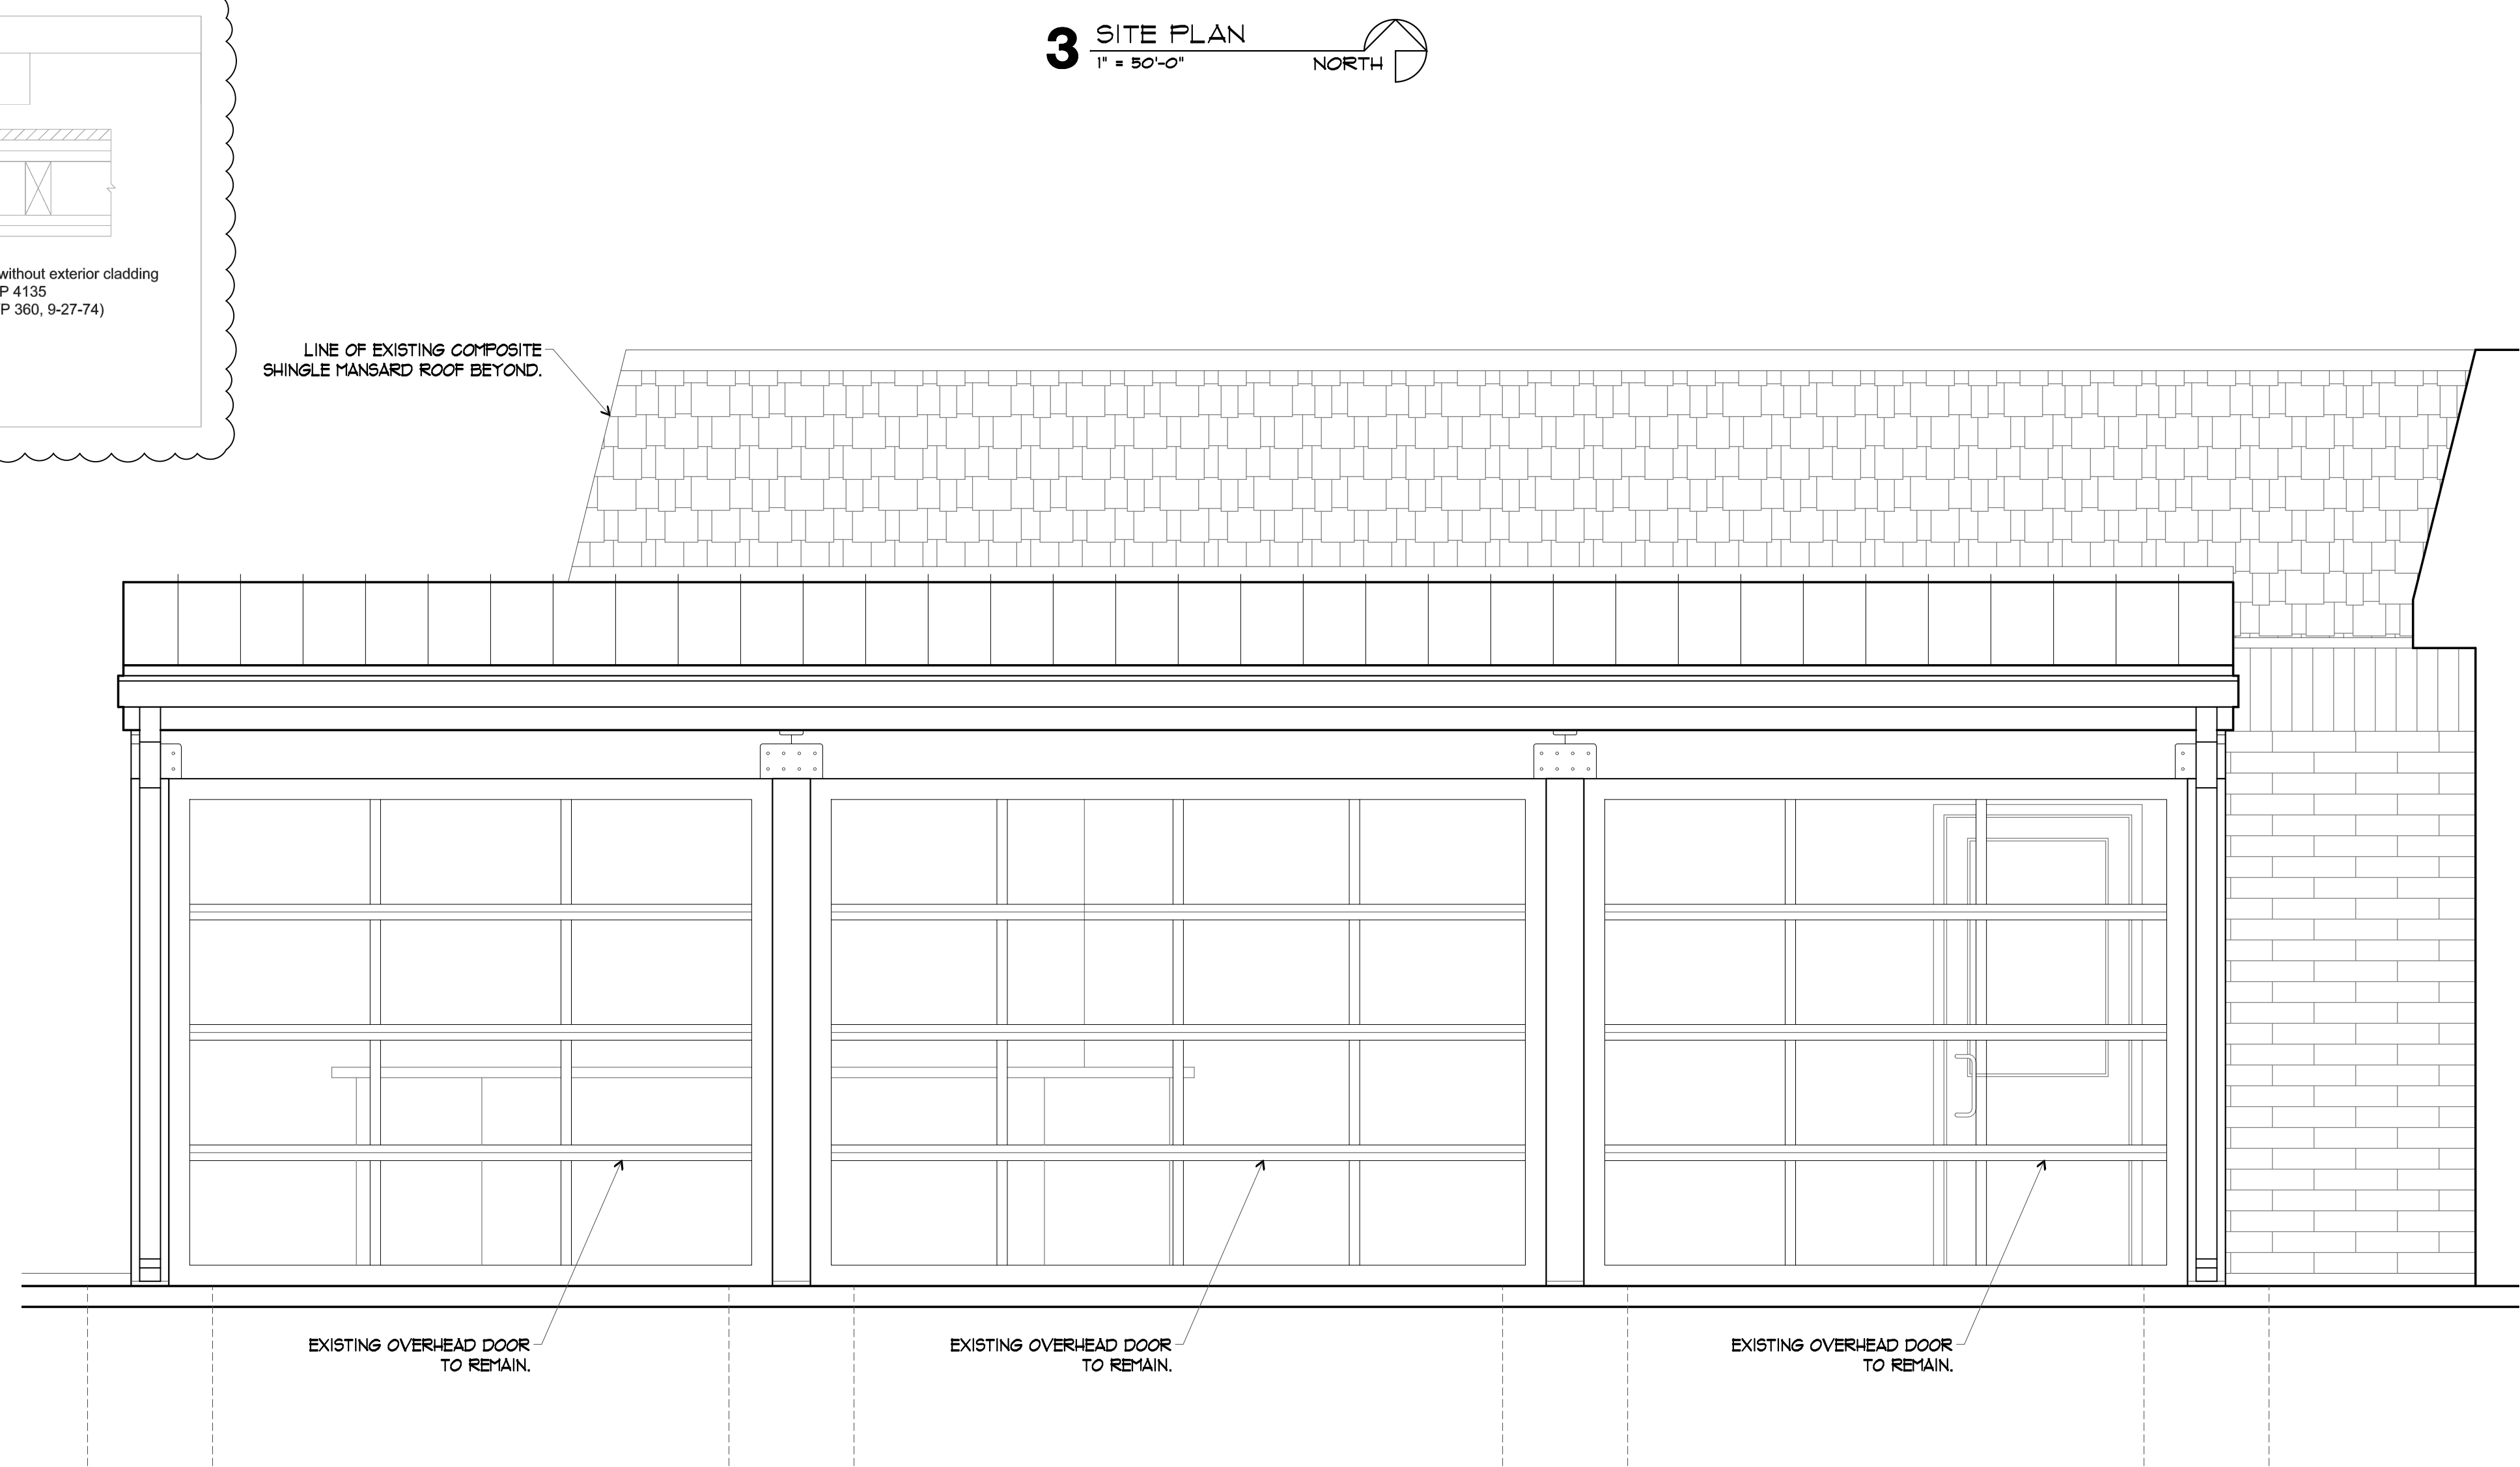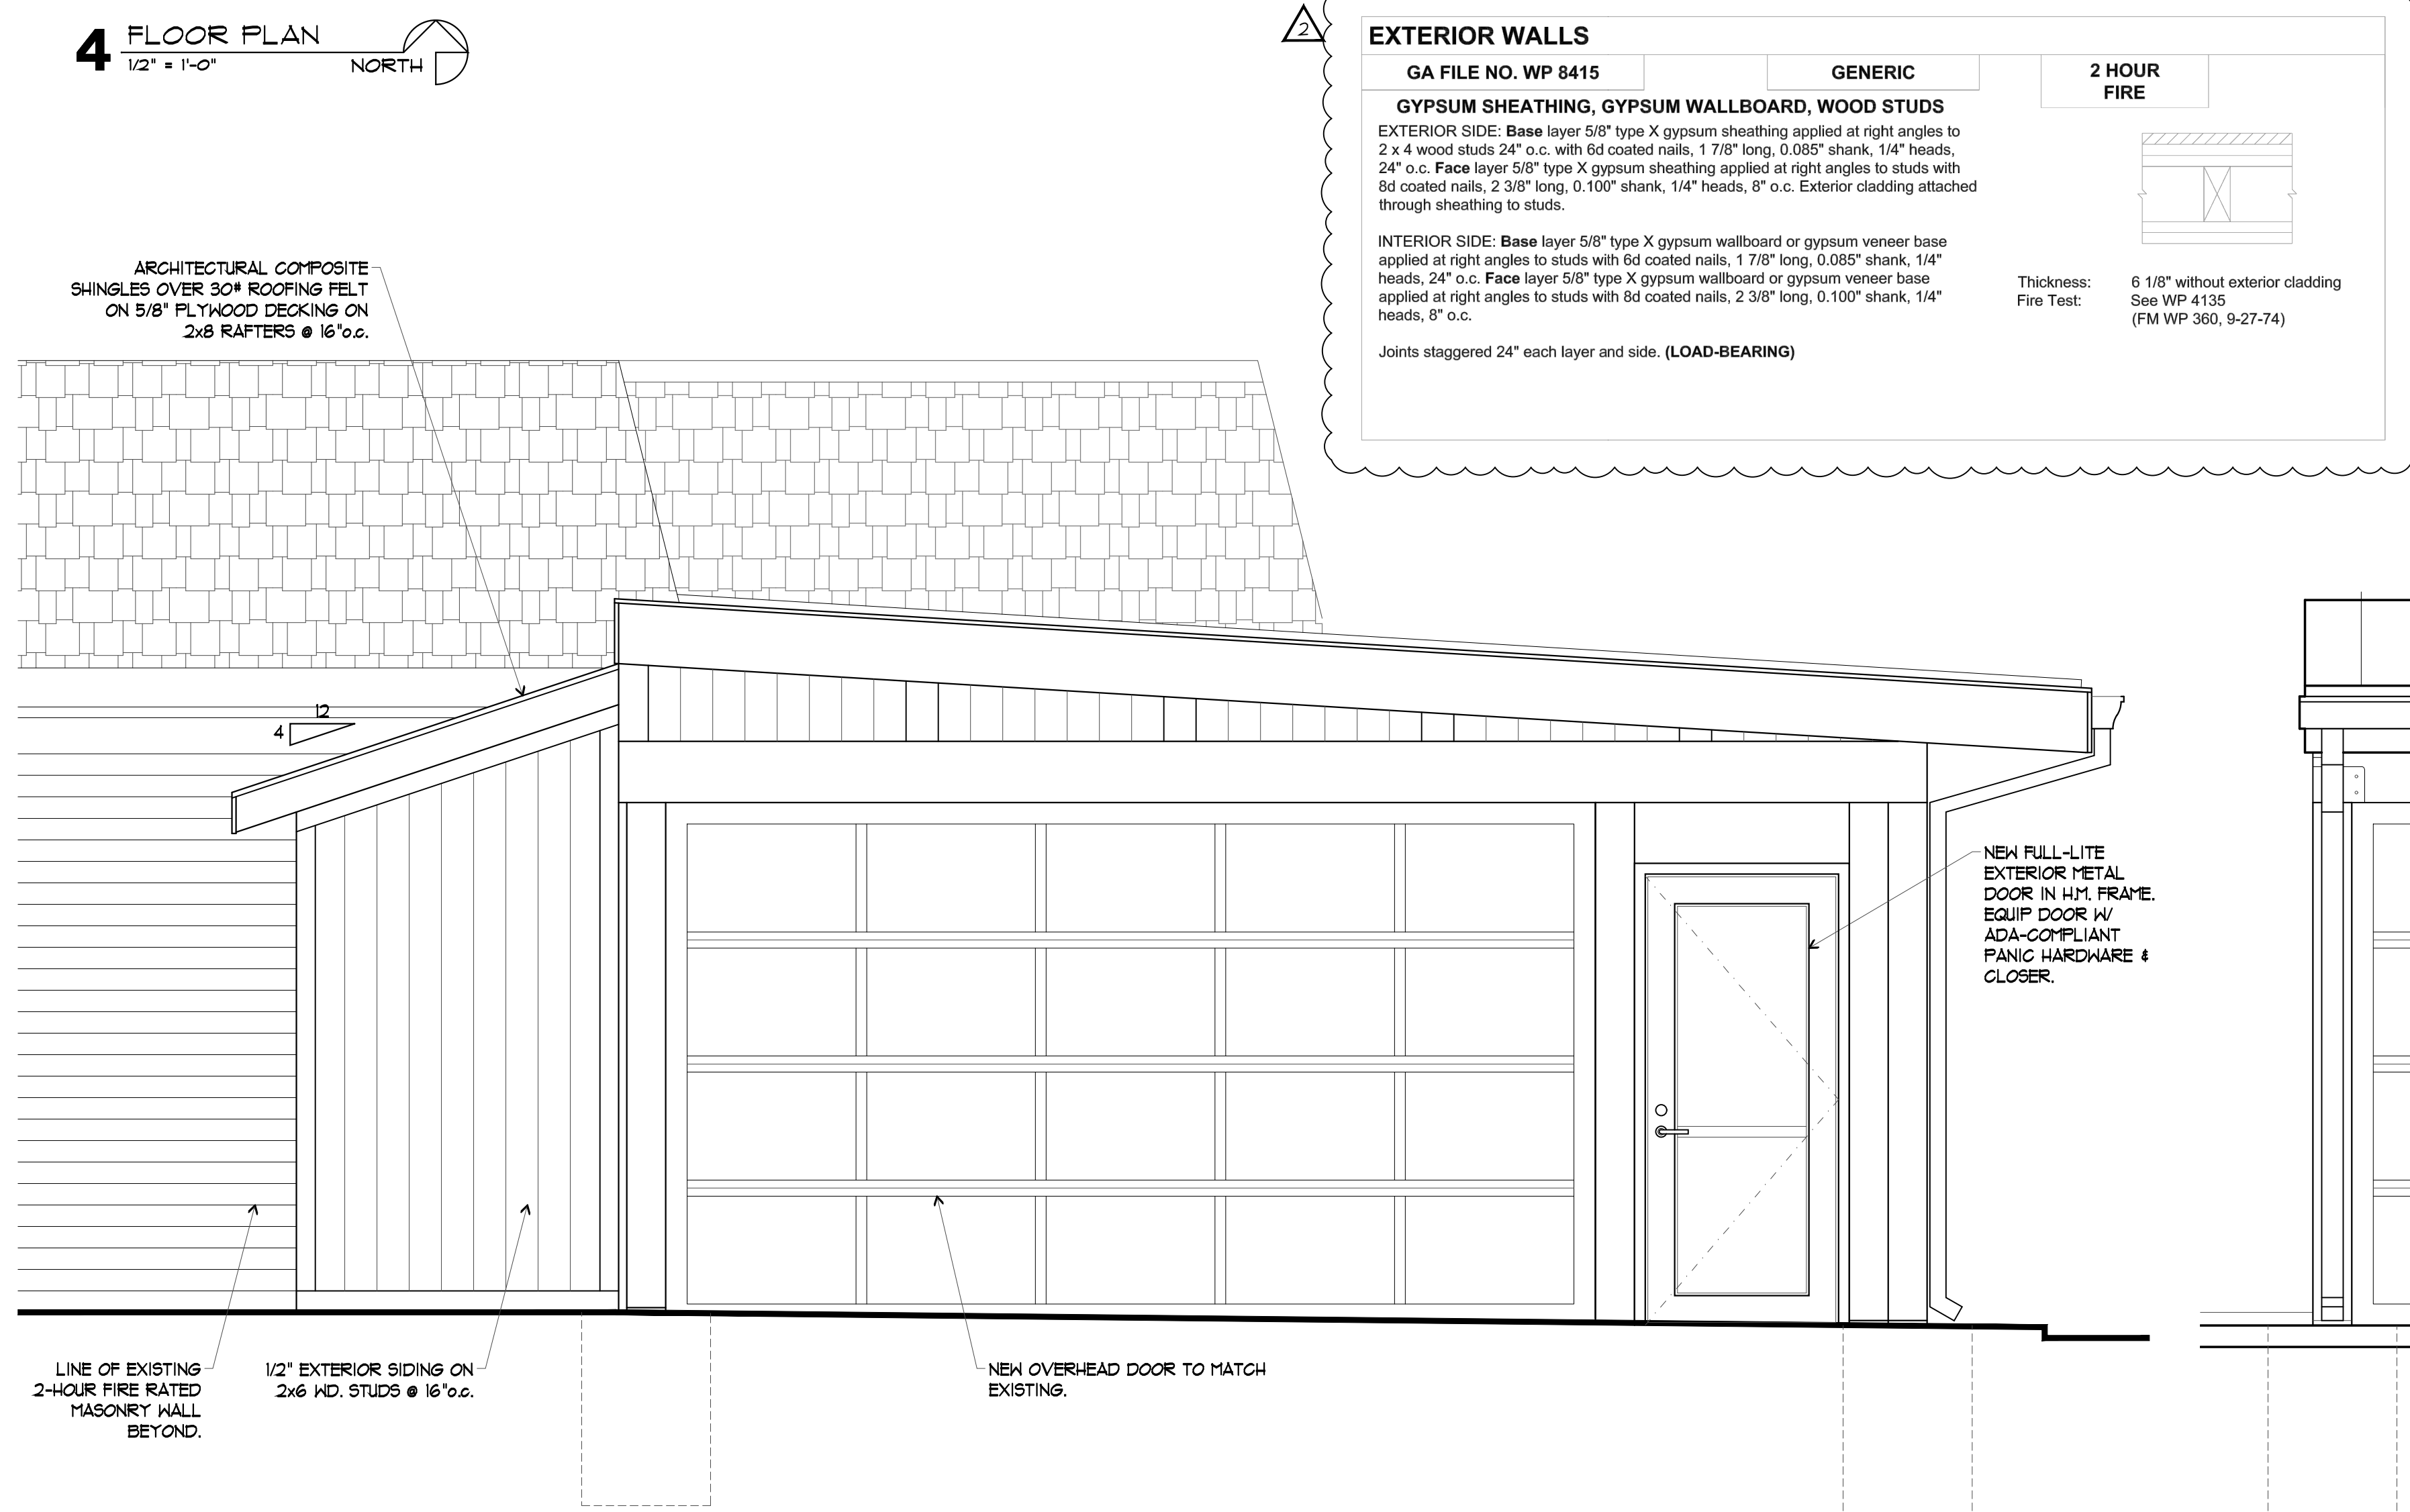

A New Patio for:

Lakewood Local

811 NE Lakewood Blvd.
Lee's Summit, MO 64064

Date	1/25/202
Job Number	20-020.
Drawn By	
Checked By	

Number	Date	Description
1	5-12-2021	CITY COMMENT
2	5-19-2021	CITY COMMENT

A1.0

©2021 h|d Architecture, LLC