## CONSTRUCTION STAKE PLOT PLAN


ACCU-SURV SURVEY COMPANY 300 S. SUNSET LANE RAYMORE, MO. 64083 (816) 322-1973 FAX (816)322-9522

ORDERED BY: Stewart Builders, LLC

XXXXX ACCEPTABLE DAYLIGHT LOCATION ELEV. = NONE

ADDRESS:

//// ACCEPTABLE WALK-OUT LOCATION ELEV. = NONE

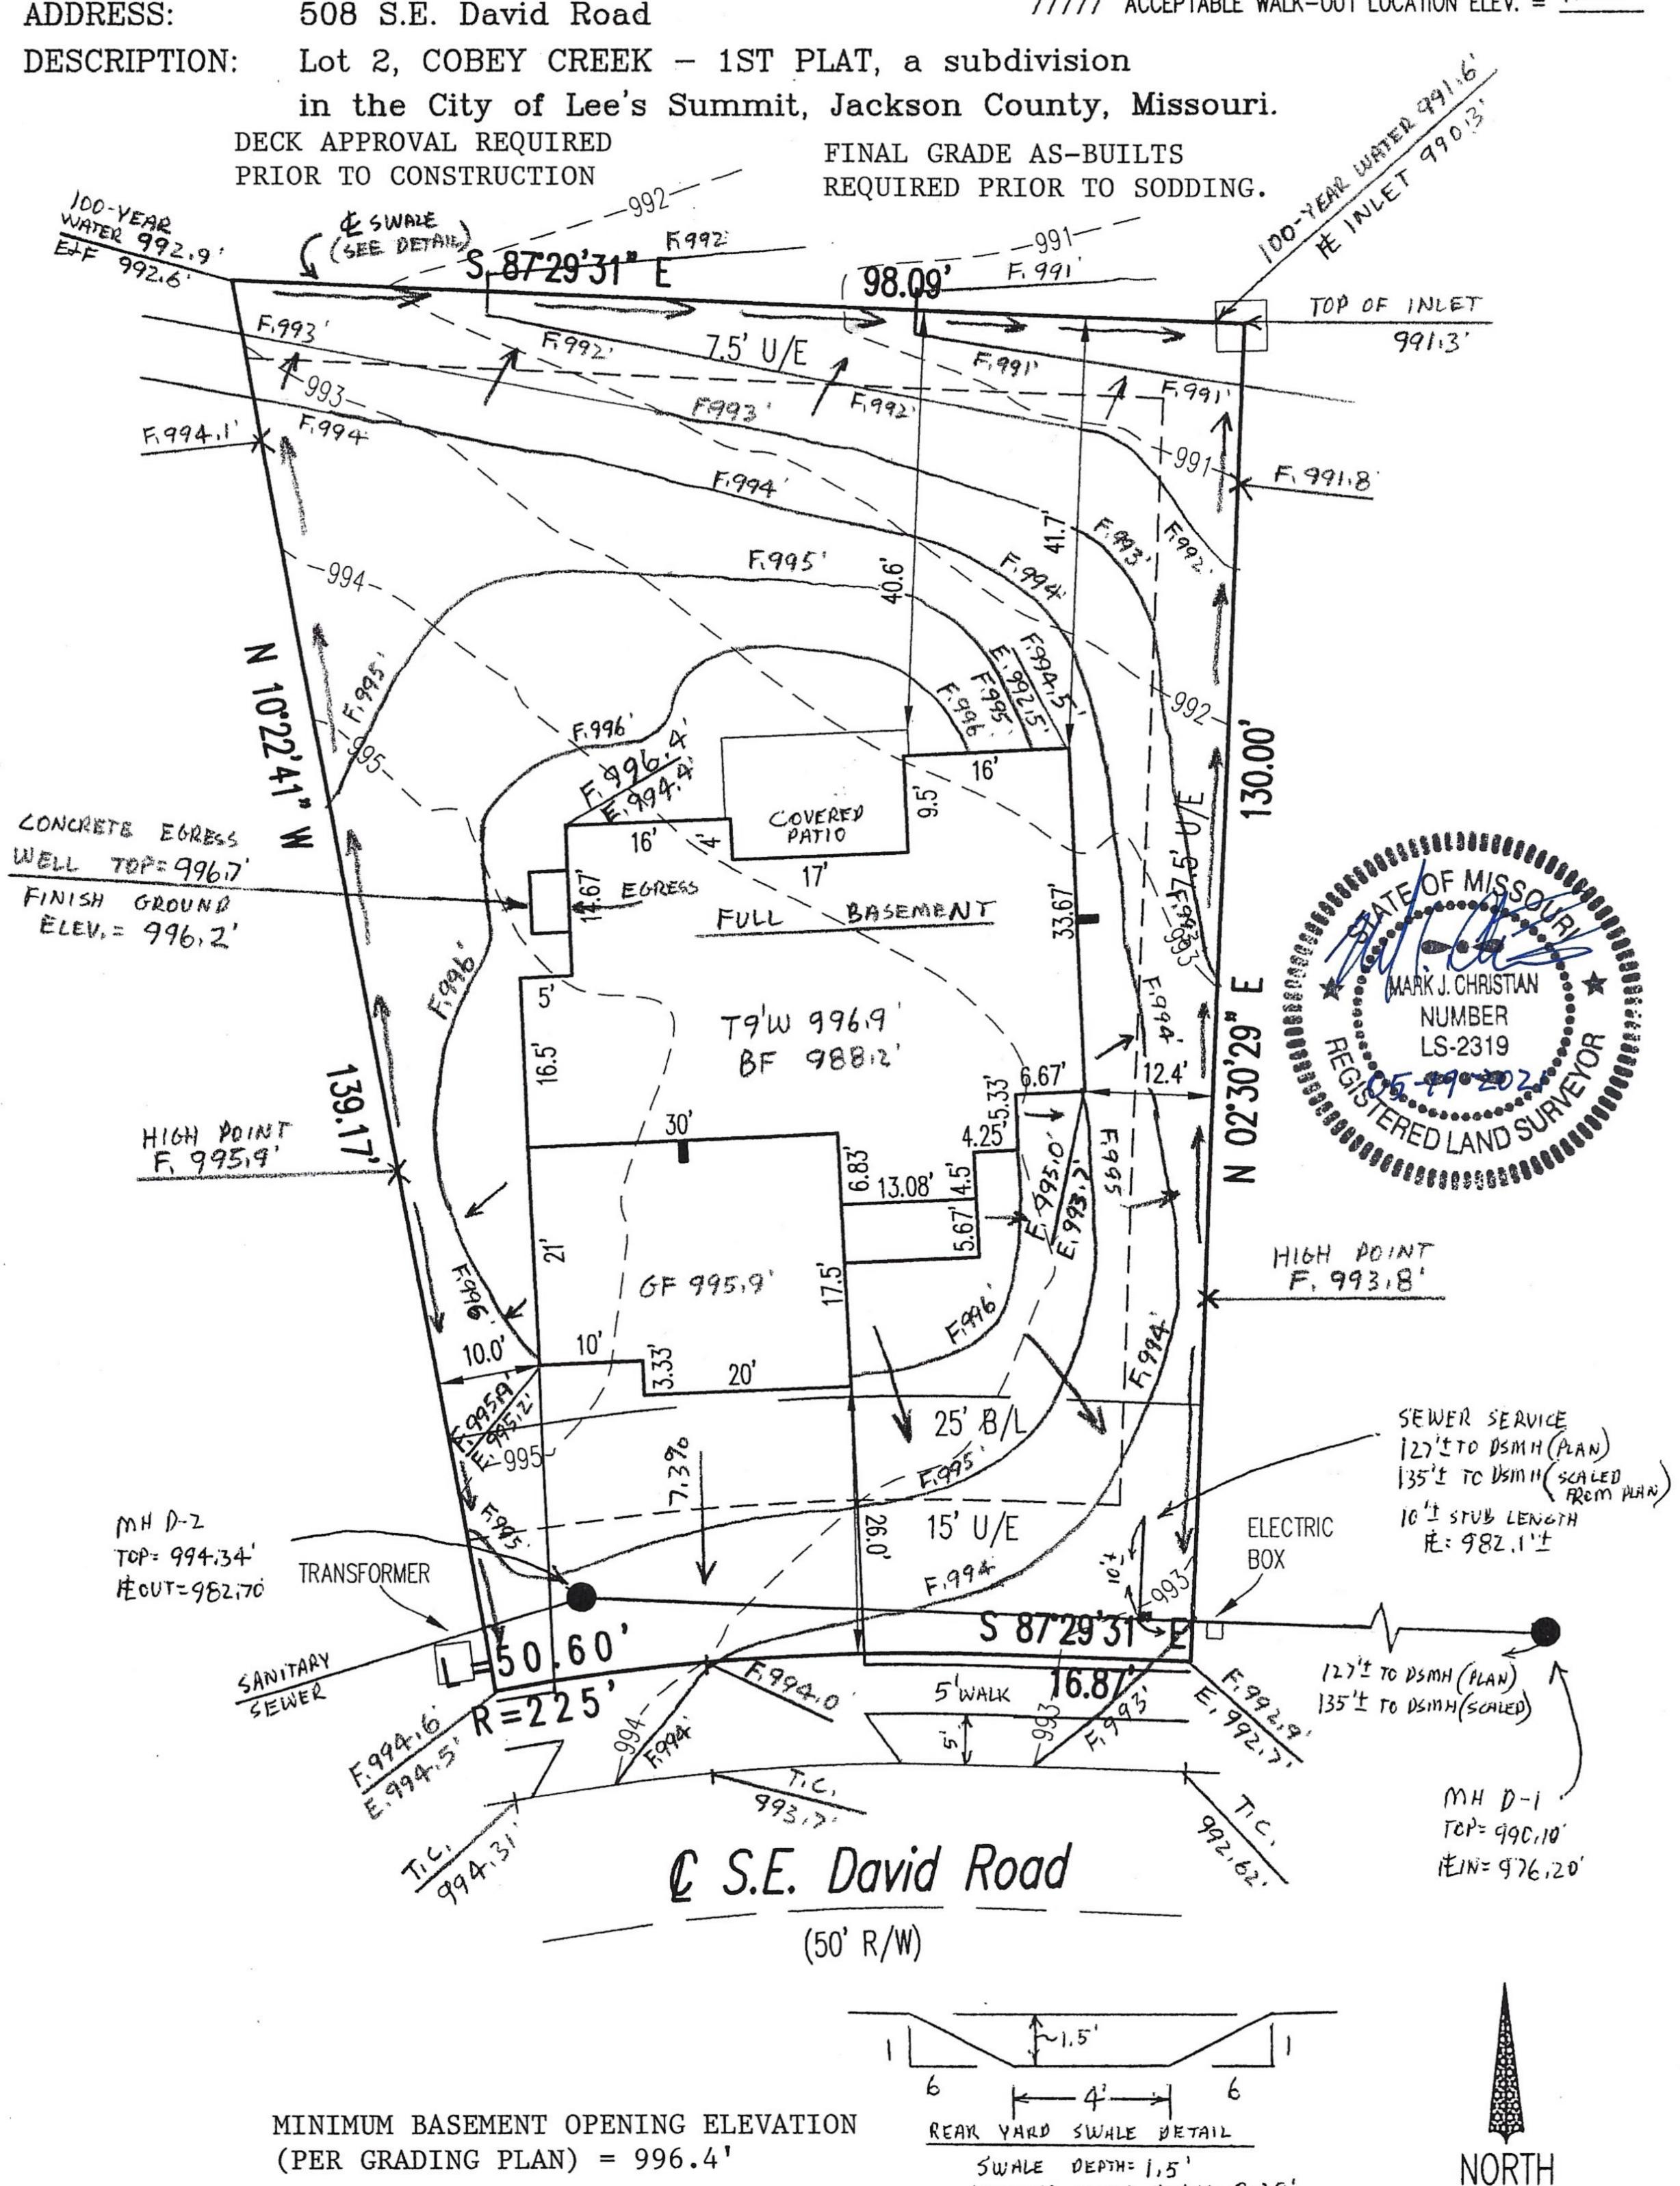

ATTENTION: Contractor to check and verify house dimensions and elevations at job site. We are not responsible for unknown or unplatted easements of any kind unless we are furnished the description of said easements before the field work is performed. NOTE: Final decision as to cuts and foundation height are to be made by builder on job site. NOTE: This plot plan is not to be construed as a boundary survey, and is not to be used for construction of fences. This plot plan is not an "AS-BUILT SURVEY" as the house shown was staked prior to construction and cannot be used in place of a "SURVEYOR'S REAL PROPERTY REPORT" or "MORTGAGE INSPECTION". © Copyright 2021

LOW OPENING IS TOP OF EGRESS

WELL ELEVATION = 996.7

= 20'SCALE:

SCALE IN FEET

ICC-YEAR WATER DEPTH = 0128'

SLOPE = 2% (MIN)

CAPACITY = 125 CFS

DATE: 03-28-2021 REVISED! 05-19-2021 JOB NO: 21040