



FC.1 / FC.1a EXTERIOR BAND OF LETTERS W/ BACKER PANEL (Qty 2 Sets)

SQUARE FOOTAGE FC.1: 43.6
SQUARE FOOTAGE FC.1a: 43.6

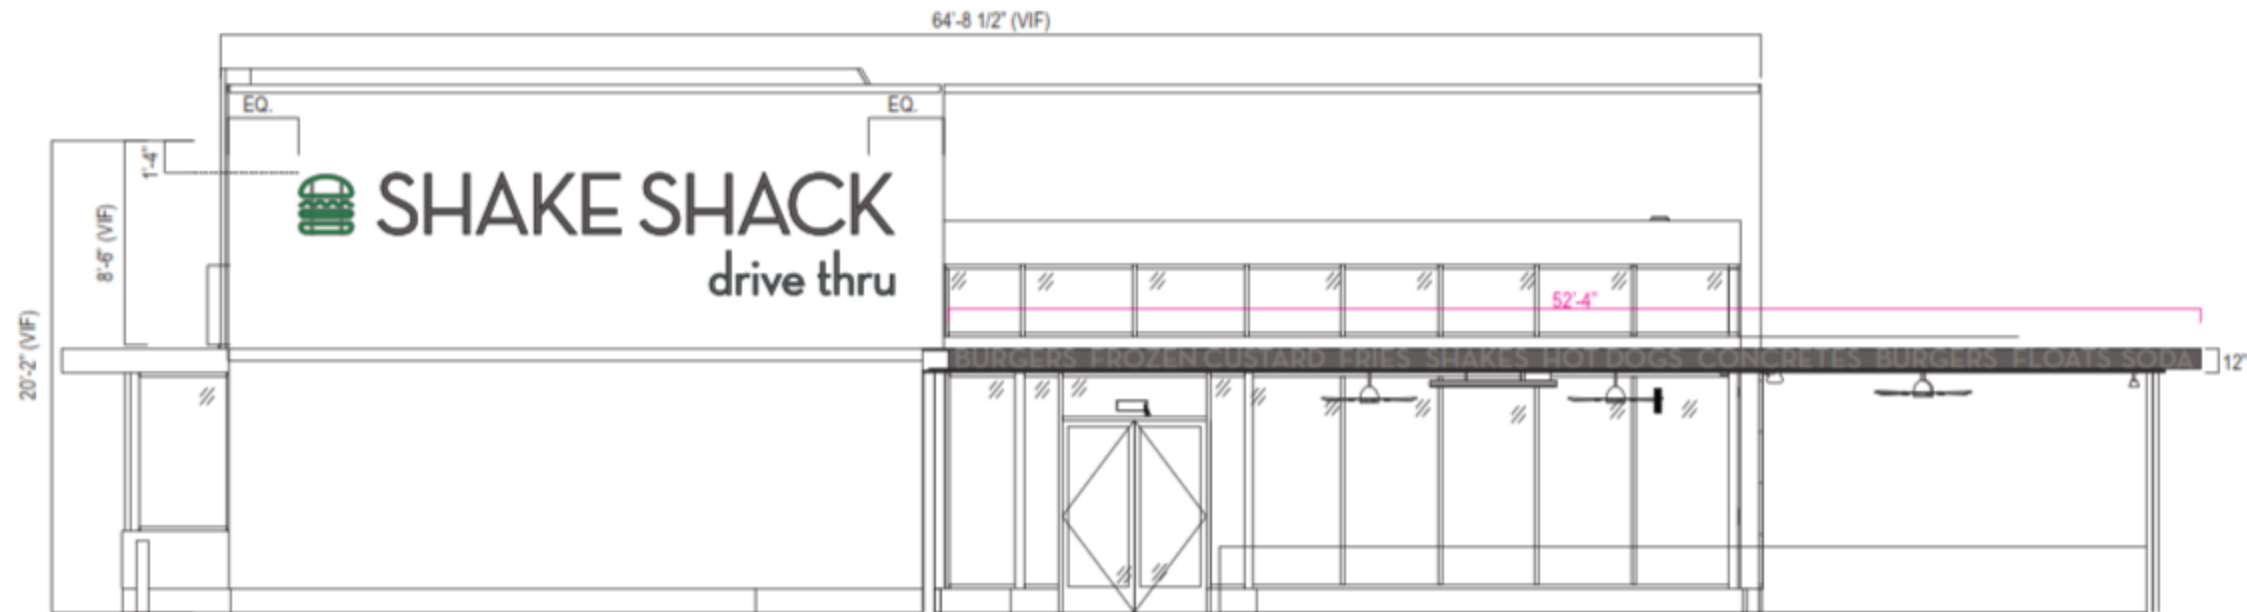

EAST EXTERIOR ELEVATION
SCALE: 1/8" = 1'-0"

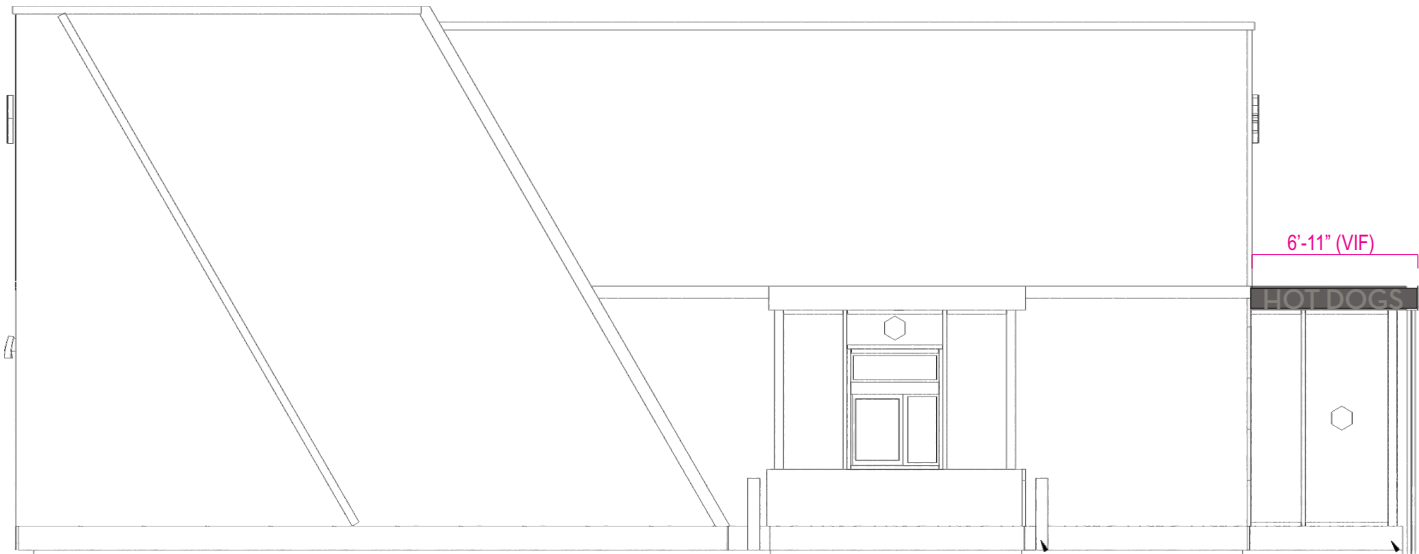

SOUTH EXTERIOR ELEVATION
SCALE: 1/8" = 1'-0"


<div>JONES SIGN</div> <div>Your Vision. Accomplished.</div> <div>WWW.JONESSIGN.COM</div>	JOB #: 250360-R10	REV.	DATE	BY	DESCRIPTION	CLIENT APPROVAL	DATE	SHAKE SHACK	SHAKE SHACK	SHEET NUMBER
	DATE: 12.14.2020	1	01.19.21	SW	REVISED PER REQUESTED CHANGE	LANDLORD APPROVAL	DATE		2051 NW LOWENSTEIN DR LEE'S SUMMIT, MO 64081	
	DESIGNER: S. Wiands	2	01.21.21	AR	REVISE PER COMMENTS					
	SALES REP:	3	02.03.21	AR	REVISE PER MARK-UPS					
PROJ MGR: S. KOSTKA		4	02.12.21	AR	REVISE PER MARK-UPS				3.0	
	5	04.16.21	SW	REVISE PER MARK-UPS	QC		DESIGN PHASE: CONCEPTUAL			
	6	04.23.21	SW	REVISE PER MARK-UPS						
	7	05.04.21	SW	REVISE PER MARK-UPS						
	8	05.20.21	SW	UPDATE ELEVATIONS AND VARIOUS						
	9	05.21.21	SW	UPDATE PER REQUEST						
	10	06.09.21	SW	REVISED PER REQUEST						

This is an original, unpublished drawing by Jones Sign Co., Inc. It is for your personal use in conjunction with a project being planned for you by JONES SIGN. It is not to be shown to anyone outside of your organization, nor is it to be used, reproduced, copied or exhibited in any fashion. Use of this design or the salient elements of this design in any sign done by any other company, without the express written permission of JONES SIGN, is forbidden by law and carries a civil forfeiture of up to 25% of the purchase price of the sign. JONES SIGN will endeavor to closely match colors, including PMS, where specified. We cannot guarantee exact matches due to varying compatibility of surface materials and paints used. All sizes and dimensions are illustrated for client's conception of project and are not to be understood as being exact size or exact scale.

FC.2/FC.3 EXTERIOR BAND OF LETTERS W/ BACKER PANEL (Qty 1 Sets)


SQUARE FOOTAGE FC.2: 39.4
SQUARE FOOTAGE FC.3: 48.43

FC.2

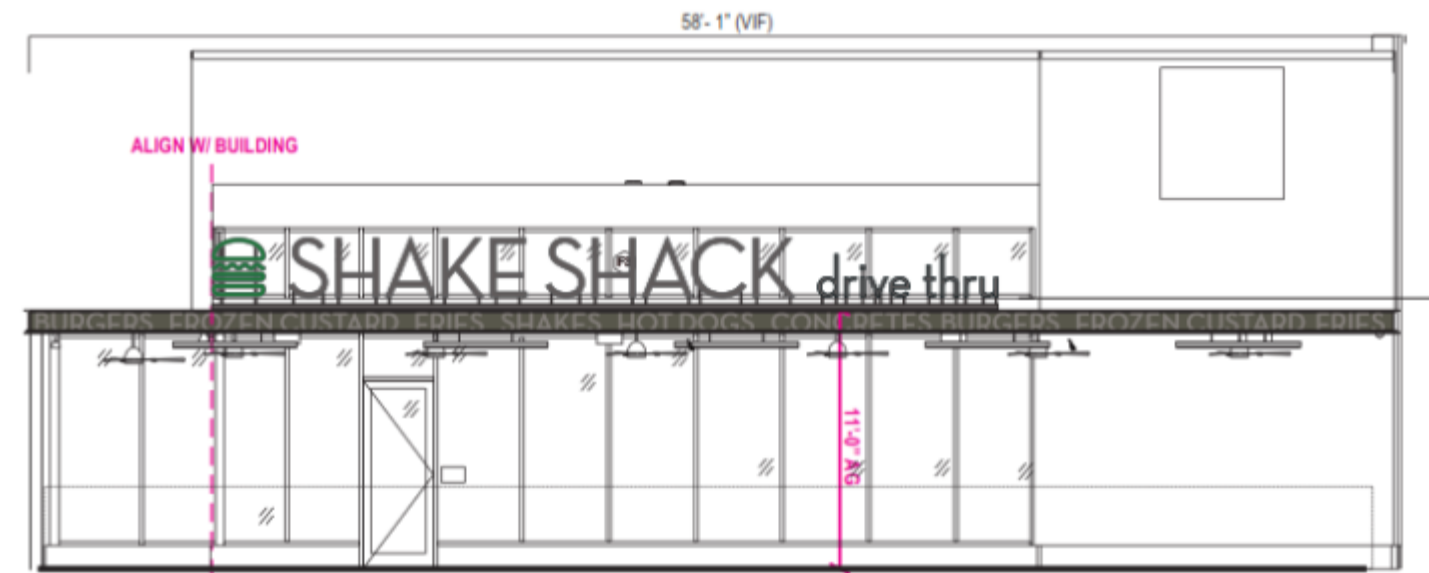

NORTH EXTERIOR ELEVATION
SCALE: 1/8" = 1'-0"

FC.3

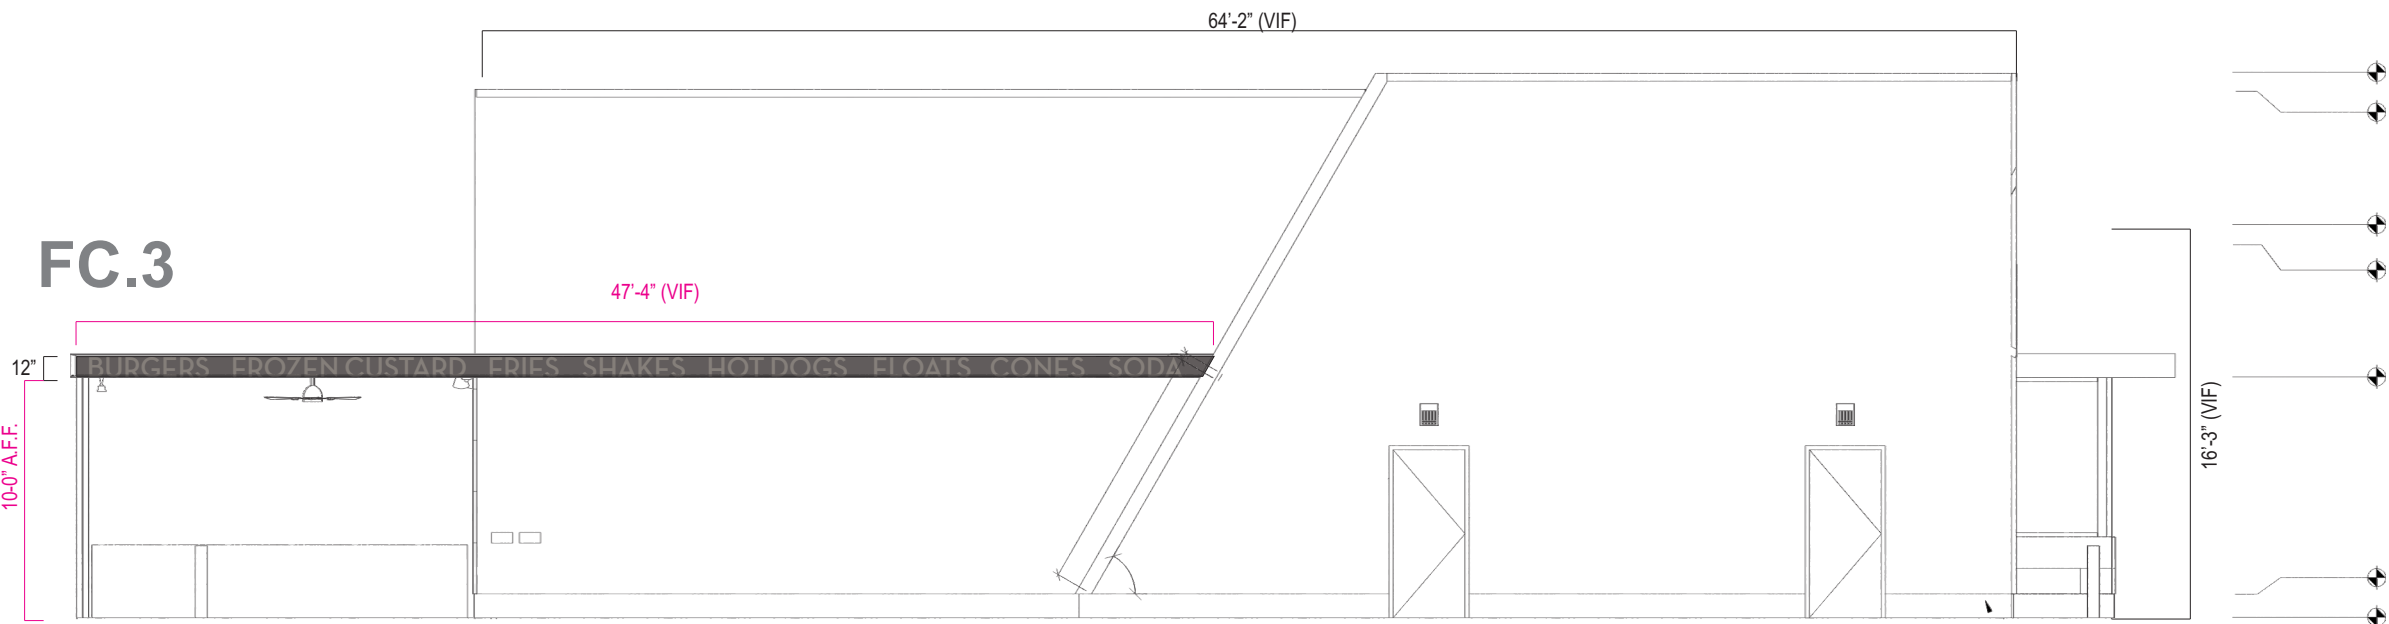

WEST EXTERIOR ELEVATION
SCALE: 1/8" = 1'-0"





<div>JONES SIGN</div> <div>Your Vision. Accomplished.</div> <div>WWW.JONESSIGN.COM</div>	<div>JOB #: 250360-R10</div> <div>DATE: 12.14.2020</div> <div>DESIGNER: S. Wiands</div> <div>SALES REP:</div> <div>PROJ MGR: S. KOSTKA</div>	REV.	DATE	BY	DESCRIPTION	CLIENT APPROVAL	DATE	SHAKE SHACK	SHAKE SHACK	SHEET NUMBER
		1	01.19.21	SW	REVISED PER REQUESTED CHANGE	LANDLORD APPROVAL	DATE		2051 NW LOWENSTEIN DR LEE'S SUMMIT, MO 64081	
		2	01.21.21	AR	REVISE PER COMMENTS					
		3	02.03.21	AR	REVISE PER MARK-UPS					
4	02.12.21	AR	REVISE PER MARK-UPS	5	04.16.21	SW	REVISE PER MARK-UPS	DESIGN PHASE: CONCEPTUAL		
6	04.23.21	SW	REVISE PER MARK-UPS	7	05.04.21	SW	REVISE PER MARK-UPS			
8	05.20.21	SW	UPDATE ELEVATIONS AND VARIOUS	9	05.21.21	SW	UPDATE PER REQUEST			
10	06.09.21	SW	REVISED PER REQUEST	QC						

This is an original, unpublished drawing by Jones Sign Co., Inc. It is for your personal use in conjunction with a project being planned for you by JONES SIGN. It is not to be shown to anyone outside of your organization, nor is it to be used, reproduced, copied or exhibited in any fashion. Use of this design or the salient elements of this design in any sign done by any other company, without the express written permission of JONES SIGN, is forbidden by law and carries a civil forfeiture of up to 25% of the purchase price of the sign. JONES SIGN will endeavor to closely match colors, including PMS, where specified. We cannot guarantee exact matches due to varying compatibility of surface materials and paints used. All sizes and dimensions are illustrated for client's conception of project and are not to be understood as being exact size or exact scale.

FC.1 / FC.1a/ FC.2 / FC.3 EXTERIOR BAND OF LETTERS W/ BACKER PANEL (Qty 3 Sets)

SQUARE FOOTAGE FC.1: 43.6 SQUARE FOOTAGE FC.2: 48.43

SQUARE FOOTAGE FC.1a: 8.75 SQUARE FOOTAGE FC.3: 39.4

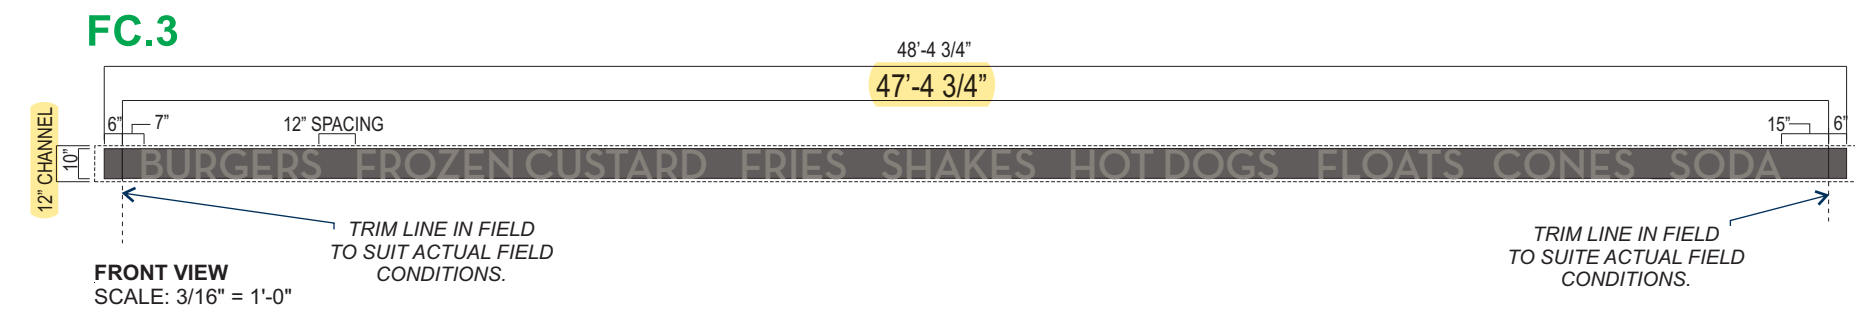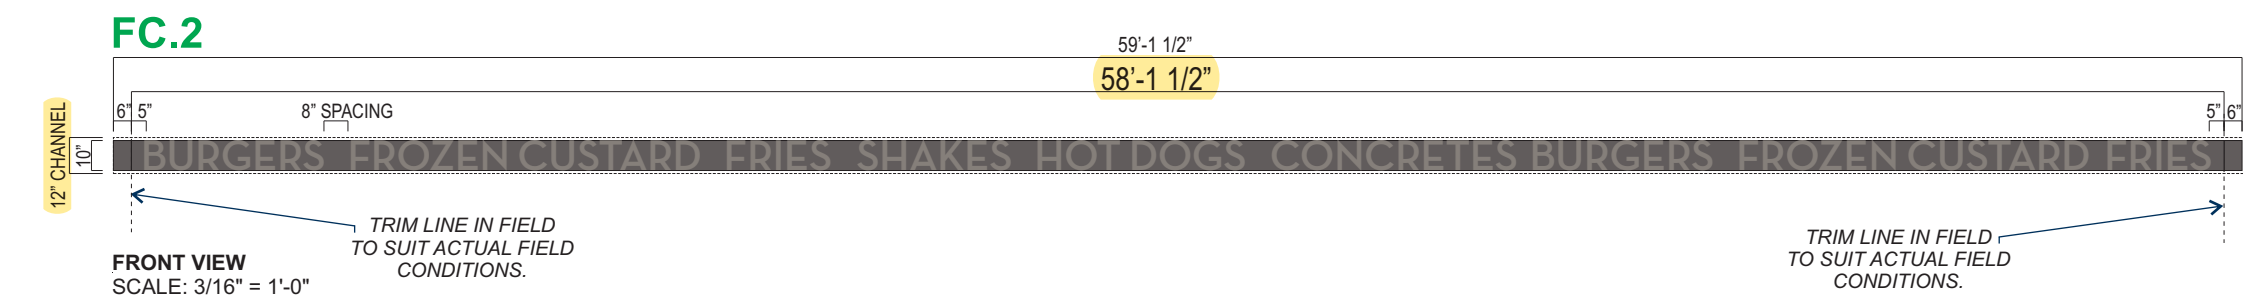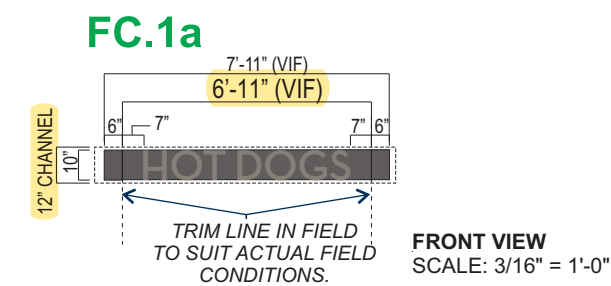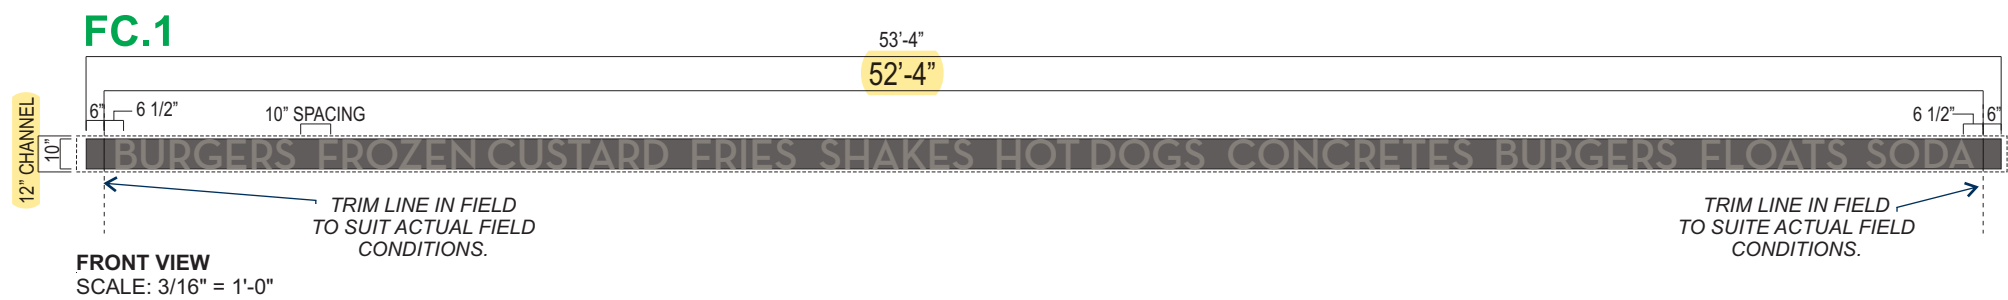


SPECIFICATIONS

- 1. 1/4" THK. ALUMINUM PAINTED **P-1**
- 2. 3/8" Ø SPACER TUBES AND BACKER PANEL PTD. **P-2**

COLORS/FINISHES

- P-1** MP 18140 SMOKY SILVER METALLIC - MATTE FINISH
- P-2** SW 7069 - IRON ORE - MATTE FINISH

C-CHANNEL
BAND OF LETTERS
DETAIL
SCALE: 3"=1'-0"

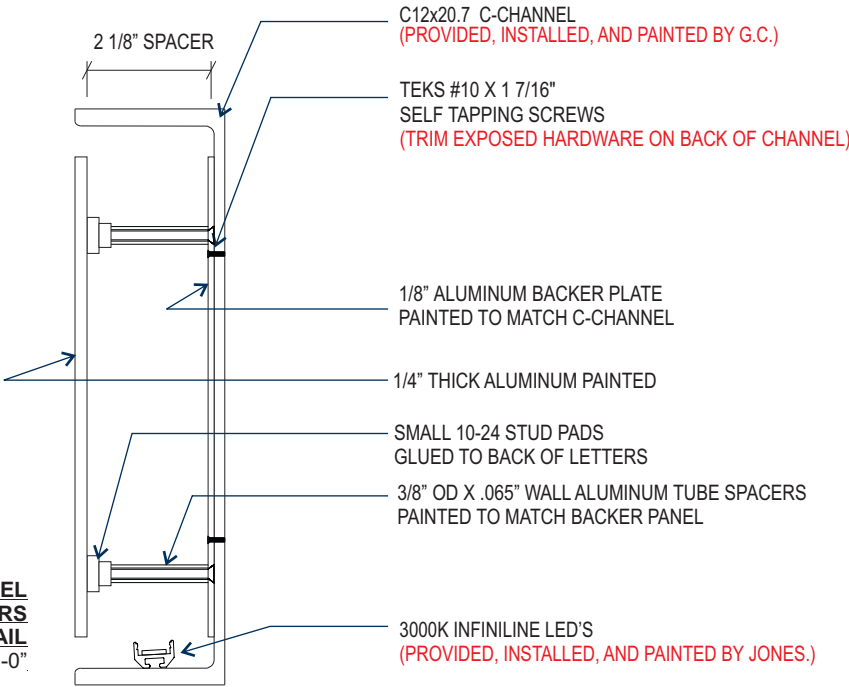

<div>JONES SIGN</div> <div>Your Vision. Accomplished.</div> <div>WWW.JONESSIGN.COM</div>	JOB #: 250360-R10	REV.	DATE	BY	DESCRIPTION	CLIENT APPROVAL	DATE	SHAKE SHACK	SHAKE SHACK	SHEET NUMBER
	DATE: 12.14.2020	1	01.19.21	SW	REVISED PER REQUESTED CHANGE	LANDLORD APPROVAL	DATE		2051 NW LOWENSTEIN DR LEE'S SUMMIT, MO 64081	
	DESIGNER: S. Wiands	2	01.21.21	AR	REVISE PER COMMENTS					
	SALES REP:	3	02.03.21	AR	REVISE PER MARK-UPS					
PROJ MGR: S. KOSTKA		4	02.12.21	AR	REVISE PER MARK-UPS				3.2	
		5	04.16.21	SW	REVISE PER MARK-UPS	QC	DESIGN PHASE: CONCEPTUAL			
		6	04.23.21	SW	REVISE PER MARK-UPS					
		7	05.04.21	SW	REVISE PER MARK-UPS					
		8	05.20.21	SW	UPDATE ELEVATIONS AND VARIOUS					
		9	05.21.21	SW	UPDATE PER REQUEST					
		10	06.09.21	SW	REVISED PER REQUEST					