


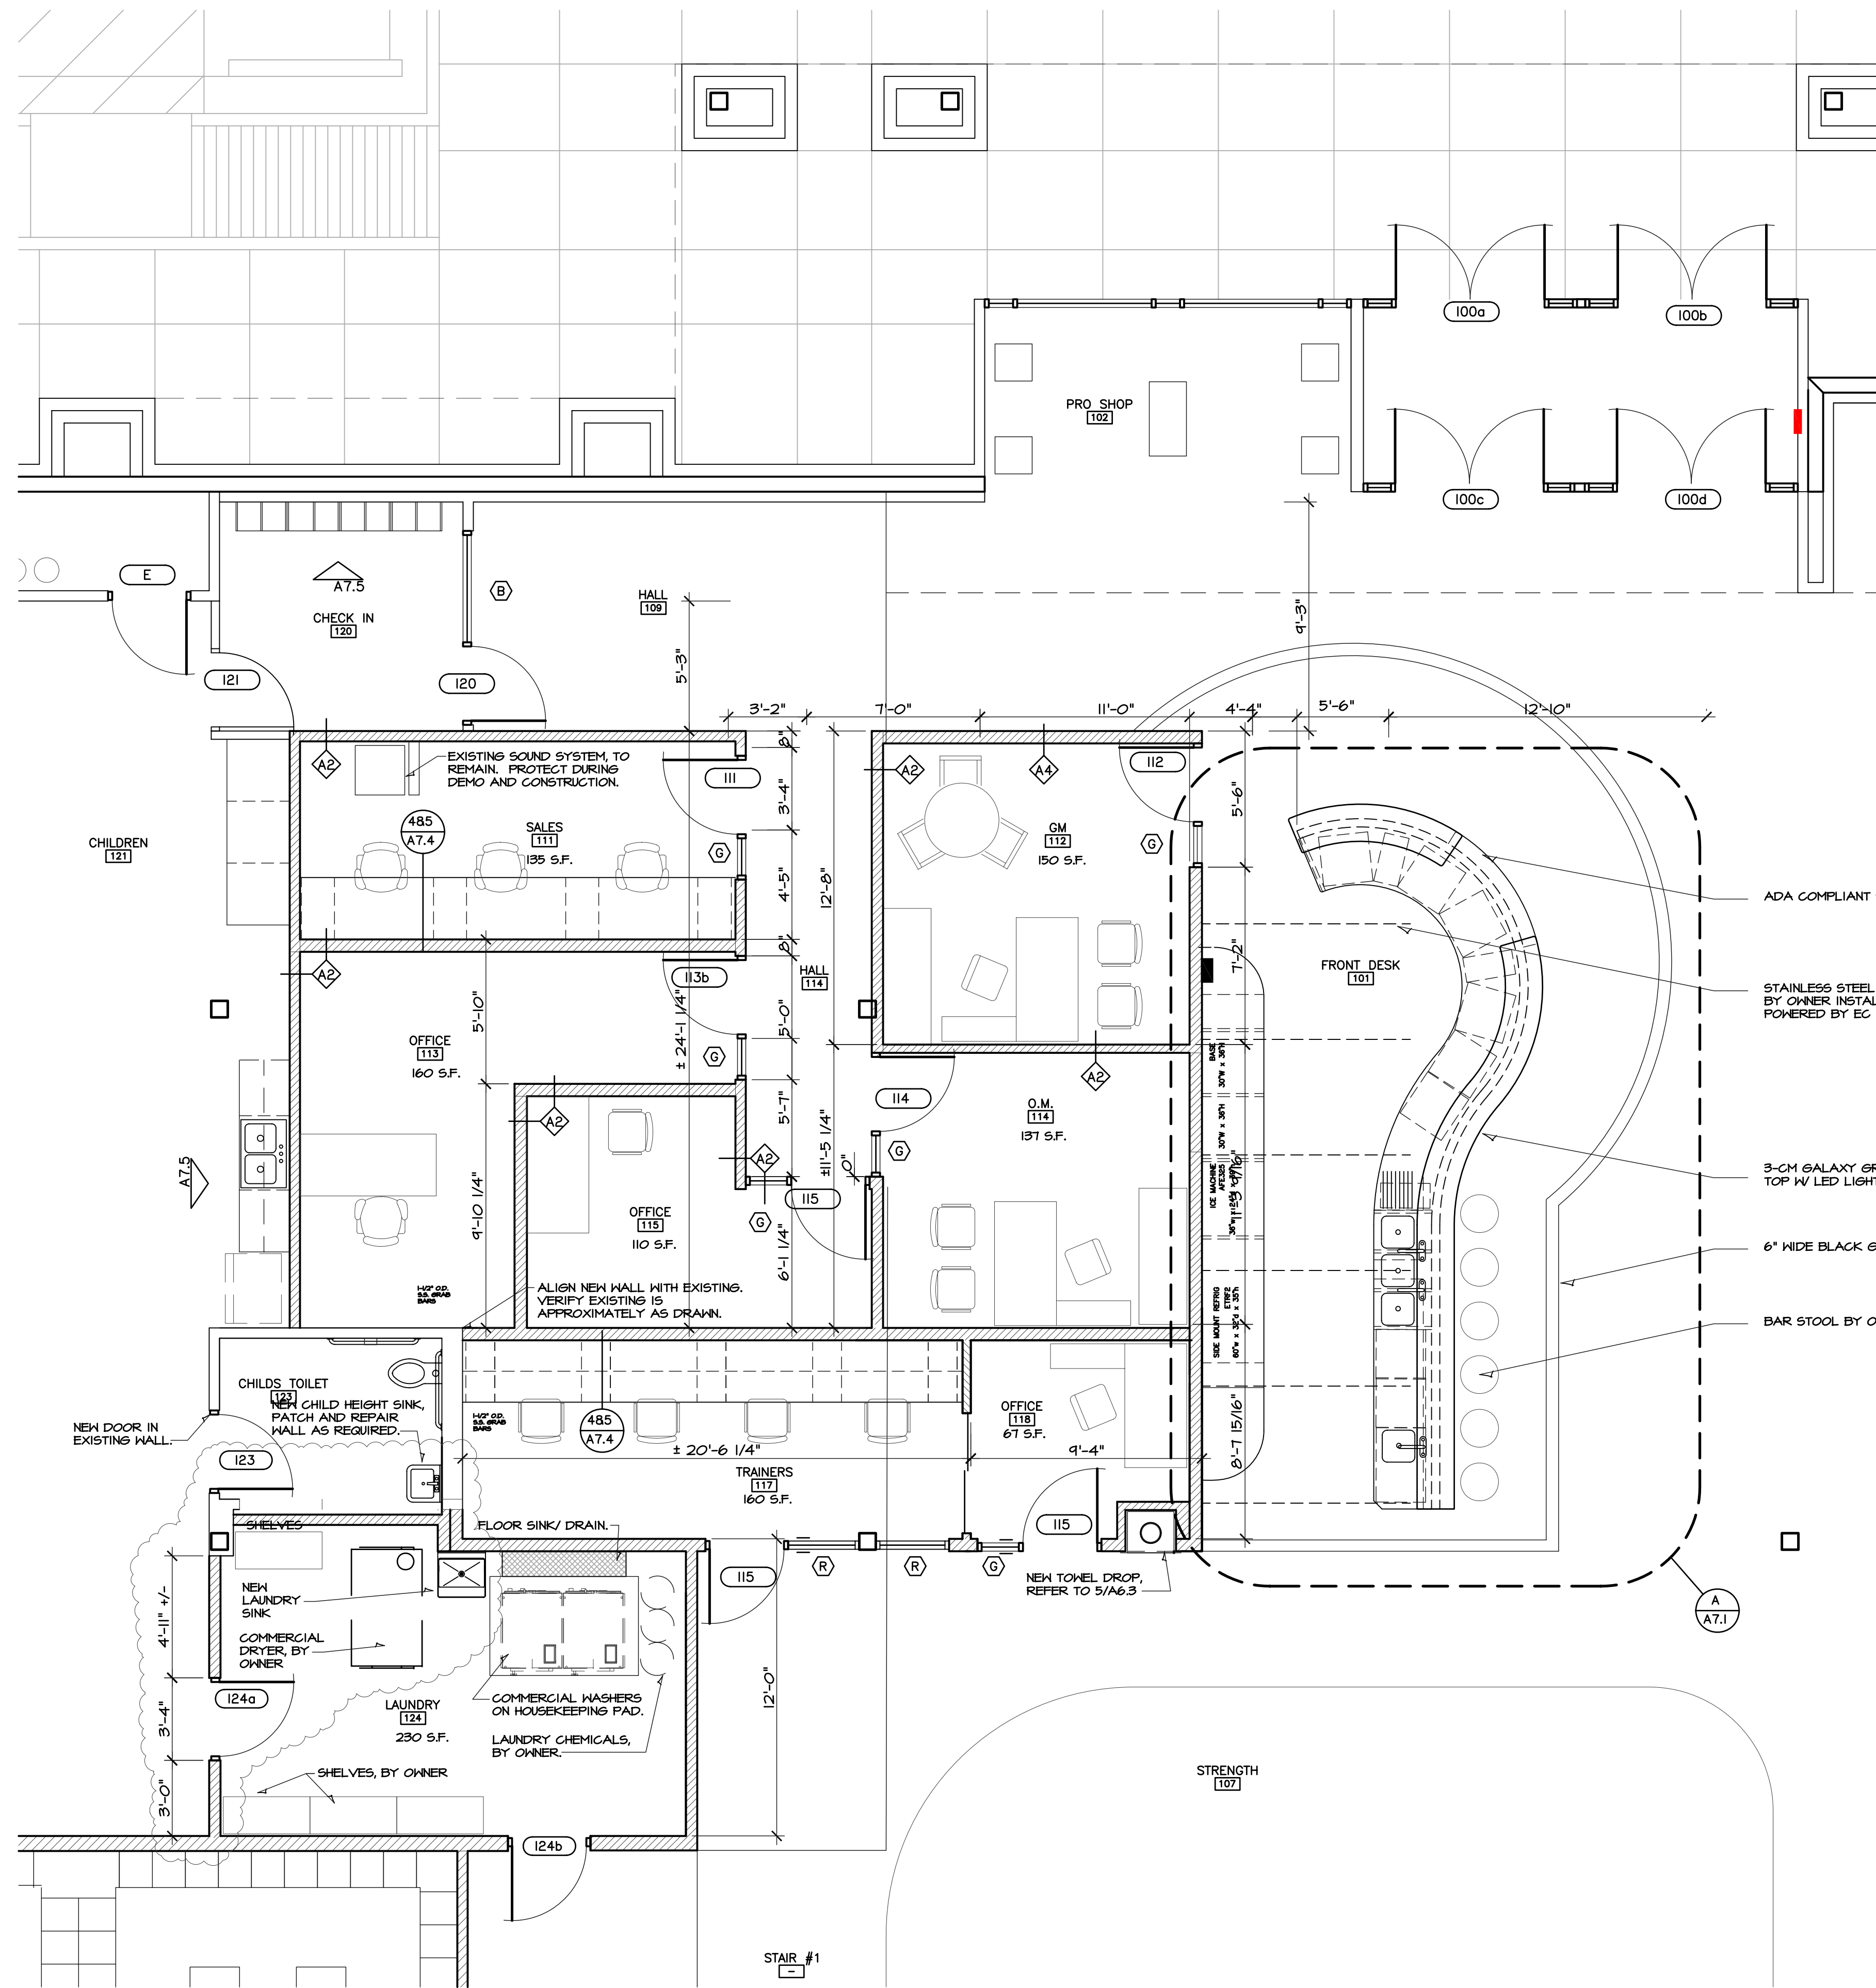


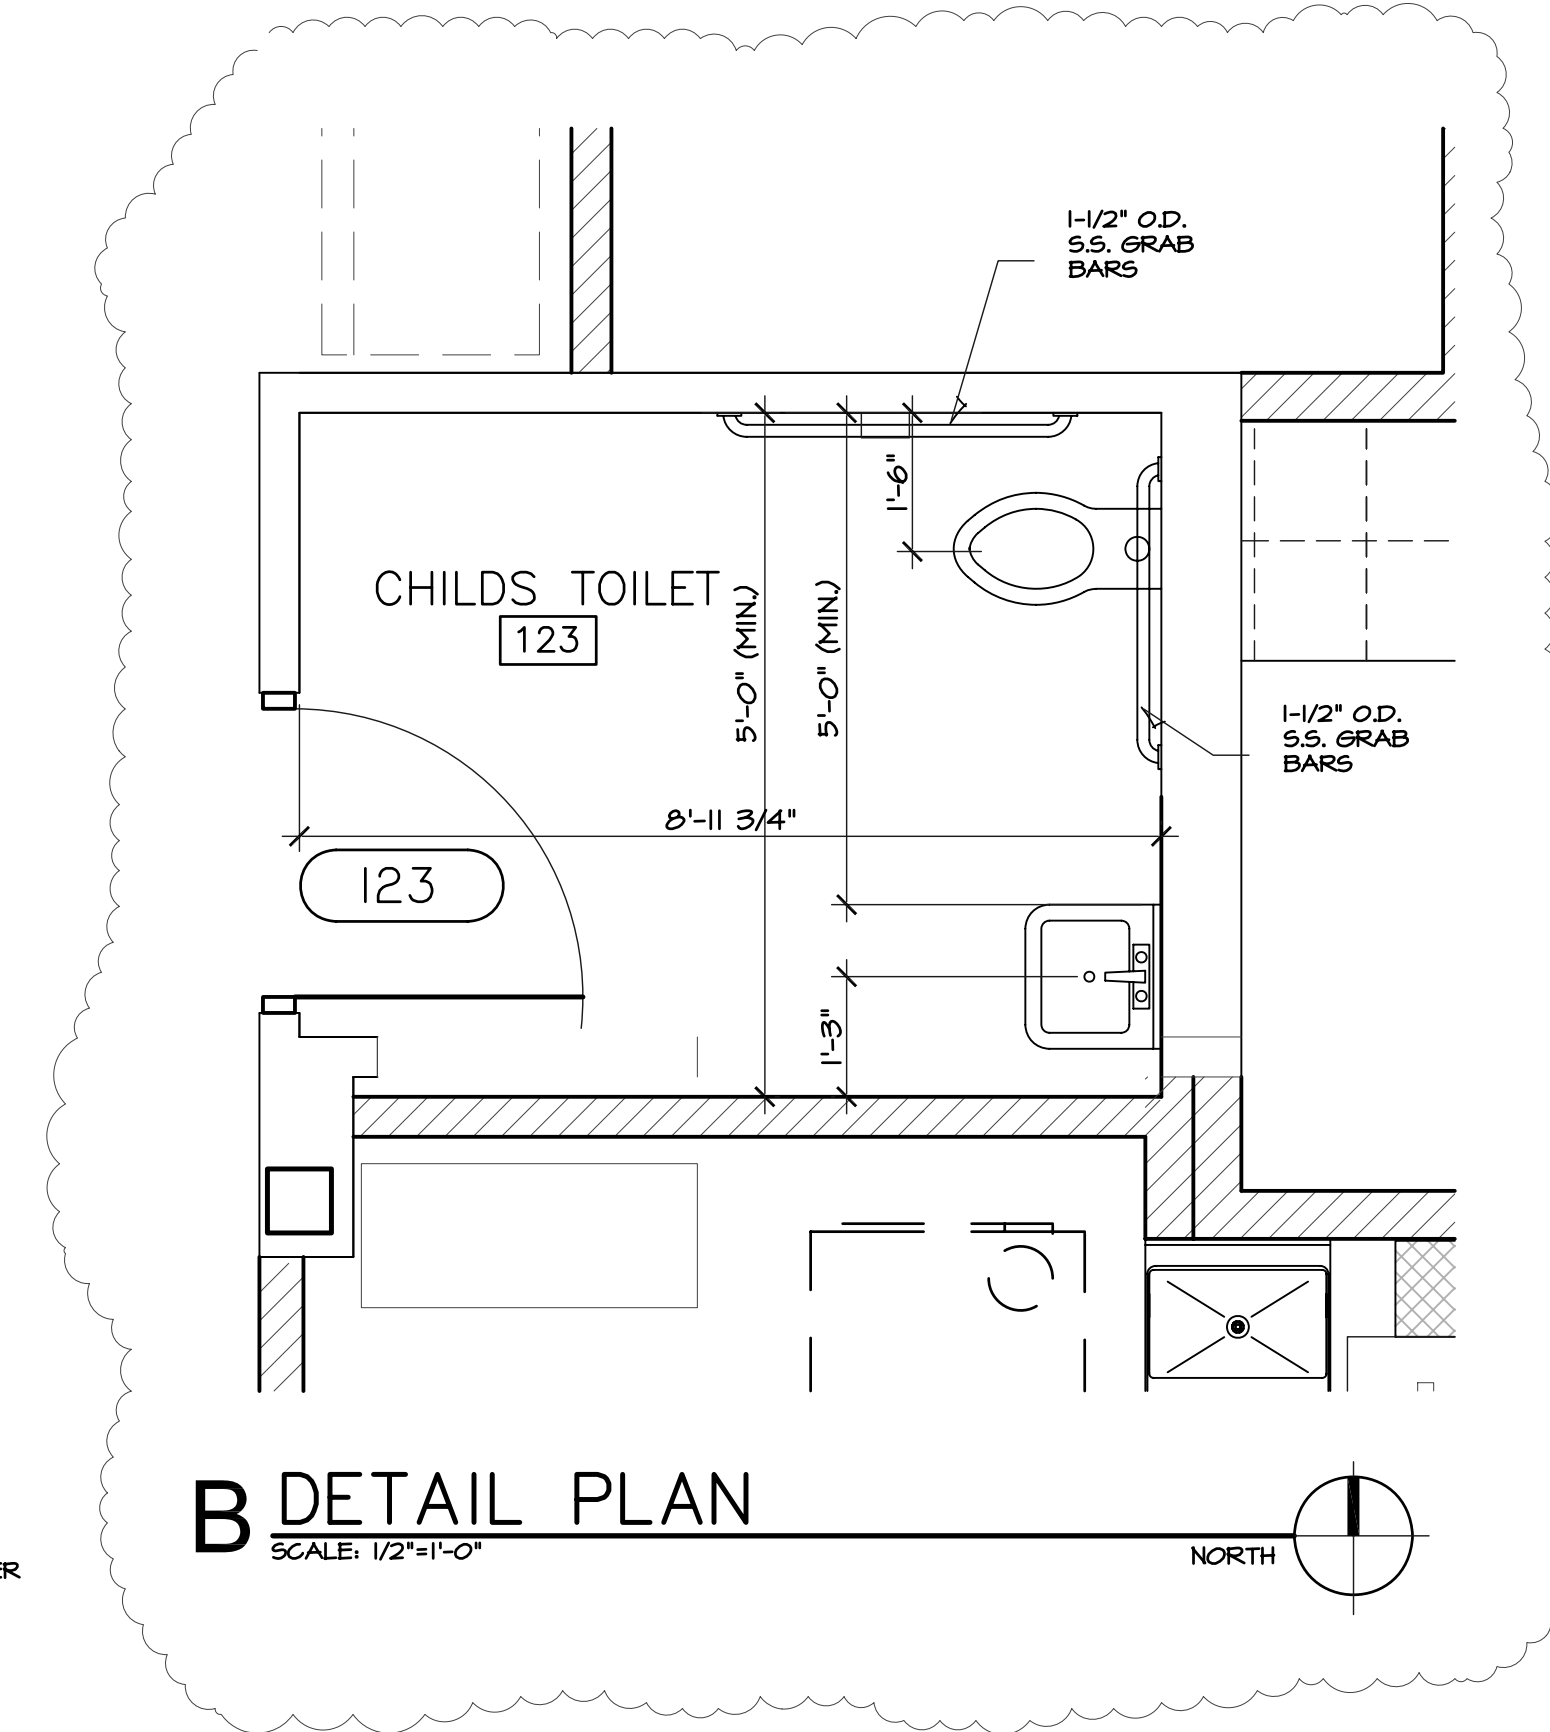


A OFFICE & FRONT DESK ENLARGED PLAN
SCALE: 1/4"=1'-0"

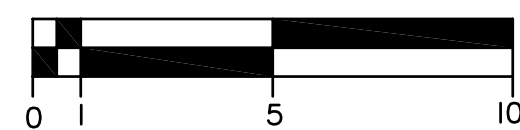

B DETAIL PLAN
SCALE: 1/2"=1'-0"

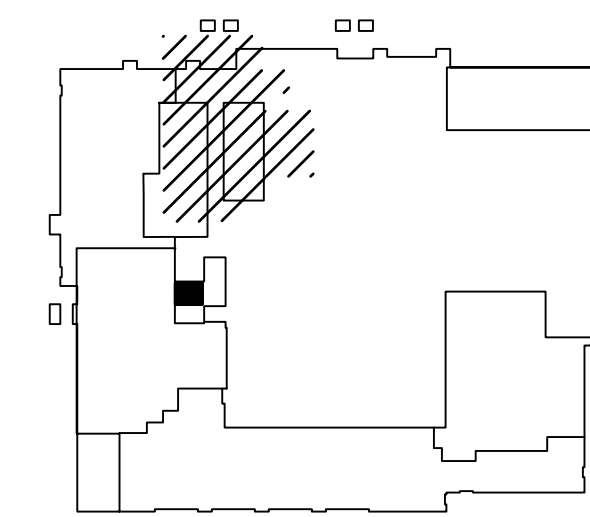

KEY PLAN
NOT TO SCALE

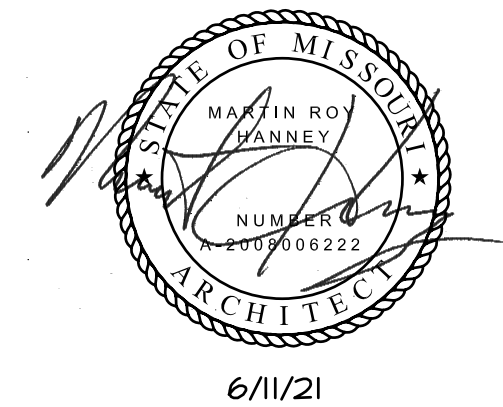

6/11/21
HAMNEY & ASSOCIATES ARCHITECTS
1726 South Hillside, Wichita, Kansas 67211
Phone (316) 683-8985
Fax (316) 684-1441

2021
GENESIS HEALTH CLUBS
900 N.E. Deerbrook Terrace
Lee's Summit, Missouri 64086



DRAWINGS ISSUED			
NO.	DATE	ITEM	ISSUED
10	6/11/21	CODE REVISION	
9	05/31/21	PLAN REVIEW	
8	05/21/21	REVIEW	
7	04/21/21	REVIEW	
6	04/20/21	REVIEW	
5	03/30/21	REVIEW	
4	03/05/21	REVIEW	
3	03/02/21	REVIEW	
2	1/12/21	REVIEW	
1	12/22/20	REVIEW	

COMPUTER DRAWING	
ELS_A103.dwg	

DATE:	JANUARY, 2021
DRAWN BY:	CHECKED BY:
MH, CH, TC, JC, TH	MRH

SHEET	
A1.4	
OF	SHEETS