

JP MORGAN CHASE, N.A. HWY 291 & NE LANGSFORD RD

890 NE LANGSFORD RD LEE'S SUMMIT, MO 64063 CHASE OVP#38200P368999

REV 2 - PLAN REVIEW COMMENTS & RDC 21/WIRELESS UPDATES

PROJECT DIRECTORY	CODE INFORMATION	PROJECT DATA
OWNER J.P. MORGAN CHASE 10 S. DEARBORN ST., 15th FLOOR CHICAGO, IL 60603 PHONE: 312.325.3388 CONTACT: CHRIS FOIT EMAIL: christopher.m foll@jpmchase.com OWNER REPRESENTATIVE CBRE PHONE: 1.816.223.9437 CONTACT: RUSSEIL PROPP EMAIL: russell.propp@jpmchase.com CHASE DESIGNER J.P. MORGAN CHASE CONTACT: JIN BYUN EMAIL: jin byun@chase.com PROJECT CONTACT CORE STATES, INC. 6500 CHIPPEWA ST., SUITE 200 ST. LOUIS, MO 63109 PHONE: 314.270.5090 CONTACT: CASEY THEBEAU EMAIL: chebeau@core-states.com ARCHITECT CORE STATES, INC. 6500 CHIPPEWA ST., SUITE 200 ST. LOUIS, MO 63109 PHONE: 314.270.5090 CONTACT: CASEY THEBEAU EMAIL: chebeau@core-states.com ARCHITECT CORE STATES, INC. 6500 CHIPPEWA ST., SUITE 200 ST. LOUIS, MO 63109 PHONE: 314.343.320 CONTACT: BRUCE LASURS EMAIL: blasurs@core-states.com ST. LOUIS AND 63109 PHONE: 314.270.5090 CONTACT: DAVID LEIFFER EMAIL: dielffer@core-states.com ELECTRICAL ENGINEER CORE STATES, INC. 1700 INDUSTRIAL DRIVE, SUITE B ROGERS, AR 72756 PHONE: 479.986.4400 CONTACT: DAVID LEIFFER EMAIL: dielffer@core-states.com ELECTRICAL ENGINEER CORE STATES, INC. 1700 INDUSTRIAL DRIVE, SUITE B ROGERS, AR 72756 PHONE: 479.986.4400 CONTACT: DAVID LEIFFER EMAIL: dielffer@core-states.com ST. LOUIS, MO 63109 PHONE: 314.343.320 CONTACT: BRUCE LASURS EMAIL: blasurs@core-states.com ST. LOUIS AND 63109 PHONE: 314.243.4320 CONTACT: BRUCE LASURS EMAIL: blasurs@core-states.com	JURISDICTION CITY OF LEE'S SUMMIT DEVELOPMENT SERVICES DEPARTMENT 220 SE GREEN STREET LEE'S SUMMIT, MO 64063 (816) 969-1200 APPLICABLE CODES BUILDING CODE: INTERNATIONAL BUILDING CODE (2018 EDITION) MECHANICAL CODE: INTERNATIONAL MECHANICAL CODE (2018 EDITION) PLUMBING CODE: INTERNATIONAL PLUMBING CODE (2018 EDITION) ELECTRICAL CODE: NATIONAL PLUMBING CODE (2018 EDITION) FIRE CODE: INTERNATIONAL FIRE CODE (2018 EDITION) ACCESSIBILITY CODE: INTERNATIONAL FIRE CODE (2018 EDITION) ACCESSIBILITY CODE: ICC/ANSI A117.1-2009, ACCESSIBLE AND USABLE BUILDINGS AND FACILITIES ENERGY CONSERVATION CODE: INTERNATIONAL ENERGY CODE (2018 EDITION) SCOPE OF WORK: CONSTRUCTION OF A NEW COMMERCIAL BANKING CENTER WITH REMOVE DRIVE THRU ATM CANOPY AND TRASH ENCLOSURE. THE SCOPE INCLUDES CIVIL, ARCHITECTURE, STRUCTURAL, MECHANICAL, PLUMBING, AND ELECTRICAL. CIVIL SCOPE SUBMITTED UNDER SEPARATE COVER.	USE CLASSIFICATION OF WORK SQUARE FOOTAGE VOLUME OCCUPANCY CLASSIFICATION OCCUPANCY LOAD OCCUPANCY LOAD PER CLASSIFICATION: PUBLIC FLOOR AREA / 150 3,320 SF / 150 = 23 OCCUPANTS CONSTRUCTION TYPE SEISMIC CATEGORY SPRINKLERED FIRE ALARM BUILDING HEIGHTS AND AREAS BUILDING AREA ALLOWABLE HEIGHTS STORIES FEET FIRE SEPARATION PER IBC 2018 CH. 6 TABLE 602 FRONT BUILDING SETBACK (NORTH) (X > 30') SIDE BUILDING SETBACK (EAST) (X > 30') SIDE BUILDING SETBACK (SOUTH) (X > 30') REAR BUILDING SETBACK (SOUTH) (X > 30') EGRESS WIDTH: OCCUPANTS x (0.2 - OTHER EGRESS COMPONENTS) 23 x 0.2" = 4.6" WIDTH REQUIRED EXITS AND EXIT ACCESS DOORWAYS EXITS (MAX OCCUPANT OF 49 FOR 1 EXIT)
LOCATION MAP	FIRE-RESISTANCE RATING REQUIREMENTS	DOOR WIDTH COMMON PATH OF TRAVEL (30'; 75' IF OCC. LOAD < 50)
BUILDING LOCATION Lumber Liquidatory Flooring Delivery The Insurance Groupe Ur. Special Gifts 8. Keepsakes Gift shop To the liquidatory The Insurance Groupe The Insurance	PER 2018 IBC TABLE 601 - CONSTRUCTION TYPE II-B REQUIRED PRIMARY STRUCTURAL FRAME 0 HR REQUIRED BEARING WALLS EXTERIOR / INTERIOR 0 HR REQUIRED NONBEARING WALLS EXTERIOR / INTERIOR 0 HR REQUIRED FLOOR CONSTRUCTION 0 HR REQUIRED ROOF CONSTRUCTION 0 HR FLAME SPREAD DATA CERAMIC TILE: IBC REQUIRED MINIMUM N/A IBC REQUIRED MINIMUM CLASS II PROVIDED CLASS II SUPPROFUDED ACOUSTICAL CEILINGS: IBC REQUIRED MINIMUM CLASS B PAINTS AND COATING: PROVIDED CLASS A IBC REQUIRED MINIMUM CLASS B PROVIDED CLASS A CLASS A PROVIDED CLASS A RESILIENT FLOORING: IBC REQUIRED MINIMUM CLASS II PROVIDED CLASS II CLAS	EXIT ACCESS TRAVEL DISTANCE DEAD END CORRIDORS PLUMBING FIXTURES OCCUPANT LOAD PER 2018 IPC CODE 403.2 SEPARATE FACILITIES SHALL BE PROVIDED FOR EACH SE FIXTURES (PER 2018 IPC CH. 4 TABLE 403.1) WATER CLOSETS - 1 PER 25 FOR FIRST 50 LAVATORIES - 1 PER 40 FOR FIRST 80 DRINKING FOUNTAIN (1 PER 100) SERVICE SINK (1 PER FLOOR)
Rete 2	GC SHALL OBTAIN PERMITS LISTED BELOW PRIOR TO INSTALLATION PER LOCAL JURISDICTION REQUIREMENTS.	SECURITY ENAHNCEMENTS: NO BR. DATE OF DRC ISSUED: 09/30/2


USE	NEW RETAIL BANKING CENT	TER
CLASSIFICATION OF WORK	NEW BUILD GROUND UP	
SQUARE FOOTAGE	3,320 GSF	
VOLUME	56,440 CSF	
OCCUPANCY CLASSIFICATION	BUSINESS GROUP B	
OCCUPANCY LOAD		
OCCUPANCY LOAD PER CLASSIFICATION:	SEE LIFE SAFETY PLAN	
PUBLIC FLOOR AREA / 150	23 = TOTAL OCCUPANTS PE	R 2018 IBC
3,320 SF / 150 = 23 OCCUPANTS		
CONSTRUCTION TYPE	II-B	
SEISMIC CATEGORY	В	
SPRINKLERED	NOT REQUIRED	
FIRE ALARM	NOT REQUIRED	
BUILDING HEIGHTS AND AREAS	ALLOWABLE/REQ'D	PROPC
BUILDING AREA	23,000 S.F.	3,320
50.50.000		
ALLOWABLE HEIGHTS		
STORIES	3	1
FEET	55'-0"	21'-6
FIRE SEPARATION PER IBC 2018 CH. 6 TABLE 602		
FRONT BUILDING SETBACK (NORTH) (X > 30')	0 HRS.	0 HR
SIDE BUILDING SETBACK (EAST) (X > 30')	0 HRS.	0 HR
SIDE BUILDING SETBACK (WEST) (X > 30')	0 HRS.	0 HR
REAR BUILDING SETBACK (SOUTH) (X > 30')	0 HRS.	0 HR
EGRESS WIDTH:		
OCCUPANTS x (0.2 - OTHER EGRESS COMPONENTS)		
23 x 0.2" = 4.6" WIDTH REQUIRED		
EXITS AND EXIT ACCESS DOORWAYS	SEE LIFE SAFETY PL	AN SHEET A1.
EXITS (MAX OCCUPANT OF 49 FOR 1 EXIT)		
DOOR WIDTH		
COMMON PATH OF TRAVEL (30'; 75' IF OCC. LOAD < 50)		
EXIT ACCESS TRAVEL DISTANCE		
DEAD END CORRIDORS		
PLUMBING FIXTURES		
OCCUPANT LOAD	= 23 TOTAL OCCUPANTS PI	ER 2018 IBC
PER 2018 IPC CODE 403.2		
SEPARATE FACILITIES SHALL BE PROVIDED FOR EACH SEX.		
FIXTURES (PER 2018 IPC CH. 4 TABLE 403.1)		
WATER CLOSETS - 1 PER 25 FOR FIRST 50	1/1	1/
LAVATORIES - 1 PER 40 FOR FIRST 80	1/1	1/
DRINKING FOUNTAIN (1 PER 100)	1	1 HIGH /
SERVICE SINK (1 PER FLOOR)	1	1

NO BRG, SECURITY FILMS, ANTI-GRAFFITI FILMS

SIGNATURE CANOPY

REMOTE DRIVE-UP ATM:

INCLUDES RETAIL DESIGN COMMUNICATION UP TO:

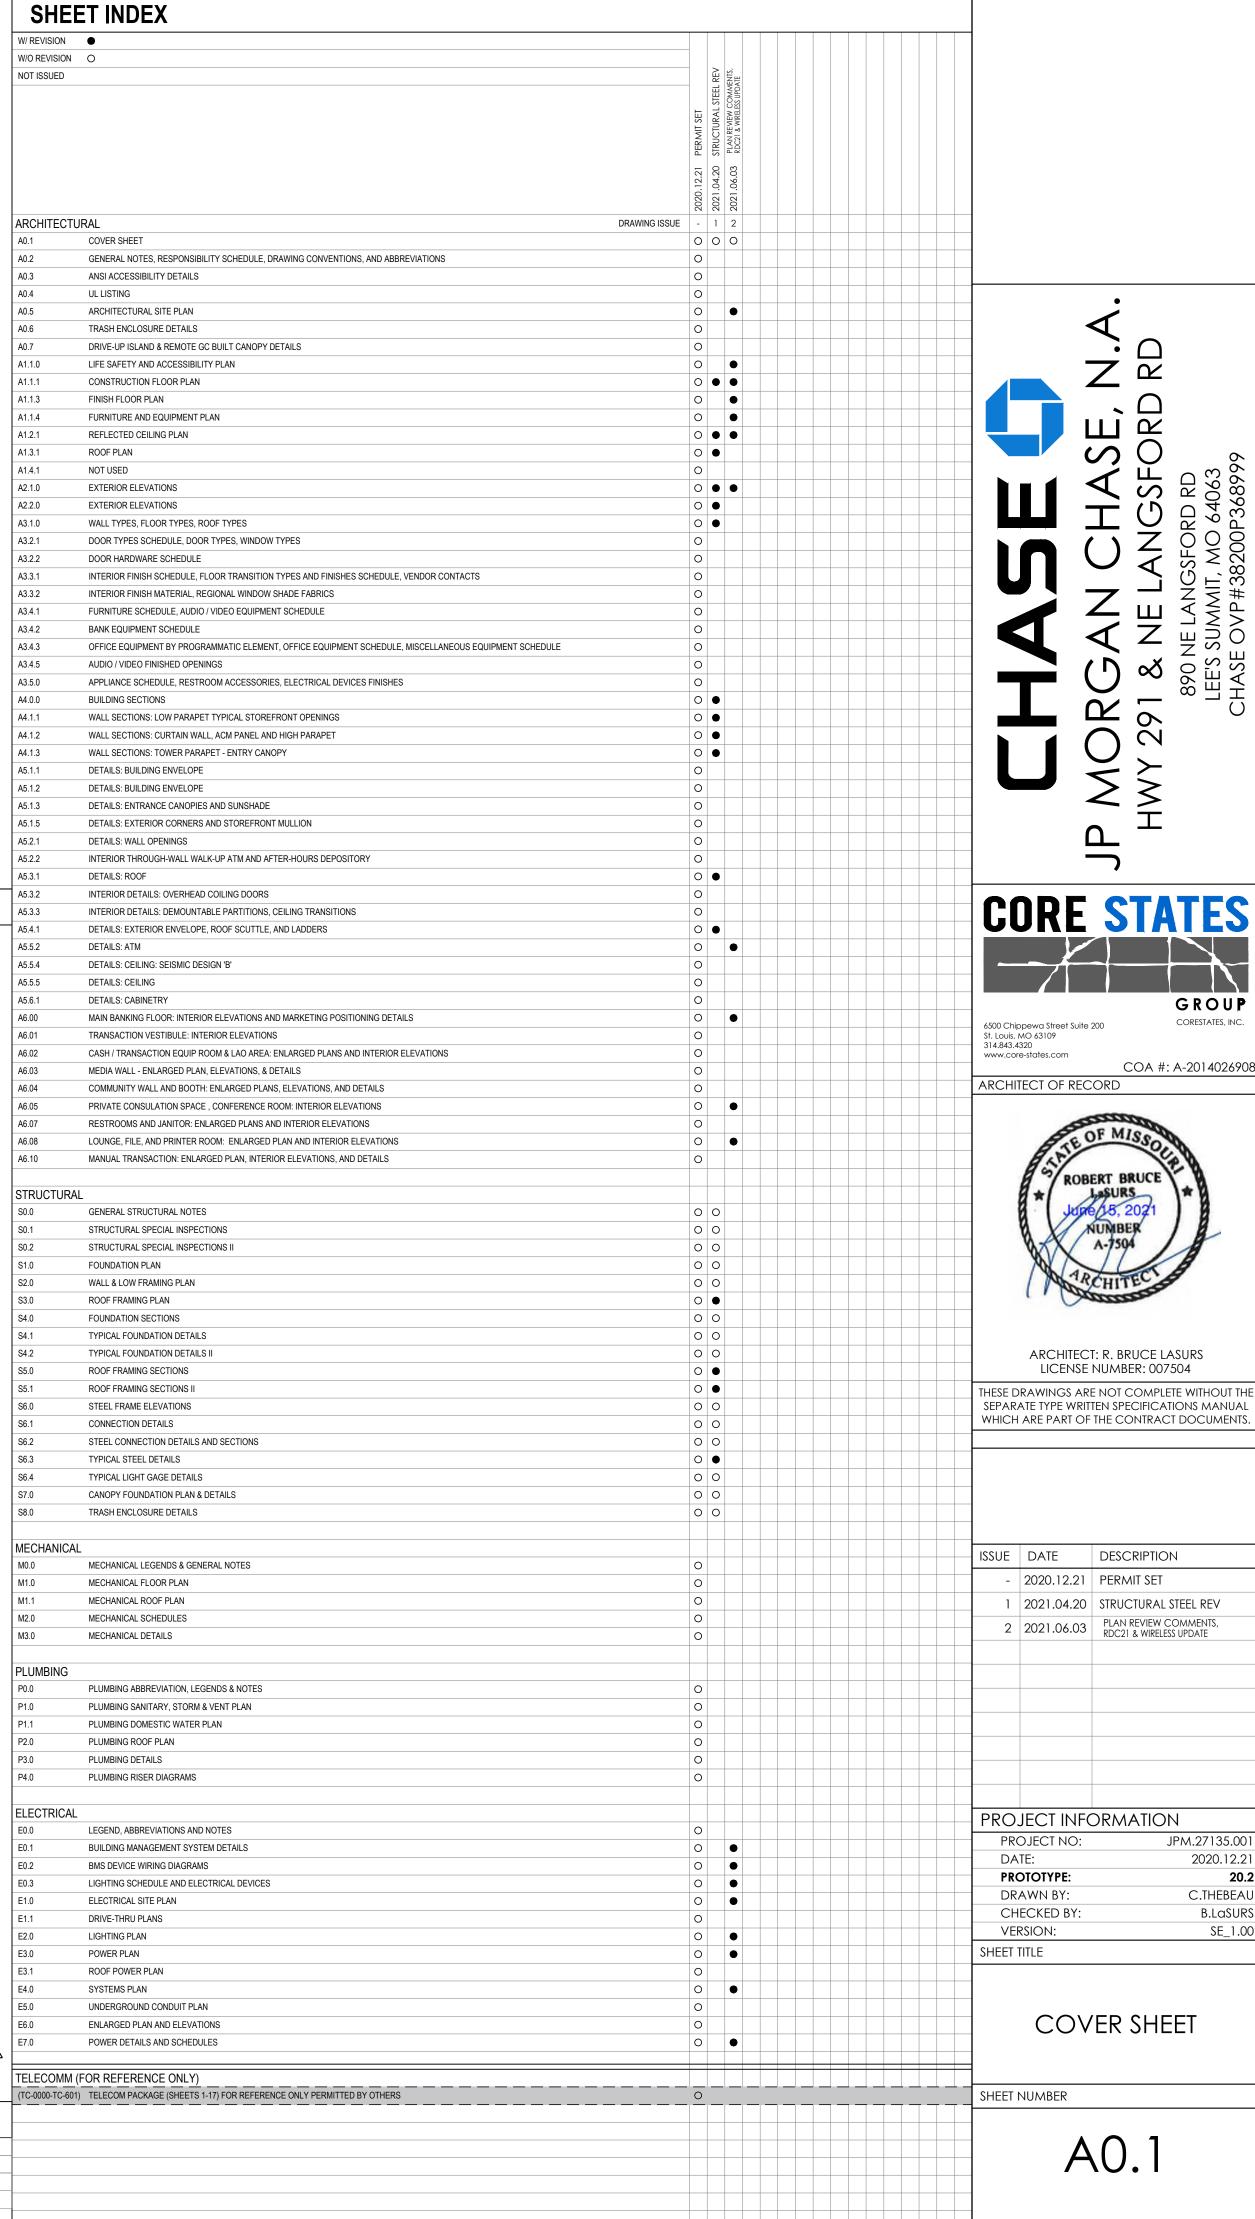






HESE DRAWINGS ARE NOT COMPLETE WITHOUT THE SEPARATE TYPE WRITTEN SPECIFICATIONS MANUAL

-	2020.12.21	PERMIT SET
1	2021.04.20	STRUCTURAL STEEL REV
2	2021.06.03	PLAN REVIEW COMMENTS, RDC21 & WIRELESS UPDATE

ROJECT INFORMA	ATION
PROJECT NO:	JPM.27135.00
DATE:	2020.12.2
PROTOTYPE:	20.5
DRAWN BY:	C.THEBEAU
CHECKED BY:	B.LaSUR
VERSION:	SE_1.00

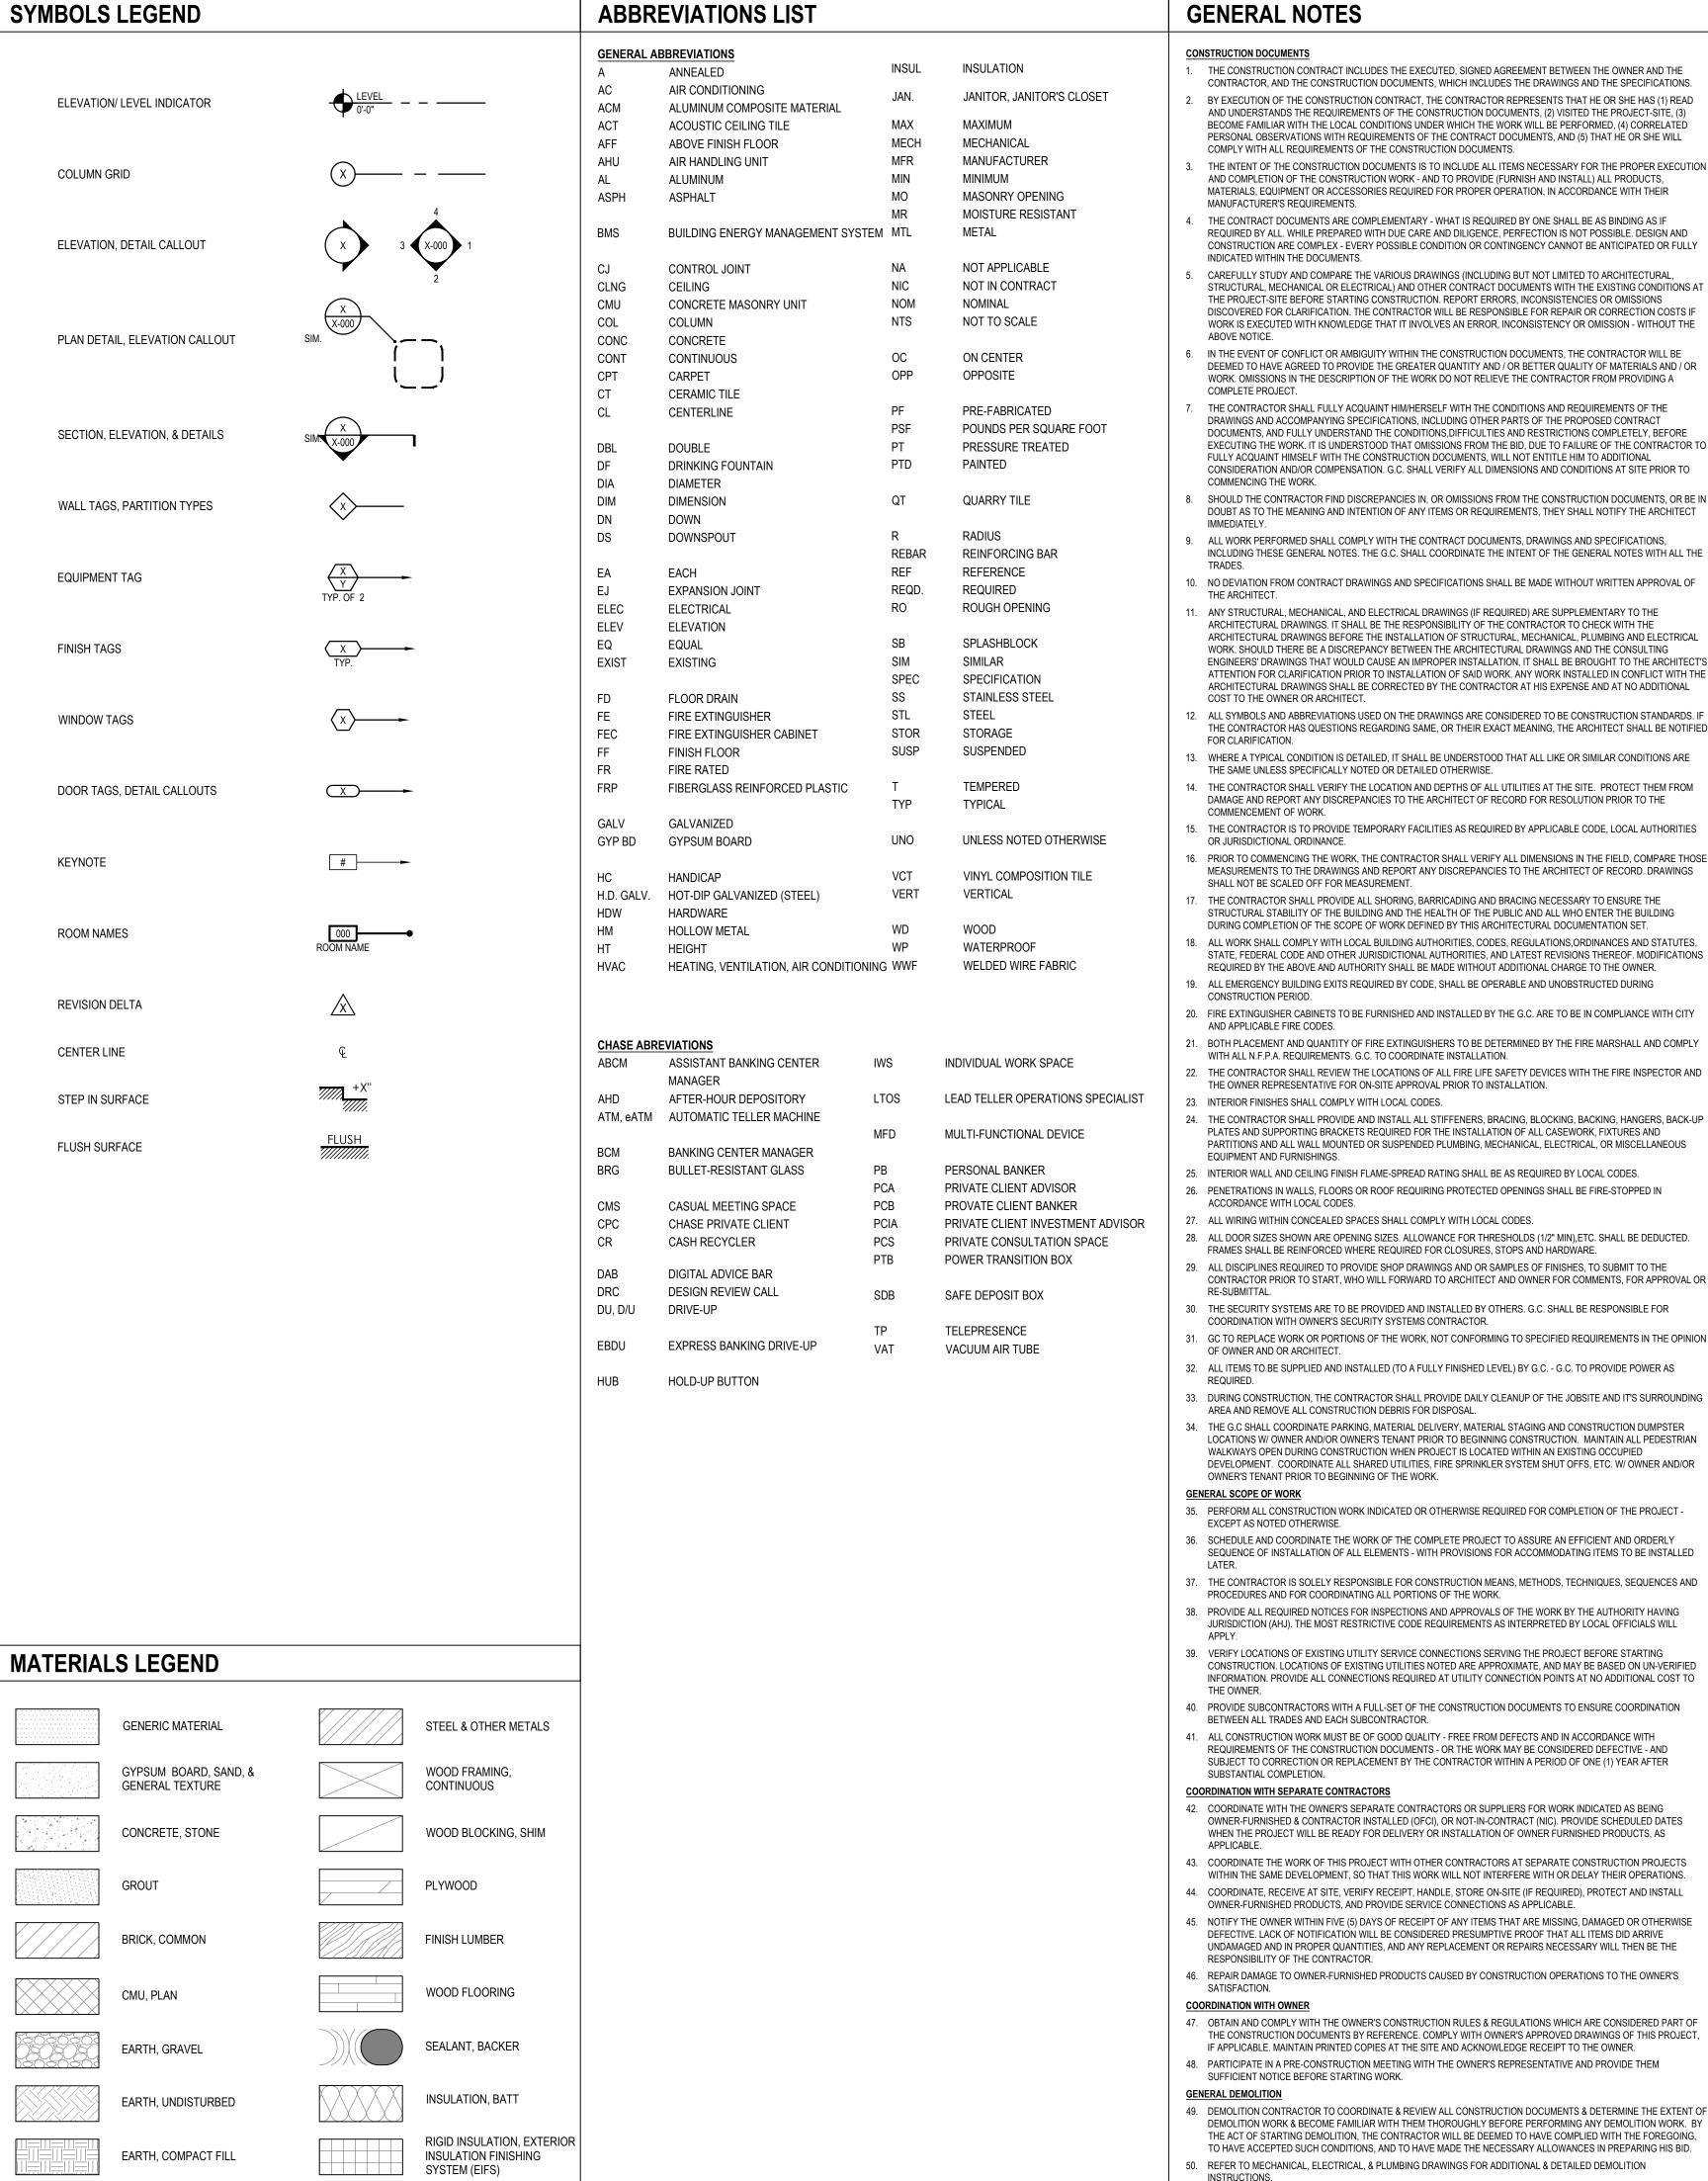

GENERAL NOTES

COMMENCING THE WORK.

- THE CONSTRUCTION CONTRACT INCLUDES THE EXECUTED, SIGNED AGREEMENT BETWEEN THE OWNER AND THE CONTRACTOR, AND THE CONSTRUCTION DOCUMENTS, WHICH INCLUDES THE DRAWINGS AND THE SPECIFICATIONS BY EXECUTION OF THE CONSTRUCTION CONTRACT, THE CONTRACTOR REPRESENTS THAT HE OR SHE HAS (1) READ AND UNDERSTANDS THE REQUIREMENTS OF THE CONSTRUCTION DOCUMENTS. (2) VISITED THE PROJECT-SITE. (3) BECOME FAMILIAR WITH THE LOCAL CONDITIONS UNDER WHICH THE WORK WILL BE PERFORMED (4) CORRELATED.
- COMPLY WITH ALL REQUIREMENTS OF THE CONSTRUCTION DOCUMENTS. THE INTENT OF THE CONSTRUCTION DOCUMENTS IS TO INCLUDE ALL ITEMS NECESSARY FOR THE PROPER EXECUTION AND COMPLETION OF THE CONSTRUCTION WORK - AND TO PROVIDE (FURNISH AND INSTALL) ALL PRODUCTS, MATERIALS, EQUIPMENT OR ACCESSORIES REQUIRED FOR PROPER OPERATION, IN ACCORDANCE WITH THEIR

PERSONAL OBSERVATIONS WITH REQUIREMENTS OF THE CONTRACT DOCUMENTS, AND (5) THAT HE OR SHE WILL

- MANUFACTURER'S REQUIREMENTS. THE CONTRACT DOCUMENTS ARE COMPLEMENTARY - WHAT IS REQUIRED BY ONE SHALL BE AS BINDING AS IF REQUIRED BY ALL. WHILE PREPARED WITH DUE CARE AND DILIGENCE, PERFECTION IS NOT POSSIBLE. DESIGN AND CONSTRUCTION ARE COMPLEX - EVERY POSSIBLE CONDITION OR CONTINGENCY CANNOT BE ANTICIPATED OR FULLY
- INDICATED WITHIN THE DOCUMENTS. CARFFULLY STUDY AND COMPARE THE VARIOUS DRAWINGS (INCLUDING BUT NOT LIMITED TO ARCHITECTURAL STRUCTURAL. MECHANICAL OR ELECTRICAL) AND OTHER CONTRACT DOCUMENTS WITH THE EXISTING CONDITIONS AT THE PROJECT-SITE BEFORE STARTING CONSTRUCTION, REPORT ERRORS, INCONSISTENCIES OR OMISSIONS DISCOVERED FOR CLARIFICATION. THE CONTRACTOR WILL BE RESPONSIBLE FOR REPAIR OR CORRECTION COSTS IF WORK IS EXECUTED WITH KNOWLEDGE THAT IT INVOLVES AN ERROR, INCONSISTENCY OR OMISSION - WITHOUT THE
- IN THE EVENT OF CONFLICT OR AMBIGUITY WITHIN THE CONSTRUCTION DOCUMENTS. THE CONTRACTOR WILL BE DEFMED TO HAVE AGREED TO PROVIDE THE GREATER QUANTITY AND / OR BETTER QUALITY OF MATERIALS AND / OR WORK. OMISSIONS IN THE DESCRIPTION OF THE WORK DO NOT RELIEVE THE CONTRACTOR FROM PROVIDING A
- THE CONTRACTOR SHALL FULLY ACQUAINT HIM/HERSELF WITH THE CONDITIONS AND REQUIREMENTS OF THE DRAWINGS AND ACCOMPANYING SPECIFICATIONS, INCLUDING OTHER PARTS OF THE PROPOSED CONTRACT DOCUMENTS, AND FULLY UNDERSTAND THE CONDITIONS DIFFICULTIES AND RESTRICTIONS COMPLETELY, BEFORE EXECUTING THE WORK. IT IS UNDERSTOOD THAT OMISSIONS FROM THE BID. DUE TO FAILURE OF THE CONTRACTOR TO FULLY ACQUAINT HIMSELF WITH THE CONSTRUCTION DOCUMENTS. WILL NOT ENTITLE HIM TO ADDITIONAL CONSIDERATION AND/OR COMPENSATION. G.C. SHALL VERIFY ALL DIMENSIONS AND CONDITIONS AT SITE PRIOR TO
- SHOULD THE CONTRACTOR FIND DISCREPANCIES IN, OR OMISSIONS FROM THE CONSTRUCTION DOCUMENTS, OR BE IN DOUBT AS TO THE MEANING AND INTENTION OF ANY ITEMS OR REQUIREMENTS. THEY SHALL NOTIFY THE ARCHITECT
- ALL WORK PERFORMED SHALL COMPLY WITH THE CONTRACT DOCUMENTS, DRAWINGS AND SPECIFICATIONS. INCLUDING THESE GENERAL NOTES. THE G.C. SHALL COORDINATE THE INTENT OF THE GENERAL NOTES WITH ALL THE
- NO DEVIATION FROM CONTRACT DRAWINGS AND SPECIFICATIONS SHALL BE MADE WITHOUT WRITTEN APPROVAL OF
- THE ARCHITECT.
- ANY STRUCTURAL, MECHANICAL, AND ELECTRICAL DRAWINGS (IF REQUIRED) ARE SUPPLEMENTARY TO THE ARCHITECTURAL DRAWINGS. IT SHALL BE THE RESPONSIBILITY OF THE CONTRACTOR TO CHECK WITH THE ARCHITECTURAL DRAWINGS BEFORE THE INSTALLATION OF STRUCTURAL, MECHANICAL, PLUMBING AND ELECTRICAL WORK. SHOULD THERE BE A DISCREPANCY BETWEEN THE ARCHITECTURAL DRAWINGS AND THE CONSULTING ENGINEERS' DRAWINGS THAT WOULD CAUSE AN IMPROPER INSTALLATION. IT SHALL BE BROUGHT TO THE ARCHITECT'S ATTENTION FOR CLARIFICATION PRIOR TO INSTALLATION OF SAID WORK, ANY WORK INSTALLED IN CONFLICT WITH THE ARCHITECTURAL DRAWINGS SHALL BE CORRECTED BY THE CONTRACTOR AT HIS EXPENSE AND AT NO ADDITIONAL COST TO THE OWNER OR ARCHITECT
- ALL SYMBOLS AND ABBREVIATIONS USED ON THE DRAWINGS ARE CONSIDERED TO BE CONSTRUCTION STANDARDS. IF THE CONTRACTOR HAS QUESTIONS REGARDING SAME, OR THEIR EXACT MEANING, THE ARCHITECT SHALL BE NOTIFIED

. WHERE A TYPICAL CONDITION IS DETAILED, IT SHALL BE UNDERSTOOD THAT ALL LIKE OR SIMILAR CONDITIONS ARE

- THE SAME UNLESS SPECIFICALLY NOTED OR DETAILED OTHERWISE 14. THE CONTRACTOR SHALL VERIFY THE LOCATION AND DEPTHS OF ALL UTILITIES AT THE SITE. PROTECT THEM FROM
- DAMAGE AND REPORT ANY DISCREPANCIES TO THE ARCHITECT OF RECORD FOR RESOLUTION PRIOR TO THE COMMENCEMENT OF WORK.
- 15. THE CONTRACTOR IS TO PROVIDE TEMPORARY FACILITIES AS REQUIRED BY APPLICABLE CODE, LOCAL AUTHORITIES OR JURISDICTIONAL ORDINANCE.
- PRIOR TO COMMENCING THE WORK, THE CONTRACTOR SHALL VERIFY ALL DIMENSIONS IN THE FIELD, COMPARE THOSE MEASUREMENTS TO THE DRAWINGS AND REPORT ANY DISCREPANCIES TO THE ARCHITECT OF RECORD. DRAWINGS SHALL NOT BE SCALED OFF FOR MEASUREMENT
- THE CONTRACTOR SHALL PROVIDE ALL SHORING, BARRICADING AND BRACING NECESSARY TO ENSURE THE STRUCTURAL STABILITY OF THE BUILDING AND THE HEALTH OF THE PUBLIC AND ALL WHO ENTER THE BUILDING DURING COMPLETION OF THE SCOPE OF WORK DEFINED BY THIS ARCHITECTURAL DOCUMENTATION SET ALL WORK SHALL COMPLY WITH LOCAL BUILDING AUTHORITIES, CODES, REGULATIONS, ORDINANCES AND STATUTES,
- STATE. FEDERAL CODE AND OTHER JURISDICTIONAL AUTHORITIES, AND LATEST REVISIONS THEREOF. MODIFICATIONS REQUIRED BY THE ABOVE AND AUTHORITY SHALL BE MADE WITHOUT ADDITIONAL CHARGE TO THE OWNER. 9. ALL EMERGENCY BUILDING EXITS REQUIRED BY CODE, SHALL BE OPERABLE AND UNOBSTRUCTED DURING CONSTRUCTION PERIOD
- 0. FIRE EXTINGUISHER CABINETS TO BE FURNISHED AND INSTALLED BY THE G.C. ARE TO BE IN COMPLIANCE WITH CITY AND APPLICABLE FIRE CODES
- 1. BOTH PLACEMENT AND QUANTITY OF FIRE EXTINGUISHERS TO BE DETERMINED BY THE FIRE MARSHALL AND COMPLY WITH ALL N.F.P.A. REQUIREMENTS. G.C. TO COORDINATE INSTALLATION.
- 23. INTERIOR FINISHES SHALL COMPLY WITH LOCAL CODES. 24. THE CONTRACTOR SHALL PROVIDE AND INSTALL ALL STIFFENERS, BRACING, BLOCKING, BACKING, HANGERS, BACK-UP
- PLATES AND SUPPORTING BRACKETS REQUIRED FOR THE INSTALLATION OF ALL CASEWORK, FIXTURES AND EQUIPMENT AND FURNISHINGS.
- 25. INTERIOR WALL AND CEILING FINISH FLAME-SPREAD RATING SHALL BE AS REQUIRED BY LOCAL CODES. 26. PENETRATIONS IN WALLS, FLOORS OR ROOF REQUIRING PROTECTED OPENINGS SHALL BE FIRE-STOPPED IN

THE OWNER REPRESENTATIVE FOR ON-SITE APPROVAL PRIOR TO INSTALLATION.

- ACCORDANCE WITH LOCAL CODES.
- ALL WIRING WITHIN CONCEALED SPACES SHALL COMPLY WITH LOCAL CODES. 28. ALL DOOR SIZES SHOWN ARE OPENING SIZES. ALLOWANCE FOR THRESHOLDS (1/2" MIN), ETC. SHALL BE DEDUCTED.
- FRAMES SHALL BE REINFORCED WHERE REQUIRED FOR CLOSURES, STOPS AND HARDWARE. ALL DISCIPLINES REQUIRED TO PROVIDE SHOP DRAWINGS AND OR SAMPLES OF FINISHES. TO SUBMIT TO THE
- CONTRACTOR PRIOR TO START, WHO WILL FORWARD TO ARCHITECT AND OWNER FOR COMMENTS, FOR APPROVAL OR 30. THE SECURITY SYSTEMS ARE TO BE PROVIDED AND INSTALLED BY OTHERS. G.C. SHALL BE RESPONSIBLE FOR
- COORDINATION WITH OWNER'S SECURITY SYSTEMS CONTRACTOR. . GC TO REPLACE WORK OR PORTIONS OF THE WORK, NOT CONFORMING TO SPECIFIED REQUIREMENTS IN THE OPINION
- OF OWNER AND OR ARCHITECT. 2. ALL ITEMS TO BE SUPPLIED AND INSTALLED (TO A FULLY FINISHED LEVEL) BY G.C. - G.C. TO PROVIDE POWER AS
- 33. DURING CONSTRUCTION, THE CONTRACTOR SHALL PROVIDE DAILY CLEANUP OF THE JOBSITE AND IT'S SURROUNDING
- AREA AND REMOVE ALL CONSTRUCTION DEBRIS FOR DISPOSAL. . THE G.C SHALL COORDINATE PARKING, MATERIAL DELIVERY, MATERIAL STAGING AND CONSTRUCTION DUMPSTER LOCATIONS W/ OWNER AND/OR OWNER'S TENANT PRIOR TO BEGINNING CONSTRUCTION. MAINTAIN ALL PEDESTRIAN WALKWAYS OPEN DURING CONSTRUCTION WHEN PROJECT IS LOCATED WITHIN AN EXISTING OCCUPIED DEVELOPMENT. COORDINATE ALL SHARED UTILITIES, FIRE SPRINKLER SYSTEM SHUT OFFS, ETC. W/ OWNER AND/OR

GENERAL SCOPE OF WORK 35. PERFORM ALL CONSTRUCTION WORK INDICATED OR OTHERWISE REQUIRED FOR COMPLETION OF THE PROJECT EXCEPT AS NOTED OTHERWISE.

- SCHEDULE AND COORDINATE THE WORK OF THE COMPLETE PROJECT TO ASSURE AN EFFICIENT AND ORDERLY SEQUENCE OF INSTALLATION OF ALL ELEMENTS - WITH PROVISIONS FOR ACCOMMODATING ITEMS TO BE INSTALLED
- 37. THE CONTRACTOR IS SOLELY RESPONSIBLE FOR CONSTRUCTION MEANS, METHODS, TECHNIQUES, SEQUENCES AND PROCEDURES AND FOR COORDINATING ALL PORTIONS OF THE WORK.
- 38. PROVIDE ALL REQUIRED NOTICES FOR INSPECTIONS AND APPROVALS OF THE WORK BY THE AUTHORITY HAVING JURISDICTION (AHJ). THE MOST RESTRICTIVE CODE REQUIREMENTS AS INTERPRETED BY LOCAL OFFICIALS WILL
- 39. VERIFY LOCATIONS OF EXISTING UTILITY SERVICE CONNECTIONS SERVING THE PROJECT BEFORE STARTING CONSTRUCTION. LOCATIONS OF EXISTING UTILITIES NOTED ARE APPROXIMATE, AND MAY BE BASED ON UN-VERIFIED

INFORMATION. PROVIDE ALL CONNECTIONS REQUIRED AT UTILITY CONNECTION POINTS AT NO ADDITIONAL COST TO

- 40. PROVIDE SUBCONTRACTORS WITH A FULL-SET OF THE CONSTRUCTION DOCUMENTS TO ENSURE COORDINATION BETWEEN ALL TRADES AND EACH SUBCONTRACTOR.
- 1. ALL CONSTRUCTION WORK MUST BE OF GOOD QUALITY FREE FROM DEFECTS AND IN ACCORDANCE WITH REQUIREMENTS OF THE CONSTRUCTION DOCUMENTS - OR THE WORK MAY BE CONSIDERED DEFECTIVE - AND SUBJECT TO CORRECTION OR REPLACEMENT BY THE CONTRACTOR WITHIN A PERIOD OF ONE (1) YEAR AFTER

SUBSTANTIAL COMPLETION. COORDINATION WITH SEPARATE CONTRACTORS

OWNER'S TENANT PRIOR TO BEGINNING OF THE WORK.

- 42. COORDINATE WITH THE OWNER'S SEPARATE CONTRACTORS OR SUPPLIERS FOR WORK INDICATED AS BEING OWNER-FURNISHED & CONTRACTOR INSTALLED (OFCI), OR NOT-IN-CONTRACT (NIC), PROVIDE SCHEDULED DATES WHEN THE PROJECT WILL BE READY FOR DELIVERY OR INSTALLATION OF OWNER FURNISHED PRODUCTS, AS
- 3. COORDINATE THE WORK OF THIS PROJECT WITH OTHER CONTRACTORS AT SEPARATE CONSTRUCTION PROJECTS WITHIN THE SAME DEVELOPMENT, SO THAT THIS WORK WILL NOT INTERFERE WITH OR DELAY THEIR OPERATIONS.
- 4. COORDINATE, RECEIVE AT SITE, VERIFY RECEIPT, HANDLE, STORE ON-SITE (IF REQUIRED), PROTECT AND INSTALL OWNER-FURNISHED PRODUCTS, AND PROVIDE SERVICE CONNECTIONS AS APPLICABLE.
- 5. NOTIFY THE OWNER WITHIN FIVE (5) DAYS OF RECEIPT OF ANY ITEMS THAT ARE MISSING, DAMAGED OR OTHERWISE DEFECTIVE. LACK OF NOTIFICATION WILL BE CONSIDERED PRESUMPTIVE PROOF THAT ALL ITEMS DID ARRIVE UNDAMAGED AND IN PROPER QUANTITIES, AND ANY REPLACEMENT OR REPAIRS NECESSARY WILL THEN BE THE RESPONSIBILITY OF THE CONTRACTOR.
- 46. REPAIR DAMAGE TO OWNER-FURNISHED PRODUCTS CAUSED BY CONSTRUCTION OPERATIONS TO THE OWNER'S SATISFACTION.

- 47. OBTAIN AND COMPLY WITH THE OWNER'S CONSTRUCTION RULES & REGULATIONS WHICH ARE CONSIDERED PART OF THE CONSTRUCTION DOCUMENTS BY REFERENCE. COMPLY WITH OWNER'S APPROVED DRAWINGS OF THIS PROJECT. IF APPLICABLE. MAINTAIN PRINTED COPIES AT THE SITE AND ACKNOWLEDGE RECEIPT TO THE OWNER.
- 48. PARTICIPATE IN A PRE-CONSTRUCTION MEETING WITH THE OWNER'S REPRESENTATIVE AND PROVIDE THEM
- **GENERAL DEMOLITION** 49. DEMOLITION CONTRACTOR TO COORDINATE & REVIEW ALL CONSTRUCTION DOCUMENTS & DETERMINE THE EXTENT OF DEMOLITION WORK & BECOME FAMILIAR WITH THEM THOROUGHLY BEFORE PERFORMING ANY DEMOLITION WORK. BY THE ACT OF STARTING DEMOLITION, THE CONTRACTOR WILL BE DEEMED TO HAVE COMPLIED WITH THE FOREGOING, TO HAVE ACCEPTED SUCH CONDITIONS, AND TO HAVE MADE THE NECESSARY ALLOWANCES IN PREPARING HIS BID.
- . REFER TO MECHANICAL, ELECTRICAL, & PLUMBING DRAWINGS FOR ADDITIONAL & DETAILED DEMOLITION INSTRUCTIONS.

CHASE NOTES

AND/OR INSTALLED BY OTHERS

51. PROTECT FROM DAMAGE DURING CONSTRUCTION ALL EXISTING WALLS. FLOORS, CEILINGS, ETC. THAT ARE TO REMAIN

52. IF CONTRACTOR ENCOUNTERS ANY HAZARDOUS MATERIALS DURING DEMOLITION OR CONSTRUCTION, HE SHALL

53. ALL DEMOLITION SHALL BE CARRIED OUT IN A SAFE MANNER & IN STRICT ACCORDANCE WITH OSHA REGULATIONS.

TO THE DEMOLITION AND REMOVAL OF ANY WALLS. COUNTERS, FURNITURE, BULKHEADS, DOORS, PLUMBING.

54. THE SUB-CONTRACTOR SHALL FIELD VERIFY THE EXTENT OF DEMOLITION. THE WORK INCLUDES, BUT IS NOT LIMITED

MECHANICAL AND ELECTRICAL ITEMS INCLUDING CONDUITS AND DUCTWORK AS SHOWN ON THE DRAWINGS OR AS

55. WHEN UTILITIES ARE REMOVED, CAP & SEAL A MINIMUM OF 8" BELOW FINISH FLOOR OR A MINIMUM OF 6" ABOVE FINISH

56. PROVIDE BARRIERS, FENCES AND OTHER CONTROLS TO PREVENT PUBLIC ENTRY TO CONSTRUCTION AREAS, AND TO

57. PROVIDE PROTECTION OF CONSTRUCTION MATERIALS FROM LOSS, DAMAGE, FIRE OR THEFT, AND PROTECT EXISTING

59. PROVIDE DUMPSTERS AND COLLECT WASTE DAILY. DISPOSE OF MATERIAL IN A LAWFUL MANNER. PLACE DUMPSTER IN

61. APPLICATION OF A MATERIAL OR EQUIPMENT ITEM TO WORK INSTALLED BY OTHERS CONSTITUTES ACCEPTANCE OF

THAT WORK AND ASSUMPTION OF RESPONSIBILITY FOR SATISFACTORY INSTALLATION AND PERFORMANCE.

62. INSPECT EACH ITEM OF MATERIAL OR EQUIPMENT IMMEDIATELY PRIOR TO INSTALLATION. REJECT DAMAGED AND

63. REVIEW THE OWNER'S SEPARATE CASEWORK/FIXTURES, FURNISHINGS, EQUIPMENT, & SIGNAGE DRAWINGS FOR UNIT

64. PROVIDE ALL HVAC, PLUMBING, GAS OR ELECTRIC SERVICE CONNECTIONS TO CASEWORK / FIXTURES, SIGNAGE, OR

65. VERIFY DISPOSITION OF ALL FURNISHINGS, MILLWORK, LIGHTING FIXTURES, ETC. TO BE REMOVED W/ OWNER. ALL

66. ESTABLISH AND MAINTAIN DURABLE MARKERS TO LOCATE ALL ELEMENTS OF THE WORK, INCLUDING BUT NOT LIMITED

TO PARTITIONS, CASEWORK, FIXTURES, EQUIPMENT AND LIGHT-FIXTURES, AND THEIR RELATED MECHANICAL,

67. AT PROJECTIONS OF FINISHED SURFACES, INCLUDING PILASTERS OR THICKENED WALLS, RETURN ALL EXPOSED

68. PERFORM ALL CUTTING, PATCHING AND FITTING TO ACCOMMODATE CONSTRUCTION WORK AND TO ACHIEVE THE

INTENT OF THE CONSTRUCTION DOCUMENTS. CUT & PATCH PARTITIONS FOR INSTALLATION OF PLUMBING OR

ELECTRICAL SERVICES AND FOR INSTALLATION OF WALL BLOCKING, IF NECESSARY. PROVIDE ESCUTCHEONS,

CONSTRUCTION ONLY TO STRUCTURAL ELEMENTS ABOVE - EVEN IF NOT SPECIFICALLY NOTED. DO NOT ANCHOR TO

70. JUST BEFORE OWNER OCCUPANCY. CLEAN ALL SURFACES INCLUDING FIXTURES AND EQUIPMENT FOR THE OWNER'S

USE AND OPERATION. POLISH GLASS AND PLUMBING FIXTURES TO BE WITHOUT NOTICEABLE STREAKS. VACUUM CLEAN

FLOORS AND DAMP WIPE WALLS, FIXTURES AND EQUIPMENT TO BE DUST-FREE WITHOUT STAINS, FILMS AND OTHER

REMOVE STAINS, SPILLS AND OTHER FOREIGN DEPOSITS. RAKE GROUNDS THAT ARE NEITHER PAVED NOR PLANTED,

72.1. PROVIDE MASONRY CONTROL-JOINTS AT 24 FT SPACING MAXIMUM (EVEN IF NOT NOTED), AND WHERE NOTED ON THE

73.1. PROVIDE .042 INCH (18 GA) COLD-FORMED METAL FRAMING AT 16 INCH OC AT EXTERIOR FRAMED WALLS MINIMUM, OR

74.2. PROVIDE FIRE-RETARDANT TREATED PLYWOOD BACKING AT ALL ELECTRICAL. PHONE AND SECURITY SYSTEM PANELS

74.3. PROVIDE CONCEALED WOOD BLOCKING, BRACING OR NAILERS FOR SECURE ANCHORAGE OF ALL SHELVES, RUNNING

74.4. CUT TO FIT ALL WOOD TRIM OR OTHER PREFINISHED TRIM UNITS AND FINISH ALL EXPOSED SURFACES TO MATCH

74.5. ANCHOR WOOD BLOCKING TO METAL STUD FRAMING W/ #12 TEK SCREWS @ 16" OC MAX - ANCHOR BLOCKING TO

75.1. VERIFY THAT ALL EXTERIOR FINISHED GRADES ADJACENT TO EXTERIOR WALL ARE BELOW THE FINISHED FLOOR

75.2. PROVIDE MIN 3-1/2" BATT INSULATION ON CEILINGS ABOVE AND WITHIN PARTITIONS AROUND AND BETWEEN ALL TOILET

75.3. SEAL ALL EXTERIOR BUILDING JOINTS AT BOTH THE OUTSIDE AND INSIDE SURFACES, AND OTHER OPENINGS AGAINST

75.4. PROVIDE SEALANT ALL-AROUND: DOOR OR WINDOW FRAMES, COUNTERTOPS & BACK-SPLASHES, WALL-MOUNTED

76.1. DOOR AND WINDOW DIMENSIONS NOTED ARE NOMINAL - COORDINATE WITH FIELD-CONDITIONS AND VERIFY WITH

77.2. PROVIDE BACK-TO-BACK DOUBLED .0312" (20 GA) METAL STUDS WHERE WALL-BLOCKING IS PROVIDED FOR SUPPORT

77.3. DRYWALL HEADERS: PROVIDE FRAMING @ 16" OC SUSPENDED FROM STRUCTURE ABV W/ 1 LAYER 5/8" GYP BD ON

77.4. PAINT OR STAIN FINISH ALL EXPOSED SURFACES OF CONSTRUCTION UNLESS NOTED OTHERWISE OR IF SURFACE IS

PRE-FINISHED. PROVIDE PAINT FINISH MIN AT ALL SURFACES NOT OTHERWISE INDICATED TO RECEIVE OTHER FINISH.

"RESTROOM" OR AS APPROPRIATE TO USE/TITLE OF ROOM - MOUNT 9" FROM STRIKE EDGE OF DOOR & 60 INCHES AFF

FINISH EXPOSED EDGES OR SURFACES OF CUT WOOD OR PREFINISHED TRIM TO MATCH ADJACENT SURFACES.

78.1. AT "ASSEMBLY" OCCUPANCIES PROVIDE "MAXIMUM OCCUPANCY" SIGN IN A CONSPICUOUS LOCATION AS APPROVED

78.2. ACCESSIBLE DOOR SIGN W/ RAISED LETTERS, PICTORIAL-SYMBOL & BRAILLE PLATE READING "MEN". "WOMEN".

78.3. TOWEL-DISPENSER AND WASTE RECEPTACLE AT EACH LAVATORY OR HAND SINK - PROVIDE WALL BLOCKING IF

79.1. PROVIDE WATER-SERVICE SHUTOFF-VALVE W/ BACK-FLOW PREVENTER (DOWNSTREAM OF VALVE) AT EA HOT- OR

80.1. SUBMIT SPRINKLER-SYSTEM DESIGN DRAWINGS TO AHJ AND OWNER (WHEN APPLICABLE) AND OBTAIN THEIR

81.3. MINIMUM SLOPE OF EXTERIOR PAVEMENT (WITHIN 10 FEET OF BUILDING) 2% DRAINING AWAY FROM BUILDING.

80.2. PROVIDE SEMI-CONCEALED TYPE SPRINKLER HEADS IN PUBLIC VIEW AREAS. PROVIDE STANDARD SURFACE-MTD

76.2. HARDWARE MATERIALS: PROVIDE NON-FERROUS MATERIALS AT EXTERIOR LOCATIONS.

77.1. PROVIDE 5/8" THICK GLASS-MAT GYPSUM BACKER-BOARD AT ALL PARTITIONS W/ TILE FINISH.

FIXTURES OR EQUIPMENT (INCLUDING LAVS OR SINKS) TO ADJACENT WALL SURFACES, AND OTHER SIMILAR

MOISTURE AND AIR-INFILTRATION. AT JOINTS AROUND STOREFRONT/CURTAIN WALL SYSTEMS, PROVIDE SHIM-SPACE

ELEVATION. IF NOT, PROVIDE WATERPROOF MEMBRANE WITH PROTECTION COURSE OVER EITHER

SMOOTH-SURFACED MASONRY OR CAST-IN-PLACE CONCRETE TURNED-UP FROM THE FLOOR SLAB.

TRIM, RAILINGS, SUSPENDED ITEMS, DOOR-STOPS, GRAB-BARS, AND OTHER SIMILAR WOODWORK, HARDWARE,

ADJACENT FINISHED MATERIALS. INSTALL WOODWORK WITH A MINIMUM NUMBER OF JOINTS. COPE ALL RETURNS

MITER ALL CORNERS AND USE SCARF-JOINTS AT END-TO-END CONNECTIONS (BUTT JOINTS ARE NOT ACCEPTABLE).

CMU'S OR CONCRETE WITH 1/4" TAPCONS AT MAXIMUM 16" OC. STAGGER FASTENERS WHEN BLOCKING IS WIDER THAN

74.1. PROVIDE PRESERVATIVE-TREATED WOOD WHEN WOOD IS IN DIRECT CONTACT WITH CONCRETE OR MASONRY

71. CLEAN THE PROJECT SITE OF RUBBISH, LITTER AND OTHER FOREIGN SUBSTANCES. BROOM CLEAN PAVED AREAS AND

GROMMETS AND SIMILAR SURFACE CLOSURE OR FINISHED TRIMS AT EXPOSED PENETRATIONS OF FINISHED

69. BRACE PARTITIONS, SUSPEND CEILINGS OR SOFFITS, AND BRACE PLATFORMS, SUSPENDED ITEMS OR SIMILAR

ROOF DECK, PLUMBING / SPRINKLER PIPES, DUCTWORK, ELECTRICAL CONDUIT OR SIMILAR ELEMENTS.

REFER TO GENERAL NOTES SHEETS FOR EACH PROFESSIONAL DISCIPLINE FOR ALL OTHER CONSTRUCTION

REPORT DISCREPANCIES OR OMISSIONS OF EQUIPMENT REQUIREMENTS PRIOR TO INSTALLATION.

EQUIPMENT INDICATED (WHETHER UNITS ARE INSTALLED BY CONTRACTOR OR BY OTHERS).

ITEMS TO BE DISPOSED SHALL BE DISPOSED OF OFF-SITE AND IN AN EXPEDITIOUS MANNER.

SURFACE FINISHES BACK TO THE PRIMARY SURFACE EVEN IF NOT SPECIFICALLY NOTED.

SIZES, WEIGHTS, SERVICE-CONNECTIONS AND CLEARANCES REQUIRED - WHETHER FURNISHED OR INSTALLED BY THE

CONTRACTOR OR OTHERS. VERIFY THAT REQUIRED ROUGH-INS. CONNECTIONS AND CLEARANCES WILL BE PROVIDED.

PROVIDE OPENINGS AND DELIVERY ACCESS FOR FF&E ITEMS, AND PROVIDE STAGING SPACE FOR THEIR INSTALLATION.

60. STORE PRODUCTS PER MANUFACTURER'S INSTRUCTIONS, PROTECTED FROM DAMAGE OR ABUSE, AND WITH

58. PROVIDE TEMPORARY FIRE-PREVENTION MEASURES AND PROCEDURES INCLUDING FIRE-EXTINGUISHERS PER AHJ

IMMEDIATELY SUSPEND WORK & NOTIFY THE AREA CONSTRUCTION MANAGER BEFORE PROCEEDING.

REQUIRED TO COMPLETE THE INSTALLATION OF THE NEW WORK FOR A COMPLETE JOB.

PROTECT CONSTRUCTION WORKERS AND THE PUBLIC FROM HAZARDS OF CONSTRUCTION.

CONSTRUCTION FROM DAMAGE BY CONSTRUCTION OPERATIONS.

LOCATION APPROVED BY OWNER OR LANDLORD, AS APPLICABLE.

COORDINATION WITH FIXTURES, FURNISHINGS & EQUIPMENT (FF&E)

EXISTING ADJACENT CONSTRUCTION & FINISHES

TEMPORARY FACILITIES, UTILITIES & CONTROLS

VENTILATION TO AVOID CONDENSATION.

REQUIREMENTS.

GENERAL PRODUCT REQUIREMENT

GENERAL EXECUTION OF THE WORK

FINAL CLEANING

ELECTRICAL AND PLUMBING CONNECTIONS

TO A SMOOTH EVEN-TEXTURED SURFACE.

GREATER AS NOTED ON STRUCTURAL DRAWINGS.

SPECIALTIES, ACCESSORIES, FIXTURES OR EQUIPMENT

REFINISH ALL EXPOSED CUTS AND DAMAGED WOODWORK.

AND SEALANT INSIDE AND OUTSIDE WITH BACKER-ROD.

MANUFACTURERS BEFORE FABRICATION.

77.1. DRYWALL CONTROL JOINTS: LOCATE AS NOTED.

EXPOSED SIDE(S) AND BOTTOM SURFACE.

NECESSARY FOR SECURE ATTACHMENT.

APPROVAL BEFORE STARTING WORK.

COLD-WATER CONNECTION TO EQUIPMENT (EXCEPT AT SINKS).

81.1. MAXIMUM ALLOWABLE SLOPE OF NEW PAVEMENT: 4.9% (1:21).

81.2. MAXIMUM ALLOWABLE CROSS-SLOPE OF NEW PAVEMENT: 2% (1:48).

79.2. PROVIDE SHUTOFF VALVES (STOPS), SUPPLIES AND TRAPS AT ALL LAVS OR SINKS.

SPRINKLER HEADS IN BACK AREAS NOT IN PUBLIC VIEW, UNLESS OTHERWISE NOTED.

OF GRAB-BARS OR SHELVING.

TO SIGN CENTERI INFS

80. DIVISION 21 - FIRE SUPPRESSION SYSTEM NOTES:

81. DIVISION 32 - SITE IMPROVEMENTS:

REQUIREMENTS NOT LISTED BELOW.

75. DIVISION 7 - THERMAL MOISTURE:

77. DIVISION 9 FINISHES:

78. DIVISION 10 - SPECIALTIES:

79. DIVISION 11 - EQUIPMENT:

72. DIVISION 4 - MASONRY

73. DIVISION 5 - METAL

74. DIVISION 6 - WOOD

CONTRACTOR TO PATCH & REPAIR ANY DAMAGED PORTIONS OF THE EXISTING BUILDING AS REQUIRED TO MATCH THE

- ALL WORK SHALL BE IN COMPLIANCE WITH APPLICABLE FEDERAL, STATE AND LOCAL BUILDING CODES, REGULATIONS, ORDINANCES AND STANDARDS INCLUDING ADA AND OR OTHER HANDICAP ACCESSIBILITY CODES.
- GENERAL CONTRACTOR IS RESPONSIBLE FOR COORDINATING WITH CHASE'S VENDORS REGARDING SCHEDULING ON SITE DURING CONSTRUCTION AND SEQUENCING OF THE WORK.
- THE CONSTRUCTION NOTES AND DRAWINGS ARE SUPPLIED TO ILLUSTRATE THE DESIGN INTENT AND GENERAL TYPE OF CONSTRUCTION DESIRED AND ARE INTENDED TO IMPLY THE FINEST QUALITY OF CONSTRUCTION, MATERIAL AND
- PRIOR TO COMMENCEMENT OF ANY CONSTRUCTION. CONTRACTOR SHALL VERIFY EXISTENCE AND LOCATION OF ALL EXISTING
- ABOVE AND BELOW GRADE, UTILITIES, INCLUDING SANITARY SEWER, STORM SEWER, WATER, GAS, ELECTRICAL, TELEPHONE, ETC. ANY DISCREPANCIES IN UTILITY LOCATIONS SHALL BE BROUGHT TO THE IMMEDIATE ATTENTION OF THE ARCHITECT. ALL PENETRATIONS SHALL RECEIVE CAULKING TO SEAL ANY TYPE OF ENERGY LOSS.
- THE CONTRACTOR SHALL VERIFY AND COORDINATE ALL APPLICABLE DIMENSIONS OF FIXTURES AND EQUIPMENT SUPPLIED
- UPON COMPLETION OF PROJECT, G.C. TO OBTAIN ALL FINAL INSPECTIONS AS REQUIRED BY LOCAL JURISDICTIONS AND FURNISH CHASE WITH EVIDENCE OF ALL SUCH INSPECTIONS AND CERTIFICATES OF OCCUPANCY.
- SIGNS, UNLESS NOTED OTHERWISE, ARE PROVIDED BY CHASE'S SIGN CONTRACTOR. GENERAL CONTRACTOR TO PROVIDE
- ROUGH-IN & FINAL CONNECTION AND BRAILLE EXIT SIGN. GENERAL CONTRACTOR TO PROVIDE FOUR (4) 30 YARD DUMPSTERS DURING CHASE RETAIL MOVE-IN.
- . GENERAL CONTRACTOR SHALL PROVIDE ONE SKILLED LABORER FOR ONE WEEK DURING CHASE RETAIL MOVE-IN. (40 HOURS) GENERAL CONTRACTOR TO MAINTAIN SUPERINTENDENT AVAILABILITY DURING ENTIRE WEEK OF RETAIL MOVE-IN TO ASSIST
- 1. GENERAL CONTRACTOR SHALL BE RESPONSIBLE FOR SET-UP AND COORDINATION OF ALL THE UTILITY SERVICES FOR THE

FURNISHED/ | FURNISHED/ | FURNISHED | COORDINATED

INICTALLED BY INICTALLED BY

- 12. GENERAL CONTRACTOR TO PROVIDE FINAL KEYING ON DAY OF TURNOVER PER CHASE KEYING GUIDELINES.
- 13. REFER TO "PROJECT MANUAL" FOR ALL OTHER INSTRUCTIONS & DIRECTIVES NOT SHOWN IN DRAWINGS.

RESPONSIBILITY MATRIX

	INSTALLED BY CHASE'S EQUIPMENT CONTRACTOR	INSTALLED BY GENERAL CONTRACTOR	BY CHASE/ INSTALLED BY GENERAL CONTRACTOR	BY GENERAL CONTRACTOR (YES/NO)
EXTERIOR BLDG. SIGNAGE (SEE NOTE 4)	X			YES
ATM - WALK OR DRIVE-UP (SEE NOTE 3)	Х			YES
NIGHT DEPOSITORY	Х			YES
MERCHANT AND TELLER LINE COUNTERS	Х			YES
TELLER CASH DISPENSERS	Х			YES
UNDER COUNTER BANK EQUIPMENT	Х			YES
FURNITURE	Х			YES
DIGITAL DISPLAYS	Х			YES
EMPLOYEE LOCKERS	Х			YES
TELECOMMUNICATIONS	Х			YES
DATA PROCESSING	Х			NO
SECURITY SYSTEM (SEE NOTE 5)	REFER TO SEC	URITY DRAWING F	OR RESPONSIBILIT	IES
COPY MACHINE	Х			NO
INTERIOR BLDG. SIGNAGE (SEE NOTE 4)	Х			NO
TEMPORARY CONSTRUCTION SIGN	Х			YES
TOILET ROOM SIGNS & ALL ACCESSORIES		Х		YES
MOTORIZED & MANUAL SHADES		Х		YES
CARPET TILE & RESILIENT FLOORING		Х		YES
VESTIBULE WALK OFF MAT		Х		YES
FLOORING		Х		YES
MILLWORK		Х		YES
PAINTING & WALL COVERING		Х		YES
MICROWAVE AND REFRIGERATOR		Х		YES
PERMANENT CORES/KEYING		Х		NO
WASTE CONTAINER (EXT.)		Х		YES
UTILITIES & FIRE PROTECTION SERVICES		Х		YES
DOOR HARDWARE		Х		YES
MUZAK SOUND SYSTEM	Х			YES
AREA RUGS		Х		YES
MAILBOX (SEE NOTE 6)		Х		YES
BICYCLE RACK		Х		YES
MONUMENT SIGN (SEE NOTE 7)	Х			YES

- FOR OWNER'S EQUIPMENT GENERAL CONTRACTOR TO PROVIDE REQUIRED OPENINGS, ACCESS PANELS, AND ELECTRICAL REQUIREMENTS (INCLUDING FINAL HOOK-UP).
- MILLWORK ITEMS. GENERAL CONTRACTOR TO PROVIDE "BACK OF STORE" MILLWORK WHICH INCLUDES BASE AND WALL CABINETS, WORK COUNTERS AND SHELVING.
- ATM BUILDING, ATM SURROUNDS. GENERAL CONTRACTOR TO PROVIDE POWER & CONDUITS. SIGNAGE TO INCLUDE DIRECTIONAL SIGNAGE, AND MAIN BUILDING LETTER SET. GENERAL CONTRACTOR TO PROVIDE
- CONDUIT. ROUGH-IN & FINAL ELECTRICAL CONNECTIONS. ELECTRONIC SECURITY SYSTEM INCLUDING ALARM AND CCTV. GENERAL CONTRACTOR TO PROVIDE CONDUITS. POWER
- AND PLYWOOD AT DATA ROOM. REFER TO SECURITY PLAN FOR ITEMS TO BE ACCOMMODATED IN GENERAL CONTRACTORS BASE BID.
- FINAL LOCATION DETERMINED BY BRANCH PLANNING.
- MONUMENT SIGN FOUNDATION/MASONRY BY CONSULTANT'S SIGN VENDOR. ELECTRICAL BY GENERAL CONTRACTOR. . EQUIPMENT CONTRACTOR IS A SUBCONTRACTOR OF THE OWNER.

ALL DIMENSIONS ARE FROM SUBSTRATE TO SUBSTRATE OR FACE OF MASONRY, U.N.O.


NOTIFY THE ARCHITECT OF ANY DISCREPANCIES PRIOR TO BEGINNING CONSTRUCTION.

DO NOT SCALE DRAWINGS. CONTRACTOR TO VERIFY ALL EXISTING CONDITIONS AND DIMENSION.

- 9. GENERAL CONTRACTOR TO FURNISH QUANTITY TAKEOFF INCLUDING 10% ATTIC STOCK



COA #: A-2014026908 ARCHITECT OF RECORD

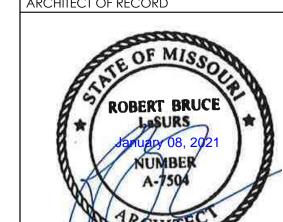

ARCHITECT: R. BRUCE LASURS LICENSE NUMBER: 007504

HESE DRAWINGS ARE NOT COMPLETE WITHOUT THE SEPARATE TYPE WRITTEN SPECIFICATIONS MANUAL WHICH ARE PART OF THE CONTRACT DOCUMENTS.

DESCRIPTION

2020.12.21 | PERMIT SET

PROJECT INFORMATION PROJECT NO: JPM.27135.001

C.THEBEAU CHECKED BY: **B.LaSURS VERSION:** SE 1.00 SHEET TITLE GENERAL NOTES, RESPONSIBILITY SCHEDULE,


2020.12.2

DRAWING CONVENTIONS. & ABBREVIATIONS

SHEET NUMBER

PROTOTYPE

DRAWN BY:

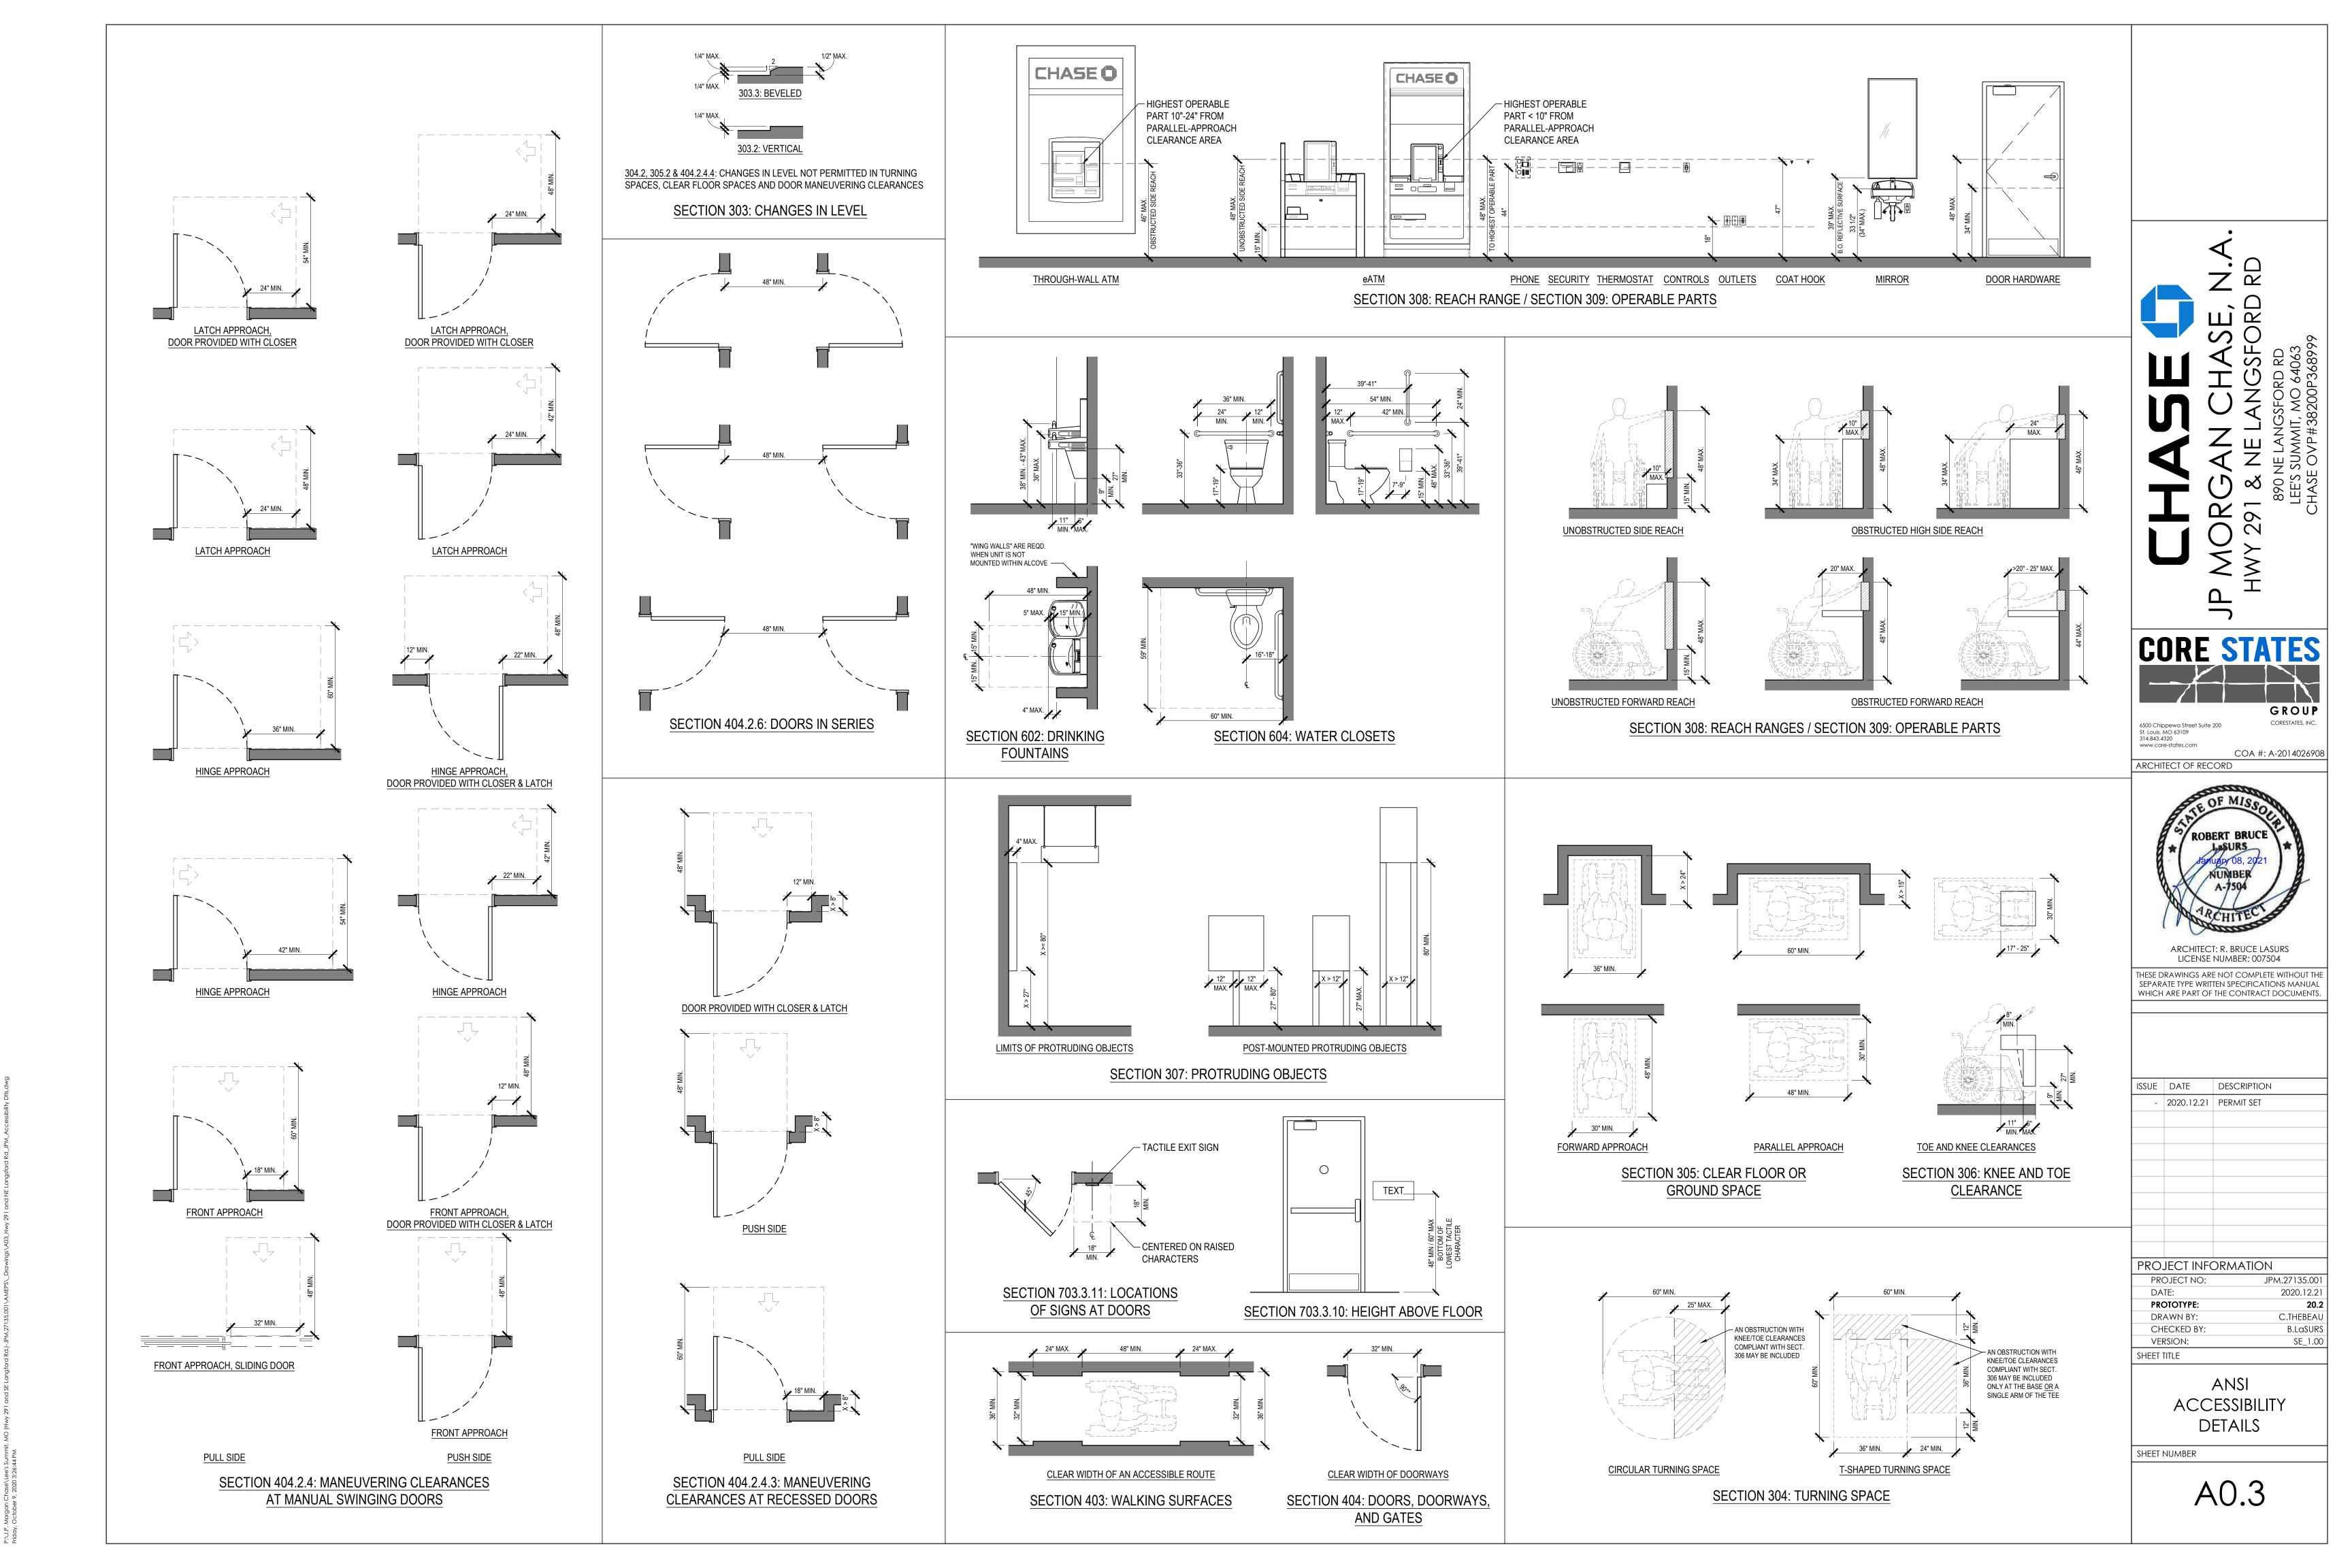


System No. W-L-1001

June 15, 2005

F.Ratings - 1, 2, 3 and 4 Hr (See Items 2 and 3)

T Ratings - 0, 1, 2, 3, and 4 Hr (See Item 3)

L Rating At Ambient - less than 1 CFM/sq ft

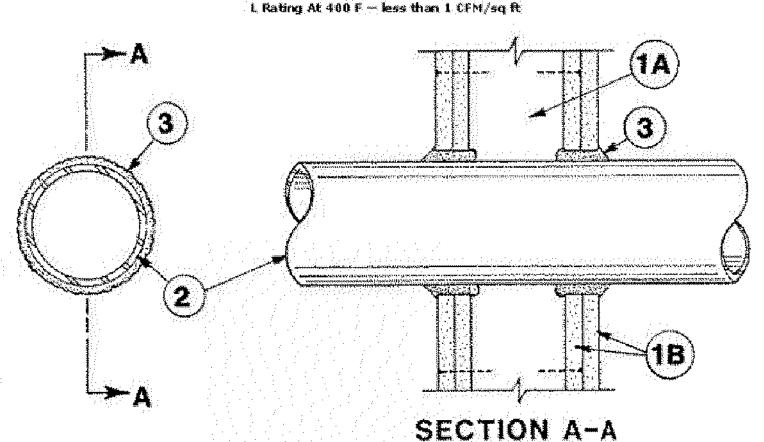

1. Wall Assembly — The 1, 2, 3 or 4 hr fire-rated gypsion walkoard/stud wall assembly shall be constructed of the materials and in the manner described in the individual U300 or U400 Series Wall or Partition Designs in the UL Fire Resistance Directory and shall believe the following construction features:

> A. Stude - Wall framing may consist of either mood stude (max 2 h fire rated assembles) or stude channel strate. Wood strate to consist of norm 2 by 4 in. (\$1 by 102 mm) lumber spaced 16 in. (405 mm) OC with norm 2 by 4 m. (51 by 102 mm) tumber and plates and cross braces. Steel stude to be min 3-5/8 in. (92 mm) wide by 1-3/8 in. (35 mm) deep channels spaced max 24 in.

B. Gypsum Boards - Nom 1/2 or 5/2 in. (13 or 16 mm) thick, 4 ft. (122 cm) wide with square or tagered edges. The gypoum wallboard type, thickness, number of layers, fastener type and sheet orientation shelf be as specified in the individual U300 or U400 Series Design in the UL Fire Resistance Directory. Max diam of opening is 26 in. (660 mm).

2. Through-Penatrant — One metalic pipe, conductor tubby installed ether concentrally or accentrically within the firestop system. The annular space between pipe, conduit or tubing and periphery of opening shall be min of O in / (O mm). (point contact) to max 2 in (51 mm) Pipe, conduit or tubing to be rightly supported on both sides of wall assembly. The following types and sizes of metalic pipes, conduits or tubing may be used:

A Steel Pipe - Norw 24 in. (610 mm) dam (or smaller) Schedule 10 (or heavier) steel pipe.

B. Draw Piec - Nom 24 in (610 mm) dam (or smaler) service weight (or heavier) cast fron sol ope, nom 12 in (305 mm) diam for smaler) or Class 50 (or heaver) ductile for pressure spe-

C. Conduit - Nom S in: (152 mm) dam (or smaller) steel conduit or nom 4 in (102 mm) dam (or

smaller) steel electrical metalic tubing

O. Copper Tubing - Nom 5 in. (152 mm) diam (or smaler) Type L (or heavier) copper tabing

E. Copper Pipe — Warn 6 in. (152 mm) dam (or smaler) Regular (or heavier) copper size.

F. Through Penetrating Products — Fixable Metal Phing The following types of steel flexible metal gas gong may be used:

1. Nom 2 in (S1 mm) diam (or smaler) steel fier bis metal gas piping. Plastic covering on plang

may or may not be removed on both sides of hoor or wall assembly. OMEGA PLEX INC

2. Nom 1 in (25 mm) dam (or smaler) steel feath metal gas piping. Plastic covering on plang may or may not be removed on both sides of floor or wall assembly.

GASTITE, DIV OF TITEFLEX I. No m I in (IS mm) diam (or smaler) steel flexible metal gas piping. Plastic covering on piping. may or may not be removed on both sides of floor or wall assembly.

WARD MFGLLC

3. Fill Vold or Cavity Material? — Casit or Sealant — Min 5/8. , 1-1/4.1-7/6 and 2-1/2 in (16, 32, 46 and 64 mm) thickness of casis, for 1, 2, 2 and 4 hr rated assembles, respectively, applied within annulus, such with both surfaces of wall Min 1/4 in (6 mm) diam bead of caulk applied to gypsum board/penetrant interface at point contact location on both sides of wall. The hourly F Rating of the Brestop system is dependent upon the bourly fire rating of the wall assembly in which it is installed, as shown in the following table. The hously Il Rating of the frestop system is dependent upon the type or size of the pipe or conduct and the hously fire rating of the wall assembly in which it is installed, as tabulated below:

Hax Pipe or Conduit Olum In (mm)	Ruling Hi	r Ratiog He
1(25)	1002	0+.1002
1(25)	3 of 4	ior#
4 (102)	1802	Ġ
6 (152)	3 55 4	
12 (305)	larz	

4 When copper pipe is used, T Rating is 0 h.

BH COMPANY - CP 25WB+ or PS-3000 WT.

* Indicates each products shall bear the UL or cUL Certification Plank for jurisdictions employing the UL or cUL Certification (such as Canada), respectively.


UL U419 1-HR RATED ASSEMBLY

Through-penetration Firestop Systems

See General Information for Through-penetration Firestop Systems

System No. W-L-7005 October 31, 2006

F Rating - 2 Hr

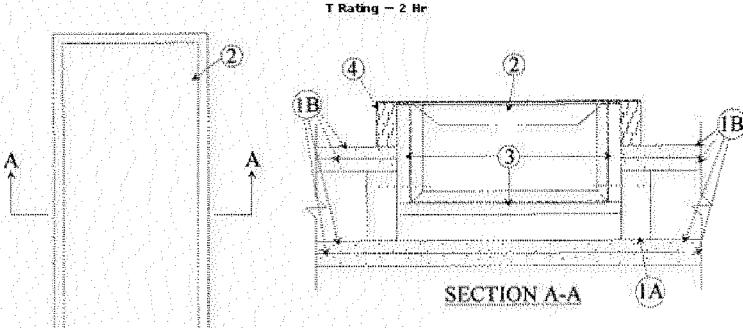

1. Wall Assembly - The fire-rated gypsum wasboard/stud wall assembly shall be constructed of the materials and in the manner specified in the individual U300 or U400 Series Wall and Partition Designs in the UL Fire Resistance Directory and shall ackule the following construction features:

> A: Stude - Wall framing may consist of wood stude or steel channel stude. Wood stude to consist of nom 2 by 4 in, lumber spaced 16 in, OC. Steel studs to be min 3-5/8 in, wide and spaced max 24 in OC. When aluminum trim is used with cabinets, the wall opening shall be framed on all sides using lengths of study installed between vertical study and attached to the study at each end.

B. Gypsum Board* - Two layers of norm 5/8 in: thick gypsum wallboard, as specified in the individual Wall and Partition Design.

2. Cabineta* - Fire extraorisher cabinet installed per manufacturers installation instructions in max 33-3/4 by 17-3/4 in. opening on one side of the well. Max gap between cabinet and walloard shall be 1/8 in.

MODERN METAL PRODUCTS - Models Nos. 101R-1, 101SR-2, 101SR-3.5, 102R-1, 102SR-2, 102SR-3, 102(6)R-1. 102(6)SR-2, 102(6)SR-3, 102(6)SR-4, 104R-1, 104SR-2, 104SR-3, 104SR-4, 105R-1, 105SR-2, 105SR-3, 105SR-4, 106SR-1, 106SR-2, 106SR-3, 106SR-4, 118R-1, 116SR-2, 118SR-3, 120R-1, 120SR-2, 120SR-3, 145R-1, 145SR-3, 147R-1, 147SR-3, 180R-1, 180SR-2, 180SR-3, 184R-1, 184SR-2, 184SR-3, 184SR-4, 186R-1, 186SR-2, 186SR-3, 18658-4

3. Gypsum Board* - Any 5/8 in thick gypsum walloard bearing the UL Classification Marking as to Fire Resistance. Gypsum wallboard installed in the fire extinguisher cabinets (Item 2) per manufacturers installation instructions. See **Gypsum Board** category for names of manufacturers.

4. Nimerall Wool - May 4.0 pcf mineral wool bats insulation firmly packed inside cabinet trans.

* Indicates such products shall bear the UL or cUL Certification Mark for jurisdictions employing the UL or cUL Certification (such as Canada), respectively.


THROUGH-PENETRATION FIRESTOP SYSTEM W-L-7005

A0.4 / N.T.S.

Design No. U419

February 19, 2013

Nonbearing Wall Ratings — 1, 2, 3 or 4 Hr (See Items 4 & 5)

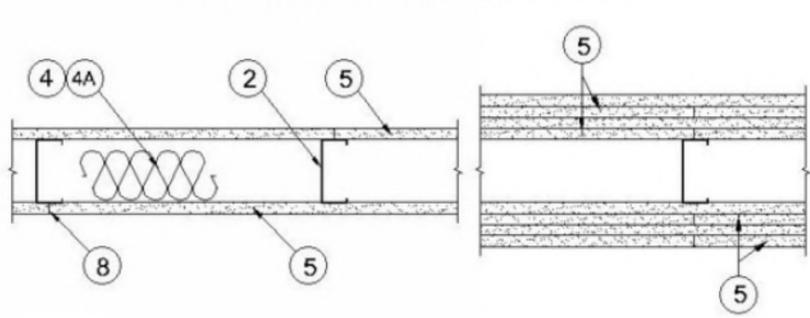

oriented strand board (OSB) or 15/32 in. thick structural 1 sheathing (plywood) complying with DOC PS1 or PS2, or APA Standard PRP-108, manufactured with exterior glue, applied horizontally or vertically to the steel studs. Vertical joints centered on studs, and staggered one stud space from wallboard joints. Attached to studs with flat-head self-drilling tapping screws with a min. head diam. of 0.292 in. at maximum 6 in. OC. in the perimeter and 12 in. OC. in the field. When used, fastener lengths for gypsum panels increased by min. 1/2 in.

4. Batts and Blankets* - (Required as indicated under Item 5) - Mineral wool batts, friction fitted between studs and runners. Min nom thickness as indicated under Item 5. See Batts and Blankets (BKNV or BZJZ) Categories for names

3. Wood Structural Panel Sheathing — (Optional, For use with Item 5 Only.)- (Not Shown) - 4 ft wide, 7/16 in. thick

 Floor and Ceiling Runners — (Not shown) — For use with Item 2 - Channel shaped, fabricated from min 25 MSG corrosion-protected steel, min depth to accommodate stud size, with min 1-1/4 in. long legs, attached to floor and ceiling

2. Steel Studs — Channel shaped, fabricated from min 25 MSG corrosion-protected steel, min depth as indicated under

Item 5, spaced a max of 24 in. OC. Studs to be cut 3/8 to 3/4 in. less than assembly height.

with fasteners 24 in. OC max.

of Classified companies.

4A. Batts and Blankets* — (Optional) — Placed in stud cavities, any glass fiber or mineral wool insulation bearing the UL Classification Marking as to Surface Burning Characteristics and/or Fire Resistance. See Batts and Blankets (BKNV or BZJZ) Categories for names of Classified companies.

 Gypsum Board* — Gypsum panels with beveled, square or tapered edges, applied vertically or horizontally. Vertical joints centered over studs and staggered one stud cavity on opposite sides of studs. Vertical joints in adjacent layers (multilayer systems) staggered one stud cavity. Horizontal joints need not be backed by steel framing. Horizontal edge joints and horizontal butt joints on opposite sides of studs need not be staggered. Horizontal edge joints and horizontal butt joints in adjacent layers (multilayer systems) staggered a min of 12 in. The thickness and number of layers for the 1 hr, 2 hr. 3 hr and 4 hr ratings are as follows:

Gypsum Board Protection on Each Side of Wall

Rating, Hr	Min Stud Depth, in. Items 2, 2D, 2E, 2G and 2H	Min Stud Depth, in. Item 2A	No. of Layers & Thkns of Panel	Min Thkns of Insulation (Item 4)
1	3-1/2	3-5/8	1 layer, 5/8 in. thick	Optional
1	2-1/2	3-5/8	1 layer, 1/2 in. thick	1-1/2 in.
1	1-5/8	3-5/8	1 layer, 3/4 in. thick	Optional
2	1-5/8	2-1/2	2 layers, 1/2 in. thick	Optional
2	1-5/8	2-1/2	2 layers, 5/8 in. thick	Optional
2	3-1/2	3-5/8	1 layer, 3/4 in. thick	3 in.
3	1-5/8	2-1/2	3 layers, 1/2 in. thick	Optional
3	1-5/8	2-1/2	2 layers, 3/4 in. thick	Optional
3	1-5/8	2-1/2	3 layers, 5/8 in. thick	Optional
4	1-5/8	2-1/2	4 layers, 5/8 in. thick	Optional
4	1-5/8	2-1/2	4 layers, 1/2 in. thick	Optional
4	2-1/2	2-1/2	2 layers, 3/4 in. thick	2 in.

6. Fasteners — (Not shown) — For use with Items 2 and 2F - Type S or S-12 steel screws used to attach panels to stude (Item 2) or furring channels (Item 7). Single layer systems: 1 in. long for 1/2 and 5/8 in. thick panels or 1-1/4 in. long for 3/4 in. thick panels, spaced 8 in. OC when panels are applied horizontally, or 8 in. OC along vertical and bottom edges and 12 in. OC in the field when panels are applied vertically. Two layer systems: First layer- 1 in. long for 1/2 and 5/8 in. thick panels or 1-1/4 in. long for 3/4 in. thick panels, spaced 16 in. OC. Second layer- 1-5/8 in. long for 1/2 in., 5/8 in. thick panels or 2-1/4 in. long for 3/4 in. thick panels, spaced 16 in. OC with screws offset 8 in. from first layer. Three-layer systems: First layer- 1 in. long for 1/2 in., 5/8 in. thick panels, spaced 24 in. OC. Second layer- 1-5/8 in. long for 1/2 in., 5/8 in. thick panels, spaced 24 in. OC. Third layer- 2-1/4 in. long for 1/2 in., 5/8 in. thick panels or 2-5/8 in. long for 5/8 in. thick panels, spaced 12 in. OC. Screws offset min 6 in. from layer below. Four-layer systems: First layer- 1 in. long for 1/2 in., 5/8 in. thick panels, spaced 24 in. OC. Second layer- 1-5/8 in. long for 1/2 in., 5/8 in. thick panels, spaced 24 in. OC. Third layer- 2-1/4 in. long for 1/2 in. thick panels or 2-5/8 in. long for 5/8 in. thick panels, spaced 24 in. OC. Fourth layer- 2-5/8 in. long for 1/2 in. thick panels or 3 in. long for 5/8 in. thick panels, spaced 12 in. OC. Screws offset min 6 in. from layer below.

7. Furring Channels — (Optional, not shown, for single or double layer systems) — Resilient furring channels fabricated from min 25 MSG corrosion-protected steel, spaced vertically a max of 24 in. OC. Flange portion attached to each intersecting stud with 1/2 in. long Type S-12 steel screws. Not for use with Item 5A and 5E.

8. Joint Tape and Compound — Vinyl or casein, dry or premixed joint compound applied in two coats to joints and screw heads of outer layers. Paper tape, nom 2 in. wide, embedded in first layer of compound over all joints of outer layer panels. Paper tape and joint compound may be omitted when gypsum panels are supplied with a square edge.

 Siding, Brick or Stucco — (Optional, not shown) — Aluminum, vinyl or steel siding, brick veneer or stucco, meeting the requirements of local code agencies, installed over gypsum panels. Brick veneer attached to studs with corrugated metal wall ties attached to each stud with steel screws, not more than each sixth course of brick.

 Caulking and Sealants* — (Optional, not shown) — A bead of acoustical sealant applied around the partition perimeter for sound control.

 Lead Batten Strips — (Not Shown, For Use With Item 5B) - Lead batten strips, min 1-1/2 in. wide, max 10 ft long with a max thickness of 0.125 in. Strips placed on the interior face of studs and attached from the exterior face of the stud with two 1 in. long Type S-12 pan head steel screws, one at the top of the strip and one at the bottom of the strip. Lead batten strips to have a purity of 99.9% meeting the Federal specification QQ-L-201f, Grade "C". Lead batten strips required behind vertical joints of lead backed gypsum wallboard (Item 5B) and optional at remaining stud locations. Required behind


11A. Lead Batten Strips — (Not Shown, For Use With Item 5H) Lead batten strips, 2 in. wide, max 10 ft long with a max thickness of 0.140 in. Strips placed on the face of studs and attached to the stud with two min. 1 in. long min. Type S-8 pan head steel screws, one at the top of the strip and one at the bottom of the strip or with one min. 1 in. long min. Type S-8 pan head steel screw at the top of the strip. Lead batten strips to have a purity of 99.9% meeting the Federal specification QQ-L-201f, Grades "A, B, C or D". Lead batten strips required behind vertical joints of lead backed gypsum wallboard and optional at remaining stud locations.

12. Lead Discs or Tabs — (Not Shown, For Use With Item 5B) - Used in lieu of or in addition to the lead batten strips (Item 11) or optional at other locations - Max 3/4 in. diam by max 0.125 in. thick lead discs compression fitted or adhered over steel screw heads or max 1/2 in. by 1-1/4 in. by max 0.125 in. thick lead tabs placed on gypsum boards (Item 5B) underneath screw locations prior to the installation of the screws. Lead discs or tabs to have a purity of 99.9% meeting the Federal specification QQ-L-201f, Grade "C".

12A. Lead Discs - (Not Shown, for use with Item 5H) Max 5/16 in. diam by max 0.140 in. thick lead discs compression fitted or adhered over steel screw heads. Lead discs to have a purity of 99.9% meeting the Federal Specification QQ-L-201f, Grades "A, B, C or D".

13. Lead Batten Strips — (Not Shown, For Use With Item 5E) Lead batten strips, 2 in. wide, max 10 ft long with a max thickness of 0.142 in. Strips placed on the face of studs and attached to the stud with two min. 1 in. long min. Type S-8 pan head steel screws, one at the top of the strip and one at the bottom of the strip or with one min. 1 in. long min. Type S-8 pan head steel screw at the top of the strip. Lead batten strips to have a purity of 99.9% meeting the Federal specification QQ-L-201f, Grade "C". Lead batten strips required behind vertical joints of lead backed gypsum wallboard (Item 5E) and optional at remaining stud locations.

14. Lead Tabs - (Not Shown, For Use With Item 5E) 2 in. wide, 5 in. long with a max thickness of 0.142 in. Tabs frictionfit around front face of stud, the stud folded back flange, and the back face of the stud. Tabs required at each location where a screw (that secures the gypsum boards, Item 5E) will penetrate the steel stud. Lead tabs to have a purity of 99.9% meeting the Federal specification QQ-L-201f, Grade "C". Lead tabs may be held in place with standard adhesive tape if necessary.

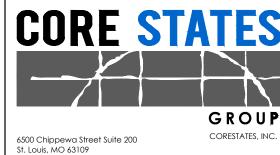

St. Louis, MO 63109 314.843.4320

COA #: A-2014026908

ARCHITECT OF RECORD ROBERT BRUCE LaSURS_

> ARCHITECT: R. BRUCE LASURS LICENSE NUMBER: 007504

HESE DRAWINGS ARE NOT COMPLETE WITHOUT THE SEPARATE TYPE WRITTEN SPECIFICATIONS MANUAL WHICH ARE PART OF THE CONTRACT DOCUMENTS.

DESCRIPTION ISSUE DATE 2020.12.21 PERMIT SET

PROJECT INFORMATION PROJECT NO: JPM.27135.001 2020.12.21 **PROTOTYPE** DRAWN BY: S.KRAMER


B.LaSURS

SE 1.00

CHECKED BY: VERSION: SHEET TITLE

SHEET NUMBER

UL LISTING

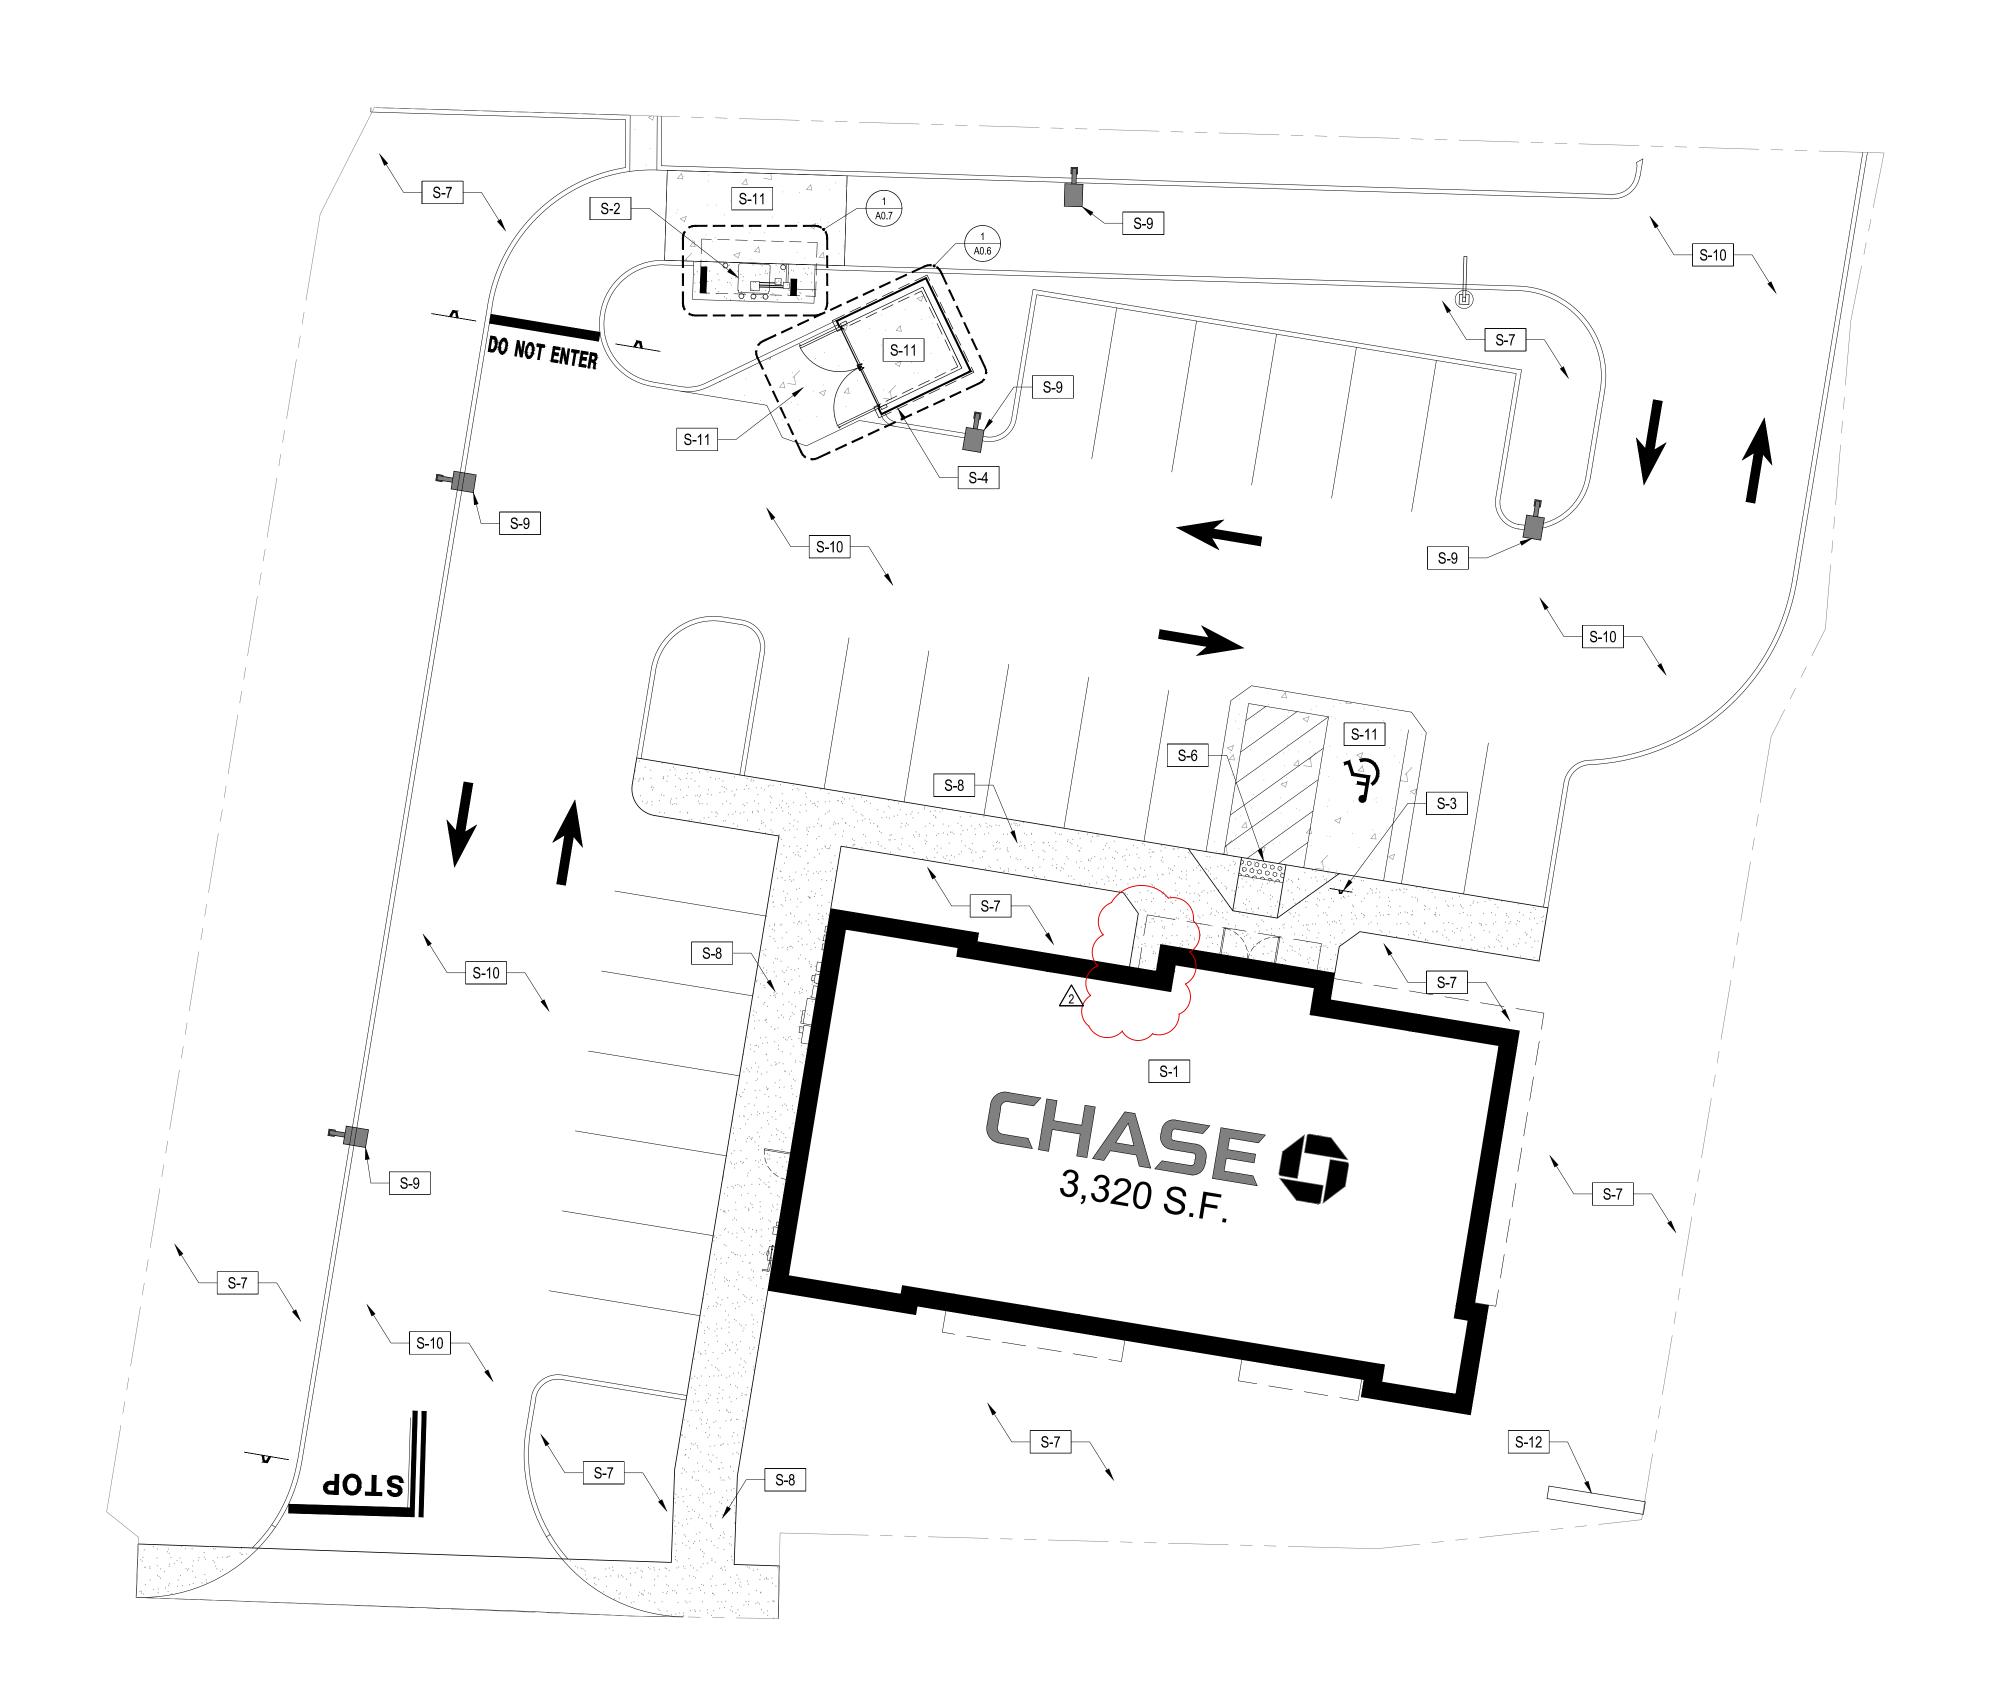

GENERAL SITE PLAN NOTES

A SEE CIVIL DRAWINGS FOR BUILDING SETBACKS, DRAINAGE, PAVING, AND GRADING INFORMOATION - SETBACKS AMENDED PER HEARING.

SITE PLAN KEYNOTES

S-1 PROPOSED 3,320 SF CHASE BANK

S-2 PROPOSED DRIVE-UP ATM

S-3 PROPOSED ACCESSIBLE PARKING SIGN

S-4 PROPOSED TRASH ENCLOSURE

S-5 PROPOSED BIKE RACKS-6 PROPOSED DETECTABLE WARNING DEVICE

S-7 PROPOSED GRASS/LANDSCAPED AREAS

S-8 PROPOSED CONCRETE SIDEWALKS-9 PROPOSED SITE LIGHTING

S-10 PROPOSED ASPHALT


S-11 PROPOSED HEAVY DUTY CONCRETE PAD
S-12 PROPOSED MONUMENT SIGN

JP MORGAN CHASE, N.A HWY 291 & NE LANGSFORD RD 890 NE LANGSFORD RD



uis, MO 63109 43.4320 core-states.com COA #: A-2014026908

ARCHITECT OF RECORD

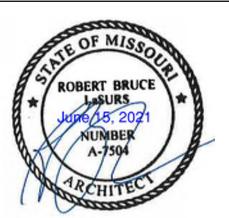

ARCHITECT: R. BRUCE LASURS LICENSE NUMBER: 007504

THESE DRAWINGS ARE NOT COMPLETE WITHOUT THE SEPARATE TYPE WRITTEN SPECIFICATIONS MANUAL WHICH ARE PART OF THE CONTRACT DOCUMENTS.

ISSUE	DATE	DESCRIPTION
-	2020.12.21	PERMIT SET
1	2021.04.20	STRUCTURAL STEEL REV
2	2021.06.03	PLAN REVIEW COMMENTS, RDC21 & WIRELESS UPDATE


PRO.	JECT INFO	ORMATION	
PRO	DJECT NO:	JP	M.27135.00
DA	TE:		2020.12.2
PRC	OTOTYPE:		20.
DR.	AWN BY:		C.THEBEA
CH	ECKED BY:		B.LaSUR
VEF	RSION:		SE_1.0
SHEET 1	TITI F		

ARCHITECTURAL SITE PLAN


SHEET NUMBER

A0.5

1 ARCHITECTURAL SITE PLAN
A0.5 3/32" = 1'-0"

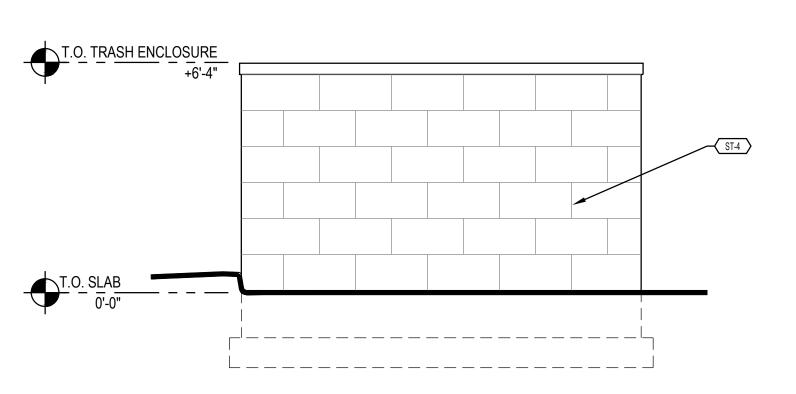

TRASH ENCLOSURE - SOUTH ELEVATION 3/8" = 1'-0"

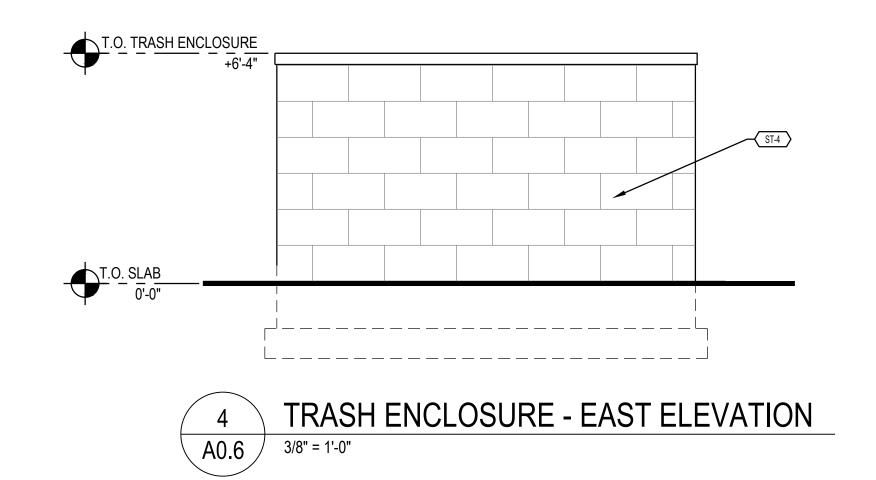

HOT-DIPPED GALV. STEEL L

IN C.M.U. COURSING -BARREL HINGE WELDED TO

EMBEDDED ANGLE AND

BOLTED TO GATE FRAME -

A0.6

1 1/2" = 1'-0"

PRIMED L 2" x 2" x 3/8" STEEL ANGLE GATE FRAME- PAINT TO MATCH E.I.F.S. / STUCCO —

3 1/2" x 3 1/2" x 12" EMBEDDED

GROUT C.M.U. CORES SOLID

ABOVE AND BELOW EMBEDDED ANGLE

8" #4 REBAR WELDED TO

EMBEDDED ANGLE HORIZ.

- CUT EMBEDDED ANGLE HORIZ. LEG TO HOLD BACK FROM MASONRY, E.I.F.S. OR STUCCO

FLANGE TOP & BOTTOM

1/2" COMPRESSIBLE FILLER

CONCRETE CURB

FINISH

STAINLESS STEEL TUBE AS REQD. EMBEDDED IN ASPHALT- POSITION TO RECEIVE CANE BOLT WITH

MFD. STONE VENEER COPING W/ WASH

EPOXY-SET ON STAINLESS STEEL PINS

RUBBERIZED ASPHALT THROUGH-WALL FLASHING WITH STAINLESS STEEL DRIP

STONE VENEER (ST-4) - REFER TO SHEET
A3.3.2 MORE INFORMATION

ALL EXPOSED STEEL COMPONENTS SHALL BE HOT-DIPPED GALVANIZED, PRIMED AND PAINTED

8" NOM. C.M.U.- REFER TO STRUCTURAL ENGINEERING DRAWINGS

ENGINEERING DRAWINGS —

T.O. CONCRETE CURB- REFER TO CIVIL

REINFORCED CONCRETE FOUNDATION AND FOOTING- REFER TO STRUCTURAL


STEEL ANGLE / PLATE AS REQD. FOR CASTER MOUNTING —


1/2" COMPRESSIBLE FILLER

TRASH ENCLOSURE - SECTION


REINFORCED CONCRETE SLAB ON
COMPACTED GRANULAR BASE- REFER
TO CIVIL ENGINEERING DRAWINGS

TRASH ENCLOSURE - CORNER DETAIL

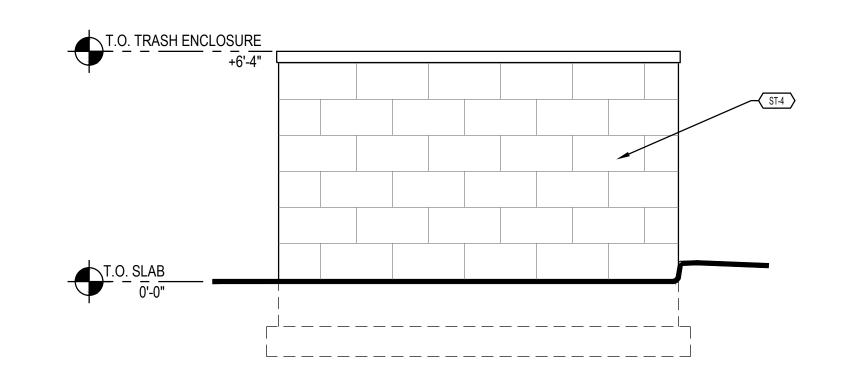


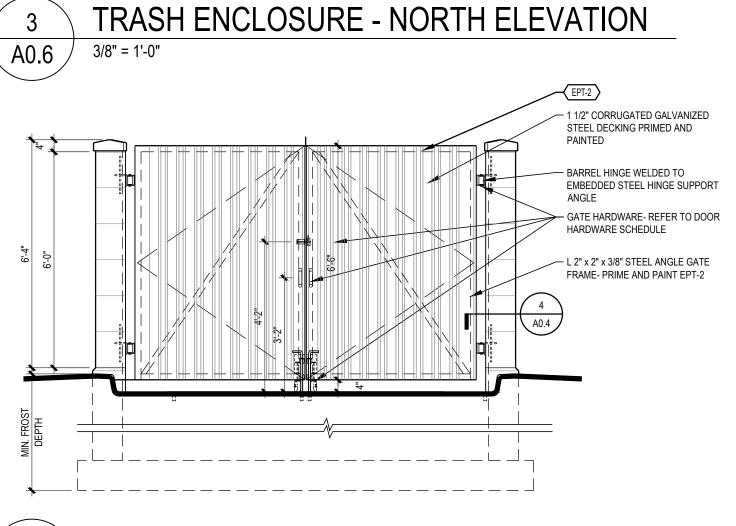

TRASH ENCLOSURE - WEST ELEVATION

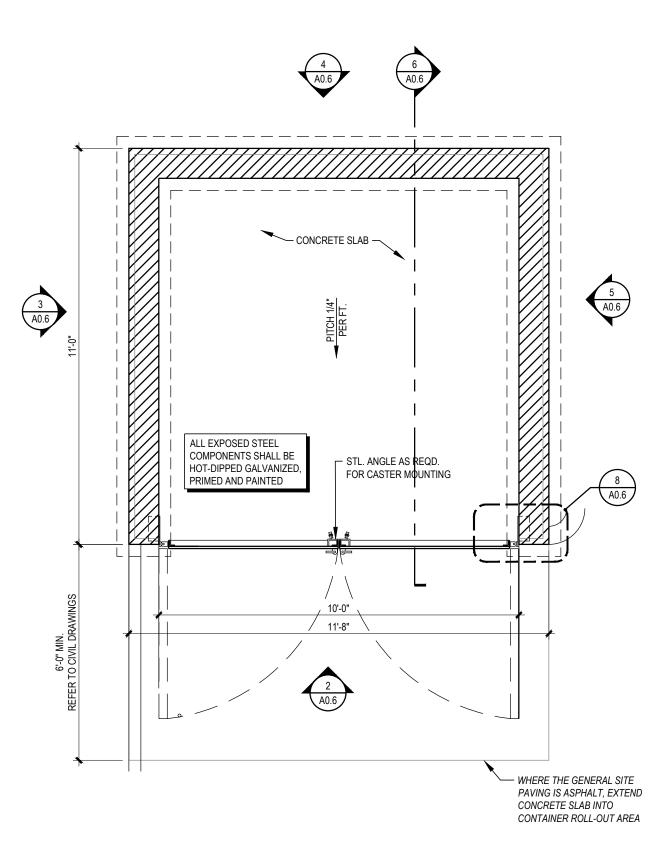


TRASH ENCLOSURE - PLAN A0.6 3/8" = 1'-0"

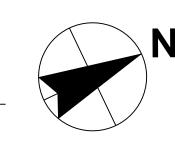





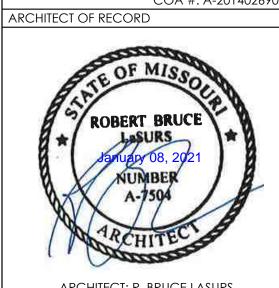

ARCHITECT: R. BRUCE LASURS LICENSE NUMBER: 007504 THESE DRAWINGS ARE NOT COMPLETE WITHOUT THE SEPARATE TYPE WRITTEN SPECIFICATIONS MANUAL WHICH ARE PART OF THE CONTRACT DOCUMENTS.

ISSUE	DATE	DESCRIPTION
-	2020.12.21	PERMIT SET


PRO.	JECT INFO	ORMATION		
PRO	DJECT NO:	JP	M.27135.00)]
DA	TE:		2020.12.2	21
PRC	OTOTYPE:		20	.2
DR	AWN BY:		C.THEBEA	U
СН	ECKED BY:		B.LaSUF	₹S
VEF	rsion:		SE_1.0)()
HEET 1	TITLE			

TRASH ENCLOSURE DETAILS

SHEET NUMBER

A0.6



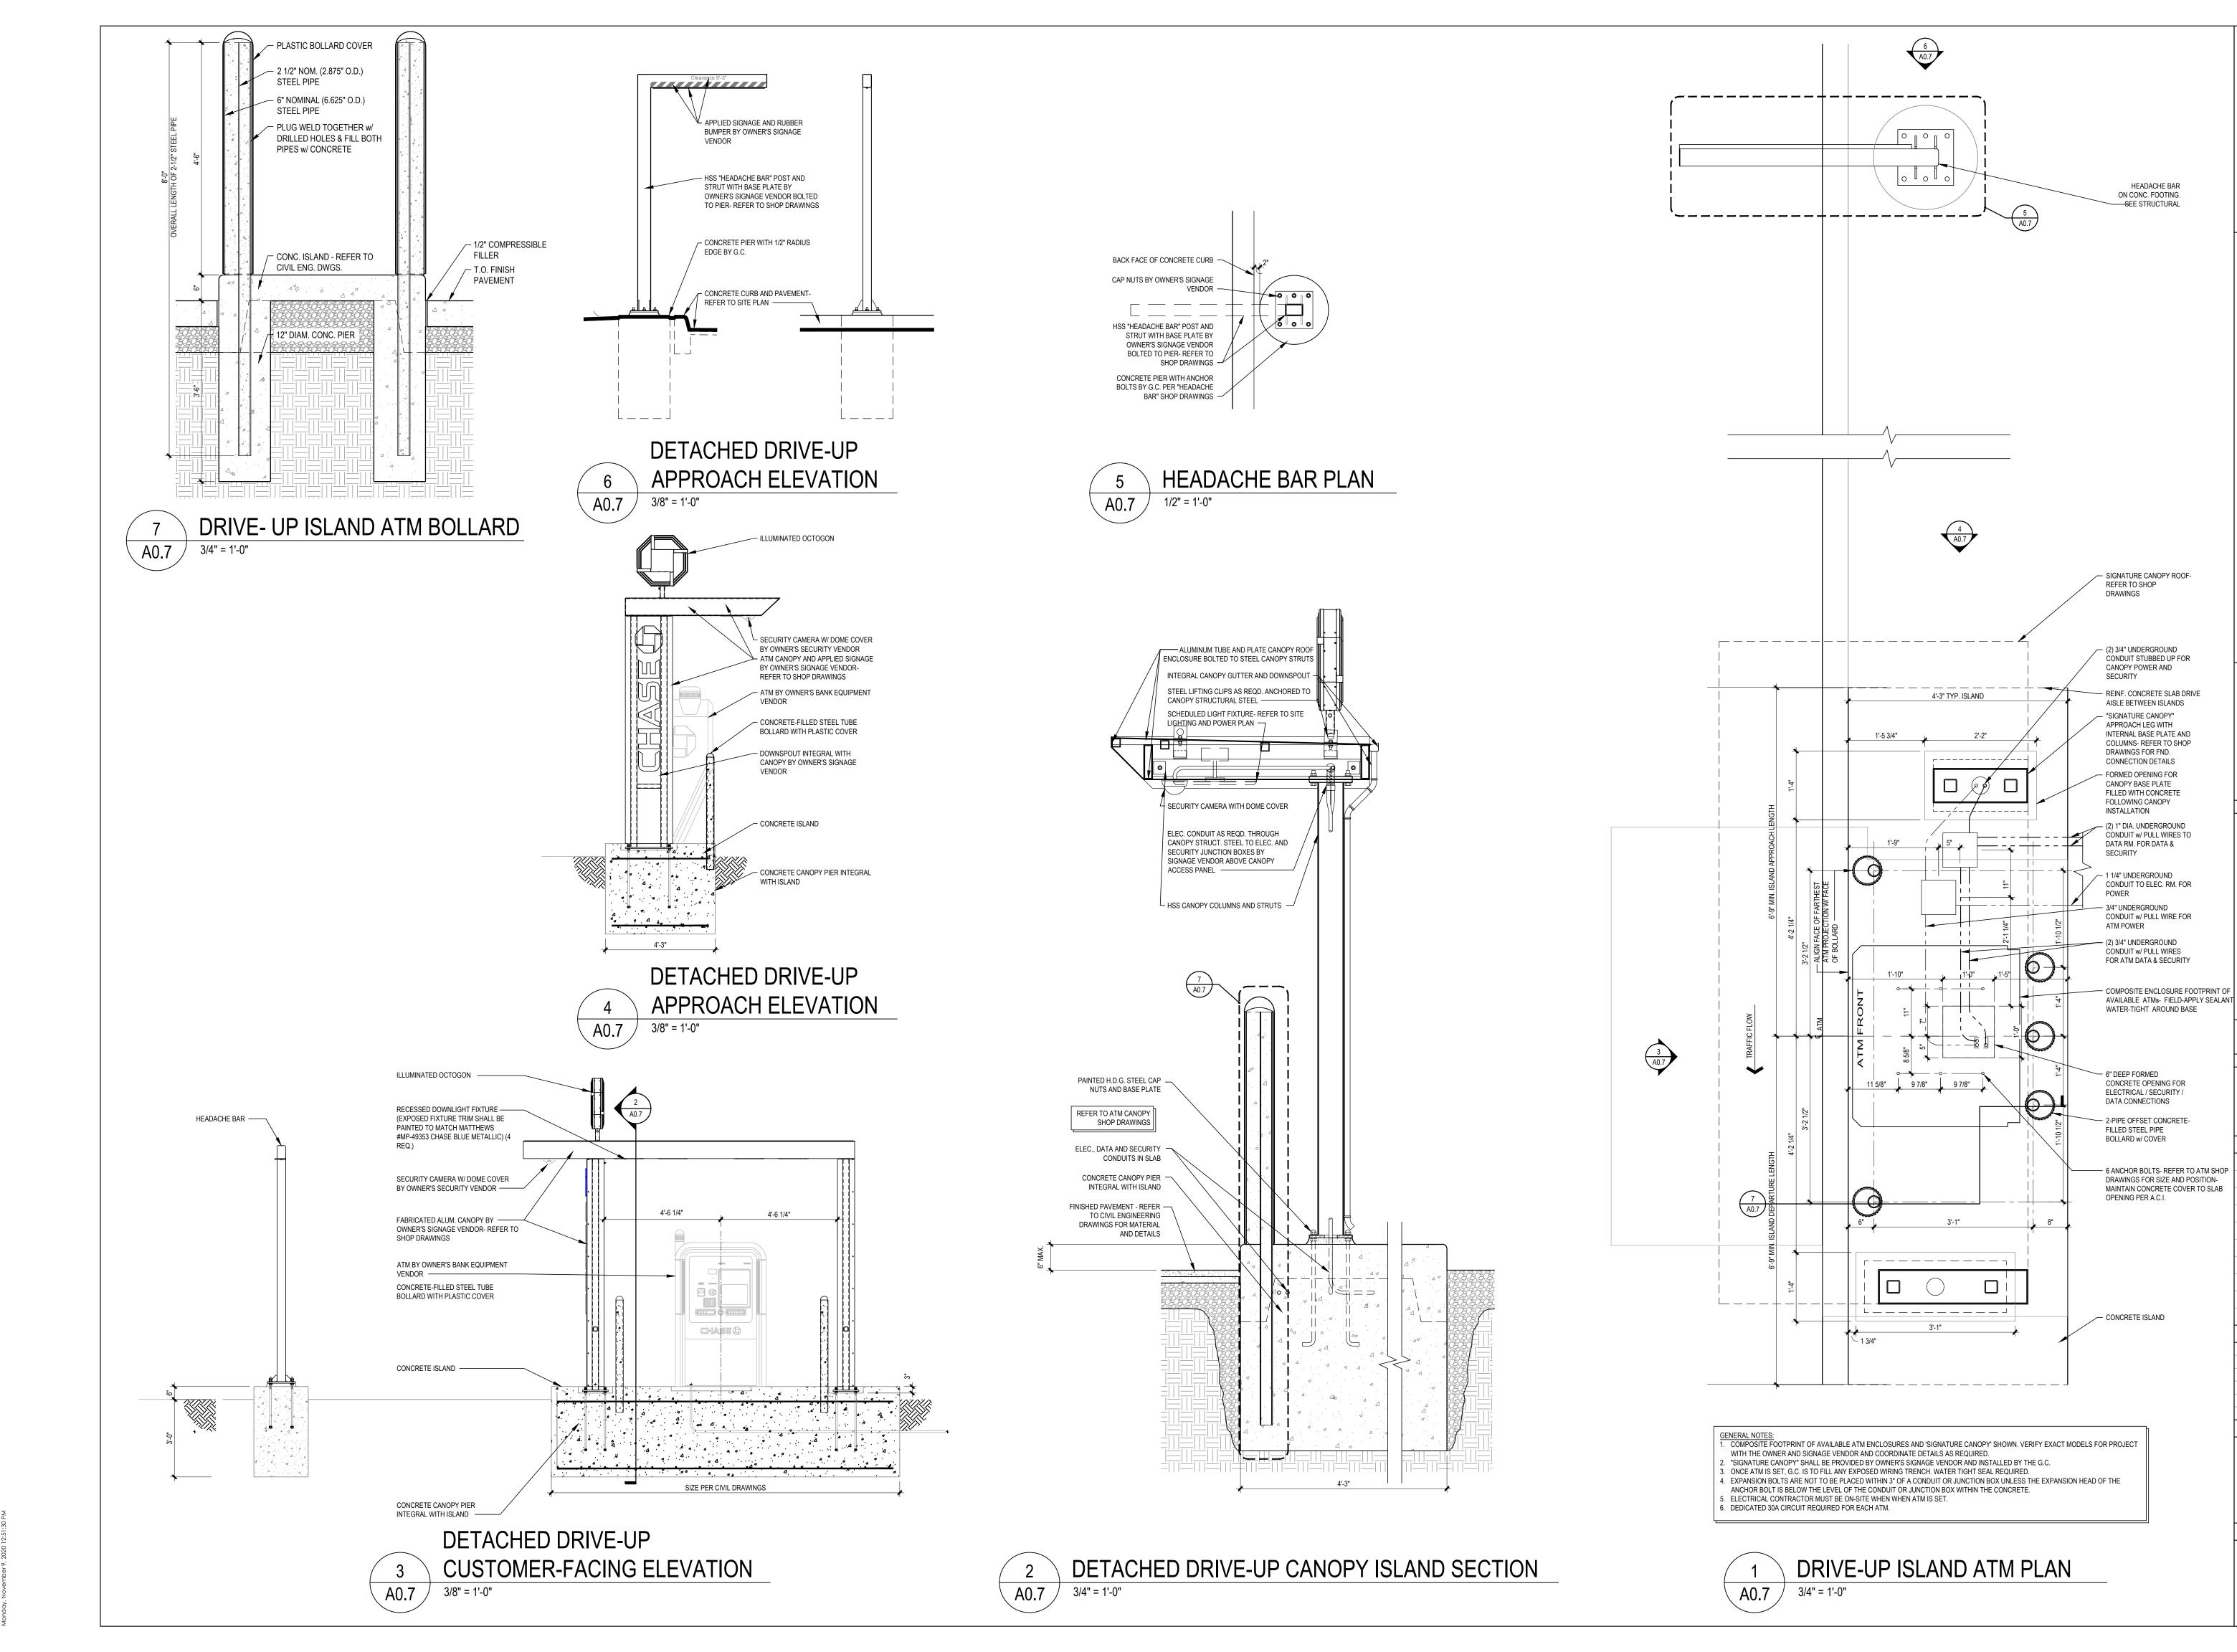

RGAN CHASE, N. A
890 NE LANGSFORD RD
890 NE LANGSFORD RD
890 NE LANGSFORD RD

GROUP

6500 Chippewa Street Suite 200
St. Louis, MO 63109

6500 Chippewa Street Suite 200 St. Louis, MO 63109 314.843.4320 www.core-states.com

COA #: A-2014026908
ARCHITECT OF RECORD

ROBERT BRUCE
LASURS
JANUARY 08, 2021
NUMBER
A-7504

ARCHITECT: R. BRUCE LASURS LICENSE NUMBER: 007504

LICENSE NUMBER: 00/504

THESE DRAWINGS ARE NOT COMPLETE WITHOUT THE SEPARATE TYPE WRITTEN SPECIFICATIONS MANUAL WHICH ARE PART OF THE CONTRACT DOCUMENTS.

SSUE DATE DESCRIPTION
- 2020.12.21 PERMIT SET

PROJECT INFORMATION
PROJECT NO: JPM.2713
DATE: 2020.

PROJECT INTORMATION

PROJECT NO: JPM.27135.001

DATE: 2020.12.21

PROTOTYPE: 20.2

DRAWN BY: C.THEBEAU

CHECKED BY: B.LaSURS

VERSION: SE_1.00

SHEET TITLE

DRIVE-UP ISLAND & REMOTE SIGNATURE CANOPY DETAILS

SHEET NUMBER

A0.7

FIRE EXSTINGUISHER LEGEND

TYPE 1 - 10 LB. DRY CHEMICAL (ABC) MP10 W/ ARCHITECTURAL SERIES

CABINET (WHERE NOTED) - 2409-6R VERTICAL DUO LAMINATED SAFETY GLASS ROUGH OPENING = 25' X 10-1/2' X 4" MOUNT AT 50" A.F.F. TO TOP

ASSIGNS TO ADHERE TO ALL ASPECTS AND REGULATIONS OF THE AMERICANS WITH DISABILITIES ACT (ADA) AND LOCAL ACCESSIBILITY CODES, THE CONTRACTOR SHALL NOT BE RELIEVED OF SOLE RESPONSIBILITY TO VERIFY ALL REQUIREMENTS OF SAID ACTS AS PERTAINING TO CONTRACT DOCUMENT CONTAINED HEREIN PRIOR TO COMMENCEMENT OF ANY WORK. HE SHALL ALSO BE RESPONSIBLE TO IMMEDIATELY NOTIFY DESIGNER OF POSSIBLE DISCREPANCIES. HE SHALL ALSO PAY SPECIAL ATTENTION TO ITEMS

WHILE IT IS THE INTENT OF THE ARCHITECT, HIS EMPLOYEES, AND

ACCESSIBILITY NOTES

A. REFER TO A0.1, COVER SHEET, FOR CODE SUMMARY & BUILDING

B. REFER TO ARCHITECTURAL FLOOR PLANS FOR BUILDING

C. REQUIRED ACCESSIBLE PARKING AREAS, CURBS, CROSSWALKS, SIGNS, ETC. SHALL COMPLY WITH CURRENT STATE AND LOCAL

D. TACTILE EXIT SIGNS SHALL BE PROVIDED AT THE FOLLOWING

D.A. EACH GRADE LEVEL EXTERIOR DOOR SHALL BE IDENTIFIED BY A TACTILE EXIT SIGN WITH THE WORD "EXIT".

OR AREA TO A CORRIDOR OR HALLWAY THAT IS REQUIRED TO HAVE A VISUAL EXIT SIGN, SHALL BE IDENTIFIED BY A TACTILE EXIT SIGN WITH THE WORDS, "EXIT ROUTE".

D.B. EACH EXIT, EXIT ACCESS DOOR FROM AN INTERIOR ROOM

. THE BOTTOM 10" OF ALL DOORS SHALL HAVE A SMOOTH UNINTERRUPTED SURFACE TO ALLOW DOOR TO BE OPENED BY A WHEELCHAIR FOOTREST.

H. MAXIMUM FORCE REQUIRED TO OPEN EXTERIOR DOORS SHALL NOT EXCEED 8.5 LBS. MAXIMUM FORCE REQUIRED TO OPEN

. NO THRESHOLD SHALL EXCEED 1/2" IN HEIGHT.

G. HAND-OPERATED DOOR OPENING HARDWARE SHALL NOT REQUIRE TIGHT GRASPING OR TWISTING OF THE WRIST IN ORDER TO OPERATE, AND SHALL BE MOUNTED NO HIGHER THAN 48" A.F.F.

INTERIOR DOORS SHALL NOT EXCEED 5 LBS. IF A DOOR HAS A CLOSER, THEN THE SWEEP PERIOD OF THE CLOSER SHALL BE ADJUSTED SO THAT FROM AN OPEN POSITION OF 70 DEGREES, THE DOOR WILL TAKE AT LEAST 3 SECONDS TO

MOVE TO A POINT 5 INCHES FROM THE LATCH, MEASURED TO THE LEADING EDGE OF THE DOOR. . FAUCET CONTROL AND OPERATING MECHANISMS SHALL BE OPERABLE WITH ONE HAND AND SHALL NOT REQUIRE TIGHT GRASPING, PINCHING, OR TWISTING OF THE WRIST. THE FORCE REQUIRED TO ACTIVATE CONTROLS SHALL BE NO GREATER THAN 5 LBS. LEVER OPERATED, FLUSH TYPE AND ELECTRONICALLY OPERATED MECHANISMS ARE EXAMPLES OF ACCEPTABLE DESIGNS. IF SELF CLOSING VALVES ARE USED, THE FAUCET SHALL

REMAIN OPEN FOR A MINIMUM OF 10 SECONDS. C. PROVIDE SIGNAGE WITH INTERNATIONAL SYMBOL OF ACCESSIBILITY IN ACCORDANCE WITH ANSI A117.1 (LATEST EDITION) AND ADA REQUIREMENT.

. SIGNAGE HEIGHT SHALL BE IN ACCORDANCE WITH ALL APPLICABLE NATIONAL, STATE AND LOCAL ACCESSABILITY

M. RESTROOM SIGNAGE SHALL BE MOUNTED ON THE WALL ADJACENT TO THE LATCH SIDE OF THE RESPECTIVE RESTROOM

I. IF FIRE ALARM SYSTEMS ARE REQUIRED, REFER TO FIRE ALARM DRAWINGS FOR PULL STATIONS AND STROBE MOUNTING HEIGHTS AND LOCATIONS.

D. ALL ACCESSIBLE LANDINGS SHALL NOT EXCEED THE 2% MAX SLOPE IN ALL DIRECTIONS.

P. IF FIRE ALARMS ARE REQUIRED, REFER TO FIRE ALARM DRAWINGS FOR PULL STATIONS AND STROBE MOUNTING HEIGHTS AND LOCATIONS.

EXITING REQUIREMENTS

		REQUIRED	PROVIDED
COMMON PATH OF EGRESS TRAVEL MAX	=	75'	29'
MINIMUM NUMBER OF EXITS	=	2 EXITS	2
TRAVEL DISTANCE MAX	=	200'	72'
DEAD END CORRIDOR	=	20'	0'
DIAGONAL OF BUSINESS AREA	=	88'-0"	
1/2 MIN. DISTANCE OF DIAGONAL W	//O AUT	OMATIC SPRIN	NKLER SYSTEM

LIFE SAFETY LEGEND

TOTAL LENGTH OF EXIT TRAVEL DISTANCE (FEET) FROM START POINT

COMMON PATH OF EGRESS TRAVEL


DISTANCE (FEET) FROM START POINT

88'-0" / 2 = 44'- 0" 51'-8"




EXIT SIGN (SEE ELECTRICAL SHEETS) —— LOCATION OF EXIT TEXT

EXIT TRAVEL DISTANCE (36" CLEAR WIDTH MIN.)

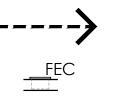

INTERNATIONAL SIGN OF ACCESSIBILTY

FIRE EXTINGUISHER CABINET

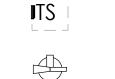

IISA

FIRE EXTINGUISHER

TACTILE "EXIT" SIGN

EGRESS CAPACITY LEGEND

Α	OCCUPANT LOAD AT EXIT (# OF OCCUPANTS / # DOORS
В	REQUIRED EXIT WIDTH [0.2" x PER OCCUPANT - (INCHES)]
С	PROVIDED EXIT WIDTH (INCHES)



WALL LEGEND

NEW WALL CONSTRUCTION NEW 1-HR RATED WALL CONSTRUCTION

LIFE SAFETY & ACCESSIBILITY PLAN

JPM.27135.001

2020.12.21

C.THEBEAU

B.LaSURS

SE_1.00

GROUP CORESTATES, INC.

COA #: A-2014026908

6500 Chippewa Street Suite 200

ARCHITECT OF RECORD

ROBERT BRUCE

ARCHITECT: R. BRUCE LASURS LICENSE NUMBER: 007504 THESE DRAWINGS ARE NOT COMPLETE WITHOUT THE

SEPARATE TYPE WRITTEN SPECIFICATIONS MANUAL

WHICH ARE PART OF THE CONTRACT DOCUMENTS.

ISSUE DATE DESCRIPTION

PROJECT INFORMATION

PROJECT NO:

PROTOTYPE:

DRAWN BY:

SHEET TITLE

CHECKED BY: VERSION:


2020.12.21 PERMIT SET

1 2021.04.20 STRUCTURAL STEEL REV


2 2021.06.03 PLAN REVIEW COMMENTS, RDC21 & WIRELESS UPDATE

St. Louis, MO 63109 314.843.4320


SHEET NUMBER

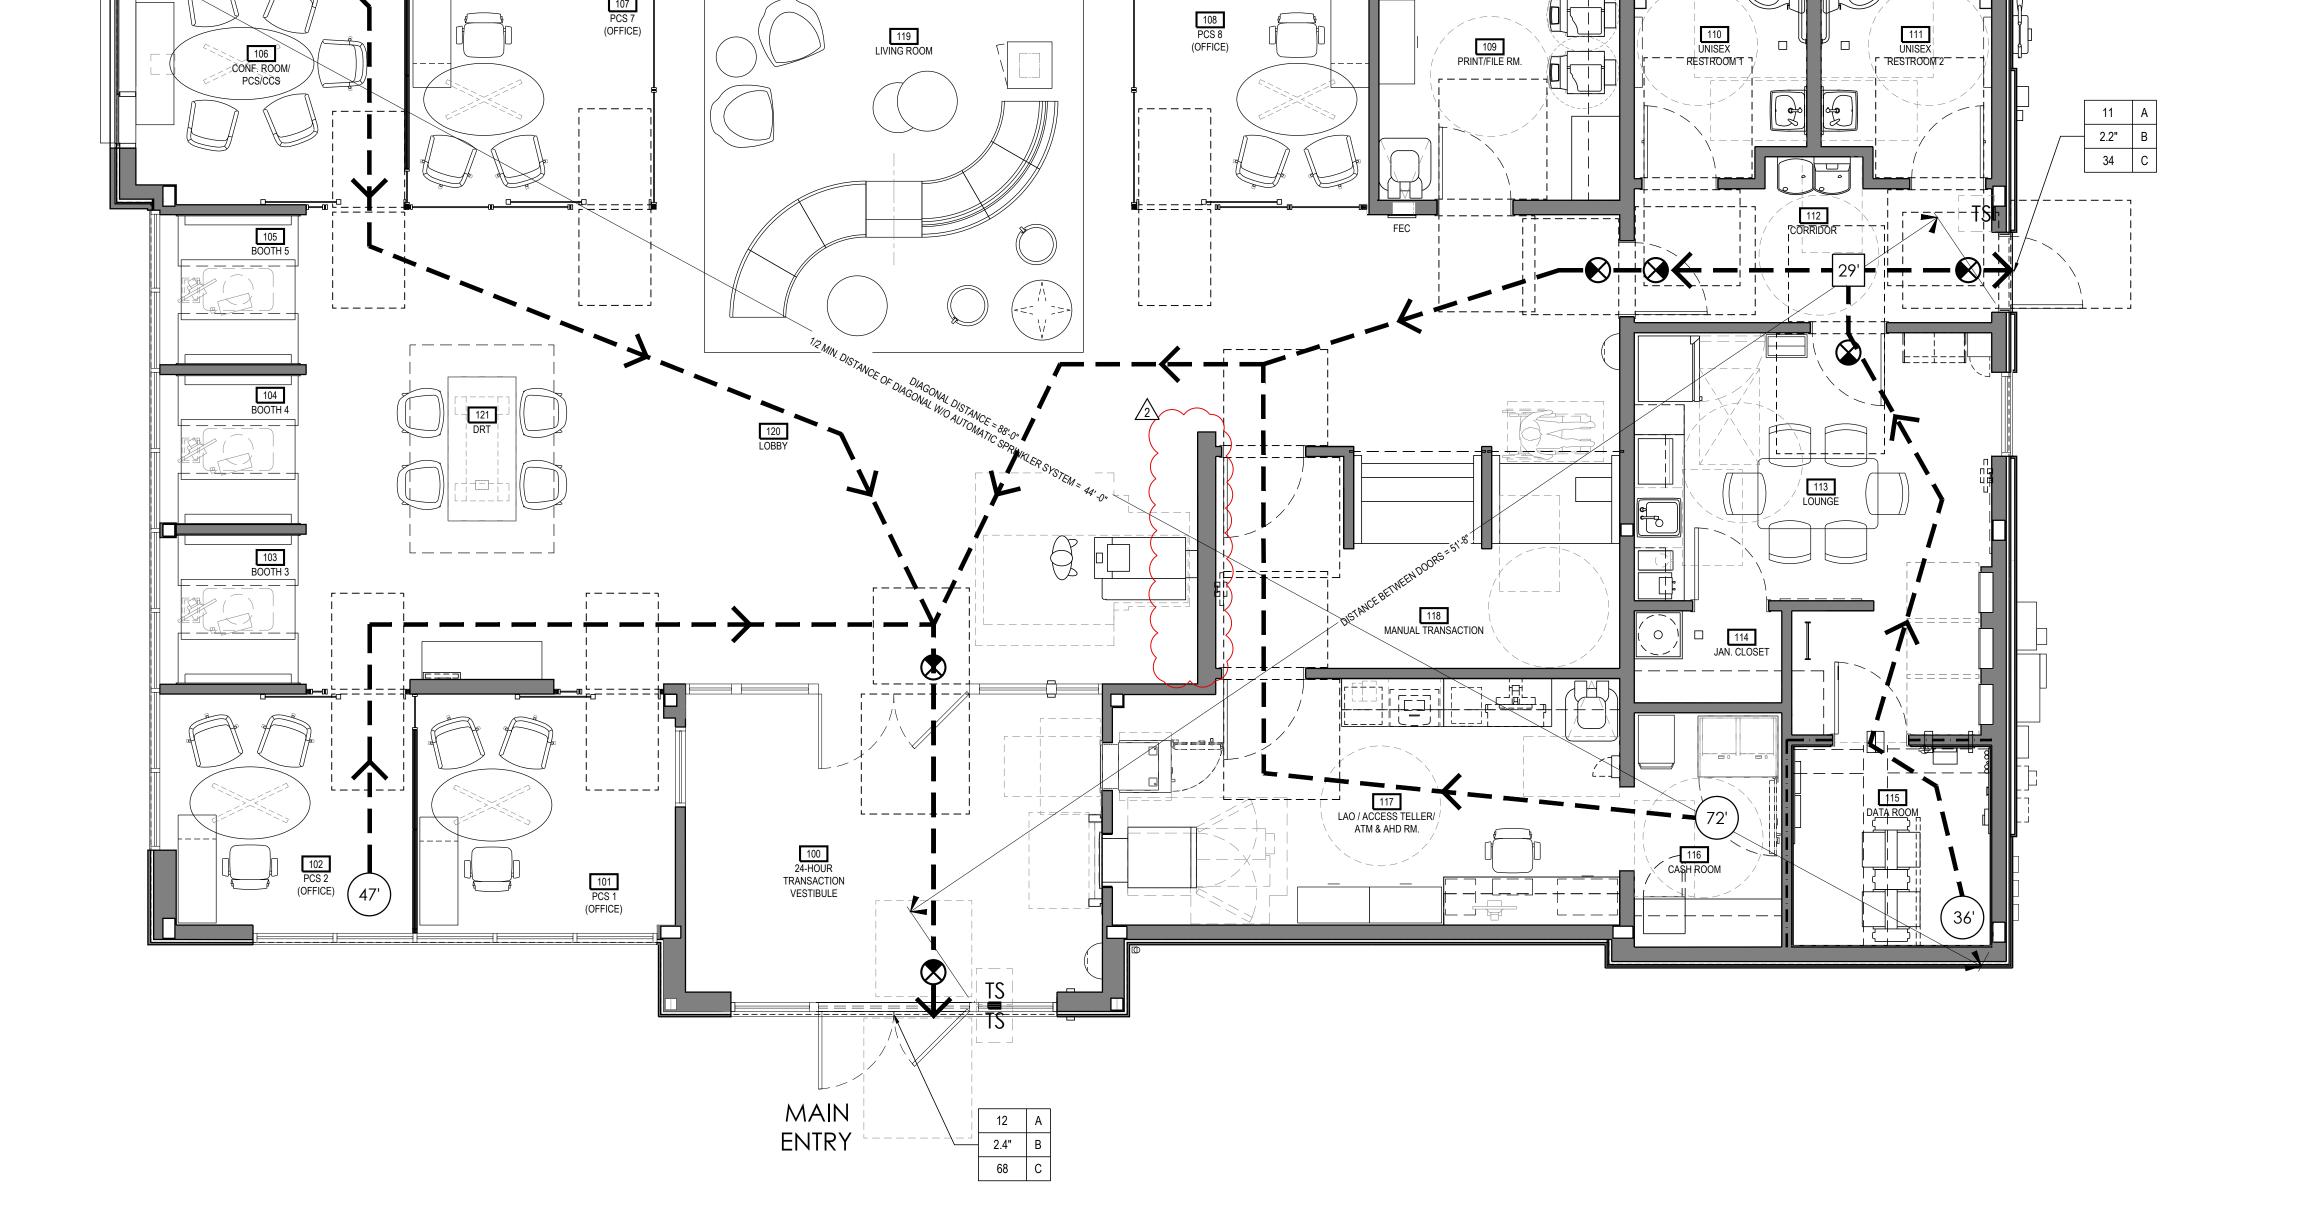



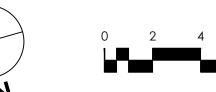



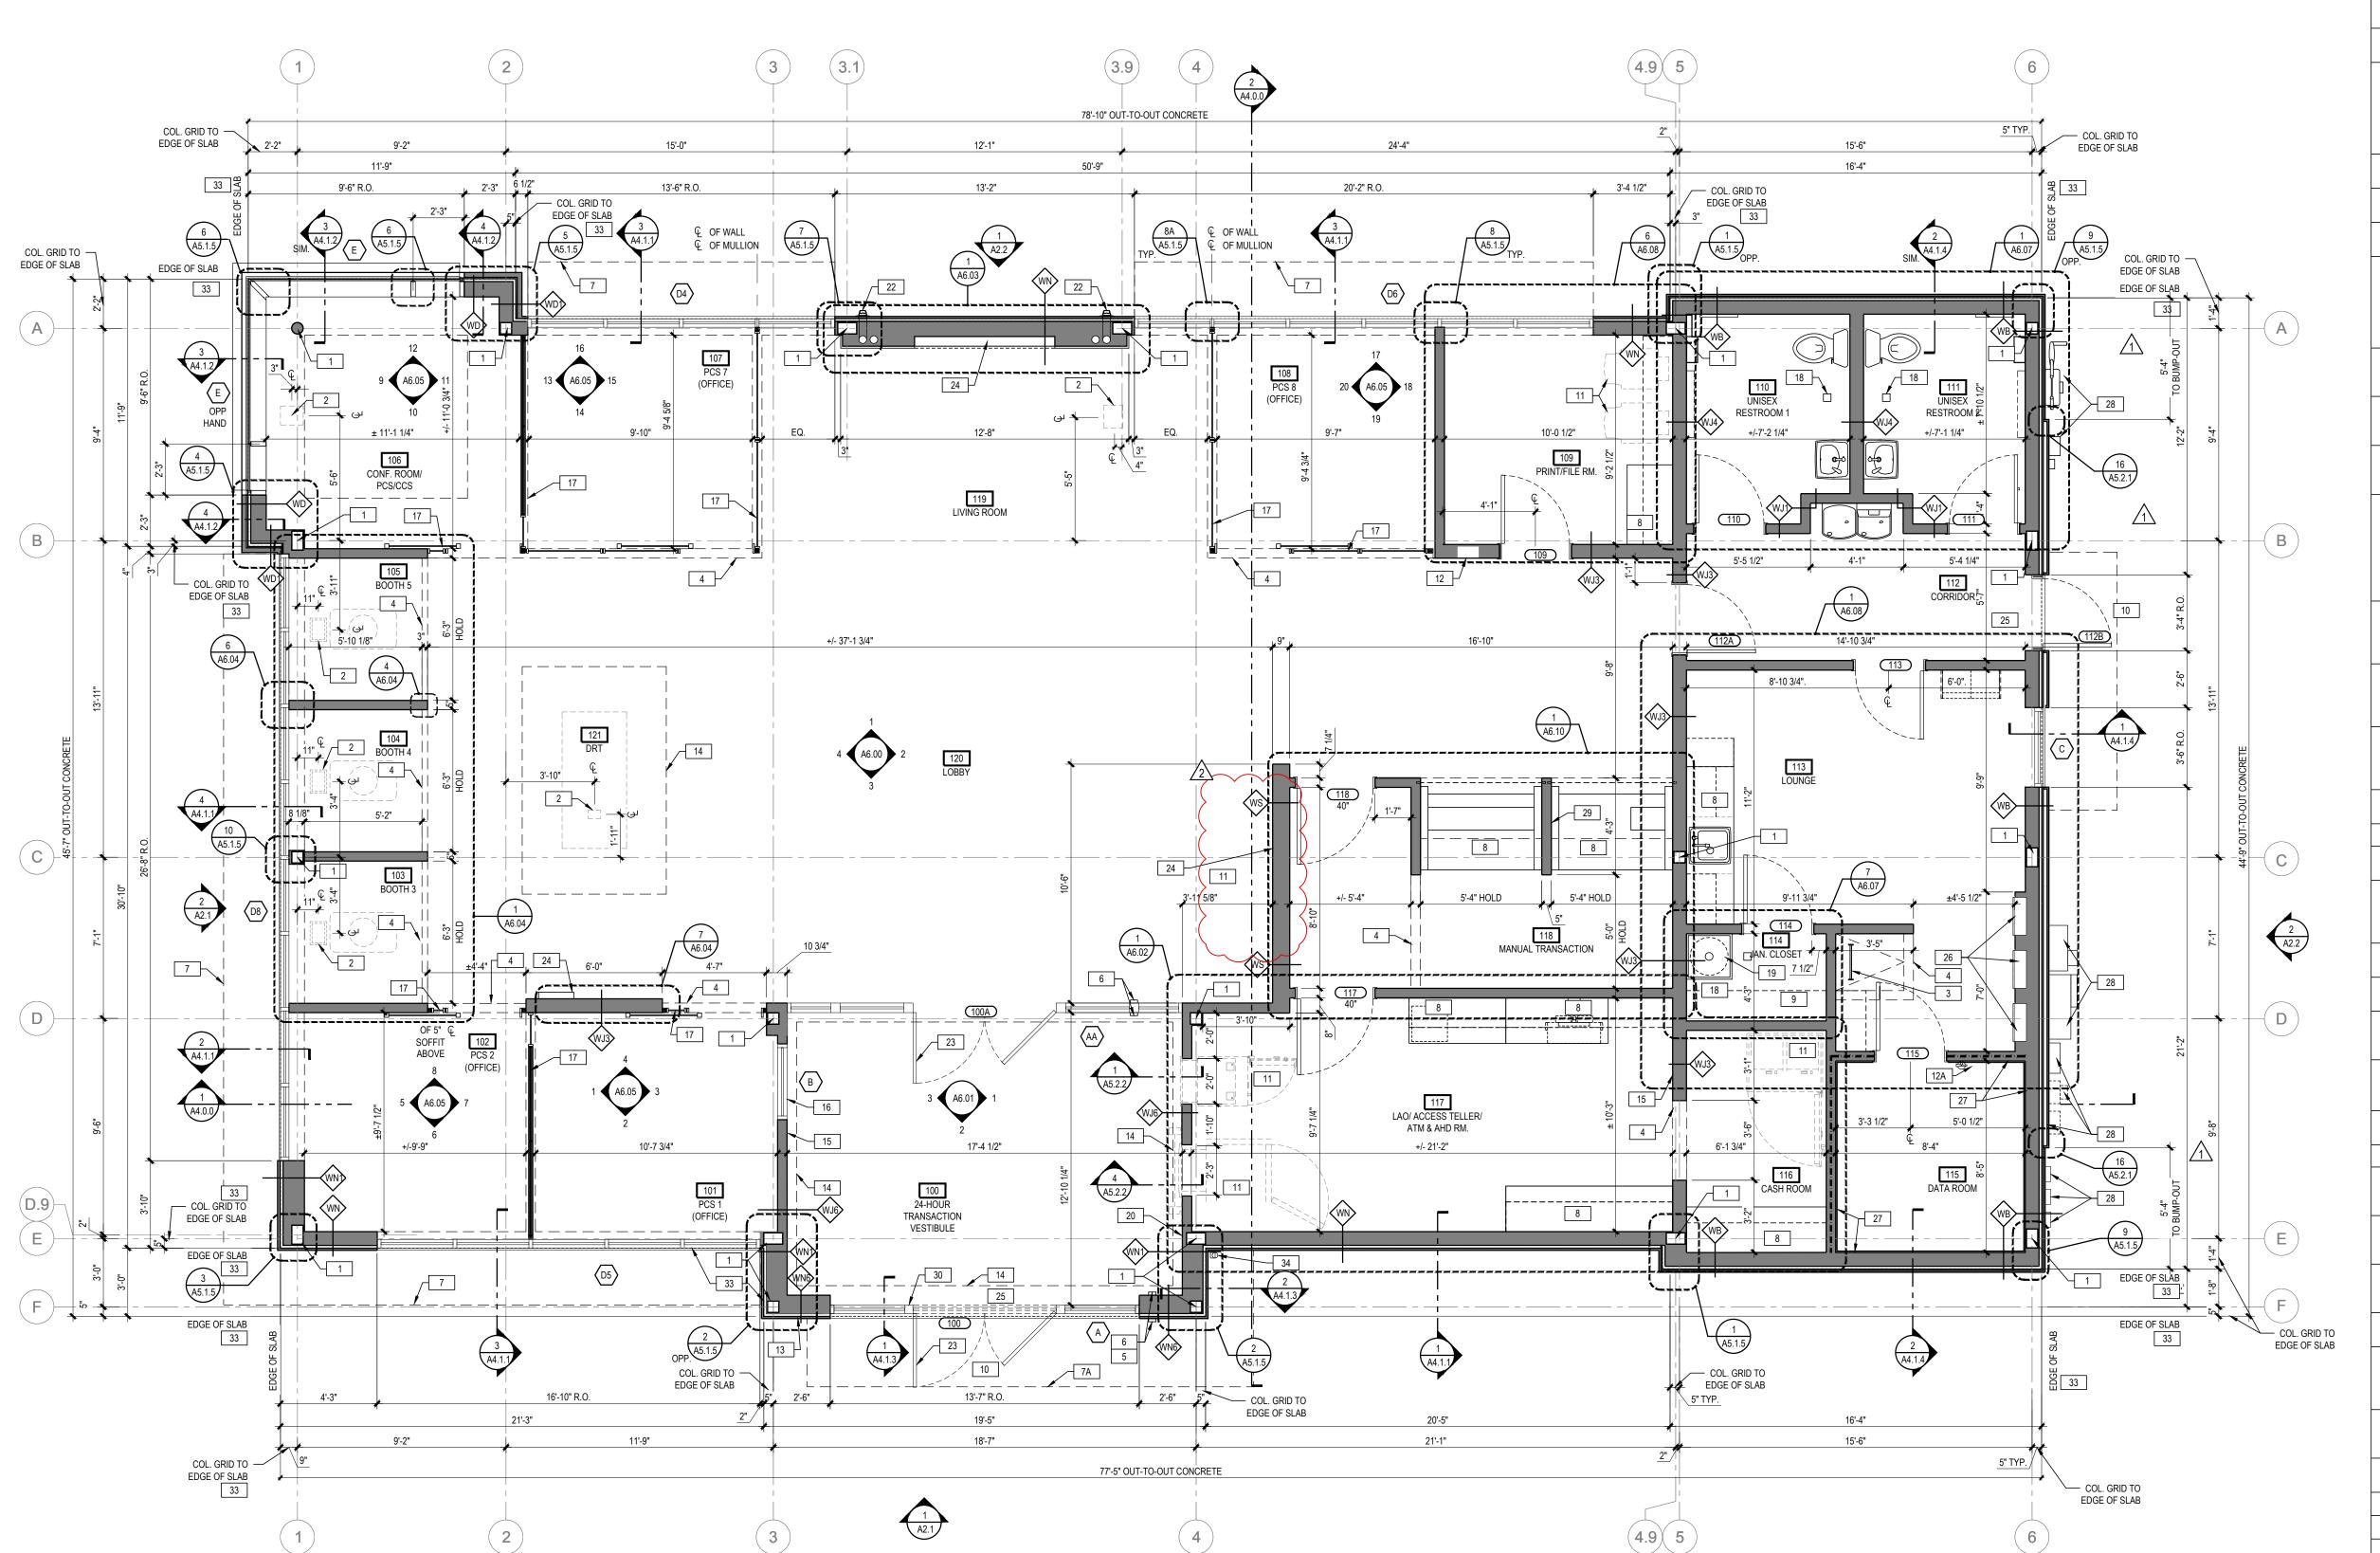





GENERAL FLOOR PLAN NOTES

- A ALL INTERIOR WALL PARTITIONS TO BE 'WJ' U.N.O. (SEE SHEET A3.1.0 FOR ADDITIONAL INFORMATION).
- B ALL DOOR FRAMES TO HAVE 4" RETURN ON HINGE SIDE U.N.O.
- C NOT ALL KEYNOTES MAY BE USED. REFER TO DRAWING.

 D ALL EXTERIOR SHEATHING SHALL BE DENSGLASS.

FLOOR PLAN KEYNOTES

- STRUCTURAL COLUMN:
 COORDINATE WITH STRUCTURAL ENGINEERING
- DRAWINGS

 POWER DATA FLOOR BOX: REFER TO ELECTRICAL
 DRAWINGS FOR ADDITIONAL INFORMATION, COORDINATE
- LOCATIONS WITH STRUCTURAL DRAWINGS.

 ROOF ACCESS LADDER & SCUTTLE:
- REFER TO ROOF PLAN AND DETAIL AS NOTED

 SOFFIT / BULKHEAD ABOVE:
- REFER TO REFLECTED CEILING PLANS, SECTIONS,
 DETAILS AND INTERIOR ELEVATIONS. PROVIDE
 DEFLECTION TRACK AT UNDERSIDE OF ROOF / FLOOR
 STRUCTURE ABOVE TO ALLOW BULKHEAD TO REST ON
- DEMOUNTABLE PARTITION SYSTEM BELOW.

 CARD READER: REFER TO EXTERIOR ELEVATIONS AND ELECTRICAL DRAWINGS FOR ADDITIONAL INFORMATION.
- 6 AUTOMATIC DOOR OPERATOR SYSTEM: REFER TO
- ELEVATIONS AND DOOR SCHEDULE.
- SUNSHADE SYSTEM: KAWNEER SUNSHADE.
- ENTRANCE CANOPY:

 MAPES SUPER LUMIDECK CANOPY SYSTEM SHOP
 FABRICATED PRE-FINISHED CUSTOM ALUMINUM CANOPY
 UNIT WITH INTEGRAL ELECTRICAL AND DRAINAGE
 SYSTEMS FASTENED TO BUILDING STRUCTURE- REFER
- CUSTOM SHOP-FABRICATED BUILT-IN MILLWORK: RFER TO INTERIOR ELEVATIONS SUBMIT SHOP DRAWINGS AND FINISH SAMPLES TO ARCHITECT FOR APPROVAL.
- 9 ADJUSTABLE SHELVES: REFER TO INTERIOR ELEVATIONS- PROVIDE BLOCKING IN WALL AS REQUIRED
- 10 CONCRETE STOOP:
 ACCESSIBILITY-COMPLIANT CONTINUOUS PAVING TO

TO ELEVATIONS AND WALL SECTIONS.

- PUBLIC R.O.W. REQD. FROM ALL EXITS

 11 EQUIPMENT/ APPLIANCE:
 REFER TO EQUIPMENT INSTALLATION MANUAL -
- ELECTRICAL, DATA, AND SECURITY ROUGH-IN WORK AS REQUIRED FRAME WALL OPENING AND PREPARE FLOOR SUBSTRATE AS REQUIRED. PROVIDE BLOCKING IN WALL AS REQUIRED.

 FIRE EXTINGUISHER AND CABINET: PROVIDE THE

COORDINATE WITH EQUIPMENT INSTALLER - PROVIDE

- MINIMUM NUMBER REQUIRED AND COORDINATE FINAL LOCATIONS WITH LOCAL FIRE MARSHALL- PROVIDE ADJACENT ACCESSIBILITY CLEARANCES.
- 12A WALL-MOUNT FIRE EXTINGUISHER: CARBON DIOXIDE ONLY / WATER OR DRY CHEMICAL TYPES NOT PERMITTED, CLASS C OR B-C, 5 LB. OR SMALLER, SET WALL BRACKET TO KEEP HANDLE <48" A.F.F.
- KNOX BOX: MOUNTED 60" A.F.F. FLUSH WITH
 SURROUNDING WALL SURFACE. VERIFY LOCATION WITH
 LOCAL FIRE MARSHALL TO ENSURE COMPLIANCE. PAINT
 TO BLEND WITH SURROUNDING WALL FINISH.

 CEILING LIGHT FIXTURE COVE- REFER TO REFLECTED
- CEILING PLAN

 15 RECESSED ATM KEY BOX MOUNTED AT 36" A.F.F.
- 16 STOREFRONT GLAZING SYSTEM INTERIOR PARTITION REFER TO INTERIOR ELEVATIONS
- 17 DEMOUNTABLE PARTITION SYSTEM WITH INTEGRAL DOORS AND POWER, DATA AND SECURITY CONDUIT SYSTEMS, ANCHORED TO BUILDING WALLS, SUBFLOOR AND BULKHEADS
- FLOOR DRAIN: REFER TO PLUMBING DRAWINGS FOR ADDITIONAL INFORMATION.
- MOP SINK: REFER TO PLUMBING DRAWINGS FOR ADDITIONAL INFORMATION.
 INSTALL SECURITY MESH ABOVE CEILING TO
- STRUCTURAL DECK TO SECURE TRANSACTION VESTIBULE.

 21 NOT USED
- SPANDREL GLASS: OPACI-COAT #3-0770 WARM GREY (FOR USE WITH PPG). SEE SPECIFICATIONS.
- 22 THROUGH WALL ROOF DRAIN. REFER TO PLUMBING DRAWINGS.
- 23 ACTIVE DOOR LEAF FOR AUTOMATIC DOOR OPERATOR.

 24 AUDIO/VIDEO EQUIPMENT:
 REFER TO SHEET A1.1.4 FOR SOLUTION TYPE AND
- ADDITIONAL INFORMATION.

 25 EXIT ALARM POWER SUPPLY:
 INSTALLED ABOVE FINISH CEILING OVER ALARMED
 EGRESS DOORS REFER TO ELECTRICAL DRAWINGS.
- 26 ELECTRICAL PANELS:
 LOCKING ENCLOSURES FOR ELECTRICAL MAIN SERVICE
- AND DISTRIBUTION

 27 PROVIDE PAINTED F.T. PLYWOOD TO 8' A.F.F. AT ALL DATA ROOM WALLS.
- 28 UTILITY EQUIPMENT:
 REFER TO EXTERIOR ELEVATIONS, SITE PLAN,
 ELECTRICAL AND PLUMBING DRAWINGS FOR ADDITIONAL
 INFORMATION.
- 29 G.C. TO INSTALL PLASTIC GROMMET AND PVC CONDUIT AT MANUAL TRANSACTION STATION. REFER TO SHEET A6.10 FOR ADDITIONAL INFORMATION.
- 30 G.C. TO PULL CONDUIT FOR SECURITY CAMERA IN MULLION.

 31 NOT USED
- 31 NOT USED

 32 NOT USED
- EDGE OF SLAB SHOWN FOR CLARITY WITH HIDDEN LINE.
 REFER TO STR DWGS FOR ADDITIONAL INFORMATION.
 DOWNSPOUT. REFER TO PLUMBING DRAWINGS FOR ADDITIONAL INFORMATION.
 - WALL LEGEND

NEW WALL CONSTRUCTION

Δ 1

P MORGAN CHASE, N.A HWY 291 & NE LANGSFORD RD 890 NE LANGSFORD RD

GROUP

CORESTATES

GROUP

CORESTATES, INC.

Soud Chippewa Sireer Suite 200 St. Louis, MO 63109 314,843,4320 www.core-states.com

COA #: A-2014026908 ARCHITECT OF RECORD



ARCHITECT: R. BRUCE LASURS

LICENSE NUMBER: 007504

THESE DRAWINGS ARE NOT COMPLETE WITHOUT THE SEPARATE TYPE WRITTEN SPECIFICATIONS MANUAL WHICH ARE PART OF THE CONTRACT DOCUMENTS.

ISSUE	DATE	DESCRIPTION
-	2020.12.21	PERMIT SET
1	2021.04.20	STRUCTURAL STEEL REV
2	2021.06.03	PLAN REVIEW COMMENTS, RDC21 & WIRELESS UPDATE

PROJECT INFORMATION

PROJECT INFORMATION

PROJECT NO: JPM.27135.001

DATE: 2020.12.21

PROTOTYPE: 20.2

DRAWN BY: C.THEBEAU


CHECKED BY: B.LaSURS

VERSION: SE_1.00

SHEET TITLE

CONSTRUCTION FLOOR PLAN

SHEET NUMBER

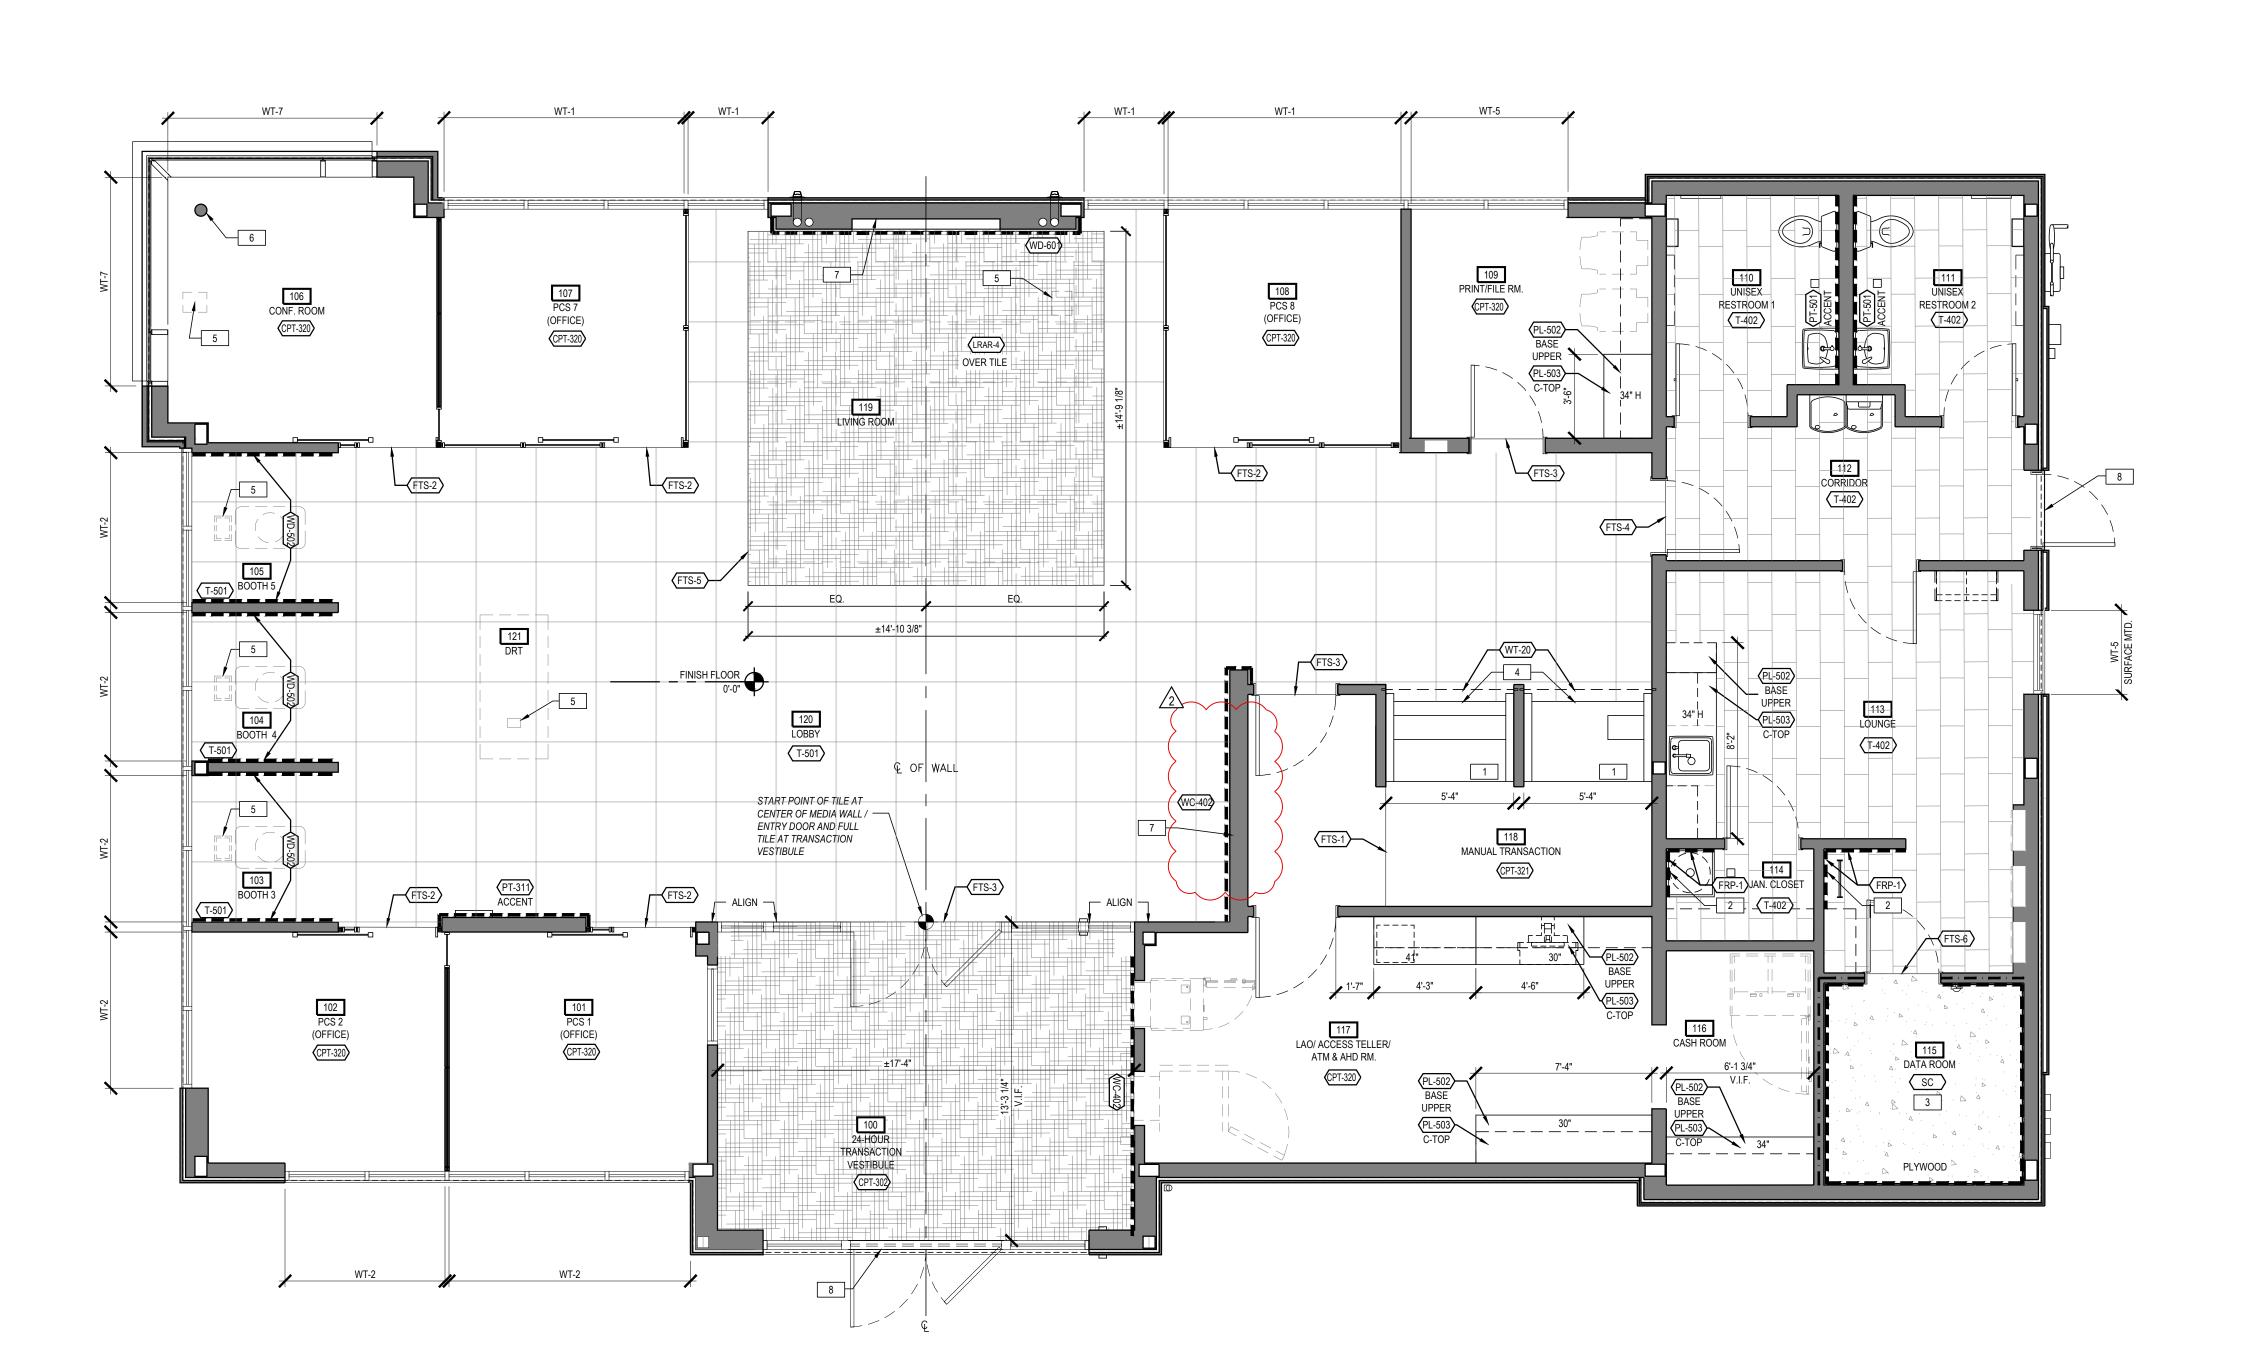

GENERAL FINISH NOTES

A. REFER TO SHEET A0.1 FOR FLAME SPREAD REQUIREMENTS.

OF THE CARPET TILE BORDER.

- B. REFER TO SHEET A3.3.1 FOR INTERIOR FINISH AND FLOOR TRANSITION SCHEDULES.
- C. RUGS ARE SECURED WITH A DOUBLE SIDED STICKY
 MESH, TACTILES, AND OPTITAPE TO SECURE
 TRANSITION EDGING TO THE FLOOR. TRANSITION
 EDGING TO BE SECURED ON THE OUTSIDE PERIMETER
- D. AREA RUG TO BE INSTALLED ASHLAR. TRIM EXCESS PIECES AS NECESSARY.
- E. REFER TO INTERIOR ELEVATIONS, FLOOR PLANS, FINISH PLANS AND REFLECTED CEILING PLANS -DRAWINGS NOTES SUPERCEDE SCHEDULES.
- F. ALL WALLS TO BE PAINTED PT-500, U.N.O.
 G. PAINT FACES AND BOTTOMS OF GYPSUM BOARD BULKHEADS TO MATCH ADJACENT WALLS UNLESS
- NOTED OTHERWISE

 H. PAINT ALL DOORS AND FRAMES TO MATCH ADJACENT WALL COLOR IN SATIN FINISH, U.N.O., SANDING WD DOORS BETWEEN COATS.
- I. PAINT INTERIOR DIFFUSERS, REGISTERS, AND LOUVERS TO MATCH ADJACENT SURFACE.
- ROLLER SHADE FABRIC SELECTION VARIES BY REGION AND CLIMATE ALL CONFERENCE ROOMS TO RECEIVE DOUBLE ROLLER SHADE WT-7
 RESTROOM WALL TILE FINISH EXTENTS:
- RESTROOM WALL TILE FINISH EXTENTS:
 PROVIDE ONLY IF REQUIRED BY JURISDICTIONS
 HAVING AUTHORITY CONTINUOUS AT ALL WALLS
 REGARDLESS OF CODE REQUIREMENTS REFER TO
 INTERIOR ELEVATIONS
- M. WINDOW SHADE ENCLOSURES AND POCKETS:
 WINDOW SHADE HOUSINGS AND POCKETS
 INTEGRATED WITH CEILING GRID CEILING SYSTEMS SHALL BE PROVIDED BY THE CEILING GRID
 MANUFACTURER AND INSTALLED BY THE CEILING
 SYSTEM VENDOR.
- FINISH SHALL MATCH THE CEILING GRID SURFACE-MOUNTED WINDOW SHADE HOUSING - SHALL BE PROVIDED BY THE WINDOW SHADE VENDOR. FINISH SHALL MATCH THE STOREFRONT GLAZING
- N. FINISH: DARK ACCENT PAINT(S) REQUIRE LEVEL 5
 FINISH
- O. G.C. TO TERMINATE FLOOR TILE AT TOE KICK OF MILLWORK. G.C. TO LEAVE OUT LAST TILE ALONG MILLWORK AND INSTALL IT AFTER MILLWORK IS INSTALLED.

SYSTEM FINISH

FINISH PLAN KEYNOTES

- MANUAL TRANSACTION MILLWORK FURNISHED AND INSTALLED BY FURNITURE VENDOR.
- 2 FRP FINISH EXTENTS:
- LADDER AREA: ALL WALL SURFACES BEHIND LADDER WITHIN 12" EACH SIDE OF LADDER, SIDE WALLS WITHIN 12" OF LADDER- CONT. FOR FULL HEIGHT OF ALL WALLS TO UNDERSIDE OF SCUTTLE FRAMING FINISH.

 FLOOR SINK AREA: SPLASH AREA AT EACH WALL SURFACE CONTACTING THE SINK FROM THE TOP OF
- THE SINK TO THE UNDERSIDE OF THE WATER HEATER SHELF ABOVE. REFER TO INTERIOR ELEVATIONS.

 3/4" X 4'-0" X 8'-0" HIGH FIRE-RETARDANT PLYWOOD ON GYP. BOARD IN DATA ROOM (ALL WALLS) PAINT PT-500 (RATED LABEL TO REMAIN VISIBLE).
- 4 LAST ROW OF TILE AT TELLER LINE TO BE LEFT OUT UNTIL TELLER LINE IS INSTALLED. FINISH UP TO TELLER LINE AFTER INSTALLATION.
- 5 FLOOR BOX REFER TO FLOOR PLAN FOR LOCATIONS AND ELECTRICAL DRAWINGS.
- 6 PAINT EXPOSED STEEL COLUMN PT-500.
- 7 PAINT ALL WALLS INSIDE NICHE FOR DIGITAL DISPLAY CSG-PT-104.
- 8 REFER TO SHEET A5.2.1 FOR EXTERIOR DOOR THRESHOLD DETAILS.





6500 Chippewa Street Suite 200 St. Louis, MO 63109 314.843.4320

3.4320 ore-states.com COA #: A-2014026908

ARCHITECT OF RECORD



ARCHITECT: R. BRUCE LASURS

LICENSE NUMBER: 007504

THESE DRAWINGS ARE NOT COMPLETE WITHOUT THE SEPARATE TYPE WRITTEN SPECIFICATIONS MANUAL WHICH ARE PART OF THE CONTRACT DOCUMENTS.

ISSUE DATE DESCRIPTION

- 2020.12.21 PERMIT SET

1 2021.04.20 STRUCTURAL STEEL REV

2 2021.06.03 PLAN REVIEW COMMENTS, RDC21 & WIRELESS UPDATE

PROJECT INFORMATION

PROJECT NO: JPM.27135.001

DATE: 2020.12.21

PROTOTYPE: 20.2

DRAWN BY: C.THEBEAU

CHECKED BY: B.LaSURS

SE_1.00

FINISH PLAN


SHEET NUMBER

VERSION:

SHEET TITLE





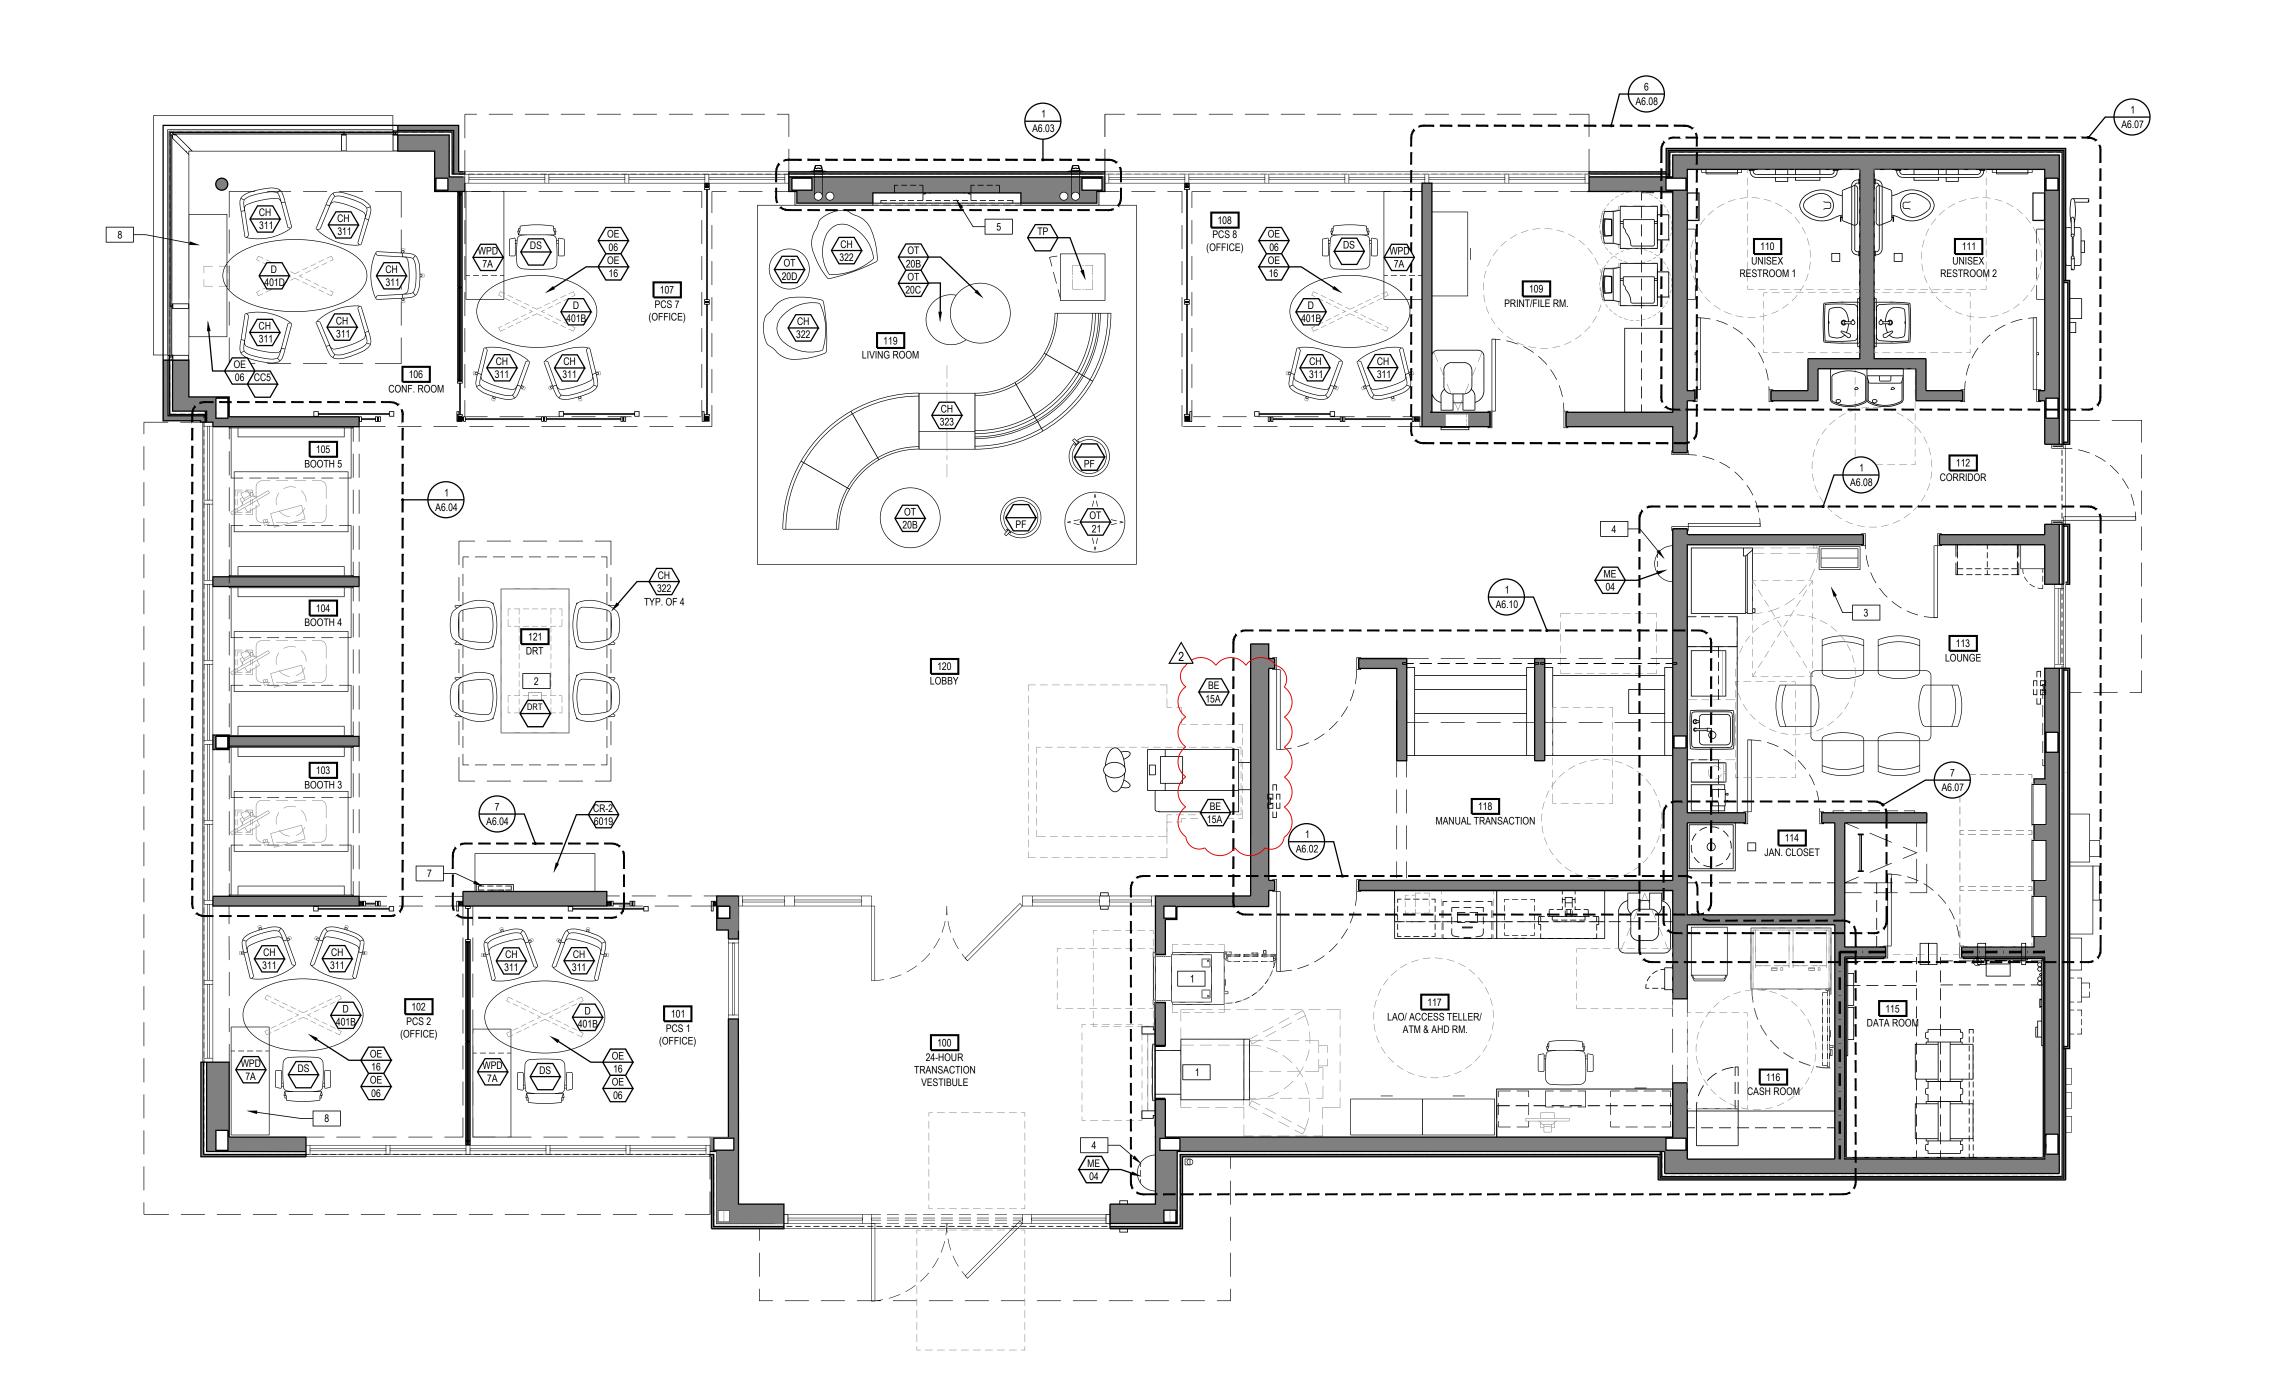

GENERAL FURNITURE & EQUIPMENT NOTES

- A GC TO COORDINATE IN FIELD BCM OFFICE LOCATION W/BRANCH MANAGEMENT FOR LOCATION OF HOLD-UPBUTTON.
- B WALL MOUNTED DISPLAYS/ SOLUTIONS:
 REFER TO A6 SERIES SHEETS FOR INTERIOR ELEVATIONS
 & A3.4.5, A6.03 & A6.04 FOR MOUNTING HEIGHTS & NICHE
 CONSTRUCTION DETAILS (WHERE SHOWN).

FURNITURE & EQUIPMENT KEYNOTES

ACCESS REQUIRES FLOOR SLAB ANCHORS - REFER TO EQUIPMENT INSTALLATION MANUAL

2 DRTs ARE NOT REQUIRED TO BE CAPTURED BY A SECURITY CAMERA.

1 ALL FLOOR-MOUNTED BANK EQUIPMENT WITH 24/7


3 TRASH RECEPTABLE BY BRANCH PLANNING4 TRASH RECEPTACLE BY G.C.

5 SOLUTION #3 (75") - WALL MOUNTED DISPLAY MONITOR; SEE GENERAL FURNITURE & EQUIPMENT NOTES. 6 NOT USED

7 SOLUTION #7 (32") - WALL MOUNTED DISPLAY MONITOR; SEE GENERAL FURNITURE & EQUIPMENT NOTES.

8 PROVIDE FINISHED BACK PANEL FOR NOTED FURNITURE


IP MORGAN CHASE, N.
HWY 291 & NE LANGSFORD RD
890 NE LANGSFORD RD

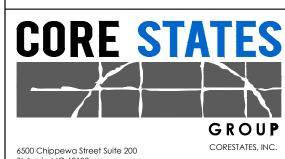

6500 Chippewa Street Suite 200 St. Louis, MO 63109 314.843.4320 www.core-states.com

COA #: A-2014026908

ARCHITECT OF RECORD

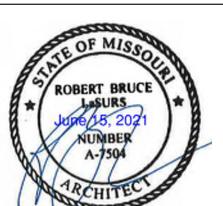

ARCHITECT: R. BRUCE LASURS LICENSE NUMBER: 007504

THESE DRAWINGS ARE NOT COMPLETE WITHOUT THE SEPARATE TYPE WRITTEN SPECIFICATIONS MANUAL WHICH ARE PART OF THE CONTRACT DOCUMENTS.

ISSUE DATE DESCRIPTION

- 2020.12.21 PERMIT SET

1 2021.04.20 STRUCTURAL STEEL REV

2 2021.06.03 PLAN REVIEW COMMENTS, RDC21 & WIRELESS UPDATE

PROJECT INFORMATION

PROJECT NO: JPM.27135.001

DATE: 2020.12.21

PROTOTYPE: 20.2

DRAWN BY: C.THEBEAU


CHECKED BY: B.LaSURS

VERSION: SE_1.00

FURNITURE & EQUIPMENT PLAN

SHEET NUMBER

SHEET TITLE

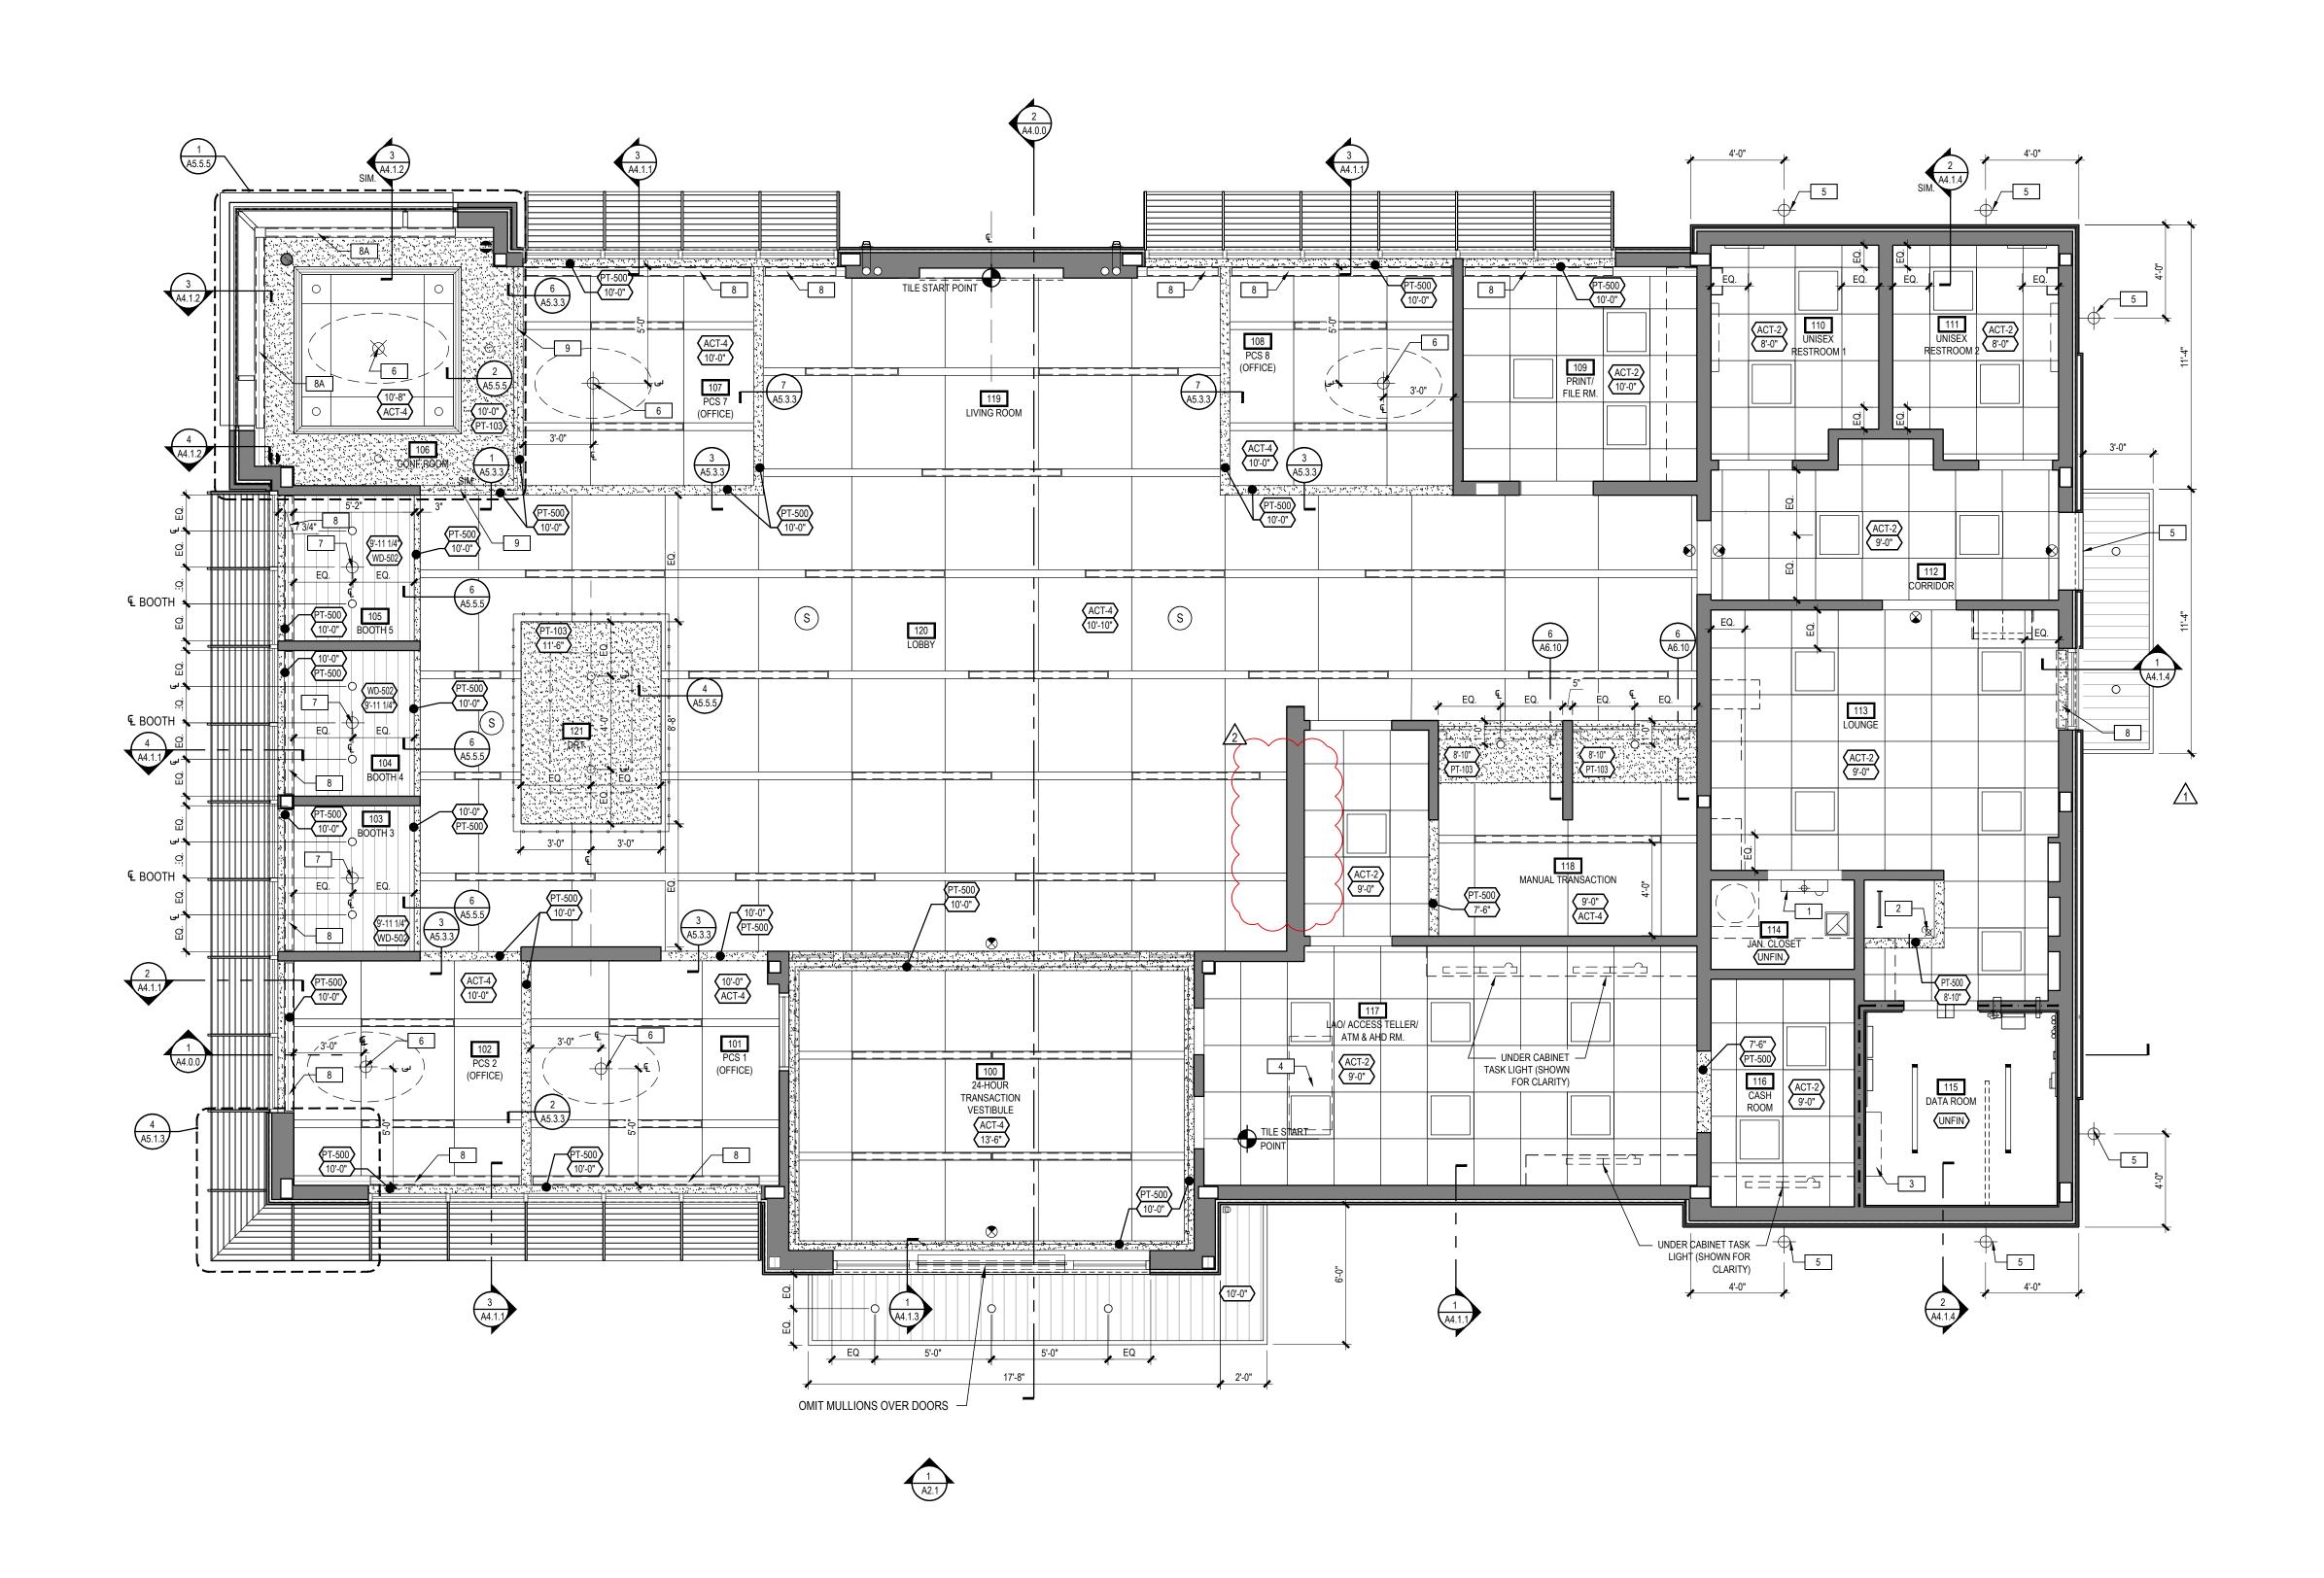




- A. ALL CEILING FIXTURES TO BE CENTERED ON CEILING TILE UNLESS SHOWN & NOTED OTHERWISE.
- B. ACOUSTIC CEILING TILE TO BE CENTERED ON SPACE.
- UNLESS SHOWN & NOTED OTHERWISE.

ACOUSTIC CEILING TILE GRID; SEE SHEET A5.5.4 FOR DETAILS.

RCP KEYNOTES

- 1 WALL LIGHT OVER DOOR REFER TO ELECTRICAL DRAWINGS.
- 2 WALL LIGHT IN LADDER CHASE REFER TO ELECTRICAL DRAWINGS.
- 3 WALL MOUNT HVAC UNIT REFER TO MECHANICAL DRAWINGS.
- 4 VESTIBULE HVAC UNIT ABOVE CEILING REFER TO MECHANICAL DRAWINGS.
- 5 EXTERIOR WALL MOUNTED LIGHT REFER TO
- ELECTRICAL DRAWINGS AND SHEETS A2.1.0 AND A2.2.0 FOR LOCATION. 6 OFFICE/ CONFERENCE ROOM PENDANT TO BE CENTERED
- ON DESK/TABLE BELOW. VERIFY DIMENSIONS SHOWN ON PLANS W/ FURNITURE PLANS. COORDINATE WITH ARCHITECT IF LIGHT INTERFERES WITH CEILING GRID. REFER TO ELECTRICAL PLANS FOR MORE INFORMATION. OFFICE: PENDANT, INSTALLED AT 82" A.F.F. CONFERENCE: PENDANT, INSTALLED AT 82" A.F.F.
- BOOTH: PENDANT, INSTALLED AT 66" A.F.F. REFER TO ELECTRICAL DRAWINGS FOR MORE INFORMATION 8 WINDOW SHADE; SEE FINISH PLAN AND FINISH SCHEDULE
- FOR MORE INFORMATION 8A WINDOW SHADE, SURFACE MOUNTED; SEE FINISH PLAN
- AND FINISH SCHEDULE FOR MORE INFORMATION

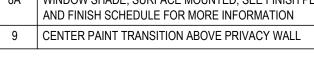






6500 Chippewa Street Suite 200 St. Louis, MO 63109 314.843.4320

COA #: A-2014026908 ARCHITECT OF RECORD

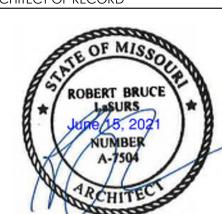

ARCHITECT: R. BRUCE LASURS

2 2021.06.03 PLAN REVIEW COMMENTS, RDC21 & WIRELESS UPDATE

PROJECT INFORMATION

JPM.27135.001 2020.12.21

C.THEBEAU

B.LaSURS

SE_1.00

PROJECT NO:

PROTOTYPE:

DRAWN BY: CHECKED BY:

VERSION:

SHEET TITLE

LICENSE NUMBER: 007504 THESE DRAWINGS ARE NOT COMPLETE WITHOUT THE SEPARATE TYPE WRITTEN SPECIFICATIONS MANUAL WHICH ARE PART OF THE CONTRACT DOCUMENTS.

$\mathcal{N}_{\otimes_{0}}$	WALL MOUNT LIGHT FIXTURE AT LADDER:			
~>	REFER TO ELEC DWGS FOR ADDL INFO	ISSUE	DATE	DESCRIPTION
+	EXTERIOR SCONE LIGHT: REFER TO ELEC DWGS FOR ADDL INFO	-	2020.12.21	PERMIT SET
		1	2021.04.20	STRUCTURAL STEEL REV

REFER TO ELEC DWG. FOR ADDL INFO SUPPLY AIR DIFFUSER:

RCP SYMBOLS LEGEND

RECESSED DOWNLIGHT:

WALL MOUNT LIGHT FIXTURE:
REFER TO ELEC DWGS FOR ADDL INFO

LAY-IN LINEAR LIGHT FIXTURE:
REFER TO ELEC DWGS FOR ADDL INFO


2' x 2' LAY-IN LIGHT FIXTURE:

WALL MOUNTED ACCENT LIGHT FIXTURE: REFER TO ELEC DWGS FOR ADDL INFO

WALL WASHER: REFER TO ELEC DWGS FOR ADDL INFO

REFER TO ELEC DWGS FOR ADDL INFO

DECORATIVE PENDANT: REFER TO ELEC DWGS FOR ADDL INFO

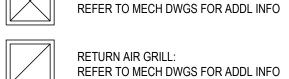

RETURN AIR GRILL: REFER TO MECH DWGS FOR ADDL INFO




EXHAUST FAN: REFER TO MECH DWGS FOR ADDL INFO



ILLUMINATED EXIT SIGN: REFER TO ELEC DWGS FOR ADDL INFO




CEILING MOUNTED SPEAKER: COORDINATE LOCATIONS W/ VENDOR —⊸— LED ACCENT LIGHTING

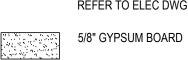


REFLECTED CEILING PLAN REFER TO ELEC DWG. FOR ADDL INFO

SHEET NUMBER

A1.2.1

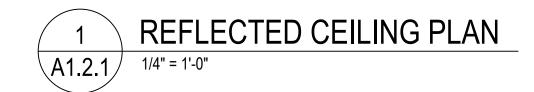



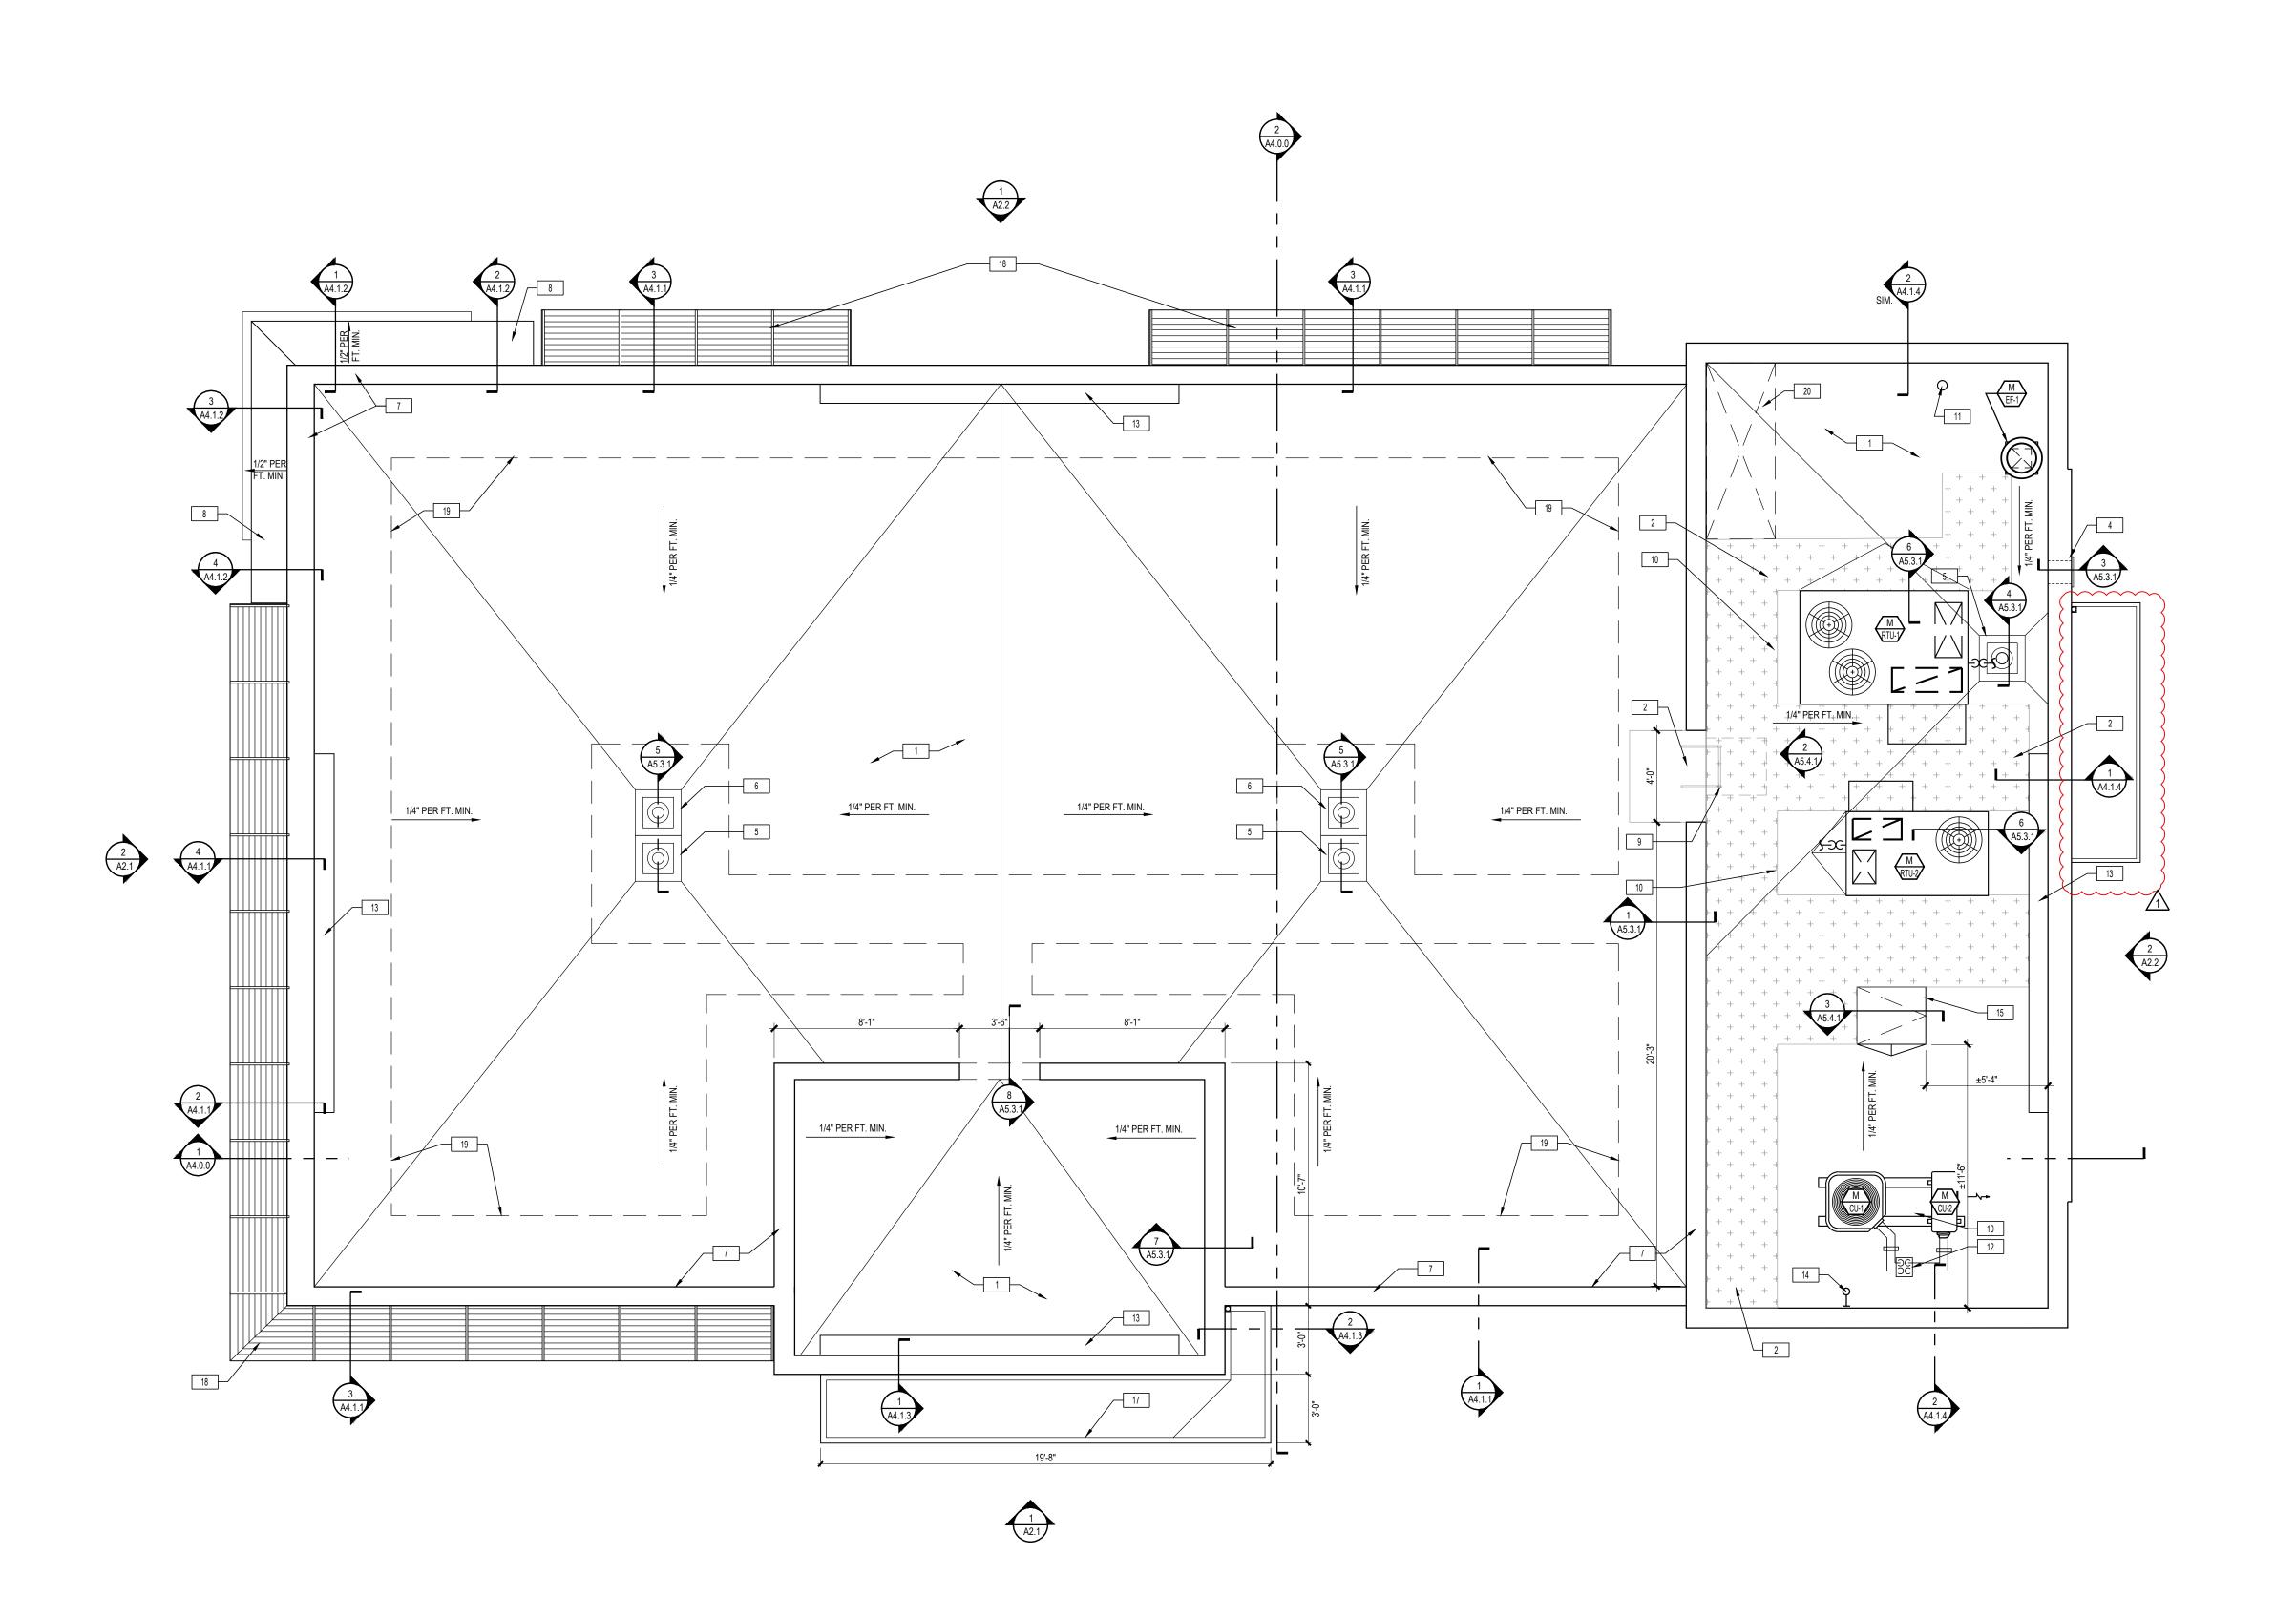

GENERAL ROOF NOTES

A NOT ALL KEYNOTES MAY BE USED. REFER TO DRAWINGS.

ROOF PLAN NOTES

1 LOW-SLOPE ROOFING: THERMOPLASTIC SHEET MEMBRANE ROOFING INSTALLED OVER TAPERED INSULATION AS REQUIRED TO FORM RIDGES, VALLEYS, CRICKETS AND SADDLES AS REQUIRED TO ACHIEVE MINIMUM 1/4" PER FOOT PITCH OR

MANUFACTURER;S MINIMUM PITCH REQUIREMENTS FOR THE APPLICATION, WHICHEVER IS GREATER- FORM SLOPES TO ELIMINATE THE POSSIBLITY OF PONDING, REFER TO WALL SECTIONS AND CONSTRUCTION TYPES. 2 ROOFING TRAFFIC PADS:

ROOFING MANUFACTUER SPECIFICATIONS TO ALL MECHANICAL EQUIPMENT. 3 PIPE PENETRATION: REFER TO MECH. & PLUMBING DWG'S PRE-FABRICATED WATER-TIGHT SURFACE-ADHERED

ROOFING PORTAL COMPATIBLE WITH ROOFING MATERIAL.

SURFACE-ADHERED TEXTURED WALWAY MATERIAL PER

WATER-TIGHT PRE-FINISHED ALUMINUM THROUGH-WALL DRAINAGE CHANNEL- REFER TO DETAILS AS NOTED PAINT TO MATCH ADJACENT WALL FINISH.

ROOF DRAIN: METAL DRAIN PAN AND BASKET ASSEMBLY WITH CLAMP RING SECURED WATER-TIGHT TO ROOFING MEMBRANE-REFER TO PLUMBING FIXTURE SCHEDULE.

OVERFLOW DRAIN:

METAL DRAIN PAN AND BASKET ASSEMBLY WITH CLAMP RING SECURED WATER-TIGHT TO ROOFING MEMBRANE-REFER TO PLUMBING FIXTURE SCHEDULE.

7 PARAPET COPING SYSTEM: SHOP-FABRICATED PRE-FINISHED ALUMINUM- REFER TO WALL SECTIONS FOR DETAILS AND EXTERIOR ELEVATIONS FOR COLOR.

BAY ROOF: SEALED-JOINT ACM COPING / CLADDING SYSTEM OVER LOW-SLOPE ROOFING AND RAIN SCREEN WATERPROOFING SYSTEM; REFER TO EXTERIOR ELEVATIONS AND WALL SECTIONS.

ROOF LADDER: REFER TO DETAILS AS NOTED.

MECHANICAL EQUIPMENT: VENTILATION UNIT, PACKAGED ROOFTOP HEATING AND COOLING UNIT OR SPLIT-SYSTEM A/C UNIT MOUNTED TO SHOP-FAB. VIBRATION-ISOLATING RAIL OR INSULATED CURB UNIT-LAP FLASH WATER-TIGHT TO ROOFING MEMBRANE. REFER TO MECHANICAL DETAILS.

PLUMBING STACK VENT: SIZED AS REQD. WITH PRE-FABRICATED COMPATIBLE 11 FLASHING BOOT ADHERED TO ROOF MEMBRANE- EXTEND VENT TO ALIGN WITH ADJACENT PARAPET COPING AND PROVIDE LATERAL BRACING AS REQD.

12 SURFACE-MOUNT MECHANICAL PIPING: REFER TO MECH. & PLUMBING DWG'S GAS AND REFRIGERANT PIPING SUPPORTED ON ROOFING BY B-LINE DURA-BLOK PRE-FAB. RUBBER-BASE GALVANIZED STEEL UNISTRUT PIPE SUPORTS AT 8'-0" o.c. MAX.

13 SURFACE-MOUNT SIGNAGE EQUIPMENT ENCLOSURE: WATER-TIGHT SHOP-FABRICATED METAL SIGNAGE ENCLOSURE BY SIGN VENDOR- SECURE TO BACKSIDE OF PARAPET WALL WITH MINIMAL PENETRATIONS OF ROOFING MEMBRANE- PROVIDE PERIMETER WATER-TIGHT SEALANT COMPATIBLE WITH ROOF MEMBRANE.

14 LANDSCAPE IRRIGATION SYSTEM WEATHER STATION: FASTENED TO BACKSIDE OF PARAPET USING MFR'S BRACKET- SEAL MEMBRANE PENETRATIONS W/100% SILICONE SEALANT.

15 SCUTTLE: PRE-FAB. INSULATED ROOF SCUTTLE WITH RETRACTABLE SAFET POST-FLASH WATER-TIGHT TO ROOFING MEMBRANE-PROVIDE CARABINER THROUGH LATCH. 30" X 42" ROOF ACCESS PANEL, G.C. TO COORDINATE LOCATION WITH JOIST LAYOUT.

16 (NOT USED) FURNACE VENT: CONCENTRIC OR SIDE-WALL PVC EXHAUST / COMBUSTION AIR INTAKE W/ ROOF MEMBRANE FLASHING BOOT - AT GAS-FIRED FURNACE LOCATIONS ONLY.

17 | ENTRANCE CANOPY: SHOP FABRICATED PRE-FINISHED CUSTOM ALUMINUM CANOPY UNIT WITH INTEGRAL ELECTRICAL AND DRAINAGE SYSTEMS FASTENDED TO BUILDING STRUCTURE- REFER TO ELEVATIONS AND WALL SECTIONS.

18 SUN SHADE:

BY STOREFRONT SYSTEM MANUFACTURER- REFER TO EXTERIOR ELEVATION NOTES. 19 FUTURE PHOTOVOLTAIC PANEL ARRAY AREA: FOR DETAILS

OF FUTURE PV SYSTEM, REFER TO "ROOFTOP SOLAR PROGRAM STANDARD BUILDING PACKAGE" DRAWINGS POSTED TO OVP/SPOTLIGHT; ADDITIONAL STRUCTURAL LOADING IS 5PSF AT SLOPED ROOGS AND 10PSF AT FLAT

20 FUTURE PHOTOVOLTAIC EQUIPMENT AREA- REFER TO ELEC. RISER DIAGRAM.

21 ROOFTOP HOSE BIB. REFER TO PLUMBING DRAWINGS.





6500 Chippewa Street Suite 200 St. Louis, MO 63109 314.843.4320

COA #: A-2014026908 ARCHITECT OF RECORD



ARCHITECT: R. BRUCE LASURS LICENSE NUMBER: 007504

THESE DRAWINGS ARE NOT COMPLETE WITHOUT THE SEPARATE TYPE WRITTEN SPECIFICATIONS MANUAL WHICH ARE PART OF THE CONTRACT DOCUMENTS.

ISSUE DATE DESCRIPTION 2020.12.21 PERMIT SET 1 2021.04.20 STRUCTURAL STEEL REV

PROJECT INFORMATION PROJECT NO: JPM.27135.001 2020.12.21 PROTOTYPE: C.THEBEAU DRAWN BY: CHECKED BY: B.LaSURS

SE_1.00

ROOF PLAN


SHEET NUMBER


VERSION:


SHEET TITLE

A1.3.1

ROOF PLAN

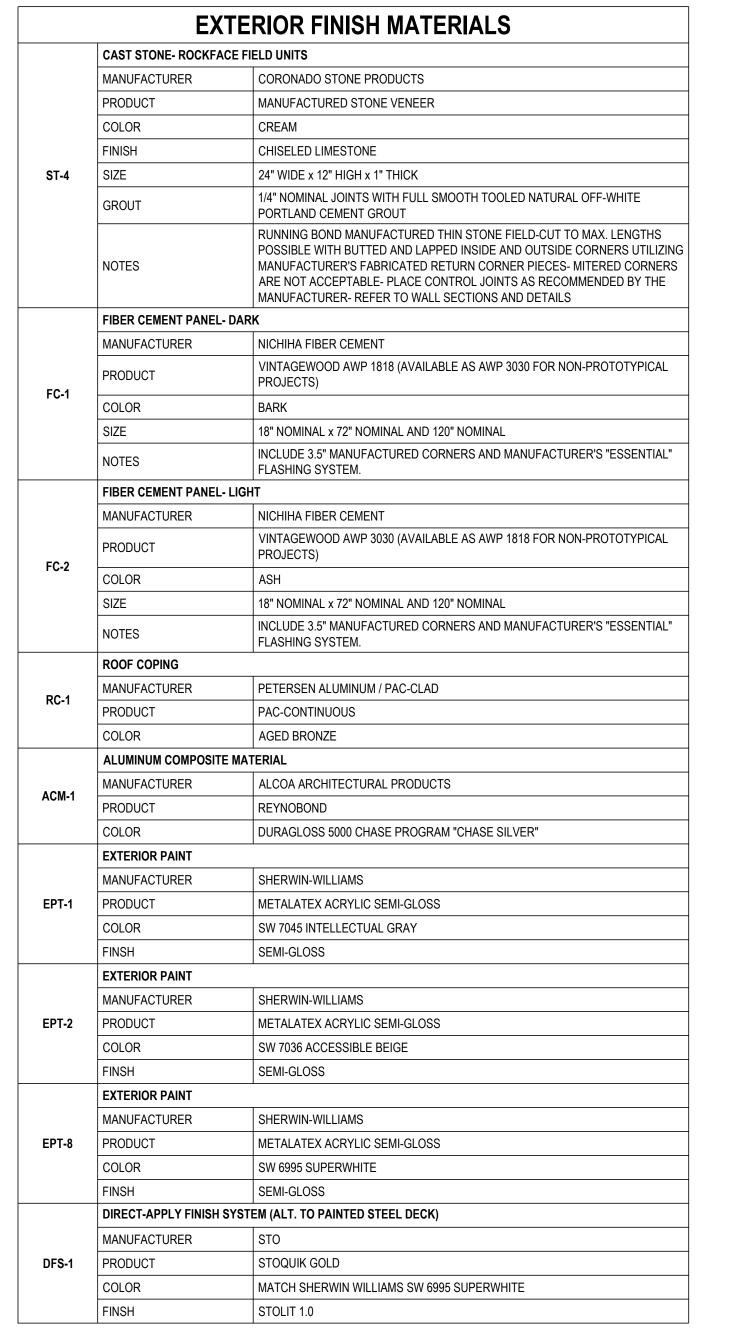

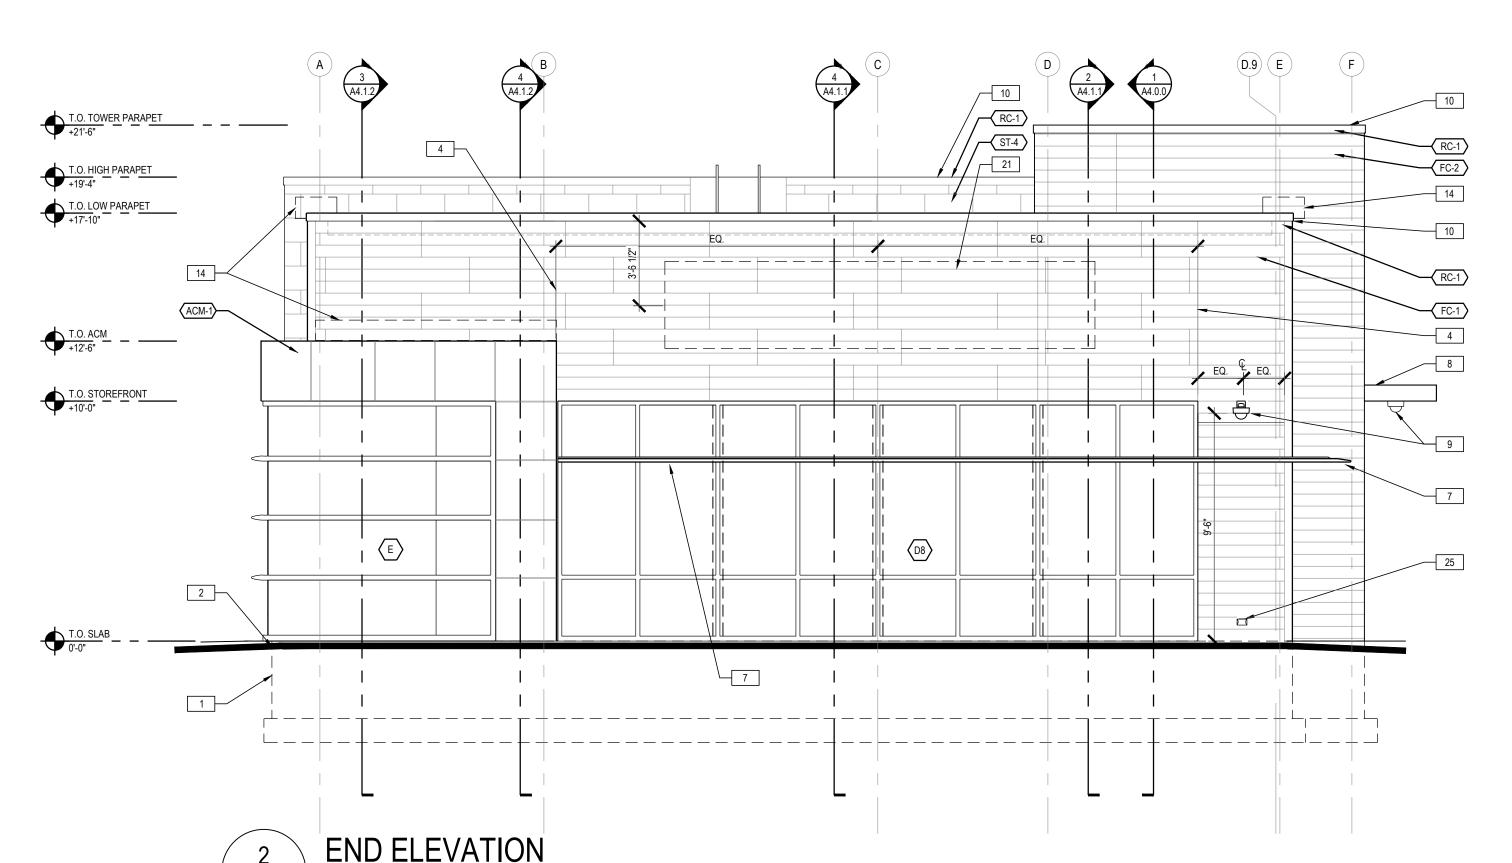

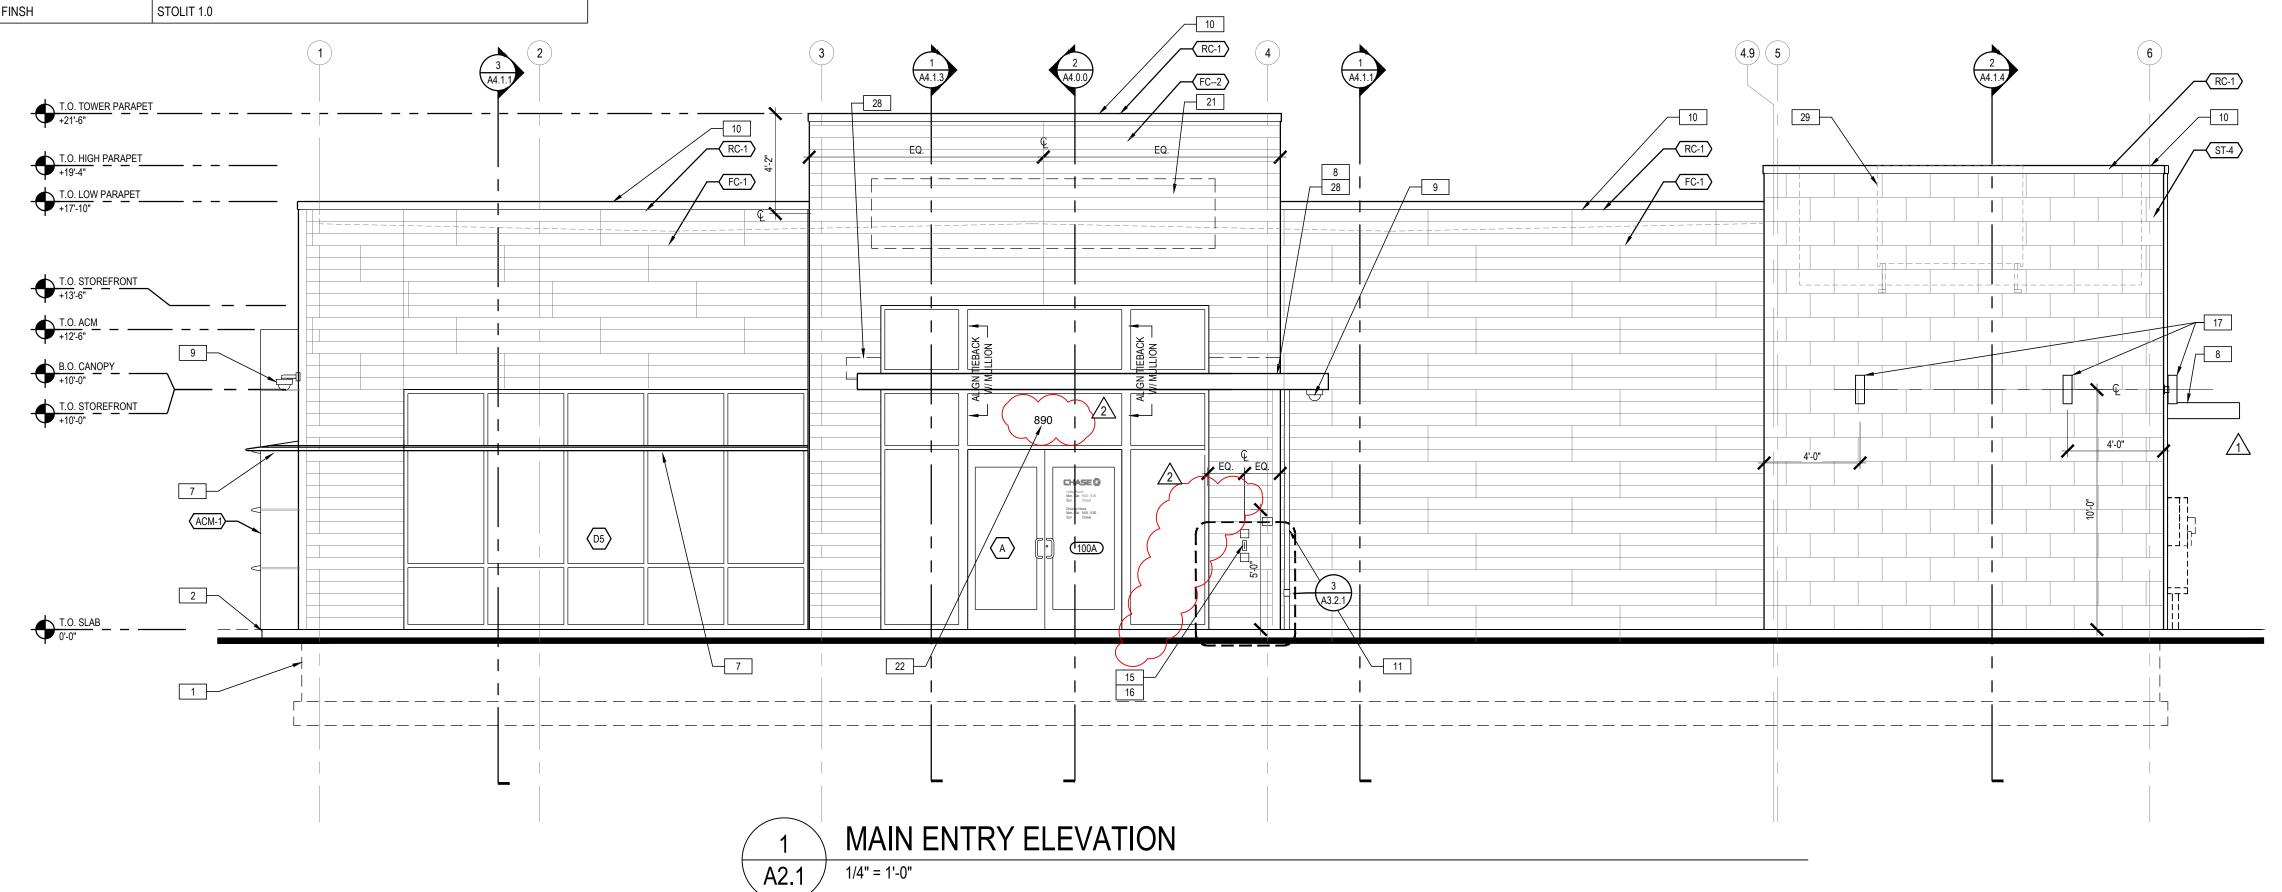

1/4" = 1'-0"

GENERAL EXTERIOR NOTES

A G.C. TO VERIFY EXTERIOR COLOR & MATERIAL LOCATIONS AS SHOWN ON ELEVATION DRAWINGS WITH CHASE DESIGNER & APPROVED BRANDING PACKAGE PRIOR TO PURCHASE & INSTALLATION.

ELEVATION NOTES

CONCRETE FOOTINGS / FOUNDATIONS: REFER TO STRUCTURAL DWGS.

CONCRETE CURB AND ISLANDS: REFER TO ARCHITECTURAL SITE PLAN AND DRIVE-UP CANOPY PLAN - SEE CIVIL DWGS FOR ADD'T INFO.

EMERGENCY ACCESS KEY BOX: NOT REQUIRED

4 CONTROL / EXPANSION JOINT: VERTICAL ELASTOMERIC SEALANT JOINT CONTINUOUS THROUGH MASONRY VENEER - MATCH SEALANT COLOR TO VENEER COLOR

LANDSCAPE IRRIGATION SYSTEM: CONTROLLER, WIRELESS NETWORK CONNECTOR, J AND DEDICATED WP POWER OUTLET. REFER TO SITE PLAN AND ELECTRICAL DRAWINGS

LIGHTING TIMER SYSTEM PHOTO SENSOR: REFER TO ELECTRICAL DRAWINGS

SUN SHADE: GLAZING SYSTEM MANUFACTUER'S STANDARD INTEGRAL SHADE ACCESSORY- REFER TO WALL SECTIONS; MATCH GLAZING SYSTEM FINISH. BASIS OF DESIGN IS KAWNEER VERSOLEIL 30" WEDGE WITH ANGULAR FASCIA AND CIRCULAR BLADES.

8 | ENTRANCE CANOPY: SHOP FABRICATED SITE-ASSEMBLED PRE-FINISHED BLACK CUSTOM ALUMINUM CANOPY UNIT WITH PREPPED ELECTRICAL OPENINGS AND INTEGRAL DRAINAGE SYSTEM FASTENDED TO BUILDING STRUCTURE- MAPES ARCHITECTURAL CANOPIES SUPER LUMIDECK WITH FLAT SOFFIT AND 12" FASCIA, OR APPROVED EQUAL- REFER TO ROOF PLAN AND WALL SECTIONS- INSTALLED BY G.C.

SECURITY CAMERA: PROVIDE CONCEALED JUNCTION BOX AND CONDUIT TO INTERIOR; REFER TO OWNER'S SECURITY CONSULTANT

10 COPING: REFER TO EXTERIOR FINISH ON THIS SHEET

11 | SMALL CANOPY DOWNSPOUT / OVERFLOW: 3" DIAM. ALUMINUM DOWNSPOUT PRE-FIN. TO MATCH THE CANOPY; CONNECT TO CAST IRON DRAIN HUB AT GRADE AND EXTEND SUBSURFACE TO SITE DRAINAGE SYSTEM-REFER TO PLUMBING DWGS AND SITE PLAN.

12 SCUPPER: PAINT TO MATCH ADJACENT EXTERIOR FINISHES. REFER TO ROOF PLAN.

13 ROOF OVERFLOW DOWNSPOUT NOZZLE: REFER TO PLUMBING DRAWINGS AND PLUMBING FIXTURE SCHEDULE

14 METAL FLASHING AND COUNTERFLASHING CONCEALED BEHIND WALL FINISH AND FINISH OF EXPOSED FLASHING TO MATCH ADJACENT ROOFING/COPING

15 AUTOMATIC DOOR OPERATOR BUTTON RECESSED FLUSH WITH WALL SURFACE- DO NOT SURFACE-MOUNT

16 KEYCARD READER RECESSED FLUSH WITH WALL SURFACE- DO NOT SURFACE-MOUNT. 17 | SURFACE-MOUNT DECORATIVE LIGHT FIXTURE:

REFER TO REFLECTED CEILING PLAN AND ELECTRICAL

DRAWINGS 18 | SURFACE-MOUNT EMERGENCY LIGHT FIXTURE: TO BE PROVIDED ONLY WHEN DOOR BELOW IS A REQUIRED OR MARKED EXIT - REFER TO REFLECTED CEILING PLAN AND LIGHT FIXTURE SCHEDULE

19 BOLLARD: CONCRETE-FILLED STEEL PIPE EMBEDDED IN CONCRETE CURB- WITH PLASTIC COVER- REFER TO SITE PLAN, DRIVE-UP CANOPY PLAN AND DETAILS- OMIT AT POSITIONS NOT ADJACENT TO VEHICULAR LANE

20 BANK EQUIPMENT: FURNISHED AND INSTALLED BY BANK EQUIPMENT VENDOR- COORD. WALL OPENINGS AND ELECTRICAL / DATA REQUIREMENTS WITH OWNER-FURNISHED

EQUIPMENT SHOP DRAWINGS AND PRODUCT DATA 21 SIGNAGE LOCATION: SIGNAGE BY OWNER'S SIGN VENDOR- N.I.C.- PROVIDE ROUGH ELEC. WORK AND BLOCKING IN WALL AS REQD. FOR VENDOR INSTALLATION. CONFIRM FINAL LOCATION WITH SIGN VENDOR.

22 BUILDING ADDRESS NUMBER: WHITE VINYL NUMBERS WITH 1/2" WIDE STROKE APPLIED TO INTERIOR FACE OF GLASS TRANSOM- MIN. 6" HEIGHT OR AS REQD. BY LOCAL CODE

23 GAS METER:

(LANDSCAPE, WALK, ETC.)

REFER TO SITE PLAN AND PLUMBING DRAWINGS 24 FIRE DEPARTMENT CONNECTION: FIRE SUPPRESSION SYSTEM EXTERIOR CONNECTION WHERE REQD. BY LOCAL CODE ONLY- VERIFY FINAL LOCATION WITH LOCAL AUTHORITIES HAVING JURISDICTION

25 | ELECTRICAL OUTLET: SET FLUSH WITH FACE OF MASONRY VENEER- PROVIDE METAL COVER COMPLIANT WITH N.E.C. 26 UTILITY EQUIPMENT:

PROVIDE AND INSTALL UTILITY TERMINATION CABINETS AND METERS AS REQUIRED- COORD. WITH OWNER'S SECURITY AND TELE-DATA SERVICES- COORD. CABINET AND METER LOCATIONS WITH LOCAL JURISDICTION-REFER TO SITE PLAN

27 TELE / DATA / UTILITY CONNECTIONS: COORDINATE FINAL LOCATION WITH CIVIL ENGINEER

28 | FLASHING AT PREFAB CANOPY: PRE-FINISHED ALUMINUM FLASHING TO SPAN GAP BETWEEN PREFAB CANOPY AND BUILDING- REFER TO WALL SECTIONS AND DETAILS- VERIFY FINAL FLASHING LENGTH AND CONFIGURATION WITH APPROVED CANOPY SHOP DWGS

29 MECHANICAL EQUIPMENT: VENTILATION UNIT. REFER TO MECHANICAL DRAWINGS FOR MORE INFORMATION.

30 SIAMESE CONNECTION: FIRE SUPPRESSION SYSTEM EXTERIOR CONNECTION WHERE REQD. BY LOCAL CODE ONLY- VERIFY FINAL LOCATION WITH LOCAL AUTHORITIES HAVING JURISDICTION

31 | FIRE ALARM SYSTEM BELL AND STROBE: WHERE REQUIRED BY LOCAL CODE ONLY- VERIFY FINAL LOCATION WITH LOCAL AUTHORITIES HAVING **JURISDICTION**





14.843.4320

COA #: A-2014026908 ARCHITECT OF RECORD



ARCHITECT: R. BRUCE LASURS

LICENSE NUMBER: 007504 HESE DRAWINGS ARE NOT COMPLETE WITHOUT THE SEPARATE TYPE WRITTEN SPECIFICATIONS MANUAL WHICH ARE PART OF THE CONTRACT DOCUMENTS.

ISSUE DATE DESCRIPTION 2020.12.21 PERMIT SET 1 2021.04.20 STRUCTURAL STEEL REV 2 2021.06.03 PLAN REVIEW COMMENTS, RDC21 & WIRELESS UPDATE

PROJECT INFORMATION

PROJECT NO: JPM.27135.001 2020.12.21 PROTOTYPE: C.THEBEAU DRAWN BY: CHECKED BY: B.LaSURS VERSION: SE_1.00 SHEET TITLE


> **EXTERIOR ELEVATIONS**


SHEET NUMBER

A2.1.0

	CAST STONE- ROCKFA	CE FIELD UNITS
	MANUFACTURER	CORONADO STONE PRODUCTS
	PRODUCT	MANUFACTURED STONE VENEER
	COLOR	CREAM
	FINISH	CHISELED LIMESTONE
ST-4	SIZE	24" WIDE x 12" HIGH x 1" THICK
	GROUT	1/4" NOMINAL JOINTS WITH FULL SMOOTH TOOLED NATURAL OFF-WHITE PORTLAND CEMENT GROUT
	NOTES	RUNNING BOND MANUFACTURED THIN STONE FIELD-CUT TO MAX. LENGTHS POSSIBLE WITH BUTTED AND LAPPED INSIDE AND OUTSIDE CORNERS UTILIZING MANUFACTURER'S FABRICATED RETURN CORNER PIECES- MITERED CORNERS ARE NOT ACCEPTABLE- PLACE CONTROL JOINTS AS RECOMMENDED BY THE MANUFACTURER- REFER TO WALL SECTIONS AND DETAILS
	FIBER CEMENT PANEL	- DARK
	MANUFACTURER	NICHIHA FIBER CEMENT
50 4	PRODUCT	VINTAGEWOOD AWP 1818 (AVAILABLE AS AWP 3030 FOR NON-PROTOTYPICAL PROJECTS)
FC-1	COLOR	BARK
	SIZE	18" NOMINAL x 72" NOMINAL AND 120" NOMINAL
	NOTES	INCLUDE 3.5" MANUFACTURED CORNERS AND MANUFACTURER'S "ESSENTIAL" FLASHING SYSTEM.
	FIBER CEMENT PANEL	- LIGHT
	MANUFACTURER	NICHIHA FIBER CEMENT
FC-2	PRODUCT	VINTAGEWOOD AWP 3030 (AVAILABLE AS AWP 1818 FOR NON-PROTOTYPICAL PROJECTS)
FU-Z	COLOR	ASH
	SIZE	18" NOMINAL x 72" NOMINAL AND 120" NOMINAL
	NOTES	INCLUDE 3.5" MANUFACTURED CORNERS AND MANUFACTURER'S "ESSENTIAL" FLASHING SYSTEM.
	ROOF COPING	
RC-1	MANUFACTURER	PETERSEN ALUMINUM / PAC-CLAD
10-1	PRODUCT	PAC-CONTINUOUS
	COLOR	AGED BRONZE
	ALUMINUM COMPOSIT	E MATERIAL
ACM-1	MANUFACTURER	ALCOA ARCHITECTURAL PRODUCTS
ACIVI-1	PRODUCT	REYNOBOND
	COLOR	DURAGLOSS 5000 CHASE PROGRAM "CHASE SILVER"
	EXTERIOR PAINT	
	MANUFACTURER	SHERWIN-WILLIAMS
EPT-1	PRODUCT	METALATEX ACRYLIC SEMI-GLOSS
	COLOR	SW 7045 INTELLECTUAL GRAY
	FINSH	SEMI-GLOSS
	EXTERIOR PAINT	
	MANUFACTURER	SHERWIN-WILLIAMS
EPT-2	PRODUCT	METALATEX ACRYLIC SEMI-GLOSS
	COLOR	SW 7036 ACCESSIBLE BEIGE
	FINSH	SEMI-GLOSS
	EXTERIOR PAINT	
	MANUFACTURER	SHERWIN-WILLIAMS
EPT-8	PRODUCT	METALATEX ACRYLIC SEMI-GLOSS
	COLOR	SW 6995 SUPERWHITE
	FINSH	SEMI-GLOSS
	DIRECT-APPLY FINISH	SYSTEM (ALT. TO PAINTED STEEL DECK)
	MANUFACTURER	STO
DFS-1	PRODUCT	STOQUIK GOLD
	COLOR	MATCH SHERWIN WILLIAMS SW 6995 SUPERWHITE
		+

FINSH

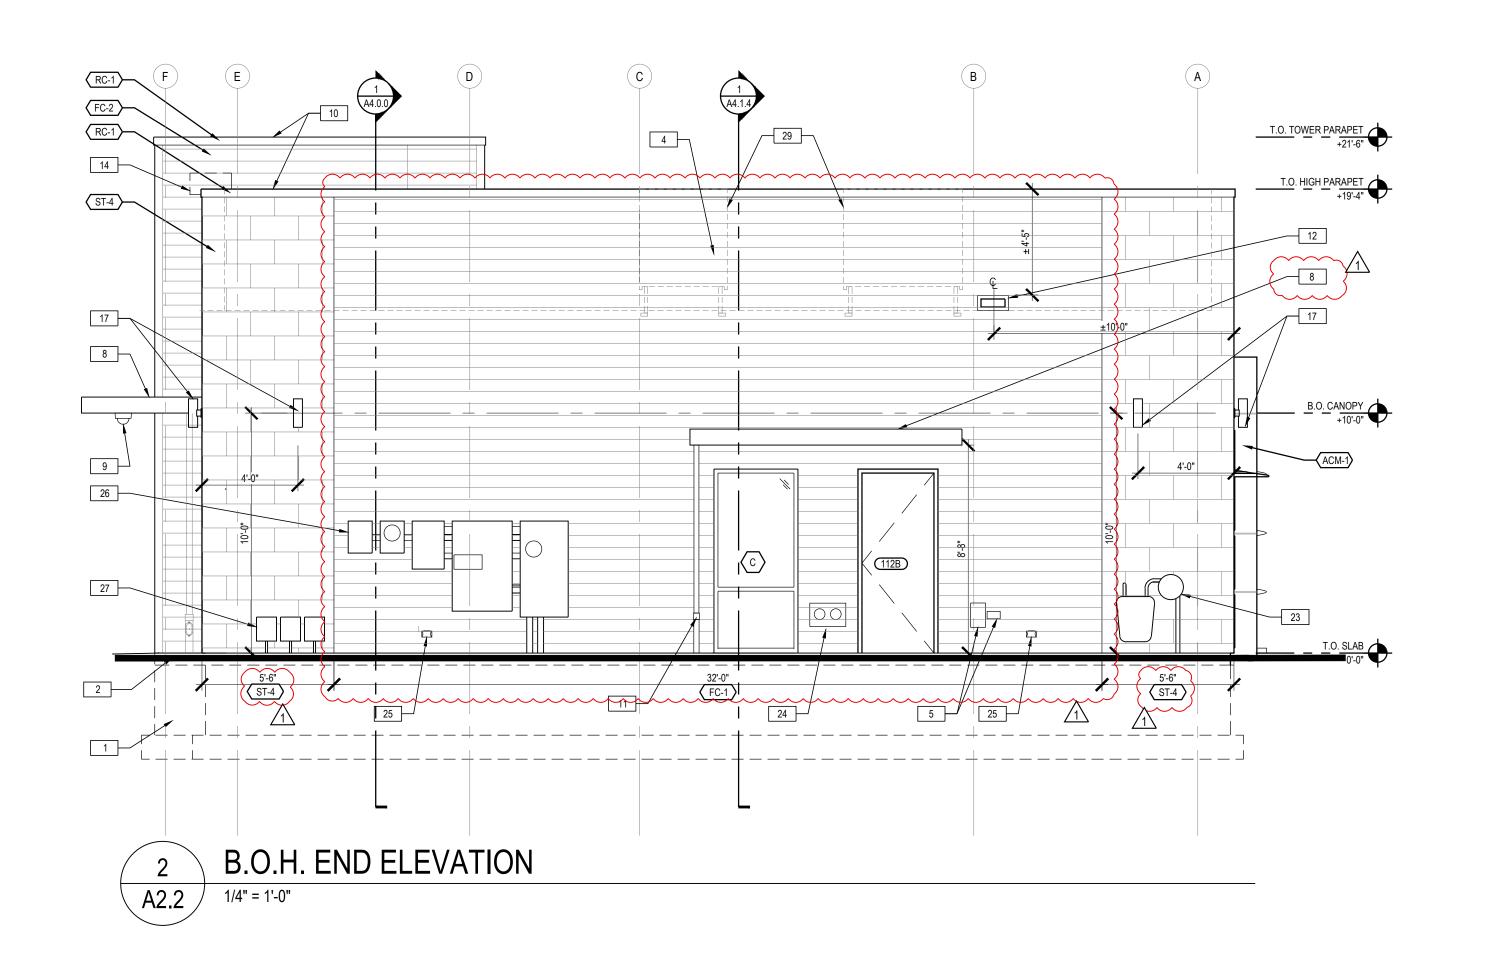

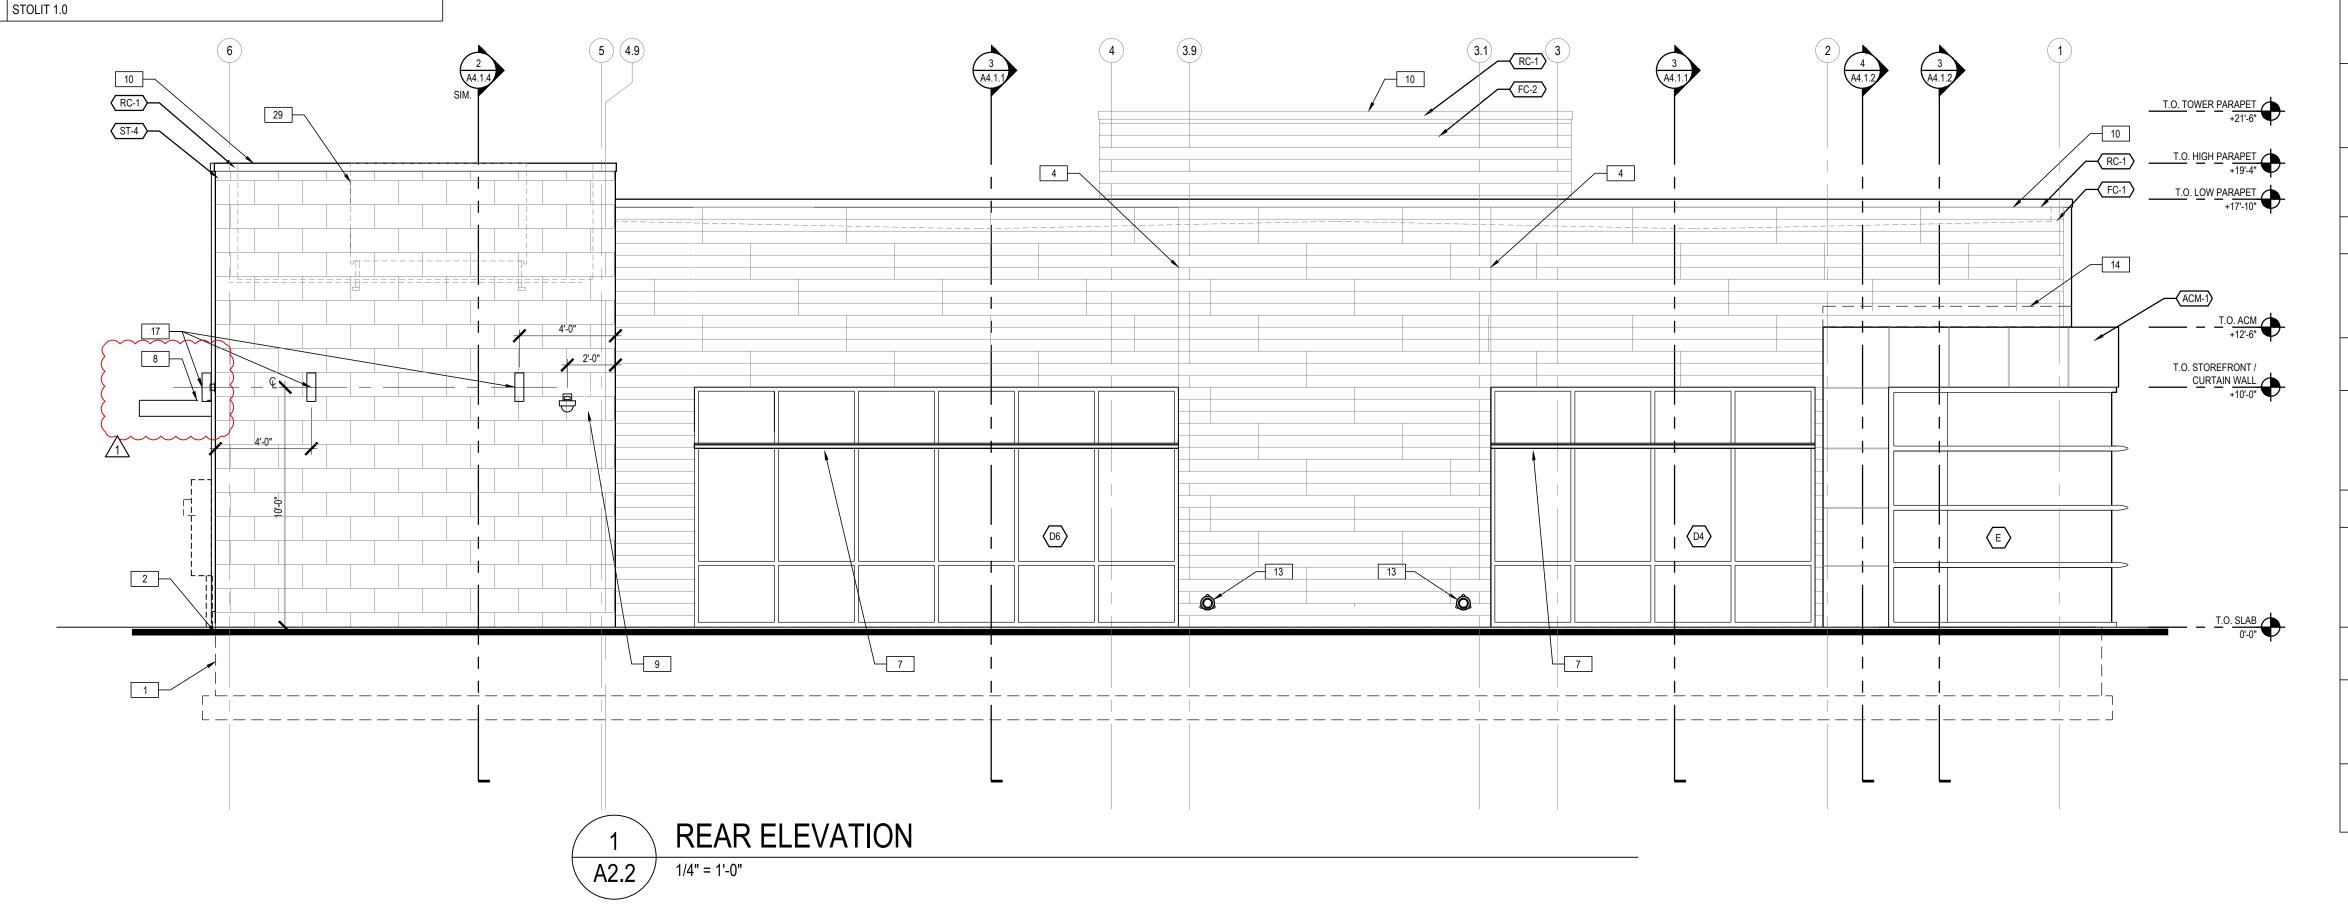

GENERAL EXTERIOR NOTES

A G.C. TO VERIFY EXTERIOR COLOR & MATERIAL LOCATIONS AS SHOWN ON ELEVATION DRAWINGS WITH CHASE DESIGNER & APPROVED BRANDING PACKAGE PRIOR TO PURCHASE & INSTALLATION.

ELEVATION NOTES CONCRETE FOOTINGS / FOUNDATIONS: REFER TO STRUCTURAL DWGS. CONCRETE CURB AND ISLANDS: REFER TO ARCHITECTURAL SITE PLAN AND DRIVE-UP CANOPY PLAN - SEE CIVIL DWGS FOR ADD'T INFO. EMERGENCY ACCESS KEY BOX: WHERE REQUIRED BY LOCAL CODE ONLY-RECESS-MOUNT IN WALL CONSTRUCTION AS REQD. TO SET FACE FLUSH WITH ADJACENT WALL FINISH- VERIFY FINAL LOCATION WITH AUTHORITIES HAVING JURISDICTION

VERTICAL ELASTOMERIC SEALANT JOINT CONTINUOUS THROUGH MASONRY VENEER - MATCH SEALANT COLOR TO VENEER COLOR 5 LANDSCAPE IRRIGATION SYSTEM:

CONTROLLER, WIRELESS NETWORK CONNECTOR, J AND DEDICATED WP POWER OUTLET. REFER TO SITE PLAN AND ELECTRICAL DRAWINGS

6 LIGHTING TIMER SYSTEM PHOTO SENSOR: REFER TO ELECTRICAL DRAWINGS

4 | CONTROL / EXPANSION JOINT:

SUN SHADE: GLAZING SYSTEM MANUFACTUER'S STANDARD INTEGRAL SHADE ACCESSORY- REFER TO WALL SECTIONS; MATCH GLAZING SYSTEM FINISH. BASIS OF DESIGN IS KAWNEER VERSOLEIL 30" WEDGE WITH ANGULAR FASCIA AND CIRCULAR BLADES.

8 ENTRANCE CANOPY: SHOP FABRICATED SITE-ASSEMBLED PRE-FINISHED BLACK CUSTOM ALUMINUM CANOPY UNIT WITH PREPPED ELECTRICAL OPENINGS AND INTEGRAL DRAINAGE SYSTEM FASTENDED TO BUILDING STRUCTURE- MAPES ARCHITECTURAL CANOPIES SUPER LUMIDECK WITH FLAT SOFFIT AND 12" FASCIA, OR APPROVED EQUAL- REFER TO ROOF PLAN AND WALL SECTIONS- INSTALLED BY G.C.

SECURITY CAMERA: PROVIDE CONCEALED JUNCTION BOX AND CONDUIT TO INTERIOR; REFER TO OWNER'S SECURITY CONSULTANT DRAWINGS.

10 COPING: REFER TO EXTERIOR FINISH ON THIS SHEET

11 | SMALL CANOPY DOWNSPOUT / OVERFLOW: 3" DIAM. ALUMINUM DOWNSPOUT PRE-FIN. TO MATCH THE CANOPY; CONNECT TO CAST IRON DRAIN HUB AT GRADE AND EXTEND SUBSURFACE TO SITE DRAINAGE SYSTEM-REFER TO PLUMBING DWGS AND SITE PLAN.

12 SCUPPER: PAINT TO MATCH ADJACENT EXTERIOR FINISHES. REFER TO ROOF PLAN.

13 ROOF OVERFLOW DOWNSPOUT NOZZLE: REFER TO PLUMBING DRAWINGS AND PLUMBING FIXTURE SCHEDULE

14 METAL FLASHING AND COUNTERFLASHING CONCEALED BEHIND WALL FINISH AND FINISH OF EXPOSED FLASHING TO MATCH ADJACENT ROOFING/COPING

15 AUTOMATIC DOOR OPERATOR BUTTON RECESSED FLUSH

WITH WALL SURFACE- DO NOT SURFACE-MOUNT.

16 KEYCARD READER RECESSED FLUSH WITH WALL SURFACE- DO NOT SURFACE-MOUNT. 17 | SURFACE-MOUNT DECORATIVE LIGHT FIXTURE: REFER TO REFLECTED CEILING PLAN AND ELECTRICAL

DRAWINGS 18 SURFACE-MOUNT EMERGENCY LIGHT FIXTURE: TO BE PROVIDED ONLY WHEN DOOR BELOW IS A REQUIRED OR MARKED EXIT - REFER TO REFLECTED CEILING PLAN AND LIGHT FIXTURE SCHEDULE

19 BOLLARD: CONCRETE-FILLED STEEL PIPE EMBEDDED IN CONCRETE CURB- WITH PLASTIC COVER- REFER TO SITE PLAN, DRIVE-UP CANOPY PLAN AND DETAILS- OMIT AT POSITIONS NOT ADJACENT TO VEHICULAR LANE

20 BANK EQUIPMENT: FURNISHED AND INSTALLED BY BANK EQUIPMENT VENDOR- COORD. WALL OPENINGS AND ELECTRICAL / DATA REQUIREMENTS WITH OWNER-FURNISHED

EQUIPMENT SHOP DRAWINGS AND PRODUCT DATA 21 | SIGNAGE LOCATION: SIGNAGE BY OWNER'S SIGN VENDOR- N.I.C.- PROVIDE ROUGH ELEC. WORK AND BLOCKING IN WALL AS REQD. FOR VENDOR INSTALLATION. CONFIRM FINAL LOCATION

WITH SIGN VENDOR. 22 BUILDING ADDRESS NUMBER: WHITE VINYL NUMBERS WITH 1/2" WIDE STROKE APPLIED TO INTERIOR FACE OF GLASS TRANSOM- MIN. 6" HEIGHT

23 GAS METER:

(LANDSCAPE, WALK, ETC.)

REFER TO SITE PLAN AND PLUMBING DRAWINGS 24 FIRE DEPARTMENT CONNECTION: FIRE SUPPRESSION SYSTEM EXTERIOR CONNECTION WHERE REQD. BY LOCAL CODE ONLY- VERIFY FINAL LOCATION WITH LOCAL AUTHORITIES HAVING JURISDICTION

25 ELECTRICAL OUTLET:

OR AS REQD. BY LOCAL CODE

SET FLUSH WITH FACE OF MASONRY VENEER- PROVIDE METAL COVER COMPLIANT WITH N.E.C. 26 UTILITY EQUIPMENT:

PROVIDE AND INSTALL UTILITY TERMINATION CABINETS AND METERS AS REQUIRED- COORD. WITH OWNER'S SECURITY AND TELE-DATA SERVICES- COORD. CABINET AND METER LOCATIONS WITH LOCAL JURISDICTION-REFER TO SITE PLAN

27 TELE / DATA / UTILITY CONNECTIONS: COORDINATE FINAL LOCATION WITH CIVIL ENGINEER

28 FLASHING AT PREFAB CANOPY: PRE-FINISHED ALUMINUM FLASHING TO SPAN GAP BETWEEN PREFAB CANOPY AND BUILDING- REFER TO WALL SECTIONS AND DETAILS- VERIFY FINAL FLASHING LENGTH AND CONFIGURATION WITH APPROVED CANOPY SHOP DWGS

29 MECHANICAL EQUIPMENT: VENTILATION UNIT. REFER TO MECHANICAL DRAWINGS FOR MORE INFORMATION.

30 SIAMESE CONNECTION: FIRE SUPPRESSION SYSTEM EXTERIOR CONNECTION WHERE REQD. BY LOCAL CODE ONLY- VERIFY FINAL LOCATION WITH LOCAL AUTHORITIES HAVING JURISDICTION


31 | FIRE ALARM SYSTEM BELL AND STROBE: WHERE REQUIRED BY LOCAL CODE ONLY- VERIFY FINAL LOCATION WITH LOCAL AUTHORITIES HAVING JURISDICTION





St. Louis, MO 63109 314.843.4320

COA #: A-2014026908 ARCHITECT OF RECORD

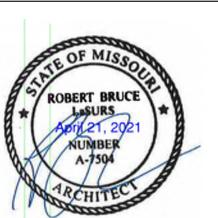

ARCHITECT: R. BRUCE LASURS LICENSE NUMBER: 007504

ISSUE DATE DESCRIPTION

HESE DRAWINGS ARE NOT COMPLETE WITHOUT THE SEPARATE TYPE WRITTEN SPECIFICATIONS MANUAL WHICH ARE PART OF THE CONTRACT DOCUMENTS.

2020.12.21 PERMIT SET 1 2021.04.20 STRUCTURAL STEEL REV


PROJECT INFORMATION PROJECT NO:

JPM.27135.001 2020.12.21 PROTOTYPE: DRAWN BY: C.THEBEAU B.LaSURS CHECKED BY: VERSION: SE_1.00 SHEET TITLE


> **EXTERIOR ELEVATIONS**


SHEET NUMBER

A2.2.0

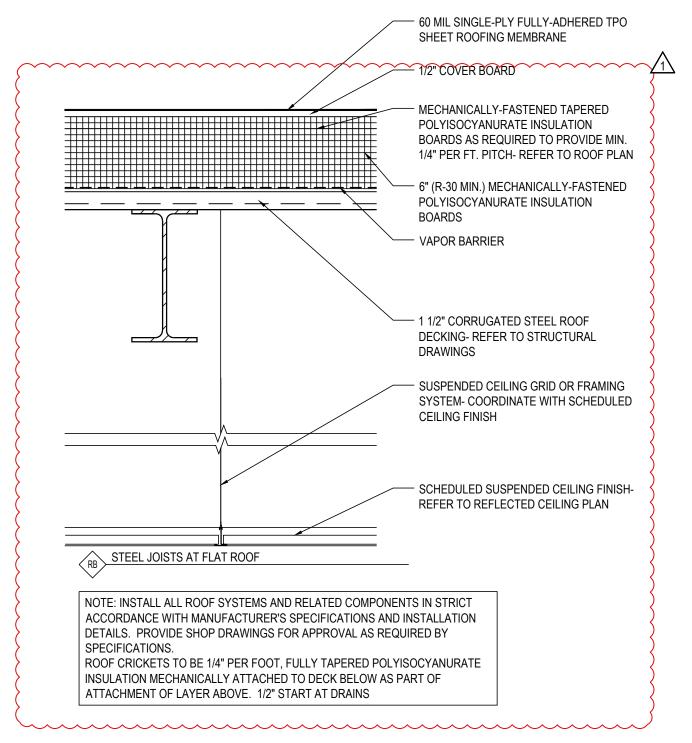




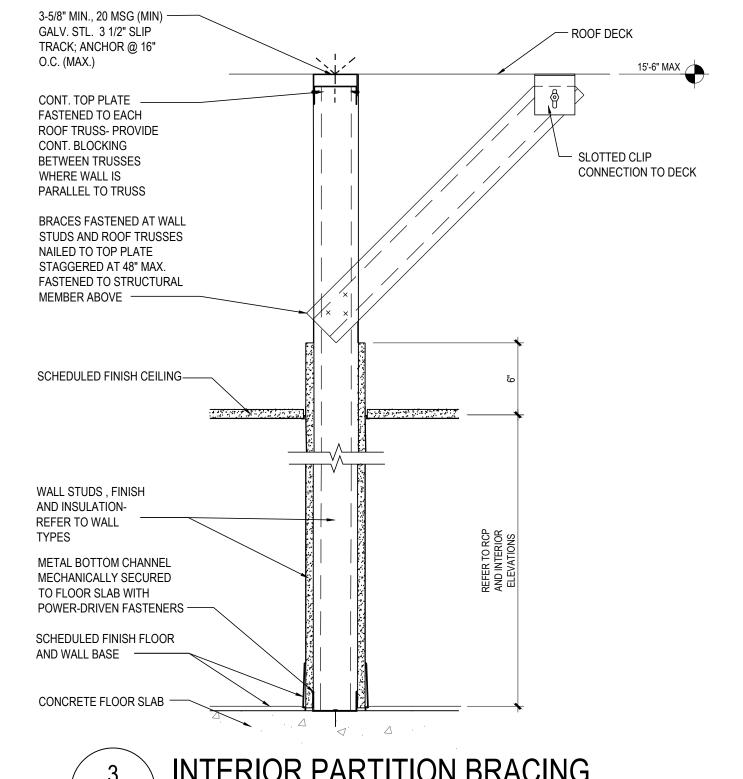


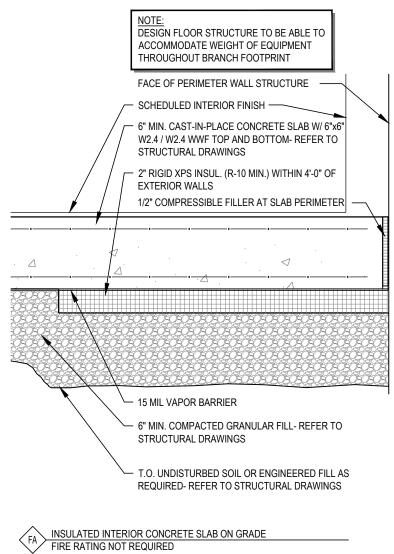

FA1 UNINSULATED INTERIOR CONCRETE SLAB ON GRADE SAME AS 'FA' EXCEPT OMIT INSULATION FA2 EXTERIOR CONCRETE SLAB ON GRADE

SAME AS 'FA'1 EXCEPT 5" SLAB THICKNESS AND SINGLE LAYER OF 6"x6" W1.6 / W1.6 WWF AT TOP OF SLAB. REFER TO CIVIL DWGS.

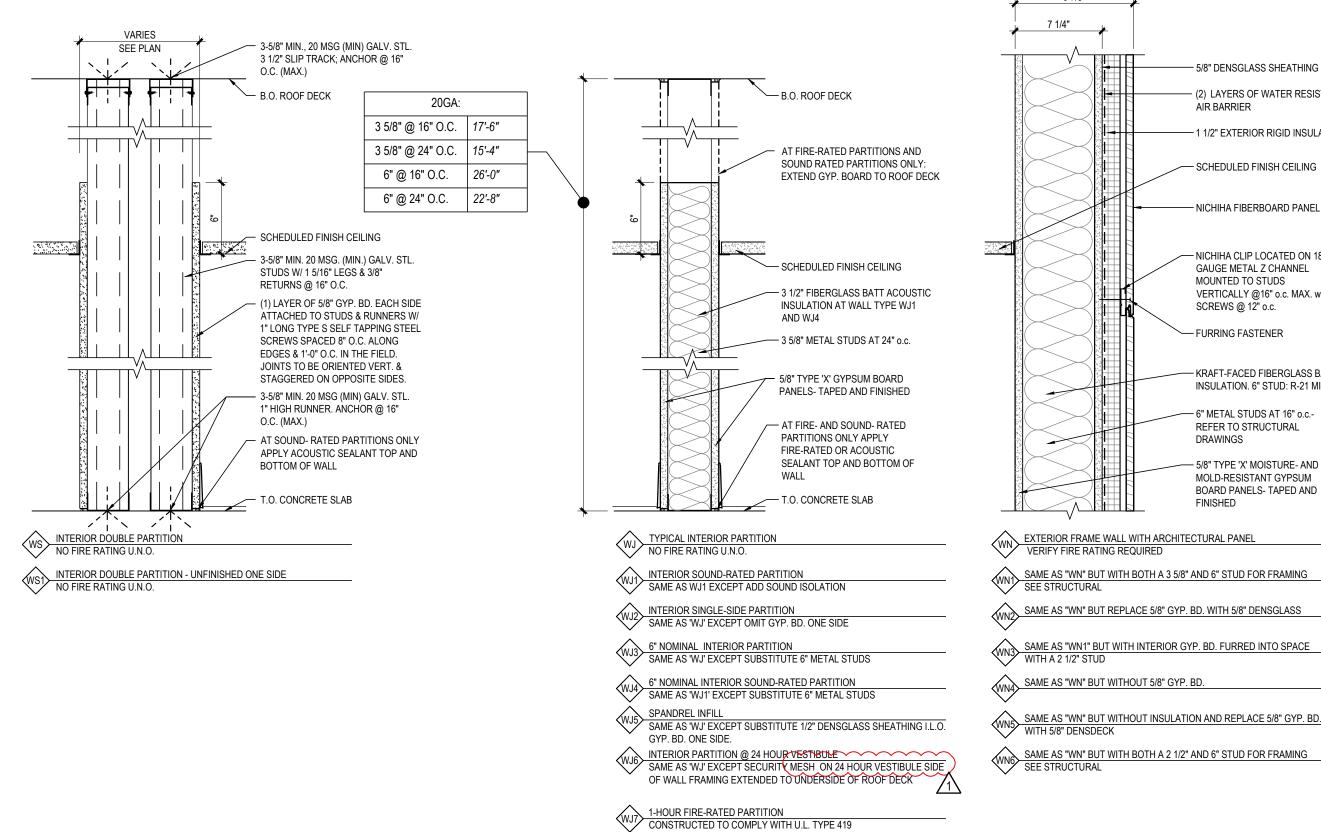

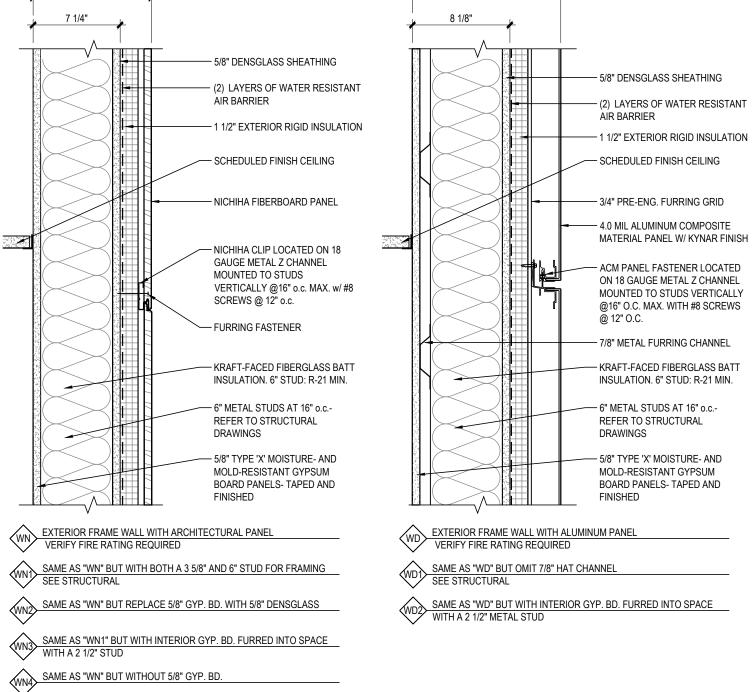

± 1'-0 3/8"

RE-ENGINEERED 3/4" FURRING GRID OPTION


B. KNIGHT WALL SYSTEM MFI SYSTEM

SMARTci GREENGRIT SYSTEM

BRACKET & WALL SYSTEMS:

A. CASCADIA CLIPS

KNIGHT WALL WALL SYSTEMS CI SYSTEM

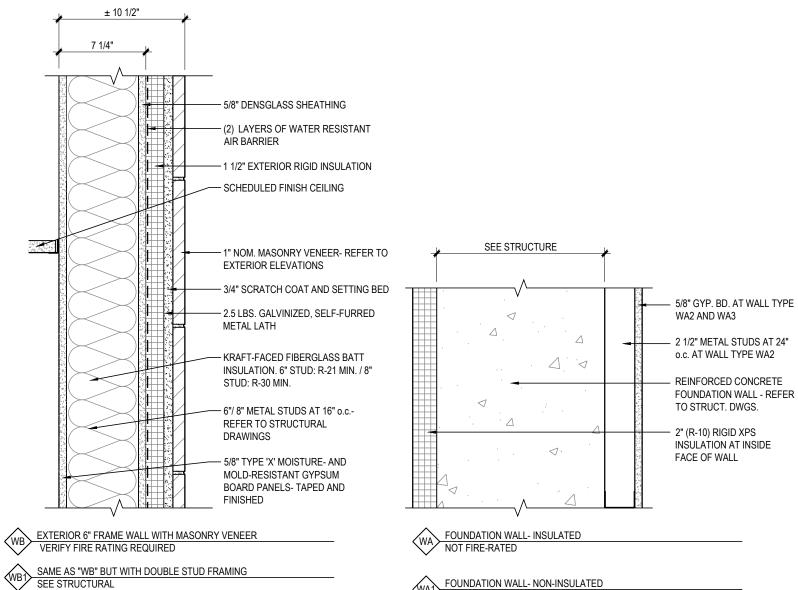

SAME AS "WB" BUT REPLACE 5/8" GYP. BD. WITH 5/8" DENSGLASS

WB5 SAME AS "WB" BUT WITHOUT INSULATION AND REPLACE 5/8" GYP. BD. WITH 5/8" DENSDECK

SAME AS "WB" BUT WITHOUT 5/8" GYP. BD

WA1 FOUNDATION WALL- NON-INSULATED SAME AS 'WA' EXCEPT OMIT RIGID INSUL.

NOT FIRE-RATED FOUNDATION WALL- INSULATED
SAME AS "WA' EXCEPT ADD 2 1/2" METAL STUD FURRING AND 5/8" GYP. BD. TO INTERIOR FACE

WA3 FOUNDATION WALL- INSULATED
SAME AS 'WA' EXCEPT ADD 5/8" GYP. BD. TO INTERIOR FACE

GROUP CORESTATES, INC. 6500 Chippewa Street Suite 200 St. Louis, MO 63109 314.843.4320 COA #: A-2014026908 ARCHITECT OF RECORD

ARCHITECT: R. BRUCE LASURS LICENSE NUMBER: 007504 THESE DRAWINGS ARE NOT COMPLETE WITHOUT THE SEPARATE TYPE WRITTEN SPECIFICATIONS MANUAL WHICH ARE PART OF THE CONTRACT DOCUMENTS.

ROBERT BRUCE LaSURS

ISSUE DATE DESCRIPTION 2020.12.21 | PERMIT SET 1 2021.04.20 STRUCTURAL STEEL REV PROJECT INFORMATION


PROJECT NO: JPM.27135.001 2020.12.21 PROTOTYPE: DRAWN BY: C.THEBEAU **B.LaSURS** CHECKED BY: VERSION: SE_1.00 SHEET TITLE


> WALL TYPES FLOOR TYPES ROOF TYPES

SHEET NUMBER

A3.1.0



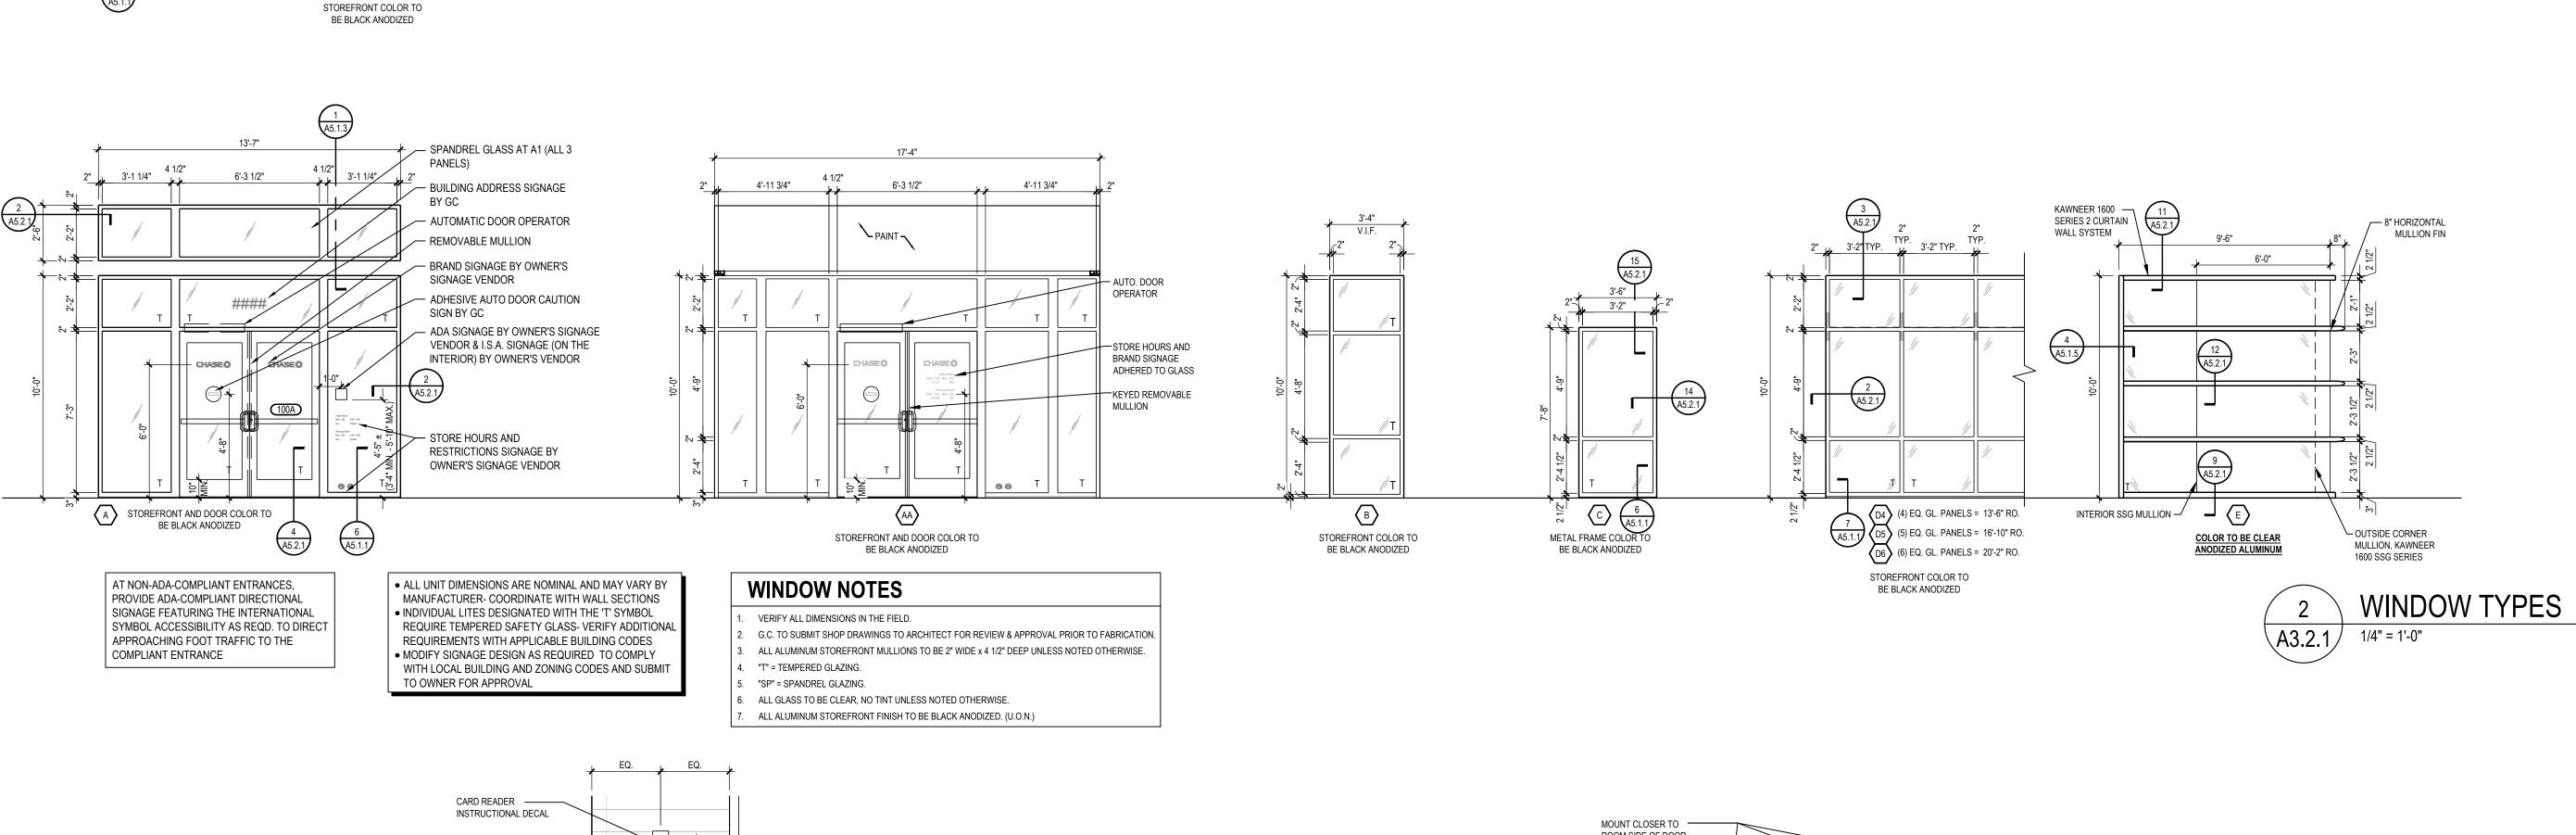

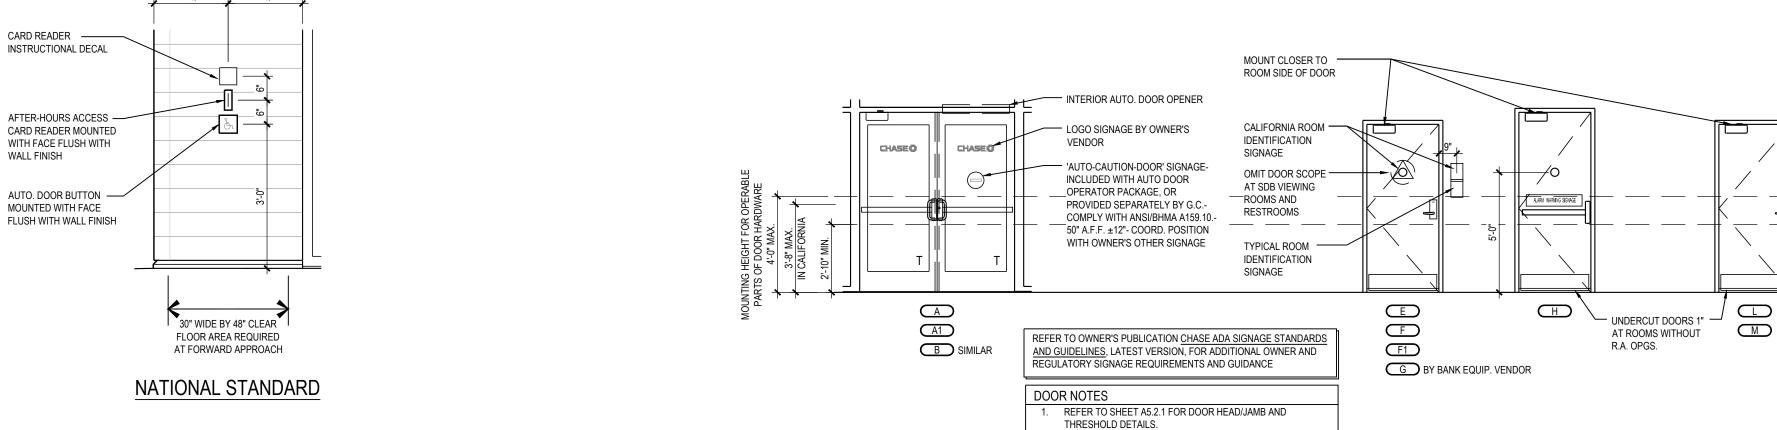

3 AUTO DOOR BUTTONS AND SIGNAGE
A3.2.1 1/2" = 1'-0"

26'-8"


D8 26'-8" RO.

1 DOOR TYPES
A3.2.1 1/4" = 1'-0"

MORGAN CHASE, N.A.

HWY 291 & NE LANGSFORD RD

890 NE LANGSFORD RD

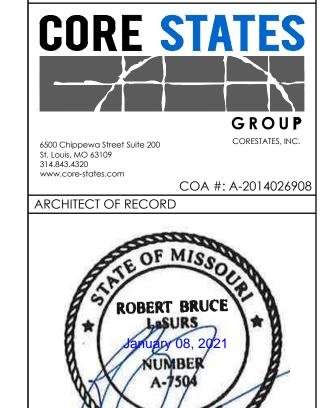

ARCHITECT: R. BRUCE LASURS
LICENSE NUMBER: 007504

THESE DRAWINGS ARE NOT COMPLETE WITHOUT THE
SEPARATE TYPE WRITTEN SPECIFICATIONS MANUAL
WHICH ARE PART OF THE CONTRACT DOCUMENTS.

DESCRIPTION

2020.12.21 PERMIT SET

ISSUE DATE

ROJECT INFO	DRMATION
PROJECT NO:	JPM.27135.001
DATE:	2020.12.21
PROTOTYPE:	20.2
DRAWN BY:	C.THEBEAU
CHECKED BY:	B.LaSURS
VERSION:	SE_1.00
HEET TITLE	

DOOR TYPES SCHEDULE DOOR TYPES WINDOW TYPES

SHEET NUMBER

A3.2.1

GROUP	COMPONENT	MFR.	MODEL	FINISH	NOTES
01	BUTT HINGE (6)	HAGER	BB1191 4.5x4.5 L1 NRP	MATCH STOREFRONT COLOR	STOCK# 006597 NOTE: STANDARD CHASE CB2020 COLOR: STANDARD POWDER COAT BLA
ENTRANCE / 01A ENTRANCE 2	REMOVABLE MULLION	VON DUPRIN	KR4854	MATCH STOREFRONT COLOR	PROVIDE REMOVABLE MULLION AT ALL NEW BUILDS. IF REMOVABLE MULLION CANNOT BE INSTALIDUE TO SITE CONSTRAINTS, PROVIDE ALTERNATE HARDWARE: SEE NOTE 9
	PANIC BAR	VON DUPRIN	CD99EO	MATCH STOREFRONT COLOR	
	PANIC BAR	VON DUPRIN	CD99NL-OP	MATCH STOREFRONT COLOR	
	MORTISE CYLINDER	SCHLAGE	20-001/C123	626 SATIN CHROMIUM	NOTE 8
	MORTISE CYLINDER (2)	SCHLAGE	20-001 XQ11-948/C123	626 SATIN CHROMIUM	
	RIM CYLINDER	SCHLAGE	20-022	626 SATIN CHROMIUM	
	ELECTRIC STRIKE	VON DUPRIN	6111 FSE DS 24V	630 SATIN STAINLESS STEEL	OMIT AT TYPE 01A (NOTES 4,5)
	CARD READER SYSTEM	PARABIT	ACSIEV2	BLACK	PROVIDED AND INSTALLED BY OWNER'S SECURITY SYSTEM VENDOR, OMIT AT TYPE 01A (NOTES
	OFFSET DOOR PULL (2)	IVES	8190-0-O	630 SATIN STAINLESS STEEL	
	OFFSET DOOR PULL (ALT.) (2) POWER OPERATOR	TRIMCO LCN	8191191E-3-4.BPVC 4640 CS	PVC MATCH STOREFRONT COLOR	PVC-COATED "STAY-COOL" PULLS FOR USE IN THE DESERT SOUTHWEST ONLY. OMIT AT TYPE 01A. MATCH EXISTING STOREFRONT COLOR AT IN-LINE OR EXISTING BUILDING PR GC TO CONFIRM FINISH COLOR WITH ARCHITECT PRIOR TO ORDER. INCLUDE CONCEALED SWITCEND PLATE 334-2. (NOTE 5)
	DOOR PUSHPLATES (2) EXCEPT CALIFORNIA PROJECTS	LCN	8310-818T (4" SQUARE)	SATIN S.S	OMIT AT TYPE 01A
	DOOR PUSHPLATES (4) CALIFORNIA PROJECTS ONLY	LCN	8310-853T (4" SQUARE)	SATIN S.S	OMIT AT TYPE 01A
	DOOR PUSHPLATES (2) OPT. BAR AT CALIFORNIA PROJECTS ONLY	LCN	8310-836T (6" x 36" BAR)	SATIN S.S	OMIT AT TYPE 01A
	SURFMOUNT PUSH PLATE ENCLOSURE	LCN	8310-867S	BLACK PLASTIC	FOR USE ONLY AT NON-STANDARD PLANS WHERE A WALL WITH ACCESSIBLE CLEARANCES IS NO AVAILABLE. NOT TO BE USED AT ANY EXTERIOR NEW-BUILD CONDITION. GC TO CONFIRM WITH ARCHITECT.
	KEY SWITCH	SCHLAGE	653-1414-L2		NARROW-STILE COVER PLATE- OMIT AT TYPE 01A.
	CLOSER	LCN	4111-3077CNS	MATCH STOREFRONT COLOR	PROVIDE 2 AT TYPE 01A, SET TO LOWEST POSSIBLE OPENING FORCE REQUIRED TO MAINTAIN W SEAL INTEGRITY
	SEALS	PEMKO	297AS	MILL-FIN. ALUMINUM	SEAL INTEGRIT
	SWEEP- STANDARD	PEMKO	2170 DV	DARK BRONZE VINYL	
	SWEEP- STANDARD SWEEP- HIGH WIND CONDITIONS	PEMKO	315 DN	DARK BRONZE VINYL DARK ANOD. BRONZE	ORDER LONG AND CUT METAL SHORT TO ALLOW NEOPRENE TO EXTEND BEYOND DOOR LOCK E
	THRESHOLD	PEMKO	253X3AFG	MILL-FIN. ALUMINUM	ORDER LONG AND COT METAL SHORT TO ALLOW NEOFRENE TO EXTEND BETOND DOOR LOCK E
02	BUTT HINGE (6)	HAGER	BB1191 4.5X4.5 L1 NRP	MATCH STOREFRONT COLOR	STOCK# 006597 NOTE: STANDARD CHASE CB2020 COLOR: STANDARD POWDER COAT B
ESTIBULE	REMOVABLE MULLION	VON DUPRIN	KR4954	MATCH STOREFRONT COLOR	STOCK# 000397 NOTE: STANDARD CHASE CB2020 COLOR: STANDARD FOWDER COAT B
	PANIC BAR	VON DUPRIN	CD99EO	MATCH STOREFRONT COLOR	
	PANIC BAR	VON DUPRIN	CD99NL-OP	MATCH STOREFRONT COLOR	
	MORTISE CYLINDER	SCHLAGE	20-001/C123	626 SATIN CHROMIUM	NOTE 8
	MORTISE CYLINDER MORTISE CYLINDER (2)	SCHLAGE	20-001/C123 20-001 XQ11-948/C123	626 SATIN CHROMIUM	NOTE 6
	RIM CYLINDER	SCHLAGE	20-001 XQ11-946/C123 20-022	626 SATIN CHROMIUM	
	OFFSET DOOR PULL (2)	IVES	8190-0-O	630 SATIN STAINLESS STEEL	
	POWER OPERATOR		4640CS	MATCH STOREFRONT COLOR	INCLUDE CONCEALED SWITCH BLANK END PLATE 334-2 (NOTE 5)
	DOOR PUSHPLATES (2)	LCN	8310-853T	MATCH STUREFRUNT CULUR	INCLUDE CONCEALED SWITCH BLANK END FLATE 354-2 (NOTE 5)
	EXCEPT CALIFORNIA PROJECTS	LCN	(4" SQUARE)	SATIN S.S	OMIT AT TYPE 01A
	DOOR PUSHPLATES (4) CALIFORNIA PROJECTS ONLY	LCN	8310-853T (4" SQUARE)	SATIN S.S	OMIT AT TYPE 01A
	DOOR PUSHPLATES (2) OPT. BAR AT CALIFORNIA PROJECTS ONLY	LCN	8310-836T (6" x 36" BAR)	SATIN S.S	OMIT AT TYPE 01A
	SURFMOUNT PUSH PLATE ENCLOSURE	LCN	8310-867S	BLACK PLASTIC	FOR USE ONLY AT NON-STANDARD PLANS WHERE A WALL WITH ACCESSIBLE CLEARANCES IS NO AVAILABLE. NOT TO BE USED AT ANY EXTERIOR NEW-BUILD CONDITION. GC TO CONFIRM WITH ARCHITECT.
	KEY SWITCH	LCN	8310-806K		RECESSED IN HINGE JAMB MULLION at 38" AFF (NOTE 5)
	CLOSER	LCN	4111-3077CNS	MATCH STOREFRONT COLOR	LEFT-HAND LEAF AS VIEWED FROM EXTERIOR, ADA COMPLIANT
03	BUTT HINGE (3)	HAGER	BB1191 ANSI A2112 4.5x4.5	652 SATIN CHROMIUM	
ECURED	ELECTRONIC LOCK	SCHLAGE	CO-100-CY-70-KP-SPA-626-PD-C123	626 SATIN CHROMIUM	NOTE 8
	CLOSER	LCN	4011/4041-3077	SP28 GRAY PAINT	DOOR-MOUNT ON ROOM SIDE- NOT VISIBLE TO CUSTOMERS; ADA COMPLIANT
	FLOOR STOP	IVES	FS13 / FS17	626 SATIN CHROMIUM	AT DOORS OPENING AGAINST WALL; WITH R14 RISER AS REQUIRED
	OVERHEAD STOP	GLYNN-JOHNSON	410S	630 SATIN STAINLESS STEEL	AT DOORS OPENING AGAINST FURNITURE
	KICK PLATE	IVES	8400	630 SATIN STAINLESS STEEL	PUSH SIDE ONLY; 8" x 2" LESS THAN DOOR WIDTH
	DOOR SCOPE	IPI / DOOR SCOPE	DS2000	SILVER PAINT	ALUMINUM BODY, NOTE 1
	SILENCERS	IVES	SR64	GRAY	
04	BUTT HINGE (3)	HAGER	BB1191 ANSI A22112 4.5x4.5	652 SATIN CHROMIUM	
PRIVACY	ELECTRONIC LOCK	SCHLAGE	CO-100-CY-40-KP-SPA-626-PD-C123	626 SATIN CHROMIUM	WITH PRIVACY FUNCTION; PREPARE DOOR FOR MAGNETIC RESET FUNCTION. NOTE 8
	CLOSER	LCN	4011/4041-3077	SP28 GRAY PAINT	DOOR-MOUNT ON ROOM SIDE- NOT VISIBLE TO CUSTOMERS, ADA COMPLIANT
	FLOOR STOP	IVES	FS13 / FS17	626 SATIN CHROMIUM	WITH R14 RISER AS REQUIRED
	KICK PLATE	IVES	8400	630 SATIN STAINLESS STEEL	PUSH SIDE ONLY; 8" x 2" LESS THAN DOOR WIDTH
	COAT HOOKS (2)	IVES	581	626 SATIN CHROMIUM	AT RESTROOMS ONLY, 1 AT 36" AFF, 1 AT 60" AFF
	DOOR SCOPE	IPI / DOOR SCOPE	DS2000	SILVER PAINT	ALUMINUM BODY- OMIT AT RESTROOMS & SDB VIEWING ROOMS, NOTE 1
	SILENCERS	IVES	SR64	GRAY	
04A NDARD AT	BUTT HINGE (3)	HAGER	BB1191 ANSI A22112 4.5x4.5	652 SATIN CHROMIUM	
/IEWING RM.	PRIVACY LOCK	SCHLAGE	ND50PD/C123/SPA	626 SATIN CHROMIUM	PUSH-BUTTON PRIVACY INTERIOR / KEYED EXTERIOR; NOTE 8
 ERNATE AT	CLOSER	LCN	4011/4041-3077	SP28 GRAY PAINT	OMIT AT SDB VIEWING ROOMS; DOOR-MOUNT ON ROOM SIDE, ADA COMPLIANT
STROOMS	FLOOR STOP	IVES	FS13 / FS17	626 SATIN CHROMIUM	WITH R14 RISER AS REQUIRED
EXCEPTION	KICK PLATE	IVES	8400	630 SATIN STAINLESS STEEL	PUSH SIDE ONLY; 8" x 2" LESS THAN DOOR WIDTH
	COAT HOOKS (2)	IVES	581	626 SATIN CHROMIUM	AT RESTROOMS ONLY, 1 AT 36" AFF, 1 AT 60" AFF
	DOOR SCOPE	IPI / DOOR SCOPE	DS2000	SILVER PAINT	ALUMINUM BODY- OMIT AT RESTROOMS & SDB VIEWING ROOMS, NOTE 1
	SILENCERS	IVES	SR64	GRAY	
05	BUTT HINGE (3)	HAGER	BB1191 ANSI A2112 4.5x4.5	652 SATIN CHROMIUM	
PASSAGE	PASSAGE LATCH SET	SCHLAGE	ND10S/SPA	626 SATIN CHROMIUM	INCLUDE MILLED GROOVES (/8SP) AT ELECTRICAL ROOM DOORS
	CLOSER	LCN	4011/4041-3077	SP28 GRAY PAINT	DOOR-MOUNT ON ROOM SIDE- NOT VISIBLE TO CUSTOMERS, ADA COMPLIANT
	FLOOR STOP	IVES	FS13 / FS17	626 SATIN CHROMIUM	WITH R14 RISER AS REQUIRED
	KICK PLATE	IVES	8400	630 SATIN STAINLESS STEEL	PUSH SIDE ONLY; 8" x 2" LESS THAN DOOR WIDTH
	_	i	i l		

GRAY

SILENCERS

IVES

06	BUTT HINGE (3)	HAGER	BB1191 ANSI A2112 4.5x4.5	652 SATIN CHROMIUM	
UTILITY	STOREROOM LOCK SET	SCHLAGE	ND80PD/C123/SPA	626 SATIN CHROMIUM	NOTE 8
	CLOSER	LCN	4011/4041-3077	SP28 GRAY PAINT	DOOR-MOUNT ON ROOM SIDE- NOT VISIBLE TO CUSTOMERS, ADA COMPLIANT
	CONCEALED OVERHEAD STOP/HOLDER	GLYNN-JOHNSON	410H	630 SATIN STAINLESS STEEL	OVERHEAD CONCEALED COMBINED STOP/HOLDER REQUIRED AT PLUMBING/JANITOR CLOSET, ELECTRICAL, AND DATA ROOMS; OMIT AT ROOMS WITH LADDER ONLY.
	KICK PLATE (2)	IVES	8400	630 SATIN STAINLESS STEEL	8" x 2" LESS THAN DOOR WIDTH; PLUMBING/JANITOR CLOSET, ELECTRICAL, AND DATA ROOMS REQUIRE KICK PLATES AT BOTH SIDES OF DOOR.
	DOOR SWEEP	PEMKO	4131CNBL	CLEAR ANOD. ALUMINUM	DATA ROOM DOOR ONLY
	DOOR SCOPE	IPI / DOOR SCOPE	DS2000	SILVER PAINT	ALUMINUM BODY, NOTE 1
	SILENCERS	IVES	SR64	GRAY	
09	BUTT HINGE (2)	HAGER	BB1191 ANSA A5112 NRP 4.5x4.5	630 SATIN STAINLESS STEEL	
EGRESS	POWER TRANSFER HINGE (1)	HAGER	BB1191 ANSIA5112 ETW 4.5 x 4.5	630 SATIN STAINLESS STEEL	4-CONDUCTOR THROUGH-WIRE POWER TRANSFER HINGE
	PANIC BAR WITH ALARM	VON DUPRIN	99NL-OP-ALK-AR-CON-3'-US26D	626 SATIN CHROMIUM	PANIC BAR WITH ALARM KIT, AUTO-RESET, AND MFR'S POWERED HINGE WIRING KIT, LENGTH AS REQD.
	ALARM POWER SUPPLY	VON DUPRIN	PS-900 SERIES		INCLUDE INTERNAL BACKUP BATTERY; SEE NOTE 7
	MORTISE CYLINDER	SCHLAGE	20-001/C123	626 SATIN CHROMIUM	NOTE 8
	RIM CYLINDER	SCHLAGE	20-022	626 SATIN CHROMIUM	
	CLOSER	LCN	4111-3077 CNS	SP28 GRAY PAINT	ADA COMPLIANT
	KICK PLATE	IVES	8400	630 SATIN STAINLESS STEEL	8" x 2" LESS THAN DOOR WIDTH
	SEALS	PEMKO	297AS	MILL-FIN. ALUMINUM	
	DOOR SWEEP	PEMKO	315CN	CLEAR ANOD. ALUMINUM	
	THRESHOLD	PEMKO	170A	MILL-FIN. ALUMINUM	
	DOOR SCOPE	IPI / DOOR SCOPE	DS2000 168 degree	SILVER PAINT	ALUMINUM BODY, NOTE 1
10	CONTINUOUS HINGE			SATIN CHROME/STAINLESS STEEL	BY BANK EQUIPMENT VENDOR
BULLET-RESISTANT	ELECTRONIC LOCK	SCHLAGE	CO-100-CY-70-KP-SPA-626-PD-C123	626 SATIN CHROMIUM	BY BANK EQUIPMENT VENDOR; NOTE 8
	CLOSER	LCN	4011/4041-3077 CNS	SP28 GRAY PAINT	BY BANK EQUIPMENT VENDOR, ADA COMPLIANT
	FLOOR STOP	IVES	FS13 / FS17	626 SATIN CHROMIUM	WITH R14 RISER AS REQUIRED
	KICK PLATE	IVES	8400	630 SATIN STAINLESS STEEL	PUSH SIDE ONLY; 8" x 2" LESS THAN DOOR WIDTH
	DOOR SCOPE	IPI / DOOR SCOPE	DS2000	SILVER PAINT	ALUMINUM BODY, NOTE 1
	SILENCERS	IVES	SR64	GRAY	
14	DADDEL LUNIOSO (4 DAID DED LEAS)	0111551111	2130.100	PAINT TO MATCH ADJ. FINISH	AT C.M.U. ENCLOSURES- OR EQUAL- 1000-LB. CAPACITY PER PAIR, PRIMED STEEL
TRASH ENCLOSURE	BARREL HINGES (1 PAIR PER LEAF)	GUARDIAN	2135.100	PAINT TO MATCH ADJ. FINISH	AT STEEL POST ENCLOSURES- OR EQUAL- 1000-LB. CAPACITY PER PAIR, PRIMED STEEL
GATE	LATCH	STANLEY	621513	GALVANIZED STEEL	OR EQUAL
	PULL (1 PER LEAF)	CROWN BOLT	62309	GALVANIZED STEEL	OR EQUAL
	CANE BOLT (1 PER LEAF)	STANLEY	532531	GALVANIZED STEEL	BY PANEL SYSTEM MANUFACTURER
	SPRING-LOADED CASTERS (1 PER LEAF)	ABBEY TRADING	081-368-1	GALVANIZED STEEL	OR EQUAL
	BOLTS AND MISC. HARDWARE			STAINLESS STEEL	
16	BUTT HINGE (3)	HAGER	BB1191 4.5x4.5 L1 NRP	MATCH STOREFRONT COLOR	STOCK #006597
EMPLOYEE ENTRANCE	MORTISE DEAD LATCH	SCHLAGE	L9080/C123/SPA	626 SATIN CHROMIUM	WHERE DOOR MFR'S LOCK BODY IS REQD., PROVIDE SCHLAGE LOCK CYLINDER, ANSI F07 "STOREROOM LOCK" FUNCTION; ADA SINGLE-ACTION COMPLIANT; NOTE 8
	LEVERS (2)	SCHLAGE	SPARTA	626 SATIN CHROMIUM	
	SILENCERS	IVES	SR64	GRAY	
	CLOSER	LCN	4111-3077/CNS	MATCH STOREFRONT COLOR	NOTE: STANDARD CHASE CB2020 COLOR: STANDARD POWDER COAT BLACK
	FLOOR STOP	IVES	FS13 / FS17	626 SATIN CHROMIUM	
L		1			

COA #: A-2014026908

ARCHITECT OF RECORD ROBERT BRUCE

ARCHITECT: R. BRUCE LASURS

ISSUE DATE DESCRIPTION - 2020.12.21 PERMIT SET

LICENSE NUMBER: 007504 THESE DRAWINGS ARE NOT COMPLETE WITHOUT THE SEPARATE TYPE WRITTEN SPECIFICATIONS MANUAL WHICH ARE PART OF THE CONTRACT DOCUMENTS.

PROJECT INFORMATION PROJECT NO: JPM.27135.001 2020.12.21

PROTOTYPE: C.THEBEAU DRAWN BY: B.LaSURS CHECKED BY: VERSION:

DOOR HARDWARE SCHEDULE

SHEET NUMBER

A3.2.2

FLOOR- FIELD TILE	T-501
WALK-OFF MAT	CPT-302
WALL BASE	WB-402
ATM WALL	WC-402
WALLS (NON-ATM)	PT-500
SUSPENDED GRID CEILING	ACT-4
SOFFITS- FACE AND BOTTOM	PT-500
LIGHT FIXTURES- GENERAL	L-500
ILLUMINATED OCTAGON	PREFERRED
LOBBY AND CORRIDOR	
FLOOR- FIELD TILE	T-501
WALL BASE	WB-402
WALLS - GENERAL	PT-500
WALL - CAFÉ / COMMUNITY WALL	PT-311 (NOTE 13) PT-311 (NOTE 13)
WALL - ATM WITH DIGITAL SCREEN SUSPENDED GRID CEILING	ACT-4
GYPSUM CEILINGS, SOFFIT BOTTOMS AND SOFFIT	AC1-4
FACES NOT FLUSH WITH WALL	PT-500
WINDOW SILLS	SS-300
LIGHT FIXTURES- GENERAL	L-500
LIGHT FIXTURES - CEILING ACCENT	L-11
WINDOW SHADES (NOTE 6B)	WT-1 / WT-2
LIVING ROOM	
FLOOR- AREA RUG	LRAR-4
WALLS- GENERAL EFATURE WALL DANIELS	PT-500
FEATURE WALL PANELS	WD-601
LIGHT FIXTURES- GENERAL MANUAL TRANSACTIONS	L-500
FLOOR	CPT-321
WALL BASE	WB-402
WALLS - GENERAL	PT-500
WALLS - GENERAL WALLS - MANUAL TRANSACTION BACK WALL	PT-500
WALLS - MANOAL TRANSACTION BACK WALL WALLS - ACCENT	(NOTE 13)
MILLWORK- GENERAL	PL-502 / PL-503
MANUAL TRANSACTION MODULE FRONT PANELS	(NOTE 5)
MANUAL TRANSACTION MODULE COUNTER	(NOTE 5)
CEILING	ACT-4
SOFFITS- BOTTOM AND FACES NOT FLUSH WITH	
WALL	PT-500
LIGHT FIXTURES- GENERAL	L-11
ILLUMINATED OCTAGON	PREFERRED
SCRIM CASUAL AND PRIVATE CONSULTATION SPACE	WT-20
FLOOR - GENERAL	CPT-320
WALL BASE	WB-400
WALL DASE WALLS	(NOTE 12)
WALLS - PARTIAL HEIGHT	(NOTE 12)
	DEMOUNTABLE WAL
GLAZING HARDWARE	SYTEM (NOTE 12)
DOOR CLOSER COVER	DEMOUNTABLE WAL
	SYTEM (NOTE 12)
CEILING	ACT-4
PCS/CMS BULKHEADS	PT-500
SOFFILS - BOLLOM AND FACES NOT FILISH WITH -	PT-500
SOFFITS - BOTTOM AND FACES NOT FLUSH WITH WALL	
WALL	L-500
WALL LIGHT FIXTURES- GENERAL	L-500 L-410
WALL LIGHT FIXTURES- GENERAL LIGHT FIXTURES- PENDANT - PCS WINDOW SHADES: PCS / CMS (NOTE 6B) CONFERENCE ROOM	L-410 WT-1 / WT-2
WALL LIGHT FIXTURES- GENERAL LIGHT FIXTURES- PENDANT - PCS WINDOW SHADES: PCS / CMS (NOTE 6B) CONFERENCE ROOM FLOOR - GENERAL	L-410 WT-1 / WT-2 CPT-320
WALL LIGHT FIXTURES- GENERAL LIGHT FIXTURES- PENDANT - PCS WINDOW SHADES: PCS / CMS (NOTE 6B) CONFERENCE ROOM FLOOR - GENERAL WALL BASE	L-410 WT-1 / WT-2 CPT-320 WB-402
WALL LIGHT FIXTURES- GENERAL LIGHT FIXTURES- PENDANT - PCS WINDOW SHADES: PCS / CMS (NOTE 6B) CONFERENCE ROOM FLOOR - GENERAL WALL BASE WALLS	L-410 WT-1 / WT-2 CPT-320 WB-402 (NOTE 12)
WALL LIGHT FIXTURES- GENERAL LIGHT FIXTURES- PENDANT - PCS WINDOW SHADES: PCS / CMS (NOTE 6B) CONFERENCE ROOM	L-410 WT-1 / WT-2 CPT-320 WB-402 (NOTE 12) (NOTE 12)
WALL LIGHT FIXTURES- GENERAL LIGHT FIXTURES- PENDANT - PCS WINDOW SHADES: PCS / CMS (NOTE 6B) CONFERENCE ROOM FLOOR - GENERAL WALL BASE WALLS WALLS - PARTIAL HEIGHT	L-410 WT-1 / WT-2 CPT-320 WB-402 (NOTE 12) (NOTE 12)
WALL LIGHT FIXTURES- GENERAL LIGHT FIXTURES- PENDANT - PCS WINDOW SHADES: PCS / CMS (NOTE 6B) CONFERENCE ROOM FLOOR - GENERAL WALL BASE WALLS WALLS - PARTIAL HEIGHT GLAZING HARDWARE	L-410 WT-1 / WT-2 CPT-320 WB-402 (NOTE 12) (NOTE 12) DEMOUNTABLE WALL SYTEM (NOTE 12) DEMOUNTABLE WALL
WALL LIGHT FIXTURES- GENERAL LIGHT FIXTURES- PENDANT - PCS WINDOW SHADES: PCS / CMS (NOTE 6B) CONFERENCE ROOM FLOOR - GENERAL WALL BASE WALLS WALLS - PARTIAL HEIGHT GLAZING HARDWARE	L-410 WT-1 / WT-2 CPT-320 WB-402 (NOTE 12) (NOTE 12) DEMOUNTABLE WALL SYTEM (NOTE 12) DEMOUNTABLE WALL SYTEM (NOTE 12)
WALL LIGHT FIXTURES- GENERAL LIGHT FIXTURES- PENDANT - PCS WINDOW SHADES: PCS / CMS (NOTE 6B) CONFERENCE ROOM FLOOR - GENERAL WALL BASE WALLS WALLS - PARTIAL HEIGHT GLAZING HARDWARE DOOR CLOSER COVER CEILING	L-410 WT-1 / WT-2 CPT-320 WB-402 (NOTE 12) (NOTE 12) DEMOUNTABLE WAL SYTEM (NOTE 12) DEMOUNTABLE WAL SYTEM (NOTE 12) ACT-4
WALL LIGHT FIXTURES- GENERAL LIGHT FIXTURES- PENDANT - PCS WINDOW SHADES: PCS / CMS (NOTE 6B) CONFERENCE ROOM FLOOR - GENERAL WALL BASE WALLS WALLS WALLS - PARTIAL HEIGHT GLAZING HARDWARE DOOR CLOSER COVER CEILING CONFERENCE BULKHEADS	L-410 WT-1 / WT-2 CPT-320 WB-402 (NOTE 12) (NOTE 12) DEMOUNTABLE WAL SYTEM (NOTE 12) DEMOUNTABLE WAL SYTEM (NOTE 12)
WALL LIGHT FIXTURES- GENERAL LIGHT FIXTURES- PENDANT - PCS WINDOW SHADES: PCS / CMS (NOTE 6B) CONFERENCE ROOM FLOOR - GENERAL WALL BASE WALLS WALLS - PARTIAL HEIGHT GLAZING HARDWARE DOOR CLOSER COVER CEILING CONFERENCE BULKHEADS SOFFITS - BOTTOM AND FACES NOT FLUSH WITH	L-410 WT-1 / WT-2 CPT-320 WB-402 (NOTE 12) (NOTE 12) DEMOUNTABLE WAL SYTEM (NOTE 12) DEMOUNTABLE WAL SYTEM (NOTE 12) ACT-4
WALL LIGHT FIXTURES- GENERAL LIGHT FIXTURES- PENDANT - PCS WINDOW SHADES: PCS / CMS (NOTE 6B) CONFERENCE ROOM FLOOR - GENERAL WALL BASE WALLS WALLS - PARTIAL HEIGHT GLAZING HARDWARE DOOR CLOSER COVER CEILING CONFERENCE BULKHEADS SOFFITS - BOTTOM AND FACES NOT FLUSH WITH WALL	L-410 WT-1 / WT-2 CPT-320 WB-402 (NOTE 12) (NOTE 12) DEMOUNTABLE WAL SYTEM (NOTE 12) DEMOUNTABLE WAL SYTEM (NOTE 12) ACT-4 PT-500
WALL LIGHT FIXTURES- GENERAL LIGHT FIXTURES- PENDANT - PCS WINDOW SHADES: PCS / CMS (NOTE 6B) CONFERENCE ROOM FLOOR - GENERAL WALL BASE WALLS WALLS - PARTIAL HEIGHT GLAZING HARDWARE DOOR CLOSER COVER CEILING CONFERENCE BULKHEADS SOFFITS - BOTTOM AND FACES NOT FLUSH WITH WALL LIGHT FIXTURES- GENERAL	L-410 WT-1 / WT-2 CPT-320 WB-402 (NOTE 12) (NOTE 12) DEMOUNTABLE WAL SYTEM (NOTE 12) DEMOUNTABLE WAL SYTEM (NOTE 12) ACT-4 PT-500 PT-500
WALL LIGHT FIXTURES- GENERAL LIGHT FIXTURES- PENDANT - PCS WINDOW SHADES: PCS / CMS (NOTE 6B) CONFERENCE ROOM FLOOR - GENERAL WALL BASE WALLS WALLS - PARTIAL HEIGHT GLAZING HARDWARE DOOR CLOSER COVER CEILING CONFERENCE BULKHEADS SOFFITS - BOTTOM AND FACES NOT FLUSH WITH WALL LIGHT FIXTURES - GENERAL LIGHT FIXTURES - ACCENT - CONFERENCE ROOM	L-410 WT-1 / WT-2 CPT-320 WB-402 (NOTE 12) (NOTE 12) DEMOUNTABLE WAL SYTEM (NOTE 12) DEMOUNTABLE WAL SYTEM (NOTE 12) ACT-4 PT-500 PT-500 L-500
WALL LIGHT FIXTURES- GENERAL LIGHT FIXTURES- PENDANT - PCS WINDOW SHADES: PCS / CMS (NOTE 6B) CONFERENCE ROOM FLOOR - GENERAL WALL BASE WALLS WALLS - PARTIAL HEIGHT GLAZING HARDWARE DOOR CLOSER COVER CEILING CONFERENCE BULKHEADS SOFFITS - BOTTOM AND FACES NOT FLUSH WITH WALL LIGHT FIXTURES - GENERAL LIGHT FIXTURES - ACCENT - CONFERENCE ROOM	L-410 WT-1 / WT-2 CPT-320 WB-402 (NOTE 12) (NOTE 12) DEMOUNTABLE WAL SYTEM (NOTE 12) DEMOUNTABLE WAL SYTEM (NOTE 12) ACT-4 PT-500 PT-500 L-500 L-413
WALL LIGHT FIXTURES- GENERAL LIGHT FIXTURES- PENDANT - PCS WINDOW SHADES: PCS / CMS (NOTE 6B) CONFERENCE ROOM FLOOR - GENERAL WALL BASE WALLS WALLS - PARTIAL HEIGHT GLAZING HARDWARE DOOR CLOSER COVER CEILING CONFERENCE BULKHEADS SOFFITS - BOTTOM AND FACES NOT FLUSH WITH WALL LIGHT FIXTURES- GENERAL LIGHT FIXTURES - ACCENT - CONFERENCE ROOM WINDOW SHADES: CONFERENCE (NOTE 6B) BOOTH	L-410 WT-1 / WT-2 CPT-320 WB-402 (NOTE 12) (NOTE 12) DEMOUNTABLE WAL SYTEM (NOTE 12) DEMOUNTABLE WAL SYTEM (NOTE 12) ACT-4 PT-500 PT-500 L-500 L-413
WALL LIGHT FIXTURES- GENERAL LIGHT FIXTURES- PENDANT - PCS WINDOW SHADES: PCS / CMS (NOTE 6B) CONFERENCE ROOM FLOOR - GENERAL WALL BASE WALLS WALLS - PARTIAL HEIGHT GLAZING HARDWARE DOOR CLOSER COVER CEILING CONFERENCE BULKHEADS SOFFITS - BOTTOM AND FACES NOT FLUSH WITH WALL LIGHT FIXTURES - GENERAL LIGHT FIXTURES - ACCENT - CONFERENCE ROOM WINDOW SHADES: CONFERENCE (NOTE 6B) BOOTH	L-410 WT-1 / WT-2 CPT-320 WB-402 (NOTE 12) (NOTE 12) DEMOUNTABLE WAL SYTEM (NOTE 12) DEMOUNTABLE WAL SYTEM (NOTE 12) ACT-4 PT-500 PT-500 L-500 L-413 WT-7
WALL LIGHT FIXTURES- GENERAL LIGHT FIXTURES- PENDANT - PCS WINDOW SHADES: PCS / CMS (NOTE 6B) CONFERENCE ROOM FLOOR - GENERAL WALL BASE WALLS WALLS - PARTIAL HEIGHT GLAZING HARDWARE DOOR CLOSER COVER CEILING CONFERENCE BULKHEADS SOFFITS - BOTTOM AND FACES NOT FLUSH WITH WALL LIGHT FIXTURES - GENERAL LIGHT FIXTURES - ACCENT - CONFERENCE ROOM WINDOW SHADES: CONFERENCE (NOTE 6B) BOOTH FLOOR WALL BASE	L-410 WT-1 / WT-2 CPT-320 WB-402 (NOTE 12) (NOTE 12) DEMOUNTABLE WAL SYTEM (NOTE 12) DEMOUNTABLE WAL SYTEM (NOTE 12) ACT-4 PT-500 PT-500 L-413 WT-7 T-501
WALL LIGHT FIXTURES- GENERAL LIGHT FIXTURES- PENDANT - PCS WINDOW SHADES: PCS / CMS (NOTE 6B) CONFERENCE ROOM FLOOR - GENERAL WALL BASE WALLS WALLS - PARTIAL HEIGHT GLAZING HARDWARE DOOR CLOSER COVER CEILING CONFERENCE BULKHEADS SOFFITS - BOTTOM AND FACES NOT FLUSH WITH WALL LIGHT FIXTURES - GENERAL LIGHT FIXTURES - ACCENT - CONFERENCE ROOM WINDOW SHADES: CONFERENCE (NOTE 6B) BOOTH FLOOR WALL BASE WALLS - ACCENT PAINT	L-410 WT-1 / WT-2 CPT-320 WB-402 (NOTE 12) (NOTE 12) DEMOUNTABLE WAL SYTEM (NOTE 12) DEMOUNTABLE WAL SYTEM (NOTE 12) ACT-4 PT-500 PT-500 L-500 L-413 WT-7 T-501 WB-402
WALL LIGHT FIXTURES- GENERAL LIGHT FIXTURES- PENDANT - PCS WINDOW SHADES: PCS / CMS (NOTE 6B) CONFERENCE ROOM FLOOR - GENERAL WALL BASE WALLS WALLS - PARTIAL HEIGHT GLAZING HARDWARE DOOR CLOSER COVER CEILING CONFERENCE BULKHEADS SOFFITS - BOTTOM AND FACES NOT FLUSH WITH WALL LIGHT FIXTURES- GENERAL LIGHT FIXTURES - ACCENT - CONFERENCE ROOM WINDOW SHADES: CONFERENCE (NOTE 6B) BOOTH FLOOR WALL BASE WALLS - ACCENT PAINT WALLS - WOOD ACCENT	L-410 WT-1 / WT-2 CPT-320 WB-402 (NOTE 12) (NOTE 12) DEMOUNTABLE WAL SYTEM (NOTE 12) DEMOUNTABLE WAL SYTEM (NOTE 12) ACT-4 PT-500 PT-500 L-500 L-413 WT-7 T-501 WB-402 PT-501 (NOTE 12)
WALL LIGHT FIXTURES- GENERAL LIGHT FIXTURES- PENDANT - PCS WINDOW SHADES: PCS / CMS (NOTE 6B) CONFERENCE ROOM FLOOR - GENERAL WALL BASE WALLS WALLS - PARTIAL HEIGHT GLAZING HARDWARE DOOR CLOSER COVER CEILING CONFERENCE BULKHEADS SOFFITS - BOTTOM AND FACES NOT FLUSH WITH WALL LIGHT FIXTURES - GENERAL LIGHT FIXTURES - ACCENT - CONFERENCE ROOM WINDOW SHADES: CONFERENCE (NOTE 6B)	L-410 WT-1 / WT-2 CPT-320 WB-402 (NOTE 12) (NOTE 12) DEMOUNTABLE WAL SYTEM (NOTE 12) DEMOUNTABLE WAL SYTEM (NOTE 12) ACT-4 PT-500 PT-500 L-500 L-413 WT-7 T-501 WB-402 PT-501 (NOTE 12) WD-502
WALL LIGHT FIXTURES- GENERAL LIGHT FIXTURES- PENDANT - PCS WINDOW SHADES: PCS / CMS (NOTE 6B) CONFERENCE ROOM FLOOR - GENERAL WALL BASE WALLS WALLS WALLS - PARTIAL HEIGHT GLAZING HARDWARE DOOR CLOSER COVER CEILING CONFERENCE BULKHEADS SOFFITS - BOTTOM AND FACES NOT FLUSH WITH WALL LIGHT FIXTURES- GENERAL LIGHT FIXTURES - ACCENT - CONFERENCE ROOM WINDOW SHADES: CONFERENCE (NOTE 6B) BOOTH FLOOR WALL BASE WALLS - ACCENT PAINT WALLS - WOOD ACCENT CEILING BOOTH BULKHEADS SOFFITS - BOTTOM AND FACES NOT FLUSH WITH	L-410 WT-1 / WT-2 CPT-320 WB-402 (NOTE 12) (NOTE 12) DEMOUNTABLE WAL SYTEM (NOTE 12) DEMOUNTABLE WAL SYTEM (NOTE 12) ACT-4 PT-500 PT-500 L-500 L-413 WT-7 T-501 WB-402 PT-501 (NOTE 12) WD-502 WD-502 PT-500
WALL LIGHT FIXTURES- GENERAL LIGHT FIXTURES- PENDANT - PCS WINDOW SHADES: PCS / CMS (NOTE 6B) CONFERENCE ROOM FLOOR - GENERAL WALL BASE WALLS WALLS - PARTIAL HEIGHT GLAZING HARDWARE DOOR CLOSER COVER CEILING CONFERENCE BULKHEADS SOFFITS - BOTTOM AND FACES NOT FLUSH WITH WALL LIGHT FIXTURES - GENERAL LIGHT FIXTURES - ACCENT - CONFERENCE ROOM WINDOW SHADES: CONFERENCE (NOTE 6B) BOOTH FLOOR WALL BASE WALLS - ACCENT PAINT WALLS - WOOD ACCENT CEILING BOOTH BULKHEADS SOFFITS - BOTTOM AND FACES NOT FLUSH WITH WALLS - WOOD ACCENT CEILING BOOTH BULKHEADS SOFFITS - BOTTOM AND FACES NOT FLUSH WITH WALL	L-410 WT-1 / WT-2 CPT-320 WB-402 (NOTE 12) (NOTE 12) DEMOUNTABLE WAL SYTEM (NOTE 12) DEMOUNTABLE WAL SYTEM (NOTE 12) ACT-4 PT-500 PT-500 L-500 L-413 WT-7 T-501 WB-402 PT-501 (NOTE 12) WD-502 WD-502 PT-500 PT-500
WALL LIGHT FIXTURES- GENERAL LIGHT FIXTURES- PENDANT - PCS WINDOW SHADES: PCS / CMS (NOTE 6B) CONFERENCE ROOM FLOOR - GENERAL WALL BASE WALLS WALLS - PARTIAL HEIGHT GLAZING HARDWARE DOOR CLOSER COVER CEILING CONFERENCE BULKHEADS SOFFITS - BOTTOM AND FACES NOT FLUSH WITH WALL LIGHT FIXTURES- GENERAL LIGHT FIXTURES - ACCENT - CONFERENCE ROOM WINDOW SHADES: CONFERENCE (NOTE 6B) BOOTH FLOOR WALL BASE WALLS - ACCENT PAINT WALLS - WOOD ACCENT CEILING BOOTH BULKHEADS SOFFITS - BOTTOM AND FACES NOT FLUSH WITH	L-410 WT-1 / WT-2 CPT-320 WB-402 (NOTE 12) (NOTE 12) DEMOUNTABLE WAL SYTEM (NOTE 12) DEMOUNTABLE WAL SYTEM (NOTE 12) ACT-4 PT-500 PT-500 L-500 L-413 WT-7 T-501 WB-402 PT-501 (NOTE 12) WD-502 WD-502 PT-500

DINING ROOM TABLE (DR	RT)
FLOOR (DRT ON HARD SURFACE)	T-501
WALL BASE	WB-402
WALLS - GENERAL	PT-500
WALLS - DIGITAL	PT-311 (NOTE 13)
WALLS - PARTIAL HEIGHT	PT-500
-	ACT-4
CEILING	
LIGHT FIXTURES- GENERAL	L-500
SDB CHEST ROOM OR	
FLOOR	CPT-320
WALL BASE	WB-402
WALLS - GENERAL	PT-500
CEILING	ACT-2
LIGHT FIXTURES	L-2
SDB VIEWING ROOM	
FLOOR	CPT-320
WALL BASE	WB-402
WALLS	PT-500
WALL- ACCENT (COUNTER WALL)	PT-501
MILLWORK COUNTER	SS-300
CARREL COUNTER	SS-300
CEILING	ACT-2
LIGHT FIXTURES- GENERAL	L-2
RESTROOMS (NOTE 6B	
FLOOR- FIELD	T-402
WALLS - GENERAL	PT-500
WALL- VANITY	PT-501
WALL TILE	T-402
CEILING	ACT-2
LIGHT FIXTURES- GENERAL	L-2
WORK / PRINT / FILE / STORAGE ROOMS, LTOS AND C	
MANUAL TRANSACTION AR	
	CPT-320
FLOOR	
FLOOR WALL BASE	WB-402
	WB-402 PT-500
WALL BASE	
WALL BASE WALLS	PT-500
WALL BASE WALLS MILLWORK	PT-500 PL-502 / PL-503
WALL BASE WALLS MILLWORK CEILING	PT-500 PL-502 / PL-503 ACT-2 L-2
WALL BASE WALLS MILLWORK CEILING LIGHT FIXTURES	PT-500 PL-502 / PL-503 ACT-2 L-2
WALL BASE WALLS MILLWORK CEILING LIGHT FIXTURES LAO (FORMERLY LTOS) / CASH ROOMS- OPEN TO MA	PT-500 PL-502 / PL-503 ACT-2 L-2 ANUAL TRANSACTION AREAS CPT-321
WALL BASE WALLS MILLWORK CEILING LIGHT FIXTURES LAO (FORMERLY LTOS) / CASH ROOMS- OPEN TO MA	PT-500 PL-502 / PL-503 ACT-2 L-2 ANUAL TRANSACTION AREAS CPT-321 WB-402
WALL BASE WALLS MILLWORK CEILING LIGHT FIXTURES LAO (FORMERLY LTOS) / CASH ROOMS- OPEN TO MA FLOOR WALL BASE WALLS	PT-500 PL-502 / PL-503 ACT-2 L-2 ANUAL TRANSACTION AREAS CPT-321 WB-402 PT-500
WALL BASE WALLS MILLWORK CEILING LIGHT FIXTURES LAO (FORMERLY LTOS) / CASH ROOMS- OPEN TO MA FLOOR WALL BASE WALLS MILLWORK	PT-500 PL-502 / PL-503 ACT-2 L-2 ANUAL TRANSACTION AREAS CPT-321 WB-402 PT-500 PL-502 / PL-503
WALL BASE WALLS MILLWORK CEILING LIGHT FIXTURES LAO (FORMERLY LTOS) / CASH ROOMS- OPEN TO MA FLOOR WALL BASE WALLS MILLWORK CEILING	PT-500 PL-502 / PL-503 ACT-2 L-2 ANUAL TRANSACTION AREAS CPT-321 WB-402 PT-500 PL-502 / PL-503 ACT-2
WALL BASE WALLS MILLWORK CEILING LIGHT FIXTURES LAO (FORMERLY LTOS) / CASH ROOMS- OPEN TO MA FLOOR WALL BASE WALLS MILLWORK CEILING LIGHT FIXTURES LOUNGE FLOOR WALL BASE WALLS MILLWORK MILLWORK MILLWORK MILLWORK MILLWORK MILLWORK MILLWORK MILLWORK MILLWORK	PT-500 PL-502 / PL-503 ACT-2 L-2 ANUAL TRANSACTION AREAS CPT-321 WB-402 PT-500 PL-502 / PL-503 ACT-2 L-2 T-402 WB-402 PT-500 PL-503 PL-503 PL-503 PL-503
WALL BASE WALLS MILLWORK CEILING LIGHT FIXTURES LAO (FORMERLY LTOS) / CASH ROOMS- OPEN TO MA FLOOR WALL BASE WALLS MILLWORK CEILING LIGHT FIXTURES LOUNGE FLOOR WALL BASE WALLS MILLWORK CEILING LIGHT FIXTURES COUNTER MILLWORK COUNTER MILLWORK CEILING MILLWORK CEILING	PT-500 PL-502 / PL-503 ACT-2 L-2 ANUAL TRANSACTION AREAS CPT-321 WB-402 PT-500 PL-502 / PL-503 ACT-2 L-2 T-402 WB-402 PT-500 PL-503 PL-503 PL-503 PL-502 ACT-2
WALL BASE WALLS MILLWORK CEILING LIGHT FIXTURES LAO (FORMERLY LTOS) / CASH ROOMS- OPEN TO M/ FLOOR WALL BASE WALLS MILLWORK CEILING LIGHT FIXTURES FLOOR WALL BASE WALL BASE WALLS MILLWORK CEILING LIGHT FIXTURES COUNGE FLOOR WALL BASE WALLS MILLWORK CEILING LIGHT FIXTURES	PT-500 PL-502 / PL-503 ACT-2 L-2 ANUAL TRANSACTION AREAS CPT-321 WB-402 PT-500 PL-502 / PL-503 ACT-2 L-2 T-402 WB-402 PT-500 PL-503 PL-503 PL-502 ACT-2 L-2 L-2
WALL BASE WALLS MILLWORK CEILING LIGHT FIXTURES LAO (FORMERLY LTOS) / CASH ROOMS- OPEN TO MA FLOOR WALL BASE WALLS MILLWORK CEILING LIGHT FIXTURES LOUNGE FLOOR WALL BASE WALLS MILLWORK CEILING LIGHT FIXTURES LOUNGE FLOOR WALL BASE WALLS MILLWORK COUNTER MILLWORK CEILING LIGHT FIXTURES JANITOR / DATA / ELECTRICAL/ LADDE	PT-500 PL-502 / PL-503 ACT-2 L-2 ANUAL TRANSACTION AREAS CPT-321 WB-402 PT-500 PL-502 / PL-503 ACT-2 L-2 T-402 WB-402 PT-500 PL-503 PL-503 PL-503 PL-502 ACT-2 L-2 ER / ATM ROOMS
WALL BASE WALLS MILLWORK CEILING LIGHT FIXTURES LAO (FORMERLY LTOS) / CASH ROOMS- OPEN TO MADE FLOOR WALL BASE WALLS MILLWORK CEILING LIGHT FIXTURES LOUNGE FLOOR WALL BASE WALLS MILLWORK CEILING LIGHT FIXTURES LOUNGE FLOOR WALL BASE WALLS MILLWORK COUNTER MILLWORK CEILING LIGHT FIXTURES FLOOR FLOOR FLOOR FLOOR	PT-500 PL-502 / PL-503 ACT-2 L-2 ANUAL TRANSACTION AREAS CPT-321 WB-402 PT-500 PL-502 / PL-503 ACT-2 L-2 T-402 WB-402 PT-500 PL-503 PL-503 PL-503 PL-502 ACT-2 L-2 ER / ATM ROOMS SC (NOTE 14)
WALL BASE WALLS MILLWORK CEILING LIGHT FIXTURES LAO (FORMERLY LTOS) / CASH ROOMS- OPEN TO MADE FLOOR WALL BASE WALLS MILLWORK CEILING LIGHT FIXTURES LOUNGE FLOOR WALL BASE WALLS MILLWORK CEILING LIGHT FIXTURES LOUNGE FLOOR WALL BASE WALLS MILLWORK COUNTER MILLWORK CEILING LIGHT FIXTURES JANITOR / DATA / ELECTRICAL / LADDE FLOOR WALL BASE	PT-500 PL-502 / PL-503 ACT-2 L-2 ANUAL TRANSACTION AREAS CPT-321 WB-402 PT-500 PL-502 / PL-503 ACT-2 L-2 T-402 WB-402 PT-500 PL-503 PL-503 PL-502 ACT-2 L-2 ER / ATM ROOMS SC (NOTE 14) WB-403
WALL BASE WALLS MILLWORK CEILING LIGHT FIXTURES LAO (FORMERLY LTOS) / CASH ROOMS- OPEN TO M/ FLOOR WALL BASE WALLS MILLWORK CEILING LIGHT FIXTURES LOUNGE FLOOR WALL BASE WALLS MILLWORK COUNTER MILLWORK CEILING LIGHT FIXTURES MILLWORK CEILING LIGHT FIXTURES MILLWORK CEILING LIGHT FIXTURES WALLS MILLWORK CEILING LIGHT FIXTURES JANITOR / DATA / ELECTRICAL/ LADDE FLOOR WALL BASE WALLS (NOTE 8)	PT-500 PL-502 / PL-503 ACT-2 L-2 ANUAL TRANSACTION AREAS CPT-321 WB-402 PT-500 PL-502 / PL-503 ACT-2 L-2 T-402 WB-402 PT-500 PL-503 PL-503 PL-502 ACT-2 L-2 ER / ATM ROOMS SC (NOTE 14) WB-403 PT-500
WALL BASE WALLS MILLWORK CEILING LIGHT FIXTURES LAO (FORMERLY LTOS) / CASH ROOMS- OPEN TO MADE FLOOR WALL BASE WALLS MILLWORK CEILING LIGHT FIXTURES LOUNGE FLOOR WALL BASE WALLS MILLWORK CEILING LIGHT FIXTURES LOUNGE FLOOR WALL BASE WALLS MILLWORK COUNTER MILLWORK CEILING LIGHT FIXTURES JANITOR / DATA / ELECTRICAL / LADDE FLOOR WALL BASE	PT-500 PL-502 / PL-503 ACT-2 L-2 ANUAL TRANSACTION AREAS CPT-321 WB-402 PT-500 PL-502 / PL-503 ACT-2 L-2 T-402 WB-402 PT-500 PL-503 PL-503 PL-502 ACT-2 L-2 ER / ATM ROOMS SC (NOTE 14) WB-403
WALL BASE WALLS MILLWORK CEILING LIGHT FIXTURES LAO (FORMERLY LTOS) / CASH ROOMS- OPEN TO M/ FLOOR WALL BASE WALLS MILLWORK CEILING LIGHT FIXTURES LOUNGE FLOOR WALL BASE WALLS MILLWORK COUNTER MILLWORK CEILING LIGHT FIXTURES MILLWORK CEILING LIGHT FIXTURES MILLWORK CEILING LIGHT FIXTURES WALLS MILLWORK CEILING LIGHT FIXTURES JANITOR / DATA / ELECTRICAL/ LADDE FLOOR WALL BASE WALLS (NOTE 8)	PT-500 PL-502 / PL-503 ACT-2 L-2 ANUAL TRANSACTION AREAS CPT-321 WB-402 PT-500 PL-502 / PL-503 ACT-2 L-2 T-402 WB-402 PT-500 PL-503 PL-503 PL-502 ACT-2 L-2 ER / ATM ROOMS SC (NOTE 14) WB-403 PT-500

WB-402	WB-402	⟨WB-402⟩	⟨WB-402⟩	⟨WB-403⟩	⟨WB-502⟩
3/4" 4 1/4"	3/8" 4 1/4"	4 1/2"	5/8" 4 1/4"	4	\$/8"
TILE	WALK-OFF N	MAT UNCUSHION CARPET	ED CUSHIONEL CARPET	CONCRETE (RESILIENT SIMIL	<u>BOOTH</u> AR)

TYP. WALL BASE

€ DOOR OR FACE OF

L DOOR OR FACE OF OPENING

OPENING

SCHEDULED CUSHIONED

JOHNSONITE LS-40-D

SUBFLOOR LEVELING

SCHEDULED CARPET -

SCHEDULED CARPET -JOHNSONITE LS-40-E SUBFLOOR LEVELING SYSTEM OR LIQUID-APPLIED SUBFLOOR

SCHEDULED TILE SET IN THINSET ADHESIVE


FEATHERING AS REQUIRED — CERAMIC TOOL CO. #14CAT-


REQUIRED


SYSTEM OR LIQUID-APPLIED


SUBFLOOR FEATHERING AS


ACCENT PAINT LOCATION GUIDELINES:
REQUIRED AT: • WALLS WITH LETTERSETS
PREFERRED AT: SOFFITS WITH LETTERSETS BRAND FOCAL WALLS MERCH WALLS SO YOU CAN" FEATURE WALLS PAPER DOMINANT WALLS (EXCEPT BEHIND TELLER LINE) LOBBY FOCAL POINTS
NOTES: 1. PREFERENCE TO TERMINATE ACCENT PAINT AT INSIDE CORNERS 2. REFER TO FINISH SCHEDULE FOR ACCENT PAINT COLOR

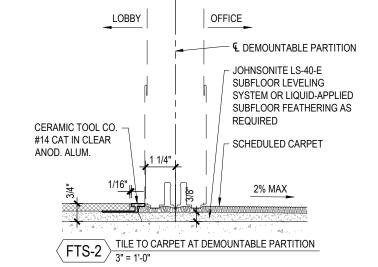


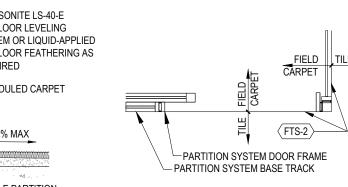


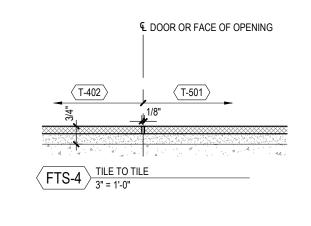


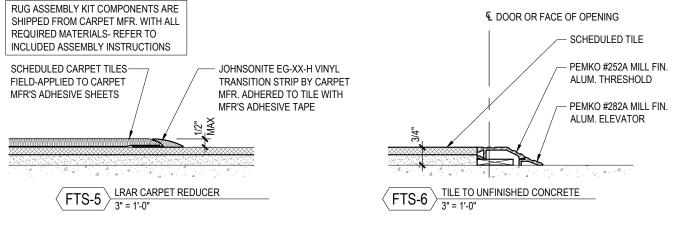


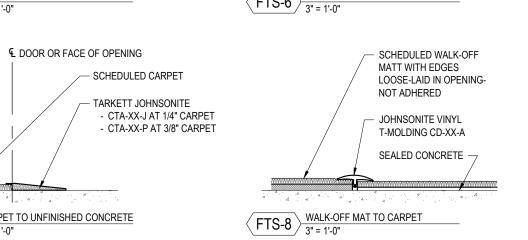

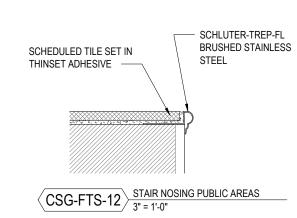


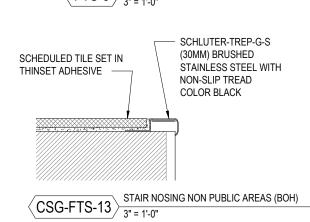

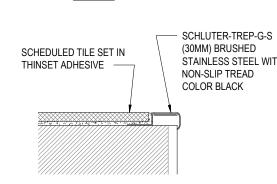

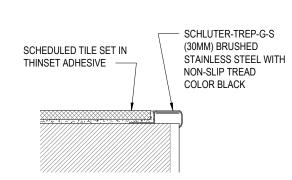

FLOOR TRANSITION TYPES AND STAIR BULLNOSE PROFILES A3.3.1 3" = 1'-0"

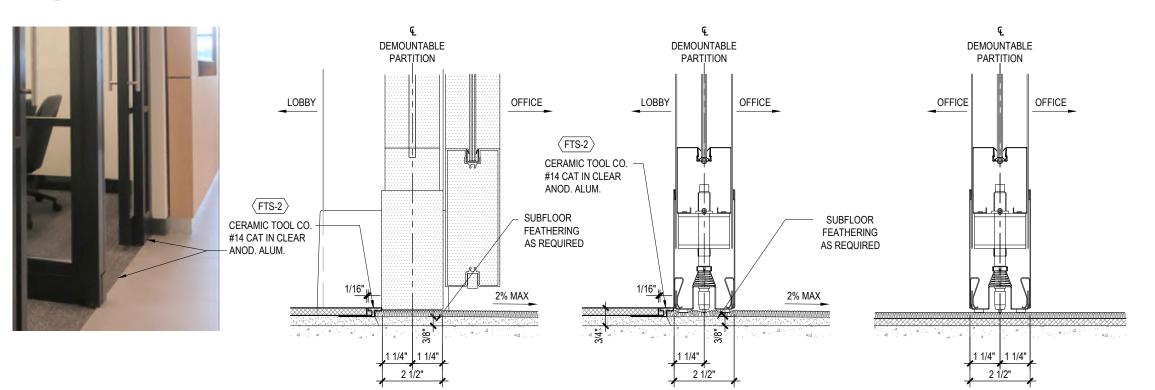


DEMOUNTABLE WALL FLOOR TRANSITIONS A3.3.1 3" = 1'-0"

FLOORING TRANSITION FINISHES				
MATERIAL	PALETTE	FINISH		
NON-METALLIC TRANSITIONS	ALL	BLACK		
METALLIC TRANSITIONS	ALL	CLEAR ANODIZED ALUMINUM		
T-BAR	ALL	CLEAR ANODIZED ALUMINUM		
		•		

NOTE: CONFIRM CONTACT INFORMAT		CONTACTS	MANAGER/COORDINATOR				
VENDOR / MFR.	CONTACT	PHONE	E-MAIL				
ACME BRICK CO.		708-344-1000	L-MAIL				
BENJAMIN MOORE	LOCAL DISTRIBUTOR	700-344-1000					
BENTLEY	CHRIS CLARK	800-423-4709 EXT 5844	Chris Clark@hantloymills.com				
PRINCE STREET	CITAIS CLARK	000-423-4709 EXT 3044	Chris.Clark@bentleymills.com				
BROOKSIDE VENEERS	KEVIN HALL	718-369-0526	kevinh@brooksideveneers.com				
CARRIER	JOANNE HERTEL	315-432-7634	joanne.hertel@carrier.utc.com Strategic.Accounts1@carrier.utc.com				
CBBE	KRISTI FRANKS	770-342-8272	Kfranks@cbbe.net				
CERTAINTEED	LOCAL DISTRIBUTOR						
CORONADO STONE	DERRICK JOHNSON	909-561-8922	derrick@coronado.com				
DAINTREE B.M.S. (CURRENT BY GE)	PETER MEGAN	603-247-3363	peter.megan@gecurrent.com				
DESIGN TEX	JULIE BRINKWORTH	800-221-1540	jbrinkworth@designtex.com				
DL COUCH	MEGAN CUDA	800-433-0790 EXT.1113	mcuda@dlcouch.com				
EMSER	AMBER SHOWALTER	323-650-2000	chase@emser.com				
FSG	ISAIAH RAMDEEN	888-671-4074	jpmc@fsgi.com				
GORDON, INC.	ERIC MAU	847-797-1010	eric@mauinc.com				
HARVEY CEMENT PRODUCTS, INC.	ELLICE HERMAN CRAIG KIRK	708-833-1900 708-822-3907					
HINES, INC.	NATE HINES	870-233-7925 480-710-7474	nate@hinesinc.com				
INTERFACE FLOR	JOE FOLEY	312-961-7046	joe.foley@interface.com				
JOHNSONITE	LOCAL DISTRIBUTOR						
LLUMAR	SCOTT CURRY LISA BOAZ	888-257-5470					
LUMENOMICS, LLC	MARTI HOFFER	206-327-9037	chaseteam@lumenomics.com				
MADICO LOCAL DISTRIBUTOR							
MAPES ARCHITECTURAL CANOPIES CHAD FREEBURGER		888-273-1132	cfreeberger@mapes.com				
MATTHEWS PAINT LOCAL DISTR							
NICHIHA FIBER CEMENT	ADAM COSSICK	770-570-0011	chase@nichiha.com				
NEVAMAR	LOCAL DISTRIBUTOR						
CERTAINTEED WOOD CEILINGS & WALLS (NORTON INDUSTRIES, INC.	ALEXANDRA SCOTT	216-228-6650	chase@nichiha.com				
PHOTOVOLTAIC SYSTEM (FUTURE)	CHRIS ROGGE	913-458-8110	RoggeC@bv.com				
PIONEER MILLWORKS	JERED SLUSSER	800-951-9663	jered@pioneermillworks.com				
PIONITE	LOCAL DISTRIBUTOR						
PRINCIPLE USA	CHASE HEARING LOOP PROJECT MANAGER	865-692-4104	ChaseHearingLoop@principleglobal.com				
PULP STUDIOS	ALEX ROSUL	216-227-1801	arosul@sbcglobal.neet				
QMI SECURITY SOLUTIONS	KEVIN BECERRA	800-446-2500	kbecerra@qmiusa.com				
ROLL-A-SHADE	DEANNA MCCOY	951-245-5077	Deanna.McCoy@RollAShade.com				
SBEMCO	MARK TUCCI	800-468-0860 X:51	mtucci@mattingbydesign.com				
SHERWIN-WILLIAMS	LOCAL DISTRIBUTOR						
STEELCASE (EMPIRE OFFICE)	MARIBETH CAREY	212-607-5568	MCarey@EmpireOffice.com				
STONE SOURCE	DAVID SELTZER	212-979-6400	DSELTZER@STONESOURCE.COM				
TELLEREX	BRIAN LECHLITNER	888-395-0170	brian.lechlitner@tellerex.com				
TELEPRESENCE (CHASE GTI)	TODD YORK	972-324-8100	todd.york@jpmorgan.com				
USG	EDDIE LOPEZ	312-436-8007	HXLopez@usg.com				
WASTE WISE PRODUCTS, INC	PAUL DECONINCK	877-680-8361					
WEATHERMATIC	BRODIE BRUNER	972-926-2170	Brodie.Bruner@weathermatic.com				
WILSONART	LOCAL DISTRIBUTOR						

G.C. TO OBTAIN THE MOST UP-TO-DATE PROJECT SPECIFIC VENDOR LIST FROM THE CHASE PROJECT MANAGER.

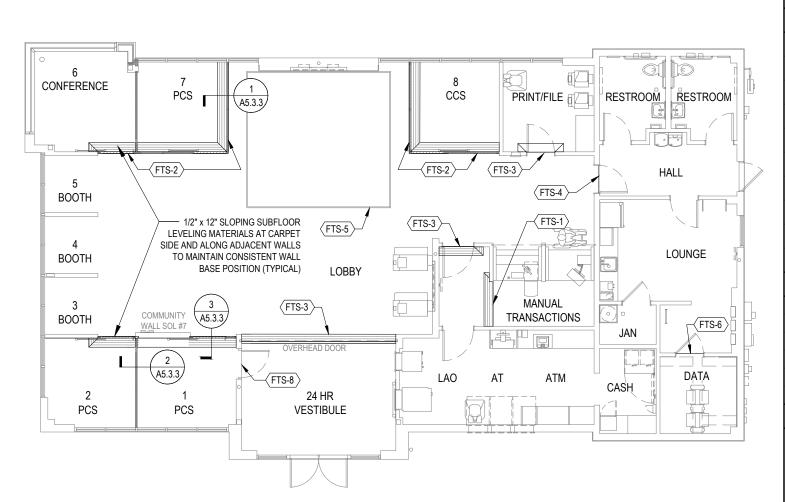

FLOORING TRANSITION GUIDELINE SAMPLE FLOORPLAN AND PROGRAM AREAS FOR REFERENCE

NOTE: NOT ALL ITEMS MAY BE USED IN THIS PROJECT.

GROUP CORESTATES, INC. 6500 Chippewa Street Suite 200 St. Louis, MO 63109 314.843.4320

COA #: A-2014026908 ARCHITECT OF RECORD



ARCHITECT: R. BRUCE LASURS LICENSE NUMBER: 007504 THESE DRAWINGS ARE NOT COMPLETE WITHOUT THE

SEPARATE TYPE WRITTEN SPECIFICATIONS MANUAL WHICH ARE PART OF THE CONTRACT DOCUMENTS.

ISSUE DATE DESCRIPTION 2020.12.21 PERMIT SET

PROJECT INFORMATION PROJECT NO: JPM.27135.001 2020.12.21 PROTOTYPE: C.THEBEAU DRAWN BY: B.LaSURS CHECKED BY: VERSION: SE_1.00 SHEET TITLE

INTERIOR FINISH SCHEDULE FLOOR TRANSITION TYPES & FINISHES SCHEDULE VENDOR CONTACTS

SHEET NUMBER

A3.3.1

	NI. FIN. MAIE	RIALS SCHEDULE
		PAINT
T-103	CEILING PAINT	
	MFR.	BENJAMIN MOORE
	PRODUCT	AURA WATERBORNE INTERIOR PAINT
	COLOR	CLOUD COVER #OC-25
	FINISH	EGGSHELL FINISH 524
	FIRE CLASSIFICATION	CLASS A
PT-311	ACCENT PAINT - NAVY	
	MFR.	BENJAMIN MOORE
	PRODUCT	ULTRA SPEC SCUFF-X
	PRODUCT NUMBER	OLD NAVY #2063-10
	FINISH	MATTE (484)
	FIRE CLASSIFICATION	CLASS A
T-500	GENERAL WALL / CEILIN	NG PAINT
	MFR.	BENJAMIN MOORE
	PRODUCT	AURA WATERBORNE INTERIOR PAINT
	COLOR	CLOUD WHITE #CC-40
	FINISH	EGGSHELL FINISH 524 (WALLS)
		SATIN FINISH 526 (DOORS & FRAMES)
	FIRE CLASSIFICATION	CLASS A
T-501	ACCENT WALL PAINT- G	GREY
	MFR.	BENJAMIN MOORE
	PRODUCT	AURA WATERBORNE INTERIOR PAINT
	COLOR	HEARTHSTONE #1601
	FINISH	EGGSHELL FINISH 524 (WALLS)
		SATIN FINISH 526 (DOORS & FRAMES)
	FIRE CLASSIFICATION	CLASS A

CSG-PT-104	TYPICAL AV NICHE WALL PAINT					
	MFR.	BENJAMIN MOORE				
	PRODUCT	AURA WATERBORNE INTERIOR PAINT				
	COLOR	JET BLACK #2120-10				
	FINISH	FLAT FINISH				
	FIRE CLASSIFICATION	CLASS A				

WC-402	WALL COVERING AT AT	M WALL (WALLCOVERING 1)				
110 402	MFR.	D.L. COUCH				
	PRODUCT	RECORE 'BACCARAT'				
	COLOR	BASALT #NA-4C-JPM501				
	WIDTH	53" ROLLED MATERIAL				
	FIRE CLASSIFICATION	CLASS A				
FRP-1	FIBERGLASS-REINFORC					
	MFR.	CRANE COMPOSITES				
	PRODUCT	GLASBORD PIF				
	FINISH	84 IVORY				
	LOCATIONS	JANITOR CLOSET / LADDER ROOM				
	FIRE CLASSIFICATION	CLASS C				
		N TREATMENTS				
WT-1		HADE (5% OPENNESS FACTOR)				
•	VENDOR / INSTALLER	LUMENOMICS				
	PRODUCT	SHEER WEAVE 2000				
	SHADE COLOR	WHITE PLATINUM P05				
	HOUSING	REFER TO INTERIOR FINISH SCHEDULE				
	NOTES	PRODUCT INSTALLED BY LUMENOMICS,				
	110120	REFER TO STANDARDS FOR GC COORDINATION WITH VENDOR				
WT-1 ALT	MOTORIZED ROLLING S	HADE (5% OPENNESS FACTOR)				
	VENDOR / INSTALLER	ROLL-A-SHADE				
	PRODUCT	SHEER WEAVE 2000				
	SHADE COLOR	WHITE PLATINUM P05				
	HOUSING	REFER TO INTERIOR FINISH SCHEDULE				
	NOTES	PRODUCT INSTALLED BY ROLL-A-SHADE, REFER TO STANDARDS FOR GC COORDINATION WITH VENDOR				
WT-2	MOTORIZED ROLLING S	HADE (3% OPENNESS FACTOR)				
	VENDOR / INSTALLER	LUMENOMICS				
	PRODUCT	SHEER WEAVE 2410 P14				
	SHADE COLOR	PEARL GREY / OYSTER				
	HOUSING	REFER TO INTERIOR FINISH SCHEDULE				
	NOTES	PRODUCT INSTALLED BY LUMENOMICS, REFER TO STANDARDS FOR GC COORDINATION WITH VENDOR				
WT-2 ALT	MOTORIZED ROLLING S	HADE (3% OPENNESS FACTOR)				
	VENDOR / INSTALLER	ROLL-A-SHADE				
	PRODUCT	SHEER WEAVE 2410 P14				
	SHADE COLOR	PEARL GREY / OYSTER				
	HOUSING	REFER TO INTERIOR FINISH SCHEDULE				
	NOTES	PRODUCT INSTALLED BY ROLL-A-SHADE, REFER TO STANDARDS FOR GC COORDINATION WITH VENDOR				
WT-4	FROSTED WINDOW FILM	i				
	MFR.	LLUMAR				
	PRODUCT	NRM PS2				
	COLOR	FROSTED 69% TRANSMITTANCE				
	USES	AT CLOSED VESTIBULE GLAZING ADJACENT				

\neg		1					
	WT-5		DE (5% OPENNESS FACTOR)				
		VENDOR / INSTALLER	LUMENOMICS				
		PRODUCT	SHEER WEAVE 2000				
		SHADE COLOR	WHITE PLATINUM P05				
	VALT CALT	HOUSING	REFER TO INTERIOR FINISH SCHEDULE				
	WT-5 ALT		DE (5% OPENNESS FACTOR)				
		VENDOR / INSTALLER	ROLL-A-SHADE				
		PRODUCT	SHEER WEAVE 2000				
		SHADE COLOR	WHITE PLATINUM P05				
		HOUSING	REFER TO INTERIOR FINISH SCHEDULE				
	WT-6		DE (3% OPENNESS FACTOR)				
		VENDOR / INSTALLER	LUMENOMICS				
		PRODUCT	SHEER WEAVE 2410 P14				
		SHADE COLOR	PEARL GREY / OYSTER				
		HOUSING	REFER TO INTERIOR FINISH SCHEDULE				
	WT-6 ALT	MANUAL ROLLING SHAD	DE (3% OPENNESS FACTOR)				
		VENDOR / INSTALLER	ROLL-A-SHADE				
		PRODUCT	SHEER WEAVE 2410 P14				
-		SHADE COLOR	PEARL GREY / OYSTER				
		HOUSING	REFER TO INTERIOR FINISH SCHEDULE				
_	WT-7	DOUBLE-ROLLER SHAD	E				
		VENDOR / INSTALLER	LUMENOMICS				
		PRODUCT	MBOR				
		FRONT SHADE	MATCH TYPICAL FABRIC WITHIN BRANCH,				
			WT-1 OR WT-2				
		BACK SHADE	INDIANA COATED GRAY (OPAQUE)				
		HOUSING	REFER TO INTERIOR FINISH SCHEDULE				
		NOTES	PRODUCT INSTALLED BY LUMENOMICS,				
			REFER TO STANDARDS FOR GC COORDINATION WITH VENDOR				
		USES	TYPICAL AT ALL CONFERENCE ROOM				
			WINDOWS				
	WT-7 ALT	DOUBLE-ROLLER SHAD	E				
		VENDOR / INSTALLER	ROLL-A-SHADE				
		PRODUCT	MBOR				
		FRONT SHADE	MATCH TYPICAL FABRIC WITHIN BRANCH,				
		DA OK CHADE	WT-1 OR WT-2				
		BACK SHADE	INDIANA COATED GRAY (OPAQUE)				
7		HOUSING	REFER TO INTERIOR FINISH SCHEDULE				
\dashv		NOTES	PRODUCT INSTALLED BY LUMENOMICS, REFER TO STANDARDS FOR GC				
\dashv			COORDINATION WITH VENDOR				
_		USES	TYPICAL AT ALL CONFERENCE ROOM				
_	WT-8	WINDOWS FIELD-APPLIED SPANDREL FILM					
_	111-0	VENDOR / INSTALLER	Тзм				
7		VENDOR/INSTALLER					
		PRODUCT					
		PRODUCT	SCOTCHCAL GRAPHIC FILM				
		COLOR	3630-51, SILVER				
		COLOR FURNISHED BY	3630-51, SILVER GENERAL CONTRACTOR				
		COLOR	3630-51, SILVER GENERAL CONTRACTOR RETROFIT STOREFRONT GLAZING TO BLOCK				
		COLOR FURNISHED BY	3630-51, SILVER GENERAL CONTRACTOR				
	WT-20	COLOR FURNISHED BY USES FIRE CLASSIFICATION	3630-51, SILVER GENERAL CONTRACTOR RETROFIT STOREFRONT GLAZING TO BLOCK VISIBILITY CLASS A				
	WT-20	COLOR FURNISHED BY USES FIRE CLASSIFICATION MOTORIZED ROLLING TO	3630-51, SILVER GENERAL CONTRACTOR RETROFIT STOREFRONT GLAZING TO BLOCK VISIBILITY CLASS A ELLER SCRIM (OPAQUE)				
	WT-20	COLOR FURNISHED BY USES FIRE CLASSIFICATION MOTORIZED ROLLING TO VENDOR / INSTALLER	3630-51, SILVER GENERAL CONTRACTOR RETROFIT STOREFRONT GLAZING TO BLOCK VISIBILITY CLASS A ELLER SCRIM (OPAQUE) LUMENOMICS				
	WT-20	COLOR FURNISHED BY USES FIRE CLASSIFICATION MOTORIZED ROLLING TO	3630-51, SILVER GENERAL CONTRACTOR RETROFIT STOREFRONT GLAZING TO BLOCK VISIBILITY CLASS A ELLER SCRIM (OPAQUE)				
	WT-20	COLOR FURNISHED BY USES FIRE CLASSIFICATION MOTORIZED ROLLING TO VENDOR / INSTALLER	3630-51, SILVER GENERAL CONTRACTOR RETROFIT STOREFRONT GLAZING TO BLOCK VISIBILITY CLASS A ELLER SCRIM (OPAQUE) LUMENOMICS MOBR INTERIOR SUN CONTROL FABRICS				
	WT-20	COLOR FURNISHED BY USES FIRE CLASSIFICATION MOTORIZED ROLLING TO VENDOR / INSTALLER PRODUCT	3630-51, SILVER GENERAL CONTRACTOR RETROFIT STOREFRONT GLAZING TO BLOCK VISIBILITY CLASS A ELLER SCRIM (OPAQUE) LUMENOMICS MOBR INTERIOR SUN CONTROL FABRICS PHIFER SHEAR WEAVE 7100 WHITE P-02 ANODIZED ALUMINUM - PAINT TO MATCH				
	WT-20	COLOR FURNISHED BY USES FIRE CLASSIFICATION MOTORIZED ROLLING TO VENDOR / INSTALLER PRODUCT SHADE COLOR ENCLOSURE COLOR	3630-51, SILVER GENERAL CONTRACTOR RETROFIT STOREFRONT GLAZING TO BLOCK VISIBILITY CLASS A ELLER SCRIM (OPAQUE) LUMENOMICS MOBR INTERIOR SUN CONTROL FABRICS PHIFER SHEAR WEAVE 7100 WHITE P-02 ANODIZED ALUMINUM - PAINT TO MATCH ADJACENT FINISHES				
	WT-20	COLOR FURNISHED BY USES FIRE CLASSIFICATION MOTORIZED ROLLING TO VENDOR / INSTALLER PRODUCT SHADE COLOR	3630-51, SILVER GENERAL CONTRACTOR RETROFIT STOREFRONT GLAZING TO BLOCK VISIBILITY CLASS A ELLER SCRIM (OPAQUE) LUMENOMICS MOBR INTERIOR SUN CONTROL FABRICS PHIFER SHEAR WEAVE 7100 WHITE P-02 ANODIZED ALUMINUM - PAINT TO MATCH ADJACENT FINISHES ANODIZED ALUMINUM WITH GREY RUBBER				
	WT-20	COLOR FURNISHED BY USES FIRE CLASSIFICATION MOTORIZED ROLLING TO VENDOR / INSTALLER PRODUCT SHADE COLOR ENCLOSURE COLOR	3630-51, SILVER GENERAL CONTRACTOR RETROFIT STOREFRONT GLAZING TO BLOCK VISIBILITY CLASS A ELLER SCRIM (OPAQUE) LUMENOMICS MOBR INTERIOR SUN CONTROL FABRICS PHIFER SHEAR WEAVE 7100 WHITE P-02 ANODIZED ALUMINUM - PAINT TO MATCH ADJACENT FINISHES ANODIZED ALUMINUM WITH GREY RUBBER BOTTOM SEAL				
	WT-20	COLOR FURNISHED BY USES FIRE CLASSIFICATION MOTORIZED ROLLING TI VENDOR / INSTALLER PRODUCT SHADE COLOR ENCLOSURE COLOR EXPOSED HEM BAR	3630-51, SILVER GENERAL CONTRACTOR RETROFIT STOREFRONT GLAZING TO BLOCK VISIBILITY CLASS A ELLER SCRIM (OPAQUE) LUMENOMICS MOBR INTERIOR SUN CONTROL FABRICS PHIFER SHEAR WEAVE 7100 WHITE P-02 ANODIZED ALUMINUM - PAINT TO MATCH ADJACENT FINISHES ANODIZED ALUMINUM WITH GREY RUBBER BOTTOM SEAL PRODUCT INSTALLED BY LUMENOMICS, REFER TO STANDARDS FOR GC				
		COLOR FURNISHED BY USES FIRE CLASSIFICATION MOTORIZED ROLLING TO VENDOR / INSTALLER PRODUCT SHADE COLOR ENCLOSURE COLOR EXPOSED HEM BAR NOTES	3630-51, SILVER GENERAL CONTRACTOR RETROFIT STOREFRONT GLAZING TO BLOCK VISIBILITY CLASS A ELLER SCRIM (OPAQUE) LUMENOMICS MOBR INTERIOR SUN CONTROL FABRICS PHIFER SHEAR WEAVE 7100 WHITE P-02 ANODIZED ALUMINUM - PAINT TO MATCH ADJACENT FINISHES ANODIZED ALUMINUM WITH GREY RUBBER BOTTOM SEAL PRODUCT INSTALLED BY LUMENOMICS, REFER TO STANDARDS FOR GC COORDINATION WITH VENDOR				
	WT-20 WT-20 ALT	COLOR FURNISHED BY USES FIRE CLASSIFICATION MOTORIZED ROLLING TO VENDOR / INSTALLER PRODUCT SHADE COLOR ENCLOSURE COLOR EXPOSED HEM BAR NOTES MOTORIZED ROLLING TO	3630-51, SILVER GENERAL CONTRACTOR RETROFIT STOREFRONT GLAZING TO BLOCK VISIBILITY CLASS A ELLER SCRIM (OPAQUE) LUMENOMICS MOBR INTERIOR SUN CONTROL FABRICS PHIFER SHEAR WEAVE 7100 WHITE P-02 ANODIZED ALUMINUM - PAINT TO MATCH ADJACENT FINISHES ANODIZED ALUMINUM WITH GREY RUBBER BOTTOM SEAL PRODUCT INSTALLED BY LUMENOMICS, REFER TO STANDARDS FOR GC COORDINATION WITH VENDOR ELLER SCRIM (OPAQUE)				
		COLOR FURNISHED BY USES FIRE CLASSIFICATION MOTORIZED ROLLING TO VENDOR / INSTALLER PRODUCT SHADE COLOR ENCLOSURE COLOR EXPOSED HEM BAR NOTES MOTORIZED ROLLING TO VENDOR / INSTALLER	3630-51, SILVER GENERAL CONTRACTOR RETROFIT STOREFRONT GLAZING TO BLOCK VISIBILITY CLASS A ELLER SCRIM (OPAQUE) LUMENOMICS MOBR INTERIOR SUN CONTROL FABRICS PHIFER SHEAR WEAVE 7100 WHITE P-02 ANODIZED ALUMINUM - PAINT TO MATCH ADJACENT FINISHES ANODIZED ALUMINUM WITH GREY RUBBER BOTTOM SEAL PRODUCT INSTALLED BY LUMENOMICS, REFER TO STANDARDS FOR GC COORDINATION WITH VENDOR ELLER SCRIM (OPAQUE) ROLL-A-SHADE				
		COLOR FURNISHED BY USES FIRE CLASSIFICATION MOTORIZED ROLLING TO VENDOR / INSTALLER PRODUCT SHADE COLOR ENCLOSURE COLOR EXPOSED HEM BAR NOTES MOTORIZED ROLLING TO	3630-51, SILVER GENERAL CONTRACTOR RETROFIT STOREFRONT GLAZING TO BLOCK VISIBILITY CLASS A ELLER SCRIM (OPAQUE) LUMENOMICS MOBR INTERIOR SUN CONTROL FABRICS PHIFER SHEAR WEAVE 7100 WHITE P-02 ANODIZED ALUMINUM - PAINT TO MATCH ADJACENT FINISHES ANODIZED ALUMINUM WITH GREY RUBBER BOTTOM SEAL PRODUCT INSTALLED BY LUMENOMICS, REFER TO STANDARDS FOR GC COORDINATION WITH VENDOR ELLER SCRIM (OPAQUE) ROLL-A-SHADE MOBR INTERIOR SUN CONTROL FABRICS				
		COLOR FURNISHED BY USES FIRE CLASSIFICATION MOTORIZED ROLLING TO VENDOR / INSTALLER PRODUCT SHADE COLOR ENCLOSURE COLOR EXPOSED HEM BAR NOTES MOTORIZED ROLLING TO VENDOR / INSTALLER	3630-51, SILVER GENERAL CONTRACTOR RETROFIT STOREFRONT GLAZING TO BLOCK VISIBILITY CLASS A ELLER SCRIM (OPAQUE) LUMENOMICS MOBR INTERIOR SUN CONTROL FABRICS PHIFER SHEAR WEAVE 7100 WHITE P-02 ANODIZED ALUMINUM - PAINT TO MATCH ADJACENT FINISHES ANODIZED ALUMINUM WITH GREY RUBBER BOTTOM SEAL PRODUCT INSTALLED BY LUMENOMICS, REFER TO STANDARDS FOR GC COORDINATION WITH VENDOR ELLER SCRIM (OPAQUE) ROLL-A-SHADE				
		COLOR FURNISHED BY USES FIRE CLASSIFICATION MOTORIZED ROLLING TO VENDOR / INSTALLER PRODUCT SHADE COLOR ENCLOSURE COLOR EXPOSED HEM BAR NOTES MOTORIZED ROLLING TO VENDOR / INSTALLER PRODUCT SHADE COLOR	3630-51, SILVER GENERAL CONTRACTOR RETROFIT STOREFRONT GLAZING TO BLOCK VISIBILITY CLASS A ELLER SCRIM (OPAQUE) LUMENOMICS MOBR INTERIOR SUN CONTROL FABRICS PHIFER SHEAR WEAVE 7100 WHITE P-02 ANODIZED ALUMINUM - PAINT TO MATCH ADJACENT FINISHES ANODIZED ALUMINUM WITH GREY RUBBER BOTTOM SEAL PRODUCT INSTALLED BY LUMENOMICS, REFER TO STANDARDS FOR GC COORDINATION WITH VENDOR ELLER SCRIM (OPAQUE) ROLL-A-SHADE MOBR INTERIOR SUN CONTROL FABRICS PHIFER SHEAR WEAVE 7100 WHITE P-02				
		COLOR FURNISHED BY USES FIRE CLASSIFICATION MOTORIZED ROLLING TI VENDOR / INSTALLER PRODUCT SHADE COLOR ENCLOSURE COLOR EXPOSED HEM BAR NOTES MOTORIZED ROLLING TI VENDOR / INSTALLER PRODUCT	3630-51, SILVER GENERAL CONTRACTOR RETROFIT STOREFRONT GLAZING TO BLOCK VISIBILITY CLASS A ELLER SCRIM (OPAQUE) LUMENOMICS MOBR INTERIOR SUN CONTROL FABRICS PHIFER SHEAR WEAVE 7100 WHITE P-02 ANODIZED ALUMINUM - PAINT TO MATCH ADJACENT FINISHES ANODIZED ALUMINUM WITH GREY RUBBER BOTTOM SEAL PRODUCT INSTALLED BY LUMENOMICS, REFER TO STANDARDS FOR GC COORDINATION WITH VENDOR ELLER SCRIM (OPAQUE) ROLL-A-SHADE MOBR INTERIOR SUN CONTROL FABRICS PHIFER SHEAR WEAVE 7100				
		COLOR FURNISHED BY USES FIRE CLASSIFICATION MOTORIZED ROLLING TO VENDOR / INSTALLER PRODUCT SHADE COLOR ENCLOSURE COLOR EXPOSED HEM BAR NOTES MOTORIZED ROLLING TO VENDOR / INSTALLER PRODUCT SHADE COLOR	3630-51, SILVER GENERAL CONTRACTOR RETROFIT STOREFRONT GLAZING TO BLOCK VISIBILITY CLASS A ELLER SCRIM (OPAQUE) LUMENOMICS MOBR INTERIOR SUN CONTROL FABRICS PHIFER SHEAR WEAVE 7100 WHITE P-02 ANODIZED ALUMINUM - PAINT TO MATCH ADJACENT FINISHES ANODIZED ALUMINUM WITH GREY RUBBER BOTTOM SEAL PRODUCT INSTALLED BY LUMENOMICS, REFER TO STANDARDS FOR GC COORDINATION WITH VENDOR ELLER SCRIM (OPAQUE) ROLL-A-SHADE MOBR INTERIOR SUN CONTROL FABRICS PHIFER SHEAR WEAVE 7100 WHITE P-02 ANODIZED ALUMINUM - PAINT TO MATCH ADJACENT FINISHES ANODIZED ALUMINUM WITH GREY RUBBER				
		COLOR FURNISHED BY USES FIRE CLASSIFICATION MOTORIZED ROLLING TI VENDOR / INSTALLER PRODUCT SHADE COLOR ENCLOSURE COLOR EXPOSED HEM BAR NOTES MOTORIZED ROLLING TI VENDOR / INSTALLER PRODUCT SHADE COLOR ENCLOSURE COLOR EXPOSED HEM BAR	3630-51, SILVER GENERAL CONTRACTOR RETROFIT STOREFRONT GLAZING TO BLOCK VISIBILITY CLASS A ELLER SCRIM (OPAQUE) LUMENOMICS MOBR INTERIOR SUN CONTROL FABRICS PHIFER SHEAR WEAVE 7100 WHITE P-02 ANODIZED ALUMINUM - PAINT TO MATCH ADJACENT FINISHES ANODIZED ALUMINUM WITH GREY RUBBER BOTTOM SEAL PRODUCT INSTALLED BY LUMENOMICS, REFER TO STANDARDS FOR GC COORDINATION WITH VENDOR ELLER SCRIM (OPAQUE) ROLL-A-SHADE MOBR INTERIOR SUN CONTROL FABRICS PHIFER SHEAR WEAVE 7100 WHITE P-02 ANODIZED ALUMINUM - PAINT TO MATCH ADJACENT FINISHES ANODIZED ALUMINUM WITH GREY RUBBER BOTTOM SEAL				
		COLOR FURNISHED BY USES FIRE CLASSIFICATION MOTORIZED ROLLING TO VENDOR / INSTALLER PRODUCT SHADE COLOR ENCLOSURE COLOR EXPOSED HEM BAR NOTES MOTORIZED ROLLING TO VENDOR / INSTALLER PRODUCT SHADE COLOR ENCLOSURE COLOR ENCLOSURE COLOR	3630-51, SILVER GENERAL CONTRACTOR RETROFIT STOREFRONT GLAZING TO BLOCK VISIBILITY CLASS A ELLER SCRIM (OPAQUE) LUMENOMICS MOBR INTERIOR SUN CONTROL FABRICS PHIFER SHEAR WEAVE 7100 WHITE P-02 ANODIZED ALUMINUM - PAINT TO MATCH ADJACENT FINISHES ANODIZED ALUMINUM WITH GREY RUBBER BOTTOM SEAL PRODUCT INSTALLED BY LUMENOMICS, REFER TO STANDARDS FOR GC COORDINATION WITH VENDOR ELLER SCRIM (OPAQUE) ROLL-A-SHADE MOBR INTERIOR SUN CONTROL FABRICS PHIFER SHEAR WEAVE 7100 WHITE P-02 ANODIZED ALUMINUM - PAINT TO MATCH ADJACENT FINISHES ANODIZED ALUMINUM WITH GREY RUBBER BOTTOM SEAL PRODUCT INSTALLED BY ROLL-A-SHADE,				
		COLOR FURNISHED BY USES FIRE CLASSIFICATION MOTORIZED ROLLING TI VENDOR / INSTALLER PRODUCT SHADE COLOR ENCLOSURE COLOR EXPOSED HEM BAR NOTES MOTORIZED ROLLING TI VENDOR / INSTALLER PRODUCT SHADE COLOR ENCLOSURE COLOR EXPOSED HEM BAR	3630-51, SILVER GENERAL CONTRACTOR RETROFIT STOREFRONT GLAZING TO BLOCK VISIBILITY CLASS A ELLER SCRIM (OPAQUE) LUMENOMICS MOBR INTERIOR SUN CONTROL FABRICS PHIFER SHEAR WEAVE 7100 WHITE P-02 ANODIZED ALUMINUM - PAINT TO MATCH ADJACENT FINISHES ANODIZED ALUMINUM WITH GREY RUBBER BOTTOM SEAL PRODUCT INSTALLED BY LUMENOMICS, REFER TO STANDARDS FOR GC COORDINATION WITH VENDOR ELLER SCRIM (OPAQUE) ROLL-A-SHADE MOBR INTERIOR SUN CONTROL FABRICS PHIFER SHEAR WEAVE 7100 WHITE P-02 ANODIZED ALUMINUM - PAINT TO MATCH ADJACENT FINISHES ANODIZED ALUMINUM WITH GREY RUBBER BOTTOM SEAL				
		COLOR FURNISHED BY USES FIRE CLASSIFICATION MOTORIZED ROLLING TO VENDOR / INSTALLER PRODUCT SHADE COLOR ENCLOSURE COLOR EXPOSED HEM BAR NOTES MOTORIZED ROLLING TO VENDOR / INSTALLER PRODUCT SHADE COLOR ENCLOSURE COLOR EXPOSED HEM BAR NOTES	3630-51, SILVER GENERAL CONTRACTOR RETROFIT STOREFRONT GLAZING TO BLOCK VISIBILITY CLASS A ELLER SCRIM (OPAQUE) LUMENOMICS MOBR INTERIOR SUN CONTROL FABRICS PHIFER SHEAR WEAVE 7100 WHITE P-02 ANODIZED ALUMINUM - PAINT TO MATCH ADJACENT FINISHES ANODIZED ALUMINUM WITH GREY RUBBER BOTTOM SEAL PRODUCT INSTALLED BY LUMENOMICS, REFER TO STANDARDS FOR GC COORDINATION WITH VENDOR ELLER SCRIM (OPAQUE) ROLL-A-SHADE MOBR INTERIOR SUN CONTROL FABRICS PHIFER SHEAR WEAVE 7100 WHITE P-02 ANODIZED ALUMINUM - PAINT TO MATCH ADJACENT FINISHES ANODIZED ALUMINUM WITH GREY RUBBER BOTTOM SEAL PRODUCT INSTALLED BY ROLL-A-SHADE, REFER TO STANDARDS FOR GC				
	WT-20 ALT	COLOR FURNISHED BY USES FIRE CLASSIFICATION MOTORIZED ROLLING TO VENDOR / INSTALLER PRODUCT SHADE COLOR ENCLOSURE COLOR EXPOSED HEM BAR NOTES MOTORIZED ROLLING TO VENDOR / INSTALLER PRODUCT SHADE COLOR ENCLOSURE COLOR EXPOSED HEM BAR NOTES	3630-51, SILVER GENERAL CONTRACTOR RETROFIT STOREFRONT GLAZING TO BLOCK VISIBILITY CLASS A ELLER SCRIM (OPAQUE) LUMENOMICS MOBR INTERIOR SUN CONTROL FABRICS PHIFER SHEAR WEAVE 7100 WHITE P-02 ANODIZED ALUMINUM - PAINT TO MATCH ADJACENT FINISHES ANODIZED ALUMINUM WITH GREY RUBBER BOTTOM SEAL PRODUCT INSTALLED BY LUMENOMICS, REFER TO STANDARDS FOR GC COORDINATION WITH VENDOR ELLER SCRIM (OPAQUE) ROLL-A-SHADE MOBR INTERIOR SUN CONTROL FABRICS PHIFER SHEAR WEAVE 7100 WHITE P-02 ANODIZED ALUMINUM - PAINT TO MATCH ADJACENT FINISHES ANODIZED ALUMINUM - PAINT TO MATCH ADJACENT FINISHES ANODIZED ALUMINUM WITH GREY RUBBER BOTTOM SEAL PRODUCT INSTALLED BY ROLL-A-SHADE, REFER TO STANDARDS FOR GC COORDINATION WITH VENDOR				
	WT-20 ALT	COLOR FURNISHED BY USES FIRE CLASSIFICATION MOTORIZED ROLLING TO VENDOR / INSTALLER PRODUCT SHADE COLOR ENCLOSURE COLOR EXPOSED HEM BAR NOTES MOTORIZED ROLLING TO VENDOR / INSTALLER PRODUCT SHADE COLOR EXPOSED HEM BAR NOTES MOTORIZED ROLLING TO VENDOR / INSTALLER PRODUCT SHADE COLOR ENCLOSURE COLOR EXPOSED HEM BAR NOTES SPANDREL GLAZING (SE	GENERAL CONTRACTOR RETROFIT STOREFRONT GLAZING TO BLOCK VISIBILITY CLASS A ELLER SCRIM (OPAQUE) LUMENOMICS MOBR INTERIOR SUN CONTROL FABRICS PHIFER SHEAR WEAVE 7100 WHITE P-02 ANODIZED ALUMINUM - PAINT TO MATCH ADJACENT FINISHES ANODIZED ALUMINUM WITH GREY RUBBER BOTTOM SEAL PRODUCT INSTALLED BY LUMENOMICS, REFER TO STANDARDS FOR GC COORDINATION WITH VENDOR ELLER SCRIM (OPAQUE) ROLL-A-SHADE MOBR INTERIOR SUN CONTROL FABRICS PHIFER SHEAR WEAVE 7100 WHITE P-02 ANODIZED ALUMINUM - PAINT TO MATCH ADJACENT FINISHES ANODIZED ALUMINUM - PAINT TO MATCH ADJACENT FINISHES ANODIZED ALUMINUM WITH GREY RUBBER BOTTOM SEAL PRODUCT INSTALLED BY ROLL-A-SHADE, REFER TO STANDARDS FOR GC COORDINATION WITH VENDOR				
	WT-20 ALT	COLOR FURNISHED BY USES FIRE CLASSIFICATION MOTORIZED ROLLING TO VENDOR / INSTALLER PRODUCT SHADE COLOR ENCLOSURE COLOR EXPOSED HEM BAR NOTES MOTORIZED ROLLING TO VENDOR / INSTALLER PRODUCT SHADE COLOR ENCLOSURE COLOR EXPOSED HEM BAR NOTES MOTORIZED ROLLING TO VENDOR / INSTALLER PRODUCT SHADE COLOR ENCLOSURE COLOR EXPOSED HEM BAR NOTES SPANDREL GLAZING (SEME) MFR.	3630-51, SILVER GENERAL CONTRACTOR RETROFIT STOREFRONT GLAZING TO BLOCK VISIBILITY CLASS A ELLER SCRIM (OPAQUE) LUMENOMICS MOBR INTERIOR SUN CONTROL FABRICS PHIFER SHEAR WEAVE 7100 WHITE P-02 ANODIZED ALUMINUM - PAINT TO MATCH ADJACENT FINISHES ANODIZED ALUMINUM WITH GREY RUBBER BOTTOM SEAL PRODUCT INSTALLED BY LUMENOMICS, REFER TO STANDARDS FOR GC COORDINATION WITH VENDOR ELLER SCRIM (OPAQUE) ROLL-A-SHADE MOBR INTERIOR SUN CONTROL FABRICS PHIFER SHEAR WEAVE 7100 WHITE P-02 ANODIZED ALUMINUM - PAINT TO MATCH ADJACENT FINISHES ANODIZED ALUMINUM - PAINT TO MATCH ADJACENT FINISHES ANODIZED ALUMINUM WITH GREY RUBBER BOTTOM SEAL PRODUCT INSTALLED BY ROLL-A-SHADE, REFER TO STANDARDS FOR GC COORDINATION WITH VENDOR PECIAL- CASE USE ONLY) VIRACON				
	WT-20 ALT	COLOR FURNISHED BY USES FIRE CLASSIFICATION MOTORIZED ROLLING TI VENDOR / INSTALLER PRODUCT SHADE COLOR ENCLOSURE COLOR EXPOSED HEM BAR NOTES MOTORIZED ROLLING TI VENDOR / INSTALLER PRODUCT SHADE COLOR ENCLOSURE COLOR ENCLOSURE COLOR ENCLOSURE COLOR ENCLOSURE COLOR ENCLOSURE COLOR EXPOSED HEM BAR NOTES SPANDREL GLAZING (SEMFR. PRODUCT	GENERAL CONTRACTOR RETROFIT STOREFRONT GLAZING TO BLOCK VISIBILITY CLASS A ELLER SCRIM (OPAQUE) LUMENOMICS MOBR INTERIOR SUN CONTROL FABRICS PHIFER SHEAR WEAVE 7100 WHITE P-02 ANODIZED ALUMINUM - PAINT TO MATCH ADJACENT FINISHES ANODIZED ALUMINUM WITH GREY RUBBER BOTTOM SEAL PRODUCT INSTALLED BY LUMENOMICS, REFER TO STANDARDS FOR GC COORDINATION WITH VENDOR ELLER SCRIM (OPAQUE) ROLL-A-SHADE MOBR INTERIOR SUN CONTROL FABRICS PHIFER SHEAR WEAVE 7100 WHITE P-02 ANODIZED ALUMINUM - PAINT TO MATCH ADJACENT FINISHES ANODIZED ALUMINUM WITH GREY RUBBER BOTTOM SEAL PRODUCT INSTALLED BY ROLL-A-SHADE, REFER TO STANDARDS FOR GC COORDINATION WITH VENDOR PECIAL- CASE USE ONLY) VIRACON				

		TRIM			
WB-402	VINYL WALL BASE- STRAIGHT- AREAS WITH FLOORING				
	MFR.	JOHNSONITE			
	PRODUCT	TIGHTLOCK			
	COLOR	20 CHARCOAL WG			
	PROFILE	4 1/2" STRAIGHT (TOELESS)			
WB-403	VINYL WALL BASE- COVE- AREAS WITH EXPOSED SLAB				
	MFR.	JOHNSONITE			
	PRODUCT	TRADITIONAL WALL BASE			
	COLOR	20 CHARCOAL WG			
	PROFILE	4" COVE			
WB-502	WALL BASE - AT BOOTH ONLY				
	MFR.	PIONEER MILLWORKS			
	PRODUCT/COLOR	MODERN FARMHOUSE- CLEAN ASH			
	PROFILE	4 1/4" X 5/8"			
	NOTES	MATCHING 5/8" PERIMETER TRIM IN WIDTHS PER ELEVATIONS TO BE ORDERED THROUGH PIONEER MILLWORKS. SEE NOTE 1.			

	MILLWO	RK SURFACES
SS-300	SOLID SURFACE MATERI	AL
	DESCRIPTION	1/2" ACRYLIC SOLID SURFACE WITH EASED EDGES
	MFR.	DUPONT CORIAN
	COLOR	SILVER BIRCH
	USES	WINDOW SILLS & MILLWORK SURFACES
PL-502	MILLWORK LAMINATE	
	DESCRIPTION	PLASTIC LAMINATE
	MFR.	WILSONART

	DESCRIPTION	PLASTIC LAMINATE
	MFR.	WILSONART
	COLOR	NATURAL RECON 7996-38
	USES	MILLWORK, CHECK DESK
PL-503	MILLWORK LAMINATE	
	DESCRIPTION	PLASTIC LAMINATE
	MFR.	WILSONART
	COLOR	LECHE VISTA 4987K-07
	USES	BOH MILLWORK COUNTER SURFACE
WD-502	WOOD ACCENT	
	DESCRIPTION	ENGINEERED PLANK, RAKED PROFILE
	MFR.	PIONEER MILLWORKS
	PRODUCT	MODERN FARMHOUSE- CLEAN ASH
	SIZE	5 1/2" X 5/8", FCS MIX
	TEXTURE	RAKED
	FINISH	CLEAR, POLY CLASS A FIRE RETARDANT
	USES	BOOTH MILLWORK
	NOTES	MATCHING 5/8" PERIMETER TRIM IN WIDTHS PER ELEVATIONS, AND BOOTH BASE (WB-502) TO BE ORDERED THROUGH PIONEER MILLWORKS
WD-601	VENEER PANELS	
	MFR.	BROOKSIDE VENEERS

ALPIKORD PREFINISHED - CROSS GRAIN

APPLIED TO FEATURE DIGITAL WALL

REFER TO FINISH PLAN AND ELEVATIONS

SLAVONY OAK, PLANK

10.84K ALPIKORD

PRODUCT

SPECIES


COLOR

NOTES

		CARPET				
CPT-302	WALK-OFF MAT					
	MFR.	SBEMCO / MATTING BY DESIGN				
	PRODUCT	ULTRA DRY PCR PET				
	COLOR	PUMICE #620				
	SIZE	PER PLAN				
	BACKING	THERMAL BONDED, BLOWN PVC, ANTI-MICROBIAL PINK				
	NOTES	LOOSE-LAID/NOT ADHERED				
		RIB DIRECTION TO RUN PARALLEL TO ENTRY DOOR				
	FIRE CLASSIFICATION	CLASS 1				
CPT-320	GENERAL CARPET					
	MFR.	INTERFACE				
	PRODUCT	HARMONIZE				
	COLOR	GRAVEL 104043				
	SIZE	25CM X 1M TILE (9.84" x 39.37")				
	BACKING	GLASBAC				
	PATTERN	ASHLAR				
	FIRE CLASSIFICATION	CLASS 1				
CPT-321	MANUAL TRANSACTION AREA CARPET					
	MFR.	INTERFACE				
	PRODUCT	HARMONIZE				
	COLOR	GRAVEL 104043				
	SIZE	25CM X 1M TILE (9.84" x 39.37")				
	BACKING	CUSHIONBAC PLUS (ANTI-FATIGUE CUSHION				
	PATTERN	ASHLAR				
	FIRE CLASSIFICATION	CLASS 1				
	A	REA RUGS				
LRAR -4	FLOATING CARPET- NA	VY				
	MFR.	INTERFACE				
	PRODUCT	HAPTIC				
	COLOR	INDIGO				
	SIZE	PER PLAN				
	BACKING	GLASBAC				
	EDGING	MFR.: JOHNSONITE PRODUCT # EG-XX-H COLOR: 40 BLACK B				
	NOTES	EDGE BANDING/RUG KIT PROVIDED BY MANUFACTURER				
	FIRE CLASSIFICATION	CLASS 1				

	FIDE OF ACCIETO ATION	MANUFACTURER				
	FIRE CLASSIFICATION	CLASS 1				
T 400	TILE					
T-402	RESTROOM WALL & FLO					
	MFR.	STONE SOURCE				
	PRODUCT	CREOS				
	COLOR	DORIAN				
	FINISH	NATURAL FINISH				
	SIZE	12" x 24" x 3/8"				
	GROUT	CUSTOM BUILDING PRODUCTS PRISM ULTIMATE PERFORMANCE GROUT #165 "DELOREAN GRAY"				
	GROUT JOINT	1/8"				
	NOTES	MATCHING TILE WALL BASE AVAILABLE FOR RESTROOMS				
T-501	GENERAL FLOOR TILE					
	MFR.	STONE SOURCE				
	PRODUCT	CREOS				
	COLOR	DORIAN				
	FINISH	NATURAL FINISH				
	SIZE	30" X 30" x 3/8"				
	GROUT	CUSTOM BUILDING PRODUCTS PRISM ULTIMATE PERFORMANCE GROUT #165 "DELOREAN GRAY"				
	GROUT JOINT	1/8"				
	MISCELLA	NEOUS FLOORING				
SC	CONCRETE FLOOR PAIN	IT				
	MFR.	SHERWIN WILLIAMS				
	PRODUCT	TREAD-PLEX 100% ACRYLIC WATER BASED FLOOR COATING				
	COLOR	DECK GRAY				
	FINISH	SEMI-GLOSS, SLIP-RESISTANT				
	FIRE CLASSIFICATION	CLASS A				
VCT-1	VINYL COMPOSITION TIL	LE				
	DESCRIPTION	PLASTIC LAMINATE				
	MFR	ARMSTRONG FLOORING - EXCELON SDT				
	COLOR	ARMOR GRAY #51951				
	USES	DATA ROOM FLOOR (WHERE NOTED)				
	FIRE CLASSIFICATION	CLASS 1				

ACT-2	ACOUSTICAL CEILING (NON-CUSTOMER AREAS)				
	MFR.	USG				
	PRODUCT	MARS CLIMAPLUS HIGH-NRC (ITEM NO. 87100				
	COLOR	WHITE				
	SIZE	24"x24"x7/8"				
	EDGE	9/16" FINELINE BEVEL (FLB)				
	GRID	CENTRICITEE DXT 9/16" EXPOSED TEE SYSTEM				
		E USG Centricitee™ DXT™				
	GRID FINISH	FLAT WHITE				
	FIRE CLASSIFICATION	FICATION CLASS A				
ACT-4	ACOUSTICAL CEILING (CUSTOMER AREAS)				
	MFR.	USG				
	PRODUCT	MARS HIGH-NRC LOGIX CLIMAPLUS PERFORMANCE FIELD AND CHANNEL PANELS				
	COLOR	WHITE				
	SIZE	48" x 48" x 1" FIELD PANELS (#80281) AND 4"x48"x1" CHANNEL PANELS (#80268)				
	EDGE	9/16" FINELINE BEVEL (FLB)				
	GRID	IDENTITEE DXI 9/16" TEE SYSTEM WITH 9/16" STANDARD PERIMETER MOLDING				
		PROFILE EDGE DETAIL				
		19/16" 113/16" USG Donn' Brand Fineline' Bevel				
	GRID FINISH	FLAT WHITE				
	FIRE CLASSIFICATION	CLASS A				
NOTES	l	l				
1	INTUMESCENT FLAME R BY UNIVERSAL FIRE SHI	ETARDANT: FIREKOTE 100 AS MANUFACTURED				

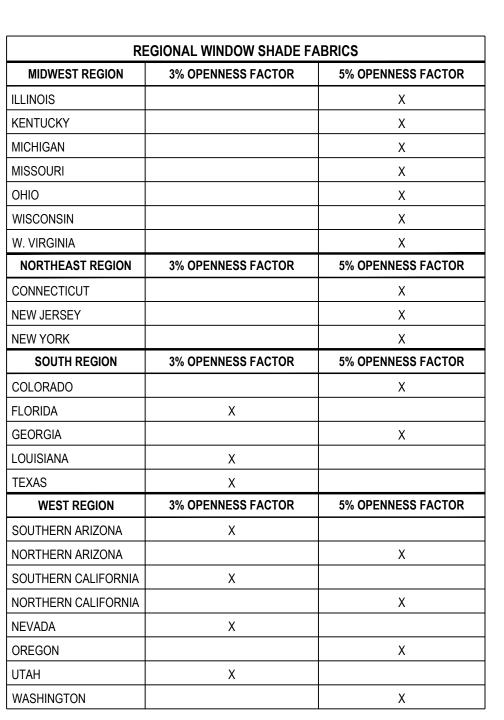



COA #: A-2014026908 ARCHITECT OF RECORD

ROBERT BRUCE

ARCHITECT: R. BRUCE LASURS LICENSE NUMBER: 007504 THESE DRAWINGS ARE NOT COMPLETE WITHOUT THE SEPARATE TYPE WRITTEN SPECIFICATIONS MANUAL WHICH ARE PART OF THE CONTRACT DOCUMENTS.

ISSUE DATE DESCRIPTION - 2020.12.21 PERMIT SET

PROJECT INFORMATION PROJECT NO: JPM.27135.001 200200.XX.XX PROTOTYPE: X.X.LASTNAME DRAWN BY: CHECKED BY: B.LaSURS VERSION: SE_1.00 SHEET TITLE

INTERIOR FINISH MATERIAL REGIONAL WINDOW SHADE **FABRICS**

SHEET NUMBER

A3.3.2

			FURNITURE SCHEDULE												
								FU	JRNIS 	IN!	INSTALLE				
GROUP	OGL TAG	DESCRIPTION	VENDOR	VENDOR#	MANUFACTURER	MODEL	FINISH	OWNER	29	EQUIP. VENDOR	FURN. VENDOR	OWNER	OS C	EQUIP. VENDOR	
	2AF	30" 2-DRAWER LATERAL FILE	EMPIRE	2A1	STEELCASE	900 SERIES	MF-1				•			\dashv	
	2AP	15" PEDESTAL BBF	EMPIRE	2A1	STEELCASE	900 SERIES	MF-1				-				
	2AW	30" 2-DRAWER LATERAL FILE W/ WOOD TOP	EMPIRE	2A1W	STEELCASE	901 SERIES	OAK COMPOSITE				•				
	2BF	36" 2-DRAWER LATERAL FILE	EMPIRE	2B1	STEELCASE	900 SERIES	MF-1				=	\sqcup			
	2BP	15" PEDESTAL BBF	EMPIRE	2B1	STEELCASE	900 SERIES	MF-1				-	\vdash	_		
	2BW	36" 2-DRAWER LATERAL FILE W/ WOOD TOP	EMPIRE	2B1W	STEELCASE	901 SERIES	OAK COMPOSITE		_	\dashv	-	\vdash	\dashv		
E!! E0	2CF	42" 2-DRAWER LATERAL FILE	EMPIRE	2C1	STEELCASE	900 SERIES	MF-1				-	\vdash	_		
FILES	2CP 2CW	15" PEDESTAL BBF 42" 2-DRAWER LATERAL FILE W/ WOOD TOP	EMPIRE EMPIRE	2C1 2C1W	STEELCASE STEELCASE	900 SERIES 901 SERIES	MF-1 OAK COMPOSITE				_	\vdash	_		
	3A	30" 3-DRAWER LATERAL FILE W/ WOOD TOP	EMPIRE	3A1	STEELCASE	901 SERIES 900 SERIES	MF-1			-	_	\vdash	+		
	3B	36" 3-DRAWER LATERAL FILE	EMPIRE	3B1	STEELCASE	900 SERIES	MF-1				-	\vdash	_		
	3C	42" 3-DRAWER LATERAL FILE	EMPIRE	361 3C1	STEELCASE	900 SERIES	MF-1			-	-		+		
	5A	30" 5-DRAWER LATERAL FILE	EMPIRE	5A1	STEELCASE	900 SERIES	MF-1		_	$\overline{}$	-		+		
	5B	36" 5-DRAWER LATERAL FILE	EMPIRE	5B1	STEELCASE	900 SERIES	MF-1				_		_		
	5C	42" 5-DRAWER LATERAL FILE	EMPIRE	5C1	STEELCASE	900 SERIES	MF-1				_	\vdash	+		
	LC	5-TIER LOCKERS (15"D x 15"W x 72"H)	EMPIRE	FLC-11	PENCO		028 GRAY				•		+		
	BT4-A	LOUNGE TABLE, 36" DIA.	EMPIRE	FT-14	STEELCASE	853600	CLEAR MAPLE				•		+		
LOUNGE	BT4-B	LOUNGE TABLE, 48" DIA.	EMPIRE	FT-14 48	STEELCASE	853600	CLEAR MAPLE				•		\top		
	BT4-C	LOUNGE TABLE, 60x35	EMPIRE	FT-14 60X35	STEELCASE	853600	CLEAR MAPLE				•				
	BS	LOUNGE CHAIR	EMPIRE	FS-14	TURNSTONE	TS37101	BLACK				-				
		TALL KITCHEN TRASH RECEPTACLE	CHASE BP GROUP					•				•			
		WIRE SHELVING - HANG TRACK			CLOSETMAID	282400, 282600, 283600	WHITE		•				-		
JANITOR'S CLOSET / GENERAL STORAGE		WIRE SHELVING - STANDARD			CLOSETMAID	280000, 280100, 280800, 281200, 280400	WHITE		•				•		
	WS-1	WIRE SHELVING - 12" SHELF ("SUPERSLIDE")			CLOSETMAID	471400, 471700, 471800, 471900	WHITE		•				•		
		WIRE SHELVING - 12" BRACKET			CLOSETMAID	5285300	WHITE		•			\vdash	•		
		WIRE SHELVING - 16" SHELF ("CLOSE MESH")			CLOSETMAID	139500, 3731800	WHITE		•			\vdash	•		
	07.004	WIRE SHELVING - 16" BRACKET			CLOSETMAID	5285400	WHITE		•	-		 	-		
	OT-20A	KIMBERLY TABLE- 36"DIA X 21"H	EMPIRE		STEELCASE	CUSTOM	PLANKED OAK				-	\vdash	_		
	OT-20B	KIMBERLY TABLE- 30"DIA X 18"H	EMPIRE		STEELCASE	CUSTOM	PLANKED OAK		$\overline{}$	$\overline{}$	-	\vdash	+	-	
	OT-20C OT-20D	KIMBERLY TABLE- 25"DIA X 15"H KIMBERLY TABLE- 20"DIA X 18"H	EMPIRE EMPIRE		STEELCASE	CUSTOM	PLANKED OAK PLANKED OAK		\longrightarrow	$\overline{}$	•	\vdash	+		
	OT-20D	GINGKO WIRE CAFÉ TABLE- 30" DIA	EMPIRE		STEELCASE DAVIS	CUSTOM	PLANKED OAK TOP, BLACK BASE		_		-	+	+		
	CH-322	ALWAYS LOUNGE CHAIR	EMPIRE		NAUGHTONE	ALWAYS	GEIGER: IOTA- NAVY, BLACK BASE		_	$\overline{}$		$\overline{}$	+		
							DESIGNTEX: WOOLISH- OSPREY, BLACK		_	$\overline{}$	•	$\overline{}$	+		
VINO DOOM LODDY	CH-323 CH-324	STYLEX SHARE SOFA- CURVED STYLEX SHARE SOFA- CURVED 1/2 UPHOLSTERED, 1/2 VINYL	EMPIRE EMPIRE		STYLEX	SHARE	MATTE LEGS BLACK METAL SLED FRAME, BACK OF SOFA UPHOLSTERY: DESIGNTEX: BARKCLOTH-CHARCOAL, SEAT OF SOFA UPHOLSTERY: DESIGNTEX:				•				
VING ROOM/ LOBBY	CH-325	DRT CHAIR - ALWAYS CHAIR	EMPIRE		NAUGHTONE	ALWAYS	SORANO-KEYSTONE DESIGNTEX: EVERYWHERE TEXTURE- STORM				•		+		
	PF	WHIMSY POUF	EMPIRE		NATIONAL	WHIMSY	BLACK STRAP HANDLE, UPHOLSTERY: DESIGNTEX: SPANDAU-COGNAC				•				
	FS-3	STOOL-CAFÉ HEIGHT	EMPIRE		GORDON	FORMULA	BLACK MATTE FRAME, UPHOLSTERY: DESIGNTEX: HYDE STONE				•				
	TP DRT	TELEPRESENCE SIDE TABLE- LIVING ROOM DINING ROOM TABLE (4 OR 6 PERSON)	GTI CBBE	34X72	SALAMANDER CBBE	CUSTOM	NATURAL OAK-NOT TEXTURED STAIN TO MATCH: OAK			•	•		+	-	
		,		34X96						$\overline{}$		\vdash			
	CR-2 3619	COFFEE CREDENZA, 36x19	EMPIRE	36X19	STEELCASE	TBD	OAK, SILVER BIRCH CORIAN			-	•	\vdash			
	CR-2 4819	COFFEE CREDENZA, 48x19	EMPIRE	48X19	STEELCASE	TBD	OAK, SILVER BIRCH CORIAN			-	-		+		
	CR-2 6019 CT	COFFEE CREDENZA, 60x19	EMPIRE EMPIRE	60X19 30D, 36D	STEELCASE COALESSE	TBD MONTARA	OAK, SILVER BIRCH CORIAN WHITE TOP, BLACK BASE		-		_	$\overline{}$			
	WT	CAFÉ TABLE- HIGH TOP WORK TABLE- DESK HEIGHT	EMPIRE EMPIRE	30D, 36D 36D	COALESSE	MONTARA	WHITE TOP, BLACK BASE WHITE TOP, BLACK BASE		_	\rightarrow	-	$\overline{}$	+		
	BT-2	BOOTH TABLE WITH POWER MODULE	EMPIRE	57X30, 57X36, 57X42, 57X48	COALESSE	LAGUNITAS	WHITE TOP, BLACK BASE		\rightarrow	$\overline{}$	•		+		
MISC.	BB-1	BOOTH BENCH (QTY- 2 BENCHES)	CBBE		CBBE	CUSTOM	BACK OF BOOTH UPHOLSTERY: DESIGNTEX- WOOLISH: OSPREY, BOOTH SEAT UPHOLSTERY: DESIGNTEX: SORANO- KEYSTONE, BLACK FEET BACK OF BOOTH UPHOLSTERY:				•				
	BB-2	DROP IN BOOTH	EMPIRE	1873U EU/3U	NATIONAL	FRINGE	DESIGNTEX- WOOLISH: OSPREY, BOOTH SEAT UPHOLSTERY: DESIGNTEX: SORANO- KEYSTONE, BLACK FEET ARCTIC WHITE SURFACE, BLACK				•				
	TD	TRAINING CHAIR	EMPIRE	48X30, 60X30, 72X30	COALESSE	AKIRA	BASE/CASTERS BLACK SHELL/SEAT, BLACK		-		-		+		
	TC	TRAINING CHAIR	EMPIRE		COALESSE	KART	BASE/CASTERS, NESTING				•		\perp		
	MST-3	MANUAL TRANSACTION MODULE - MST	EMPIRE	TC 1M	STEELCASE	CUSTOM	QUARTER CUT OAK COMPOSITE				•				
MANUAL	AST-3	MANUAL TRANSACTION MODULE - LEFT AST	EMPIRE	TC 1AL	STEELCASE	CUSTOM	QUARTER CUT OAK COMPOSITE				•				
TRANSACTIONS	AST-3	MANUAL TRANSACTION MODULE - RIGHT AST	FMPIRE	TC 1A	STEELCASE	CUSTOM	QUARTER CUT OAK COMPOSITE	1				ı I	[

CBBE


ACR1

ACR1

ACRYLIC RISER (1 PER AST)

ACR1

D-401D	CONF. TABLE WITH X BASE (72X36)	EMPIRE	72X36	STEELCASE/GORDON		QUARTER CUT OAK COMPOSITE, BLACK 'X' BASE		•		
D-401E	CONF. TABLE WITH X BASE(84X36)	EMPIRE	84X36	STEELCASE/GORDON		QUARTER CUT OAK COMPOSITE, BLACK 'X' BASE		•	•	
D-401F	CONF. TABLE WITH X BASE (96X48)	EMPIRE	96X48	STEELCASE/GORDON		QUARTER CUT OAK COMPOSITE, BLACK 'X' BASE		•	•	
CC5	CONF CREDENZA W/ WOOD TOP	EMPIRE	CCREDDW	STEELCASE		QUARTER CUT OAK COMPOSITE		•	•	
CC6	CONF CREDENZA W/ CORIAN TOP	EMPIRE	CCREDPWC/CCREDDW	C STEELCASE		QUARTER CUT OAK COMPOSITE, SILVER BIRCH CORIAN		•	-	
D-400A / DB-400	BANKER DESK, WOOD TOP, X BASE, (36R)	EMPIRE	36DIA	STEELCASE		QUARTER CUT OAK COMPOSITE, BLACK HARDWARE		•	•	
D-401A / DB-400	BANKER DESK, WOOD TOP, X BASE, (42R)	EMPIRE	42DIA	STEELCASE		QUARTER CUT OAK COMPOSITE, BLACK HARDWARE		•	•	
D-401B / DB-400	BANKER DESK, OVAL, WOOD TOP, X BASE, (54X36)	EMPIRE	54X36	STEELCASE		QUARTER CUT OAK COMPOSITE, BLACK HARDWARE		•	•	
D-401 C/ DB-400	BANKER DESK, OVAL, WOOD TOP, X BASE, (60x36)	EMPIRE	60X36	STEELCASE		QUARTER CUT OAK COMPOSITE, BLACK HARDWARE		•	•	
HAD-2	OLOGY HEIGHT ADJUSTABLE DESK	EMPIRE		STEELCASE	OLOGY	QUARTER CUT OAK COMPOSITE TOP, BLACK ADJUSTABLE BASE		•	•	
WPD-6A	BANKER DESK PEDESTAL FILE- 18"	EMPIRE		STEELCASE	CUSTOM	QUARTER CUT OAK COMPOSITE, BLACK HARDWARE		•	•	
WPD-6B	BANKER DESK PEDESTAL FILE- 30"	EMPIRE		STEELCASE	CUSTOM	QUARTER CUT OAK COMPOSITE, BLACK HARDWARE			•	
WPD-7A	LATERAL FILE WITH CPU CABINET- MEDIUM OFFICE- 54"	EMPIRE		STEELCASE	CUSTOM	QUARTER CUT OAK COMPOSITE, BLACK HARDWARE		•	-	
WPD-7B	LATERAL FILE WITH CPU CABINET- MEDIUM OFFICE- 48"	EMPIRE		STEELCASE	CUSTOM	QUARTER CUT OAK COMPOSITE, BLACK HARDWARE			-	
WPD-8	IWS TALL PEDESTAL FILE	EMPIRE		STEELCASE	CUSTOM	QUARTER CUT OAK COMPOSITE, BLACK HARDWARE		•	-	
DS	BANKER DESK AND LAO CHAIR	EMPIRE	FS-11T	STEELCASE	THINK	BLACK, NON-NESTING, ADJUSTABLE ARMS		•	•	1
CH-311	BINDU CONFERENCE CHAIR- LOW BACK ON CASTERS	EMPIRE		COALESSE	BINDU	DESIGNTEX: BARK CLOTH-DARK CHARCOAL, BLACK BASE ON CASTERS		•		1
CS-3	SDB CARREL / VIEWING ROOM	EMPIRE	TRADCARREL-C	STEELCASE	CARREL	QUARTER CUT OAK COMPOSITE		-	-	_
CH-320	SDB ARMLESS CHAIR	EMPIRE		STEELCASE	FORMULA	DESIGNTEX: BARKCLOTH-DARK CHARCOAL, BLACK SLED BASE		•	•	
	D-401E D-401F CC5 CC6 D-400A / DB-400 D-401A / DB-400 D-401B / DB-400 D-401 C/ DB-400 HAD-2 WPD-6A WPD-6B WPD-7A WPD-7B WPD-8 DS CH-311 CS-3	D-401E CONF. TABLE WITH X BASE (84X36) D-401F CONF. TABLE WITH X BASE (96X48) CC5 CONF CREDENZA W/ WOOD TOP CC6 CONF CREDENZA W/ CORIAN TOP D-400A / DB-400 BANKER DESK, WOOD TOP, X BASE, (36R) D-401A / DB-400 BANKER DESK, WOOD TOP, X BASE, (42R) D-401B / DB-400 BANKER DESK, OVAL, WOOD TOP, X BASE, (54X36) D-401 C / DB-400 BANKER DESK, OVAL, WOOD TOP, X BASE, (60x36) HAD-2 OLOGY HEIGHT ADJUSTABLE DESK WPD-6A BANKER DESK PEDESTAL FILE- 18" WPD-6B BANKER DESK PEDESTAL FILE- 30" WPD-7A LATERAL FILE WITH CPU CABINET- MEDIUM OFFICE- 54" WPD-7B LATERAL FILE WITH CPU CABINET- MEDIUM OFFICE- 48" WPD-8 IWS TALL PEDESTAL FILE DS BANKER DESK AND LAO CHAIR CH-311 BINDU CONFERENCE CHAIR- LOW BACK ON CASTERS CS-3 SDB CARREL / VIEWING ROOM	D-401E CONF. TABLE WITH X BASE (84X36) EMPIRE D-401F CONF. TABLE WITH X BASE (96X48) EMPIRE CC5 CONF CREDENZA W/ WOOD TOP EMPIRE CC6 CONF CREDENZA W/ CORIAN TOP EMPIRE D-400A / BANKER DESK, WOOD TOP, X BASE, (36R) EMPIRE D-401A / DB-400 BANKER DESK, WOOD TOP, X BASE, (42R) EMPIRE D-401B / DB-400 BANKER DESK, OVAL, WOOD TOP, X BASE, (54X36) EMPIRE D-401C / DB-400 BANKER DESK, OVAL, WOOD TOP, X BASE, (60x36) EMPIRE WPD-6A BANKER DESK, OVAL, WOOD TOP, X BASE, (60x36) EMPIRE WPD-6B BANKER DESK PEDESTAL FILE- 18" EMPIRE WPD-7A LATERAL FILE WITH CPU CABINET- MEDIUM OFFICE-54" WPD-7B LATERAL FILE WITH CPU CABINET- MEDIUM OFFICE-48" WPD-8 IWS TALL PEDESTAL FILE DS BANKER DESK AND LAO CHAIR EMPIRE CH-311 BINDU CONFERENCE CHAIR- LOW BACK ON CASTERS CH-311 BINDU CONFERENCE CHAIR- LOW BACK ON EMPIRE	D-401E CONF. TABLE WITH X BASE (84X36) EMPIRE 84X36 D-401F CONF. TABLE WITH X BASE (96X48) EMPIRE 96X48 CC5 CONF CREDENZA W/ WOOD TOP EMPIRE CCREDDW CC6 CONF CREDENZA W/ CORIAN TOP EMPIRE CCREDPWC/CCREDDW D-400A / DB-400 BANKER DESK, WOOD TOP, X BASE, (36R) EMPIRE 36DIA D-401A / DB-400 BANKER DESK, WOOD TOP, X BASE, (42R) EMPIRE 42DIA D-401B / DB-400 BANKER DESK, OVAL, WOOD TOP, X BASE, (54X36) EMPIRE 54X36 D-401 C/ DB-400 BANKER DESK, OVAL, WOOD TOP, X BASE, (60x36) EMPIRE 60X36 HAD-2 OLOGY HEIGHT ADJUSTABLE DESK EMPIRE WPD-6A BANKER DESK PEDESTAL FILE- 18" EMPIRE WPD-6B BANKER DESK PEDESTAL FILE- 30" EMPIRE WPD-7B LATERAL FILE WITH CPU CABINET- MEDIUM OFFICE- 54" EMPIRE WPD-7B IATERAL FILE WITH CPU CABINET- MEDIUM OFFICE- 48" EMPIRE WPD-8 IWS TALL PEDESTAL FILE EMPIRE DS BANKER DESK AND LAO CHAIR EMPIRE CH-311	D-401E CONF. TABLE WITH X BASE (84X36) EMPIRE 84X36 STEELCASE/GORDON D-401F CONF. TABLE WITH X BASE (96X48) EMPIRE 96X48 STEELCASE/GORDON CC5 CONF CREDENZA W/ WOOD TOP EMPIRE CCREDDW STEELCASE CC6 CONF CREDENZA W/ CORIAN TOP EMPIRE CCREDDWC/CCREDDWC STEELCASE D-400A/DB-400/D	D-401E CONF. TABLE WITH X BASE (98X48) EMPIRE 84X36 STEELCASE/GORDON D-401F CONF. TABLE WITH X BASE (98X48) EMPIRE 96X48 STEELCASE/GORDON CC5 CONF CREDENZA W/ WOOD TOP EMPIRE CCREDDW STEELCASE CC6 CONF CREDENZA W/ CORIAN TOP EMPIRE CCREDDWC/CCREDDWC STEELCASE D-400A / DB-400 BANKER DESK, WOOD TOP, X BASE, (36R) EMPIRE 36DIA STEELCASE D-401A / DB-400 BANKER DESK, WOOD TOP, X BASE, (42R) EMPIRE 42DIA STEELCASE D-401B / DB-400 BANKER DESK, OVAL, WOOD TOP, X BASE, (64X36) EMPIRE 54X36 STEELCASE D-401C / DB-400 BANKER DESK, OVAL, WOOD TOP, X BASE, (60X36) EMPIRE 60X36 STEELCASE HAD-2 OLOGY HEIGHT ADJUSTABLE DESK EMPIRE STEELCASE CUSTOM WPD-6A BANKER DESK PEDESTAL FILE- 30" EMPIRE STEELCASE CUSTOM WPD-7B LATERAL FILE WITH CPU CABINET- MEDIUM OFFICE- 54" EMPIRE <td< td=""><td>D-401D COWN RABLE WITH X BASE (IZAS) EMPIRE 7XAB STEELCASE(SORDON YE BASE X SAB STEELCASE(SORDON QUARTER CUT OAX COMPOSITE, BLACK X SASE COMPOSITE, BLACK SA</td><td>D-401E CONF. TABLE WITH X BASE (90X48) EMPIRE 84X36 STEELCASE/GORDON QUARTER CUT DAX COMPOSITE, BLACK X BASE X BASE (90X48) EMPIRE 84X36 STEELCASE/GORDON QUARTER CUT DAX COMPOSITE, BLACK X BASE CONTROL OF TABLE WITH X BASE (90X48) EMPIRE 96X48 STEELCASE/GORDON QUARTER CUT DAX COMPOSITE, BLACK X BASE CONTROL OF TABLE WITH X BASE (90X48) EMPIRE COREDOW STEELCASE QUARTER CUT DAX COMPOSITE BLACK X BASE COREDOW STEELCASE QUARTER CUT DAX COMPOSITE COMPOSITE SULVER BIRCH CORIAN DE COREDOW STEELCASE QUARTER CUT DAX COMPOSITE, BLACK COMPOSITE SULVER BIRCH CORIAN DE COREDOW STEELCASE QUARTER CUT DAX COMPOSITE, BLACK HARDWARE SULVER BIRCH CORIAN STEELCASE QUARTER CUT DAX COMPOSITE, BLACK HARDWARE COREDOW STEELCASE QUARTER CUT DAX COMPOSITE, BLACK HARDWARE COREDOW STEELCASE QUARTER CUT DAX COMPOSITE, BLACK HARDWARE STEELCASE QUARTER CUT DAX COMPOSITE, BLACK HARDWARE COREDOW STEELCASE QUARTER CUT DAX COMPOSITE, BLACK HARDWARE COREDOW STEELCASE QUARTER CUT DAX COMPOSITE, BLACK HARDWARE STEELCASE QUARTER CUT DAX COMPOSITE, BLACK HARDWARE COREDOW STEELCASE QUARTER CUT DAX COMPOSITE, BLACK HARDWARE COREDOW STEELCASE QUARTER CUT DAX COMPOSITE, BLACK HARDWARE COREDOW STEELCASE QUARTER CUT DAX COMPOSITE, BLACK HARDWARE STEELCASE QUARTER CUT DAX COMPOSITE, BLACK HARDWARE STEELCASE QUARTER CUT DAX COMPOSITE COREDOW STEELCASE QUARTER CUT DAX COMPOSITE, BLACK HARDWARE STEELCASE QUARTER CUT DAX COMPOSITE, BLACK AND STEELCASE STEELCASE STEELCASE STEELCASE STEELCAS</td><td> D-4010 D-4010 CONF. MARCE WITH X BASE (MXX8) EMPIRE 36X36 STEELCASE/GORDON QUARTER CUT OAK COMPOSITE, BLACK X BASE X BASE </td><td> D-4010 CONF. TRBLE WITH X BASE (BAX56)</td></td<>	D-401D COWN RABLE WITH X BASE (IZAS) EMPIRE 7XAB STEELCASE(SORDON YE BASE X SAB STEELCASE(SORDON QUARTER CUT OAX COMPOSITE, BLACK X SASE COMPOSITE, BLACK SA	D-401E CONF. TABLE WITH X BASE (90X48) EMPIRE 84X36 STEELCASE/GORDON QUARTER CUT DAX COMPOSITE, BLACK X BASE X BASE (90X48) EMPIRE 84X36 STEELCASE/GORDON QUARTER CUT DAX COMPOSITE, BLACK X BASE CONTROL OF TABLE WITH X BASE (90X48) EMPIRE 96X48 STEELCASE/GORDON QUARTER CUT DAX COMPOSITE, BLACK X BASE CONTROL OF TABLE WITH X BASE (90X48) EMPIRE COREDOW STEELCASE QUARTER CUT DAX COMPOSITE BLACK X BASE COREDOW STEELCASE QUARTER CUT DAX COMPOSITE COMPOSITE SULVER BIRCH CORIAN DE COREDOW STEELCASE QUARTER CUT DAX COMPOSITE, BLACK COMPOSITE SULVER BIRCH CORIAN DE COREDOW STEELCASE QUARTER CUT DAX COMPOSITE, BLACK HARDWARE SULVER BIRCH CORIAN STEELCASE QUARTER CUT DAX COMPOSITE, BLACK HARDWARE COREDOW STEELCASE QUARTER CUT DAX COMPOSITE, BLACK HARDWARE COREDOW STEELCASE QUARTER CUT DAX COMPOSITE, BLACK HARDWARE STEELCASE QUARTER CUT DAX COMPOSITE, BLACK HARDWARE COREDOW STEELCASE QUARTER CUT DAX COMPOSITE, BLACK HARDWARE COREDOW STEELCASE QUARTER CUT DAX COMPOSITE, BLACK HARDWARE STEELCASE QUARTER CUT DAX COMPOSITE, BLACK HARDWARE COREDOW STEELCASE QUARTER CUT DAX COMPOSITE, BLACK HARDWARE COREDOW STEELCASE QUARTER CUT DAX COMPOSITE, BLACK HARDWARE COREDOW STEELCASE QUARTER CUT DAX COMPOSITE, BLACK HARDWARE STEELCASE QUARTER CUT DAX COMPOSITE, BLACK HARDWARE STEELCASE QUARTER CUT DAX COMPOSITE COREDOW STEELCASE QUARTER CUT DAX COMPOSITE, BLACK HARDWARE STEELCASE QUARTER CUT DAX COMPOSITE, BLACK AND STEELCASE STEELCASE STEELCASE STEELCASE STEELCAS	D-4010 D-4010 CONF. MARCE WITH X BASE (MXX8) EMPIRE 36X36 STEELCASE/GORDON QUARTER CUT OAK COMPOSITE, BLACK X BASE X BASE	D-4010 CONF. TRBLE WITH X BASE (BAX56)

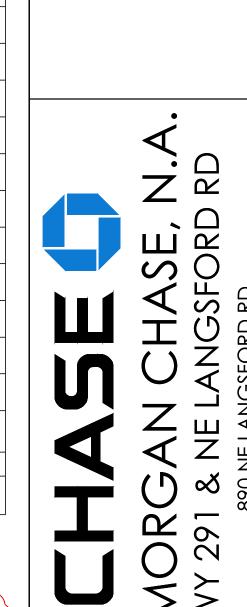




0 Chippewa Street Suite 200 .ouis, MO 63109 .843.4320 w.core-states.com

COA #: A-201402690

ARCHITECT OF RECORD

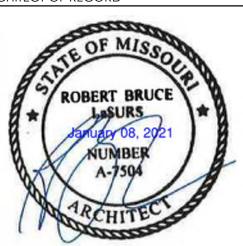

ARCHITECT: R. BRUCE LASURS LICENSE NUMBER: 007504

THESE DRAWINGS ARE NOT COMPLETE WITHOUT THE SEPARATE TYPE WRITTEN SPECIFICATIONS MANUAL WHICH ARE PART OF THE CONTRACT DOCUMENTS.

ISSUE DATE DESCRIPTION

- 2020.12.21 PERMIT SET

1 2021.04.20 STRUCTURAL STEEL REV

PROJECT INFORMATION

PROJECT NO: JPM.27135.001

DATE: 2020.12.21

PROTOTYPE: 20.2

DRAWN BY: J.SANCHEZ

CHECKED BY: B.LaSURS

VERSION: SE_1.00

SHEET TITLE

FURNITURE SCHEDULE

SHEET NUMBER

A3.4.1

FURNISHED BY INSTALLED BY **ELECTRICAL** BANK EQUIP. PRODUCT (NOTE 3) WEIGHT (NOTE 1) TAG MANUFACTURER FINISH DESCRIPTION ATM SIGNAGE SIGNAGE REQUIREMENTS OWNER EQUIP. GC OWNER GC VENDOR RIGGER VENDOR VENDOR VENDOR VENDOR VENDOR VENDOR 1929 LB DEDICATED ATM, WALK-UP, EXTERIOR, BE-01A THROUGH-WALL 120V / 20A HYOSUNG MX 7800 TR DEDICATED ATM SURROUND SUR-TTW-U-4 120V / 3A SIGNAGE VENDOR ---NA DEDICATED ATM, WALK-UP, INTERIOR, BE-01B THROUGH-WALL 120V / 20A HYOSUNG MX 7800 TR DEDICATED ATM SURROUND SIGNAGE VENDOR SUR-TTW-U-4 120V / 3A 120V / 30A 2043 2194 LB DEDICATED BE-02A ATM, DRIVE-UP, ISLAND 120V / 30A HYOSUNG MX 7800 IR DEDICATED 120V / 10A NCR 6684 1984 LB DEDICATED ATM, DRIVE-UP, THROUGH-WALL BE-02B HYOSUNG MX 7800 DR 1852 LB DEDICATED ATM SURROUND SIGNAGE VENDOR SUR-TTW-U-4-TP 120V / 3A AC-225-SX + AC-1-H + DIEBOLD BLACK NONE NA M-7-UD BE-03 APRON CASE HAMILTON BLACK DIEBOLD SD-3-C-SL BLACK NONE NA ACCESSIBLE TELLER BE-04A PEDESTAL HAMILTON BLACK NONE S-604 NA DIEBOLD SD-3-LL/RL BLACK NA NONE ACCESSIBLE TELLER PEDESTAL WITH LOCKER HAMILTON BLACK NONE 604 NONE DIEBOLD BLACK SU-4-2C NA BE-05 STANDARD TELLER PEDESTA HAMILTON S-205 BLACK NONE BLACK SU-4-L2L/R2L NONE STANDARD TELLER PEDESTAL BE-06 WITH LOCKERS HAMILTON S-207 BLACK NONE BE-07 TELLER BRG INTERCOM PRINCIPLE USA STS S.S. / ALUM. 120V / 1.6A BE-08 COMBO ATM / AHD NCR 5285 2853 LB 120V / 10A ---BE-09 NOT USED DIEBOLD 30901 TL-15 S.S. / BLACK 120V / 4A 1495 LB BE-10 AFTER HOURS DEPOSITORY HAMILTON S.S. / TAUPE 14-126 L/R 1886 LB 120V / 4A 120V / 20 A DIELBOLD VAT 30 GX 89G- 13 ---DEDICATED BE-11 VACUUM AIR TUBE 120V / 20 A DIEBOLD 42 - 15163 ---DEDICATED 120V / 12 A HYOSUNG MS500 970 LB DEDICATED CASH RECYCLER 120 V / 6A GLORY RBG-100 DEDICATED TELEQUIP T-FLEX (DUAL CUPS) HYOSUNG HYOSUNG 12 LB 120V / 4A ---COIN DISPENSER GLORY GLORY GLORY INSTACHANGE 10 LB 120V 1A 271-95 + 20530 + 20531 + DIEBOLD BLACK NONE 2922 LB (2) 20532 + (12) P-1500-CTK MAIN CASH CHEST BE-13 (FULL-HEIGHT) 14-123 L/R + (12) (HSCT310 + HAMILTON NONE BLACK 3545 LB HSCT211 + HSCT303) 271-80 + 20531 + 20532 + BLACK NONE (6) P-1500-CTK MAIN CASH CHEST BE-13A (HALF-HEIGHT) 14-127 L/R + (6) (HSCT310 + HAMILTON BLACK 2444 LB NONE HSCT211 + HSCT303) 271-80 + 20531 + 20536 + MAIN CASH CHEST DIEBOLD BLACK 1580 LB NONE 40537 + 40534 BE-13B (HALF-HEIGHT -**EVERYDAY EXPRESS)** 18-029 L/R BLACK 2078 LB NONE BLACK NONE 478-98 4739 LB MAX. BE-14 SAFE DEPOSIT CHEST WITH BLACK NONE 14-124 L/R 4, 6, 7, 12 HAMILTON BLACK 14-125 L/R NONE (MIXED) BE-15 ATM, WALK-UP, LOBBY (V2.5.5) MX 8700 QT HYOSUNG 2094 LB DEDICATED 120V / 12A ATM, WALK-UP, LOBBY (V3.0) MX 8200 QT 1432 LB HYOSUNG DEDICATED WALL POWER TRANSITION BLACK CUSTOM NONE WALK UP FREESTANDING 120V / 12A MX 8100 QTN 1050 LB (fully loaded) HYOSUNG MICRO ATM DEDICATED WALL POWER TRANSITION CUSTOM BLACK NONE BE-16 MICRO ATM KIOSK HYOSUNG CUSTOM VARIES CLASS 2 MODULAR 6-SIDE PANELS 123 LB/SF DIEBOLD NONE BE-17 MODULAR VAULT NONE HAMILTON TBD NA TBD S.S., ALUM. + TITAN + 223-80 DAY GATE 5250 LB DIEBOLD 120V / 20A GLASS BE-18 VAULT DOOR WITH DAY GATE S.S., ALUM. + HAMILTON TBD TBD GLASS 1092 LB MAX. DIEBOLD LM SERIES S.S. PER STACK BE-19 VAULT SDB NESTS HAMILTON TBD TBD TBD TBD MX 8200 QT BE-20 ATM V3.0 SIDE CAR HYOSUNG ACCESSORY UNIT BE-21 NOT USED BE-22 TELLER LINE SCANNER LS150 NA 120V / 2A ELECTRONICS | BE-23 | TELLER LINE | PRINTER TELLER LINE RECEIPT BANKJET 1500 120V BE-24 NOT USED UNDERCOUNTER CASH DIEBOLD 271-30 BLACK 823 lbs CHEST ('DAY SAFE') HAMILTON 14-130 L/R BLACK 1157 LB 271-30 + (2) 20536 + BLACK NONE DIEBOLD 905 LB (4) P-1500-CTK UNDERCOUNTER CASH BE-25A CHEST ('SMALL CASH CHEST') 14-129 L/R + (3) (HSCT310 + HAMILTON BLACK 1278 LB NONE 4, 5, 9 HSCT211 + HSCT303) DXE TL-15 DIEBOLD BLACK 267 LB UNDERCOUNTER CASH 11H X 17W X 20D BE-25B | CHEST (EVERYDAY EXPRESS DEA TL-15 SMALLEST RANCHES ONLY) HAMILTON BLACK 387 LB NONE 11H X 17W X 20D BE-26 | CURRENCY COUNTER CUMMINS JETSCAN 120V / 1A INGENICO iPP320 BLACK BE-27 TELLER PIN PAD 9.41 oz POWERED VIA USB ALL EQUIPMENT WEIGHTS ARE LISTED AS EMPTY. B.O. SURROUND 7 1/4" AFF AT NCR UNIT, 12" AFF AT HYOSUNG UNIT. MODEL NUMBERS ARE PROVIDED TO REFERENCE PRODUCT CUT SHEETS FOR SPACE PLANNING PURPOSES ONLY. PRIOR TO ORDERING EQUIPMENT, VERIFY MAKE / MODEL W/ CHASE BRANCH PLANNING MANAGER. VENDOR TO INCLUDE INTERNAL CABLE DOOR STOP FOR FIELD-ADJUSTEMENT BY INSTALLER TO STOP DOOR AS INDICATED IN PLAN. INCLUDES CHEST MANUFACTURER'S LOCKERS. INTERNAL BOX CONFIGURATION TO BE DETERMINED BY CHASE BRANCH PLANNING. PROVIDE AMERICAN SECURITY PRODUCT CO. ESL20 DAY LOCK AT ALL SDB CHESTS IN ROOMS WITH VIEWING CARRELS. PROVIDE MANUFACTURER'S KEY TRAYS AND MATCHING METAL CEILING AND WALL CLOSURE PANELS AS INDICATED IN DRAWINGS. FOR USE BY EXCEPTION ONLY AT ROOMS WITH ACCESS TELLER AND NO MAIN CASH SAFE, INCLUDES INTERNAL TELLER CASH DRAWER LOCKERS. INCLUDES MANUFACTURER'S ENCLOSURE, FLOOR POWER TRANSITION BOX, AND SIGN PANEL POWERED BY ATM. 6-SIDED, CLASS II, 9'-0" CLEAR INTERIOR HEIGHT. PROVIDE DAY LOCK AT CHESTS LOCATED IN THE SAME ROOM AS A VIEWING CARREL. PROVIDE WALL POWER TRANSITION BOX AT WALL INSTALLATIONS ONLY. FOR FREESTANDING INSTALLATIONS PROVIDE MANUFACTURER'S POWER TRANSITION BOX. ATM VENDOR TO PROVIDE AND INSTALL SCREEN LOCKING BRACKETS TO MAINTAIN SCREEN POSITION WITH ALL OPERABLE PARTS WITHIN ACCESSIBLE REACH RANGE.

BANK EQUIPMENT SCHEDULE

GROUP CORESTATES, INC.

500 Chippewa Street Suite 200 St. Louis, MO 63109 314.843.4320

COA #: A-2014026908 ARCHITECT OF RECORD



AKCHIIECI: K. BKUCE LASUKS LICENSE NUMBER: 007504

THESE DRAWINGS ARE NOT COMPLETE WITHOUT THE SEPARATE TYPE WRITTEN SPECIFICATIONS MANUAL WHICH ARE PART OF THE CONTRACT DOCUMENTS.

ISSUE DATE DESCRIPTION - 2020.12.21 PERMIT SET

PROJECT INFORMATION PROJECT NO: JPM.27135.001 2020.12.21 PROTOTYPE: C.THEBEAU DRAWN BY: B.LaSURS

CHECKED BY: VERSION: SHEET TITLE

BANK EQUIPMENT SCHEDULE

SE_1.00

SHEET NUMBER

	OFFICE EQUIPMENT SCHEDULE												
			FURNISI							INSTAL	LED BY		
TAG	DESCRIPTION	MANUFACTURER	PRODUCT	FINISH	OWNER	GC	EQUIP VENDOR	FURN VENDOR	OWNER	GC	EQUIP VENDOR	FURN VENDOR	NOTES
DE-01-BW	MULTI-FUNCTIONAL DEVICE (MFD) - B/W	LEXMARK	MX710	PUTTY	•				•				
	SWIVEL BASE	LEXMARK	3052765	BLACK	•				-				
	5.1" SPACER	LEXMARK	30G0854	PUTTY					•				
	550 SHEET DRAWER	LEXMARK	30G0802	PUTTY					•				
OE-01-C	MULTI-FUNCTIONAL DEVICE (MFD) - COLOR	LEXMARK	656DTE	PUTTY	•				•				
	SWIVEL BASE	LEXMARK	3052765	BLACK	•				•				
	5.1" SPACER	LEXMARK	30G0854	PUTTY					•				
	550 SHEET DRAWER	LEXMARK	30G0802	PUTTY					•				
OE-02	NOT USED												
OE-03	MICR 9720 PRINTER	SOURCE TECHNOLOGIES	R0006912		•				-				
	MICR 9720 LOCKING DRAWER	SOURCE TECHNOLOGIES	R0007399		•				•				
	MICR 9720 UNDERCOUNTER STAND	BRETFORD	C15 \ A2188209	BLACK					•				
OE-04	ADA MONITOR & KEYBOARD STAND	HUMANSCALE	QSLBHD	BLACK				•					
OE-05	KEYBOARD TRAY	HUMANSCALE		BLACK				•				_	
OE-06	23" MONITOR AND STAND	TBD	TBD	WHITE				-	•			_	ALL MONITORS EXCEPT AST
	PRIVACY SCREEN FILTER	VARIES	VARIES		_				_				
	SOUND BAR	TBD	TBD	WHITE	_				_				
OE-07	TELLER CPU	HP	N8P49US#ABA	BLACK	_				_				
OE-08	WIRED KEYBOARD & MOUSE	LOGITECH	MK520	WHITE	_				_				
OE-00	NOT USED	LOGITECH	IVING20	VVIIIE					-				
OE-10	NOT USED	LUINAANOOALE	OODLIGOENIN	VA/LUTE									
OE-11	ACCESS TELLER MONITOR STAND	HUMANSCALE	QSBH30FNN	WHITE									POLE MOUNT TURQUEU OPOLIMET
OE-12	DESK MONITOR ARM	HUMANSCALE	MFLEX	GRAY				•					POLE-MOUNT THROUGH GROMMET
OE-13	NOT USED	TDD	TDD	\A/I IITE									ACTIVOLITOR
OE-14	23" MONITOR LESS STAND	TBD	TBD	WHITE	-				-				AST MONITOR
	PRIVACY SCREEN FILTER	VARIES	VARIES						•				
	SOUND BAR	TBD	TBD	WHITE					•				
OE-15	VDI TERMINAL	HP	T630	BLACK					•				
	VDI TERMINAL ADAPTER								•				
OE-16	WIRELESS KEYBOARD AND MOUSE	LOGITECH	K520, M310, Unifying Receiver	BLACK	•				•				
OE-17	NOT USED												
OE-18	CPU/VDI UNDER SURFACE MOUNT	HUMANSCALE	CPU200	WHITE BR ALUM.				•				•	UNDER SURFACE MOUNT WITH 360 DEGREE SWIVEL CAPABILITY
OE-19	NOT USED												
OE-20	NOT USED												
OE-21	NOT USED												
OE-22	NOT USED												
OE-23	NOT USED												
OE-24A	NOT USED												
OE-24B	NOT USED												
OE-24C	NOT USED												
OE-25	NOT USED												
OE-26	NOT USED												
OE-27	PLATFORM STATION WIRED 10-KEY KEYPAD	CONTROL INC	A0674838	BLACK	•								
OE-28	PHONE	CISCO	IP 7962	BLACK									
OE-28-V	PHONE - VIDEO PHONE	CISCO	CP-8865-K9	CHARCOAL									
OE-29	CUSTOMER UNIVERSAL CHARGING STATION	CHARGE TECH	CHW2	BLACK	_								

			MISCELLA	NEOUS	S EQU	IPME	NT SC	HEDU	ILE				
						FURNI	SHED BY			INSTA	LLED BY		
TAG	DESCRIPTION	MANUFACTURER	PRODUCT	FINISH	OWNER	GC	EQUIP VENDOR	FURN VENDOR	OWNER	GC	EQUIP VENDOR	FURN VENDOR	NOTES
ME-01	SHRED BIN				•				•				FURNISHED & INSTALLED BY CHASE FACILITIES GROUF
ME-02	DUAL BAND QUEUE ROPES AND STANCHIONS	LAWRENCE METALS	TENSABARRIER	BLACK									REFER TO FLOOR PLANS FOR QUANTITIES
	POST WITH BELT	LAWRENCE METALS	889 DUAL	BLACK									
	POST WITHOUT BELT	LAWRENCE METALS	889 T2U-33-RCV	BLACK									
ME-03	BRUSH EXTRUSION KIT	DOUG MOCKETT	BRKIT1	BLACK								•	FURNITURE OR MILLWORK VENDOR TO COORDINATE WITH OWNER FOR REQUIRED OPENING
ME-04	HALF ROUND WASTE RECEPTACLE	RUBBERMAID COMMERCIAL	FGSO8SSSPL	STAINLESS STEEL									(1) COUNT - IN MAIN LOBBY
ME-05	EXTERIOR WASTE RECEPTACLE	RUBBERMAID	FGS3ETBKPL	BLACK									
IVIE-US	ANCHOR KIT	HILTI	3.3.8 KWIK Bolt 3	N/A									
ME-06	MUSIC PLAYER AND SPEAKERS	MOOD MEDIA	PROFUSION IS	BLACK	•								
ME-08	DUAL-CONTROL KEY BOX	BLOCK AND COMPANY	STEELMASTER #201SP8801	GRAY	•								INCLUDES KABA LOCK. G.C. TO PROVIDE SOLID WOOD BLOCKING AS REQUIRED.
ME-09A	BULLETIN BOARD	QUARTET	QRT 303			•				-			AVAILABLE FROM OFFICE DEPOT/MAX. 'OR EQUAL' SUBSTITUTIONS PERMITTED BASED ON LOCAL AVAILABILITY- 36"W x 24"H NATURAL CORK WITH OAK FRAME.
ME-09B	DRY ERASE BOARD	QUARTET	EMA 203			•				•			AVAILABLE FROM OFFICE DEPOT/MAX. 'OR EQUAL' SUBSTITUTIONS PERMITTED BASED ON LOCAL AVAILABILITY- 36"W x 24"H ALUM. FRAME WITH PEN LEDGE AND WHTE MELAMINE SURFACE.
ME-09C	MAGNETIC STRIP BULLETIN BOARD	THREE BY THREE	31189 (8 REQUIRED)	NAVY BLUE									EIGHT 28" X 2.5" PAINTED METAL STRIPS WITH INCLUDED SCREWS AND MAGNETS ADHERED TO WAL WITH 3M SCOTCH OR EQUAL PERMANENT DOUBLE-SIDED FOAM MOUNTING TAPE.
ME-11	TABLET CHARGING CABINET	KENSINGTON	K67862AM	BLACK	•								PROVIDE AND INSTALLED BY CHASE GTI.
ME-12	RECESSED ATM KEY BOX	TELLEREX	RECESSED TRACCESS BOX	BLACK									

PROG	GRAMMATIC ELEMENT				
ABBREV.	DESCRIPTION	TAG	QTY.	DESCRIPTION	
			1	23" MONITOR AND STAND	
MST	MERCHANT SERVICES	OE-06	1	PRIVACY SCREEN FILTER	
БОТ	TELLER,		1	SOUND BAR	
PST	PERSONAL SERVICES TELLER, OR	OE-07	1	TELLER CPU	
AT	ACCESS TELLER	OE-08	1	WIRED KEYBOARD & MOUSE	
		OE-10	1	WIRE MANAGEMENT KIT	
		OE-04	1	ADA MONITOR & KEYBOARD STAND	
		OE-07	1	TELLER CPU	
		OE-08	1	WIRED KEYBOARD & MOUSE	
AST	ACCESSIBLE SERVICES TELLER	OE-10	1	WIRE MANAGEMENT KIT	
	TELLET		1	23" MONITOR - LESS STAND	
		OE-14	1	PRIVACY SCREEN FILTER	
			1	SOUND BAR	
		OE-05	1	KEYBOARD TRAY	
			1	23" MONITOR AND STAND	
	LEAD ASSOCIATE OPERATIONS	OE-06	1	PRIVACY SCREEN FILTER	
LAO				1	SOUND BAR
		OE-07	1	TELLER CPU	
		OE-08	1	WIRED KEYBOARD & MOUSE	
		OE-10	1	WIRE MANAGEMENT KIT	
DRT	DINING ROOM TABLE	OE-29	1	CUSTOMER UNIVERSAL CHARGING STATION	
			1	23" MONITOR AND STAND	
		OE-06	1	PRIVACY SCREEN FILTER	
			1	SOUND BAR	
		OE-15	1	VDI TERMINAL	
	воотн	OE-15	1	VDI TERMINAL ADAPTER	
		OE-16	1	WIRELESS KEYBOARD AND MOUSE	
		OE-18	1	CPU/VDI UNDER SURFACE MOUNT	
		OE-28	1	PHONE	
		OE-29	1	CUSTOMER UNIVERSAL CHARGING STATION	
			1	23" MONITOR	
		OE-06	1	PRIVACY SCREEN FILTER	
			1	SOUND BAR	
	0.0000	OE-12	1	MONITOR ARM	
ccs	CASUAL CONSULTATION SPACE	OE-15	1	VDI TERMINAL	
	2	UE-10	1	VDI TERMINAL ADAPTER	
		OE-16	1	WIRELESS KEYBOARD AND MOUSE	
		OE-27	1	PLATFORM STATION WIRED 10-KEY KEYPAD	

			1	23" MONITOR AND STAND		
		OE-06	1	PRIVACY SCREEN FILTER		
		02.00	1	SOUND BAR		
		OE-12	1	MONITOR ARM		
PCS	PRIVATE CONSULTATION		1	VDI TERMINAL		
	SPACE	OE-15	1	VDI TERMINAL ADAPTER		
		OE-16	1	WIRELESS KEYBOARD AND MOUSE		
		OE-27	1	PLATFORM STATION WIRED 10-KEY KEYPAD		
		OE-28	1	PHONE		
			1	23" MONITOR		
		OE-06	1	PRIVACY SCREEN FILTER		
			1	SOUND BAR		
	CONFERENCE ROOM	OE-12	1	MONITOR ARM		
	MARKET CONFERENCE SPACE	05.45	1	VDI TERMINAL 3		
		OE-15	1	VDI TERMINAL ADAPTER		
		OE-16	1	WIRELESS KEYBOARD AND MOUSE		
		OE-27	1	PLATFORM STATION WIRED 10-KEY KEYPAD		
		OE-28	1	PHONE		
			1	23" MONITOR AND STAND		
		OE-06	1	PRIVACY SCREEN FILTER		
			1	SOUND BAR		
IVA/C	INDIVIDUAL MODIZ CRACE	OE-15	1	VDI TERMINAL		
IWS	INDIVIDUAL WORK SPACE	OE-15	1	VDI TERMINAL ADAPTER		
		OE-16	1	WIRELESS KEYBOARD AND MOUSE		
		OE-27	1	PLATFORM STATION WIRED 10-KEY KEYPAD		
		OE-28	1	PHONE		
OTES						
1.	MONITOR ARM PROVIDED AND INSTALLED BY FURNITURE VENDOR. ALL OTHER SCHEDULED EQUIPMENT PROVIDED BY CHASE GLOBAL TECHNOLOGY INFRASTRUCTURE (GTI).					
2.	IF SPACE IS BEING DESIGNED TO ACCOMMODATE A VIDEO ADVISOR, MANAGING DIRECTOR OR REGIONAL DIRECTOR, ADD A/V SOLUTION 4					

IF TABLE IS CENTERED IN ROOM AND FLOOR POWER/ DATA CONNECTIONS ARE PROVIDED. ADD CPU/VDI UNDER-SURFACE MOUNT [OE-18]

ONE OFFICE TO RECEIVE 2-ARM MONITOR STAND, LOCATION TO BE DETERMINED BY BRANCH PLANNING MANAGER DURING TURNOVER.



CORE STATES

10 Chippewa Street Sulte 200 Louis, MO 63109 1.843.4320 rw.core-states.com

COA #: A-2014026908
ARCHITECT OF RECORD



ARCHITECT: K. BRUCE LASURS
LICENSE NUMBER: 007504

THESE DRAWINGS ARE NOT COMPLETE WITHOUT THE
SEPARATE TYPE WRITTEN SPECIFICATIONS MANUAL
WHICH ARE PART OF THE CONTRACT DOCUMENTS.

ISSUE DATE DESCRIPTION
- 2020.12.21 PERMIT SET

PROJECT INFORMATION

PROJECT NO: JPM.27135.001

DATE: 2020.12.21

PROTOTYPE: 20.2

DRAWN BY: C.THEBEAU

CHECKED BY: B.LaSURS

CHECKED BY: B.LaSURS
VERSION: SE_1.00


SHEET TITLE

OFFICE EQUIPMENT BY
PROGRAMMATIC ELEMENT

OFFICE EQUIPMENT SCHEDULE MISCELLANEOUS EQUIPMENT


SCHEDULE SHEET NUMBER

A3 / 3

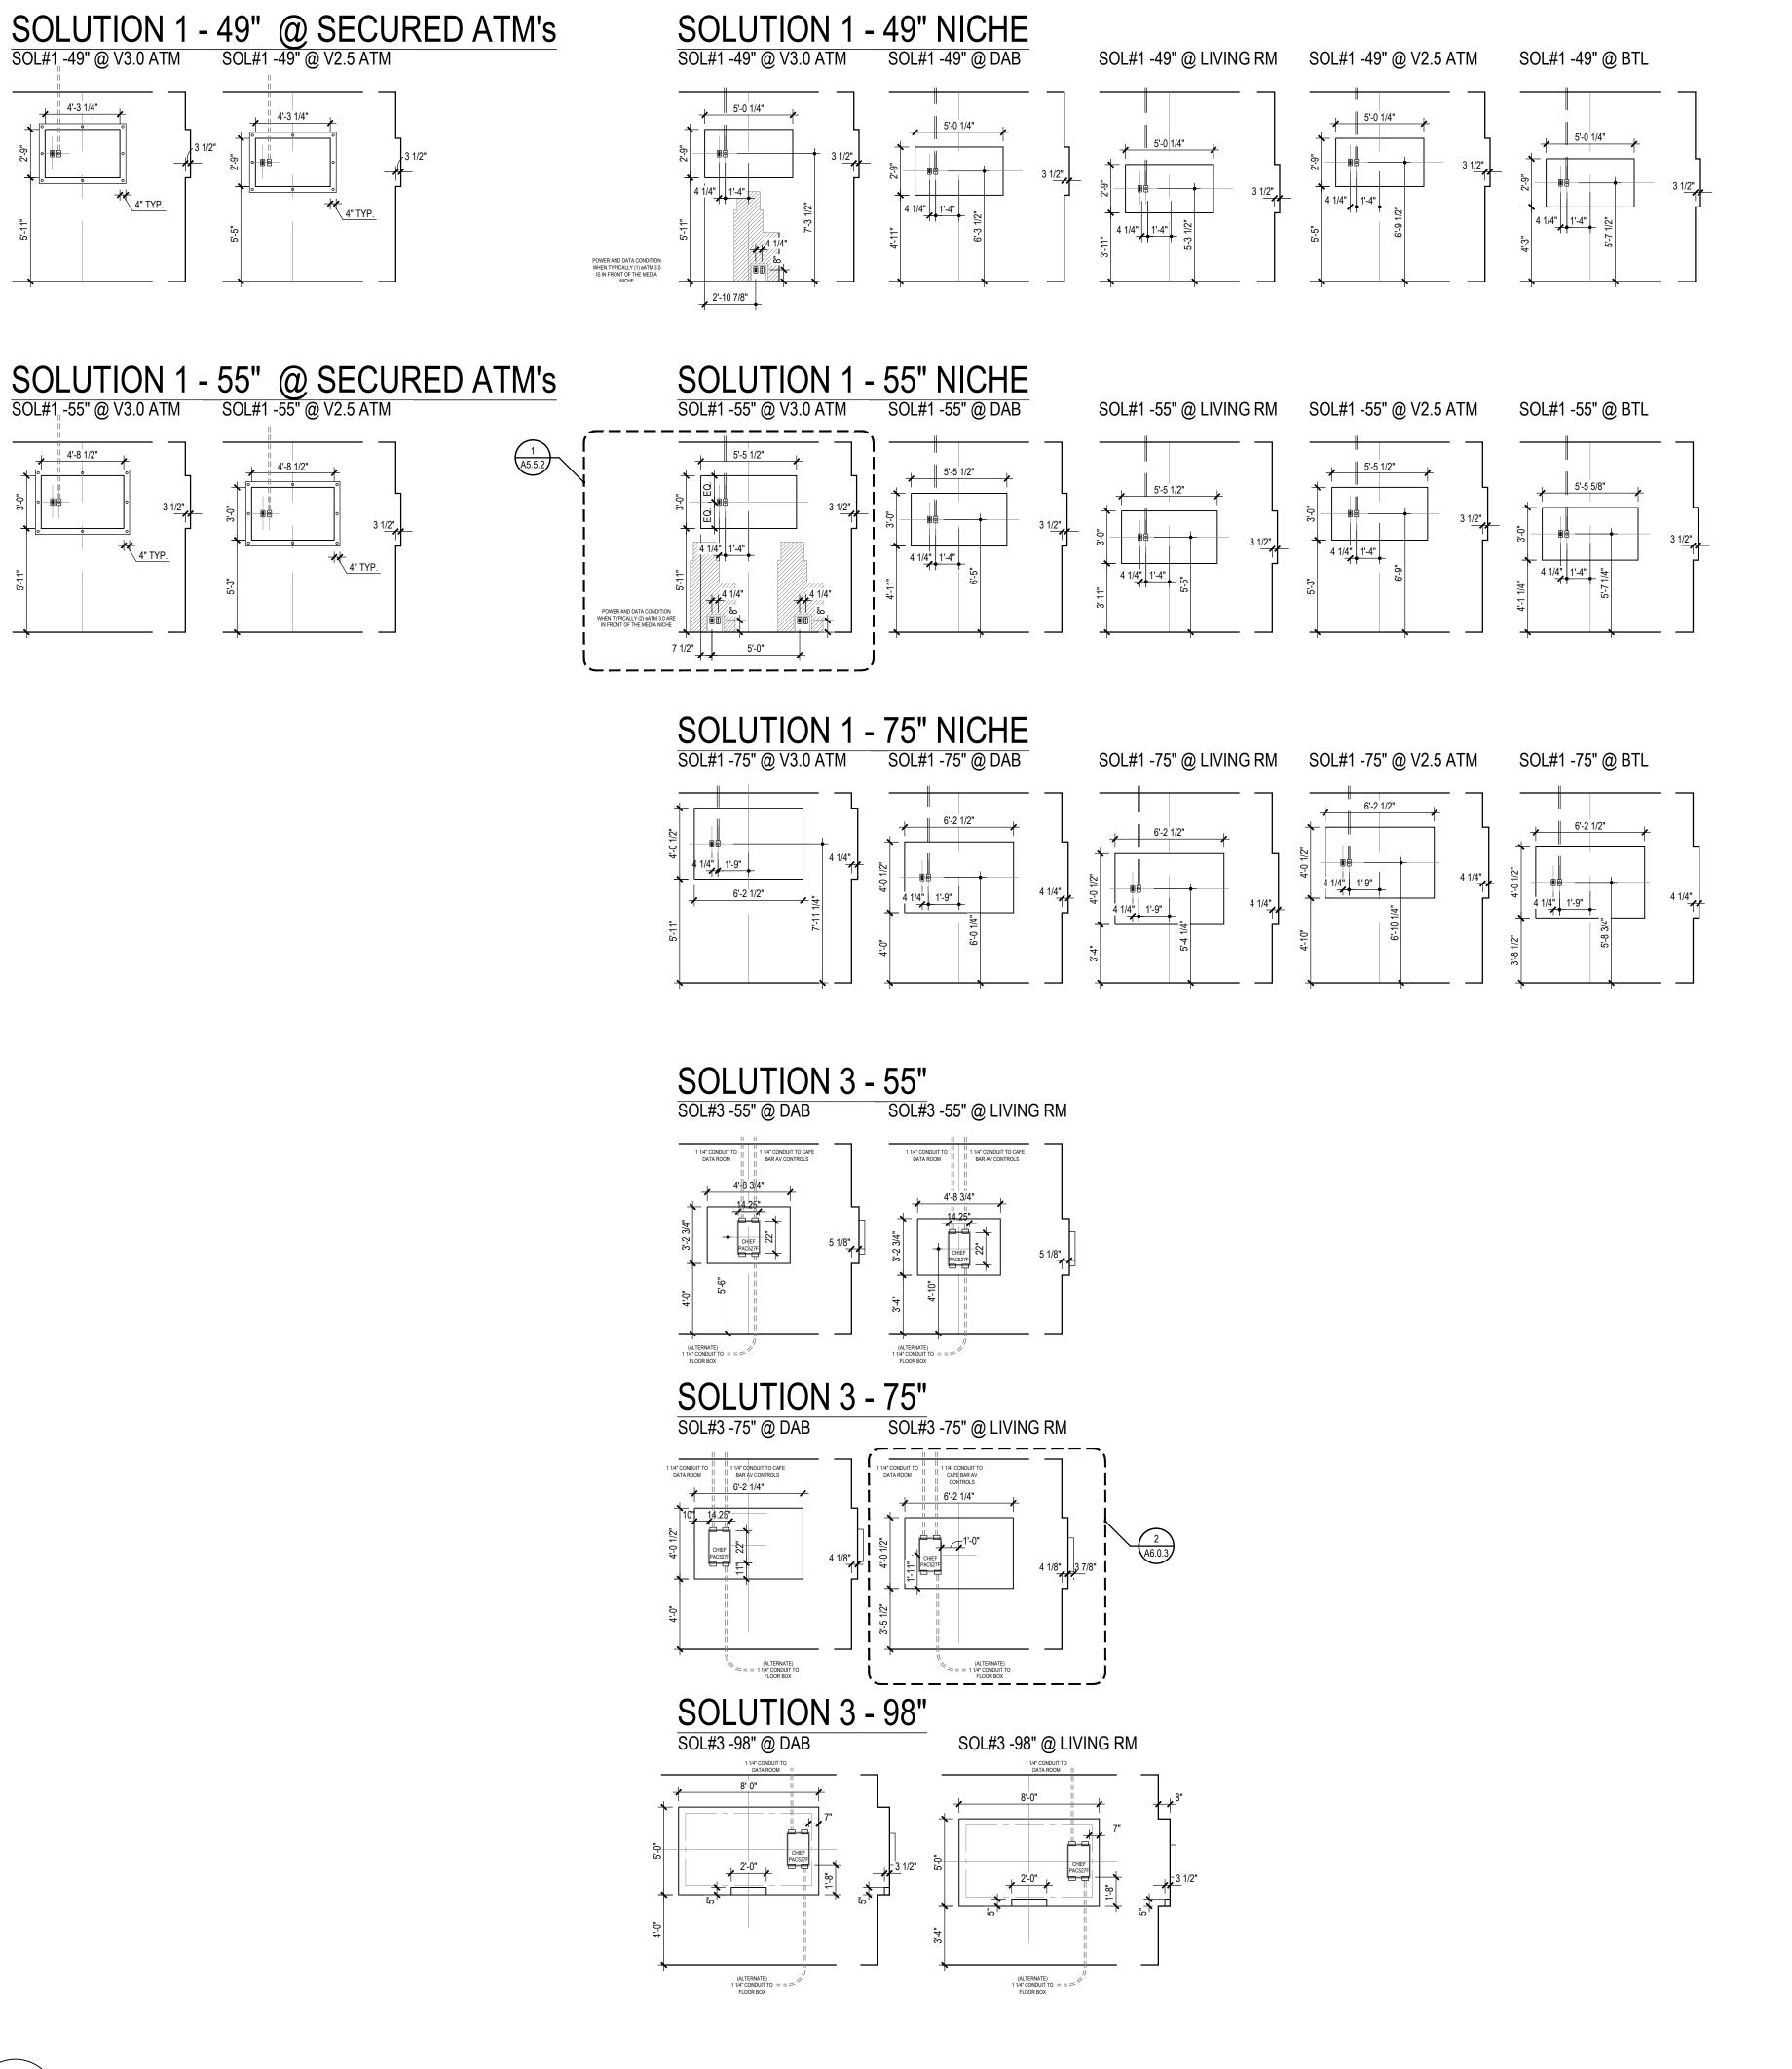


SOLUTION 1 - 49" SURFACE MOUNTED

SOLUTION 1 - 55" SURFACE MOUNTED

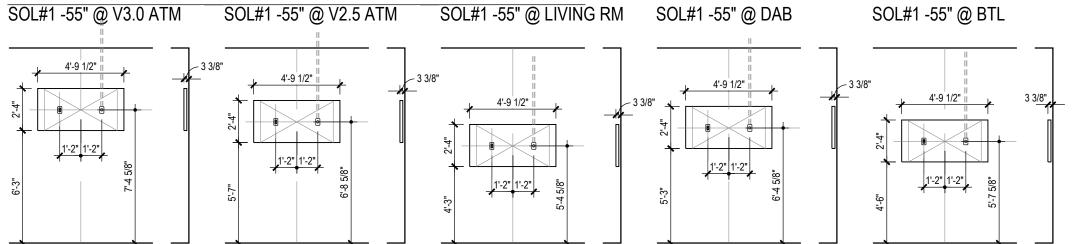


SOLUTION 1 - 75" SURFACE MOUNTED

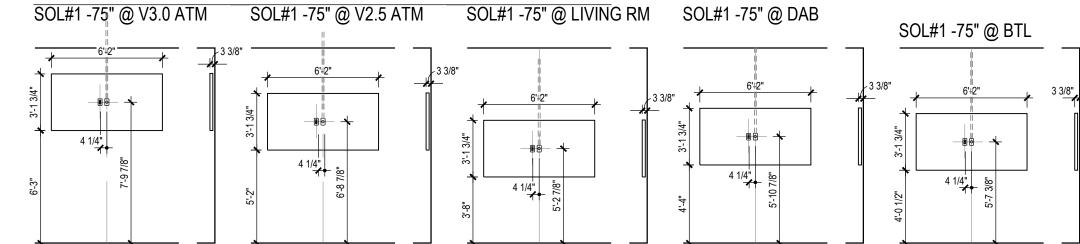

SOLUTION 7 - 32"


SOL #7 -32" @ CAFE BAR SOL #7 -32" @ WELCOME WALL

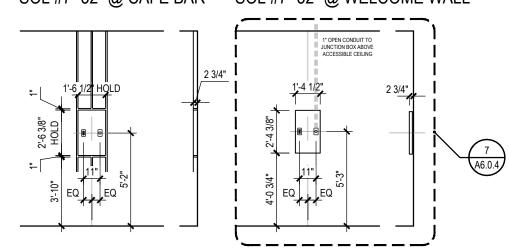

AUDIO/ VISUAL NOTES

- A GC TO VERIFY "SOLUTION" TYPE WITH FURNITURE & EQUIPMENT PLAN; SEE A1.1.4 SHEET(S). IF SOLUTION IS NOT INDICATED ON THAT DRAWING GC IS TO NOTIFY ARCHITECT.
- ALL DIMENSIONS SHOWN FOR NICHE OPENINGS ARE FROM FINISH TO FINISH. GC IS RESPONSIBLE FOR LOCATING WALL FRAMING TO ACCOUNT FOR FINISH MATERIAL & SUBSTRATE TYPE AS NOTED IN DRAWINGS; SEE A1.1.1, A1.1.4, A3.1.0, A6 SERIES (FOR INTERIOR ELEVATIONS), & A6.03 FOR MEDIA WALL DETAILS.
- IF THERE IS A CONFLICT WITH DIMENSIONS SHOWN ON CONSTRUCTION FLOOR PLAN FOR NICHE SIZE, THE NICHE DIMENSIONS SHOWN ON THIS SHEET ARE TO SUPERCEDE. NOTIFY ARCHITECT IF CONFLICT OCCURS.
- D GC TO CONFIRM FINISHED OPENING FOR DISPLAY MONITOR/ SCREEN IS CORRECT SIZE WITH CHASE A/V VENDOR PRIOR TO NICHE CONSTRUCTION.
- E GC TO CONTACT ARCHITECT IMMEDIATELY IF VERTICAL LOCATION NICHE CONFLICTS WITH CEILING HEIGHT. REFER TO A1.2.1 SHEET(s) FOR REFLECTED CEILING PLAN.

MORGAN CHASE, N
HWY 291 & NE LANGSFORD RI
890 NE LANGSFORD RD

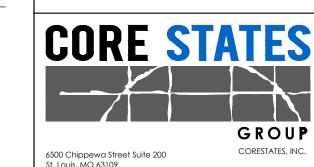

6500 Chippewa Street Suite 200 St. Louis, MO 63109 314.843.4320 www.core-states.com

www.core-states.com

COA #: A-2014026908

ARCHITECT OF RECORD



ARCHITECT: R. BRUCE LASURS LICENSE NUMBER: 007504

THESE DRAWINGS ARE NOT COMPLETE WITHOUT THE SEPARATE TYPE WRITTEN SPECIFICATIONS MANUAL WHICH ARE PART OF THE CONTRACT DOCUMENTS.

UE DATE DESCRIPTION

- 2020.12.21 PERMIT SET

PROJECT INFORMATION
PROJECT NO: JPM.27135.001
DATE: 2020.12.21

DATE: 2020.12.21

PROTOTYPE: 20.2

DRAWN BY: C.THEBEAU

CHECKED BY: B.LaSURS


VERSION: SE_1.00

SHEET TITLE

AUDIO / VIDEO FINISHED OPENINGS

SHEET NUMBER

A3.4.5

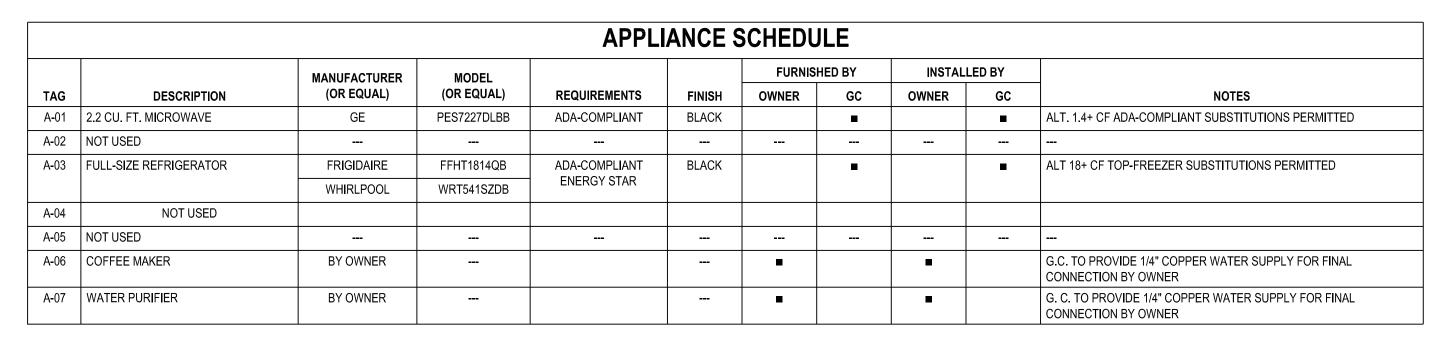

	RESTROOM ACCESSORIES SCHEDULE										
TAG	DESCRIPTION	MFR.	MODEL	FINISH	NOTES						
TA-01	TOILET TISSUE DISPENSER	BOBRICK	B-2888	S.S.	1,6						
TA-02	UNIVERSAL C-FOLD / MULTI-FOLD PAPER TOWEL DISPENSER	BOBRICK	B-262	S.S.	1						
TA-03	WASTE RECEPTACLE	BOBRICK	B-279	S.S.	6						
TA-04	GRAB BARS	BOBRICK	B-5806 SERIES	S.S.	6						
TA-05	MIRROR	BOBRICK	B-165 2448	S.S.	6						
TA-06	FOAM SOAP DISPENSER: LAVMOUNT, LONG SHANK, 4" SPOUT	BOBRICK	B-823	POL. S.S.	1, 2, 6						
TA-06 (OPT.)	LIQUID SOAP DISPENSER: LAVMOUNT, LONG SHANK, 4" SPOUT	BOBRICK	B-822	POL. S.S.	1, 2, 6						
TA-07	SANITARY NAPKIN DISPOSAL	BOBRICK	B-270	S.S.	6						
TA-08	TOILET SEAT COVER DISPENSER	BOBRICK	B-4221	S.S.	6						
TA-09	SHELF	GAMCO	B-7816	S.S.	4, 6						
TA-10	BABY CHANGING STATION (ONLY WHERE CODE REQUIRED)	GAMCO	BCS-2	GREY HOPE	4, 5, 6						

NOTES:
1. G.C. TO VERIFY OPTION PREFERENCE WITH OWNER'S LOCAL FACILITIES MANAGER.
2. FIELD-CUT SOAP DISPENSER SHANK TO MINIMIZE RESERVOIR EXPOSURE.
3. AoR TO COORDINATE DISPENSER POSITION TO MAINTAIN ACCESSIBLE REACH RANGE AND PATH TO DISPENSER AND ADJACENT FIXTURES
4. AVAILABLE FROM BOBRICK.
5. BABY CHANGING STATION TO BE PROVIDED ONLY WHEN REQUIRED BY A.H.J MOUNT FOR ACCESSIBILITY COMPLIANCE, AT HEIGHT OF 27" A.F.F., HANDLE < 44" AFF.

ELECTRICAL DEVICE	E FINISHES	
LOCATION	LUTRON	LEVITON. LEGRAND

6. PROVIDE IN ALL RESTROOMS, MEN / WOMEN / UNISEX.

ELECTRICAL DEVICE FINISHES						
LOC	ATION	LUTRON	LEVITON, LEGRAND			
SURFACE	FINISH					
CEILINGS AND SOFFIT FACES		WHITE	WHITE			
TYPICAL WALL		WHITE	WHITE			
COMMUNITY WALL		RECESSED BLACK	RECESSED BLACK			

GROUP

6500 Chippewa Street Suite 200 St. Louis, MO 63109 314.843.4320 www.core-states.com COA #: A-2014026908

ARCHITECT OF RECORD

CORESTATES, INC.




ARCHITECT: K. BRUCE LASURS LICENSE NUMBER: 007504 THESE DRAWINGS ARE NOT COMPLETE WITHOUT THE SEPARATE TYPE WRITTEN SPECIFICATIONS MANUAL WHICH ARE PART OF THE CONTRACT DOCUMENTS.


ISSUE DATE DESCRIPTION - 2020.12.21 PERMIT SET

PROJECT INFORMATION PROJECT NO: JPM.27135.001 2020.12.21 PROTOTYPE: DRAWN BY: C.THEBEAU CHECKED BY: B.LaSURS SE_1.00 VERSION: SHEET TITLE

APPLIANCE SCHEDULE RESTROOM ACCESSORIES ELECTRICAL DEVICES FINISHES

SHEET NUMBER

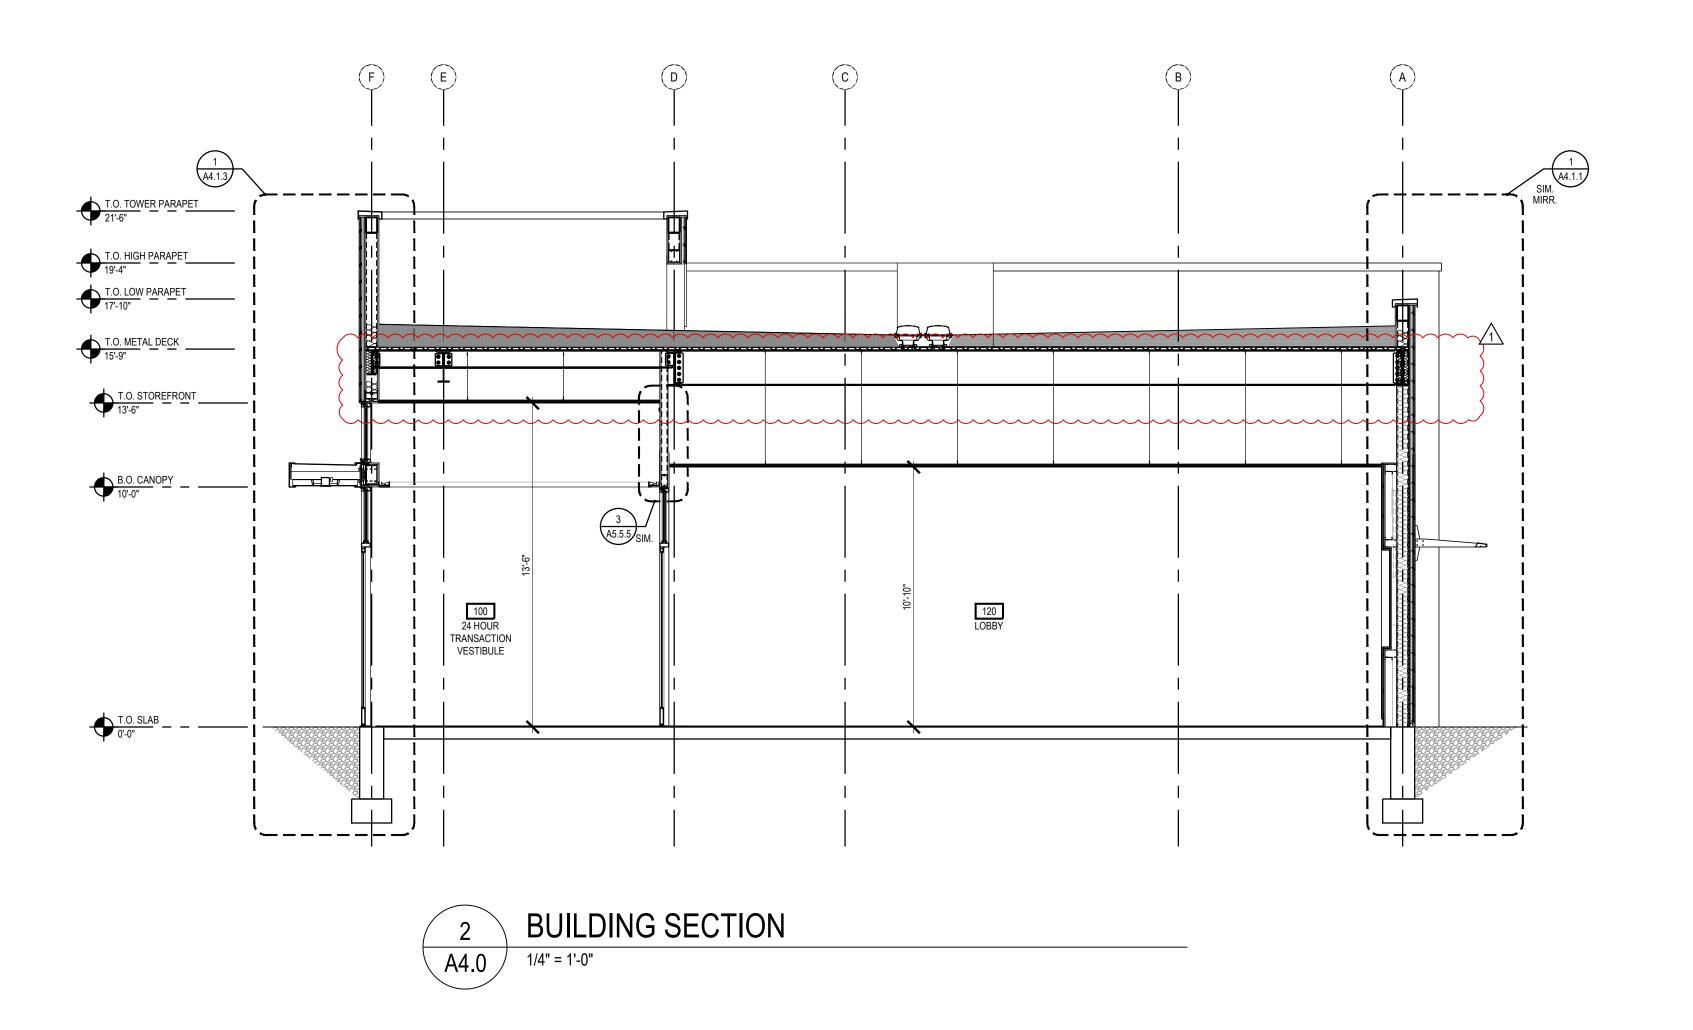

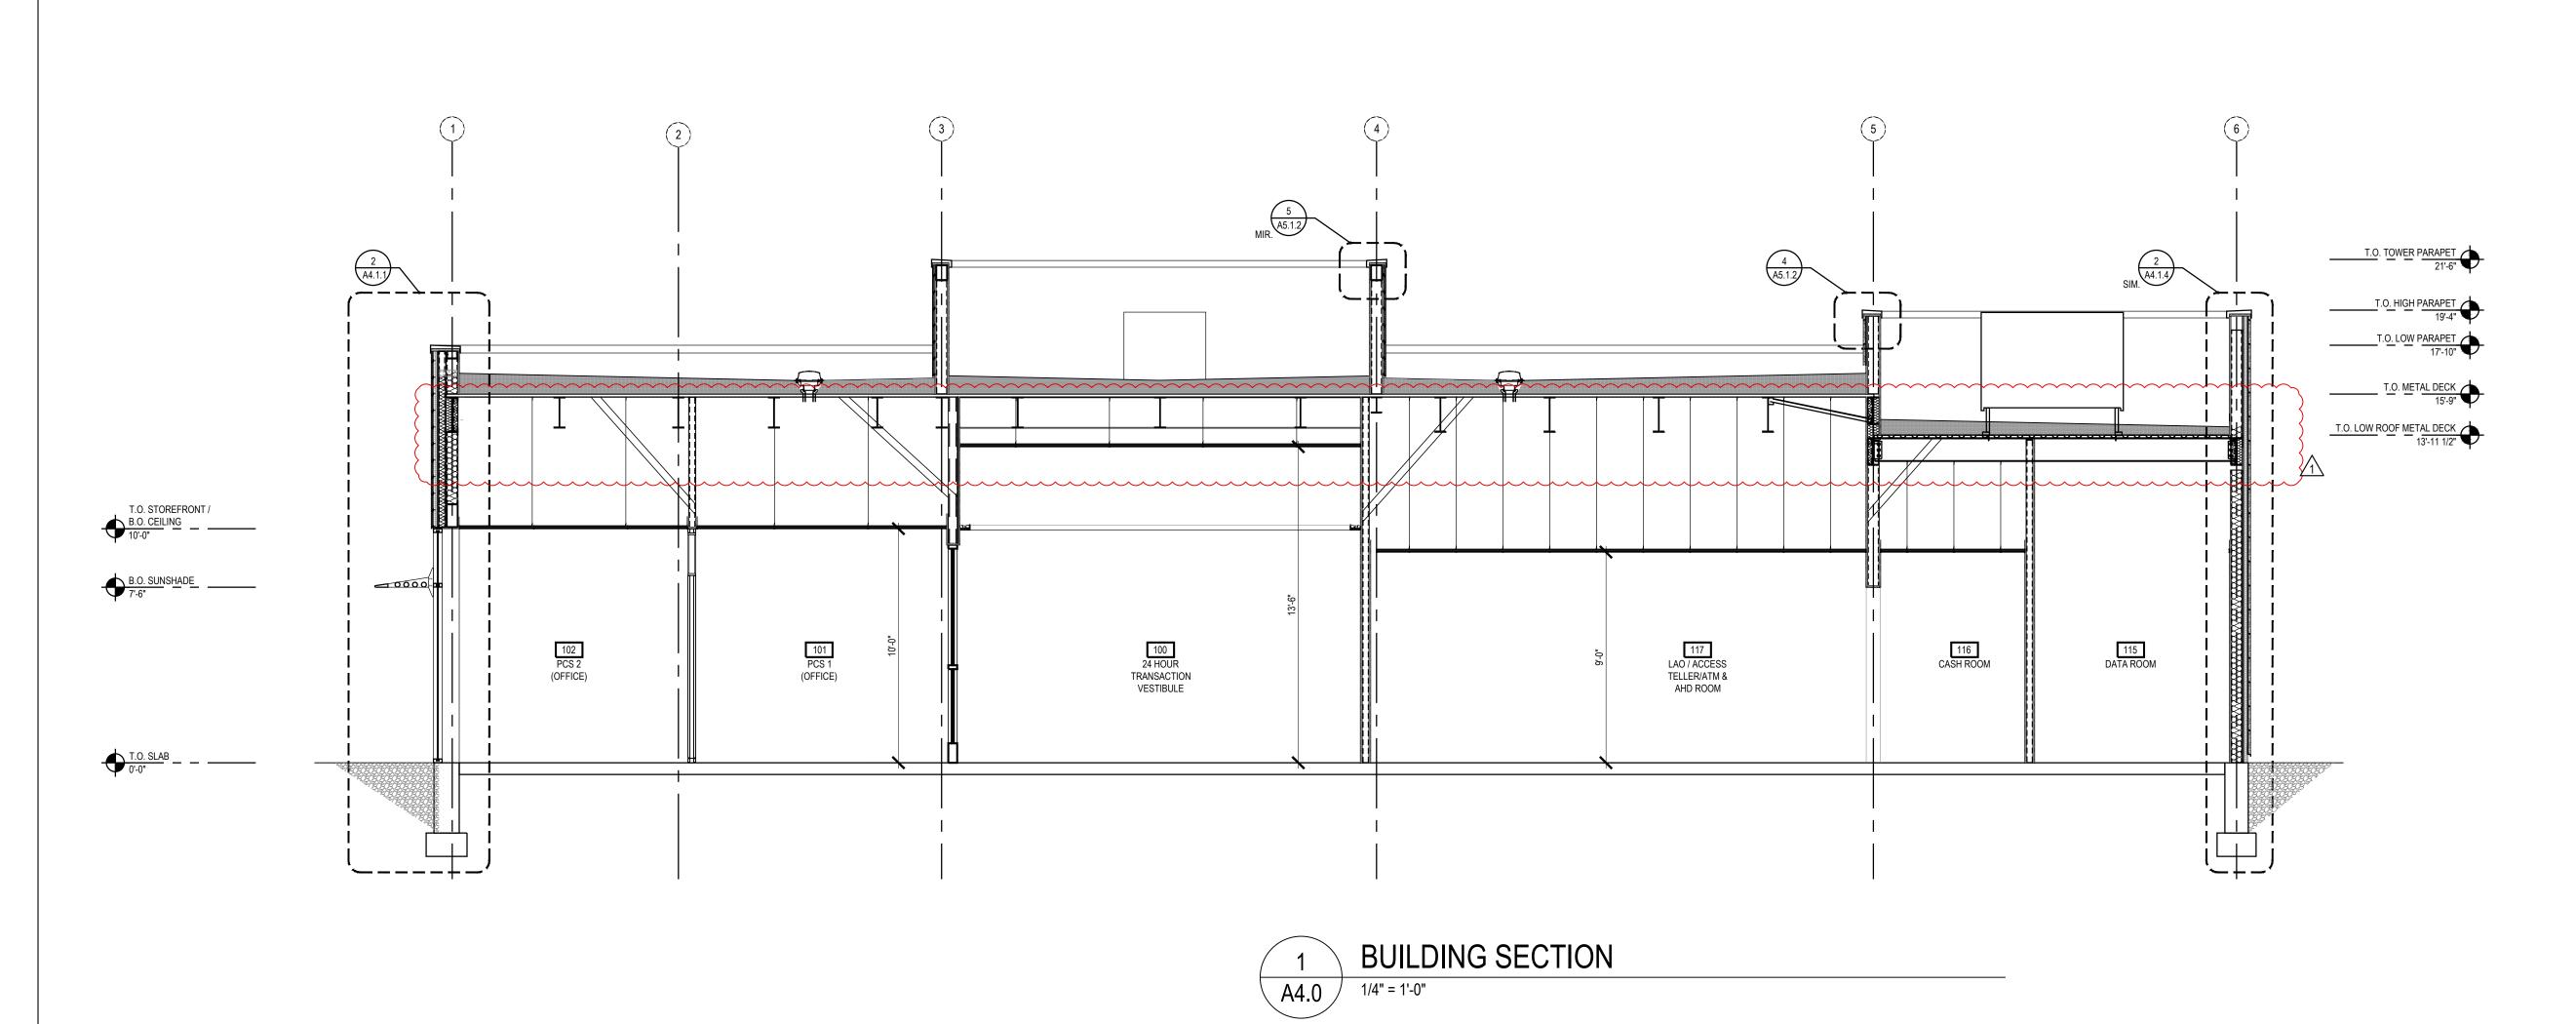

GROUP

COA #: A-2014026908 ARCHITECT OF RECORD

ROBERT BRUCE

ARCHITECT: R. BRUCE LASURS LICENSE NUMBER: 007504

THESE DRAWINGS ARE NOT COMPLETE WITHOUT THE SEPARATE TYPE WRITTEN SPECIFICATIONS MANUAL WHICH ARE PART OF THE CONTRACT DOCUMENTS.

ISSUE DATE DESCRIPTION - 2020.12.21 PERMIT SET 1 2021.04.20 STRUCTURAL STEEL REV


PROJECT INFORMATION PROJECT NO: JPM.27135.001 2020.12.21 **20.2** PROTOTYPE: C.THEBEAU B.LaSURS DRAWN BY:


CHECKED BY: VERSION: SE_1.00 SHEET TITLE


BUILDING SECTIONS

SHEET NUMBER


A4.0.0

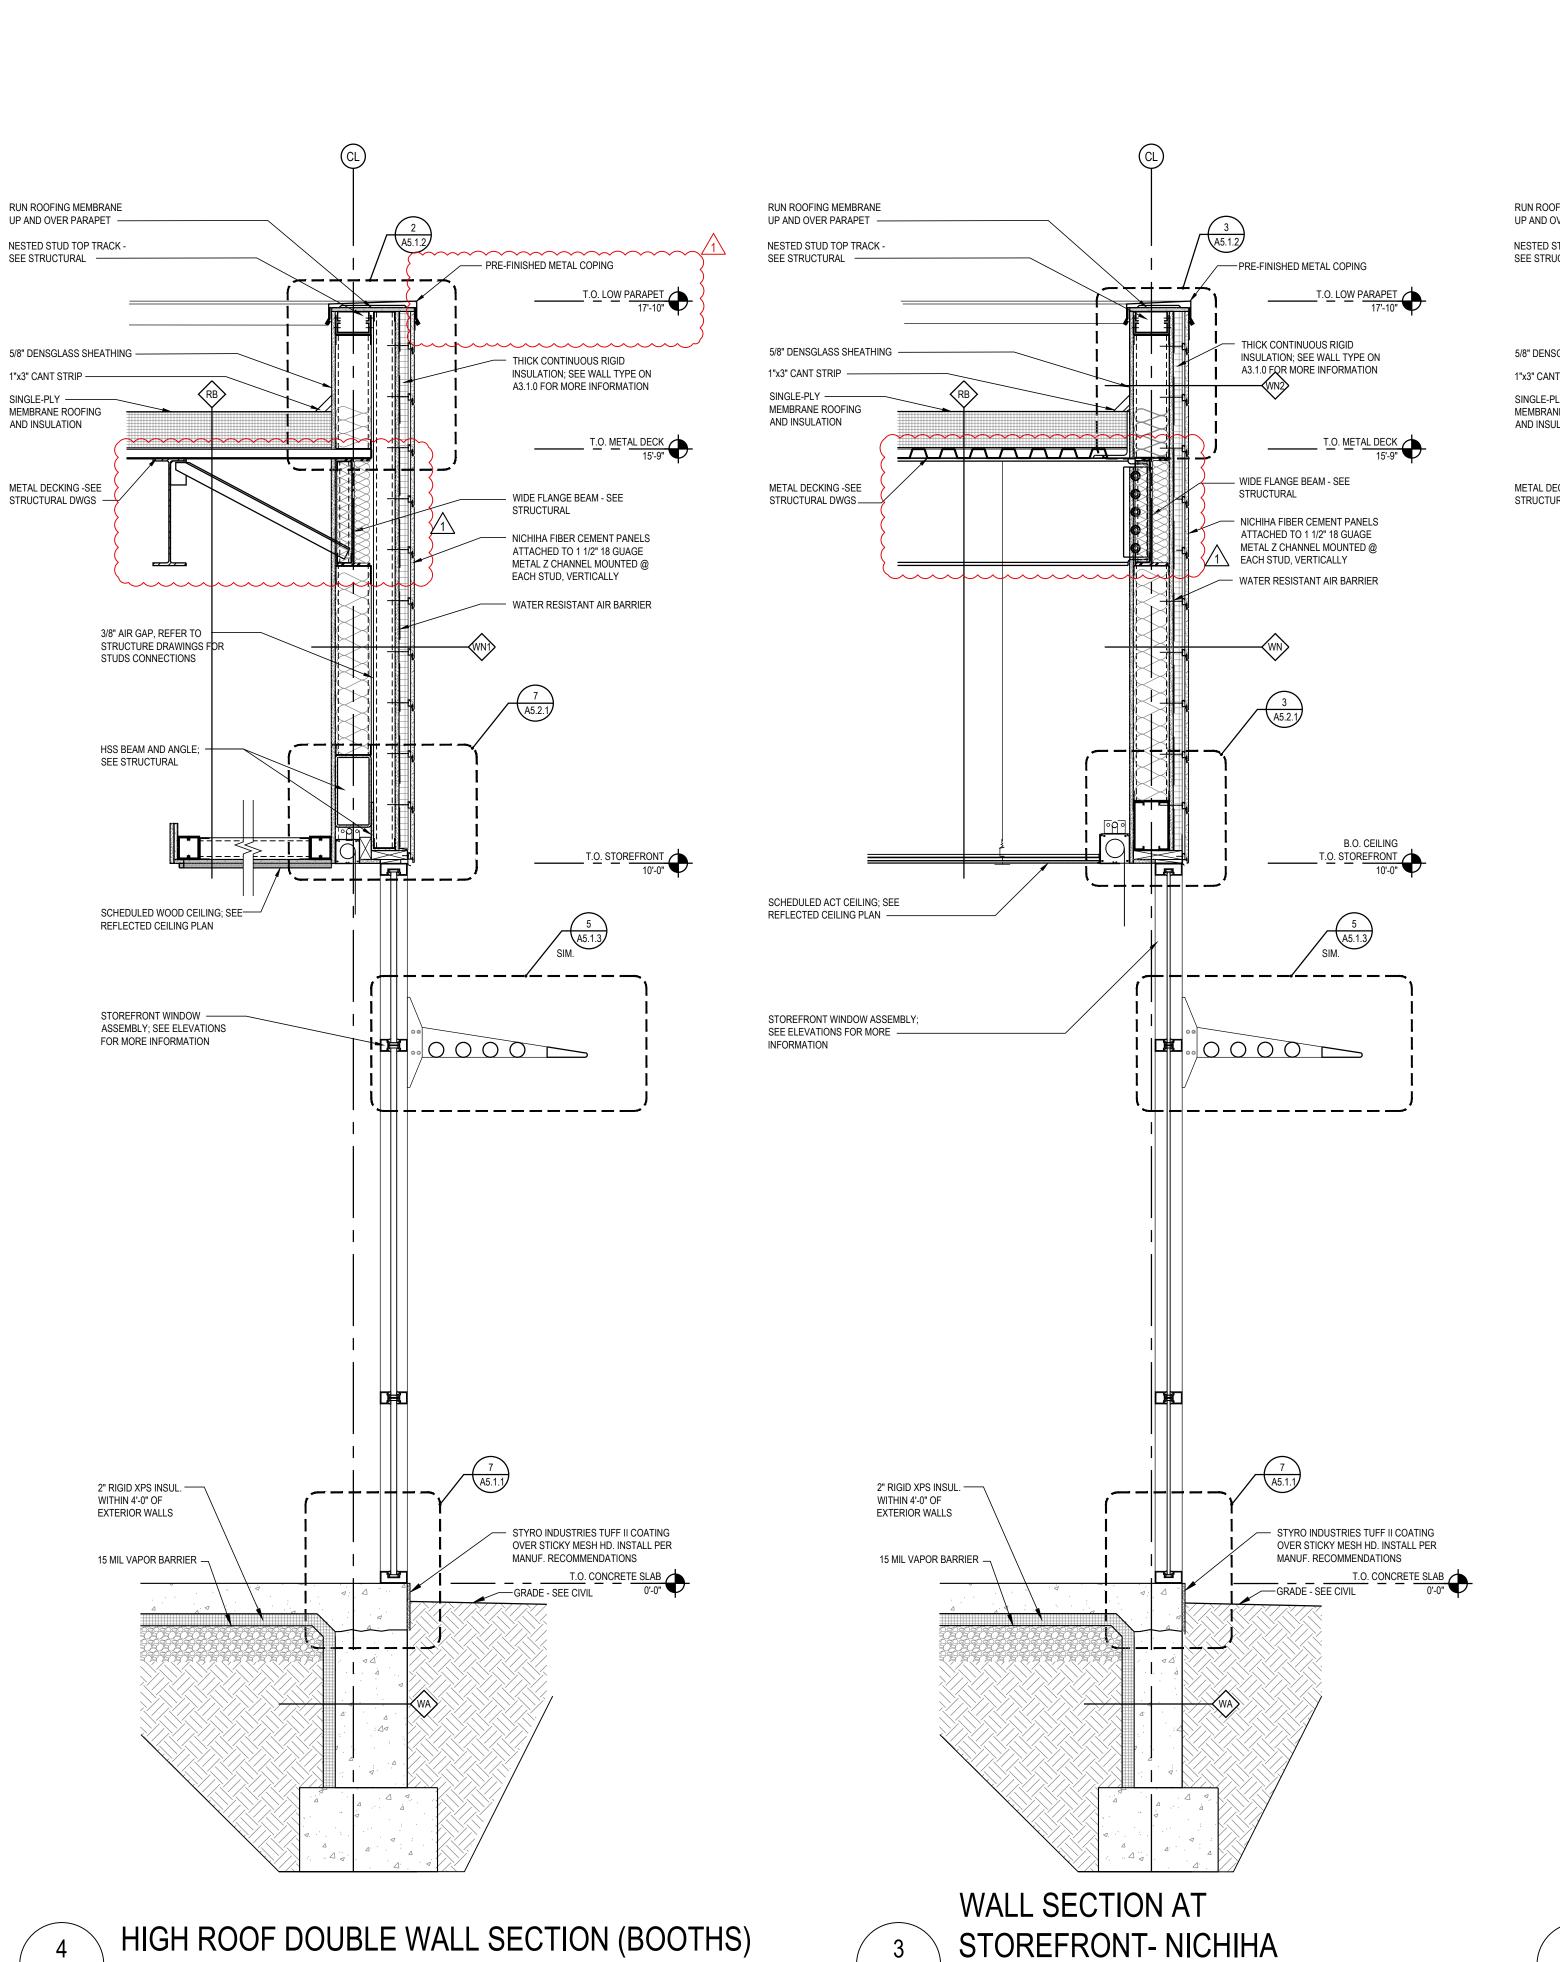

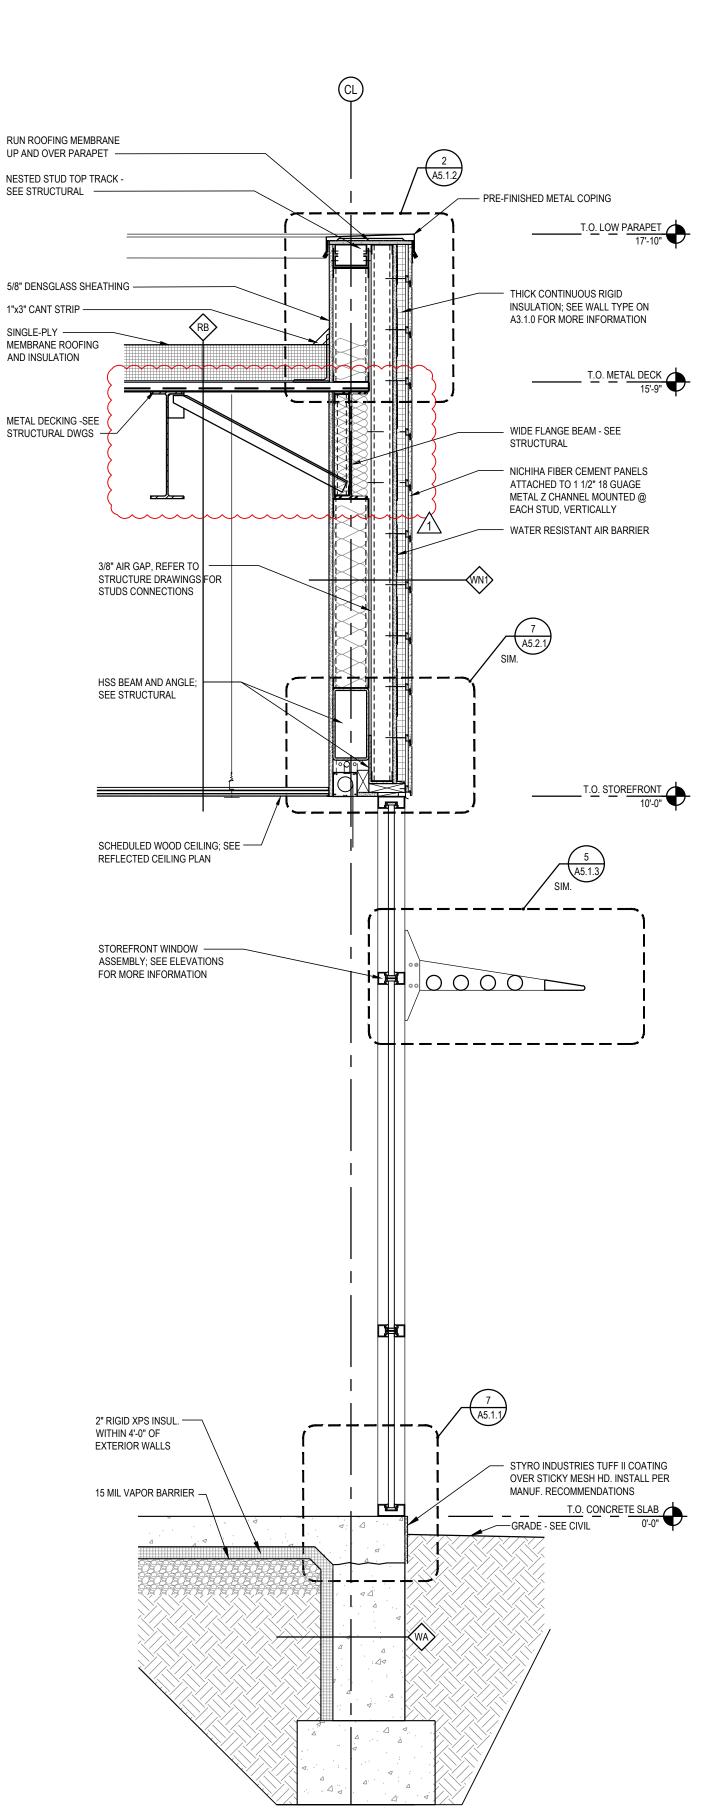

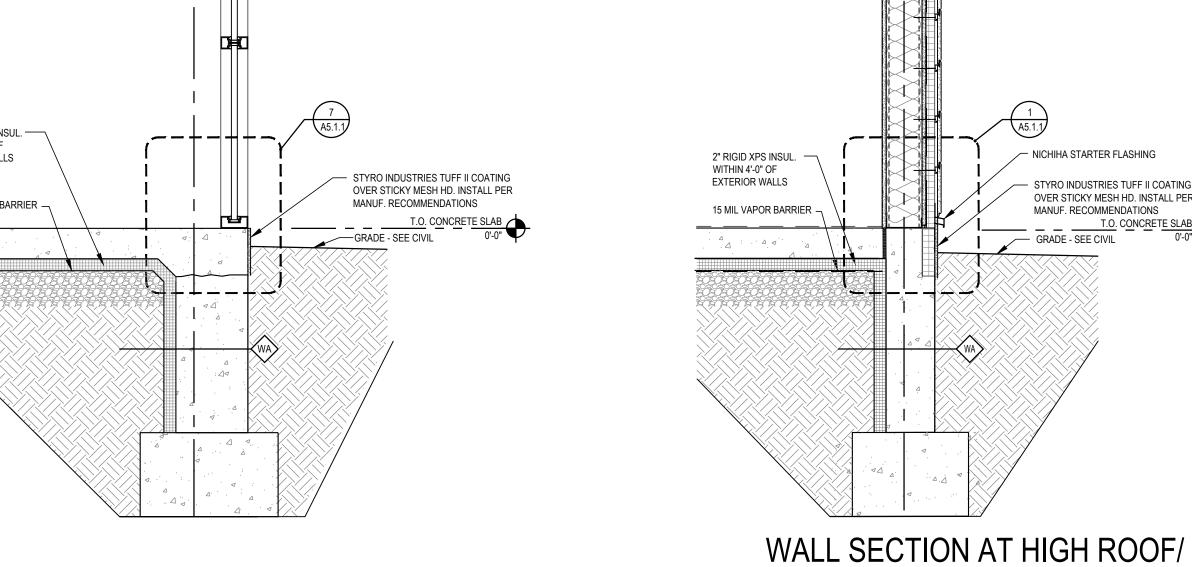

HIGH ROOF DOUBLE WALL SECTION (OFFICE)

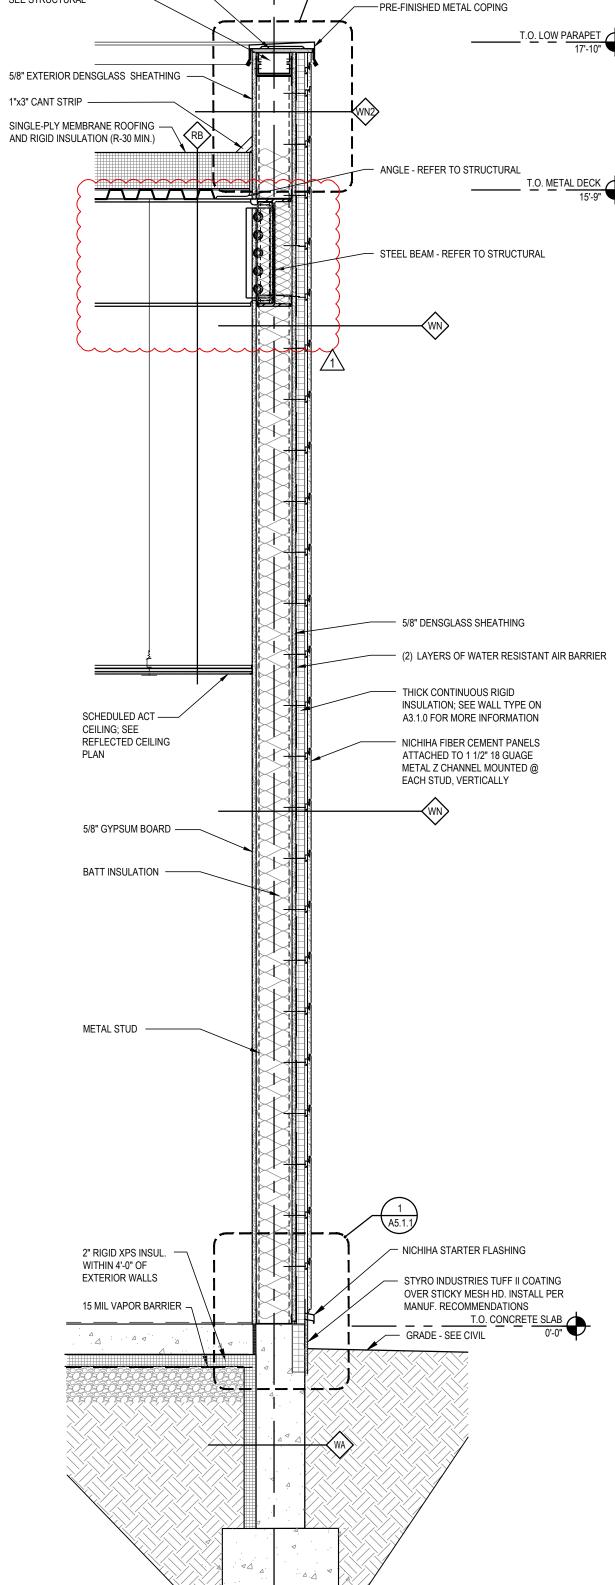

LOW PARAPET NICHIHA

RUN ROOFING MEMBRANE

SEE STRUCTURAL ---

UP AND OVER PARAPET ---NESTED STUD TOP TRACK -

> WALL SECTIONS: LOW PARAPET TYPICAL STOREFRONT OPENINGS SHEET NUMBER

6500 Chippewa Street Suite 200 St. Louis, MO 63109 314.843.4320

ARCHITECT OF RECORD

ROBERT BRUCE

ARCHITECT: R. BRUCE LASURS LICENSE NUMBER: 007504 THESE DRAWINGS ARE NOT COMPLETE WITHOUT THE SEPARATE TYPE WRITTEN SPECIFICATIONS MANUAL WHICH ARE PART OF THE CONTRACT DOCUMENTS.

DESCRIPTION

JPM.27135.001 2020.12.21

C.THEBEAU

B.LaSURS

2020.12.21 PERMIT SET

PROJECT INFORMATION

PROJECT NO:

PROTOTYPE:


DRAWN BY:

CHECKED BY: VERSION: SHEET TITLE

1 2021.04.20 STRUCTURAL STEEL REV

COA #: A-2014026908

A4.1.1

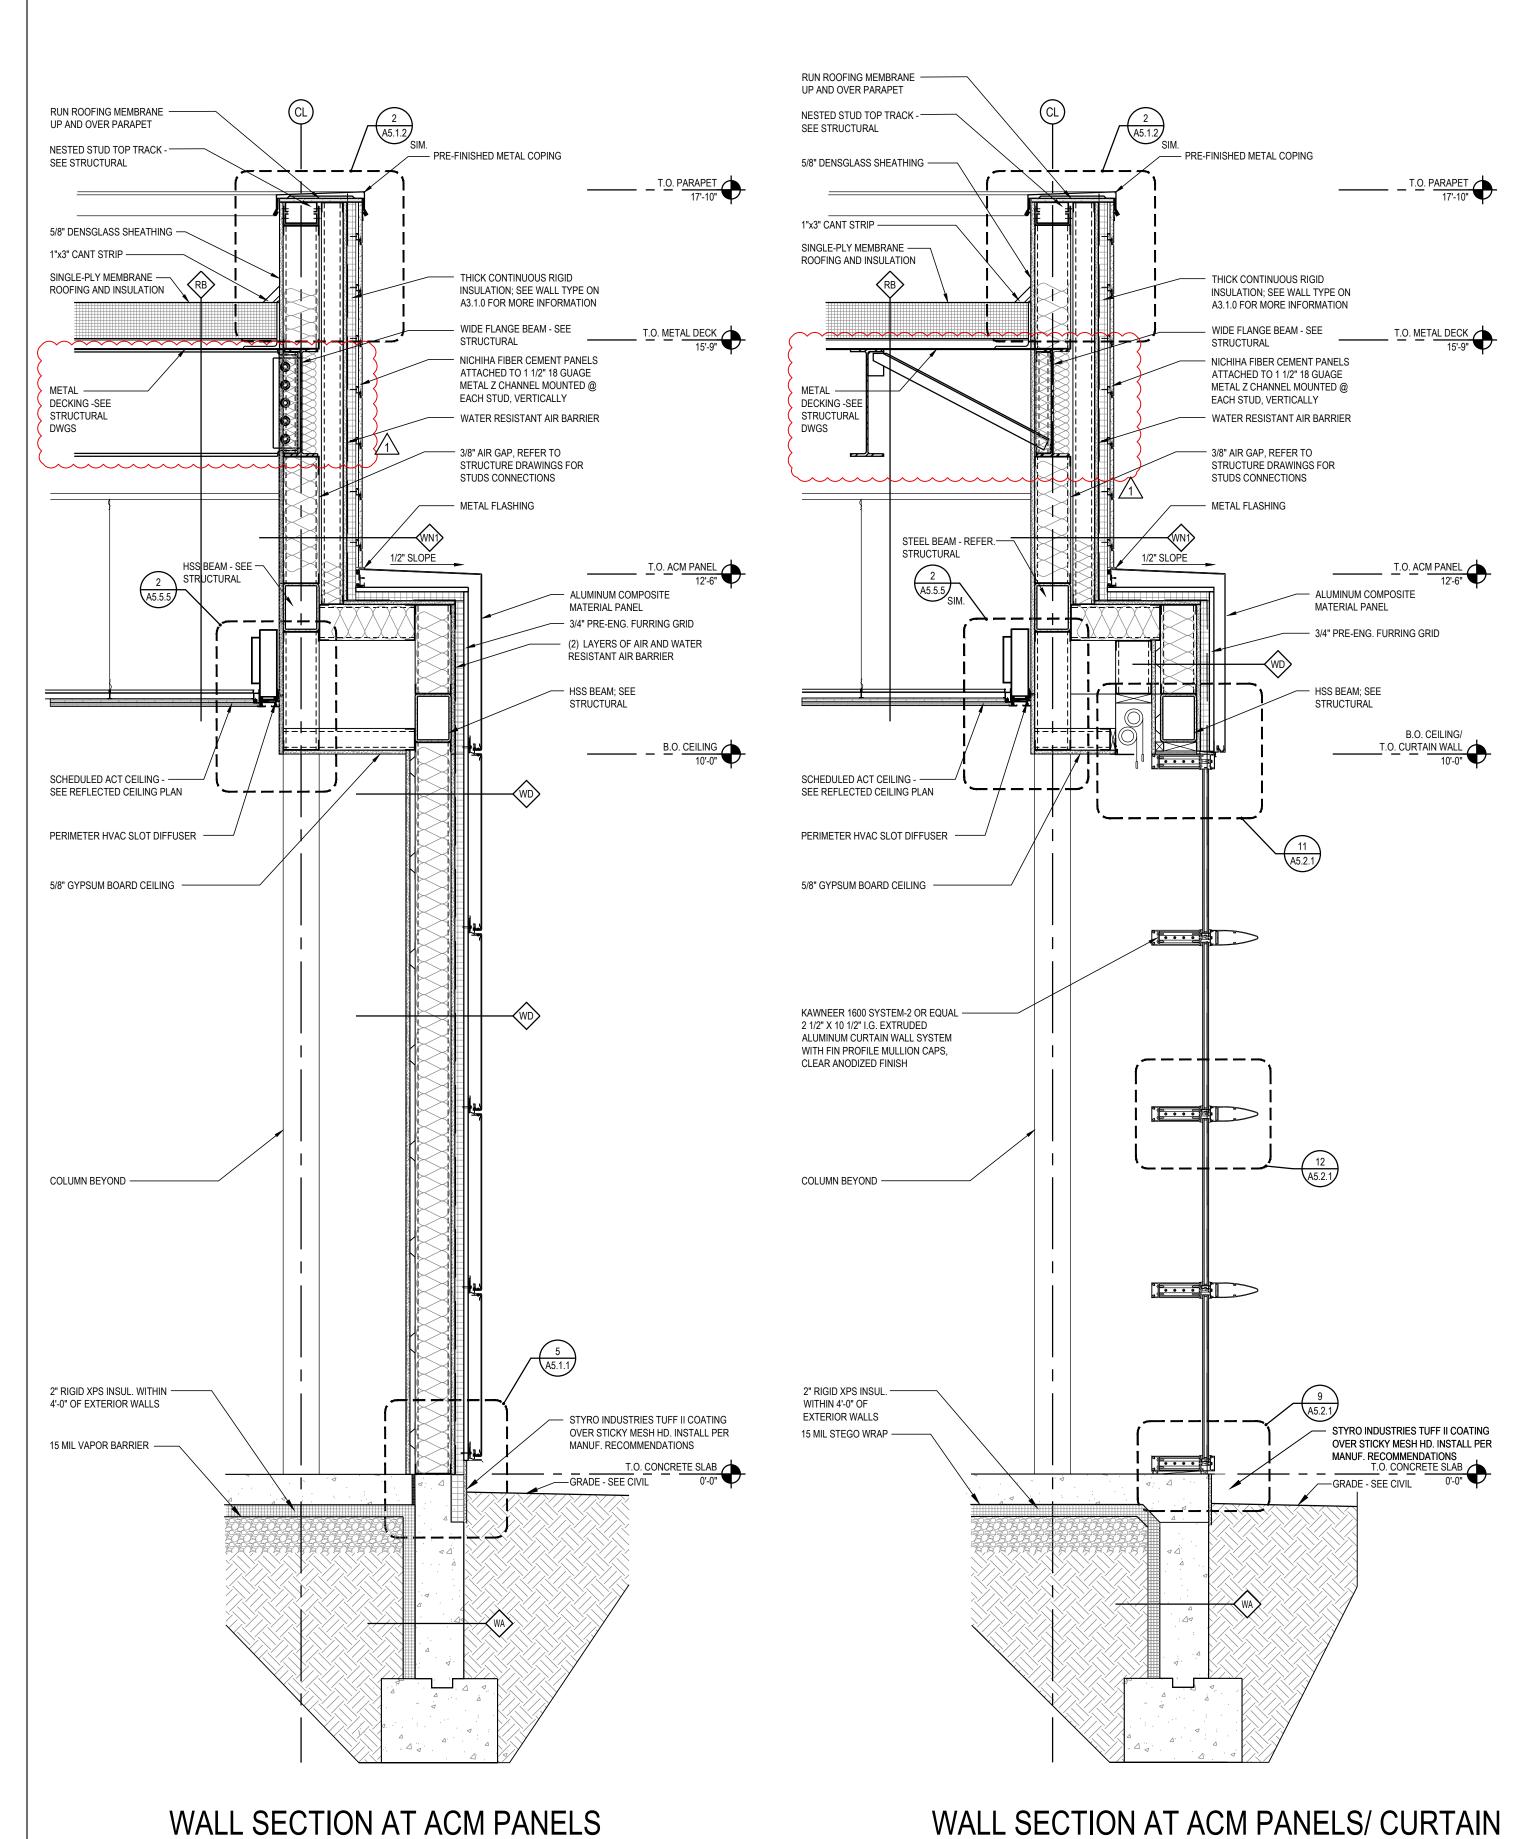


@ DOUBLE PARAPET WALL

A4.1.2 3/4" = 1'-0"

WALL SECTION AT ACM PANELS/ CURTAIN
WALL @ DOUBLE PARAPET WALL

3/4" = 1'-0"

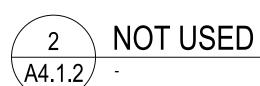

1 NOT USED

JP MORGAN CHASE, N.A.
HWY 291 & NE LANGSFORD RD
890 NE LANGSFORD RD
1EE'S SUMMIT, MO 64063

GROUP

6500 Chippewa Street Suite 200
St. Louis, MO 63109
314.843.4320
www.core-states.com

COA #: A-2014026908

COA #: A-201402690

ARCHITECT OF RECORD

ROBERT BRUCE
LISURS
APTI 21, 2021
NUMBER
A-7504

ARCHITECT: R. BRUCE LASURS
LICENSE NUMBER: 007504

THESE DRAWINGS ARE NOT COMPLETE WITHOUT THE
SEPARATE TYPE WRITTEN SPECIFICATIONS MANUAL
WHICH ARE PART OF THE CONTRACT DOCUMENTS.

JE DATE DESCRIPTION
- 2020.12.21 PERMIT SET

1 2021.04.20 STRUCTURAL STEEL REV

PROJECT INFORMATION

PROJECT NO: JPM.27135.001

DATE: 2020.12.21

PROTOTYPE: 20.2

DRAWN BY: C.THEBEAU

CHECKED BY: B.LaSURS


VERSION: SE_1.00


SHEET TITLE

WALL SECTIONS: CURTAIN WALL, ACM PANEL AND HIGH PARAPET


SHEET NUMBER


A4.1.2

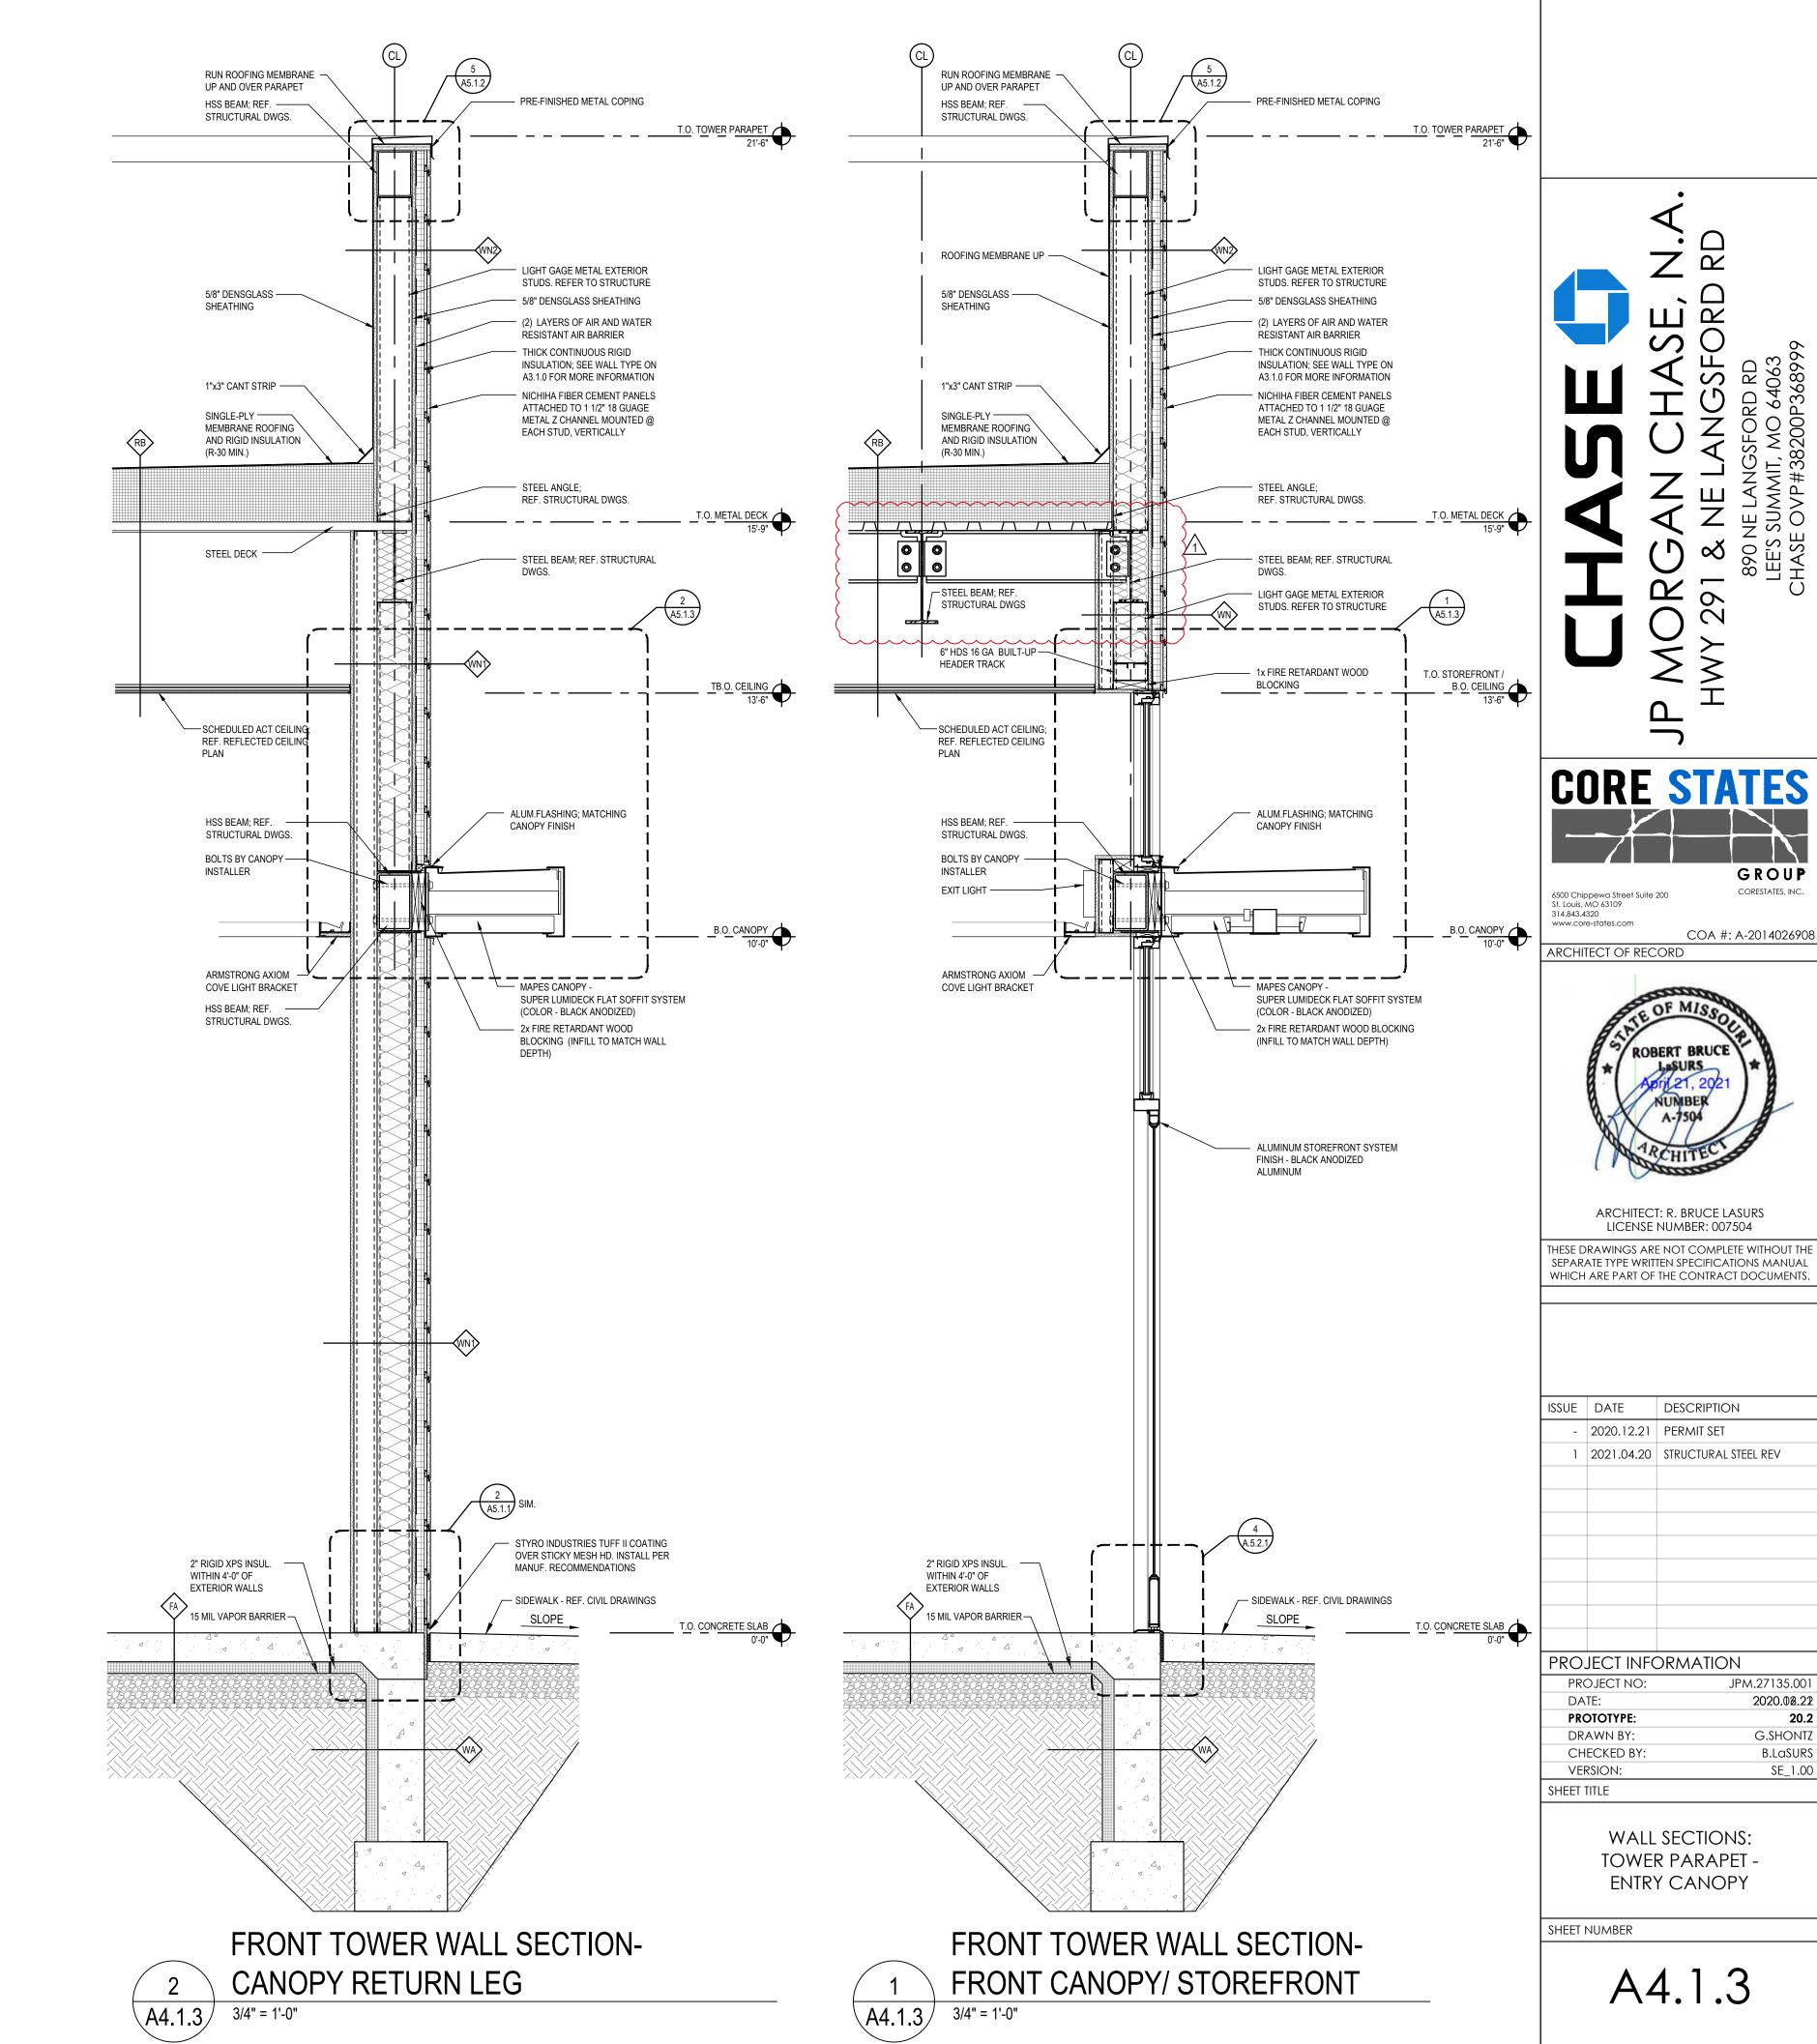

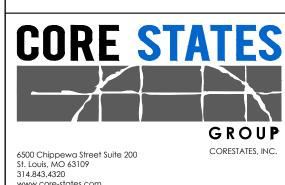

JPM.27135.001 2020.08.22 G.SHONTZ B.LaSURS

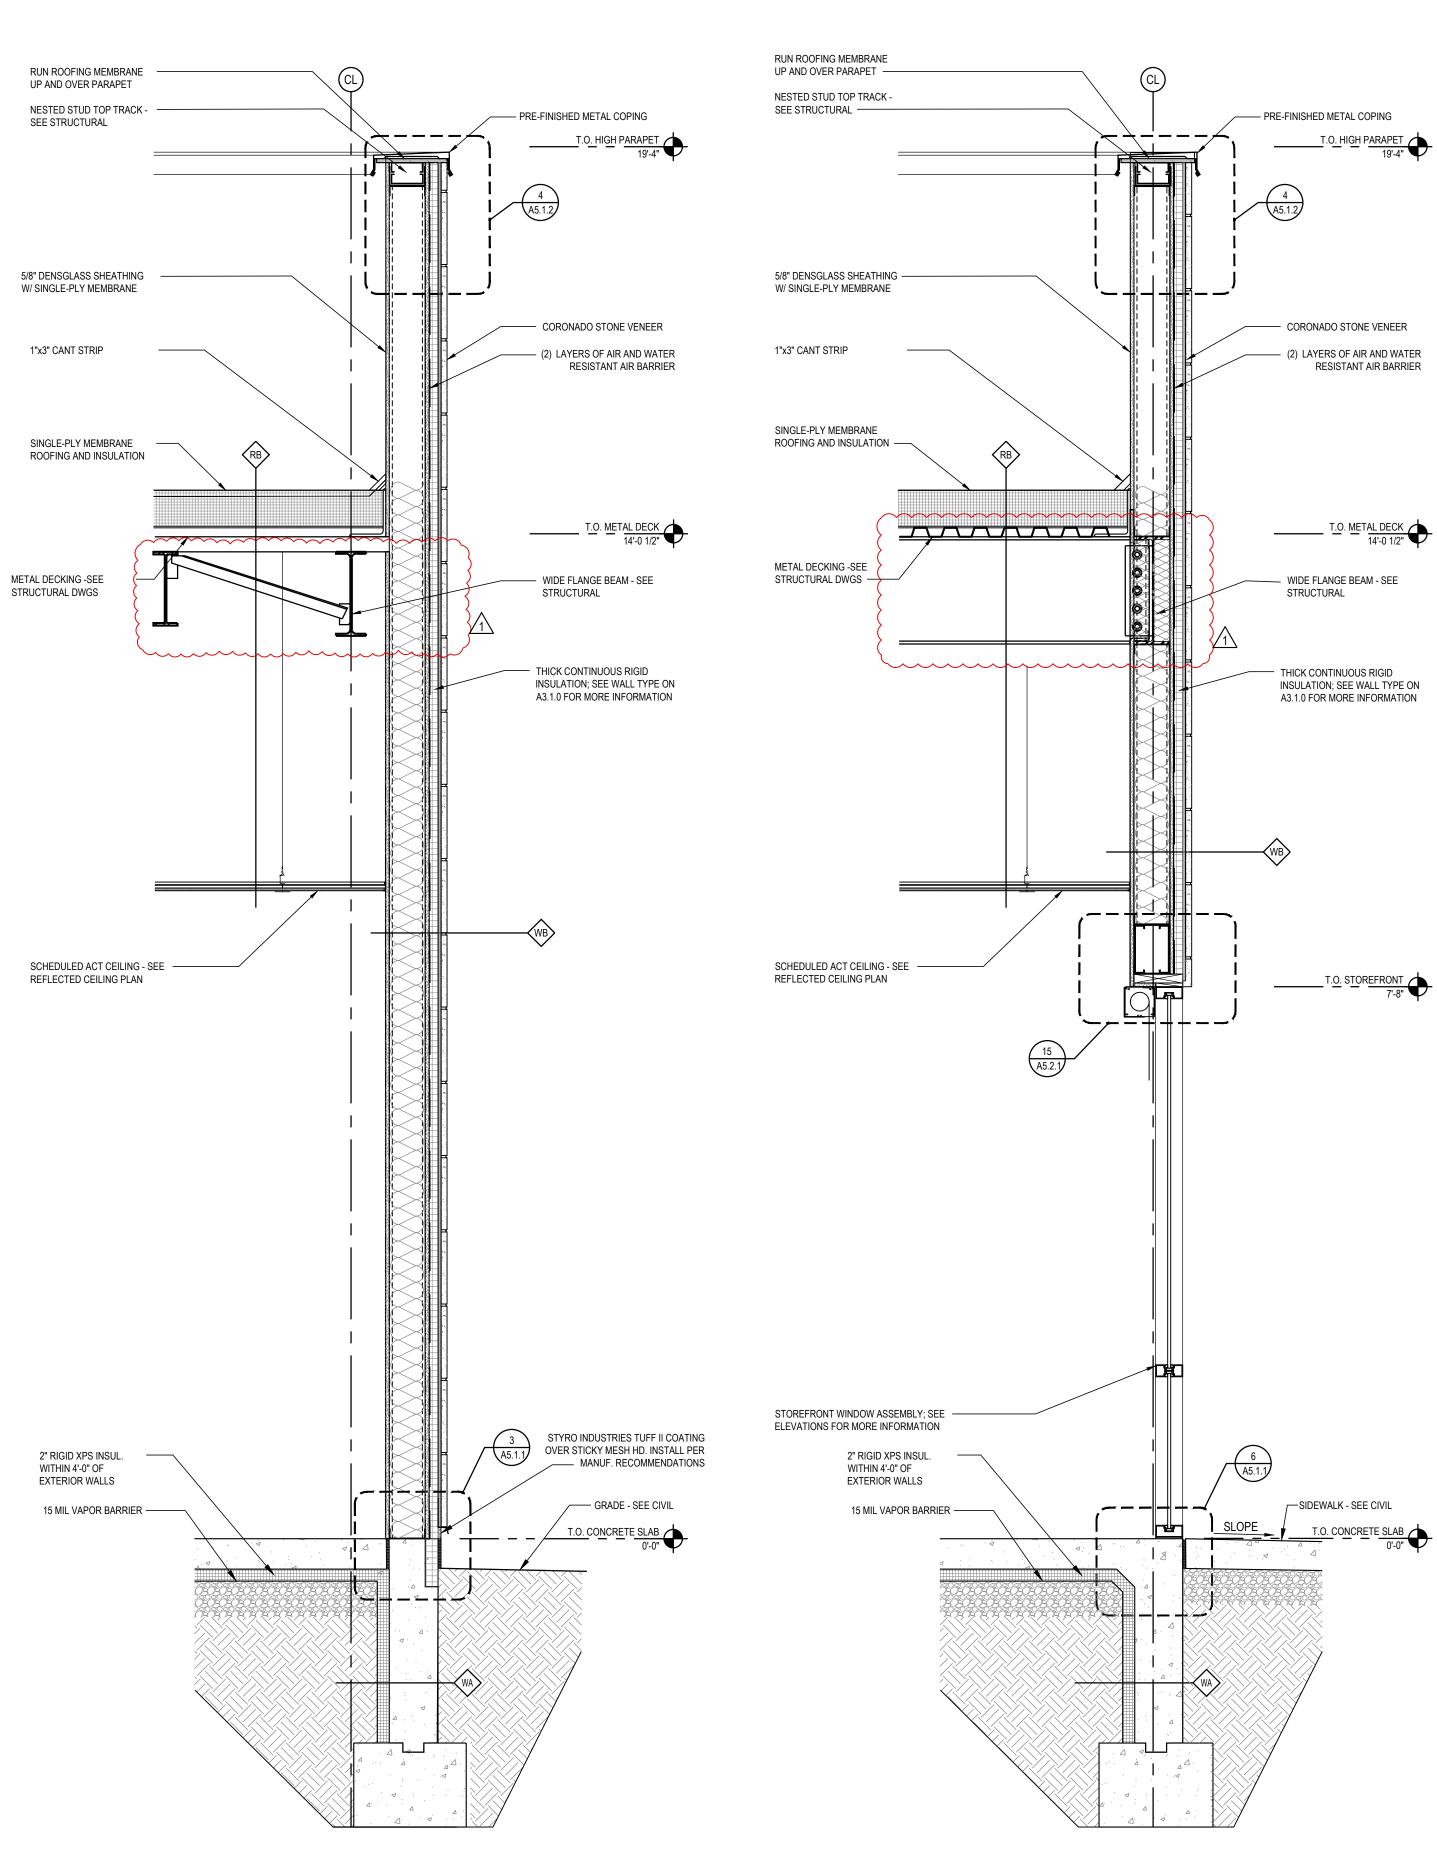

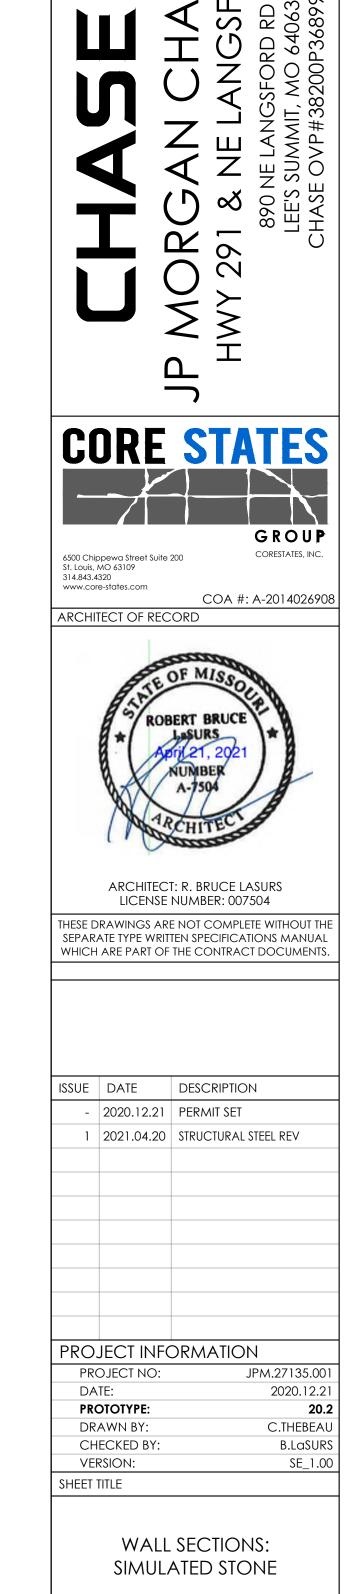


SHEET NUMBER


A4.1.4

2 WALL SECTION AT SIMULATED STONE
A4.1.4 3/4" = 1'-0"


1 WALL SECTION AT SIMULATED STONE / STOP A4.1.4 3/4" = 1'-0"

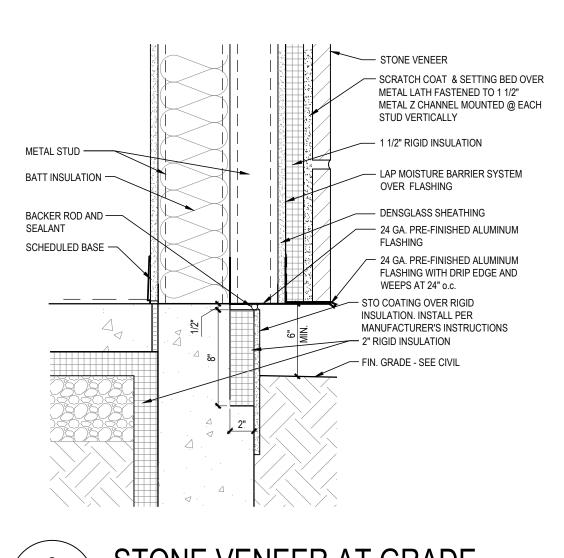




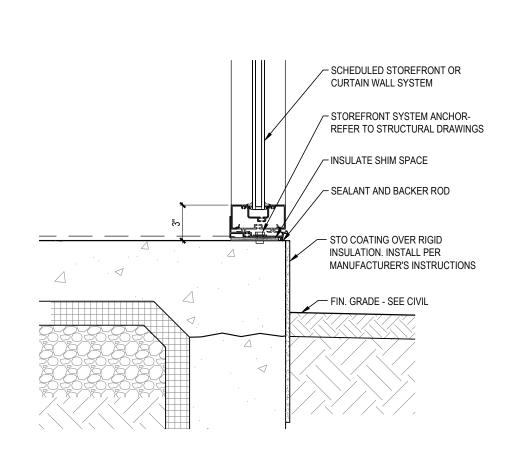




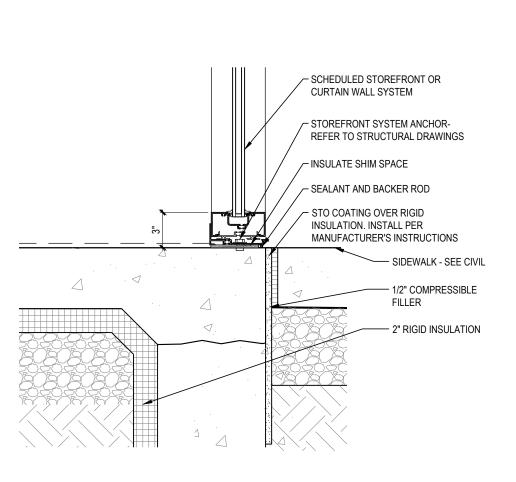




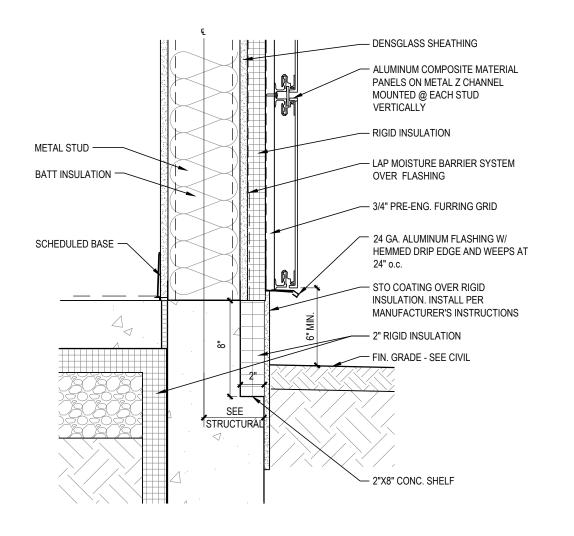




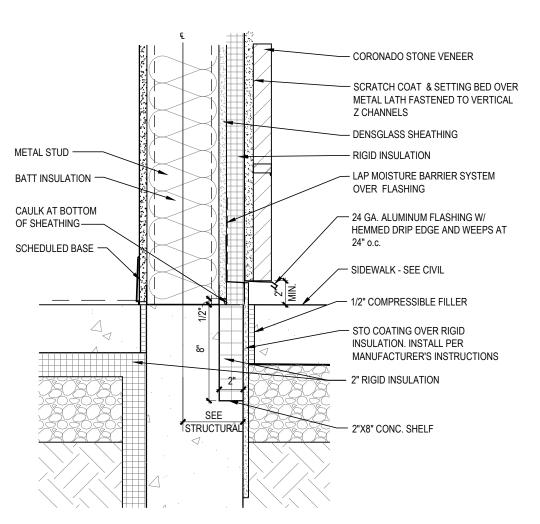




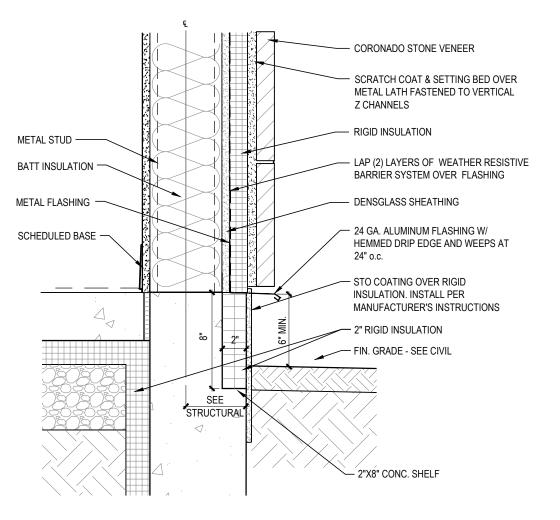



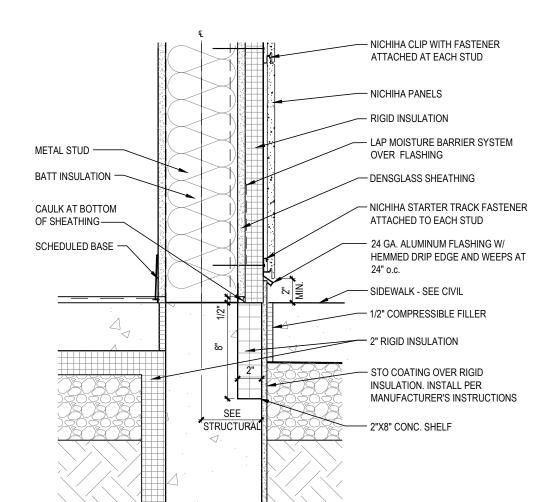



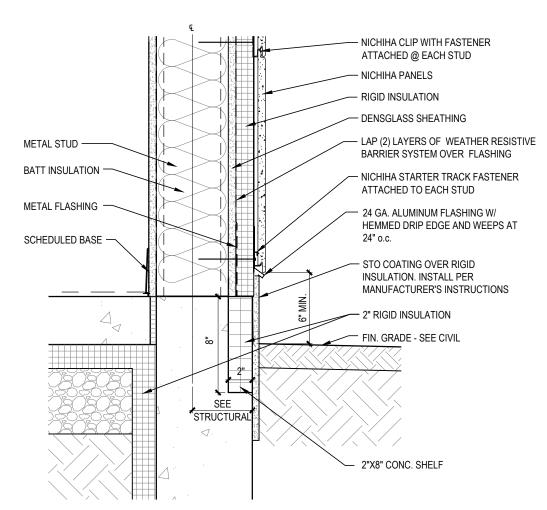

1 NICHIHA PANELS AT GRADE
A5.1.1 11/2" = 1'-0"

JA MORGAN CHASE, N.
HWY 291 & NE LANGSFORD RE
890 NE LANGSFORD RE
1 FF'S SLIMME MO 64063

CORE STATES

GROUP

6500 Chippewa Street Suite 200
St. Louis, MO 63109
314.843.4320
www.core-states.com

COA #: A-2014026908

ARCHITECT OF RECORD

ARCHITECT: R. BRUCE

January 08, 2021

NUMBER

ARCHITECT: R. BRUCE LASURS

LICENSE NUMBER: 007504

THESE DRAWINGS ARE NOT COMPLETE WITHOUT THE

SEPARATE TYPE WRITTEN SPECIFICATIONS MANUAL
WHICH ARE PART OF THE CONTRACT DOCUMENTS.

PRO.	JECT INFO	ORMATION
PRO	DJECT NO:	JPM.27135.001
DA	TE:	2020.12.21
PRO	OTOTYPE:	20.2
DR	AWN BY:	C.THEBEAU
СН	ECKED BY:	B.LaSURS
VER	rsion:	SE_1.00
SHEET 1	TITLE	
		FTAII S·

DESCRIPTION

2020.12.21 PERMIT SET


ISSUE DATE

DETAILS: BUILDING ENVELOPE


SHEET NUMBER

A5.1.1



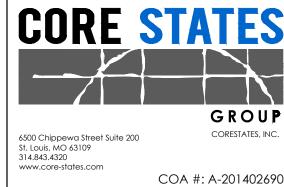

ARCHITECT OF RECORD

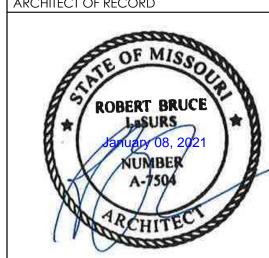

ARCHITECT: R. BRUCE LASURS LICENSE NUMBER: 007504

THESE DRAWINGS ARE NOT COMPLETE WITHOUT THE SEPARATE TYPE WRITTEN SPECIFICATIONS MANUAL WHICH ARE PART OF THE CONTRACT DOCUMENTS.

SSUE	DATE	DESCRIPTION
-	2020.12.21	PERMIT SET


DA		2020.12.21
DD	OJECT NO:	JPM.27135.001
RO.	JECT INFO	ORMATION


1 103201 11 11 01(17)7 (11011	
PROJECT NO:	JPM.27135.001
DATE:	2020.12.21
PROTOTYPE:	20.2
DRAWN BY:	C.THEBEAU
CHECKED BY:	B.LaSURS
VERSION:	SE_1.00
SHEET TITLE	


DETAILS: BUILDING ENVELOPE

SHEET NUMBER

A5.1.2

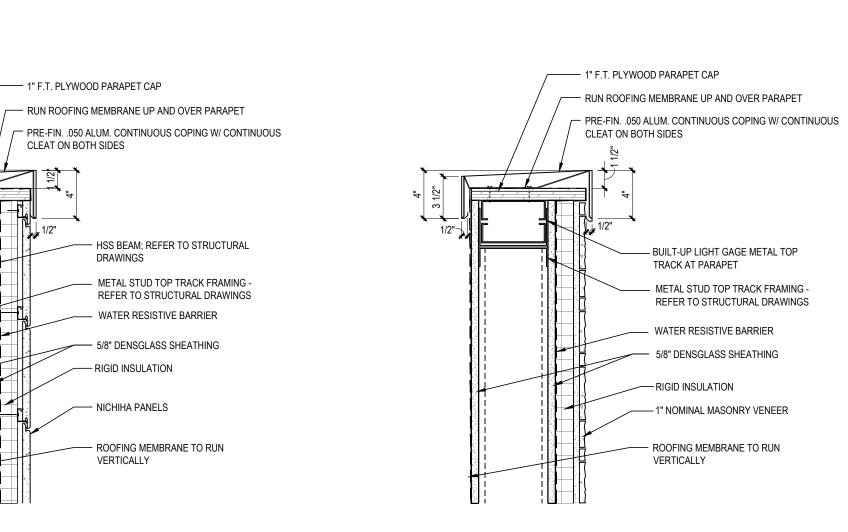

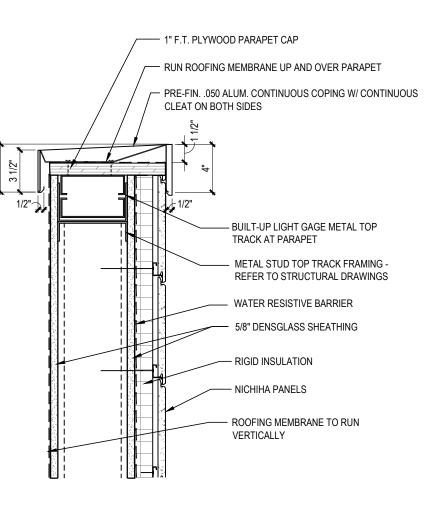

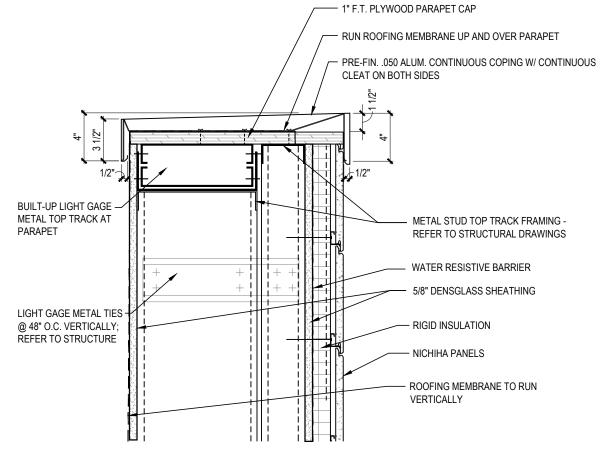







A5.1.2 1 1/2" = 1'-0"

TOWER ROOF PARAPET

1" F.T. PLYWOOD PARAPET CAP


DRAWINGS

- RIGID INSULATION


- NICHIHA PANELS

VERTICALLY

A5.1.2 1 1/2" = 1'-0"

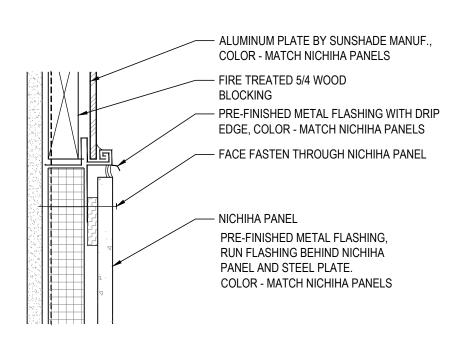



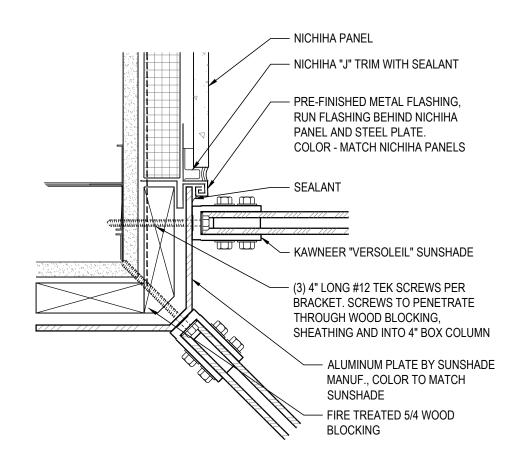



FLASHING AND SEALANT BY G.C.

WATER-TIGHTNESS OF ROOFING

EXTERIOR END OF RACEWAY BY

AS REQUIRED TO MAINTAIN


ELECTRICAL DISCONNECT AT


VENTED METAL RACEWAY

AND CONDUIT TO SIGNAGE BY SIGN INSTALLER -

A5.1.3 1 1/2" = 1'-0"


SIGN INSTALLER -

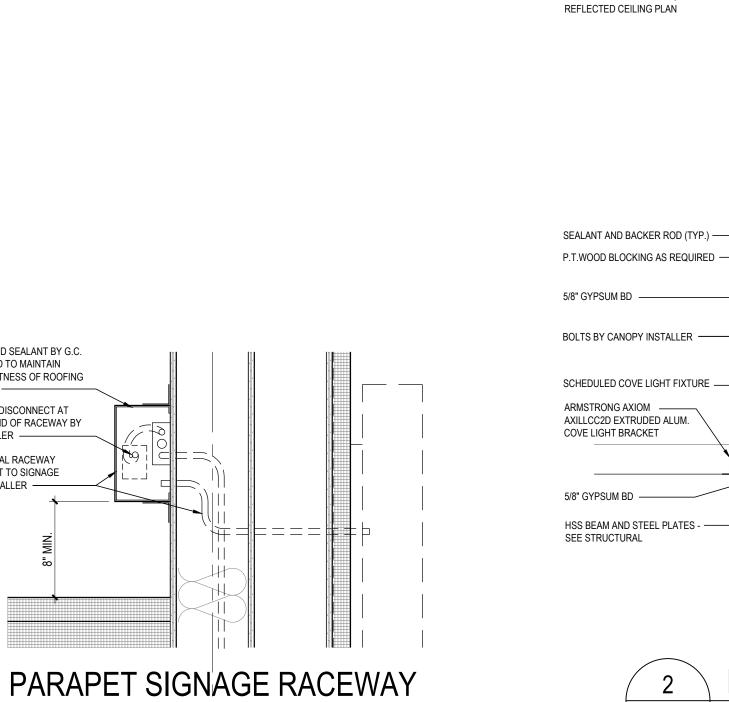


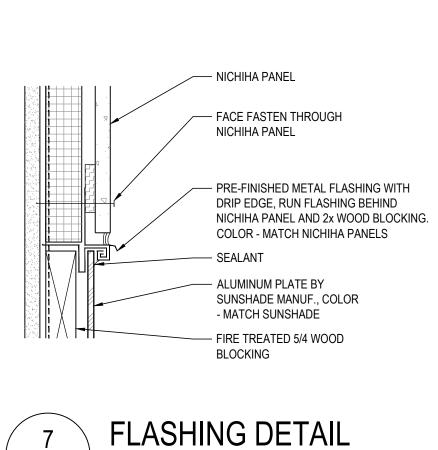

∖A5.1.3*/*

3" = 1'-0"

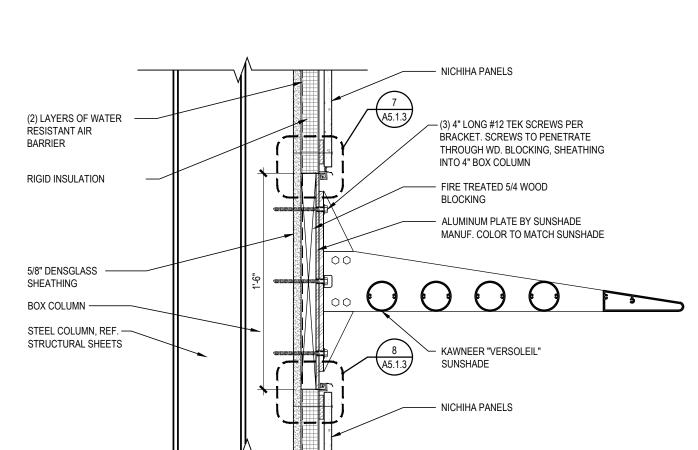

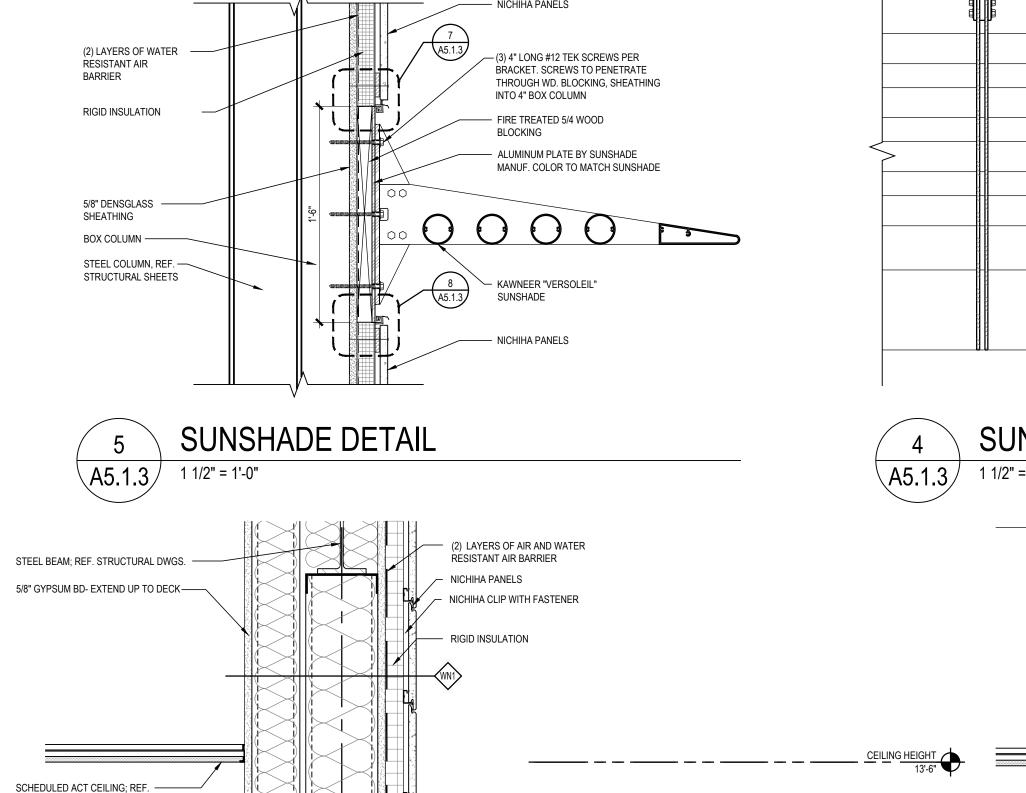

2x PRESSURE TREATED AND FIRE R.

_ 2 LAYERS OF WATER RESISTIVE

- PRE-FIN ALUM. FLASHING MATCH

CANOPY FINISH

NICHIHA CLIP WITH FASTENER

- (2) LAYERS OF AIR AND WATER

RESISTANT AIR BARRIER


NICHIHA PANELS RIGID INSULATION

ENTRANCE CANOPY - RETURN LEG

A5.1.3 1 1/2" = 1'-0"

WOOD BLOCKING (INFILL WALL FLUSH)

DECKING SOFFIT

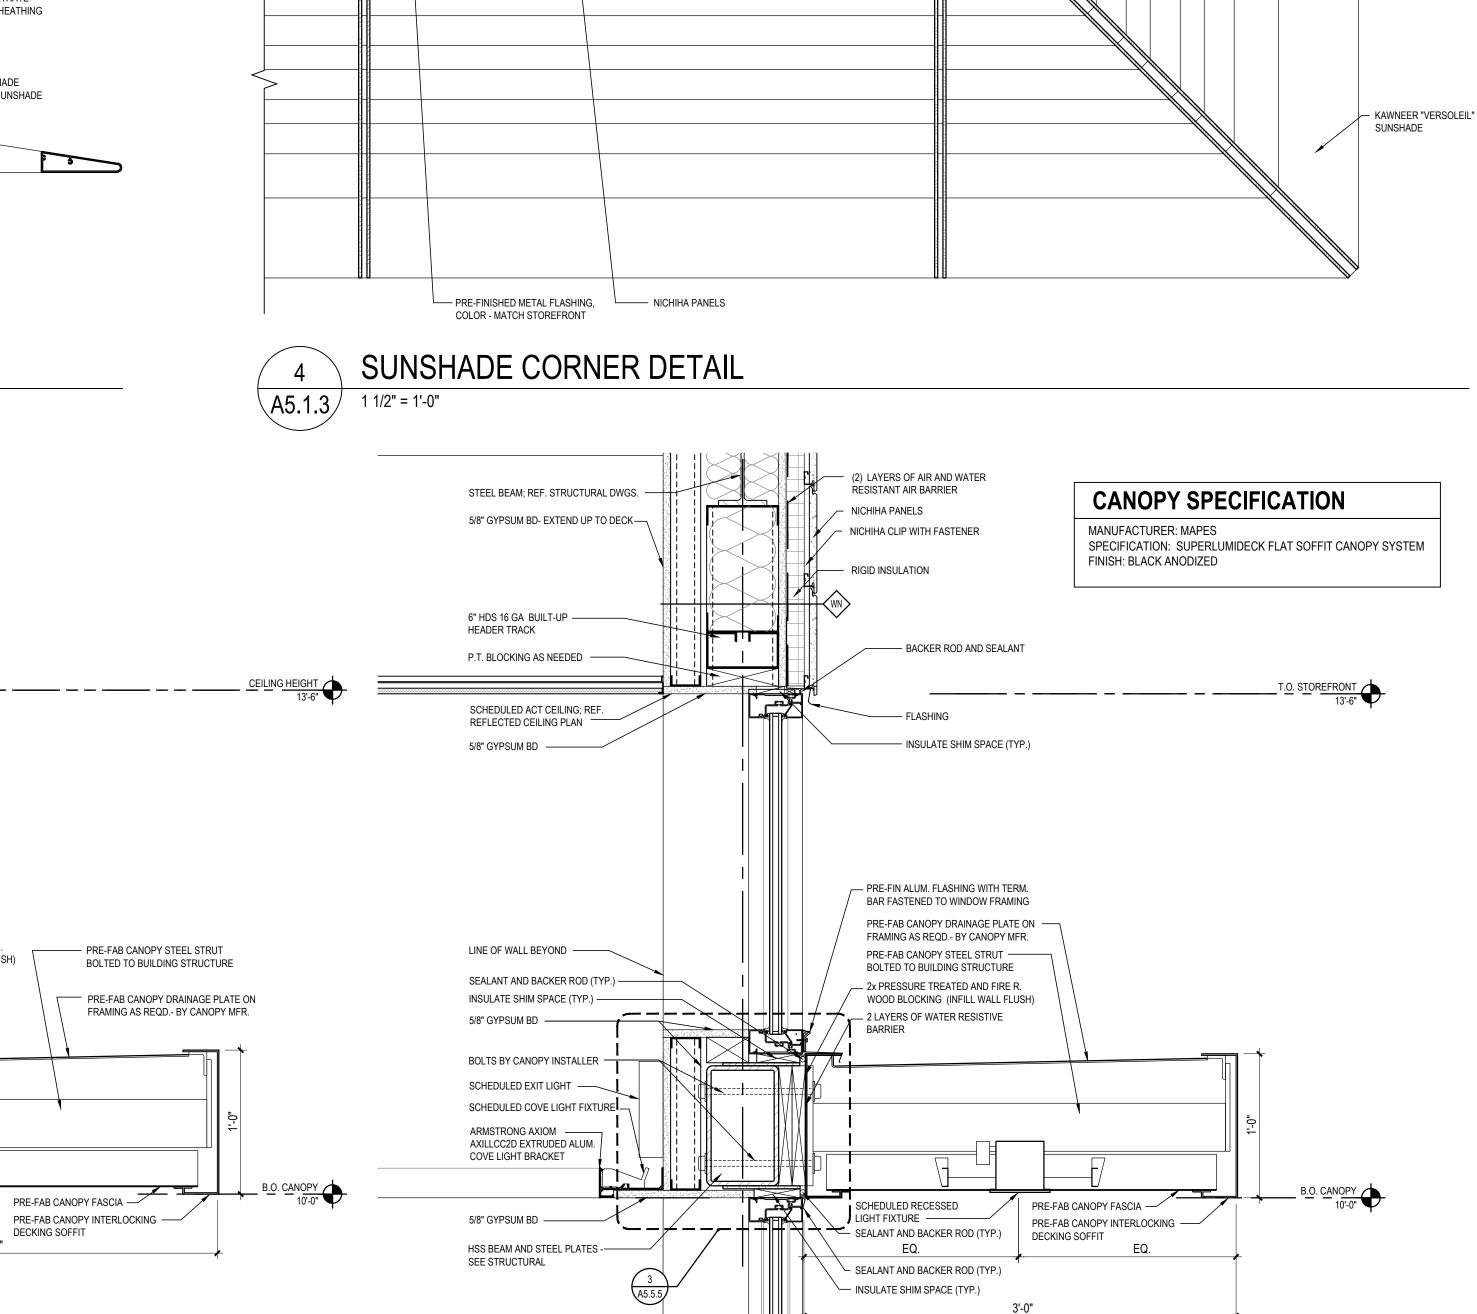

ENTRY VESTIBULE CANOPY

A5.1.3 1 1/2" = 1'-0"

ALUMINUM STOREFRONT —

WINDOW SYSTEM

2x FIRE/ PRESSURE

(2) LAYERS OF WATER

5/8" GYPSUM BOARD —

5/8" DENSGLASS -SHEATHING

4" METAL STUDS @ -

BATT INSULATION —

6" METAL STUDS @ —

STEEL COLUMN, REF.

STRUCTURAL DRAWINGS.

16" O.C.

BOX COLUMN - (2) 4" 12 GA. MTL. STUDS w/ 4" — 12 GA. TRACK, TOP AND BOTTOM. CONNECT

TRACK TO STUD w/ #10 TEK SCREWS @ 12"

O.C. CONNECT TRACK TO STEEL COLUMN w/

(2) 0.157" DIA. PAF'S @ 16" O.C. VERTICAL.

RÉSISTANT AIR BARRIER

SUNSHADE SPECIFICATION

PROFILE: ANGULAR FASCIA AND CIRCULAR BLADES

SPECIFICATION: VERSOLEIL SUNSHADE SYSTEM - 30" WEDGE

(2) LAYERS OF WATER

RESISTANT AIR BARRIER

5/8" DENSGLASS ——

5/8" GYPSUM BOARD -

6" METAL STUDS @ —

BATT INSULATION -

SHEATHING

16" O.C.

MANUFACTURER: KAWNEER

2x FIRE TREATED WOOD —

ALUMINUM STOREFRONT WINDOW SYSTEM

BLOCKING

FINISH: TO MATCH GLAZING SYSTEM

TREATED WOOD BLOCKING



30" KAWNEER "VERSOLEIL"

SUNSHADE OUTRIGGER

PRE-FINISHED METAL

MATCH STOREFRONT

FLASHING, COLOR -

NICHIHA PANELS

- ALUMINUM PLATE BY

SUNSHADE MANUF. COLOR TO MATCH SUNSHADE

FIRE TREATED 5/4 WOOD

BLOCKING

GROUP

6500 Chippewa Street Suite 200 St. Louis, MO 63109 314.843.4320

COA #: A-2014026908 ARCHITECT OF RECORD



ARCHITECT: R. BRUCE LASURS LICENSE NUMBER: 007504

THESE DRAWINGS ARE NOT COMPLETE WITHOUT THE

SEPARATE TYPE WRITTEN SPECIFICATIONS MANUAL WHICH ARE PART OF THE CONTRACT DOCUMENTS.

DESCRIPTION ISSUE DATE 2020.12.21 PERMIT SET


PROJECT INFORMATION


PROJECT NO: JPM.27135.001 2020.12.21 PROTOTYPE: C.THEBEAU DRAWN BY: CHECKED BY: B.LaSURS VERSION: SE_1.00 SHEET TITLE

DETAILS: ENTRANCE CANOPIES AND SUNSHADE


SHEET NUMBER

A5.1.3

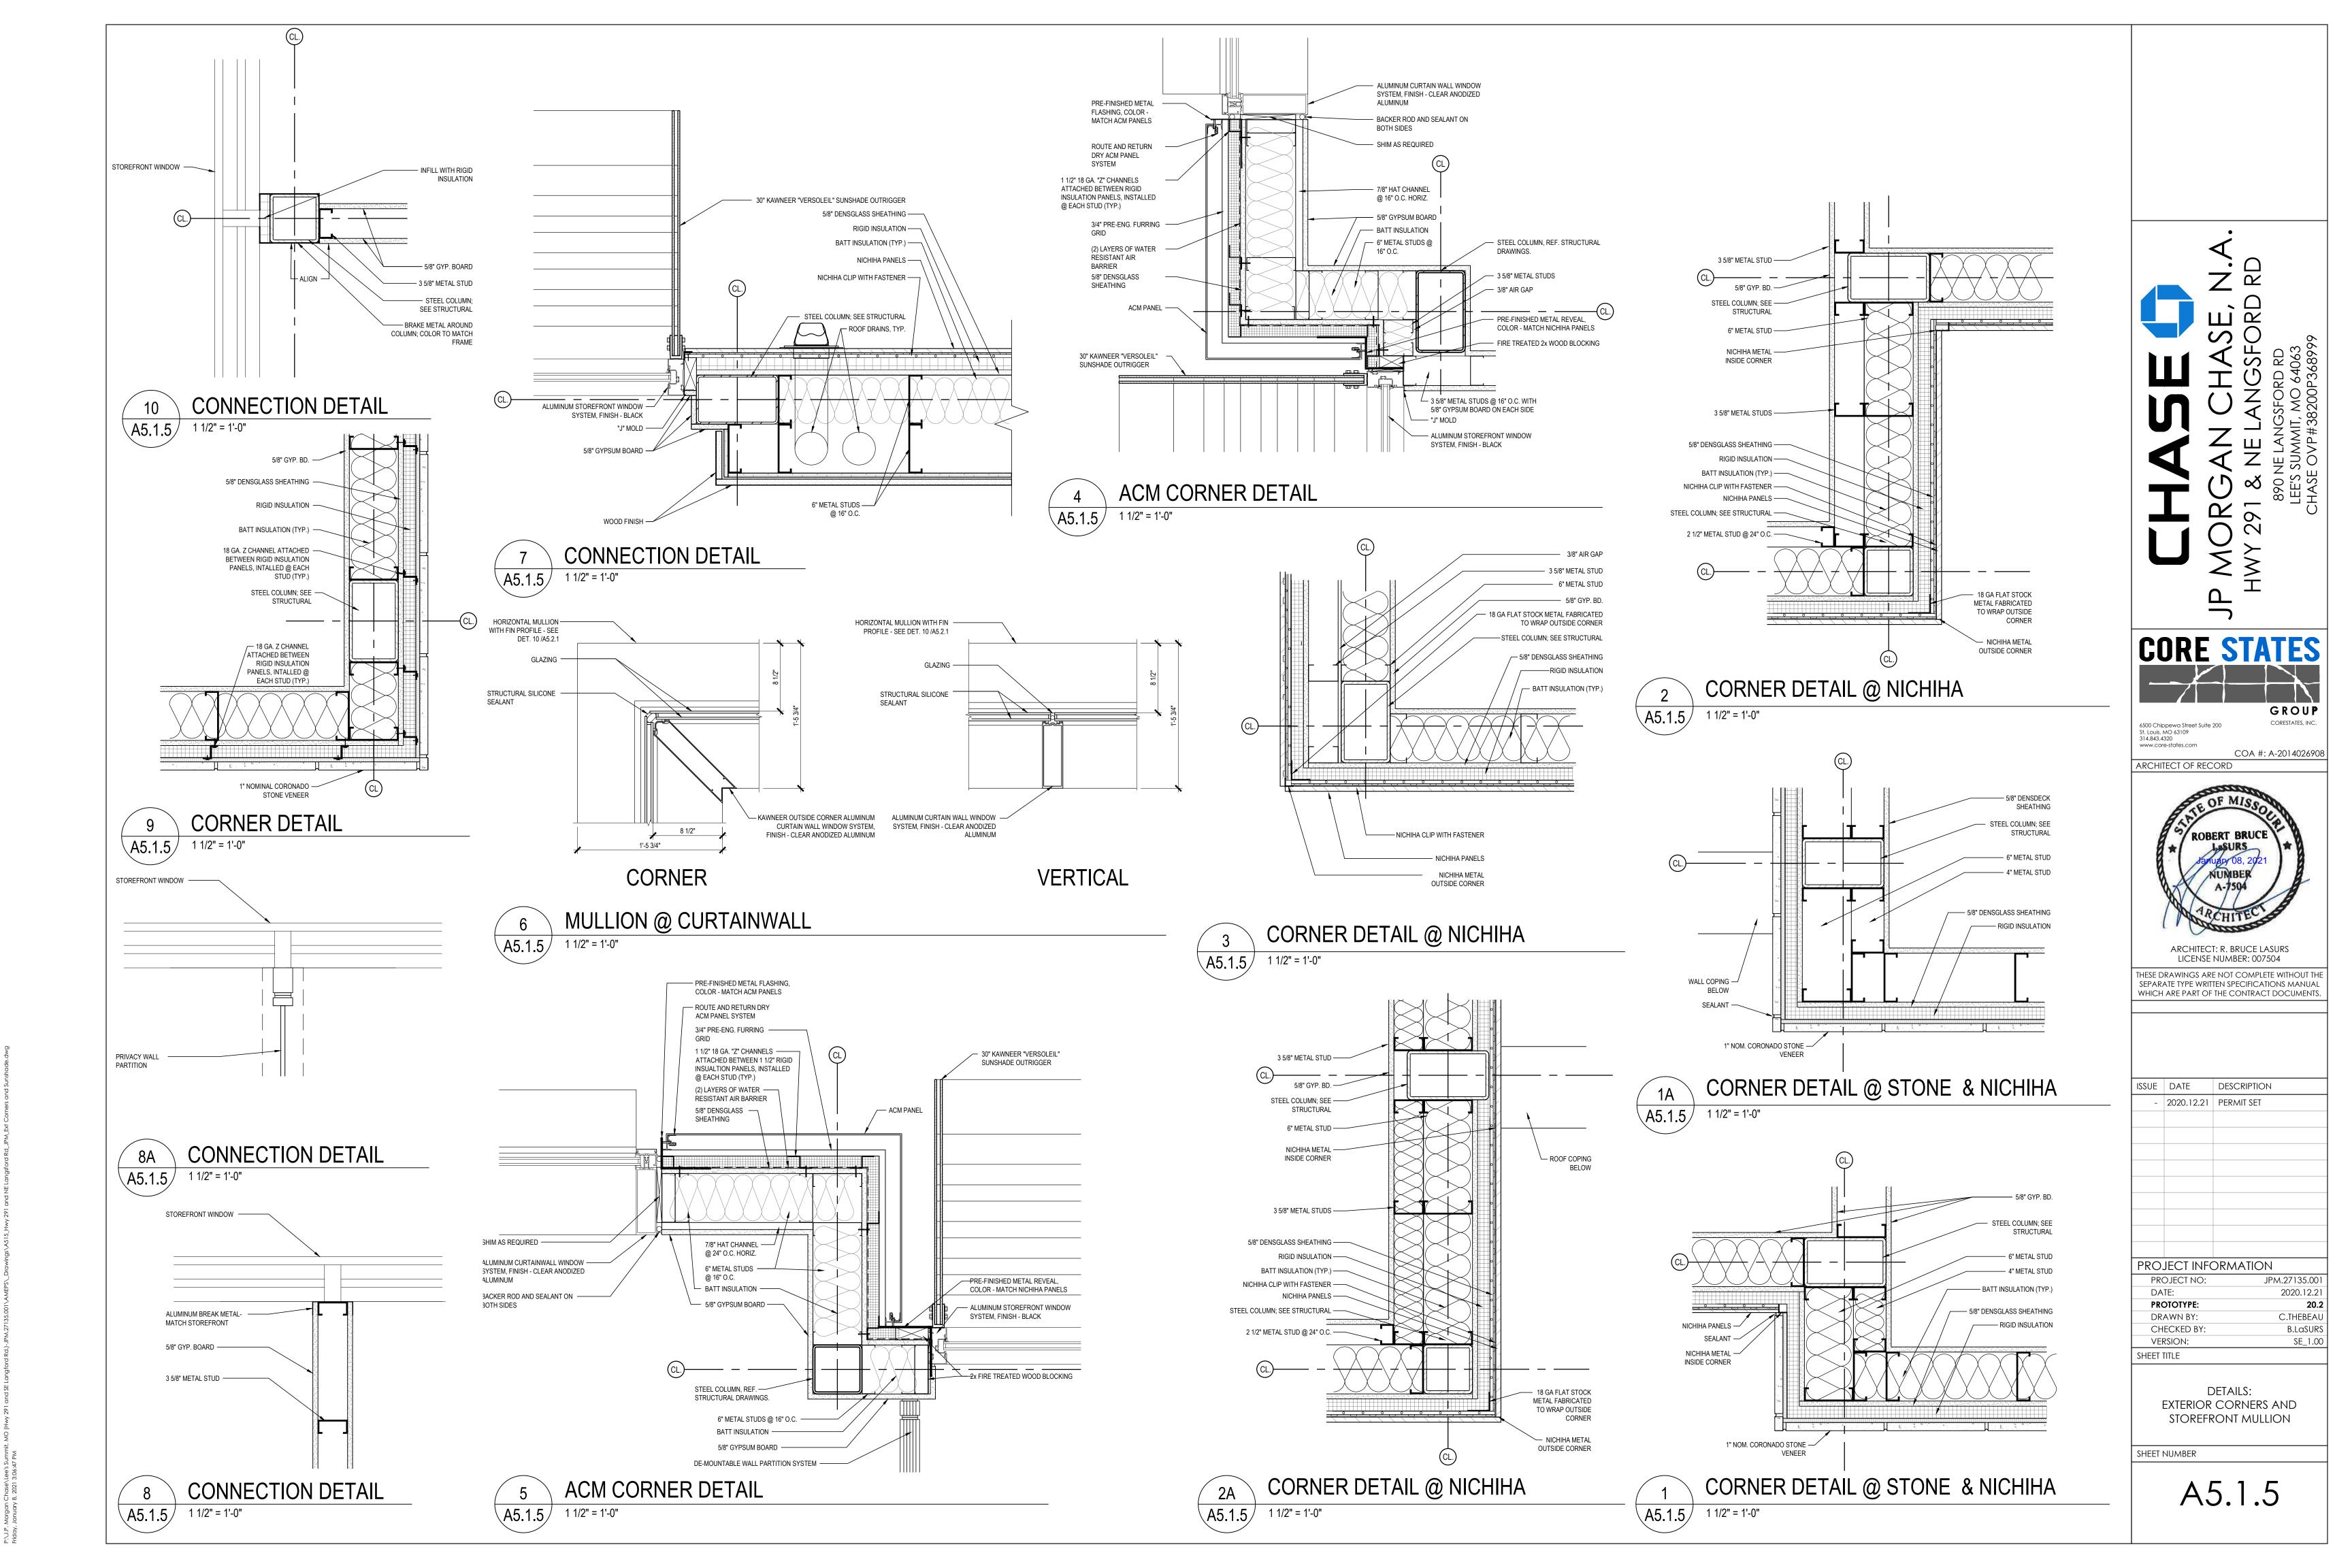


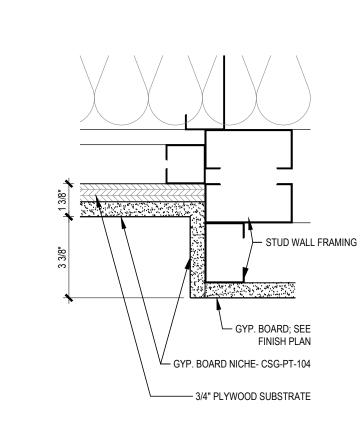


SCREEN NICHE

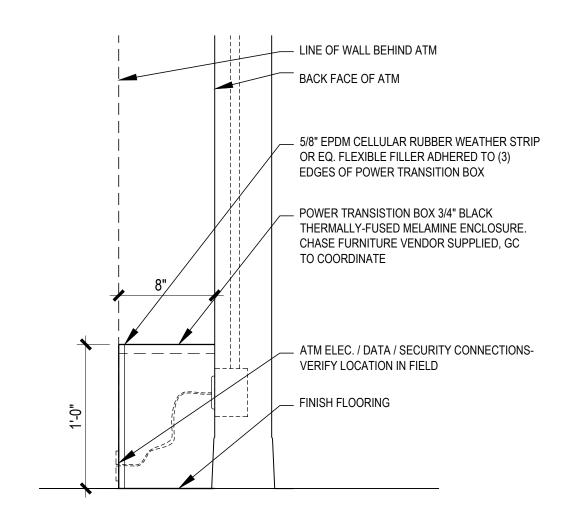

MILLWORK POWER TRANSITION BOX A5.5.2 1 1/2" = 1'=0"

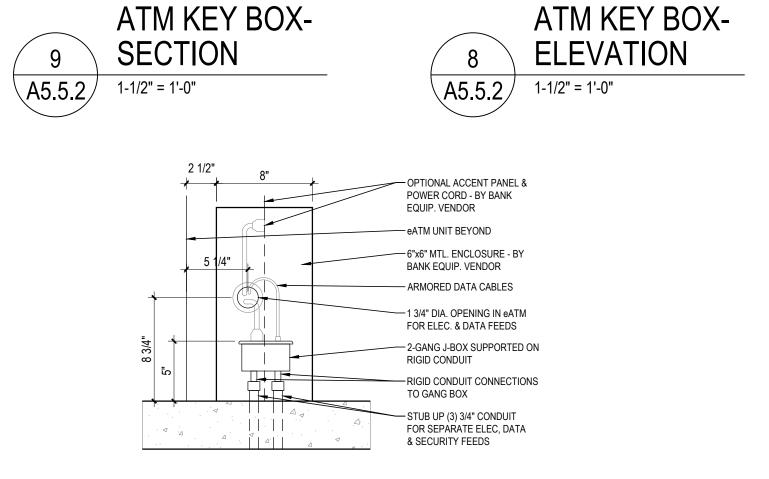

FREESTANDING eATM - ELEC./DATA/ SECURITY ROUGH-INS (VERT.) A5.5.2 1 1/2" = 1'=0"

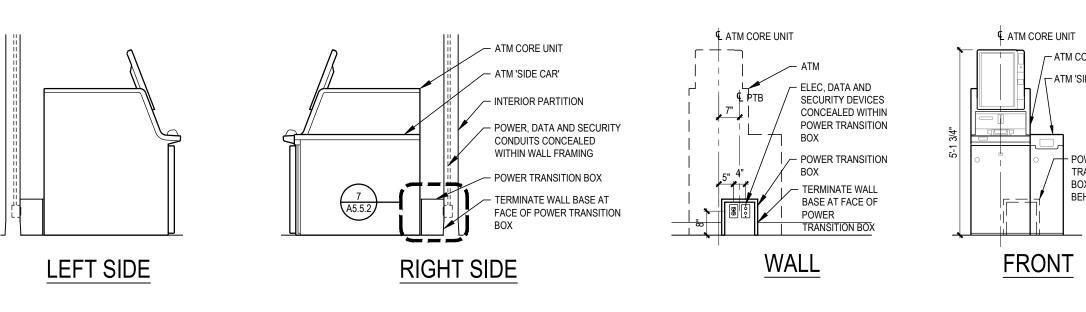

ATM CORE UNIT _ ATM CORE UNIT ATM 'SIDE CAR' ATM CORE UNIT ← ATM 'SIDE CAR' TRANSITION -POWER BOX (PTB) TRANSITION BOX BEHIND ATM - ATM ELEC & DATA CONNECTIONS BACK

ATM v3.0 ELEVATIONS A5.5.2 3/8" = 1'-0"

BLOCK-OUT AREA

ATM CORE UNIT

ATM v3.0


A5.5.2 3/8" = 1'-0"

- JUNCTION BOX ENCLOSURE AND


MOUNTING CLIP BY ATM VENDOR

REQUIRED TO PRECEISELY POSITION


FREESTANDING PLAN

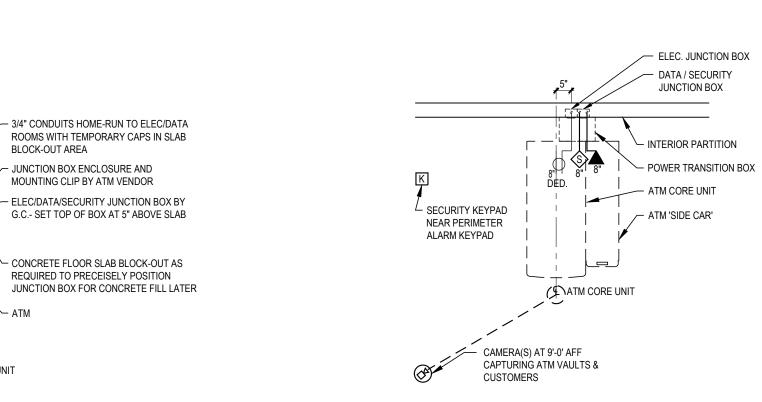


ATM v3.0 ELEC./DATA/SEC. PLAN A5.5.2 3/8" = 1'-0"

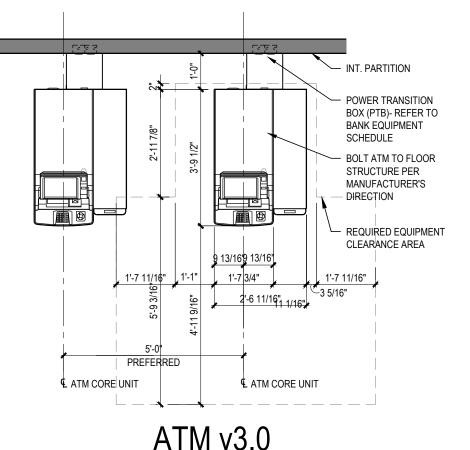

ATM v3.0 FLOOR PLAN A5.5.2 3/8" = 1'-0"

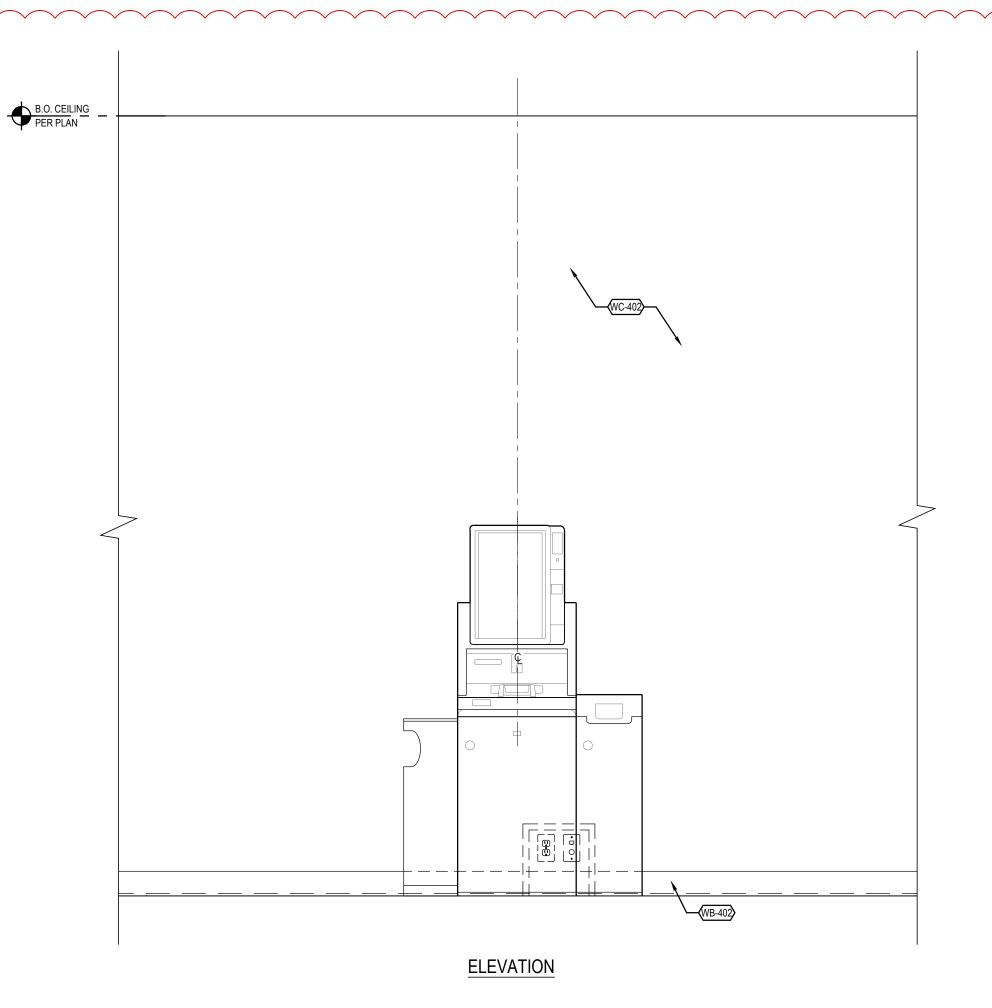

A5.5.2 3/4" = 1'-0"

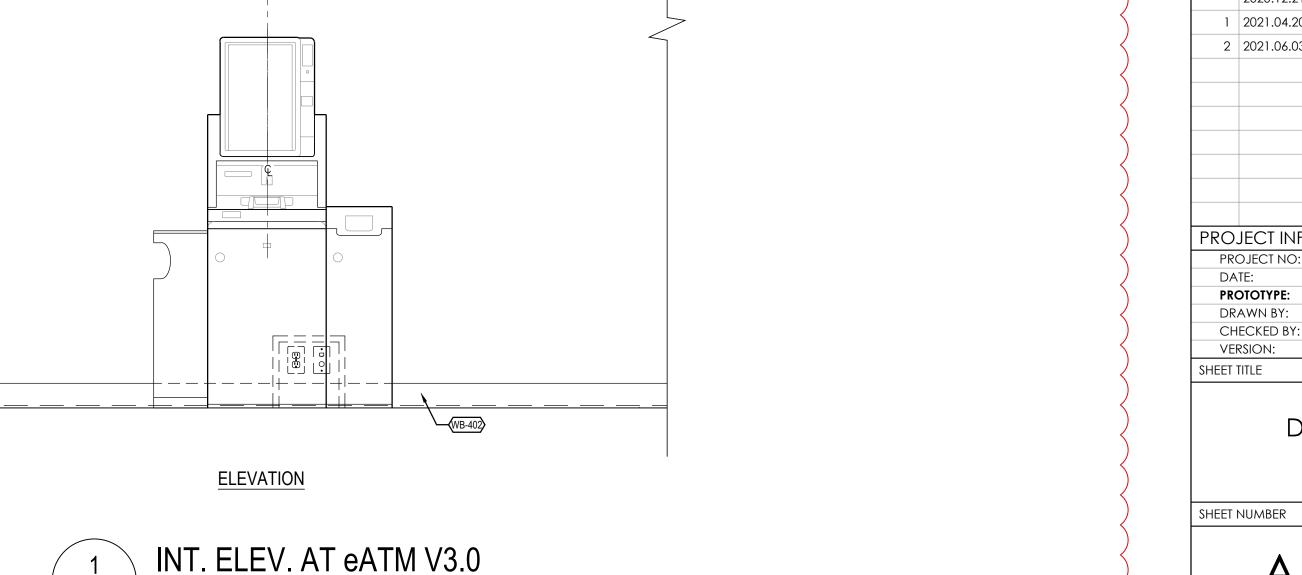

GROUP 6500 Chippewa Street Suite 200 St. Louis, MO 63109 314.843.4320

COA #: A-2014026908 ARCHITECT OF RECORD



ARCHITECT: R. BRUCE LASURS LICENSE NUMBER: 007504 THESE DRAWINGS ARE NOT COMPLETE WITHOUT THE SEPARATE TYPE WRITTEN SPECIFICATIONS MANUAL


WHICH ARE PART OF THE CONTRACT DOCUMENTS.


DESCRIPTION ISSUE DATE - 2020.12.21 PERMIT SET 1 2021.04.20 STRUCTURAL STEEL REV 2 2021.06.03 PLAN REVIEW COMMENTS, RDC21 & WIRELESS UPDATE

PROJECT INFORMATION JPM.27135.001 2020.12.21 C.THEBEAU B.LaSURS SE_1.00


> **DETAILS:** ATM

A5.5.2

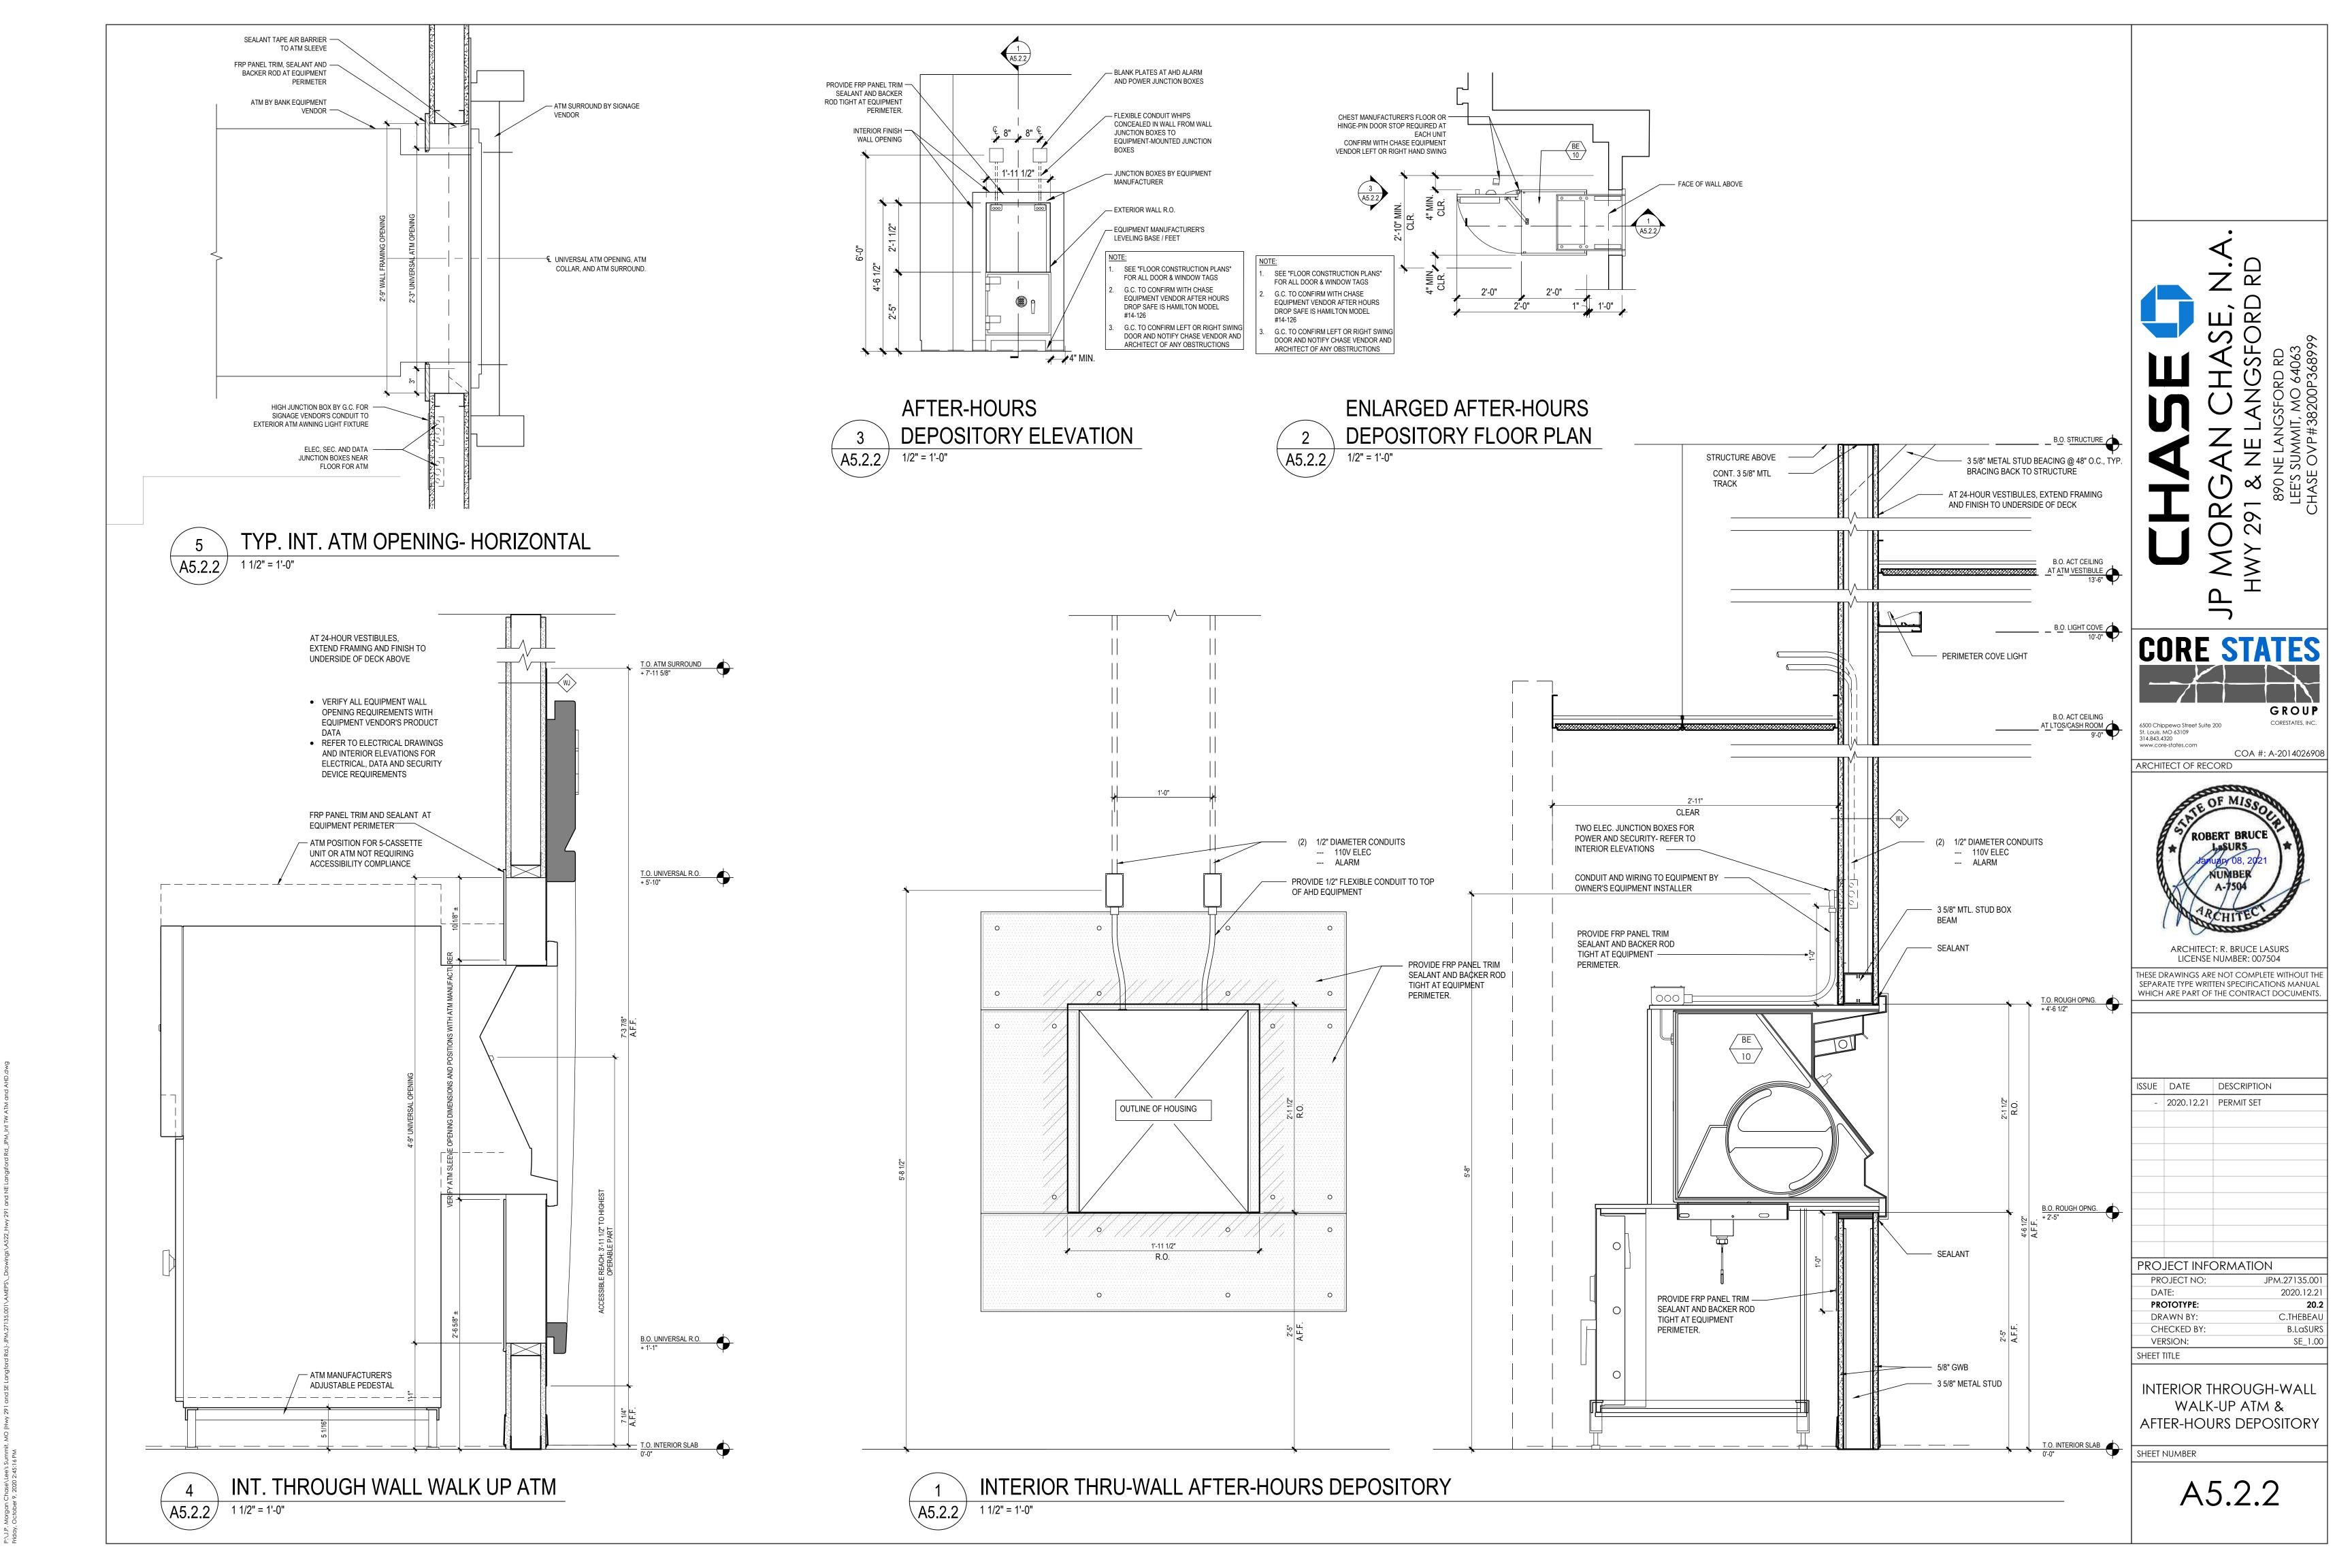


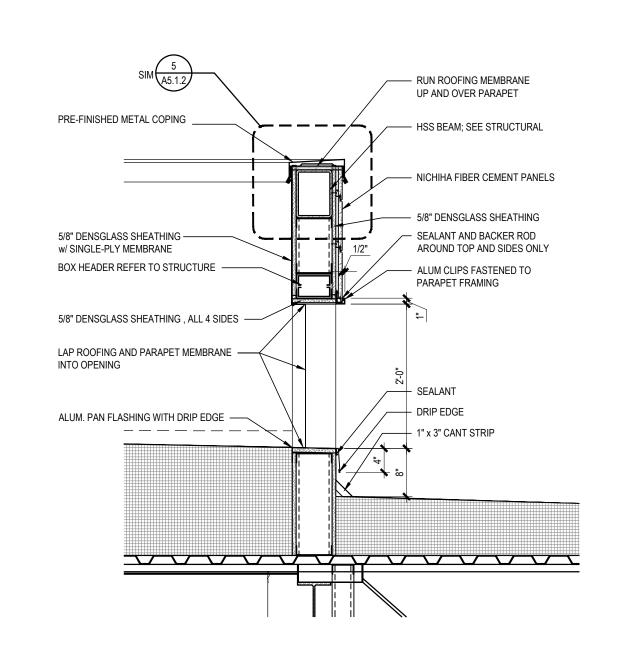




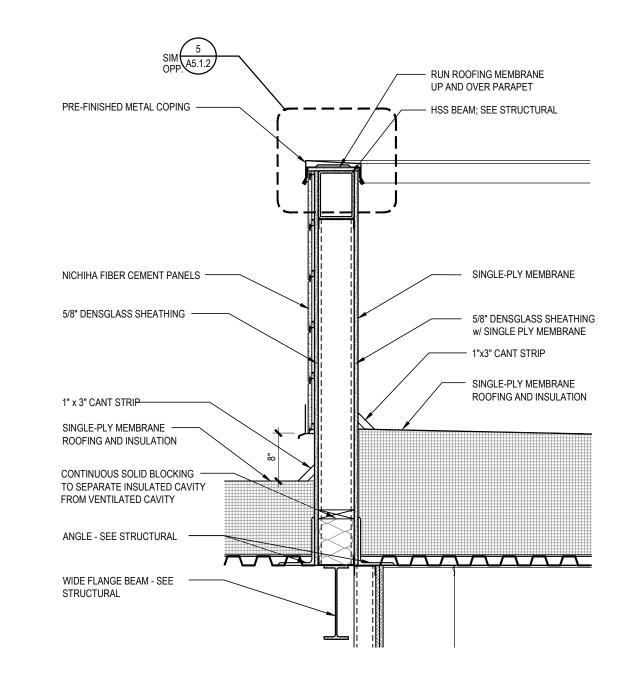





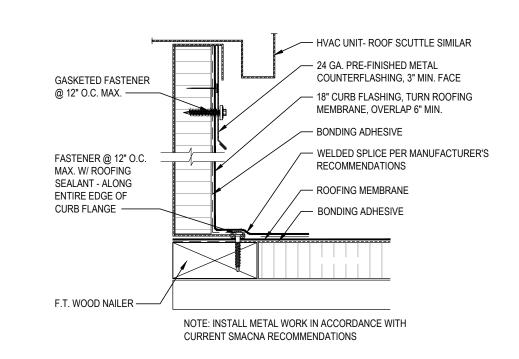




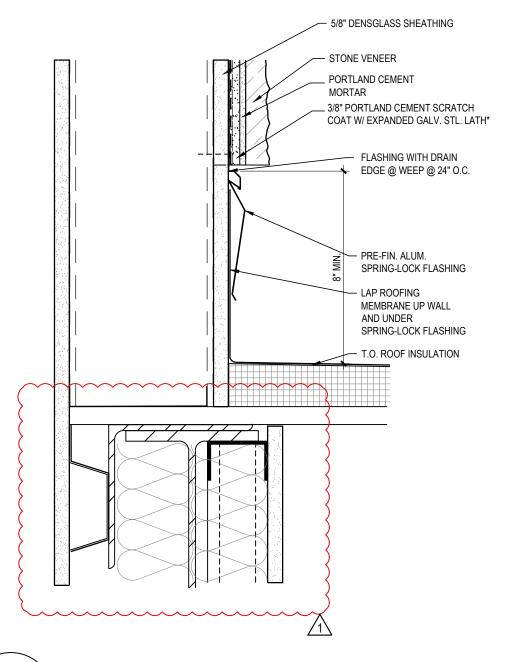

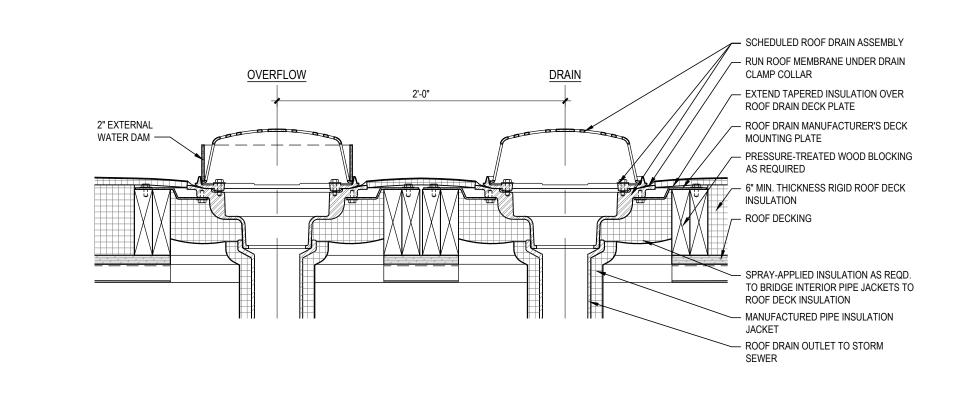

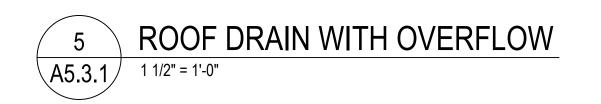

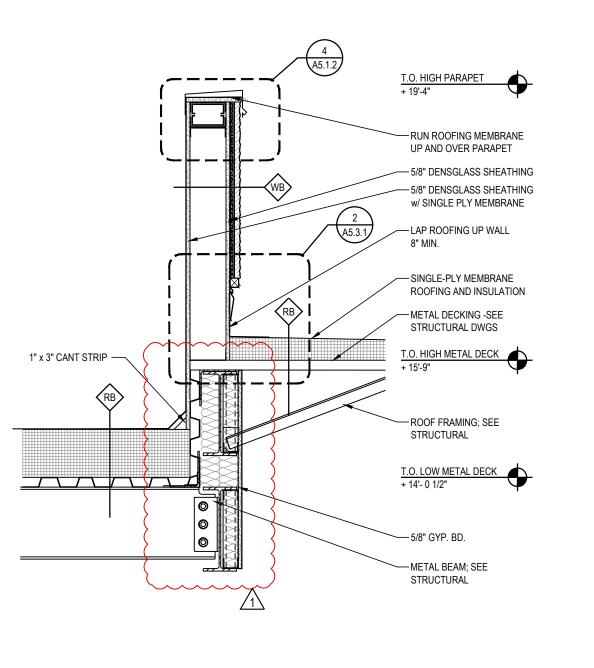







St. Louis, MO 63109
314.843.4320
www.core-states.com

COA #: A-201402690

ARCHITECT OF RECORD



ARCHITECT: R. BRUCE LASURS
LICENSE NUMBER: 007504

THESE DRAWINGS ARE NOT COMPLETE WITHOUT THE
SEPARATE TYPE WRITTEN SPECIFICATIONS MANUAL
WHICH ARE PART OF THE CONTRACT DOCUMENTS.

ISSUE DATE DESCRIPTION					
-	2020.12.21	PERMIT SET			
1	2021.04.20	STRUCTURAL STEEL REV			
PRO.	JECT INFO	DRMATION			
PRO	OJECT NO:	JPM.27135.001			
D.4	тг.	2020 12 2			

PROJECT INFORMATION

PROJECT NO: JPM.27135.001

DATE: 2020.12.21

PROTOTYPE: 20.2

DRAWN BY: C.THEBEAU

CHECKED BY: B.LaSURS


VERSION: SE_1.00

SHEET TITLE


DETAILS: ROOF


SHEET NUMBER


A5.3.1

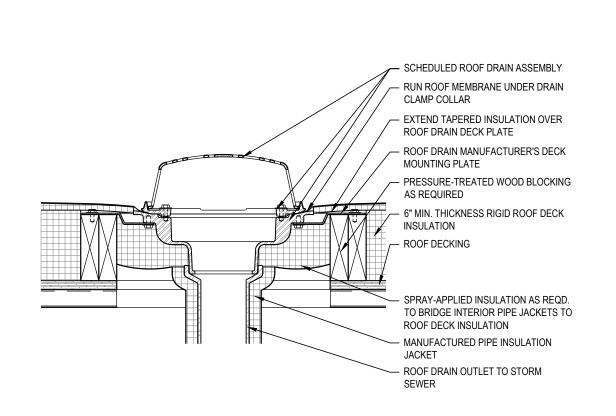


4 TYPICAL ROOF DRAIN
A5.3.1 11/2" = 1'-0"

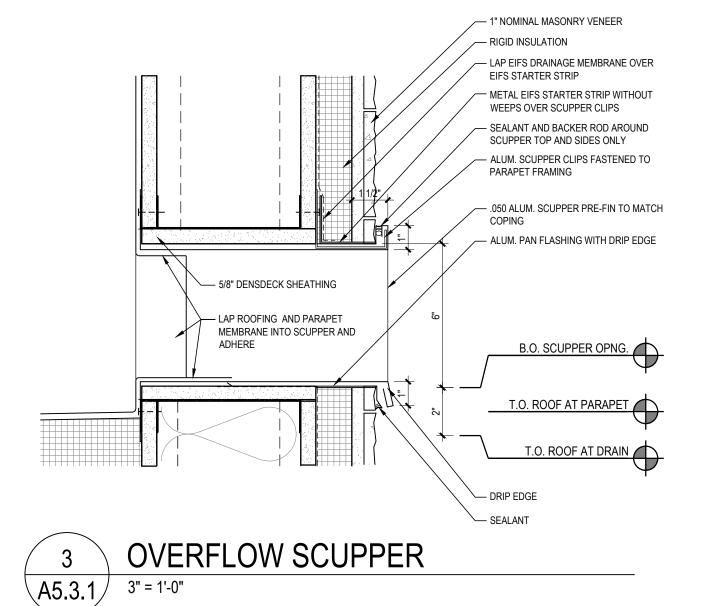

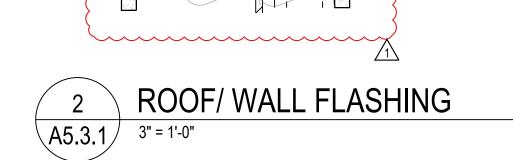


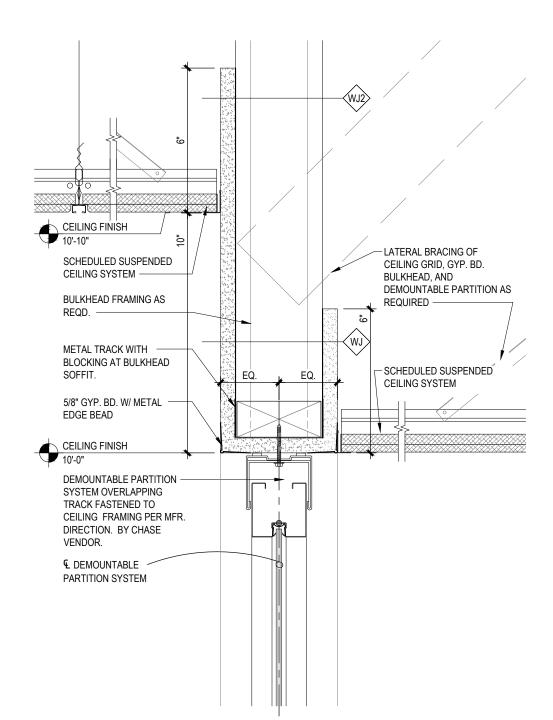

TYP. OFFICE / LOBBY AT DEMOUNTABLE PARTITION - CENTERED A5.3.3 3" = 1'-0"

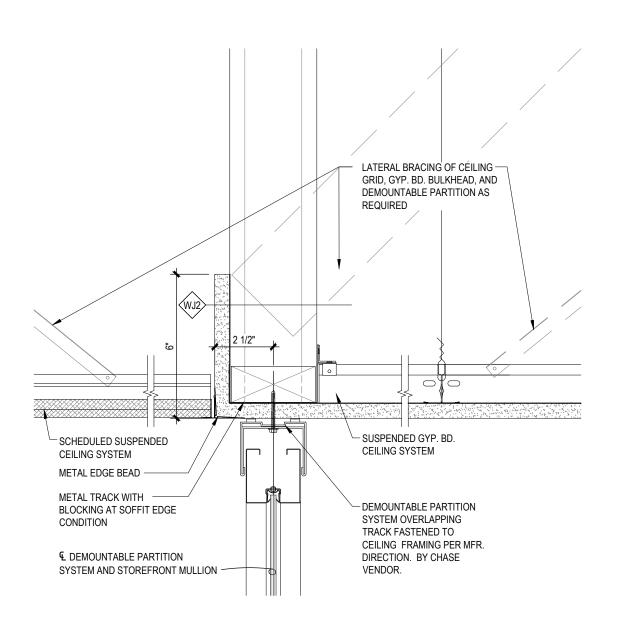


TYP. OFFICE / CONFERENCE AT DEMOUNTABLE PARTITION A5.3.3 3" = 1'-0"

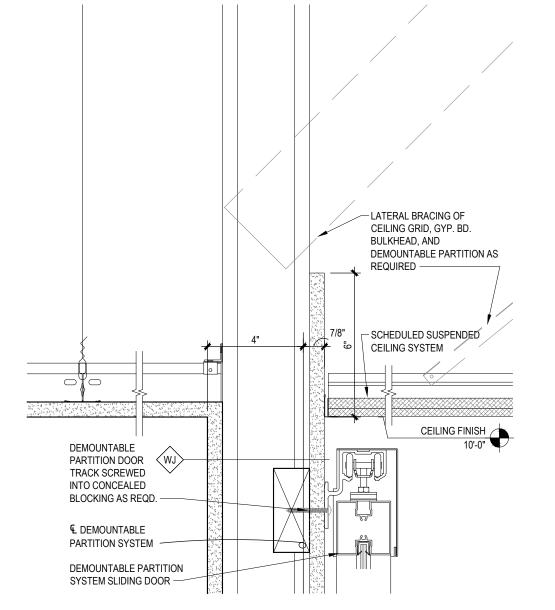


DEMOUNTABLE PARTITION SLIDING DOOR TRACK A5.3.3 3" = 1'-0"



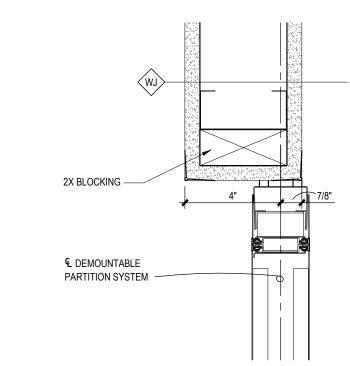


TYP. GYPSUM JAMB AT DEMOUNTABLE PARTITION

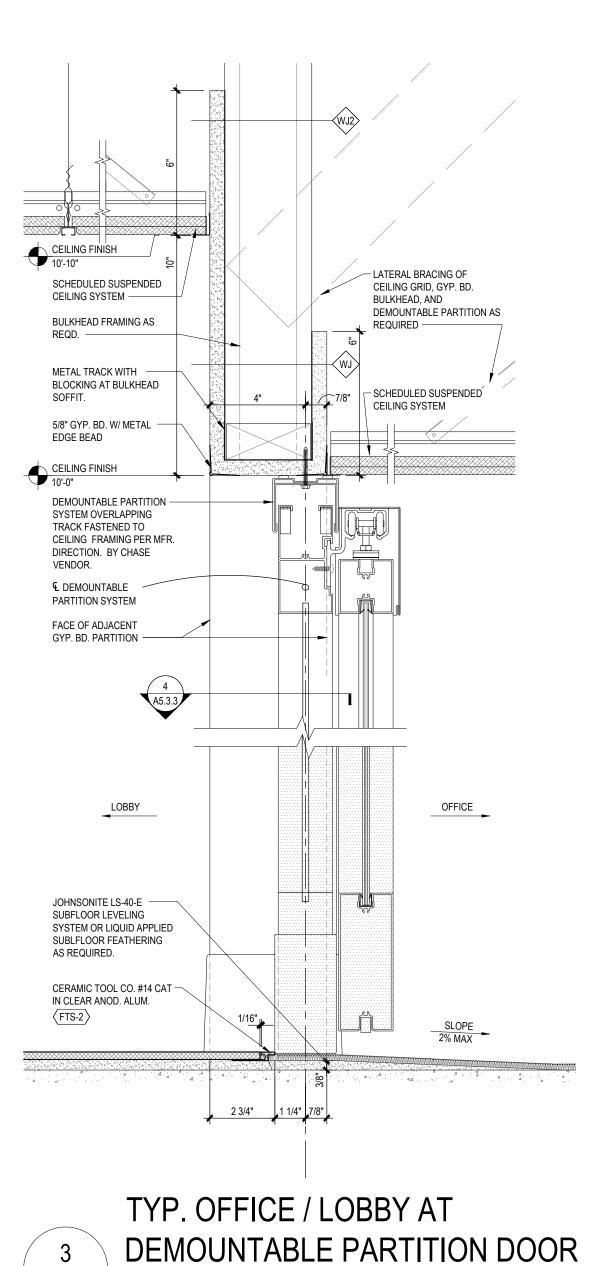


A5.3.3 3" = 1'-0"



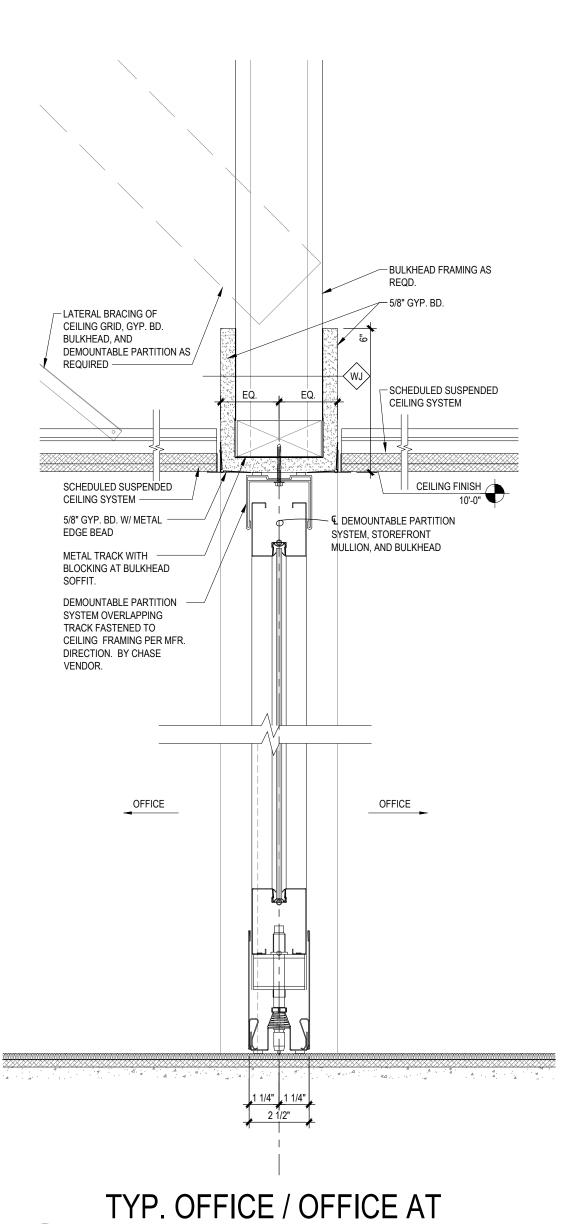



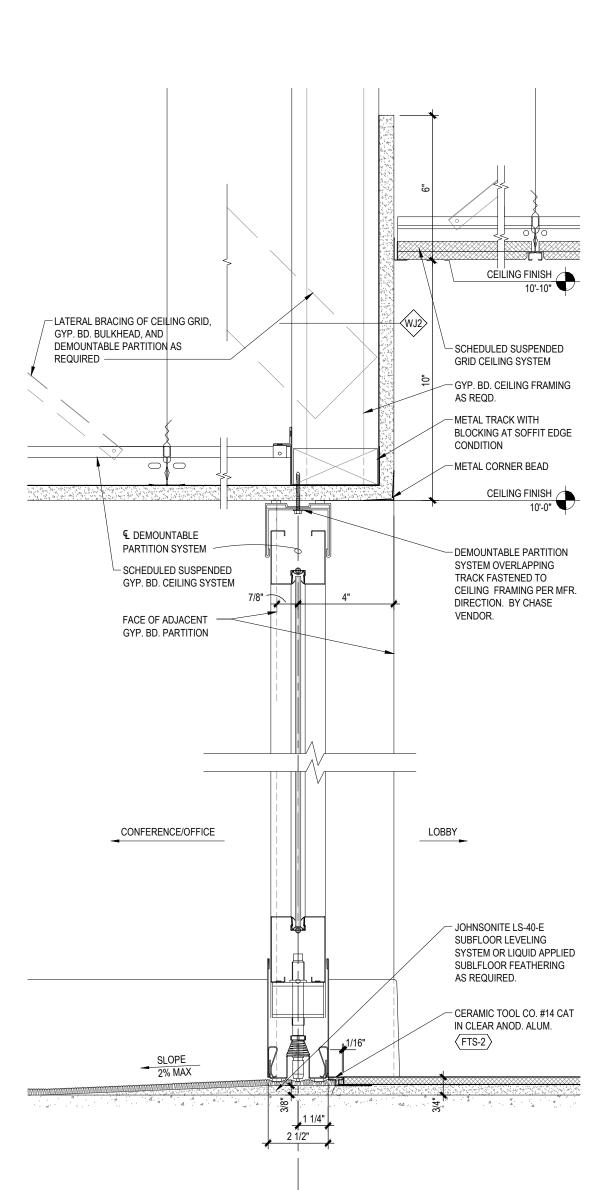

TYP. CONFERENCE / LOBBY AT **DEMOUNTABLE PARTITION**

CORES	TATES
6500 Chippewa Street Suite 200 St. Louis, MO 63109 314,843420 www.core-states.com	GROUP CORESTATES, INC.
ARCHITECT OF RECORD	MISSOLIA
ROBERT	BRUCE JRS 08, 2021 BER 504
ARCHITECT: R. E LICENSE NUM THESE DRAWINGS ARE NOT	BER: 007504
SEPARATE TYPE WRITTEN SI WHICH ARE PART OF THE C	

PRO.	JECT INFO	ORMATION
PRO	OJECT NO:	JPM.27135.001
DA	TE:	2020.12.21
PRO	OTOTYPE:	20.2
DR.	AWN BY:	C.THEBEAU
СН	ECKED BY:	B.LaSURS
VFI	52I∪NI·	SF 1.00

DESCRIPTION

2020.12.21 PERMIT SET

INTERIOR DETAILS: DEMOUNTABLE PARTITIONS CEILING TRANSITIONS


SHEET NUMBER

SHEET TITLE


ISSUE DATE

A5.3.3


ROOF SCUTTLE LADDER- SECTION A5.4.1 3" = 1'-0"

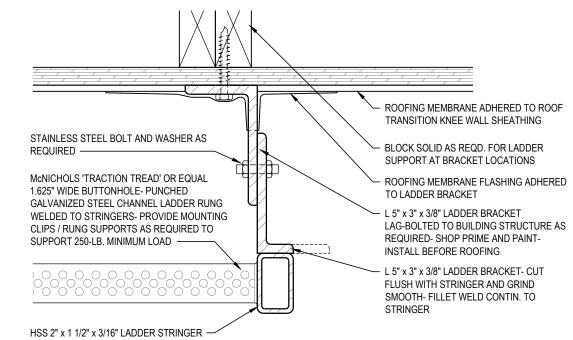


4 ROOF TRANSITION LADDER- SECTION A5.4.1 3" = 1'-0"

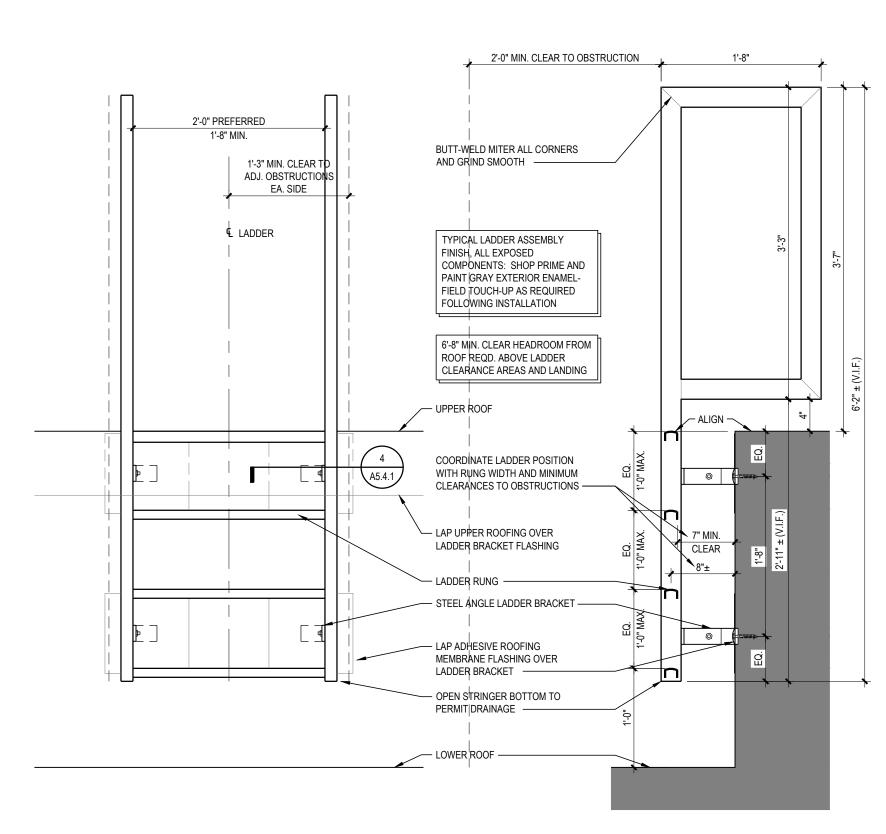



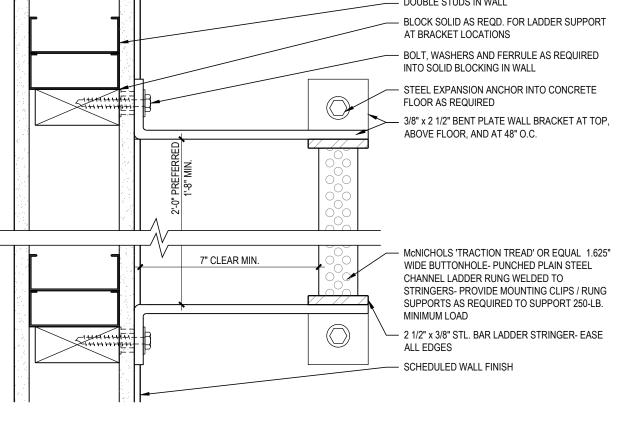



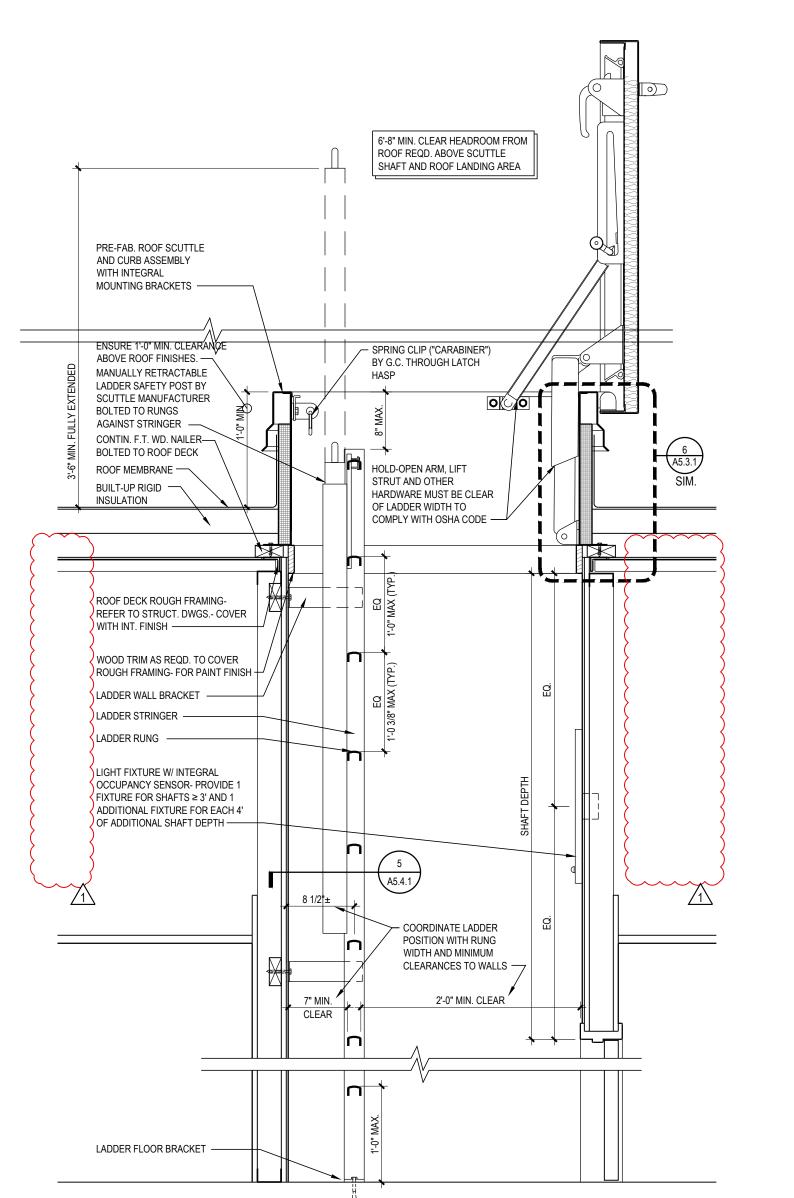

NOTE: ALL WOOD BLOCKING & PLYWOOD SHALL BE FIRE-TREATED.

ROOF SCUTTLE & LADDER - SECTION

GROUP CORESTATES, INC. 6500 Chippewa Street Suite 200 St. Louis, MO 63109 314.843.4320 COA #: A-2014026908 ARCHITECT OF RECORD

ROBERT BRUCE

ARCHITECT: R. BRUCE LASURS LICENSE NUMBER: 007504 THESE DRAWINGS ARE NOT COMPLETE WITHOUT THE SEPARATE TYPE WRITTEN SPECIFICATIONS MANUAL WHICH ARE PART OF THE CONTRACT DOCUMENTS.


ISSUE DATE DESCRIPTION - 2020.12.21 PERMIT SET 1 2021.04.20 STRUCTURAL STEEL REV


PROJECT INFORMATION PROJECT NO: JPM.27135.001 2020.12.21 PROTOTYPE: C.THEBEAU DRAWN BY: B.LaSURS CHECKED BY: SE_1.00 VERSION: SHEET TITLE


> DETAILS: EXTERIOR ENVELOPE, ROOF SCUTTLE, AND LADDERS

SHEET NUMBER

A5.4.1

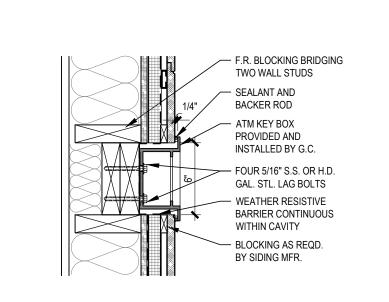

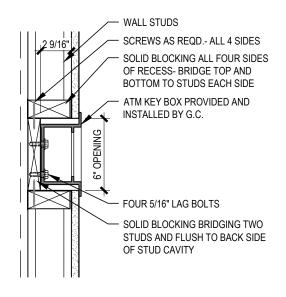

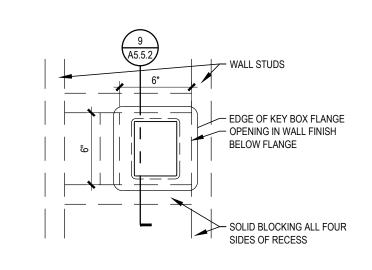



- LINE OF WALL BEHIND ATM

EDGES OF POWER TRANSITION BOX

POWER TRANSISTION BOX 3/4" BLACK

BACK FACE OF ATM

TO COORDINATE

FINISH FLOORING

POWER TRANSITION BOX

1" OPEN CONDUIT TERMINATED IN

CEILING -

JUNCTION BOX ABOVE ACCESSIBLE

MILLWORK


A5.5.2 1 1/2" = 1'=0"

VERIFY LOCATION IN FIELD


INTERIOR PARTITION

ATM KEY BOX-SECTION A5.5.2 1-1/2" = 1'-0"



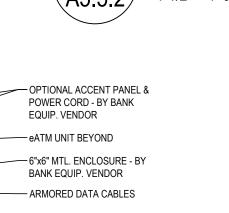

5/8" EPDM CELLULAR RUBBER WEATHER STRIP OR EQ. FLEXIBLE FILLER ADHERED TO (3) THERMALLY-FUSED MELAMINE ENCLOSURE. CHASE FURNITURE VENDOR SUPPLIED, GC ATM ELEC. / DATA / SECURITY CONNECTIONS-

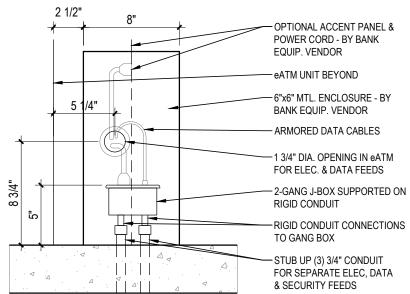





WALL CAVITY OPEN TO PLENUM ABOVE FOR VENTING


ONLY WHERE REQUIRED


FOR FIRE BLOCKING -


PREFERRED - CAP FRAMING

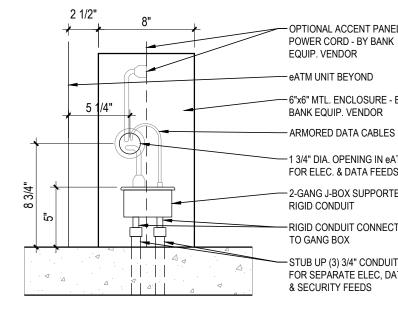


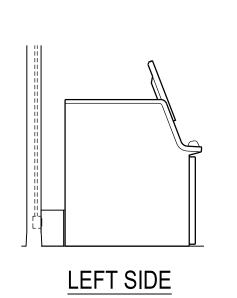

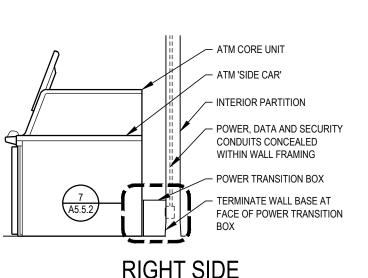

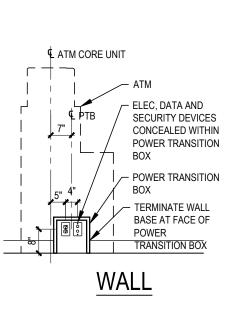

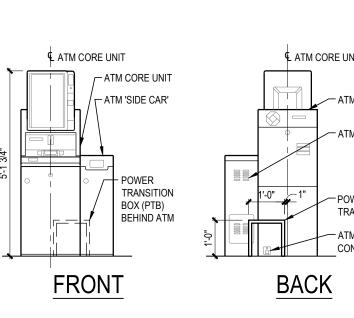

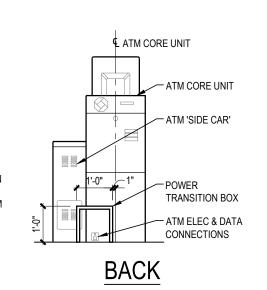



— STUD WALL FRAMING

GYP. BOARD; SEE FINISH PLAN


V— GYP. BOARD NICHE- CSG-PT-104


----- 3/4" PLYWOOD SUBSTRATE

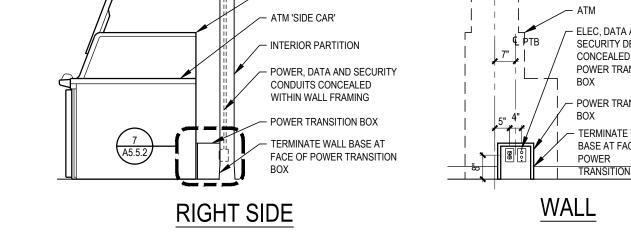


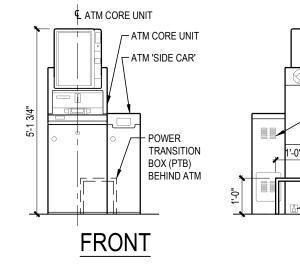


SCREEN NICHE

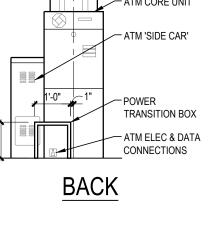

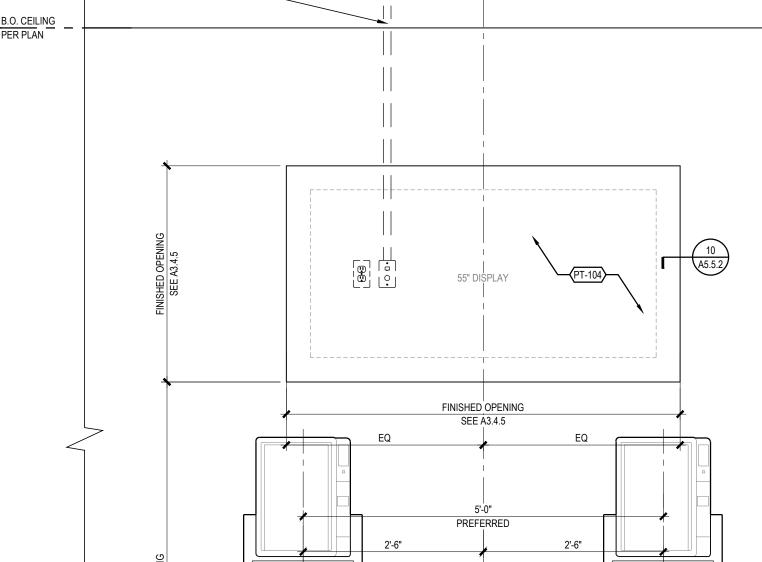


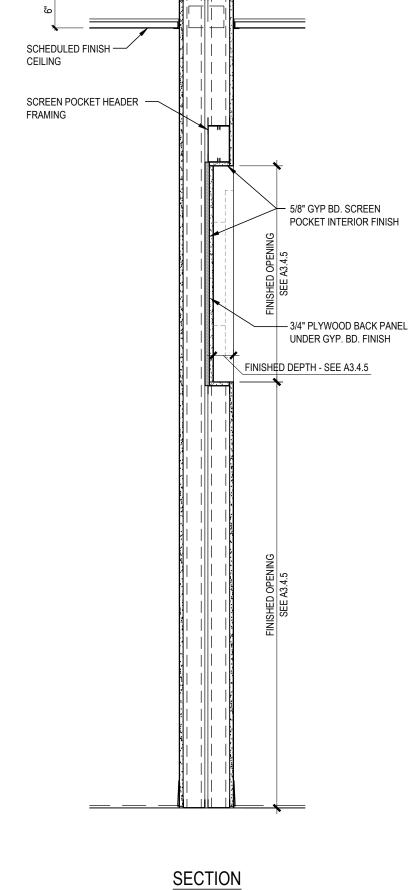




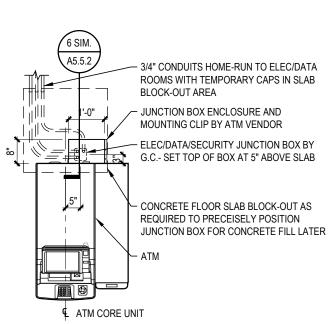



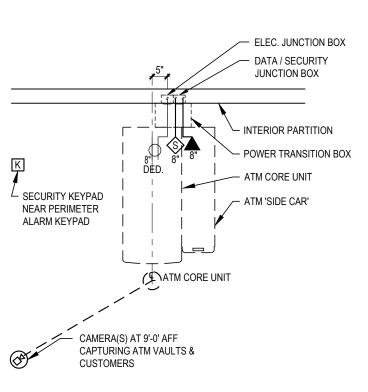



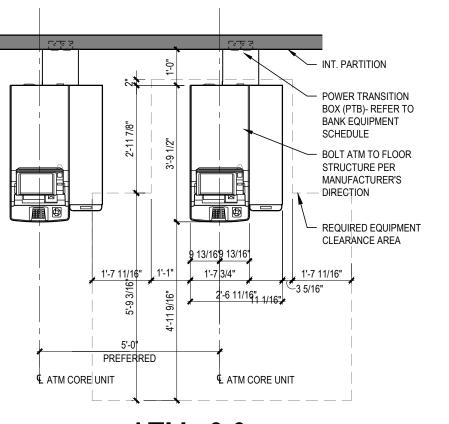

ATM v3.0 FLOOR PLAN \A5.5.2\) 3/8" = 1'-0"

A5.5.2 3/4" = 1'-0"

WB-402

ELEVATION

SOLUTION #1-55" DISPLAY AT eATMS V3.0

A5.5.2

DETAILS:

ATM

GROUP

CORESTATES, INC.

COA #: A-2014026908

6500 Chippewa Street Suite 200 St. Louis, MO 63109 314.843.4320

ARCHITECT OF RECORD

ROBERT BRUCE

LaSURS

ARCHITECT: R. BRUCE LASURS

LICENSE NUMBER: 007504

HESE DRAWINGS ARE NOT COMPLETE WITHOUT THE

SEPARATE TYPE WRITTEN SPECIFICATIONS MANUAL

WHICH ARE PART OF THE CONTRACT DOCUMENTS.

DESCRIPTION

JPM.27135.001

2020.12.21

C.THEBEAU

B.LaSURS

SE_1.00

2020.12.21 PERMIT SET

PROJECT INFORMATION

PROJECT NO:

PROTOTYPE:

DRAWN BY:

VERSION:

SHEET NUMBER

SHEET TITLE

CHECKED BY:

ISSUE DATE


- BRACE WALL FRAMING TO

STRUCTURE ABOVE PER


STRUCTURAL DRAWINGS

—BUILDING STRUCTURE -HILTI CC27 CLIP FOR EQUAL #12 SAFTEY WIRE TIED TO -SEISMIC RESTRAINT CLIP MINIMUM (4) PER LIGHT FIXTURE TYPICAL SAFETY WIRE SUPPORT HOLES & FASTENED TO BLDG. STRUCTURE. MINIMUM (2) SAFETY WIRES PER LIGHT FIXTURE PLACED AT DIAGONAL EXPOSED T--BAR CEILING LIGHT FIXTURE SAFETY WIRE SUPORT HOLE, TYPICAL NOTE: ALL WIRES ARE TO BE TAUT WITH A MINIMUM OF 3 TIGHT TURNS AROUND SELF - TYPICAL

Utility Channel Created with Main Tees

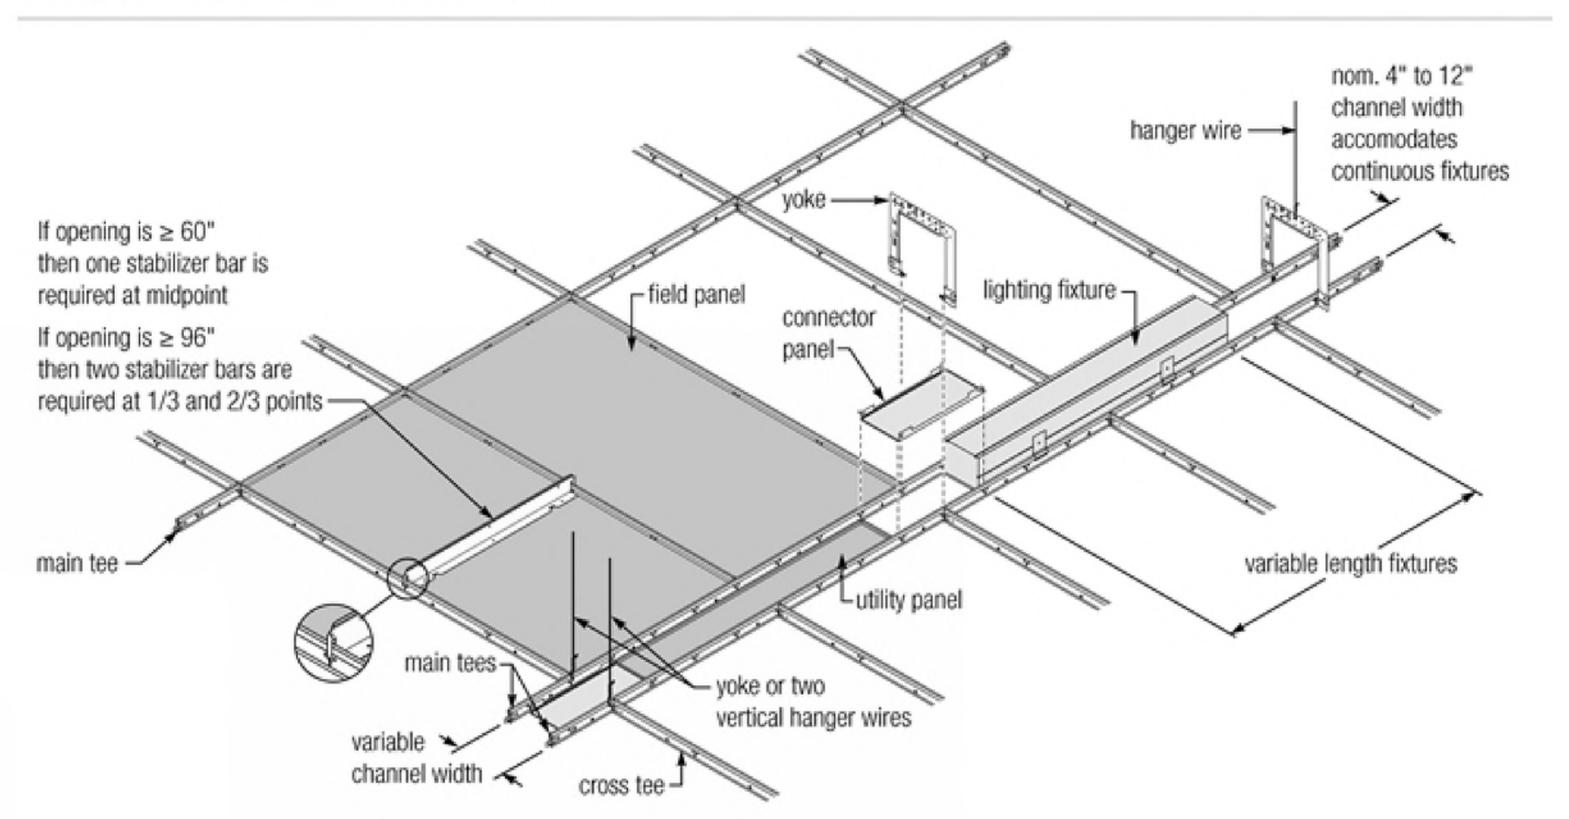


3 LIGHT FIXTURE DETAIL
A5.5.4 1/4" = 1'-0"

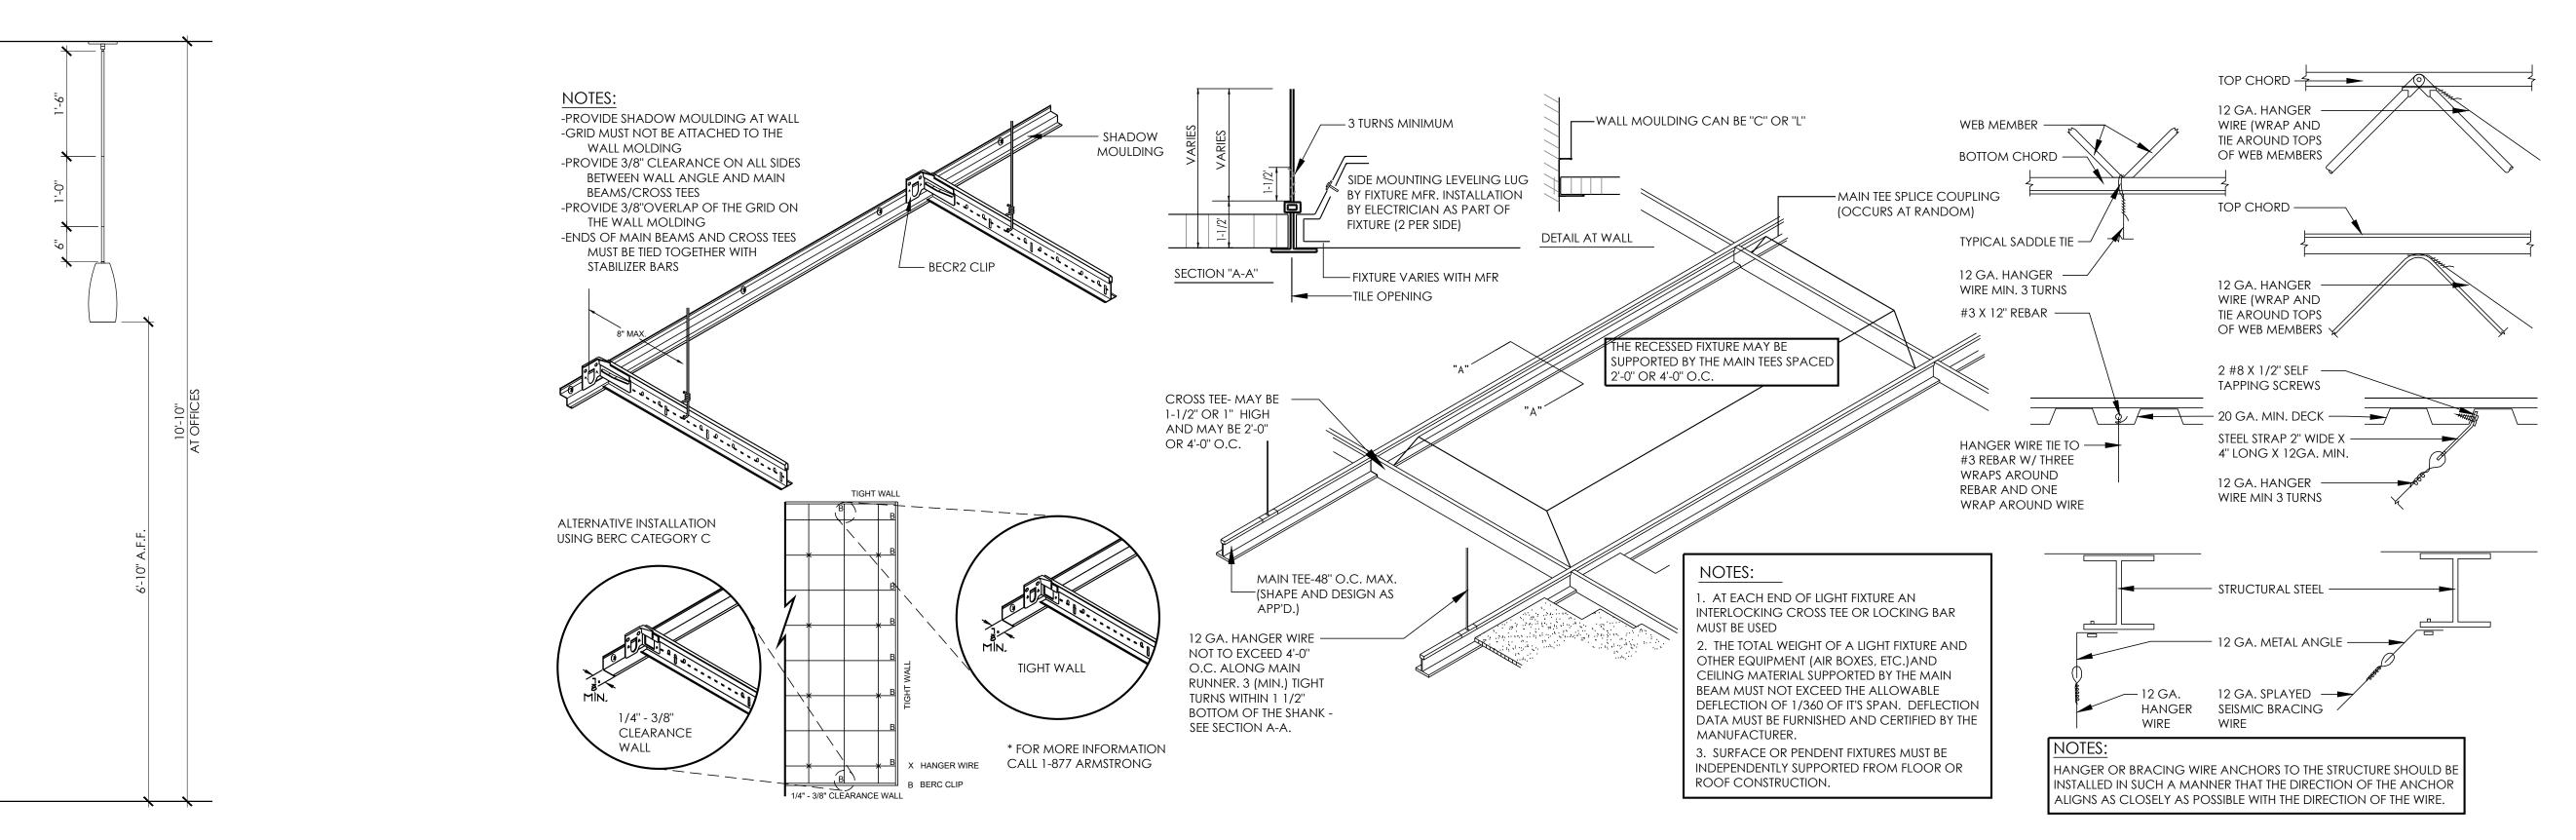

1 CELING GRID - SEISMIC 'B' DETAILS

1/4" = 1'-0"

JP MORGAN CHASE, N.A.
HWY 291 & NE LANGSFORD RD
1EE'S SUMMIT, MO 64063

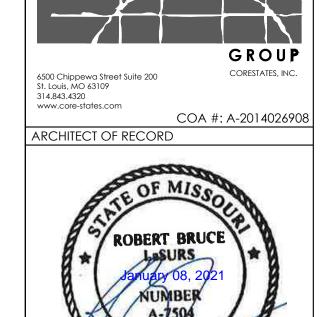

ARCHITECT: R. BRUCE LASURS
LICENSE NUMBER: 007504
THESE DRAWINGS ARE NOT COMPLETE WITHOUT THE

SEPARATE TYPE WRITTEN SPECIFICATIONS MANUAL WHICH ARE PART OF THE CONTRACT DOCUMENTS.

ISSUE DATE DESCRIPTION
- 2020.12.21 PERMIT SET

PROJECT INFORMATION

PROJECT INFORMATION

PROJECT NO: JPM.27135.001

DATE: 2020.12.21

PROTOTYPE: 20.2

DRAWN BY: C.THEBEAU

CHECKED BY: B.LaSURS

VERSION: SE_1.00

SHEET TITLE

DETAILS: CEILING SEISMIC DESIGN 'B'


SHEET NUMBER

A5.5.4


OFFICE PENDANT LIGHT DETAIL

A5.5.4


3/4" = 1'-0"

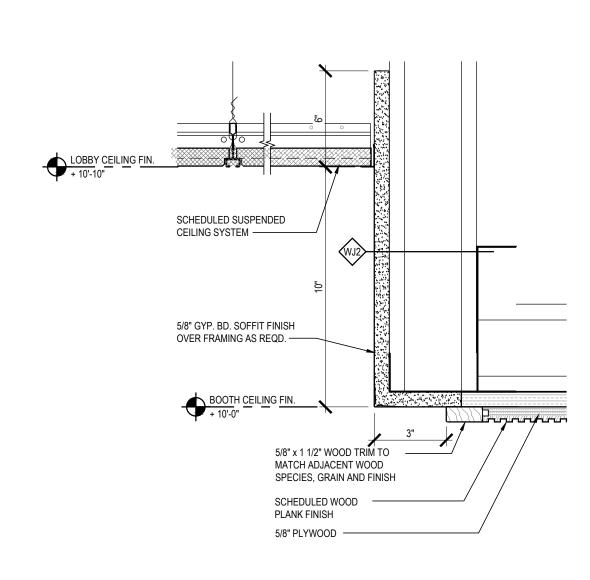




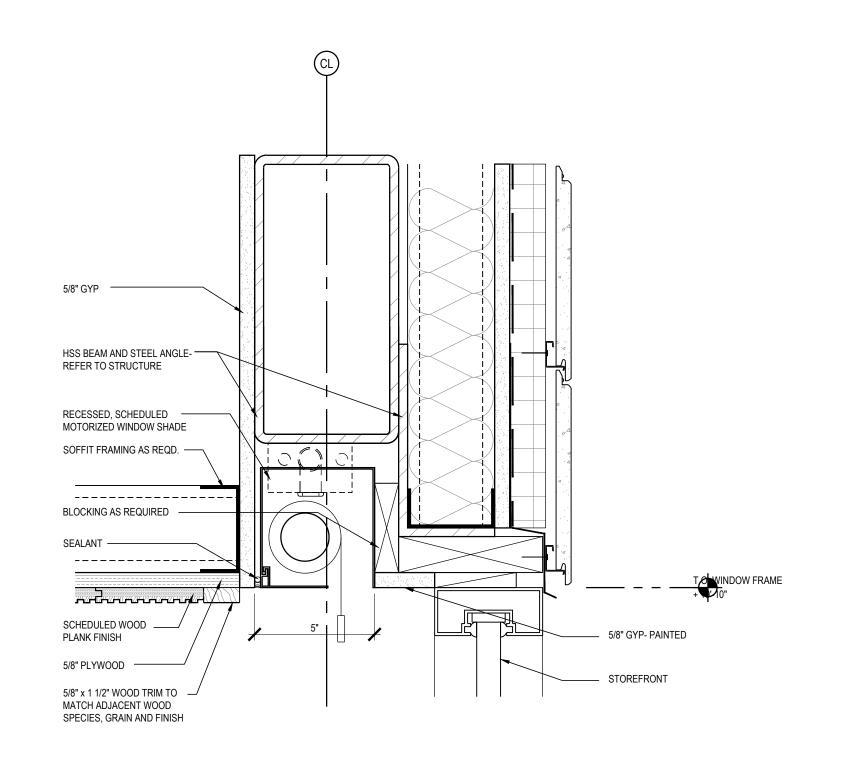




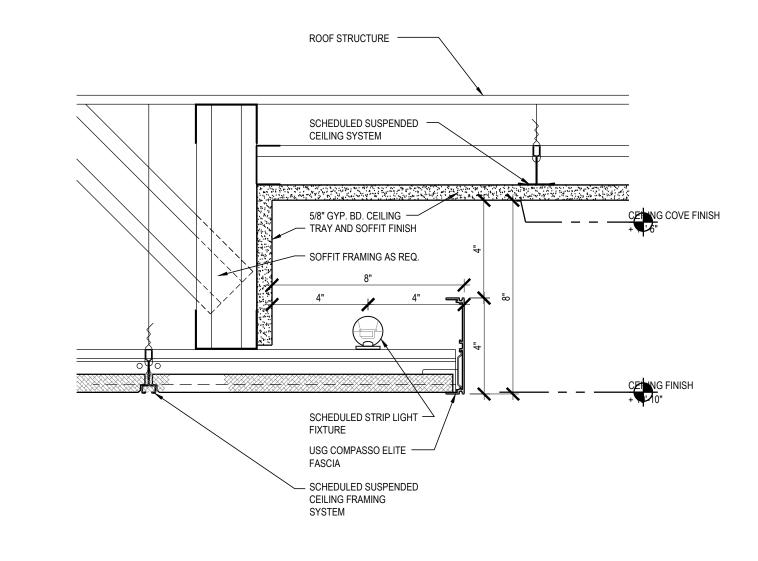


4 LOBBY COVE CEILING TRANSITION AT DRT
A5.5.5 3" = 1'-0"

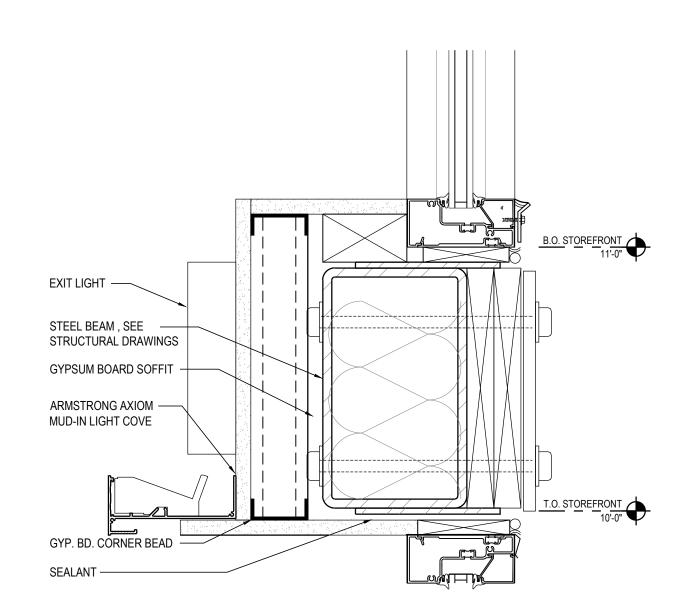



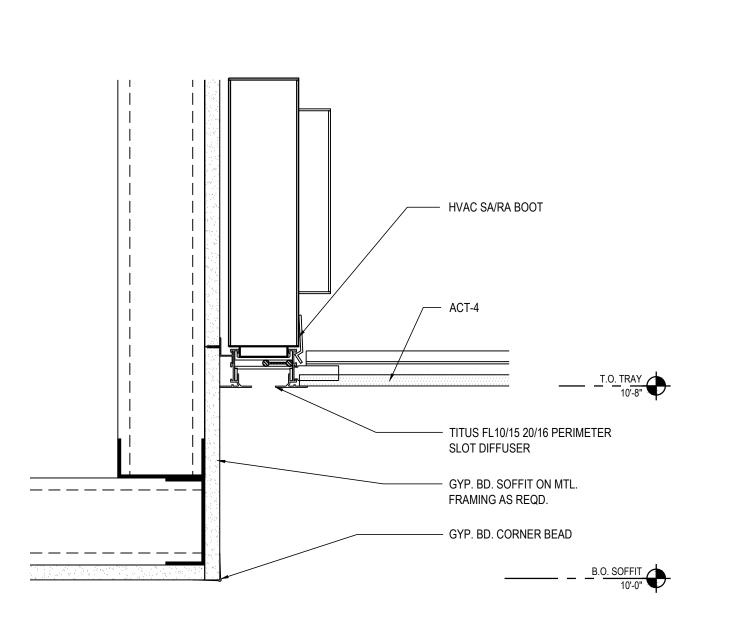


2 CEILING TRAY TRANSITION IN CONFERENCE ROOM
A5.5.5 3" = 1'-0"

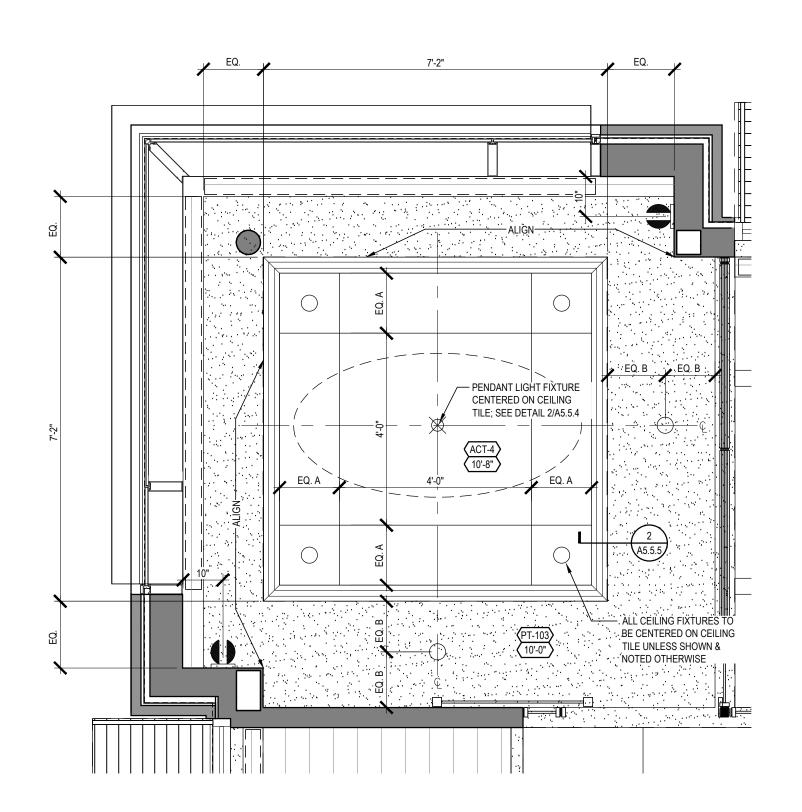

1 CONFERENCE ROOM CEILING PLAN DETAIL
A5.5.5 1/2" = 1'-0"



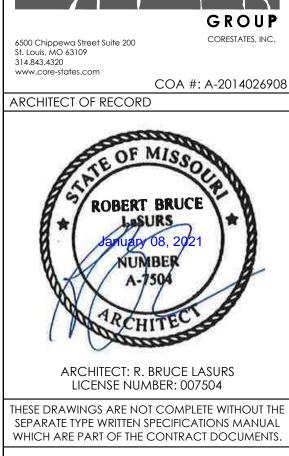

ISSUE DATE DESCRIPTION

- 2020.12.21 PERMIT SET

PROJECT INFORMATION

PROJECT NO: JPM.27135.001

DATE: 2020.12.21

PROTOTYPE: 20.2

DRAWN BY: C.THEBEAU

CHECKED BY: B.LaSURS


VERSION: SE_1.00


SHEET TITLE


DETAILS: CEILING

SHEET NUMBER

A5.5.5

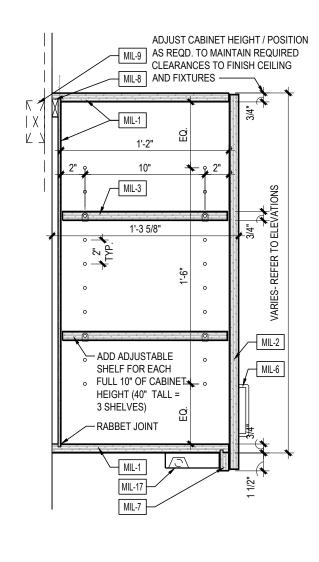


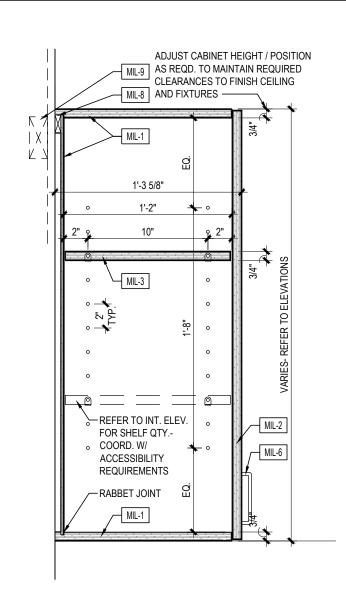


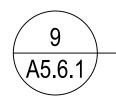



WALL CABINET W/ DOORS & LIGHT FIXTURE




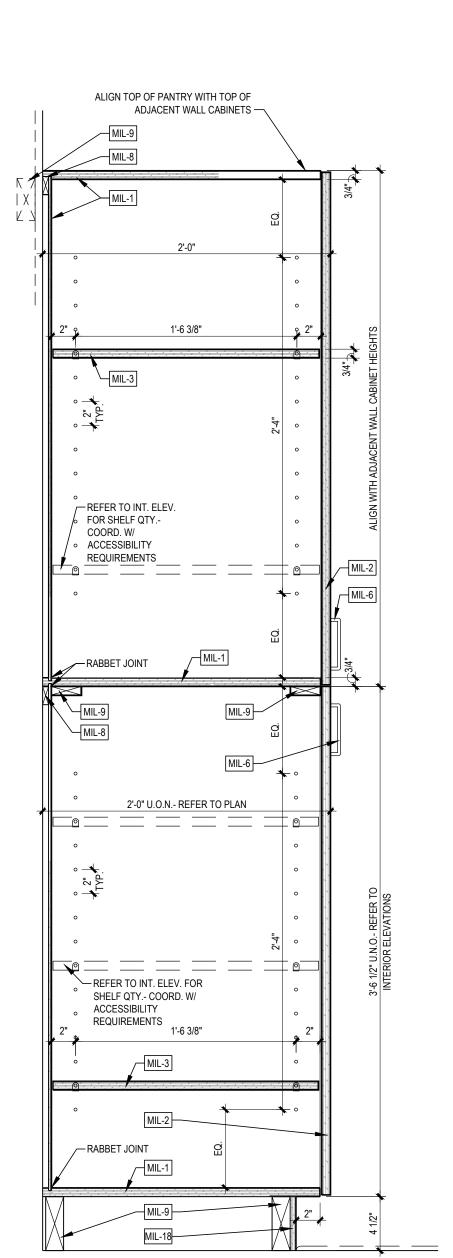


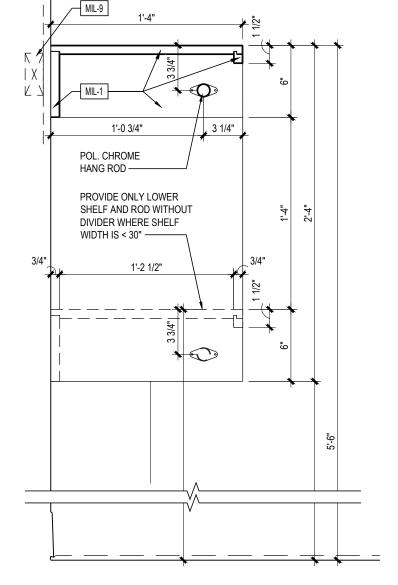

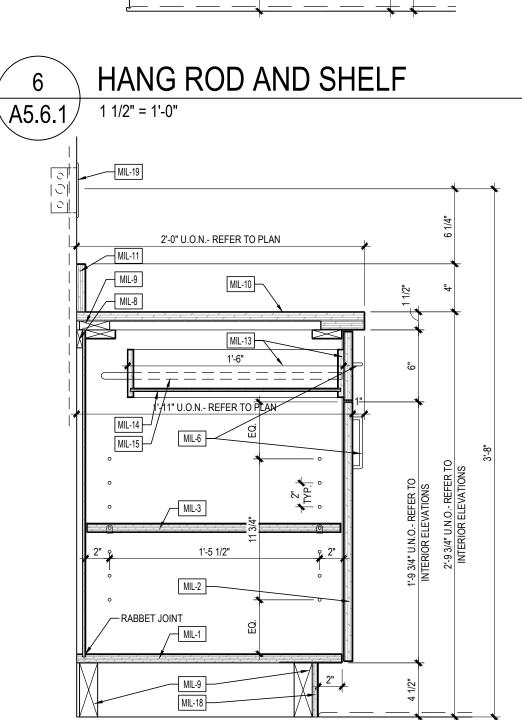


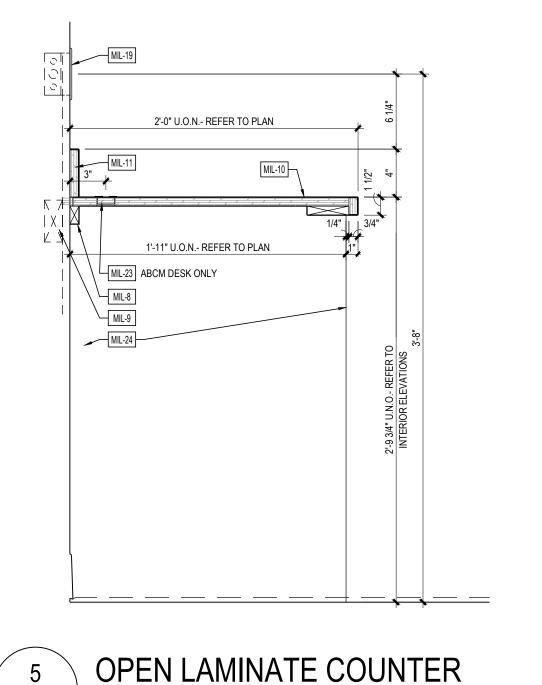

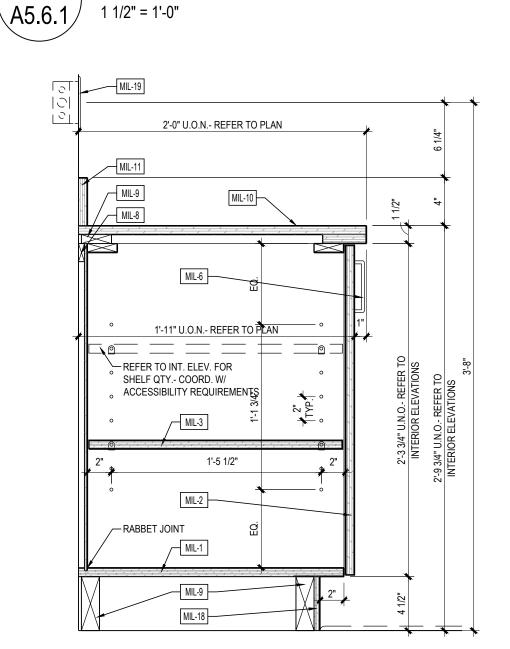

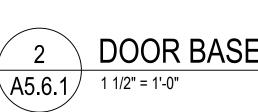



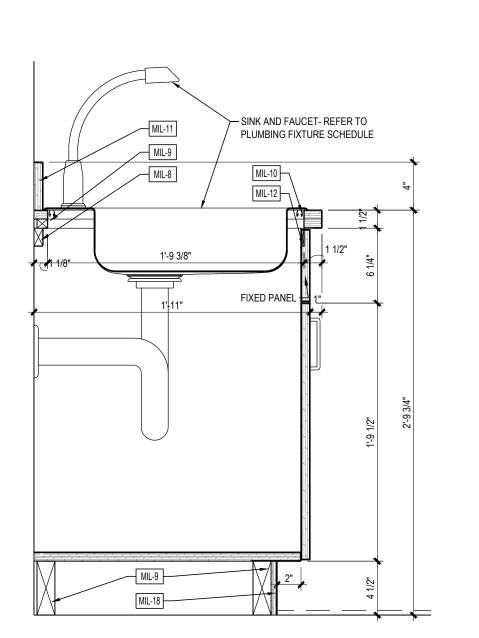

STANDARD SINK BASE SINK BASE CABINET

CUSTOM CABINET NOTES SUBMIT SHOP DRAWINGS AND MATERIALS TO ARCHITECT OF RECORD FOR REVIEW AND APPROVAL PRIOR TO FABRICATION REFER TO INTERIOR FINISH MATERIALS SCHEDULE FOR LAMINATE SPECIFICATIONS CABINET TOP / BOTTOM / SIDE PANEL: 3/4" PLASTIC LAMINATE MDF ALL EXPOSED SURFACES - INTERIOR SURFACES WHITE MELAMINE CABINET DOOR: 3/4" PLASTIC LAMINATE MDF ALL 6 FACES ADJUSTABLE SHELF: 3/4" PLASTIC LAMINATE MDF ALL 6 FACES - PROVIDE FOUR 5MM NICKEL-PLATED SPOON-SHAPED PINS EACH SHELF-DRILL 5MM HOLES IN CABINET SIDE PANELS AS NOTED CABINET BACK: 1/4" PLASTIC LAMINATE MDF EXPOSED FACE MIL-5 SURFACE-MOUNT ELECTRICAL / DATA RACEWAY MIL-6 LIGHT VALENCE: 3/4" PLASTIC LAMINATE MDF EXPOSED FACES CONTINUOUS WOOD CLEAT: SIZE AS REQUIRED-PAINT TO MATCH ADJACENT WALL SURFACE WOOD BLOCKING AS REQUIRED COUNTER TOP: REFER TO INTERIOR FINISH MATERIALS SCHEDULE COUNTER SPLASH: MATCH COUNTER TOP MATERIAL COUNTER APRON: MATCH COUNTER TOP MATERIAL DRAWER BACK / SIDE / SUB-FRONT: 1/2" WHITE MELAMINE MDF DRAWER BOTTOM: 1/4" WHITE MELAMINE MDF DRAWER SLIDE: FULL-EXTENSION BALL-BEARING COUNTER EDGE SUPPORT: CONT. STEEL ANGLE BOLTED TO SOLID WOOD BLOCKING CONCEALED WITHIN WALLS- RE-PRIME FOLLOWING INSTALLATION SCHEDULED LIGHT FIXTURE TOE-KICK: 1/2" MINIMUM PLASTIC LAMINATE MDF- COLOR AND PATTERN TO MATCH CABINET PANELS | ELECTRICAL / DATA ROUGH-IN AND COVER PLATE MIL-20 SINK APRON: 3/4" PLASTIC LAMINATE MDF COUNTER EQUIPMENT SUPPORT: 1 1/2" x 1 1/2" x 1/4" STEEL ANGLE BOLTED TO CABINET BACK, SIDES AND APRON - PRIME AND PAINT TO MATCH CABINET GROMMET: MOCKET #BRKIT 12" BLACK LINEAR BRUSH GROMMET GROMMET: MOCKET #BG 1 1/2" ROUND BLACK PLASTIC GROMMET COUNTER SUPPORT: 3/4" THICK PLASTIC LAMINATE MDF PANEL MATCHING COUNTER DEPTH- QUANTITY AND POSITIONS AS REQUIRED TO ENSURE MAX. COUNTER DEFLECTION OF L/768 (1/8" OVER 8') CABINET TOP / BOTTOM / SIDE / DOOR PANEL: 3/4" PLASTIC LAMINATE MDF ALL SURFACES EXPOSED TO VIEW, INCLUDING INTERIOR- REFER TO INTERIOR FINISH SCHEDULE FOR LAMINATE SPECIFICATION SOLID SURFACE COUNTER: 2" BUILT-UP FRONT EDGES, OPENINGS, AND VERTICAL PANELS, ALL CONTACT EDGES EASED- REFER TO INTERIOR FINISH SCHEDULE FOR MATERIAL SPECIFICATION REFUSE CAN TRAY, 36-QT PLASTIC CAN, AND DRAWER GLIDES ATTACHED TO CABINET BOTTOM AND DRAWER PANELS OPEN COUNTER SUPPORT BRACKET: CENTERLINE BRACKETS #CSA-004-20, COLOR WHITE- 24" MAX. O.C.- CUT MINIMAL OPENING IN WALL FINISH AS REQD, LAG-SCREW TO WALL STUDS OR BLOCKING- PATCH WALL FINISH OPENING ELECTRICAL / DATA OUTLETS: COORD. WITH ELECTRICIAN TO PROVIDE MUD RING OF SUFFICIENT DEPTH TO REACH CABINET BACK- INSTALL OVER PLATES OVER CABINET BACK CONTINUOUS COUNTER UNDERLAYMENT: 3/4" PLYWOOD- PROVIDE WHITE PLASTIC LAMINATE FACE AT UNDERSIDE OF OPEN COUNTER SECTIONS

GROMMET NOTES

(6) - DOUG MOCKETT BG3 1-1/2" BLACK

GC TO PROVIDE GROMMETS TO BE FIELD-LOCATED BY CHASE BRANCH BANK STAFF AND INSTALLED BY GC AT TURNOVER.

(2) - DOUG MOCKETT AG SERIES - 3/4" WHITE AT MANUAL TRANSACTION MILLWORK. (2) - DOUG MOCKETT OG3 - 1" WHITE AT MANUAL TRANSACTION MILLWORK. (6) - DOUG MOCKETT BG3 1-1/2" WHITE

MIL-39 | FIXED DRAWER SHELF: PLASTIC LAMINATE

MIL-31 STOP: 1/2" x 3/4" EASED-EDGE PAINT GRADE-WOOD

SHEDULE FOR PAINT SPECIFICATIONS

MIL-32 CABINET PULL: AMEROCK #BP55364G10 'RIVA' IN SATIN NICKEL, 3" CTC

CORNERS OF ASSEMBLIES TO CONCEAL JOINTS

HARDWOOD FIN: 1" x 3 1/2" AND 2" x 9 1/4" SOLID AND VENEER NATURAL RED OAK

FOR STAIN AND CLEAR FINISH- REFER TO FINISH MATERIALS SCHEDULE- MITER

PAINTED CABINET BACK: 1/2" MDF FOR PAINT FINISH- REFER TO FINISH MATERIAL

FIN PLINTH: SOLID RED OAK FOR STAIN AND CLEAR FINISH PER MATERIALS FINISH SCHEDULE- APPLY FACE BOARD WITH MINIMAL FINISH NAILS TO

SACRIFICIAL BASE: 1/2" x 4" SOLID RED OAK FOR STAIN AND CLEAR FINISH-

FACE-FRAME CABINET SIDE PANEL: EXTENDED 3/4" PLASTIC LAMINATE MDF

CABINET SIDE PANEL AND FACE ALIGNED WITH HARDWOOD FIN ABOVE

APPLY WITH MINIMAL FINISH NAILS TO FACILITATE REPLACEMENT

REFUSE OPENING: 4" DIAM. HOLE WITH 2" BUILT-UP EASED EDGE

DESCRIPTION ISSUE DATE

2020.12.21 PERMIT SET

GROUP

CORESTATES, INC.

COA #: A-2014026908

6500 Chippewa Street Suite 200

ARCHITECT OF RECORD

ROBERT BRUCE

LaSURS

ARCHITECT: R. BRUCE LASURS

ESE DRAWINGS ARE NOT COMPLETE WITHOUT THE

SEPARATE TYPE WRITTEN SPECIFICATIONS MANUAL WHICH ARE PART OF THE CONTRACT DOCUMENTS.

LICENSE NUMBER: 007504

14.843.4320

PROJECT INFORMATION PROJECT NO: JPM.27135.001 2020.12.21 **PROTOTYPE** DRAWN BY: C.THEBEAU **B.LaSURS** CHECKED BY: VERSION: SE_1.00 SHEET TITLE

> **DETAILS:** CABINETRY

SHEET NUMBER

A5.6.1


∖A5.6.1*/*


PANTRY

1 1/2" = 1'-0"

A5.6.1


DOOR / DRAWER BASE CABINET 1 1/2" = 1'-0"

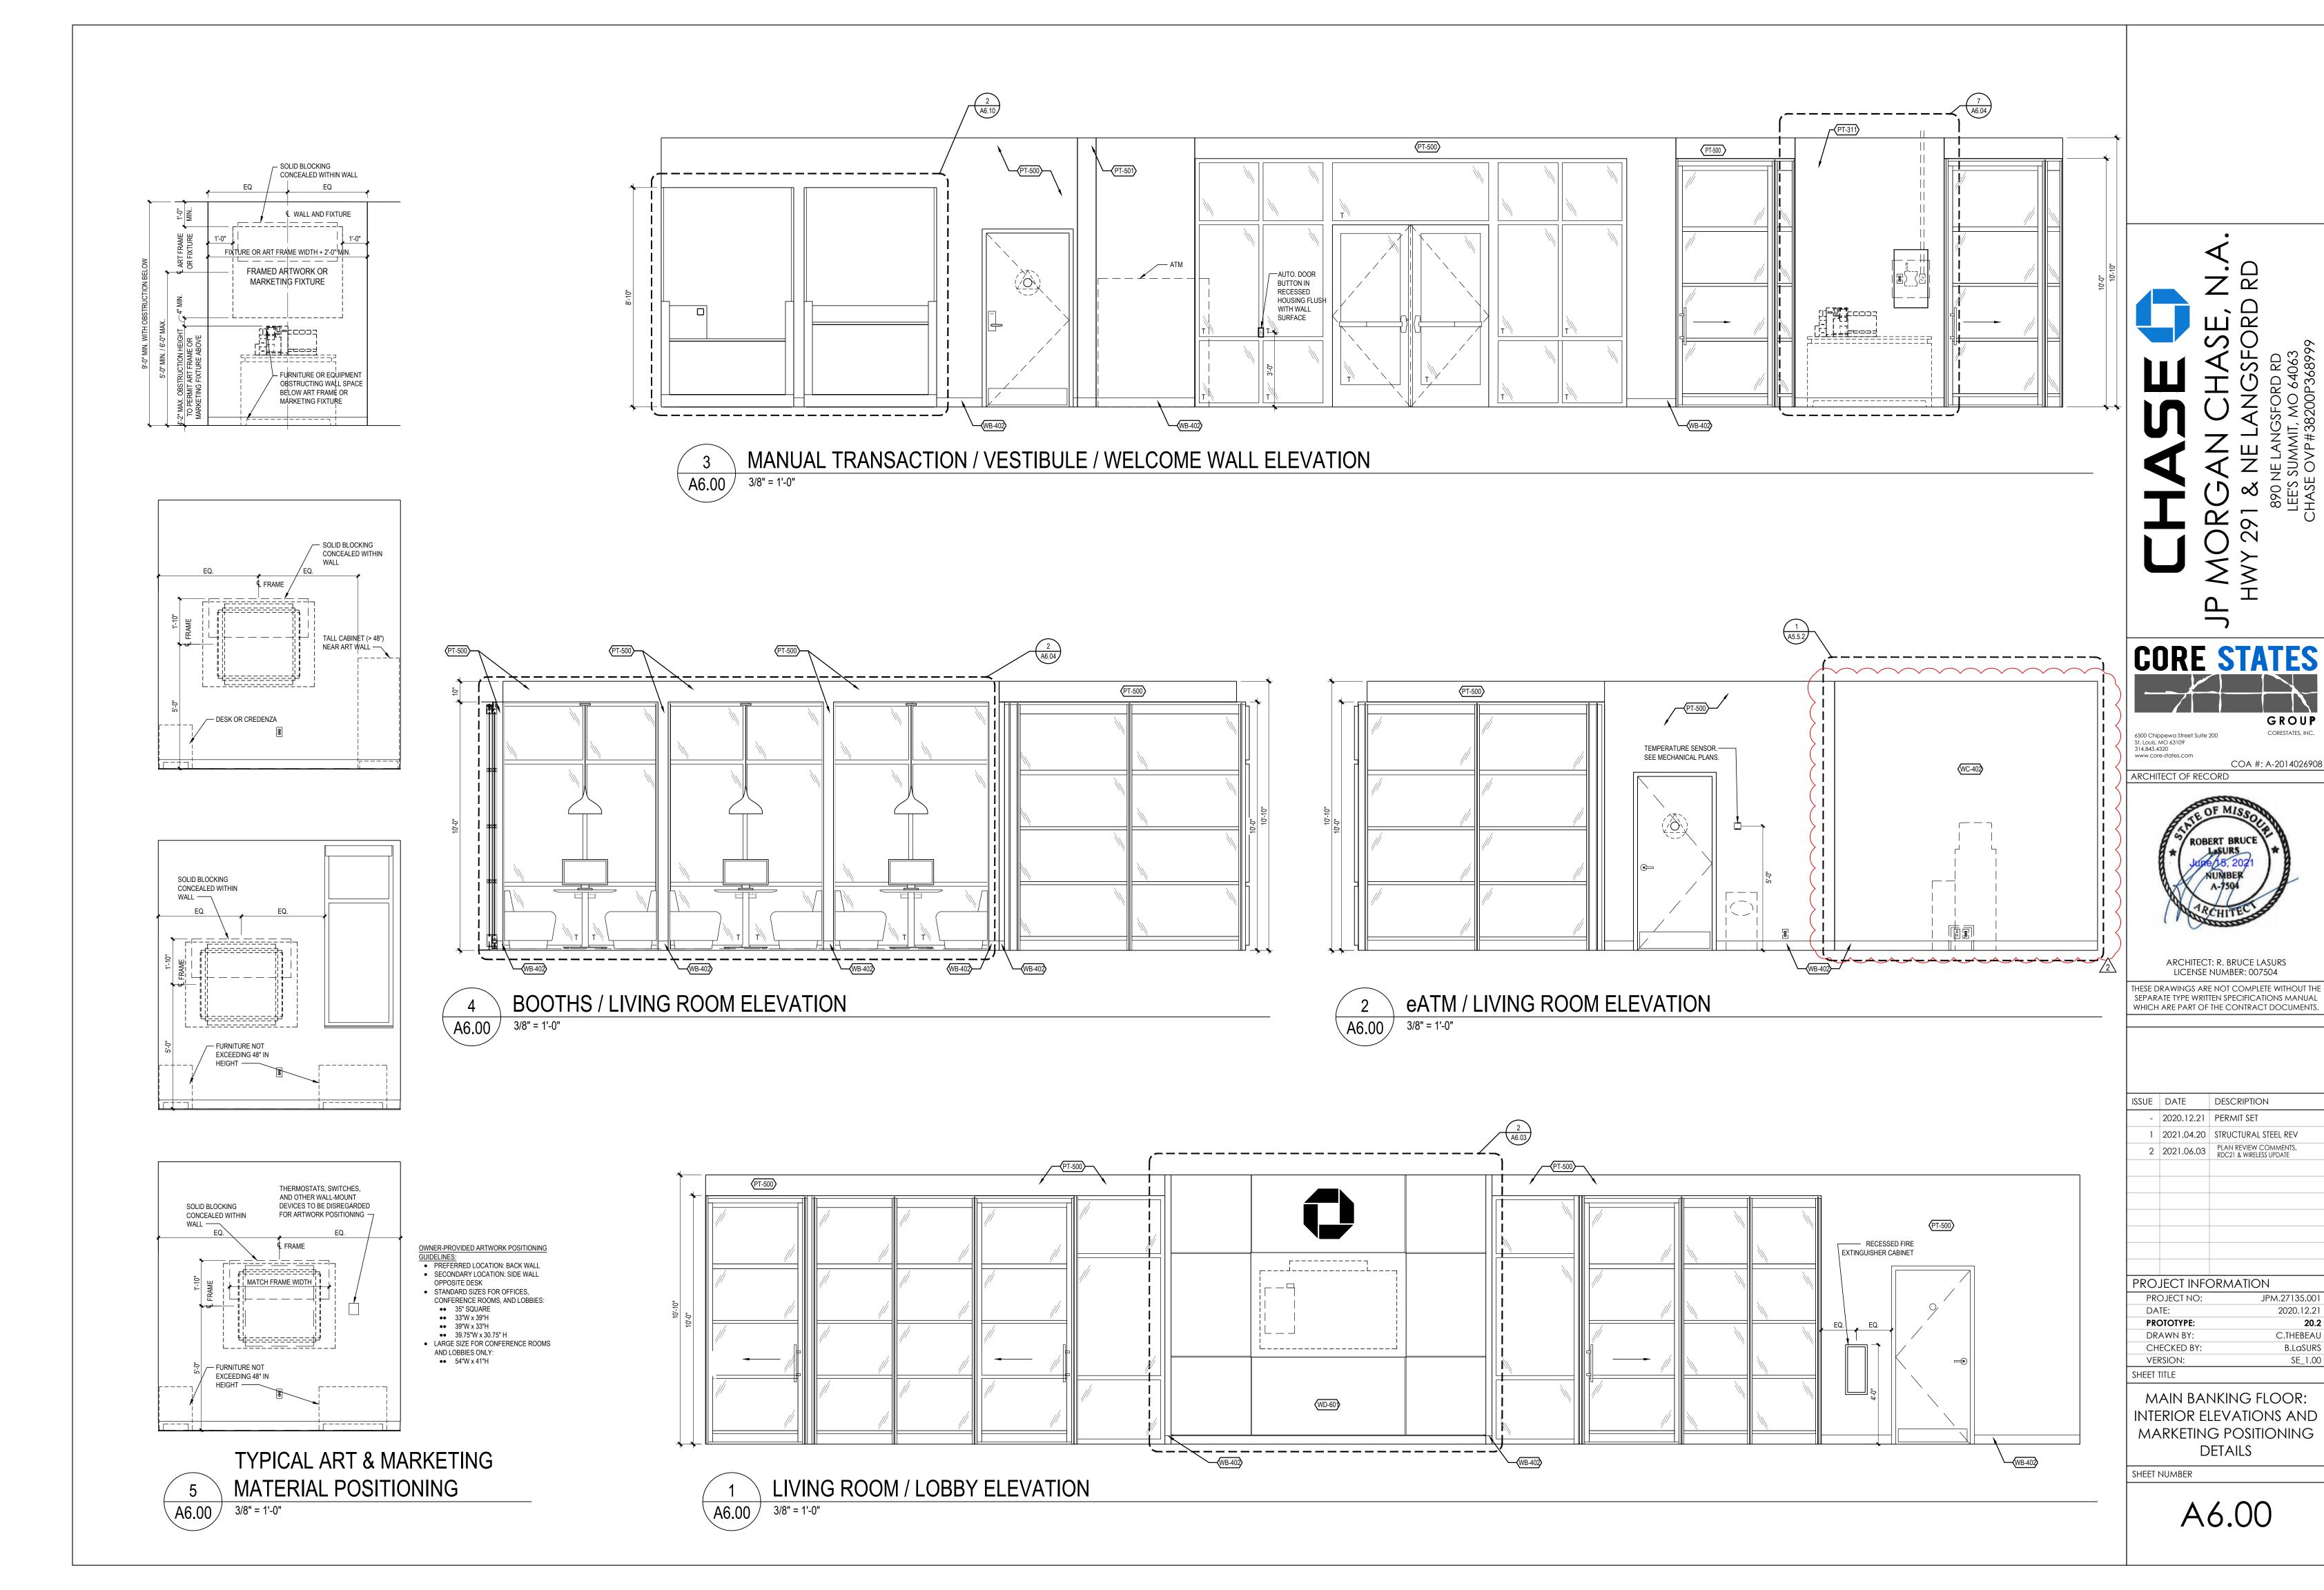

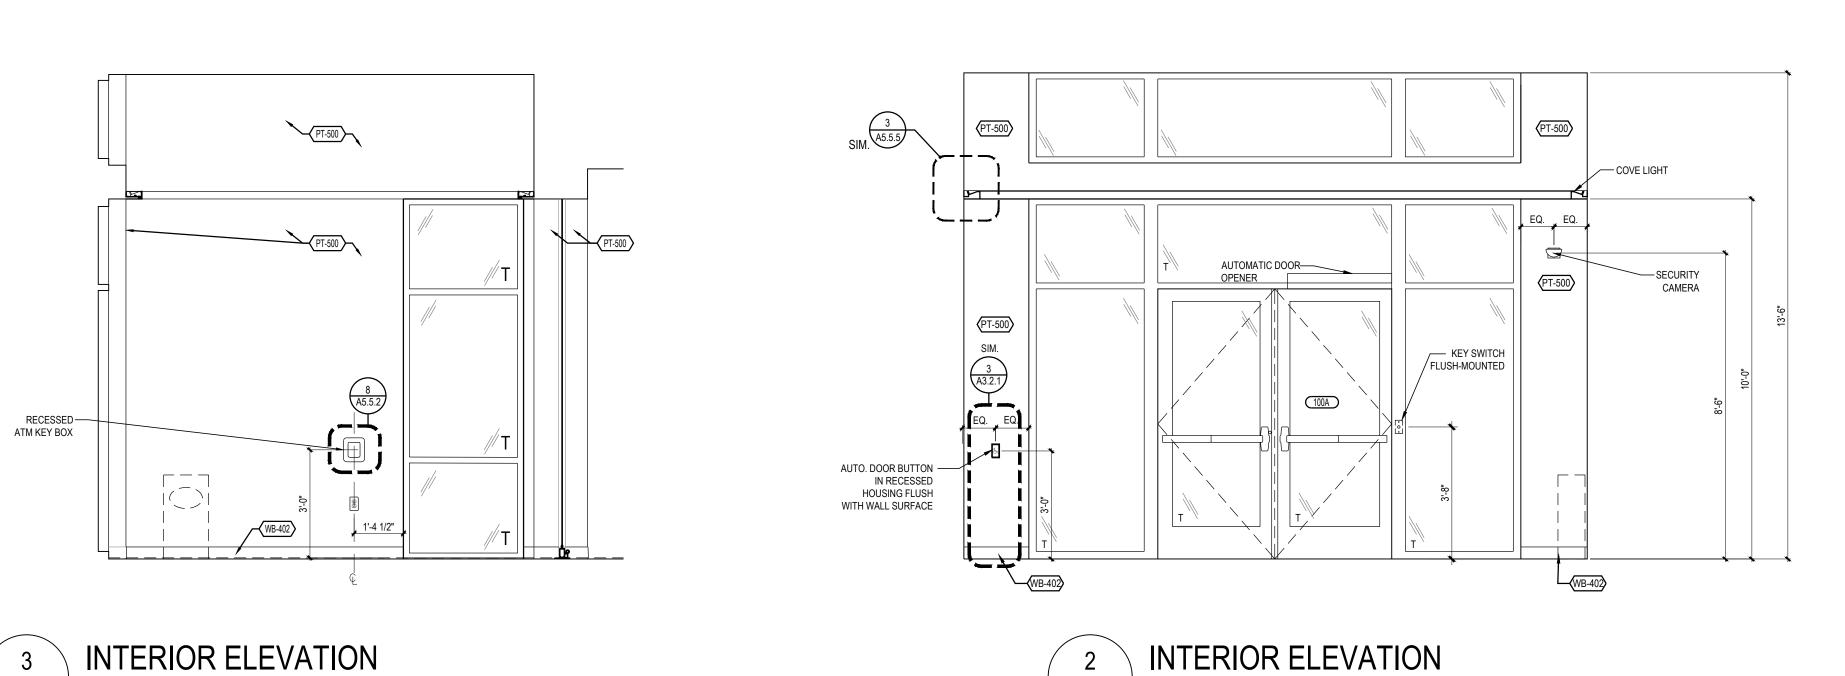

A6.01 3/8" = 1'-0"

A6.01 3/8" = 1'-0"

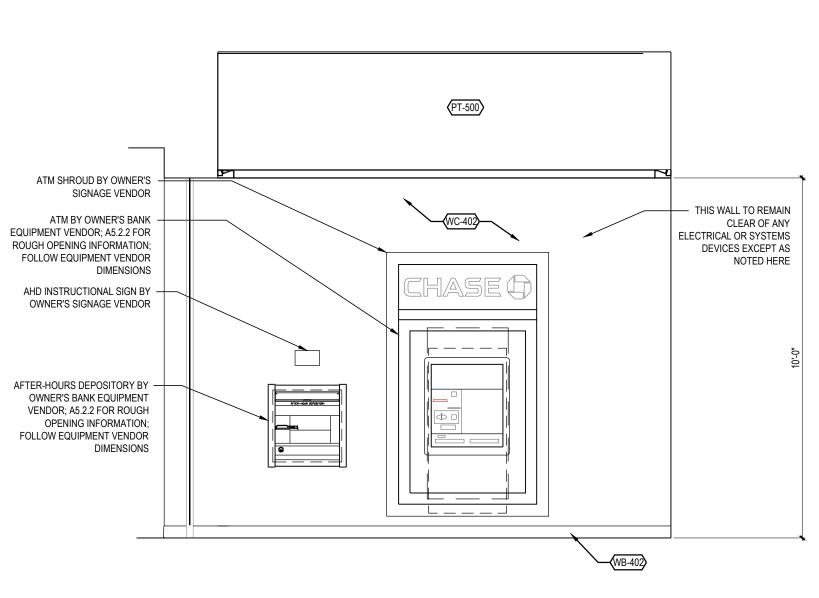

INTERIOR ELEVATION

A6.01 3/8" = 1'-0"

A6.01

ARCHITECT OF RECORD ROBERT BRUCE

ARCHITECT: R. BRUCE LASURS LICENSE NUMBER: 007504 THESE DRAWINGS ARE NOT COMPLETE WITHOUT THE SEPARATE TYPE WRITTEN SPECIFICATIONS MANUAL WHICH ARE PART OF THE CONTRACT DOCUMENTS.


DESCRIPTION ISSUE DATE - 2020.12.21 PERMIT SET


PROJECT INFORMATION PROJECT NO: JPM.27135.001


2020.X%.&X 20.2 PROTOTYPE: X.X.LASTNAME B.LaSURS DRAWN BY: CHECKED BY: VERSION: SE_1.00 SHEET TITLE

TRANSACTION VESTIBULE: INTERIOR ELEVATIONS


SHEET NUMBER

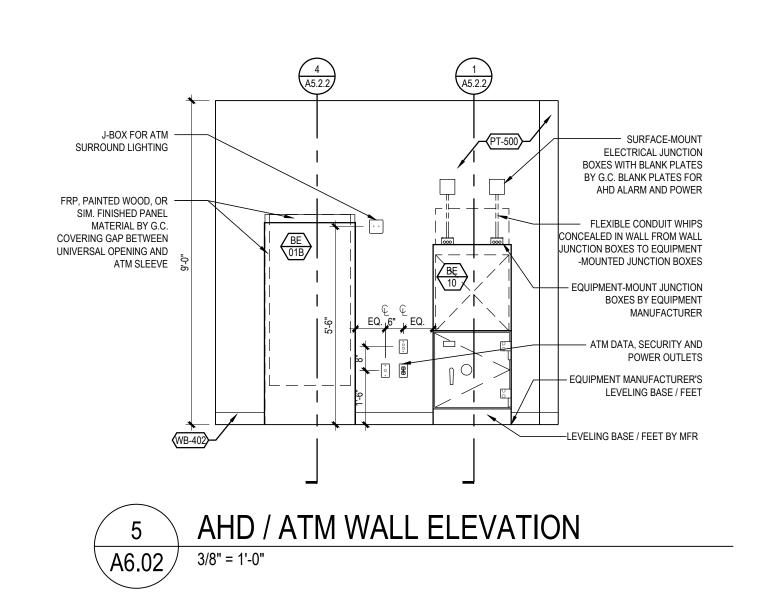


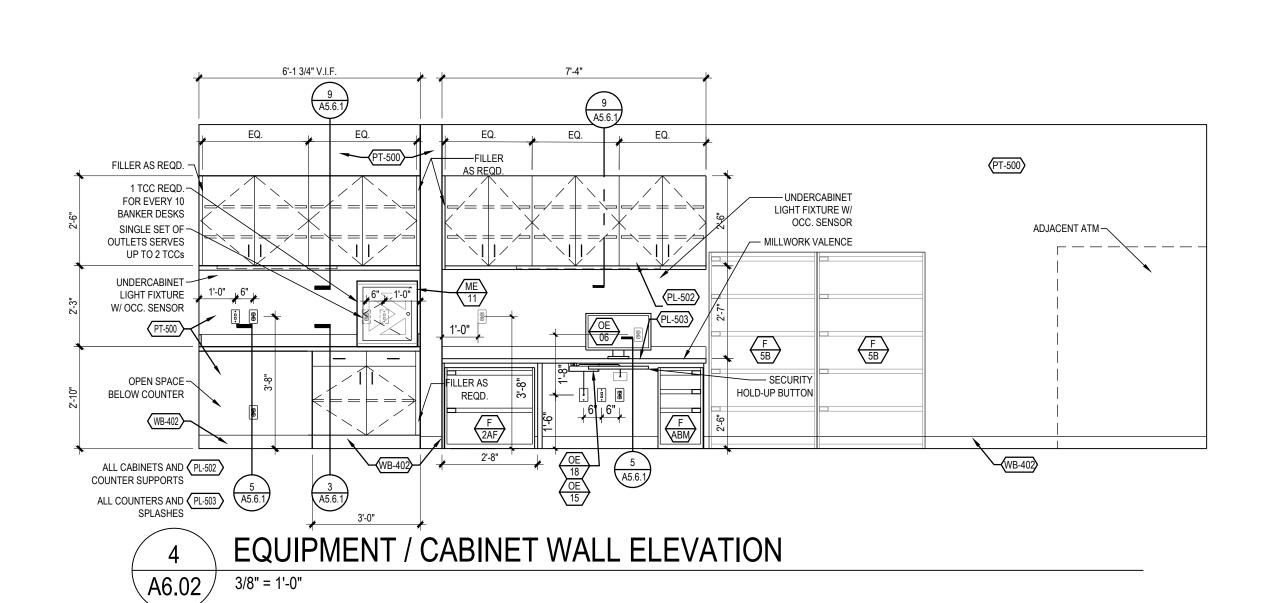

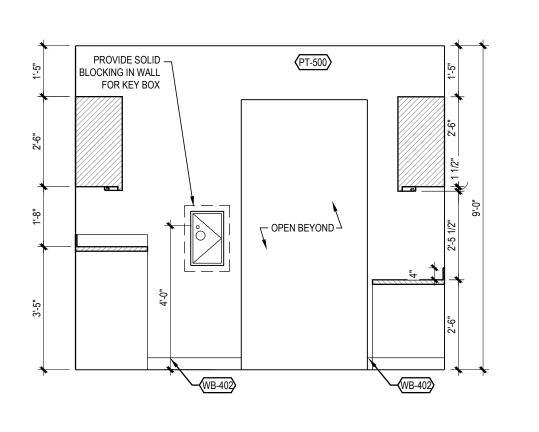



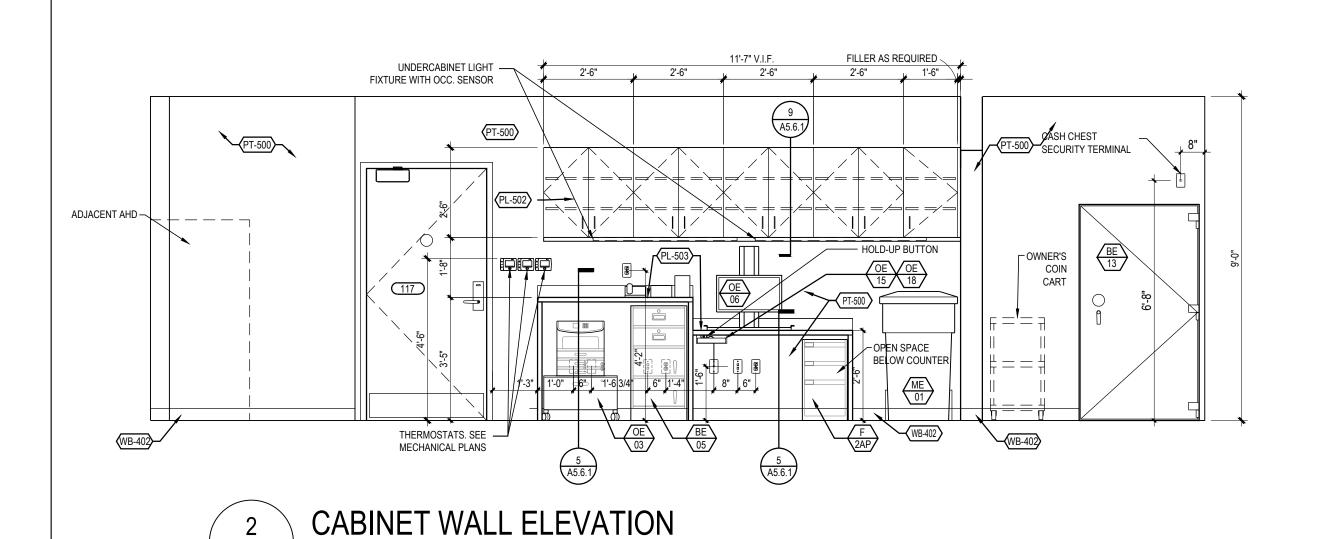

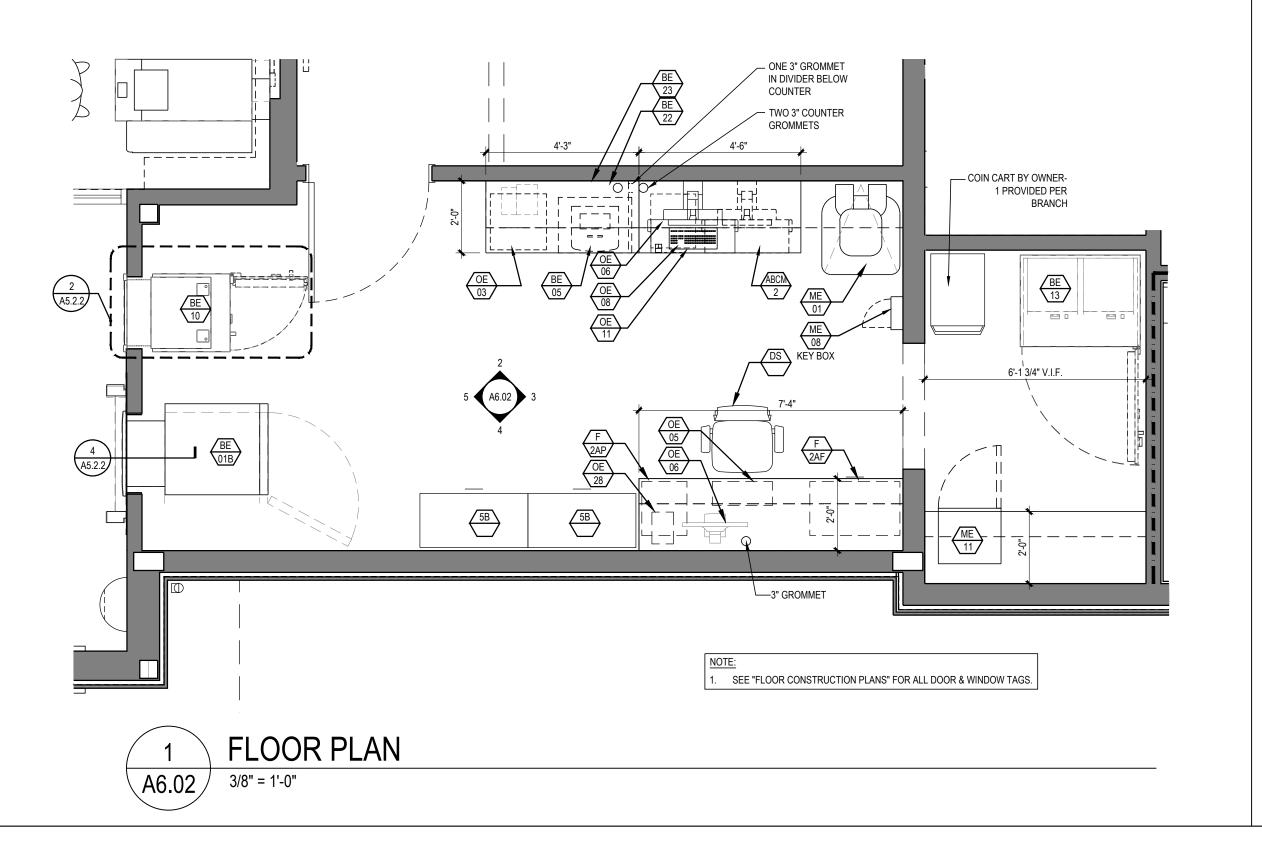

CASH / TRANSACTION EQUIP ROOM & LAO AREA: ENLARGED PLANS AND INTERIOR ELEVATIONS SHEET NUMBER

A6.02

GROUP 6500 Chippewa Street Suite 200 St. Louis, MO 63109 314.843.4320 COA #: A-2014026908 RCHITECT OF RECORD

EQUIPMENT

ACTION

ROBERT BRUCE ARCHITECT: R. BRUCE LASURS LICENSE NUMBER: 007504


ESE DRAWINGS ARE NOT COMPLETE WITHOUT THE SEPARATE TYPE WRITTEN SPECIFICATIONS MANUAL WHICH ARE PART OF THE CONTRACT DOCUMENTS.

DESCRIPTION 2020.12.21 PERMIT SET

PROJECT INFORMATION PROJECT NO:

JPM.27135.001 2020.12.21 **20.2** PROTOTYPE: C.THEBEAU B.LaSURS DRAWN BY: CHECKED BY: SE_1.00

SHEET TITLE

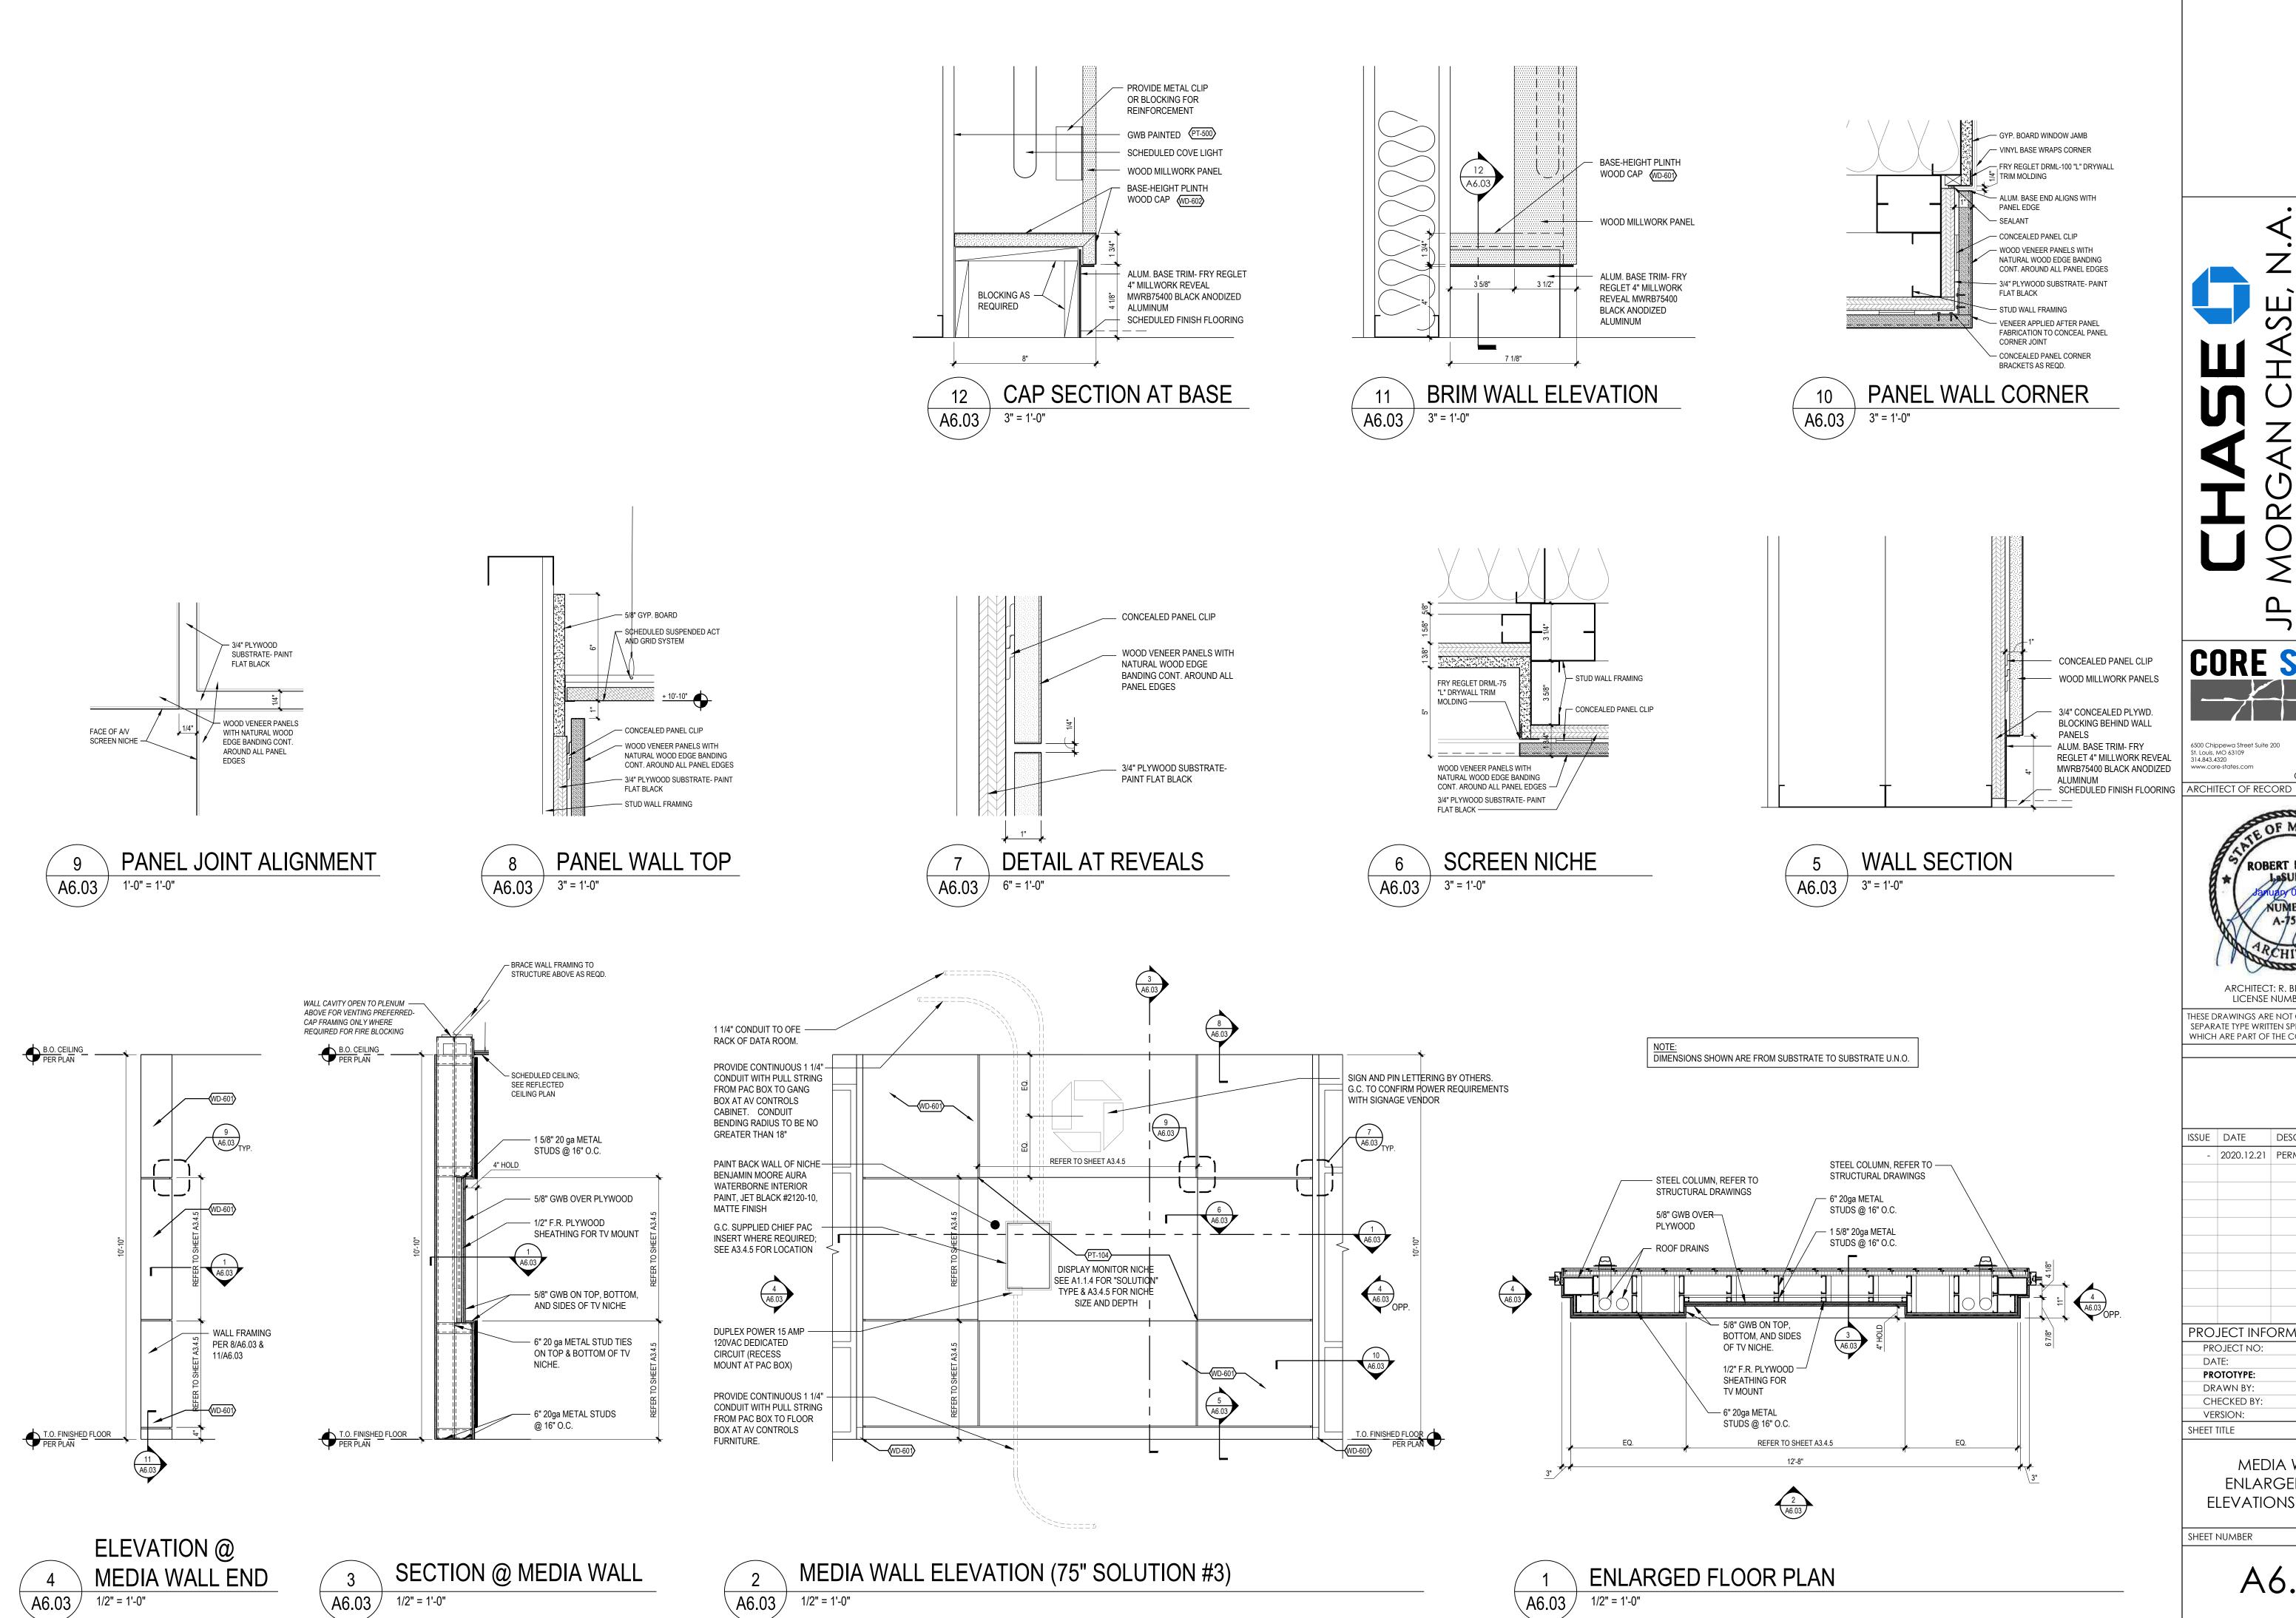

GROUP CORESTATES, INC.

6500 Chippewa Street Suite 200 St. Louis, MO 63109 314.843.4320

COA #: A-2014026908



ARCHITECT: R. BRUCE LASURS LICENSE NUMBER: 007504


HESE DRAWINGS ARE NOT COMPLETE WITHOUT THE SEPARATE TYPE WRITTEN SPECIFICATIONS MANUAL WHICH ARE PART OF THE CONTRACT DOCUMENTS.


DESCRIPTION 2020.12.21 PERMIT SET


PROJECT INFORMATION JPM.27135.001 2020.12.21 C.THEBEAU B.LaSURS SE_1.00


MEDIA WALL -ENLARGED PLAN, **ELEVATIONS & DETAILS**

A6.03

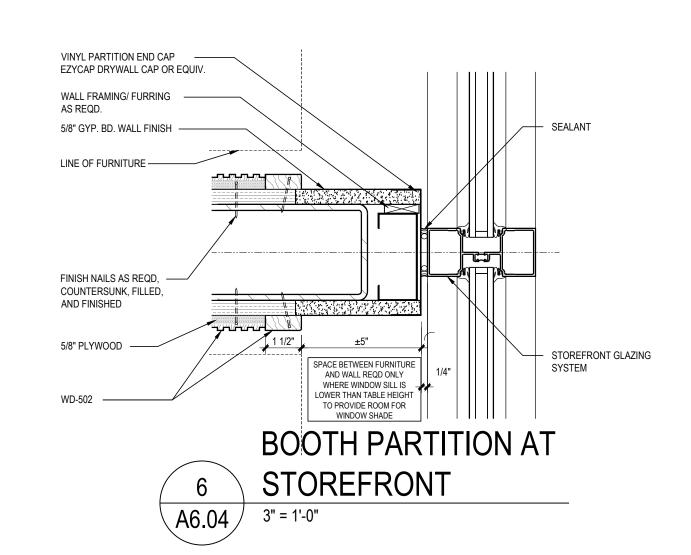

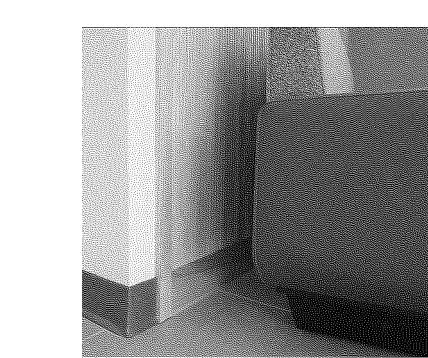


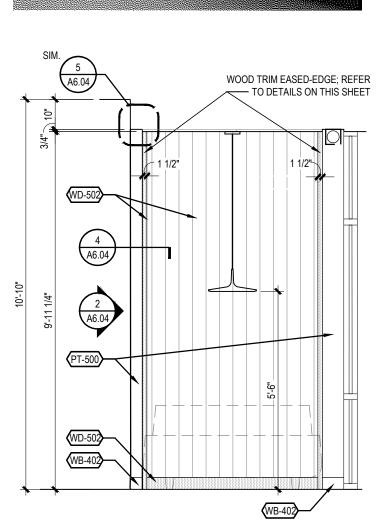

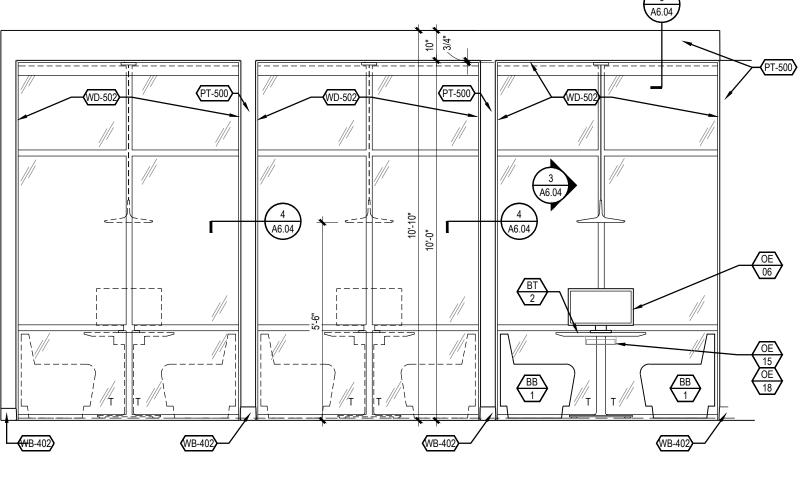






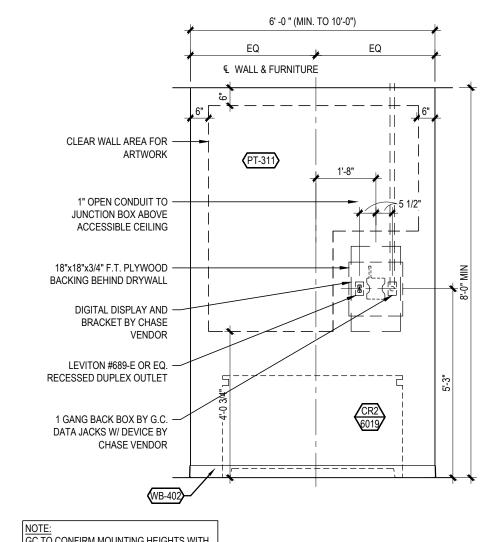


GC TO CONFIRM MOUNTING HEIGHTS WITH CHASE TELECOMMUNICATIONS DRAWINGS


COMMUNITY WALL ELEVATION 3/8" = 1'-0"

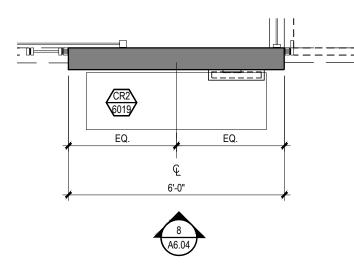

ENLARGED COMMUNITY WALL PLAN

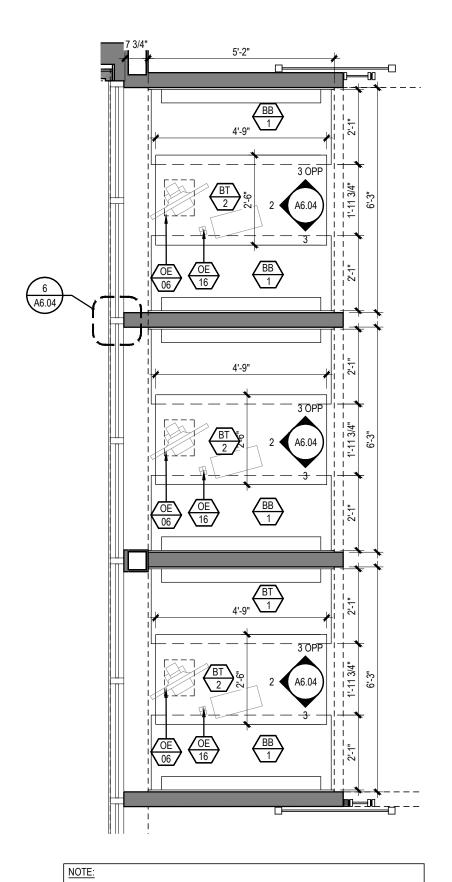



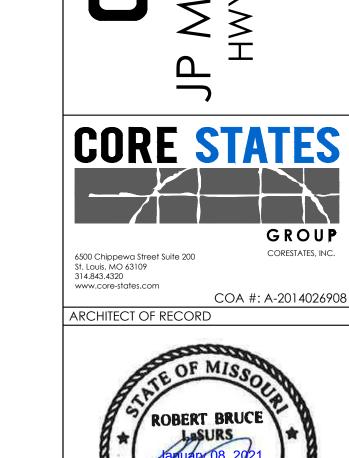

ARCHITECT: R. BRUCE LASURS LICENSE NUMBER: 007504 THESE DRAWINGS ARE NOT COMPLETE WITHOUT THE SEPARATE TYPE WRITTEN SPECIFICATIONS MANUAL WHICH ARE PART OF THE CONTRACT DOCUMENTS.

DESCRIPTION 2020.12.21 PERMIT SET


PROJECT INFORMATION PROJECT NO: JPM.27135.001 2020.12.21 PROTOTYPE: C.THEBEAU B.LaSURS DRAWN BY: CHECKED BY: VERSION: SE_1.00

COMMUNITY WALL AND BOOTH: ENLARGED PLANS, ELEVATIONS, AND DETAILS


SHEET TITLE

SHEET NUMBER


A6.04

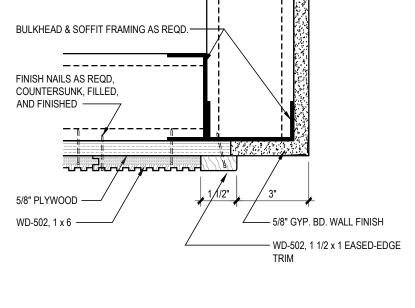




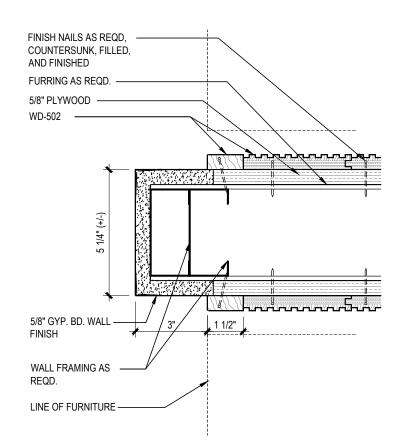



BOOTH WALL DETAIL

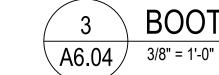



BOOTH SEAT WALL ELEVATION

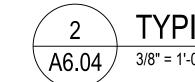


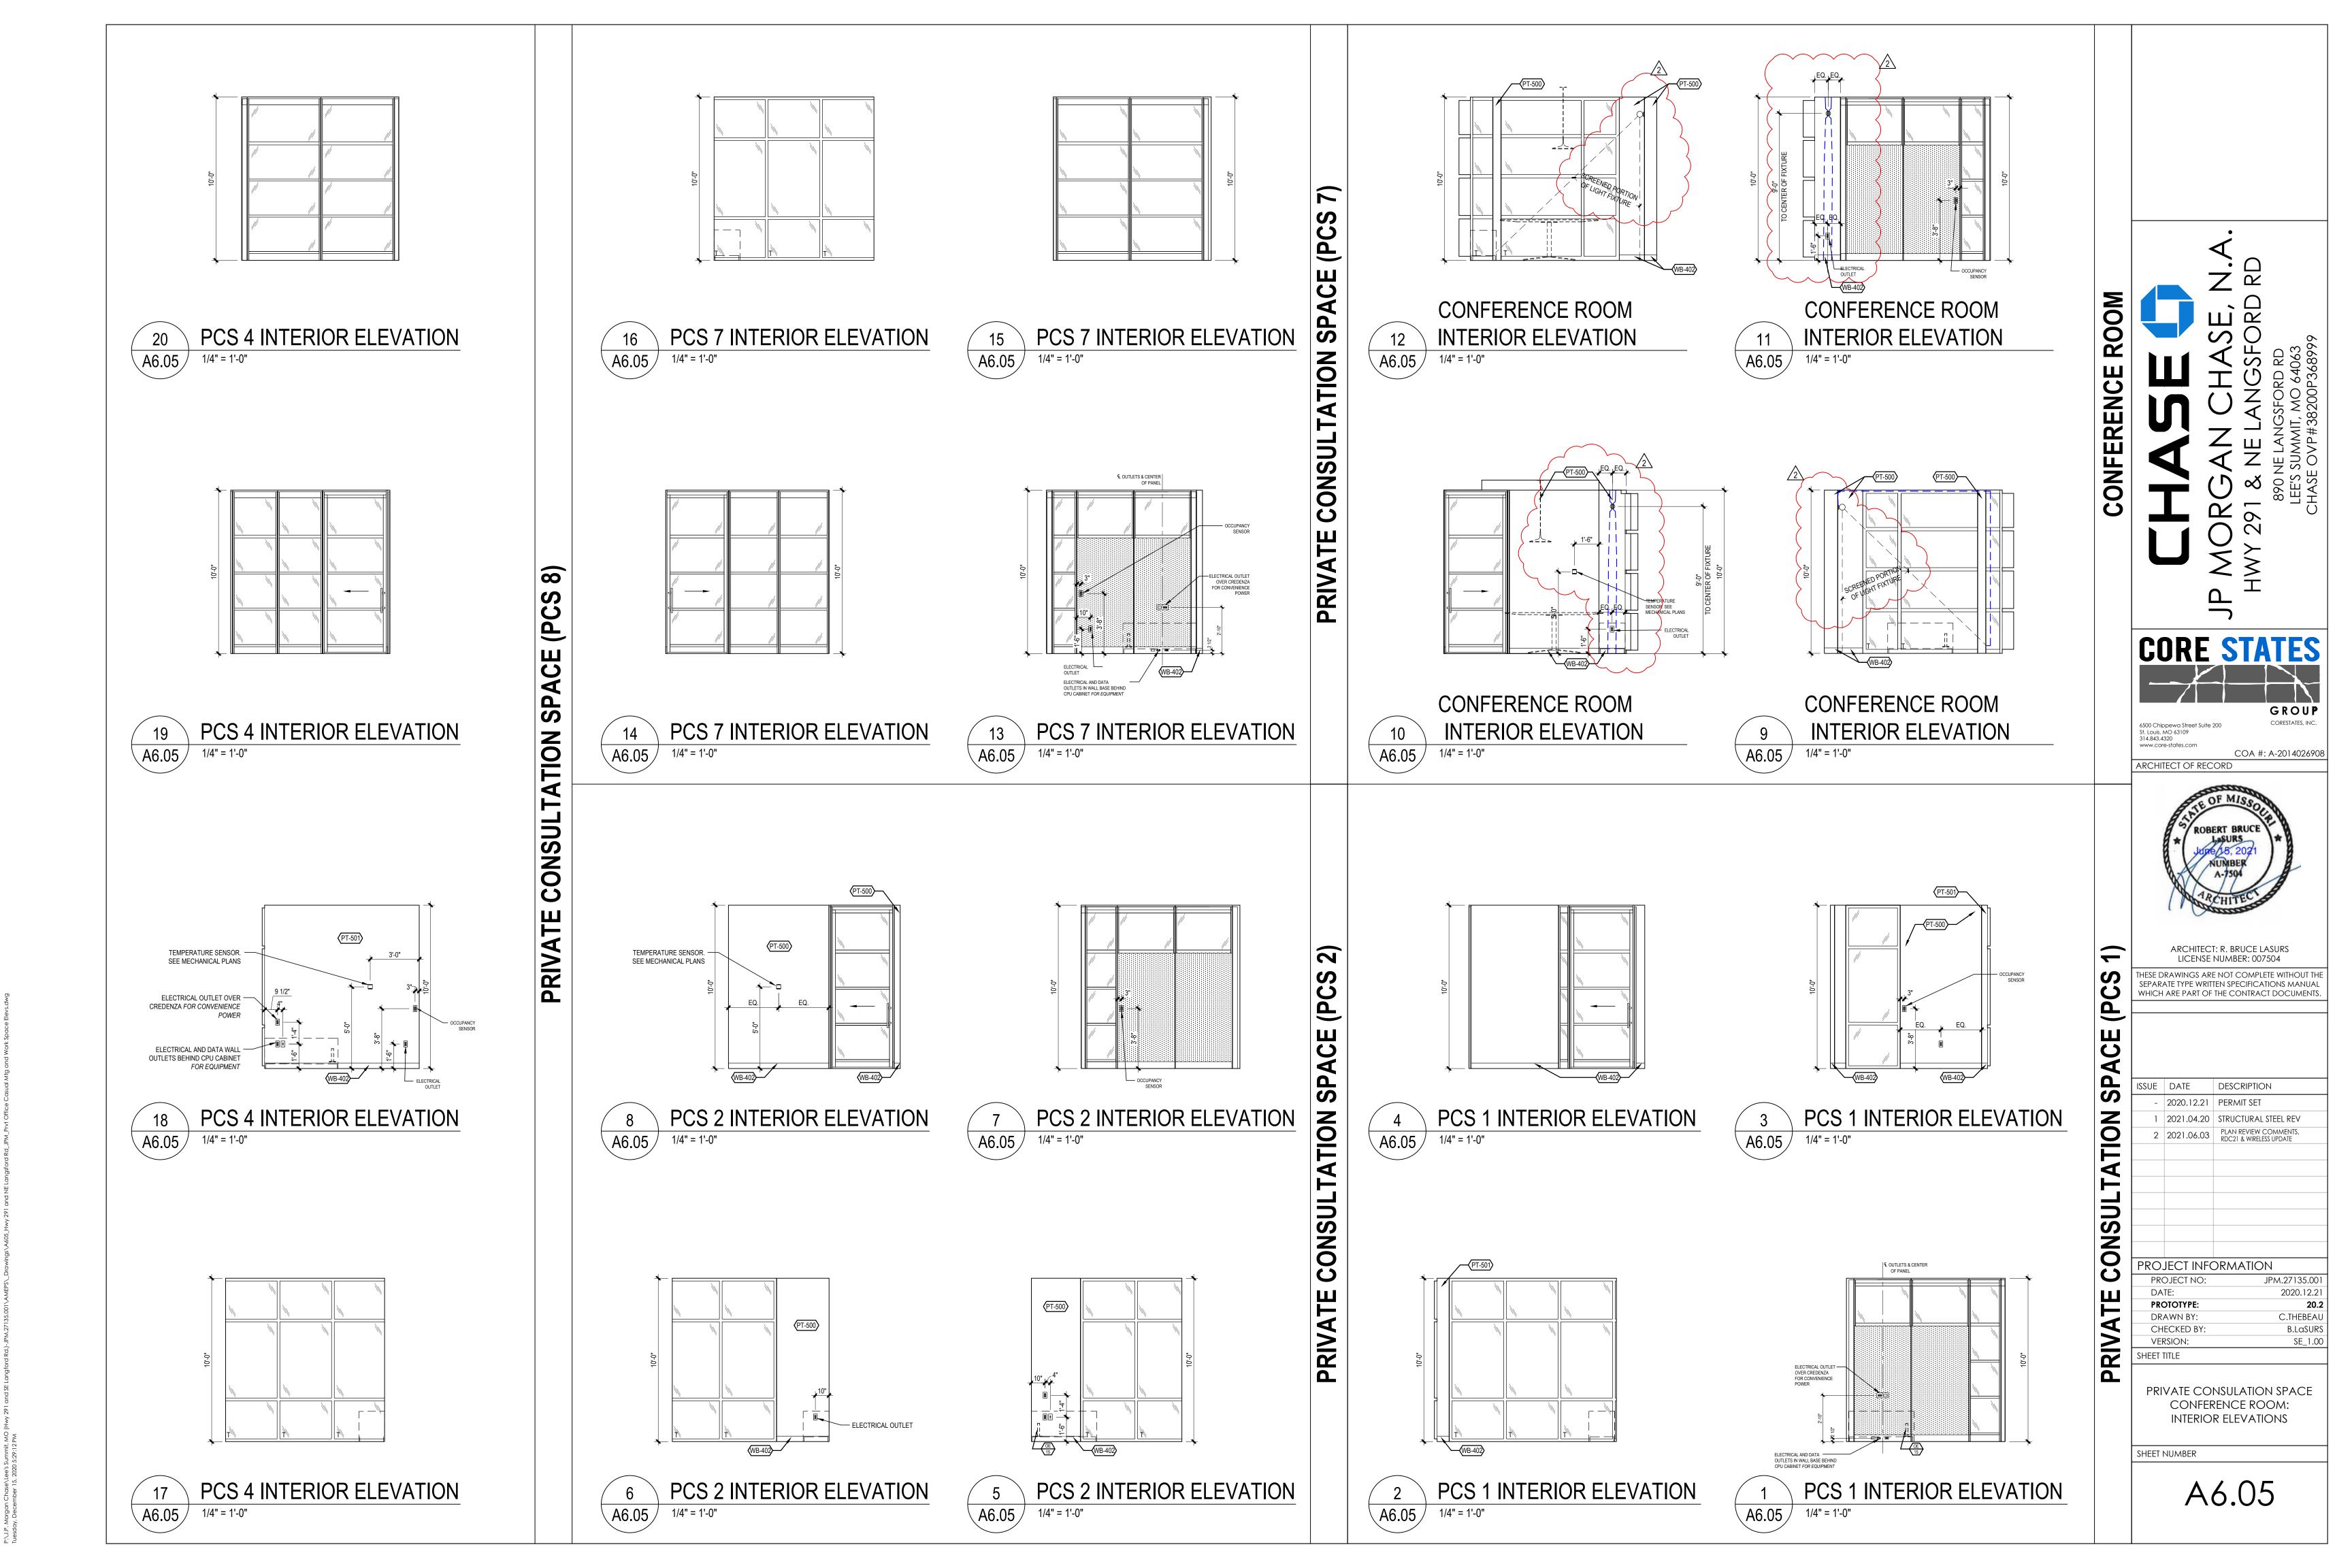


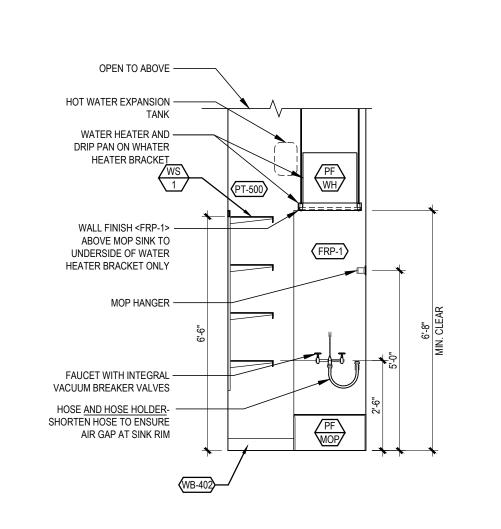

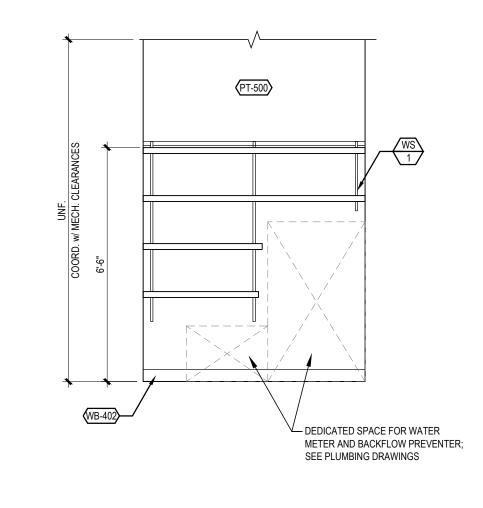

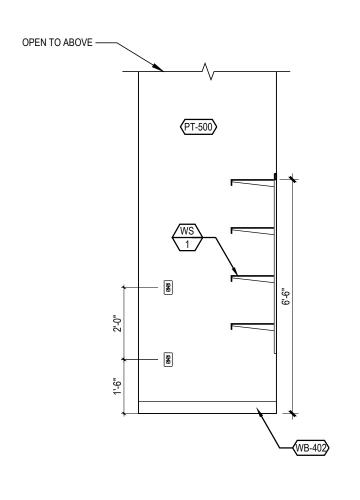

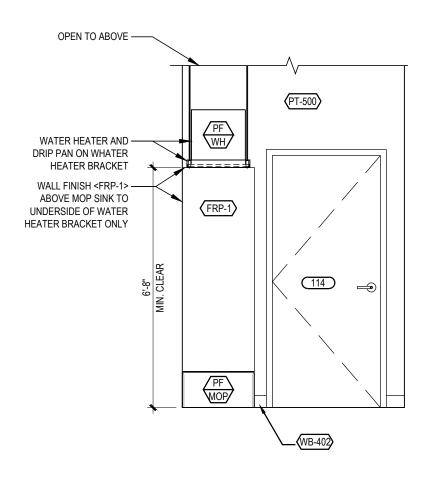

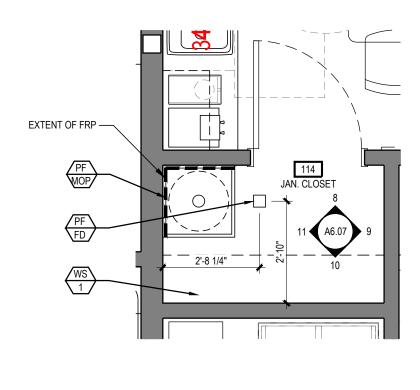

OSE

JANITO













— SCHLUTER QUADEC CAP; CLEAR ANOD.

ALUM; MITER ALL




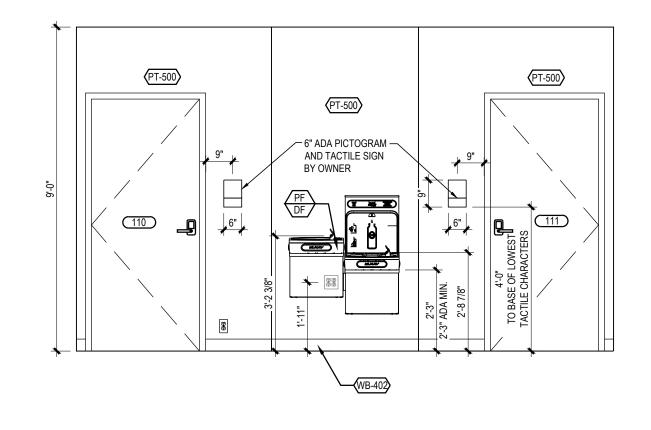


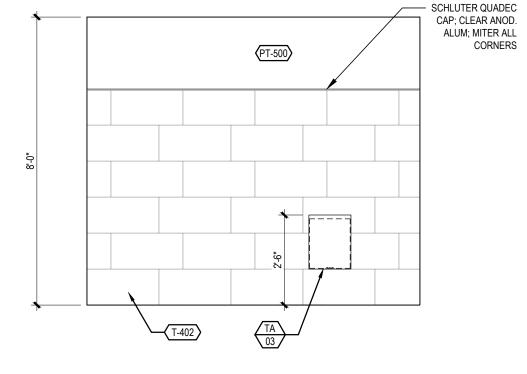







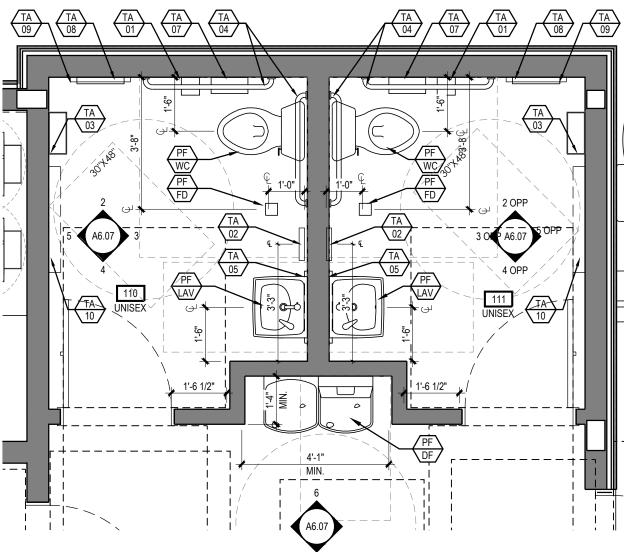

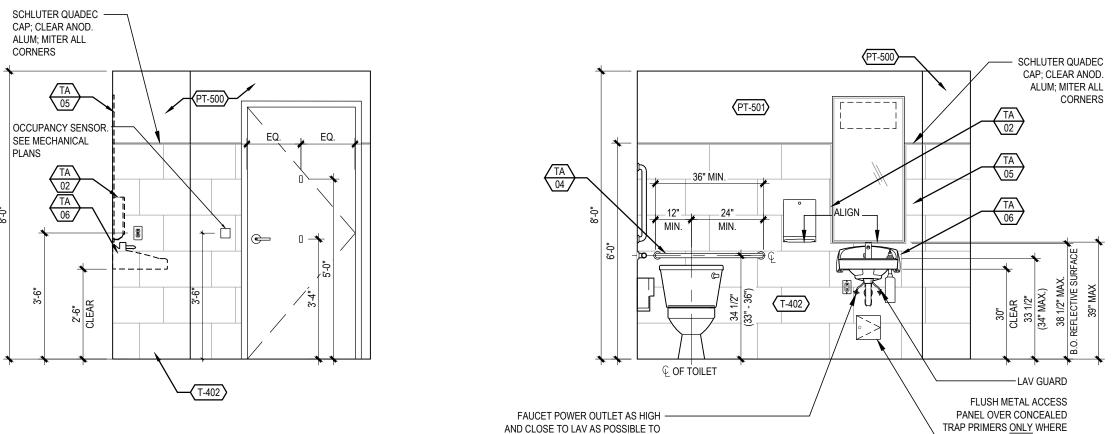

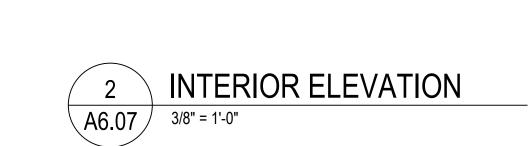





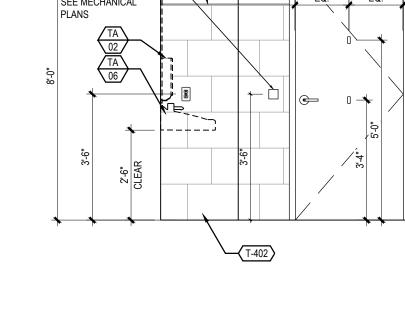

INTERIOR ELEVATION

A6.07 3/8" = 1'-0"

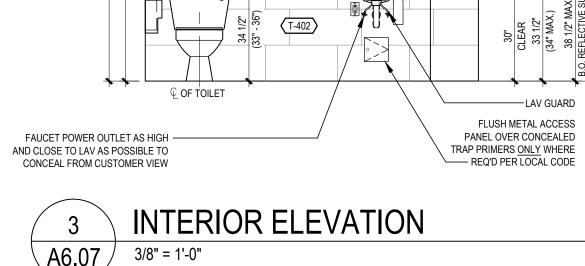

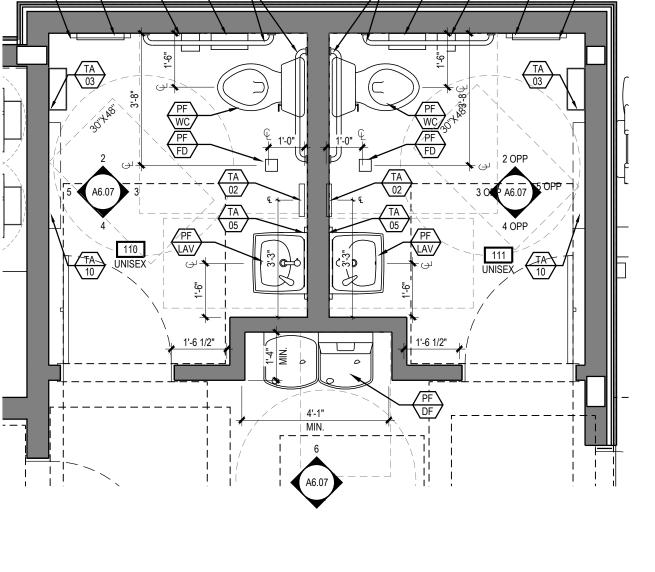

PLANS AND INTERIOR ELEVATIONS . SEE "FLOOR CONSTRUCTION PLANS" FOR ALL DOOR & WINDOW TAGS. SHEET NUMBER

A6.07

RESTROOM AND

JANITOR: ENLARGED

GROUP

COA #: A-2014026908

6500 Chippewa Street Suite 200 St. Louis, MO 63109 314.843.4320

ARCHITECT OF RECORD

STROOMS

ROBERT BRUCE

ARCHITECT: R. BRUCE LASURS

LICENSE NUMBER: 007504 HESE DRAWINGS ARE NOT COMPLETE WITHOUT THE

SEPARATE TYPE WRITTEN SPECIFICATIONS MANUAL WHICH ARE PART OF THE CONTRACT DOCUMENTS.

DESCRIPTION

2020.12.21 PERMIT SET

PROJECT INFORMATION

JPM.27135.001

2020.12.21 **20.2**

C.THEBEAU B.LaSURS

SE_1.00


PROJECT NO:

PROTOTYPE:


DRAWN BY: CHECKED BY:

VERSION:


SHEET TITLE

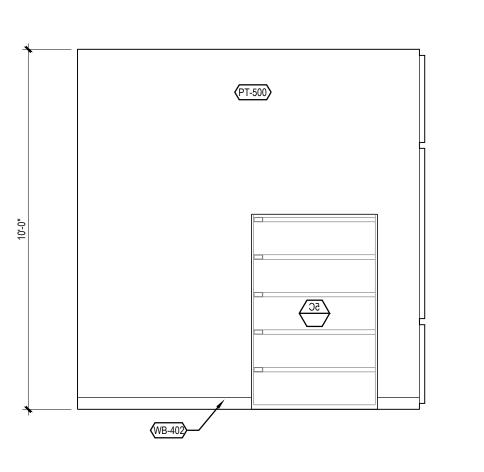




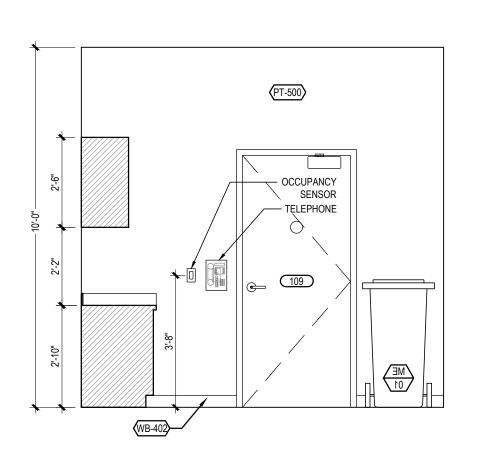


9 INTERIOR ELEVATION
A6.08 3/8" = 1'-0"

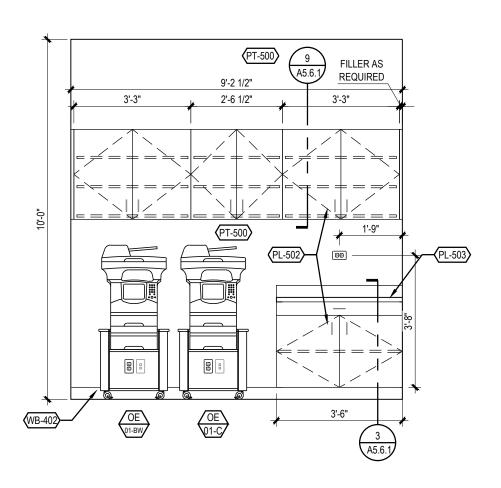


8 INTERIOR ELEVATION
A6.08 3/8" = 1'-0"

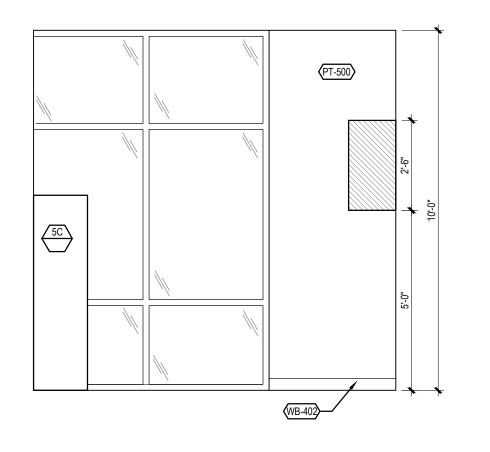




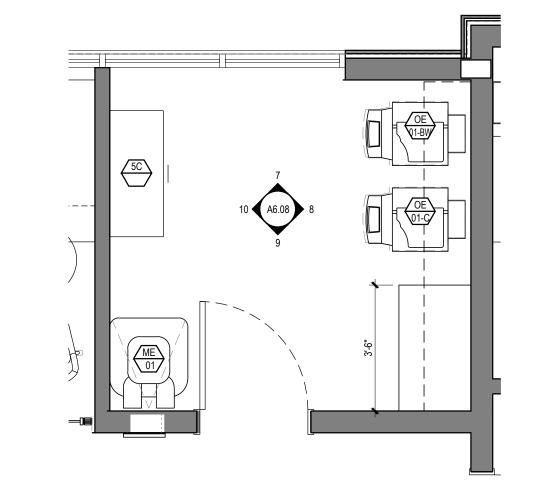


6 ENLARGED PRINT/FILE ROOM PLAN
A6.08 3/8" = 1'-0"

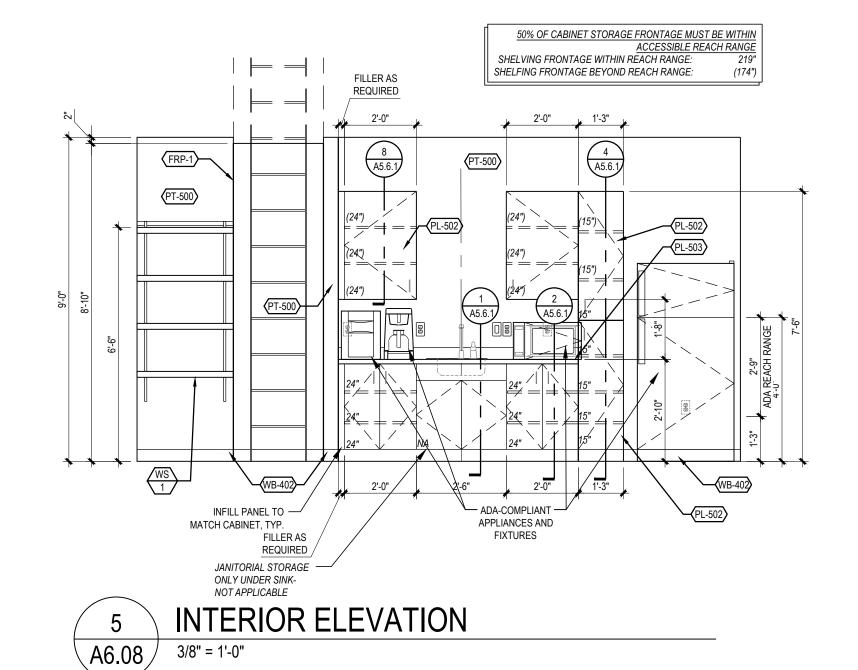


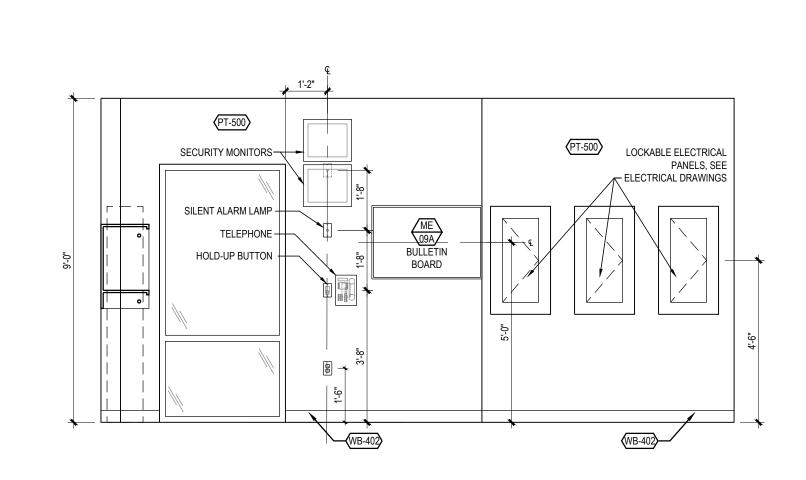




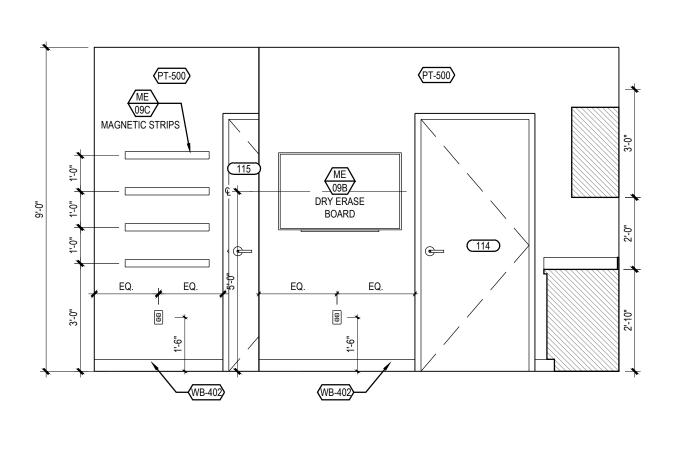



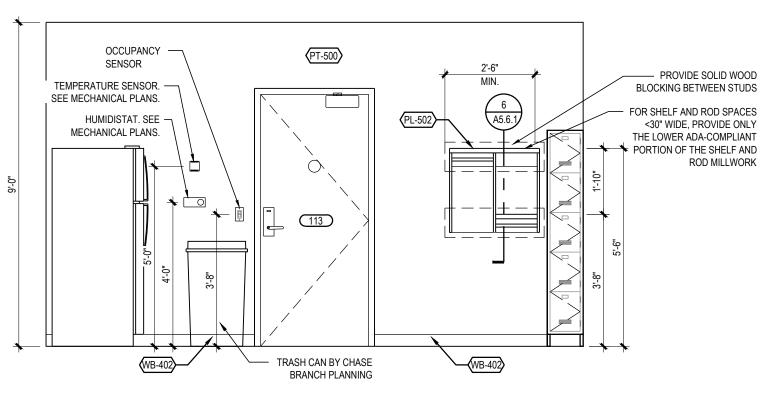



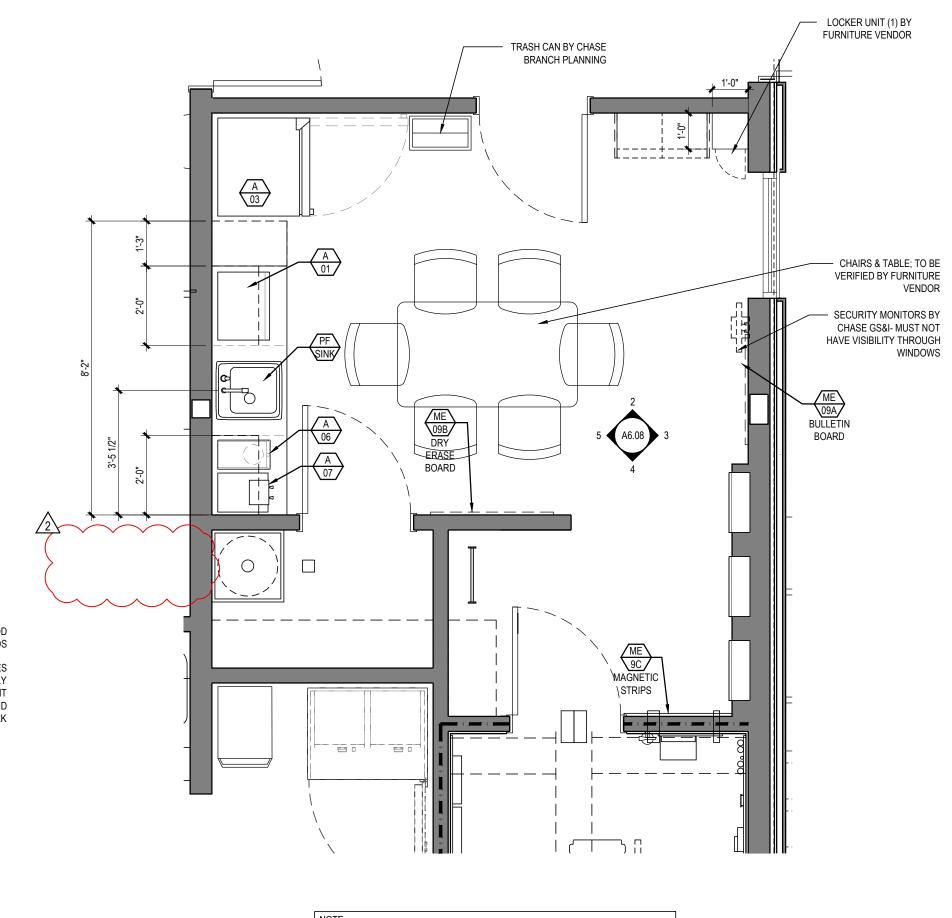

SEE "FLOOR CONSTRUCTION PLANS" FOR ALL WALL, DOOR & WINDOW TAGS.
 ALL FURNITURE TO BE VERIFIED BY CLIENT & FURNITURE VENDOR.

√80.6A

ENLARGED LOUNGE PLAN

GROUP

6500 Chippewa Street Suite 200
St. Louis, MO 63109
314.843.4320
www.core-states.com

COA #: A-2014026908

ARCHITECT OF RECORD

ROOM

ARCHITECT: R. BRUCE LASURS
LICENSE NUMBER: 007504

THESE DRAWINGS ARE NOT COMPLETE WITHOUT THE
SEPARATE TYPE WRITTEN SPECIFICATIONS MANUAL
WHICH ARE PART OF THE CONTRACT DOCUMENTS.

ISSUE DATE DESCRIPTION

- 2020.12.21 PERMIT SET

1 2021.04.20 STRUCTURAL STEEL REV

2 2021.06.03 PLAN REVIEW COMMENTS, RDC21 & WIRELESS UPDATE

PROJECT INFORMATION

PROJECT NO: JPM.27135.001

DATE: 2020.12.21

PROTOTYPE: 20.2

DRAWN BY: C.THEBEAU

CHECKED BY: B.LaSURS

VERSION: SE_1.00


LOUNGE, FILE, AND PRINTER ROOM: ENLARGED PLANS AND INTERIOR ELEVATIONS

SHEET TITLE

SHEET NUMBER


۸ / ೧۲

A6.08

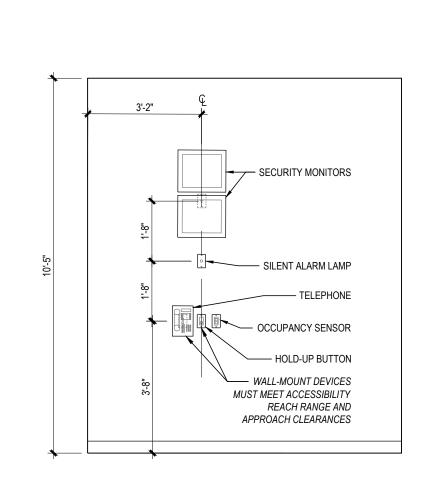


INTERIOR ELEVATION - HALLWAY

A6.10 3/8" = 1'-0"

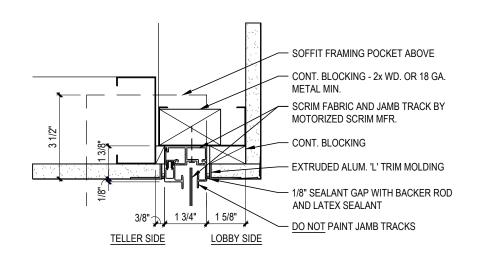


7 SCRIM JAMB
A6.10 3" = 1'-0"

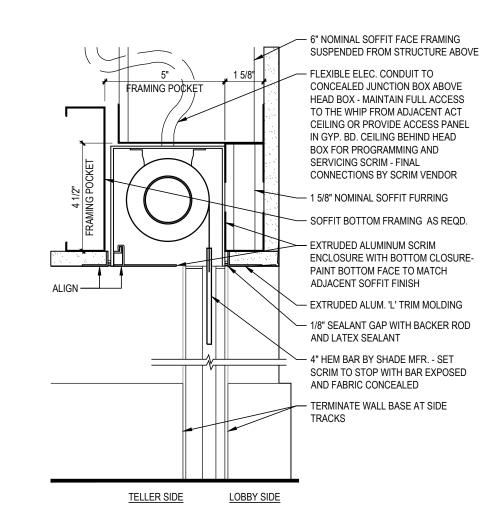


6 SCRIM HEAD

3" = 1'-0"

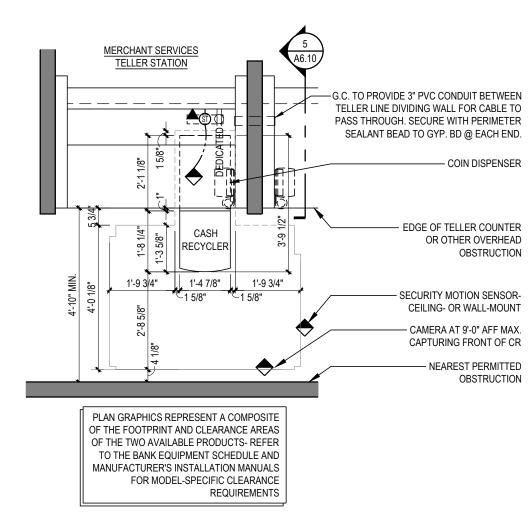


CASH RECYCLER CLEARANCES AND CONNECTIONS


3/8" = 1'-0"

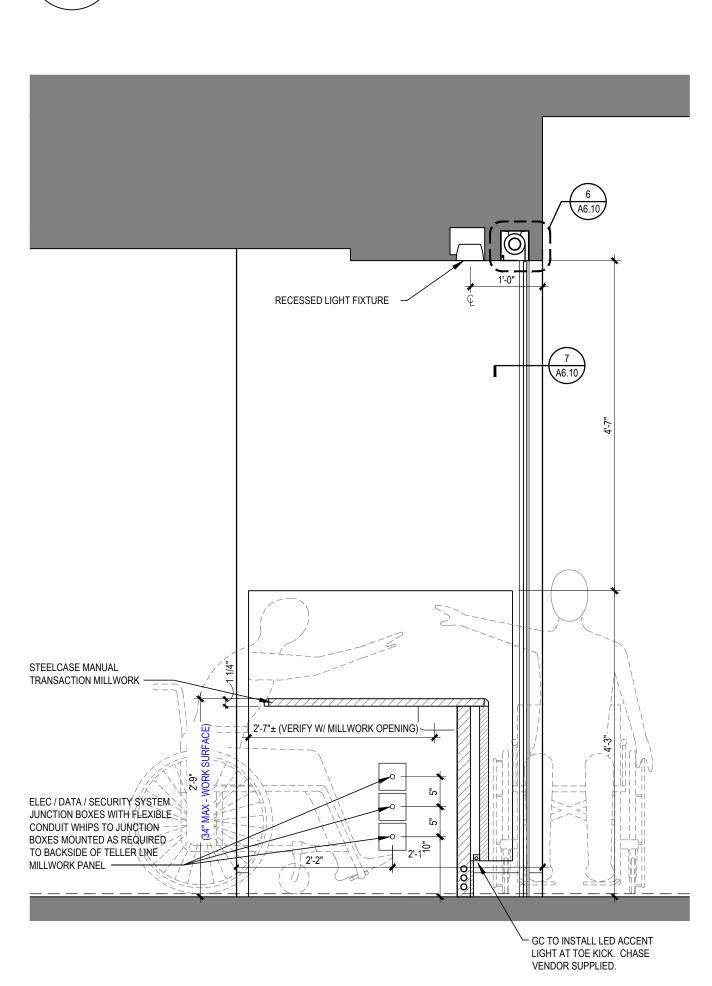




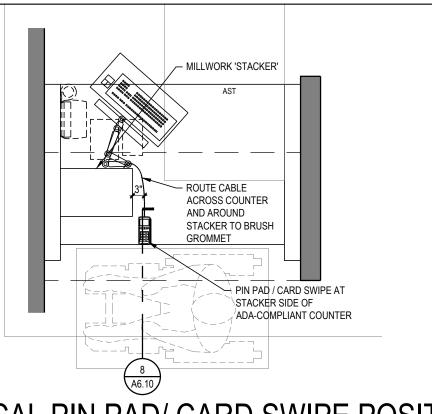


9 TYPICAL PIN PAD/ CARD SWIPE POSITON
A6.10 1/2" = 1'-0"

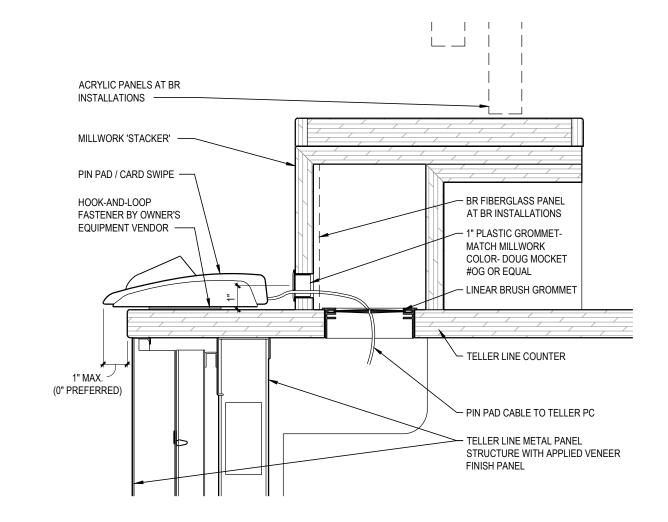


8 PIN PAD/ CARD SWIPE MOUNTING DETAIL
A6.10 3" = 1'-0"

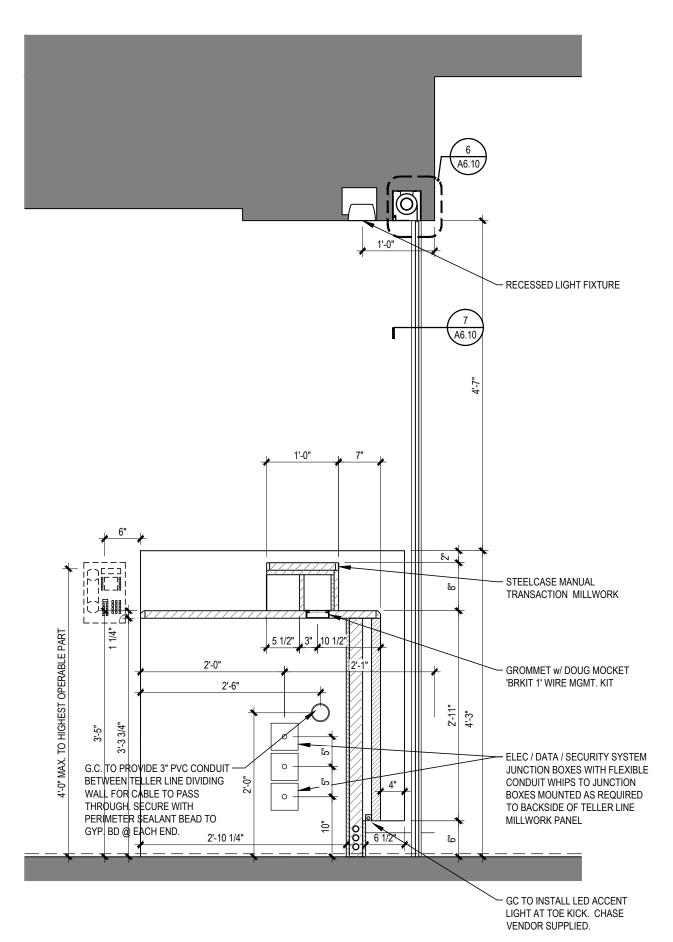


SECTION @ STANDARD TELLER

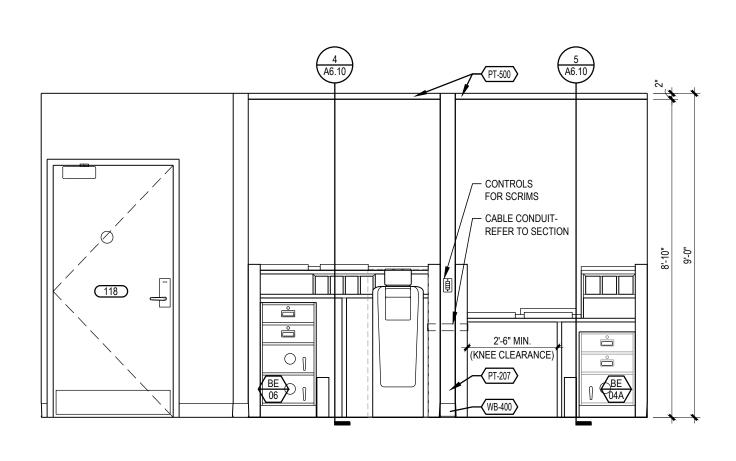

3 INTERIOR ELEVATION - EMPLOYEE SIDE A6.10 3/8" = 1'-0"

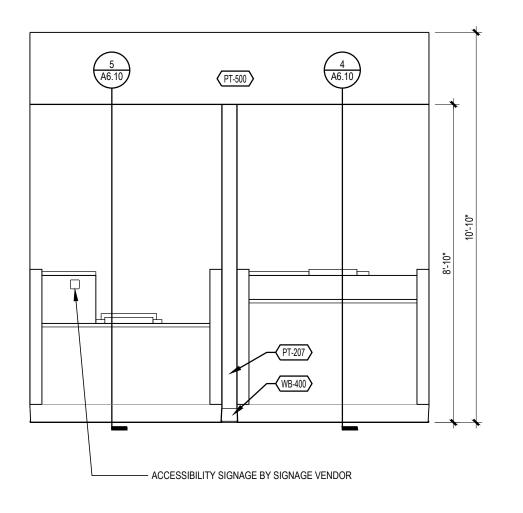


2 INTERIOR ELEVATION - CUSTOMER SIDE 3/8" = 1'-0"

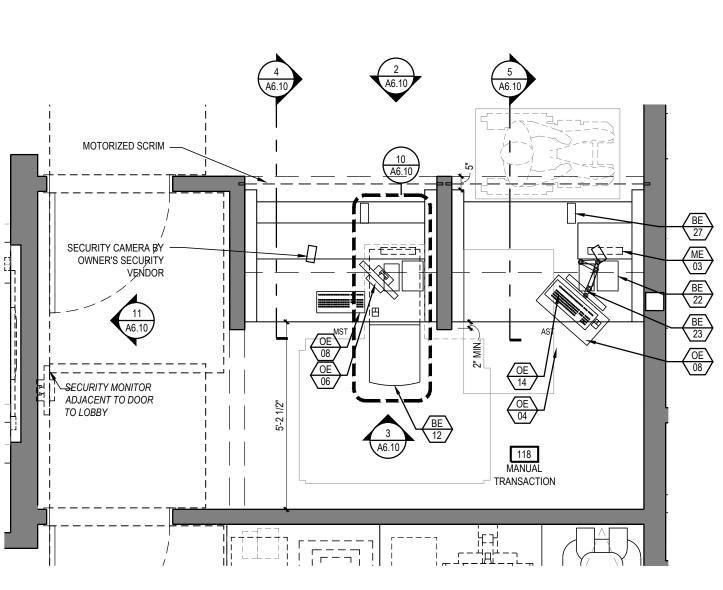

1 ENLARGED TELLER PLAN
A6 10 3/8" = 1'-0"





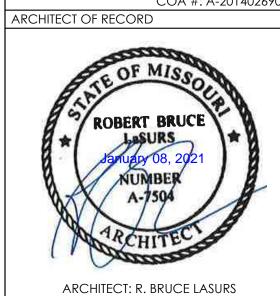

LICENSE NUMBER: 007504

THESE DRAWINGS ARE NOT COMPLETE WITHOUT THE SEPARATE TYPE WRITTEN SPECIFICATIONS MANUAL WHICH ARE PART OF THE CONTRACT DOCUMENTS.

	ISSUE	DATE	DESCRIPTION
	-	2020.12.21	PERMIT SET
}			
/			
)			
}			
'			

PROJECT INF	ORMATION
PROJECT NO:	JPM.27135.0
DATE:	2020.12.
PROTOTYPE:	20
DRAWN BY:	C.THEBE
CHECKED BY:	B.LaSU
VERSION:	SE_1.
SHEET TITLE	_

MANUAL TRANSACTION: ENLARGED PLAN, INTERIOR ELEVATIONS, AND DETAILS

SHEET NUMBER

A6.10

GENERAL STRUCTURAL NOTES

- CONTRACTOR IS RESPONSIBLE FOR AND SHALL VERIFY AND COORDINATE ALL DIMENSIONS AND DETAILS BEFORE PROCEEDING WITH WORK. ANY DISCREPANCIES SHALL BE BROUGHT TO THE
- IMMEDIATE ATTENTION OF THE ARCHITECT AND ENGINEERS 2. DETAILS SHOWN IN ANY SECTION APPLY TO ALL SIMILAR SECTIONS AND CONDITIONS UNLESS NOTED
- 3. CONTRACTOR SHALL FULLY BRACE AND OTHERWISE PROTECT ALL WORK IN PROGRESS UNTIL THE BUILDING IS COMPLETED.
- 4. THE STRUCTURAL DRAWINGS SHALL BE USED IN CONJUNCTION WITH THE SPECIFICATIONS AND THE ARCHITECTURAL AND MECHANICAL DRAWINGS. IF THERE IS A DISCREPANCY BETWEEN DRAWINGS, IT IS THE CONTRACTOR'S RESPONSIBILITY TO NOTIFY THE ARCHITECT PRIOR TO PERFORMING WORK. IN CASE OF CONFLICT THE MOST STRINGENT CONDITION SHALL APPLY.
- ALL DIMENSIONS MUST BE COORDINATED WITH ARCHITECTURAL DRAWINGS AND WITH EQUIPMENT MANUFACTURER (I.E. WINDOW, DOOR, AIR HANDLER, ETC.). CONTRACTOR MUST OBTAIN AN ARCHITECTURAL DIRECTIVE IN CASE OF ANY CONFLICT. REFER TO ARCHITECTURAL DRAWINGS FOR DIMENSIONS NOT SHOWN IN STRUCTURAL DRAWINGS.

GOVERNING BUILDING CODE: 2018 INTERNATIONAL BUILDING CODE

DO NOT SCALE OFF DRAWINGS.

• •	THE CONTESTINE	"
2.	MINIMUM FIRST FLOOR LIVE LOADS: A. UNIFORM LIVE LOAD B. CONCENTRATED LIVE LOAD C. IMPACT LOAD D. LIVE LOAD REDUCTION	= 100 PSF = 2000 LB = N/A = N/A
3.	ROOF DEAD LOAD	= 25 PSF
4.	MINIMUM ROOF LIVE LOAD	= 20 PSF
5.	ROOF SNOW DATA: A. SNOW IMPORTANCE FACTOR, IS B. GROUND SNOW LOAD, Pg C. FLAT ROOF SNOW LOAD, Pf D. SNOW EXPOSURE FACTOR, Ce E. THERMAL FACTOR, Ct F. DRIFT LOAD DATA INDICATED ON ROOF FRAMING PLAN	= 1.00 = 20 PSF = 20 PSF = 1.0 = 1.0
6.	WIND DESIGN DATA: A. WIND IMPORTANCE FACTOR, IW B. ULTIMATE DESIGN WIND SPEED (3 SECOND GUST), VULT NOMINAL DESIGN WIND SPEED, VASD C. WIND EXPOSURE CATEGORY D. INTERNAL PRESSURE COEFFICIENTS E. WIND DESIGN PRESSURES PER ASCE 7-10	= 1.0 = 110 MPH = 85 MPH = B = ±0.18
7.	SEISMIC DESIGN DATA: A. SEISMIC IMPORTANCE FACTOR, Ie B. MAPPED SPECTRAL RESPONSE COEFFICIENTS SS S1 C. SITE CLASS D. DESIGN SPECTRAL RESPONSE COEFFICIENTS SDS SD1 E. SEISMIC DESIGN CATEGORY F. BASIC SEISMIC FORCE RESISTANCE SYSTEMS: STEEL SYSTEMS G. SEISMIC RESISTANCE (R = 3.0) H. DESIGN BASE SHEAR, V I. SEISMIC RESPONSE COEFFICIENTS, Cs J. PROCEDURE: EQUIVALENT LATERAL FORCE PROCEDURE	= 1.00 = 0.100 = 0.068 = C = 0.087 = 0.068 = B TEMS NOT SPECIFICALLY DETAILED FOR = 4.8 KIPS = 0.025

FOUNDATIONS AND SLAB-ON-GRADE

8. FOUNDATION DESIGN DATA

FLOOD DESIGN DATA:

10. SPECIAL LOADS:

ALLOWABLE BEARING PRESSURE

FTG.MINIMUM FROST DEPTH

FOUNDATIONS HAVE BEEN DESIGNED IN ACCORDANCE WITH GEOTECHNICAL RECOMMENDATIONS PROVIDED BY PROFESSIONAL SERVICE INDUSTRIES, INC. (PSI) IN THEIR PROJECT No. 03382159 DATED DECEMBER 2, 2020. 2. ALL SUBGRADE SHALL BE PREPARED IN STRICT CONFORMANCE TO THE GEOTECHNICAL ENGINEER'S

= 2300 PSF COLS., 1900 PSF STRIP

- RECOMMENDATIONS. REFER TO THE GEOTECHNICAL REPORT, SUPPLEMENTARY LETTERS AND SPECIFICATIONS FOR ADDITIONAL INFORMATION. THE CONTRACTOR SHALL NOTIFY THE ARCHITECT OR ENGINEER OF RECORD IMMEDIATELY IN THE EVENT
- THAT THE SOIL CONDITIONS ENCOUNTERED VARY FROM THOSE SHOWN ON THE BORING LOGS.
- ALL EXTERIOR FOOTINGS SHALL EXTEND BELOW THE MAXIMUM ANTICIPATED DEPTH OF FROST ANY FILL REQUIRED BELOW SLABS-ON-GRADE OR FOOTINGS SHALL BE COMPACTED AS REQUIRED BY THE
- 6. ALL FOOTINGS SHALL BEAR ON SOIL CAPABLE OF SUSTAINING AN ALLOWABLE BEARING PRESSURE AS NOTED
- ABOVE FOR FOOTINGS UNDER FULL SERVICE DEAD AND LIVE LOADS ALL BEARING MATERIAL SHALL BE INSPECTED BY THE INDEPENDENT TESTING AGENCY PRIOR TO CONCRETE
- PLACEMENT. THE INDEPENDENT TESTING AGENCY SHALL BE THE SOLE JUDGE AS TO THE SUITABILITY OF THE BEARING MATERIAL. FOOTING ELEVATIONS SHALL BE ADJUSTED AS REQUIRED.
- 8. THE TOP OF EXTERIOR FOOTING ELEVATION SHALL BE SET A MINIMUM OF 8" BELOW LOWEST FINAL ADJACENT EXTERIOR GRADE AND A MINIMUM OF 8" BELOW FINISH FLOOR. THE BOTTOM OF EXTERIOR FOOTINGS SHALL
- BEAR AT MINIMUM BEARING DEPTH BELOW LOWEST FINAL ADJACENT EXTERIOR GRADE
- FINAL ADJACENT GRADE IS DEFINED AS THE LOWEST ADJACENT GRADE WITHIN 5 FEET OF THE FOUNDATION FOR PERIMETER (OR EXTERIOR) FOOTINGS AND FINISHED FLOOR LEVEL FOR INTERIOR FOOTINGS. VERIFY THE USE AND EXTENT OF PERIMETER INSULATION WITH THE ARCHITECTURAL DRAWINGS PRIOR TO
- THE INSTALLATION OF FOUNDATIONS. INSTALL PERIMETER INSULATION AS REQUIRED. STANDARD PROCEDURES OF FROST PROTECTION FOR FOUNDATIONS AND EXCAVATIONS SHALL BE
- EMPLOYED FOR WINTER CONSTRUCTION. BACK FILLING OF EXCAVATIONS SHALL BE DONE AS SOON AS
- POSSIBLE TO PROTECT FOUNDATIONS FROM FROST. 12. HORIZONTAL BARS IN FOOTINGS AND CONCRETE WALLS SHALL BE CONTINUOUS. PROVIDE CORNER BARS AT
- ALL CORNERS AND INTERSECTIONS, UNO.
- 13. FOUNDATION PENETRATIONS SHALL BE SUBJECT TO APPROVAL BY THE ARCHITECT/ENGINEER. PENETRATIONS SHALL BE FOUNDATION STEM WALL OR 6" CLEAR BELOW FOOTING.


CONCRETE AND REINFORCING STEEL

- ALL CONCRETE AND REINFORCEMENT SHALL BE IN ACCORDANCE WITH THE LATEST EDITION OF AMERICAN CONCRETE INSTITUTE BUILDING CODE (ACI 318) AND WITH SPECIFICATIONS FOR STRUCTURAL
- CONCRETE FOR BUILDINGS (ACI 301). ALL CONCRETE SHALL BE NORMAL-WEIGHT (DENSITY=145 PCF) AND SHALL HAVE A 28-DAY
- COMPRESSIVE STRENGTH AS NOTED IN THE TABLE BELOW. THE SLUMP OF ALL CONCRETE SHALL BE 4" ±1".
- ALL EXTERIOR CONCRETE SHALL BE AIR-ENTRAINED PER ACI-318, LATEST EDITION, BASED ON
- FREEZE-THAW EXPOSURE SEVERITY AND AGGREGATE SIZE.
- MAXIMUM NOMINAL COURSE AGGREGATE SIZE SHALL BE 3/4" TYPICAL UNLESS NOTED OTHERWISE.
- THE MINIMUM PORTLAND CEMENT CONTENT (ASTM C150 TYPE I/II) OF ALL CONCRETE SHALL CONFORM TO THE FOLLOWING TABLE:

LOCATION SPECIFIED COMPRES STRENGTH (PSI)			
SLAB-ON-GRADE	4000	0.45 - 0.55	2 ±1
FOUNDATIONS	4500	0.45 - 0.55	5 ±1

- 7. ALL REINFORCED CONCRETE WORK SHALL BE PER "BUILDING CODE REQUIREMENTS FOR STRUCTURAL CONCRETE" ACI 318, LATEST EDITION.
- THE CONTRACTOR SHALL SUBMIT CONCRETE MIX DESIGNS FOR REVIEW A MINIMUM OF TWO WEEKS PRIOR TO THE PLACEMENT OF ANY CONCRETE. THE CONCRETE MIX DESIGNS SHALL INCLUDE ALL
- STRENGTH DATA NECESSARY TO SHOW COMPLIANCE WITH THE PROJECT SPECIFICATIONS. CONCRETE REINFORCING STEEL SHALL CONFORM TO ASTM A615, GRADE 60, UNLESS NOTED
- WELDED WIRE FABRIC SHALL CONFORM TO ASTM A-185.
- CONCRETE REINFORCING STEEL TO BE WELDED SHALL CONFORM TO ASTM A706.
- HOOK ENDS OF BARS INTERRUPTED BY OPENINGS. HOOK TOP BARS AT ALL EDGES. AT ALL WALL AND SLAB OPENINGS, PROVIDE 2 - #5BARS x OPENING WIDTH PLUS 4 FEET(EACH SIDE) EACH FACE UNLESS
- ALL REINFORCING SHALL BE DETAILED, FABRICATED, AND PLACED IN ACCORDANCE WITH THE LATEST
- EDITION OF THE AMERICAN CONCRETE INSTITUTE DETAILING MANUAL ALL REINFORCING SHALL BE SUPPORTED IN FORMS, SPACED WITH NECESSARY ACCESSORIES AND SHALL BE SECURELY WIRED TOGETHER, IN ACCORDANCE WITH THE LATEST EDITION OF THE CRSI "MANUAL OF STANDARD PRACTICE".
- THE GENERAL CONTRACTOR SHALL CHECK WITH ARCHITECTURAL, MECHANICAL AND ELECTRICAL DRAWINGS AND THE SUB-CONTRACTORS FOR OPENINGS, SLEEVES, ANCHORS, HANGERS, INSERTS, SLAB DEPRESSIONS AND OTHER ITEMS RELATED TO THE CONCRETE WORK AND SHALL ASSUME RESPONSIBILITY FOR THEIR PROPER LOCATION.

- ALL STRUCTURAL MEMBERS SHALL BE DESIGNED IN ACCORDANCE WITH AISI-NAS, "SPECIFICATION FOR THE DESIGN OF COLD FORMED STRUCTURAL MEMBERS", LATEST EDITION. PROVIDE SIGNED AND SEALED CALCULATIONS AND DRAWINGS FOR ALL LIGHT GAGE STRUCTURAL ELEMENTS OF THE BUILDING, INCLUDING THE EXTERIOR METAL STUDS (CURTAIN WALL), AND ALL EXTERIOR CEILINGS.
- 2. ALL STRUCTURAL STUDS AND JOISTS 22, 20, AND 18 GAUGES SHALL BE FORMED FROM GALVANIZED STEEL PER ASTM A653, G60 COATING MEETING THE REQUIREMENTS OF ASTM C955 WITH A YIELD STRENGTH OF 33,000 PSI
- 3. ALL STRUCTURAL STUDS AND JOISTS 16, 14, AND 12 GAUGES SHALL BE FORMED FROM GALVANIZED STEEL PER ASTM A653, G60 COATING MEETING ASTM C955, WITH YIELD STRENGTH OF 50,000 PSI.
- 4. ALL STRUCTURAL TRACK AND BRIDGING SHALL BE FORMED FROM GALVANIZED STEEL PER ASTM A653, G60 COATING MEETING THE REQUIREMENTS OF ASTM C595, WITH YIELD STRENGTH OF 33,000
- WITH EACH TYPE OF METAL FRAMING REQUIRED, PROVIDE MANUFACTURER'S STANDARD STEEL RUNNERS (TRACKS), BLOCKING, LINTELS, CLIP ANGELS, SHOES, REINFORCEMENTS, FASTENERS, AND ACCESSORIES AS RECOMMENDED BY MANUFACTURER FOR APPLICATIONS INDICATED, AS NEEDED TO PROVIDE A COMPLETE METAL FRAMING SYSTEM.
- PROVIDE GALVANIZED FINISH TO METAL FRAMING COMPONENTS COMPLYING WITH ASTM A653 FOR MINIMUM G60 COATING. ATTACH SIMILAR COMPONENTS BY WELDING. ATTACH DISSIMILAR COMPONENTS BY WELDING, BOLTING OR SCREW FASTENERS, AS STANDARD WITH MANUFACTURER ALL WELDING SHALL BE PERFORMED BY WELDERS CERTIFIED AND EXPERIENCED IN LIGHT GAGE STRUCTURAL STEEL FRAMING WORK.
- INSTALL METAL FRAMING SYSTEMS IN ACCORDANCE WITH MANUFACTURER'S PRINTED OR WRITTEN INSTRUCTIONS AND RECOMMENDATIONS, UNLESS OTHERWISE INDICATED.
- 8. INSTALL CONTINUOUS TRACKS SIZED TO MATCH STUDS.
- 9. WHERE STUD SYSTEM ABUTS STRUCTURAL COLUMN OR WALLS, ANCHOR ENDS OF STIFFENERS TO SUPPORTING STRUCTURE.
- 10. SECURE STUDS TO TOP AND BOTTOM RUNNER TRACKS BY EITHER WELDING OR SCREW FASTENERS AT BOTH INSIDE AND OUTSIDE FLANGES.
- 11. LIGHT GAGE METAL SHOP DRAWINGS AND CALCULATIONS MUST BE SIGNED BY A REGISTERED PROFESSIONAL ENGINEER IN THE STATE IN WHICH THIS SITE IS LOCATED.

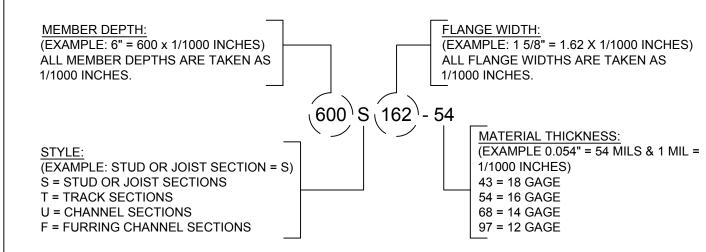

LIGHT GAGE METAL FRAMING PRODUCT IDENTIFICATION

ACCORDING TO STEEL STUD MANUFACTURERS ASSOCIATION FOUR PART IDENTIFICATION CODE SYSTEM

- THE USE OF ROLLED STEEL SECTIONS AND/OR BOLTS MANUFACTURED OUTSIDE THE UNITED STATES WILL REQUIRE VERIFICATION THAT THE PRODUCTS COMPLY WITH APPLICABLE ASTM STANDARDS. MILL CERTIFICATES WILL BE REQUIRED FOR ALL STEEL. STRUCTURAL STEEL GRADES NOT MEETING THE ASTM SPECIFICATIONS FOR ROLLED SHAPES LISTED IN AISC STEEL
- CONSTRUCTION MANUAL TABLE 2-4 WILL REQUIRE TESTING BY AN APPROVED LABORATORY. ALL STRUCTURAL STEEL WORK SHALL BE FABRICATED AND ERECTED IN ACCORDANCE WITH THE
- LATEST A.I.S.C. SPECIFICATIONS. 3. STRUCTURAL STEEL SHALL CONFORM TO:

WIDE FLANGE (WF)	ASTM A992 (50 KSI)
SHAPES (L,T,C,PL)	ASTM A36
STRUCTÙRAL TUBE (HSS)	ASTM A500 (46 KSI)
STEEL PIPE (HSS)	ASTM A500 (42 KSI)
ANCHOR BOLTS	ASTM F1553 (36 KSI) U.N.
FRAMING BOLTS	ASTM A325 OR A490
SHEAR STUDS	ASTM A108
WELDING ELECTRODES	E70XX

- ALL HIGH STRENGTH BOLTS SHALL CONFORM TO ASTM SPECIFICATION A325 AND SHALL BE PROVIDED WITH HARDENED WASHERS UNDER THE TURNED ELEMENT (NUT OR BOLT HEAD).
- INSTALLATION AND TIGHTENING OF ALL HIGH STRENGTH BOLTS SHALL CONFORM TO THE "SPECIFICATION FOR STRUCTURAL JOINTS USING ASTM A325 OR A490 BOLTS". SHOP CONNECTIONS MAY BE WELDED OR HIGH STRENGTH BOLTED. ALL BOLTS SHALL BE 3/4"
- DIAMETER MINIMUM. ALL CONNECTIONS SHALL CONFORM TO THE TYPICAL CONNECTION DETAILS SHOWN ON THE PLANS UNLESS SPECIFICALLY APPROVED BY THE ENGINEER. ALL WELDING SHALL CONFORM TO THE AMERICAN WELDING SOCIETY CODE, ANS01.1, ALL WELDING
- SHALL BE PERFORMED USING E70XX U.N.O. CUTS, HOLES, COPINGS, ETC. REQUIRED IN STRUCTURAL STEEL MEMBERS FOR THE WORK OF OTHER TRADES SHALL BE SHOWN IN THE STRUCTURAL STEEL SHOP DRAWINGS AND SHALL BE MADE
- IN THE SHOP. HOLES SHALL BE REINFORCED AS REQUIRED BY THE ENGINEER. BURNING OF HOLES, CUTS, ETC. IN STRUCTURAL STEEL MEMBERS IN THE FIELD WILL NOT BE
- PERMITTED, EXCEPT WITH THE SPECIFIC APPROVAL OF THE ENGINEER. 10. ALL STEEL MEMBERS EXPOSED TO WEATHER (SUCH AS LINTELS, DOOR JAMBS, ETC.) SHALL BE
- 11. FOR MISCELLANEOUS STEEL, SEE ARCHITECTURAL DRAWINGS.
- 12. ANY STEEL MEMBERS REQUIRED BY THE ELECTRICAL OR MECHANICAL TRADES FOR THE SUPPORT OF THEIR EQUIPMENT, WHICH ARE NOT SHOWN ON ARCHITECTURAL OR STRUCTURAL DRAWINGS, SHALL BE PROVIDED BY THE TRADE REQUIRING SUCH SUPPORT. 13. SEE SPECIFICATIONS FOR PAINTING OF STRUCTURAL STEEL. ALL FABRICATION AND ERECTION
- MARKS SHALL BE COVERED DURING FIELD TOUCH-UP PAINTING. 14. ALL CONNECTIONS TO BE DOUBLE ANGLE FRAMED BEAM CONNECTION PER AISC UNLESS NOTED OTHERWISE. ALL BOLTS TO BE 3/4" MINIMUM DIAMETER UNLESS NOTED OTHERWISE. SHOP
- CONNECTIONS MAY BE WELDED OR BOLTED. WELDS ARE TO BE EQUAL IN STRENGTH TO BOLTS. 15. DESIGN CONNECTIONS FOR THE MAXIMUM SHEAR (V IN KIPS) LISTED IN THE TABLES FOR "ALLOWABLE UNIFORM LOADS IN KIPS FOR BEAMS LATERALLY SUPPORTED" AT THE BOTTOM OF EACH PAGE IN THE "PROPERTIES AND REACTION VALUES", PART 2 OF THE LATEST EDITION OF THE AISC "MANUAL OF STEEL CONSTRUCTION". PROVIDE SIGNED AND SEALED DRAWINGS AND
- CALCULATIONS BY A PROFESSIONAL ENGINEER. 16. A REGISTERED PROFESSIONAL ENGINEER SHALL INSPECT THE WELDING AND HIGH-STRENGTH BOLTING OF STRUCTURAL STEEL FRAMING AND WELDING, BOLTING AND FASTENING OF LIGHT
- WEIGHT MATERIAL SYSTEMS, AND METAL SIDINGS OF BUILDING. 17. ALL STEEL MEMBERS SHALL BE MADE IN AN APPROVED FABRICATOR'S SHOP; THE APPROVED FABRICATOR SHALL SUBMIT THE CERTIFICATE OF COMPLIANCE TO THE BUILDING INSPECTOR PRIOR

- I. STEEL ROOF DECK IS INDICATED IN THE ROOF FRAMING NOTES LOCATED ON THE ROOF PLAN DRAWING. STEEL DECK TO BE PLACED ON ENTIRE ROOF STRUCTURE RESTING ON LIGHT GAGE TRUSSES (INCLUDING OVERFRAMED AREAS)
- 2. ALL STEEL ROOF DECK SHALL BE HOT-DIPPED GALVANIZED, G60 COATING AS PER ASTM
- 3. ALL STEEL ROOF DECK SHALL BE CAPABLE OF SUPPORTING ALL CONSTRUCTION LOADS. 4. ALL STEEL ROOF DECK SHALL BE CONTINUOUS OVER FOUR OR MORE STRUCTURAL SUPPORTS (i.e. DECK SHOULD BE DETAILED FOR A THREE SPAN CONDITION).
- 5. STEEL ROOF DECK SHALL HAVE NESTING SIDE LAPS (ATTACHED BY MECHANICAL MEANS) 6. IF DECK IS CUT IN SINGLE SPAN CONDITION, EACH END OF SUCH SECTIONS SHALL BE WELDED TO ITS SUPPORT THROUGH WELDING WASHERS IN THE BOTTOM OF EACH RIB. 7. IN AREAS WHERE THE DECK IS CUT AS PER NOTE 6, THE GAGE OF THE SINGLE SPAN DECK SHALL BE
- ADJUSTED UPWARDS AS REQUIRED BY THE ENGINEER TO SUPPORT THE LOADS. 8. ANY ELECTRICAL WORK WEIGHING MORE THAN 5PSF OR 50 LBS CONCENTRATED SHALL BE HUNG FROM STEEL BEAMS ONLY. FOR HANGERS, SEE SPECIFICATIONS. ALL MECHANICAL WORK AND PIPING SHALL BE HUNG FROM STEEL BEAMS. SEE STRUCTURAL STEEL NOTE 11 (OF STRUCTURAL STEEL NOTES) FOR ADDITIONAL STEEL REQUIRED BY MECHANICAL/ELECTRICAL TRADES TO SUPPORT THEIR
- EQUIPMENT. 9. METAL DECK CONTRACTOR TO PROVIDE 18 GAGE RIDGE PLATE, VALLEY PLATE, EDGE STRIP, ETC., AS
- REQUIRED. 10. CUT OUT METAL DECK WHERE BOLT PROJECTIONS INTERFERE WITH METAL DECK.

EXTERIOR/OSB SHEATHING

- ALL SHEATHING SHALL CONFORM TO AMERICAN PLYWOOD ASSOCIATION (APA) DESIGN SPECIFICATION, LATEST EDITION.
- 2. WALL SHEATHING SHALL BE 5/8" DENSGLASS. ALL WALL SHEATHING SHALL BE FASTENED TO SUPPORTING MEMBERS W/ #10 TEK SCREWS @ 6" O.C. AT PANEL EDGES AND 12" O.C. AT INTERMEDIATE SUPPORTS, U.N.O.
- 3. REFER TO DRAWINGS FOR SPECIAL SHEATHING OR NAILING REQUIREMENTS. PROVIDE SIMPSON "PSCL" PANEL CLIPS, MIN. 1 CLIP PER SIDE TO ALLOW FOR EXPANSION. THE SHEATHING SHALL NOT BE USED AS A NAILING EDGE.
- 4. ROOF SHEATHING SHALL BE 23/32" (3/4" NOMINAL) APA RATED SHEATHING, EXPOSURE 1. 48/24. UNO. FOR NON-COMBUSTABLE BUILDING CONSTRUCTION SHEATHING TO BE FIRE TREATED. COORD WITH ARCH. DWGS. ALL ROOF SHEATHING SHALL BE FASTENED TO SUPPORTING MEMBERS W/ #7 x 2" WOOD SCREWS @ 6" O.C. AT PANEL EDGES, AND 12" O.C. AT INTERMEDIATE SUPPORTS. U.N.O.

- ALL GRADES OF LUMBER INDICATED ON STRUCTURAL DRAWINGS SHALL BE RATED BY THE SOUTHERN PINE INSPECTION BUREAU (SPIB), OR THE WESTERN WOOD PRODUCTS ASSOCIATION (WWPA). LUMBER GRADES SHALL BE AS FOLLOWS, WITH A MAXIMUM MOISTURE CONTENT OF 19%:
- SOUTHERN PINE NO. 1.
- DOUGLAS FIR-LARCH NO. 1.

HEM-FIR NORTH NO. 1

- 2. BOLT HEADS AND NUTS BEARING ON WOOD SHALL BE PROVIDED WITH STANDARD CUT WASHERS.
- 3. ALL WOOD IN CONTACT WITH CONCRETE OR MASONRY SHALL BE PRESSURE TREATED.
- 4. CONNECTORS SHOWN ON THE DETAILS ARE MANUFACTURED BY SIMPSON. WRITTEN APPROVAL BY ENGINEER REQUIRED FOR SUBSTITUTIONS.
- 5. MINIMUM NAILED CONNECTIONS FOR WOOD FRAMING MEMBERS SHALL BE IN ACCORDANCE WITH THE LOCAL BUILDING CODE OR TABLE 2304.9.1 OF THE INTERNATIONAL BUILDING CODE AND CONFORM TO THE FOLLOWING TABLE:

FASTENER SCHEDULE	
CONNECTION TYPE	SIZE / SPACING
1. JOIST TO SILL OR GIRDER, TOENAIL 2. BRIDGING TO JOIST, TOENAIL EACH END 3. 1"x6" (25MMx152MM) SUBFLOOR OR LESS TO JOIST, FACE NAIL 4. WIDER THAN 1" X 6" (25MMx152MM) SUBFLOOR TO JOIST, FACE NAIL 5. 2" (52MM) SUBFLOOR TO GIRDER, BLIND AND FACE NAIL 6. SOLE PLATE TO JOIST OR BLOCKING, TYPICAL FACE NAIL 7. SOLE PLATE TO JOIST OR BLOCKING, AT BRACED W. PANELS 8. TOP PLATE TO STUD, END NAIL 9. STUD TO SOLE PLATE 10. DOUBLE STUDS, FACE NAIL 11. DOUBLE STUDS, FACE NAIL 12. DOUBLE TOP PLATES, LAP SPLICE 13. BLOCKING BETWEEN JOISTS OR RAFTERS TO TOP PLATE, TOENAIL 14. RIM JOIST TO TOP PLATE, TOENAIL 15. TOP PLATES, LAPS AND INTERSECTIONS, FACE NAIL 16. CONTINUOUS HEADER, TWO PIECES 17. CEILING JOISTS TO PLATE, TOENAIL 18. CONTINUOUS HEADER TO STUD, TOENAIL 19. CEILING JOISTS, LAP OVER PARTITIONS, FACE NAIL 20. CEILING JOISTS TO PARALLEL RAFTERS, FACE NAIL 21. RAFTER TO PLATE, TOENAIL 22. 1" (25MM) BRACE TO EACH STUD AND PLATE, FACE NAIL 23. 1"x8" SHEATHING OR LESS TO EACH BEARING, FACE NAIL 24. WIDER THAN 1"x8" SHEATHING TO EACH BEARING, FACE NAIL 25. BUILT-UP CORNER STUDS 26. 2" PLANKS 27. 2x6 BOX BEAM / HEADER 28. BUILT-UP GIRDER AND BEAMS	(3-8d) (2-8d) (2-8d) (3-8d) (2-16d) (16d @16" O.C.) (3-16d PER 16") (2-16d) (2-16d END NAIL) (16d @ 24", O.C.) (16d @ 16" O.C.) (8-16d) (3-8d) (8d @ 6" O.C.) (2-16D) (16d @ 16" O.C. ALONG EDGE) (3-8d) (4-8d) (3-8d) (4-8d) (3-16d) (3-16d) (3-8d) (2-8d) (2-8d) (2-8d) (2-8d) (2-8d) (2-8d) (2-8d) (2-16d AT EACH SPLICE) (12d @ 12" O.C.) (20d @ 32" O.C. AT TOP & BOTTOM AND STAGGERED

1. DESIGN AND CONSTRUCTION SHALL CONFORM TO BUILDING CODE REQUIREMENTS FOR MASONRY STRUCTURES (ACI 530-11/ ASCE 5-11 / TMS 402-11). AND SPECIFICATIONS FOR MASONRY STRUCTURES (ACI 530-11/ ASCE 6-11 / TMS 602-11).

2-20d AT ENDS AND AT EACH

- 2. MINIMUM NET COMPRESSIVE STRENGTH OF NORMAL WEIGHT CMU BLOCK ASSEMBLY SHALL BE 1900 P.S.I.(f'm). MORTAR FOR MASONRY SHALL BE TYPE "S" OR "M".
- 3. FOR ALL EXTERIOR AND INTERIOR BEARING, BED JOINTS ARE TO COVER 100% OF THE MASONRY SURFACES AND ALL HEAD JOINTS ARE TO COVER 100% OF THE PROJECTED AREA OF THE FACE
- 4. FILL ALL CELLS AS REQUIRED WITH 3,000 P.S.I. GROUT. SLUMP SHALL BE 8 TO 11 INCHES. SUBMIT
- DESIGN MIX TO ENGINEER FOR APPROVAL MINIMUM VERTICAL REINFORCING SHALL BE 1-#5 @ 48" OR 1-#4 @ 32" O.C., (U.N.O.).
- 6. PROVIDE ADDITIONAL VERTICAL REINFORCING BAR AT EVERY CORNER, INTERSECTION, CONTROL
- JOINT, AND OPENING EDGES (U.N.O.).
- 7. MINIMUM SPLICE FOR HORIZONTAL JOINT REINFORCING = 12".
- 8. ALL CELLS BELOW FIRST FLOOR FINISHED ELEVATION MUST BE FULLY FILLED SOLID WITH GROUT. 9. ALL KNOCK OUT BLOCK HORIZONTAL BARS SHALL HAVE CORNER BARS AT ALL CORNERS AND WALL
- INTERSECTIONS. SIZE AND NUMBER OF CORNER BARS SHALL BE SAME AS HORIZONTAL BARS. 10. ALL INTERSECTING WALLS AND CORNER WALLS SHALL BE LAID IN AN OVERLAPPING MASONRY BONDING PATTERN, WITH ALTERNATE UNITS HAVING A BEARING OF NOT LESS THAN 3 INCHES ON UNIT

SHOP DRAWING SUBMITTALS

- THE DEFERRED SUBMITTAL ITEMS SHALL BE SUBMITTED TO THE ARCHITECT OR ENGINEER OF RECORD WHO SHALL REVIEW AND APPROVE THEM, AND FORWARD THEM TO THE BUILDING OFFICIAL WITH A NOTATION INDICATING THAT THE DEFERRED SUBMITTAL DOCUMENTS HAVE BEEN REVIEWED AND APPROVED AND THAT THEY HAVE BEEN FOUND TO BE IN GENERAL CONFORMANCE WITH THE DESIGN OF THE BUILDING. THE DEFERRED SUBMITTAL ITEMS SHALL NOT BE INSTALLED UNTIL THEIR DESIGN AND SUBMITTAL DOCUMENTS HAVE BEEN APPROVED BY THE BUILDING OFFICIAL. PROVIDE AMPLE TIME FOR THE BUILDING OFFICIAL TO REVIEW THE DOCUMENTS
- 2. REFER TO PROJECT SPECIFICATIONS FOR SUBMITTAL REQUIREMENTS.
- 3. SHOP DRAWINGS AND SUBMITTALS WILL BE REVIEWED FOR THE LIMITED PURPOSE OF CHECKING FOR CONFORMANCE WITH INFORMATION GIVEN AND THE DESIGN CONCEPT EXPRESSED IN THE CONTRACT DOCUMENTS.
- 4. SUBMITTAL REVIEW WILL NOT BE CONDUCTED FOR THE PURPOSE OF DETERMINING THE ACCURACY AND COMPLETENESS OF OTHER DETAILED INFORMATION SUCH AS DIMENSIONS AND QUANTITIES, OR FOR SUBSTANTIATING INSTRUCTIONS FOR INSTALLATION OR PERFORMANCE OF EQUIPMENT OR SYSTEMS DESIGNED BY THE CONTRACTOR. ALL OF THIS REMAINS THE RESPONSIBILITY OF THE
- 5. REVIEW SHALL NOT CONSTITUTE APPROVAL OF SAFETY PRECAUTIONS OR OF ANY CONSTRUCTION MEANS, METHODS, TECHNIQUES, SEQUENCES OR PROCEDURES.
- 6. APPROVAL OF A SPECIFIC ITEM SHALL NOT INDICATE APPROVAL OF AN ASSEMBLY OF WHICH THE
- 7. SHOP DRAWINGS AND/OR PRODUCT DATA FOR THE FOLLOWING ITEMS ARE TO BE SUBMITTED TO THE STRUCTURAL ENGINEER FOR REVIEW AND APPROVAL:
- A. REINFORCING STEEL
- STRUCTURAL STEEL LIGHT GAGE STEEL DRAWINGS AND CALCULATIONS SIGNED AND SEALED BY A LICENSED PROFESSIONAL IN THE STATE IN WHICH THIS SITE IS LOCATED.
- 8. SHOP DRAWINGS ARE TO BE DISTRIBUTED ONLY FROM RETURNED SUBMITTALS BEARING AN INITIALED REVIEW STAMP AND WORK ON THESE ITEMS SHALL NOT PROCEED UNLESS THE STAMP CLEARLY INDICATES THE DRAWINGS ARE "APPROVED" OR "APPROVED AS NOTED."
- 9. SHOP DRAWINGS AND/OR PRODUCT DATA FOR THE FOLLOWING ITEMS ARE TO BE SUBMITTED TO THE STRUCTURAL ENGINEER FOR REVIEW. THE ENGINEER'S REVIEW WILL BE LIMITED TO CONFORMANCE WITH DESIGN AND PERFORMANCE CRITERIA SPECIFIED IN THE CONSTRUCTION DOCUMENTS AND THE INTERFACE BETWEEN THESE ITEMS/SYSTEMS AND THE BUILDING STRUCTURE. THIS REVIEW WILL CHECK THE COMPATIBILITY OF LOADS AND POSITIONS OF LOADS IMPARTED ONTO THE BUILDING STRUCTURE, AND COMPATIBILITY OF CONNECTIONS WITH THE BUILDING STRUCTURE. THE MANUFACTURER/SUPPLIER AND IT'S SPECIALTY STRUCTURAL ENGINEER RESPONSIBLE FOR THE DESIGN OF THE ITEM/SYSTEM WILL RETAIN ALL RIGHTS AND RESPONSIBILITIES FOR THE DESIGN OF THE PRODUCT AND THE CONNECTIONS TO THE BUILDING
- A. CONCRETE MIXES B. CONCRETE FORMWORK

STRUCTURE.

- 10. NO WORK ON STRUCTURAL ELEMENTS SUPPORTING OR RELATED TO THESE ITEMS IS TO PROCEED UNLESS THE REVIEW STAMP CLEARLY INDICATES "REVIEWED" OR "REVIEWED, SEE COMMENTS" BY THE STRUCTURAL ENGINEER.
- 11. CONCRETE IS A PRE-ENGINEERED MATERIAL DESIGNED BY THE SUPPLIER TO MEET THE STRENGTH AND PERFORMANCE CRITERIA SPECIFIED IN THE CONTRACT DOCUMENTS. CONCRETE MIX DESIGNS SHALL BE IN CONFORMANCE WITH ACI 318, CHAPTER 5, AND SHALL BE SUBMITTED TO THE INDEPENDENT TESTING LAB WITH APPROPRIATE HISTORICAL TEST DATA AND ANALYSIS FOR REVIEW AND APPROVAL. SUBMIT MIX DESIGNS AND THE TESTING LAB REVIEW TO THE ARCHITECT/ENGINEER FOR REVIEW.
- 12. MANY VARIABLES, INCLUDING MIX COMPONENTS AND ENVIRONMENTAL CONDITIONS AFFECT THE QUALITY OF CONCRETE. THE CONTRACTOR IS RESPONSIBLE FOR CONTROLLING VARIABLES AND REQUESTING MIX MODIFICATIONS AND SHALL BE SOLELY RESPONSIBLE FOR THE QUALITY OF CONCRETE DELIVERED AND PLACED ON THE SITE.
- GENERAL CONTRACTOR SHALL PRE-CHECK ALL SHOP DRAWINGS BEFORE SUBMISSION TO THE ENGINEER FOR REVIEW. ALL SUBMITTAL MATERIALS MUST BEAR AN INITIALED REVIEW STAMP OF THE GENERAL CONTRACTOR. SUBMITTALS WITHOUT THE REVIEW STAMP OF THE GENERAL CONTRACTOR WILL BE RETURNED WITHOUT REVIEW AND SHALL NOT BE CAUSE FOR CLAIMS OF
- 14. GENERAL CONTRACTOR SHALL SCHEDULE SUBMITTALS SUFFICIENTLY IN ADVANCE OF THE DATE REQUIRED TO ALLOW REASONABLE TIME FOR DELIVERY, PROCESSING AND REVIEW BY THE DESIGN TEAM. THIS SHALL INCLUDE A MINIMUM OF TEN WORKING DAYS, EXCLUDING DELIVERY TIME, FOR ENGINEER'S PROCESSING AND REVIEW OF SHOP DRAWINGS. INCLUDE TIME FOR CONTRACTOR'S RESUBMISSION AND SUBSEQUENT REVIEW IF NECESSARY.
- ENGINEER. THESE ACCELERATED SERVICES, AND APPROPRIATE COMPENSATION, MUST BE NEGOTIATED WITH THE ENGINEER AND ARCHITECT IN ADVANCE. 16. THE USE OF REPRODUCTIONS OF THESE CONTRACT DRAWINGS, INCLUDING THE USE OF ELECTRONIC FILES, BY ANY CONTRACTOR, SUBCONTRACTOR, ERECTOR, FABRICATOR, OR MATERIAL SUPPLIER IN LIEU OF THE INDEPENDENT PREPARATION OF SHOP DRAWINGS, SIGNIFIES

HIS ACCEPTANCE OF ALL INFORMATION SHOWN HEREON AS CORRECT AND OBLIGATES HIMSELF TO

ANY JOB EXPENSE, REAL OR IMPLIED, ARISING DUE TO ANY ERRORS THAT MAY OCCUR HEREON.

15. SHORTER REVIEW PERIODS WILL ONLY BE HONORED WITH PRIOR WRITTEN CONSENT FROM THE


SUCH USE OF REPRODUCTIONS OF THESE CONTRACT DOCUMENTS WILL NOT BE ALLOWED WITHOUT PRIOR CONSENT FROM THE ENGINEER. 17. WHEN USING ELECTRONIC FORMAT FOR SUBMITTALS, THE CONTRACTOR SHALL PROVIDE ONE PRINTED HARD COPY FOR ENGINEER REVIEW OR EXECUTE AN AGREEMENT FOR REIMBURSING THE

ENGINEER FOR PRINTING COSTS FOR ONE COPY.

SHOP DRAWING SUBMITTALS REQUIRED BY THESE GENERAL STRUCTURAL NOTES WHICH CONTAIN DESIGN CALCULATIONS SEALED BY A REGISTERED ENGINEER OTHER THAN THE ENGINEER OF RECORD, SHALL BE SUBMITTED DURING CONSTRUCTION TO THE CITY FIELD INSPECTOR FOR REVIEW. THE DOCUMENTS WILL FIRST BE REVIEWED BY THE ENGINEER OF RECORD AND DETERMINED TO BE IN GENERAL CONFORMANCE WITH THE BUILDING DESIGN. THESE DEFERRED SUBMITTAL ITEMS SHALL NOT BE INSTALLED UNTIL THEIR DESIGN AND SUBMITTAL DOCUMENTS HAVE BEEN APPROVED BY THE BUILDING OFFICIAL. THE FOLLOWING ITEMS SHALL BE SUBMITTED PER THIS SECTION:

- A. OPEN WEB STEEL JOIST
- LIGHT GAGE METAL FRAMING



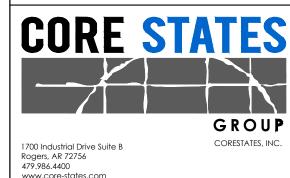

ENGINEER OF RECORD DAVID BALMA NUMBER PE-2015003007

HESE DRAWINGS ARE NOT COMPLETE WITHOUT THE SEPARATE TYPE WRITTEN SPECIFICATIONS MANUAL

WHICH ARE PART OF THE CONTRACT DOCUMENTS.

ISSUE DATE DESCRIPTION - | 2020.12.21 | PERMIT SET 1 2021.04.20 STRUCTURAL STEEL REV

PROJECT INFORMATION PROJECT NO: JPM.27135.001 2020.12.21 **PROTOTYPE** DRAWN BY: E.SCALGIONE CHECKED BY: VERSION: SHEET TITLE

GENERAL

SHEET NUMBER

STRUCTURAL SPECIAL INSPECTIONS

SPECIAL INSPECTIONS

- 1. SPECIAL INSPECTIONS SHALL BE PERFORMED IN ACCORDANCE WITH SECTION 1705 OF THE 2018 INTERNATIONAL BUILDING CODE.
- 2. THE OWNER WILL EMPLOY THE SERVICES OF ONE OR MORE SPECIAL INSPECTORS TO PROVIDE SPECIAL INSPECTIONS DURING CONSTRUCTION FOR THE REQUIRED SPECIAL INSPECTION ITEMS. 3. THE SPECIAL INSPECTOR SHALL BE A QUALIFIED PERSON WHO SHALL DEMONSTRATE COMPETENCE, TO THE SATISFACTION OF THE BUILDING OFFICIAL AND THE REGISTERED DESIGN PROFESSIONAL RESPONSIBLE FOR THE DESIGN OF THE STRUCTURE, FOR INSPECTION OF THE PARTICULAR TYPE
- OF CONSTRUCTION OR OPERATION REQUIRING SPECIAL INSPECTION. 4. DUTIES AND RESPONSIBILITIES OF THE SPECIAL INSPECTOR: A. THE SPECIAL INSPECTOR SHALL OBSERVE THE WORK ASSIGNED FOR CONFORMANCE WITH THE APPROVED DESIGN DRAWINGS AND SPECIFICATIONS. THE INSPECTOR MAY NOT ALTER, MODIFY, ENLARGE OR WAVE ANY OF THE REQUIREMENTS OF THE DOCUMENTS.
- B. THE SPECIAL INSPECTOR SHALL FURNISH INSPECTION REPORTS TO THE BUILDING OFFICIAL, THE PROFESSIONAL-OF-RECORD, AND THE CONTRACTOR. ALL DISCREPANCIES SHALL BE BROUGHT TO THE IMMEDIATE ATTENTION OF THE CONTRACTOR FOR CORRECTION, THEN, IF UNCORRECTED, SUBMIT A COMPLETE LIST OF ALL OUTSTANDING DISCREPANCIES ON A WEEKLY BASIS TO THE OWNER, THE BUILDING OFFICIAL, AND THE PROFESSIONAL-OF-RECORD, UNTIL ALL CORRECTIONS HAVE BEEN COMPLETED.
- C. THE SPECIAL INSPECTOR SHALL SUBMIT A FINAL SIGNED REPORT STATING WHETHER THE WORK REQUIRING SPECIAL INSPECTION WAS, TO THE BEST OF THE INSPECTOR'S KNOWLEDGE, IN CONFORMANCE WITH THE APPROVED PLANS AND SPECIFICATIONS AND THE APPLICABLE
- WORKMANSHIP PROVISIONS OF THE BUILDING CODE. 5. STRUCTURAL OBSERVATION (AS DEFINED IN CHAPTER 17 OF THE BUILDING CODE) IS NOT REQUIRED,
- UNLESS SPECIFICALLY REQUIRED BY THE BUILDING OFFICIAL. 6. THE FOLLOWING AREAS OF WORK REQUIRE SPECIAL INSPECTIONS IN ACCORDANCE WITH THE LISTED SECTIONS/LOCATIONS:

A. SOILS - SECTION 1705.6 PER TABLE 1705.6

	SPECIAL INSPECTION AND VERIFICATION OF SOILS					
SPECIAL INSPECTION REQUIRED Y/N	VERIFICATION AND INSPECTION TASK		PERIODICALLY DURING TASK LISTED	IBC REFERENCE		
Y	1. VERIFY MATERIALS BELOW SHALLOW FOOTINGS ARE ADEQUATE TO ACHIEVE THE DESIGN BEARING CAPACITY.		Х	1705.6		
Y 2. VERIFY EXCAVATIONS ARE EXTENDED TO PROPER DEPTH AND HAVE REACHED PROPER MATERIAL.			x	1705.6		
Y 3. PERFORM CLASSIFICATION AND TESTING OF COMPACTED FILL MATERIALS.			Х	1705.6		
Y	4. VERIFY USE OF PROPER MATERIALS, DENSITIES AND LIFT THICKNESS DURING PLACEMENT AND COMPACTION OF CONTROLLED FILL.	х		1705.6		
Υ	5. PRIOR TO PLACEMENT OF CONTROLLED FILL, INSPECT SUBGRADE AND VERIFY THAT SITE HAS BEEN PREPARED PROPERLY.		х	1705.6		

B. CONCRETE CONSTRUCTION - SECTION 1705.3 PER TABLE 1705.3

	SPECIAL INSPECTION AND VER	IFICATION OF	CONCRETE C	ONSTRUCTIO	N				
SPECIAL	FREQUENCY OF INSPECTION REFERENCE FOR CRITERIA								
INSPECTION REQUIRED Y/N	VERIFICATION AND INSPECTION	CONTINUOUS DURING TASK LISTED	PERIODICALLY DURING TASK LISTED	IBC SECTION	REFERENCED STANDARD				
Y	INSPECTION OF REINFORCING STEEL, INCLUDING PRE-STRESSING TENDONS AND VERIFY PLACEMENT.		х	1908.4	ACI 318: CH. 20, 25.2, 25.3, 26.6.1-26.6.3				
N	2. REINFORCING BAR WELDING								
-	a. VERIFY WELDABILITY OF REINFORCING BARS OTHER THAN ASTM A706;		Х		_				
-	b. INSPECT SINGLE-PASS FILLET WELDS, MAXIMUM 5/16		Х		AWS D1.4 ACI 318: 26.6.4				
-	c. INSPECT OTHERS WELDS	X							
Υ	3. INSPECTION OF ANCHORS CAST IN CONCRETE		Х		ACI318: 17.8.2				
Υ	4. INSPECT ANCHORS POST-INSTALLED IN HARDENED CONCRETE MEMBERS								
N	a. ADHESIVE ANCHORS INSTALLED IN HORIZONTALLY OR UPWARDLY INCLINED ORIENTATIONS TO RESIST SUSTAINED TENSION LOADS.	×			ACI 318: 17.8.2.4				
Υ	b. MECHANICAL ANCHORS AND ADHESIVE ANCHORS NOT DEFINED IN 4a.		Х		ACI 318: 17.8.2				
Y	5. VERIFYING USE OF REQUIRED DESIGN MIX.		Х	1904.1, 1904.2, 1908.2, 1408.3	ACI 318: CH. 19, 26.4.3, 26.4.4				
Y	6. PRIOR TO CONCRETE PLACEMENT, FABRICATE FOR STRENGTH TESTS, PERFORM SLUMP AND AIR ENTRAINED TESTS, AND DETERMINE THE TEMPERATURE OF THE CONCRETE	х		1908.10	ASTM C 172 ASTM C 31 ACI 318: 26.5, 26.12				
Υ	7. INSPECTION OF CONCRETE AND SHOTCRETE PLACEMENT FOR PROPER APPLICATION TECHNIQUES.	Х		1908.6, 1908.7, 1908.8	ACI 318: 26.5				
Υ	8. INSPECTION FOR MAINTENANCE OF SPECIFIED CURING TEMPERATURE AND TECHNIQUES.		Х	1908.9	ACI 318: 26.5.3-26.5.5				
N	9. INSPECTION OF PRESTRESSED CONCRETE:								
-	a. APPLICATION OF PRESTRESSING FORCES.	Х			101040 00 40				
-	b. GROUTING OF BONDED PRESTRESSING TENDONS	Х			ACI 318: 26.10				
N	10. ERECTION OF PRECAST (TILT UP PANELS) CONCRETE MEMBERS.		Х		ACI 318: CH. 26.9				
N	11. VERIFICATION OF IN-SITU CONCRETE STRENGTH, PRIOR TO STRESSING OF TENDONS IN POST-TENSIONED CONCRETE AND PRIOR TO REMOVAL OF SHORING AND FORMS FROM BEAMS AND STRUCTURAL SLABS.		Х		ACI 318: 26.11.2				
Υ	12. INSPECT FORMWORK FOR SHAPE, LOCATION AND DIMENSIONS OF THE CONCRETE MEMBER BEING FORMED.		х		ACI 318: 26.11.1.2(b)				

C. WOOD CONSTRUCTION - SECTION 1705.5

	SPECIAL INSPECTION AND VERIFICATION OF WOOD CONSTRUCTION				
VEDICIONATION AND INODECTION TACK		CONTINUOUS DURING TASK LISTED	PERIODICALLY DURING TASK LISTED	IBC REFERENCE	
N	1. HIGH-LOAD DIAPHRAGMS		Х	1705.5.1	
N	2. METAL-PLATE CONNECTED WOOD TRUSSES SPANNING > 60 FEET		X	1705.5.2	

D. WIND RESISTANCE - SECTION 1705.11

SPECIAL INSPECTION REQUIRED Y/N	VERIFICATION AND INSPECTION TASK		PERIODICALLY DURING TASK LISTED	IBC REFERENCE
N	1. NAILING, BOLTING, ANCHORING AND OTHER FASTENING TO OTHER COMPONENTS OF THE MAINFORCE-RESISTING SYSTEM, INCLUDING WOOD SHEAR WALLS, WOOD DIAPHRAGMS, DRAG STRUTS, BRACES AND HOLD-DOWNS WHERE FASTENER SPACING FOR SHEATHING IS 4" ON-CENTER OR LESS.		Х	1705.11.1
N	2. FIELD GLUING OPERATIONS OF ELEMENTS OF THE MAIN WINDFORCE-RESISTING SYSTEM	х		1705.11.1
N	3. COLD-FORMED STEEL WELDING OPERATIONS OF ELEMENTS OF THE MAIN WINDFORCE-RESISTING SYSTEM		х	1705.11.2
N	4. COLD-FORMED STEEL SCREW ATTACHMENT, BOLTING, ANCHORING AND OTHER FASTENING OF COMPONENTS WITHIN THE MAINFORCE-RESISTING SYSTEM, INCLUDING SHEAR WALLS, DIAPHRAGMS, COLLECTORS (DRAG STRUTS), AND HOLD-DOWNS WHERE NON-GYPSUM BOARD/FIBERBOARD SHEATHING FASTENER SPACING IS 4" ON-CENTER OR LESS.		х	1705.11.2
N	5. ROOF CLADDING		Х	1705.11.3
N	6. WALL CLADDING		Х	1705.11.3

	SPECIAL INSPECTION AND VERIFICATION	OF STRUCT	URAL STEEL C	ONSTRUC	CTION	
SPECIAL		FREQUENCY	OF INSPECTION	REFERENCE FOR CRITERIA		
INSPECTION REQUIRED Y/N	VERIFICATION AND INSPECTION	CONTINUOUS DURING TASK LISTED		IBC SECTION	REFERENCED STANDARD	
	PRIOR TO	WELDING				
Y	1. QUALIFIED WELDER		Х	1705.2.1	N5.4-1, AISC 360-	
Y	2. VERIFY WELDING PROCEDURES (WPS) AND CONSUMABLE CERTIFICATES	Х		1705.2.1	N5.4-1, AISC 360-	
Y	3. MATERIAL IDENTIFICATION		Х	1705.2.1	N5.4-1, AISC 360	
Υ	4. WELDER IDENTIFICATION		Х	1705.2.1	N5.4-1, AISC 360	
Υ	5. FIT-UP GROOVE WELDS		Х	1705.2.1	N5.4-1, AISC 360	
Υ	6. FIT-UP OF CJP GROOVE WELDS		Х	1705.2.1	N5.4-1, AISC 360	
Υ	7. ACCESS HOLES		Х	1705.2.1	N5.4-1, AISC 360	
Υ	8. FIT-UP OF FILLET WELDS		Х	1705.2.1	N5.4-1, AISC 360	
	DURING	WELDING				
Y	1. CONTROL AND HANDLING OF WELDING CONSUMABLES		Х	1705.2.1	N5.4-2, AISC 360-	
Y	2. CRACKED TACK WELDS		Х	1705.2.1	N5.4-2, AISC 360	
Υ	3. ENVIRONMENTAL CONITIONS		Х	1705.2.1	N5.4-2, AISC 360	
Υ	4. WPS FOLLOWED		Х	1705.2.1	N5.4-2, AISC 360	
Y	5. WELDING TECHNIQUES		Х	1705.2.1	N5.4-2, AISC 360	
Y	6. STEEL HEADED ANCHORS	Х		1705.2.1	N5.4-2, AISC 360	
	AFTER \	WELDING				
Υ	1. WELD IS CLEANED		Х	1705.2.1	N5.4-3, AISC 360	
Υ	2. SIZE, LENGTH AND LOCATION OF WELDS	Х		1705.2.1	N5.4-3, AISC 360	
Y	3. WELDS MEET VISUAL ACCEPTANCE CRITERIA	х		1705.2.1	N5.4-3, AISC 360	
Y	4. ARC STRIKES	Х		1705.2.1	N5.4-3, AISC 360	
Υ	5. K-AREA	Х		1705.2.1	N5.4-3, AISC 360	
Y	6. WELD ACCESS HOLES	X		1705.2.1	N5.4-3, AISC 360	
Y	7. BACKING AND WELD TABS REMOVED	Х		1705.2.1	N5.4-3, AISC 360	
Y	8. REPAIR ACTIVITIES	Х		1705.2.1	N5.4-3, AISC 360	
Y	9. DOCUMENT ACCEPTANCE OR REJECTION OF WELDED JOINT/NUMBER	X		1705.2.1	N5.4-3, AISC 360	
Y	10. NO PROHIBITED WELDS		Х	1705.2.1	N5.4-3, AISC 360	
	NON-DESTRUC	CTIVE TESTI	NG		T	
N	1. CJP WELDS (RISK CAT. II)		Х	1705.2.1	N5.5, AISC 360-	
N	2. CJP WELDS (RISK CAT. III OR IV)	Х		1705.2.1	N5.5, AISC 360-	
N	3. WELDED JOINTS SUBJECT TO FATIGUE	X		1705.2.1	N5.5, AISC 360-	


E. STEEL CONSTRUCTION (STRUCTURAL STEEL) - SECTION 1705.2.1 (CONTINUED)

		EDEOUENOY.	OF INCOFOTION	DECESE:	IOE FOR ORITER!
SPECIAL		FREQUENCY	OF INSPECTION	REFERENCE FOR CRITERIA	
INSPECTION REQUIRED Y/N	VERIFICATION AND INSPECTION	CONTINUOUS DURING TASK LISTED		IBC SECTION	REFERENCE STANDARD
	PRIOR TO	BOLTING			
Υ	1. CERTIFICATIONS OF FASTENERS	х		1705.2.1	N5.6-1, AISC 360
Υ	2. FASTENERS MARKED		Х	1705.2.1	N5.6-1, AISC 36
Υ	3. PROPER FASTENERS FOR JOINT		Х	1705.2.1	N5.6-1, AISC 36
Υ	4. PROPER BOLTING PROCEDURE		Х	1705.2.1	N5.6-1, AISC 36
Υ	5. CONNECTING ELEMENTS		Х	1705.2.1	N5.6-1, AISC 36
Υ	6. PRE-INSTALLED VERIFICATION TESTING		Х	1705.2.1	N5.6-1, AISC 36
Υ	7. PROPER STORAGE		Х	1705.2.1	N5.6-1, AISC 36
	DURING	BOLTING			
Υ	1. FASTENER ASSEMBLIES		Х	1705.2.1	N5.6-2, AISC 36
N	2. SNUG TIGHT PRIOR TO PRE-TENSIONING		Х	1705.2.1	N5.6-2, AISC 36
Υ	3. FASTENER COMPONENT		Х	1705.2.1	N5.6-2, AISC 36
N	3. PRE-TENSIONED FASTENERS		Х	1705.2.1	N5.6-2, AISC 36
	AFTER E	BOLTING			
Υ	1. DOCUMENT ACCEPTANCE OR REJECTION OF BOLTED CONNECTIONS	x		1705.2.1	N5.6-3, AISC 36
	OTHER STEEL	INSPECTION	NS		
Υ	1. STRUCTURAL STEEL DETAILS		Х	1705.2.1	N5.8, AISC 360
Y	2. ANCHOR RODS AND OTHER EMBEDMENTS SUPPORTING STRUCTURAL STEEL		Х	1705.2.1	N5.8, AISC 360

	SPECIAL INSPECTION AND VERIFICATI	ION OF OTHE	ER STEEL CON	ISTRUCTION	NC
ODEOLAL		FREQUENCY	OF INSPECTION	REFERENCE FOR CRITERIA	
SPECIAL INSPECTION REQUIRED Y/N	VERIFICATION AND INSPECTION	CONTINUOUS DURING TASK LISTED	PERIODICALLY DURING TASK LISTED	IBC SECTION	REFERENCED STANDARD
	PRIOR TO DEC	K PLACEMEI	NT		
Y	1. VERIFY MATERIAL COMPLIANCE	X		1705.2.1	N5.4-1, AISC 360-1
Υ	2. DOCUMENT ACCEPTANCE OR REJECTION OF DECK AND DECK ACCESSORIES	х		1705.2.1	N5.4-1, AISC 360-1
	AFTER TO DEC	K PLACEME	NT		
Υ	1. VERIFY COMPLIANCE OF INSTALLATION AND DECK MATERIALS	х		1705.2.1	N5.4-1, AISC 360-1
Υ	2. DOCUMENT ACCEPTANCE OR REJECTION OF INSTALLATION OF DECK AND DECK ACCESSORIES	X		1705.2.1	N5.4-1, AISC 360-1
	PRIOR TO	WELDING			
Υ	VERIFY WELDING PROCEDURES (WPS) AND CONSUMABLE CERTIFICATES		Х	1705.2.1	N5.4-1, AISC 360-1
Υ	2. MATERIAL IDENTIFICATION		Х	1705.2.1	N5.4-1, AISC 360-1
	DURING \	WELDING			
Υ	1. QUALIFIED WELDER		Х	1705.2.1	N5.4-1, AISC 360-1
Υ	2. CONTROL AND HANDLING OF WELDING CONSUMABLES		х	1705.2.1	N5.4-2, AISC 360-1
Υ	3. ENVIRONMENTAL CONITIONS		×	1705.2.1	N5.4-2, AISC 360-1
Υ	4. WPS FOLLOWED		Х	1705.2.1	N5.4-2, AISC 360-1
	AFTER V	VELDING			
Y	1. SIZE, LENGTH AND LOCATION OF WELDS	Х		1705.2.1	N5.4-3, AISC 360-1
Υ	3. WELDS MEET VISUAL ACCEPTANCE CRITERIA	х		1705.2.1	N5.4-3, AISC 360-1
Υ	8. REPAIR ACTIVITIES	х		1705.2.1	N5.4-3, AISC 360-1
Υ	9. DOCUMENT ACCEPTANCE OR REJECTION OF WELDED JOINT/NUMBER	x		1705.2.1	N5.4-3, AISC 360-1



1700 Industrial Drive Suite B Rogers, AR 72756 479.986.4400 www.core-states.com

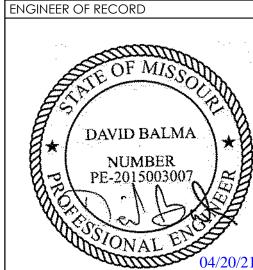

THESE DRAWINGS ARE NOT COMPLETE WITHOUT THE SEPARATE TYPE WRITTEN SPECIFICATIONS MANUAL WHICH ARE PART OF THE CONTRACT DOCUMENTS.

ISSUE DATE DESCRIPTION - | 2020.12.21 | PERMIT SET 1 2021.04.20 STRUCTURAL STEEL REV

PROJECT INFORMATION JPM.27135.001 2020.12.21 PROTOTYPE: DRAWN BY: J.PEREZ CHECKED BY: E.SCALGIONE SHEET TITLE

> STRUCTURAL SPECIAL **INSPECTIONS**

SHEET NUMBER

S_{0.1}

STRUCTURAL SPECIAL INSPECTIONS

F. COLD-FORMED STEEL DECK - SECTION 1705.2.2 (CONTINUED)

1. 0022	5-PORIMED STEEL DECK - SECTION 1705.2.2 (CONTINU	-201						
SPECIAL INSPECTION AND VERIFICATION OF COLD-FORMED STEEL DECK								
SPECIAL		FREQUENCY OF INSPECTION		REFERENCE FOR CRITERIA				
INSPECTION REQUIRED Y/N	VERIFICATION AND INSPECTION	CONTINUOUS DURING TASK LISTED		IBC SECTION	REFERENCED STANDARD			
PRIOR TO MECHANICAL FASTENING								
Υ	1. VERIFY INSTRUCTIONS AVAILABLE		Х	1705.2.1	N5.4-1, AISC 360-16			
Υ	2. PROPER TOOLS AVAILABLE		Х	1705.2.1	N5.4-1, AISC 360-16			
Υ	3 PROPER STORAGE.		X	1705.2.1	N5.4-1, AISC 360-16			
	DURING MECHAN	ICAL FASTE	NING					
Y	1. FASTENERS ARE POSITIONED AND INSTALLED ACCORDING TO MANUF. INSTRUCTIONS	Х		1705.2.1	N5.4-1, AISC 360-16			
	AFTER MECHANI	CAL FASTEN	NING					
Υ	1. SPACING, TYPE AND INSTALLATION OF SUPPORT, SIDELAP AND PERIMETER FASTENERS	Х		1705.2.1	N5.4-1, AISC 360-16			
Y	8. REPAIR ACTIVITIES	Х		1705.2.1	N5.4-3, AISC 360-16			
Υ	9. DOCUMENT ACCEPTANCE OR REJECTION OF MECHANICAL FASTENERS	Х		1705.2.1	N5.4-3, AISC 360-16			

G. OPEN-WEB STEEL JOISTS AND GIRDERS - TABLE 1705.2.3


REQUIRED SPECIAL INSPECTIONS OF OPEN-WEB JOISTS AND JOIST GIRDERS							
CDECIAL		FREQUENCY OF INSPECTION		REFERENCE FOR CRITERIA			
SPECIAL INSPECTION REQUIRED Y/N	VERIFICATION AND INSPECTION	CONTINUOUS DURING TASK LISTED	PERIODICALLY DURING TASK LISTED	IBC SECTION	REFERENCED STANDARD		
	INSTALLATION OF OPEN-WEB JOISTS AND JOIST GIDERS						
Υ	a. END CONNECTIONS - WELDING OR BOLTED		Х	1705.2.3	SJI SPECIFICATIONS, SECTION 2207.1		
Υ	b. BRIDGING - HORIZONTAL OR DIAGONAL			1705.2.3			
Υ	1. STANDARD BRIDGING		Х	1705.2.3	SJI SPECIFICATIONS SECTION 2207.1		
Υ	BRIDGING THAT DIFFERS FROM THE SJI SPECIFCATIONS LISTED IN SECTION 2207.1		Х	1705.2.3			


H. COLD-FORMED STEEL TRUSSES SPANNING > 60 FEET - SECTION 1705.2.4

REQUIRED SPECIAL INSPECTIONS OF COLD-FORMED STEEL TRUSSES SPANNING > 60 FEET						
SPECIAL INSPECTION REQUIRED Y/N			FREQUENCY OF INSPECTION		ICE FOR CRITERIA	
	VERIFICATION AND INSPECTION	CONTINUOUS DURING TASK LISTED	PERIODICALLY DURING TASK LISTED	IBC SECTION	REFERENCED STANDARD	
Y	1. TRUSSES SPANNING > 60 FEET		Х	1705.2.4		

I. MASONRY - SECTION 1705.4 (THIS TABLE 3.1.2 - LEVEL B QUALITY ASSURANCE)

	MINIM	UM TESTS				
	VERIFICATION OF SLUMP FLOW AND VISUAL STABILITY INDEX (VSI) AS ARTICLE 1.5B.1.b.3 FOR S			SITE IN ACCO	ORDANCE WITH SPECIF	FICATION
VERIFICA	TION OF f_M AND f_{AAC} IN ACCORDANCE WITH SPECIFICATION ARTICLE 1.4B PR	OR TO CONSTE	RUCTION, EXCEP	T WHERE SP	ECIFICALLY EXEMPTED	D BY THIS CODE
	MINIMUM INS	PECTION				
SPECIAL		FREQUENCY (OF INSPECTION		REFERENCE FOR CRI	TERIA
INSPECTION REQUIRED Y/N	VERIFICATION AND INSPECTION	CONTINUOUS DURING TASK LISTED	PERIODICALLY DURING TASK LISTED	IBC SECTION	TMS 402/ ACI 530/ ASCE 5	TMS 602/ ACI 530.1/ ASCE 6
Υ	1. VERIFY COMPLIANCE WITH THE APPROVED SUBMITTALS		Х	1705.4		ART. 1.5
	2. AS MASONRY CONSTRUCTION BEGINS, VERIFY THAT THE FOLLOWING AF	RE IN COMPLIA	NCE:	•		
Υ	a. PROPORTIONS OF SITE-PREPARED MORTAR		Х	1705.4		ART. 2.1, 2.6A
Υ	b. CONSTRUCTION OF MORTAR JOINTS		Х			ART. 3.3B
N	c. GRADE AND SIZE OF PRE-STRESSING TENDONS AND ANCHORAGES		Х	1705.4		ART 2.4B, 2.4H
Υ	d. LOCATION OF REINFORCEMENT, CONNECTORS, AND PRE-STRESSING TENDONS AND ANCHORAGES		Х	1705.4		ART. 3.4, 3.6A
N	e. PRE-STRESSING TECHNIQUE		Х	1705.4		ART. 3.6B
N	f. PROPERTIES OF THIN-BED MORTAR FOR ACC MASONRY		Х	1705.4		ART. 2.1C
	3. PRIOR TO GROUTING, VERIFY THAT THE FOLLOWING ARE IN COMPLIANC	E:				
Υ	a. GROUT SPACE		Х			ART. 3.2D, 3.2F
Υ	b. GRADE, TYPE AND SIZE OF REINFORCEMENT AND ANCHOR BOLTS, AND PRE-STRESSING TENDONS AND ANCHORAGES		Х	1705.4	SEC. 6.1	ART. 2.4, 3.4
Υ	c. PLACEMENT OF REINFORCEMENT, CONNECTORS, AND PRE-STRESSING TENDONS AND ANCHORAGES		Х	1705.4	SEC. 6.1, 6.2.1, 6.2.6, 6.2.7	ART. 3.2E, 3.4, 3.6A
Υ	d. PROPORTIONS OF SITE-PREPARED GROUT AND PRE-STRESSING GROUT FOR BONDED TENDONS		Х	1705.4		ART. 2.6B, 2.4G.1.b
Υ	e. CONSTRUCTION OF MORTAR JOINTS		Х	1705.4		ART. 3.3B
	4. VERIFY DURING CONSTRUCTION:					,
Υ	a. SIZE AND LOCATION OF STRUCTURAL ELEMENTS		Х	1705.4		ART. 3.3F
Y	b. TYPE, SIZE AND LOCATION OF ANCHORS, INCLUDING OTHER DETAILS OF ANCHORAGE OF MASONRY TO STRUCTURAL MEMBERS, FRAMES, OR OTHER CONSTRUCTION		Х	1705.4	SEC. 1.2.1(e), 6.1.4.3, 6.2.1	
N	c. WELDING OF REINFORCEMENT	×			SEC. 8.1.6.7.2, 9.3.3.4(c), 11.3.3.4(b)	
Υ	d. PREPARATION, CONSTRUCTION, AND PROTECTION OF MASONRY DURING COLD WEATHER (TEMPERATURE BELOW 40°F(4.4°C)) OR HOT WEATHER (TEMPERATURE ABOVE 90°F(32.2°C))		Х	1705.4		ART. 1.8C, 1.8D
N	e. APPLICATION AND MEASUREMENT OF PRE-STRESSSING FORCE	Х		1705.4		ART. 3.6B
N	f. PLACEMENT OF GROUT AND PRE-STREEING GROUT FOR BONDED TENDONS IS IN COMPLIANCE	X		1705.4		ART. 3.5, 3.6C
N	g. PLACEMENT OF AAC MASONRY UNITS AND CONSTRUCTION OF THIN-BED MORTAR JOINTS		Х	1705.4		ART. 3.3B.9, 3.3F.1.L
Υ	5. OBSERVE PREPARATION OF GROUT SPECIMENS, MORTAR SPECIMENS, AND/OR PRISMS		×	1705.4		ART. 1.4B.2.a.3, 1.4B.2.b.3, 1.4B.2.c.3, 1.4B.3, 1.4B.4

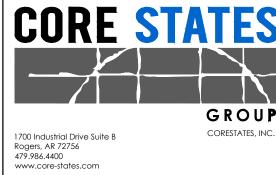

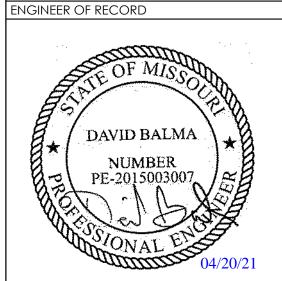

THESE DRAWINGS ARE NOT COMPLETE WITHOUT THE SEPARATE TYPE WRITTEN SPECIFICATIONS MANUAL WHICH ARE PART OF THE CONTRACT DOCUMENTS.


ISSUE	DATE	DESCRIPTION
-	2020.12.21	PERMIT SET
2	2021.04.20	STRUCTURAL STEEL REV

PROJECT INFO	DRMATION
PROJECT NO:	JPM.27135.001
DATE:	2020.12.21
PROTOTYPE:	20.2
DRAWN BY:	J.PEREZ
CHECKED BY:	E.SCALGIONE
VERSION:	SE_1.00
SHEET TITLE	

STRUCTURAL SPECIAL INSPECTIONS II

SHEET NUMBER

S0.2

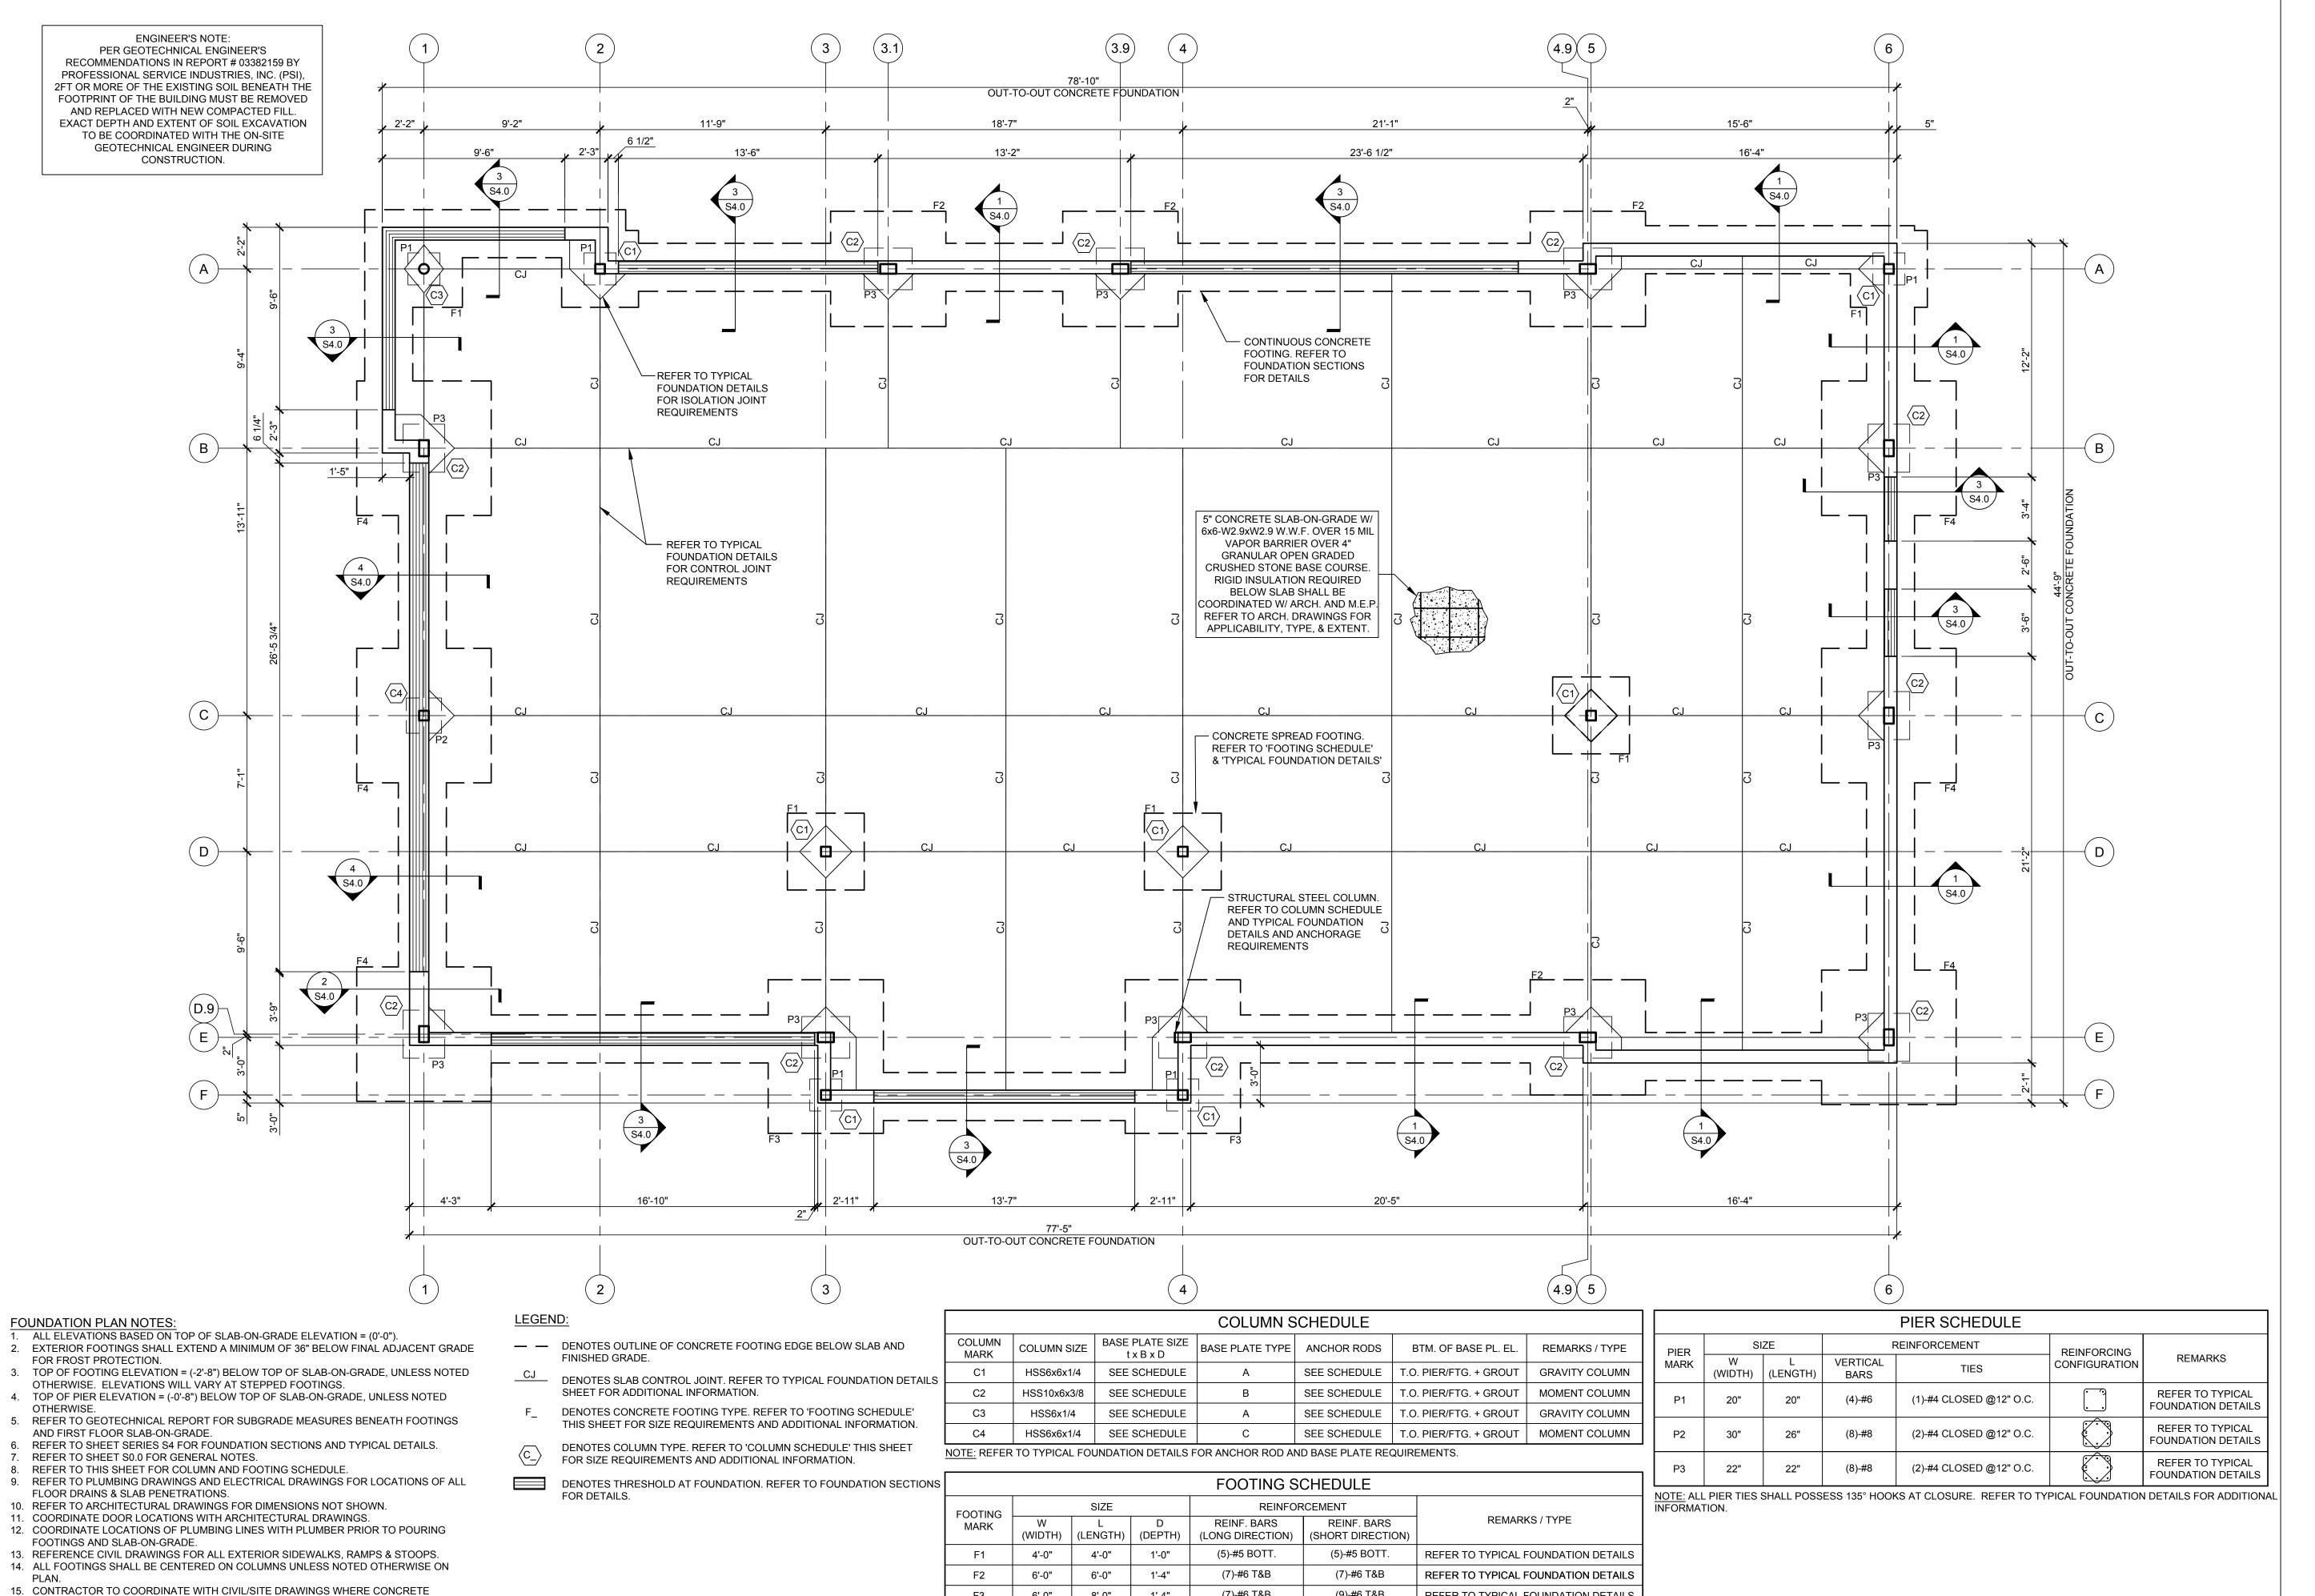

(7)-#6 T&B

(9)-#6 T&B

(9)-#6 T&B

(9)-#6 T&B

F3

SIDEWALK ABUTS BUILDING FOUNDATION.

6'-0"

8'-0"

7'-6"

1'-4"

1'-4"


NOTE: REFER TO TYPICAL FOUNDATION DETAILS FOR FOOTING AND ANCHOR ROD REQUIREMENTS.

REFER TO TYPICAL FOUNDATION DETAILS

REFER TO TYPICAL FOUNDATION DETAILS

GROUP 1700 Industrial Drive Suite B Rogers, AR 72756 479.986.4400

ENGINEER OF RECORD

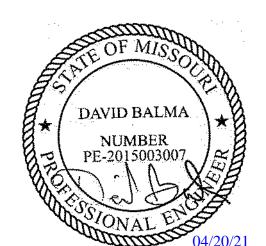

HESE DRAWINGS ARE NOT COMPLETE WITHOUT THE SEPARATE TYPE WRITTEN SPECIFICATIONS MANUAL WHICH ARE PART OF THE CONTRACT DOCUMENTS.

ISSUE DATE DESCRIPTION - | 2020.12.21 | PERMIT SET 1 2021.04.20 STRUCTURAL STEEL REV


PROJECT INFORMATION PROJECT NO: JPM.27135.001 2020.12.21

PROTOTYPE: DRAWN BY: J.PEREZ CHECKED BY: E.SCALGIONE VERSION: SHEET TITLE

> **FOUNDATION** PLAN

SHEET NUMBER

FOUNDATION PLAN SCALE 1/4"=1'-0"

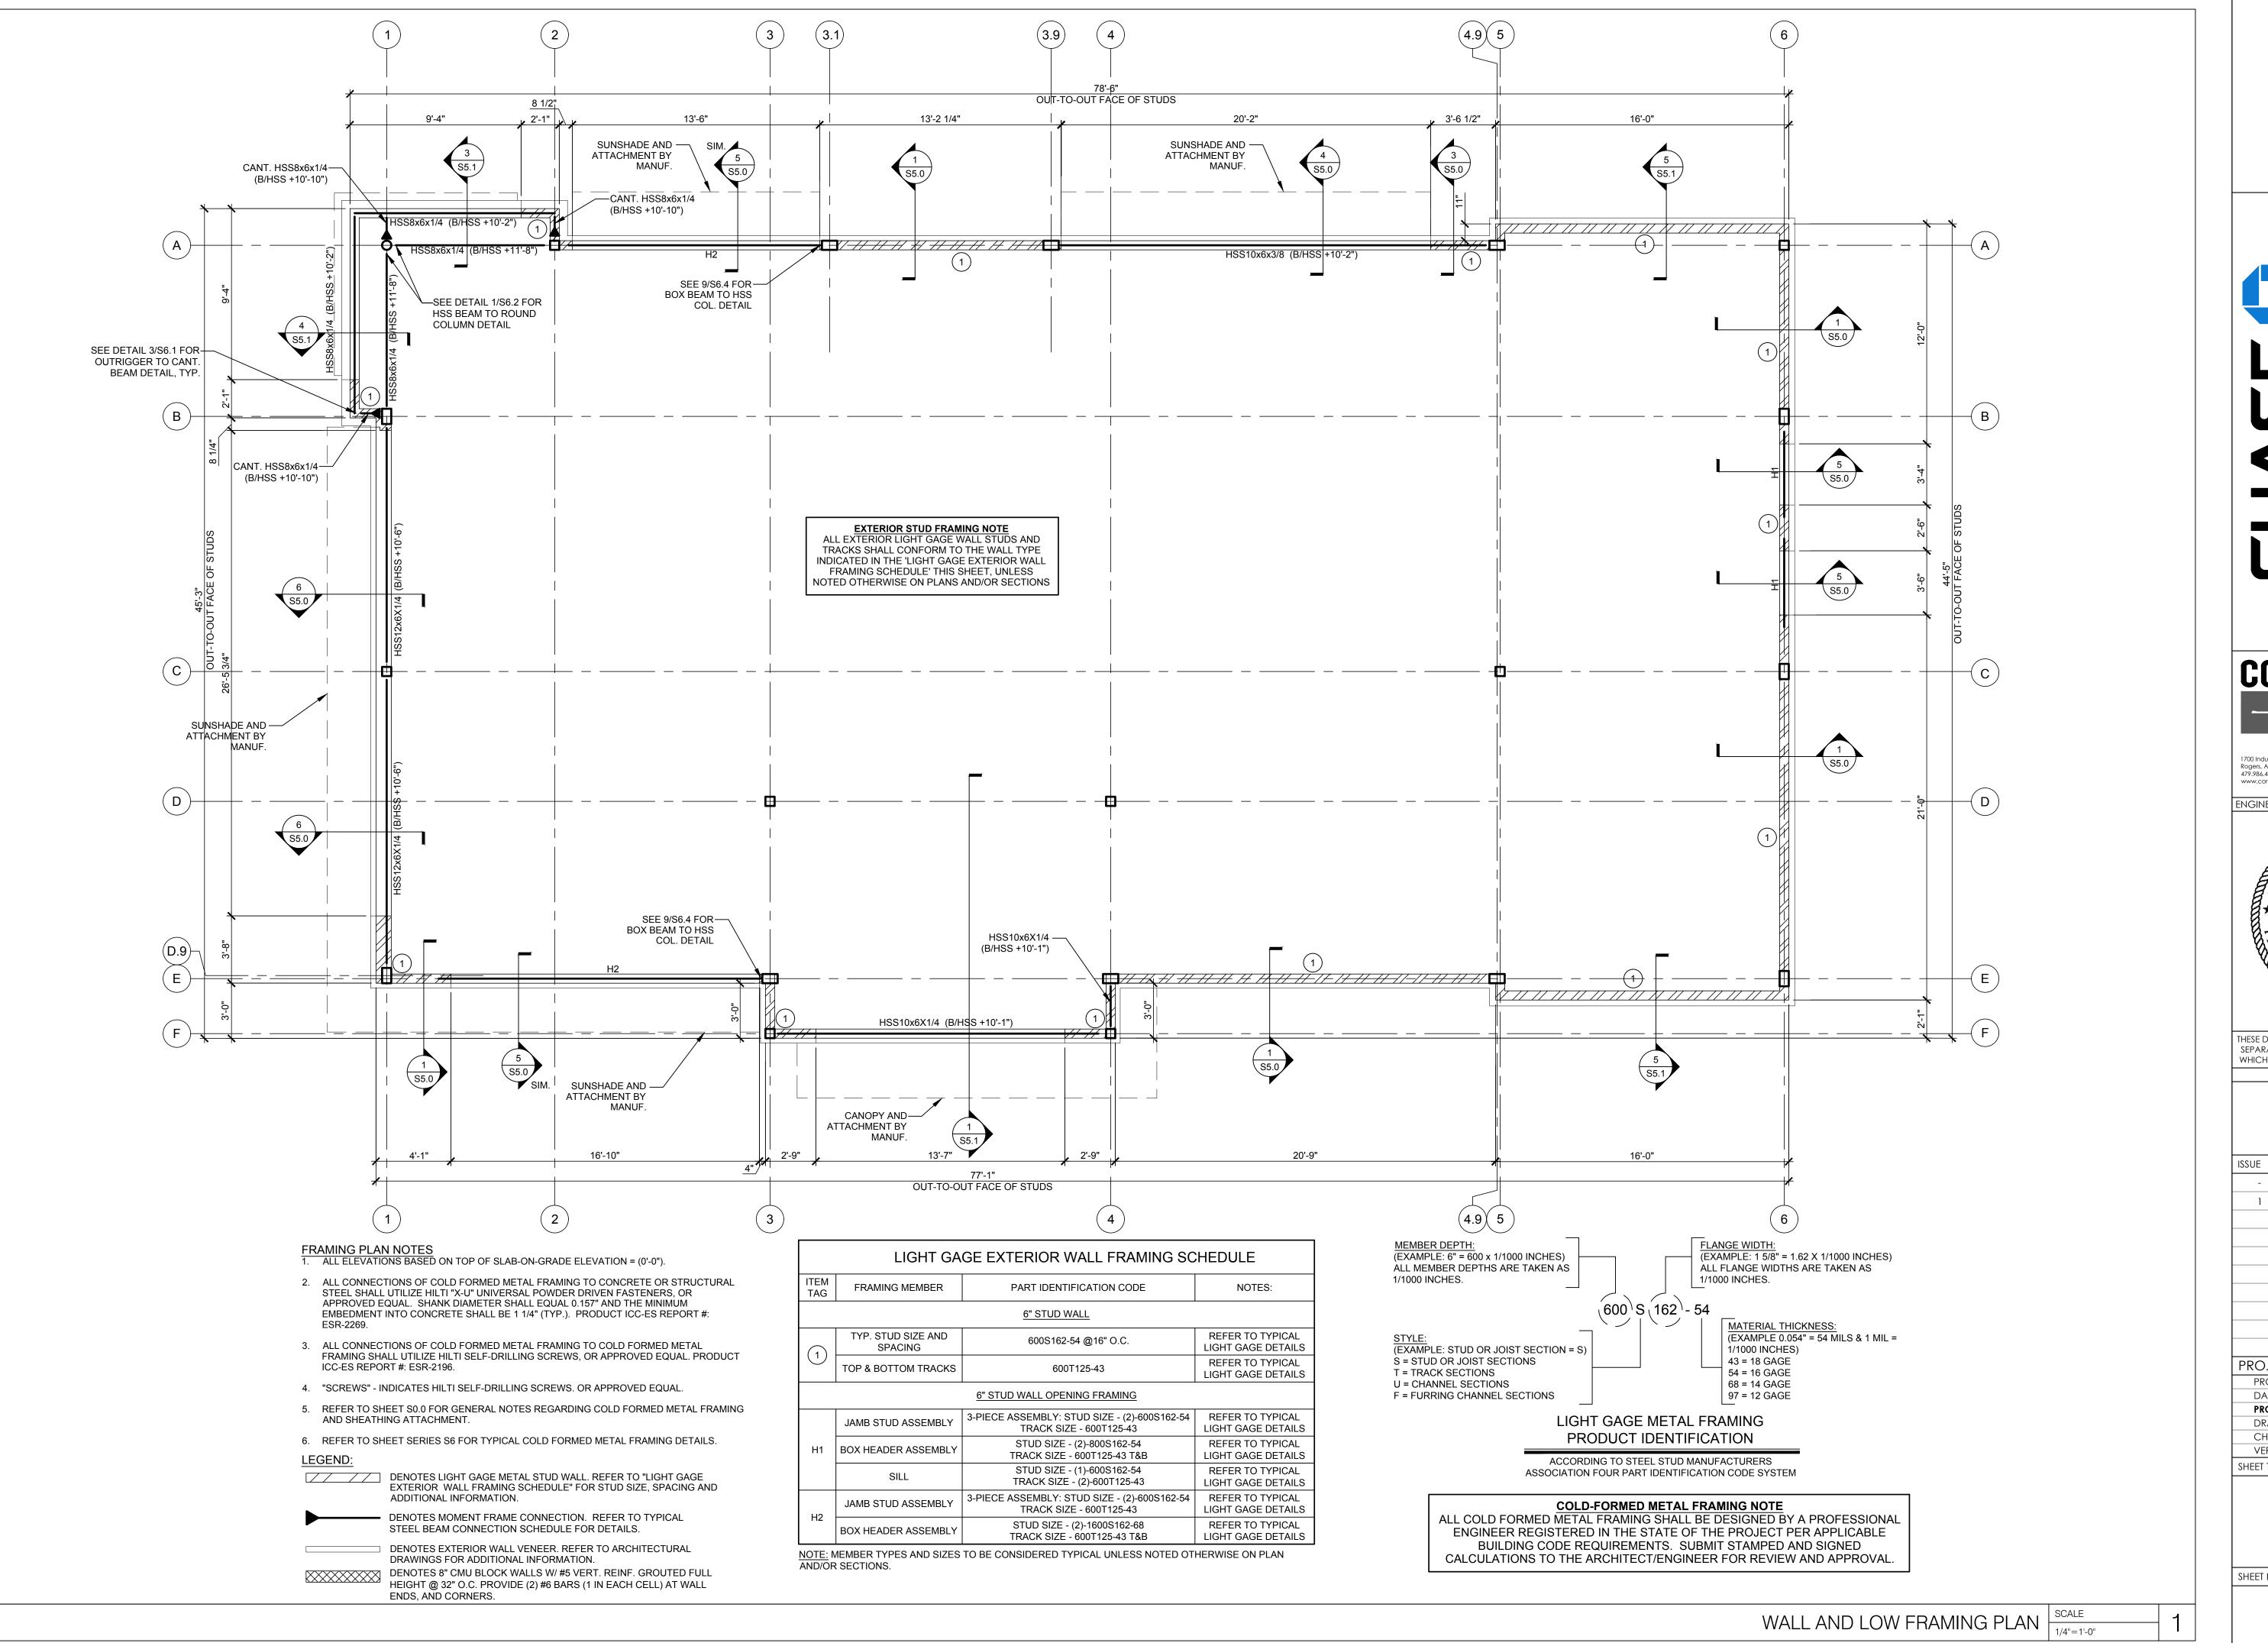

GROUP 1700 Industrial Drive Suite B Rogers, AR 72756 479.986.4400

ENGINEER OF RECORD

DAVID BALMA NUMBER PE-2015003007

HESE DRAWINGS ARE NOT COMPLETE WITHOUT THE SEPARATE TYPE WRITTEN SPECIFICATIONS MANUAL WHICH ARE PART OF THE CONTRACT DOCUMENTS.


ISSUE DATE DESCRIPTION - | 2020.12.21 | PERMIT SET 1 2021.04.20 STRUCTURAL STEEL REV


PROJECT INFORMATION PROJECT NO: JPM.27135.001 **PROTOTYPE**


2020.12.21 DRAWN BY: J.PEREZ E.SCALGIONE CHECKED BY: VERSION: SHEET TITLE


> WALL AND LOW FRAMING PLAN


SHEET NUMBER

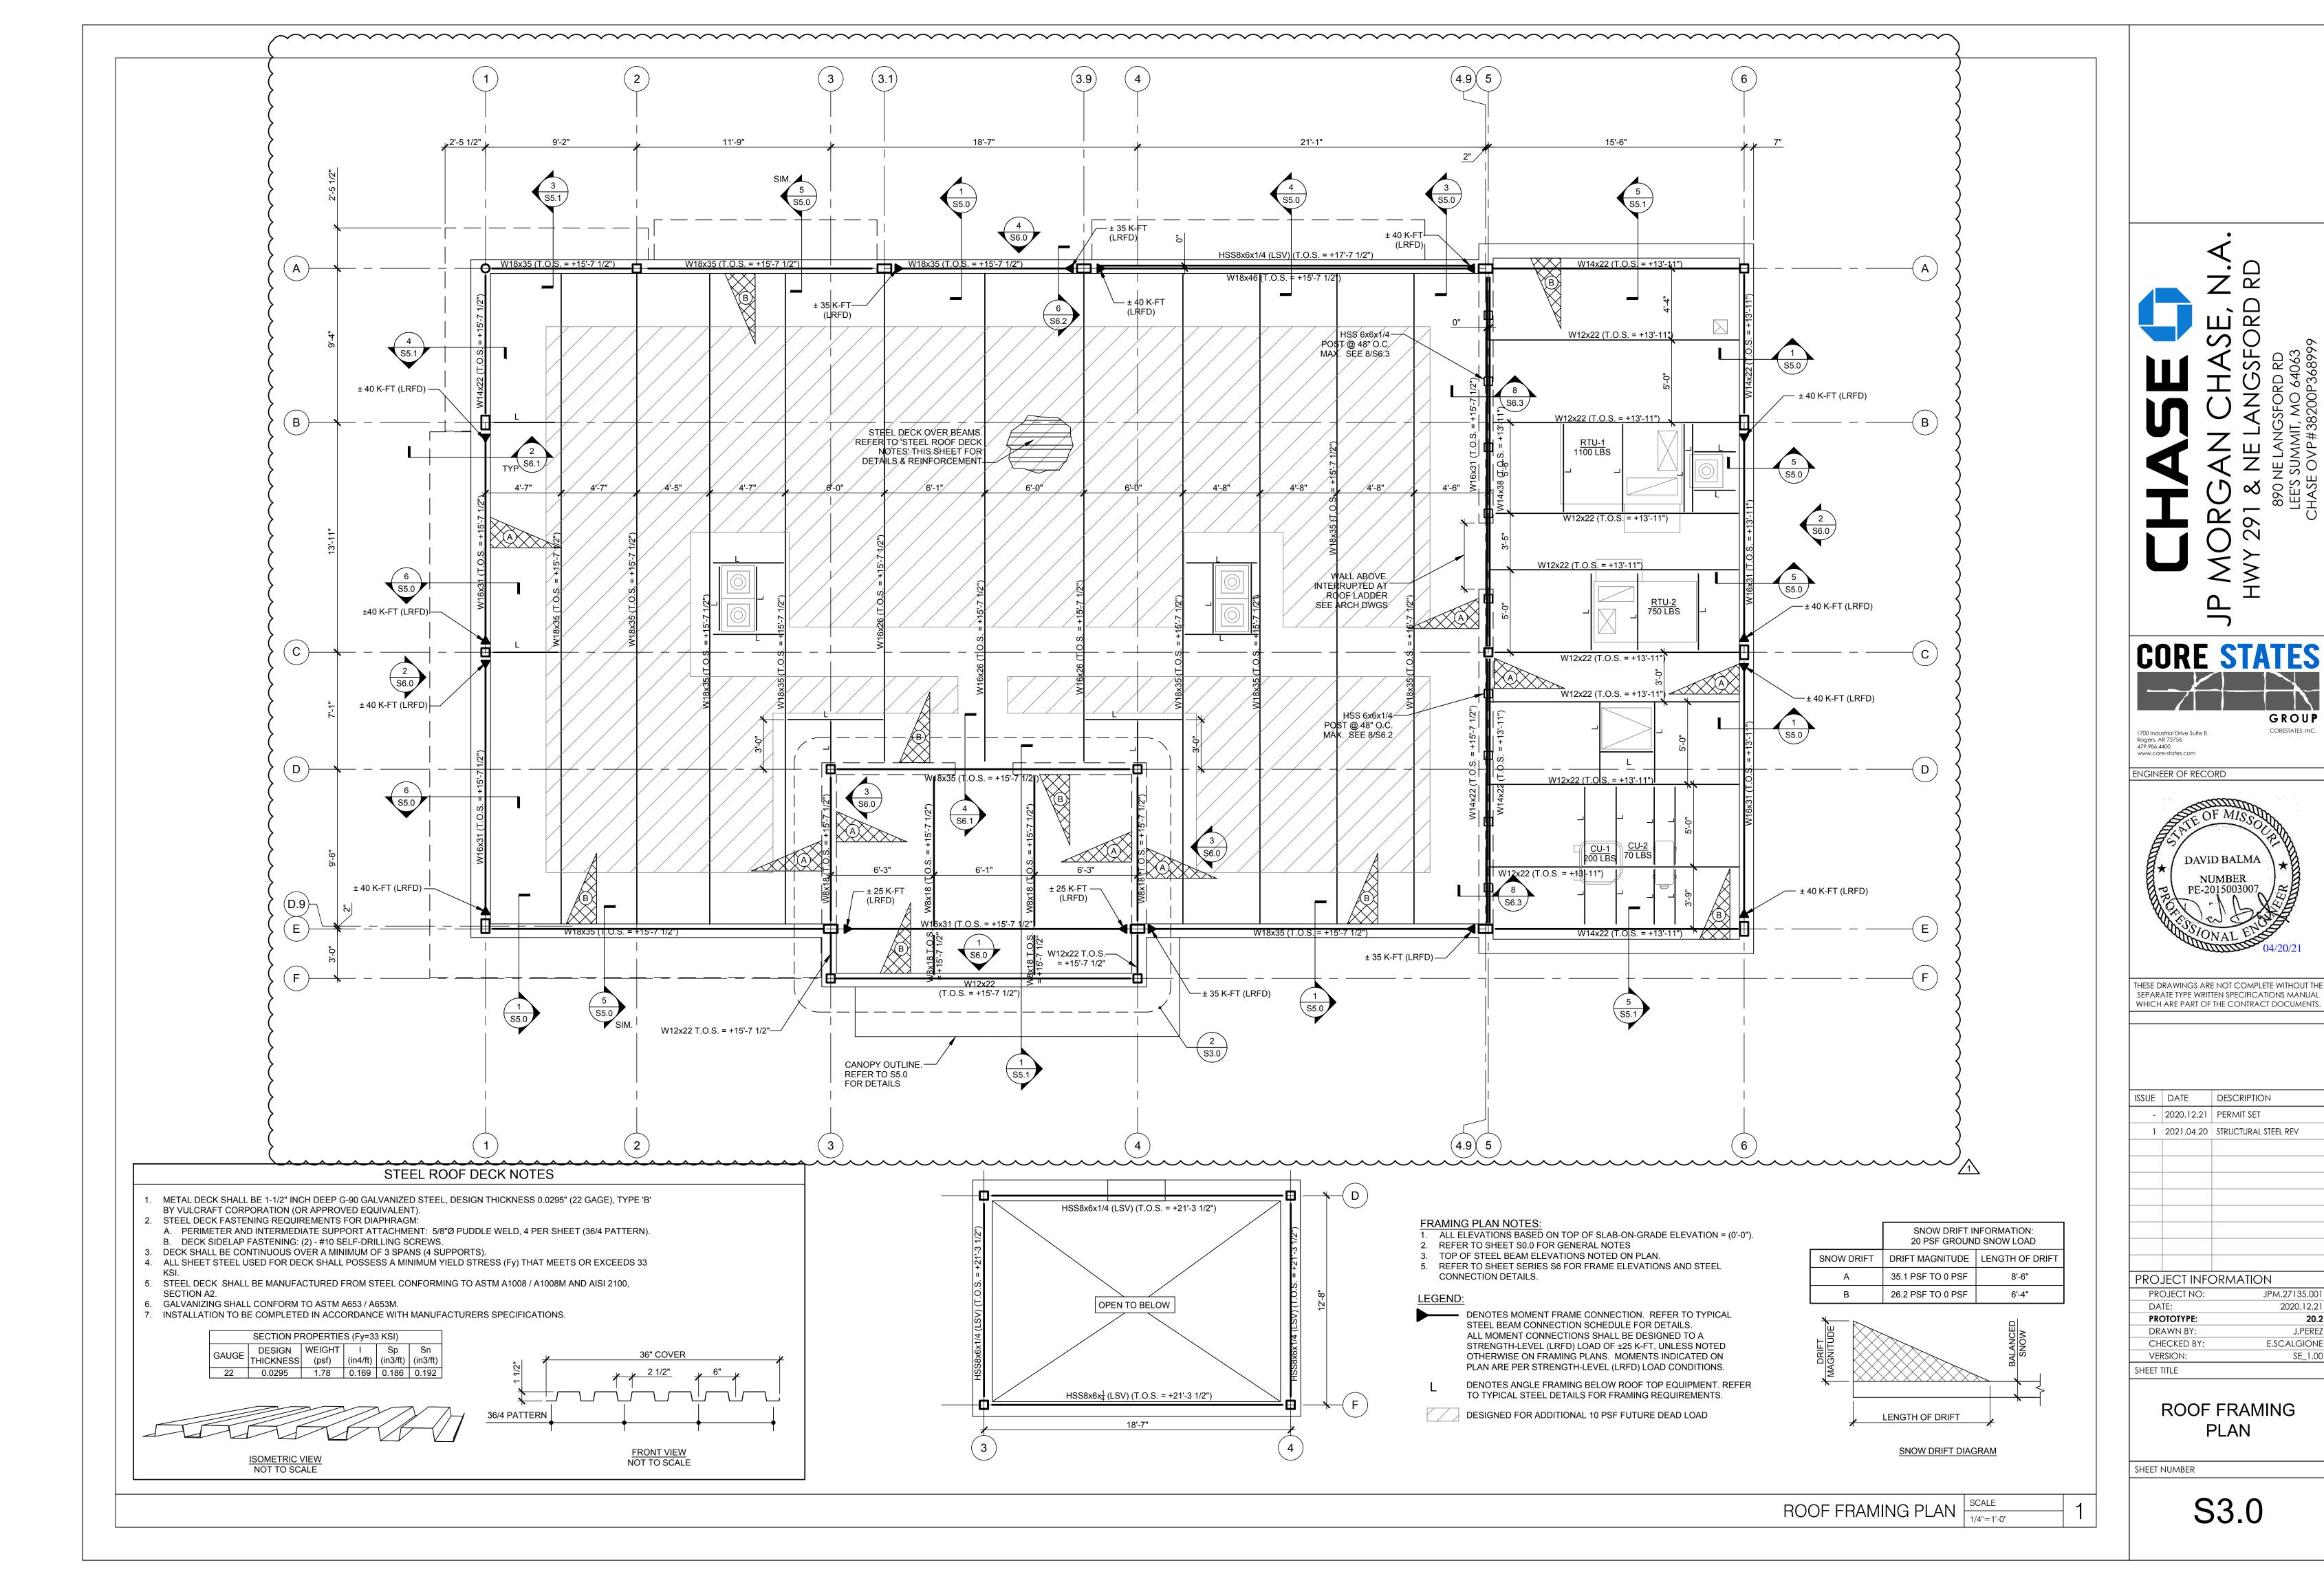 


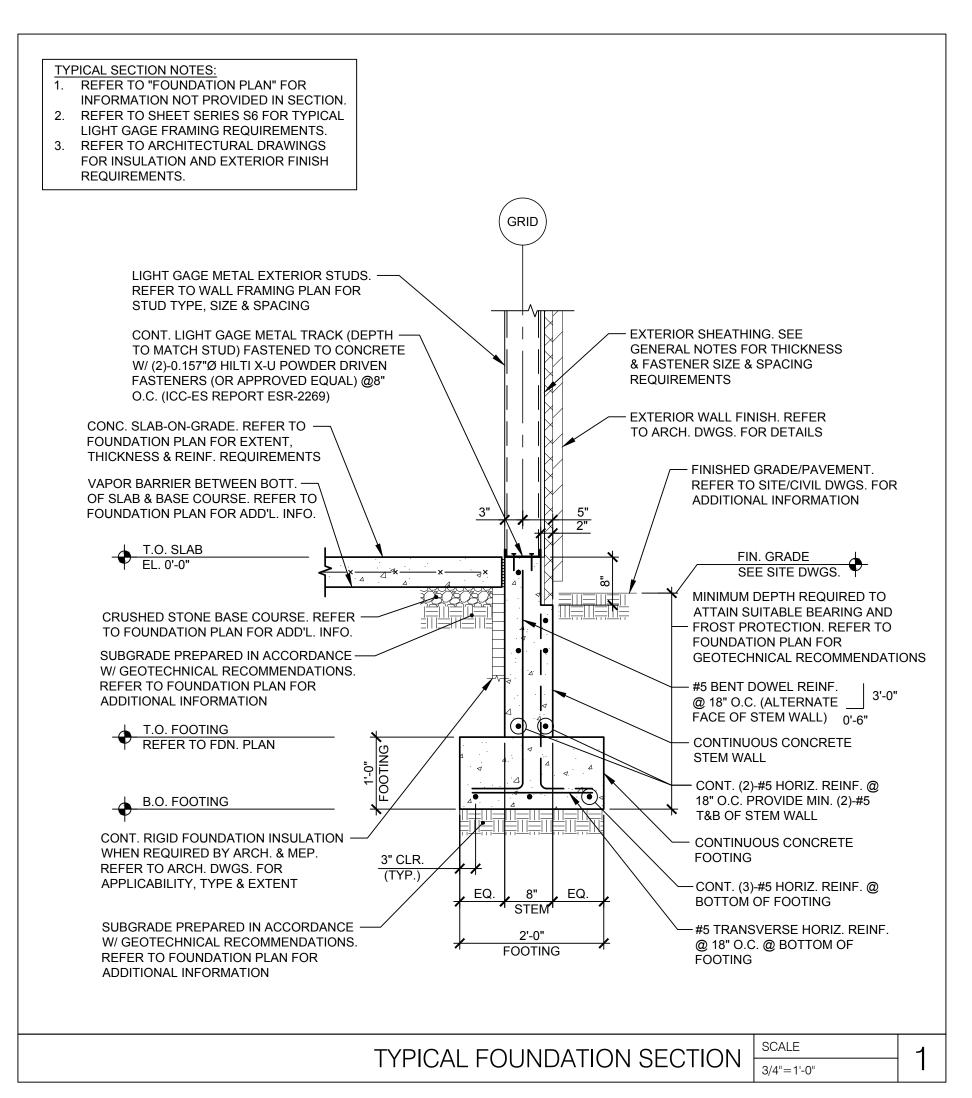


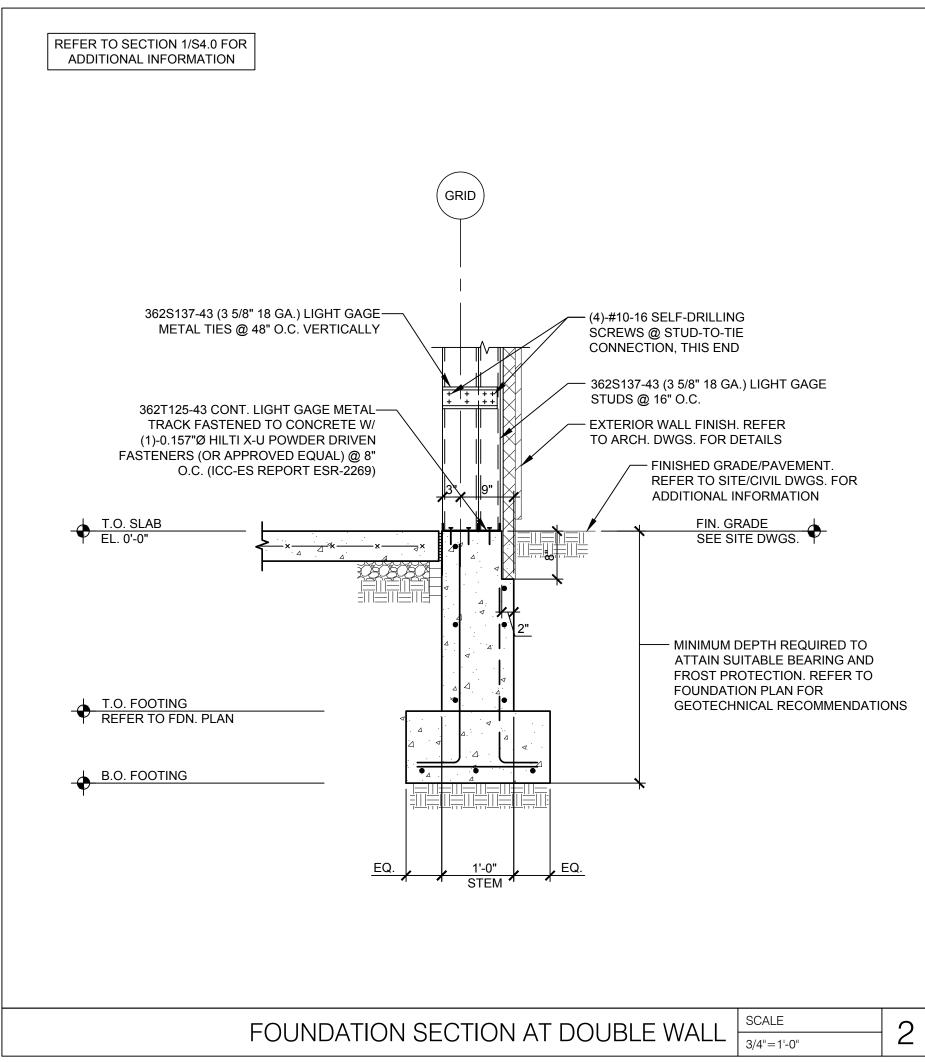

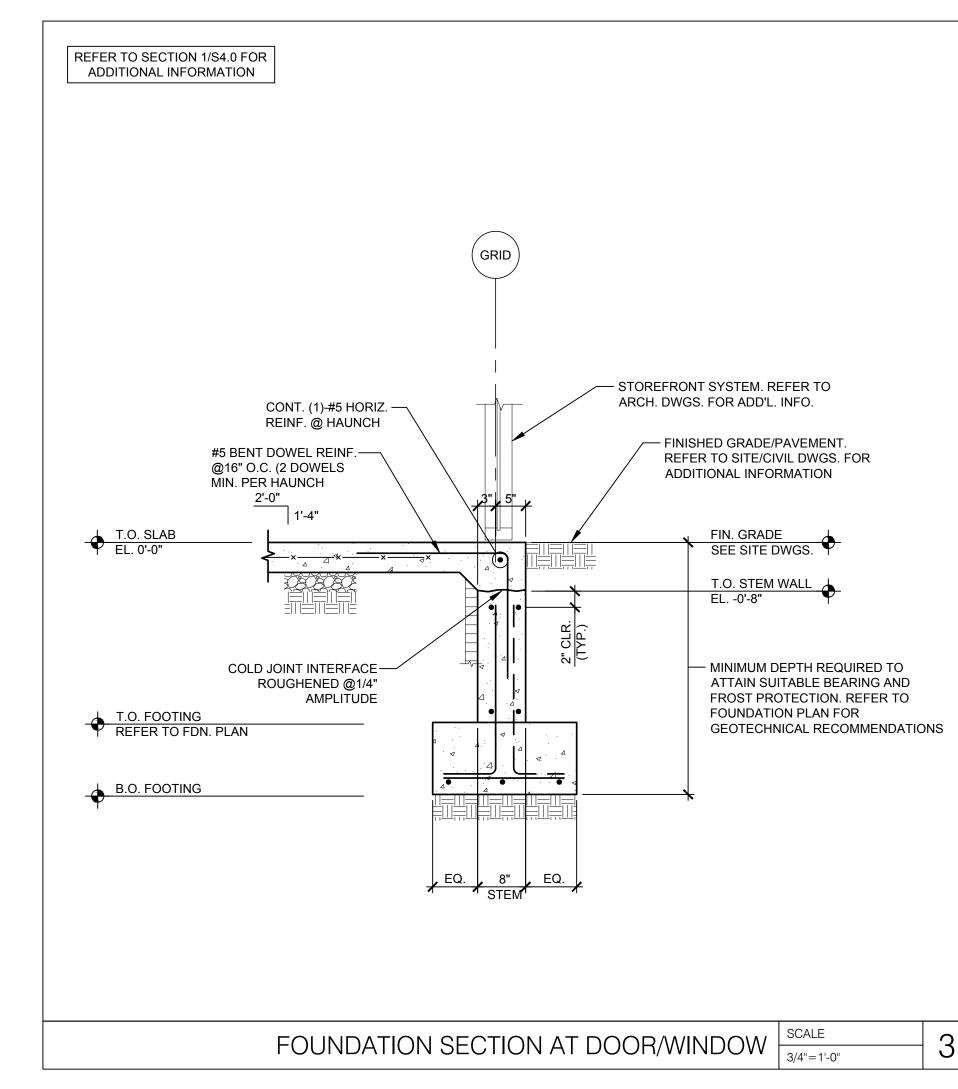

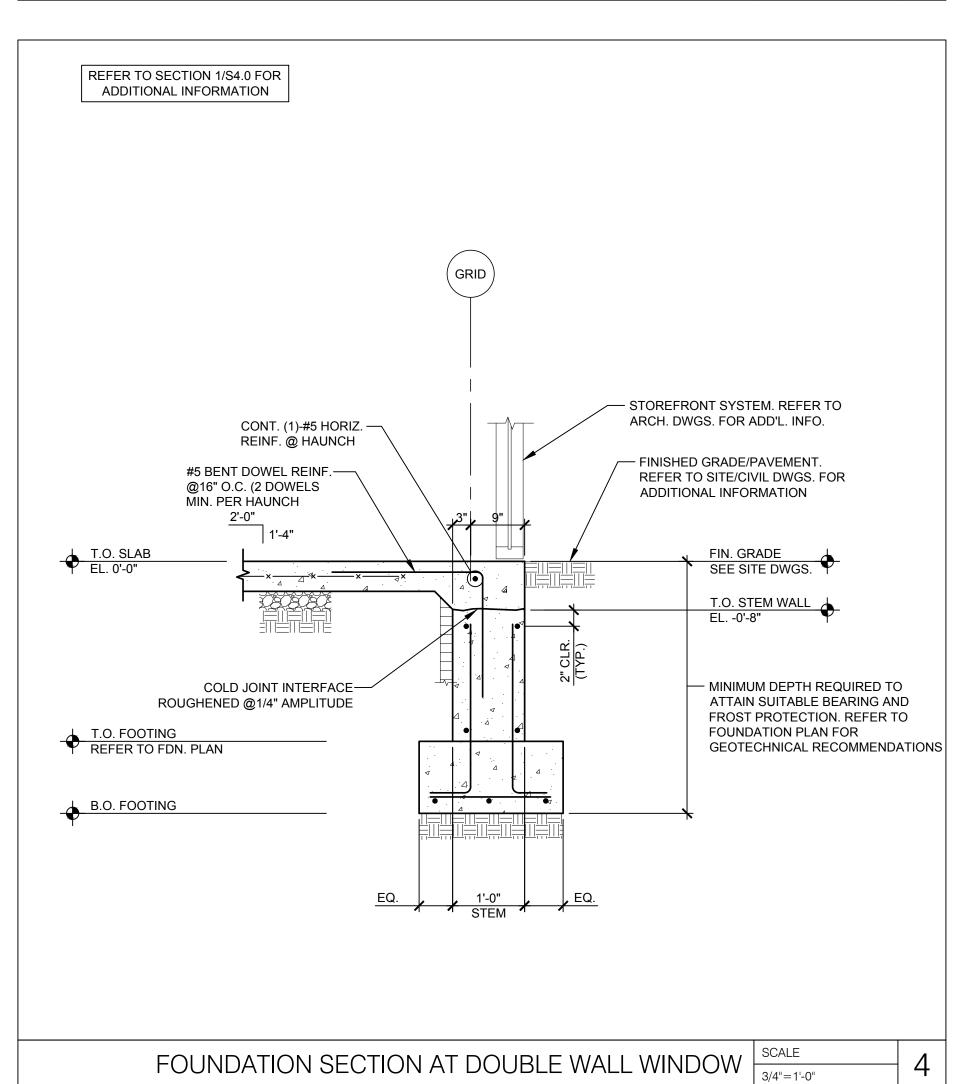




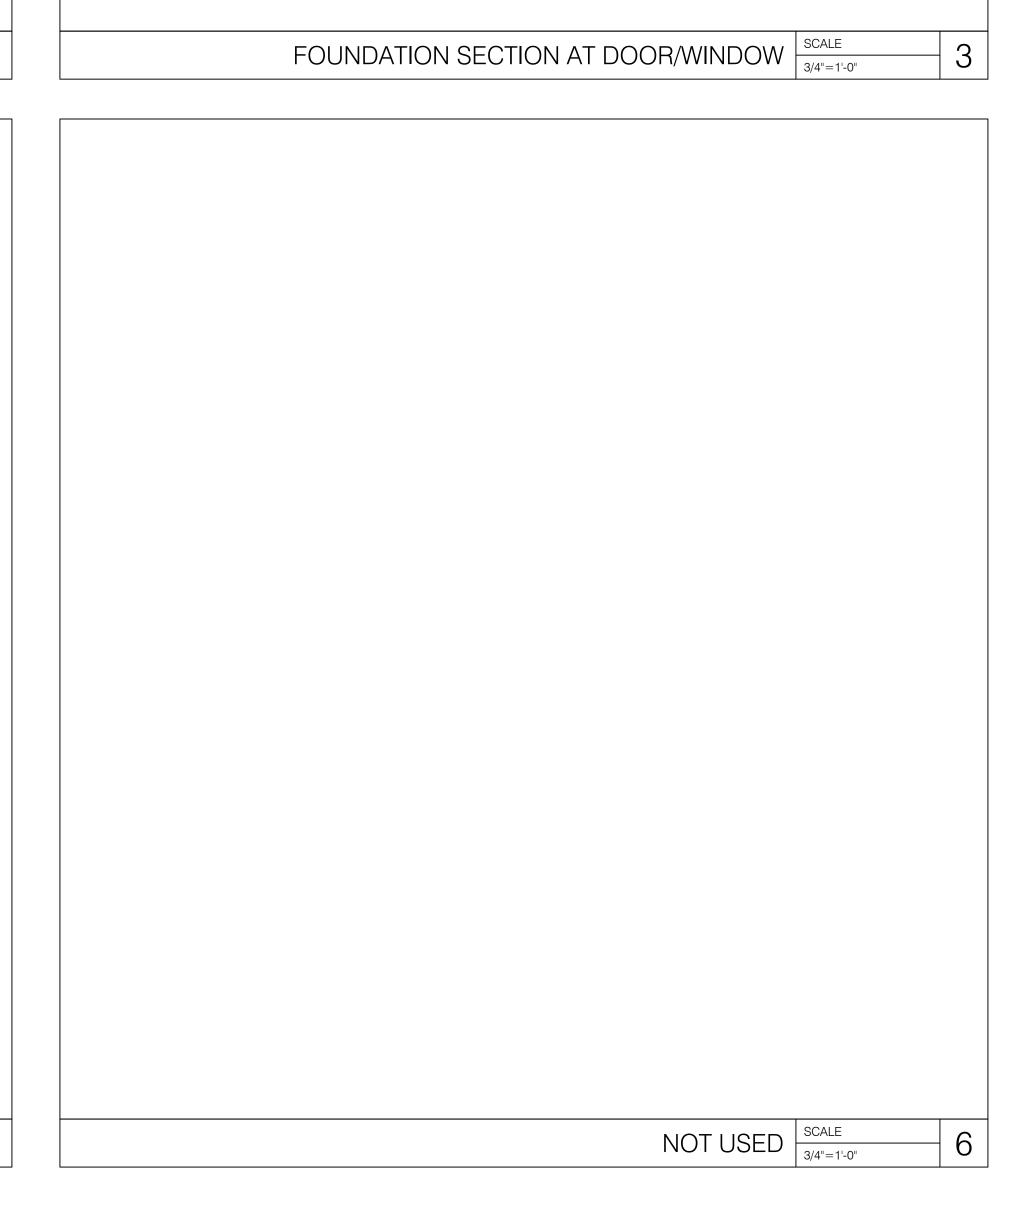





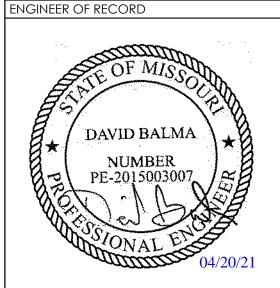

THESE DRAWINGS ARE NOT COMPLETE WITHOUT THE SEPARATE TYPE WRITTEN SPECIFICATIONS MANUAL WHICH ARE PART OF THE CONTRACT DOCUMENTS.

ISSUE	DATE	DESCRIPTION
-	2020.12.21	PERMIT SET
}	2021.04.20	STRUCTURAL STEEL REV
PRO.	JECT INFO	DRMATION

PROJECT INFORMATION

PROJECT NO: JPM.27135.001

DATE: 2020.12.21

PROTOTYPE: 20.2

DRAWN BY: J.PEREZ

CHECKED BY: E.SCALGIONE


VERSION: SE_1.00


SHEET TITLE


FOUNDATION SECTIONS


SHEET NUMBER


S4.0

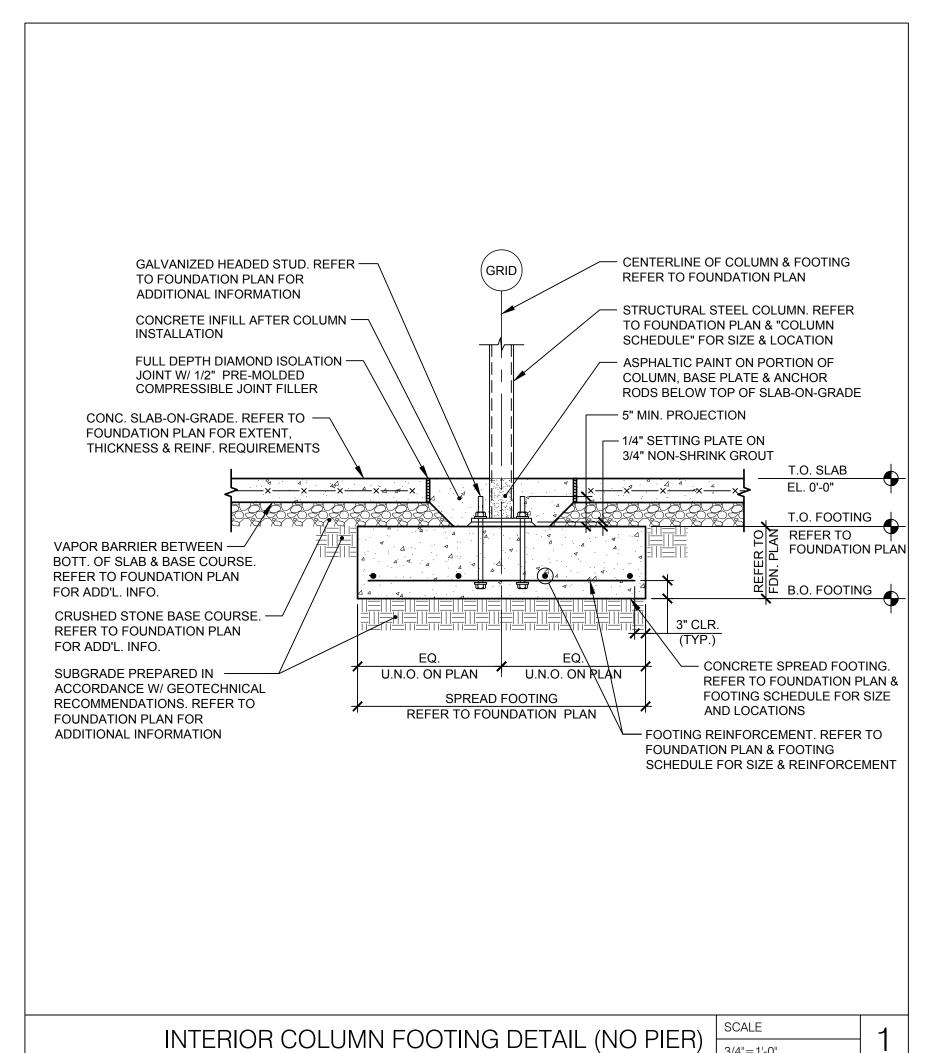


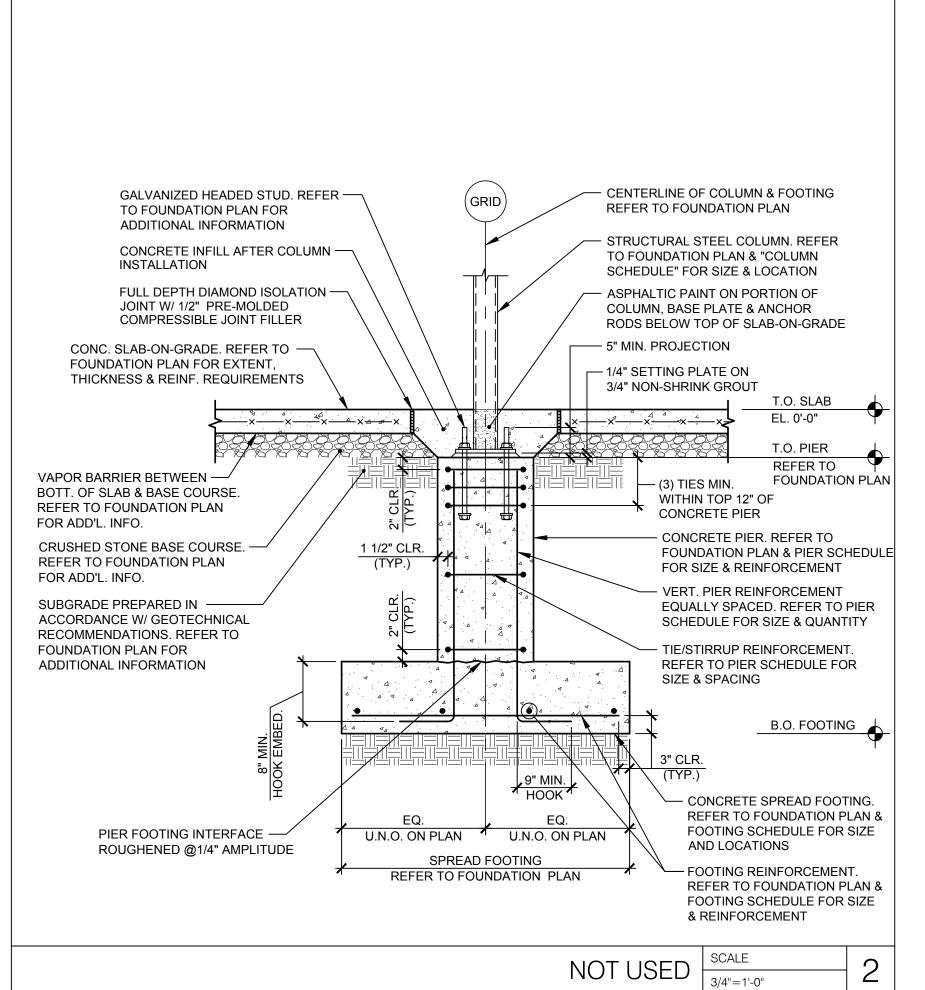

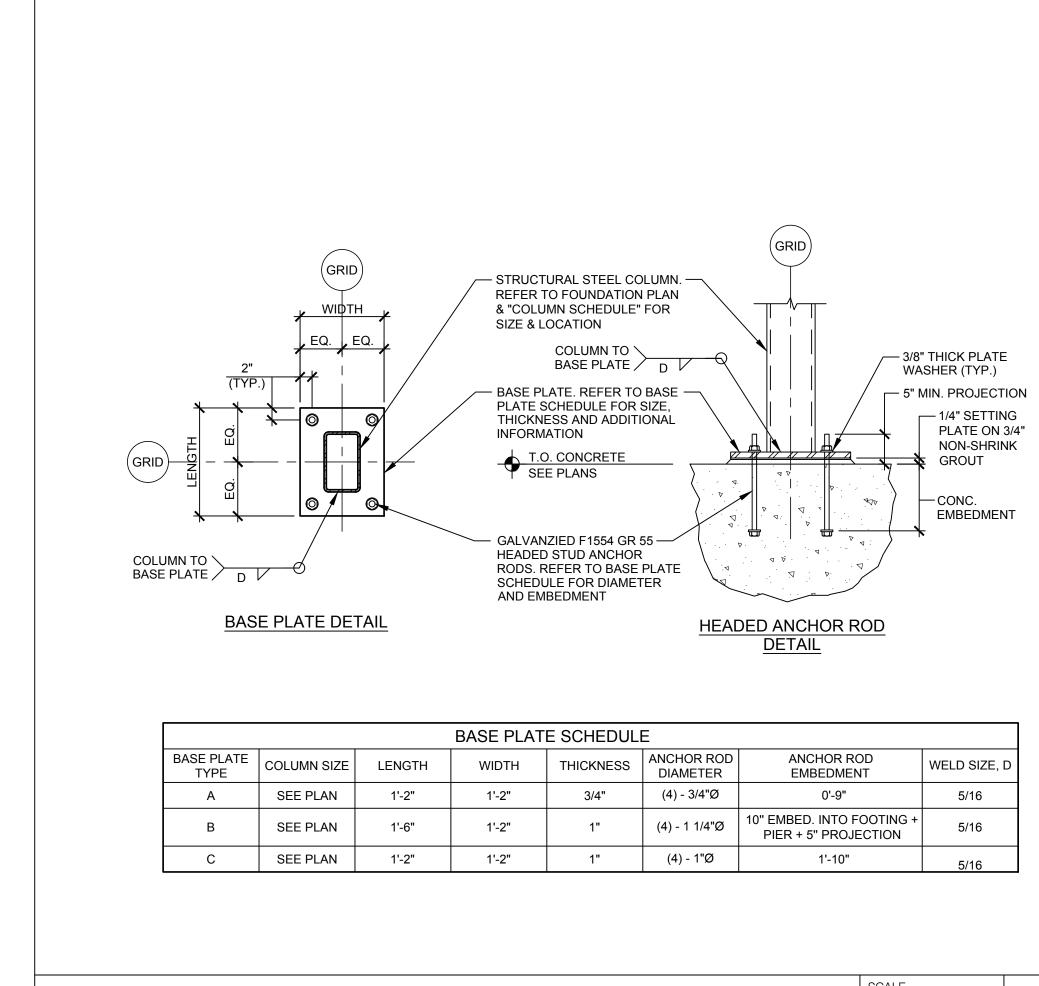

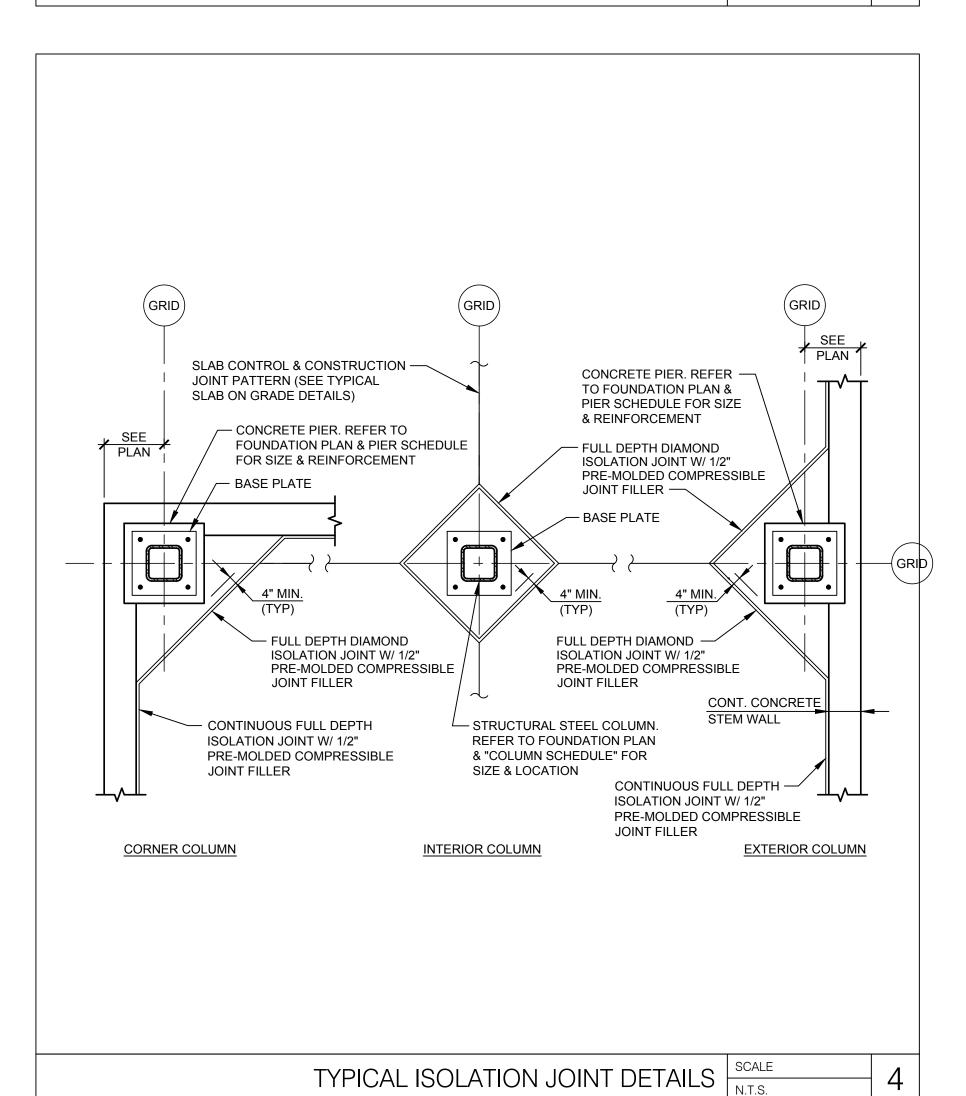

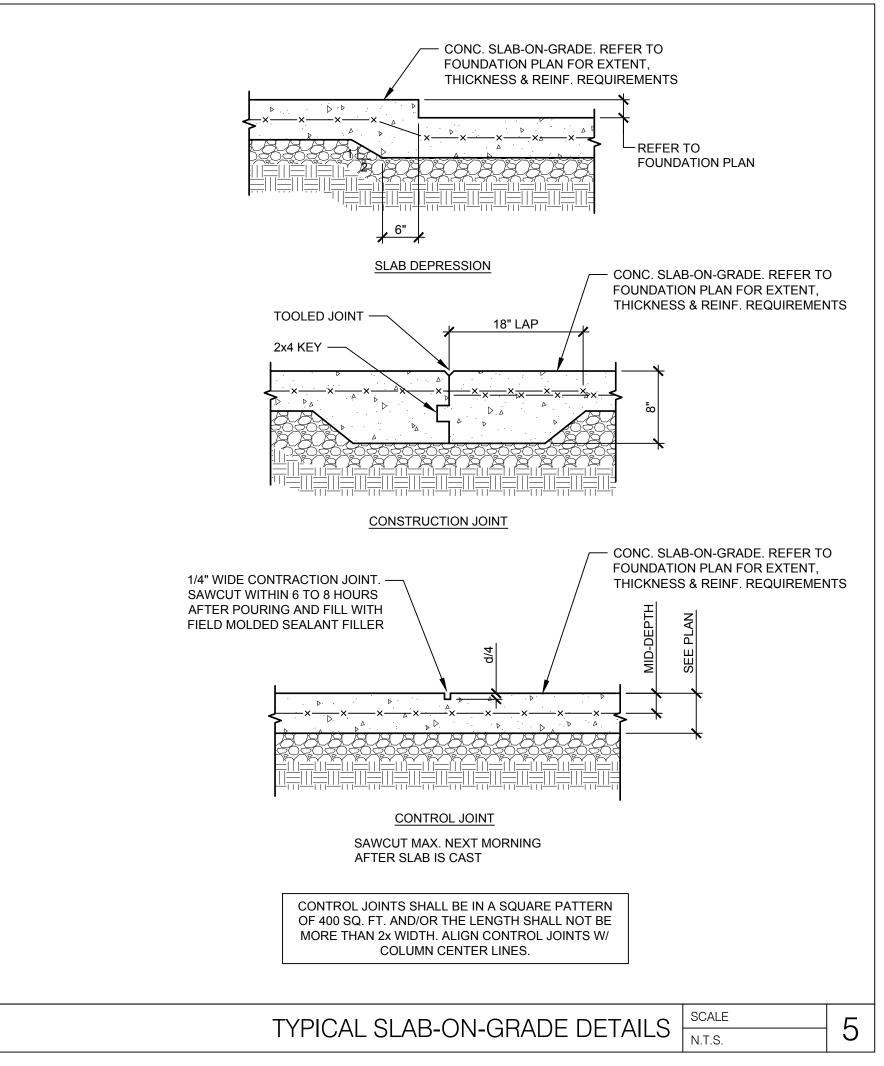

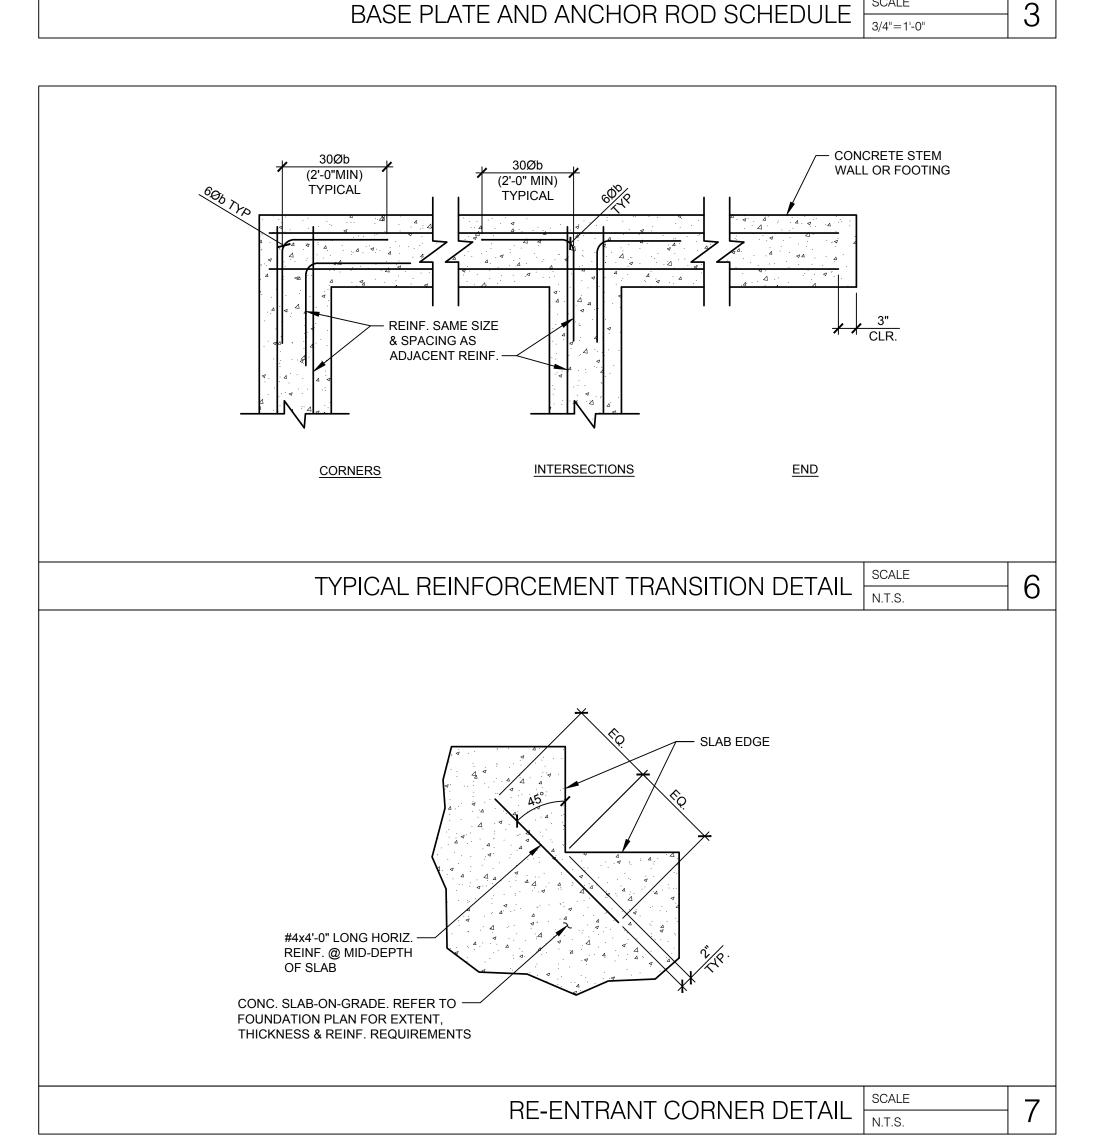





DAVID BALMA

NUMBER

PE-2015003007

PS-2015003007

O4/20/21

THESE DRAWINGS ARE NOT COMPLETE WITHOUT THE SEPARATE TYPE WRITTEN SPECIFICATIONS MANUAL WHICH ARE PART OF THE CONTRACT DOCUMENTS.

ISSUE DATE DESCRIPTION

- 2020.12.21 PERMIT SET

1 2021.04.20 STRUCTURAL STEEL REV

PROJECT INFORMATION

PROJECT INFORMATION

PROJECT NO: JPM.27135.001

DATE: 2020.12.21

PROTOTYPE: 20.2

DRAWN BY: J.PEREZ

CHECKED BY: E.SCALGIONE


VERSION: SE_1.00


SHEET TITLE


TYPICAL FOUNDATION DETAILS

SHEET NUMBER

S4.1

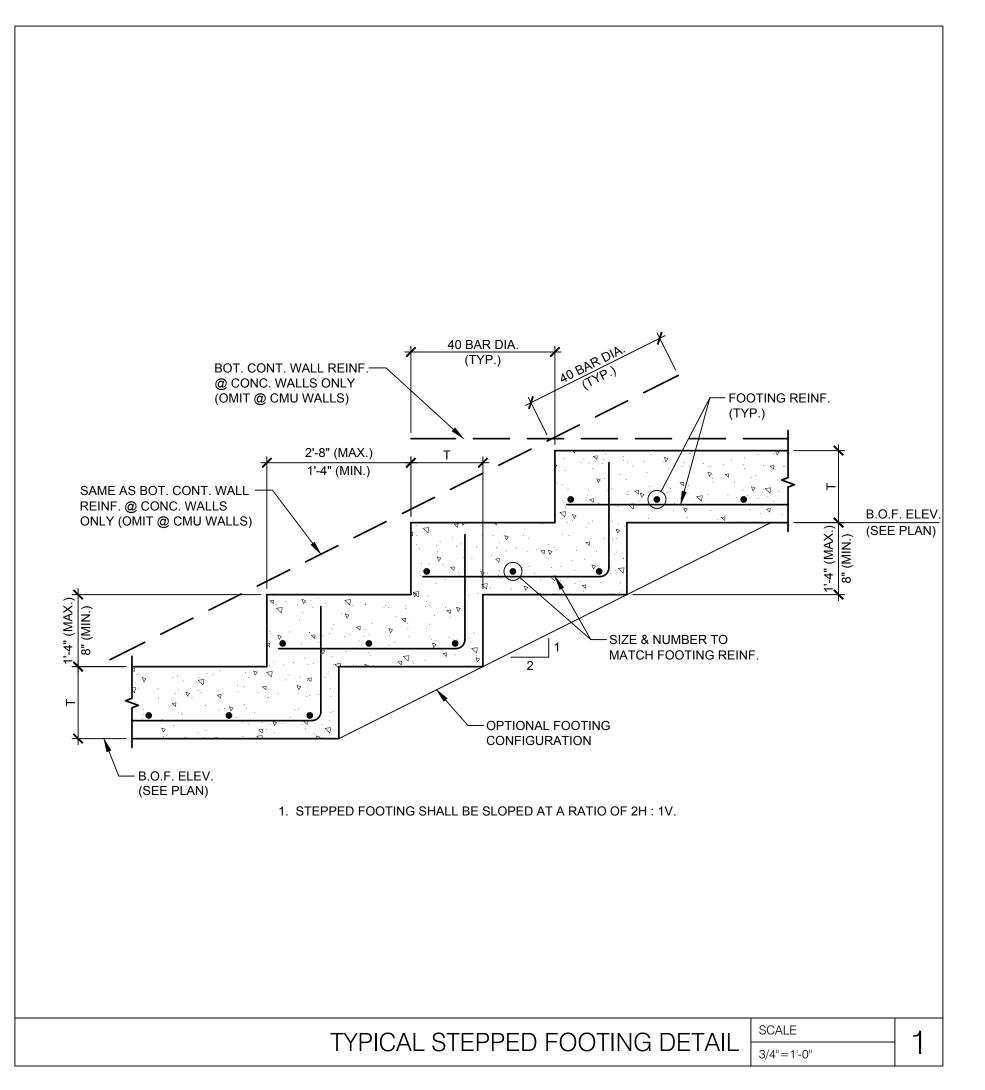

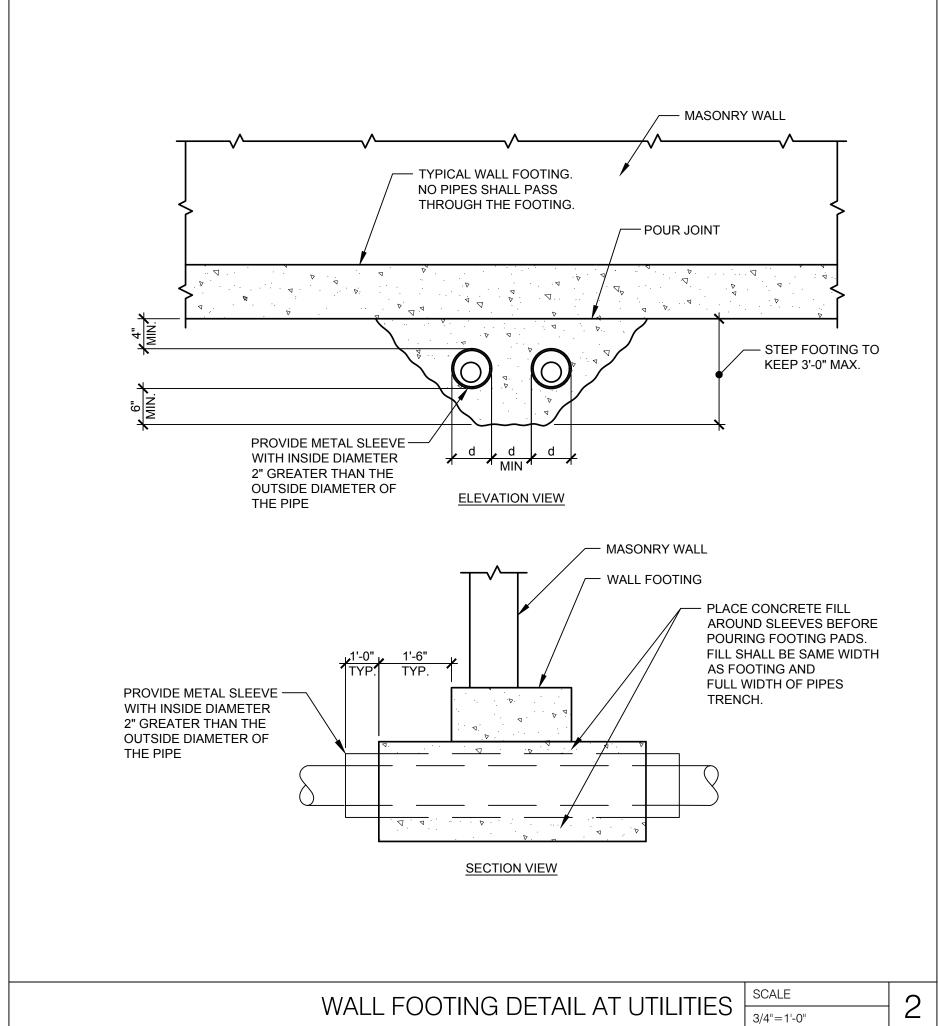

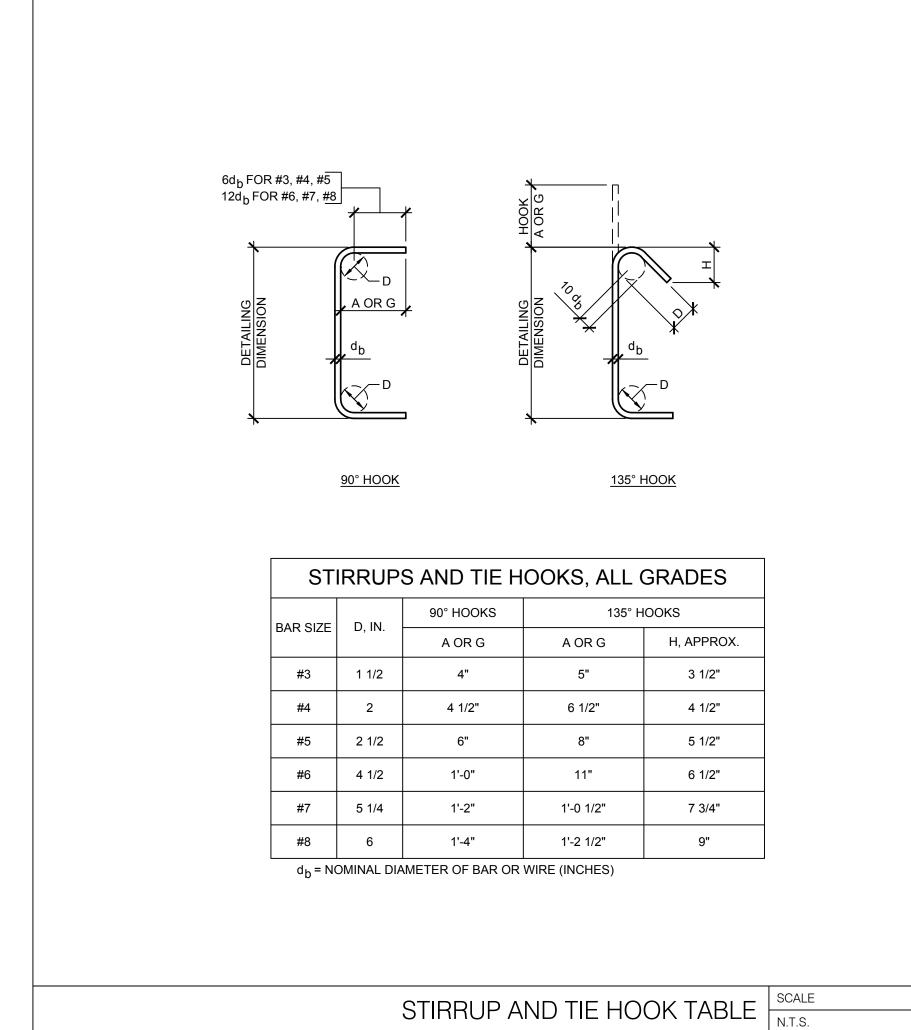


		Т	COMPRESSION			
DAD	LAD	LAP L	ENGTH PER SPAC	ING AND COVER	CASE	LAP
BAR SIZE	LAP CLASS	CAS	SE 1	CAS	SE 2	SPLICES
0.22	02/100	TOP BARS	OTHER BARS	TOP BARS	OTHER BARS	
#3	В	24	19	36	28	12
#4	В	32	25	48	37	15
#5	В	40	31	60	47	19
#6	В	48	37	72	56	23
#7	В	70	54	106	81	26
#8	В	80	62	121	93	30
#9	В	91	70	136	105	34
#10	В	102	79	153	118	38
#11	В	113	87	170	131	42

- UTILIZE A FACTOR OF 1.5 WHERE CONTACT SPLICES ARE REQUIRED.
 TABLE APPLIES TO CONCRETE WITH fc = 4000 PSI OR GREATER.
 CASE 1: COVER AT LEAST 1Øb AND CENTER-TO-CENTER SPACING AT LEAST
- CASE 2: COVER LESS THAN 1Øb AND CENTER-TO-CENTER SPACING AT LESS THAN 2Øb.


LAP SPLICE TABLE SCALE NONE

4	

THE MINIMUM CLEAR COVER FOR REINFORCEMENT BARS SHALL BE ONE BAR DIAMETER OR THE VALUES TABULATED BELOW, WHICHEVER IS THE GREATER. SLABS (LT.WT. CONC. OR STONE CONC.) SLABS NOT EXPOSED TO WEATHER OR IN CONTACT WITH GROUND 3/4* GIRDERS AND BEAMS (TO STIRRUPS) JOISTS (STONE OR LT.WT.) BOTTOM BARS 1 1/4* TIED COLUMNS AND PIERS SURFACE EXPOSED TO EARTH AND WEATHER (TO TIES) OTHER SURFACES (TO TIES) FOUNDATION ELEMENTS FORMED SURFACES SURFACES PLACED AGAINST EARTH WALLS SURFACES EXPOSED TO EARTH 2* SURFACES EXPOSED TO WEATHER 1 11/2* OTHER SURFACES 1 1/2*
SURFACE EXPOSED TO EARTH AND WEATHER (TO TIES) 2" OTHER SURFACES (TO TIES) 1 1/2" FOUNDATION ELEMENTS FORMED SURFACES 2" SURFACES PLACED AGAINST EARTH 3" WALLS SURFACES EXPOSED TO EARTH 2" SURFACES EXPOSED TO WEATHER 1 1 1/2"
OTHER SURFACES (TO TIES) 1 1/2" FOUNDATION ELEMENTS FORMED SURFACES 2" SURFACES PLACED AGAINST EARTH 3" WALLS SURFACES EXPOSED TO EARTH 2" SURFACES EXPOSED TO WEATHER 1 1/2"
FOUNDATION ELEMENTS FORMED SURFACES 2" SURFACES PLACED AGAINST EARTH 3" WALLS SURFACES EXPOSED TO EARTH 2" SURFACES EXPOSED TO WEATHER 1 1/2"
FORMED SURFACES 2" SURFACES PLACED AGAINST EARTH 3" WALLS SURFACES EXPOSED TO EARTH 2" SURFACES EXPOSED TO WEATHER 1 1/2"
SURFACES PLACED AGAINST EARTH 3" WALLS SURFACES EXPOSED TO EARTH 2" SURFACES EXPOSED TO WEATHER 1 1/2"
SURFACES EXPOSED TO EARTH 2" SURFACES EXPOSED TO WEATHER 1 1/2"
SURFACES EXPOSED TO WEATHER 1 1/2"
OTHER SURFACES 1"

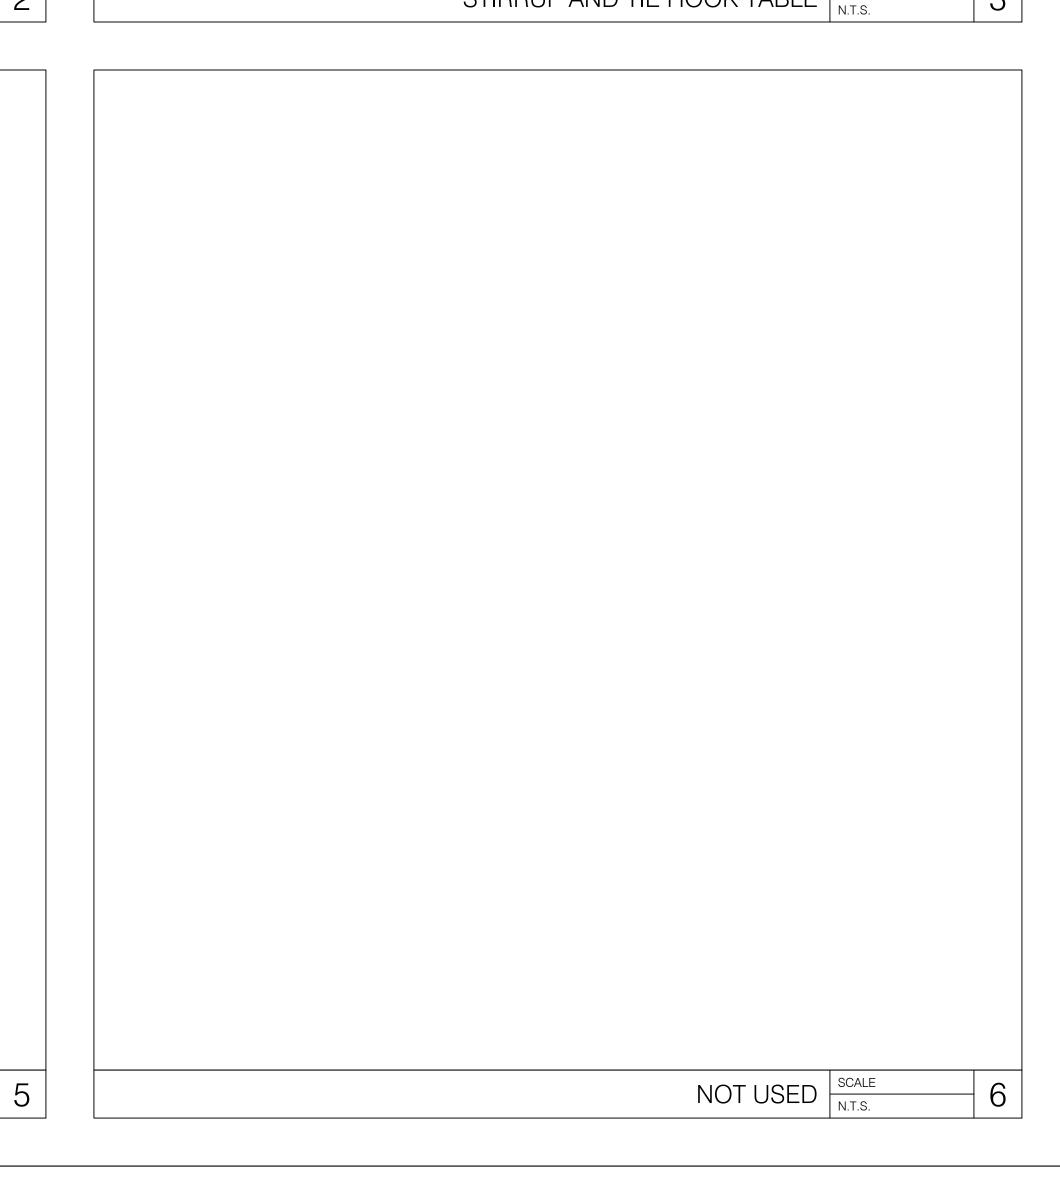



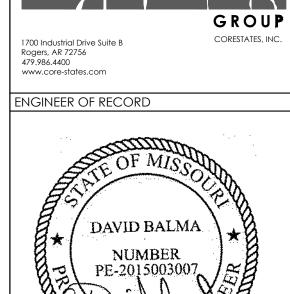

THESE DRAWINGS ARE NOT COMPLETE WITHOUT THE SEPARATE TYPE WRITTEN SPECIFICATIONS MANUAL WHICH ARE PART OF THE CONTRACT DOCUMENTS.


SSUE	DATE	DESCRIPTION
-	2020.12.21	PERMIT SET
1	2021.04.20	STRUCTURAL STEEL REV


PROJECT INFO	ORMATION
PROJECT NO:	JPM.27135.001
DATE:	2020.12.21
PROTOTYPE:	20.2
DRAWN BY:	J.PEREZ
CHECKED BY:	e.scalgione
VERSION:	SE_1.00
SHEET TITLE	


TYPICAL FOUNDATION **DETAILS II**


SHEET NUMBER


S4.2

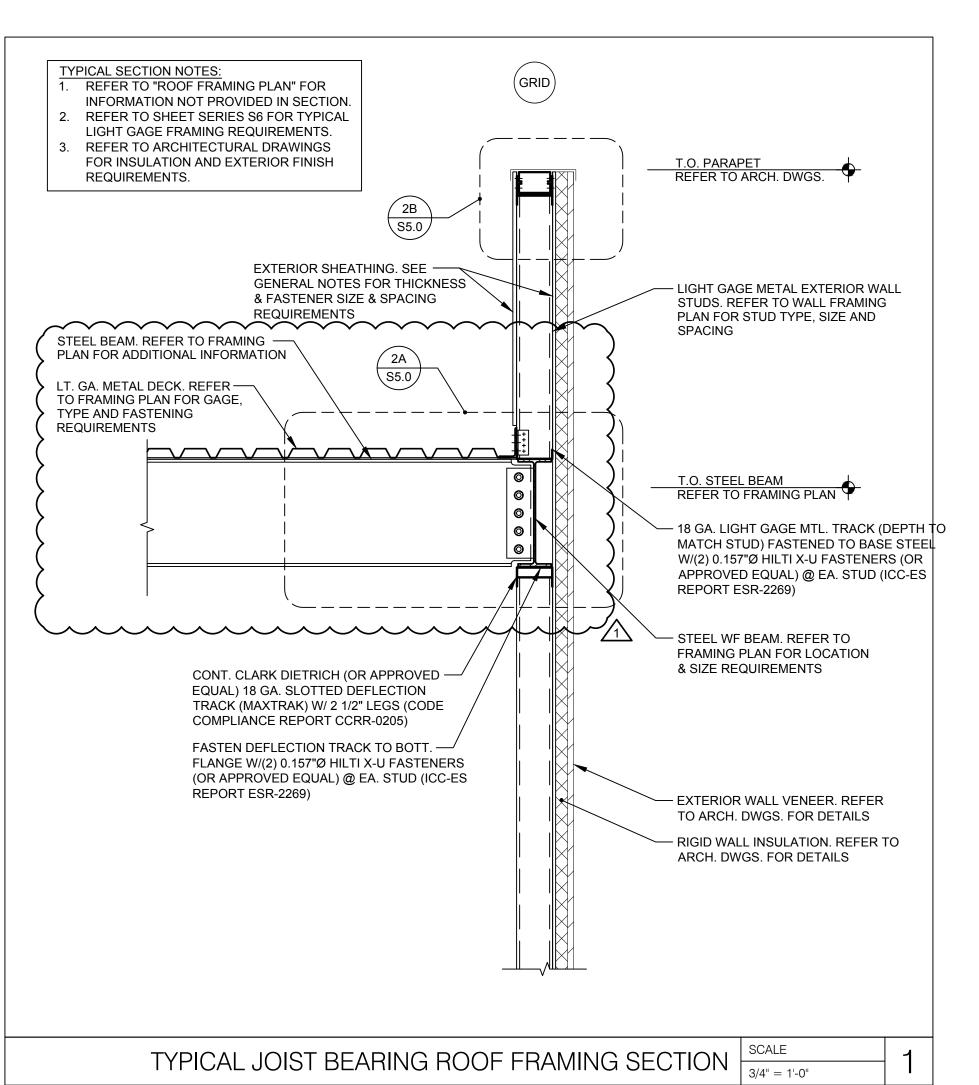


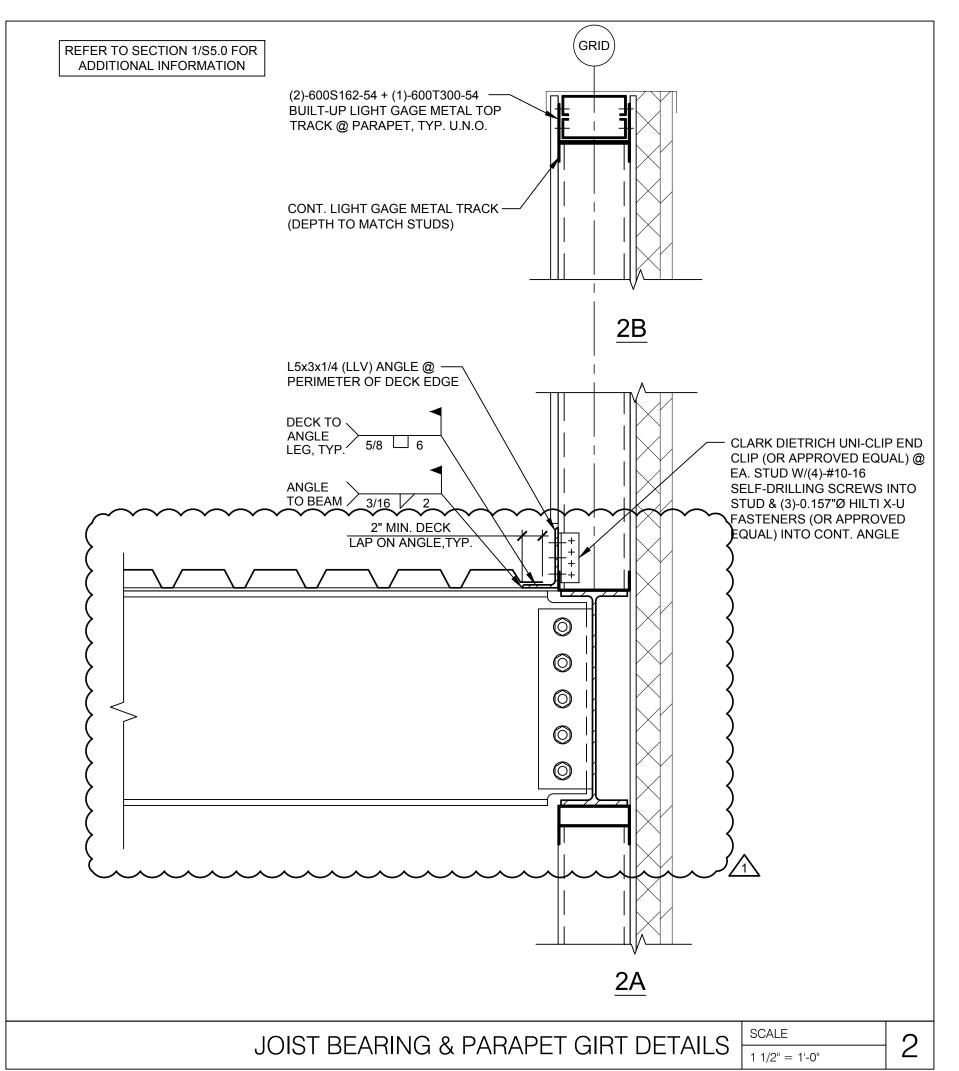


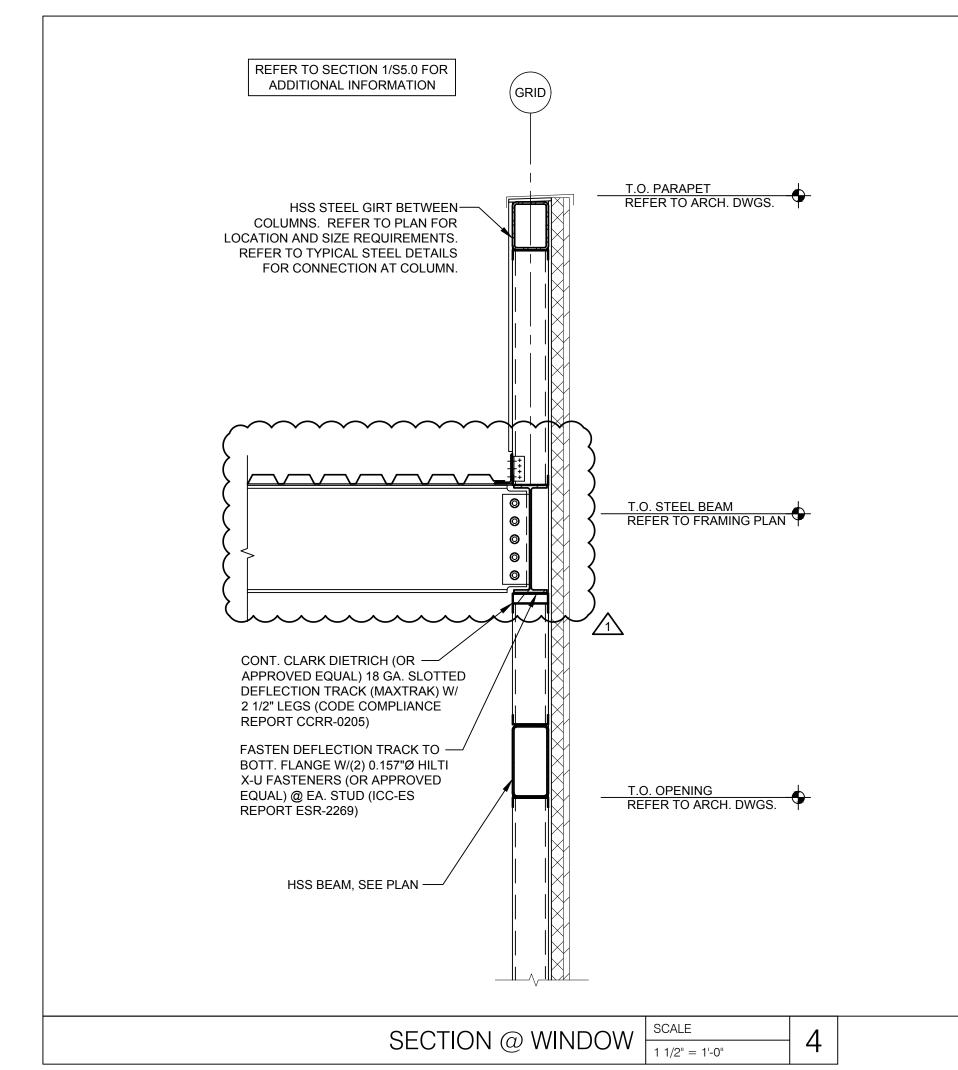

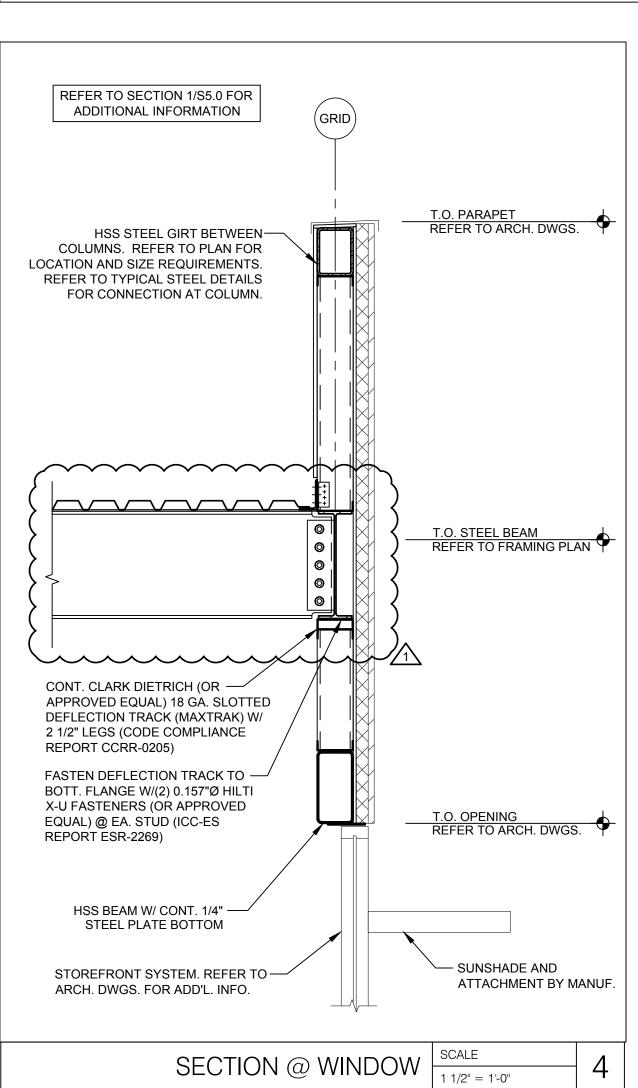


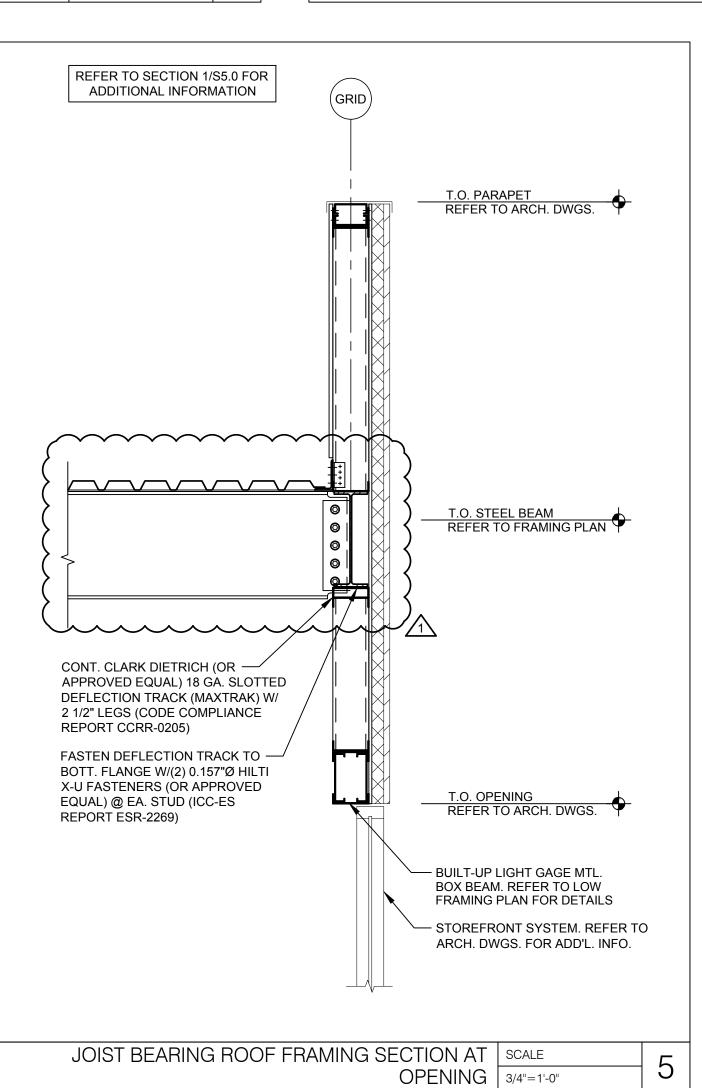

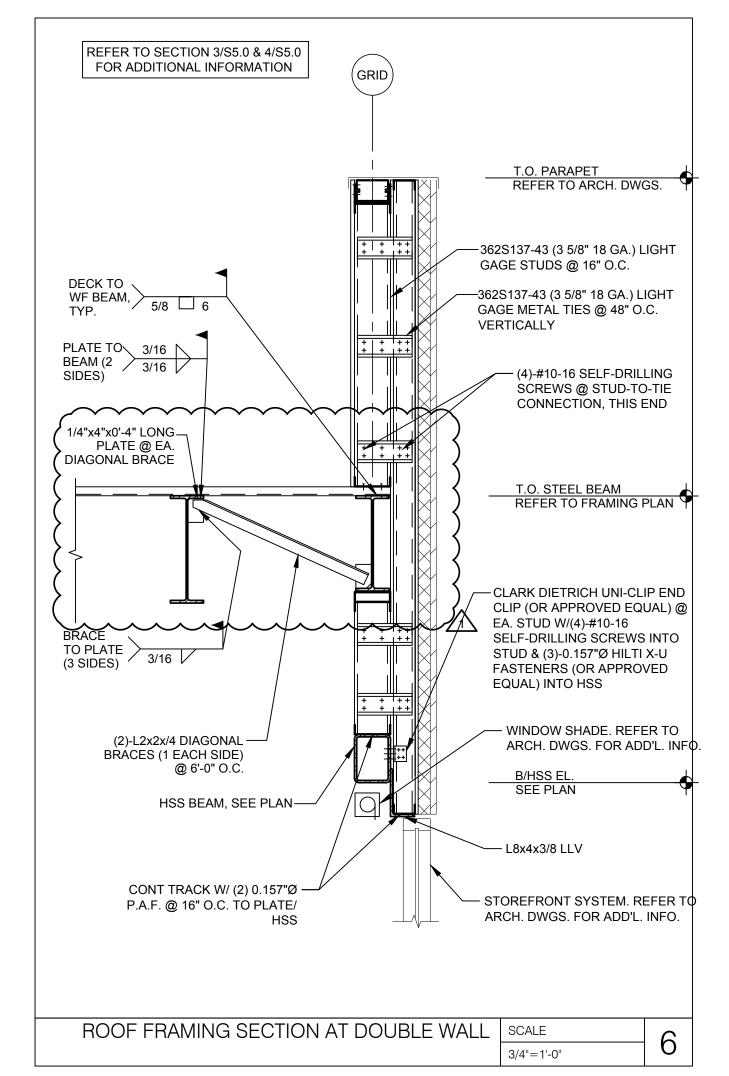

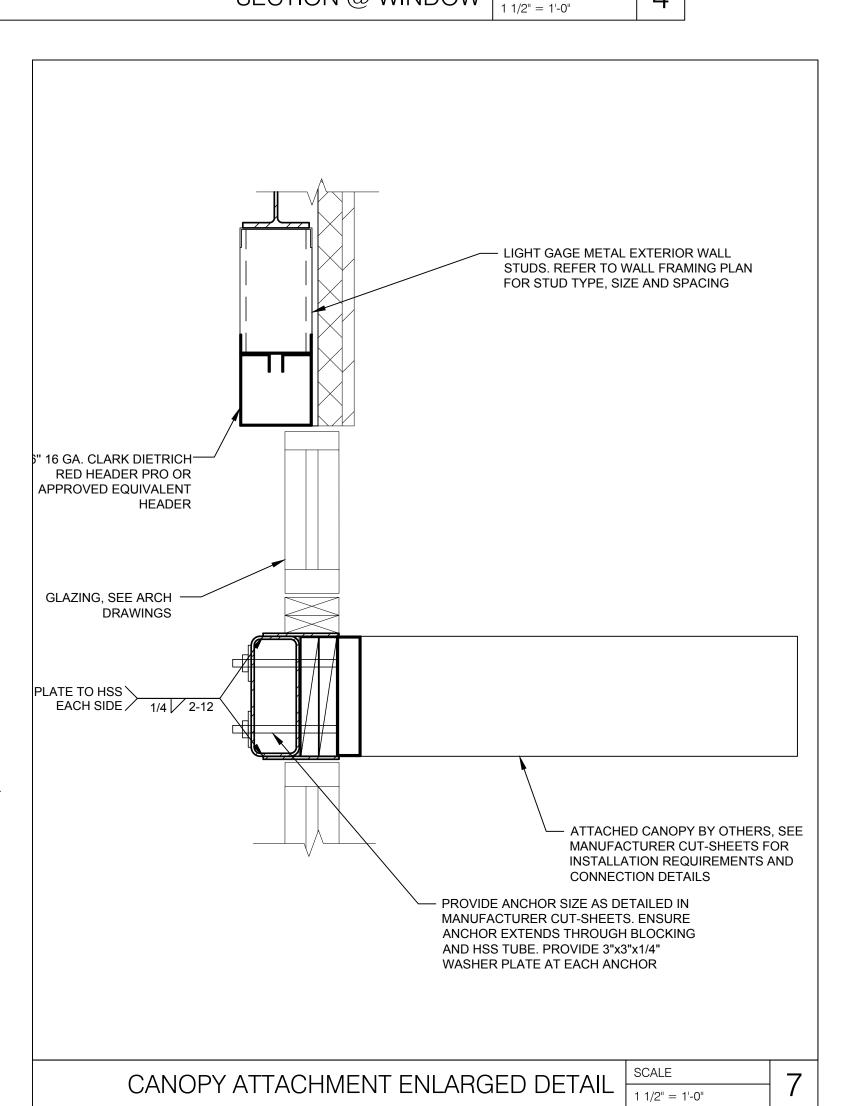



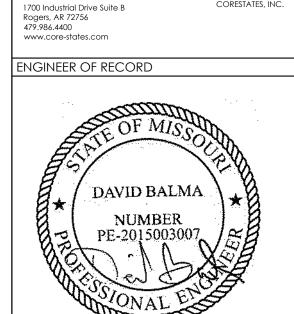

GROUP

THESE DRAWINGS ARE NOT COMPLETE WITHOUT THE SEPARATE TYPE WRITTEN SPECIFICATIONS MANUAL WHICH ARE PART OF THE CONTRACT DOCUMENTS.

ISSUE	DATE	DESCRIPTION
-	2020.12.21	PERMIT SET
1	2021.04.20	STRUCTURAL STEEL REV
PROJECT INFORMATION		
PROJECT NO:		JPM.27135.001
DA	TE:	2020.12.21
PRO	OTOTYPE:	20.2

ROOF FRAMING SECTIONS

J.PEREZ

E.SCALGIONE

SHEET NUMBER


DRAWN BY:

VERSION:


SHEET TITLE


CHECKED BY:


S5.0

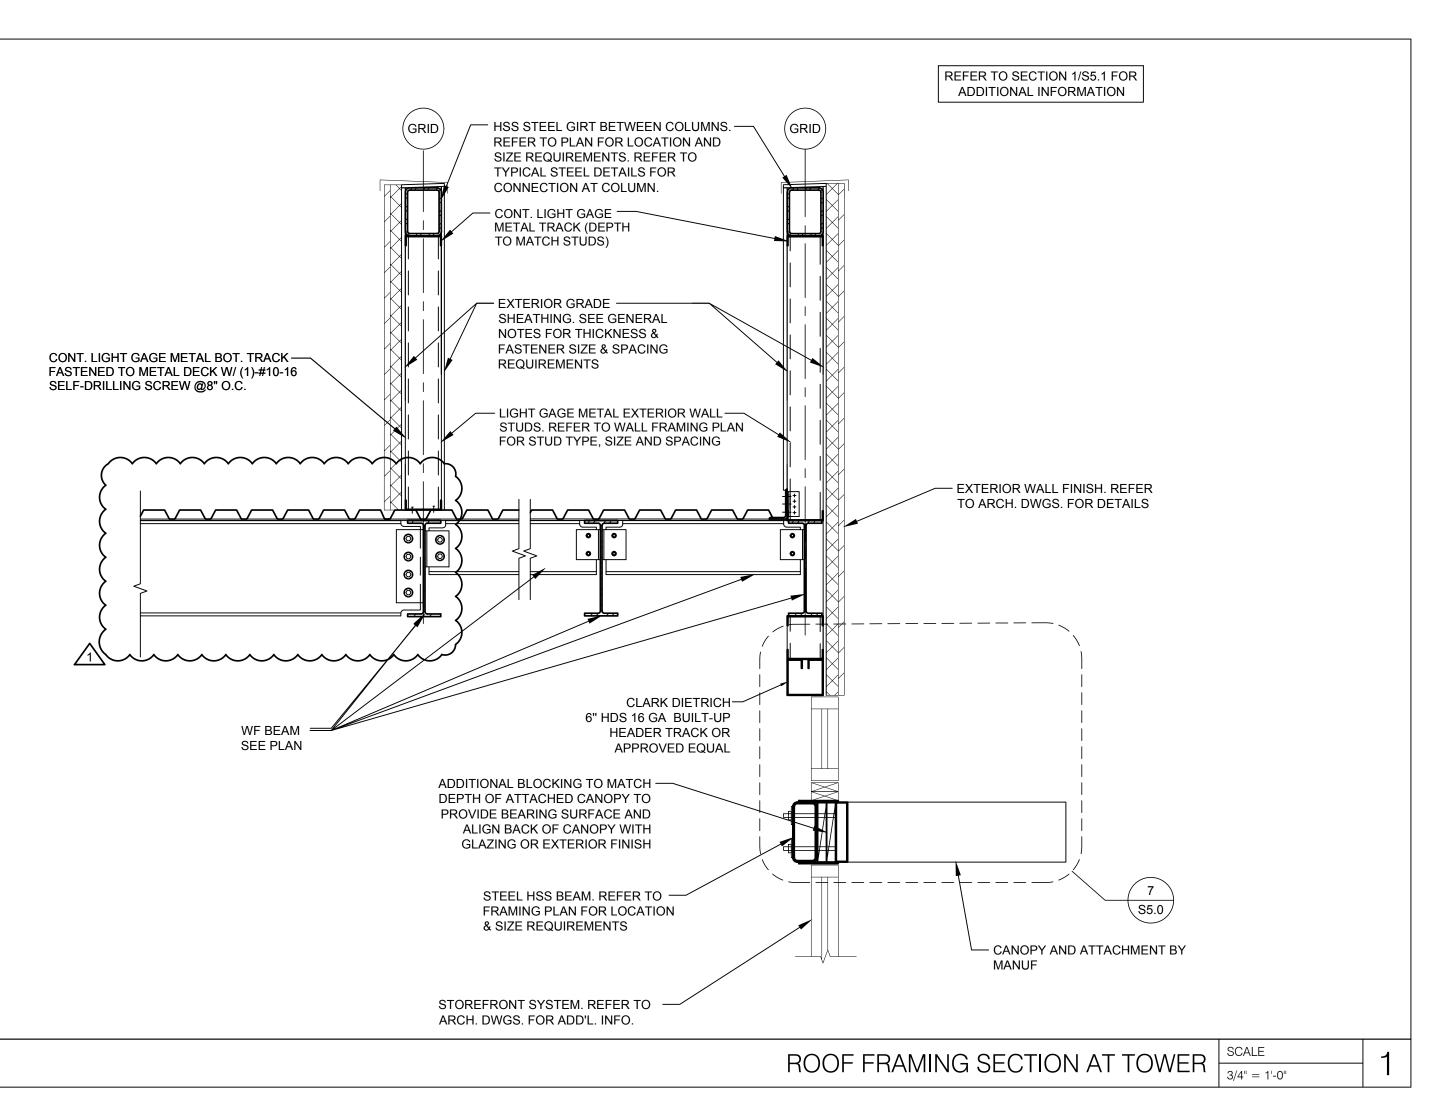



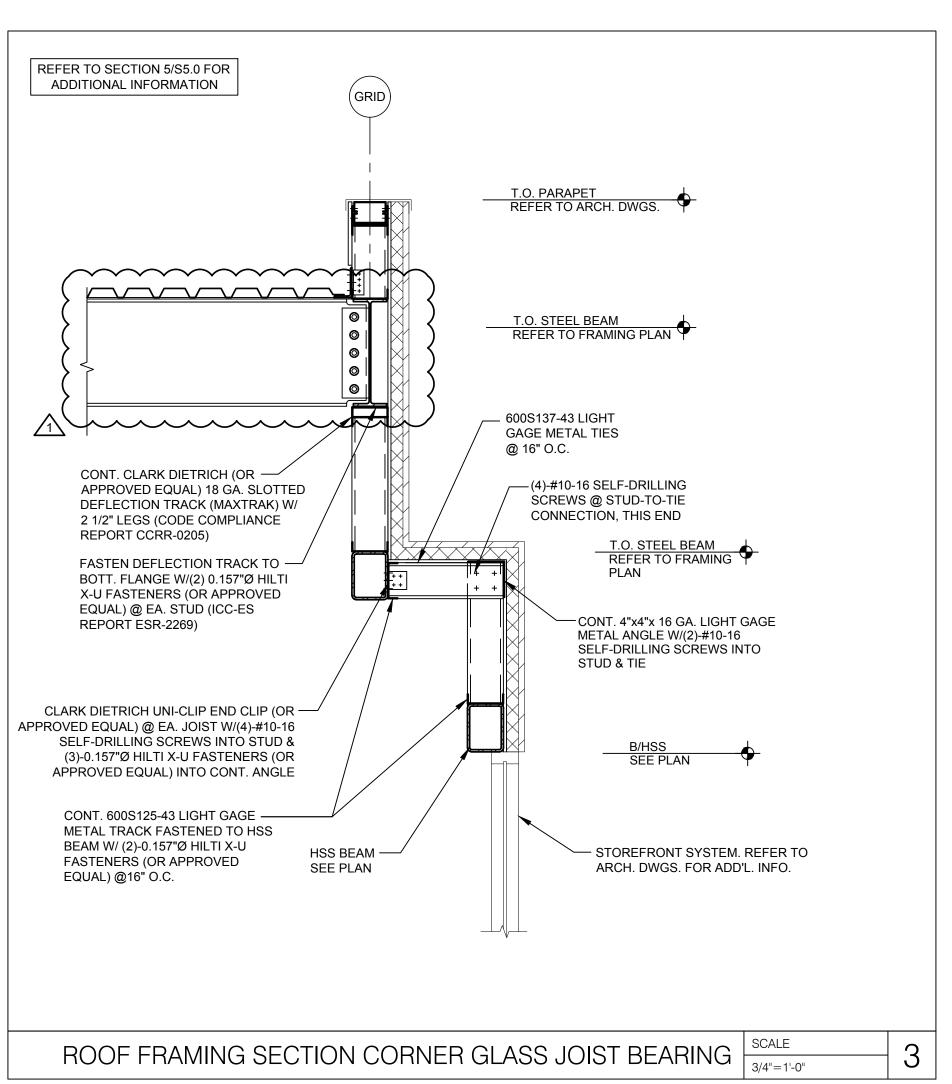

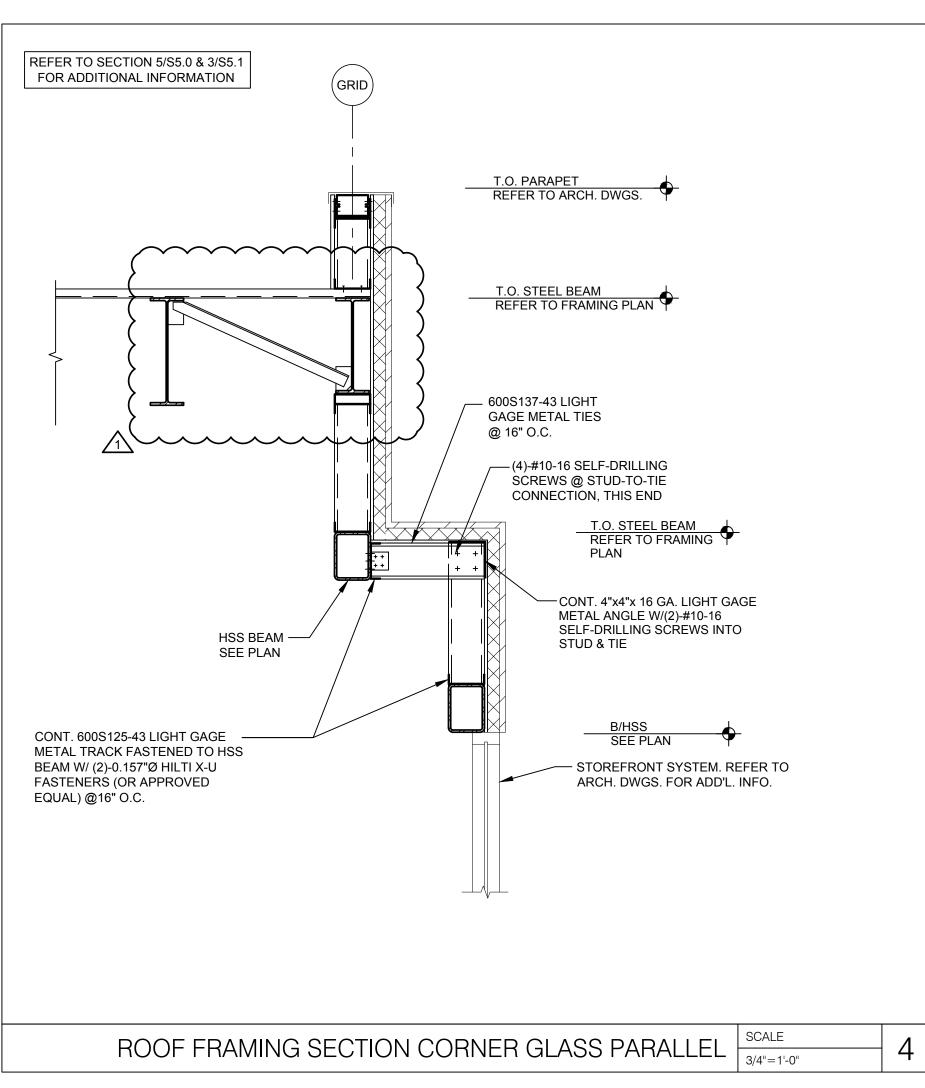


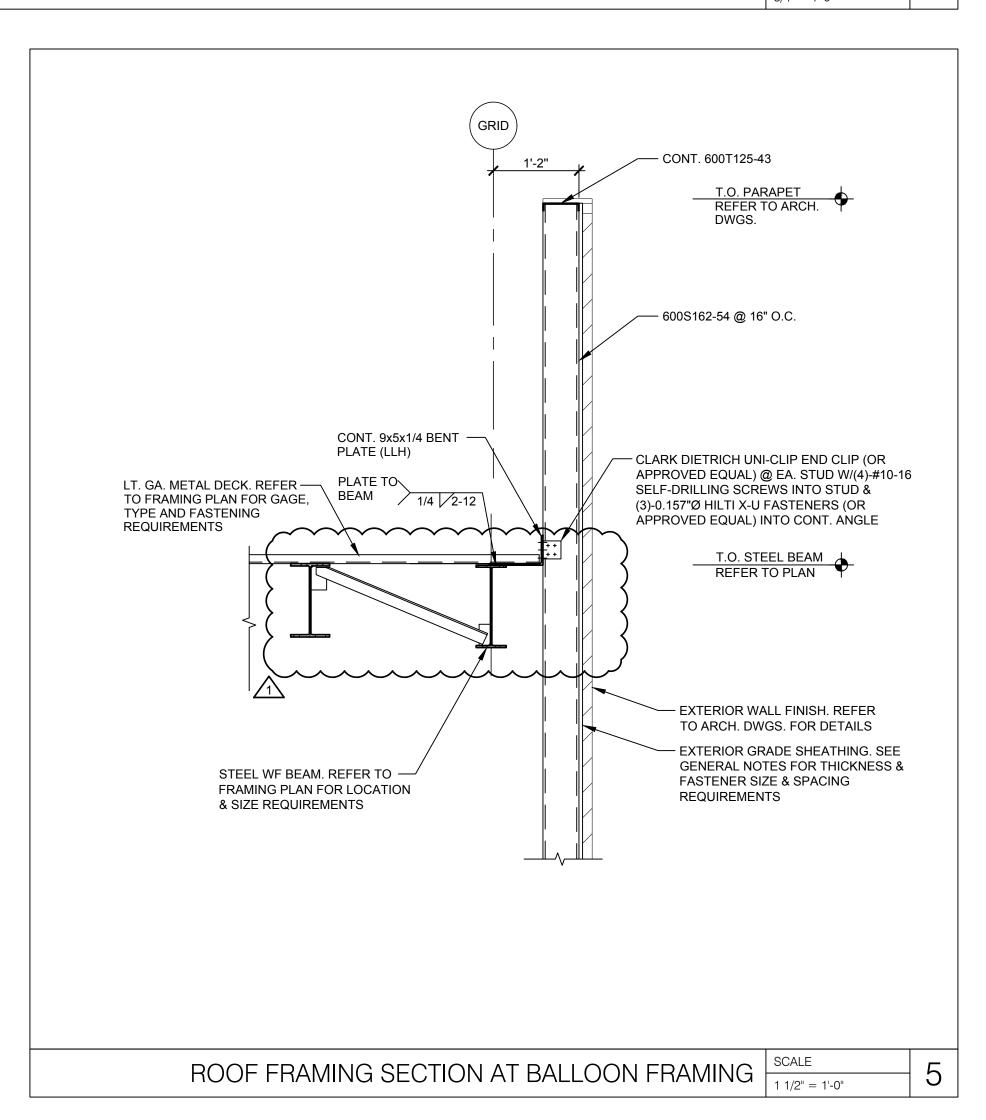



I 700 Industrial Drive Suite B
Rogers, AR 72756
479.986.4400
www.core-states.com

ENGINEER OF RECORD

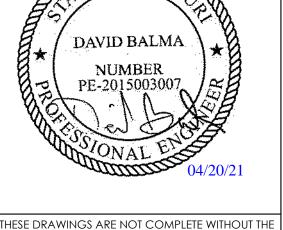

THESE DRAWINGS ARE NOT COMPLETE WITHOUT THE SEPARATE TYPE WRITTEN SPECIFICATIONS MANUAL WHICH ARE PART OF THE CONTRACT DOCUMENTS.

ISSUE	DATE	DESCRIPTION		
-	2020.12.21	PERMIT SET		
3	2021.04.20	STRUCTURAL STEEL REV		
PROJECT INFORMATION				
PROJECT NO:		JPM.27135.001		
DATE:		2020.12.21		
PRO	OTOTYPE:	20.2		
DR	AWN BY:	J.PEREZ		
CHECKED BY:		E.SCALGIONE		

ROOF FRAMING SECTIONS II


SE_1.00


SHEET NUMBER


VERSION:


SHEET TITLE


S5.

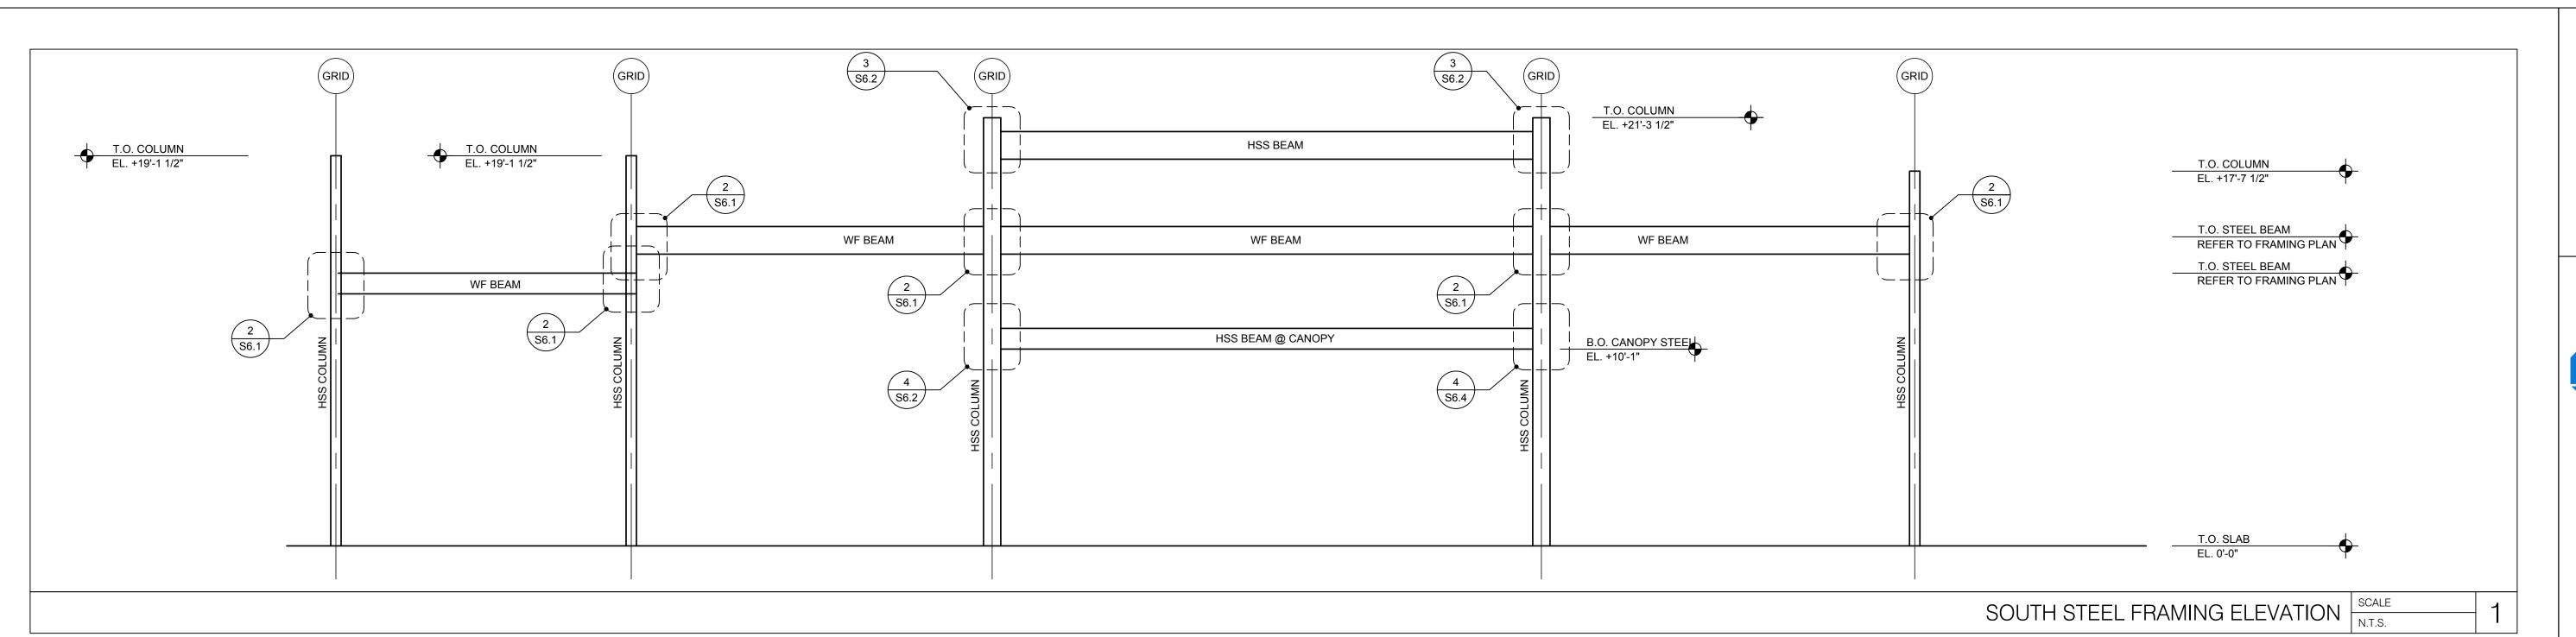

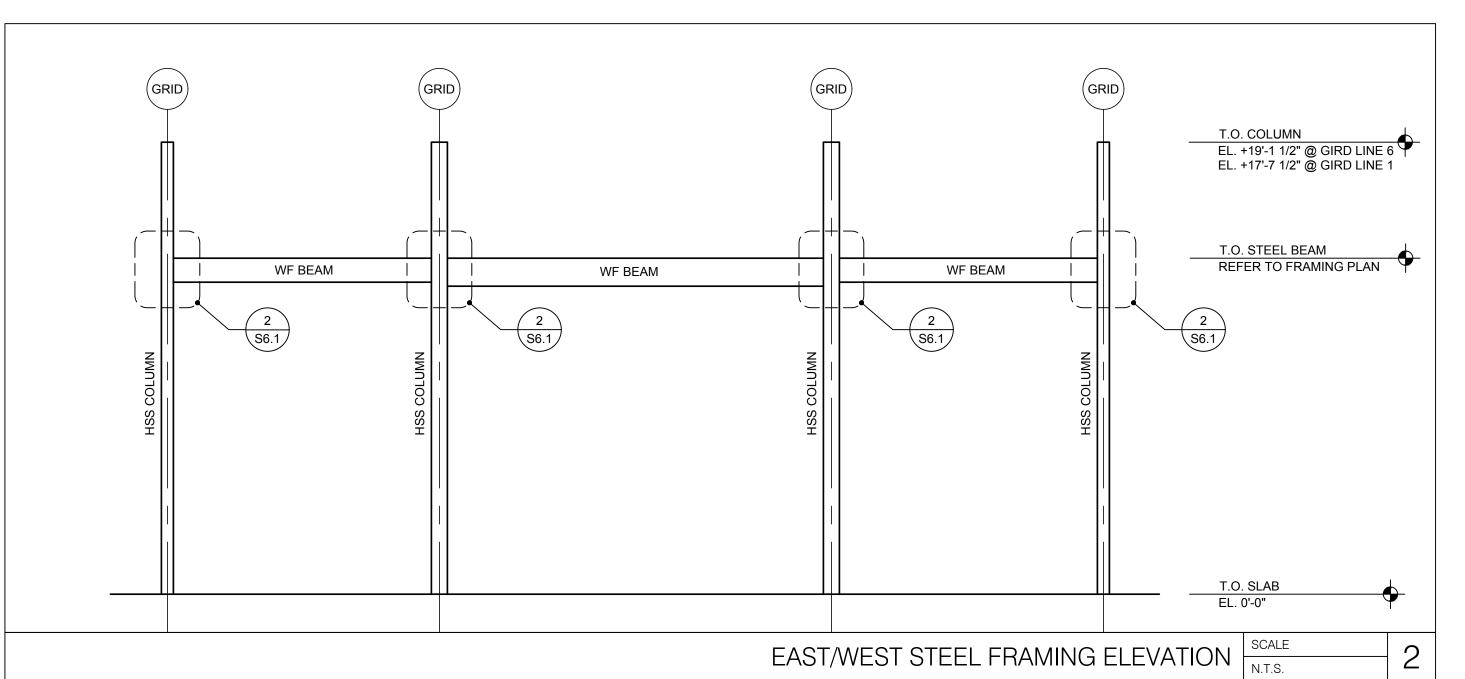


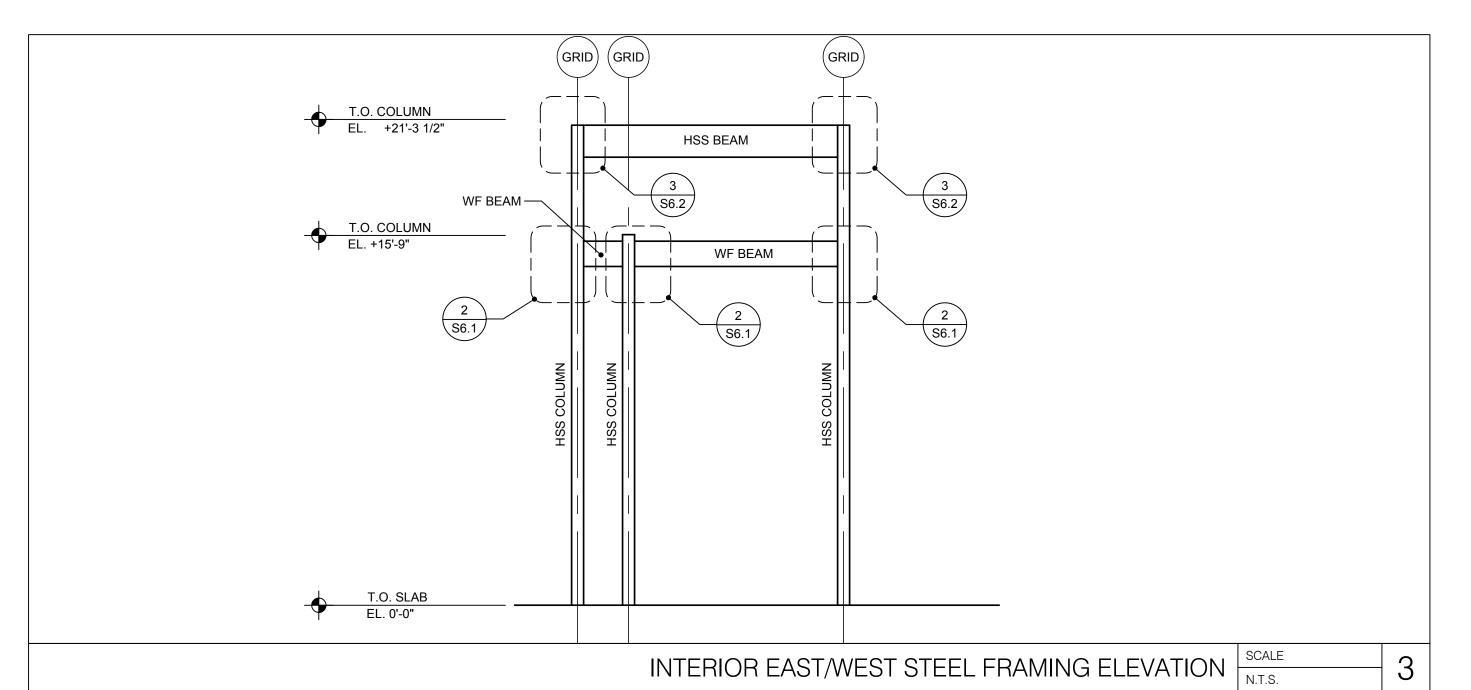

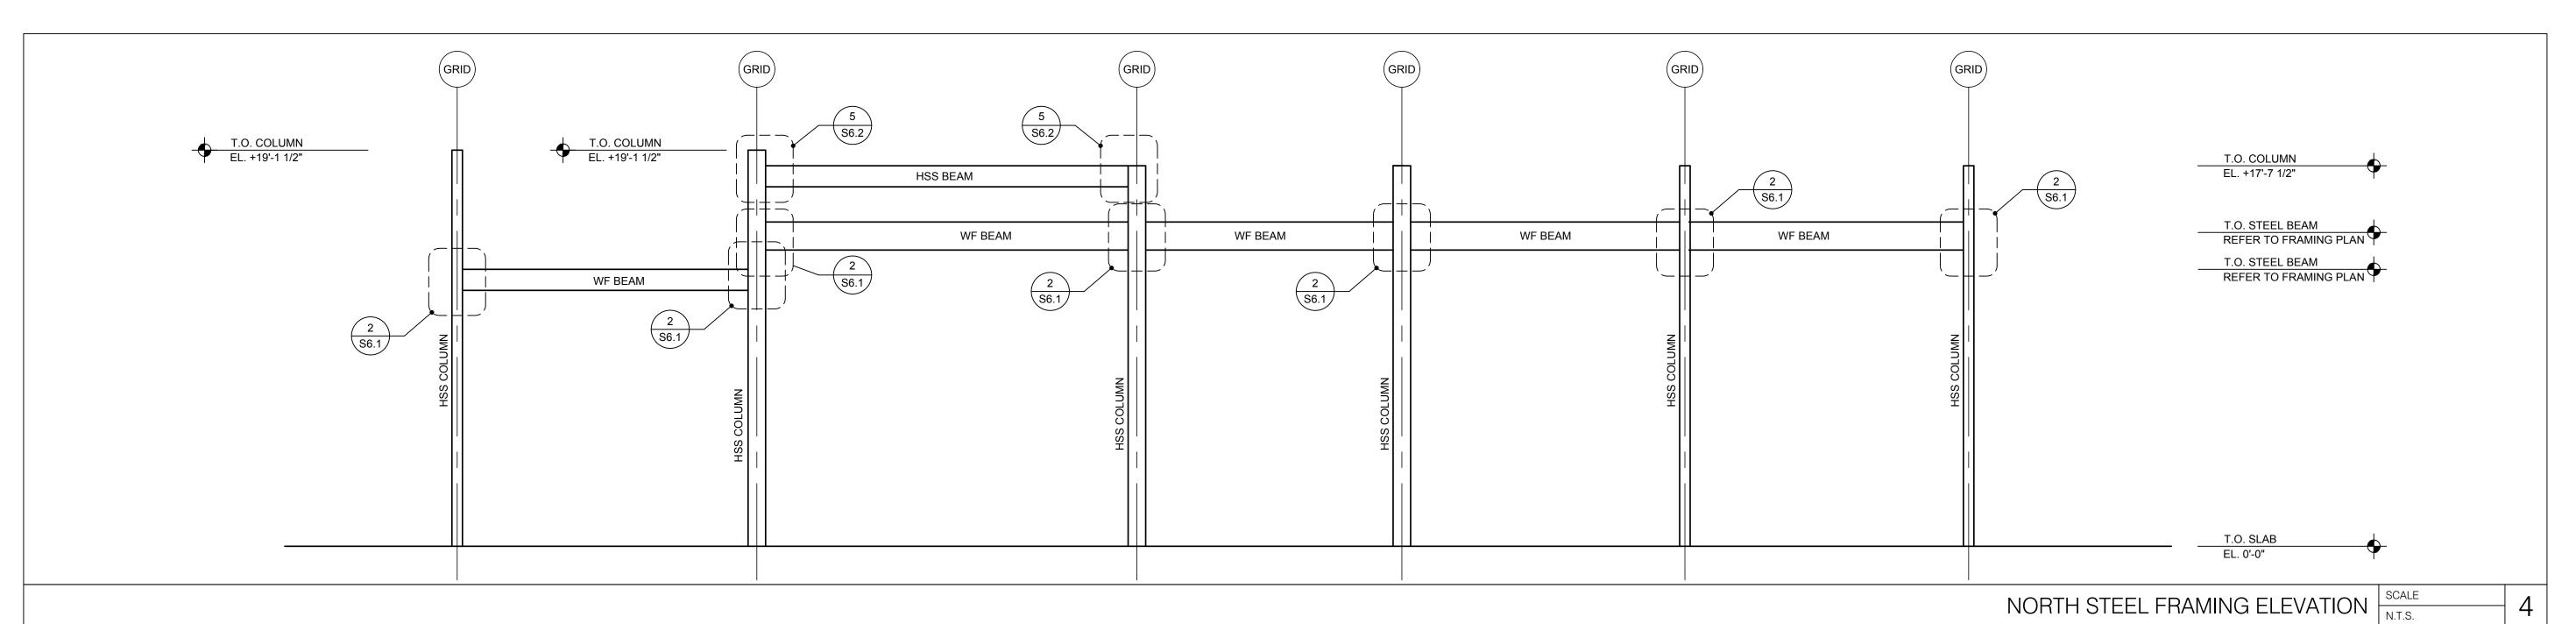

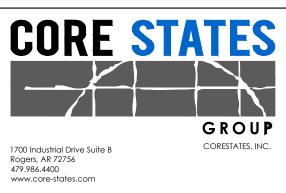

ENGINEER OF RECORD

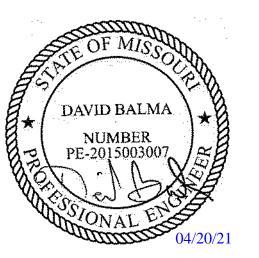



THESE DRAWINGS ARE NOT COMPLETE WITHOUT THE SEPARATE TYPE WRITTEN SPECIFICATIONS MANUAL WHICH ARE PART OF THE CONTRACT DOCUMENTS.


ISSUE	DATE	DESCRIPTION
-	2020.12.21	PERMIT SET
1	2021.04.20	STRUCTURAL STEEL REV
PRO.	JECT INFO	ORMATION
PRO	OJECT NO:	JPM.27135.00
DA	TE:	2020.12.2
PRO	OTOTYPE:	20.
DRAWN BY:		J.PERE
CHECKED BY:		E.SCALGION
VE	RSION:	SE_1.0
SHEET	TITLE	


STEEL FRAME **ELEVATIONS**

SHEET NUMBER

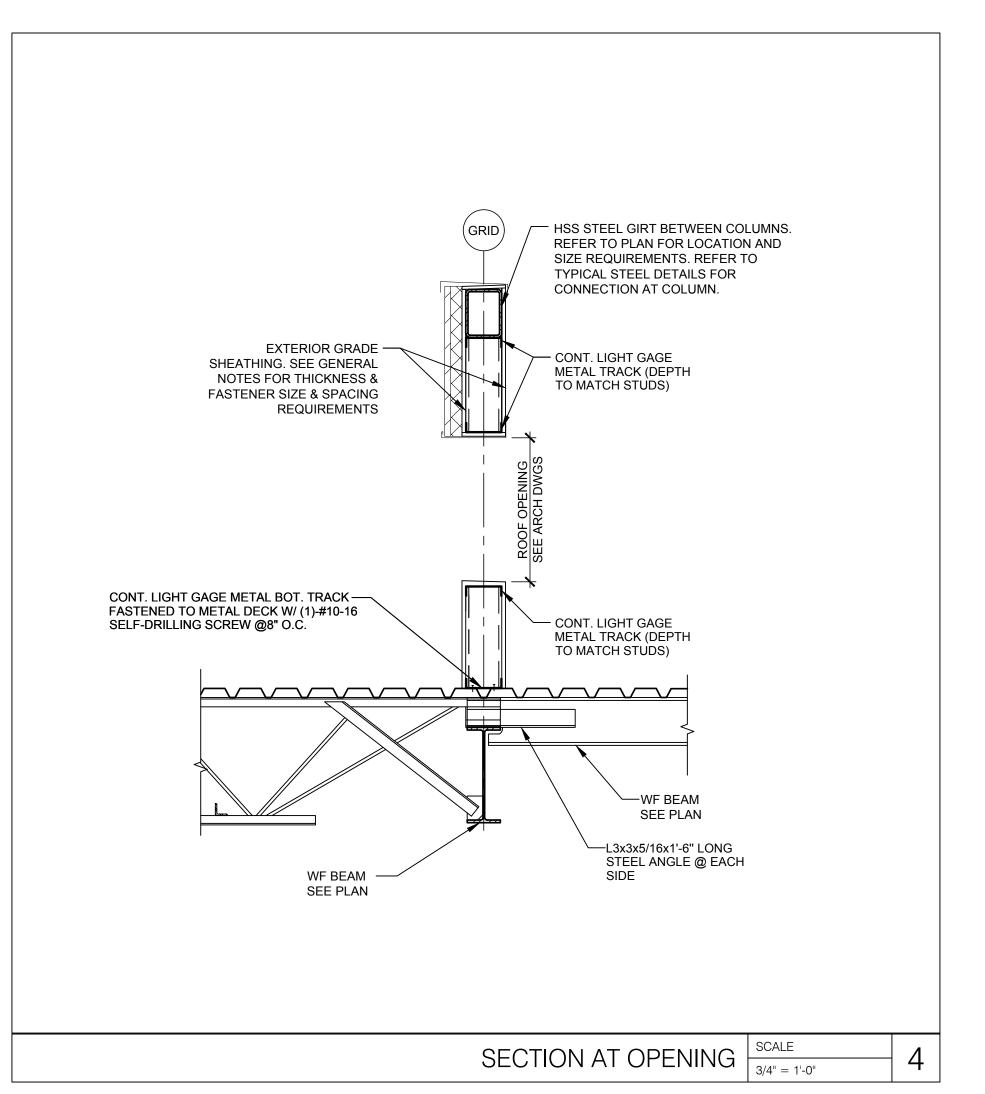

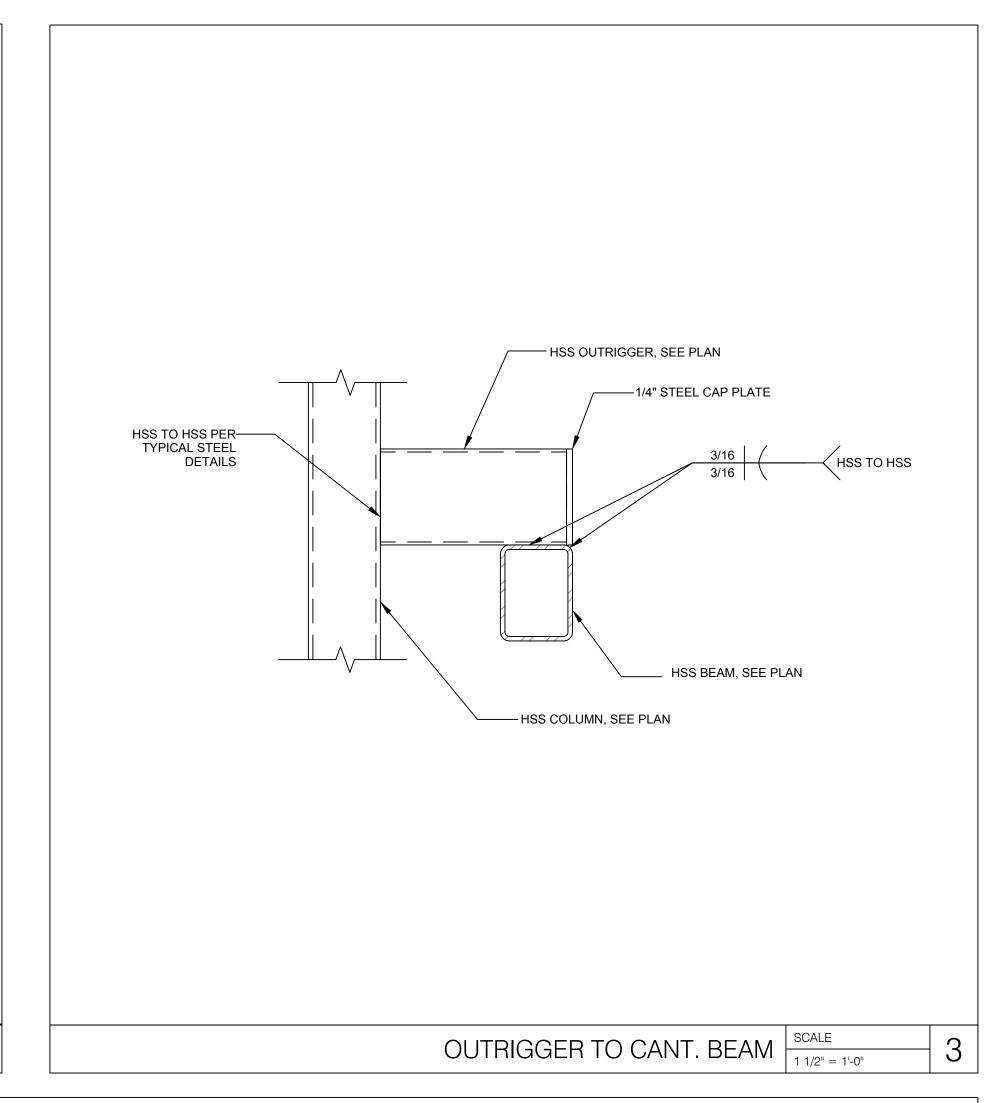

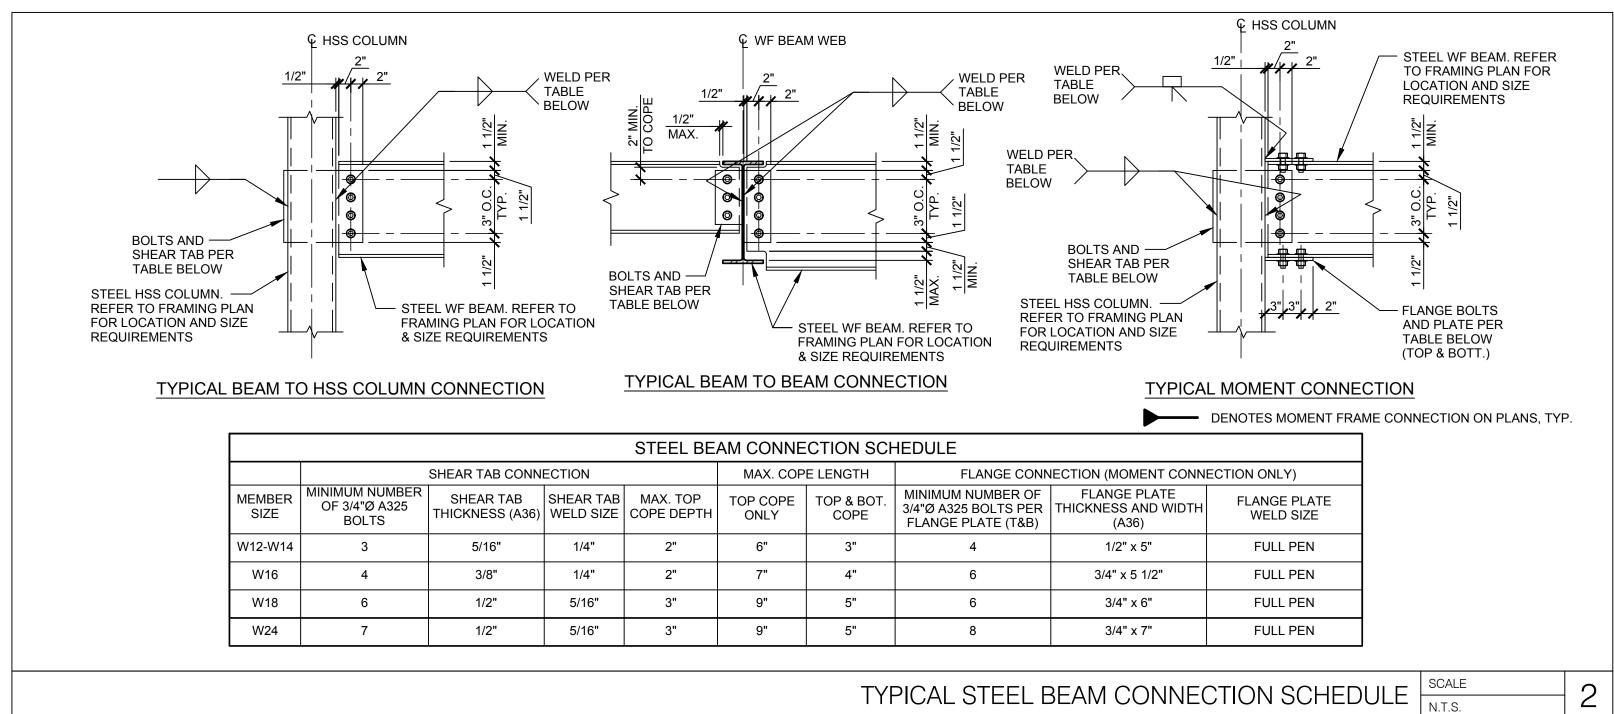

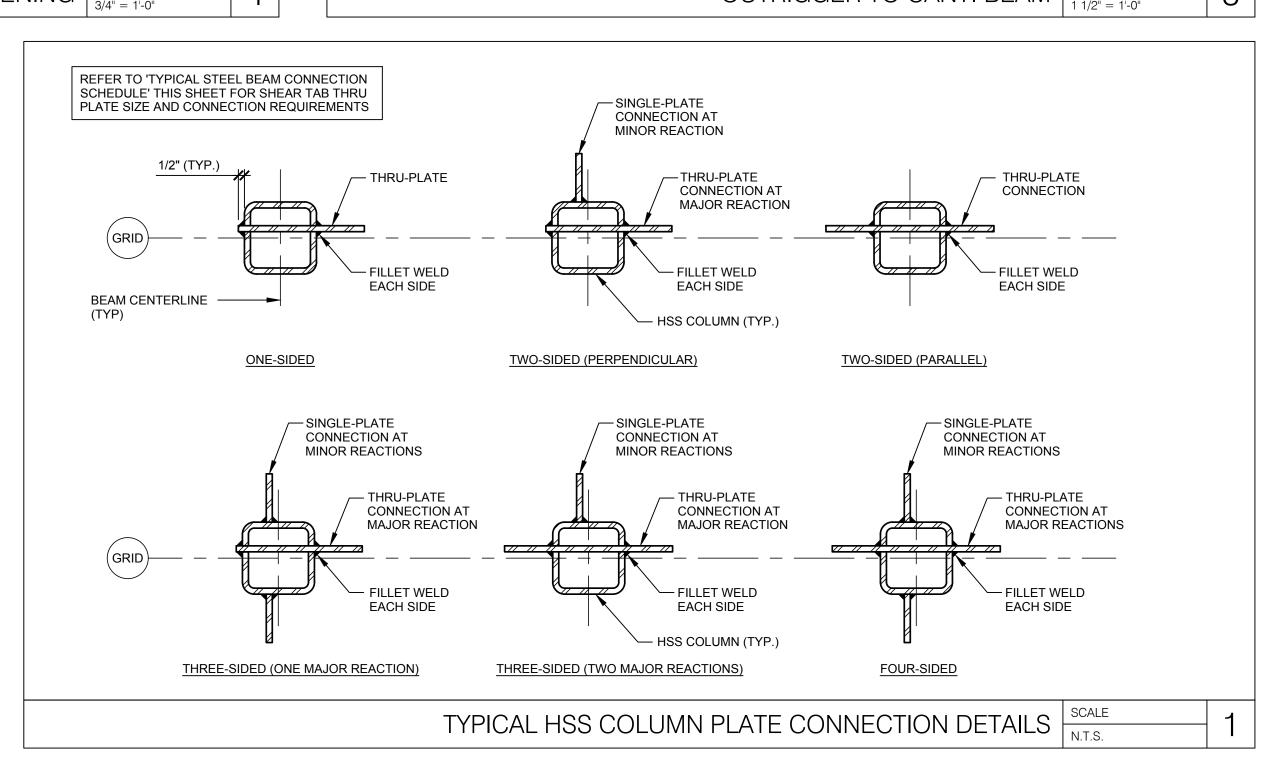




CORE STATES

GROUP

1700 Industrial Drive Suite B
Rogers, AR 72756
479,986.4400
www.core-states.com

ENGINEER OF RECORD

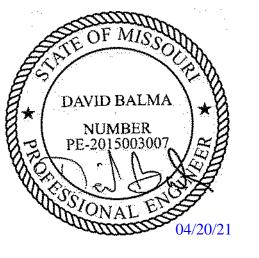

THESE DRAWINGS ARE NOT COMPLETE WITHOUT THE SEPARATE TYPE WRITTEN SPECIFICATIONS MANUAL WHICH ARE PART OF THE CONTRACT DOCUMENTS.


SSUE	DATE	DESCRIPTION	
-	2020.12.21	PERMIT SET	
24	2021.04.20	STRUCTURAL STEEL REV	
PROJECT INFORMATION			
PROJECT NO:		JPM.27135.001	
DATE:		2020.12.21	
PRO	OTOTYPE:	20.2	
DR	AWN BY:	J.PEREZ	
CHECKED BY:		F.SCALGIONE	


CONNECTION DETAILS


SHEET NUMBER


VERSION:


SHEET TITLE

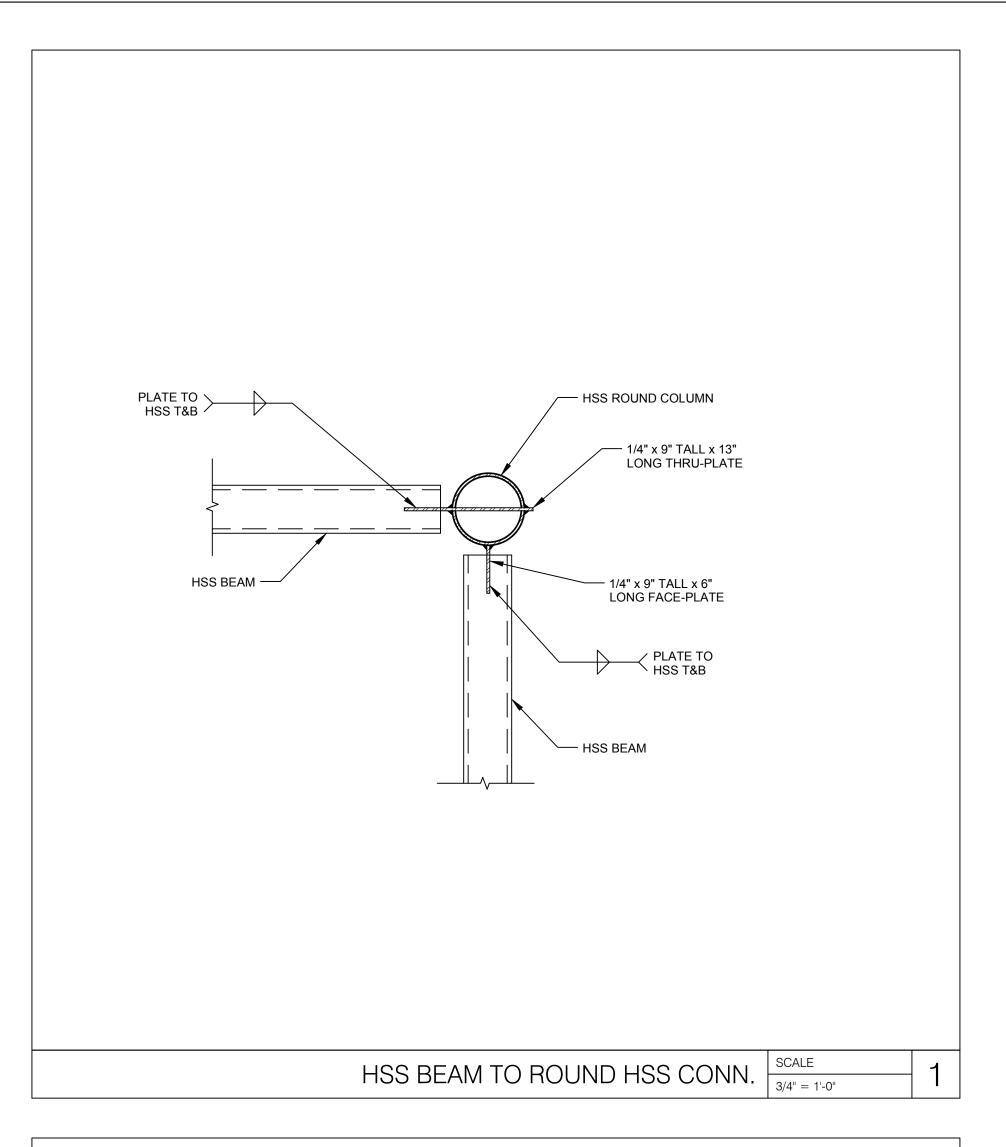


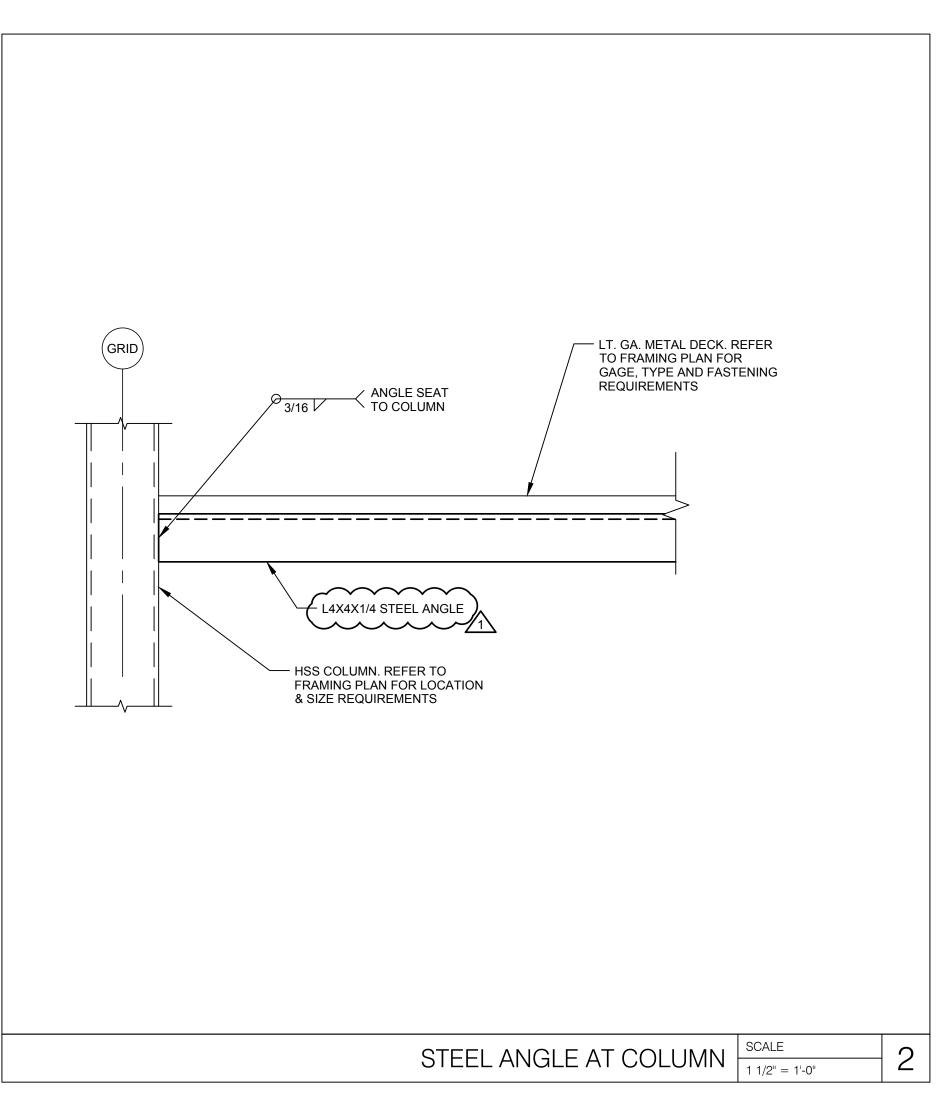

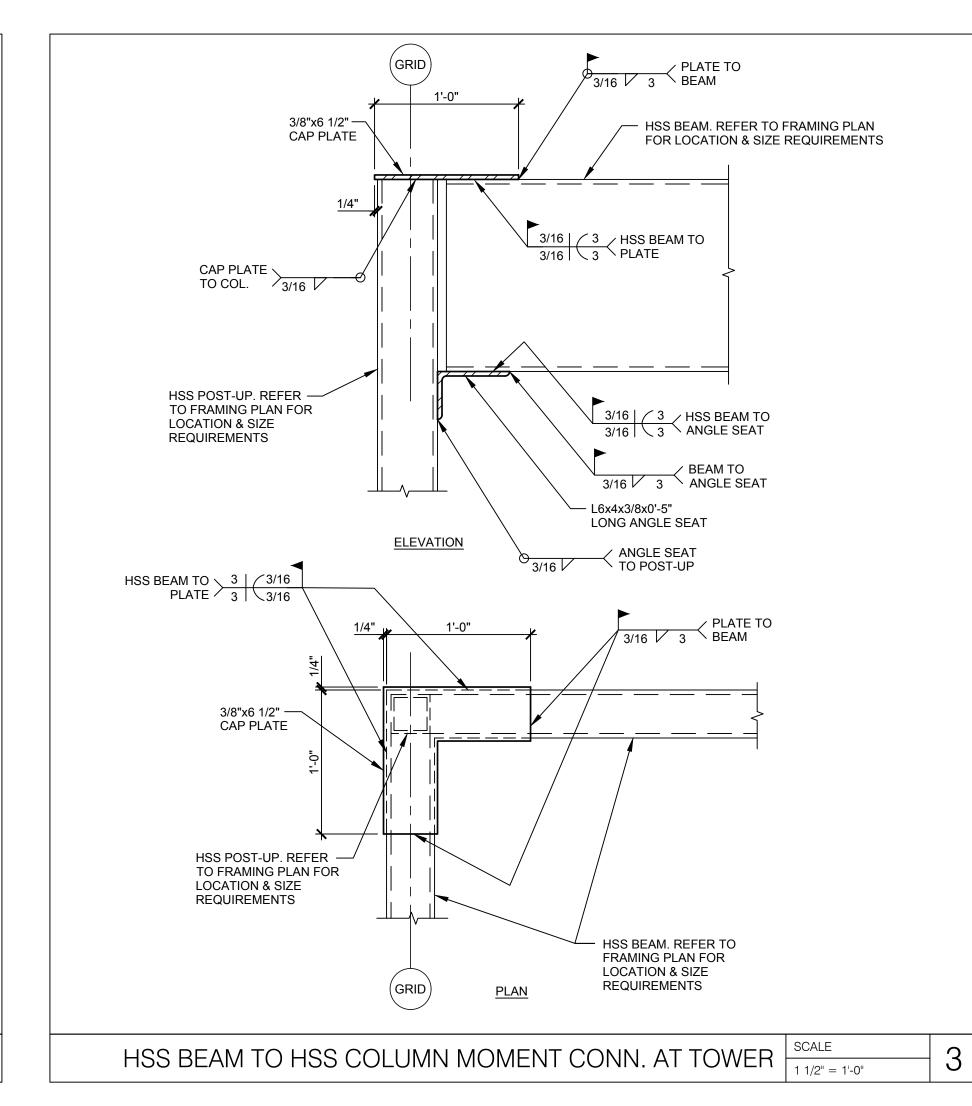

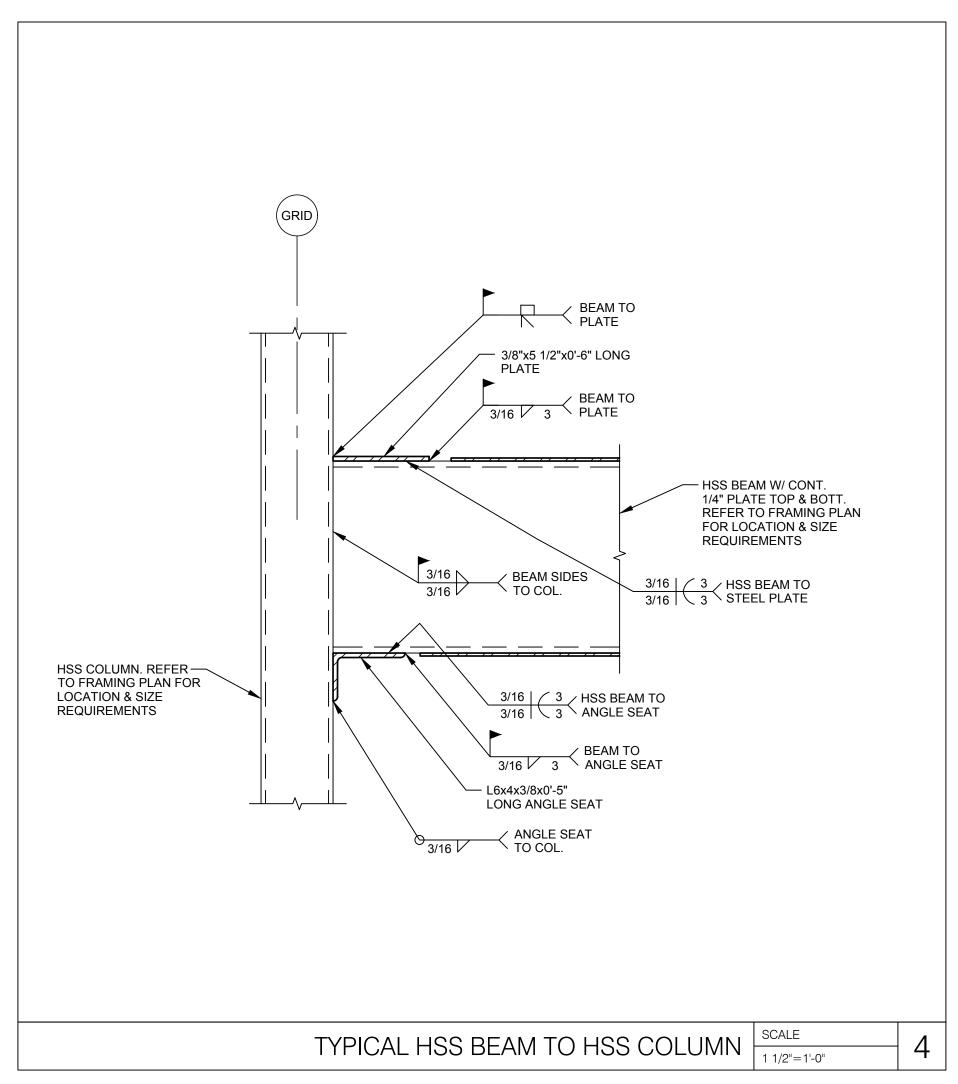

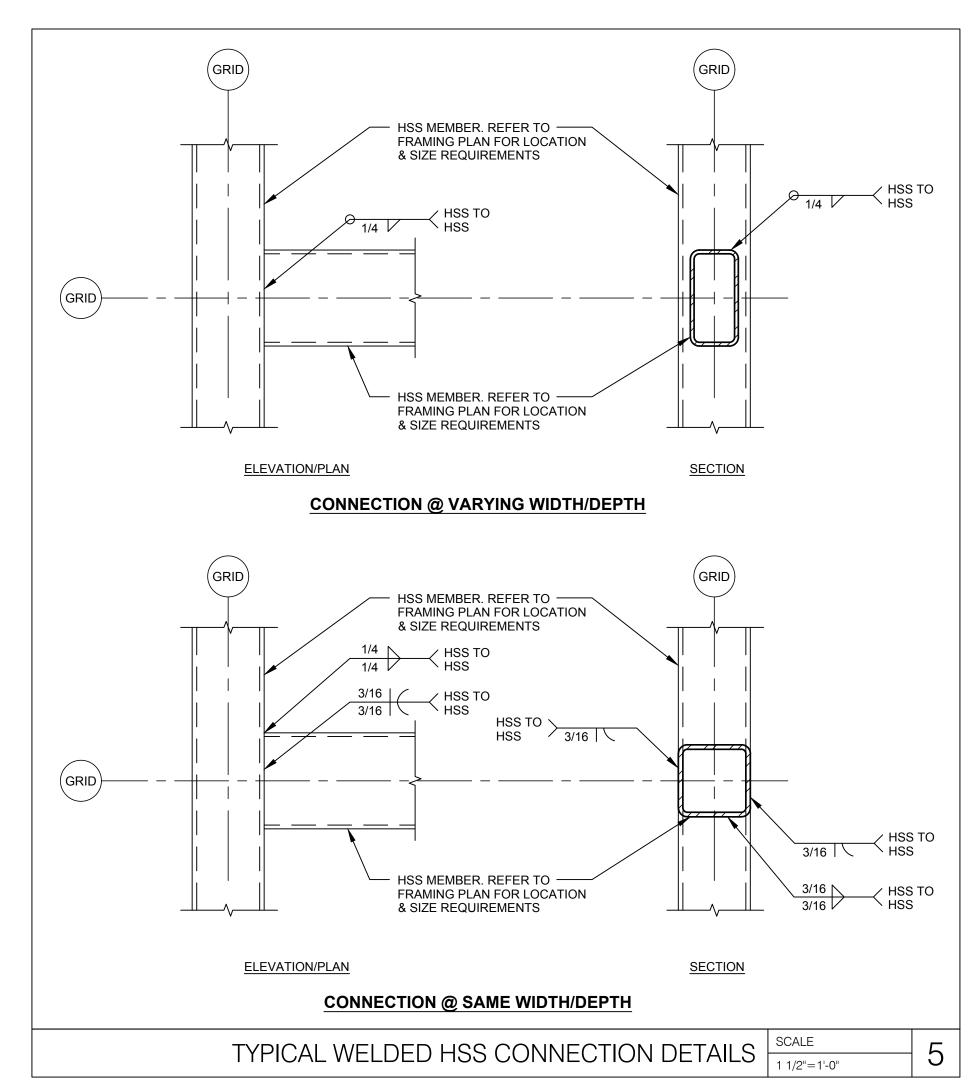

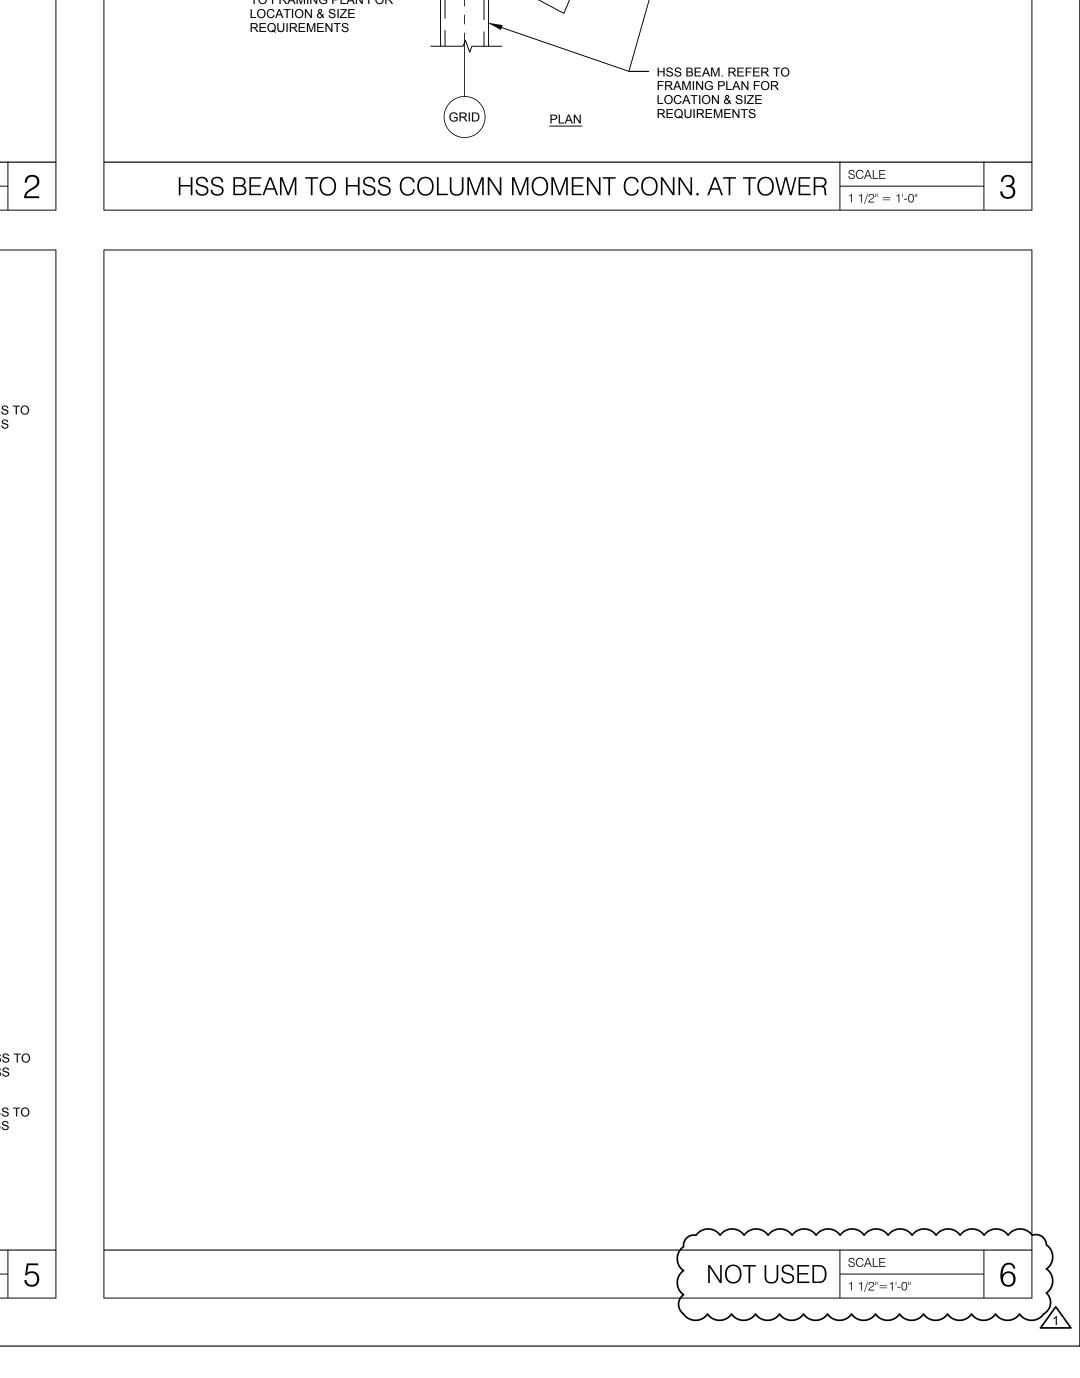



DAVID BALMA
NUMBER
PE-2015003007
PS-2015003007
04/20/21

1700 Industrial Drive Suite B Rogers, AR 72756 479.986.4400

vww.core-states.com

GROUP

THESE DRAWINGS ARE NOT COMPLETE WITHOUT THE SEPARATE TYPE WRITTEN SPECIFICATIONS MANUAL WHICH ARE PART OF THE CONTRACT DOCUMENTS.

ISSUE DATE DESCRIPTION

- 2020.12.21 PERMIT SET

1 2021.04.20 STRUCTURAL STEEL REV

PROJECT INFORMATION

PROJECT NO: JPM.27135.001

DATE: 2020.12.21

PROTOTYPE: 20.2

J.PEREZ

E.SCALGIONE


STEEL CONNECTION
DETAILS AND
SECTIONS


SHEET NUMBER


DRAWN BY:


SHEET TITLE


CHECKED BY:

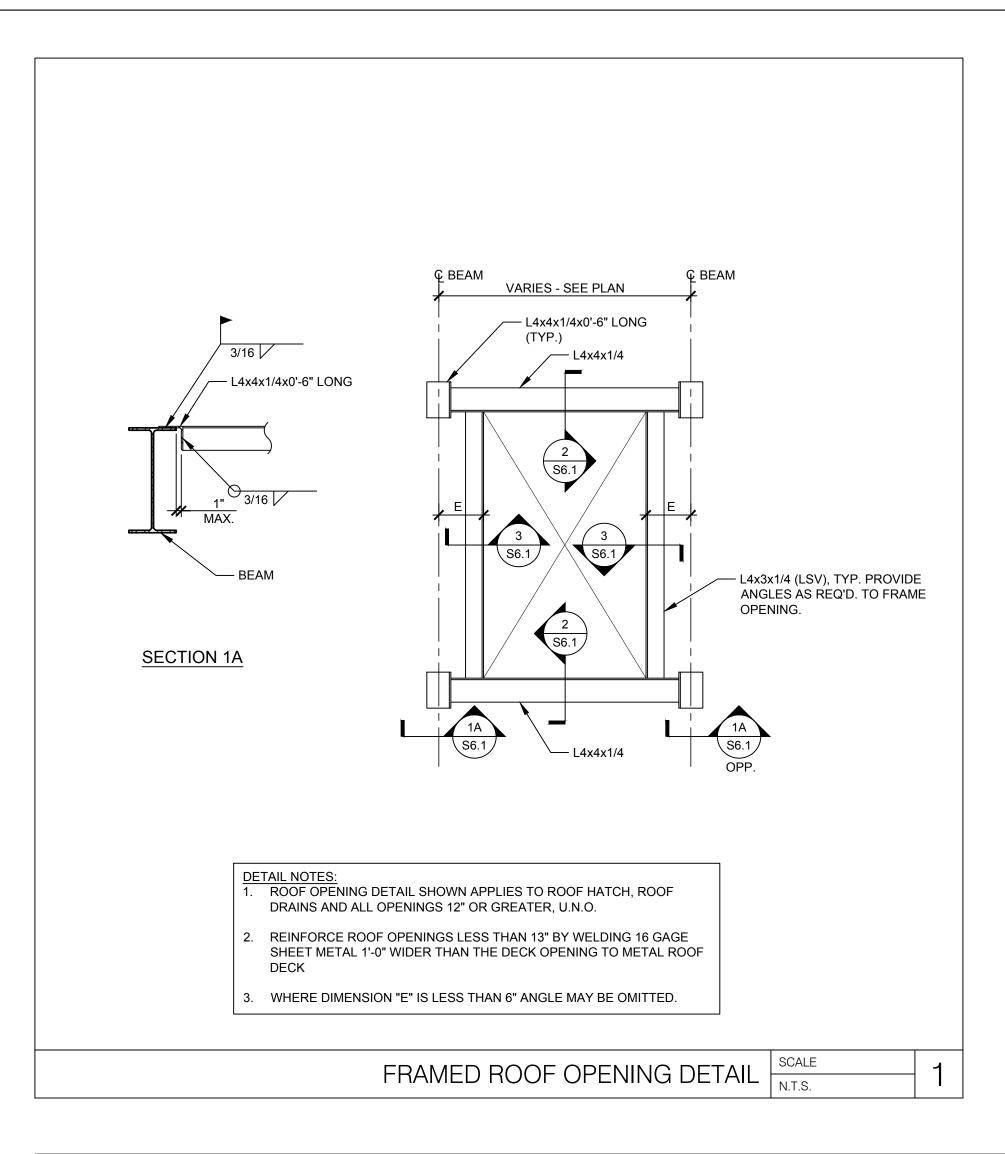


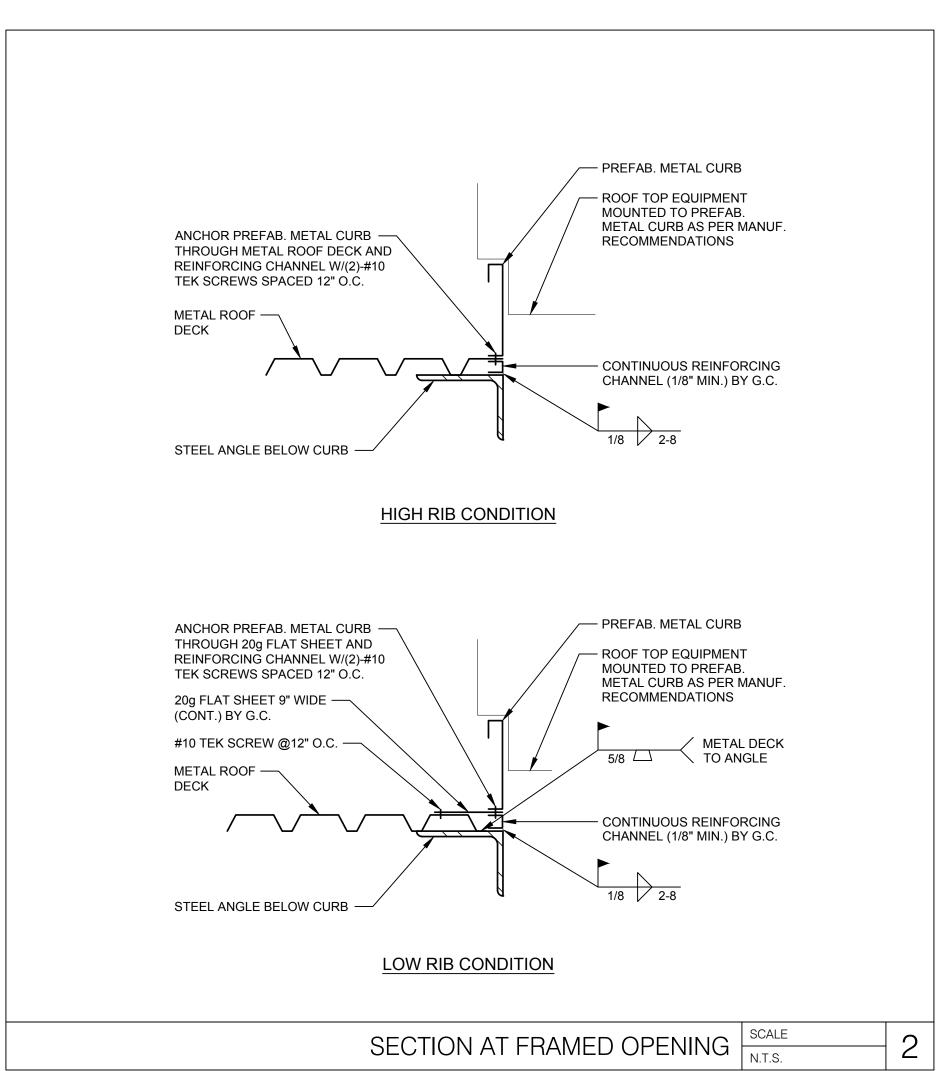


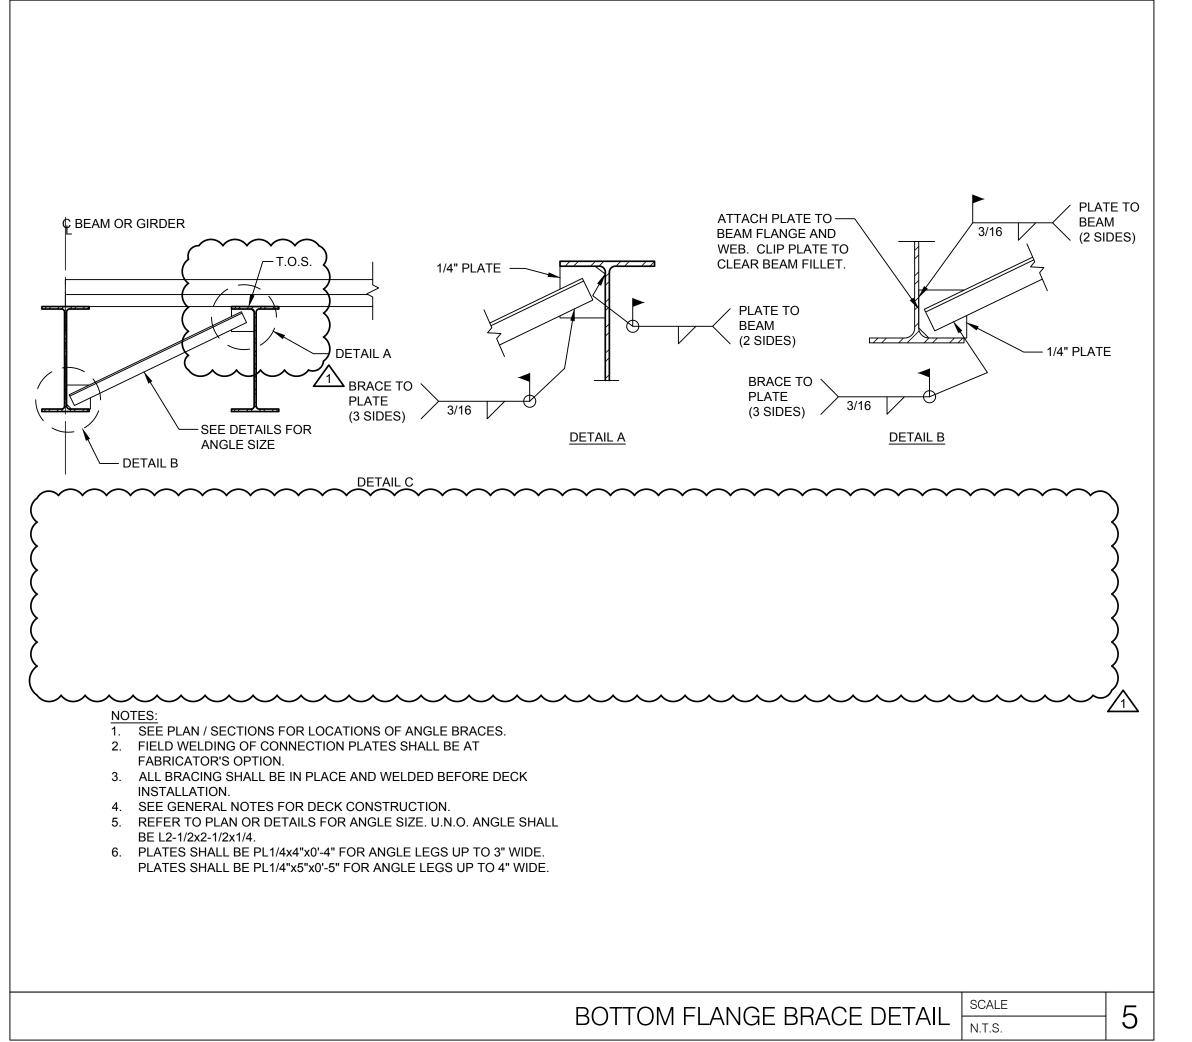

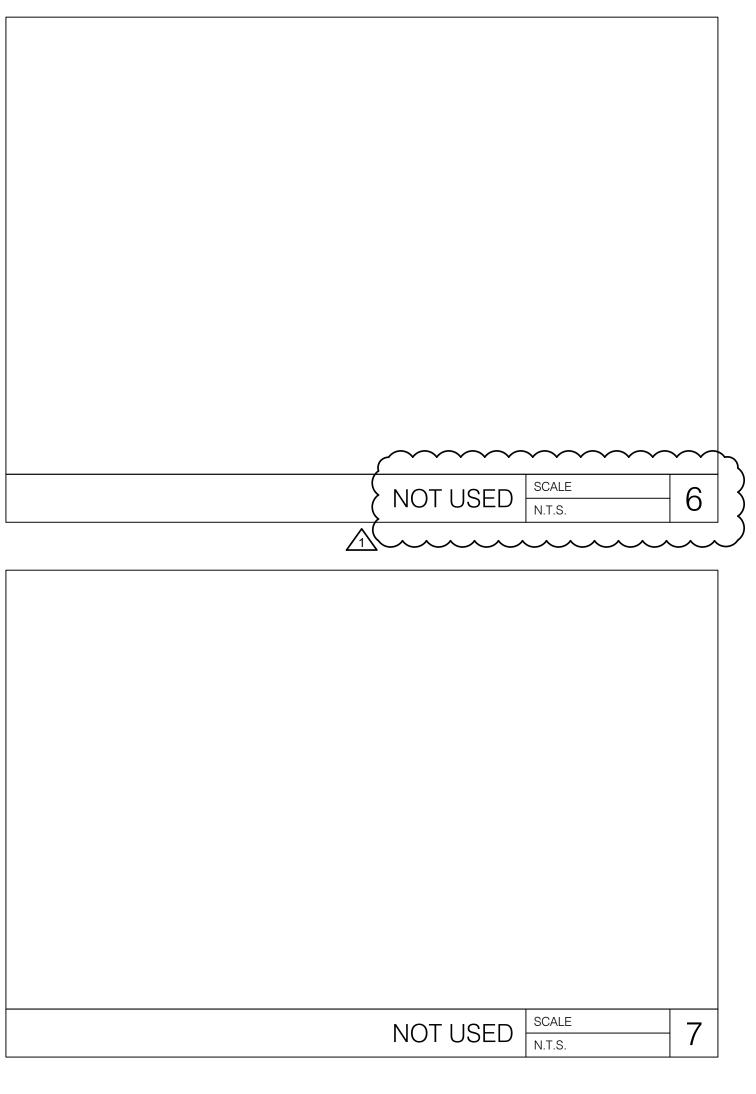


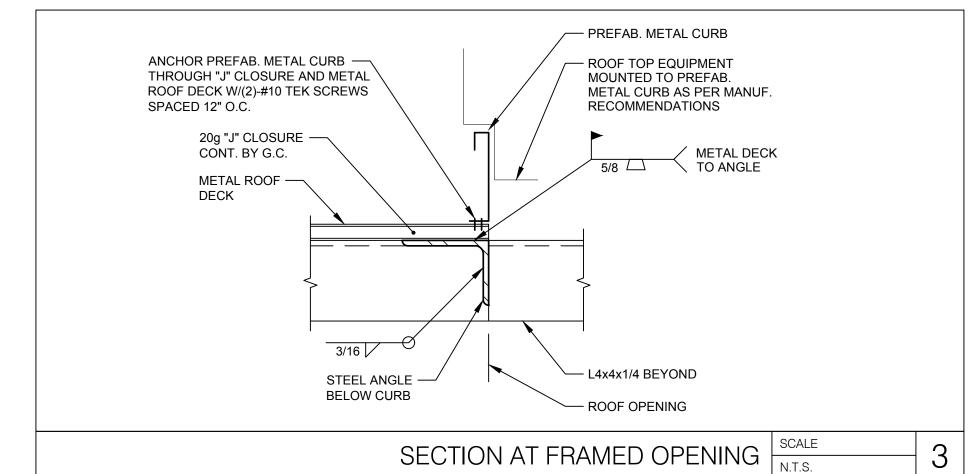

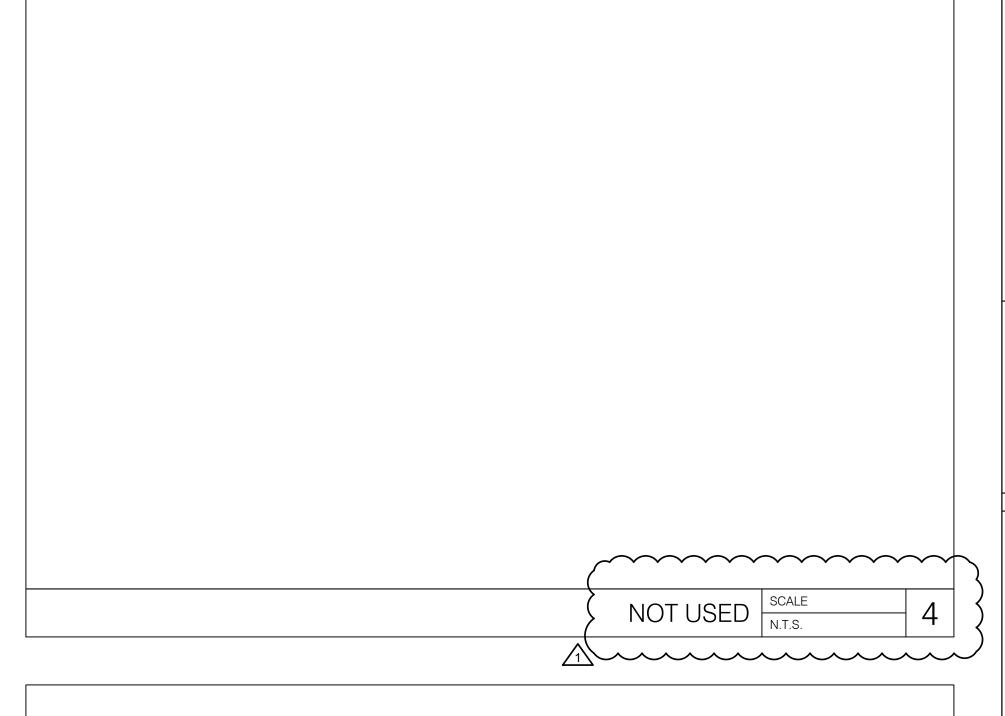

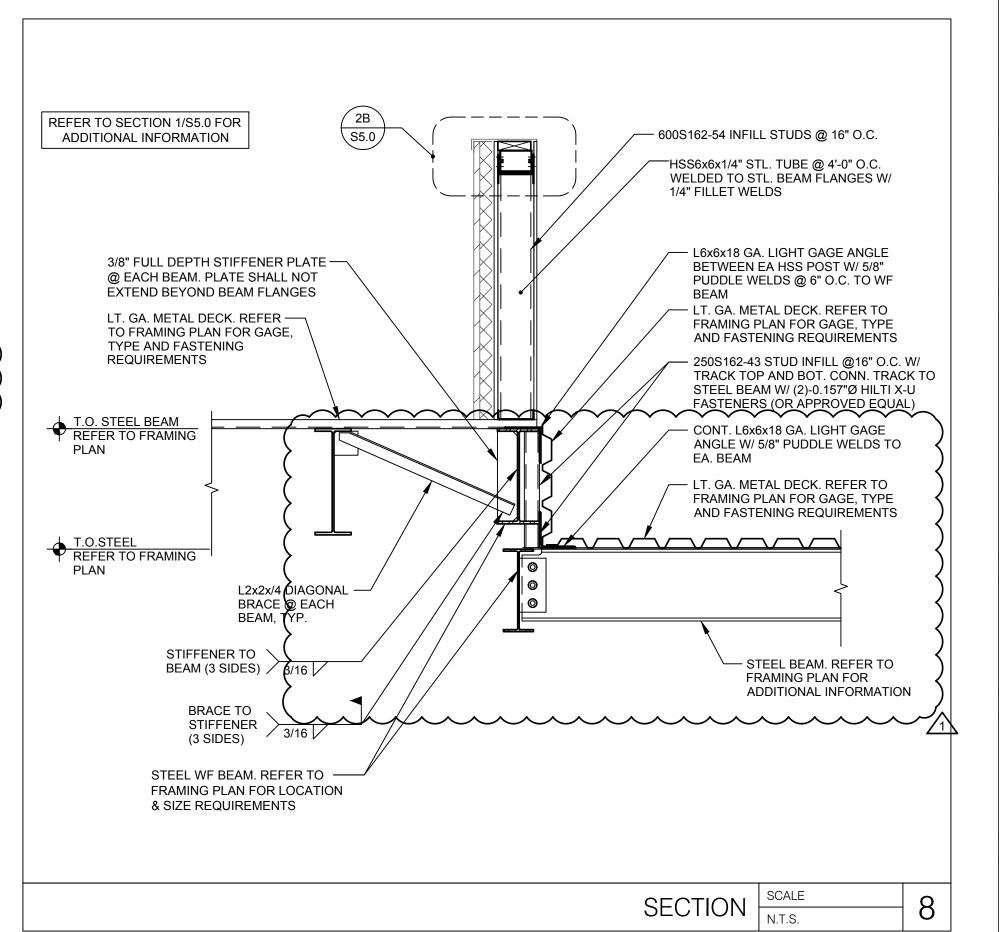



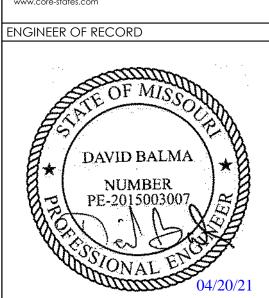

1700 Industrial Drive Suite B Rogers, AR 72756 479.986.4400 GROUP

THESE DRAWINGS ARE NOT COMPLETE WITHOUT THE SEPARATE TYPE WRITTEN SPECIFICATIONS MANUAL WHICH ARE PART OF THE CONTRACT DOCUMENTS.

ISSUE	DATE	DESCRIPTION
-	2020.12.21	PERMIT SET
}	2021.04.20	STRUCTURAL STEEL REV
PRO.	JECT INFO	ORMATION
PRO	DJECT NO:	JPM.27135.001
DA	TE:	2020.12.21
PRO	OTOTYPE:	20.2

TYPICAL STEEL DETAILS

J.PEREZ

E.SCALGIONE


SHEET NUMBER


DRAWN BY:


VERSION:


SHEET TITLE


CHECKED BY:

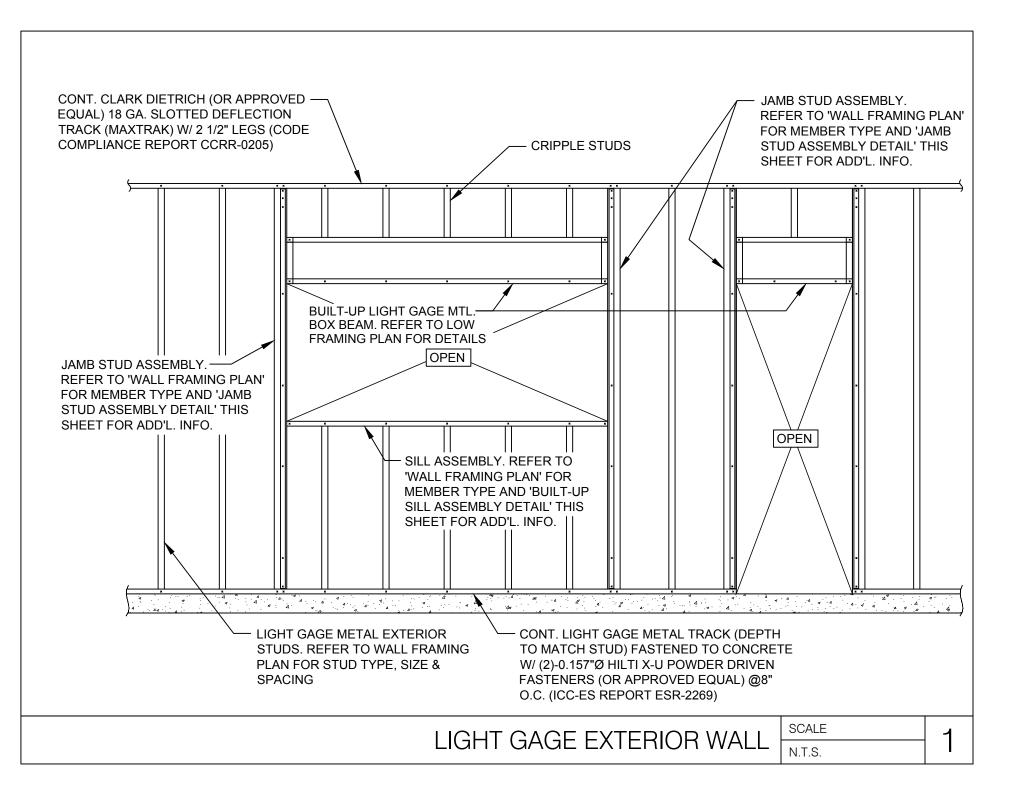


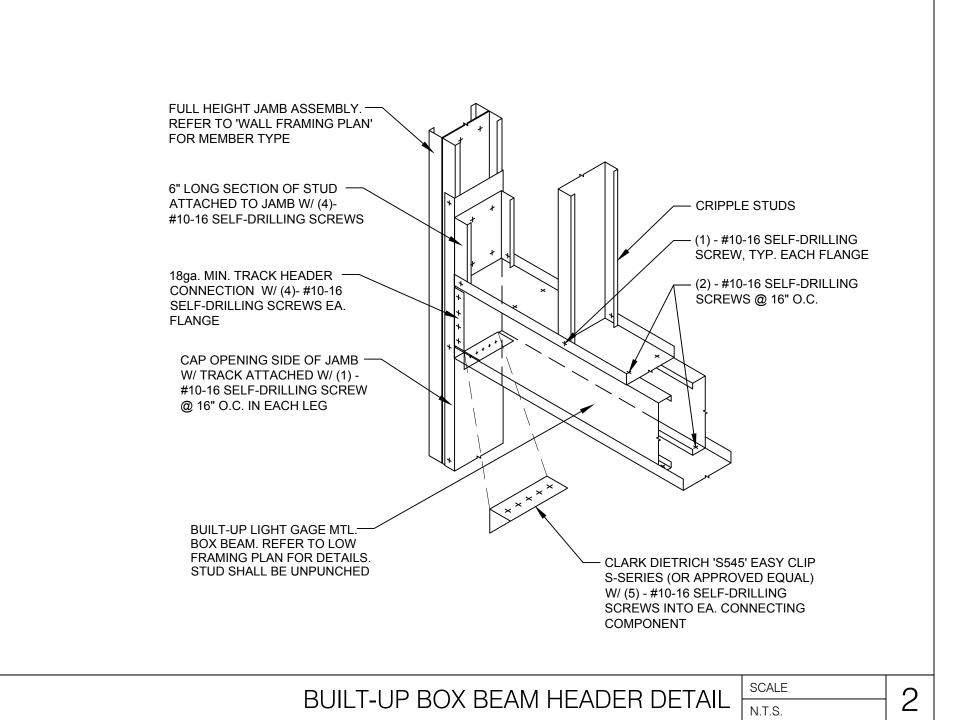


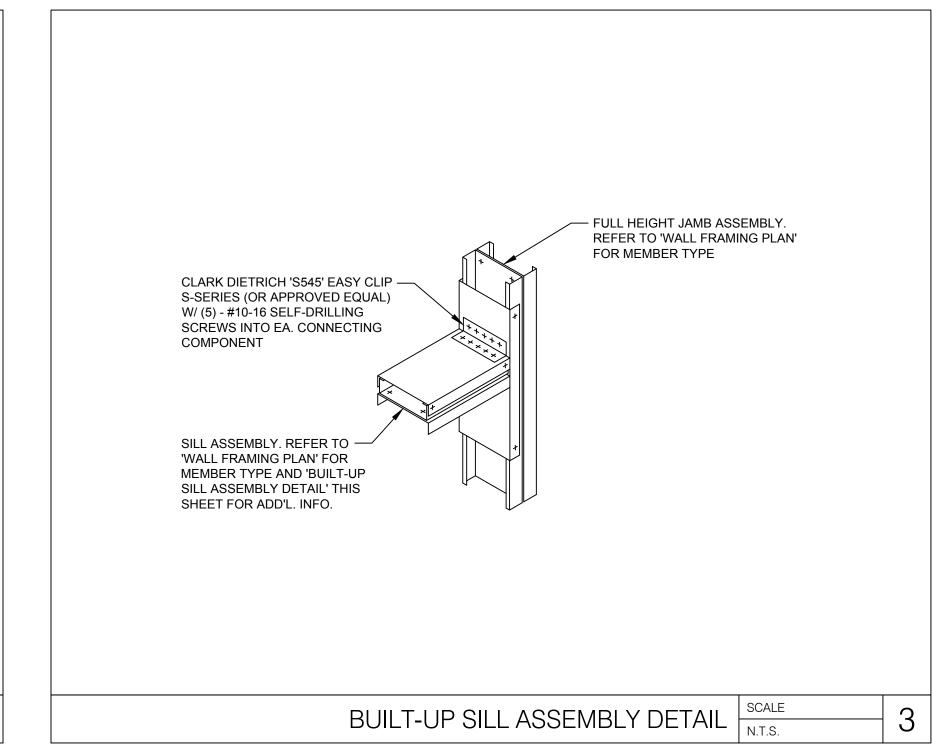


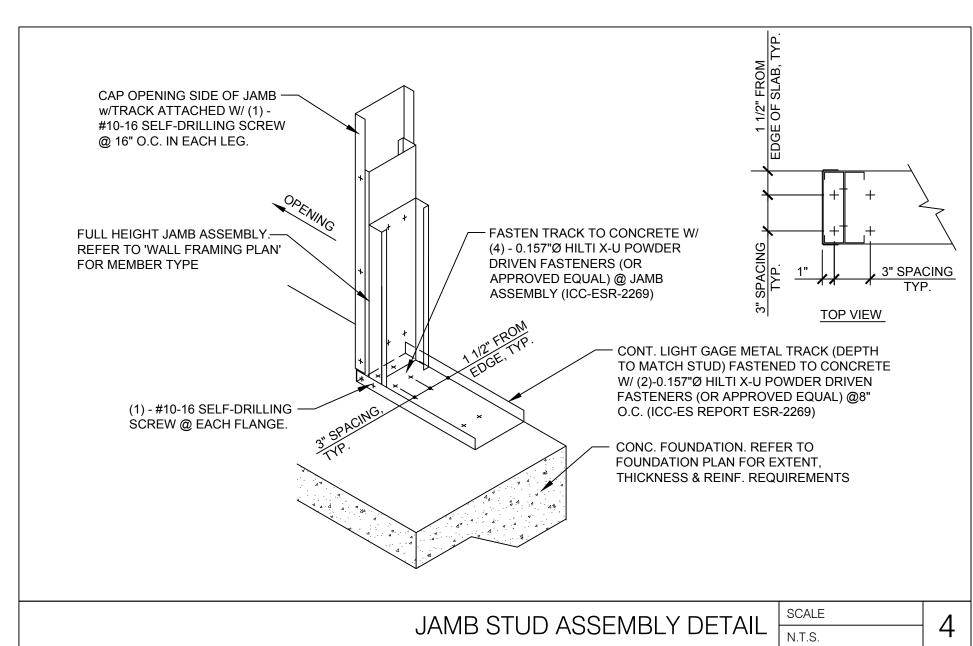


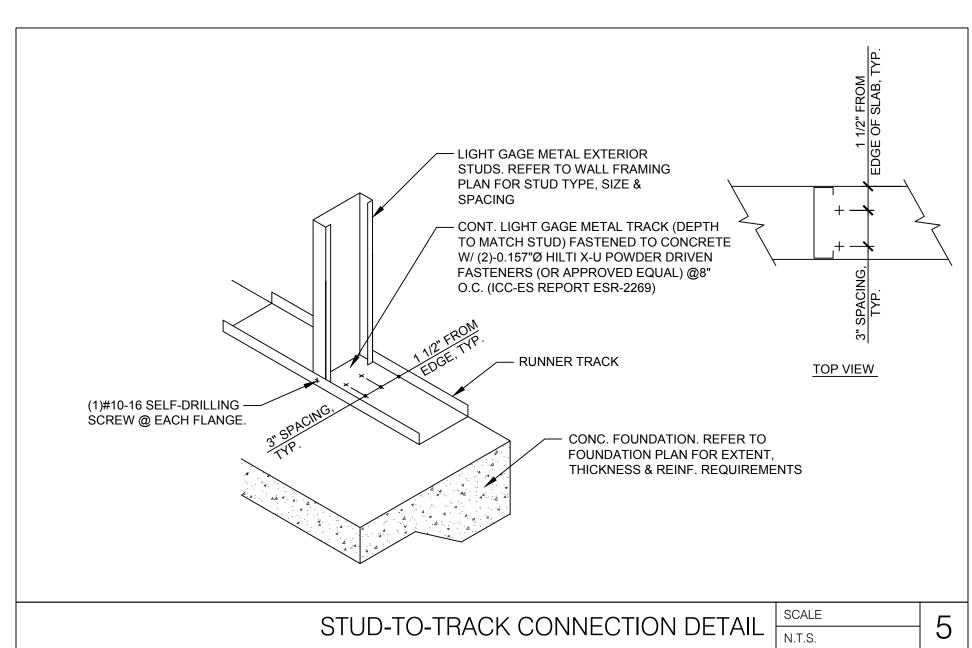

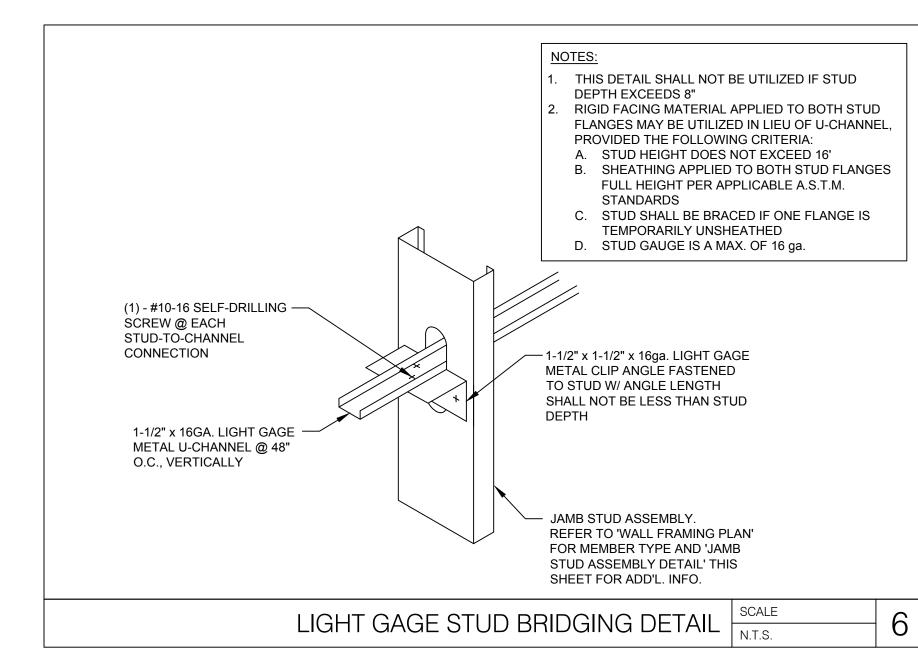


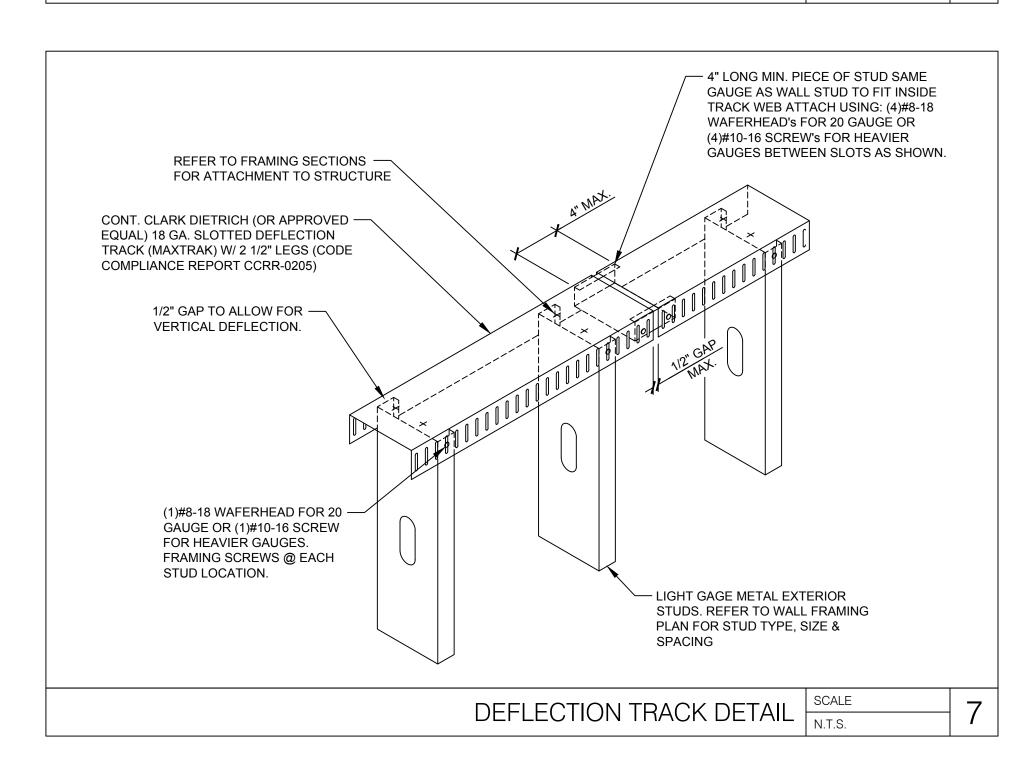

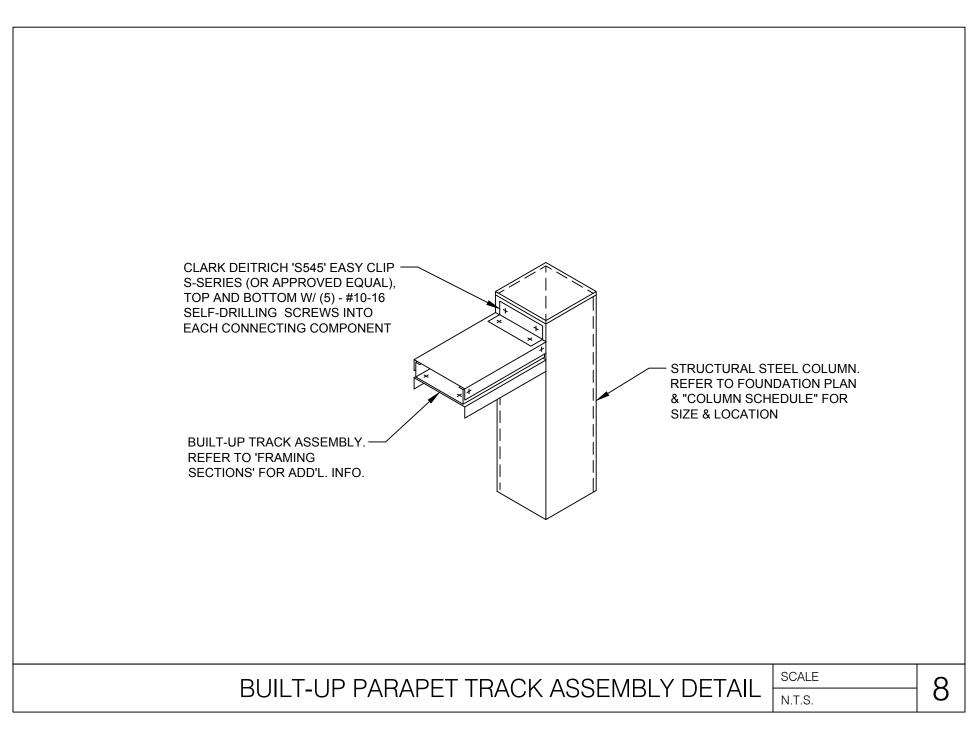

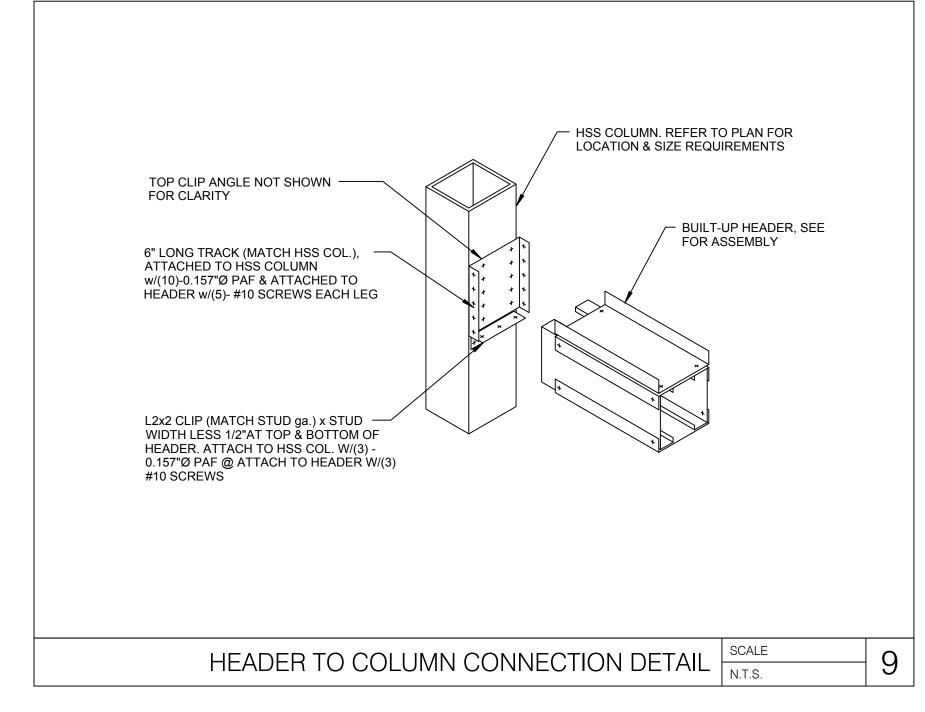



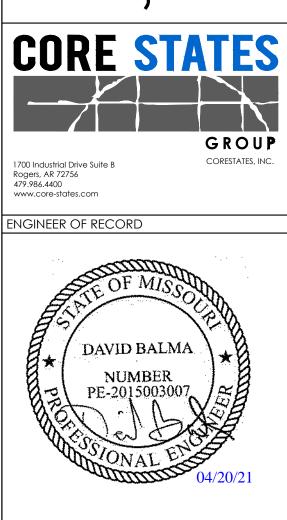

HESE DRAWINGS ARE NOT COMPLETE WITHOUT THE SEPARATE TYPE WRITTEN SPECIFICATIONS MANUAL


WHICH ARE PART OF THE CONTRACT DOCUMENTS.


ISSUE	DATE	DESCRIPTION
-	2020.12.21	PERMIT SET
}	2021.04.20	STRUCTURAL STEEL REV
PRO.	JECT INFO	ORMATION
PROJECT NO:		JPM.27135.001
DATE:		2020.12.21
PROTOTYPE: DRAWN BY:		20.2
		J.PEREZ
СН	ECKED BY:	E.SCALGIONE
VERSION:		SE_1.00


TYPICAL LIGHT GAGE DETAILS


SHEET NUMBER

SHEET TITLE

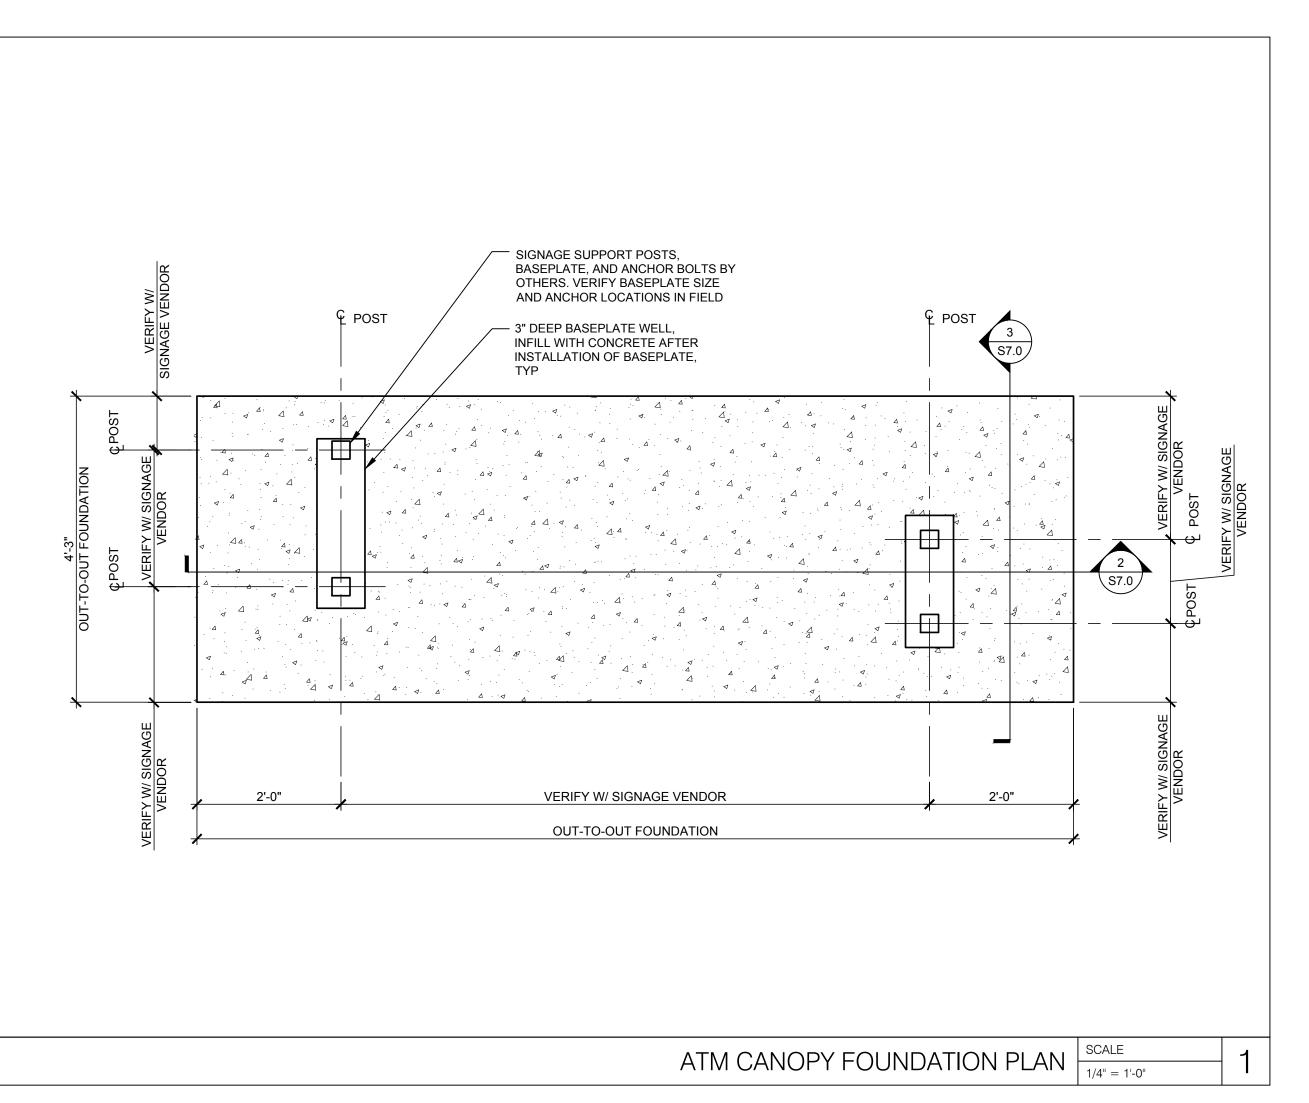


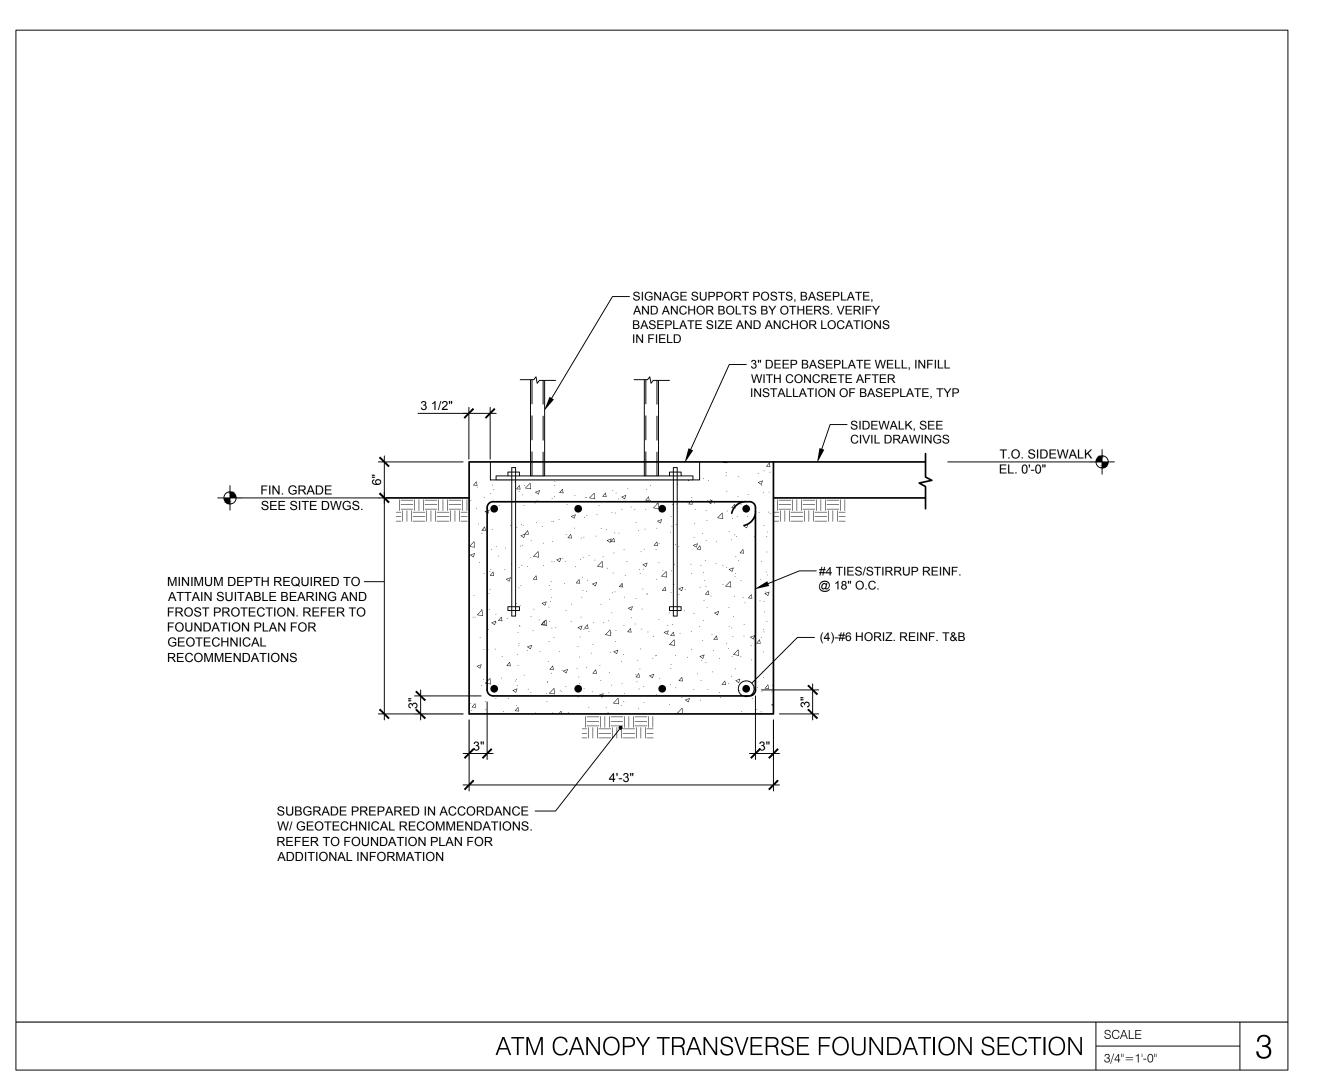

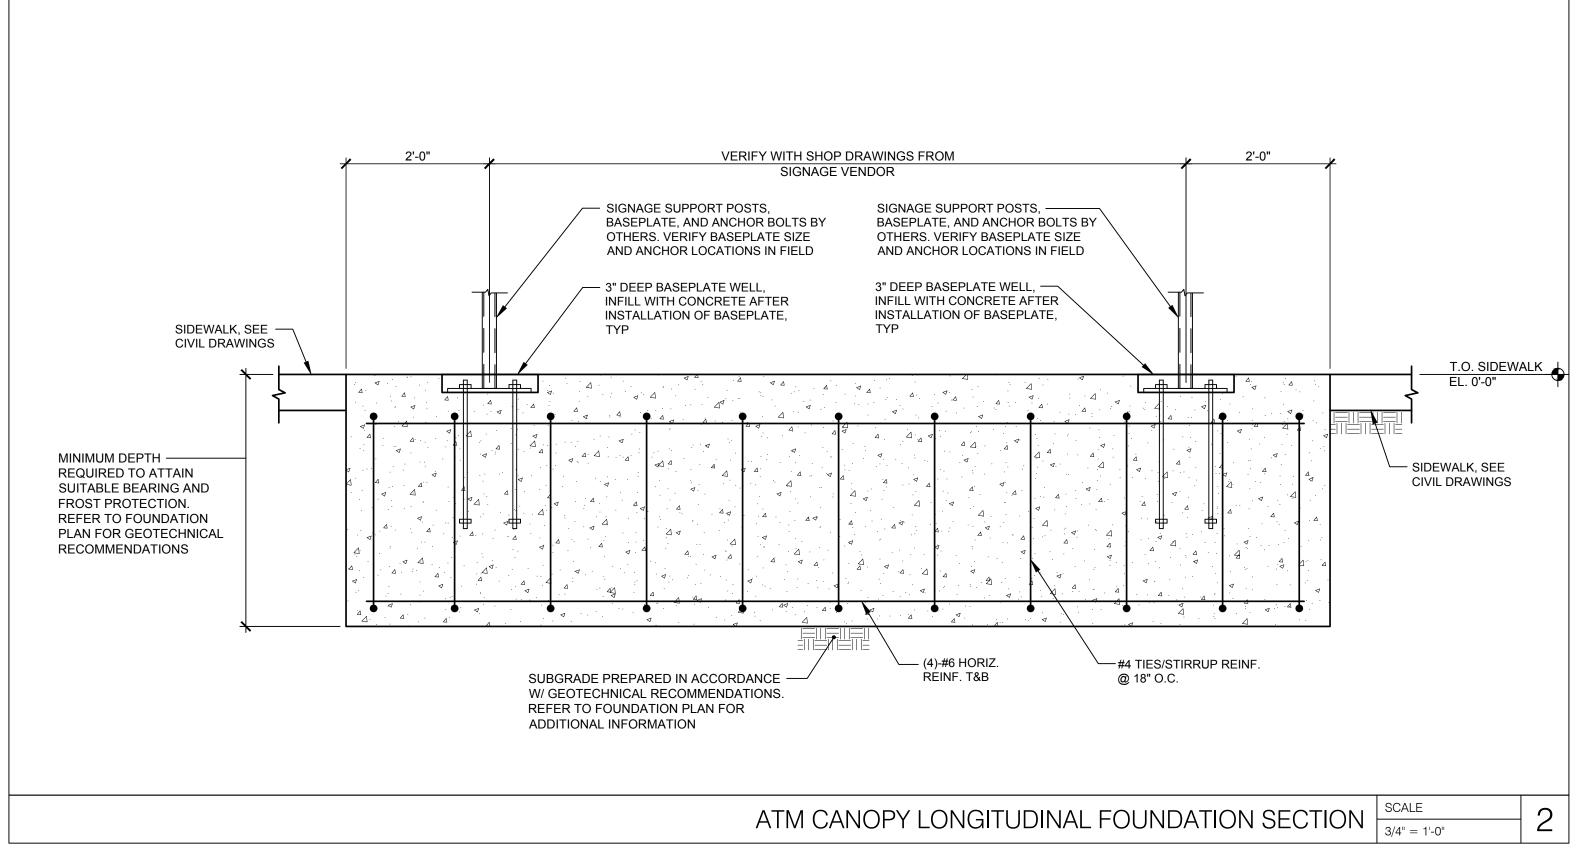

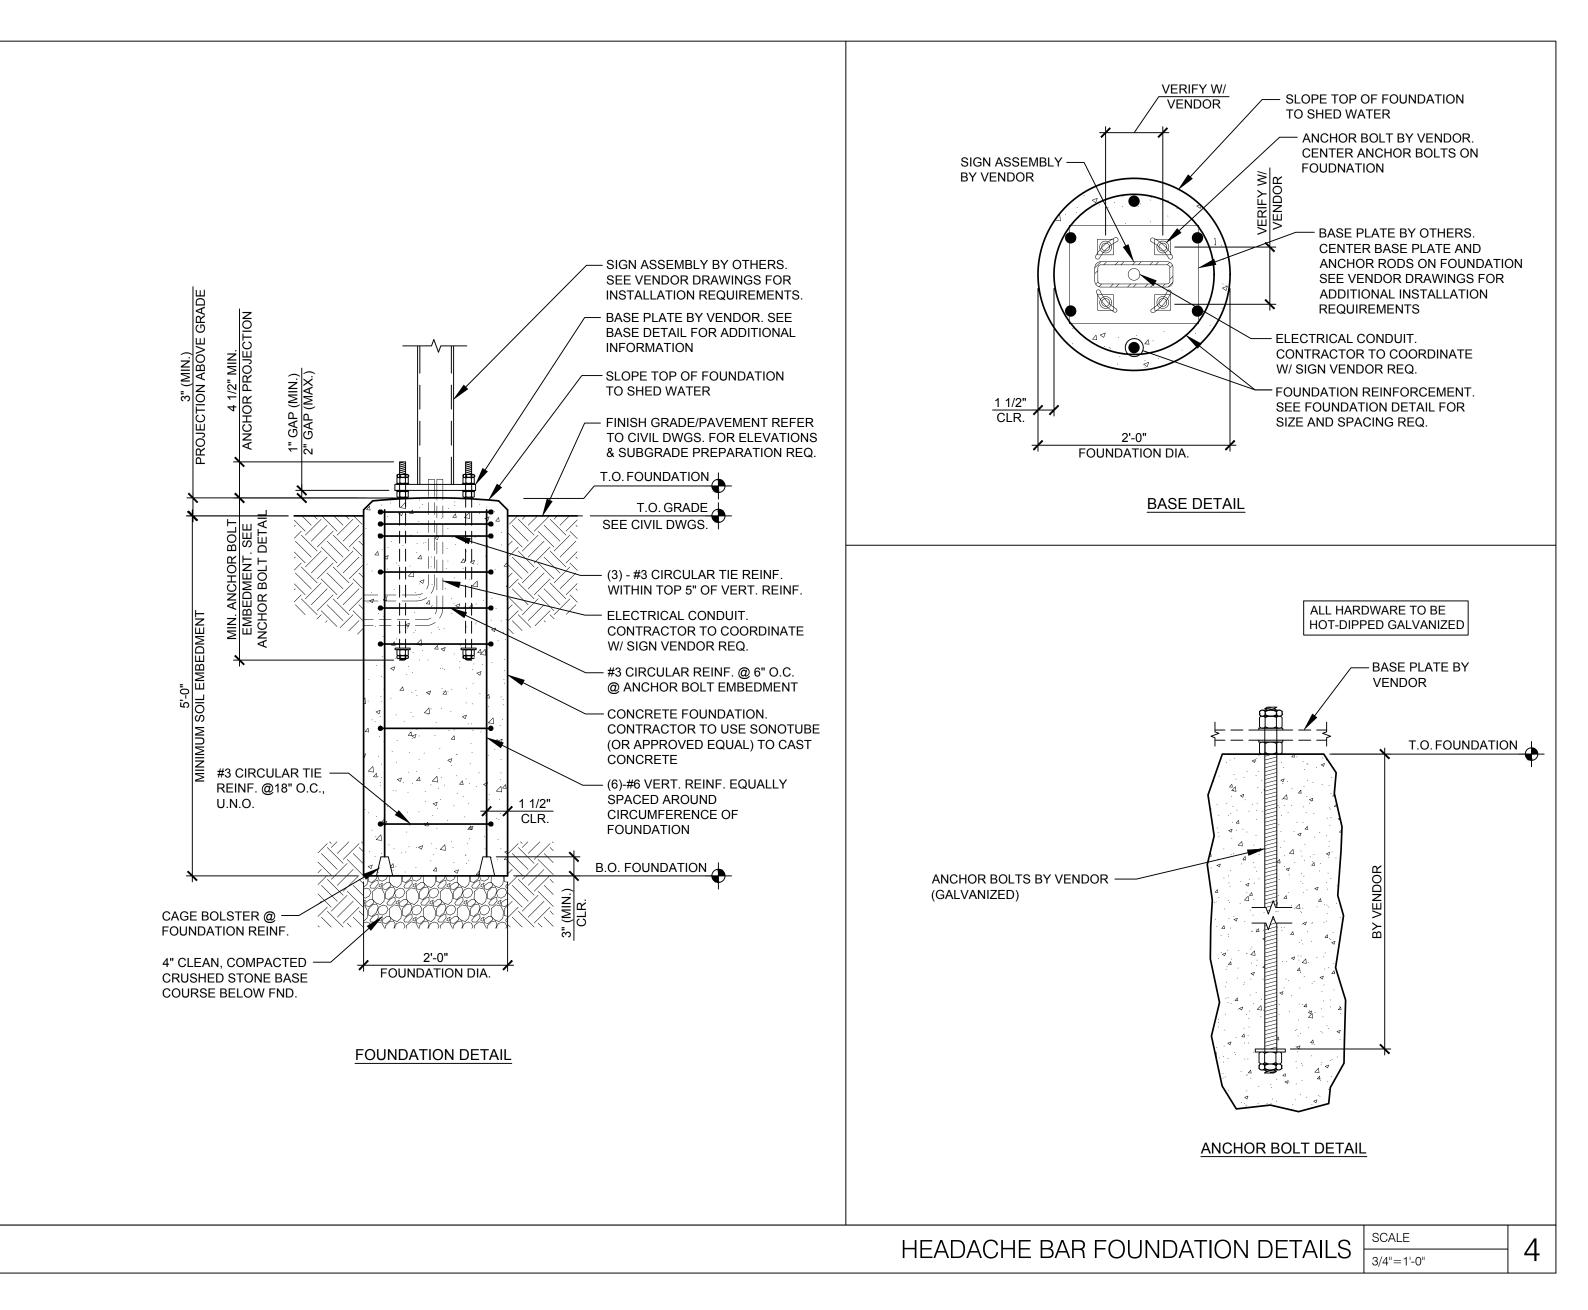



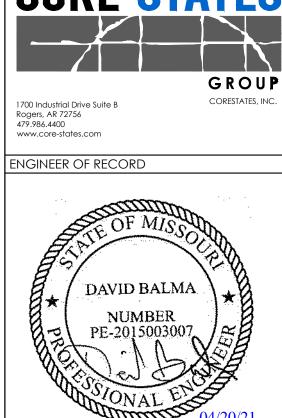

THESE DRAWINGS ARE NOT COMPLETE WITHOUT THE SEPARATE TYPE WRITTEN SPECIFICATIONS MANUAL WHICH ARE PART OF THE CONTRACT DOCUMENTS.

ISSUE DATE DESCRIPTION

-	2020.12.21	PERMIT SET		
1	2021.04.20	STRUCTURAL STEEL REV		
PROJECT INFORMATION				
PROJECT NO:		JPM.27135.001		
DATE:		2020.12.21		
PROTOTYPE:		20.2		
DR	AWN BY:	J.PEREZ		
СН	ECKED BY:	E.SCALGIONE		

CANOPY FOUNDATION PLAN & DETAILS


SE_1.00


SHEET NUMBER


VERSION:


SHEET TITLE

S7.0

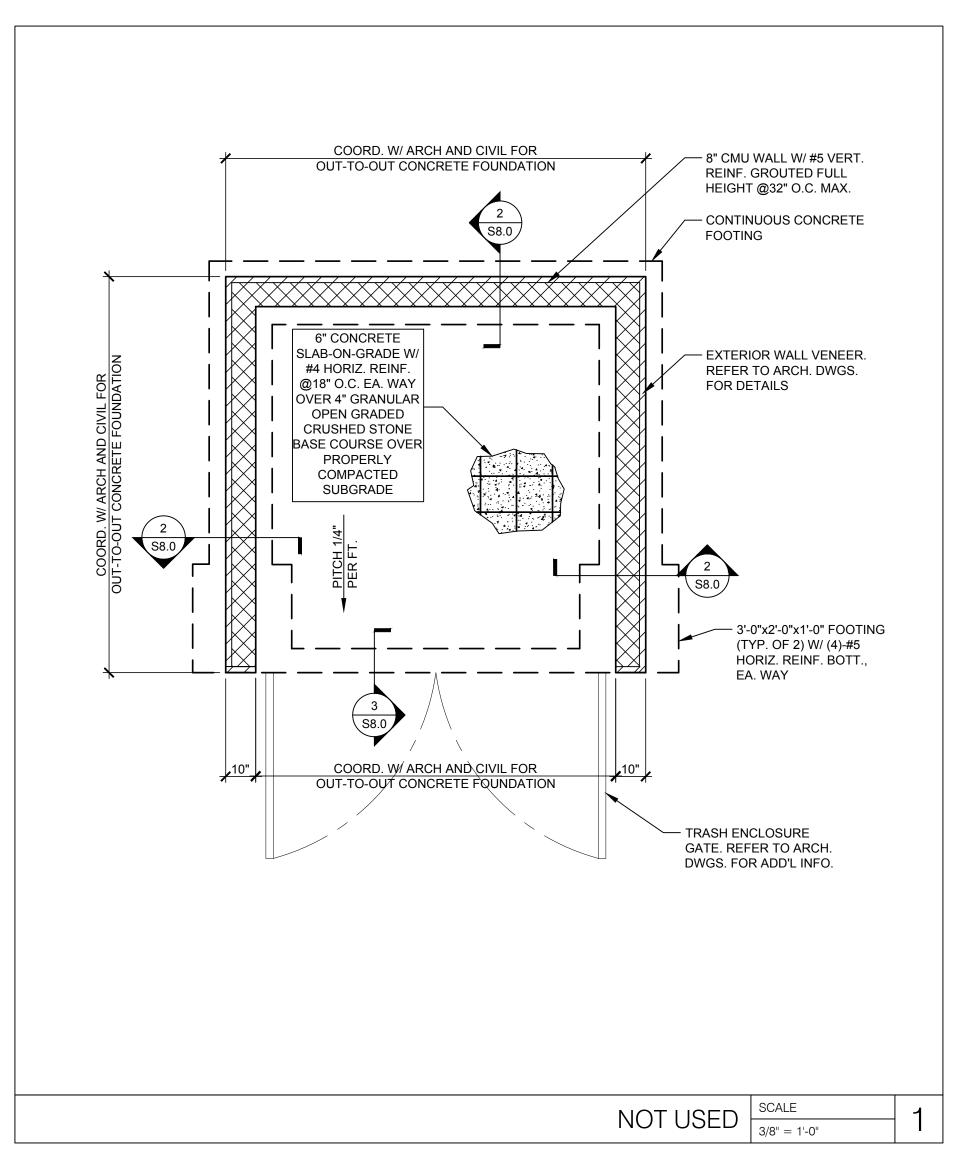


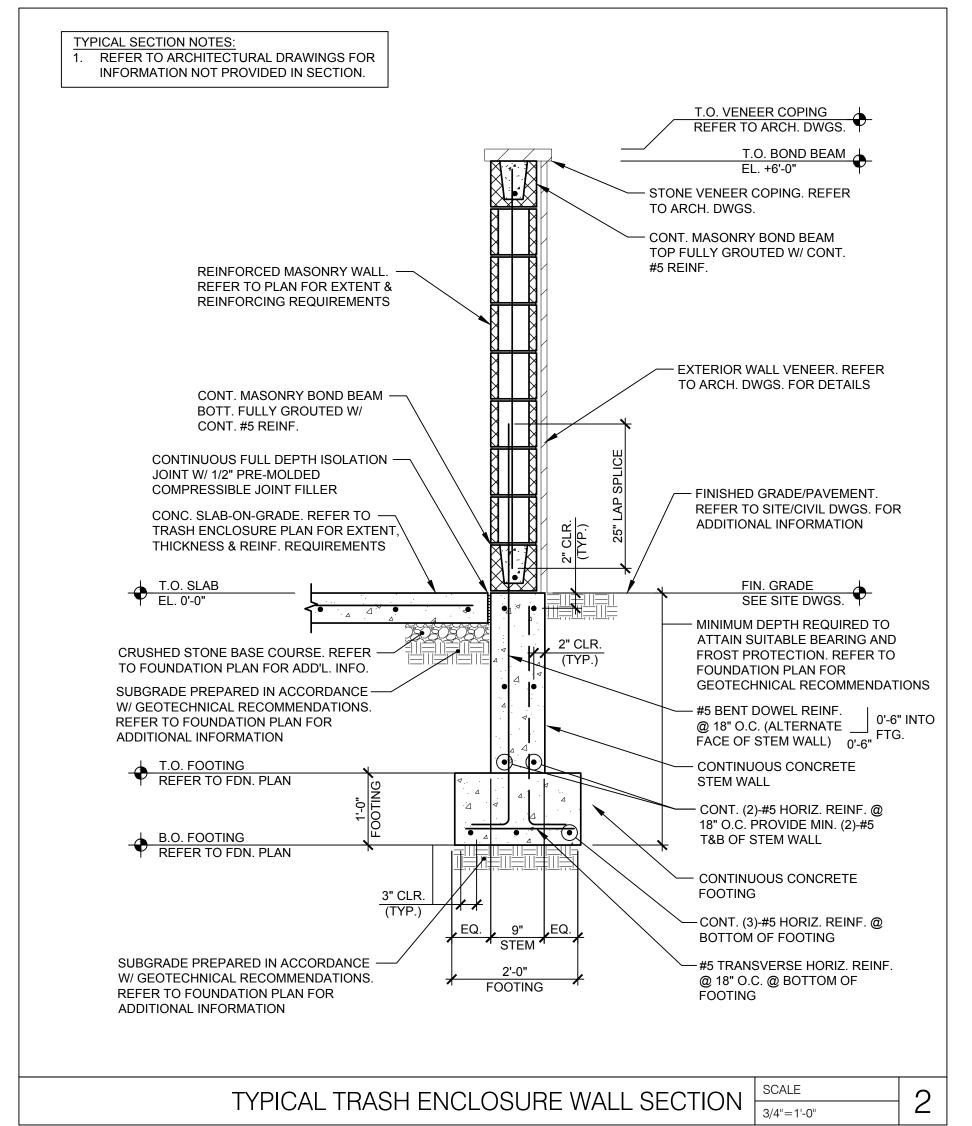

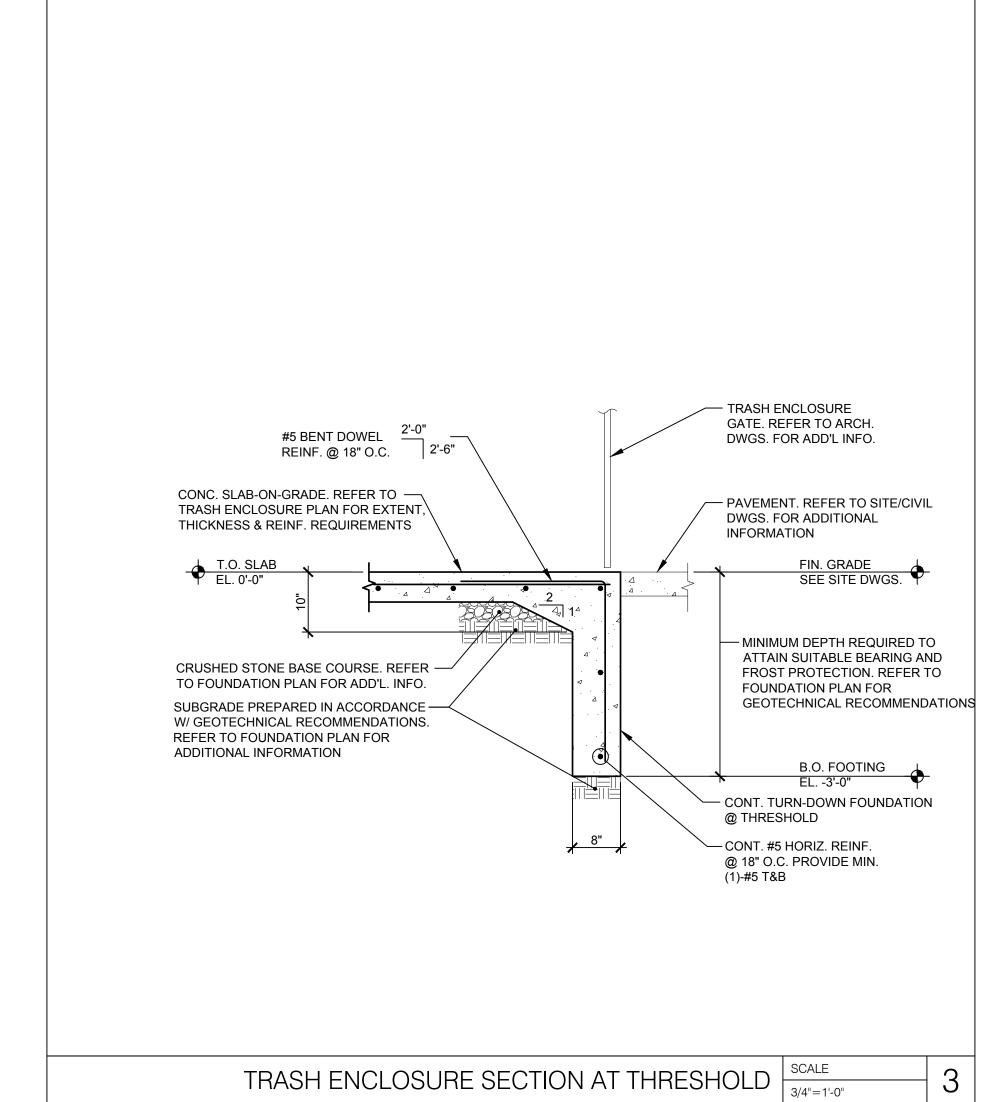

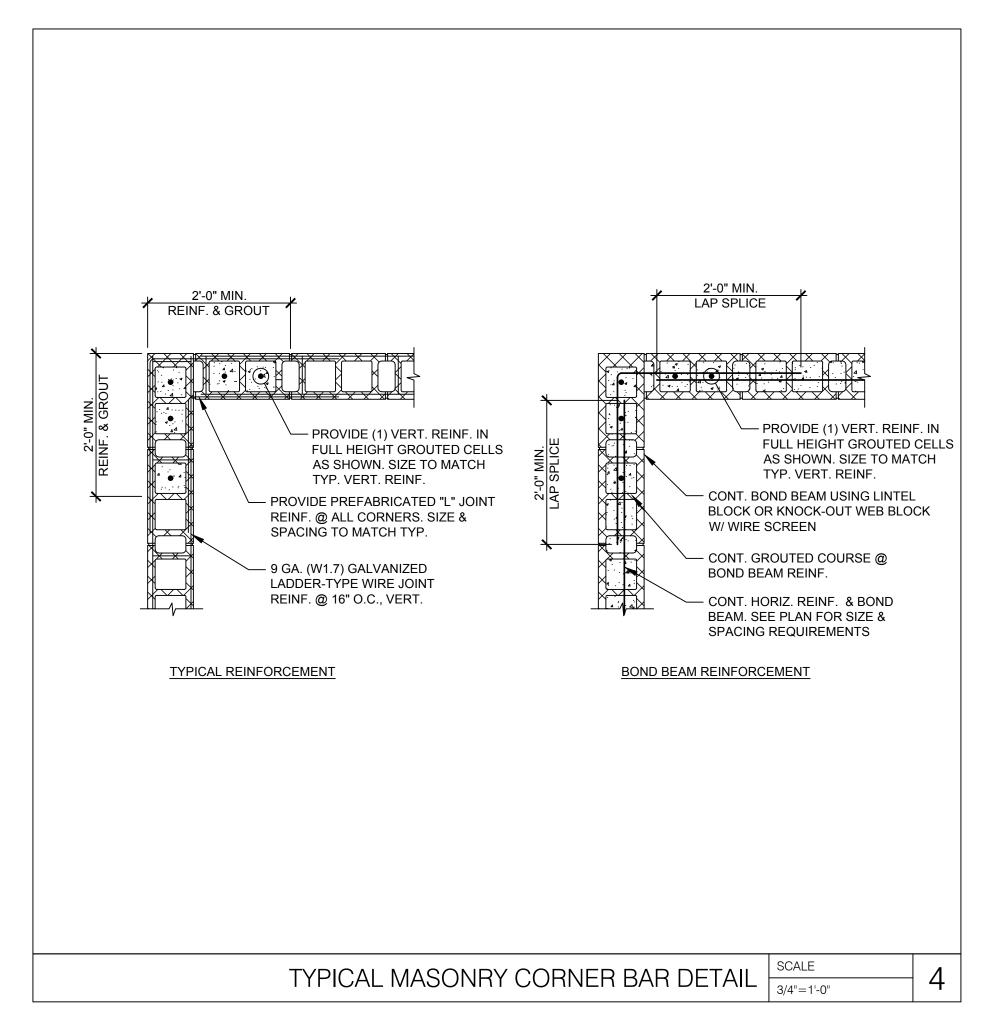



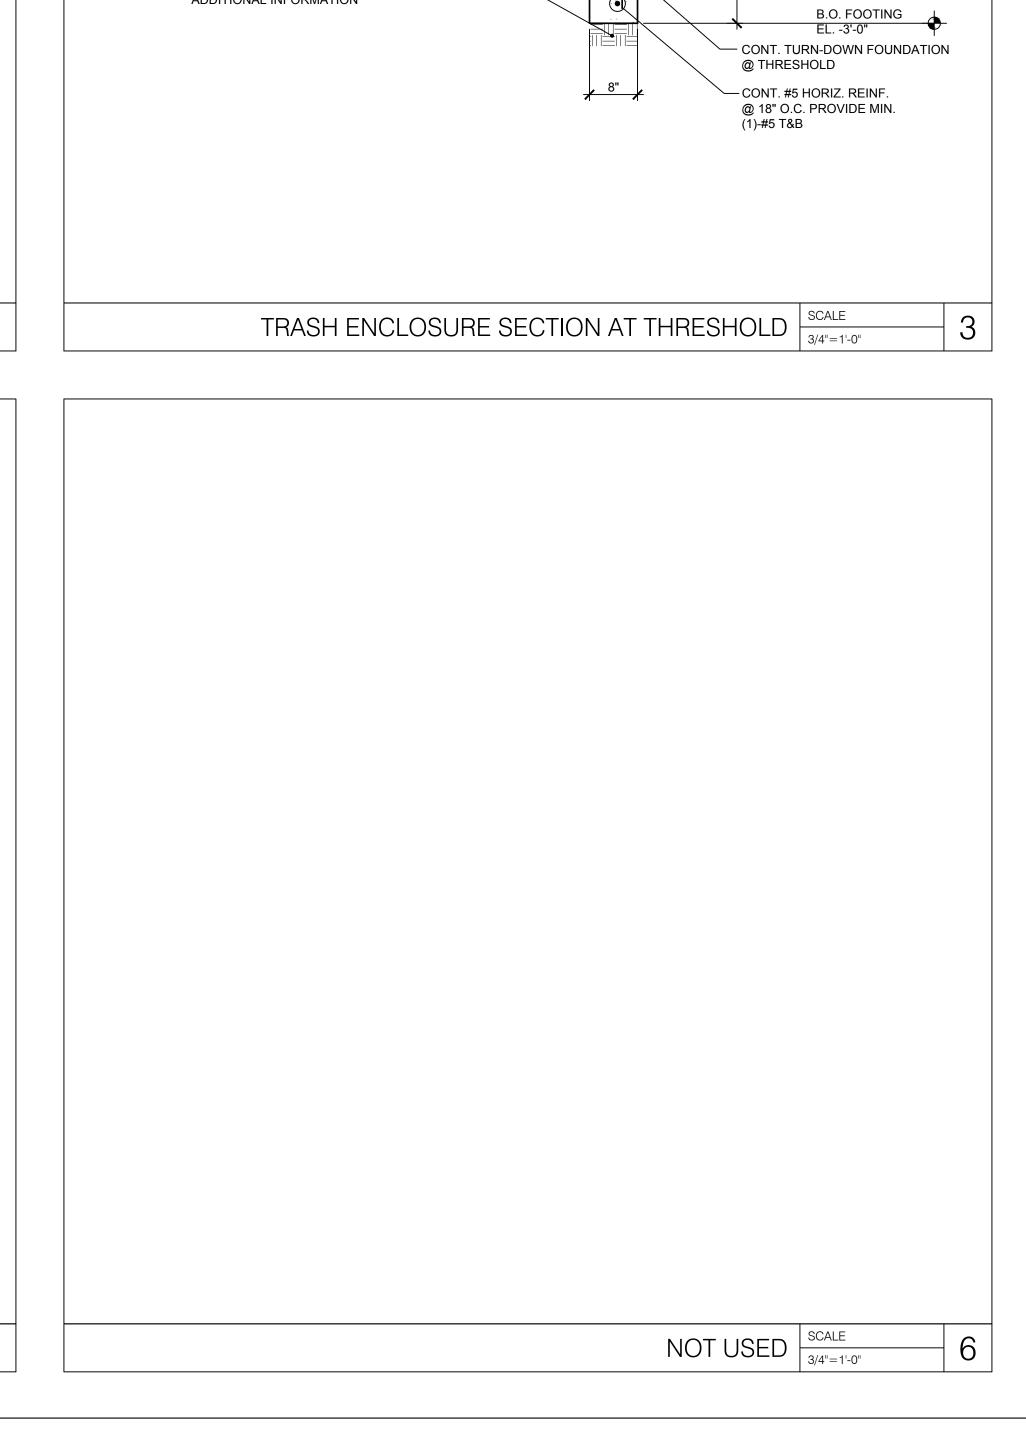



1700 Industrial Drive Suite B
Rogers, AR 72756
479.986.4400
www.core-states.com

ENGINEER OF RECORD

DAVID BALMA

NUMBER
PE-2015003007

O4/20/21

GROUP

THESE DRAWINGS ARE NOT COMPLETE WITHOUT THE SEPARATE TYPE WRITTEN SPECIFICATIONS MANUAL WHICH ARE PART OF THE CONTRACT DOCUMENTS.

- 2020.12.21 PERMIT SET

1 2021.04.20 STRUCTURAL STEEL REV

PROJECT INFORMATION

PROJECT NO: JPM.27135.001

DATE: 2020.12.21

PROTOTYPE: 20.2

DRAWN BY: J.PEREZ

CHECKED BY: E.SCALGIONE

DESCRIPTION

ISSUE DATE

TRASH ENCLOSURE DETAILS

SHEET NUMBER

VERSION: SHEET TITLE

S8.0

MECHANICAL GENERAL NOTES:

- HVAC WORK CONSISTS OF PROVIDING AIR CONDITIONING SYSTEMS FOR A COMPLETE OPERATING SYSTEM AS INDICATED ON THE DRAWINGS. ALL WORK SHALL COMPLY WITH 2018 INTERNATIONAL MECHANICAL CODE AND ALL OTHER APPLICABLE CODES IN SPECIFICATIONS. IT IS THE INTENTION OF THE CONTRACT DRAWINGS AND SPECIFICATION TO CALL FOR COMPLETE, FINISHED WORK, TESTED, AND READY FOR OPERATION.
- AN AIR BALANCE SHALL BE PERFORMED BY AN APPROVED INDEPENDENT THIRD PARTY AIR BALANCE CONTRACTOR IN ACCORDANCE WITH THE LATEST EDITION OF STANDARDS PUBLISHED BY THE ASSOCIATED AIR BALANCE COUNCIL (AABC), THE NATIONAL ENVIRONMENTAL BALANCING BUREAU (NEBB), OR THE TESTING, ADJUSTING, AND BALANCING BUREAU \mid (TABB). BALANCE EACH SUPPLY, RETURN, EXHAUST AND OUTSIDE AIR DEVICE WITHIN 5% OF REQUIREMENTS AND FURNISH A REPORT TO THE CONSTRUCTION MANAGER AND ENGINEER OF RECORD. THE ENTIRE HVAC SYSTEM MUST BE FULLY OPERABLE, BALANCED, AND APPROVED BY THE OWNER'S REPRESENTATIVE.
- \mid all duct sizes shown are free area sizes and do not account for insulation. Insulate all ductwork, excep \mid EXHAUST DUCTWORK, WITH 2" FIBERGLASS DUCT WRAP INSTALLED TO A MINIMUM R VALUE OF 6. PROVIDE WITH VAPOR BARRIER AND TAPE ALL JOINTS. PROVIDE 1" THICK DUCT LINER WHERE INDICATED ON PLANS.
- PROVIDE SPIN-IN FITTINGS AT ALL FLEXIBLE DUCT RUN OUTS TO DIFFUSERS (NO EXTRACTOR) AND DAMPER.
- MAXIMUM LENGTH OF FLEX DUCT IS LIMITED TO 5'-0".
- ALL PIPING SUBJECT TO THERMAL EXPANSION AND/OR CONTRACTION THAT PENETRATES A SMOKE, FIRE, OR FIRE/SMOKE WALL, PARTITION, OR FLOOR SLAB SHALL BE SUITABLY SLEEVED AND FIRE-SAFED.
- METAL DUCTS WHICH PENETRATE 1 HOUR RATED FIRE WALLS AND ARE LESS THAN 100 SQUARE INCHES SHALL EXTEND A MINIMUM OF 5 FEET ON BOTH SIDES OF THE WALL WITHOUT AN OPENING (TO PRECLUDE THE REQUIREMENT OF A FIRE DAMPER). DUCTWORK SHALL IN NO CASE BE LIGHTER THAN 24 GAUGE STEEL.
- PROVIDE IDENTIFICATION OF THE LOCATION OF ALL FIRE AND BALANCING DAMPERS. IDENTIFICATION TAGS SHALL BE AFFIXED TO THE WALLS OR CEILINGS AND SHALL BE VISIBLE FROM THE OCCUPIED SPACE.
- PROVIDE ORANGE TAGS ON ALL VOLUME AND BALANCING DAMPERS ABOVE THE CEILING. TAGS AND DAMPER HANDLES SHALL BE VISIBLE AND ACCESSIBLE FOR THE TEST & BALANCE AGENCY.
- ALL PIPING SHALL BE SUPPORTED WITH COMMERCIAL MANUFACTURED CLAMPS. PROVIDE ISOLATION SLEEVES TO PREVENT
- CONTACT OF DISSIMILAR METALS.
- INSTALL ALL EQUIPMENT IN STRICT ACCORDANCE WITH THE MANUFACTURERS' INSTRUCTIONS AND RECOMMENDATIONS. CONTRACTOR TO PROVIDE ALL SUPPLEMENTARY STEEL REQUIRED TO SUSPEND MECHANICAL EQUIPMENT AND MATERIALS.
- ALL INSULATION SHALL BE FIRE RATED IN ACCORDANCE WITH NFPA 90A 50/25 SMOKE DEVELOPMENT AND FLAME SPREAD REQUIREMENTS. INSULATION "R" VALUES SHALL COMPLY WITH APPLICABLE ENERGY CODE.
- MOUNT ALL SPACE THERMOSTATS 48" AFF. MOUNT REMOTE TEMPERATURE SENSORS AT 60" AFF UNLESS OTHERWISE NOTED. COORDINATE WITH ADJACENT EQUIPMENT.
- INSTALL DUCT MOUNTED SMOKE DETECTORS (FURNISHED BY DIVISION 26) IN SUPPLY AND/OR RETURN AIR DUCTWORK WHERE REQUIRED AND IN ACCORDANCE WITH APPLICABLE CODE. WIRE DUCT MOUNTED SMOKE DETECTORS SUCH THAT ACTIVATION WILL DE-ENERGIZE AIR HANDLING UNIT FAN. LOCATE DUCT MOUNTED SMOKE DETECTORS THE REQUIRED DISTANCE DOWNSTREAM FROM BENDS OR INLETS AS RECOMMENDED BY THE MANUFACTURER.
- SEE ELECTRICAL DRAWINGS FOR ELECTRICAL CHARACTERISTICS OF MECHANICAL EQUIPMENT.
- UNLESS OTHERWISE NOTED, INSTALL ALL DUCTWORK AS HIGH AS POSSIBLE, TIGHT TO THE BOTTOM OF THE STRUCTURE. COORDINATE ELEVATION AND LOCATION WITH RAIN LEADERS, WATER PIPING, PLUMBING VENTS, AND MAJOR ELECTRICA CONDUITS OR CABLE TRAY.
- 18. PROVIDE DRAIN P-TRAPS IN THE CONDENSATE LINES AT ALL AIR HANDLING UNITS. SIZE PER MANUFACTURERS
- l requirements. CONTRACTOR SHALL NOT ATTACH SUPPORTS OR HANGERS DIRECTLY TO THE DECK, CEILING SUPPORT SYSTEM, OR DUCTWORK ABOVE. HANGERS, SUPPORTS, FASTENING DEVICES, ETC. SHALL BE FASTENED TO TOP CHORD OF THE JOIST
- THE ENGINEER HAS MADE AN EXTENSIVE EFFORT TO IDENTIFY ABOVE CEILING CONFLICTS. THE CONTRACTOR IS RESPONSIBLE TO CHECK FIELD CONDITIONS PRIOR TO COMMENCING WORK AND REPORT ANY PROBLEMS/CONFLICTS TO THE ENGINEER WITHIN 2 DAYS OF DISCOVERY. ANY CHANGES RESULTING FROM CONDITIONS ARISING IN THE FIELD WHICH WERE NOT BROUGHT TO THE ENGINEER'S ATTENTION ARE TO BE MADE BY THIS CONTRACTOR WITH NO ADDITIONAL COST
- THE WORK INDICATED ON THESE DRAWINGS IS GENERALLY DIAGRAMMATIC AND IS INTENDED TO CONVEY THE SCOPE OF WORK AND INDICATE THE GENERAL ARRANGEMENT OF DUCTWORK AND EQUIPMENT.
- ALL WORK IS TO BE FREE OF DEFECTS IN WORKMANSHIP AND MATERIALS FOR A PERIOD OF ONE (1) YEAR FROM DATE OF FINAL ACCEPTANCE. ALL DEFECTS WHICH DEVELOP OR ARE DISCOVERED WITHIN THIS PERIOD SHALL BE REPAIRED BY THE CONTRACTOR TO THE SATISFACTION OF THE OWNER AT NO ADDITIONAL COST TO THE OWNER.
- UPON COMPLETION OF THE WORK UNDER THIS CONTRACT, THE CONTRACTOR SHALL REMOVE ALL TOOLS, APPLIANCES, SURPLUS MATERIALS, AND SCRAP. ALL IDENTIFIED EXISTING EQUIPMENT TO BE REMOVED SHALL BE TURNED OVER TO THE
- WHEN CONFLICTS OCCUR IN SPECIFICATIONS OR IN THE DRAWINGS, OR BETWEEN EITHER, THE ITEMS OF GREATER QUANTITY OR HIGHER COST SHALL BE PROVIDED.
- \mid the contractor shall coordinate work with other trades in order to avoid conflicts.
- PROVIDE BALANCING DAMPER IN EACH BRANCH CONNECTION. ALL DUCTWORK INSTALLED ON THIS PROJECT SHALL BE OF SHEET METAL CONSTRUCTION. DUCTWORK SHALL BE
- FABRICATED AND CONSTRUCTED IN ACCORDANCE WITH SMACNA REQUIREMENTS
- MECHANICAL CONTRACTOR SHALL PROVIDE NAMEPLATE INFO TO THE FACILITY MANAGER FOR ALL MECHANICAL EQUIPMENT, INCLUDING BUT NOT LIMITED TO, FAN COILS, CONDENSING UNITS, RTU'S, AND EXHAUST FANS.
- ALL REFRIGERANT SHALL BE R-410A. NO R-22 SHALL BE USED.

AND/OR FLANGE OF THE BEAMS ABOVE.

- ALL PROVISIONS FOR LINE VOLTAGE WIRING SHALL BE BY THE ELECTRICAL CONTRACTOR. ALL PROVISIONS FOR LOW VOLTAGE WIRING SHALL BE BY THE MECHANICAL CONTRACTOR. FINAL CONNECTIONS SHALL BE BY THE MECHANICAL CONTRACTOR FOR LOW VOLTAGE WIRING UNLESS PROHIBITED BY LOCAL JURISDICTION, IN SUCH CASE THE MECHANICAL CONTRACTOR SHALL INFORM THE ELECTRICAL CONTRACTOR.
- ROUTE FULL SIZE PVC DRAIN PIPE FROM EACH RTU (1" MIN) DRAIN PAN AND FROM EACH FCU (3/4" MIN)TO RESPECTIVE FLOOR DRAIN OR TO DAYLIGHT WITH AIR GAP. INSULATE WITH 3/4" ARMSTRONG "ARMAFLEX" INSULATION.
- ALL MATERIALS WITHIN RETURN AIR PLENUMS OR EXPOSED WITHIN DUCTS SHALL BE NONCOMBUSTIBLE AND/OR SHALL HAVE A FLAME SPREAD INDEX NOT GREATER THAN 25 AND A SMOKE DEVELOPED INDEX NOT GREATER THAN 50 WHEN TESTED IN ACCORDANCE WITH ASTME 84.

ABBREVIATIONS

AC	AIR CONDITIONING
ACH	AIR CHANGES PER HOUR
AD	ACCESS DOOR
AFF	ABOVE FINISHED FLOOR
AHU	AIR HANDLING UNIT
AP	ACCESS PANEL
BD	BYPASS DAMPER
BFF	BELOW FINISHED FLOOR
BHP	BRAKE HORSE POWER

- BOTTOM BOT BRITISH THERMAL UNIT PER HOUR CONDENSATE DRAIN
- CUBIC FEET PER MINUTE CHILLED WATER RETURN CHILLED WATER SUPPLY

CU

- CLG **CEILING COOLING TOWER**
- CONDENSER WATER RETURN **CWS** CONDENSER WATER SUPPLY

CONDENSING UNIT

- DB DRY BULB DDC DIRECT DIGITAL CONTROL
- DG DOOR GRILLE
- DN DOWN **DEW POINT**
- EXHAUST AIR ENTERING AIR TEMPERATURE
- ELECTRIC DUCT HEATER

DIRECT EXPANSION

- ENERGY EFFICIENCY RATIO EXHAUST FAN
- **EXPANSION TANK**
- ELEVATION EQUIP EQUIPMENT
- ENTERING WATER TEMPERATURE
- EXISTING
- **EXTERNAL STATIC PRESSURE**
- FIRE DAMPER
- FCU FAN COIL UNIT FD FLOOR DRAIN
- FLOOR
- FEET PER MINUTE
- FSD FIRE/SMOKE DAMPER
- NATURAL GAS
- **GALLONS PER HOUR**
- **GALLONS PER MINUTE**
- HUMIDITY
- HC HEATING COIL HEAT EXCHANGER
- HORSE POWER
- HOT WATER RETURN
- **HOT WATER SUPPLY** KILOWATT
- LEAVING AIR TEMPERATURE
- LEAVING WATER TEMPERATURE
- MOTORIZED DAMPER MAXIMUM
- MINIMUM
- NORMALLY CLOSED
- **NOT IN CONTRACT** NORMALLY OPEN
- OUTSIDE AIR
- **OUTSIDE AIR INTAKE**
- **OUTSIDE SCREW & YOKE**
- PRESSURE DROP **PRESS** PRESSURE
- RETURN AIR
- **ROOF DRAIN REFRIGERANT**
- RAIN LEADER
- RUNNING LOAD AMPS
- **REVOLUTIONS PER MINUTE ROOF TOP UNIT**
- **SMOKE DETECTOR**
- SUPPLY AIR
- STATIC PRESSURE
- SYSTEM
- **TEMPERATURE**
- **TYPICAL**

UNDERCUT

- UNDERGROUND
- **UNDERWRITERS LABORATORY**
- UNLESS OTHERWISE NOTED UON **VOLUME DAMPER** VD
- VSD VARIABLE SPEED DRIVE
- WET BULB

MECHANICAL AND PLUMBING EQUIPMENT COMPONENTS EARTHQUAKE LOAD RESISTANCE OCCUPANCY CATEGORY BUSINESS - E EQUIPMENT AND SYSTEM ANCHORAGE TO LOCATION OF PROFESSIONALLY SEALED COMPONENTS FLOORS, ROOFS, ETC. ANCHORAGE AND SWAY BRACING DETAILS PROVIDED DRAWING OR SHOP PROVIDED NOT **PROVIDED PROVIDED** SPEC. SECTION | DRAWINGS | PERMIT & PLANS EQUIPMENT ON ROOF RTU, CU-1 & CU-2 EQUIPMENT SUSPENDED FROM STRUCTURE (Ip = 1.0EQUIPMENT MOUNTED ON WALL (lp = 1.0)

PIPING PIPING AND/OR EQUIPMENT TO BE REMOVED **├----**EXISTING PIPING TO REMAIN **≥** CW\$ — **~** CONDENSER WATER SUPPLY CONDENSER WATER RETURN Z——CHWS—— CHILLED WATER SUPPLY **≥**——CHWR—— CHILLED WATER RETURN CONDENSATE LINE REFRIGERANT PIPING **₹**——HWS——**₹** HOT WATER SUPPLY HWR ----HOT WATER RETURN **─** - **─** - **─** DOMESTIC WATER **₹** GATE VALVE CHECK VALVE BALL VALVE PLUG VALVE **BUTTERFLY VALVE** PRESSURE REDUCING VALVE SAFETY OR PRESSURE RELIEF VALVE VALVE IN RISER DIRECTION OF FLOW REDUCER OR INCREASER ECCENTRIC REDUCER TOP CONNECTION, 45 OR 90 DEG. BOTTOM CONNECTION, 45 OR 90 DEG. SIDE CONNECTION CAPPED OUTLET DROP IN PIPING RISE IN PIPING OUTSIDE SCREW & YOKE (O S & Y) FLEXIBLE CONNECTION PRESSURE GAUGE THERMOMETER STRAINER WITH BALL VALVE TAILOL NOISNAYA EXPANSION JOINT

GENERAL CONTROL DEVICES

THERMOSTAT / TEMPERATURE SENSOR HUMIDITY SENSOR / CARBON DIOXIDE SENSOR SMOKE DETECTOR (DUCT MOUNTED) PROVIDED BY DIV. 16 INSTALLED BY DIV. 15

DAINTREE CONTROL DEVICES

BMS WIRELESS THERMOSTAT: BMS WIRELESS EXTERIOR TEMP. SENSOR: DAINTREE NETWORKS #WTS10 TITAN #TPZOS/O/HA1.2 BMS WIRELESS REMOTE TEMP. SENSOR: BMS WIRELESS DUCT TEMP. SENSOR: DAINTREE #TPZRS/HA1.2 (WALL MOUNT) TITAN #TPZDS-S OR SIMILAR BMS HARDWIRED EQUIP. TEMP. SENSOR: BMS WIRELESS REMOTE TEMP. SENSOR: DAINTREE #TPZRS/HA1.2 (CEILING MOUNT) DAINTREE #RBA-BA/10K-2-86 CURRENT TRANSFORMER: BMS WIRELESS GENERAL ADAPTER: DAINTREE #CR9580-10-M DAINTREE #WGA100

BMS WIRELESS SENSOR ADAPTER:


DAINTREE #WSA10


BMS CONTROL DEVICES TO BE ORDERED FROM THE BMS EQUIPMENT VENDOR. COORDINATE WITH PROJECT ELECTRICIAN


LEAK DETECTION SENSOR.
DAINTREE #RBA-BA/LDT1-PS-BB;

NOTE:

THESE ARE STANDARD SYMBOLS AND GENERAL NOTES AND MAY NOT ALL APPEAR ON THE PROJECT DRAWINGS; HOWEVER WHEREVER THE SYMBOL APPEARS ON THE PROJECT DRAWINGS, THE ITEM SHALL BE PROVIDED AND INSTALLED.

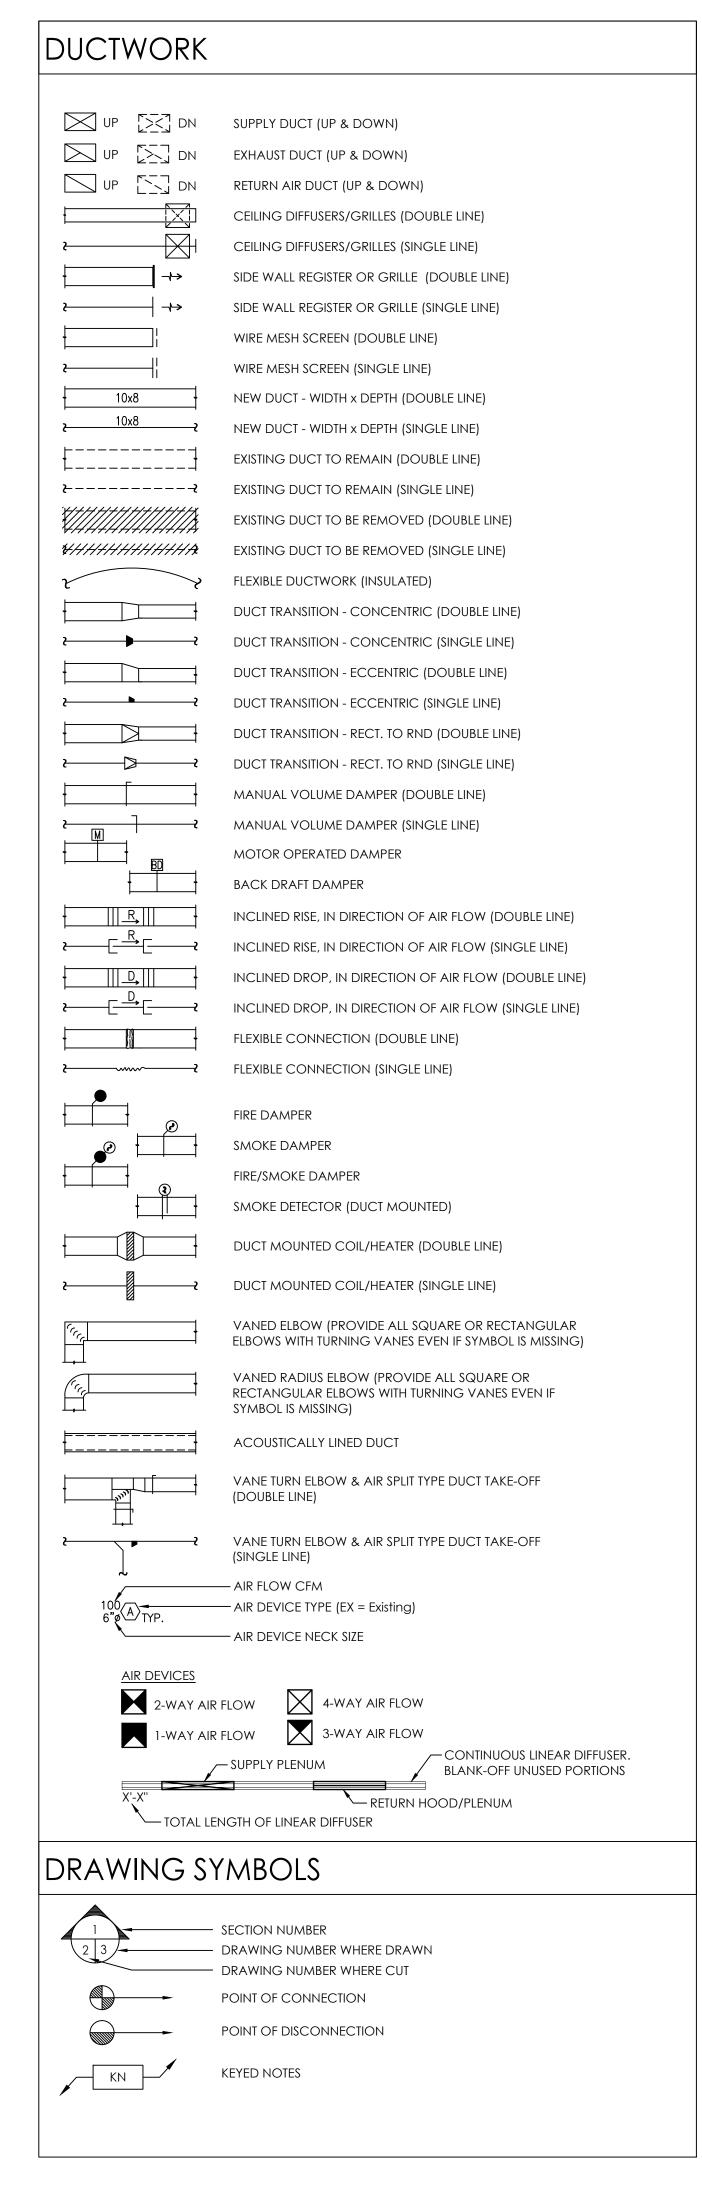

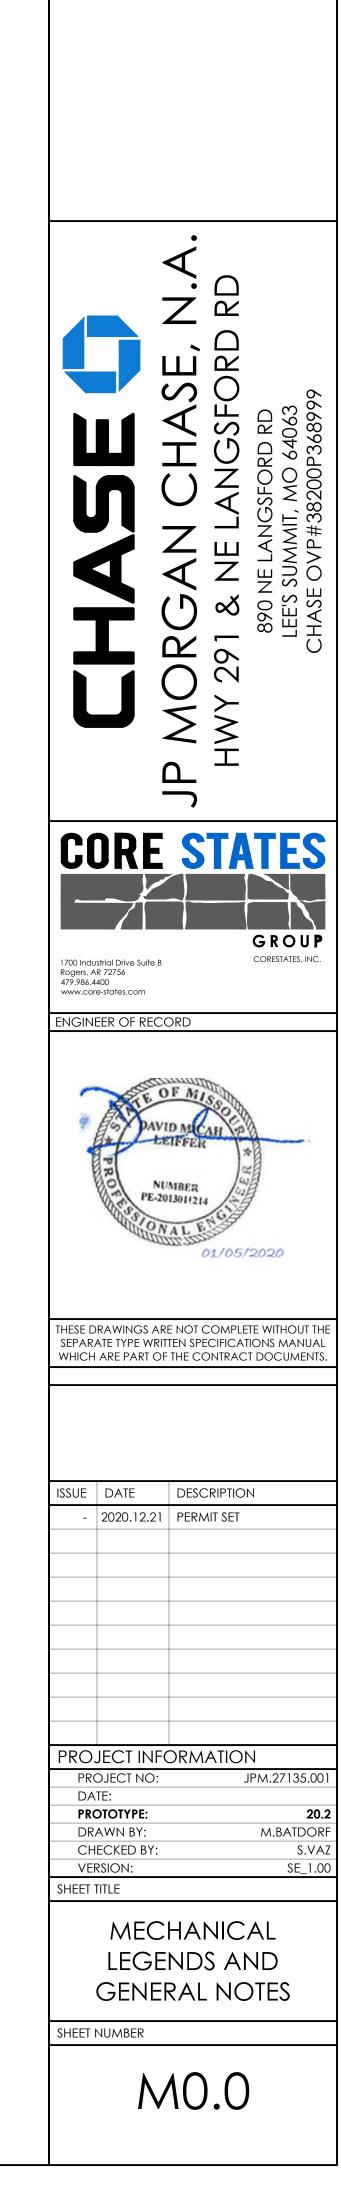

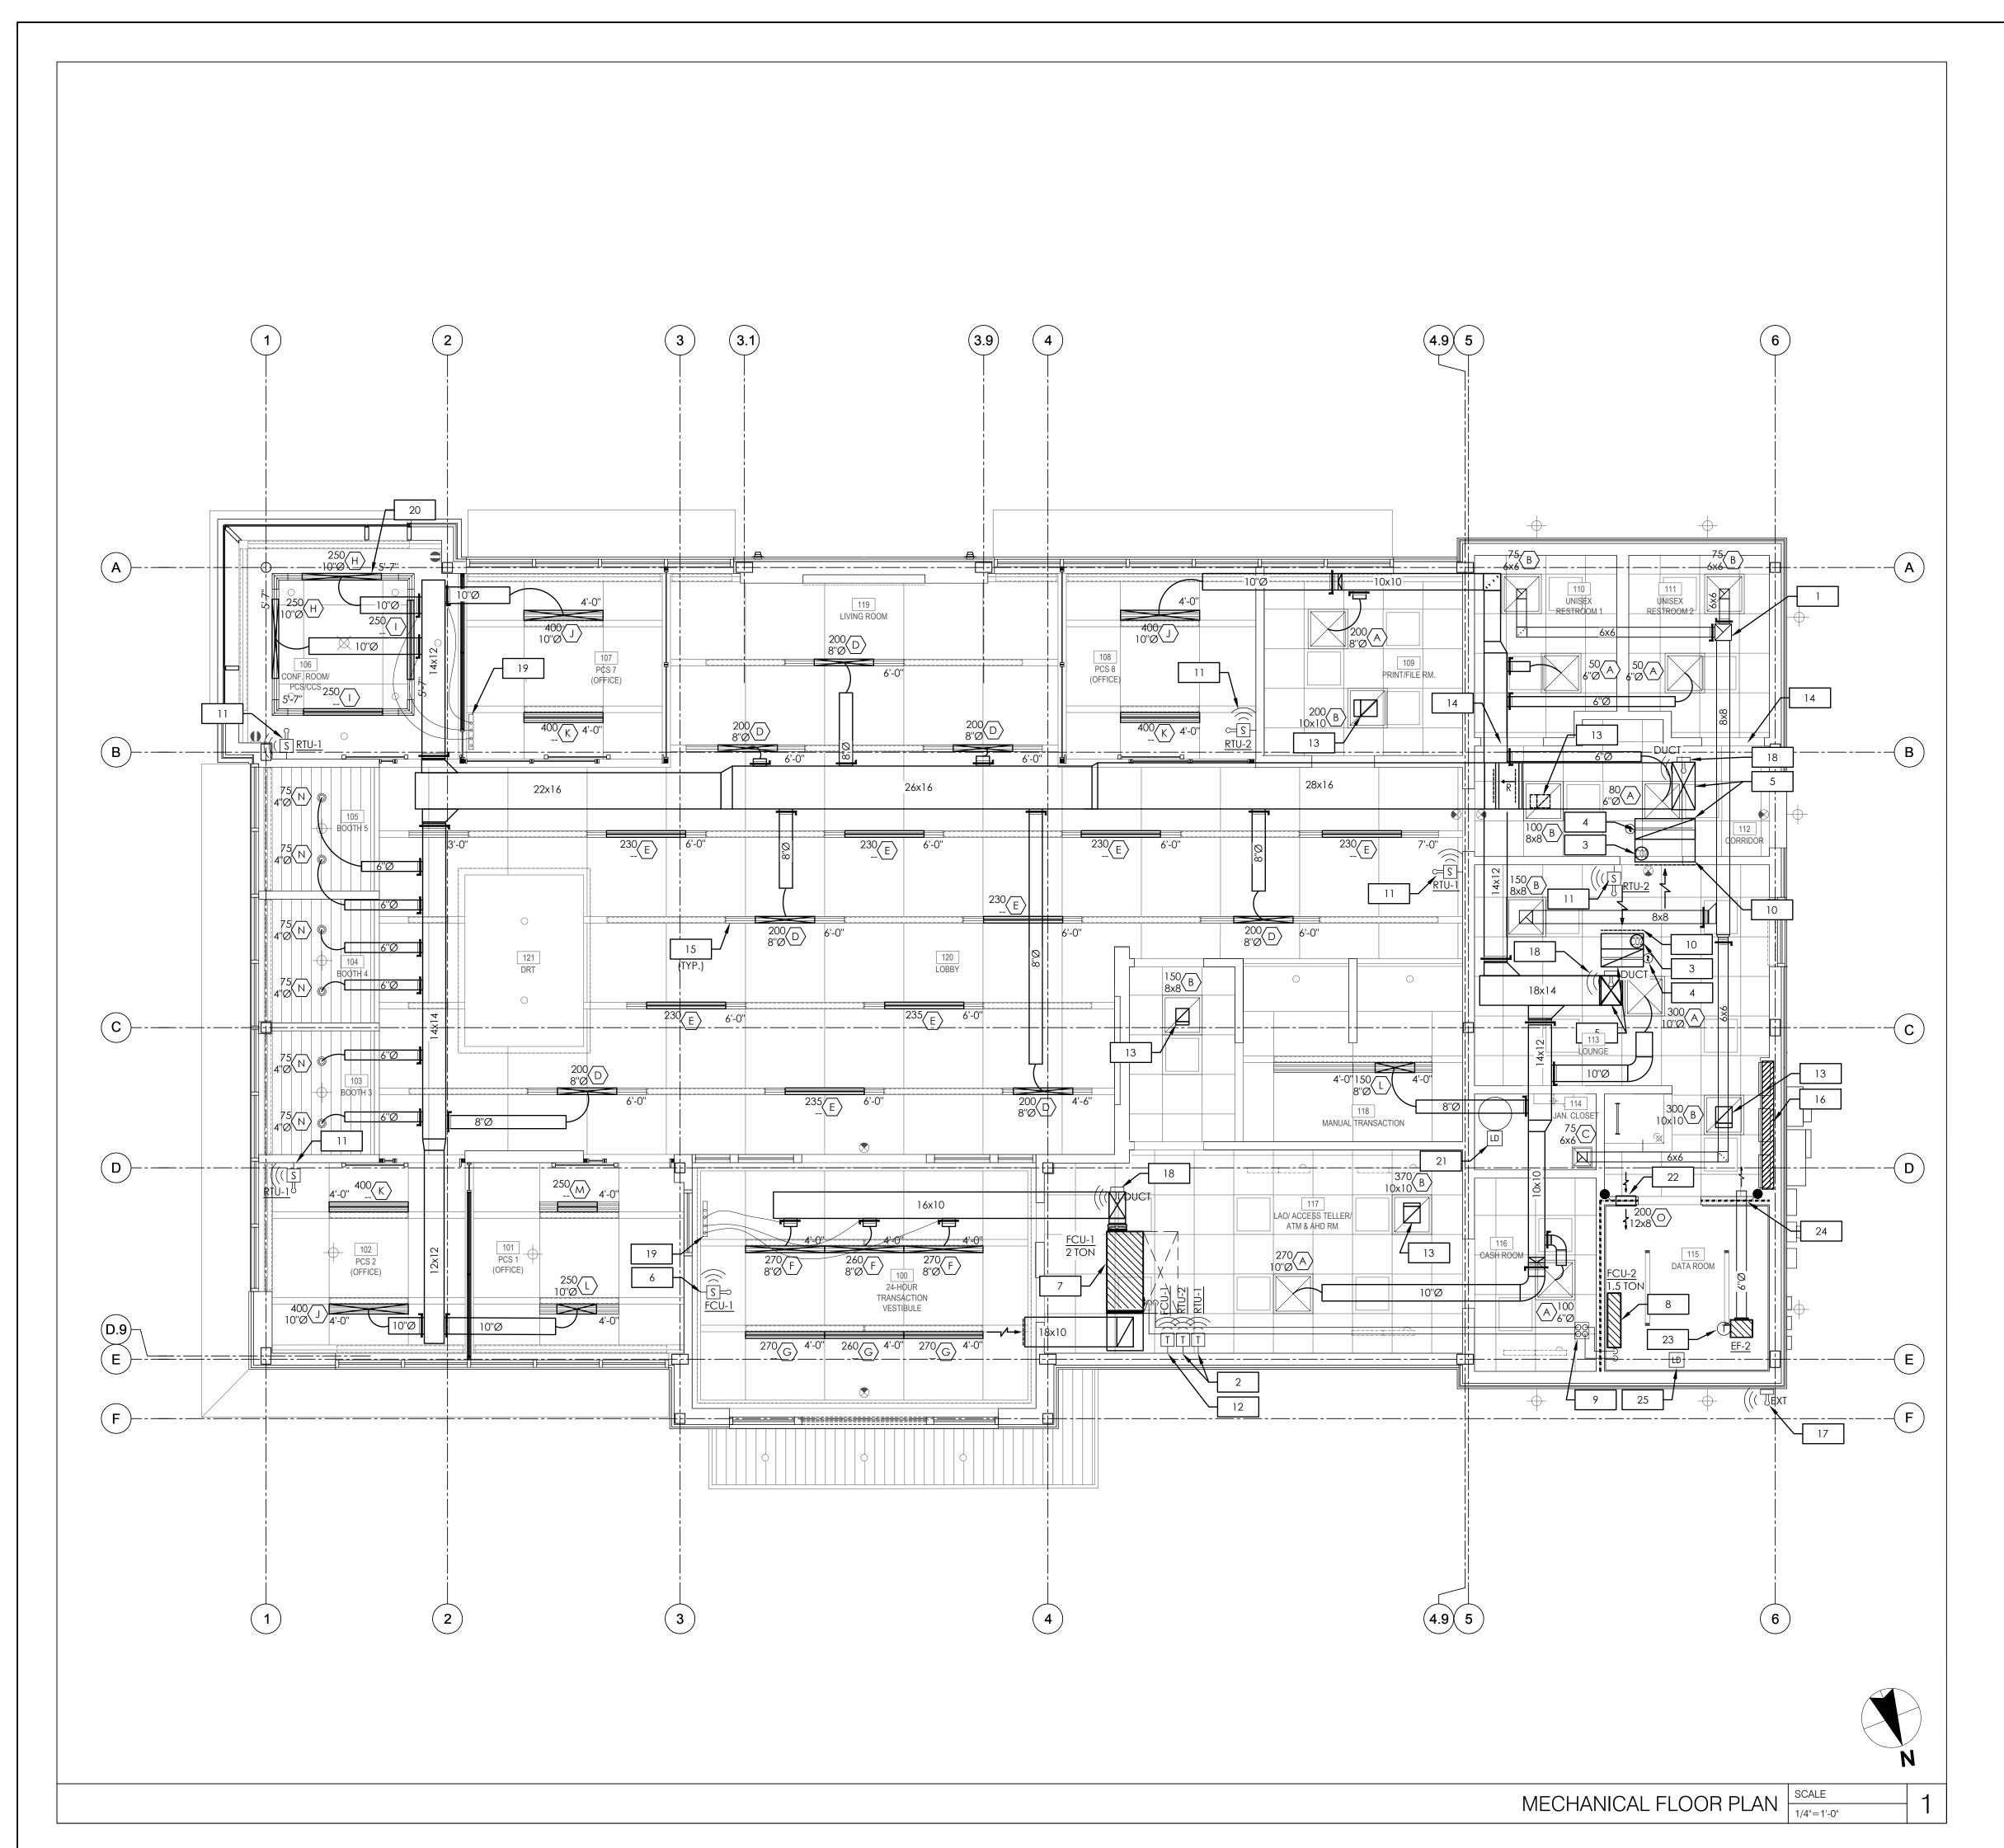

MECHANICAL NOTES:

- 1. CONTRACTOR TO PROVIDE AND INSTALL NEW 10x10 EXHAUST DUCT FROM UP THROUGH ROOF TO ROOF MOUNTED EXHAUST FAN. COORDINATE ROOF PENETRATION WITH BUILDING STRUCTURE.
- 2. CONTRACTOR TO INSTALL NEW STANDARD DAINTREE 5-WIRE WI-FI COMMUNICATING THERMOSTAT. THERMOSTAT SHALL BE WIRED FOR CONTROL OF RTU'S WITH REMOTE SENSOR INPUT. MOUNT ON WALL 48" ABOVE FINISHED FLOOR AND COORDINATE EXACT LOCATION WITH ARCHITECT/OWNER. REFER TO HVAC CONTROLS TABLE ON SHEET M2.0 FOR ADDITIONAL INFORMATION.
- PROVIDE DUCT MOUNTED CO2 SENSOR FOR ROOF TOP UNIT.
 MOUNT NEW 120V DUCT MOUNTED SMOKE DETECTOR (FURNISHED AND
- WIRED BY DIV 26) IN MAIN RETURN AIR DUCT. DETECTORS SHALL BE INTERLOCKED BY ELECTRICAL CONTRACTOR TO SHUT DOWN ROOFTOP UNITS UPON DETECTION OF SMOKE.
- 5. SUPPLY AIR DUCT AND RETURN AIR DUCT UP THROUGH ROOF TO ROOF MOUNTED A/C UNIT (RTU). PROVIDE WITH FLEXIBLE DUCT CONNECTIONS. TRANSITION DUCTWORK TO FULL SIZE OF UNIT OPENING AS REQUIRED.
- 6. CONTRACTOR TO INSTALL STANDARD DAINTREE WIRELESS REMOTE TEMPERATURE SENSOR SERVING FCU-1. MOUNT ON WALL 60" ABOVE FINISHED FLOOR AND COORDINATE EXACT LOCATION WITH ARCHITECT/OWNER. REFER TO HVAC CONTROLS TABLE ON SHEET M2.0 FOR ADDITIONAL INFORMATION.
- 7. DUCTED FAN COIL UNIT (FCU-1) LOCATED JUST ABOVE LAO ROOM CEILING. SUSPEND UNIT FROM STRUCTURE AND INSTALL UNIT SUCH THAT ALL MAINTENANCE PANELS ARE IN AN ACCESSIBLE LOCATION. PROVIDE CONDENSATE PUMP, AUXILIARY DRAIN PAN, AND WATER LEVEL DETECTION DEVICE. SEE PLUMBING PLANS FOR CONDENSATE ROUTING.
- WALL MOUNTED DUCTLESS FAN COIL UNIT (FCU-2). COORDINATE ACTUAL INSTALLATION LOCATION IN FIELD WITH OWNER. INSTALL CONDENSATE PUMP ON WALL ABOVE DROP CEILING AS CLOSE AS POSSIBLE TO FAN COIL. SEE PLUMBING DRAWINGS FOR CONDENSATE PIPE ROUTING.
- REFRIGERANT SUCTION AND LIQUID LINES UP THROUGH ROOF TO REMOTE ROOF MOUNTED CONDENSING UNITS (CU-1 & 2). ROUTE LINES ABOVE ROOF AS STRAIGHT AS POSSIBLE, PROVIDE WITH MINIMUM 3/4" THICK INSULATION.
- 10. CONTRACTOR TO ROUTE FULL SIZE RETURN DUCT DOWN FROM ROOF TOP UNIT. PROVIDE RETURN DUCT WITH 1" LINER AND TERMINATE WITH A 90° ELBOW AND WIRE MESH SCREEN.
- 11. CONTRACTOR TO INSTALL STANDARD DAINTREE WIRELESS REMOTE
 AVERAGING TEMPERATURE SENSOR SERVING CORRESPONDING RTU.
 MOUNT ON WALL 60" ABOVE FINISHED FLOOR AND COORDINATE EXACT
 LOCATION WITH ARCHITECT/OWNER. REFER TO HVAC CONTROLS TABLE
 ON SHEET M2.0 FOR ADDITIONAL INFORMATION.
- 12. CONTRACTOR TO PROVIDE AND INSTALL NEW STANDARD DAINTREE 5-WIRE COMMUNICATING THERMOSTAT. THERMOSTAT SHALL BE WIRED FOR CONTROL OF FCU-1 AND INSTALLED IN THE LTOS ROOM. MOUNT ON WALL 48" ABOVE FINISHED FLOOR. REFER TO HVAC CONTROLS TABLE ON M2.0 FOR ADDITIONAL INFORMATION.
- 13. CONTRACTOR TO PROVIDE AND INSTALL SOUND ATTENUATION BOOT ON RETURN GRILLE. REFER TO DETAIL ON SHEET M3.0 FOR MORE INFORMATION. DUCT SIZE SHALL MATCH SIZE INDICATED ON DIFFUSER
- 14. PROVIDE 1" DOOR UNDERCUT.
- 15. LINEAR SLOT FIXTURES SET IN 4" UTILITY CHANNEL ARE INTENDED TO HAVE A CONTINUOUS SEAMLESS APPEARANCE FOR THE FULL RUN OF THE CHANNEL WITHOUT VISUAL DIFFERENTIATION BETWEEN SUPPLY AIR, RETURN AIR, AND UNUSED PORTIONS OF THE RUN. TOTAL LENGTH OF LINEAR DIFFUSER IS INDICATED ON THE FLOOR PLAN. CONTRACTOR TO PROVIDE TITUS 4" FL-TZ 1-SLOT LINEAR DIFFUSER WITH A 1" SLOT WIDTH WITH FBPI SUPPLY AIR PLENUMS, FBRI RETURN HOODS, AND FBBO BLANK-OFFS AS REQUIRED. REFER TO SCHEDULE ON SHEET M2.0 FOR ADDITIONAL INFORMATION.
- 16. DEDICATED ELECTRICAL SPACE. THE SPACE EQUAL TO THE WIDTH AND DEPTH OF THE ELECTRICAL EQUIPMENT AND EXTENDING FROM THE FLOOR TO A HEIGHT SIX FEET ABOVE THE EQUIPMENT OR TO THE STRUCTURE. WHICHEVER IS LOWER. SHALL BE DEDICATED TO ELECTRICAL EQUIPMENT, NO PIPING FOREIGN TO THE ELECTRICAL INSTALLATION SHALL BE PERMITTED WITHIN THIS ZONE.
- 17. CONTRACTOR TO INSTALL DAINTREE EXTERIOR WIRELESS TEMPERATURE
- SENSOR. MOUNT ON EXTERIOR WALL 10'-0" ABOVE GRADE.

 18. CONTRACTOR TO INSTALL DAINTREE WIRELESS DUCT TEMPERATURE SENSOR IN SUPPLY DUCT.
- 19. CONTRACTOR TO PROVIDE AND INSTALL CABLE OPERATED DAMPER SIMILAR TO YOUNG REGULATOR MODEL 270-275 WITH 5020CC DAMPER. PROVIDE WITH BALANCING STATION IN ACCESSIBLE LOCATION ABOVE DROP CEILING.
- 20. LINEAR SLOT FIXTURES ARE INTENDED TO HAVE A CONTINUOUS SEAMLESS APPEARANCE FOR THE FULL RUN OF THE DIFFUSER WITHOUT VISUAL DIFFERENTIATION BETWEEN SUPPLY AIR, RETURN AIR, AND UNUSED PORTIONS OF THE RUN. PROVIDE OPTIONAL MITERED CORNERS. TOTAL LENGTH OF LINEAR DIFFUSER SECTIONS INDICATED ON PLAN. CONTRACTOR TO PROVIDE TITUS 4" FL 1-SLOT LINEAR DIFFUSER WITH A 1" SLOT WIDTH WITH FBPI SUPPLY AIR PLENUMS, FBRI RETURN HOODS, AND FBBO BLANK-OFFS AS REQUIRED. REFER TO SCHEDULE ON SHEET M2.0 FOR ADDITIONAL INFORMATION.
- 21. CONTRACTOR TO INSTALL LEAK DETECTOR IN DRAIN PAN OF WATER HEATER AND INTERLOCK WITH DAINTREE BMS.
- 22. CONTRACTOR TO PROVIDE RELIEF OPENING IN WALL AT 8" A.F.F. PROVIDE GREENHECK MODEL #FD-100 FIRE DAMPER WITH 8" LONG SLEEVE AND GRILLE TABS. ALIGN FIRE DAMPER IN SLEEVE WITH WALL. ALSO PROVIDE WITH GREENHECK MODEL #ES-32 BACKDRAFT DAMPER MOUNTED WITHIN THE FIRE DAMPER SLEEVE. COORDINATE PENETRATION WITH OTHER WALL MOUNTED EQUIPMENT.
- 23. CONTRACTOR TO PROVIDE LINE-VOLTAGE THERMOSTAT AND MOUNT DIRECTLY TO FAN HOUSING AND SET TO 85°F.
- CONTRACTOR TO PROVIDE 6" DIAMETER FIRE DAMPER GREENHECK MODEL #FDR-510 IN WALL PENETRATION.
- 5. CONTRACTOR TO INSTALL DRAINTREE LEAK DETECTOR ON THE FLOOR IMMEDIATELY ADJACENT TO THE DATA RACK AND WIRED TO A WALL MOUNTED DAINTREE WIRELESS ADAPTER. REFER TO ELECTRICAL DRAWINGS FOR ADDITIONAL INFORMATION.





1700 Industrial Drive Suite B Rogers, AR 72756 479.986.4400 www.core-states.com

www.core-states.com



HESE DRAWINGS ARE NOT COMPLETE WITHOUT THE SEPARATE TYPE WRITTEN SPECIFICATIONS MANUAL WHICH ARE PART OF THE CONTRACT DOCUMENTS.

SSUE DATE DESCRIPTION

- | 2020.12.21 | PERMIT SET


-	

PROJECT INFORMATION		
PROJECT NO:	JPM.27135.00	
DATE:		
PROTOTYPE:	20	
DRAWN BY:	M.BATDO	
CHECKED BY:	S.V	
VERSION:	SE_1.0	
SHEET TITLE		

MECHANICAL FLOOR PLAN

SHEET NUMBER


M1.0

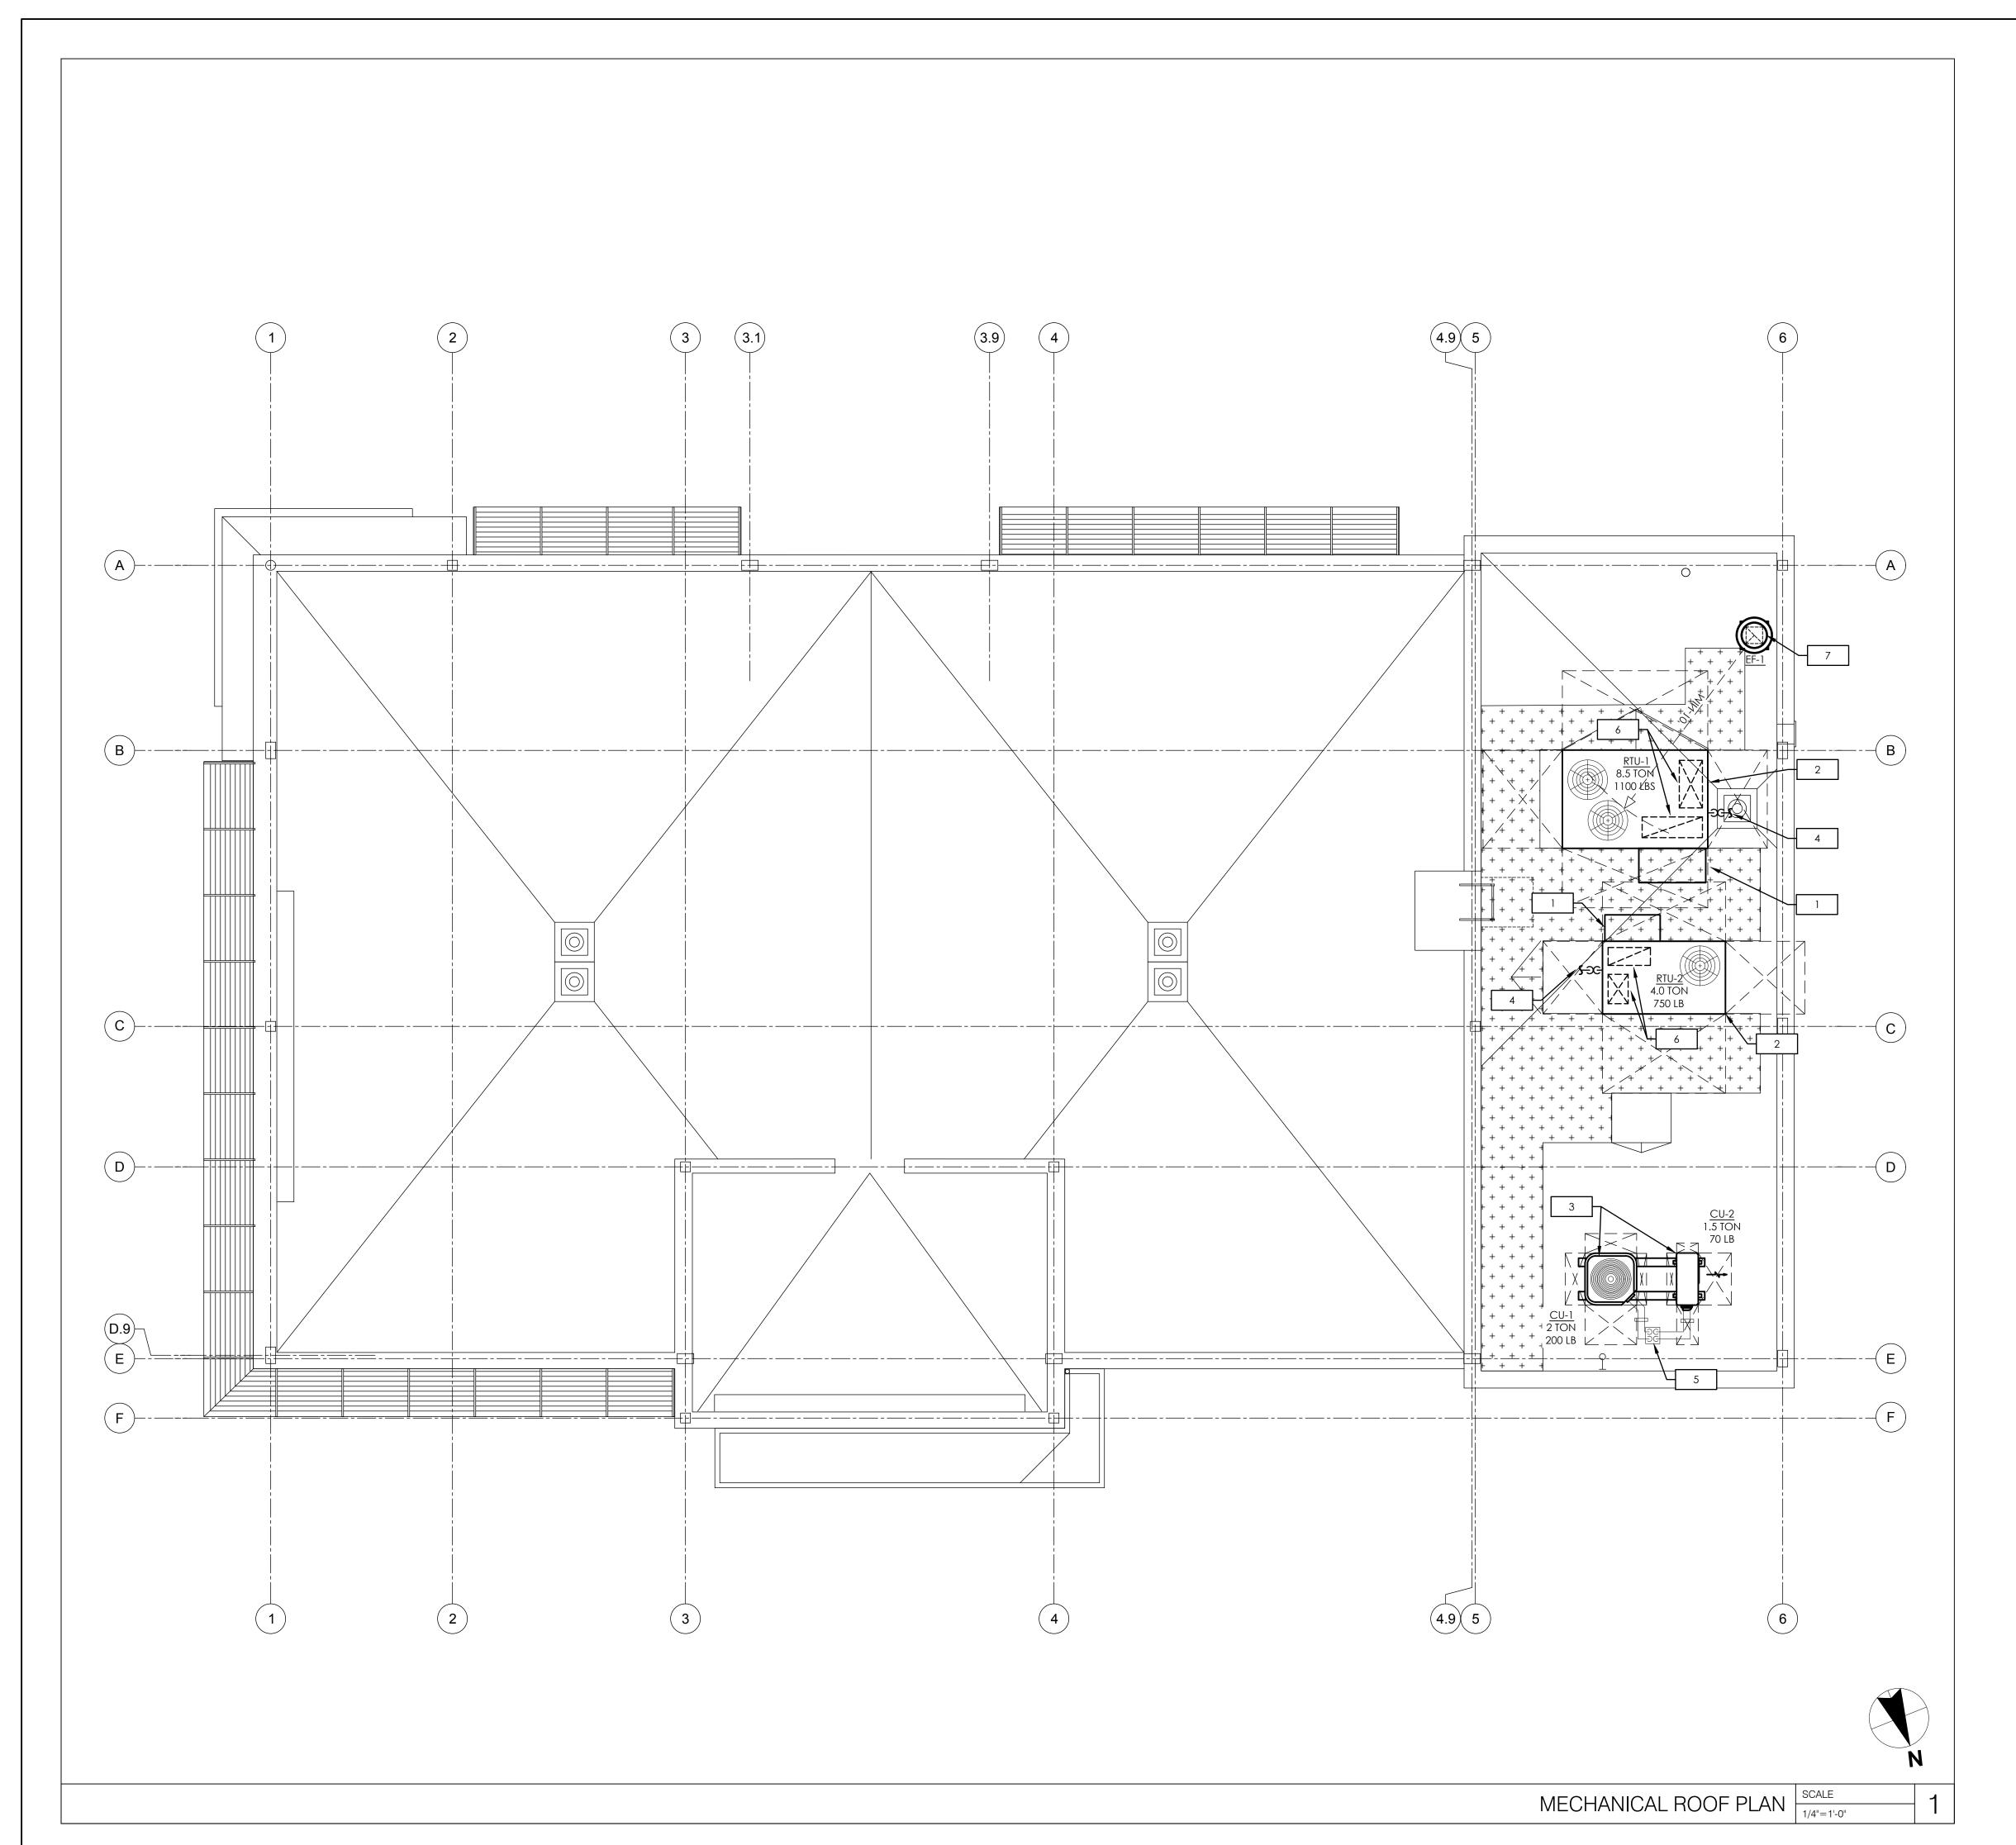

MECHANICAL NOTES:

- MODULATING MOTORIZED OUTSIDE AIR DAMPER, DAMPER SHALL BE SET FOR OUTSIDE AIR QUANTITIES INDICATED IN VENTILATION SCHEDULE AND ROOFTOP A/C UNIT SCHEDULE ON M2.0.
- NEW ROOF MOUNTED A/C UNIT WITH MANUFACTURER'S ROOF CURB. FURNISH AND INSTALL TEMPERATURE CONTROL WIRING FROM THE UNIT TO THE THERMOSTAT OR OTHER CONTROL DEVICES. PRIOR TO TURNOVER ALL UNITS SHALL HAVE ALL FILTERS REPLACED, COILS CLEANED, AND CONDENSER FINS COMBED STRAIGHT.
- PROPOSED LOCATION FOR SPLIT A/C SYSTEM REMOTE ROOF MOUNTED CONDENSING UNITS AND REFRIGERATION SUPPORT SYSTEM. PROVIDE A/C SUPPORT STAND. REFER TO DETAIL ON SHEET M3.0 FOR MORE INFORMATION.
- 1" CONDENSATE DRAIN LINE. ROUTE TO NEAREST PRIMARY ROOF DRAIN AND TERMINATE WITH A MINIMUM 2" AIR GAP.
- REFRIGERATION LIQUID AND SUCTION LINES FROM ROOF MOUNTED CONDENSING UNITS, DOWN THRU ROOF TO ASSOCIATED EVAPORATOR COIL. PROVIDE WITH PIPE PORTAL AND 3/4" INSULATION ON REFRIGERANT PIPING. ALL EXPOSED EXTERIOR PIPE INSULATION TO RECEIVE ULTRAVIOLET RESISTANT PVC JACKET.
- SUPPLY AND RETURN AIR DUCTWORK DOWN THROUGH ROOF. ROUTE THROUGH ROOF JOISTS TO ABOVE CEILING SPACE. COORDINATE PENETRATIONS WITH STRUCTURAL BUILDING CONDITIONS AND ALL OTHER TRADES, TRANSITION AS REQUIRED. SEE SHEET M1.0 FOR CONTINUATION. PROVIDE SUPPLY AND RETURN AIR DUCT MAINS WITH MINIMUM 1" THICK DUCT LINER FOR THE FIRST 10'-0" FROM UNIT.
- ROOF MOUNTED EXHAUST FAN EF-1. MAINTAIN A MINIMUM 10'-0" FROM ANY OUTSIDE AIR INTAKE OPENING. COORDINATE LOCATION WITH STRUCTURAL BUILDING CONDITIONS.

	PIPE INS	ULAT	ION	1				
FINAL DESIGN OPERATING	INSULATION COND	UCTIVITY	NOMINAL PIPE SIZE (INCH)					
TEMPERATURE RANGE	CONDUCTIVITY	MEAN TEMP.	<1	1-1 1/2	1 1/2 TO 4			
(°F)	BTU in/(h ft2 x °F)	RATING	THICKNESS (IN)					
40-60	0.21-0.27	75	0.5	0.5	1.0			
<40	0.20-0.26	50	0.5	1.0	1.0			

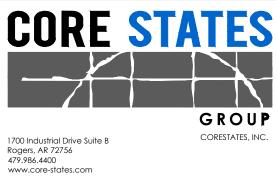

ENGINEER OF RECORD



THESE DRAWINGS ARE NOT COMPLETE WITHOUT THE SEPARATE TYPE WRITTEN SPECIFICATIONS MANUAL WHICH ARE PART OF THE CONTRACT DOCUMENTS.

ISSUE DATE DESCRIPTION 2020.12.21 PERMIT SET

PROJECT INFORMATION

PROJECT NO: JPM.27135.001 PROTOTYPE:

M.BATDORF DRAWN BY: CHECKED BY: SE_1.00 SHEET TITLE

> MECHANICAL **ROOF PLAN**

SHEET NUMBER

M1.1

			DIFF	USER, C	SRILLE, A	AND REC	SISTER SCHEDULE	
TAG	LOCATION	TYPE	MATERIAL	PATTERN	FACE SIZE	MANUFACTURER & MODEL NO.	GENERAL	REMARKS
A	CEILING	SUPPLY	ALUMINUM	4-WAY	24x24	TITUS OMNI-AA-NT	LAY-IN W/ DAMPER	1,2,3,4,9
B	CEILING	RETURN/ EXHAUST	ALUMINUM	-	24x24	TITUS 350FL	LAY-IN, OBD AG-15	1,2,3,6
(C)	CEILING	EXHAUST	ALUMINUM	-	12x12	TITUS 350FL	DUCT MOUNTED	1,2,3,6
D	CEILING	SUPPLY	ALUMINUM	HIGH-THROW	4"W-36"L	TITUS FL-TZ-DF	36" LONG PLENUM ON 1-SLOT LINEAR DIFFUSER WITH 1" SLOT WIDTH. SEE PLAN FOR TOTAL LENGTH.	1,2,3,5,8,9,10
E	CEILING	RETURN	ALUMINUM	HIGH-THROW	4"W-48"L	TITUS FL-TZ-DF	48" LONG PLENUM/HOOD ON 1-SLOT LINEAR DIFFUSER WITH 1" SLOT WIDTH. SEE PLAN FOR TOTAL LENGTH.	1,2,3,7,8,10
F	CEILING	SUPPLY	ALUMINUM	JET-THROW	4"W-48"L	TITUS FL-10	48" LONG PLENUM ON 1-SLOT LINEAR DIFFUSER WITH 1" SLOT WIDTH. SEE PLAN FOR TOTAL LENGTH.	1,2,3,5,9,13
G	CEILING	RETURN	ALUMINUM	JET-THROW	4"W-48"L	TITUS FL-10	48" LONG PLENUM/HOOD ON 1-SLOT LINEAR DIFFUSER WITH 1" SLOT WIDTH. SEE PLAN FOR TOTAL LENGTH.	1,2,3,7,13
H	CEILING	SUPPLY	ALUMINUM	HIGH-THROW	4"W-48"L	TITUS FL-10	48" LONG PLENUM ON 1-SLOT LINEAR DIFFUSER WIDTH 1" SLOT WIDTH, SEE PLANS FOR TOTAL LENGTH.	1,2,3,5,9,10,11
	CEILING	RETURN	ALUMINUM	HIGH-THROW	4"W-48"L	TITUS FL-10	48" LONG PLENUM/HOOD ON 1-SLOT LINEAR DIFFUSER WIDTH 1" SLOT WIDTH. SEE PLANS FOR TOTAL LENGTH.	1,2,3,7,10,11
J	CEILING	SUPPLY	ALUMINUM	HIGH-THROW	6"W-48"L	TITUS FL-25	48" LONG PLENUM ON 1-SLOT LINEAR DIFFUSER WITH 2.5" SLOT WIDTH. SEE PLAN FOR TOTAL LENGTH.	1,2,3,5,9,13
K	CEILING	RETURN	ALUMINUM	HIGH-THROW	6W-48"L	TITUS FL-25	48" LONG PLENUM/HOOD ON 1-SLOT LINEAR DIFFUSER WITH 2.5" SLOT WIDTH. SEE PLAN FOR TOTAL LENGTH.	1,2,3,7,13
L	CEILING	SUPPLY	ALUMINUM	HIGH-THROW	6W-24"L	TITUS FL-25	24" LONG PLENUM ON 1-SLOT LINEAR DIFFUSER WITH 2.5" SLOT WIDTH. SEE PLAN FOR TOTAL LENGTH.	1,2,3,5,9,13
M	CEILING	RETURN	ALUMINUM	HIGH-THROW	6"W-24"L	TITUS FL-25	24" LONG PLENUM/HOOD ON 1-SLOT LINEAR DIFFUSER WITH 2.5" SLOT WIDTH. SEE PLAN FOR TOTAL LENGTH.	1,2,3,7,13
N	CEILING	SUPPLY	ALUMINUM	-	4"DIA. OPENING	AIR CONCEPTS ANR-04	SURFACE MOUNT AIR NOZZLE DIFFUSER WITH CORE	1,2,3,9,12
(o)	WALL	TRANSFER	ALUMINUM	-	12"W-8"H	TITUS 350FL	WALL MOUNTED TRANSFER GRILLE	2,3

REMARKS:

- COORDINATE WITH LIGHTS FOR EXACT LOCATIONS OF ALL AIR DEVICES.
- COORDINATE FRAME STYLES WITH CEILING OR WALL SYSTEM.
- N.C. VALUES FOR DIFFUSERS, GRILLES AND REGISTERS SHALL NOT EXCEED 30, WITH A ROOM ABSORPTION RATE OF 10db.
- PROVIDE BACK SIDE OF SUPPLY AIR DEVICES WITH FACTORY INSTALLED R-6 INSULATION BLANKET.
- PROVIDE WITH TITUS INSULATED PLENUM, MODEL NO. FBPI, FOR LINEAR SUPPLY DIFFUSERS. ALL LAY-IN RETURN GRILLES SHALL BE FULL-FACE AND PROVIDED WITH MAXIMUM NECK SIZE. CONTRACTOR TO THEN TRANSITION MAXIMUM
- NECK SIZE TO RETURN DUCT SIZE INDICATED ON PLANS. PROVIDE WITH TITUS INSULATED RETURN HOOD/LIGHT SHIELD MODEL NO. FBRI ON ENTIRE LENGTH OF DIFFUSER.
- 8. PROVIDE WITH DF BORDER AND HANGER CLIPS.
- PROVIDE DAMPER AT TAKE-OFF TO DEVICE
- 10. PROVIDE WITH TITUS STRAIGHT END BOARDER AND TITUS END CAPS AT THE END OF ALL RUNS. 11. PROVIDE WITH BORDER TYPE 66 AND ASSOCIATED WC4, SS1, UHC CLIPS, AND MITERED CORNERS.
- 12. PROVIDE WITH COUNTER SUNK SCREW HOLES.
- 13. PROVIDE WITH BORDER TYPE 16 WITH SC1 AND UHC HANGER CLIPS.

				FAN	SCH	HEDU	LE						
					ESP				ELECTR	RICAL		WEIGHT	
TAG	SERVICE	LOCATION	CFM	MANUF MODEL	(W.C)	DRIVE	TYPE	HP	V.	Ø	Hz	(LBS)	REMARKS
EF-1	EXHAUST	ROOF	375	GREENHECK- G-090-VG	0.375	DIRECT	CENT.	1/10	115	1	60	22	1-4
EF-2	EXHAUST	DATA ROOM	200	GREENHECK- SP-B200	0.15	DIRECT	CENT.	1/4	115	1	60	17	2,5,6,7
1.	A. BD-10 B. NEMA C. 12" ROPROVIDE WARK BALA FOR EXHAL EACH RESTI LOUNGE. R PROVIDE W	A 1 DISCON OOF CURB /ITH THERM/ ARIABLE SP ANCED POS JST FAN CO ROOM, ON EFER TO ELE /ITH LINE VC /ITH INTEGR	BACKE INECT S AL OVE EED CO SITION O NTROL, E OCCI ECTRIC, DLTAGE AL BAC	IG: DRAFT DAMPER SWITCH MOUNTED ON: RLOAD PROTECTION DNTROLLER FOR ALL DIF DN CONTROLLER. PROVIDE 4-WAY CON UPANCY SENSOR IN TH AL DRAWINGS FOR EXH THERMOSTAT AND ATT SKDRAFT DAMPER. PLATION KIT AND MOUN	RECT DRI TROL CIF E JANITC HAUST FA TACH DIF	VE FANS. RCUIT BY CORS CLOSE IN CONTR RECTLY TO	T & B CC DNE OCC ET, AND (OL DIAC	ONTRAC CUPANO ONE TIM	CY SEN	ISOR I THE			

			C	Ondensing	UN	IIT S	CH	HEDU	JLE			
			COOLING CAPACITY				ELECTR	ICAL		WEIGHT	AHRI RATING	
TAG	SERVICE	LOCATION	(TONS)	MANUF MODEL	V.	Ø	Hz	МСА	МОСР	(LBS)	(EER/SEER)	REMARKS
CU-1	FCU-1	ROOF	2.0	CARRIER - 24ABC624A003	208	1	60	17	30	200	13.0/16.0	1,2
CU-2	FCU-2	ROOF	1.5	CARRIER- 38MHRC18A	208	1	60	15	20	70	10.5/17.0	1,2
REMA	RKS:											

٠	
	PROVIDE THERMAL OVERLOAD PROTECTION.
	DDOLUDE HOURD LIVE CDECLALTIES IN COLUDINO SHITED DDIED CLOUT

١.	TROVIDE MERIVINE OVEREOND FROTECTION.
2.	PROVIDE LIQUID LINE SPECIALTIES INCLUDING FILTER DRIER, SIGHT GLASS, TXV, SOLENOID
	VALVE, IF NOT FACTORY-INSTALLED.

				VEN ⁻	TILATION	AIR SCH	HEDULE			
ZONE	ROOM	OCCUPANCY	AREA (SQ. FT.)	NUMBER OF OCCUPANTS	PEOPLE OUTDOOR AIRFLOW RATE (CFM/ OCC.)	AREA OUTDOOR AIRFLOW RATE (CFM/SQ, FT.)	REQUIRED OUTDOOR AIRFLOW RATE (CFM)	PROVIDED OUTSIDE AIRFLOW RATE (CFM)	SYSTEM OUTDOOR AIRFLOW RATE (CFM)	PROVIDED EXHAUST AIRFLOW RATE (CFM)
	120 LOBBY/ 119 LIVING ROOM	LOBBIES	877	9	5	0.06	122	125		-
	121 DRT	LOBBIES	222	0	5	0.06	17	20		-
	101 PC\$ 1	OFFICE SPACE	103	3	5	0.06	26	30		
	102 PCS 2	OFFICE SPACE	94	3	5	0.06	26	30		
RTU-1	103 BOOTH	OFFICE SPACE	38	3	5	0.06	22	25	360	-
	104 BOOTH	OFFICE SPACE	38	3	5	0.06	22	25		-
	105 BOOTH	OFFICE SPACE	38	3	5	0.06	22	25		-
	106 CONFERENCE	OFFICE SPACE	118	6	5	0.06	46	50		-
	107 PCS 7	OFFICE SPACE	93	3	5	0.06	26	30		-
	108 PCS 8	OFFICE SPACE	90	3	5	0.06	26	30		-
	109 PRINT/FILE	OFFICE SPACE	94	0	5	0.06	7	10		-
	110 UNISEX	TOILET ROOM	65	1	0	0	0	0		75
	111 UNISEX	TOILET ROOM	65	1	0	0	0	0		75
	112 CORRIDOR	CORRIDOR	88	0	5	0.06	7	10		-
RTU-2	113 LOUNGE	OFFICE SPACE	218	5	5	0.06	48	50	170	150
	114 JANITOR CLOSET	UNOCCUPIED SPACE	27	0	0	0	0	0		75
	116 CASH	OFFICE SPACE	56	1	5	0.06	10	15		
	117 LTOS	OFFICE SPACE	280	1	5	0.06	27	30		
	118 MANUAL TRANSACTION	OFFICE SPACE	102	2	5	0.06	20	25		
FCU-1	100 TRANSACTION VESTIBULE	UNOCCUPIED SPACE	192	0	0	0	0	0	-	-
FCU-2	115 DATA ROOM	UNOCCUPIED SPACE	67	0	0	0	0	0	-	-
						TOTALS	472	530	530	375

		ER CONDITION				°F W.B.		R	OOF T	OP A	IR C	DNC	ITIC	INC	NC	JU 6	VITS						
					COOLIN	IG CAPACITY	HEATING	CAPACITY	- HEATING						ELECTR	RICAL							
TAG	SERVICE	TYPE	CFM	TONS	TOTAL (MBH)	SENSIBLE (MBH)	INPUT (MBH)	OUTPUT (MBH)	EFFICIENCY (%)		ESP. (IN W.C.)	IFM TYPE	V.	Ø	Hz	MCA	МОСР	WEIGHT (LBS)	HEIGHT (IN)	CARRIER MODEL	AHRI RATING (EER/SEER/IEER)	REF/ CHARGE	REMARKS
RTU-1	SEE PLANS	ROOF TOP	3,400	8.5	103.6	81.0	224	184	82	360	1.5	HIGH	208	3	60	50	60	1,323	49-3/8"	48HCFD09	12.0/-/13.8	R-410A/ 15 LB - 2 OZ (2)	1-13
RTU-2	SEE PLANS	ROOF TOP	1,600	4.0	50.0	37.1	150	120	80	170	1.0	MED	208	3	60	30	40	860	33-3/8"	48GCFN05	12.0/16.0/-	R-410A/ 14 LB - 8 OZ	1-13

<u>REMARKS</u>

- . PROVIDE WITH 14" TALL ROOF CURB.
- 2. PROVIDE WITH ELECTROMECHANICAL CONTROLS. DAINTREE TO PROVIDE WI-FI COMMUNICATING THERMOSTATS AND ASSOCIATED SENSORS. 3. PROVIDE THRU-THE-BASE SINGLE POINT POWER CONNECTION WITH FACTORY MOUNTED STARTER. DISCONNECT TO BE PROVIDED BY DIVISION 26.
- 4. PROVIDE FACTORY-INSTALLED POWERED CONVENIENCE OUTLET.
- 5. PROVIDE DUCT MOUNTED CO2 SENSORS AS INDICATED ON PLAN.
- 6. PROVIDE 5-YEAR COMPRESSOR AND HEAT EXCHANGER WARRANTY. 7. UNIT SHALL BE U.L TESTED AND CERTIFIED IN ACCORDANCE WITH ANSI Z21.47.
- 8. PROVIDE FILTERS THAT BEAR THE LABEL OF AN APPROVED AGENCY.
- 9. PROVIDE CONDENSATE PIPE DRAIN PER MANUFACTURER'S RECOMMENDATIONS. 10. PROVIDE CONDENSER COIL HAIL GUARD GRILLE.
- 11. PROVIDE WATER-LEVEL MONITORING DEVICE (FLOAT SWITCH). DEVICE SHALL BE INSTALLED INSIDE THE PRIMARY DRAIN PAN AND SHALL BE INTERLOCKED TO
- SHUT DOWN UNIT. EXTERNALLY INSTALLED DEVICES AND DEVICES INSTALLED IN THE DRAIN LINE SHALL NOT BE PERMITTED.
- 12. PROVIDE WITH STANDARD TEMPERATURE LOW LEAK ECONOMIZER WITH BAROMETRIC RELIEF. ECONOMIZER CONTROLLER SHALL HAVE ON-BOARD FAULT DETECTION AND DIAGNOSTIC CAPABILITY.
- 13. PROVIDE EQUIPMENT MANUFACTURERS START-UP SERVICE.

CARRIER NATIONAL ACCOUNT NOTE:

JPMC HAS A CARRIER CORPORATION NATIONAL ACCOUNT. CONTACT CARRIER NATIONAL ACCOUNTS 315.432.7634 FOR QUOTATION AND TO ARRANGE PURCHASE AND DELIVERY.

					FAN	COIL	UNIT SC	CHE	DU	LE					
					COOLING	G COIL	HEATING COIL			ELECTR	ICAL				
TAG	SERVICE	LOCATION	SUPPLY AIR (CFM)	ESP (IN. W.C.)	TOTAL CAPACITY (MBH)	SENSIBLE CAPACITY (MBH)	CAPACITY (kW)	V.	Ø	Hz	MCA	МОСР	WEIGHT (LBS)	MANUF MODEL	remarks
FCU-1	VESTIBULE	CEILING	800	0.35	24.0	14.0	5.0	208	1	60	26	30	122	CARRIER - FX4DNF025	1,2,3,5,7,8,9
FCU-2	DATA ROOM	WALL	500	-	18.0	13.2	-	208	1	60	-	-	32	CARRIER - 40MHHC18	1,2,3,4,5,6,7

REMARKS:

- PROVIDE THERMAL OVERLOAD PROTECTION.
- PROVIDE LIQUID LINE SPECIALTIES INCLUDING FILTER DRIER, SIGHT GLASS, TXV, SOLENOID VALVE, IF NOT FACTORY-INSTALLED. INSTALL IN STRICT ACCORDANCE WITH MANUFACTURER'S INSTALLATION INSTRUCTIONS.
- 4. UNIT TO BE CONTROLLED VIA DAINTREE THERMOSTAT AND ASSOCIATED TEMPERATURE SENSOR. PROVIDE WITH 24V INTERFACE KIT FOR DAINTREE INTEGRATION.
- 5. PROVIDE REFRIGERANT PIPING SIZED PER MANUFACTURER'S RECOMMENDATIONS. "ACR" COPPER ONLY. INDOOR UNIT ELECTRICALLY FED FROM OUTDOOR UNIT.
- PROVIDE WITH CONDENSATE PUMP.
- 8. FAN COIL UNIT TO BE INTERLOCKED WITH BUILDING MANAGEMENT SYSTEM (BMS) BY DAINTREE. FAN COIL UNIT TO BE CONNECTED TO DAINTREE THERMOSTAT. PROVIDE WATER-LEVEL MONITORING DEVICE (FLOAT SWITCH). DEVICE SHALL BE INSTALLED INSIDE THE PRIMARY DRAIN PAN AND MOUNT IN AUXILIARY DRAIN PORT. DEVICE SHALL BE INTERLOCKED TO SHUT DOWN THE UNIT. EXTERNALLY INSTALLED DEVICES AND DEVICES INSTALLED IN THE DRAIN LINE ARE NOT PERMITTED.

SEQUENCE OF OPERATIONS

OCCUPIED AND UNOCCUPIED OPERATION

THE TEMPERATURE CONTROL SYSTEM SHALL BE SET FOR OCCUPIED AND UNOCCUPIED HOURS. DURING THE OCCUPIED HOURS, THE SPACE SHALL BE MAINTAINED AT 72°F (ADJ.) IN THE COOLING MODE AND 70°F (ADJ.) IN THE HEATING MODE. DURING UNOCCUPIED PERIODS, THE SPACE TEMPERATURE SHALL MAINTAIN 75°F (ADJ.) IN THE COOLING MODE AND 65°F (ADJ.) IN THE HEATING

RTU-1 AND RTU-2:

UPON RECEIVING A SIGNAL FROM THE TEMPERATURE CONTROL SYSTEM FOR OCCUPIED HOURS, THE RTU FAN SHALL ENERGIZE AND REMAIN ON DURING OCCUPIED HOURS. THE OUTSIDE AIR DAMPER SHALL REMAIN CLOSED FOR MORNING WARM-UP UNTIL THE OCCUPIED HOURS ARE REACHED, AND THEN WILL OPEN TO ITS MINIMUM POSITION.

THE TEMPERATURE CONTROL SYSTEM SHALL MAINTAIN THE COOLING AND HEATING SETPOINTS. UPON SENSING AN AVERAGE TEMPERATURE RISE OF 0.5°F ABOVE COOLING SETPOINT AND WHEN THE OUTDOOR AIR TEMPERATURE IS BELOW 55°F, THE MODULATING DAMPER WILL MODULATE THE OUTDOOR AIR DAMPER AND RETURN AIR DAMPER AND THE RELIEF DAMPER WILL BE OPENED.

THE CO2 SENSORS SHALL MONITOR THE AMOUNT OF CO2 IN EACH REGULARLY OCCUPIED SPACE. WHEN THE AMOUNT OF CO2 REACHES A PRESET LIMIT, THE OUTSIDE AIR DAMPER SHALL OPEN TO ITS MINIMUM POSITION. THE DAMPER SHALL MODULATE OPEN IN STEPS AS THE AMOUNT OF CO2 IN THE SPACE INCREASES UNTIL THE AMOUNT OF OUTSIDE AIR HAS REACHED ITS MAXIMUM. THE OUTSIDE AIR DAMPER SHALL STAY AT ITS MAXIMUM UNTIL THE CO2 SENSOR REGISTERS A DROP IN CO2. THE OUTSIDE AIR DAMPER SHALL BE CLOSED DURING UNOCCUPIED HOURS. IF CO2 LEVELS DO NOT DROP, AN ALARM SHALL SOUND.

24-HOUR VESTIBULE (FCU-1):

THE TEMPERATURE CONTROL SYSTEM SHALL BE SET FOR THE SPACE TO BE MAINTAINED AT 72°F (ADJ.) IN THE COOLING MODE AND 70°F (ADJ.) IN THE HEATING MODE, 24 HOURS A DAY.

DAINTREE HVAC CONTROLS

ENTIRE MECHANICAL SYSTEM SHALL BE INTERLOCKED WITH BUILDING MANAGEMENT SYSTEM (BMS) BY DAINTREE. CONTRACTOR TO INSTALL WIRELESS TEMPERATURE SENSORS SERVING CORRESPONDING UNITS IN LOCATIONS SHOWN ON PLANS. CONTRACTOR TO INSTALL THERMOSTATS SERVING CORRESPONDING UNITS IN LOCATIONS SHOWN ON PLANS. CONTRACTOR TO ROUTE ALL LOW VOLTAGE WIRING FROM THERMOSTAT TO CORRESPONDING MECHANICAL UNIT.

ELECTRIC CONTRACTOR IS RESPONSIBLE FOR THE PURCHASE AND PROCUREMENT OF ALL DAINTREE COMPONENTS FOR A COMPLETE BMS. MECHANICAL CONTRACTOR TO COORDINATE ALL REQUIRED COMPONENTS AND PARTS WITH ELECTRICAL CONTRACTOR PRIOR TO PROCUREMENT TO ENSURE ONLY ONE ORDER IS PLACED.


- ALL WIRELESS ADAPTERS MUST BE PROVIDED WITH UNINTERRUPTED/UNSWITCH POWER. #WSA10
- WIRE SENSOR ADAPTERS REQUIRE 24V POWER. DURING INSTALLATION THE LAST 4 DIGITS OF THE IEEE ADDRESS FOR EACH WIRELESS COMPONENT MUST BE RECORDED ON THE SHOP DRAWING SET CORRESPONDING TO THE LOCATION OF THE
- 3. FOR ANY SENSORS ATTACHED TO A WIRELESS SENSOR ADAPTER (#WSA10) THE LAST 4 DIGITS OF THE IEEE ADDRESS FOR THE RESPECTIVE #WSA10 MUST BE RECORDED. THE SPECIFIC #WSA10 PORT
- ALSO BE RECORDED PER SENSOR.
- 4. DURING WIRELESS ADAPTER INSTALLATION, FOLLOW THESE STEPS AS DEFINED IN THE DEVICE INSTALLATION GUIDE IN THE FOLLOWING ORDER:
- 4.1. CONFIRM WIRELESS ADAPTER DIP SWITCHES ARE SET CORRECTLY. 4.2. RESET ADAPTER (ALL ADAPTERS)
- 4.3. PERFORM PROPER TEST SUITE
- 5. INSTALLER MUST BECOME FAMILIAR WITH THE PUBLISHED INSTALLATION GUIDES FOR THE PRODUCTS IN THE PROJECT SCOPE.
- ELECTRICAL CONTRACTOR IS RESPONSIBLE FOR PROCUREMENT AND INSTALL OF DAINTREE AND RELATED COMPONENTS PERTAINING TO IT/DATA, LIGHTING, POWER AND HVAC.


CONTROL SCOPE COMMISSIONING:

PROPERLY, AND RESETTING DEVICES.

- CONTRACTOR IS RESPONSIBLE FOR CORRECT WIRING, TESTING, AND DOCUMENTATION OF ALL IEEE DEVICE ADDRESSES IN A FORMAT REQUIRED BY THE CONTROLS SUPPLIER. CONTRACTOR TO RESPONSIBLE FOR COORDINATING EFFORTS WITH THE CONTROLS PROVIDER TO
- SATISFY THE CONSTRUCTION TIMELINE. 3. CONTRACTOR IS RESPONSIBLE FOR PROVIDING FIELD LABOR ASSISTANCE TO FACILITATE THE COMMISSIONING EFFORT, INCLUDING BUT NOT LIMITED TO REPAIRING INCORRECT WIRING, LOCATING DEVICES WHERE THE ADDRESSES WERE NOT DOCUMENTED OR NOT LOCATED

TYPICAL MECHANICAL EQUIPMENT BMS SCHEMATIC - SINGLE ZONE (REFER TO MECHANICAL UNIT SCHEDULES FOR ADDITIONAL INFORMATION)

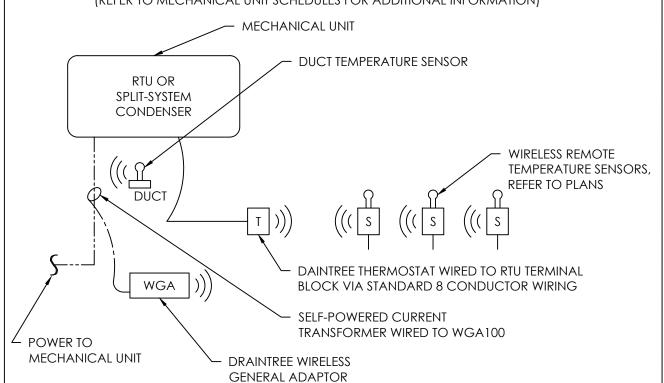

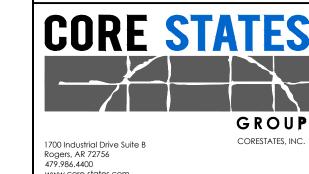

NGINEER OF RECORD



HESE DRAWINGS ARE NOT COMPLETE WITHOUT THE SEPARATE TYPE WRITTEN SPECIFICATIONS MANUAL

WHICH ARE PART OF THE CONTRACT DOCUMENTS.


JE	DATE	DESCRIPTION
-	2020.12.21	PERMIT SET


PROJECT INFORMATION PROJECT NO: JPM.27135.001 PROTOTYPE:


M.BATDORF DRAWN BY: CHECKED BY: VERSION: SE 1.00 SHEET TITLE


MECHANICAL


SHEET NUMBER

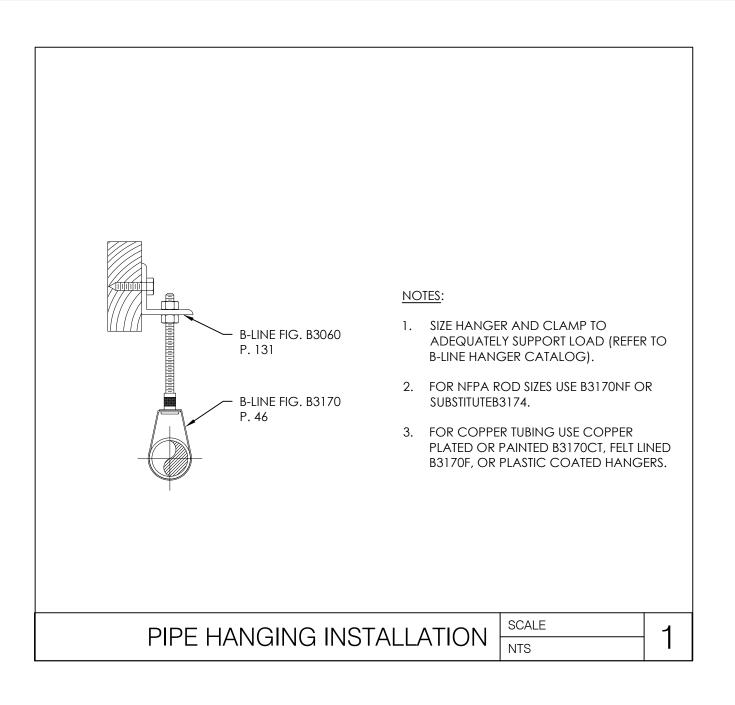


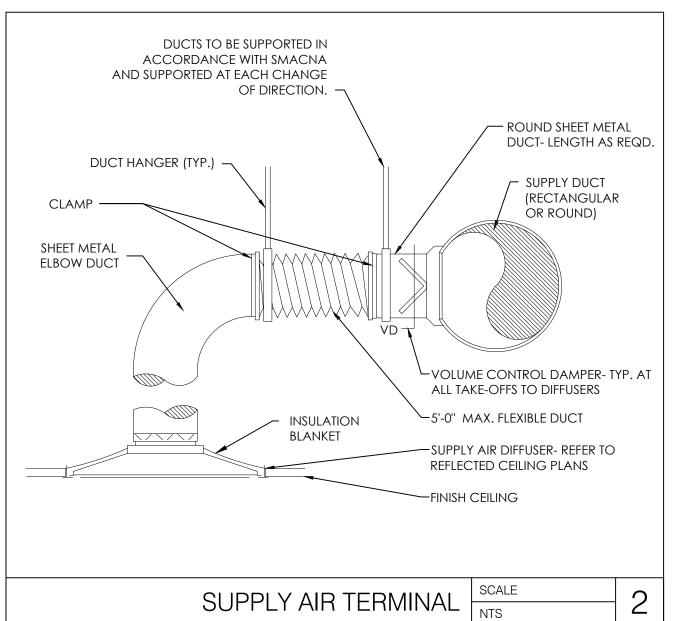


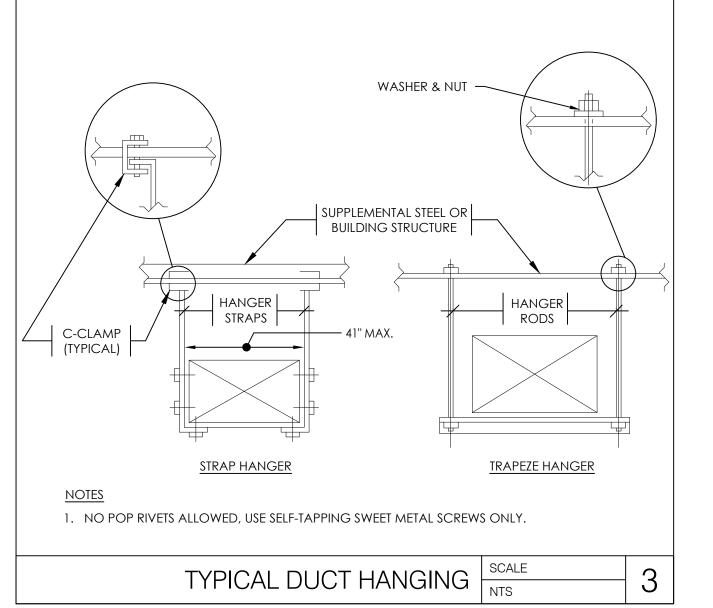


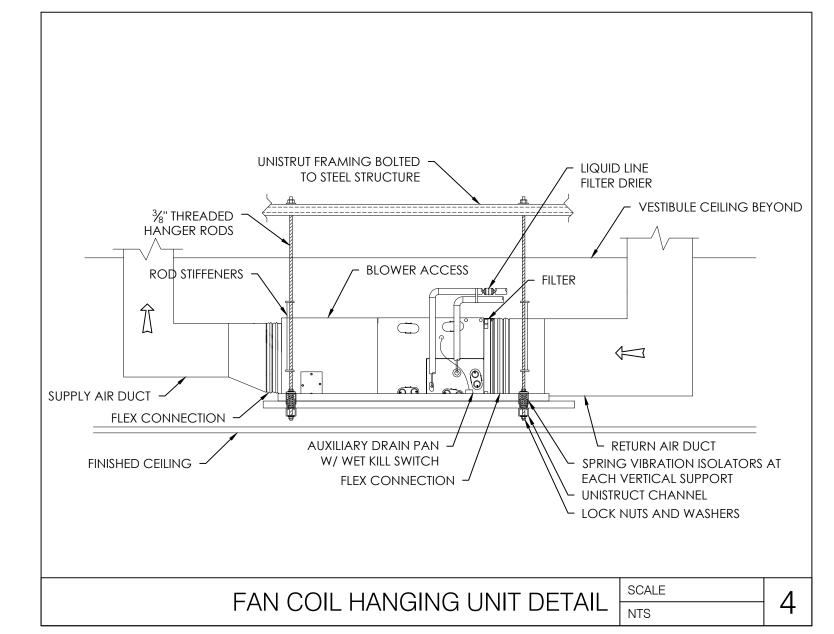


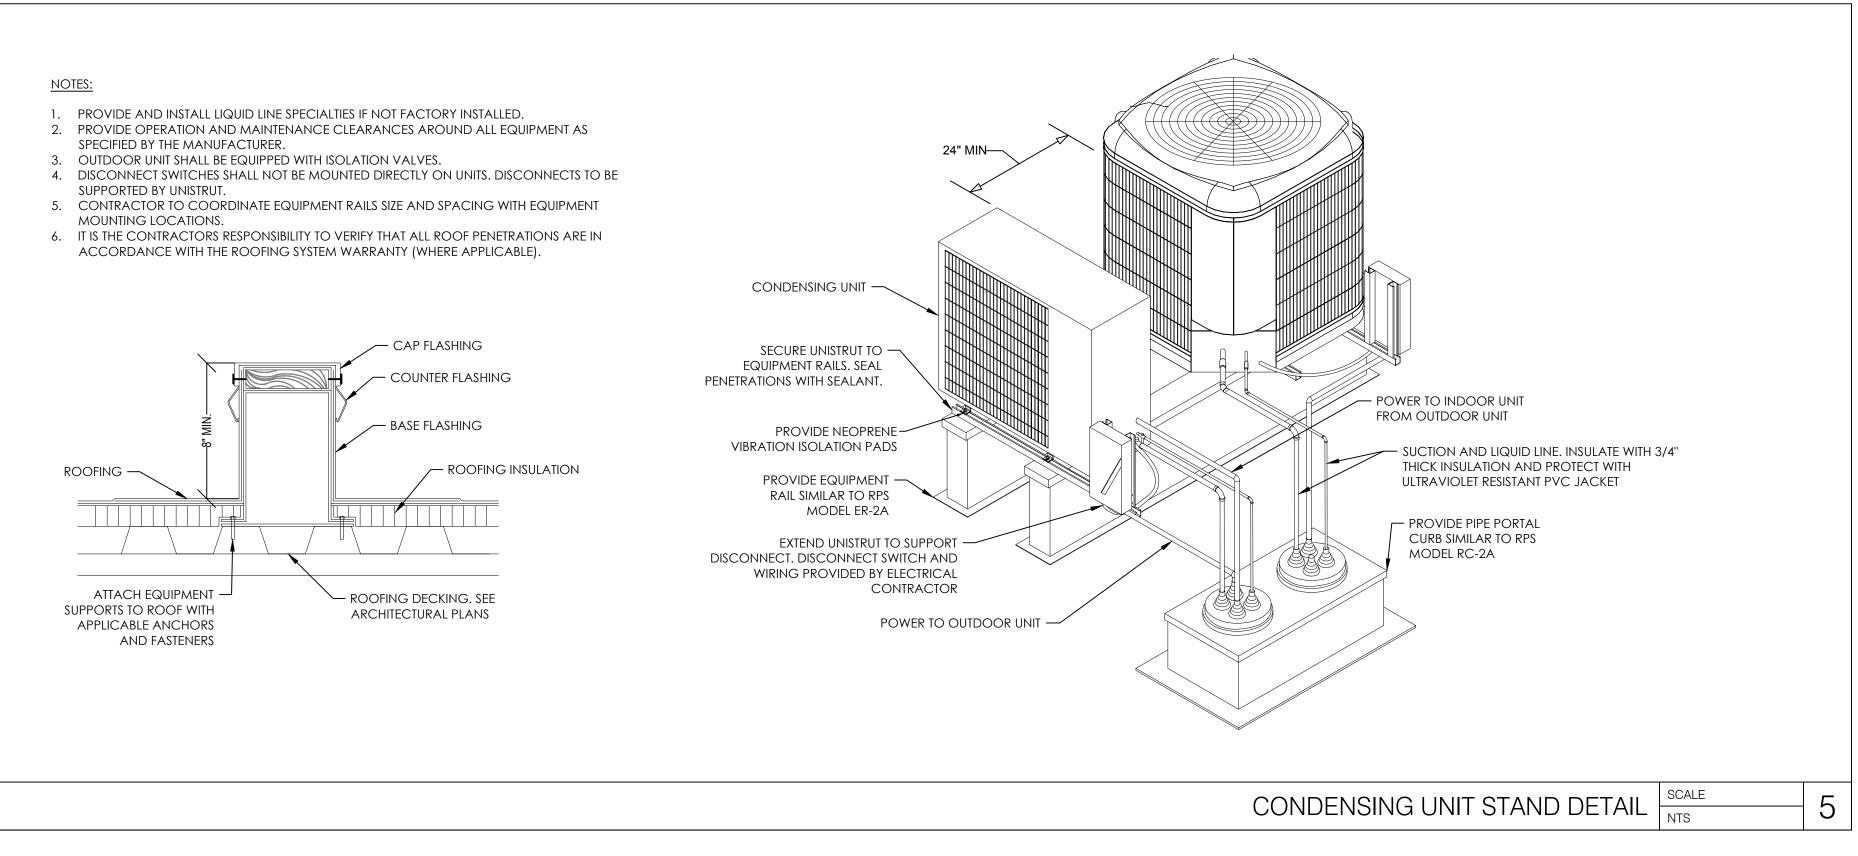


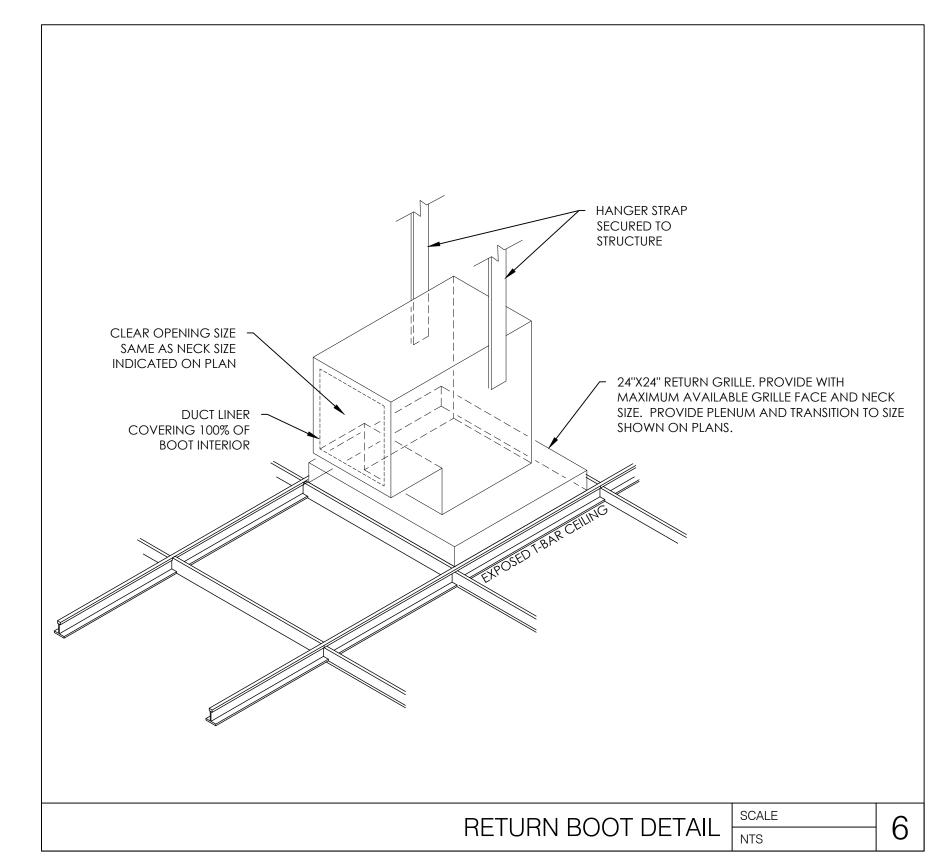

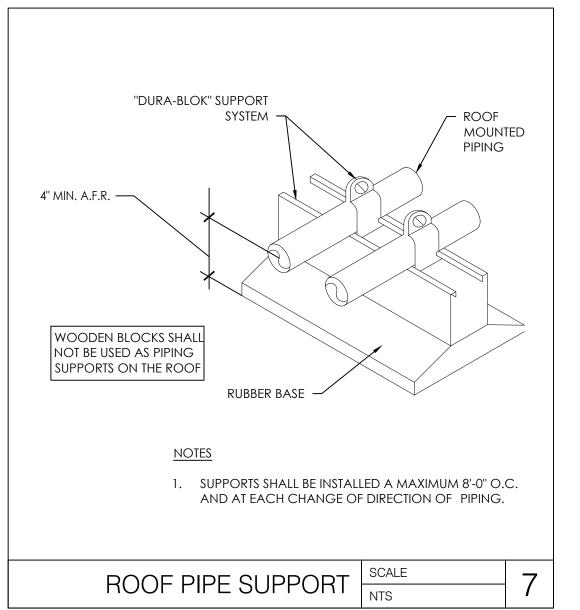


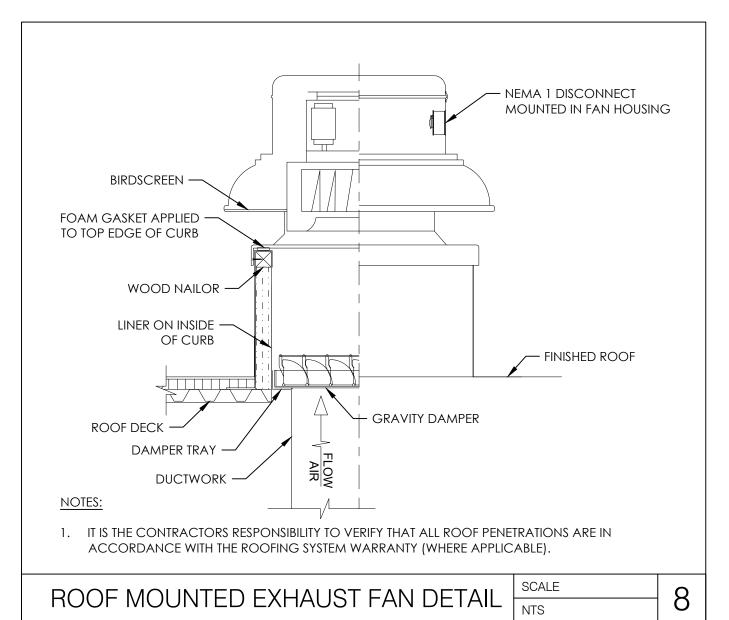

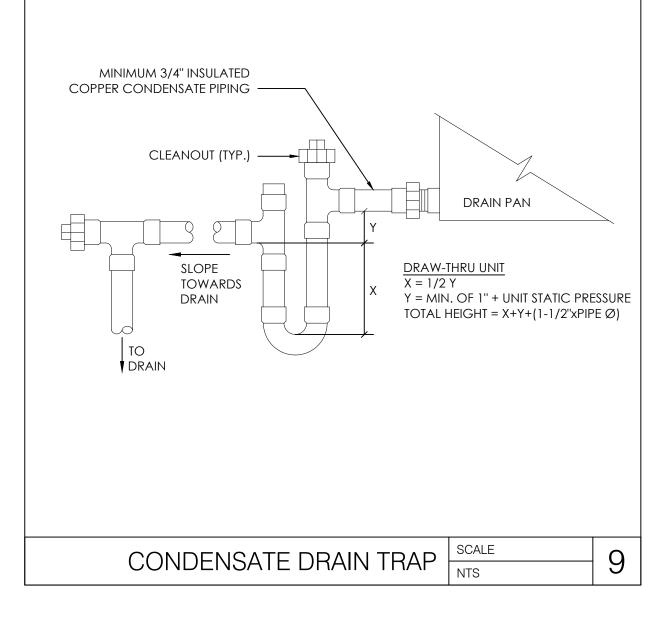

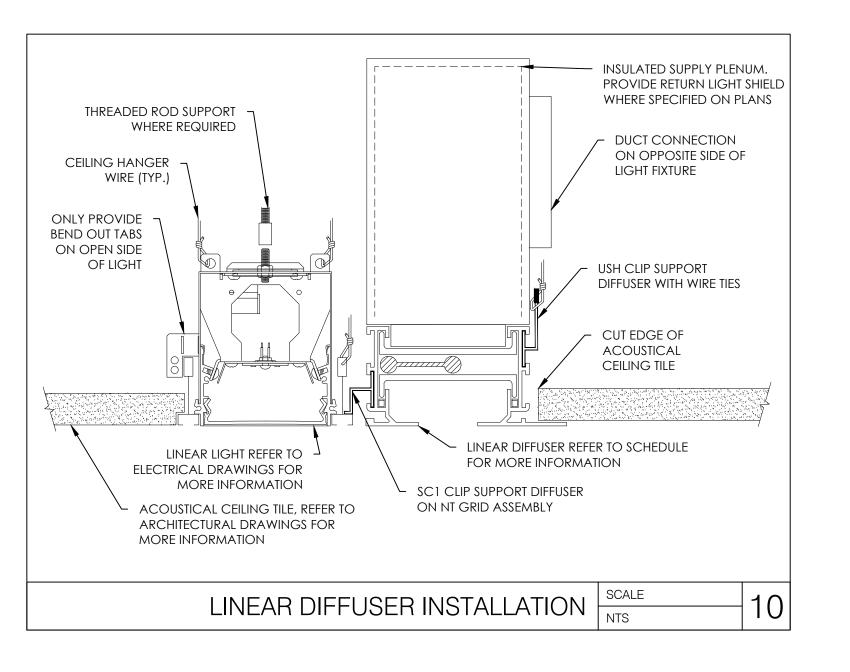



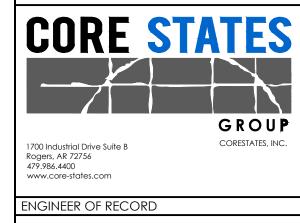

DAVID MICAH
LEIFFER
PE-2013011214

THESE DRAWINGS ARE NOT COMPLETE WITHOUT THE SEPARATE TYPE WRITTEN SPECIFICATIONS MANUAL WHICH ARE PART OF THE CONTRACT DOCUMENTS.

ISSUE	DATE	DESCRIPTION
-	2020.12.21	PERMIT SET
PRO.	JECT INFO	ORMATION
PRC	DJECT NO:	JPM.27135.001
DA	· — ·	
PRC	OTOTYPE:	20.2
DR/	AWN BY:	m.batdorf
СН	ECKED BY:	S.VAZ
VER	rsion:	SE_1.00
SHEET 1	TITLE	


MECHANICAL DETAILS


SHEET NUMBER

M3.0

PLU	JMBING FIXTURE SCHEDULE:				
MARK	ITEM: DESCRIPTION	COLD WATER	HOT WATER	WASTE	VENT
<u>P-1</u>	WATER CLOSET (PF-WC): KOHLER HIGHLINE MODEL# K-3519 OR 3519-RA TWO-PIECE FLOOR MOUNTED VITREOUS CHINA TOILET WITH ELONGATED BOWL, PRESSURE ASSISTED 1.0 GPF FLUSH, AND POLISHED CHROME TRIP LEVER. CONTRACTOR TO COORDINATE MODEL NUMBER TO POSITION FLUSH LEVER ON ADA ACCESSIBLE SIDE OF THE WATER CLOSET; SEAT: KOHLER MODEL #K-4670-CA SOLID ELONGATED PLASTIC OPEN FRONT LESS COVER; SUPPLIES: 3/8" X 12" CHROME PLATED FLEXIBLE SUPPLY WITH LOOSE KEY STOP.	1/2"	-	4"	2"
<u>P-2</u>	LAVATORY (PF-LAV): AMERICAN STANDARD LUCERNE MODEL# 0356.137 OR 0356.115 WALL MOUNTED 20-1/2" X 18-1/4" VITREOUS CHINA SINK WITH FRONT OVERFLOW, SELF DRAINING DECK, FAUCET LEDGE, AND HOLES FOR CONCEALED ARM SUPPORT. CONTRACTOR TO COORDINATE MODEL NUMBER TO POSITION EXTRA SOAP DISPENSER HOLE ON THE ADJACENT WALL-SIDE OF THE LAVATORY; FAUCET: OPTIMA# EAF-200-PLG-ISM-CP WITH PLUG ADAPTER POWER SUPPLY, INTEGRATED SIDE MIXER, POLISHED CHROME FINISH, .5 GPM AERATED SPRAY, AND INFRARED SENSOR; STRAINER: AMERICAN STANDARD 2411.015 1-1/4" POLISHED CHROME GRID DRAIN AND TAILPIECE; P-TRAP: 1-1/4" X 12" CHROME PLATED 17 GAUGE W/TAILPIECE AND CLEANOUT SUPPLIES: 3/8" X 12" CHROME PLATED FLEXIBLE SUPPLIES WITH LOOSE KEY STOPS; CARRIER: WATTS MODEL# TCA-411-D BACK TO BACK FLOOR MOUNTED CONCEALED LAVATORY CARRIER; PIPE COVERS: LAV GUARD MODEL# 102 E-Z WASTE AND SUPPLY COVERS; THERMOSTATIC MIXING VALVE (TMV): SYMMONS MODEL# 7-210-CK MOUNTED BELOW LAVATORY AND SET FOR A MAXIMUM MIXED TEMP OF 105°F.	1/2"	1/2"	2"	1-1/2"
<u>P-3</u>	LOUNGE SINK (PF-SINK): ELKAY MODEL# LRAD202255-MR2 SINGLE COMPARTMENT 19-1/2" X 22" X 5-1/2" DEEP 18 GAUGE STAINLESS STEEL; FAUCET: ELKAY MODEL# LK3000CR DECK MOUNTED FAUCET WITH REMOTE LEVER HANDLE, 8" SPOUT REACH, 2.2 GPM REGULATOR, AND CHROME FINISH; SUPPLIES: 3/8" X 12" CHROME PLATED FLEXIBLE SUPPLIES WITH WHEEL HANDLE STOP; STRAINER: ELKAY MODEL# LK99 CHROME PLATED STAINLESS STEEL STRAINER BASKET; P-TRAP: 1-1/2" PVC W/ CLEANOUT; THERMOSTATIC MIXING VALVE (TMV): SYMMONS #7-210-CK MOUNTED BELOW LAVATORY AND SET FOR A MAXIMUM MIXED TEMP OF 105°F.	1/2"	1/2"	2"	1-1/2"
<u>P-4</u>	MOP SINK (PF-MOP): MUSTEE MODEL# 63M FLOOR MOUNTED, FIBERGLASS SERVICE SINK; FAUCET: MUSTEE MODEL #63.600A DUAL HANDLE FAUCET WITH TOP REINFORCING BAR, PAIL HOOK, VACUUM BREAKER, THREADED SPOUT AND CHROME PLATED FINISH; ACCESSORIES: MUSTEE MODEL #65.700 HOSE & HOSE HOLDER AND MUSTEE MODEL #65.600 MOP HANGER. REFER TO ARCHITECTURAL ROOM ELEVATIONS FOR MOP SINK SIDE PANELS.	3/4"	3/4"	3"	2"
<u>P-5</u>	ELECTRIC WATER COOLER (PF-DF): ELKAY MODEL# EZSTL8WSSK BI-LEVEL WALL MOUNTED ADA COOLER WITH ALL STAINLESS STEEL FINISH, FRONT AND SIDE PUSHBAR, FLEXIBLE ANTI-MICROBIAL SAFETY BUBBLER, AND EZH20 BOTTLE FILLING STATION. BOTTLE FILLING STATION TO BE INSTALLED ON LOW SIDE OF WATER COOLER. SUPPLIES: 3/8" X 12" CHROME PLATED FLEXIBLE SUPPLIES WITH LOOSE KEY STOP; CARRIER: FLOOR MOUNTED IN WALL CARRIER MOUNTING SYSTEM.	1/2"	-	2"	1-1/2"
<u>P-6</u>	EXTERIOR WALL HYDRANT (PF-WHB): WOODFORD MODEL# B65-CH WITH STANDARD CHROME FINISH, AUTOMATIC ANTI-SIPHON VACCUM BREAKER, 3/4" CONNECTION, AND BRASS FACE WITH INTEGRAL VACUUM BREAKER. MOUNT 18" ABOVE GRADE.	3/4"	-	-	-
<u>P-7</u>	ROOFTOP HOSE BIBB (PF-RHB): WOODFORD MODEL# SRH-MS COMPLETE, COMMERCIAL ROOF HYDRANT WITH VACUUM BREAKER BACKFLOW PREVENTER, 3/4" CONNECTION	3/4"	-	-	-
RD1	ROOF DRAIN (PF-RD1): ZURN MODEL# ZC100-DP-VP 15" DIAMETER ROOF DRAIN WITH DURA-COATED CAST IRON BODY, BOTTOM OUTLET, TOP-SET DECK PLATE, VANDAL PROOF SECURED TOP, AND LOW SILHOUUETTE CAST IRON DOME. PROVIDE PERIMETER BLOCKING TO RAISE THE DECK PLATE TO THE ROOFING LEVEL.	-	-	SEE DRAWINGS	-
ORD	OVERFLOW ROOF DRAIN (PF-OD1): ZURN MODEL# ZC100-DP-VP-89 15" DIAMETER ROOF DRAIN WITH DURA-COATED CAST IRON BODY, BOTTOM OUTLET, 2" EXTERNAL WATER DAM, TOP-SET DECK PLATE, VANDAL PROOF SECURED TOP, AND LOW SILHOUUETTE CAST IRON DOME. PROVIDE PERIMETER BLOCKING TO RAISE THE DECK PLATE TO THE ROOFING LEVEL.	-	-	SEE DRAWINGS	-
DNZ	DOWNSPOUT NOZZLE (PF-DN1): ZURN MODEL# ZANB199-SS DOWNSPOUT NOZZLE. PROVIDE WITH NICKEL BRONZE BODY, REMOVABLE STAINLESS SCREEN, AND DECORATIVE WALL FLANGE.	-	-	SEE DRAWINGS	-
<u>DNB</u>	DOWNSPOUT SHOE: PIEDMONT MODEL# SG-2.5X3-12 CUSTOM DOWNSPOUT WITH 2.5" x 3" INLET, 3" OUTLET, 12" BODY LENGTH	-	-	SEE DRAWINGS	-
<u>FD</u>	FLOOR DRAIN (PF-FD): ZURN MODEL# ZN415S-Y FLOOR DRAIN, DURA-COATED CAST IRON BODY WITH BOTTOM OUTLET, ADJUSTABLE COLLAR, AND HEEL PROOF NICKEL BRONZE TOP. PROVIDE WITH SQUARE 5x5 STRAINER, SEDIMENT BUCKET, AND TRAP SEAL SIMILAR TO JAY R. SMITH 2692-04 (WHERE ACCEPTABLE BY LOCAL CODES).	-	-	SEE DRAWINGS	<u>-</u>
<u>GCO</u>	GRADE CLEANOUT (PF-GCO): ZURN MODEL# ZN1400 ADJUSTABLE CLEANOUT WITH DURA-COATED CAST IRON BODY, GAS AND WATERTIGHT ABS TAPERED THREAD PLUG, AND ROUND SCORIATED COVER. NOTE: LOCATION OF THIS CLEANOUT FOR TYPE OF DUTY REQUIRED FOR THE COVER.	-	-	SEE DRAWINGS	-
WCO	WALL CLEANOUT (PF-WCO): ZURN MODEL# Z1446 DURA-COATED CAST IRON BODY WITH GAS AND WATERTIGHT TAPERED THREAD PLUG, SMOOTH ROUND STAINLESS STEEL COVER, AND SECURING SCREW.	-	-	SEE DRAWINGS	-
FCO	FLOOR CLEANOUT (PF-FCO): ZURN MODEL# ZN1400 ADJUSTABLE FLOOR CLEANOUT WITH DURA-COATED CAST IRON BODY, GAS AND WATERTIGHT ABS TAPERED THREAD PLUG, AND ROUND SCORIATED COVER.	-	ı	SEE DRAWINGS	-
<u>EWH</u>	ELECTRIC WATER HEATER (PF-WH): A.O. SMITH MODEL# DEL-10 ENERGY SAVER, 18" DIA x 18" H, 10 GALLON LINED TANK, ONE 3000 WATT ELEMENT 208/1/60, 20 AMP BREAKER. PROVIDE WITH WALL SUPPORT BRACKET HOLDRITE MODEL# 40-SWHP-W. ELECTRICAL CONTRACTOR TO PROVIDE DAINTREE LEAK DETECTOR WITH REMOTE SPOT SENSOR ACCESSORY. MOUNT DETECTOR ON WALL AND MOUNT REMOTE SENSOR IN OVERFLOW PAN.	3/4"	3/4"	-	1
WHA	WATER HAMMER ARRESTORS: SIOUX CHIEF MODEL#660 SERIES PISTON TYPE TYPE L COPPER TUBE	-	-	-	-
<u>BFP</u>	BACKFLOW PREVENTER: WATTS MODEL# LF7C LEAD FREE DUAL CHECK VALVE FOR WATER DISPENSER AND COFFEE MAKER.	SEE DRAWINGS	-	-	-
RPZ-1	BUILDING REDUCED PRESSURE ZONE ASSEMBLY: WATTS MODEL# LF009M2QT LEAD FREE REDUCED PRESSURE ZONE ASSEMBLY WITH INTERNAL PRESSURE DIFFERENTIAL RELIEF VALVE, ISOLATION VALVES, TEST PORTS, AND AIR GAP DRAIN FITTING.	SEE DRAWINGS	-	-	-
RPZ-2	IRRIGATION REDUCED PRESSURE ZONE ASSEMBLY: WATTS MODEL# LF009M2QT LEAD FREE REDUCED PRESSURE ZONE ASSEMBLY WITH INTERNAL PRESSURE DIFFERENTIAL RELIEF VALVE, ISOLATION VALVES, TEST PORTS, AND AIR GAP DRAIN FITTING.	SEE DRAWINGS	-	-	-

4BBR	EVIATIONS	PIPING	
AFF	ABOVE FINISHED FLOOR		
BFF	BELOW FINISHED FLOOR		NEW COLD WATER PI
BOT	воттом		
CD	CONDENSATE DRAINAGE	·	NEW HOT WATER PIPI
CP	CHROME PLATED		NEW HOT WATER RET
CLG	CEILING		NEW HOT WATER REI
CO	CLEANOUT	\ \	NEW SANITARY AND/
CW DN	COLD WATER DOWN		
DNZ	DOWNSPOUT NOZZLE	├ — — — — →	NEW VENT PIPING
DINZ	DRAIN	3 St ———— 3	NEW PRIMARY STORM
ET	EXPANSION TANK	31	NEW FRIMARI SIOKN
EWH	ELECTRIC WATER HEATER	5	NEW SECONDARY ST
FCO	FLOOR CLEANOUT		
FC	FAN COIL	₹ CD — ₹	NEW CONDENSATE D
FD	FLOOR DRAIN	₹	NEW GAS PIPING
FL	FLOOR		NEW GAS FIFTING
GCO	GRADE CLEANOUT		HAMMER ARRESTOR
GPF	GALLONS PER FLUSH		
GPM	GALLONS PER MINUTE	\$	CLEANOUT IN FLOOR
GV HB	GATE VALVE HOSE BIBB		GRADE CLEANOUT
ны НW	HOT WATER		ORADE CELANOOI
INV	INVERT (VERIFY IN FIELD)	<u>5</u>	FLOOR DRAIN
MAX	MAXIMUM		
MIN	MINIMUM	\$	ROOF DRAIN (PRIMA
ORD	OVERFLOW ROOF DRAIN	5 💮	ROOF DRAIN (SECON
RD	ROOF DRAIN		1.001 210 111 (02001
RWL	RAINWATER LEADER	S—————————————————————————————————————	WALL CLEANOUT EXF
S	SANITARY	→	
ST	STORM DRAIN	0	VALVE IN RISER
S.ST	SECONDDARY STORM DRAIN	├	DIRECTION OF FLOW
W/TPC TMV	WITH TRAP PRIMER CONNECTION THERMOSTATIC MIXING VALVE	~	
TYP	TYPICAL	<u>₹</u>	TOP CONNECTION, 4
UON	UNLESS OTHERWISE NOTED	ί, τ	BOTTOM CONNECTION
V	VENT	~	BOTTOM CONNECTION
VO	VALVED OUTLET	2	SIDE CONNECTION
VIF	VERIFY IN FIELD	ф	
VTR	VENT THRU ROOF	ş — — — — — — — — — — — — — — — — — — —	CAPPED OUTLET
W WCO	WASTE WALL CLEANOUT	₹	DROP IN PIPING
,,,,,,	LE GLE, WYOOT	\ \	RISE IN PIPING
		}	HOSE BIBB
		₹ ————————————————————————————————————	BALL VALVE

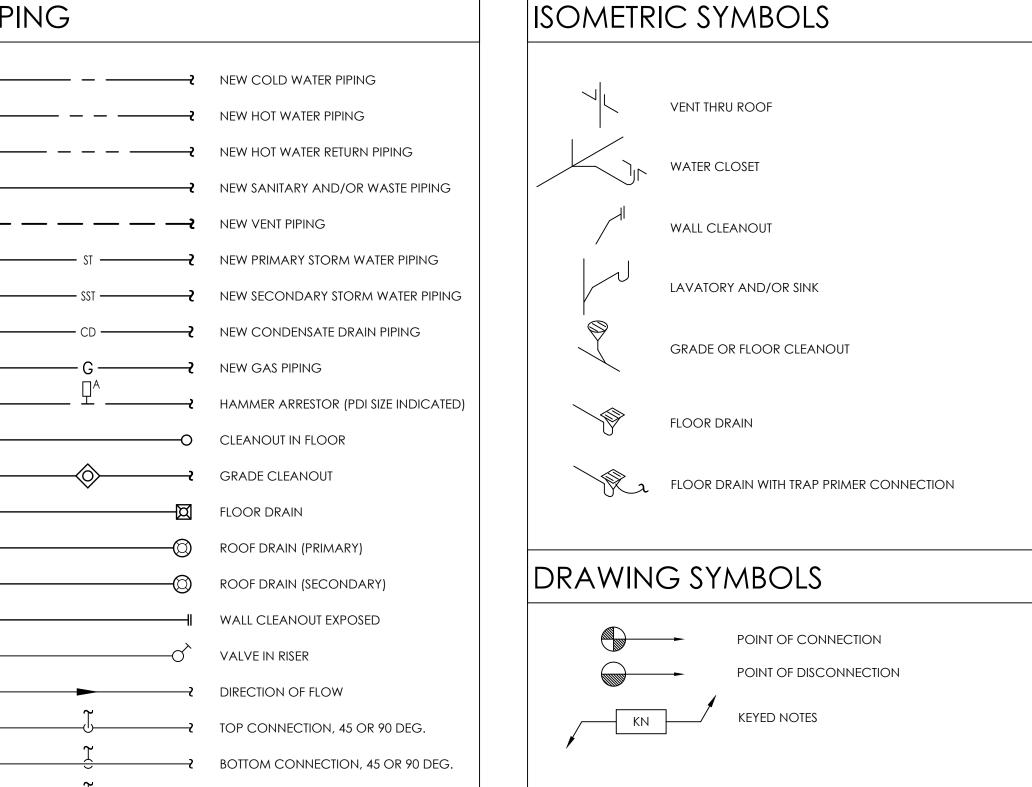

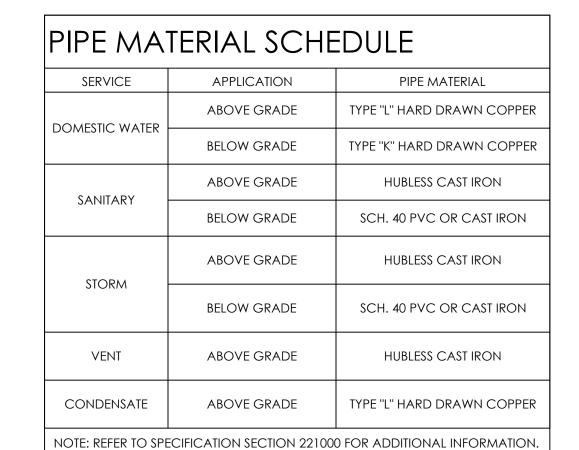


OWNER'S IRRIGATION STRICT COMMENTAL WEATHERMATIC ENABLED FOR ZIGBEE WIF PROTOCOL BY OWNERS LANDSCAPER

COORDINATE WITH PROJECT ELECTRICIAN.

OWNER'S IRRIGATION SYSTEM CONTROL PANEL:

WEATHERMATIC ENABLED FOR ZIGBEE WIRELESS

NOTE: BMS CONTROL DEVICES TO BE ORDERED FROM THE BMS EQUIPMENT VENDOR.

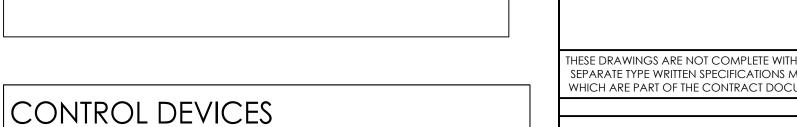

ISSUE	DATE	DESCRIPTION
-	2020.12.21	PERMIT SET

PROJECT INFORMATION					
PROJECT NO: JPM.27135.00					
DATE:					
PRC	OTOTYPE:	20.2			
DR	AWN BY:	m.batdorf			
СН	ECKED BY:	S.VAZ			
VEF	rsion:	SE_1.00			

PLUMBING ABBREVIATION, **LEGENDS & NOTES**

SHEET NUMBER

SHEET TITLE

PLUMBING GENERAL NOTES: CONTRACTOR SHALL PROVIDE COMPLETE PLUMBING SYSTEMS AS DETAILED ON THESE DRAWINGS, IN COMPLIANCE WITH 2018 INTERNATIONAL PLUMBING CODE. WORK CONSISTS OF FURNISHING ALL MATERIALS, EQUIPMENT, AND SERVICES REQUIRED FOR COMPLETE SYSTEMS. INCLUDE ANY INCIDENTAL APPARATUS, APPLIANCES, MATERIAL LABOR AND SERVICES NECESSARY TO MAKE NEW WORK COMPLETE IN ALL RESPECTS AND FULLY READY FOR OPERATION. VERIFY THE EXACT LOCATION OF EXISTING SANITARY SEWERS AND WATER MAINS FROM THE ACTUAL JOB SITE PRIOR TO SUBMITTING BID. SUBMISSION OF YOUR PROPOSAL SHALL BE CONSTRUED AS INDICATING SUCH KNOWLEDGE. NO ADDITIONAL PAYMENT WILL BE MADE ON CLAIMS THAT ARISE FROM THE CONTRACTOR'S FAILURE TO COMPLY WITH THIS REQUIREMENT. MAKE SUCH OFFSETS AND DEVIATIONS FROM WORK SHOWN ON THE DRAWINGS, AS MAY BE NECESSARY TO FIT THE ACTUAL SPACE CONDITIONS WHERE VALVES OCCUR ABOVE DRYWALL OR PLASTER OR ARE CONCEALED BEHIND WALLS, THIS CONTRACTOR SHALL FURNISH AND INSTALL ACCESS PANELS. COORDINATE COLOR AND STYLE WITH ENGINEER/ARCHITECT. INSTALLER SHALL NOT CUT ANY STRUCTURAL MEMBERS WITHOUT FIRST SECURING WRITTEN APPROVAL FROM THE ARCHITECT. PROVIDE DIELECTRIC UNIONS AT ALL CONNECTIONS BETWEEN DISSIMILAR PIPING METALS. NO VENT THROUGH ROOF SHALL TERMINATE CLOSER THAN 10 FT. TO ANY OUTSIDE AIR INTAKE OR VENTILATION LOUVERS, DOORS, WINDOWS AND OTHER BUILDING OPENINGS. SANITARY SEWER AND MAIN WATER PIPING UNDERGROUND SHALL BE A MINIMUM OF 36" BELOW EXTERIOR GRADE. PIPING IN CONCRETE BLOCK WALLS SHALL BE INSTALLED AS BLOCK IS BEING LAID. DO NOT CUT BLOCK WALL. PROVIDE ALL SINKS AND LAVATORIES WITH TRAP FITTINGS FOR CLEANOUT CONTRACTOR IS RESPONSIBLE TO ALSO CHECKING FIELD CONDITIONS PRIOR TO BIDDING AND REPORT ANY PROBLEMS/CONFLICTS TO THE ENGINEER WITHIN 2 DAYS OF DISCOVERY. ANY CHANGES RESULTING FROM CONDITIONS ARISING IN THE FIELD WHICH WERE NOT BROUGHT TO THE ENGINEER'S ATTENTION ARE TO BE MADE BY THIS CONTRACTOR WITH NO ADDITIONAL COST TO THE OWNER ALL WORK IS TO BE FREE OF DEFECTS IN WORKMANSHIP AND MATERIALS FOR A PERIOD OF ONE(1) YEAR FROM DATE OF FINAL ACCEPTANCE. ALL DEFECTS WHICH DEVELOP OR ARE DISCOVERED WITHIN THIS PERIOD SHALL BE REPAIRED BY THE CONTRACTOR TO THE SATISFACTION OF THE OWNER AT NO ADDITIONAL COST TO THE OWNER. UPON COMPLETION OF THE WORK UNDER THIS CONTRACT, THE CONTRACTOR SHALL REMOVE ALL TOOLS, APPLIANCES, SURPLUS MATERIALS, AND SCRAP. ALL IDENTIFIED EXISTING EQUIPMENT TO BE REMOVED SHALL BE TURNED OVER TO THE OWNER. 14. THE CONTRACTOR SHALL COORDINATE WORK WITH OTHER TRADES IN ORDER TO AVOID CONFLICTS. 15. THE CONTRACTOR SHALL PROVIDE ALL CHROME EXPOSED TRAP PRIMER CONNECTIONS BELOW LAVATORIES 16. PLUMBING CONTRACTOR SHALL PROVIDE NAMEPLATE INFO TO THE FACILITY MANAGER FOR WATER HEATER AND RPZ. ALL CONDENSATE DRAIN PIPING SHALL BE INSULATED WITH 3/4" ARMSTRONG "ARMAFLEX" INSULATION. THE FIRST 8 FEET OF PIPING FROM THE HOT WATER HEATER SHALL BE INSULATED WITH 1/2" INSULATION FOR COLD WATER AND 1" INSULATION FOR HOT WATER. CONTRACTOR TO VISUALLY INSPECT CONDITION OF EXISTING SANITARY PIPING PRIOR TO COMMENCING WORK WITH APPROVED VIDEO CAMERA PROBE. CONTRACTOR TO RECORD INSPECTION AND PROVIDE TO ARCHITECT. IMMEDIATELY NOTIFY ARCHITECT OF ANY DEFECTS, DAMAGES, OR ISSUES IN EXISTING PIPING. UPON COMPLETION OF WORK RE-INSPECT PIPING. ALL NEW AND EXISTING POTABLE WATER PIPING SHALL BE DISINFECTED PRIOR TO OCCUPANCY. ALL MATERIALS WITHIN RETURN AIR PLENUMS OR EXPOSED WITHIN DUCTS SHALL BE NONCOMBUSTIBLE AND/OR SHALL HAVE A FLAME SPREAD INDEX NOT GREATER THAN 25 AND A SMOKE DEVELOPED INDEX NOT GREATER THAN 50 WHEN TESTED IN ACCORDANCE WITH ASTM 84 TESTING.

NO NEW OR EXISTING PLASTIC PIPING (PVC,ABS,OR CPVC) IS ALLOWED IN OPEN PLENUM RETURN AIR SYSTEMS, UNLESS WRAPPED IN PLENUM RATED INSULATION SIMILAR TO 3M FIRE BARRIER


THE CONTRACTOR SHALL PAINT ALL EXPOSED EXTERIOR METAL GAS PIPING, VALVES, SERVICE REGULATORS, AND PIPING SPECIALTIES, EXCEPT COMPONENTS WITH FACTORY-APPLIED PAINT OR PROTECTIVE COATING. CONTRACTOR SHALL PRIME WITH AN ALKYD ANTICORROSIVE METAL PRIMER AND TOP WITH A MINIMUM OF TWO COATS OF ALKYD ENAMEL. COORDINATE COLOR

PLENUM WRAP 5A+ OR EQUAL.

WITH ARCHITECT/LANDLORD.

PLUMBING EQUIPMENT COMPONENTS								
OCCUPANCY C	ATEGORY (ш) Е	ARTHQ	UAKE	LOAD R	ESISTA	NCE SE	EISMIC DESIGN CATEGORY (B)
EQUIPMENT AND SYSTEM COMPONENTS	ANCHORAGE TO FLOORS, ROOFS, ETC.		SWAY BRACING		LOCATION OF I ANCHORAGI		COMMENTS	
					ON CONST. DOCUMENTS	SUBSEQUENT SUBMITTAL		
	NOT PROVIDED	PROVIDED	NOT PROVIDED	PROVIDED	DRAWING NO. OR SPEC. SECTION	SHOP DRAWINGS	SEPARATE PERMIT & PLANS	
WASTE PIPING	Х		Х					SEISMIC BRACING NOT REQUIRED FOR DESIGN CATEGORY B
EXTERIOR GAS PIPING (Ip=1.5)	Х		X					SEISMIC BRACING NOT REQUIRED FOR DESIGN CATEGORY B
INTERIOR GAS PIPING (IP=1.5)	Х		Х					SEISMIC BRACING NOT REQUIRED FOR DESIGN CATEGORY B
VENT PIPING (IP=1.0)	Х		Х					SEISMIC BRACING NOT REQUIRED FOR DESIGN CATEGORY B
WATER PIPING (IP=1.0)	Х		Х					SEISMIC BRACING NOT REQUIRED FOR DESIGN CATEGORY B
STORM PIPING (IP=1.0)	Х		Х					SEISMIC BRACING NOT REQUIRED FOR DESIGN CATEGORY B
WATER HEATER (IP=1.0)	Х		Х					SEISMIC BRACING NOT REQUIRED FOR DESIGN CATEGORY B




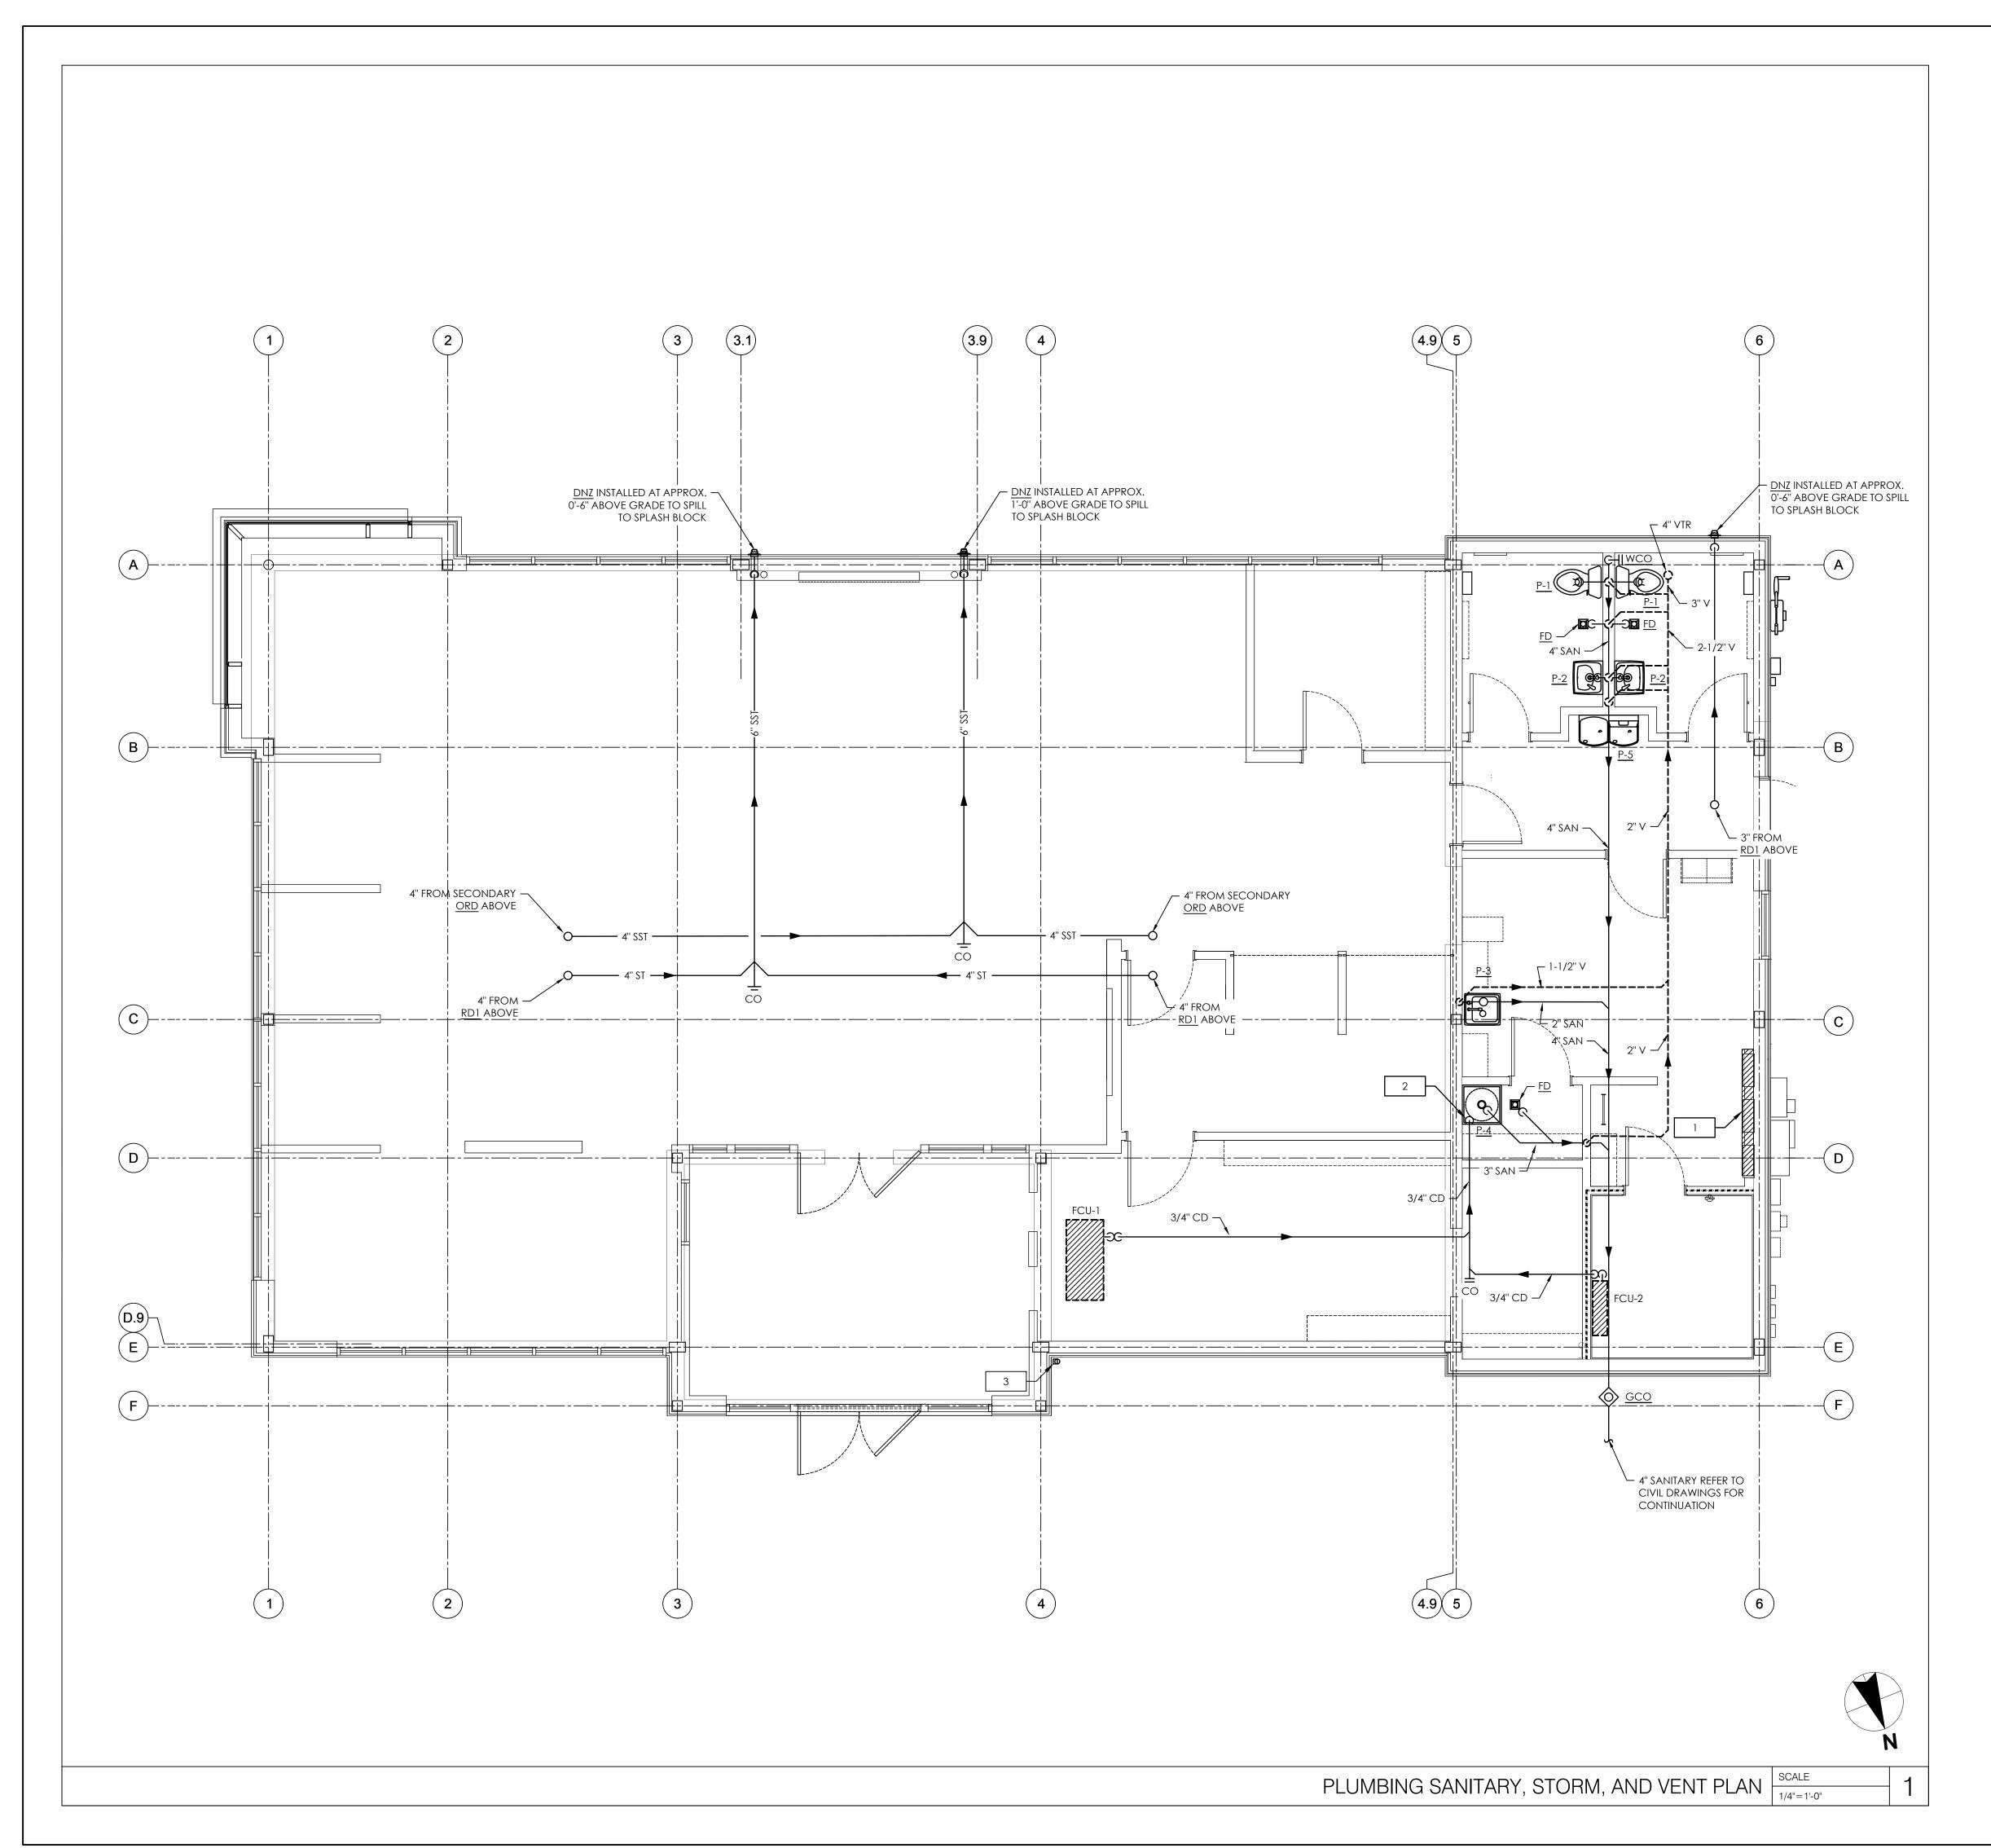

PLUMBING NOTES:

- 1. DEDICATED ELECTRICAL SPACE. THE SPACE EQUAL TO THE WIDTH AND DEPTH OF THE ELECTRICAL EQUIPMENT AND EXTENDING FROM THE FLOOR TO A HEIGHT SIX FEET ABOVE THE EQUIPMENT OR TO THE STRUCTURE. WHICHEVER IS LOWER. SHALL BE DEDICATED TO ELECTRICAL EQUIPMENT, NO PIPING FOREIGN TO THE ELECTRICAL INSTALLATION SHALL BE PERMITTED WITHIN THIS ZONE.
- 2. CONTRACTOR TO ROUTE 1" CONDENSATE DRAIN FROM MECHANICAL EQUIPMENT AND TERMINATE AT MOP SINK WITH 2" AIR GAP FROM RIM
- CONTRACTOR TO PROVIDE DOWNSPOUT SHOE (<u>DNZ</u>) TO CONNECT TO CANOPY DOWNSPOUT AND DAYLIGHT TO LANDSCAPE. DOWNSPOUT PROVIDED BY CANOPY MANUFACTURER. CANOPY MANUFACTURER TO COORDINATE DOWNSPOUT LOCATION WITH SHOE AND FIELD CUT ASSOCIATED DRAIN HOLE IN THE CANOPY.



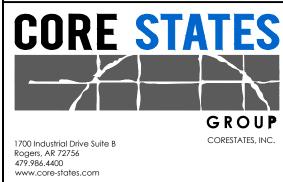

ENGINEER OF RECORD



THESE DRAWINGS ARE NOT COMPLETE WITHOUT THE SEPARATE TYPE WRITTEN SPECIFICATIONS MANUAL WHICH ARE PART OF THE CONTRACT DOCUMENTS.


SUE	DATE	DESCRIPTION
-	2020.12.21	PERMIT SET

PROJECT INFORM	ATION
PROJECT NO:	JPM.27135.00
DATE:	
PROTOTYPE:	20.
DRAWN BY:	m.batdor
CHECKED BY:	S.VA
VERSION:	SE_1.0
SHEET TITLE	

PLUMBING SANITARY, STORM, & VENT PLAN

SHEET NUMBER


P1.0

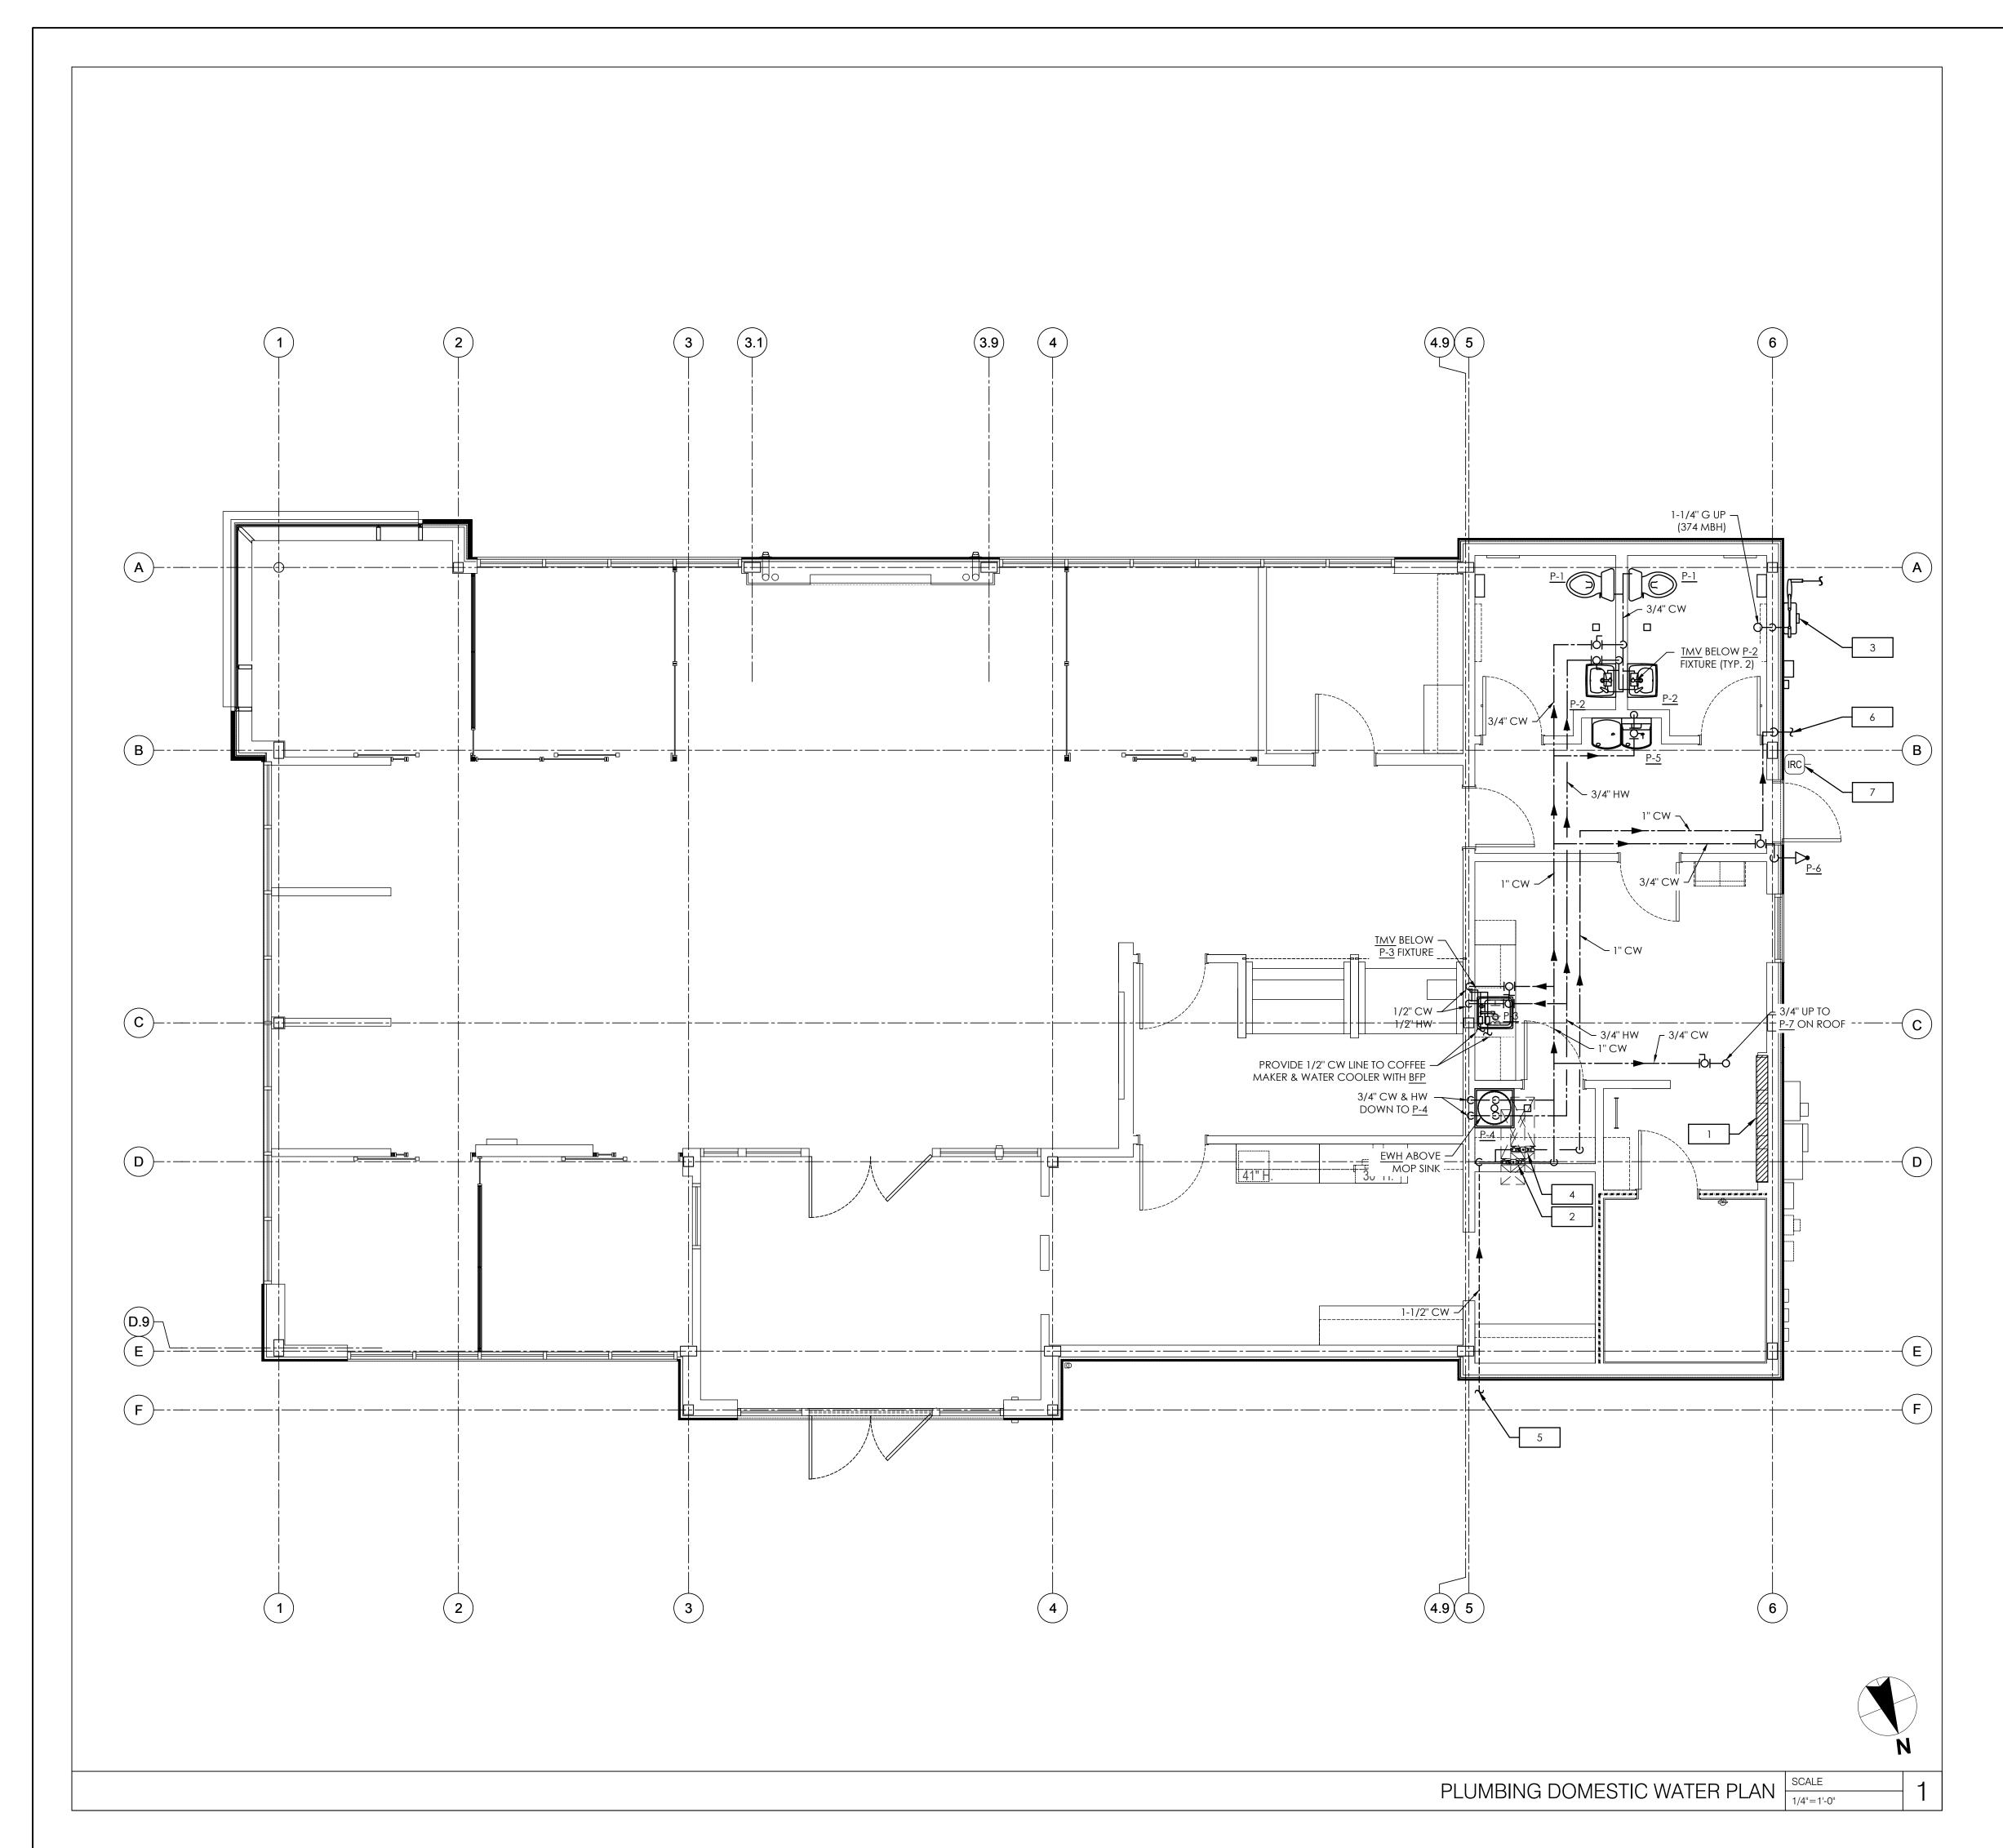

PLUMBING NOTES:

- 1. DEDICATED ELECTRICAL SPACE. THE SPACE EQUAL TO THE WIDTH AND DEPTH OF THE ELECTRICAL EQUIPMENT AND EXTENDING FROM THE FLOOR TO A HEIGHT SIX FEET ABOVE THE EQUIPMENT OR TO THE STRUCTURE. WHICHEVER IS LOWER. SHALL BE DEDICATED TO ELECTRICAL EQUIPMENT, NO PIPING FOREIGN TO THE ELECTRICAL INSTALLATION SHALL BE PERMITTED WITHIN THIS ZONE.
- CONTRACTOR TO PROVIDE 1" WATTS LF009M2QT BACKFLOW PREVENTION DEVICE SERVING BUILDING DOMESTIC WATER SYSTEM.
 NEW GAS METER PROVIDED BY UTILITY COMPANY. COORDINATE WITH UTILITY COMPANY AS REQUIRED. CONTRACTOR TO EXTEND AND CONNECT NEW 1-1/4" GAS PIPING AND ROUTE TO ROOF. OFFSET PIPING TO ROOF IN CEILING PLENUM.
- 4. CONTRACTOR TO PROVIDE 1" WATTS LF009M2QT BACKFLOW PREVENTION DEVICE SERVING BUILDING IRRIGATION SYSTEM.
- . 1-1/2" DOMESTIC COLD WATER SERVICE BELOW GRADE. REFER TO CIVIL PLANS FOR CONTINUATION.
- 6. 1" COLD WATER TO BUILDING IRRIGATION SYSTEM BY OTHERS. REFER TO IRRIGATION PLANS FOR CONTINUATION. CONTRACTOR TO COORDINATE PIPE ROUTING AND TIE-IN WITH IRRIGATION CONTRACTOR PRIOR TO COMMENCING WORK.
- LANDSCAPE IRRIGATION SYSTEM CONTROLLER AND WIRELESS NETWORK LINK. CONTROLLER SHALL BE LINKED TO DAINTREE BMS.

JP MORGAN CHASE, N.A HWY 291 & NE LANGSFORD RD 890 NE LANGSFORD RD

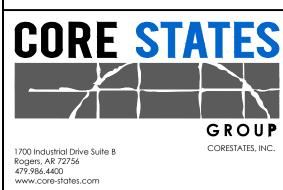

www.core-states.com

ENGINEER OF RECORD



THESE DRAWINGS ARE NOT COMPLETE WITHOUT THE SEPARATE TYPE WRITTEN SPECIFICATIONS MANUAL WHICH ARE PART OF THE CONTRACT DOCUMENTS.

ISSUE DATE DESCRIPTION

- 2020.12.21 PERMIT SET

PROJECT INFORMATION

PROJECT NO: JPM.27135.001

DATE:

PROTOTYPE: 20.2

DRAWN BY: M.BATDORF


CHECKED BY: S.VAZ

VERSION: SE_1.00


PLUMBING DOMESTIC WATER PLAN

SHEET NUMBER

21.1

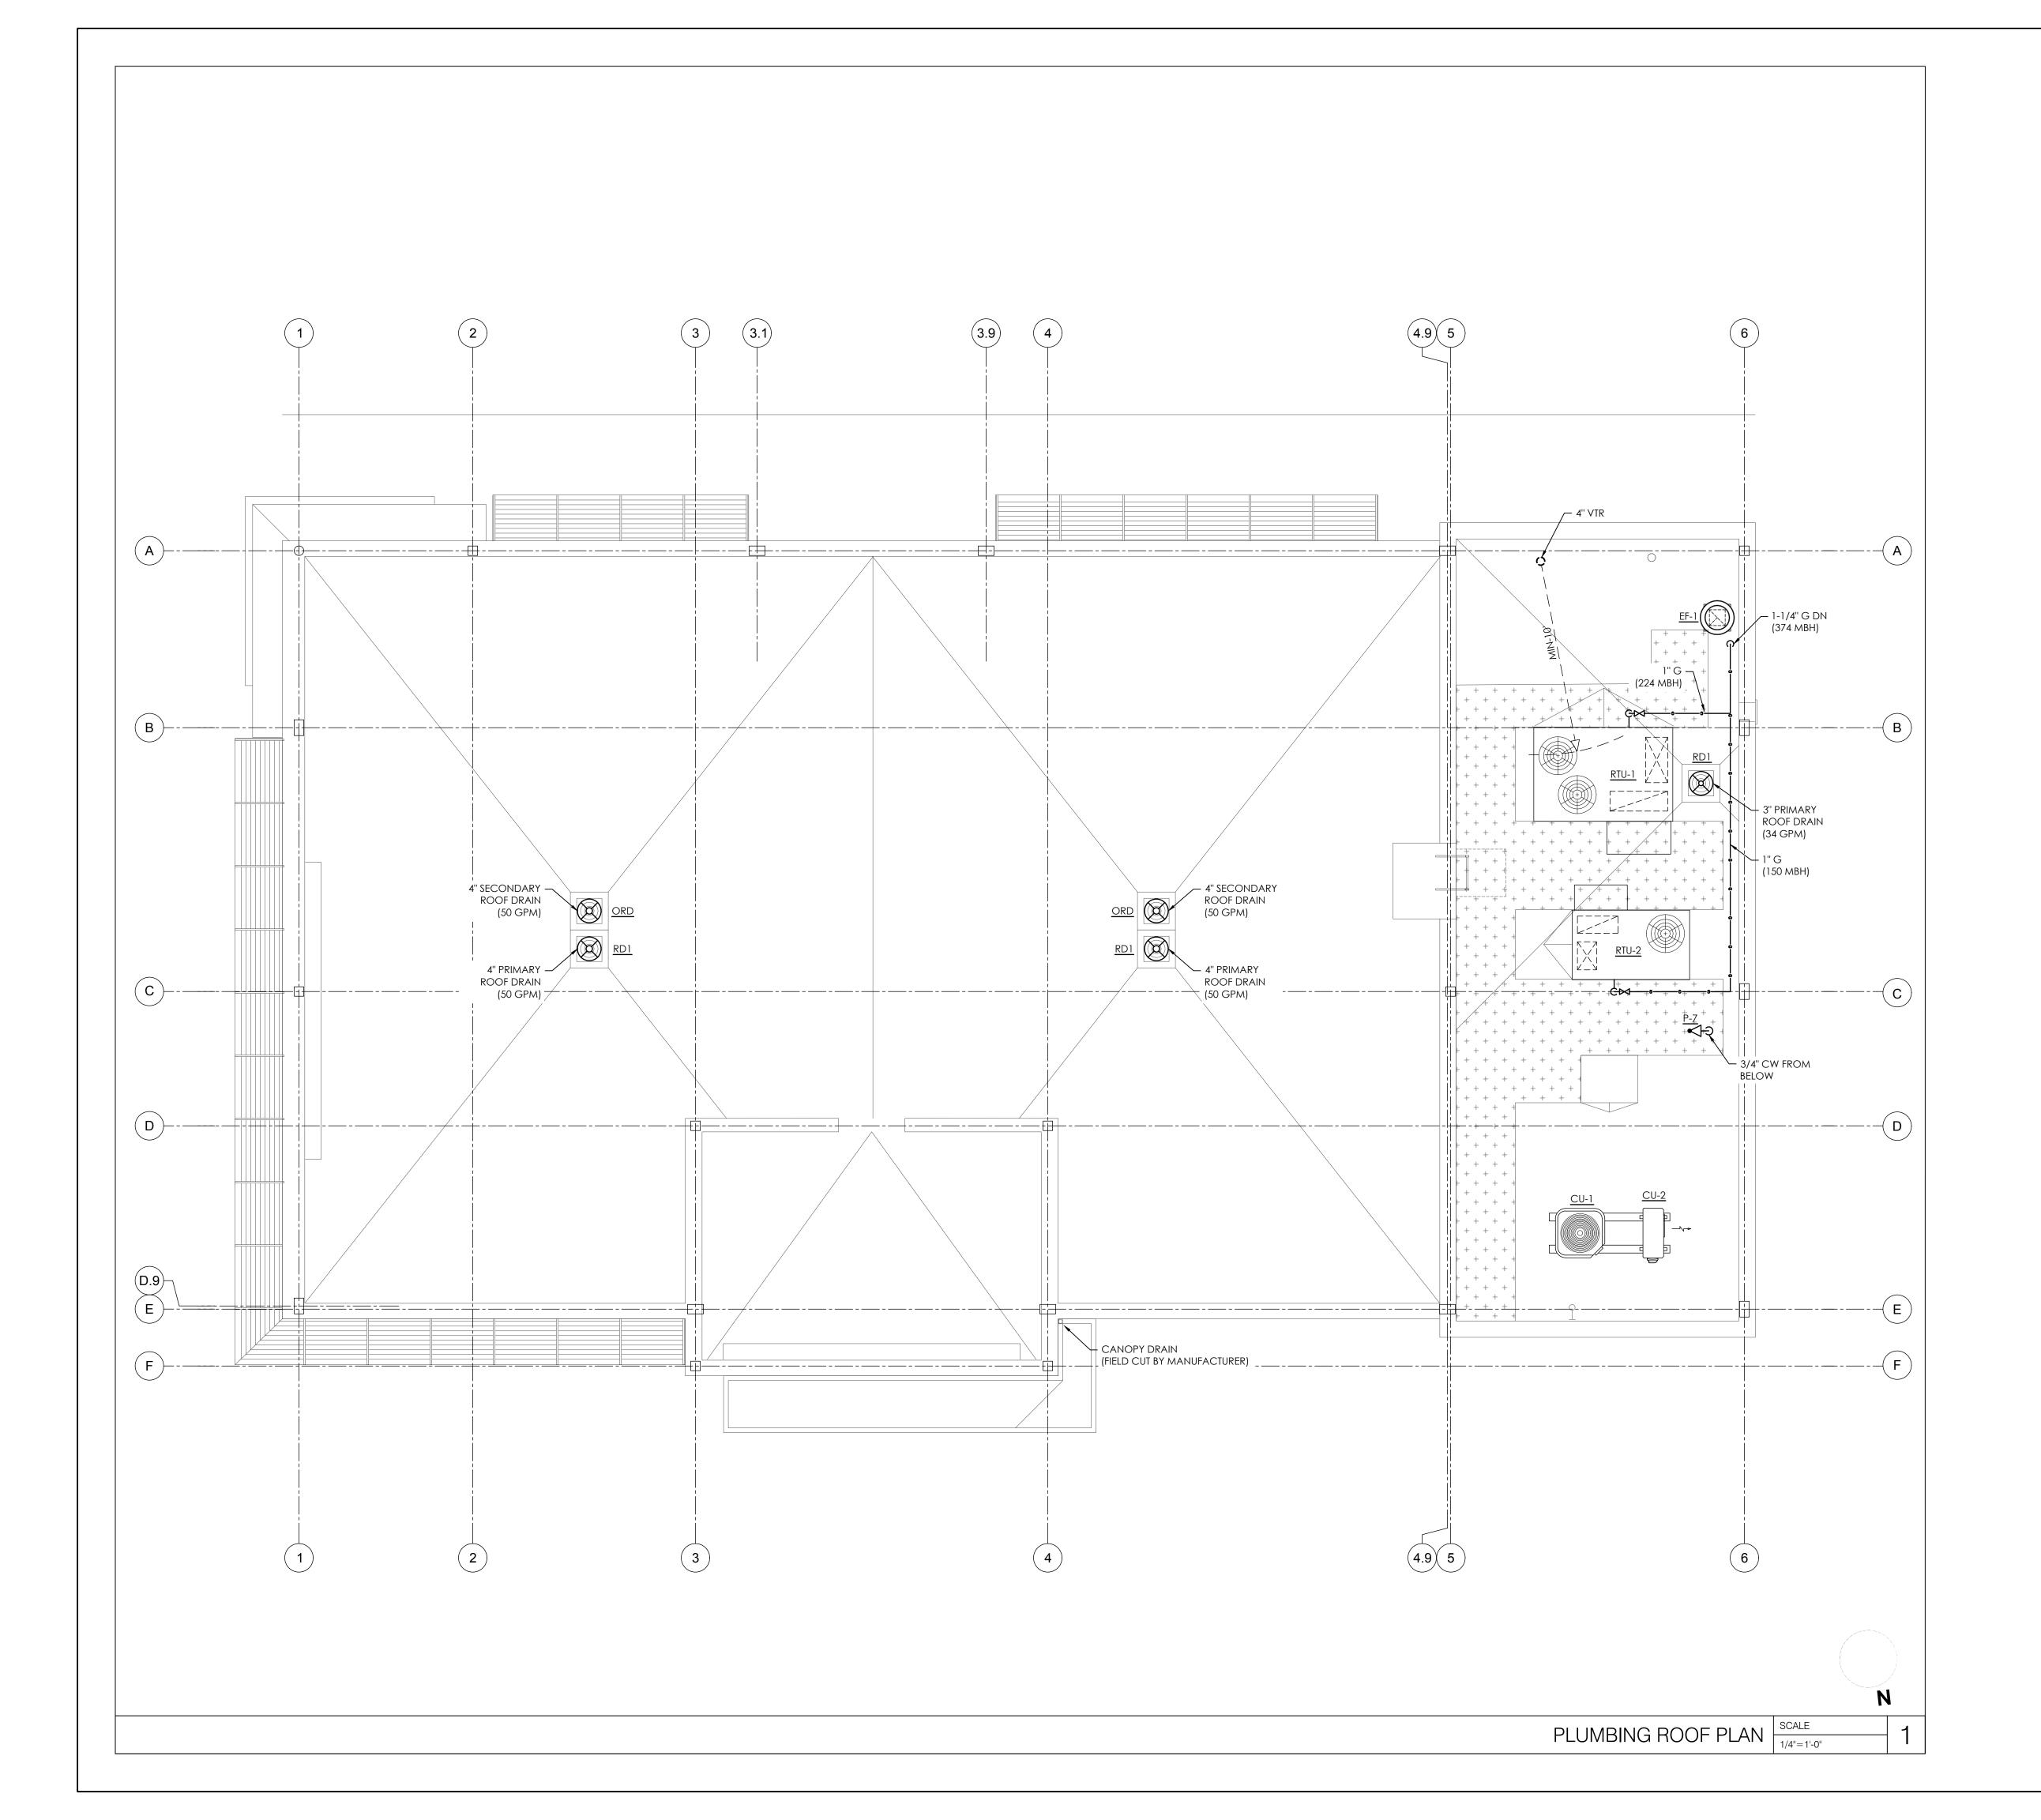

JP MORGAN CHASE, N.A HWY 291 & NE LANGSFORD RD 890 NE LANGSFORD RD 1EE'S SUMMIT, MO 64063

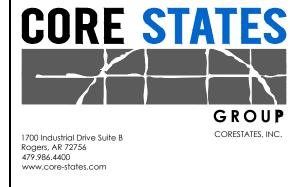

NGINEER OF RECORD



THESE DRAWINGS ARE NOT COMPLETE WITHOUT THE SEPARATE TYPE WRITTEN SPECIFICATIONS MANUAL WHICH ARE PART OF THE CONTRACT DOCUMENTS.

ISSUE DATE DESCRIPTION

- 2020.12.21 PERMIT SET

PROJECT INFORMATION

PROJECT NO: JPM.27135.001

DATE:

PROTOTYPE: 20.2

DRAWN BY: M.BATDORF

CHECKED BY: S.VAZ


VERSION: SE_1.00


SHEET TITLE


PLUMBING ROOF PLAN


SHEET NUMBER


P2.0

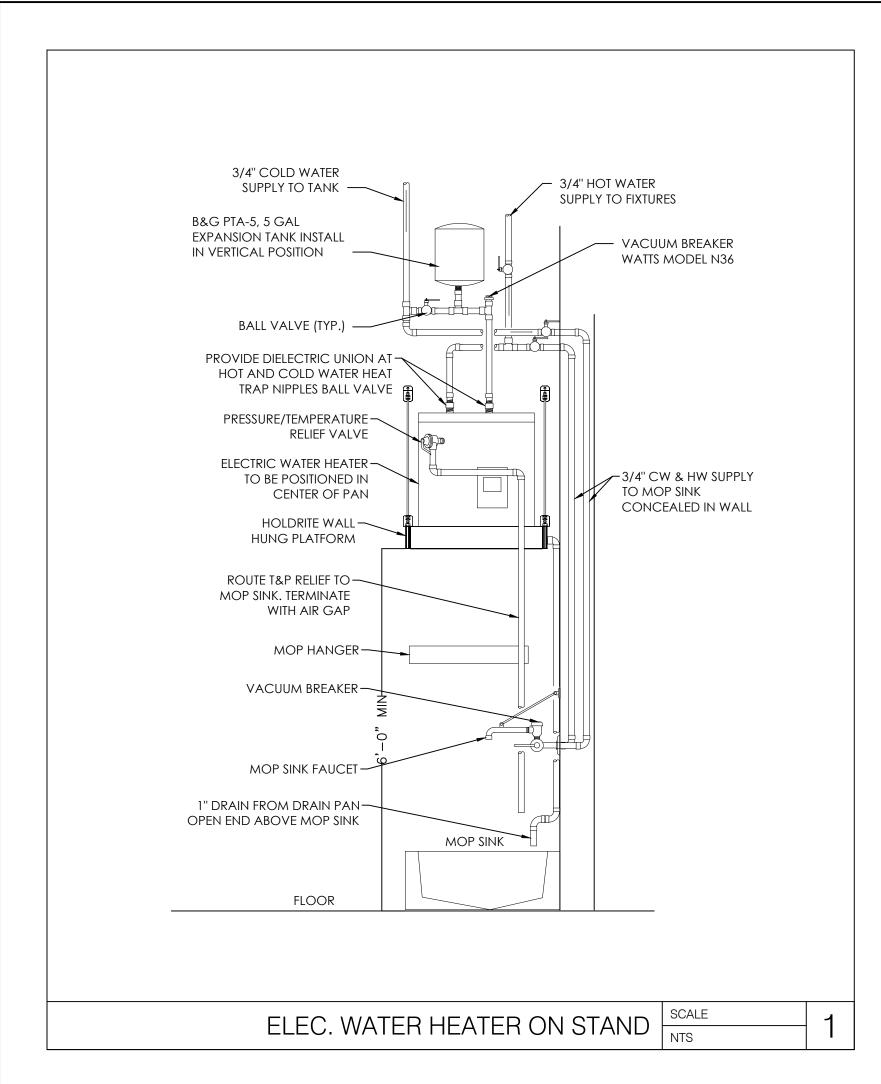


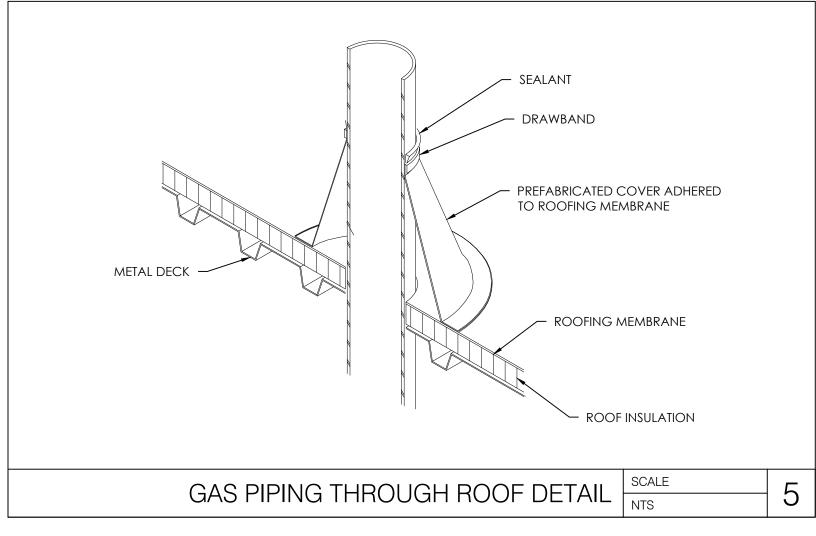


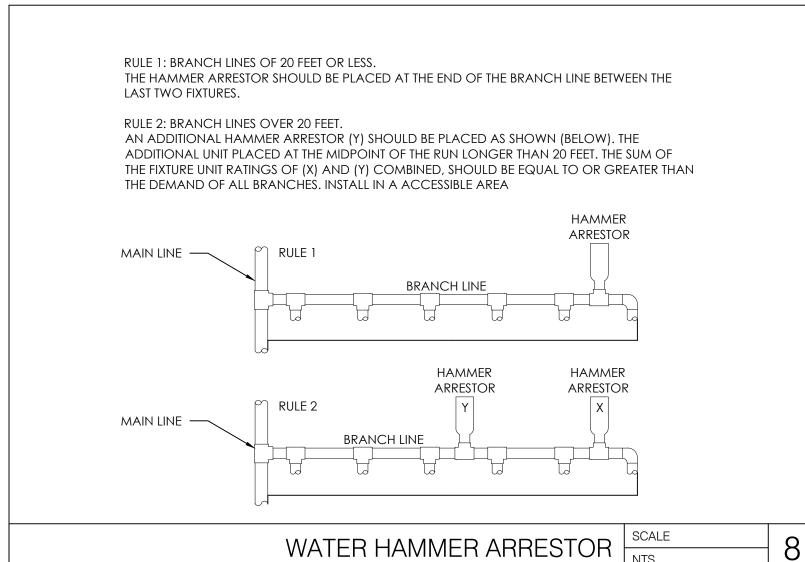


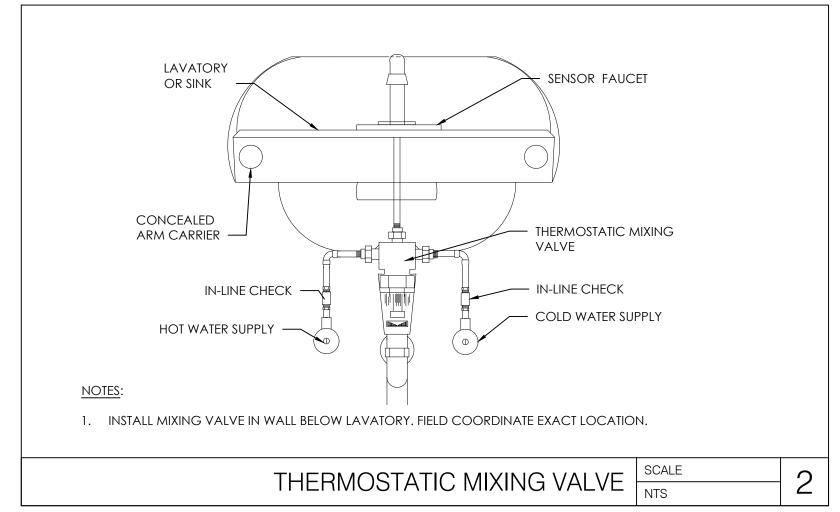


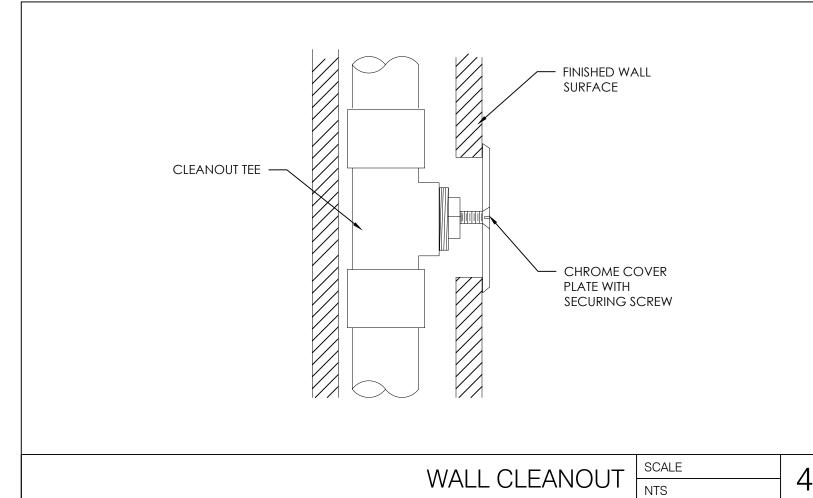

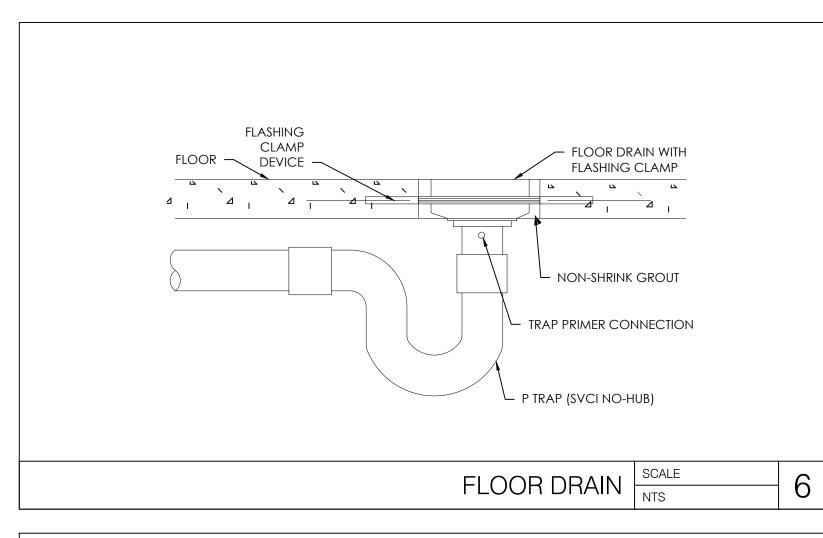


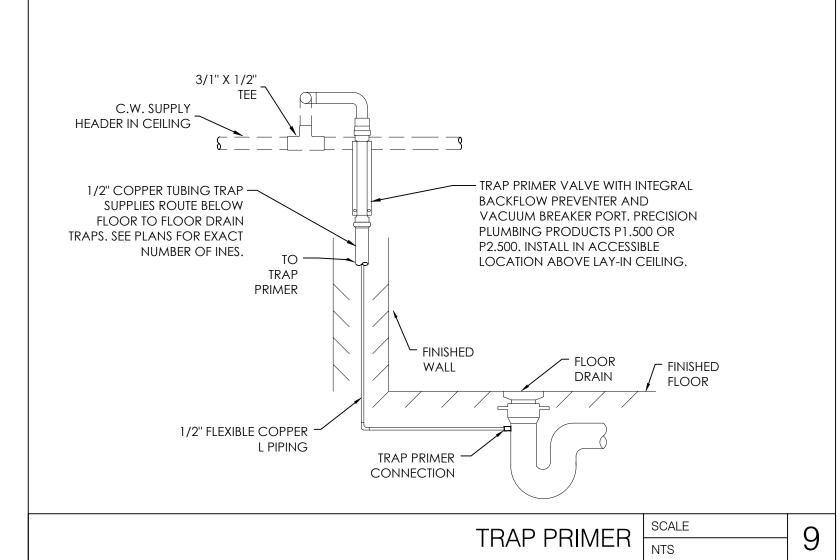

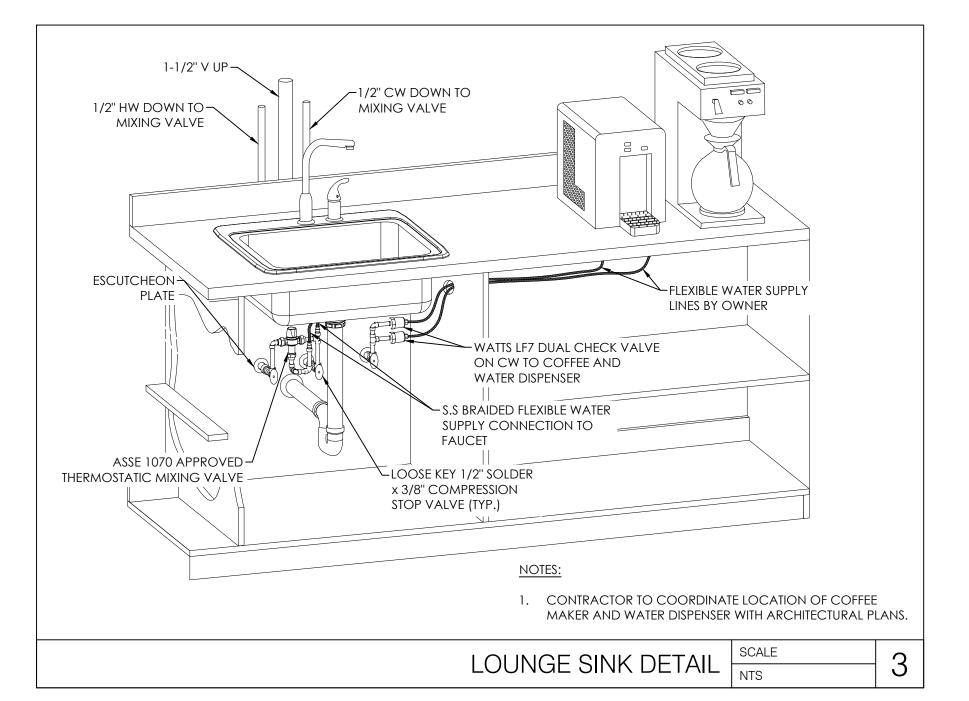

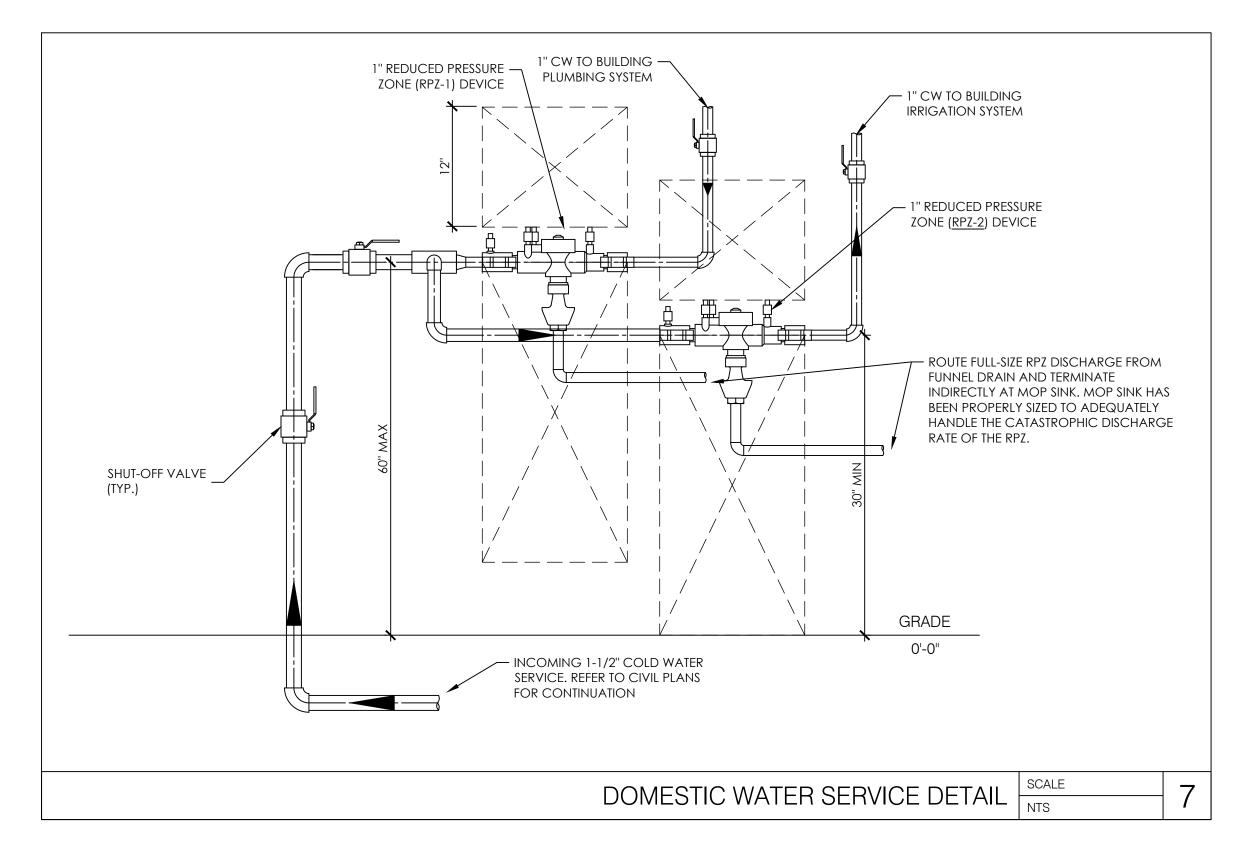



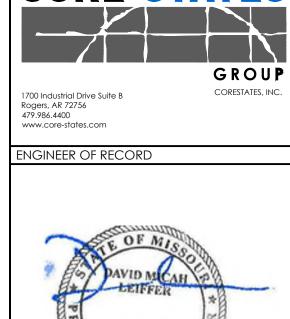

THESE DRAWINGS ARE NOT COMPLETE WITHOUT THE SEPARATE TYPE WRITTEN SPECIFICATIONS MANUAL WHICH ARE PART OF THE CONTRACT DOCUMENTS.


01/05/2020


ISSUE	DATE	DESCRIPTION			
-	2020.12.21	PERMIT SET			
PRO.	JECT INFO	ORMATION			
PRO	OJECT NO:	JPM.27135.001			
DA	TE:				
PROTOTYPE: 20.2					
DR.	AWN BY:	m.batdorf			
СН	ECKED BY:	S.VAZ			
VEF	rsion:	SE_1.00			
SHEET	TITLE				


PLUMBING DETAILS


SHEET NUMBER

P3.0

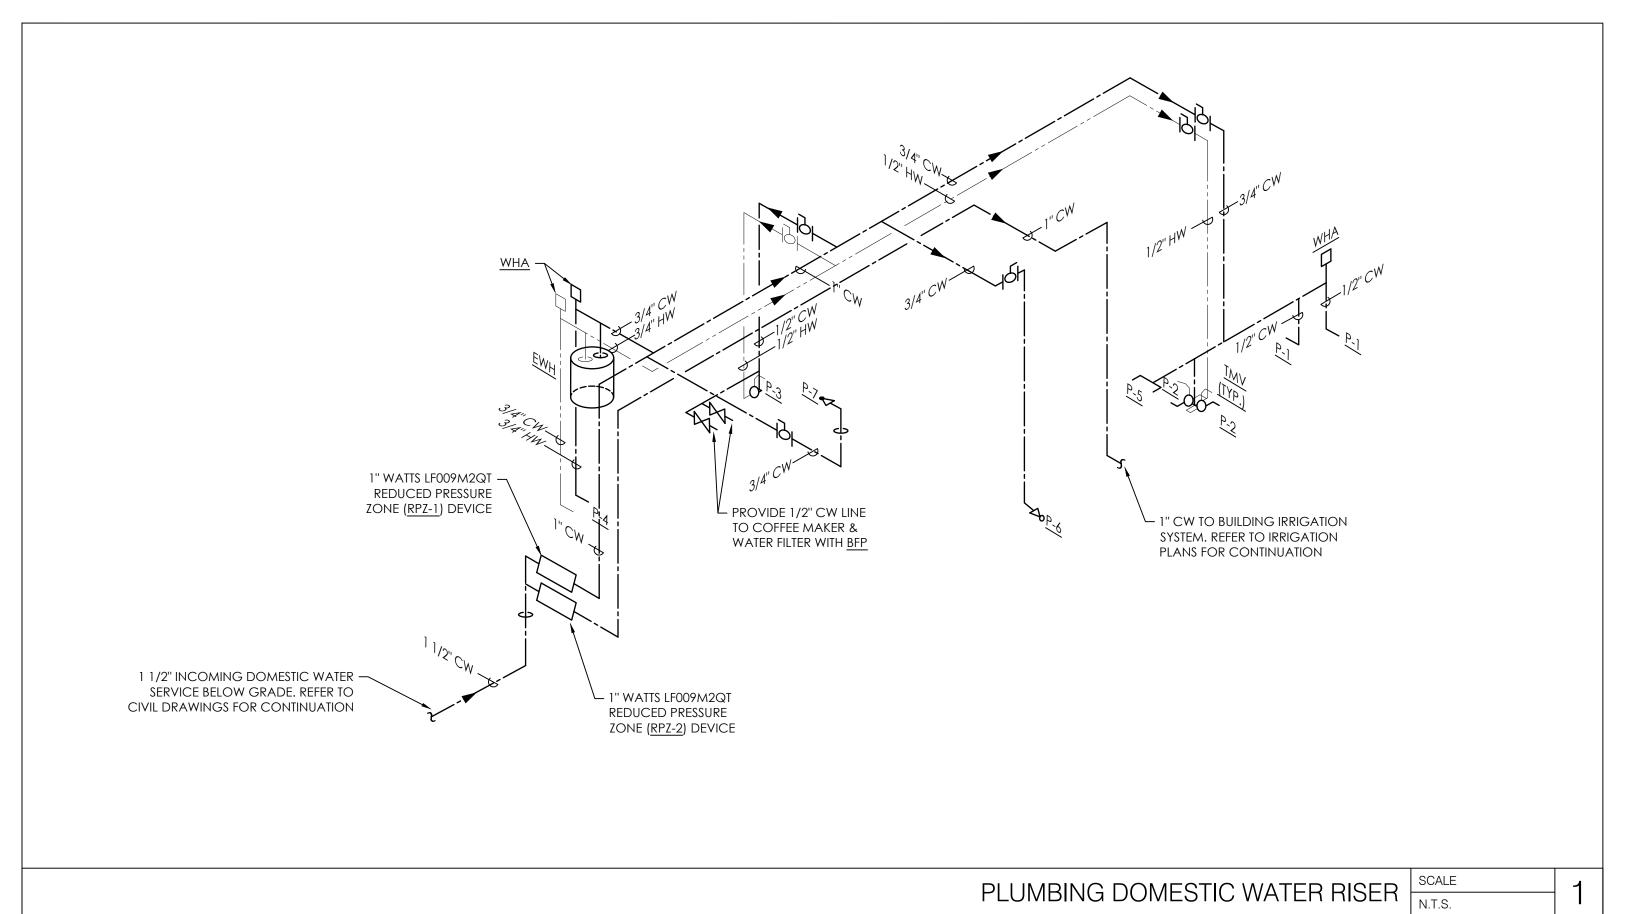


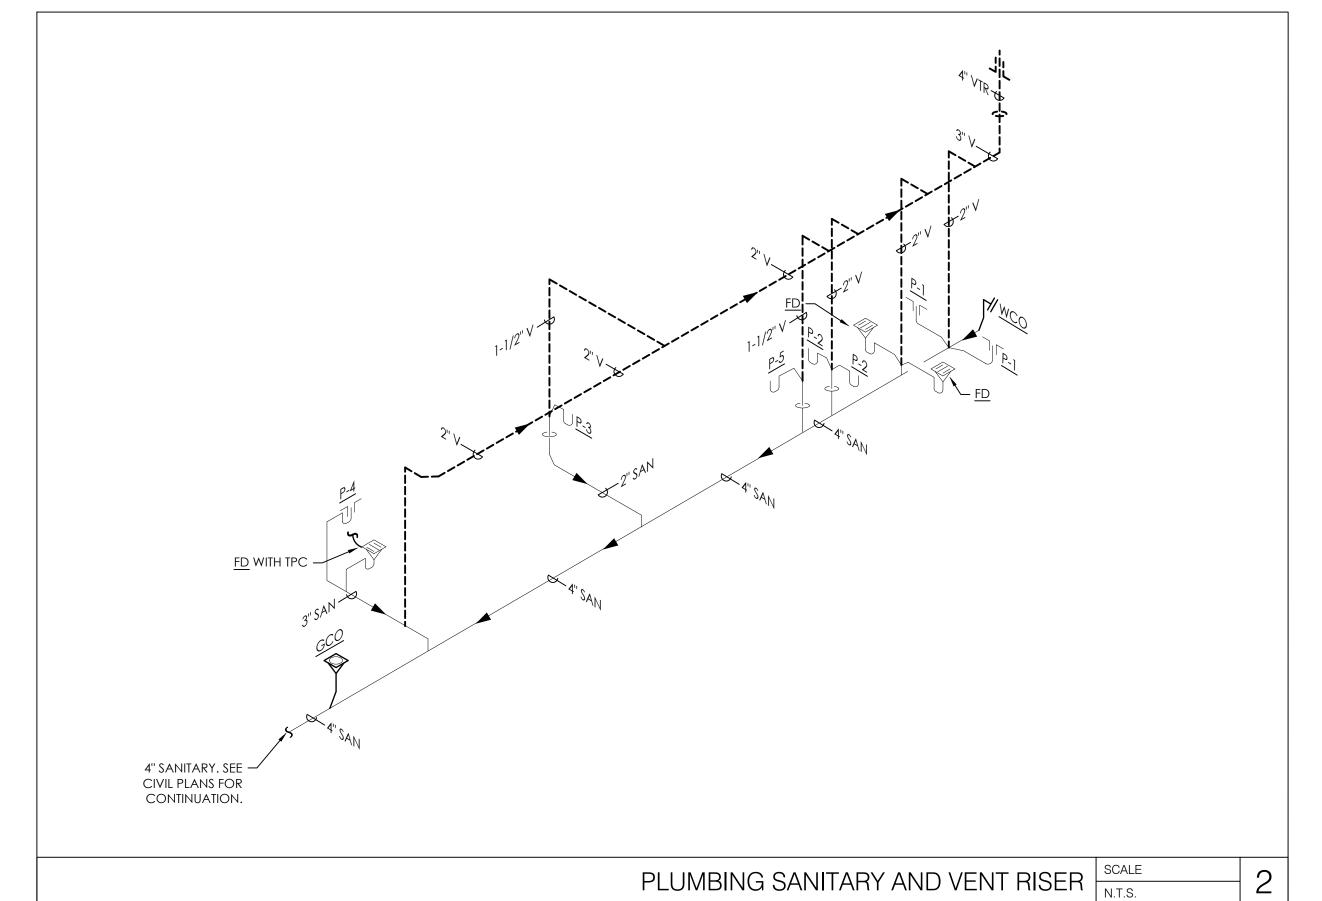

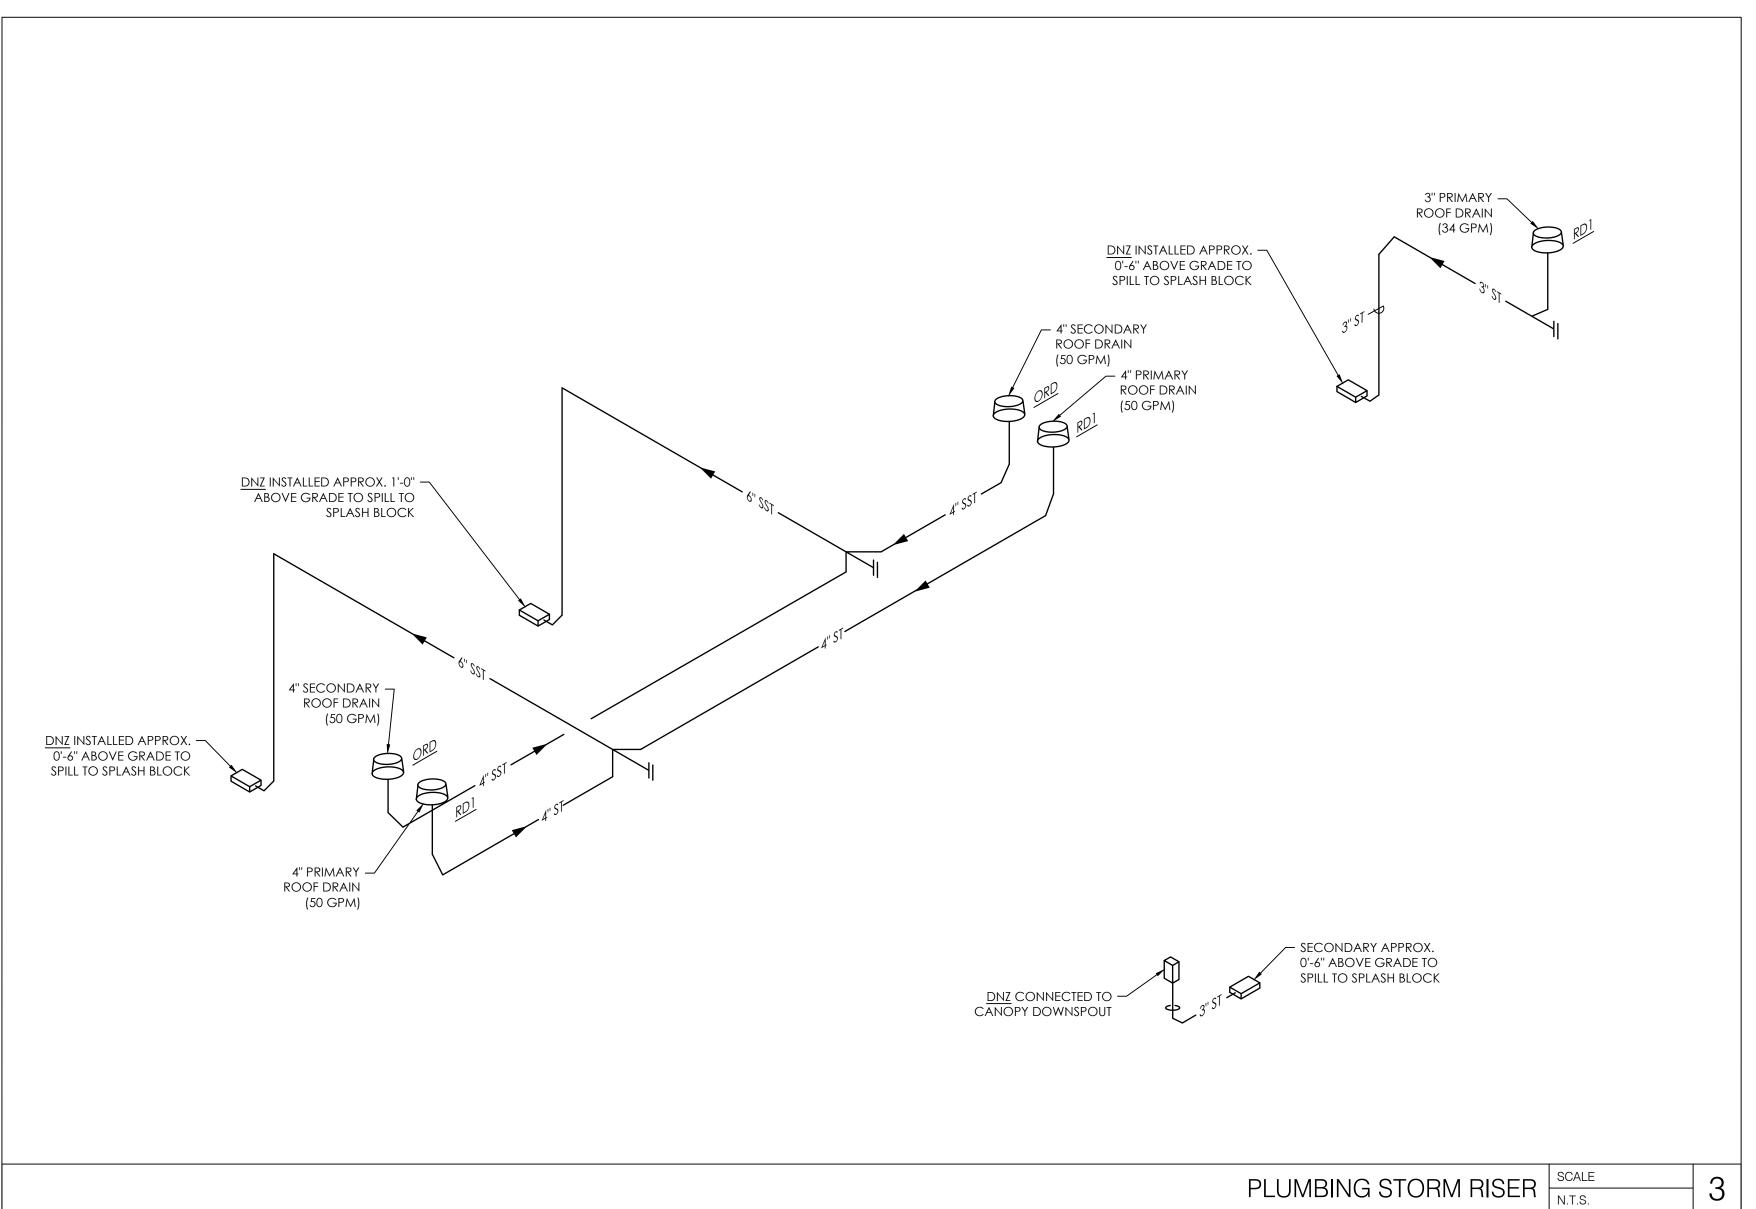


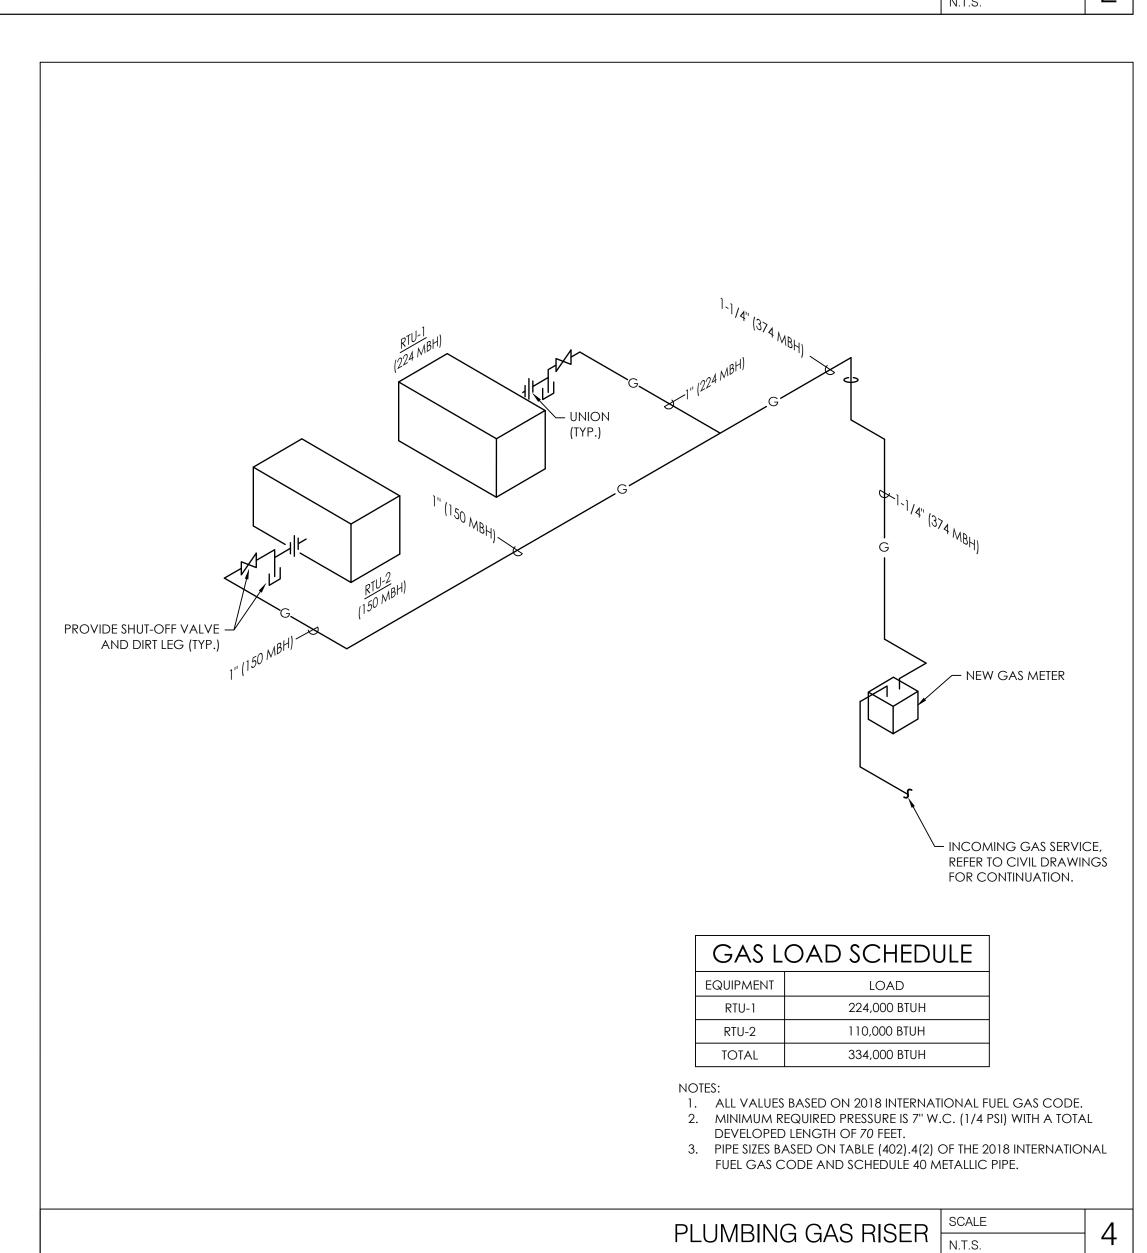



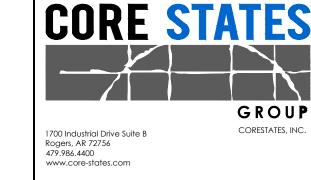

ENGINEER OF RECORD

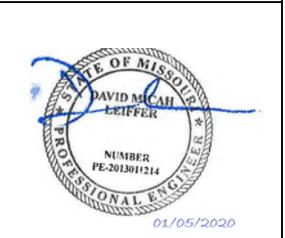

THESE DRAWINGS ARE NOT COMPLETE WITHOUT THE SEPARATE TYPE WRITTEN SPECIFICATIONS MANUAL WHICH ARE PART OF THE CONTRACT DOCUMENTS.

SSUE	DATE	DESCRIPTION
-	2020.12.21	PERMIT SET

PROJECT INFORM	ATION
PROJECT NO:	JPM.27135.001
DATE:	
PROTOTYPE:	20.2
DD A WALL DV:	AA BATDODE

PROTOTYPE: 20.2

DRAWN BY: M.BATDORF

CHECKED BY: S.VAZ

VERSION: SE_1.00

SHEET TITLE

PLUMBING RISER DIAGRAMS

SHEET NUMBER

P4.0

ABBREVIATIONS AMPERE ABOVE FINISHED FLOOR AIR HANDLING UNIT ATS AUTOMATIC TRANSFER SWITCH AMERICAN WIRE GAUGE AWG CIRCUIT BREAKER CLG CEILING CURRENT TRANSFORMER CU COPPER DWG DRAWING EXISTING EQUIPMENT BOARD E.C. ELECTRICAL CONTRACTOR EXHAUST FAN EMERGENCY EMT ELECTRICAL METALLIC TUBING ENCL **ENCLOSURE** ELECTRIC WATER COOLER EWH ELECTRIC WATER HEATER FIRE ALARM FATC FIRE ALARM TERMINAL CABINET FACP FIRE ALARM CONTROL PANEL GFI, GFCI GROUND FAULT CIRCUIT INTERRUPTER GND,G GROUND HACR HEATING/AIR CONDITIONING-RATED HAND DRYER HORSEPOWER ISOLATED GROUND JUNCTION BOX **KCMIL** THOUSAND CIRCULAR MILS KVA KILOVOLT AMPERE KW KILOWATT MCB MAIN CIRCUIT BREAKER MDP MAIN DISTRIBUTION PANEL MLO MTS MANUAL TRANSFER SWITCH NC NORMALLY CLOSED NEC NATIONAL ELECTRICAL CODE NEMA NATIONAL ELECTRICAL MANUFACTURERS ASSOCIATION NFPA NATIONAL FIRE PROTECTION ASSOCIATION POLYVINYL CHLORIDE CONDUIT PVC REF REFRIGERATOR SURGE PROTECTIVE DEVICE SPD SWBD SWITCHBOARD TIME SWITCH TYPICAL UG UNDERGROUND UNIT HEATER UNLESS OTHERWISE NOTED UON UPS UNINTERRUPTIBLE POWER SUPPLY VARIABLE AIR VOLUME VFD VARIABLE FREQUENCY DRIVE WEATHER PROOF WR WEATHER RESISTANT TRANSFORMER NOT ALL ABBREVIATIONS WILL BE USED. USED FOR REFERENCE PURPOSES ONLY.

COMMUNICATIONS LEGEND

REFERENCE ARCHITECTURAL ELEVATION PLANS FOR DEVICE MOUNTING HEIGHT UNLESS OTHERWISE NOTED (UON).

- DATA OUTLET WALL MOUNTED UON BOTTOM TO BOTTOM 15" AFF
- √(TEL) TELEPHONE OUTLET WALL MOUNTED UON BOTTOM TO BOTTOM 15" AFF
- DATA/TELEPHONE OUTLET WALL MOUNTED UON BOTTOM TO BOTTOM 15" AFF (TO SHOW BOTH DATA/DATA FOR TELEPHONE LOCATIONS)
- FLUSH FLOOR BOX WITH THE FOLLOWING: J (2) DATA CABLE

LEGRAND (EFB45S) FLOOR RECESSED JUNCTION BOX WITH COMMUNICATION INTERNAL ACCESSORIES AS REQUIRED FOR DATA DEVICES, TWO BLANK PLATES WITH (EFB45) COVER PLATES IN BRUSHED ALUMINUM. CONTRACTOR TO FURNISH AND INSTALL FLOOR BOX AND ALL CONNECTORS, ETC. REFER TO SYSTEMS PLAN SHEET FOR LOCATION.

FIRE ALARM LEGEND

- IN-DUCT SMOKE DETECTOR 120 VOLT FURNISHED AND WIRED BY DIVISION 16 - INSTALLED BY DIVISION 15
- REMOTE ALARM INDICATOR WITH KEY OPERATED TEST SWITCH, LED, AND RESET - WALL MOUNT 60" AFF TO CENTER
- RELAY FOR UNIT SHUT-DOWN

GENERAL INFORMATION

- 1. TEXT SHOWN ON PLANS ADJACENT TO LIGHTING FIXTURES SHALL DENOTE THE FOLLOWING: A - UPPERCASE LETTER INDICATES FIXTURE TYPE a - LOWERCASE LETTER INDICATES LIGHT SWITCH CONTROL 1 - NUMBER INDICATES BRANCH CIRCUIT NUMBER
- 2. LIGHT FIXTURE HATCHING SHALL BE INTERPRETED AS FOLLOWS:
- NORMAL BRANCH CIRCUIT

EMERGENCY LIGHT FIXTURE WITH BATTERY BACKUP

- NUMBERS SHOWN ON PLANS ADJACENT TO WIRING DEVICES INDICATE BRANCH CIRCUIT NUMBER.
- STANDARD SYMBOLS SHOWN ON LEGEND MAY NOT APPEAR ON ALL PLANS. WHERE SYMBOL APPEARS ON PLANS FURNISH AND INSTALL AS SPECIFIED.

LIGHTING LEGEND

REFERENCE ARCHITECTURAL ELEVATION PLANS FOR DEVICE MOUNTING HEIGHT UNLESS OTHERWISE NOTED (UON).

LIGHT FIXTURE: CEILING SURFACE-MOUNT OR PENDANT

LIGHT FIXTURE: WALL SURFACE-MOUNT

LIGHT FIXTURE: RECESSED DOWNLIGHT \bigcirc

LIGHT FIXTURE: RECESSED 2x2 GRID

LIGHT FIXTURE: GRID-RECESSED LINEAR TROFFER

LIGHT FIXTURE: LINEAR SURFACE-MOUNT UPLIGHT

LIGHT FIXTURE: HORIZONTAL WALL-MOUNT WITH INTEGRAL OCCUPANCY SENSOR

LIGHT FIXTURE: UNDERCABINET WITH INTEGRAL OCCUPANCY SENSOR

LIGHT FIXTURE: VERTICAL WALL-MOUNT WITH INTEGRAL OCCUPANCY SENSOR

EXIT SIGN INDICATING LIGHTED SIDE(S) AND EGRESS ARROW DIRECTION

BATTERY-POWERED TWIN HEAD EMERGENCY LIGHT FIXTURE

POWER LEGEND


REFERENCE ARCHITECTURAL ELEVATION PLANS FOR DEVICE MOUNTING HEIGHT UNLESS OTHERWISE NOTED (UON).



HOMERUN TO PANEL INDICATED (CONCEALED), MINIMUM 3/4" CONDUIT, UNLESS OTHERWISE NOTED PROVIDE #12 CONDUCTORS AS REQUIRED BY THE NUMBER OF CIRCUITS SHOWN. INCLUDE #12 GROUND AND #12 NEUTRAL CONDUCTORS. FOR HOMERUNS EXCEEDING 100' IN LENGTH PROVIDE #10 CONDUCTORS. FOR HOMERUNS EXCEEDING 150' IN LENGTH PROVIDE #8 CONDUCTORS. THERE SHALL BE A MAXIMUM OF 2 BRANCH CIRCUITS FOR SINGLE PHASE AND 3 BRANCH CIRCUITS FOR THREE PHASE PER HOMERUN (AS INDICATED ON THE PLANS). TEXT SHOWN BY HOMERUN INDICATES PANELBOARD DESIGNATION AND CIRCUIT NUMBER(S).



CONDUIT CONCEALED IN WALL OR ABOVE CEILING SPACE. UNLESS OTHERWISE NOTED PROVIDE #12 CONDUCTORS AS REQUIRED BY THE NUMBER OF CIRCUITS SHOWN. INCLUDE #12 GROUND AND #12 NEUTRAL. MINIMUM 1/2" CONDUIT.

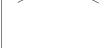

UNDERGROUND OR BELOW SLAB CONDUIT. UNLESS OTHERWISE NOTED PROVIDE



#12 CONDUCTORS AS REQUIRED BY THE NUMBER OF CIRCUITS SHOWN. INCLUDE #12 GROUND AND #12 NEUTRAL. MINIMUM 3/4" CONDUIT.

GROUNDING ELECTRODE CONDUCTOR AS INDICATED CEILING OR WALL MOUNTED JUNCTION BOX - UON SIZE AS REQUIRED BY NEC

MOTOR AS INDICATED

SURGE PROTECTIVE DEVICE AS INDICATED PANELBOARD - BRANCH CIRCUIT TYPE - 120/208V

UTILITY TRANSFORMER AS INDICATED (PAD OR POLE MOUNTED)

METER SOCKET

NON-FUSIBLE DISCONNECT SWITCH - HEAVY DUTY - SEE SPECIFICATIONS - MOUNT TOP OF ENCLOSURE 66" AFF, (UON) FUSIBLE DISCONNECT SWITCH - HEAVY DUTY - FUSED AS INDICATED ON

PLANS - SEE SPECIFICATIONS - MOUNT TOP OF ENCLOSURE 66" AFF, (UON)

ENCLOSED CIRCUIT BREAKER - HEAVY DUTY - SEE SPECIFICATIONS - MOUNT TOP OF ENCLOSURE 66" AFF, (UON)

SINGLE RECEPTACLE - 20A, 120V - CENTER MOUNTED 18" AFF, (UON) DUPLEX RECEPTACLE - 20A, 120V - CENTER MOUNTED 18" AFF, (UON)

FLUSH FLOOR BOX WITH THE FOLLOWING: (2) POWER AS SHOWN ON POWER PLAN SHEET LEGRAND (EFB45S) FLOOR RECESSED JUNCTION BOX WITH POWER AND INTERNAL ACCESSORIES AS REQUIRED FOR TWO 120V DUPLEX RECEPTACLES AND TWO BLANK PLATES WITH (EFB45) COVER PLATES IN BRUSHED ALUMINUM. CONTRACTOR TO FURNISH AND INSTALL FLOOR BOX AND ALL OUTLETS, CONNECTORS, ETC. REFER TO POWER PLAN SHEET FOR LOCATION.

DOUBLE DUPLEX RECEPTACLE - 20A, 120V - CENTER MOUNTED 18" AFF, (UON)

SECURITY LEGEND

REFERENCE ARCHITECTURAL ELEVATION PLANS FOR DEVICE MOUNTING HEIGHT UNLESS OTHERWISE NOTED (UON).

- KEY SWITCH MOUNTED IN DOOR JAMB
- CARD READER UON BOTTOM MOUNTED
- PUSH BUTTON ACTUATOR UON BOTTOM MOUNTED
- KEY PAD UON BOTTOM MOUNTED
- ELECTRIC STRIKE MOUNTED ON DOOR
- **AUTOMATIC TELLER MACHINE**
- AHD AFTER HOURS DEPOSITORY ALARM TCD - TELLER CASH DISPENSER
- ALARM LIGHT/LAMP @ 80" A.F.F., U.O.N.
- VAULT

HUB - HOLDUP BUTTON WHUB - WIRELESS HOLDUP BUTTON

ALARM SHUNT SWITCH

MAIN SECURITY PANEL

JUNCTION BOX/MAIN

VIDEO SWITCHER VIDEO TIMER

VIDEO MONITOR

RADIO @ 12" ABOVE CEILING, (UON)

INTERNAL ATM CAMERA

SECURITY/COMMUNICATION SYSTEM E.C. TO PROVIDE ROUGH-IN @ CONCEALED SPACES; ROUGH-IN TO CONSIST OF 3/4" CONDUIT, 4x4 BOXES AND SINGLE GANG RINGS (VERTICAL), LOW VOLTAGE VENDOR TO PROVIDE AND INSTALL SECURITY CABLING, COORDINATE WITH SECURITY VENDOR.

SWITCHING LEGEND

REFERENCE ARCHITECTURAL ELEVATION PLANS FOR DEVICE MOUNTING HEIGHT UNLESS OTHERWISE NOTED (UON).

SINGLE POLE SWITCH - 20A, 120V - REFER TO ARCH DRAWINGS FOR MOUNTING HEIGHTS

SINGLE POLE SWITCH - 20A, 120V - REFER TO ARCH DRAWINGS FOR MOUNTING HEIGHTS

- LOWERCASE LETTER INDICATES SWITCHING DESIGNATION DOUBLE POLE SWITCH - 20A, 120V - REFER TO ARCH DRAWINGS FOR MOUNTING HEIGHTS LOWERCASE LETTER INDICATES SWITCHING DESIGNATION
- THREE WAY SWITCH 20A, 120V REFER TO ARCH DRAWINGS FOR MOUNTING HEIGHTS
- LOWERCASE LETTER INDICATES SWITCHING DESIGNATION FOUR WAY SWITCH - 20A, 120V - REFER TO ARCH DRAWINGS FOR MOUNTING HEIGHTS LOWERCASE LETTER INDICATES SWITCHING DESIGNATION
- KEYED SWITCH 20A, 120V REFER TO ARCH DRAWINGS FOR MOUNTING HEIGHTS LOWERCASE LETTER INDICATES SWITCHING DESIGNATION
- DIMMER SWITCH REFER TO ARCH DRAWINGS FOR MOUNTING HEIGHTS LOWERCASE LETTER INDICATES SWITCHING DESIGNATION
- MOTOR RATED SWITCH WITH TOL REFER TO ARCH DRAWINGS FOR MOUNTING HEIGHTS
- TIMER DELAY SWITCH REFER TO ARCH DRAWINGS FOR MOUNTING HEIGHTS TIME SWITCH AS INDICATED - UON MOUNT TOP OF ENCLOSURE 66" AFF
- PHOTO CELL COORDINATE MOUNTING LOCATION WITH ARCHITECT LIGHTING CONTACTOR - ELECTRICALLY HELD - NUMBER OF POLES AS NEEDED
- OCCUPANCY SENSOR WALL MOUNTED SEE SPECIFICATIONS - REFER TO ARCH DRAWINGS FOR MOUNTING HEIGHTS
- OCCUPANCY SENSOR CEILING MOUNTED SEE SPECIFICATIONS
- WAPM)) WIRELESS ADAPTER (WA100-PM) WGA 100) WIRELESS GENERAL ADAPTER (WGA 100)
- WIRELESS WALL DIMMER (WWD1) (RM))) WIRELESS PIR (WOS2-RM-E)

GENERAL NOTES:

REFER TO ARCHITECTURAL DRAWINGS FOR INTERIOR ELECTRICAL SYSTEM DEVICE AND FIXTURE LOCATIONS AND ADDITIONAL INFORMATION ON BUILDING ENVELOPE FIXTURES AND DEVICES.

- ALL LINE- AND LOW-VOLTAGE WIRING SHALL BE INSTALLED IN CONDUIT SYSTEMS CONFORMING TO PROJECT MANUAL SPECIFICATIONS SECTION 260531. THE FOLLOWING CONDUITS ARE PERMITTED; • GALVANIZED RIGID CONDUIT (GRC): HOT DIPPED GALVANIZED RIGID STEEL WITH THREADED ENDS. MEET ASTM STANDARD A-153 GALVANIZED AFTER FABRICATION. • INTERMEDIATE METAL CONDUIT (IMC): RIGID MILD STEEL TUBE WITH WELDED SEAMS, HOT DIPPED
 - GALVANIZED WITH THREADED ENDS. • THIN WALL: ELECTRO-GALVANIZED ELECTRICAL METALLIC TUBING (EMT).
 - CONDUITS MUST ALSO BE; • FLEXIBLE: ALLOWED WITH-IN 4'-0" FLEXIBLE CONNECTION ONLY. HOT DIPPED GALVANIZED MATERIAL OF MILD STEEL OF UNIFORM WIDTH AND THICKNESS. • FLEXIBLE LIQUID TIGHT: ALLOWED WITH-IN 4'-0" FLEXIBLE CONNECTION ONLY. HOT DIPPED
- ALL CONDUIT SYSTEMS CONFORMING TO PROJECT MANUAL SPECIFICATIONS SECTION 260531 MUST BE UTILIZED WITH APPROPRIATE CONDUIT FITTINGS;
 - GRC CONDUIT: THREADED TYPE.

GALVANIZED MATERIAL OF MILD SHELL OF UNIFORM WIDTH AND THICKNESS WITH EXTRUDED


- IMC CONDUIT: THREADED TYPE • THIN WALL OR EMT: RAIN-TIGHT AND CONCRETE-TIGHT, GLAND COMPRESSION TYPE, INSULATED NYLON THROAT WITH DIE-CAST BODY AND STEEL NUT, APPLETON TYPE 86T SERIES OR EQUAL. FOR CONDUIT SIZES 3" AND LARGER (WHERE NOT REQUIRED TO BE RAIN OR CONCRETE TIGHT)
- SET-SCREW TYPE IS ACCEPTABLE. • FLEXIBLE CONDUIT: SINGLE OR TWO PIECE SQUEEZE TYPE.

MOISTURE AND OIL PROOF PVC JACKET.

- FLEXIBLE LIQUID TYPE: COMPRESSION TYPE. ALL LINE- AND LOW-VOLTAGE WIRING SHALL BE INSTALLED IN CONDUIT SYSTEMS CONFORMING TO PROJECT MANUAL SPECIFICATIONS SECTION 260531. ARMORED AND METAL-SHEATHED CABLES (GENERICALLY "BX"), TYPES AC AND MC, AND NON-METALLIC SHEATHED CABLES (GENERICALLY
- "ROMEX"), TYPES NM, NMC, AND NMS, ARE NOT PERMITTED. ALL ENDS OF CONDUIT SHALL HAVE BUSHING OR A COUPLING INSTALLED FOR THE PURPOSE OF
- PROVIDING PROTECTION OF CONDUCTORS. IN NO CASE ARE CONDUIT ENDS PERMITTED TO REMAIN
- ALL LOW VOLTAGE WIRING IN INACCESSIBLE AREAS SHALL BE INSTALLED IN METALLIC CONDUIT. CONDUIT SYSTEMS INSTALLED ON THE ROOF SHALL BE INSTALLED IN METALLIC CONDUIT AND
- SUPPORTED EVERY FIVE FEET.
- ALL WIRING FOR THE PURPOSE OF EMERGENCY SYSTEMS SHALL BE INSTALLED IN A SEPARATE CONDUIT SYSTEM INDEPENDENT OF OTHER SYSTEMS.
- THERE SHALL BE SEPARATE IDENTIFIED NEUTRAL INSTALLED FOR EACH EMERGENCY LIGHTING CIRCUIT AND/OR EXIT LIGHTING CIRCUIT.
- SECURELY FASTEN EACH RECESSED GRID LIGHT FIXTURE TO THE CEILING SYSTEM WITH APPROPRIATE SUPPORT BRACKETS AND CLIPS PER INDUSTRY STANDARDS. AT LEAST TWO CORNERS OF EACH FIXTURE SHALL BE SUPPORTED INDEPENDENTLY FROM ANY OTHER SUPPORTING SYSTEM.
- REFER TO ARCHITECTURAL DRAWINGS FOR ALL LIGHT FIXTURE LAMP ORIENTATION.
- ALL LIGHTING SHALL BE PROTECTED BY A MAXIMUM 20 AMP CIRCUIT BREAKER.
- COORDINATE WITH SPECIFICATION 260519 THAT LOW VOLTAGE CONDUCTOR AND CABLE IS COMPLIANT. SHALL CONTAIN A PROPERLY SIZED GREED GROUND CONDUCTOR AND SHALL NOT EXCEED SIX FEET (6') IN LENGTH.
- ALL BRANCH CIRCUIT CONDUCTORS SHALL BE CONNECTED BY MEANS OF A SCREW TERMINAL. THE CONTINUITY OF ANY BRANCH CIRCUIT CONDUCTOR INCLUDING ANY IDENTIFIED GROUNDED CONDUCTOR SHALL NOT DEPEND UPON DEVICE CONNECTIONS, SUCH AS LAMPHOLDERS,
- RECEPTACLES, ETC., WHERE THE REMOVAL OF SUCH DEVICES WOULD INTERRUPT THE CONTINUITY. DE-RATING OF THE NEUTRAL IS PROHIBITED.
- THE USE OF AUXILIARY GUTTERS, WIREWAYS, RACEWAYS, AS ENCLOSURES FOR SERVICE ENTRANCE
- OR TAPPING OF SERVICE ENTRANCE CONDUCTORS IS STRICTLY PROHIBITED. METAL IDENTIFICATION TAGS SHALL BE INSTALLED WHERE THE GROUNDING CONDUCTOR IS

JUNCTION BOXES AT 8" MIN. AFF AND PROVIDE FLEXIBLE CONDUIT TO PARTITIONS SYSTEM RACEWAY.

- CONNECTED TO THE GROUNDING ELECTRODE. ALL POWER, DATA AND SECURITY CONDUIT CONNECTIONS TO SYSTEMS FURNITURE PANELS SHALL BE BY THE ELECTRICAL CONTRACTOR. COORDINATE EXACT LOCATIONS AND CONNECTION requirements with owner's systems furniture vendor prior to rough-in, install flusi
- REFER TO ARCHITECTURAL DRAWINGS FOR ORIENTATION OF POWER, DATA AND SECURITY SYSTEMS JUNCTION BOXES AND MUD RINGS
- REFER TO ARCHITECTURAL DRAWINGS FOR ELECTRICAL, DATA, AND SECURITY DEVICE AND COVER
- PLATE COLORS. ISOLATED GROUND RECEPTACLES SHALL BE ORANGE.
- PENETRATIONS OF FLOORS, ROOF, WALLS AND WALL MEMBRANES REQUIRED TO HAVE FIRE-RESISTANCE RATINGS SHALL BE PROTECTED WITH THROUGH-PENETRATION FIRE STOPS SUITABLE FOR THE METHOD OF PENETRATION. MAINTAIN ALL FIRE RATINGS. THROUGH-PENETRATIONS FIRE
- STOPS SHALL BE TESTED IN ACCORDANCE WITH UL AND BUILDING CODE REQUIREMENTS. ALL WORK SHALL BE IN ACCORDANCE WITH THE CURRENTLY ENFORCED NATIONAL ELECTRICAL
- UNLESS OTHERWISE DICTATED BY APPLICABLE CODES OR THE AHJ, ALL MATERIALS WITHIN RETURN AIR PLENUM MUST BE NONCOMBUSTIBLE AND/OR HAVE A FLAME SPREAD INDEX OF NOT MORE THAN 25 AND A SMOKE-DEVELOPED INDEX NOT MORE THAN 50 IN ACCORDANCE WITH ATSM E 84
- THE ELECTRICAL/DATA ROOM MUST BE 100% COMPLETE AT A MINIMUM OF 45 DAYS PRIOR TO CONSTRUCTION COMPLETION/TURNOVER DATE.
- UNLESS OTHERWISE NOTED, ALL RECEPTACLES SHALL BE MOUNTED AT 18" AFF. REFER TO ARCHITECTURAL ELEVATIONS FOR FINAL LOCATIONS AND MOUNTING HEIGHTS.
 - E.C. TO PROVIDE LABELS ON ALL RECEPTACLES (ELECTRICAL, DATA, AND SECURITY). COORDINATE LABEL NAMING CONVENTIONS WITH OWNER PRIOR TO INSTALLATION.

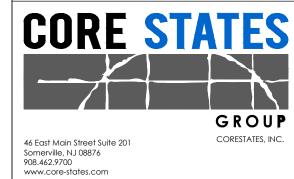

ENGINEER OF RECORD



01/19/2021

HESE DRAWINGS ARE NOT COMPLETE WITHOUT THE SEPARATE TYPE WRITTEN SPECIFICATIONS MANUAL

WHICH ARE PART OF THE CONTRACT DOCUMENTS.

JOHN FERGUSON, P.E.

LICENSE #: 2008014085

ISSUE DATE DESCRIPTION 2020.12.21 PERMIT SET

PROJECT INFORMATION

PROJECT NO: JPM.27135.001 2020.12.21 **PROTOTYPE** D. BORELLI DRAWN BY: CHECKED BY: D. MULVANEY VERSION: SE_1.00

LEGEND, **ABBREVIATIONS** AND NOTES

SHEET TITLE

SHEET NUMBER

			CONTROL FUNCTION					
ZONE	LOCATION / ROOM / FUNCTION	ON	OFF	TYPE	OVER-RIDE TYPE	OVER-RIDE LOCATION	REMARKS	
1	DRIVE-UP CANOPY	PHOTOCELL	SCHEDULE	DAINTREE	SOFTWARE, WALL SWITCH	AT OR NEAR TELLER LINE	4	
2A, 2B	BUILDING AND POLE-MOUNT EXTERIOR AREA LIGHT FIXTURES (SUB-ZONES AS REQUIRED)	PHOTOCELL	SCHEDULE	DAINTREE	SOFTWARE, WALL SWITCH	AT OR NEAR TELLER LINE	4	
3	EXTERIOR ENTRANCE DOWNLIGHTS AND SITE MONUMENT / PYLON SIGNS	PHOTOCELL	PHOTOCELL	DAINTREE	SOFTWARE, WALL SWITCH	AT OR NEAR TELLER LINE	4	
4	EXTERIOR BUILDING SIGNAGE AND CANOPY SIGNAGE	PHOTOCELL	SCHEDULE	DAINTREE	SOFTWARE, WALL SWITCH	AT OR NEAR TELLER LINE	4	
5	EXTERIOR DECORATIVE AND WALL-WASH FIXTURES AND EXTERIOR-FACING INTERIOR SIGNAGE	SCHEDULE	SCHEDULE	DAINTREE	SOFTWARE, WALL SWITCH	AT OR NEAR TELLER LINE	4	
6	VESTIBULE (ALWAYS ON)	NA	NA	DAINTREE	SOFTWARE, WALL SWITCH	AT OR NEAR TELLER LINE	1, 5	
7	CONFERENCE ROOM ACCENT	SCHEDULE	SCHEDULE	DAINTREE	SOFTWARE, WALL SWITCH	IN ROOM		
8	CONFERENCE ROOM PENDANT(S) (ALWAYS ON, WITH IN-ROOM OVER-RIDE)	SCHEDULE 50%	SCHEDULE 10%	DAINTREE	SOFTWARE, WALL DIMMER	2 IN ROOM	2	
9A, 9B	PRIVATE OFFICE (PCS/CCS) AND BOOTH DESK PENDANTS (ALWAYS ON)	SCHEDULE 50%	SCHEDULE 10%	DAINTREE	SOFTWARE, WALL DIMMER	AT OR NEAR TELLER LINE	2	
I0A, 10B	LOBBY GENERAL (SUB-ZONES AS REQUIRED)	SCHEDULE	SCHEDULE	DAINTREE	SOFTWARE, WALL SWITCH	AT OR NEAR TELLER LINE	1	
I1A, 11B	VESTIBULE AND LOBBY ACCENT - COVE STRIPS, ETC. (ALWAYS ON)	NA O	NA	DAINTREE	SOFTWARE, WALL DIMMER	AT OR NEAR TELLER LINE		
12A, 12B	OFFICE AND CONFERENCE GENERAL LIGHTING	NA	NA	DAINTREE	SOFTWARE, WALL DIMMER	IN ROOM	1	
13A, 13B	BOOTH GENERAL LIGHTING	OCCUPANCY^	VACANCY	~LINE/VOLTAGE~	NONE	NA NA	1	
14	PRINT/FILE	OCCUPANCY	VACANCY	LINE VOLTAGE	NONE	NA	3	
15	SDB CHEST AND VIEWING ROOMS AND SDB VAULTS	OCCUPANCY	VACANCY	LINE VOLTAGE	NONE	NA		
16	BACK-OF-HOUSE WORK AREAS (LAO, CASH, AT, ATM, ETC.)	OCCUPANCY	VACANCY	LINE VOLTAGE	NONE	NA	3	
17	MANUAL TRANSACTION (TELLER LINE)	OCCUPANCY	VACANCY	LINE VOLTAGE	NONE	NA	3	
18	SERVICE HALLWAYS	OCCUPANCY	VACANCY	LINE VOLTAGE	NONE	NA		
19	RESTROOMS	OCCUPANCY	VACANCY	LINE VOLTAGE	NONE	NA		
20	LOUNGE	OCCUPANCY	VACANCY	LINE VOLTAGE	NONE	NA	3	
21	UTILITY EXCEPT DATA (JANITOR, LADDER, ELEC, PLUMBING, SPRINKLER, ETC)	OCCUPANCY	VACANCY	LINE VOLTAGE	NONE	NA	6	
22	DATA	MANUAL	MANUAL	LINE VOLTAGE	NONE	NA		
23	RESTROOM / JANITOR / LOUNGE EXHAUST SYSTEM	OCCUPANCY	VACANCY	LINE VOLTAGE	NONE	NA	7	


Aor to adjust controls specification as required to meet codes enforced by authority having jurisdiction. Where simple occupancy/vacancy sensor control is required, line voltage controls are


OR SIMILAR AUTOMATIC DIMMING CONTROL REQUIREMENTS ARE ENFORCED BY AN AUTHORITY HAVING JURISDICTION. WHERE NOT REQUIRED, OMIT PHOTOSENSORS AND AUTOMATIC DIMMING.

WHERE LINE VOLTAGE CONTROLS ARE IMPLEMENTED IN LIEU OF DAINTREE CONTROLS. PROVIDE PILOT LIGHT SWITCH WHERE FIXTURES ARE NOT VISIBLE FROM THE SWITCH LOCATION.

EXTERIOR SITE POLE, BUILDING-MOUNTED, AND SIGNAGE FIXTURES SHALL HAVE A WWD1 MASTER OVER-RIDE SWITCH LOCATED IN INTERIOR SWITCH BANK NEAR TELLER LINE CONTROLLED VIA WA100-PPM(S).

PROVIDE IN-ROOM WIRELESS MANUAL DIMMER. PROGRAM FOR 50% DIMMING DURING BRANCH HOURS AND 10% DIMMING AFTER BRANCH HOURS.

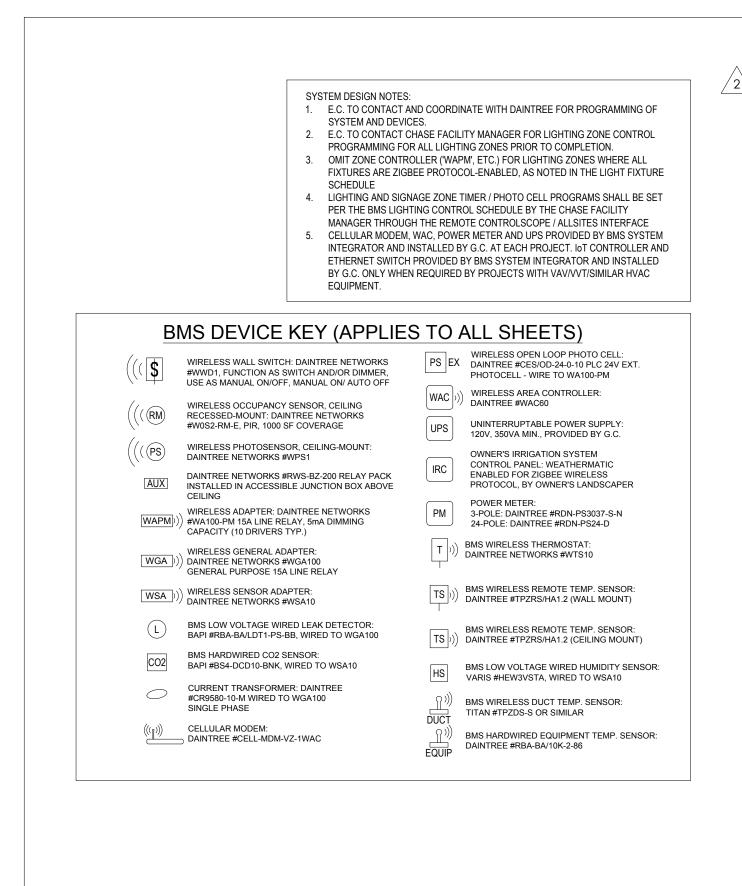

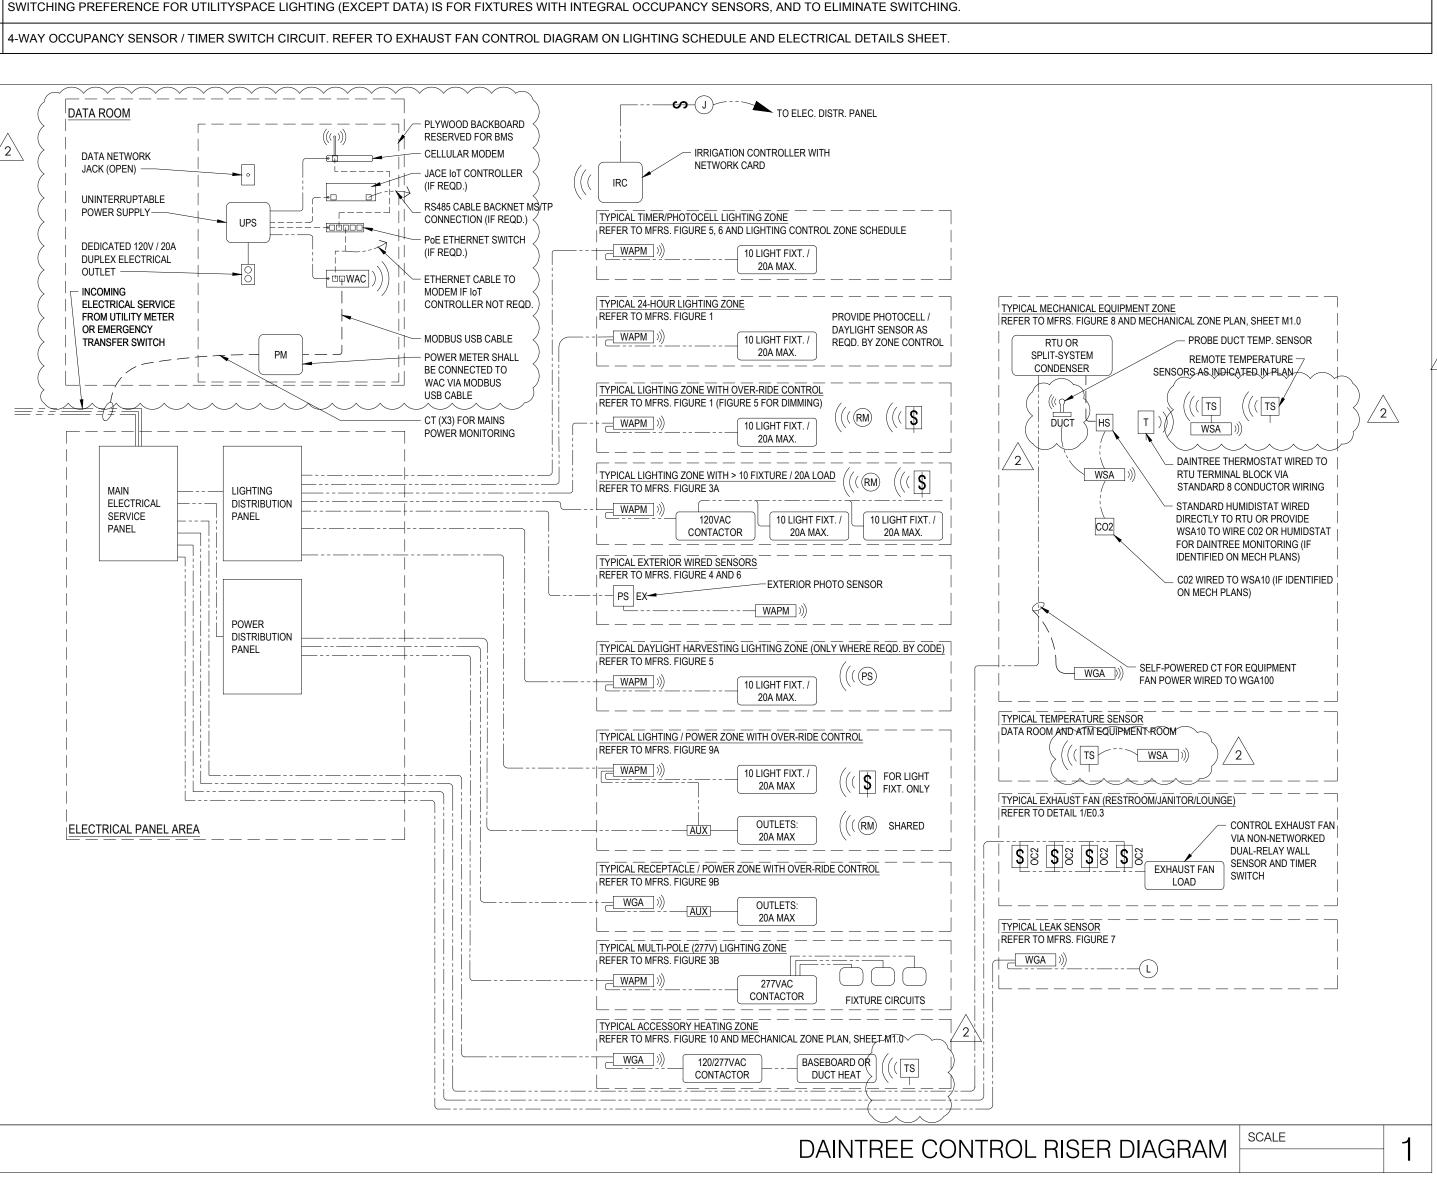

BUILDING ENERGY MANAGEMENT SYSTEM (BMS) GENERAL INSTALLATION NOTES

ALL SENSORS, SWITCHES AND CONTROLLERS AND TO CONFORM WITH THE MANUFACTURER'S RECOMMENDATIONS | VENDOR 30 DAYS IN ADVANCE OF THE BID DATE THAT AND MEET THE FUNCTIONAL REQUIREMENTS OF THE

TO THE LOCATION OF THE COMPONENT.

C. PERFORM PROPER TEST SUITE.

5. INSTALLER MUST BECOME FAMILIAR WITH THE PUBLISHED INSTALLATION GUIDES FOR THE PRODUCTS IN THE PROJECT | 5. EMERGENCY LIGHT FIXTURES WITH BATTERY PACKS ARE SCOPE. DAINTREE INSTALLATION GUIDES CAN BE FOUND AT: NOT INDICATED FOR SEPARATE ZONE CONTROL, BUT SHALL https://products.currentbyge.com/control-systems/ daintree-enterprise-wireless-controls

6. DO NOT INSTALL BATTERIES IN WIRLESS DEVICES PRIOR TO APPROVAL FROM GE'S COMMISSIONING LIAISON. INSTALLING BATTERIES MORE THAN 10 DAYS PRIOR TO COMMISSIONING CAN RESULT IN PREMATURE BATTERY FAILURE.

DAINTREE MECHANICAL CONTROL

2. DURING INSTALLATION THE LAST 4 DIGITS OF THE IEEE ADDRESS FOR EACH WIRELESS COMPONENT MUST BE RECORDED ON THE SHOP DRAWING SET CORRESPONDING TO THE LOCATION OF THE COMPONENT.

3. FOR ANY SENSORS ATTACHED TO A WIRELESS SENSOR ADAPTER (WSA10) THE LAST 4 DIGITS OF THE IEEE ADDRESS FOR THE RESPECTIVE WSA10 MUST BE RECORDED. THE SPECIFIC WSA10 PORT MUST ALSO BE RECORDED PER

4. DURING WIRELESS ADAPTER INSTALLATION FOLLOW THESE STEPS AS DEFINED IN THE DEVICE INSTALLATION GUIDE IN THE FOLLOWING ORDER. A. CONFIRM WIRELESS ADAPTER DIP SWITCHES ARE SET CORRECTLY.

INSTALLATION GUIDES FOR THE PRODUCTS IN THE PROJECT | AND PRINT ROOM CONVENIENCE RECEPTACLES (NOT https://products.currentbyge.com/control-systems/ daintree-enterprise-wireless-controls

6. ELECTRICAL CONTRACTOR IS RESPONSIBLE FOR PROCUREMENT AND INSTALL OF DAINTREE AND RELATED COMPONENTS PERTAINING TO IT/DATA, LIGHTING, POWER AND HVAC.

7. THE IOT CONTROLLER AND ASSOCIATED BACNET HARDWARE IS REQUIRED TO PROVIDE CONTROL FUNCTIONS TO VAV, VVT, OR SIMILAR MULTI-ZONED HVAC SYSTEMS. BACNET HARDWARE WILL BE INCLUDED IN THE BMS EQUIPMENT ORDER TO GE-CURRENT/DAINTREE, AND INSTALLED AND PHYSICALLY CONNECTED TO THE BMS UNDER THE GENERAL CONTRACT. INSTALLERS MAY CONTACT THEIR SYSTEM INTEGRATOR FOR INSTALLATION < ASSISTANCE.

INSTALLATION IN THEIR BIDS. THE GC'S HVAC TECHNICIAN.

8.2. POINT INTEGRATION SERVICE FOR THE BACNET HARDWARE WILL BE PERFORMED BY GE-CURRENT FOLLOWING HVAC EQUIPMENT AND CONTROLS COMMISSIONING. THIS MAY REQUIRE AN ON-SITE VISIT BY GE-CURRENT.

CONTROLSCOPE COMMISIONING

1. CONTRACTOR IS RESPONSIBLE FOR CORRECT WIRING, TESTING, AND DOCUMENTATION OF ALL IEEE DEVICE ADDRESSES IN A FORMAT REQUIRED BY THE CONTROLS SUPPLIER.

3. CONTRACTOR IS RESPONSIBLE FOR PROVIDING FIELD LABOR ASSISTANCE TO FACILITATE THE COMMISSIONING EFFORT, INCLUDING BUT NOT LIMITED TO REPAIRING INCORRECT WIRING, LOCATING DEVICES WHERE THE ADDRESSES WERE NOT DOCUMENTED OR NOT LOCATED PROPERLY, AND RESETTING DEVICES.

1. INSTALLER IS RESPONSIBLE FOR THE FINAL LOCATION OF $\parallel 1$. COORDINATION WITH THE BMS VENDOR IS REQUIRED.

2. CONTROLSCOPE UTILIZES DISTRIBUTED CONTROL FOR ON/OFF AND DIM STATE. EXISTING RELAY PANELS AND LINE-SIDE SWITCHES MUST BE OVERRIDDEN OR REMOVED. ALL WIRELESS ADAPTER MUST BE PROVIDED WITH UNINTERRUPTED/UNSWITCHED POWER.

3. DURING INSTALLATION THE LAST 4 DIGITS OF THE IEEE ADDRESS FOR EACH WIRELESS COMPONENT MUST BE RECORDED ON THE SHOP DRAWING SET CORRESPONDING

4. DURING WIRELESS ADAPTER INSTALLATION FOLLOW THESE STEPS AS DEFINED IN THE DEVICE INSTALLATION GUIDE IN THE FOLLOWING ORDER. A. CONFIRM WIRELESS ADAPTER DIP SWITCHES ARE SET

B. RESET ADAPTER (ALL ADAPTERS)

7. TO AVOID FALSE TRIGGERS FROM OCCUPANTS WALKING PAST OPEN DOORS, CARE SHOULD BE TAKEN | 8. ROOF CENTRIFUGAL EXHAUST FAN IS NOT CONTROLLED TO PLACE SENSORS WITH NO OR MINIMAL VIEWING BY BMS. REFER TO EXHAUST FAN CONTROL DIAGRAM ON ANGLE THROUGH DOORWAY. IF THE DISTANCE BETWEEN THE DOORWAY AND THE CENTER OF THE ROOM IS LESS THAN 12 FEET, IT IS ADVISABLE TO MOVE THE SENSOR TOWARD THE CORNER OF THE ROOM TO REDUCE THE VIEWING ANGLE THROUGH THE DOORWAY.

1. ALL WIRELESS ADAPTERS MUST BE PROVIDED WITH UNINTERRUPTED/UNSWITCHED POWER. WSA10 WIRELESS SENSOR ADAPTERS REQUIRE 24V POWER.

B. RESET ADAPTER (ALL ADAPTERS) C. PERFORM PROPER TEST SUITE.

SCOPE. DAINTREE INSTALLATION GUIDES CAN BE FOUND AT:

8. BIDDER ARE TO INCLUDE BACNET HARDWARE &

8.1. THE INITIAL PROGRAMMING AND COMMISSIONING OF THE CARRIER I-VUE (OR SIMILAR TRANE OR OTHER MANUFACTURER'S SYSTEM) WILL BE PERFORMED BY

2. CONTRACTOR IS RESPONSIBLE FOR COORDINATING INSTALLATION AND COMMISSIONING EFFORTS WITH THE CONTROLS PROVIDER TO SATISFY THE CONSTRUCTION TIMELINE.

BMS LIGHTING AND POWER CONTROL AND SENSOR NOTES

THE ARCHITECT/ENGINEER OF RECORD SHALL ADVISE THE PROJECT DESIGN HAS COMMENCED. SUBMITTAL FOR VENDOR REVIEW AND COORDINATION MUST BE EXECUTED WITH ADEQUATE TIME TO ALLOW COORDINATION AND ADJUSTMENTS BETWEEN THE ARCHITECT, MECHANICAL ENGINEER AND ELECTRICAL ENGINEER BEFORE BID.

2. WHERE REQUIRE BY AUTHORITIES HAVING JURISDICATION, PROVIDE CONTROL DEVICES AND CIRCUITING AS REQUIRED TO COMPLY WITH ENERGY EFFICIENCY CODE(S) ONLY WHERE APPLICABLE.

3. DESIGNER SHALL CLEARLY INDICATE IN CONSTRUCTION DOCUMENTS THAT THE WIRELESS DEVICE CONTROLS REPLACE TYPICAL HARDWIRED SWITCHING AND WIRING REQUIREMENT, AND THE THE CONDUIT SYSTEM IS NOT REQUIRED FOR THE CONTROL DEVICES ASSOCIATED WITH THE BMS EXCEPT AS NOTED.

4. ZONE Z5 FOR EXTERIOR-FACING INTERIOR SIGNAGE NOT PROVIDED WITH THIS PLAN, BUT WOULD BE REQUIRED FOR WALL-WASH RECESSED CANS AIMED AT SIGNAGE, ILLUMINATED LETTER SETS, ETC.

BE PROVIDED WITH CONTROL DEVICES AS REQUIRED TO SYNCHRONIZE FIXTURE SWITCHING WITH OTHER FIXTURES WITHIN THE SPECIFIED ZONE.

6. FIXTURES WITH INTEGRAL OCCUPANCY SENSORS (UNDERCABINET, ETC.) DO NOT REQUIRE ZONE CONTROL

7. EXIT LIGHT FIXTURES ARE EXCLUDED FROM BMS ZONE

LIGHTING SCHEDULE AND ELECTRICAL DETAILS SHEET FOR HARDWIRED LINE-VOLTAGE CONTROL REQUIREMENTS.

9. LARGE FIXTURE GROUPS TAGGED WITH A COMMON ZONE, SUCH AS THE SITE AREA LIGHT FIXTURES OR LOBBY TROFFERS, ARE TO BE CONTROLLED SIMULTANEOUSLY. CONTROL AND SUB-ZONES ARE TO BE PROVIDED AND CONTROLLED BY RELAY CIRCUITS AS DETERMINED BY THE MAXIMUM NUMBER OF FIXTURES PERMITTED ON A SINGLE

10. REFER TO MECHANICAL DRAWINGS FOR MECHANICAL EQUIPMENT REPORTING AND CONTROL DEVICES.

11. LIGHTING AND SIGNAGE ZONE TIMER / PHOTOCELL PROGRAMS SHALL BE SET PER THE BMS LIGHTING CONTROL SCHEDULE BY THE CHASE FACILITY MANAGER THROUGH THE REMOTE CONTROLSCOPE / ALLSITES INTERFACE.

12. MULTI-POLE CONTACTORS AND RELAYS SHALL BE PROVIDED AS REQUIRED BY THE ELECTRICIAN TO EXECUTE THE DESIGN-INTENT CONTROL CIRCUITING INDICATED IN

13. CONTROLLED OUTLETS TO BE PROVIDED ONLY TO THE MINIMUM EXTENT REQUIRED BY APPLICABLE ENERGY CODES. CONTROL SHALL BE PROVIDED BY NEAREST OCCUPANCY SENSOR. OFFICES, AND SIMILAR SPACES SHALL RECEIVE A SINGLE CONTROLLED DUPLEX OUTLET OVER THE DESK. CONFERENCE ROOMS SHALL RECEIVE A 5. INSTALLER MUST BECOME FAMILIAR WITH THE PUBLISHED | SINGLE CONTROLLED DUPLOEX WALL OUTLET. ALL LOBBY ADJACENT TO EQUIPMENT) SHALL BE SPLIT-WIRED TO THE NEAREST OCCUPANCY SENSOR.

> 14. PROVIDE ONE LEAK DETECTOR IN EACH ROOM WITH A WATER HEATER, SUMP/EJECTOR PUMP, OR (SOLENOID

VALVE AND/OR CONDENSATE PUMP IF REQUIRED).

15. PROVIDE ONE TEMPERATURE SENSOR IN EACH ROOM WITH ATMS OR SIMILAR TRANSACTION EQUIPMENT, EXCEPT THE LOBBY OR ANY SIMILAR OPEN SPACE. MECHANICAL PLAN SUPERCEDES.

16. CONTROL AND SENSOR DEVICES MUST NOT BE PLACED ON ANY WALL DESIGNATED FOR AN ACCENT FINISH. DEVICES ARE TO BE PLACES AS NEAR AS THE ENDS OF WALLS AS POSSIBLE, SO AS NOT TO INTERFERE WITH MARKETING MATERIAL POSITIONING.

17. LANDSCAPE IRRIGATION CONTROLLER SALL BE COMPATIBLE WITH THE BMS SYSTEM, AND BE PROVIDED WITH WI-FI CONNECTIVITY. COORDINATE CONTROLLER SPECIFICATION WITH DAINTREE AND LANDSCAPE IRRIGATION SYSTEM VENDOR.

18. THE AoR/EoR SUBMITTAL TO THE BMS VENDOR SHALL BE SUBJECT TO ADJUSTMENT TO COMPLY WITH LOCAL CODE. WHERE DIMMING, CEILING-MOUNTED SWITCH-ON/VACANCY-OFF CONTROLS ARE REQUIRED, LINE

19. SUBSTITUTIONS FOR THE SPECIFIED CONTROLS BY THE AoR/EoR OR G.C. ARE NOT PERMITTED.

VOLTAGE CONTROLS MAY BE USED WHEN APPLICABLE.

20. ALL CONCEALED SENSORS, ADAPTERS, AND OTHER COMPONENTS SHALL BE PLACED ABOVE ACCESSIBLE CEILING PANELS.

21. ANY DESIGN-BUILD POSITIONING OF BMS DEVICES THAT DEVIATES FROM THE LOCATION ON THE ENGINEERING OR INSTALLATION DRAWINGS MUST BE DOCUMENTED BY THE ELECTRICIAN AND PROVIDED TO THE AOR FOR INCLUSION IN THE AS-BUILT DRAWINGS.

22. BATTERY-POWERED DEVICES ARE NOT PERMITTED TO BE INSTALLED IN CONCEALED LOCATIONS, INCLUDING ABOVE ACCESSIBLE CEILINGS. DEVICES IN CEILINGS OR OTHER CONCEALED LOCATIONS MUST BE HARDWIRED.

23. ALL DEVICES CONCEALED ABOVE CEILINGS MUST BE POSITIONED SO AS TO BE VISIBLE FROM BELOW.









HESE DRAWINGS ARE NOT COMPLETE WITHOUT TH SEPARATE TYPE WRITTEN SPECIFICATIONS MANUAL WHICH ARE PART OF THE CONTRACT DOCUMENTS.

> JOHN FERGUSON, P.E. MISSOURI

LICENSE #: 2008014085


SUE	DATE	DESCRIPTION
-	2020.12.21	PERMIT SET
1	2021.04.20	STRUCTURAL STEEL REV
2	2021.06.03	PLAN REVIEW COMMENTS, RDC21 & WIRELESS UPDATE

O.	OJECT INFORMATION					
PRO	DJECT NO:	JPM.27135.00				
DA	TE:	2020.12.5				
PRC	OTOTYPE:	20				


D. BORELL DRAWN BY CHECKED BY: D. MULVANEY VERSION: SF 1.00 SHEET TITLE

> BUILDING MANAGEMENT SYSTEM DETAILS

SHEET NUMBER

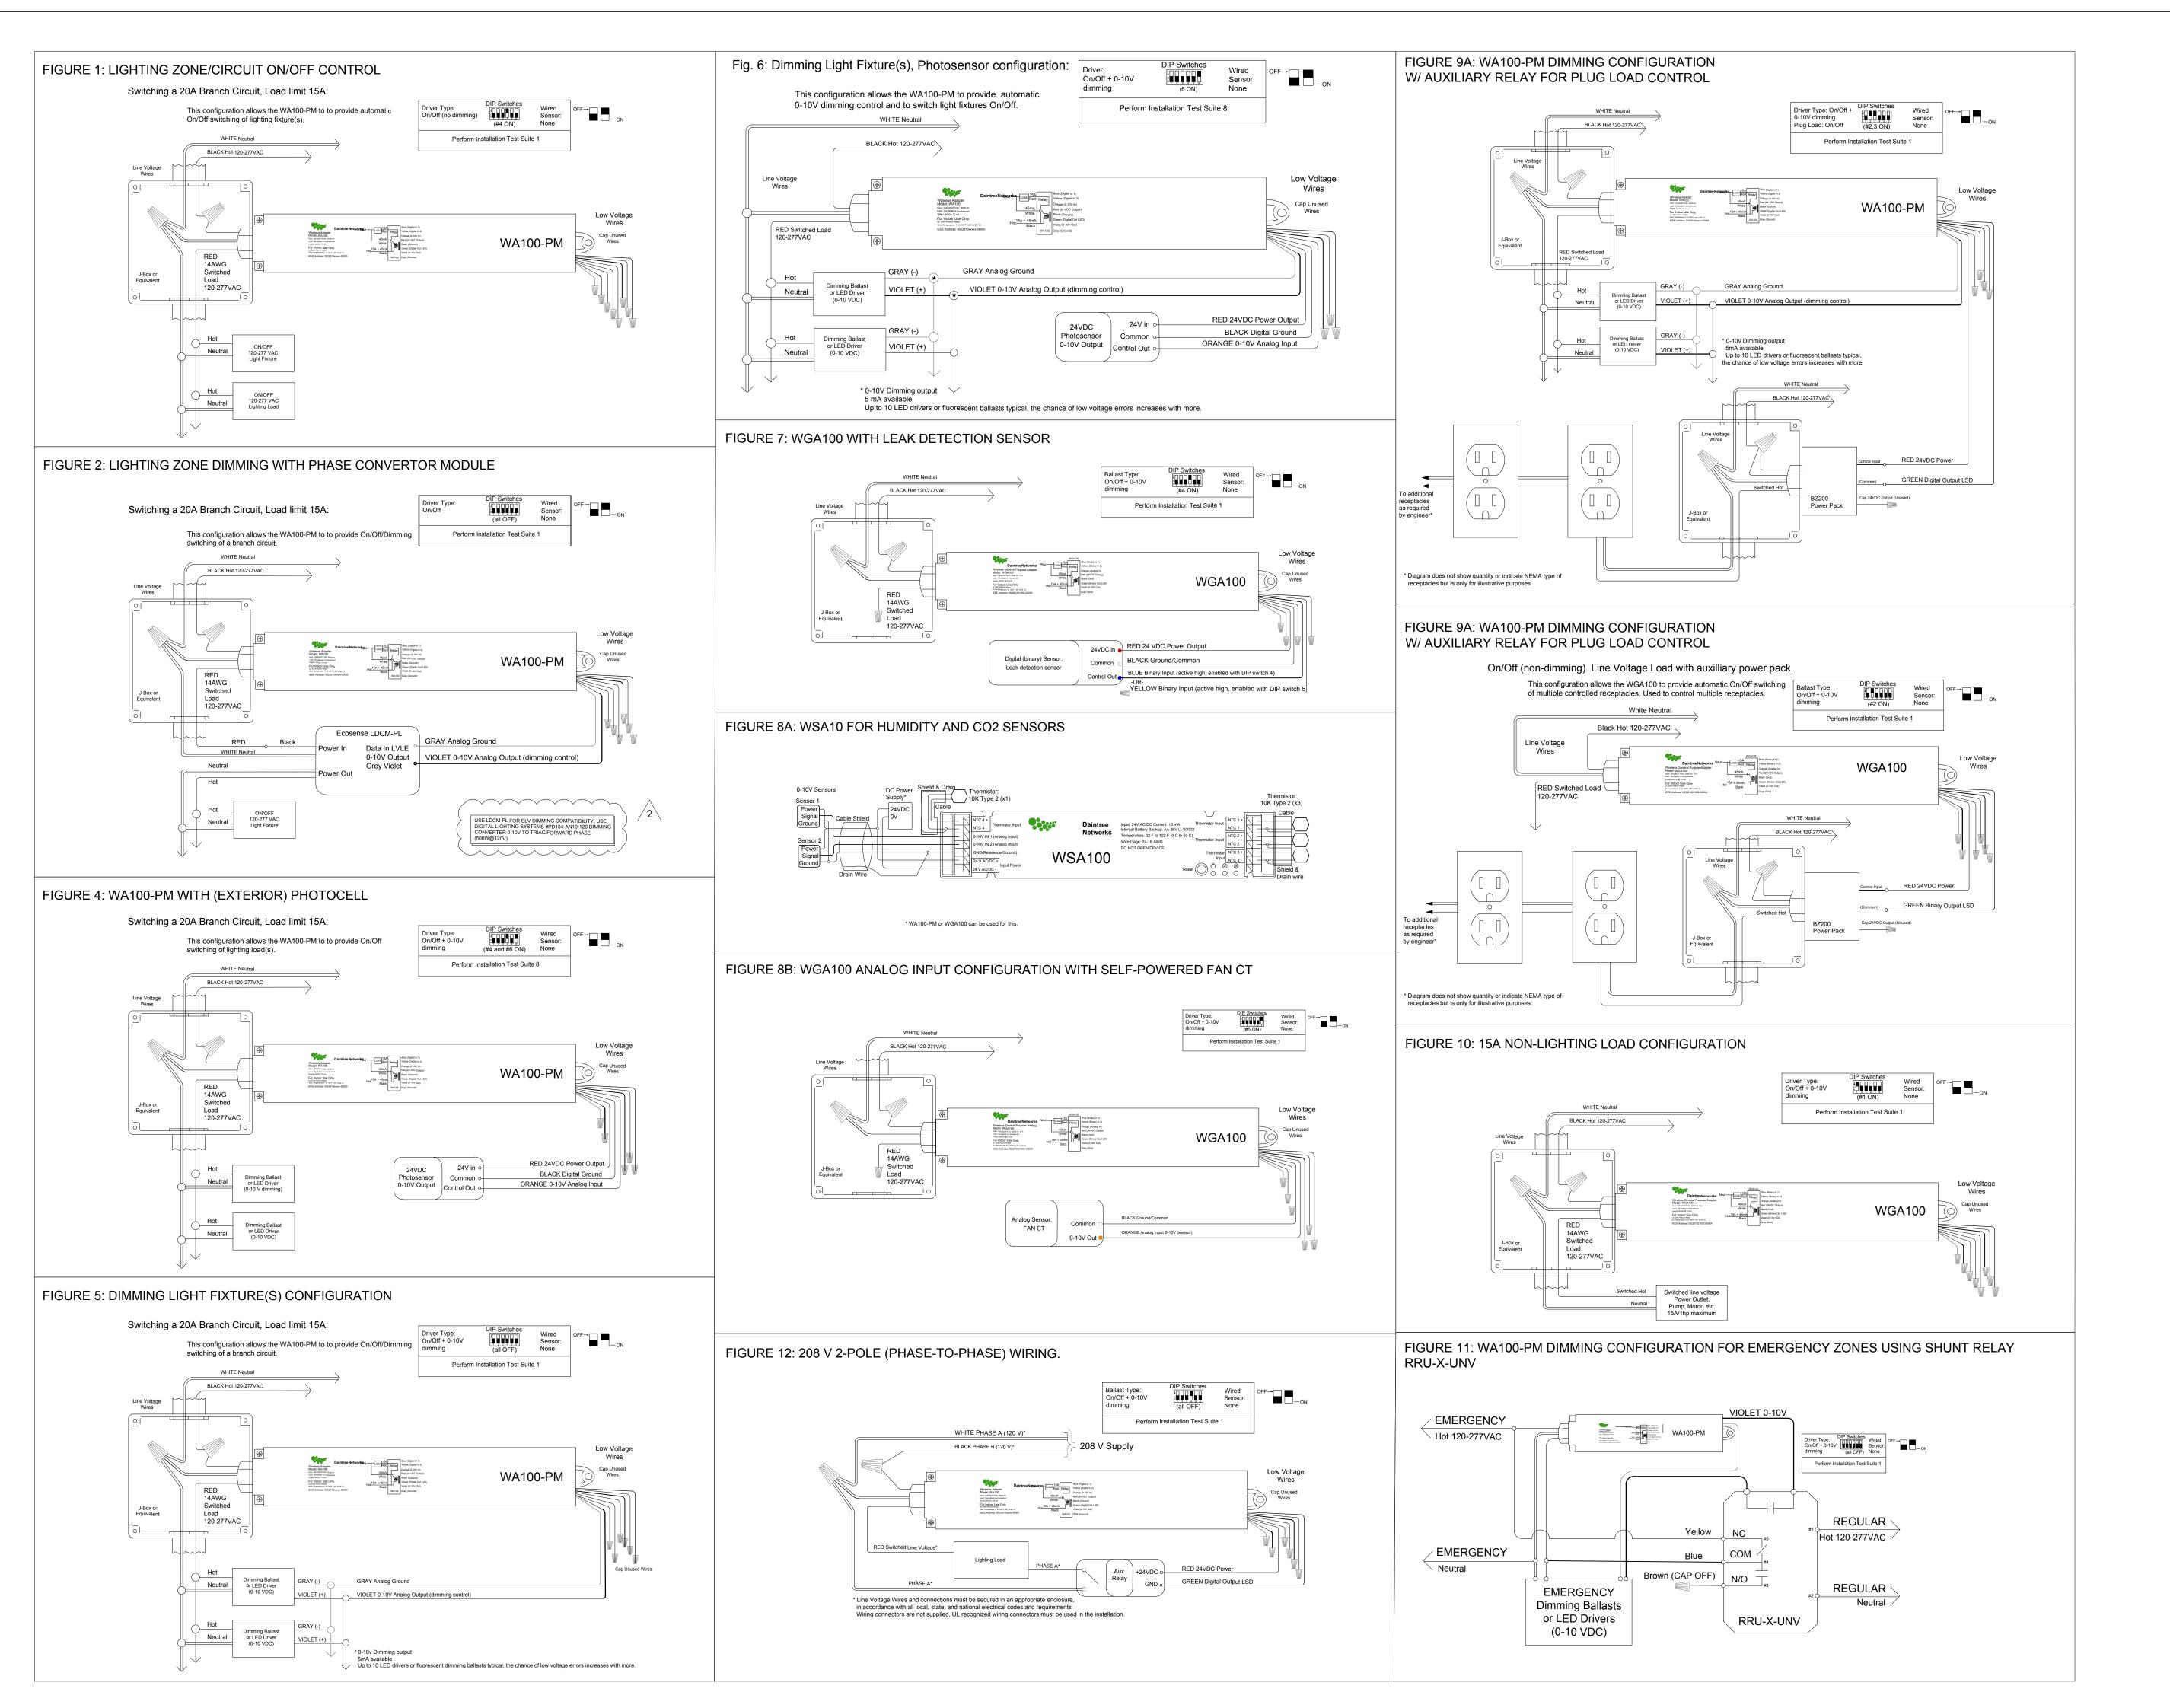



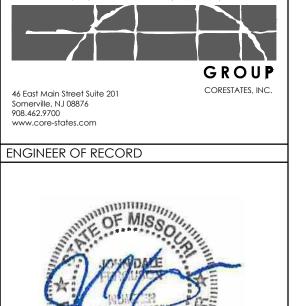



SEPARATE TYPE WRITTEN SPECIFICATIONS MANUAL WHICH ARE PART OF THE CONTRACT DOCUMENTS.

JOHN FERGUSON, P.E. MISSOURI LICENSE #: 2008014085

ISSUE DATE DESCRIPTION

- 2020.12.21 PERMIT SET

1 2021.04.20 STRUCTURAL STEEL REV

2 2021.06.03 PLAN REVIEW COMMENTS, RDC21 & WIRELESS UPDATE

PROJECT INFORMATION
PROJECT NO: JPA

PROJECT NO: JPM.27135.001

DATE: 2020.12.21

PROTOTYPE: 20.2

DRAWN BY: D. BORELLI

CHECKED BY: D. MULVANEY


VERSION: SE_1.00


BMS DEVICE WIRING DIAGRAMS

SHEET NUMBER


SHEET TITLE

E0.2

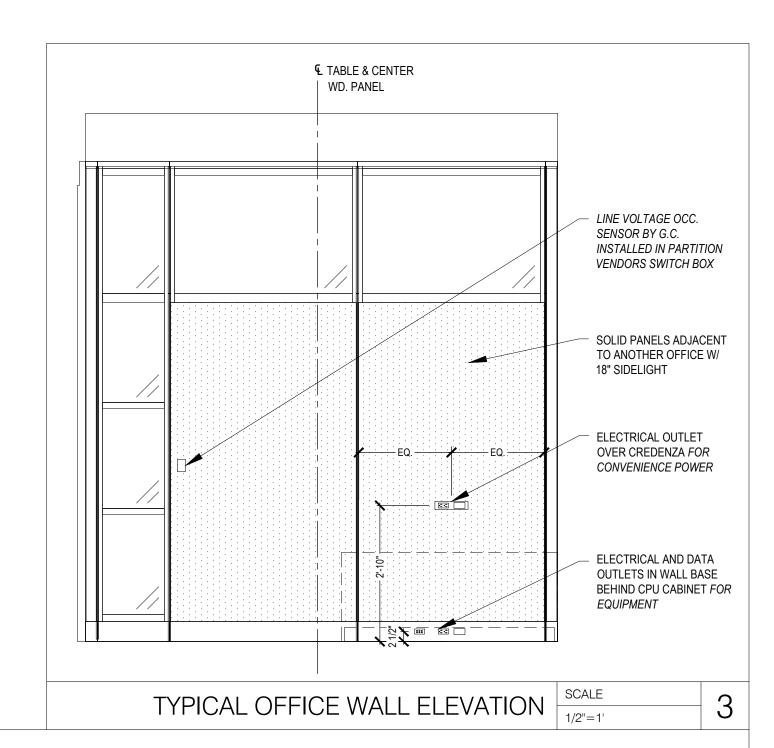


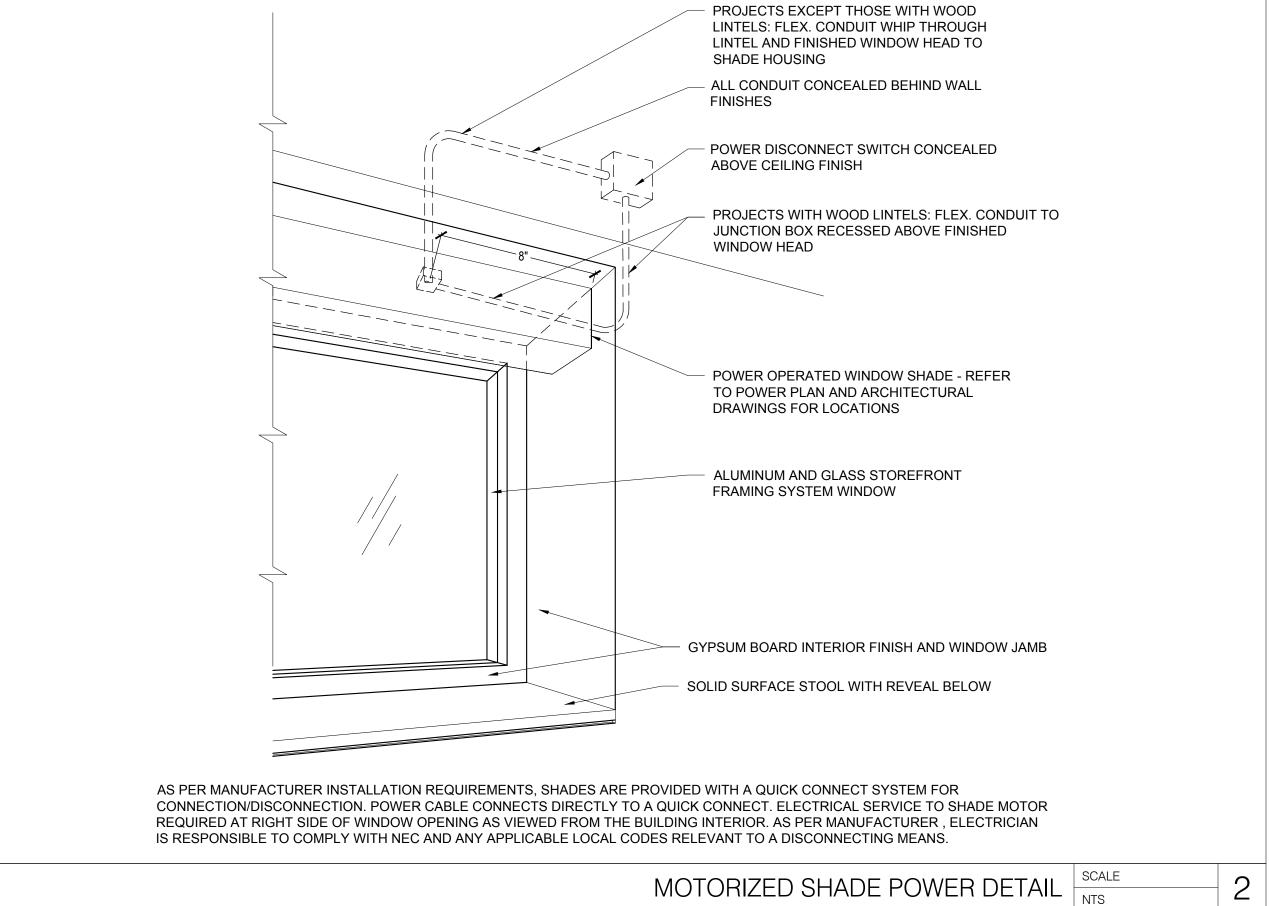

TAG	MANUFACTURER	CATALOG NUMBER	QUANTITY	MOUNTING	VOLT	VA	LAMP DATA	DESCRIPTION
CL1	C-LITE	C-CP-B-SQ-4L-50K-WH	2	CANOPY RECESSED	120	36	5000K LED	EXTERIOR DRIVE-UP SEMI-RECESSED 36W 5000K LED DOWNL
L2	GE	LBT220A033MM835VQLTWHTE	13	RECESSED	120	26	3500K LED	2X2 RECESSED LENSED 3500K LED TROFFER
L2-EM	GE	LBT220A033MM835VQLTWHTE-EL	10	RECESSED	120	26	3500K LED	L2 FIXTURE WITH EMERGENCY LIGHT DRIVER
L3	FINELITE	(2) UC-E-22"-SILVER-PS-21W-OCC	4	UNDERCABINET	120	(2) 21	3500K LED	(2) 22" LED UNDERCABINET LIGHT W/ OCCUPANCY SENSO
L4	LUMIERE	9004-W2-RW-LED-4080-W-W-CS-L1-UNV-WIS	6	WALL SCONCE	120	(2) 10	4000K	LANTERRA UP/DOWN SCONCE WITH INTEGRAL LED DRIVE
L5	iGUZZINI	I.BU27-REM-01 + 4549-0350-019-UNV-ED10	2	WALL	120	6	3000K	TRICK 360° BLADE EFFECT-90mm WITH CUSTOM BLUE LAMP, W SINGLE REMOTE 19W 0-10V DIMMING POWER SUPPLY SHARED E FIXTURES, SCREEN LENS TO ILLUMINATE ADJ. WALL AND CEILIN
L7R	LF ILLUMINATION	5811-1SA-T-20L-8040-W-D2-1-BB	1	CANOPY RECESSED	120	9.4	4000K LED	4" ROUND LED LENSED DOWNLIGHT - WET RATED (FOR INSTALLATIONS IN MAPES ENTRANCE CANOPY)
L7R-EM	LF ILLUMINATION	5811-1SA-T-20L-8040-W-D2-1-BB-EM	4	CANOPY RECESSED	120	9.4	4000K LED	L7 FIXTURE CONNECTED TO EMERGENCY INVERTER - REFERELECTRICAL LIGHTING PLAN FOR INVERTER INFORMATION
L8	GE	ALC6-1-4Y04-T-C8-1D-S-Q-Q-Q-[ST/51]-[K/A]-Q-W	1	SUSPENDED	120	27	3500K LED	SURFACE MOUNT AT CEILINGS UP TO 10'. CABLE-MOUNT AT CE OVER 10'
L8-EM	GE	ALC6-1-4Y04-T-C8-1D-S-Q-Q-Q-E-[ST/51]-[K/A]-Q-W	1	SUSPENDED	120	27	3500K LED	L8 FIXTURE WITH EMERGENCY BATTERY BACKUP
L11G	AMERLUX	(HOUSING) HDL-HP-R-NC-A17-T-18-120-0-10V (TRIM) HDL-HP-RD-A17-T-MWW-VWF-359	10	CANOPY RECESSED	120	18	3500K LED	4" ROUND LED LENSED DOWNLIGHT, PROVIDE MATTE WHITE FI (MWW) IN GRID CEILINGS
L11W	AMERLUX	(HOUSING) HDL-HP-R-NC-A17-T-18-120-0-10V (TRIM) HDL-HP-RD-A17-T-MBB-VWF-359	6	CANOPY RECESSED	120	18	3500K LED	4" ROUND LED LENSED DOWNLIGHT, PROVIDE MATTE BLACK FI (MBB) IN WOOD ACCENT CEILINGS
L20	BEST LIGHTING	EZXTEU-1-RW-EMRC	6	UNIVERSAL	120	4	LED	UNIVERSAL MOUNT SINGLE FACE LED EXIT SIGN WITH 90 MIN BABACKUP
L20 ALT.	ENCORE UNO-SERIES	X-1-C-U	-	UNIVERSAL	120	3	LED	EDGE-LIT SINGLE FACE LED EXIT SIGN WITH 90 MIN BATTERY BA
L22	LITHONIA	ZL1N-L24-1500LM-FST-MVOLT-35K-80CRI-WH-LSXR	2	WALL	120	18	3500K LED	2' LED LENSED UTILITY LIGHT W/ OCCUPANCY SENSOR
L308	PHILIPS COLOR KINETICS	223-000004-02	88	LED STRIP	120	6/FT.	3500K LED	12" 'eW COVE QLX POWERCORE' RIGID BLUE LED STRIP, WHI MOUNTED ABOVE ACT-3, USE MOUNTING TRACK MODEL #120-00 OR EQ. TO MINIMIZE BLEEDING THROUGH TILE
L308 ALT.	ECOSENSE	L35-I-12"-06-BL-MULT-120	-	LED STRIP	120	6/FT.	3500K LED	12" 'TROVE' MULT (120V-220V) BLUE LED STRIP, WHERE MOUNTED ACT-3, USE MOUNTING TRACK MODEL #1MNT-L-TRKCLIP-12 OR I MINIMIZE BLEEDING THROUGH TILE
L410	KUZCO	PD46216-BK	4	PENDANT	120	40	3000K LED	16" DIAMETER BLACK POWDER COAT FINISH, INTEGRAL LED DF INSTALLED AT 82" AFF TO BOTTOM OF FIXTURE; SET DIMMING PE ZONE CONTROL SCHEDULE
L411	TUDO	LARGE SPINNING TEARDROP CEILING PENDANT	3	PENDANT	120	60	LED	15.75" DIAMETER, MATTE BLACK, 640 LED LAMP, ELV DIMMING, INS AT 66" AFF TO BOTTOM OF FIXTURE
L413	SONNEMAN	2754.25-G	1	PENDANT	120	10	LED	KOMO EDO PENDANT - 22" DIAMETER, BLACK SATIN FINISH, ELV DINSTALLED 82" AFF TO BOTTOM OF FIXTURE
L500	AMERLUX	GRUV4-HE-GRID-A16-PL-5-35-HW-120/277-X-CUS-0-10V	21	RECESSED	120	5/FT.	3500K LED	LINEAR LED, 4" WIDE, RECESSED IN GRID CHANNELS, 2' MININ LENGTH. X=FIXTURE LENGTH(2-8 FEET LONG)
L500-EM	AMERLUX	GRUV4-HE-GRID-A16-PL-5-HW-120/277-X-CUS-0-10V-EMC-PF	7	RECESSED	120	5/FT.	3500K LED	L500 FIXTURE W/ EMERGENCY BATTERY PACK (90 MINUTE:
	GE	EACL-01-0-F4-AF-7-40-N-1-C1-DKBZ-4000K	2	POLE	120	125	4000K LED	POLE MOUNTED 4000K LED - 24' POLE
SL1	GE	EAGE-01-0-F4-AF-7-40-N-1-G1-DNDZ-4000N		TOLL	120	123	TOOOK LLD	TOLL WOONTED 4000K LED - 24 TOLL

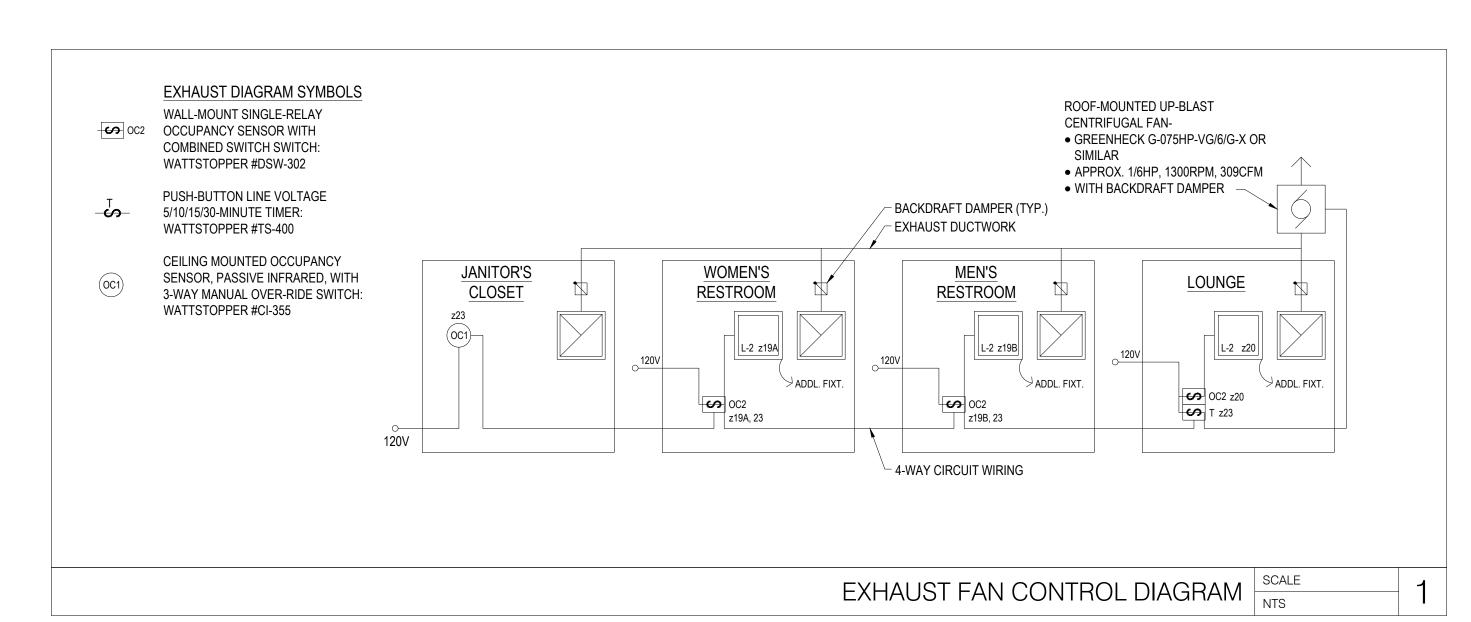



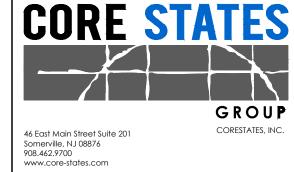

ENGINEER OF RECORD

THESE DRAWINGS ARE NOT COMPLETE WITHOUT THE SEPARATE TYPE WRITTEN SPECIFICATIONS MANUAL WHICH ARE PART OF THE CONTRACT DOCUMENTS.

> JOHN FERGUSON, P.E. LICENSE #: 2008014085

ISSUE DATE DESCRIPTION - 2020.12.21 PERMIT SET 1 2021.04.20 STRUCTURAL STEEL REV 2 2021.06.03 PLAN REVIEW COMMENTS, RDC21 & WIRELESS UPDATE


PROJECT INFORMATION PROJECT NO:

JPM.27135.001 2020.12.21 PROTOTYPE: D. BORELLI DRAWN BY: CHECKED BY: D. MULVANEY VERSION: SE_1.00 SHEET TITLE

LIGHTING SCHEDULE AND ELECTRICAL DETAILS

SHEET NUMBER

E0.3

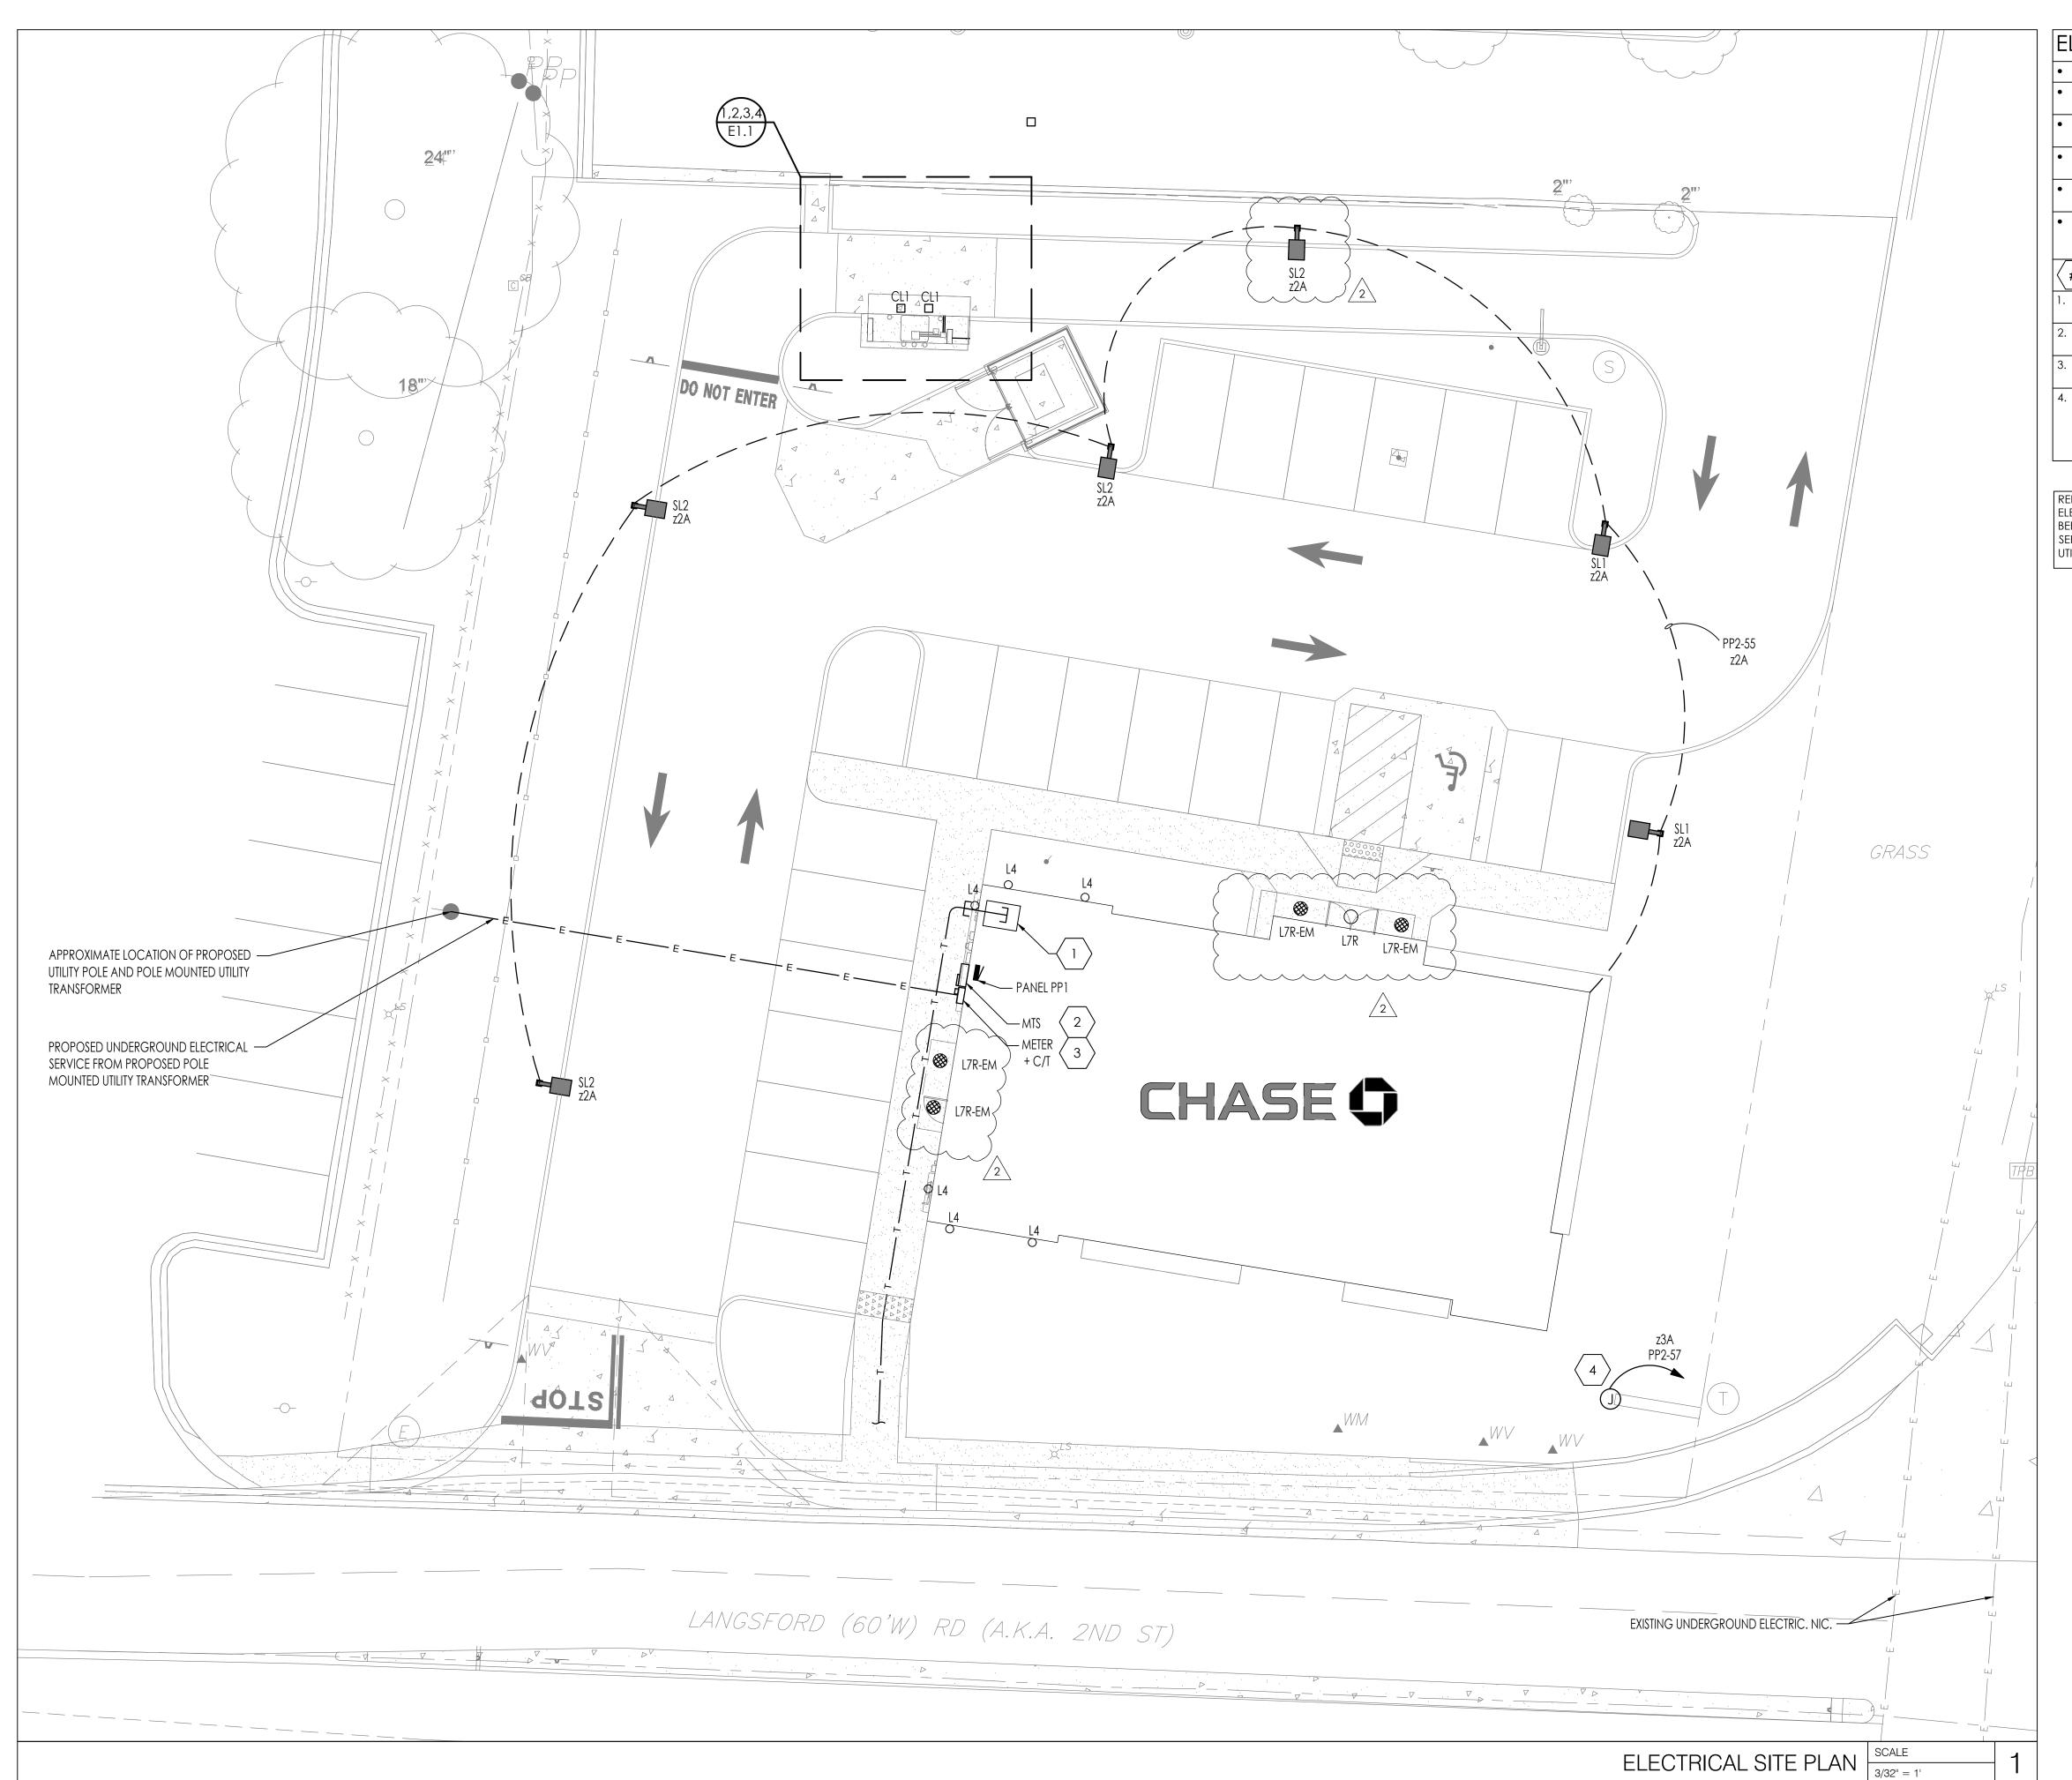

- REFER TO CIVIL SITE LIGHTING DRAWINGS FOR EXACT LOCATION AND TYPE OF SITE LIGHTING.
- PROVIDE 2#10, 1#10G, 3/4"C FEEDERS FOR ALL AREA LIGHT CONDUIT RUNS. CONTRACTOR TO VERIFY AND UPSIZE WIRES IF REQUIRED.
- REFER TO LIGHTING PLAN FOR ADDITIONAL INFORMATION REGARDING EXTERIOR WALL MOUNTED FIXTURES AND CANOPY LIGHTING.
- REFER TO LIGHTING SCHEDULES AND ELECTRICAL DETAILS SHEET FOR LIGHTING FIXTURE
- SCHEDULE AND ADDITIONAL INFORMATION. REFER TO BUILDING MANAGEMENT SYSTEM LIGHTING ZONE CONTROL SCHEDULE ON BUILDING
- MANAGEMENT SYSTEM DETAILS SHEET FOR ALL WIRING CONNECTIONS AND REQUIREMENTS. FOR ELECTRICAL SERVICE, ELECTRICAL CONTRACTOR TO PROVIDE PULLBOXES AS REQUIRED BY APPLICABLE CODES, AHJ REQUIREMENTS AND UTILITY REQUIREMENTS. PULLBOXES SHALL BE SUITABLE FOR EACH SPECIFIC APPLICATION (TRAFFIC RATED, UNDERGROUND, ETC.)

ELECTRICAL KEYNOTES:

- ROUTE (2) 2" CONDUITS WITH PULL STRINGS FOR TELEPHONE TO DATA ROOM. COORDINATE FINAL STUB-UP LOCATIONS WITH TELEPHONE PROVIDER PRIOR TO INSTALLATION.
- REFER TO POWER RISER DIAGRAM LOCATED ON POWER DETAILS AND SCHEDULES SHEET FOR
- ROUGH-IN REQUIREMENTS OF TRANSFER SWITCH.
- FINAL LOCATION OF MTS IS TO BE DECIDED BETWEEN BUILDING OWNER, ELECTRICAL CONTRACTOR, AND UTILITY.
- REFER TO ARCHITECTURAL DRAWINGS AND CIVIL DRAWINGS FOR SIGN LOCATION. JUNCTION BOX PROVIDED FOR MONUMENT SIGNAGE, FIELD COORDINATE ROUGH-IN REQUIREMENTS WITH SIGNS TO BE INSTALLED AND ADJUST ACCORDINGLY. PROVIDE DISCONNECTING MEANS AS REQUIRED. PROVIDE WHIP TO SIGNAGE LOCATION AS REQUIRED BY LANDLORD AND AS REQUIRED BY CODE.

REFER TO RISER DIAGRAM FOR ALL COORDINATION INVOLVING ELECTRICAL SERVICE. DEDICATED ELECTRICAL SERVICE HAS NOT BEEN FINALIZED. ALL INFORMATION REGARDING ELECTRICAL SERVICE IS SUBJECT TO CHANGE PENDING COORDINATION WITH UTILITY COMPANY.





46 East Main Street Suite 201 Somerville, NJ 08876 908.462.9700 www.core-states.com

NGINEER OF RECORD



HESE DRAWINGS ARE NOT COMPLETE WITHOUT TH SEPARATE TYPE WRITTEN SPECIFICATIONS MANUAL WHICH ARE PART OF THE CONTRACT DOCUMENTS.

> JOHN FERGUSON, P.E. MISSOURI LICENSE #: 2008014085

ISSUE DATE DESCRIPTION 2020.12.21 PERMIT SET 1 2021.04.20 STRUCTURAL STEEL REV 2 2021.06.03 PLAN REVIEW COMMENTS, RDC21 & WIRELESS UPDATE


PROJECT INFORMATION JPM.27135.001 2020.12.2


D. BORELL CHECKED BY: D. MULVANEY SHEET TITLE


> ELECTRICAL SITE PLAN


SHEET NUMBER

E1.0

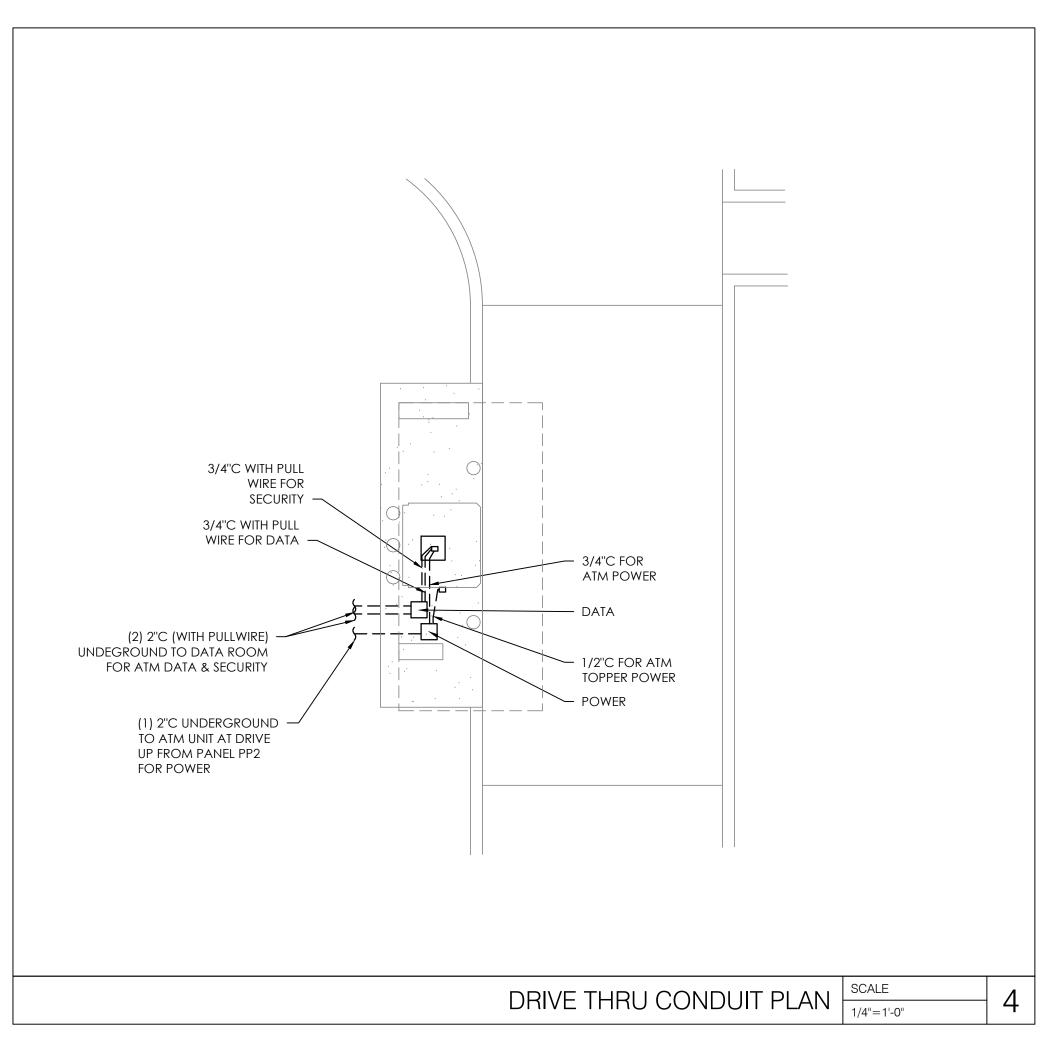

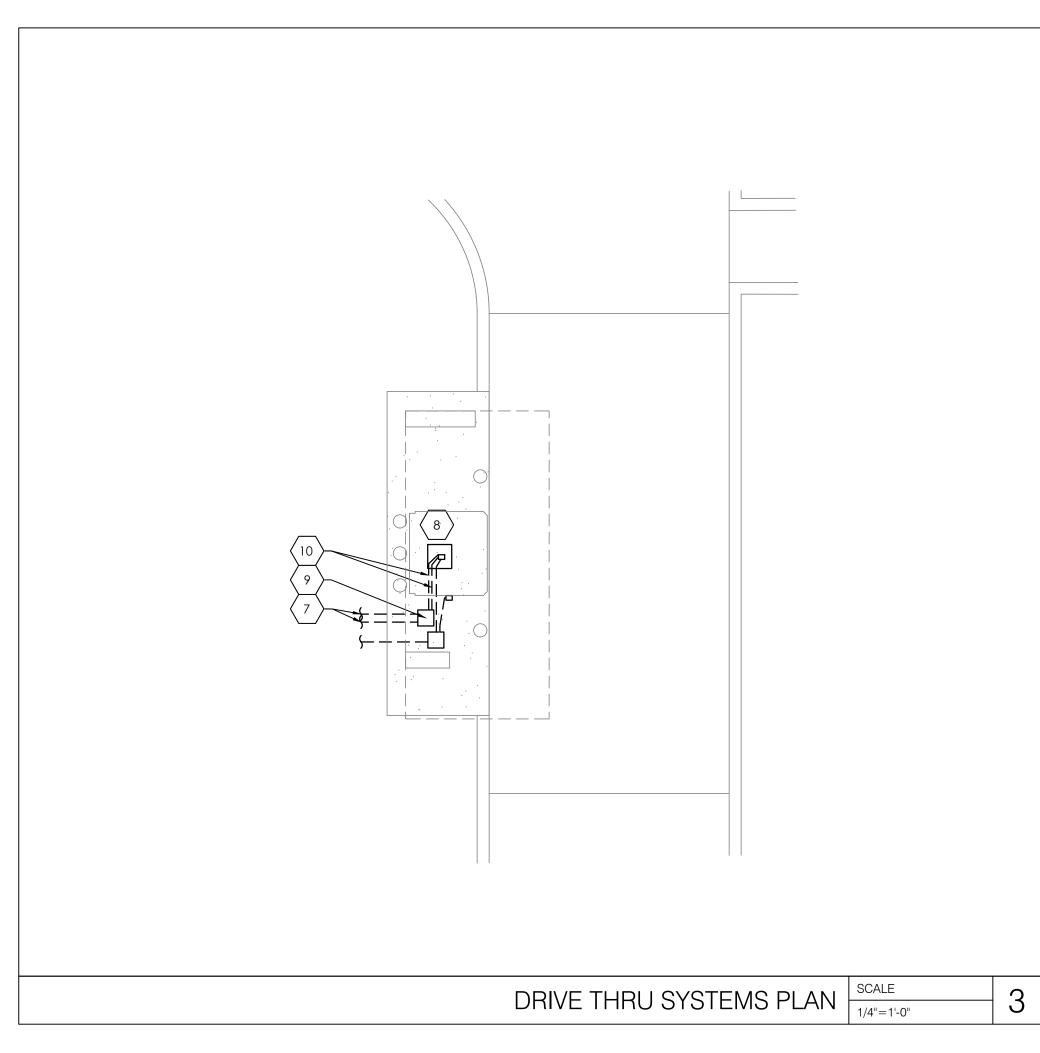

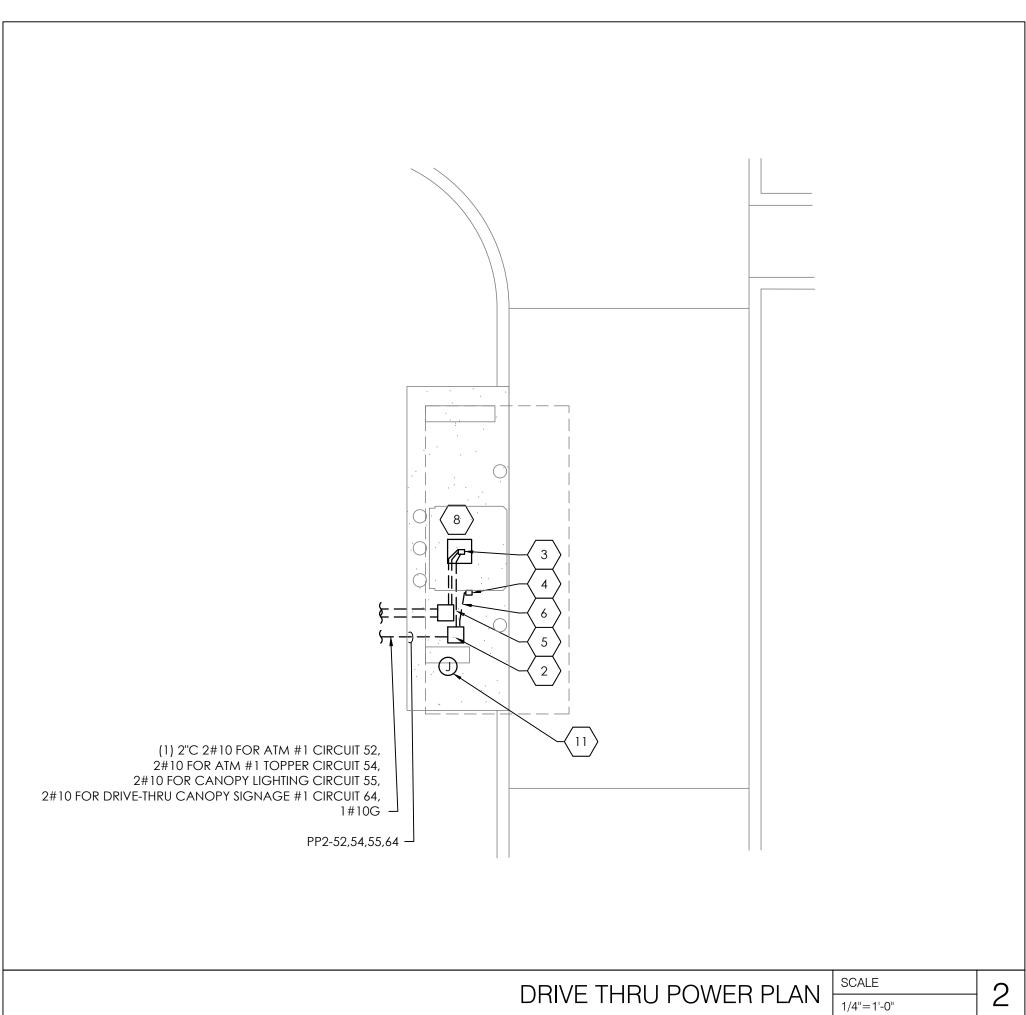

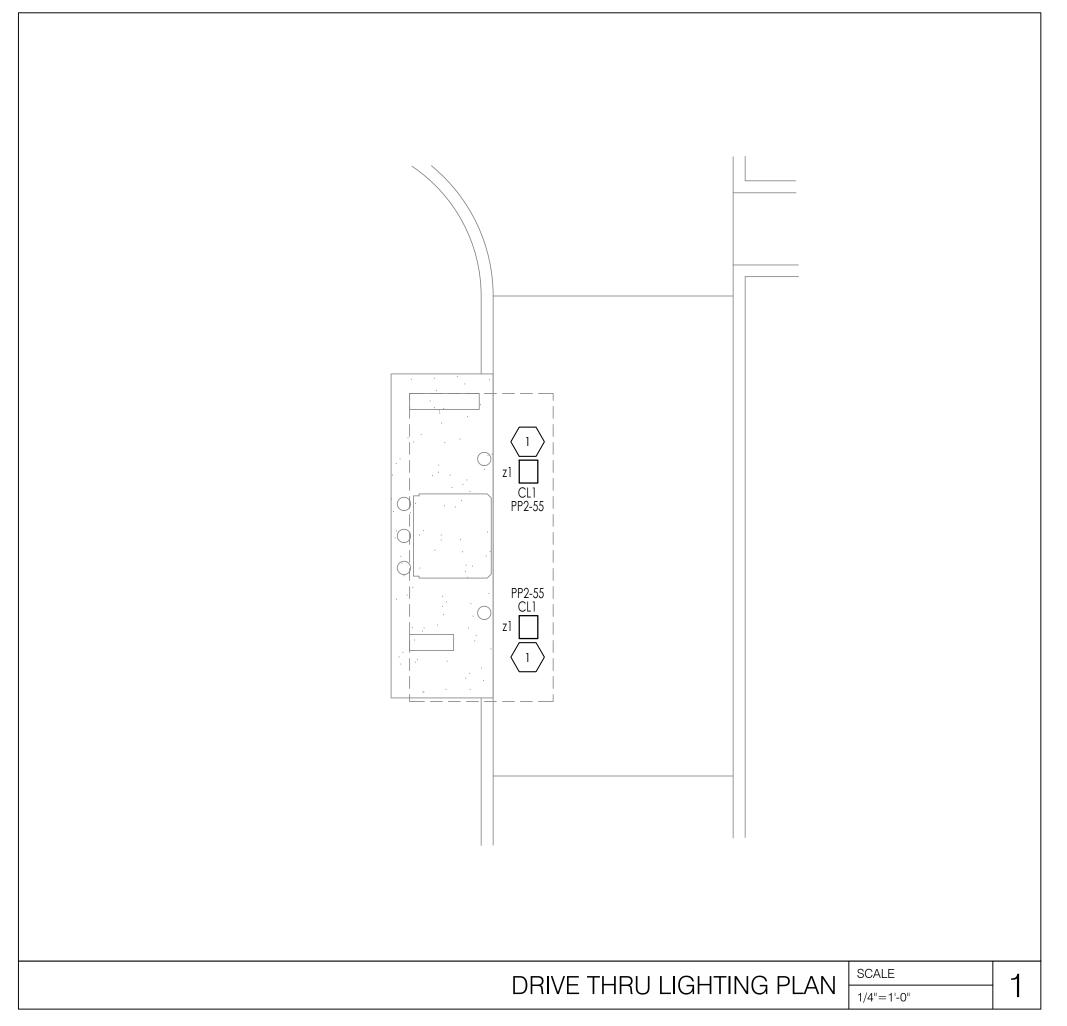

- REFER TO LIGHTING SCHEDULES AND ELECTRICAL DETAILS SHEET FOR LIGHTING FIXTURE SCHEDULE AND ADDITIONAL INFORMATION.
- REFER TO DRAWING BUILDING MANAGEMENT SYSTEM DETAILS SHEET FOR BMS LIGHTING CONTROL ZONE SCHEDULE.

$\langle \# \rangle$ ELECTRICAL KEYNOTES:

- CANOPY FIXTURES ARE TO BE CONTROLLED BY OUTDOOR PHOTOCELL, DAINTREE #RLV-ODCOP-W. REFER TO BUILDING MANAGEMENT SYSTEMS DETAILS SHEET FOR ADDITIONAL
- POWER PULL BOX 8"X8"X6" PVC PULL BOX WITH SIDEWALK RATED GASKET TOP SECURED WITH
- ATM PULL BOX 12"X12"X6" PVC PULL BOX MOUNTED FLUSH IN CONCRETE.
- 4. ATM TOPPER PULL BOX 2"X4"X2" PVC PULL BOX MOUNTED FLUSH IN CONCRETE.
- 5. 3/4" CONDUIT FROM POWER PULL BOX TO ATM PULL BOX FOR POWER TO ATM. PROVIDE 3/4" NON-METALLIC LIQUID-TIGHT CONDUIT FOR POWER INTO ATM.
- 6. 1/2" CONDUIT FROM POWER PULL BOX THROUGH ATM PULL BOX TO ATM TOPPER PULL BOX FOR POWER TO ATM TOPPER. PROVIDE 1/2" NON-METALLIC LIQUID-TIGHT CONDUIT FOR POWER INTO
- (2) 2"CONDUIT WITH PULLWIRE FROM ATM TO DATA ROOM. ATM CONDUIT AND PULLWIRE TO
- TERMINATE UNDER CEILING SLEEVES IN DATA ROOM. REFER TO THE UNDERGROUND CONDUIT PLAN SHEET.
- ROUTING FOR DEVICES IN THIS AREA.

 DATA PULL BOX 8"x8"x6" PVC PULL BOX WITH SIDEWALK RATED GASKET TOP SECURED WITH

REFER TO UNDERGROUND CONDUIT PLAN FOR UNDERGROUND CONDUIT AND CABLING

- (2) 3/4" CONDUITS WITH PULLWIRE FROM DATA PULL BOX TO ATM PULL BOX FOR DATA AND SECURITY TO ATM. PROVIDE 3/4" NON-METALLIC LIQUID TIGHT CONDUIT FOR DATA AND
- 1. PROVIDE JUNCTION BOX FOR OCTAGON SIGNAGE. COORDINATE EXACT LOCATION AND REQUIREMENTS WITH E.C. AND SIGN MANUFACTURER PRIOR TO ROUGH-IN.

JP MORGAN CHASE, N.A
HWY 291 & NE LANGSFORD RD
890 NE LANGSFORD RD



46 East Main Street Suite 201 Somerville, NJ 08876 908.462.9700 www.core-states.com

ENGINEER OF RECORD



01/19/2021

THESE DRAWINGS ARE NOT COMPLETE WITHOUT THE SEPARATE TYPE WRITTEN SPECIFICATIONS MANUAL WHICH ARE PART OF THE CONTRACT DOCUMENTS.

JOHN FERGUSON, P.E. MISSOURI LICENSE #: 2008014085

- 2020.12.21 PERMIT SET

PROJECT INFORMATION

PROJECT NO: JPM.27135.001

DATE: 2020.12.21

DATE: 2020.12.21

PROTOTYPE: 20.2

DRAWN BY: D. BORELLI

CHECKED BY: D. MULVANEY


VERSION: SE_1.00

SHEET TITLE

DRIVE-THRU PLANS

SHEET NUMBER

E1.1

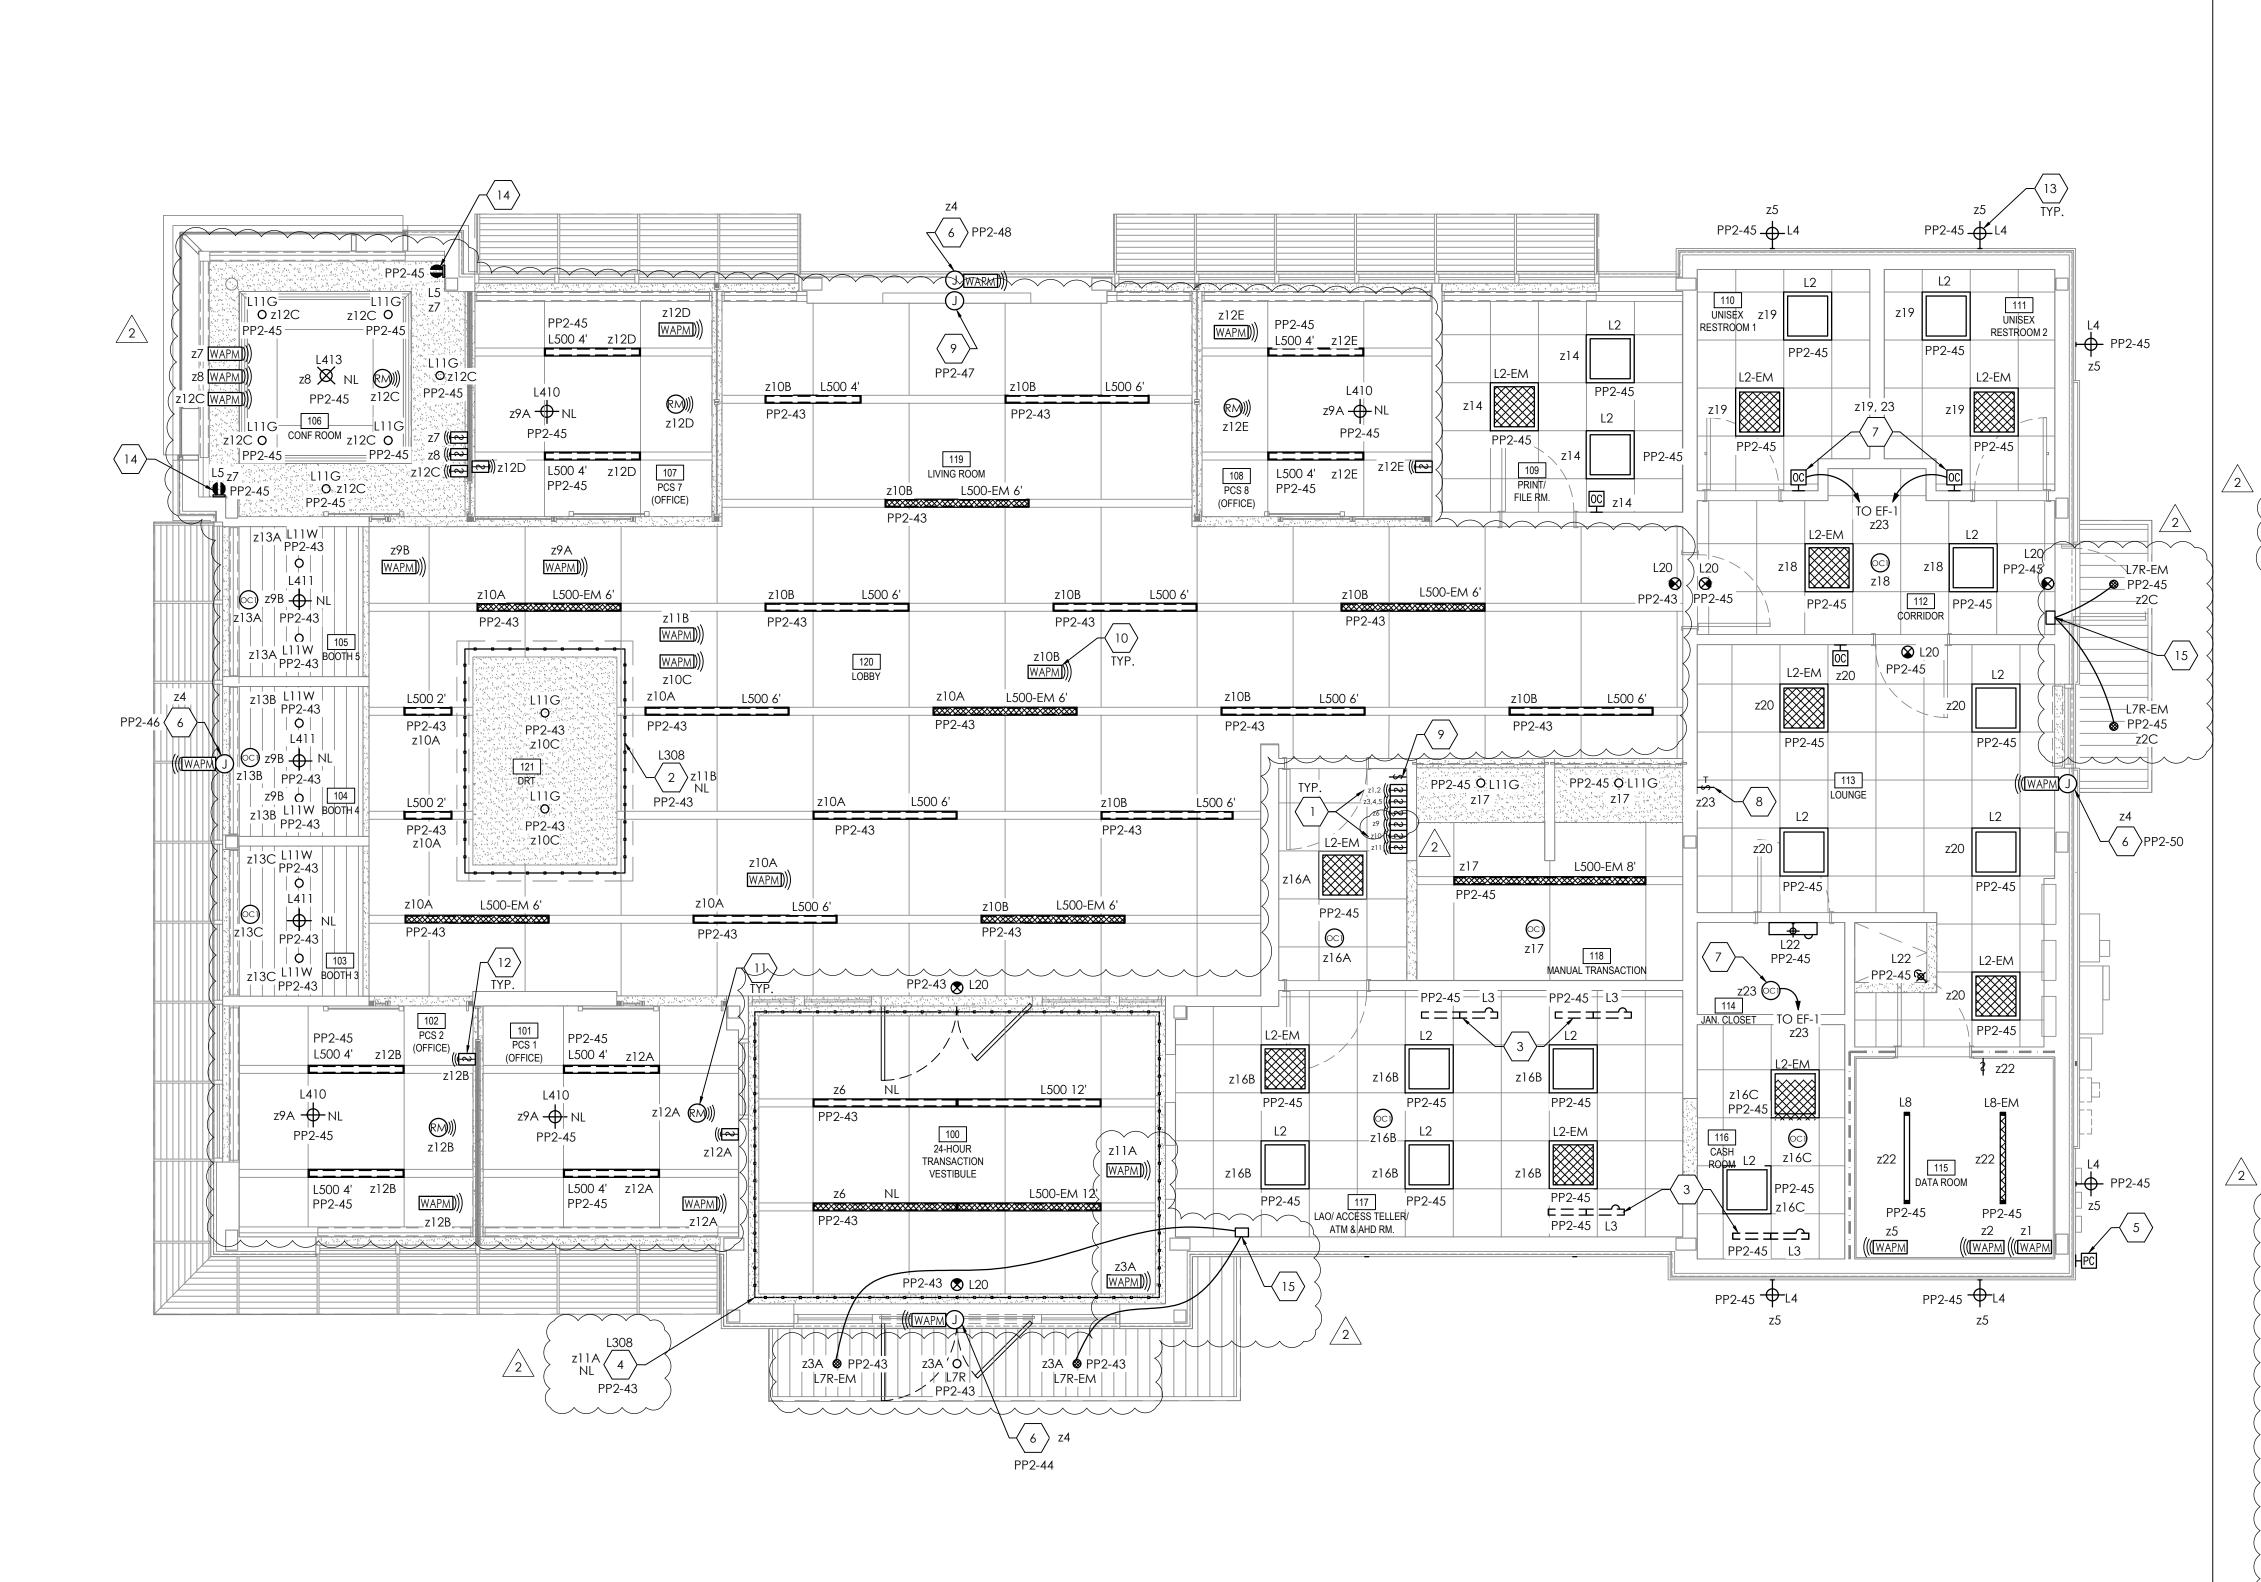

SCHEDULE AND ADDITIONAL INFORMATION.

- REFER TO LIGHTING SCHEDULES AND ELECTRICAL DETAILS SHEET FOR LIGHTING FIXTURE
- REFER TO BUILDING MANAGEMENT SYSTEM LIGHTING ZONE CONTROL SCHEDULE ON BUILDING MANAGEMENT SYSTEM DETAILS SHEET FOR ALL WIRING CONNECTIONS AND REQUIREMENTS.
- ALL LIGHTS LABELED "NL" ARE NIGHT LIGHTS THAT ARE TO BE CONNECTED UNSWITCHED.
- ALL EXIT LIGHTS "L20" SHALL BE CONNECTED TO THE CIRCUIT INDICATED ON THE LINE SIDE OF THE
- LOCAL LIGHTING SWITCH.

 ALL EMERGENCY BATTERY FIXTURES (HATCHED FIXTURES) SHALL BE CONTROLLED BY THE LOCAL

 LIGHTING SWITCH AS INDICATED SYSTEM BATTERY WIRING TO THE LINE SIDE OF THE LOCAL
- LIGHTING SWITCH AS INDICATED. EXTEND BATTERY WIRING TO THE LINE SIDE OF THE LOCAL LIGHTING SWITCH AND CONNECT FOR PROPER EMERGENCY BALLAST OPERATION.
- ALL PENDANT FIXTURES IN THE PUBLIC LOBBY AREA ARE TO BE CONNECTED TO A CONSTANT-ON CIRCUIT. EXACT LOCATIONS OF PENDANT FIXTURES ARE TO BE COORDINATED WITH THE ARCHITECTURAL FURNITURE LAYOUT.
- SECURELY FASTEN EACH RECESSED GRID LIGHT FIXTURE TO THE CEILING SYSTEM WITH APPROPRIATE SUPPORT BRACKETS AND CLIPS PER INDUSTRY STANDARDS, CODE AND ALL LOCAL
- A MAXIMUM OF 3 HOMERUNS MAY BE GROUPED TOGETHER IN ONE CONDUIT AND SHARE A COMMON NEUTRAL PROVIDED THE HOMERUNS ARE DIFFERENT PHASES. IF BRANCH CIRCUITS ARE GROUPED THEY MUST ALL BE CONTROLLED BY THE SAME MULTI-POLE BREAKER PER NEC.210.4.

ELECTRICAL KEY NOTES:

SWITCHBANK FOR BI-LEVEL CONTROL OF LOBBY LIGHTING WITH MANUAL DIMMERS. 4-GANG BOX NOT REQUIRED. COORDINATE FINAL LOCATION WITH OWNER PRIOR TO INSTALLATION. NUMBERS NEXT TO SWITCHES INDICATE THE LIGHTING ZONE BEING CONTROLLED. REFER TO BMS LIGHTING ZONE CONTROL SCHEDULE ON THE BUILDING MANAGEMENT SYSTEM DETAIL SHEET FOR ADDITIONAL INFORMATION.

PROVIDE LED COVE ACCENT LIGHTING, TYPE L308 (BLUE), AS SHOWN. LIGHTING TO BE INSTALLED IN CEILING BRIM COVE. REFER TO ARCHITECTURAL DRAWINGS FOR DETAILS. CIRCUIT AS NIGHT

3. UNDERCABINET LIGHT FIXTURES. VERIFY EXACT QUANTITY OF FIXTURES REQUIRED PRIOR TO INSTALLATION. LIGHTING FIXTURE "L3" IS PROVIDED WITH AN INTEGRAL OCCUPANCY SENSOR. DO NOT CONNECT TO WALL MOUNTED OCCUPANCY SENSOR OR SWITCHES. ROUTE LOW VOLTAGE LIGHT FIXTURE CIRCUITRY THROUGH WALL TO FIXTURE DEVICES. REFER TO ARCHITECTURAL ELEVATIONS FOR ADDITIONAL INFORMATION.

4. PROVIDE LED COVE ACCENT LIGHTING, TYPE 1308 (BLUE), AS SHOWN. LIGHTING TO BE INSTALLED IN VESTIBULE CEILING COVE. REFER TO ARCHITECTURAL DRAWINGS FOR DETAILS. CIRCUIT AS NIGHT LIGHTS.

5. PROVIDE OUTDOOR PHOTOCELL, MOUNTED ON EXTERIOR WALL, EXACT LOCATION AND MOUNTING HEIGHT TO BE VERIFIED WITH ARCHITECT PRIOR TO ROUGH-IN. MOUNT AWAY FROM LIGHT SOURCES

6. JUNCTION BOX ON THE INSIDE OF EXTERIOR WALL FOR BUILDING SIGN, REFER TO ARCHITECTURAL ELEVATIONS FOR SIGN LOCATIONS, FIELD COORDINATE ROUGH-IN REQUIREMENTS WITH SIGNS TO BE INSTALLED AND ADJUST ACCORDINGLY. PROVIDE DISCONNECTING MEANS AS REQUIRED.

INTERLOCK RESTROOMS AND JANITOR CLOSET LIGHTING AND EXHAUST FAN WITH WALL MOUNTED OCCUPANCY SENSOR. LIGHTING AND EXHAUST FAN TO BE POWERED SEPARATELY. REFER TO POWER PLAN, ROOF POWER PLAN AND MECHANICAL SCHEDULES FOR ADDITIONAL INFORMATION.

8. EXHAUST FAN TO BE INTERLOCKED WITH 3-WAY PRESET PUSH BUTTON TIMER SWITCH. REFER TO EXHAUST FAN CONTROL DIAGRAM, POWER PLAN AND MECHANICAL SCHEDULES FOR ADDITIONAL INFORMATION.

PROVIDE JUNCTION BOX ABOVE CEILING WITH MULTIPLE FLEXIBLE CONDUIT TERMINATIONS IN WALL BELOW FOR SIGNAGE ELECTRICAL CONNECTION. COORDINATE EXACT LOCATION AND TERMINATION LOCATIONS WITH CHASE SIGNAGE VENDOR SHOP DRAWINGS AND ADDITIONAL REQUIREMENTS. FIELD COORDINATE ROUGH-IN REQUIREMENTS WITH SIGN TO BE INSTALLED AND ADJUST ACCORDINGLY. CONNECT SIGN TO SPDT WALL SWITCH LOCATED AT MANUAL TRANSACTION AREA FOR MANUAL CONTROL OF SIGNAGE.

10. PROVIDE DIMMING ROOM WIRELESS ADAPTER, DAINTREE #WA100-PM SERIES, REFER TO BUILDING MANAGEMENT SYSTEM DETAILS SHEET FOR ADDITIONAL INFORMATION. ADAPTER CONTROLS UP TO 10 LUMINAIRES.

11. PROVIDE BATTERY POWERED CEILING RECESSED OCCUPANCY SENSOR, DAINTREE #WOS2-RM-E SERIES, REFER TO BUILDING MANAGEMENT SYSTEM DETAILS SHEET FOR ADDITIONAL INFORMATION.

12. PROVIDE WIRELESS WALL DIMMER, DAINTREE #WWD1 SERIES, REFER TO DETAILS ON THE BUILDING MANAGEMENT SYSTEM DETAIL SHEET FOR ADDITIONAL INFORMATION.

13. REFER TO EXTERIOR ELEVATIONS ON ARCHITECTURAL DRAWINGS FOR EXTERIOR WALL MOUNTED LIGHTING FIXTURE MOUNTING HEIGHTS AND LOCATIONS.

14. WALL MOUNTED ACCENT LIGHT FIXTURE. PAIR LOW-VOLTAGE FIXTURE IN FLUSH WALL FIXTURE BOX. CONNECT TO REMOTE DRIVER AND WAPM DAINTREE ADAPTER CONCEALED ABOVE CEILING. COORDINATE WITH MANUFACTURER FOR ALL INSTALLATION REQUIREMENTS PRIOR TO ROUGH, IN.

15. EMERGENCY CANOPY FIXTURES TO BE CONNECTED TO LF ILLUMINATION EMERGENCY INVERTER MODEL LF#EMREM50. CONTRACTOR TO VERIFY FINAL LOCATION OF INVERTER WITH OWNER. LF #EMREM50 EMERGENCY LIGHTING INVERTER IS UNIT EQUIPMENT THAT TRANSFORMS LED FIXTURES UP TO 50W INTO CODE COMPLIANT EMERGENCY LIGHTING FIXTURES.

LIGHTING NOTES:

LIGHTING SHALL BE ORDERED THROUGH:

FSG -JPMCRetail Team Isaiah Ramden Tel: (888) 671-4074 E-mail: jpmc@fsgi.com

Website: www.fsgi.com

ELECTRICAL CONTRACTOR TO PURCHASE WHOLE DAINTREE SYSTEM WITH INPUT FROM MECHANICAL CONTRACTOR. COORDINATE AS REQUIRED BETWEEN THE TRADES. ELECTRICAL CONTRACTOR TO CONFIRM ALL ORDER REQUIREMENTS WITH MECHANICAL CONTRACTOR. ELECTRICAL CONTRACTOR TO COORDINATE WITH DAINTREE FOR PROGRAMMING OF SYSTEM AND DEVICES. IF THERE ARE SPECIFIC QUESTIONS REGARDING THE DAINTREE CONTROL SYSTEM AND ADDITIONAL INFORMATION, PLEASE CONTACT:

Current, powered by GE Bob Flannery

Tel: 312-550-6554

E-mail: robert.flannery@gecurrent.com

Travis Lynch
Tel: 216-212-7558
E-mail: Travis.Lynch@gecurrent.com

LIGHTING PLAN SCALE 1/4" = 1'

FOR GENERAL SUPPORT:

E-mail: JPMCcontrols@gecurrent.com



Somerville, NJ 08876 908.462.9700

ww.core-states.com

IGINEER OF RECORD



06/01/2021

HESE DRAWINGS ARE NOT COMPLETE WITHOUT THE SEPARATE TYPE WRITTEN SPECIFICATIONS MANUAL WHICH ARE PART OF THE CONTRACT DOCUMENTS.

JOHN FERGUSON, P.E. MISSOURI LICENSE #: 2008014085

ISSUE	DATE	DESCRIPTION
-	2020.12.21	PERMIT SET
1	2021.04.20	STRUCTURAL STEEL REV
2	2021.06.03	PLAN REVIEW COMMENTS, RDC21 & WIRELESS UPDATE

PRO.	JECT INFO	ORMATION
PRO	DJECT NO:	JPM.27135.00
DA	TE:	2020.12.2
PRO	OTOTYPE:	20.
DR	AWN BY:	D. BOREL
CH	ECKED BY:	D. MULVANE


LIGHTING PLAN

SHEET NUMBER

VERSION:

SHEET TITLE

E2.0

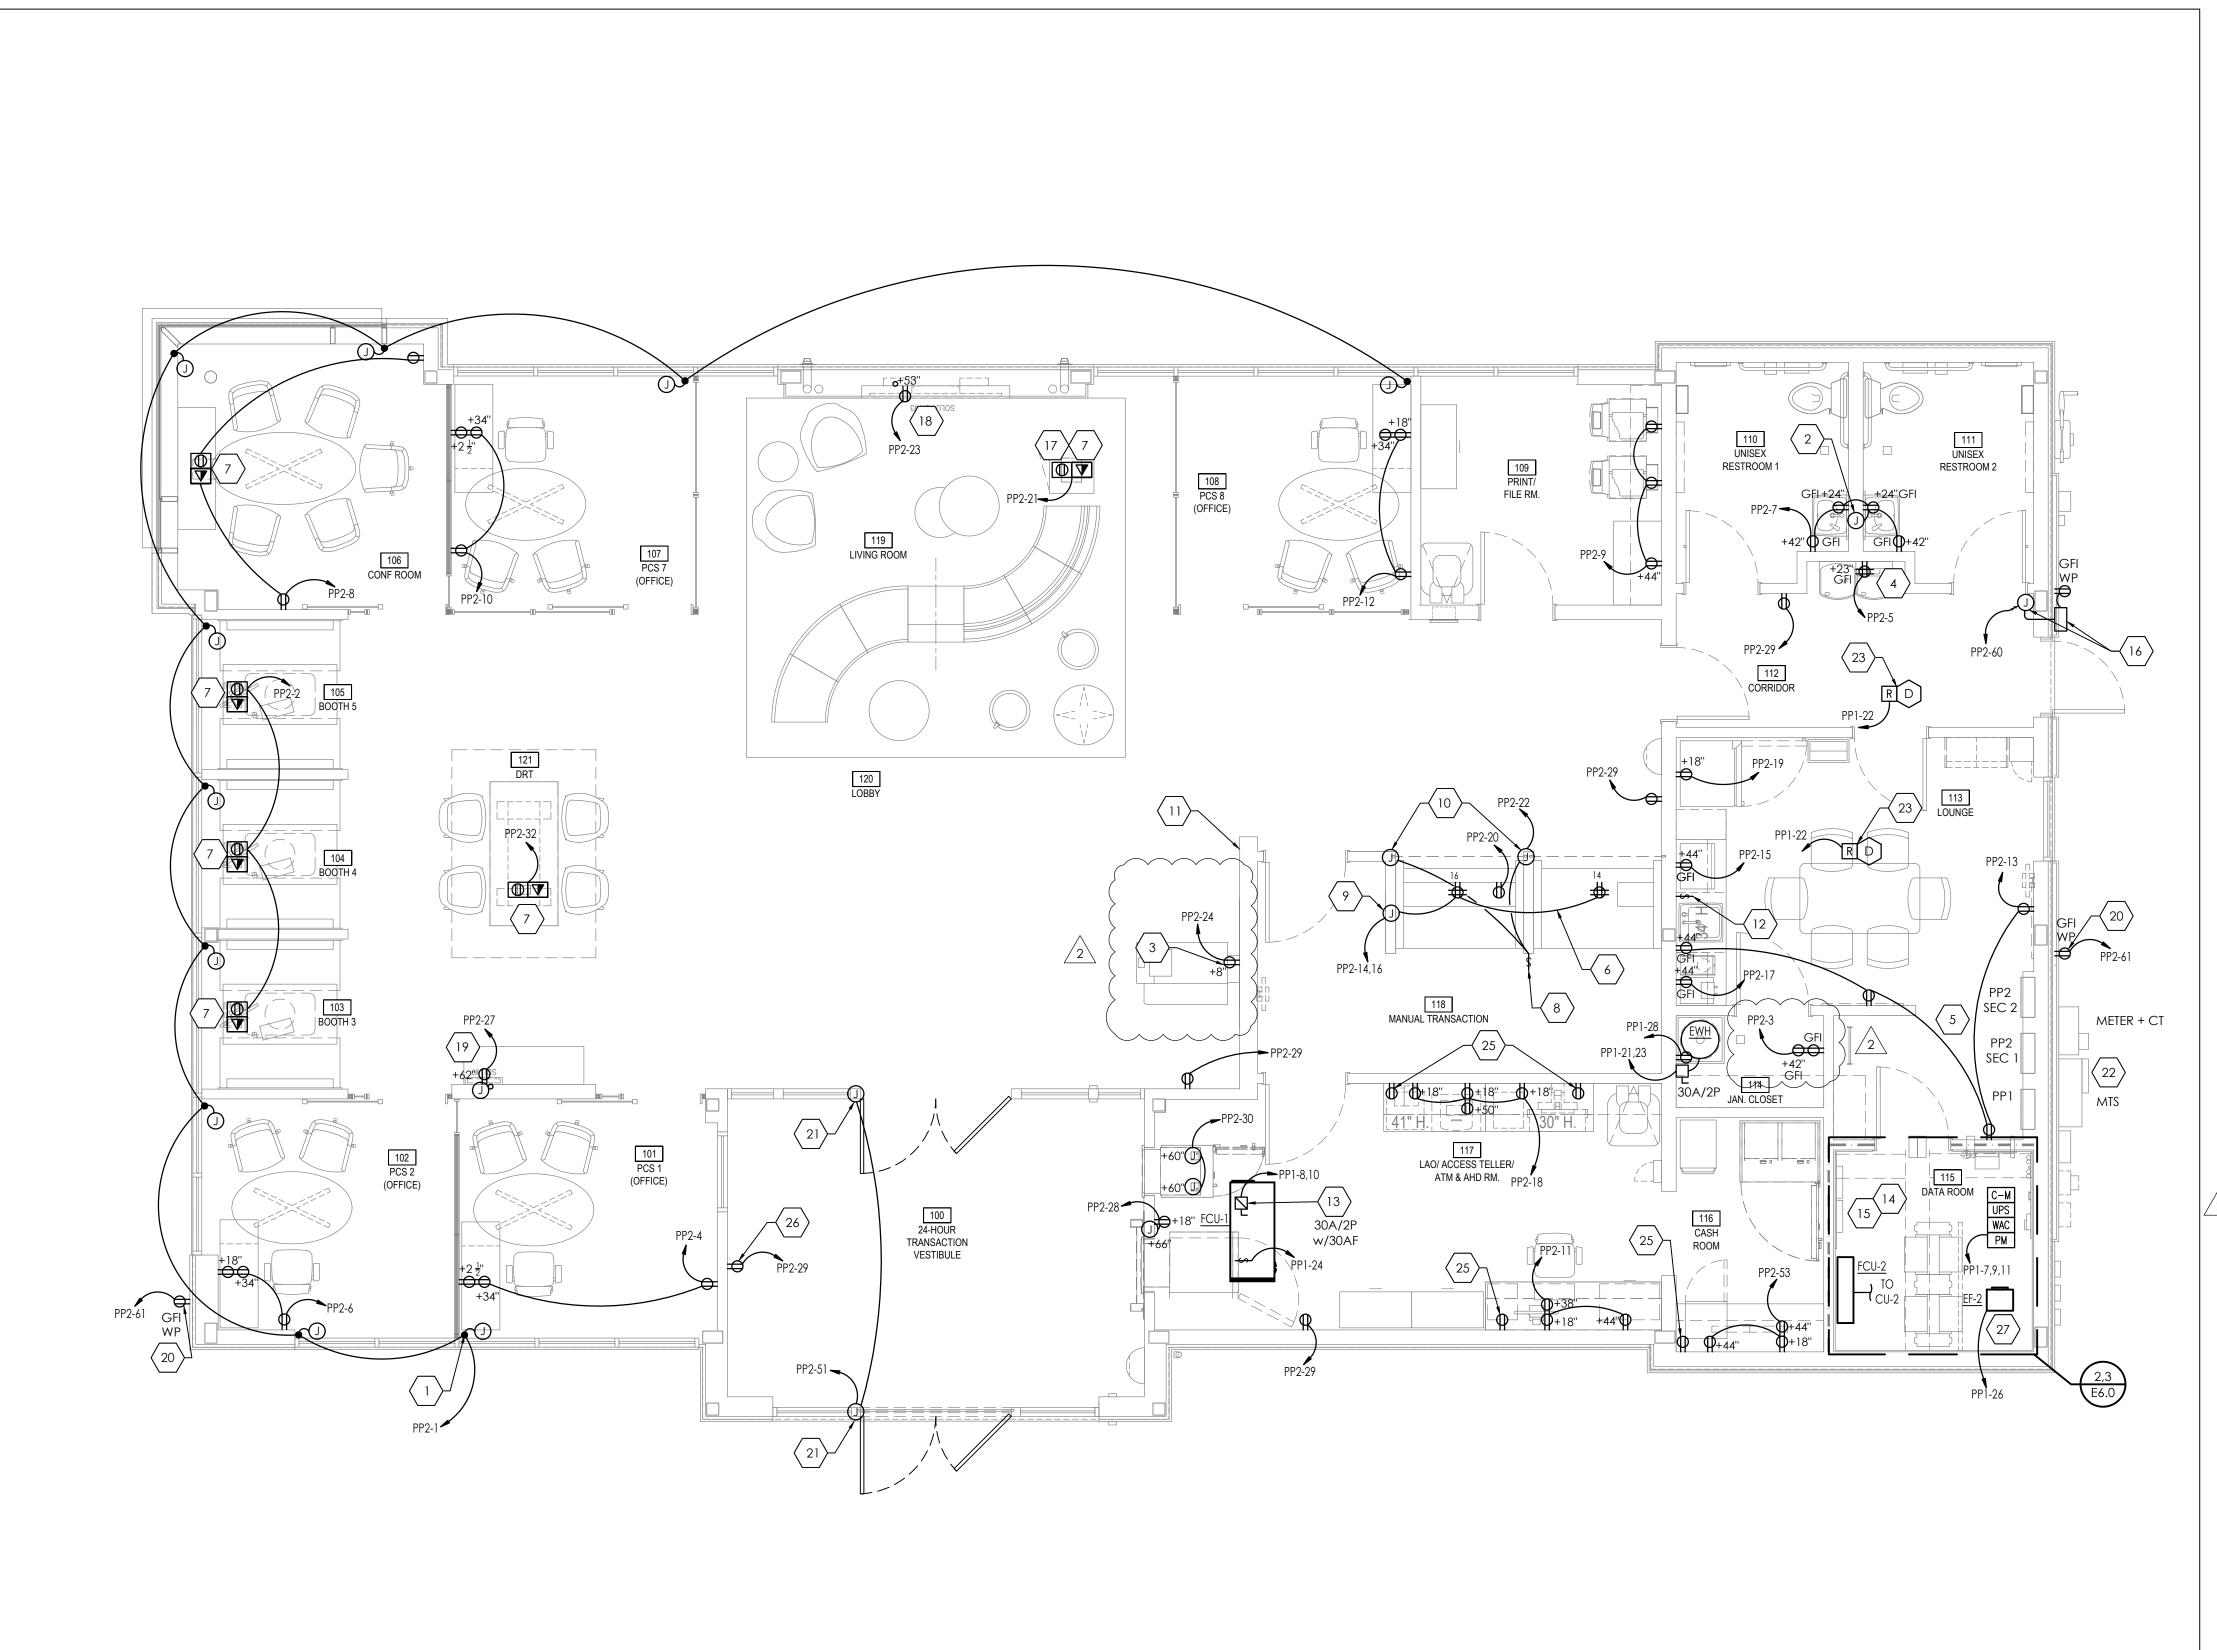

- ALL POWER CONNECTIONS TO FURNITURE (IF APPLICABLE) ARE TO BE BY THE ELECTRICAL CONTRACTOR. FINAL DATA/COMMUNICATION CABLING AND CONNECTIONS ARE TO BE BY OTHERS. COORDINATE EXACT LOCATIONS AND CONNECTION REQUIREMENTS WITH THE FURNITURE SUPPLIER/INSTALLER PRIOR TO ROUGH-IN.
- FAN COIL UNIT 2 SHALL BE POWERED THROUGH THE CORRESPONDING CONDENSING UNIT. REFER TO MECHANICAL SCHEDULES FOR ADDITIONAL INFORMATION.
- REFER TO ARCHITECTURAL ELEVATIONS FOR FINAL LOCATIONS AND MOUNTING HEIGHTS FOR RECEPTACLES.

(#) ELECTRICAL KEYNOTES:

- MOTORIZED SHADE INSTALLATION, REFER TO THE MOTORIZED SHADE POWER DETAIL FOR ROUGH-IN REQUIREMENTS. PROVIDE APPROPRIATE ROUGH-INS AND FINAL CONNECTIONS TO MOTORIZED SHADES, FIELD COORDINATE EXACT REQUIREMENTS WITH INSTALLING CONTRACTOR AND ADJUST ACCORDINGLY.
- PROVIDE POWER TO JUNCTION BOX MOUNTED 1'-0" ABOVE CEILING FOR AUTO FAUCET TRANSFORMER PROVIDED BY OTHERS. FIELD COORDINATE EXACT REQUIREMENTS AND LOCATION PRIOR TO ROUGH IN AND ADJUST ACCORDINGLY.
- 3. ROUTE POWER CONDUIT THROUGH RACEWAY TO SURFACE MOUNTED ATM AS SHOWN.
 COORDINATE WITH ATM MANUFACTURER FOR ALL INSTALLATION REQUIREMENTS PRIOR TO
 INSTALLATION.
- 4. COORDINATE ROUGH-IN LOCATION FOR DRINKING FOUNTAIN RECEPTACLES WITH SHOP
- 5. MAINTAIN REQUIRED CLEARANCES FOR ALL ELECTRICAL PANELS PER THE NEC SECTION 110.26. REFER TO POWER RISER DIAGRAM LOCATED ON POWER DETAILS AND SCHEDULES SHEET FOR ADDITIONAL INFORMATION.
- 6. ROUTE CONDUIT THROUGH RACEWAY IN MILLWORK TO SURFACE MOUNTED DEVICES AS SHOWN. COORDINATE WITH MILLWORK PROVIDER PRIOR TO INSTALL.
- 7. REFER TO UNDERGROUND CONDUIT PLAN FOR UNDERGROUND CONDUIT AND CABLING
- ROUTING FOR DEVICES IN THIS AREA.

 8. KEYPAD FOR MOTORIZED SCRIM. KEYPAD CAN CONTROL UP TO FOUR SCRIMS AND IS PROVIDE
- BY VENDOR. REFERENCE ARCHITECTURAL ELEVATIONS FOR ADDITIONAL INFORMATION.

 9. ROUTE ONE 3/4" CONDUIT TO END OF THE TELLER LINE AS SHOWN. CONCEAL CONDUIT IN WALL
- AND TERMINATE AT J-BOX. REFER TO ARCHITECTURAL SHEETS.

 10. MOTORIZED SCRIM INSTALLATION, REFER TO ARCHITECTURAL DETAIL FOR ROUGH-IN

 PEOULIPEMENTS, PROVIDE APPROPRIATE POUGH INS AND FINAL CONNECTIONS TO MOTORIZED.
- REQUIREMENTS, PROVIDE APPROPRIATE ROUGH-INS AND FINAL CONNECTIONS TO MOTORIZED SCRIM, FIELD COORDINATE EXACT REQUIREMENTS WITH INSTALLING CONTRACTOR AND ADJUST ACCORDINGLY.
- 11. WALL MOUNTED SECURITY KEYPAD FOR EATMS ON BANKING FLOOR. COORDINATE EXACT LOCATION AND REQUIREMENTS WITH GC PRIOR TO ROUGH-IN.
- 12. EXHAUST FAN SHALL BE INTERLOCKED WITH 3-WAY PRESET PUSH BUTTON TIMER SWITCH. REFER TO EXHAUST FAN CONTROL DIAGRAM, LIGHTING PLAN SHEET, ROOF POWER PLAN SHEET, AND MECHANICAL SCHEDULES ON MECHANICAL SHEETS FOR ADDITIONAL INFORMATION. TIMER SWITCH IS BEING PROVIDED BY MECHANICAL CONTRACTOR AND INSTALLED BY ELECTRICAL CONTRACTOR
- 13. PROVIDE POWER TO MECHANICAL EQUIPMENT AS SHOWN. PROVIDE DISCONNECTING MEANS AS REQUIRED. COORDINATE FINAL LOCATION AND EXACT REQUIREMENTS WITH MECHANICAL CONTRACTOR PRIOR TO ROUGH-IN.
- 14. PROVIDE WIRELESS AREA CONTROLLER, DAINTREE #WAC-50. WIRELESS AREA CONTROLLER TO BE POWERED VIA 120V RECEPTACLE IN DATA ROOM AND WIRED TO CELLULAR MODEM FOR CONTROLSCOPE CONNECTIVITY. REFER TO BUILDING MANAGEMENT SYSTEM DETAILS SHEET FOR ADDITIONAL INFORMATION.
- 15. CELLULAR MODEM TO BE BE POWERED FROM DUPLEX RECEPTACLES IN DATA ROOM. CELLULAR MODEM AND WAC RECEPTACLES TO BE CONNECTED TO UPS. REFER TO BUILDING MANAGEMENT SYSTEM DETAILS SHEET FOR ADDITIONAL INFORMATION. ELECTRICAL CONTRACTOR TO DETERMINE LOCATION FINAL LOCATION OF RECEPTACLES IN FIELD.
- 16. IRRIGATION CONTROLLER SERVICE SWITCH LOCATED ABOVE CEILING. ROUTE ONE 3/4" CONDUIT STUBBED TO IRRIGATION CONTROLLER ON EXTERIOR WALL.
- 17. TELEPRESENCE CONTROL PANEL, MICROPHONE AND VIDEO INPUT TO BE HOUSED IN LIVING ROOM TABLE. E.C. TO PROVIDE POWER RECEPTACLE AND JUNCTION BOX WITH 1" CONDUIT STUBBED UP TO PAC BOX (IF PRESENT), OTHERWISE ROUTE THE 1" CONDUIT TO ABOVE CEILING FOR TELE-PRESENCE EQUIPMENT AT CAFE AREA. REFER TO JPMC RETAIL STRUCTURED CABLING STANDARDS FOR ADDL. INFO. COORDINATE FINAL DEVICE LOCATIONS W/ THE TELECOMM DRAWINGS PREPARED BY THE ASSIGNED PROJECT GTI DESIGNER.
- 18. E.C. TO PROVIDE POWER RECEPTACLE AND 1" CONDUIT ROUTED TO PAC BOX FOR LIVING ROOM TELE-PRESENCE MONITOR POWER. ROUTE CABLE AND WIRING OVERHEAD FROM MONITOR AS REQUIRED. ROUTE ONE 1" CONDUIT FROM PAC BOX TO ABOVE CEILING ELECTRICAL PANELS AS REQUIRED. REFER TO JPMC RETAIL STRUCTURED CABLING STANDARDS FOR ADDL. INFO. COORDINATE FINAL DEVICE LOCATIONS W/ THE TELECOMM DRAWINGS PREPARED BY THE ASSIGNED PROJECT GTLDESIGNER.
- 19. E.C. TO PROVIDE POWER RECEPTACLE WITH 1" CONDUIT STUBBED ABOVE CEILING FOR COMMUNITY WALL TELE-PRESENCE MONITOR. ROUTE CABLE AND WIRING OVERHEAD FROM MONITORS AS REQUIRED. REFER TO JPMC RETAIL STRUCTURED CABLING STANDARDS FOR ADDL. INFO. COORDINATE FINAL DEVICE LOCATIONS w/ THE TELECOMM DRAWINGS PREPARED BY THE ASSIGNED PROJECT GTI DESIGNER.
- 20. SET EXTERIOR BUILDING RECEPTACLE FLUSH WITH FACE OF MASONRY VENEER. PROVIDE METAL COVER COMPLIANT WITH CURRENT NATIONAL ELECTRICAL CODE (NEC). REFER TO ARCHITECTURAL EXTERIOR ELEVATIONS FOR MORE DETAILS. PROVIDE HUBBELL MODEL #5205WO, OR EQUIVALENT THAT IS COMPLIANT WITH N.E.C.
- 21. JUNCTION BOX FOR DOOR CONTROL CLOSER. ELECTRICAL CONTRACTOR SHALL COORDINATE WITH OWNER AND MANUFACTURER FOR FINAL LOCATION AND INSTALLATION REQUIREMENTS.
 22. METER, CT CABINET, AND MANUAL TRANSFER SWITCH (MTS) MOUNTED ON EXTERIOR WALL. REFER TO POWER RISER DIAGRAM ON POWER DETAILS AND SCHEDULES SHEET FOR ADDITIONAL
- 23. STANDALONE DUCT DETECTOR, INSTALLED IN DUCT BY HVAC CONTRACTOR, WIRING BY ELECTRICAL CONTRACTOR, SYSTEM SENSOR MODEL D4120 OR EQUIVALENT. COORDINATE WITH MECHANICAL CONTRACTOR FOR LOCATION. REFER TO SYSTEMS PLAN FOR REMOTE TEST SWITCH LOCATION.
- 25. RECEPTACLE LOCATED JUST ABOVE UPPER CABINET FOR POWER SUPPLY FOR UNDERCABINET LIGHTS. (UNSWITCHED) POWER FROM CIRCUIT AS INDICATED ON LIGHTING PLAN.
- 26. ELECTRICAL CONTRACTOR SHALL PROVIDE STANDARD DUPLEX RECEPTACLE WITH BELL
- LOCKABLE COVER SPECIFICATION NUMBER MX1050S OR EQUIVALENT.

 27. DISCONNECT SWITCH IS BEING PROVIDED WITH EQUIPMENT. COORDINATE WITH MECHANICAL

POWER PLAN SCALE 1/4" = 1'

CONTRACTOR FOR INSTALLATION AND POWER CONNECTION. IF NO DISCONNECT WAS INCLUDED WITH SHIPMENT, COORDINATE WITH MECHANICAL CONTRACTOR AND PROVIDE AS REQUIRED. EXHAUST FAN DATA ROOM. REFER TO MECHANICAL DRAWINGS FOR ADDITIONAL INFORMATION.



DRE STATE



462.9700 w.core-states.com

NGINEER OF RECORD



06/01/2021

THESE DRAWINGS ARE NOT COMPLETE WITHOUT THE SEPARATE TYPE WRITTEN SPECIFICATIONS MANUAL WHICH ARE PART OF THE CONTRACT DOCUMENTS.

JOHN FERGUSON, P.E. MISSOURI LICENSE #: 2008014085

ISSUE DATE DESCRIPTION

- 2020.12.21 PERMIT SET

1 2021.04.20 STRUCTURAL STEEL REV

2 2021.06.03 PLAN REVIEW COMMENTS, RDC21 & WIRELESS UPDATE

PROJECT INFORMATION

PROJECT INFORMATION

PROJECT NO: JPM.27135.001

DATE: 2020.12.21

PROTOTYPE: 20.2

DRAWN BY: D. BORELL

CHECKED BY: D. MULVANEY


VERSION: SE_1.00

SHEET TITLE

POWER PLAN

SHEET NUMBER

E3.0

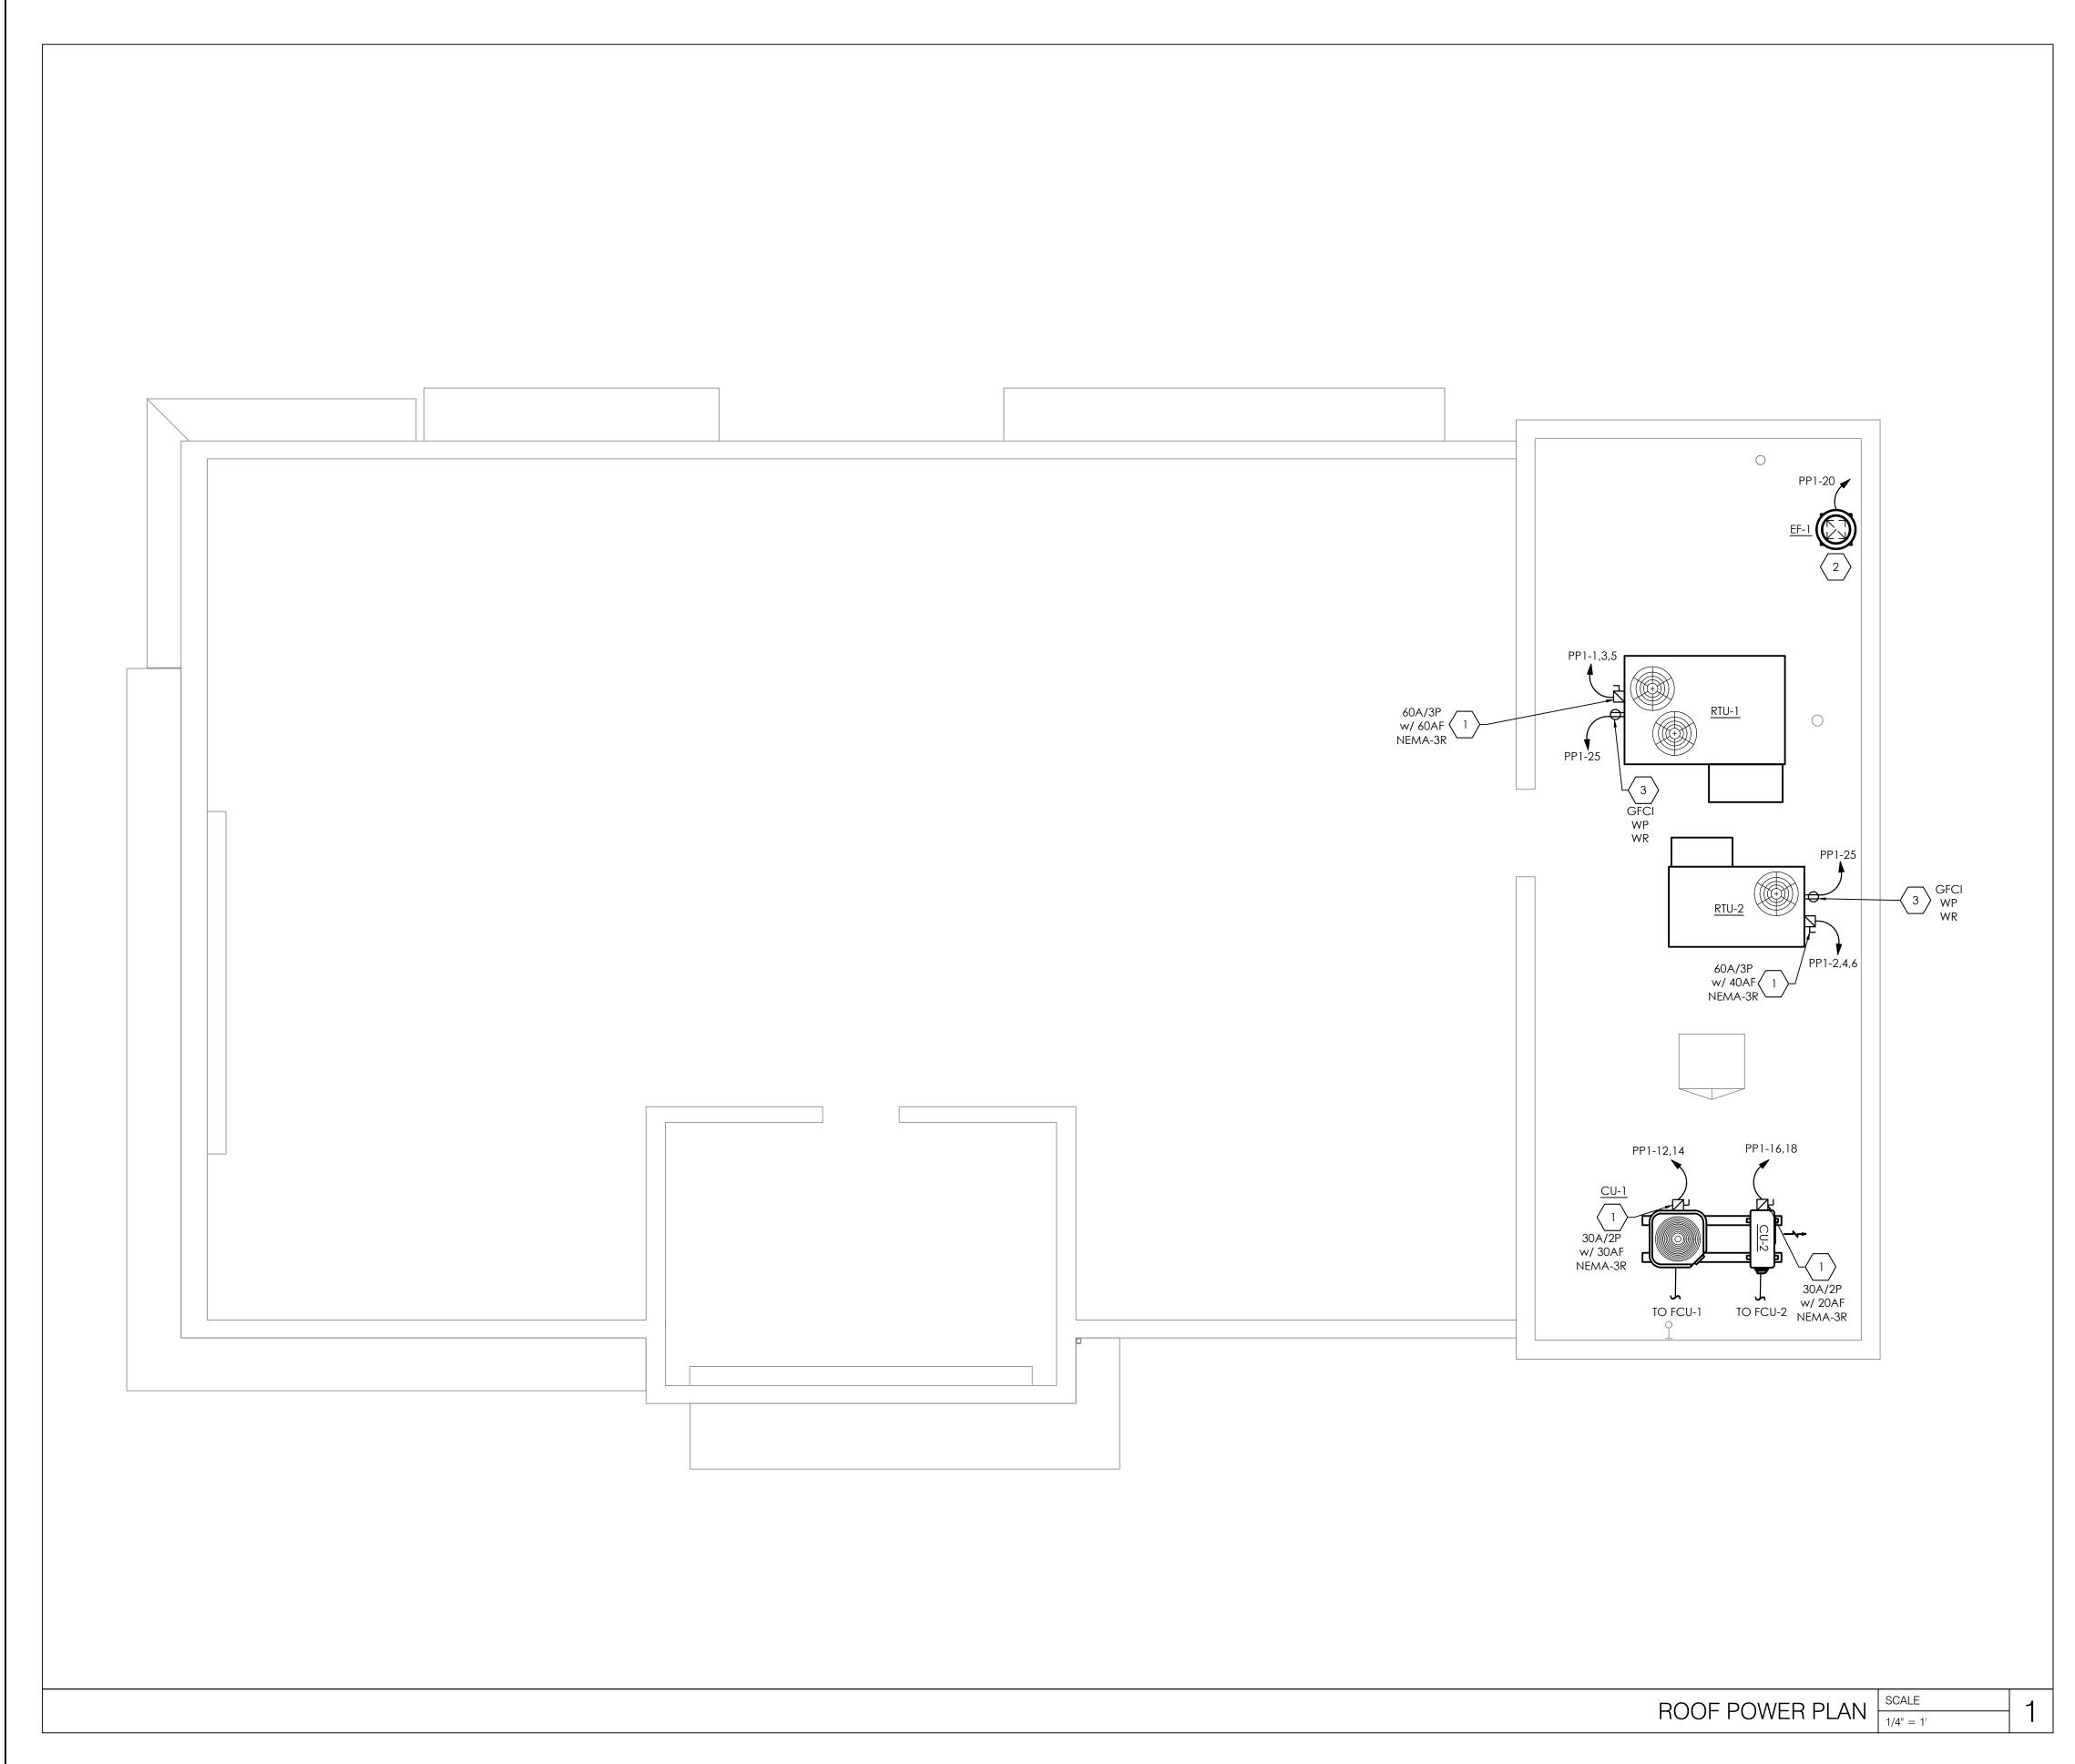

- FAN COIL UNIT 2 SHALL BE POWERED THROUGH THE CORRESPONDING CONDENSING UNIT ON THE ROOF. REFER TO MECHANICAL SCHEDULES FOR ADDITIONAL INFORMATION.
- RTU'S PROVIDED WITH POWERED RECEPTACLE. IF UNIT IS NOT PROVIDED WITH RECEPTACLE, PLEASE PROVIDE AS INDICATED. REFER TO MECHANICAL SCHEDULE SHEET FOR ADDITIONAL INFORMATION.

$\langle * \rangle$ ELECTRICAL KEY NOTES:

- 1. PROVIDE POWER TO MECHANICAL EQUIPMENT AS SHOWN. PROVIDE DISCONNECTING MEANS AS REQUIRED. COORDINATE FINAL LOCATION AND EXACT REQUIREMENTS WITH MECHANICAL CONTRACTOR PRIOR TO ROUGH-IN.
 - DISCONNECT SWITCH IS BEING PROVIDED WITH EQUIPMENT. COORDINATE WITH MECHANICAL CONTRACTOR FOR INSTALLATION AND POWER CONNECTION. IF NO DISCONNECT WAS INCLUDED WITH SHIPMENT, COORDINATE WITH MECHANICAL CONTRACTOR AND PROVIDE AS REQUIRED. EXHAUST FAN SERVES LOUNGE, JANITOR'S CLOSET AND RESTROOMS. REFER TO LIGHTING PLAN, POWER PLAN AND MECHANICAL DRAWINGS FOR ADDITIONAL INFORMATION.
 - PROVIDE WEATHERPROOF, GFI PROTECTED, WEATHER RESISTANT ROOFTOP RECEPTACLE. OUTLET BOX HOODS SHALL BE IDENTIFIED AND LISTED AS EXTRA DUTY PER ARTICLE 406.9(8)(1).





46 East Main Street Suite 201 Somerville, NJ 08876 908.462.9700 www.core-states.com

www.core-states.com

ENGINEER OF RECORD



01/19/2021

THESE DRAWINGS ARE NOT COMPLETE WITHOUT THE SEPARATE TYPE WRITTEN SPECIFICATIONS MANUAL WHICH ARE PART OF THE CONTRACT DOCUMENTS.

JOHN FERGUSON, P.E. MISSOURI LICENSE #: 2008014085

ISSUE DATE DESCRIPTION

- 2020.12.21 PERMIT SET

PROJECT INFORMATION

PROJECT NO: JPM.27135.001

DATE: 2020.12.21

PROTOTYPE: 20.2

DRAWN BY: D. BORELLI


CHECKED BY: D. MULVANEY


ROOF POWER PLAN


SHEET NUMBER

SHEET TITLE

E3.1

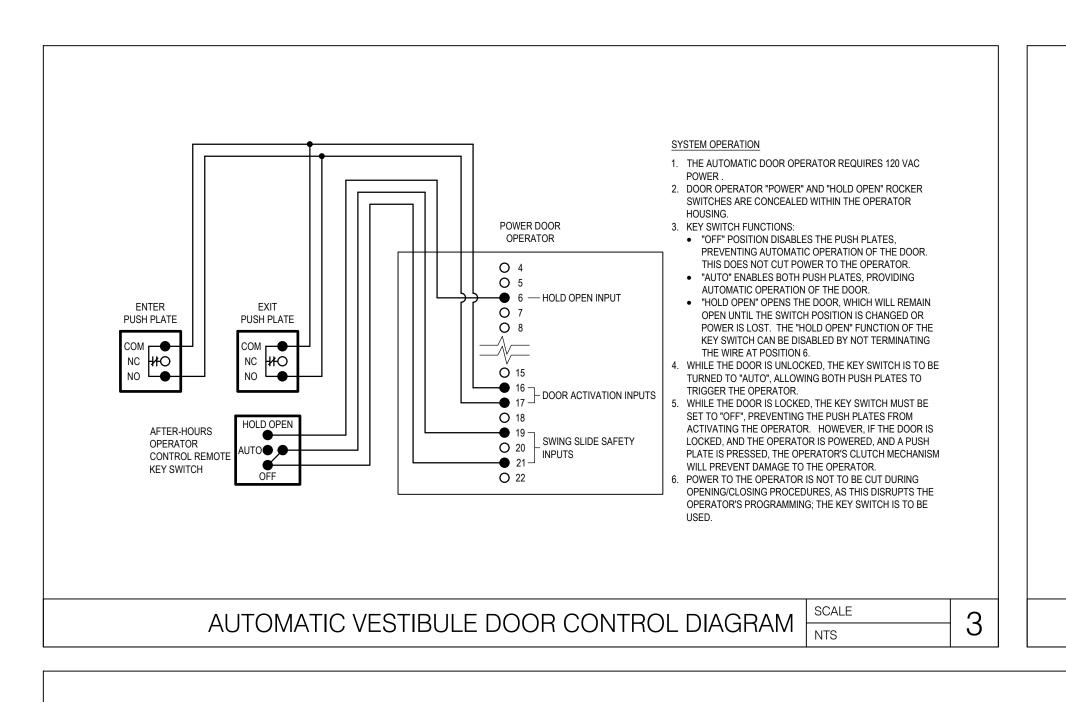

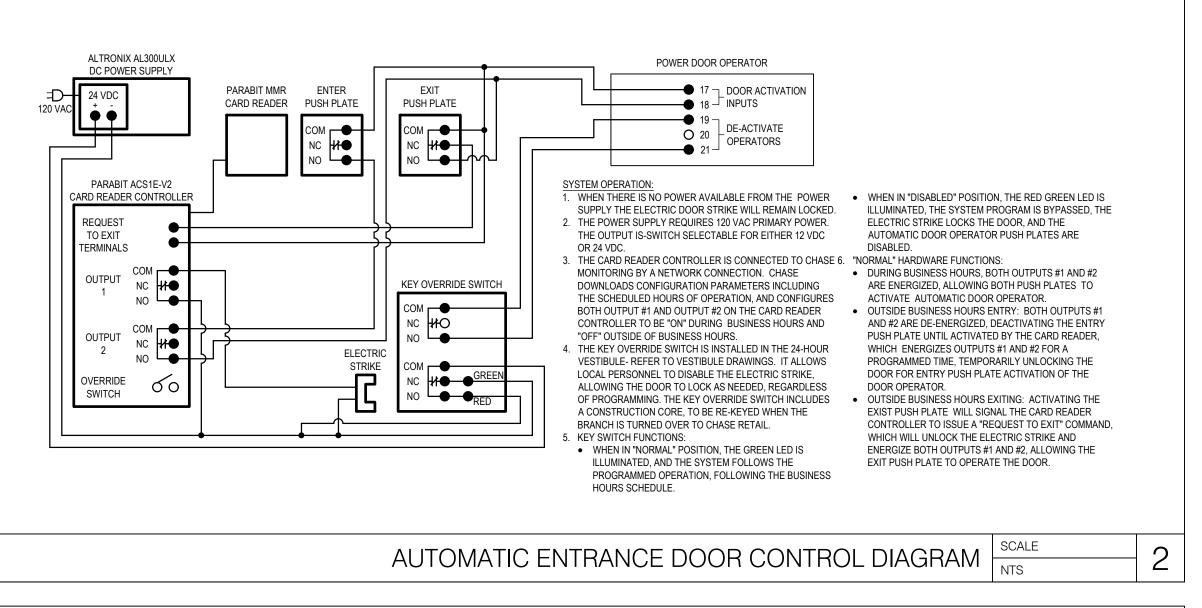

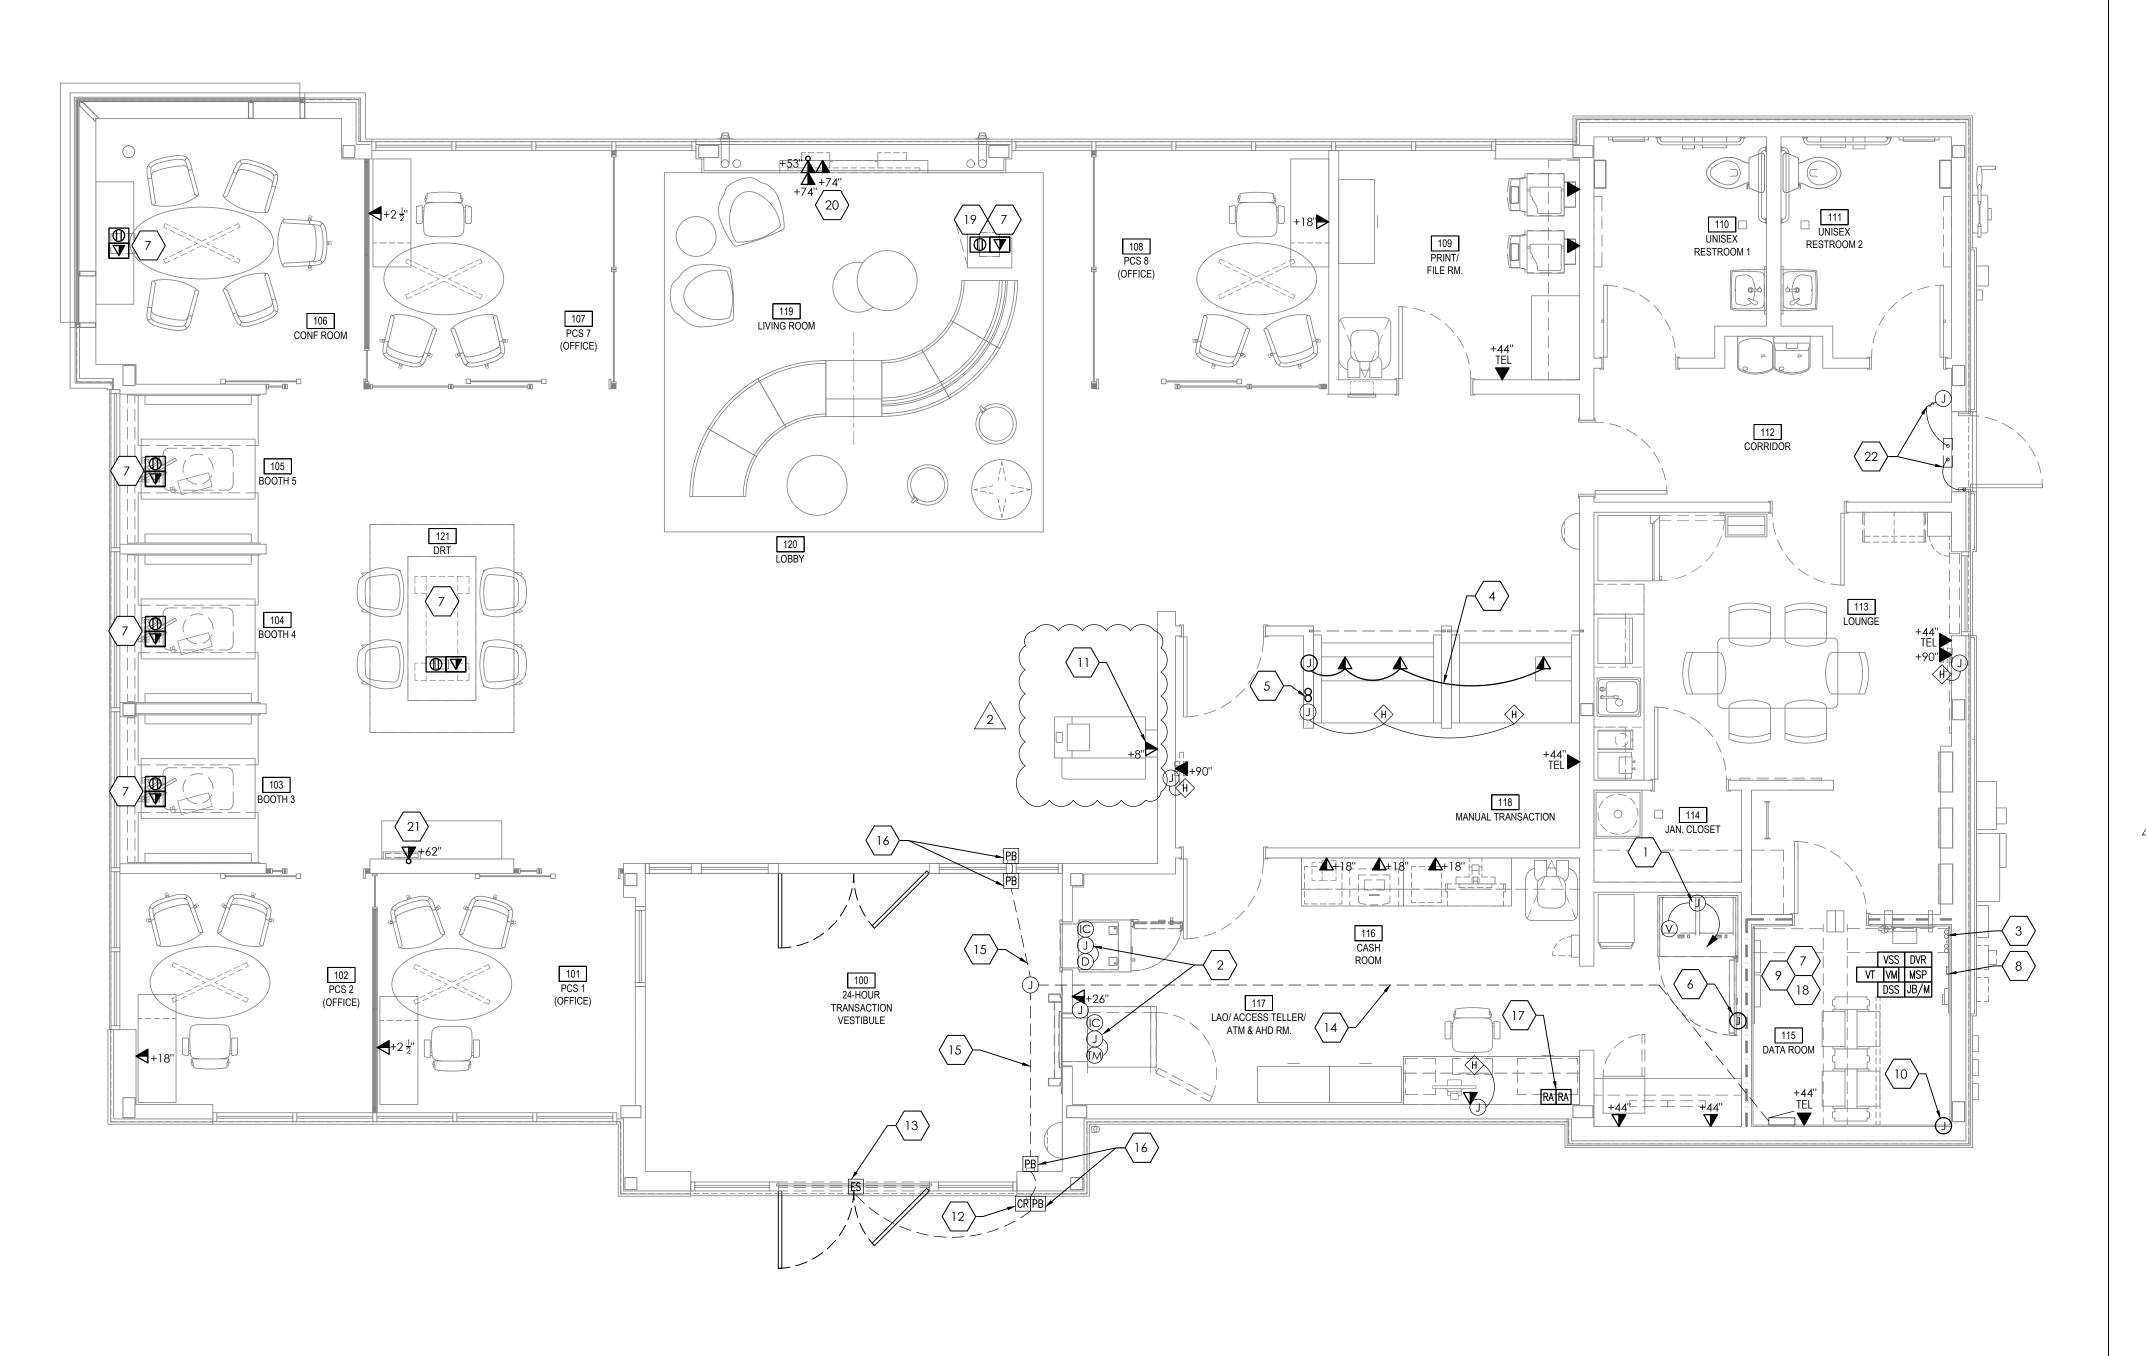

- IT IS THE ELECTRICAL CONTRACTOR'S RESPONSIBILITY TO RUN CONDUIT AND WIRING TO ALL APPROPRIATE SECURITY EQUIPMENT LOCATIONS PRIOR TO INSTALLATION. SECURITY VENDOR WILL CONNECT DEVICES. REFER TO SECURITY VENDOR DRAWINGS FOR ADDITIONAL INFORMATION.
- REFER TO CHASE TELECOMM DRAWINGS FOR ADDITIONAL INFORMATION REGARDING THE
 DATA ROOM AND ALL INSTALLATION REQUIREMENTS. REFER TO CHASE TELECOMM ELEVATIONS
 FOR ALL MOUNTING HEIGHTS AND FINAL LOCATIONS
- REFER TO JPMC RETAIL STRUCTURED CABLING STANDARDS FOR ADDL. INFO. COORDINATE FINAL EQUIPMENT LOCATIONS w/ THE TELECOMM DRAWINGS PREPARED BY THE ASSIGNED PROJECT
- ELECTRCIAL CONTRACTOR TO COORDINATE ALL SECURITY EQUIPMENT LOCATIONS WITH SECURITY VENDOR AND CHASE. ONLY EXTERIOR LOCATIONS ARE SHOWN ON THESE PLANS FOR COORDINATION DURING CONSTRUCTION.
- THE BCM OFFICE SHALL BE DETERMINED IN FIELD BY BRANCH STAFF. CONTRACTOR TO COORDINATE THE LOCATION OF BCM OFFICE WITH BRANCH STAFF FOR THE INSTALLATION OF
- REFER TO ARCHITECTURAL ELEVATIONS FOR FINAL LOCATIONS AND MOUNTING HEIGHTS FOR DATA AND TELEPHONES.

ELECTRICAL KEYNOTES:

- . 4"X4"X2-1/8" JUNCTION BOX-PROVIDE A 3/4"C W/PULLWIRE BACK TO SECURITY EQUIPMENT IN DATA ROOM, VERIFY MOUNTING HEIGHT PRIOR TO ROUGH IN.
- 4"X4"X2-1/8" JUNCTION BOX WITH BLANK COVER (FIELD COORDINATE EXACT ROUGH-IN REQUIREMENTS PRIOR TO ROUGH IN AND ADJUST ACCORDINGLY), PROVIDE A 1"C WITH PULL WIRE TO ALARM CONTROL CABINET.
- ELECTRICAL CONTRACTOR TO PROVIDE TWO 2" CONDUITS FROM THE DATA RACK TO THE CARRIER POINT OF ENTRY. ONE CONDUIT FOR TELECOMM SERVICE PROVIDER TO EXTEND DEMARCATION INTO THE NEW DATA RACK. ONE CONDUIT WILL BE OWNER SPARE. ELECTRICAL CONTRACTOR TO COORDINATE ALL ROUTING WITH BUILDING OWNER AND TELECOMMUNICATIONS CARRIER PRIOR TO INSTALLATION. REFER TO ENLARGED PLAN AND ELEVATIONS SHEET AS WELL AS TELECOMM DRAWINGS PREPARED BY GTI DESIGN TEAM FOR
- 4. ROUTE CONDUIT THOUGH RACEWAY IN MILLWORK TO SURFACE MOUNTED DEVICES AS SHOWN. COORDINATE WITH MILLWORK PROVIDER PRIOR TO INSTALL.
- ROUTE ONE 1-1/4" CONDUIT AND ONE 3/4" CONDUIT FROM THE DATA ROOM TO END OF THE TELLER LINE AS SHOWN. CONCEAL CONDUITS IN WALL AND TERMINATE AT J-BOX FOR CONNECTION TO FLOOR MOUNTED RACEWAY. REFER TO ARCHITECTURAL SHEETS.
- 6. PROVIDE JUNCTION BOX AT +114"AFF FACING INTO ATM ROOM ABOVE CEILING, FOR WIFI ANTENNA, PROVIDE A 3/4"C FROM JUNCTION BOX STUBBED UP INTO CEILING SPACE OF LOBBY
- REFER TO UNDERGROUND CONDUIT PLAN SHEET FOR UNDERGROUND CONDUIT AND CABLING ROUTING FOR DEVICES IN THIS AREA.
- 8. PROVIDE 1/2"C (1#6AWG, CU. GND) FROM DATA RACK & PHONE SYSTEM GROUND BUSS TO ELECTRICAL SERVICE GROUND ELECTRODE SYSTEM, REFER TO SERVICE GROUND DETAIL ON POWER DETAILS AND SCHEDULES SHEET FOR ADDITIONAL INFORMATION.
- 9. PROVIDE RING EXTENSION FOR 5/8" GYPSUM BOARD AND 3/4" PLYWOOD FOR ALL WALL MOUNTED JUNCTION BOXES IN DATA ROOM.
- 10. 4"X4"X2-1/8" JUNCTION BOX-PROVIDE A 3/4"C W/PULLWIRE STUB UP TO ACCESSIBLE CEILING
- SPACE.

 11. ROUTE DATA CONDUIT THROUGH RACEWAY TO SURFACE MOUNTED ATM AS SHOWN.
- COORDINATE ALL INSTALLATION REQUIREMENTS WITH ATM MANUFACTURER PRIOR TO INSTALLATION.

 12. PROVIDE A CARD READER DOOR ACCESS ENTRY SYSTEM AND AUTOMATIC DOOR OPERATOR.
- 12. PROVIDE A CARD READER DOOR ACCESS ENTRY SYSTEM AND AUTOMATIC DOOR OPERATOR WITH ELECTRIC STRIKE, SYSTEM CONTROL PANEL, CONCEALED CONDUIT, WIRING ETC. FOR A COMPLETE OPERATING SYSTEM, SEE HARDWARE SPECIFICATION SECTION.
- 13. ELECTRIC STRIKE FOR 24-HOUR VESTIBULE DOOR OPERATION ONLY.
- 14. PROVIDE A RACEWAY TO THE VESTIBULE DOOR CONTROL PANEL IN THE ELECTRICAL ROOM FOR THE PURPOSE OF PROVIDING DATA TO THE AUTOMATIC DOOR OPENING SYSTEM AND ELECTRICAL STRIKE SYSTEM.
- 15. THE ELECTRICAL CONTRACTOR SHALL PROVIDE A RACEWAY TO THE FRONT VESTIBULE DOOR FRAMES FOR THE PURPOSE OF RUNNING WIRES FOR THE AUTOMATIC DOOR OPENER PUSH BUTTON AND ASSOCIATED EQUIPMENT. THE ELECTRICAL CONTRACTOR SHALL FURNISH AND INSTALL ALL CONDUIT AND JUNCTION BOXES INCLUDING FLEXIBLE CONDUIT, IF REQUIRED, AS WELL AS PULL WIRES AS REQUIRED.
- 16. PROVIDE A PUSH BUTTON FOR AUTOMATIC DOOR OPERATION WITH CONCEALED CONDUIT, WIRING ETC. CONNECT TO SYSTEM CONTROL PANEL. FOR A COMPLETE OPERATING SYSTEM, SE HARDWARE SPECIFICATION SECTION.
- 17. REMOTE DUCT MOUNTED SMOKE DETECTOR TEST SWITCH. PROVIDE SYSTEM SENSOR MODEL APA151 ANNUNCIATOR WITH PIEZO ALERT OR EQUIVALENT AND SYSTEM SENSOR MODEL RTS151 KEY TEST SWITCH OR EQUIVALENT. ACTIVATION OF A DUCT SMOKE DETECTOR SHALL INITIATE A VISIBLE AND AUDIBLE SUPERVISORY SIGNAL AT A CONSTANTLY ATTENDED LOCATION. COORDINATE FINAL LOCATION WITH OWNER PRIOR TO INSTALLATION.
- 18. COORDINATE WITH CHASE SECURITY TEAM FOR FINAL LOCATION AND POWER REQUIREMENTS FOR THE WIRELESS RECEIVER FOR THE HUB.
- 19. TELEPRESENCE CONTROL PANEL, MICROPHONE AND VIDEO INPUT TO BE HOUSED IN LIVING ROOM TABLE. E.C. TO PROVIDE DATA RECEPTACLE AND JUNCTION BOX WITH 1" CONDUIT STUBBED UP TO PAC BOX (IF PRESENT), OTHERWISE ROUTE THE 1" CONDUIT TO ABOVE CEILING FOR TELE-PRESENCE EQUIPMENT AT CAFE AREA. REFER TO JPMC RETAIL STRUCTURED CABLING STANDARDS FOR ADDL. INFO. COORDINATE FINAL DEVICE LOCATIONS w/ THE TELECOMM DRAWINGS PREPARED BY THE ASSIGNED PROJECT GTI DESIGNER.
- 20. E.C. TO PROVIDE DATA OUTLETS AND A 1" CONDUIT ROUTED TO PAC BOX FOR LIVING ROOM TELE-PRESENCE MONITOR. ROUTE CABLE AND WIRING OVERHEAD FROM MONITORS AS REQUIRED. ROUTE 1" CONDUIT FROM PAC BOX ABOVE CEILING TO DATA ROOM AS REQUIRED. REFER TO JPMC RETAIL STRUCTURED CABLING STANDARDS FOR ADDL. INFO. COORDINATE FINAL DEVICE LOCATIONS W/ THE TELECOMM DRAWINGS PREPARED BY THE ASSIGNED PROJECT GTI
- 21. E.C. TO PROVIDE DATA BOX WITH 1" CONDUIT STUBBED ABOVE CEILING FOR COMMUNITY WALL TELE-PRESENCE MONITOR. ROUTE CABLE AND WIRING OVERHEAD FROM MONITORS AS REQUIRED.REFER TO JPMC RETAIL STRUCTURED CABLING STANDARDS FOR ADDL. INFO. COORDINATE FINAL DEVICE LOCATIONS w/ THE TELECOMM DRAWINGS PREPARED BY THE ASSIGNED PROJECT GTI DESIGNER.
- 22. DOOR ALARM POWER SUPPLY LOCATED ABOVE CEILING OVER DOOR. ROUTE 3/4" CONDUIT TO CENTER DOOR HINGE FOR POWER TRANSFER. HINGE CONNECTION BY DOOR HARDWARE INSTALLER. COORDINATE CONDUIT HEIGHT AND LOCATION WITH DOOR FRAME INSTALLATION. DOOR ALARM POWER SUPPLY SERVICE SWITCH LOCATED ABOVE CEILING. REFER TO DOOR HARDWARE SCHEDULE ON ARCHITECTURAL DRAWINGS AND COORDINATE WITH DOOR AND HARDWARE VENDOR FOR ADDITIONAL INFORMATION.





46 East Main Street Suite 201 Somerville, NJ 08876 908.462.9700

ww.core-states.com

IGINEER OF RECORD



THESE DRAWINGS ARE NOT COMPLETE WITHOUT THE SEPARATE TYPE WRITTEN SPECIFICATIONS MANUAL WHICH ARE PART OF THE CONTRACT DOCUMENTS.

JOHN FERGUSON, P.E. MISSOURI LICENSE #: 2008014085

ISSUE	DATE	DESCRIPTION
-	2020.12.21	PERMIT SET
1	2021.04.20	STRUCTURAL STEEL REV
2	2021.06.03	PLAN REVIEW COMMENTS, RDC21 & WIRELESS UPDATE

PROJECT INF	ORMATION
PROJECT NO:	JPM.27135.00
DATE:	2020.12.2
PROTOTYPE:	20
DRAWN BY:	D. BOREL
CHECKED BY:	D. MULVANE
VERSION:	SE_1.0


SYSTEMS PLAN

SHEET NUMBER

SHEET TITLE

E4.0

SYSTEMS PLAN SCALE 1/4" = 1'

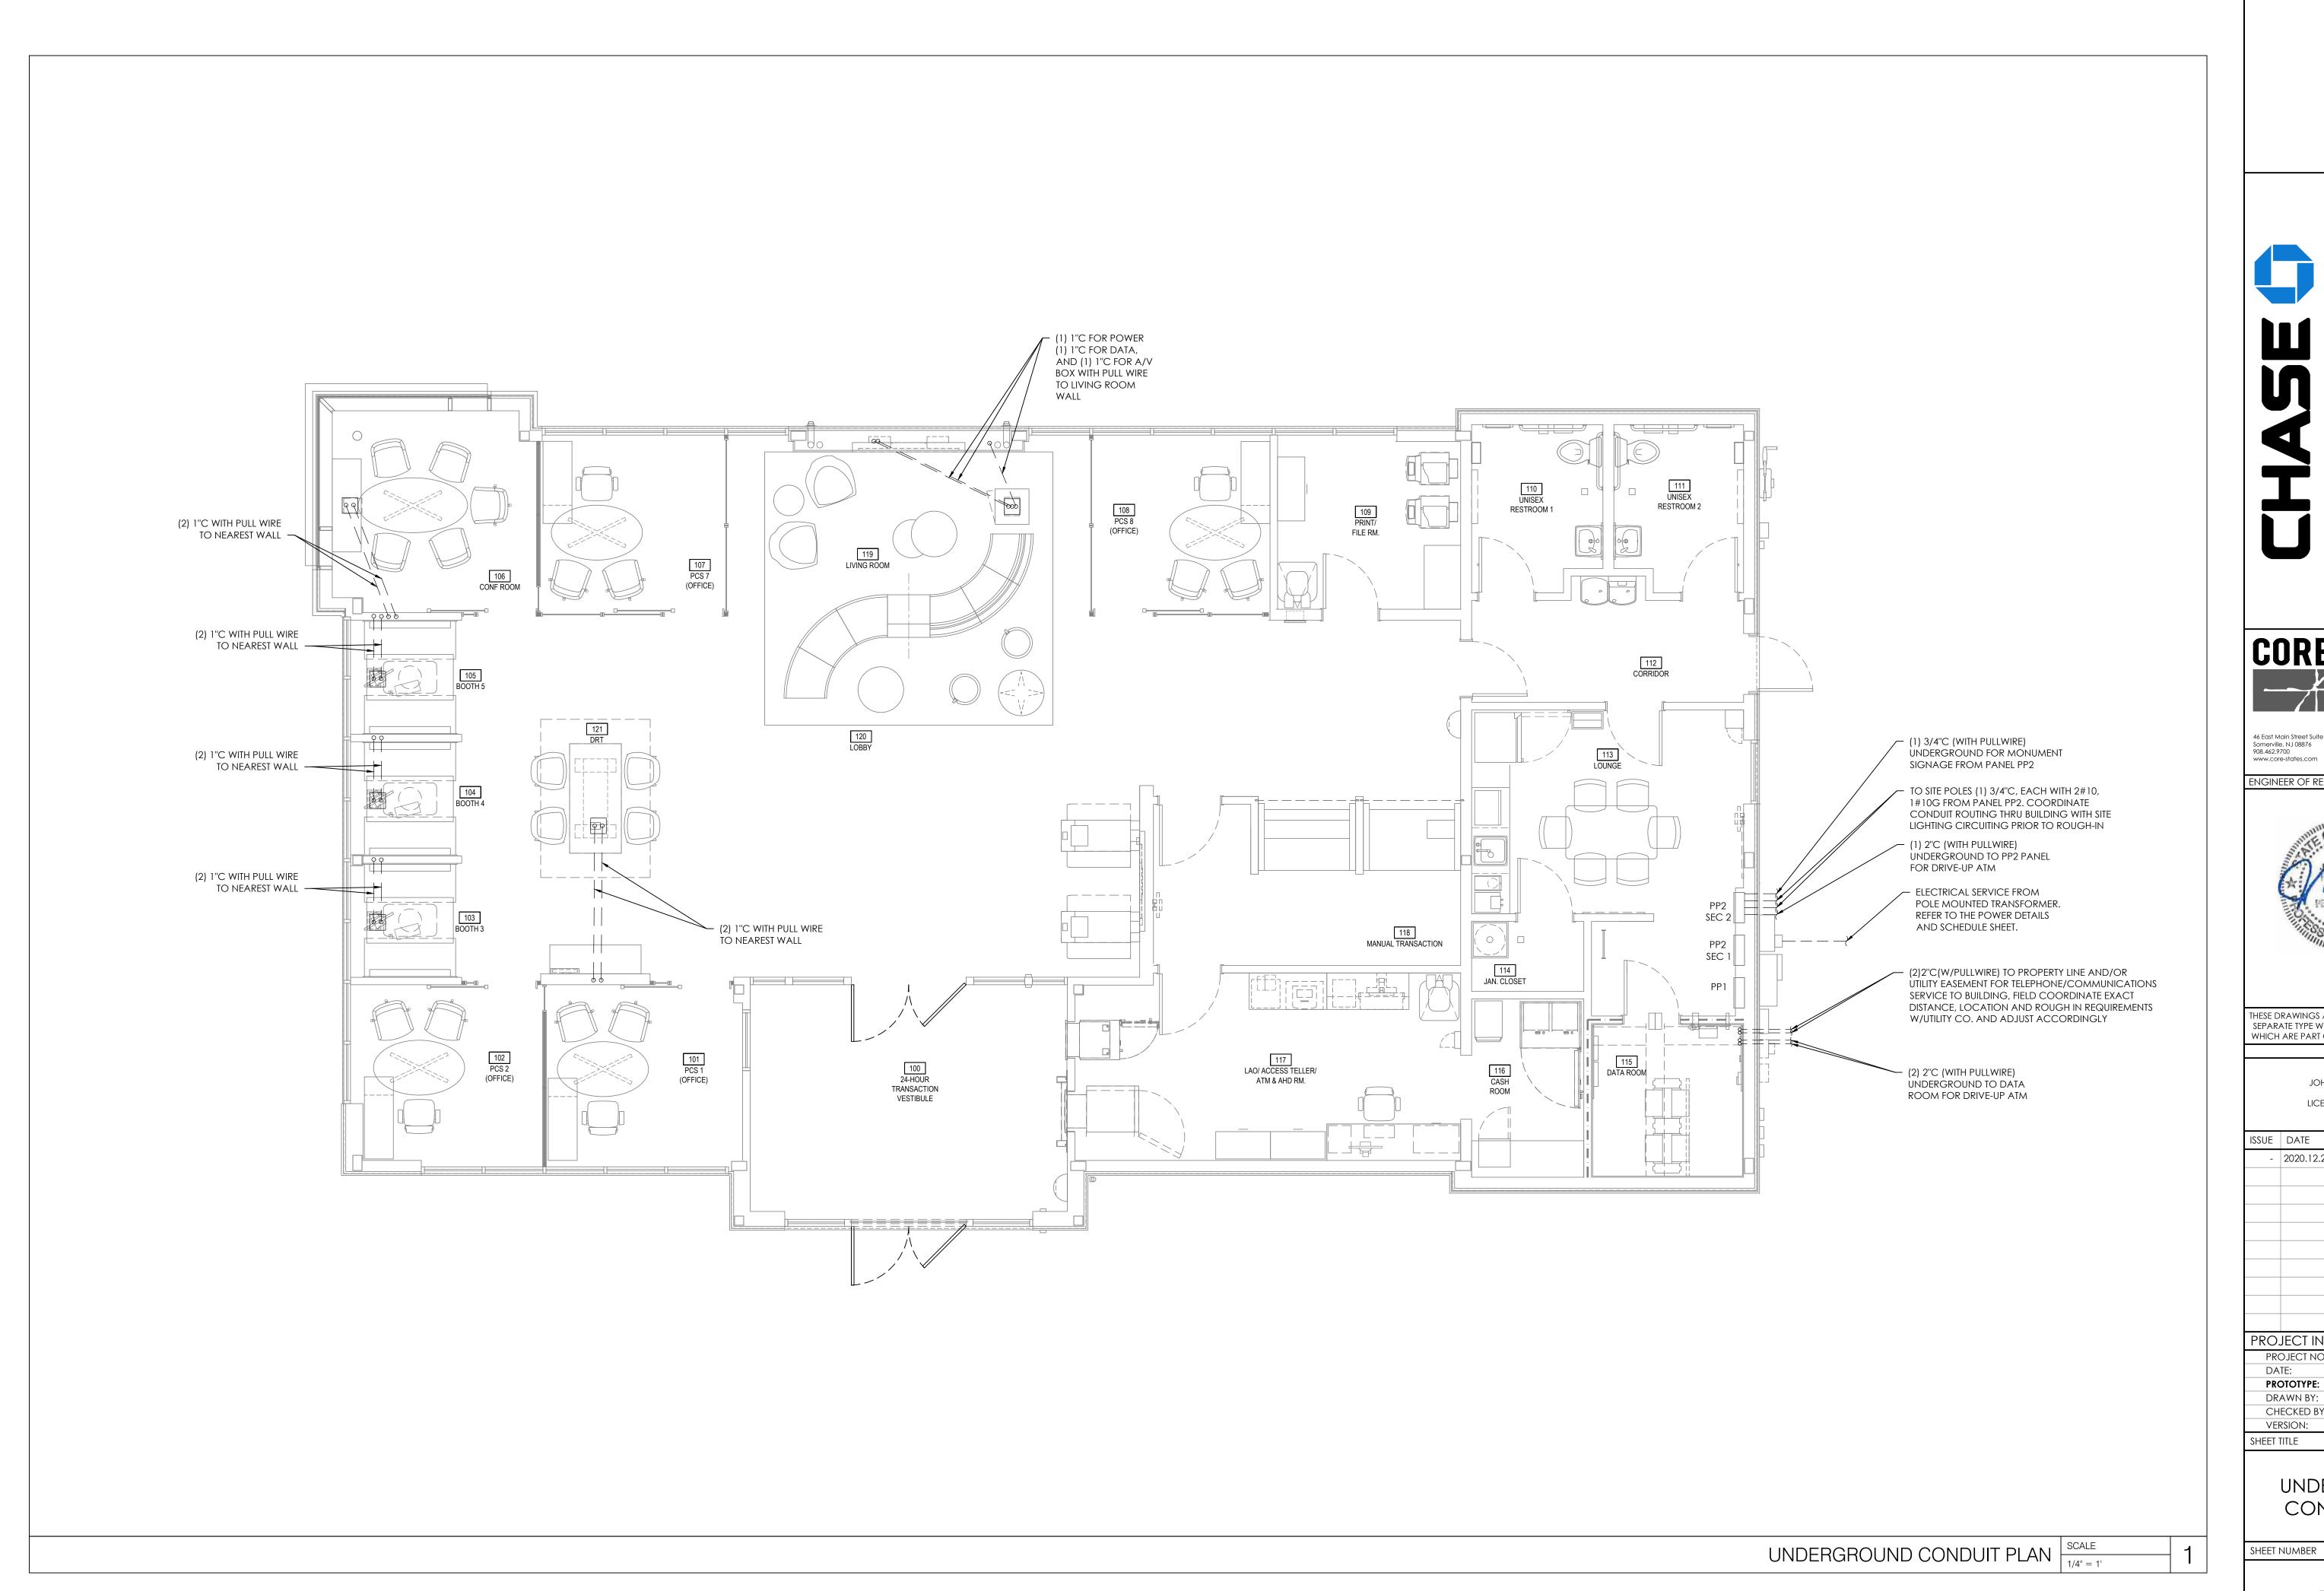

GROUP 46 East Main Street Suite 201 Somerville, NJ 08876 908.462.9700 www.core-states.com NGINEER OF RECORD 01/19/2021 THESE DRAWINGS ARE NOT COMPLETE WITHOUT THE SEPARATE TYPE WRITTEN SPECIFICATIONS MANUAL WHICH ARE PART OF THE CONTRACT DOCUMENTS. JOHN FERGUSON, P.E. MISSOURI LICENSE #: 2008014085 ISSUE DATE DESCRIPTION - 2020.12.21 PERMIT SET PROJECT INFORMATION PROJECT NO: JPM.27135.001 2020.12.21 PROTOTYPE: D. BORELL DRAWN BY: CHECKED BY: D. MULVANEY VERSION: SHEET TITLE UNDERGROUND CONDUIT PLAN


E5.0


	DATA ROOM D	DIAGRA	M KEY
E-1	ELEC PANEL: MAIN (NOT IN DATA ROOM)	D-1	DATA RACK / CABLE TRAY COMPONENTS
E-2	ELEC. PANEL: DISTRIBUTION (NOT IN DATA ROOM)	D-2	(2) 4" DATA CABLE FIRE RATED SLEEVES PROVIDED BY OWNER AND INSTALLED BY G.C. (2 LOCATIONS)
E-3	ELEC. PANEL: DISTRIBUTION (NOT IN DATA ROOM)		OWNER AND INSTALLED BY G.C. (2 LOCATIONS)
E-4	TELECOMM GROUND BUSBAR. MOUNT 6" BELOW BOTTOM OF LADDER RACK	TV-1	CATV EQUIPMENT: 24"W x 12"H
E-5	120V/20A ELEC. OUTLET- DUPLEX OR QUADRUPLEX AS SHOWN- RECESSED OR SURF. MTD.	1 V-1	CATV EQUIPMENT. 24 W X 12 H
E-6	(2) DEDICATED 208V/30A ELEC OUTLETS - TWIST-LOCK, NEMA L14-30	S-1	SECURITY EQUIPMENT: 48"W x 66"H
E-7	(2) DEDICATED 120V/20A ELEC OUTLETS - TWIST-LOCK, NEMA L5-20R	S-2	2" MUSIC SYSTEM AND BMS CABLING FIRE RATED SLEEVE PROVIDED BY OWNER AND INSTALLED BY G.C
E-8	2" CONDUITS FOR EXTERIOR ATM LOCATION W/ 2" 3-CELL MAXCELL INNERDUCT AND SWEEPING 90-DEGREE BENDS	S-3	4" SECURITY CABLE FIRE RATED SLEEVE PROVIDED BY OWNER AND INSTALLED BY G.C.
E-9	MANUAL TOGGLE LIGHT SWITCH		
E-10	DOOR CONTROL PANEL	M-1	FAN COIL UNIT AND CONDENSATE PUMP - PROVIDE DEDICATED SYSTEM THAT MEETS ROOM TEMPERATUR AND HUMIDITY REQUIREMENTS IN JPMC RETAIL STRUCTURED AND CABLING STANDARDS, APPENDIX B
T-1	TELECOM CARRIER #1: 36"W X 36"H	M-2	SECURITY MOTION SENSOR
	12-PORT FIBER ENCLOSURE FOR EXTENSION OF	M-3	MOOD MUSIC EQUIPMENT: 15"W X 24"H
T-2	CARRIER CONNECTIONS TO RACK. LABEL PORTS TO MATCH RACK MOUNTED FIBER PANEL.	M-4	SURFACE-MOUNT DATA NETWORK JACK
T-3	1" CONDUIT TO ROOF LOCATION FOR FUTURE ANTENNA	M-5	WALL BRACKET FOR REMOTE THERMOSTAT
1-3	CABLING.	M-6	DRAWING STORAGE TUBE
T-4	(2) 2" CONDUITS FOR TELECOM SERVICE W/ 2" 3-CELL MAXCELL INNERDUCT - COORD, LOCN, W/ UTILITY	M-7	STRUCTURED CABLING FLOOR PLAN: 48"W X 36"H
		M-8	TELEPHONE
T-5	12-PORT OUTPUT FOR COPPER EXTENSION OF CARRIER CONNECTIONS TO RACK.	M-9	FIRE EXTINGUISHER
	PROTECTIVE SURGE PROTECTION FOR EACH CAT6 AND CAT6A CABLES FOR POLE MOUNTED SECURITY	B-1	BMS EQUIPMENT: 15"W X 54"H
T-6	CAMERAS AND ATM ISLAND/CANOPY DEVICES. PROVIDE		

REFER TO CHASE TELECOMM DRAWINGS FOR ADDITIONAL INFORMATION REGARDING THE DATA ROOM AND ALL INSTALLATION REQUIREMENTS. REFER TO CHASE TELECOMM ELEVATIONS FOR ALL MOUNTING HEIGHTS AND FINAL LOCATIONS


ITW #CAT6-75 PROTECTION FOR EACH CAT 6 CABLE AND ITW #CAT6A-75 FOR EACH CAT6A CABLE. BOND TO GROUNDING BAR PER MANUFACTURER'S REQ'S

- THE ELECTRICAL/DATA ROOM MUST BE 100% COMPLETE AT A MINIMUM OF 45 DAYS PRIOR TO CONSTRUCTION COMPLETION/TURNOVER DATE.
- ELECTRCIAL CONTRACTOR TO COORDINATE ALL SECURITY EQUIPMENT LOCATIONS WITH
- SECURITY VENDOR AND CHASE.
- ALL CARRIER AND SECURITY CABLING MUST BE AFFIXED TO WALL AND/OR CONVEYANCE WITH HANGERS, VELCRO, AND TIES; NO HANGING CABLES.
- REFER TO JPMC RETAIL STRUCTURED CABLING STANDARDS FOR ADDL. INFO. COORDINATE FINAL EQUIPMENT LOCATIONS W/ THE TELECOMM DRAWINGS PREPARED BY THE ASSIGNED PROJECT GTI DESIGNER.

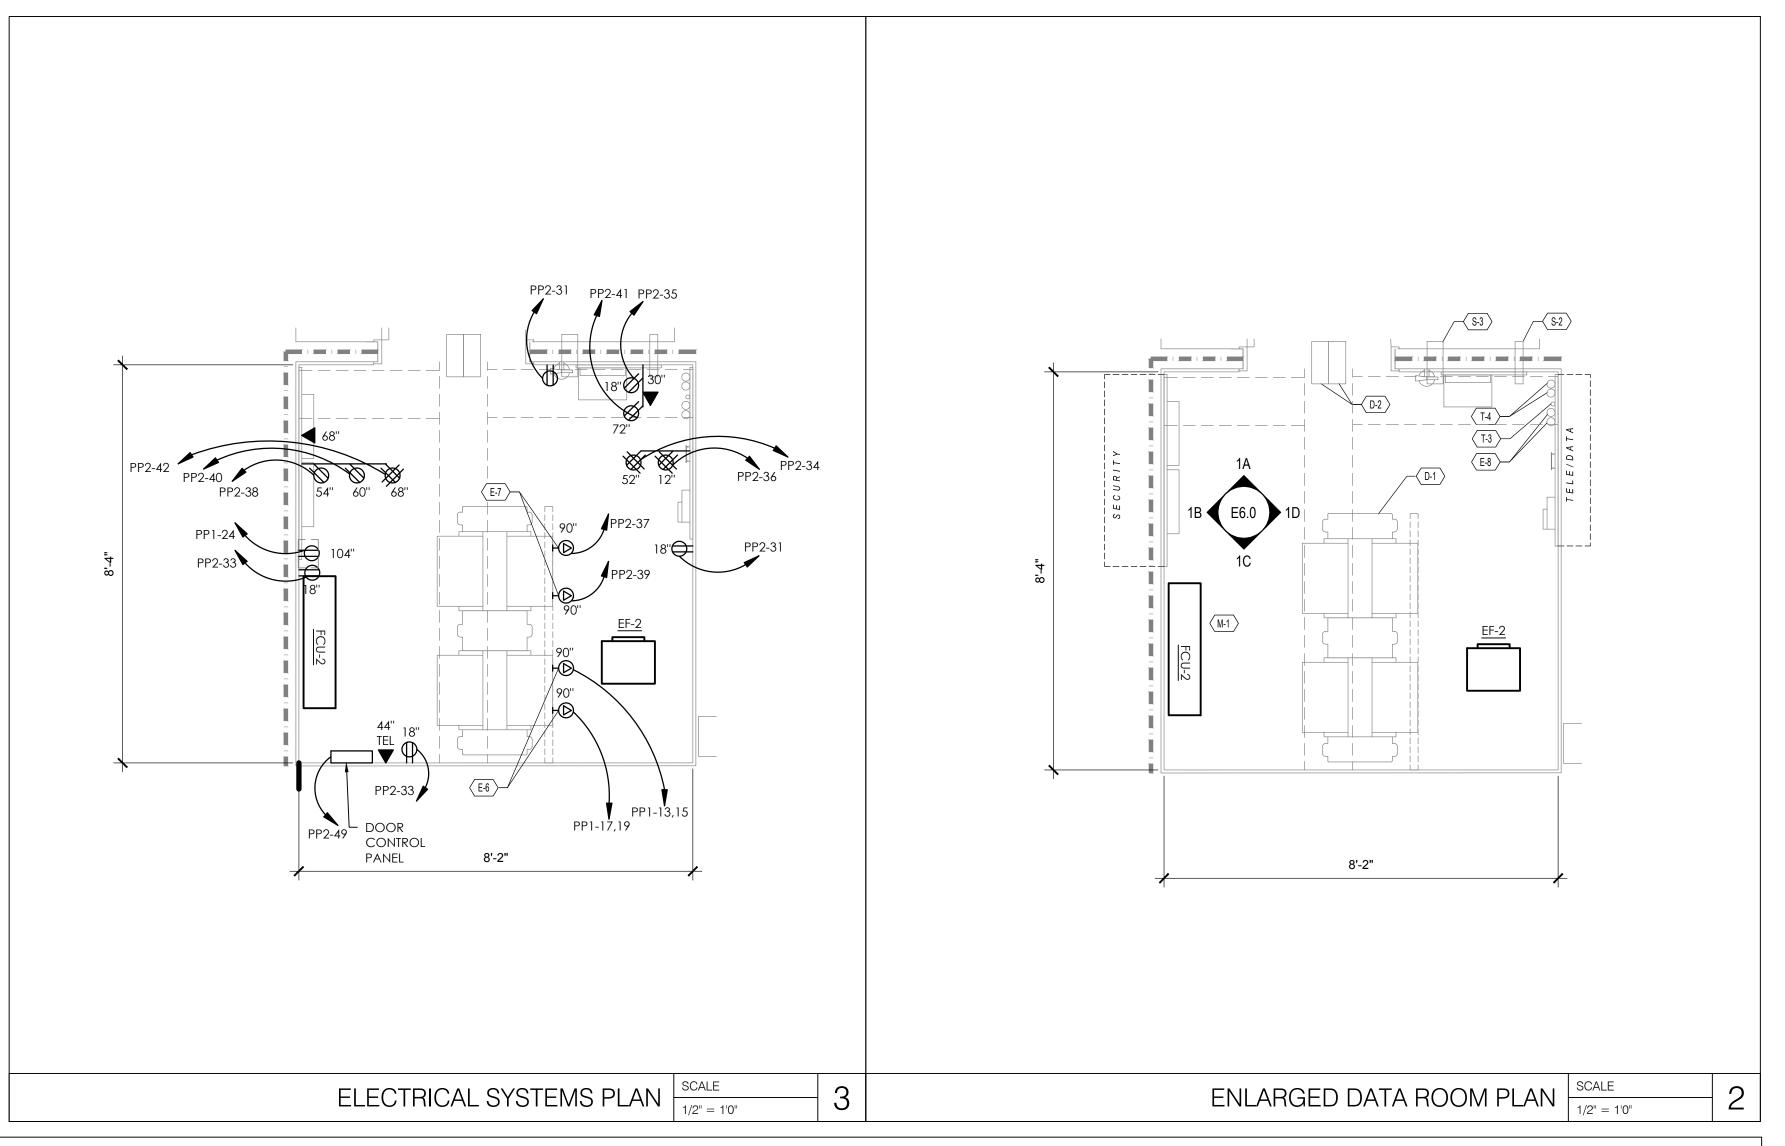

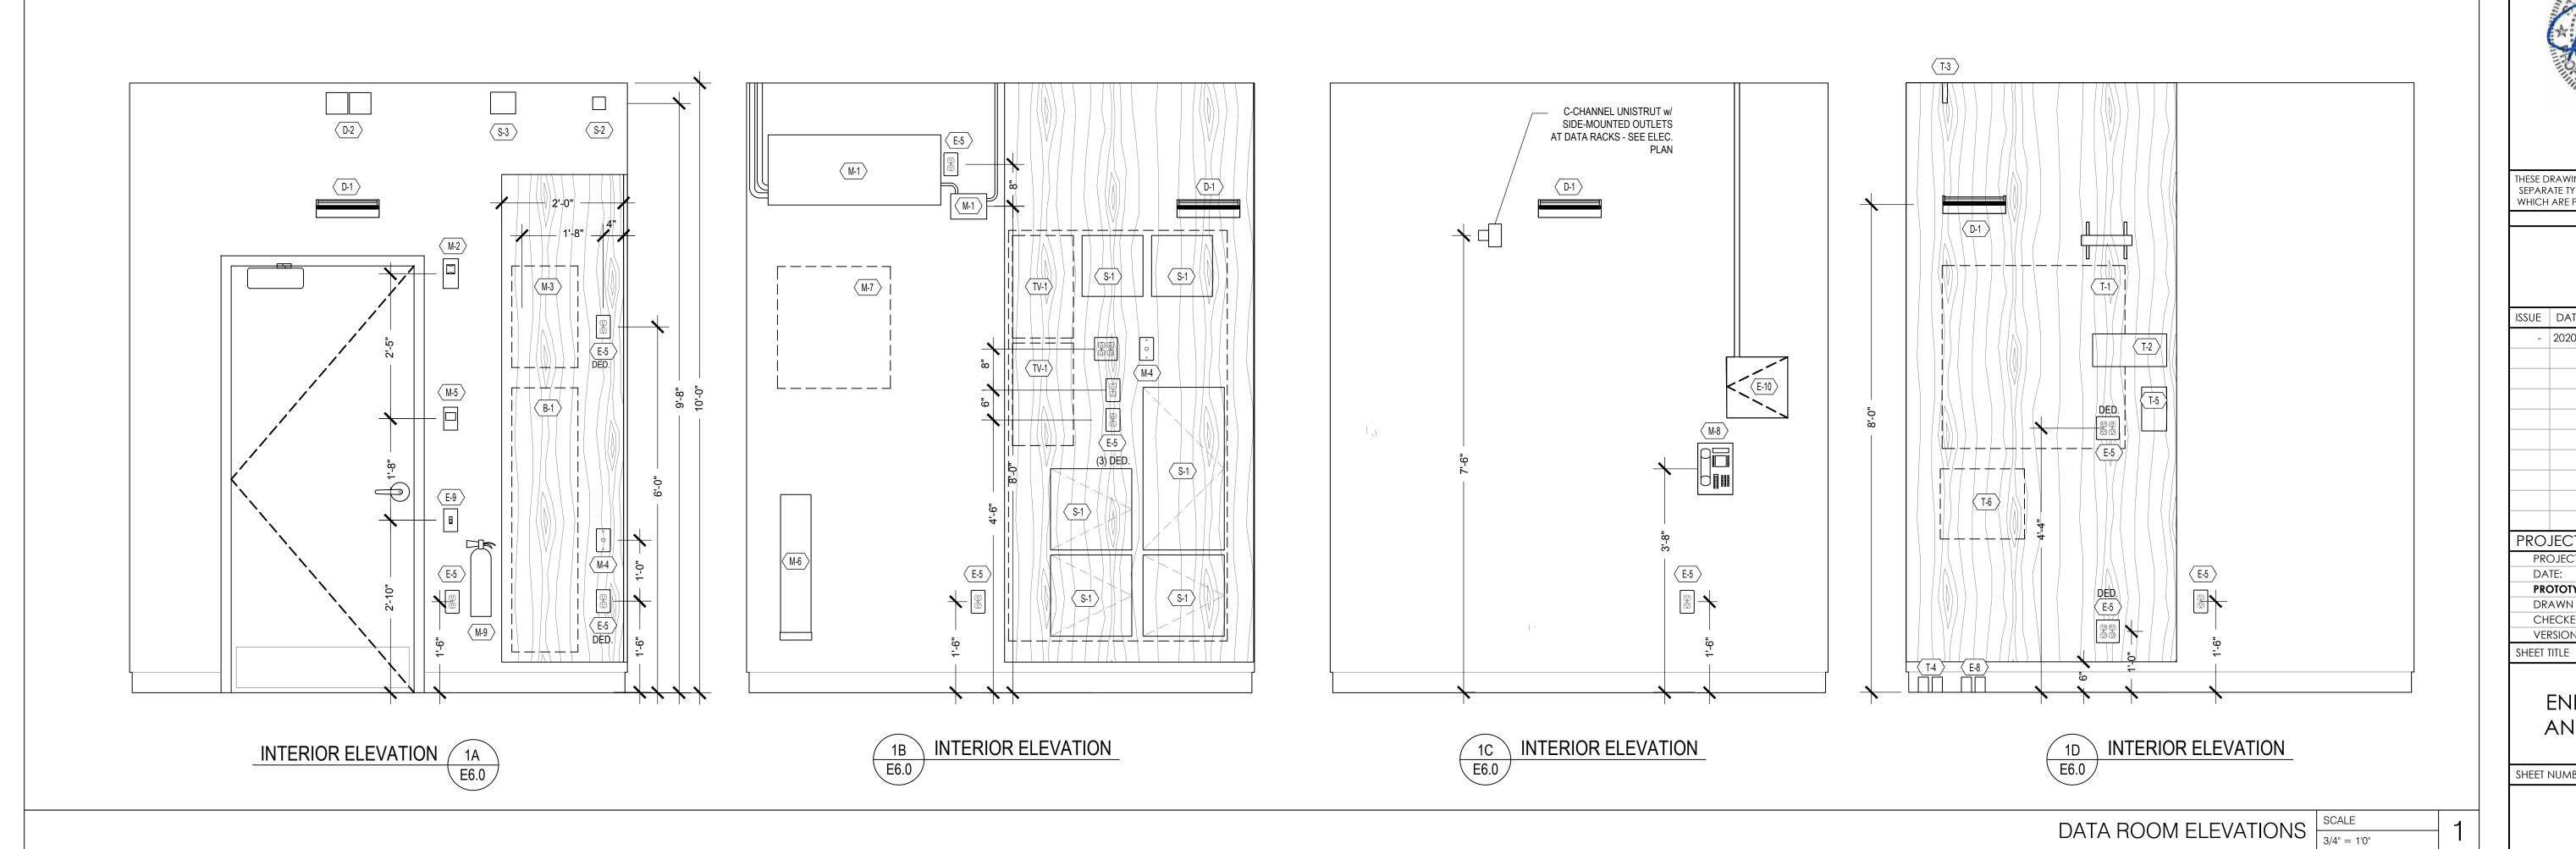



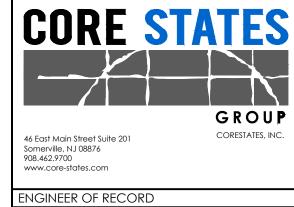



THESE DRAWINGS ARE NOT COMPLETE WITHOUT THE SEPARATE TYPE WRITTEN SPECIFICATIONS MANUAL WHICH ARE PART OF THE CONTRACT DOCUMENTS.

JOHN FERGUSON, P.E. MISSOURI LICENSE #: 2008014085

2020.12.21 PERMIT SET


DESCRIPTION

PROJECT INFORMATION PROJECT NO: JPM.27135.001 2020.12.2 PROTOTYPE: D. BORELL DRAWN BY: D. MULVANEY CHECKED BY: VERSION:

> ENLARGED PLAN AND ELEVATIONS

SHEET NUMBER


E6.0

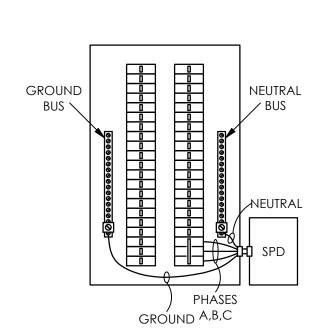

- CONNECT SPD TO BREAKER AS FOLLOWS:
 2P30 FOR 1 PHASE
- 3P30 FOR 3 PHASE


 2. RELOCATE BREAKER IN PANEL AS
 NECESSARY TO PROVIDE THE SHORTEST
 WIRE LENGTH TO SPD.
- 3. DIRECT CONNECTION TO BUS IS NOT PERMITTED.
- 4. USE A CHASE NIPPLE CONNECTION VIA KNOCKOUT.
- 5. USE #10 AWG OR LARGER CONDUCTORS.
- 6. LIMIT WIRE LENGTH TO 18" OR LESS.
- 7. KEEP WIRE FREE OF ANY SHARP BENDS.
- 8. SPD TO BE MODULAR, UL 1449 3RD EDITION LISTED,
- 9. 100 KA PER PHASE, 600V CLAMPING.

SPD PANELBOARD SCHEMATIC	SCALE	9
SPD PAINELDUARD SCHEINATIC	NTS	S

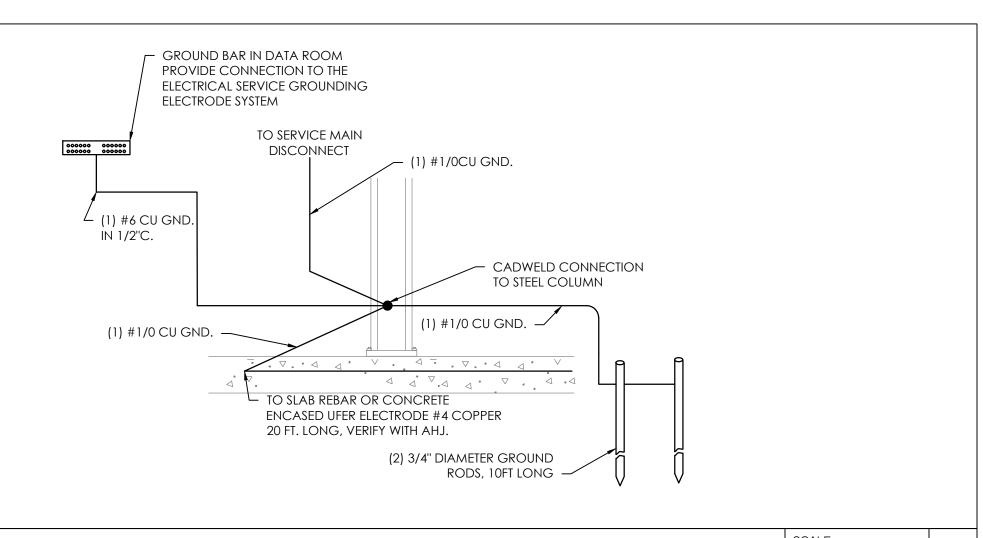

SERVICE GROUNDING SCALE NTS

DEDICATED ELECTRICAL SERVICE HAS NOT BEEN FINALIZED. ALL INFORMATION REGARDING ELECTRICAL SERVICE IS SUBJECT TO CHANGE PENDING COORDINATION WITH UTILITY COMPANY.

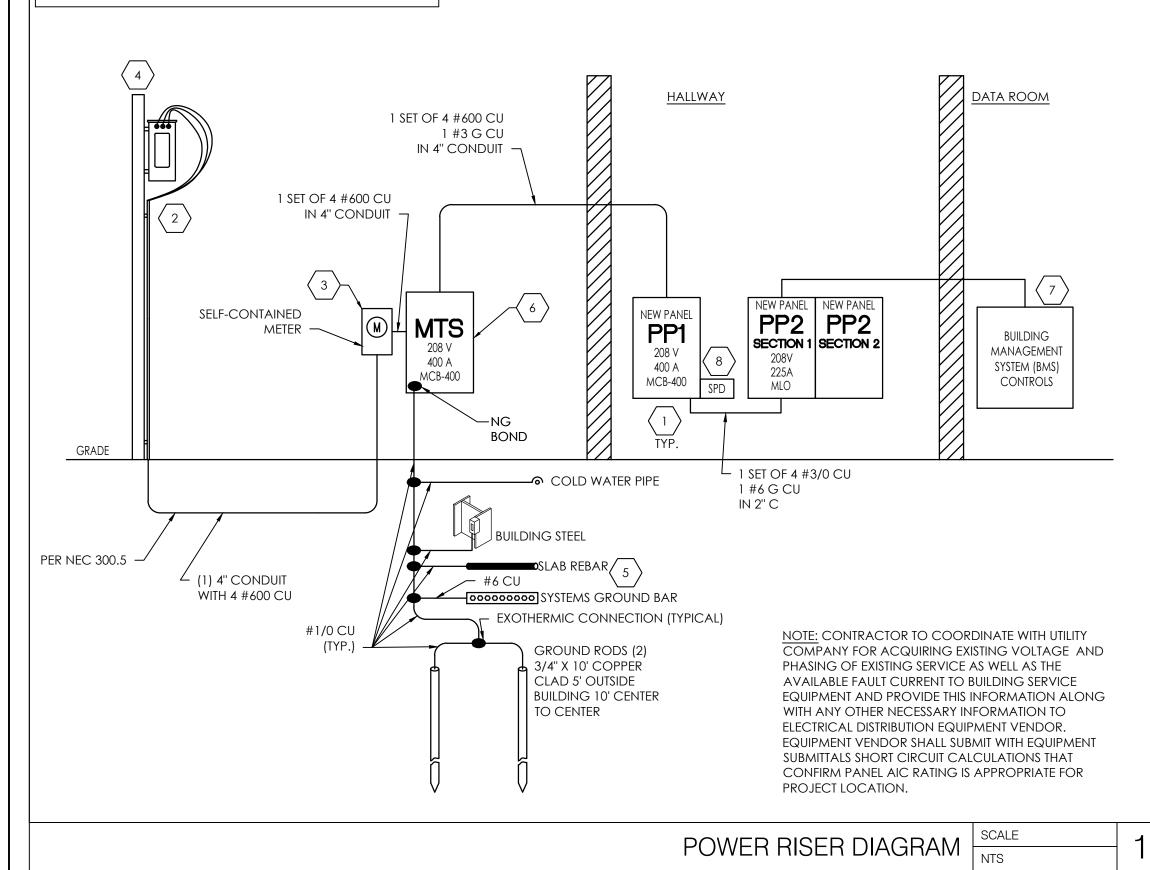

				PAN	ELE	ЗОА	RI	D:	PP	1 (1	NEW)				
MAII	S AMPS: 400A N SIZE/TYPE: 400A MCB TS/PHASE: 208Y/120V, 3PH, 4W RVES: CHASE BANK		FAI	ULT CUR						•		RAM		EQUIPMENT GROUND SUB FEED L	
LOC	CATION: LOUNGE				M	UNTI	NG:	RE	CESS	ED					
CK	DESCRIPTION		VA/PHASE	E	WIRE	BKR	Р	Р	BKR	WRE		VA/PHASI		DESCRIPTION	CKT
NO		Α	В	С	NO.	AMP			AMP	NO.	Α	В	С		NO.
1		5,764									3,603				2
3	RTU-1		5,764		6	60	3	3	40	8		3,603		RTU-2	4
5				5,764									3,603		6
7		1,441						2	30	10	2,496			FCU-1	8
9	DAINTREE POWERSCOUT METER		1,441		12	15	3					2,496			10
11				1,441				2	30	10			1,768	CU-1	12
13		360			10	30	2				1,768				14
15			360					2	20	12		1,560		CU-2 & FCU-2	16
17	DATA RACK#1 TWISTLOCK			360	10	30	2						1,560		18
19		360						1	20	12	100			EF-1	20
21	EWH		1,500		12	20	2	1	20	12		200		DUCT SMOKE DETECTORS	
23				1,500				1	20	12			400	CONDENSATE PUMPS	24
25		360			12	20	1	1	20	12	200			EF-2	
27	SPARE					20	1	1	20	12		180		EWH RECIRCULATION PUMP	28
29						20	1	1	20					SPARE	30
31	SPACE						1	1						SPACE	32
33							1	1						SPACE	
35							1	1						SPACE	36
37	SPACE						1	Г							38
39							1	3	30	10				SPD	40
41	SPACE						1								42
		12,410													
	PANEL PP2		14,172		3/0	200	3								
				12,220											
	SUBTOTAL	20,695	23,237	21,285]						8,167	8,039	7,331	SUBTOTAL	
	TOTAL PHASE A - VA 28,862	LOAD		CONN. V	/A	DF		LO	AD		(ONN. VA	DF		一
	AMPS 241	COOLIN	G	39,749		1.00	1	RE	FRIG	RATIO	ON		1.00		
	TOTAL PHASE B - VA 31,276	HEATING	G	4,992		0	1	SIC	3N/DIS	SPLAY		8,400	1.25		
	AMPS 261	LIGHTIN	IG	3,922		1.25		KIT	CHE	V			1.00		
	TOTAL PHASE C - VA 28,616	RECEPT	FACLES	24,560		1.0/.5		EX	ISTIN	3			1.00		. 1
	AMPS 238	MOTORS	S	2,500		1.00]	LA	RGE N	NOTOF	}		1.25	TOTAL DEMAND]
	TOTAL PNLBD - VA 88,754	SUPP H				1.00		SH	OWV	MNDO	W		1.25	84,555 VA]
	AMPS 246	MISC EC	UIP	9,623		1.00		LT	G TRA	CK			1.00	235 A	

"S" - INDICATES SUB-FEED CIRCUIT BREAKER

											NEW)			
	AMPS: 225A			FA	ULT CUR	RENT	REFE	RTC	POWE	RRIS	ER DIAG	RAM		EQUIPMENT GROUND
	I SIZE/TYPE: MLO FS/PHASE: 208Y/120V, 3PH, 4W													FEED THRU L
	VES: CHASE BANK													
CKT	CCATION: LOUNGE MOUNTING: RECESSED KT DESCRIPTION VAPHASE WRE BKR P P BKR WRE VAPHASE DESCRIPTION										DESCRIPTION			
NO.	DESCRIPTION		Α	B	С	NO.	AMP	-	AMP		A	B	С	DESCRIPTION
1	MOTORIZED SHADES		1,000			12	20	1	1 20	12	540			BOOTH RECEPS
3	JAN CLOSET RECEPS			360		12	20	1	1 20	12		540		PCS 101 RECEPS
5	WATER COOLER/DRINKING FOUNT	TAIN			720	12	20	1	1 20	12			540	PCS 102 RECEPS
7	RESTROOMRECEPS		720			12	20	1	1 20	12	720			CONF 106 RECEPS
9	PRINT/FILE RM RECEPS			540		12	20	1	1 20	12		540		PCS 107 RECEPS
11	LAO/ATM RM RECEPS				540	12	20	1	1 20	12			540	PCS 108 RECEPS
13	LOUNGE CONVENIENCE RECEPS		720			12	20	1	1 20	12	720			TELLER LINE RECEPS
15	MICROWAVE			1,000		12	20	1	1 20	12		720		TELLER LINE RECEPS
17	WTR MACH. & COFFEE MAKER				1,440	12	20	1	1 20	12			720	ACCESS TELLER
19	REFRIGERATOR		700			12	20	1	1 20	12	180			CASH RECYCLER
21	TELEPRESENCE EQUIPMENT			540		12	20	1	1 20	12		1,200		MOTORIZED SCRIM
$ \longrightarrow $	LIMNG ROOM MONITOR	\			540	12	20	1	1 20	12			600	LOBBY ATM#1
25	SPARE	\		\ \ \ \ \ \ \ \ \ \ \ \ \ \ \ \ \ \ \			20	1	1 20					SPARE
27	COMMUNITY WALL MONITOR			360		12	20	1	1 20	12		600		24-HOUR ATN
29	CONVENIENCE RECEPS		000		900	12	20	1	1 20	12			600	24-HOUR AHD
31	DATA ROOM RECEP		360	200		12	20	1	1 20	12	360			DRT FLOOR BOX
33	DATAROOMRECEP			360	200	12	20	1	1 20	12		360		DATA RM. TELEPHONE RECEP
35	DATA RM. BMS RECEP		700		360	12	20	1	1 20	12	000		360	DATA RM. TELEPHONE RECEP
37	DATA RACK #2 TWISTLOCK DATA RACK #2 TWISTLOCK		720	720	100000000000000000000000000000000000000	12	20	1	1 20	12	360	200	***************************************	DATA RM. SECURITY RECEP
39				120	200	12	20	1	1 20	12		360	000	DATA RM. SECURITY RECEP
41	MOOD MUSIC PLAYER				360	12	20	1	1 20	12			360	DATA RM. SECURITY RECEP
	TION: 2		1 5 2 8			10	20 [41	4 20	10	1 200			DI III DING SIGNACE
	LOBBY/VESTIBULE LTG EMPLOYEE ONLY LTG		1,528	1,533	\sim	142	20		1 20	12	1,200	1 200		BUILDING SIGNAGE
45	OCTAGON SIGNAGE	<u> </u>		1,555	1,200	12	20	#	1 20	12		1,200	1 200	BUILDING SIGNAGE
47	DOOR CONTROL PANEL		200		1,200	12	20	+	1 20	12	1 200		1,200	BUILDING SIGNAGE BUILDING SIGNAGE
51	DOOR CONTACTORS		200	200		12	20	1	1 20	10	1,200	600		DRIVE-THRU ATM#1
	CASH RM RECEPS		000000500000	200	540	12	-	1	_	10		000	200	DRIVE-THRU ATM TOPPER #1
	SITE, DRIVE-THRU LTG		822		HILLIANING	10	20	_	1 20	10			200	SPARE
	MONUMENT SIGNAGE		022	1,200		10	20	-	1 20	_				SPARE
	SPARE		100000	1,200	100000000000000	10	20	1	1 20	12			500	IRRIGATION CONTROLLER
61	EXTERIOR RECEPS		360			12	20	1	1 20	12	000000000000000000000000000000000000000		300	SPARE
63	SPARE					16	20	1	1 20	12		1,200		DRIVE-THRU ATM SIGNAGE
65	SPARE					_	20	1	1 20			1,200		SPARE
67	SPARE		-				20	1	1 20					SPARE
69	SPARE						20	1	1 20					SPARE
71	SPARE						20	1	1 20					SPARE
73	SPARE			00003000			20	1	1 20					SPARE
75	SPARE						20	1	1 20					SPARE
77	SPARE						20	1	1 20					SPARE
79	SPARE						20	1	1 20					SPARE
81	SPARE						20	1	1 20					SPARE
83	SPARE						20	1	1 20					SPARE
=	SUBTOTAL		7,130	6,813	6,600	1					5,280	7,320	5,620	SUBTOTAL
	TOTAL PHASE A - VA	12,410	LOAD		CONN.	VA	DF	L	.OAD			CONN. VA	DF	
	AMPS	103	COOLIN	G			1.00	F	REFRIG	ERATI	ON		1.00	
	TOTAL PHASE B - VA	14,133	HEATING	3			0	5	SIGN/DIS	SPLAY	1	8,400	1.25	
	AMPS	118	LIGHTIN		3,883	3	1.25	k	STCHE	4			1.00	[1]- A A A A A A A
	TOTAL PHASE C - VA	12,220	RECEPT		22,580)	1.0/.5		XISTING				1.00	
	AMPS	102	MOTORS		2,200)	1.00	L	ARGE N	MOTOR	₹		1.25	TOTAL DEMAND
		38,763	SUPP H				1.00	_	SHOWV		W		1.25	35,544 VA
_	AMPS	108	MISC EC	ALIID	1,700		1.00		TG TRA		1		1.00	99 A

ELECTRICAL GENERAL NOTES:

130.5(c) VOLTAGE DROP: THE MAXIMUM COMBINED VOLTAGE DROP ON BOTH INSTALLED FEEDER CONDUCTORS AND BRANCH CIRCUIT CONDUCTORS TO THE FARTHEST CONNECTED LOAD OR OUTLET SHALL NOT EXCEED 5 PERCENT.

ELECTRICAL KEYNOTES:

- 1. AS PER NEC 408.4, PROVIDE REQUIRED FIELD IDENTIFICATION. ALL SWITCHBOARDS, SWITCHGEAR, AND PANELBOARDS SHALL BE PERMANENTLY MARKED TO INDICATE EACH DEVICE OR EQUIPMENT WHERE THE POWER ORIGINATES. THE LABEL SHALL BE PERMANENTLY AFFIXED, OF SUFFICIENT DURABILITY TO WITHSTAND THE ENVIRONMENT INVOLVED, AND NOT HANDWRITTEN.
- 2. ELECTRICAL CONTRACTOR SHALL INCLUDE THE COST OF SECONDARY CONDUITS AND SECONDARY CABLING IN BASE BID. THE OWNER IS RESPONSIBLE FOR THE COST OF POWER COMPANY ELECTRICAL TRANSFORMER, POLE RISER, CABLES, AND ANY ASSOCIATED UPGRADES/MODIFICATIONS.
- 3. SELF-CONTAINED METER SOCKET W/ CT'S, 400 AMP, 120/208 VOLT, 3 PHASE, 4 WIRE, NEMA 3R. COORDINATE REQUIREMENTS WITH LOCAL UTILITY. INCLUDE ALL COSTS IN BASE BID.
- 4. COORDINATION WITH THE ELECTRICAL UTILITY COMPANY IS ONGOING. THE BASIS OF DESIGN IS A NEW TRANSFORMER WILL BE POLE MOUNTED ON A NEW UTILITY POLE. THE PROPOSED SERVICE FOR CHASE IS 400A AT 208/120V, 3-PHASE, 4-WIRE. UTILITY COMPANY WILL PROVIDE TRANSFORMER, POLE RISER, PRIMARY CABLING AND CONDUITS. COORDINATE WITH UTILITY COMPANY FOR EXACT TRANSFORMER SIZE AND RATING, ROUTING AND STUB-UP LOCATION. STAKE CONDUIT END LOCATION FOR UTILITY COMPANY.
- 5. SEE SERVICE GROUNDING DETAIL ON THIS SHEET.
- PROVIDE NEMA 3R, MANUAL TRANSFER SWITCH WITH LOCKING GENERATOR CONNECTION ENCLOSURE, AND INTEGRAL CABLE CAM-LOCK CONNECTION BAY. ELS STORM SWITCH #SSD4-400C-400C-208-311-S-S-X304089VSCH. SWITCH SHALL BE PROVIDED WITH INTEGRAL 400A CIRCUIT BREAKERS FOR UTILITY AND GENERATOR INPUTS RATED PER UTILITY. SUSE RATED. UL 1008 LISTED. BOND SERVICE N-G WITHIN ENCLOSURE. MOUNT ON H-FRAME SUPPORT STRUCTURE. REFER TO ELECTRICAL SITE PLAN FOR PROPOSED LOCATION. INCLUDE ALL COSTS IN BASE BID. ONCE PERMANENT POWER IS CONNECTED, BUT PRIOR TO TURN OVER TO OWNER, GC SHALL COORDINATE WITH CHASE FACILITIES TO TEST FUNCTIONALITY OF MANUAL TRANSFER SWITCH. GC SHALL PROVIDE A GENERATOR TO PERFORM THIS TEST.
- 7. REFER TO DAINTREE CONTROL RISER DIAGRAM ON BUILDING MANAGEMENT SYSTEM DETAILS FOR ADDITIONAL INFORMATION REGARDING THE DAINTREE WIRELESS CONTROL SYSTEM.
- 8. SEE SPD PANELBOARD SCHEMATIC DETAIL ON THIS SHEET.

TENANT OCCUPANCY TY	PE: B	3	SERVIC	E DESCRIF	PTION:
TENANT SQUARE FOOTA	20	8Y/120V, 3F	H		
LOAD DESCRIPTION			Connected	Demand	Demand
			KVA	FACTOR	KVA
HVAC - SUMMER			39.75	100%	39.75
HVAC - WINTER			4.99	100%	0.00
LIGHTING (PER NEC-220)			2.87	125%	3.59
RECEPTACLES			24.56	100%;50%	17.28
MOTOR LOADS			2.50	100%	2.50
LARGEST MOTOR LOAD			0.00	125%	0.00
MISCELLANEOUS EQUIPM	MENT		9.62	100%	9.62
DISPLAY CASE/SIGNAGE			8.40	125%	10.50
EXTERIOR LIGHTING			1.05	125%	1.32
TOTAL LOAD			93.75	KVA	84.5
TOTAL AMPACITY			260.21	AMPS	234.70
SERVICE AMPACITY			400	AMPS	400.00
SPARE CAPACITY				AMPS	165





Somerville, NJ 08876 908.462.9700 www.core-states.com

NGINEER OF RECORD

OF MISSO

([[]])

THESE DRAWINGS ARE NOT COMPLETE WITHOUT THE SEPARATE TYPE WRITTEN SPECIFICATIONS MANUAL WHICH ARE PART OF THE CONTRACT DOCUMENTS.

JOHN FERGUSON, P.E. MISSOURI LICENSE #: 2008014085

ISSUE DATE DESCRIPTION

- 2020.12.21 PERMIT SET

1 2021.04.20 STRUCTURAL STEEL REV

2 2021.06.03 PLAN REVIEW COMMENTS, RDC21 & WIRELESS UPDATE

PROJECT INFORMATION
PROJECT NO: JPM
DATE:

PROJECT NO: JPM.27135.001

DATE: 2020.12.21

PROTOTYPE: 20.2

DRAWN BY: D. BORELLI

CHECKED BY: D. MULVANEY

VERSION: SE_1.00

POWER DETAILS AND SCHEDULES

SHEET NUMBER

E7.0

SYMBOLS LIST

		WIDOLO LIOT		
SYMBOL	DESCRIPTION	BACKBOX REQUIREMENTS (BY EC)	CONDUIT REQUIREMENTS (BY EC)	MOUNTING HEIGHT (UNLESS NOTED OTHERWISE)
× V	DATA OUTLET LOCATION, WALL MOUNTED. PROVIDE (X) CAT 6 RJ-45 JACKS, (X) HORIZONTAL CAT 6 CABLES, & A 4-PORT WHITE FACEPLATE. PROVIDE BLANKS FOR UNOCCUPIED PORTS. "X" DENOTES NUMBER OF JACKS /CABLES. WHEN NO NUMBER IS PRESENT IT SHALL BE ONE CAT 6 JACK/CABLE.	5" SQUARE, BY 2-7/8" DEEP BACKBOX WITH A SINGLE GANG REDUCER. PROVIDE RANDL INDUSTRIES T-55017 WITH D-51 SERIES REDUCER OR EQUAL. REDUCER TO MATCH DRY WALL THICKNESS.	MINIMUM OF ONE 1" CONDUIT TO ABOVE THE ACCESSIBLE CEILING.	TYPICAL - 18" AFF, SEE ARCHITECTURAL PLANS FOR EXACT HEIGHT
X V	DATA OUTLET LOCATION, FLOOR MOUNTED. PROVIDE (X) CAT 6 RJ-45 JACKS, (X) HORIZONTAL CAT 6 CABLES, & A 4-PORT FACEPLATE OR INSERT TO FIT FLOOR BOX. PROVIDE BLANKS FOR UNOCCUPIED PORTS. "X" DENOTES NUMBER OF JACKS/CABLES. WHEN NO NUMBER IS PRESENT IT SHALL BE ONE CAT 6 JACK/CABLE.	DUAL SERVICE POWER AND LOW VOLTAGE RECESSED BOX.	MINIMUM OF ONE 1" CONDUIT TO ABOVE THE ACCESSIBLE CEILING. REFER TO CABLE FILL CHART.	FLOOR
X	DATA OUTLET LOCATION, TABLE-TOP MOUNTED. PROVIDE (X) CAT 6 RJ-45 JACKS, (X) HORIZONTAL CAT 6 CABLES, & INSERT TO FIT TABLE-TOP BOX. PROVIDE BLANKS FOR UNOCCUPIED PORTS. "X" DENOTES NUMBER OF JACKS/CABLES.	NOT APPLICABLE - FED FROM FLOOR JUNCTION BOX.	CONCEAL CABLING FROM FLOOR JUNCTION BOX WITHIN WIRE MESH.	TABLE TOP
₩	WALL MOUNTED TELEPHONE OUTLET LOCATION. WALL MOUNTED, 1-PORT OUTLET. PROVIDE (1) CAT 6 RJ-45 JACK, (1) HORIZONTAL CAT 6 CABLE, AND A 4-PORT FACEPLATE FOR MOUNTING A TELEPHONE.	5" SQUARE, BY 2-7/8" DEEP BACKBOX WITH A SINGLE GANG REDUCER. PROVIDE RANDL INDUSTRIES T-55017 WITH D-51 SERIES REDUCER OR EQUAL.	ONE 1" CONDUIT TO ABOVE THE ACCESSIBLE CEILING.	TYPICAL 44" AFF WITH A CLEARANCE ON ALL SIDE OF FACEPLATE, SEE ARCHITECTURAL PLANS FOR EXACT HEIGHT
TPC ▼	TELEPRESENCE DATA OUTLET LOCATION, WALL MOUNTED. PROVIDE (1) CAT 6 RJ-45 JACK, (1) CAT6A, SHIELDED JACK, (2) 3.5mm OUTLETS, (1) HORIZONTAL CAT 6, UTP CABLE, (1) HORIZONTAL CAT 6A F/UTP CABLE, (2) 22 / 2 SHIELDED CABLES & A WHITE AV FACEPLATE. OUTLETS SHALL BE ANGLED. REFER TO FACEPLATE DETAIL FOR ADDITIONAL INFORMATION.	SINGLE GANG 3" X 2" X 2-3/4" BACK BOX	ONE 1" CONDUIT TO AV BACK BOX.	COORDINATE WITH AV DRAWINGS
VM-AV	VIDEO MONITOR OUTLET LOCATION, WALL MOUNTED. PROVIDE (1) CAT6A SHIELDED JACK, (1) F/UTP HORIZONTAL CAT 6A CABLE, & 1 MULTIMEDIA STYLE FACEPLATE WITH 2 PORT ANGLED BEZEL. PROVIDE BLANKS FOR UNOCCUPIED PORTS. REFER TO DETAIL ON TC-302.	SINGLE GANG 3" X 2" X 2-3/4" BACK BOX	ONE 1" CONDUIT TO ABOVE THE ACCESSIBLE CEILING.	COORDINATE WITH AV DRAWINGS
ATM ▼	ATM DATA OUTLET LOCATION, WALL MOUNTED. PROVIDE (1) CAT6 & (1) CAT6A RJ-45 JACKS, (1) HORIZONTAL CAT6 CABLE, (1) HORIZONTAL CAT6A CABLE, & A 4-PORT WHITE FACEPLATE. PROVIDE BLANKS FOR UNOCCUPIED PORTS. REFER TO DETAIL ON TC-302.	5" SQUARE, BY 2-7/8" DEEP BACKBOX WITH A SINGLE GANG REDUCER. PROVIDE RANDL INDUSTRIES T-55017 WITH D-51 SERIES REDUCER OR EQUAL.	ONE 1" CONDUIT TO ABOVE THE ACCESSIBLE CEILING.	CONCEALED BEHIND ATI COORDINATE WITH ATI DESIGN
WAP WAP	WIRELESS ACCESS POINT OUTLET LOCATION. CEILING MOUNTED. PROVIDE (1) HORIZONTAL CAT 6A CABLE & A PLENUM RATED IN-CEILING CONNECTOR ASSEMBLY.	HARD CEILING LOCATIONS ONLY: 5" SQUARE, BY 2-7/8" DEEP BACKBOX WITH A SINGLE GANG REDUCER. PROVIDE RANDL INDUSTRIES T-55017 WITH D-51 SERIES REDUCER OR EQUAL. SPECIALTY, OR OPEN-TO-STRUCTURE CEILING: SEE INSTALLATION DETAILS	HARD CEILING LOCATIONS ONLY: ONE 1" CONDUIT TO ABOVE THE NEAREST ACCESSIBLE CEILING.	CEILING
CAM	SECURITY CAMERA LOCATION. CEILING MOUNTED. PROVIDE (1) HORIZONTAL CAT 6A CABLE, & A PLENUM RATED IN-CEILING CONNECTOR ASSEMBLY COILED ABOVE THE CEILING FOR THE SECURITY CONTRACTOR TO ACCESS AND CONNECT TO THE CAMERA.	HARD CEILING LOCATIONS ONLY: 5" SQUARE, BY 2-7/8" DEEP BACKBOX WITH A SINGLE GANG REDUCER. PROVIDE RANDL INDUSTRIES T-55017 WITH D-51 SERIES REDUCER OR EQUAL.	HARD CEILING LOCATIONS ONLY: ONE 1" CONDUIT TO ABOVE THE NEAREST ACCESSIBLE CEILING.	ABOVE ACCESSIBLE CEILING
CAM ▼	SECURITY CAMERA LOCATION. WALL MOUNTED. PROVIDE (1) HORIZONTAL CAT 6A CABLE & A PLENUM RATED IN-CEILING CONNECTOR ASSEMBLY COILED ABOVE THE CEILING FOR THE SECURITY CONTRACTOR TO ACCESS AND CONNECT TO THE CAMERA.	NONE REQUIRED.	NONE REQUIRED.	SEE SECURITY PLANS FO MOUNTING HEIGHTS
	FIRE-RATED WALL SLEEVE FOR HORIZONTAL CABLING. PROVIDE SIZE AS INDICATED ON THE PLANS.	NOT APPLICABLE	NOT APPLICABLE	AT LEAST 6" ABOVE FINISHED ACCESSIBLE CEILING OF SURROUNDII SPACE
	WALL SLEEVE FOR HORIZONTAL CABLING TO CONNECT TWO ACCESSIBLE CEILINGS SEPARATED AN INACCESSIBLE CEILING. PROVIDE SIZE AS INDICATED ON THE PLANS.	NOT APPLICABLE	NOT APPLICABLE	AT LEAST 6" ABOVE FINISHED ACCESSIBLE CEILING OF SURROUNDI SPACE
	LADDER RACK/CABLE RUNWAY INSTALLED WITHIN THE RMER AND/OR RTR. FINISH SHALL BE WHITE. SIZE AS INDICATED ON THE FLOOR PLAN DRAWINGS.	NOT APPLICABLE	NOT APPLICABLE	8'-0" AFF
<u> </u>	TELECOMMUNICATIONS GROUNDING BUSBAR.	NOT APPLICABLE	NOT APPLICABLE	6" BELOW LADDER RAC
• •	2-POST EQUIPMENT RACK WITH BLACK FINISH.	NOT APPLICABLE	NOT APPLICABLE	FLOOR
	VERTICAL WIRE MANAGER MOUNTED TO EITHER SIDE OF THE EQUIPMENT RACK WITH A BLACK FINISH. SIZE AS NOTED.	NOT APPLICABLE	NOT APPLICABLE	RACK
3	REFERENCE TO ANOTHER DRAWING VIEW. EXAMPLE SHOWN REFERS TO DETAIL 1 ON DRAWING TC-XXX.	NOT APPLICABLE	NOT APPLICABLE	NOT APPLICABLE

- A. BACKBOXES SHALL BE AS FOLLOWS UNLESS ALTERNATE MANUFACTURER HAS BEEN APPROVED BY OPR:
- 1. BACKBOX WITH 1" AND 1-1/4" KNOCKOUTS: RANDL INDUSTRIES INC. PART #T-55017.
- 2. BACKBOX WITH 3/4" AND 1" KNOCKOUTS: RANDL INDUSTRIES INC. PART #T-55018.
- 3. BACKBOX WITH 1/2" AND 1" KNOCKOUTS: RANDL INDUSTRIES INC. PART #T-55019.
- 4. 1/2" RAISE SINGLE GANG REDUCERS: RANDL INDUSTRIES INC. D-51G012. 5. 5/8" RAISE SINGLE GANG REDUCERS: RANDL INDUSTRIES INC. D-51G058. 6. 3/4" RAISE SINGLE GANG REDUCERS: RANDL INDUSTRIES INC. D-51G034.

OVERVIEW

- JPMORGAN CHASE IS PROPOSING TO RENOVATE THE ENTIRE BUILDING LOCATED AT 890 E LANGSFORD RD, LEE'S SUMMIT, MO 64063 IN ORDER TO OCCUPY THIS SPACE, THERE IS A NEED TO INSTALL NEW STRUCTURED CABLING TO SUPPORT THEIR TELECOMMUNICATION REQUIREMENTS. THIS DOCUMENT CONTAINS THE SPECIFICATIONS FOR INSTALLING:
- CATEGORY 6 UTP, 6A UTP, & 6A F/UTP COPPER CABLING INFRASTRUCTURE AND ASSOCIATED HARDWARE
- TELECOM ROOM EQUIPMENT
- FIBER OPTIC CABLING AND ASSOCIATED HARDWARE

N ADDITION TO THE FINAL DELIVERABLES MENTIONED IN THE JPMC STANDARDS, THE TC SHALL PROVIDE LAMINATED 'AS-BUILTS' (18"X24") OF THE FLOOR PLAN DRAWINGS IN RMER/RTR, MOUNTED TO THE WALL. 'AS-BUILT' DRAWINGS SHALL BE SUBMITTED PRIOR TO THE COMPLETION OF THE PROJECT AND IN COORDINATION WITH THE JPMC PROJECT TEAM AS THEY PLAN THE MOVE.

REFER ALL QUESTIONS TO OWNER'S PROJECT REPRESENTATIVE (OPR) LISTED BELOW: **KEVIN BRENNAN**

PH: 614-217-5158

EMAIL: kevin.m.brennan@jpmchase.com

BASE BID

ALL BID RESPONSES SHALL BE SUBMITTED ON A JPMC SUPPLIED BIDDERS RESPONSE FORM THAT IS INCLUDED IN THE BID PACKAGE. PROPER AND COMPREHENSIVE COMPLETION OF THE BIDDER PRICING FORMS IS A DETERMINING FACTOR IN THE CHOOSING OF THE CONTRACTOR. THE BASE BID SHALL INCLUDE ALL LABOR AND MATERIAL NECESSARY TO PROVIDE A COMPLETE STRUCTURED CABLING SYSTEM (E.G., ALL CABLING, CONVEYANCE, PATCH PANELS, MISCELLANEOUS MATERIALS, LABELING, ETC. REGARDLESS OF MANUFACTURER SPECIFIC ITEMS AS IDENTIFIED IN THE BID). THE BIDDER IS RESPONSIBLE FOR ALL PERMITS AND SHALL INCLUDE THE COST IN THEIR BID. BIDDERS SHALL ALSO INCLUDE APPLICABLE TAXES IN THEIR RESPONSE.

ABBREVIATIONS

AFF = ABOVE FINISHED FLOOR

AFC = ABOVE FINISHED COUNTER BAS = BUILDING AUTOMATION SYSTEM

BBC = BACKBONE BONDING CONDUCTOR

BICSI = BUILDING INDUSTRY CONSULTING SERVICE INTERNATIONAL

CAT = CATEGORY (CABLING)

CCTV = CLOSED CIRCUIT TELEVISION CM = CONSTRUCTION MANAGER

CP = CONSOLIDATION POINT EC = ELECTRICAL CONTRACTOR

EMT = ELECTRICAL METALLIC TUBING ENT = ELECTRICAL NON-METALLIC TUBING

ESD = ELECTROSTATIC DISCHARGE F/UTP = FOIL SHIELD WITH UNSHIELDED TWISTED PAIR

GC = GENERAL CONTRACTOR GTI = GLOBAL TECHNOLOGY INFRASTRUCTURE

IEC = INTERNATIONAL ELECTROTECHNICAL COMMISSION

ISO = INTERNATIONAL ORGANIZATION FOR STANDARDS LOB = LINE OF BUSINESS

MC = MECHANICAL CONTRACTOR

NEC = NATIONAL ELECTRICAL CODE NFPA = NATIONAL FIRE PROTECTION ASSOCIATION OPR = OWNER'S PROJECT REPRESENTATIVE PBB = PRIMARY BONDING BUSBAR

PDU = POWER DISTRIBUTION UNIT PM = PROJECT MANAGER RBB = RACK BONDING BUSBAR

RBC = RACK BONDING CONDUCTOR RMER = RETAIL MAIN EQUIPMENT ROOM RTR = RETAIL TELECOMMUNICATIONS ROOM SBB = SECONDARY BONDING BUSBAR

SC = SECURITY CONTRACTOR TBB = TELECOMMUNICATIONS BONDING BACKBONE TBC = TELECOMMUNICATIONS BONDING CONDUCTOR TC = TELECOMMUNICATIONS CONTRACTOR TEBC = TELECOMMUNICATIONS EQUIPMENT BONDING

TIA = TELECOMMUNICATIONS INDUSTRY ASSOCIATION UTP = UNSHIELDED TWISTED PAIR

INDEX OF DRAWINGS: TELECOMMUNICATIONS

	PEX OF DRAWINGS: TELECOMMUNICATIONS
TC-000	TELECOM DRAWING & SYMBOL LIST, NOTES, & SCOPE OF WORK
TC-001	TELECOM BOOK SPECS
TC-002	TELECOM BOOK SPECS
TC-003	TELECOM BOOK SPECS
TC-004	TELECOM BOOK SPECS
TC-005	TELECOM BOOK SPECS
TC-101	TELECOM NEW FLOOR PLAN
TC-102	TELECOM SITE PLAN
TC-201	FIRST FLOOR ENLARGED RMER PLAN AND ELEVATIONS
TC-301	TELECOM SINGLE LINE DIAGRAM
TC-302	TELECOM TERMINATION DETAILS
TC-401	TELECOM INSTALLATION DETAILS
TC-402	TELECOM INSTALLATION DETAILS
TC-403	TELECOM INSTALLATION DETAILS
TC-501	AV SOLUTION #1 55" DISPLAY INSTALLATION DETAILS
TC-502	AV SOLUTION #3 75" DISPLAY INSTALLATION DETAILS
TC-503	AV SOLUTION #7 32" DISPLAY INSTALLATION DETAILS
TC-601	TELECOM MATERIALS AND PATCH PANEL SCHEDULES

CONDUIT REQUIREMENT CABLE FILL FOR UTP CABLE

		(CA1 6 OD = 0.24", 0	CAT 6A OD = 0.285")	
	CONDUIT TRADE SIZE	CONDUIT AREA (SQ IN)	40% FILL # OF <u>CAT 6</u> CABLES	40% FILL # OF <u>CAT 6A</u> CABLES
	1"	0.81	7	5
	1-1/4"	1.27	11	9
	1-1/2"	1.86	18	12
	2"	3.26	28	21
]	3"	7.06	62	55
	4"	12.56	111	92

ASSUMES INDUSTRY STANDARD AND NEC CODE IS TO DESIGN FOR A MAXIMUM OF 40% FILL. THE ACTUAL NUMBER OF CABLES WHICH CAN BE INSTALLED IN A PARTICULAR CONDUIT CAN BE LESS DEPENDING UPON CONDUIT LENGTH AND NUMBER OF BENDS. SEE CONDUIT INSTALLATION NOTES FOR MORE INFORMATION.

IMPLEMENTATION RESPONSIBILITY MATRIX

	3AL CTOR	CAL	TOR	7 70R	OR	>	
INSTALLATION ITEMS	GENERAL	ELECTRICAL CONTRACTOR	TELECOM	SECURITY CONTRACTOR	AV CONTRACTOR	3RD PARTY	JPMC
STRUCTURED CABLING - HORIZONTAL AND BACKBONE CABLING, RACKS, PATCH PANELS, PATCH CORDS			F&I				
CONDUITS AND BACKBOXES FOR STRUCTURED CABLING, AV, AND SECURITY DEVICES		F&I					
CABLE SUPPORTS (OUTSIDE OF RMER/RTRs) FOR STRUCTURED CABLING			F&I				
LADDER RACKS (INSIDE RMER/RTRs) FOR STRUCTURED CABLING			F&I				
FIRE-RATED SLEEVES INTO THE RMER/RTR			F&I				
GROUNDING TO THE RMER/RTR INCLUDING THE WALL MOUNTED BUSBAR		F&I					
GROUNDING IN THE RMER/RTR FROM THE WALL MOUNTED BUSBAR TO THE RACK BUSBAR & ALL OTHER EQUIPMENT			F&I				
PLYWOOD BACKBOARDS	F&I						
NETWORK EQUIPMENT WITHIN RMER/RTR						I	F
RACK MOUNTED POWER DISTRIBUTION UNITS (PDUs) FOR IT EQUIPMENT			F&I				
RACK MOUNTED POWER DISTRIBUTION UNITS (PDUs) FOR AV EQUIPMENT					F&I		
POWER CORDS FOR NETWORK EQUIPMENT WITHIN THE RMER/RTR			F&I				
WIRELESS ACCESS POINTS			I				F
SECURITY DEVICES - CAMERAS, CARD READERS, ETC.				F&I			
A/V EQUIPMENT - DISPLAYS, CONTROLS, SPEAKERS, AMPLIFIERS, ETC.					F&I		
WIRELESS CELLULAR ANTENNA SYSTEM						F&I	

DEFINITIONS: F = FURNISH I = INSTALL

TELECOM SCOPE OF WORK

NEW SCOPE OF WORK

- A. THE COPPER STRUCTURED CABLING SOLUTION FOR THIS PROJECT SHALL BE COMMSCOPE/SYSTIMAX FOR UTP CABLING INFRASTRUCTURE AND BERK-TEK/LEVITON FOR F/UTP CABLING INFRASTRUCTURE. THE FIBER STRUCTURED CABLING SOLUTION FOR THIS PROJECT SHALL BE CORNING.
- B. FURNISH, INSTALL, LABEL AND TEST ALL CABLES AND COMPONENTS PER JPMC STRUCTURED CABLING STANDARDS.
- C. THE TELECOMMUNICATIONS CONTRACTOR TO FURNISH AND INSTALL PATCH CORDS AT EVERY OUTLET LOCATION AND IN THE TELECOM ROOM, AND PATCH FROM THE PATCH PANEL TO NETWORK SWITCH IN THE RACK.
- D. ALL OUTLETS, JACKS, CABLES, FACEPLATES AND PATCH PANEL IDs SHALL BE LABELED ACCORDINGLY TO REFLECT THE ACCURACY ON BOTH ENDS: TELECOMMUNICATION ROOM AND WORKSTATION.
- E. WAP INSTALLATION: CONTRACTOR SHALL RECEIVE, UN-BOX, MOUNT, PATCH, AND RECORD RELEVANT INFORMATION FOR THE WIRELESS ACCESS POINTS FURNISHED BY THE OWNER. EACH WAP HAS TWO PATCHES THAT ARE INSTALLED FROM THE OUTLET TO THE WAP AND ONE ON THE RMER/RTR SIDE.
- F. NETWORK ELECTRONICS EQUIPMENT RACK AND STACK: CONTRACTOR SHALL COORDINATE WITH JPMC GTI PROJECT
- G. WALL PHONE INSTALLATION: CONTRACTOR SHALL RECEIVE, UN-BOX, MOUNT, PATCH, LABEL WALL PHONE BRACKETS, AND RECORD RELEVANT INFORMATION FOR THE WALL MOUNTED PHONES. THE WALL PHONE BRACKETS SHALL BE LABELED WITH THE TELECOMMUNICATIONS OUTLET LABEL ID ON THE TOP OF THE BRACKET SO IT IS VISIBLE AFTER THE WALL PHONE IS INSTALLED. THE CONTRACTOR SHALL ALSO MOUNT THE WALL PHONES. THE OWNER SHALL FURNISH THE WALL PHONES AND BRACKETS.
- H. NETWORK TURN-UP: THE CONTRACTOR SHALL PROVIDE SUPPORT DURING NETWORK TURN-UP. THIS SHALL INCLUDE LABOR FOR TWO TECHNICIANS FOR OFF-HOURS WORK FOR TWO HOURS PER RMER AND/OR RTR.

GENERAL COORDINATION NOTES

- A. RMERS AND RTRS SHALL NOT BE USED AS A PASS THROUGH (WHETHER UNDER A RAISED FLOOR OR ABOVE CEILING) FOR ANY OTHER TRADES ASIDE FROM STRUCTURED CABLING. ANY PENETRATIONS INTO THESE ROOMS, INCLUDING BUT NOT LIMITED TO ELECTRICAL OR MECHANICAL FIT-OUT TO SOLELY SUPPORT THE MERS AND TRS, SHALL BE ROUTED AWAY FROM THE TECHNOLOGY EQUIPMENT. ROUTING OF CONDUIT SHALL TAKE THE SHORTEST PATH INTO THESE ROOMS.
- B. CONTRACTOR IS SOLELY RESPONSIBLE FOR DEVELOPING A STRUCTURED CABLING BILL OF MATERIALS FROM DESIGN DOCUMENTS PROVIDED. IN ALL CASES WHERE CONTRACTOR IDENTIFIES UNCLEAR OR IMPRECISE DRAWINGS OR SPECIFICATIONS DURING THE BIDDING OR QUOTATION PROCESS, CONTRACTOR SHALL CONTACT OPR, WHO SHALL FURNISH APPROPRIATE INTERPRETATION. UPON AWARD, CONTRACTOR ASSUMES RESPONSIBILITY FOR CORRECTING ANY AND ALL INCONSISTENCIES AT NO ADDITIONAL COST TO OWNER. HERE THE REQUIREMENTS OF CERTAIN SECTIONS OF THE SPECIFICATIONS ARE MORE STRINGENT THAN APPLICABLE CODES, RULES, REGULATIONS, AND ORDINANCES, THE SPECIFICATIONS SHALL APPLY. THE CONTRACTOR SHOULD NOTE ITEMS IN THE DRAWINGS OR THE SPECIFICATIONS, CONSTRUCTION OF WHICH WOULD RESULT IN CODE VIOLATIONS, THE CONTRACTOR SHALL PROMPTLY CALL THEM TO THE ATTENTION OF THE OPR IN WRITING.

CONDUIT INSTALLATION NOTES:

- . ALL NEW CONDUITS FOR TELECOMMUNICATIONS CARRIER CABLING SHALL BE RIGID METALLIC CONDUIT. EACH CONDUIT SHALL HAVE A 3-CELL MAXCELL INNERDUCT INSTALLED AND LABELED WITH THE SOURCE AND DESTINATION.
- B. ALL CABLES MUST BE PULLED AT THE SAME TIME TO ACHIEVE THE GREATER FILL LEVELS.
- C. PULL BOXES SHOULD BE PLACED EVERY 100 FEET OR IF MORE THAN 180 DEGREES OF BENDS ARE INSTALLED IN THE
- D. CONDUITS SHALL ENTER AND EXIT PULL BOXES IN A CONTINUOUS DIRECTION. PULL BOXES ARE NOT TO BE USED FOR 90 DEGREE BENDS.
- ALL 90 DEGREE BENDS SHALL HAVE A SWEEPING BEND WITH A BEND RADII EQUAL TO AT LEAST 10 TIMES THE DIAMETER OF THE CONDUIT.
- . ALL CONDUIT END POINTS SHALL BE FREE OF SHARP EDGES AND PROVIDED WITH A SUITABLE BUSHING.
- G. ALL CONDUITS SHALL HAVE A PULL STRING INSTALLED PRIOR TO THE STRUCTURED CABLING INSTALLATION. A PULL STRING SHALL ALSO BE WITHIN THE CONDUITS AFTER THE STRUCTURED CABLING INSTALLATION.

JPMORGAN CHASE & Co.

GLOBAL TECHNOLOGY INFRASTRUCTURE END USER SERVICES WORKPLACE TECHNOLOGY SERVICES STRUCTURED CABLING ENGINEERING 1111 POLARIS PARKWAY, COLUMBUS, OHIO 43240

NEW RETAIL BRANCH -**HWY 291 AND SE** LANGSFORD RD

keyplan

FOR REFERENCE ONLY ISSUED AND PERMITTED BY OTHERS



date	issue	by
12.21.2020	ISSUED FOR COORDINATION	КВ
01.19.2021	ISSUED FOR CONSTRUCTION	КВ
	12.21.2020	12.21.2020 ISSUED FOR COORDINATION

site location JP MORGAN CHASE & CO 890 NE LANGSROD RD LEE'S SUMMIT, MO 64063

designed KB 12.21.2020 checked CC scale AS NOTED

TELECOM DRAWING & SYMBOL LIST, NOTES & SCOPE OF WORK

job no.

OVP-38200P368999

sheet

1.1 GENERAL REQUIREMENTS

- A. THIS DOCUMENT IS INTENDED TO PROVIDE THE INFORMATION NECESSARY TO ALLOW THE DESIGN AND CONSTRUCTION TEAMS TO PLAN H. ILEC: INCUMBENT LOCAL EXCHANGE CARRIER AND IMPLEMENT TELECOMMUNICATIONS CABLING INFRASTRUCTURES AND TO ENSURE THAT ALL NEW INSTALLATIONS AND RENOVATIONS ARE UNIFORM AND CONSISTENT WITH COMPANY-WIDE STANDARDS. THIS DOCUMENT IDENTIFIES THE TELECOMMUNICATIONS I INFRASTRUCTURE REQUIREMENTS FOR RETAIL SPACES.
- 3. IT IS ENVISIONED THAT NOT ALL RETAIL SPACES WILL REQUIRE THE COMPLETE RANGE OF SERVICES AND TELECOMMUNICATIONS K. MANDATORY: EQUIVALENT TERMS INCLUDE MUST, SHALL, WILL, IS REQUIRED, & ARE REQUIRED. INFRASTRUCTURE DESCRIBED IN THIS DOCUMENT. THE EXACT SOLUTION THAT SUITS EACH PARTICULAR SPACE WILL BE DEFINED AT THE COMMENCEMENT OF EACH PROJECT BY THE PROJECT TEAM.

1.2 PURPOSE

- A. THIS STANDARD FOR RETAIL STRUCTURED CABLING DESIGN AND THE ACCOMPANYING APPENDICES IS INTENDED AS A STANDARD TO BE USED BY CONSTRUCTION DESIGN PROFESSIONALS (ARCHITECTS, ENGINEERS, DESIGNERS, ETC.). ITS PURPOSE IS TO DEFINE THE BASELINE DESIGN FOR RETAIL FACILITIES IN ORDER TO MAKE THEM EASIER TO SPECIFY, UTILIZÉ, AND MANAGE, AND TO STATE THE O. OPTIONAL: EQUIVALENT TERMS INCLUDE CAN, MAY, SHOULD, PREFERABLY, PREFERS, DESIRED, & DESIRABLE. CABLING INFRASTRUCTURE STANDARDS ASSOCIATED WITH THESE SPACES. TO PROMOTE WIDE UNDERSTANDING IT IS BUILT UPON A P. OWNER: JP MORGAN CHASE & COMPANY FOUNDATION OF RECOGNIZED INDUSTRY STANDARDS AND BEST PRACTICES.
- B. THIS STANDARD MUST BE USED AS A TOOL TO PLAN RETAIL FACILITIES. THIS DOCUMENT IS NOT INTENDED TO REPLACE THE SPECIFIC NEEDS OF A GIVEN RETAIL FACILITY OR ASSOCIATED DESIGN COORDINATION. IT MUST BE USED IN CONJUNCTION WITH NEEDS ASSESSMENT AND PROPER DESIGN COORDINATION. SPECIFIC PROJECT REQUIREMENTS SHALL BE DEFINED IN T-SERIES DRAWINGS THAT R. PROVIDE: TO FURNISH AND INSTALL. SHALL BE ISSUED AS PART OF A COMPLETE CONSTRUCTION DRAWING SET WITH THE ARCHITECTURAL, STRUCTURAL, MECHANICAL, S. SPECIFICATIONS: DIVISION 27 SPECIFICATIONS, WHICH OUTLINES GENERAL INSTALLATION REQUIREMENTS.
- C. IF A STANDARD CANNOT BE MET DURING THE PLANNING AND DESIGN PHASES, THE GROUP ACCOUNTABLE TO MEET THE REQUIREMENTS T. TE: TELECOMMUNICATIONS ENCLOSURE MUST SUBMIT A REQUEST FOR EXCEPTION APPROVAL PRIOR TO PROCEEDING WITH A DEVIATION FROM THE STANDARD.

1.3 DESIGN CONSULTANT REQUIREMENTS

- A. IN THE CASE WHERE A PROJECT IS DESIGNED BY AN ENTITY OTHER THAN THE JPMC STRUCTURED CABLING ENGINEERING TEAM, THE DESIGN CONSULTANT SHALL MEET ONE OF THE FOLLOWING CRITERIA:
- 1. THE ENGINEER SHALL BE A BICSI RCDD IN GOOD STANDING WITH AT LEAST 2 YEARS OF EXPERIENCE IN STRUCTURED CABLING DESIGN AND CONSTRUCTION MANAGEMENT.
- 2. THE ENGINEER SHALL HAVE 10 YEARS OF EXPERIENCE IN STRUCTURED CABLING DESIGN AND CONSTRUCTION MANAGEMENT.

1.4 TECHNOLOGY SPACE DEFINITIONS

- A. THE FOLLOWING ARE THE TYPES OF TECHNOLOGY SPACES THAT ARE FOUND IN RETAIL FACILITIES, RETAIL MAIN EQUIPMENT ROOM (RMER). RETAIL TELECOMMUNICATIONS ROOM (RTR), AND RETAIL TELECOMMUNICATIONS ENCLOSURE (RTE).
- RETAIL MAIN EQUIPMENT ROOM (RMER): THE RMER SERVES AS A COMMON NETWORK DISTRIBUTION POINT FOR THE D. CODES, REGULATIONS, STANDARDS, AND INDUSTRY PRACTICES DOCUMENTS CHANGE OVER TIME. CURRENT GOVERNING CODES AND TELECOMMUNICATIONS ROOMS OR TELECOMMUNICATIONS ENCLOSURES WITHIN THAT BUILDING, HORIZONTAL CABLING DISTRIBUTION POINT FOR A GIVEN AREA, AND THE INTERFACE WITH THE TELECOMMUNICATIONS SERVICE PROVIDERS (CARRIERS). ITEMS WITHIN THE RMER INCLUDE:
- FLOOR MOUNTED EQUIPMENT RACKS.
- 2. JPMC NETWORKING EQUIPMENT (ROUTERS AND SWITCHES).
- 3. BACKBONE CABLING TERMINATIONS FROM RMER TO RTRS (IF APPLICABLE).
- 4. HORIZONTAL CABLING TERMINATIONS.
- STRUCTURED CABLING PATHWAYS (LADDER RACKS AND FIRE-RATED WALL SLEEVES).
- WIRED TELECOMMUNICATIONS SERVICE PROVIDER CABLING ENTRANCE, CABLING TERMINATIONS, AND EQUIPMENT.
- 7. WIRELESS TELECOMMUNICATIONS SERVICE PROVIDER CABLING ENTRANCE, CABLING TERMINATIONS, AND EQUIPMENT.
- 8. TELECOMMUNICATIONS MAIN GROUNDING BUSBAR.
- DEDICATED COOLING UNIT.
- 10. AUDIO/VIDEO EQUIPMENT TO SUPPORT DIGITAL SIGNAGE APPLICATIONS.
- ACCESS CONTROL SYSTEM PANELS. 12. INTRUSION DETECTION SYSTEM PANELS.
- 13. MOOD MUSIC SYSTEM EQUIPMENT.
- 14. BUILDING MANAGEMENT SYSTEM (BMS) EQUIPMENT.
- . RETAIL TELECOMMUNICATIONS ROOMS (RTR): A RTR SERVES AS A HORIZONTAL CABLING DISTRIBUTION POINT FOR A GIVEN AREA. ITEMS
- WITHIN A RTR INCLUDE: 1. FLOOR MOUNTED RACK OR WALL MOUNTED-FLOOR SUPPORTED EQUIPMENT CABINET.
- 2. JPMC NETWORKING EQUIPMENT (SWITCHES).
- BACKBONE CABLING TERMINATIONS TO THE RMER.
- 4. HORIZONTAL CABLING TERMINATIONS. 5. STRUCTURED CABLING PATHWAYS (LADDER RACKS AND FIRE-RATED WALL SLEEVES).
- 6. TELECOMMUNICATIONS GROUNDING BUSBAR.
- DEDICATED COOLING UNIT. 8. AUDIO/VIDEO EQUIPMENT TO SUPPORT DIGITAL SIGNAGE APPLICATIONS.
- D. STAND ALONE ATM: SMALL ROOM ADJOINING OR BEHIND THE FRONT OF THE ATMS AS A HORIZONTAL CABLING DISTRIBUTION POINT FOR A LIMITED AMOUNT OF CABLES (NO MORE THAN 24). ITEMS INCLUDE:
- 1. FLOOR MOUNTED RACK OR WALL MOUNTED-FLOOR SUPPORTED EQUIPMENT CABINET.
- 2. JPMC NETWORKING EQUIPMENT (SWITCH). HORIZONTAL CABLING TERMINATIONS.
- STRUCTURED CABLING PATHWAYS (LADDER RACKS AND FIRE-RATED WALL SLEEVES)
- 5. WIRED TELECOMMUNICATIONS SERVICE PROVIDER CABLING ENTRANCE, CABLING TERMINATIONS, AND EQUIPMENT.
- 6. WIRELESS TELECOMMUNICATIONS SERVICE PROVIDER CABLING ENTRANCE, CABLING TERMINATIONS, AND EQUIPMENT.
- 7. TELECOMMUNICATIONS MAIN GROUNDING BUSBAR.
- 8. AUDIO/VIDEO EQUIPMENT TO SUPPORT DIGITAL SIGNAGE APPLICATIONS.
- 9. ACCESS CONTROL SYSTEM PANELS.
- 10. INTRUSION DETECTION SYSTEM PANELS.
- 11. ELECTRICAL PANEL
- TELECOMMUNICATIONS ENCLOSURE (TE): A TE SERVES AS A HORIZONTAL CABLING DISTRIBUTION POINT FOR A LIMITED AMOUNT OF CABLES (NO MORE THAN 24) FOR A GIVEN SMALL AREA AND SHALL ONLY BE USED WHEN ABSOLUTELY NECESSARY WITH APPROVAL FROM
- THE JPMC STRUCTURED CABLING ENGINEERING TEAM. A TE CONSISTS OF: 1. WALL MOUNTED OR WALL MOUNTED-FLOOR SUPPORTED EQUIPMENT CABINET.
- 2. JPMC NETWORKING EQUIPMENT (SWITCH).
- HORIZONTAL CABLING TERMINATIONS.
- WIRELESS TELECOMMUNICATIONS SERVICE PROVIDER CABLING ENTRANCE, CABLING TERMINATIONS, AND EQUIPMENT
- TELECOMMUNICATIONS MAIN GROUNDING BUSBAR.
- AUDIO/VIDEO EQUIPMENT TO SUPPORT DIGITAL SIGNAGE APPLICATIONS.
- ITEMS NOT WITHIN THE RMER OR RTR INCLUDE:
- ELECTRICAL PANELS. 2. FIRE ALARM PANELS.
- DOMESTIC WATER PIPING 4. SANITARY WATER PIPING
- 5. HVAC PIPING UNLESS TO SUPPORT THE RMER/RTR COOLING UNIT
- 6. FIRE PROTECTION PIPING UNLESS TO SUPPORT THE RMER/RTR PER LOCAL CODES.
- G. ITEMS NOT WITHIN TE INCLUDE:
- DOMESTIC WATER PIPING SANITARY WATER PIPING
- HVAC PIPING.
- 4. FIRE PROTECTION PIPING UNLESS TO SUPPORT THE TE PER LOCAL CODES. H. GUIDELINES FOR QUANTITY AND LOCATION OF CRITICAL TECHNOLOGY SPACES.
- RMER:
- a. ONE PER FACILITY, CENTRALLY LOCATED AS MUCH AS POSSIBLE, TO SERVE UP TO 10,000 SQUARE FEET OF SPACE ON THE SAME PART 3 EXECUTION FLOOR/LEVEL. a. ONE PER ADDITIONAL FLOOR/LEVEL THAT THE RMER DOES NOT SERVE, CENTRALLY LOCATED AS MUCH AS POSSIBLE
- b. ONE PER ADDITIONAL 10,000 SQUARE FEET THAT THE RMER DOES NOT SERVE, CENTRALLY LOCATED AS MUCH AS POSSIBLE FOR
- THE AREA SERVED.
- a. ONLY TO BE USED WITHIN A STAND-ALONE ATM DESIGN (NON-STAFFED LOCATION WITH ONLY ONE OR TWO ATMS).
- 1.5 DEFINITIONS/TERMINOLOGY/ABBREVIATIONS

C. CM: CONSTRUCTION MANAGER

- A. AHJ: AUTHORITY HAVING JURISDICTION AS DEFINED BY THE CURRENT EDITION OF THE NATIONAL ELECTRICAL CODE.
- B. AS-BUILT: DOCUMENTATION THAT INCLUDES FLOOR PLAN DRAWINGS THAT INDICATE ALL STRUCTURED CABLING OUTLET LOCATIONS WITH
- CABLE LABELING, MAJOR CABLING PATHWAYS, AND RMER/RTR/TE LAYOUTS WITH RACK ELEVATIONS UPON JOB COMPLETION THAT REFLECTS CHANGES FROM THE PLANNED TO THE FINISHED STATE.

- D. CONTRACTOR: THE STRUCTURED CABLING INSTALLATION CONTRACTOR
- E. FURNISH: THE CONTRACTOR SHALL SUPPLY
- F. GC: GENERAL CONTRACTOR
- G. HC: HORIZONTAL CROSS-CONNECT

- INSTALL: TO PUT INTO PLACE OR FIX IN POSITION READY FOR USE.
- J. JPMC: JP MORGAN CHASE & COMPANY
- RMER: RETAIL MAIN EQUIPMENT ROOM
- M. RTR: RETAIL TELECOMMUNICATIONS ROOM
- N. OPR: OWNER'S PROJECT REPRESENTATIVE. JPMC'S DESIGNATED REPRESENTATIVE RESPONSIBLE FOR A SUCCESSFUL PROJECT

- Q. PROJECT DOCUMENTS: ALL DOCUMENTS THAT PERTAIN TO THE PROJECT, INCLUDING, BUT NOT LIMITED TO, PROJECT DRAWINGS, THIS STANDARD, AND PROJECT SPECIFICATIONS.

- 1.6 CODES, REGULATIONS, & STANDARDS
- A. ALL ASPECTS OF CONSTRUCTION AND INSTALLATION MUST MEET APPLICABLE LOCAL, STATE, AND FEDERAL LAWS, AS WELL AS ANY REGULATIONS SPECIFIC TO A SITE. LEGALLY BINDING REQUIREMENTS MUST PREVAIL IF THERE ARE ANY CONFLICTS WITH REQUIREMENTS STATED OR IMPLIED IN THIS DOCUMENT. THE AHJ WILL BE THE ARBITER IN SITUATIONS WHERE INTERPRETATION IS NECESSARY TO CLARIFY INFORMATION, OR TO RESOLVE CONFLICTS INVOLVING LEGALLY BINDING REQUIREMENTS.
- B. WORK SAFETY MUST BE IN COMPLIANCE WITH PUBLIC LAW 91-596, OCCUPATIONAL SAFETY AND HEALTH ACT (OSHA). AS APPLICABLE, REQUIREMENTS OF THE NFPA 101 LIFE SAFETY CODE MUST BE FOLLOWED.
- C. CODES, REGULATIONS, STANDARDS, AND INDUSTRY PRACTICES DOCUMENTS EXPLICIT TO THIS STANDARD ARE LISTED IN SECTION 1.8 BELOW, BUT THEY ARE NOT EXHAUSTIVE. EVEN WHEN NOT EXPLICITLY CITED WITHIN THIS DOCUMENT, THERE IS AN IMPLIED REQUIREMENT OF COMPLIANCE WITH INDUSTRY NORMS REFLECTED IN RECOGNIZED STANDARDS AND PRACTICES, AS WELL AS REQUIREMENTS BASED IN
- REGULATIONS AT A SITE LOCATION, AND THE MOST RECENT EDITION OF STANDARDS AND PRACTICES DOCUMENTS (INCLUDING ERRATA, ANNEXES, AND AMENDMENTS) MUST BE USED AT THE TIME FACILITIES ARE DESIGNED AND WHEN THEY ARE UTILIZED.
- E. ALTHOUGH A NUMBER OF STANDARDS AND PRACTICES ARE CITED IN THIS DOCUMENT, ANSI/TIA-569 "COMMERCIAL BUILDING STANDARD FOR TELECOMMUNICATIONS PATHWAYS" HAS BOTH EXPLICIT AND IMPLICIT THREADS THROUGHOUT.
- F. ADDITIONALLY INFLUENCING THIS STANDARD ARE ACCEPTED INDUSTRY PRACTICES DOCUMENTS SUCH AS THOSE IN THE NECA/BICSI-568 "STANDARD FOR INSTALLING COMMERCIAL BUILDING COMMUNICATIONS CABLING", AND THE BICSI "TELECOMMUNICATIONS DISTRIBUTION METHODS MANUAL (TDMM)"
- 1.7 REFERENCED JPMC STANDARDS
- A. FOR ARCHITECTURE: RETAIL DESIGN COMMUNICATION #18-007
- B. FOR PHYSICAL SECURITY: TS NAMR RETAIL FACILITY SECURITY DESIGN STANDARD VERSION 1.0
- 1.8 REFERENCED CODES AND STANDARDS
- A. UNLESS OTHERWISE SPECIFICALLY STATED IN THIS DOCUMENT, ALL WORK SHALL BE PERFORMED IN FULL COMPLIANCE WITH THE REQUIREMENTS SET FORTH IN THE FOLLOWING REFERENCE STANDARDS. IN ANY CASE WHERE REGIONAL STANDARDS DISAGREE, LOCAL CODES AND STANDARDS APPLY. EVEN WHEN NOT EXPLICITLY CITED WITHIN THIS STANDARD DOCUMENT, THERE IS AN IMPLIED REQUIREMENT OF COMPLIANCE WITH INDUSTRY NORMS REFLECTED IN RECOGNIZED STANDARDS AND PRACTICES, AS WELL AS REQUIREMENTS BASED IN LAW. CURRENT GOVERNING CODES AND REGULATIONS AT A SITE LOCATION, AND THE MOST RECENT EDITION OF STANDARDS AND PRACTICES DOCUMENTS (INCLUDING ERRATA, ANNEXES, AND AMENDMENTS) MUST BE USED.
- 1. AMERICANS WITH DISABILITIES ACT (ADA)
- 2. ASHRAE TC9.9 2011 THERMAL GUIDELINES FOR DATA PROCESSING ENVIRONMENTS
- 3. BICSI TELECOMMUNICATIONS DISTRIBUTION METHODS MANUAL, (CURRENT EDITION) 4. CAN/ULC S115, STANDARD METHOD OF FIRE TESTS OF FIRESTOPS SYSTEMS
- 5. NFPA 70 NATIONAL ELECTRICAL CODE (CURRENT VERSION AS APPLICABLE TO SITE LOCATION) 6. TIA 568.0.D - GENERIC TELECOMMUNICATIONS CABLING FOR CUSTOMER PREMISES
- 7. TIA 568.1.D COMMERCIAL BUILDING TELECOMMUNICATIONS CABLING STANDARD 8. TIA-568-C.2 - BALANCED TWISTED-PAIR TELECOMMUNICATIONS CABLING AND COMPONENTS STANDARDS
- 9. TIA 568.3.D OPTICAL FIBER CABLING COMPONENTS STANDARD 10. TIA -569-C COMMERCIAL BUILDING STANDARD FOR TELECOMMUNICATIONS PATHWAYS AND SPACES
- 11. ANSI/TIA-EIA-569-D TELECOMMUNICATIONS PATHWAYS AND SPACES
- 12. TIA/EIA-606-C ADMINISTRATION STANDARD FOR COMMERCIAL TELECOMMUNICATIONS INFRASTRUCTURE
- 13. TIA-607 COMMERCIAL BUILDING GROUNDING (EARTHING) AND BONDING REQUIREMENTS FOR TELECOMMUNICATIONS 14. TIA/EIA-72 CENTRALIZED OPTICAL FIBER CABLING GUIDELINES
- 15. TIA/EIA-758-B CUSTOMER-OWNED OUTSIDE PLANT TELECOMMUNICATIONS CABLING STANDARD
- PART 2 PRODUCTS
- 2.1 STRUCTURED CABLING REQUIREMENTS
- A. COPPER AND FIBER OPTIC CABLING
- 1. FOR UTP COPPER CABLING, ALL MATERIAL SHALL BE MANUFACTURED BY COMMSCOPE SYSTIMAX AND THE CONTRACTOR SHALL BE AN AUTHORIZED COMMSCOPE UNIPRISE BUSINESS PARTNER (BP).
- FOR F/UTP COPPER CABLING, ALL MATERIAL SHALL BE MANUFACTURED BY BERK-TEK & LEVITON.
- 3. FOR FIBER OPTIC CABLING, ALL MATERIAL SHALL BE MANUFACTURED BY CORNING AND THE CONTRACTOR SHALL BE CERTIFIED AS A CORNING PREFERRED INSTALLER (PI).
- **B. CABLING TYPES**
- 1. HORIZONTAL CABLING FOR ALL WIRELESS ACCESS POINTS AND IP-SECURITY CAMERAS UP TO 100M IN LENGTH SHALL BE CATEGORY 6A
- 2. HORIZONTAL CABLING FOR ALL NON-WIRELESS ACCESS POINTS AND NON-IP-SECURITY CAMERAS UP TO 100M IN LENGTH SHALL BE CATEGORY 6 UTP.
- 3. HORIZONTAL CABLING FOR ALL HDBASE-T CONNECTIONS SHALL BE CATEGORY 6A F/UTP. 4. HORIZONTAL CABLING FOR IP-SECURITY CAMERAS OVER 100M IN LENGTH SHALL BE OM3 MULTIMODE FIBER OPTIC CABLE.
- C. CABLE SUPPORT & PROTECTION
- WITHIN JPMC OWNED OR LEASED SPACES:
- a. ABOVE AN ACCESSIBLE CEILING: SUPPORTED BY EITHER J-HOOKS OR A WIRE-BASKET STYLE CABLE TRAY. b. ABOVE A HARD CEILING: WITHIN CONDUIT.
- 2. OUTSIDE OF JPMC OWNED OR LEASED SPACES:
- a. ABOVE AN ACCESSIBLE CEILING: WITHIN CONDUIT. b. ABOVE A HARD CEILING: WITHIN CONDUIT.
- 3. ANY REQUIRED JUNCTION AND/OR PULL BOXES LOCATED OUTSIDE OF JPMC OWNED OR LEASED SPACE SHALL BE PROVIDED WITH LOCKS OR TAMPER-PROOF SCREWS SO THAT THE CABLING IS INACCESSIBLE TO ANYONE OTHER THAN JPMC PERSONNEL.
- D. MATERIAL INTERPRETATION
- 1. THIS SPECIFICATION CONTAINS ALL PRODUCTS CURRENTLY APPROVED BY OWNER. CONTRACTOR SHOULD NOT ASSUME THAT MATERIALS LISTED IN THIS SPECIFICATION MUST BE INSTALLED MERELY BECAUSE THEY ARE LISTED IN THIS SPECIFICATION. PROJECT-SPECIFIC DETAIL ON REQUIRED MATERIALS IS FURTHER DEFINED IN THE ACCOMPANYING PROJECT DRAWINGS.
- 3.1 RMER, RTR, & STAND ALONE ATM DESIGN REQUIREMENTS
- A. FOR SITE UTILITIES, ARCHITECTURAL, MECHANICAL, FIRE SUPPRESSION, ELECTRICAL, SECURITY, AND MORE STRUCTURED CABLING REQUIREMENTS, SEE APPENDIX B.
- 3.2 CONSTRUCTION PROGRESS CHECKLIST
- A. FOR A COMPREHENSIVE LIST OF ITEMS TO BE COMPLETED AT VARIOUS MILESTONES OF CONSTRUCTION, SEE APPENDIX A. THE
- MILESTONES ARE AS FOLLOWS AND SHALL BE INCORPORATED INTO THE CONSTRUCTION SCHEDULE.
- 1. SHELL READY CONSISTS OF GENERAL, MEP, & STRUCTURED CABLING CONSTRUCTION ITEMS 2. ROOM READY - CONSISTS OF GENERAL, MEP, SECURITY, & STRUCTURED CABLING CONSTRUCTION ITEMS
- 3. PRODUCTION READY CONSISTS OF SECURITY, & STRUCTURED CABLING CONSTRUCTION ITEMS. 4. WORKPLACE READY - CONSISTS OF GENERAL, MEP, FURNITURE, SECURITY, & STRUCTURED CABLING CONSTRUCTION ITEMS OUTSIDE OF THE RMER/RTR.

END OF SECTION

SECTION 27 00 00 COMMUNICATIONS INTRODUCTORY STANDARD

SECTION 27 05 00 - QUALITY ASSURANCE FOR STRUCTURED CABLING

PART 1 - GENERAL

1.1 DESCRIPTION A. THIS SPECIFICATION PROVIDES THE REQUIREMENTS FOR ALL STRUCTURED CABLING INSTALLATION CONTRACTORS.

1.2 INSTALLATION CONTRACTOR REQUIREMENTS

A. CERTIFICATIONS/TRAINING

THE CONTRACTOR MUST HAVE FIVE YEARS MINIMUM EXPERIENCE IN STRUCTURED CABLING INSTALLATIONS.

2. THE CONTRACTOR SHALL BE A COMMSCOPE SYSTIMAX CERTIFIED CONTRACTOR IN ORDER TO PROVIDE A MINIMUM TWENTY (20) YEAR EXTENDED PRODUCT AND APPLICATIONS ASSURANCE WARRANTY ON PARTS AND LABOR ASSOCIATED WITH THE UTP CABLING INFRASTRUCTURE.

3. THE CONTRACTOR SHALL BE A BERK-TEK/LEVITON CERTIFIED CONTRACTOR IN ORDER TO PROVIDE A MINIMUM TWENTY (20) YEAR EXTENDED PRODUCT AND APPLICATIONS ASSURANCE WARRANTY ON PARTS AND LABOR ASSOCIATED WITH THE F/UTP CABLING INFRASTRUCTURE.

4. THE CONTRACTOR SHALL BE A CORNING CERTIFIED CONTRACTOR IN ORDER TO PROVIDE A MINIMUM TWENTY (20) YEAR EXTENDED PRODUCT AND APPLICATIONS ASSURANCE WARRANTY ON PARTS AND LABOR ASSOCIATED WITH THE FIBER CABLING INFRASTRUCTURE.

5. THE CONTRACTOR MUST HAVE AT LEAST ONE EMPLOYEE THAT IS A BICSI CERTIFIED INSTALLER 1, INSTALLER 2, OR TECHNICIAN ON SITE DURING THE INSTALLATION OF STRUCTURED CABLING.

B. UNION AFFILIATION 1. IF REQUIRED BASED ON THE LOCATION OF THE PROJECT, THE CONTRACTOR SHALL BE A MEMBER OF THE LOCALLY RECOGNIZED UNION. THIS MAY INCLUDE, BUT NOT LIMITED TO, IBEW OR CWA.

1.3 APPROVED CONTRACTORS

A. PREFERRED CABLING CONTRACTOR MASTER LIST

1. JPMC UTILIZES A LIST OF PRE-QUALIFIED CONTRACTORS TO PERFORM ALL STRUCTURED CABLING INSTALLATIONS. IN ORDER FOR A CONTRACTOR TO PROVIDE PRICING FOR A STRUCTURED CABLING INSTALLATION PROJECT, THE CONTRACTOR MUST BE ON THIS LIST.

2. JPMC'S STRUCTURED CABLING DESIGN TEAM MAINTAINS THE PREFERRED CABLING CONTRACTOR MASTER LIST THAT IDENTIFIES CABLING CONTRACTORS THAT ARE PROPERLY AND TECHNICALLY QUALIFIED TO INSTALL PRODUCTS SPECIFIED WITHIN THIS STANDARD, HAVE THE FINANCIAL STRENGTH TO PERFORM PROJECTS WITHOUT DISRUPTIONS. AND HAVE A DOCUMENTED HISTORY OF SUCCESS IN PREVIOUS PROJECTS. THE STRUCTURED CABLING DESIGN TEAM IS THE SUBJECT MATTER EXPERT WITHIN JPMORGAN CHASE, REGARDING MATTERS INCLUDING, BUT NOT LIMITED TO QUALIFYING CERTIFIED CONTRACTORS. THE LIST IDENTIFIES IF A CONTRACTOR IS QUALIFIED TO PERFORM WORK IN OUR CORPORATE FACILITIES, AND/OR OUR RETAIL FACILITIES. GREAT CARE AND CONSTANT ATTENTION IS GIVEN TO THE MAINTENANCE OF THIS LIST, AND CONDITIONS FOR PROBATION AND ELIMINATION FROM OUR LIST BASED ON CONTRACTOR PERFORMANCE IS CONTAINED WITHIN THE PREFERRED CONTRACTOR MASTER LIST.

1. JPMC STRUCTURED CABLING PROJECTS AS DEFINED BY THIS STANDARD SHALL ONLY BE IMPLEMENTED BY CONTRACTORS ON THE PREFERRED CABLING CONTRACTOR MASTER LIST. THE INSTALLATION CONTRACTORS ON THIS LIST SHALL NOT SUBCONTRACT WORK TO OTHERS WITHOUT PRIOR WRITTEN OPR APPROVAL. FAILURE TO COMPLY WITH THIS REQUIREMENT MAY RESULT IN REMOVAL FROM CONSIDERATION FOR FUTURE JPMC PROJECTS. CONTRACTOR SHALL EVALUATE STAFFING REQUIREMENTS FOR CONTEMPLATED JPMC PROJECTS, AND SUBMIT REQUEST FOR SAID OPR APPROVAL AT THE TIME THAT THEY TENDER THEIR INITIAL PROPOSAL.

C. NEW CONTRACTOR PROBATION

1. A CONTRACTOR THAT HAS BEEN ADDED TO THE PREFERRED CONTRACTOR LIST IS AUTOMATICALLY PLACED ON PROBATION. THE NEW CONTRACTOR PROBATION PERIOD IS THE GREATER OF 1) 90 DAYS, AND 2) AFTER TWO OR MORE PROJECTS HAVE BEEN ACCEPTED VIA AN ON-SITE INSPECTION BY OPR. THE NEW CONTRACTOR SHALL BE IMMEDIATELY AND PERMANENTLY REMOVED FROM THE PREFERRED CONTRACTOR LIST IF A) THE RESULTS OF AN ON-SITE INSPECTION ARE JUDGED BY THE INSPECTOR TO BE UNSATISFACTORY, OR B) UPON THE OCCURRENCE OF ONE PROBATION EVENT AS DEFINED UNDER EXISTING CONTRACTOR PROBATION IN THIS STANDARD. AT THE SUCCESSFUL CONCLUSION OF THE PROBATION PERIOD, THE NEW CONTRACTOR SHALL BE ADDED TO THE PREFERRED CONTRACTOR LIST.

D. EXISTING CONTRACTOR PROBATION

1. AN EXISTING CONTRACTOR PROBATION EVENT OCCURS WHEN THE STRUCTURED CABLING DESIGN TEAM DETERMINES, IN THEIR SOLE DISCRETION, THAT THE CONTRACTOR HAS FAILED TO ADHERE TO INSTALLATION REQUIREMENTS AS DEFINED BY THE RETAIL STRUCTURED CABLING DESIGN STANDARD AND AFFILIATED DOCUMENTS. CONTRACTOR SHALL BE NOTIFIED IN WRITING REGARDING THE PROBATION EVENT, INCLUDING DETAILS OF THE EVENT, DATE OF THE EVENT, AND CONTACT INFORMATION FOR THE OPR THAT IS RESPONSIBLE FOR ADMINISTRATION OF THE PROBATION. EXISTING CONTRACTOR PROBATION PERIOD IS THE GREATER OF 1) 90 DAYS, AND 2) AFTER TWO OR MORE PROJECTS HAVE BEEN ACCEPTED VIA AN ON-SITE INSPECTION BY OPR, AND DEVIATIONS ASSOCIATED WITH THE PROBATION EVENT HAVE BEEN CORRECTED AND ACCEPTED IN WRITING BY OPR. CONTRACTOR SHALL BE IMMEDIATELY AND PERMANENTLY REMOVED FROM THE PREFERRED CONTRACTOR LIST IF A) TWO PROBATION EVENTS OCCUR IN ANY ROLLING 18-MONTH PERIOD, OR B) CONTRACTOR FAILS TO CORRECT DEVIATIONS FROM INSTALLATION REQUIREMENTS AS SPECIFIED IN THIS CLAUSE WITHIN 45 CALENDAR DAYS OF NOTIFICATION, OR C) CONTRACTOR HAS SUBCONTRACTED IN WHOLE OR IN PART A PROJECT WITHOUT PRIOR OWNER NOTIFICATION AND WRITTEN APPROVAL THEREOF, OR D) IN THE SOLE JUDGMENT OF OWNER, CONTRACTOR HAS FALSIFIED TEST RESULTS. CONTRACTOR SHALL BE NOTIFIED IN WRITING REGARDING PROBATION STATUS CHANGE, INCLUDING BUT NOT LIMITED TO PLACEMENT ON PROBATION, LIFTING OF PROBATION, AND REMOVAL FROM THE PREFERRED CONTRACTOR LIST.

E. OTHER CONTRACTOR CHANGES

- 1. UPON UNANIMOUS VOTE BY THE STRUCTURED CABLING TEAM, CONTRACTOR MAY BE REMOVED FROM THE PREFERRED CONTRACTOR LIST AT THE SOLE DISCRETION OF THE JPMC STRUCTURED CABLING TEAM AT ANY TIME, AND WITHOUT ADVANCE NOTICE BY JPMC. REASONS INCLUDE, BUT ARE NOT LIMITED TO:
- a. CONTRACTOR LOSS OF PROPER MANUFACTURER CERTIFICATION b. CONTRACTOR ASSESSMENT OF MACD (MOVE ADD CHANGE DISCONNECT) FEES, WHICH, IN THE SOLE JUDGMENT OF THE JPMC

STRUCTURED CABLING TEAM, ARE DETERMINED TO BE CONSISTENTLY EXCESSIVE

c. FALSIFYING TEST RESULTS. 2. UPON EXECUTION OF THIS CLAUSE, THE JPMC STRUCTURED CABLING TEAM MAY OR MAY NOT ISSUE NOTIFICATION TO CONTRACTOR

REGARDING SAID REMOVAL. 1.4 OTHER CONTRACTOR REQUIREMENTS

A. OMISSIONS 1. CONTRACTOR OMISSION OF ANY REQUIREMENT DESCRIBED IN PROJECT DOCUMENTS SHALL NOT BE CONSTRUED AS TO RELIEVE CONTRACTOR OF ANY RESPONSIBILITY OR OBLIGATION REQUIRED TO AFFECT THE COMPLETE AND SATISFACTORY DELIVERY, OPERATION, AND SUPPORT OF ANY AND ALL MATERIALS OR SERVICES.

1. CONTRACTOR SHALL NOT SOLICIT WRITTEN OR VERBAL TESTIMONIALS FROM JPMC PERSONNEL AT ANY TIME. CONTRACTOR SHALL NOT INSTALL OR POST IN JPMC PROPERTIES ANY FORM OF SIGNAGE THAT CONTAINS CONTRACTOR NAME, ADDRESS, TELEPHONE NUMBER, OR

B. CONTRACTOR ADVERTISING

JPMC IT RISK MANAGEMENT AND THE LOCAL JPMC SITE MANAGER. ALL REQUESTS SHALL BE SUBMITTED TO THE OPR FOR ROUTING. PART 2 - PRODUCTS

2.1 GENERAL MATERIAL REQUIREMENTS

A. NEW MATERIALS 1. ALL CABLE AND MATERIALS SHALL BE NEW, UNLESS PREVIOUSLY APPROVED IN WRITING BY OPR. NEW EQUIPMENT AND MATERIALS SHALL BE WITHOUT BLEMISH OR DEFECT. NEW EQUIPMENT AND MATERIALS SHALL BE UNDERWRITERS LABORATORIES, INC. (U.L.) LABELED AND/OR

LOGO. PHOTOGRAPHS WITHIN JPMC BUILDINGS INCLUDING TECHNOLOGY SPACES ARE STRICTLY PROHIBITED WITHOUT PRIOR APPROVAL OF

1. IT IS THE SOLE RESPONSIBILITY OF THE CONTRACTOR TO ENSURE THAT ALL PRODUCTS INSTALLED AT THIS FACILITY ARE COMPATIBLE WITH THE APPLICATION. THE OWNER MAKES NO REPRESENTATION REGARDING THE ACCURACY OF THE PART NUMBERS LISTED.

LISTED WHERE SPECIFICALLY CALLED FOR, OR WHERE NORMALLY SUBJECT TO SUCH U.L. LABELING AND/OR LISTING SERVICES.

C. SUBSTITUTIONS

1. MATERIALS SHALL BE AS LISTED. NO SUBSTITUTIONS ARE ALLOWED WITHOUT WRITTEN CONSENT FROM THE JPMC STRUCTURED CABLING ENGINEERING TEAM. PROPOSALS FOR EQUIVALENT PRODUCTS MUST BE PRESENTED TO THE OPR VIA RFI'S, SUBMITTALS, AND/OR SHOP DRAWINGS. OPR WRITTEN APPROVAL IS REQUIRED BEFORE ANY SUBSTITUTIONS ARE MADE. MATERIALS MUST BE COMPATIBLE WITH THE END-TO-END SOLUTION BEING PROPOSED

PART 3 - EXECUTION

3.1 PROTECTION OF PROPERTY

A. EXTREME CARE SHALL BE TAKEN BY CONTRACTOR TO PROTECT ALL COMPONENTS OF THE PROPERTY FROM DAMAGE. CONTRACTOR SHALL REPLACE ANY DAMAGED CEILING TILES THAT ARE BROKEN DURING CABLE INSTALLATION. CONTRACTOR SHALL PROVIDE ALL PROTECTIVE DEVICES AND COVERINGS REQUIRED TO PROTECT AREAS ADJACENT TO THE WORK AREA. CONTRACTOR SHALL REPAIR DAMAGE TO AREAS ADJACENT TO THE WORK AREA AT NO COST TO THE OWNER, OR THE OWNER SHALL MAKE THE REPAIRS AND BACK CHARGE AGAINST THE TELECOM CONTRACTOR. CONTRACTOR SHALL ASSUME COMPLETE RESPONSIBILITY FOR DAMAGES TO THIRD PARTIES INCURRED AS A RESULT OF CONTRACTOR'S WORK IN THIS PROJECT. PROTECTION OF PROPERTY SHALL INCLUDE, BUT NOT BE LIMITED TO, THE FOLLOWING PROTECTIVE

B. IT IS CONTRACTOR'S SOLE RESPONSIBILITY TO SECURE, READ AND UNDERSTAND ALL RELEVANT JPMC STANDARDS, AND EXECUTE INSTALLATIONS

- 1. KEEPING THE RMER OR RTR FREE OF FOOD AND DRINK AT ALL TIMES. 2. LEAVING RMER OR RTR DOORS CLOSED AT ALL TIMES.
- 3. EMPLOYING HEPA VACUUM WHENEVER DRILLING, CUTTING, CORING, OR PERFORMING ANY WORK THAT WILL IMPACT AIR QUALITY.
- 3.2 DOCUMENTATION A. UPON REQUEST BY JPMC, THE CONTRACTOR SHALL PROVIDE PROOF OF ANY CERTIFICATIONS, TRAINING, OR UNION AFFILIATIONS.

END OF SECTION

IN ACCORDANCE WITH SAID STANDARDS.

SECTION 27 05 00 - QUALITY ASSURANCE FOR STRUCTURED CABLING JPMorgan Chase & Co.


GLOBAL TECHNOLOGY INFRASTRUCTURE END USER SERVICES WORKPLACE TECHNOLOGY SERVICES STRUCTURED CABLING ENGINEERING 1111 POLARIS PARKWAY, COLUMBUS, OHIO 43240

NEW RETAIL BRANCH -**HWY 291 AND SE** LANGSFORD RD

keyplan

FOR REFERENCE ONLY **ISSUED AND** PERMITTED BY OTHERS

issue

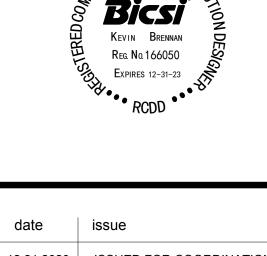

ISSUED FOR COORDINATION 12.21.2020 B 01.19.2021 ISSUED FOR CONSTRUCTION

> JP MORGAN CHASE & CO 890 NE LANGSROD RD LEE'S SUMMIT, MO 64063

> > drawn KB

TELECOM BOOK SPECS

12.21.2020

scale AS NOTED

sheet

designed KB

checked

OVP-38200P368999

SECTION 27 05 03 - TECHNOLOGY SPACE CLEANING

PART 1 - GENERAL

1.1 DESCRIPTION

- A. THIS SPECIFICATION PROVIDES THE REQUIREMENTS FOR FINAL CLEANING OF TECHNOLOGY SPACES, INCLUSIVE OF RETAIL MAIN EQUIPMENT ROOMS (RMERS), RETAIL TELECOMMUNICATIONS ROOMS (RTRS), AND STAND ALONE ATMS.
- 1.2 STANDARDS OF OPERATION
- A. CLEANING PERSONNEL ARE REQUIRED TO OBSERVE THE TECHNOLOGY ROOM STANDARDS OF OPERATIONS AT ALL TIMES. AT A MINIMUM,
- THIS INCLUDES:
- 1. NO FOOD OR DRINK IN THE ROOM 2. NO PROPPING TECHNOLOGY ROOM DOORS
- 3. NO INTERFERING WITH THE OPERATION OF TECHNOLOGY ROOM EQUIPMENT
- 4. NO UNAUTHORIZED/UN-BADGED PERSONNEL IN TECHNOLOGY ROOM
- B. WORKERS MUST WEAR CLOTHING THAT EASILY IDENTIFIES THEM AS MEMBERS OF THE CLEANING COMPANY
- C. DURING THE CLEANING, WORKERS ARE RESPONSIBLE FOR CONDUCTING THEMSELVES IN SUCH A MANNER AS TO PROTECT THE OWNER'S EQUIPMENT AND INFRASTRUCTURE AND TO AVOID CREATING HAZARDS FOR EMPLOYEES WHO ENTER THE WORK AREA.
- D. SIGNAGE OR SAFETY CONES SHOULD BE USED TO SURROUND OPEN FLOOR TILES, ELECTRICAL CORDS STRUNG ALONG THE FLOOR, AND ANY AREAS THAT ARE BEING DAMP-MOPPED.

PART 2 - PRODUCTS

- 2.1 APPROVED EQUIPMENT & MATERIALS
- A. THE CONTRACTOR WILL USE THE FOLLOWING APPROVED EQUIPMENT AND SUPPLIES:
- 1. TRIPLE-FILTRATION HIGH-EFFICIENCY PARTICULATE AIR (HEPA) OR S-CLASS VACUUMS, CAPABLE OF REMOVING 99.97 PERCENT OF PARTICLES 0.3 MICRONS OR LARGER.
- 2. CLEANING CHEMICALS THAT ARE PH NEUTRAL, STATIC DISSIPATIVE, AND APPROVED OR QUALIFIED BY COMPUTER HARDWARE
- 3. MATERIAL SAFETY DATA SHEETS MUST BE PROVIDED TO THE OWNER PRIOR TO PERFORMING WORK.
- CANNED AIR.
- 5. LINT-FREE MOPS THAT ARE APPROVED OR QUALIFIED BY COMPUTER HARDWARE MANUFACTURERS. MOPS SHOULD HAVE NONMETAL HANDLES AND SEWN ENDS, TO PREVENT SNAGGING. MOP HEADS SHOULD HAVE LOOPED ENDS, NOT ENDS THAT ARE OPEN OR STRINGY
- 6. LINT-FREE, ANTISTATIC WIPES AND TOWELS THAT ARE APPROVED OR QUALIFIED BY COMPUTER HARDWARE MANUFACTURERS.
- 7. LOW-SPEED FLOOR SCRUBBING MACHINES.
- 8. ELECTRICAL CORDS THAT ARE IN GOOD CONDITION AND POSSESS APPROPRIATE GROUND CONFIGURATION.
- A STABLE STEPLADDER WITH NON-MARKING RUBBER FEET.
- PART 3 EXECUTION
- 3.1 EQUIPMENT CLEANING PROCEDURES
- A. A HEPA VACUUM WILL BE USED TO CLEAN THE HORIZONTAL SURFACES OF ALL EQUIPMENT.
- B. CLOTHS TREATED WITH ANTISTATIC PROPERTY CHEMICAL WILL BE USED TO WIPE DOWN ALL EXTERNAL SURFACES OF ALL CABINETS. POLYSTYRENE END-ROW SHEETS, SERVERS, NETWORKING DEVICES, AND STORAGE UNITS.
- C. CHEMICALS WILL NOT BE SPRAYED DIRECTLY ONTO EQUIPMENT
- D. KEYBOARDS WILL NOT BE TOUCHED DURING CLEANINGS.
- E. CLEANING ACTIVITIES SHOULD GENERALLY PROGRESS DOWNWARD FROM THE CEILING AND OUTWARD FROM THE ROOM'S AIR HANDLERS.
- 3.2 HIGH LEVEL CLEANING PROCEDURES
- A. ALL CABLE TRAYS, LADDER RACKS, UNISTRUT, BEAMS, ETC. TO BE BLOWN THROUGH WITH COMPRESSED AIR AND WIPED DOWN WITH
- APPROPRIATE CLOTHS AND CHEMICALS.
- 3.3 LOW LEVEL CLEANING PROCEDURES
- A. VACUUM SURFACE DUST AND PARTICLES FROM THE TOP OF ALL RACEWAYS AND CABLE TRAYS THAT ARE SECURED BELOW THE ROOM'S DECK OR CEILING.
- B. MAKE NOTE OF ANY UNUSUAL CONDITIONS--LOOSE BRACKETS, DAMAGED CABLE BUNDLES, CONDENSATION, AND SO ON--AND INCLUDE THEM IN THE FINAL REPORT TO BE PROVIDED TO THE CM AND OWNER.
- 3.4 CLEANING OF TECHNOLOGY CABINETS/RACKS
- A. WIPE DOWN THE EXTERNAL SURFACES OF ALL CABINETS USING LINT-FREE CLOTHS TREATED WITH ANTISTATIC CHEMICAL. AVOID DISTURBING PATCH CORDS OR POWER CABLES, TOUCHING KEYBOARDS, MOVING HARDWARE, OR SPRAYING CHEMICALS DIRECTLY ONTO
- B. USE CANNED AIR TO DISLODGE DUST IN AREAS THAT CANNOT BE REACHED BY HAND.
- 3.5 FLOOR SURFACE CLEANING PROCEDURES
- A. WHEN CLEANING THE RAISED FLOOR, AVOID DISTURBING ANY CABLES THAT ARE ROUTED THROUGH THE NOTCHED OPENING OF FLOOR
- B. VACUUM SURFACE DUST AND PARTICLES FROM THE TOP OF ALL ACCESSIBLE PORTIONS OF THE FLOOR, INCLUDING BLANK, NOTCHED, AND PERFORATED FLOOR TILES.
- C. TREAT SMUDGES, STAINS, BLACK MARKS, AND SO ON, WITH AN APPROVED SOLUTION AND SCRUB WITH A MEDIUM-GRADE SCRUB PAD. USE AN APPROVED FLOOR MACHINE TO CLEAN ALL ACCESSIBLE PORTIONS OF THE FLOOR.
- D. LAST, MOP THE FLOOR WITH A DAMP--NOT WET--MOP USING CLEAN, WARM WATER. USE A TWO-BUCKET SYSTEM, ONE FOR MOPPING AND ONE FOR RINSING. CHANGE WATER FREQUENTLY IN BOTH BUCKETS.

END OF SECTION

3

SECTION 27 05 03 TECHNOLOGY SPACE CLEANING

SECTION 27 05 26 - GROUNDING AND BONDING FOR STRUCTURED CABLING

PART 1 - GENERAL

- 1.1 DESCRIPTION
- A. JPMC'S REAL ESTATE GROUP IS RESPONSIBLE FOR PROPER INSTALLATION OF A GROUNDING (EARTHING) BACKBONE THAT HAS BEEN DESIGNED AND INSTALLED IN ACCORDANCE WITH J-STD-607 OR EQUIVALENT REGIONAL STANDARD. IF SUCH GROUNDING (EARTHING) BACKBONE DOES NOT APPEAR TO BE IN PLACE, CONTRACTOR SHALL INFORM OPR, WHO WILL TAKE ACTION AS APPROPRIATE.
- B. ALL BONDING AND GROUNDING (EARTHING) SHALL TRACK METHODS AND PROCEDURES DESCRIBED IN J-STD-607 OR EQUIVALENT REGIONAL STANDARD.

PART 2 - PRODUCTS

- 2.1 MATERIALS
- A. COMPONENTS: SEE THE GROUNDING SCHEMATIC ON DRAWINGS FOR MANUFACTURERS AND PART NUMBERS.
- B. ALL GROUNDING/BONDING CONDUCTORS SHALL BE COPPER (NO ALUMINUM ALLOWED).
- PART 3 EXECUTION
- 3.1 SEE THE GROUNDING SCHEMATIC ON DRAWINGS FOR CONTRACTOR REQUIREMENTS

END OF SECTION

SECTION 27 05 26 - GROUNDING AND BONDING FOR STRUCTURED CABLING

SECTION 27 05 53 - IDENTIFICATION FOR STRUCTURED CABLING

PART 1 - GENERAL

- 1.1 DESCRIPTION
- A. SYSTEM ACCEPTANCE SHALL BE WITHHELD UNTIL OPR HAS REVIEWED AND APPROVED ALL LABELING AS DEFINED ELSEWHERE IN THIS SECTION.
- B. IN CASES WHERE 100 PERCENT OF THE CABLING INFRASTRUCTURE IS NEW, ALL LABELING SHALL BE PERFORMED IN ACCORDANCE WITH THIS SECTION 27 05 53. IN CASES WHERE NEW INFRASTRUCTURE IS BEING ADDED TO AN EXISTING (LEGACY) INFRASTRUCTURE THAT FOLLOWS AN EARLIER VERSION JPMC CABLING STANDARD, CONTRACTOR SHALL FURNISH TO OPR A DETAILED DESCRIPTION OF DEVIATIONS FROM THE PREVAILING RETAIL STRUCTURED CABLING STANDARD, AND UPON OPR WRITTEN APPROVAL, FOLLOW INSTEAD THE LEGACY LABELING STANDARD.
- C. BECAUSE THE CABLE INFRASTRUCTURE IS A COMPREHENSIVE, INTEGRATED DESIGN, PROPER AND COMPREHENSIVE LABELING IS CRITICAL. TO ENSURE THE SUCCESS OF THIS COMPONENT OF THE SYSTEM DESIGN, ALL LABELS SHALL BE FULLY COMPLIANT WITH THE REQUIREMENTS SET FORTH IN THIS SECTION. CONTRACTOR IS RESPONSIBLE FOR FURNISHING AND INSTALLING ALL LABELS AND LABEL HOLDERS AS SPECIFIED HEREIN.
- D. ALL LABELS SHALL BE INSTALLED IN ACCORDANCE WITH INFORMATION CONTAINED IN PROJECT DRAWINGS AND AS SPECIFIED IN THIS SECTION.
- E. THIS SPECIFICATION SETS FORTH GENERAL REQUIREMENTS FOR INFRASTRUCTURE IDENTIFICATION, NOT SPECIFIC NUMBERING SCHEMES. BEFORE THE LABELING PROCESS BEGINS, CONTRACTOR SHALL SUBMIT A WRITTEN PLAN THAT INCLUDES SPECIFIC NUMBERING SEQUENCES FOR EACH TELECOMMUNICATIONS ELEMENT, AND SHALL NOT PROCEED WITH THE PLAN UNTIL OPR FURNISHES WRITTEN APPROVAL OF SAID PLAN WHICH MAY CONTAIN STANDARDS-BASED MODIFICATIONS.

PART 2 - PRODUCTS

- 2.1 GENERAL MATERIAL REQUIREMENTS
- A. ALL LABELS SHALL BE INDELIBLE, PRE-PRINTED (NOT HAND-WRITTEN), AND PERMANENT, USING BRADY PRINTER OR EQUIVALENT, ARIAL FONT OR EQUIVALENT. THE TEXT COLOR SHALL BE BLACK WITH A WHITE BACKGROUND, UNLESS AFFIXED ON A BLACK SURFACE, IN WHICH CASE THE LABEL BACKGROUND SHALL BE BLACK AND TEXT SHALL BE WHITE.

PART 3 - EXECUTION

- 3.1 SYSTEM DESCRIPTION
- A. THE FOLLOWING INFRASTRUCTURE COMPONENTS SHALL BE INCLUDED AND FULLY LABELED IN THE IDENTIFICATION SCHEMA:
- INFORMATION OUTLET FACEPLATES
- 2. HORIZONTAL CABLING
- 3. COPPER PATCH PANELS
- 4. BACKBONE CABLING
- 5. FIBER PATCH PANELS
- RACKS
- 7. POWER DISTRIBUTION UNITS AND POWER STRIPS
- 8. IT EQUIPMENT ASSET TAGS
- 9. CONDUIT AND SLEEVE PATHWAYS

3.2 INFORMATION OUTLET FACEPLATES

- A. EACH INFORMATION OUTLET IDENTIFIER SHALL BE NUMBERED IN ACCORDANCE WITH THE FACEPLATE LABELING CONFIGURATION DETAIL, USING PAPER LABELS AND CLEAR WINDOWS INCLUDED WITH EACH APPROPRIATE INFORMATION OUTLET FACEPLATE. WHERE CLEAR WINDOWS ARE NOT APPLICABLE, CONTRACTOR SHALL COORDINATE A COMPLIANT LABEL THAT IS RESISTANT TO DAMAGE OR DEGRADATION OVER TIME (E.G. VINYL). TEXT HEIGHT AND POSITIONING SHALL BE IN ACCORDANCE WITH THE FACEPLATE LABELING CONFIGURATION DETAIL.
- B. VOICE AND DATA OUTLETS SHALL BE LOCATED IN EACH FACEPLATE IN ACCORDANCE WITH THE FACEPLATE LABELING CONFIGURATION DETAIL.
- 3.3 HORIZONTAL CABLING
- A. LABELS TO BE AFFIXED AT EVERY USED PATCH PANEL AND ON EACH HORIZONTAL CABLE ON BOTH ENDS.
- NOMENCLATURE: X#Y##
- a. WHERE X = RMER/RTR DESIGNATION, USE "M" FOR RMER AND "T" FOR RTR.
- b. WHERE # = RACK DESIGNATION (NUMERIC).
- c. WHERE Y = A SINGLE SEQUENTIAL ALPHA CHARACTER, BEGINNING WITH "A", IDENTIFYING THE PATCH PANEL
- d. WHERE ## = TWO-DIGIT SEQUENTIAL NUMBER BEGINNING WITH "01", IDENTIFYING PATCH PANEL PORT NUMBER
- B. COPPER PATCH PANEL PORT IDENTIFICATION SHALL BE FULLY COMPLIANT WITH THE FACEPLATE LABELING CONFIGURATION DETAIL C. IF LABEL IS AFFIXED TO A BLACK OR DARK GRAY SURFACE, LABEL INFORMATION SHALL BE WHITE IN COLOR. IF LABEL IS AFFIXED TO BEIGE
- OR LIGHT-COLORED SURFACE, LABEL INFORMATION SHALL BE BLACK IN COLOR. D. COPPER PATCH PANEL LABELS SHALL EMPLOY MANUFACTURER-SUPPLIED LABELING MATERIALS AND COVERS (IF APPLICABLE), AFFIXED TO
- EACH PANEL IN ACCORDANCE WITH MANUFACTURER SPECIFICATIONS.
- E. COPPER PATCH PANEL LABELS SHALL BE WHITE IN COLOR.
- 3.4 BACKBONE CABLING
- A. THE CABLE SHALL BE LABELED ON BOTH ENDS.
- B. NOMENCLATURE: SOURCE = X-#-ZZ AND DESTINATION = X-Y-ZZ-##/##-TTT
- WHERE X = RMER OR RTR DESIGNATION.
- WHERE # = RACK DESIGNATION.
- 3. WHERE ZZ = PATCH PANEL DESIGNATION (RACK UNIT # FROM UPPER LEFT CORNER WHEN PANEL IS INSTALLED). 4. WHERE ##/## = STARTING STRAND NUMBER/END STRAND NUMBER.
- 5. WHERE TTT = FIBER TYPE, OM2, OM3, OR OM4 FOR MULTIMODE OR OS2 FOR SINGLE MODE.
- C. WHERE ROUTE DIVERSITY IS EMPLOYED DESIGNATION STRIPS LOCATED ON TERMINATION PANELS FOR EACH ROUTE SHALL BE OF DISTINCTLY DIFFERENT COLORS.
- 3.5 FIBER PATCH PANELS
- A. THE PATCH PANEL SHALL BE LABELED ON THE FRONT DOOR.
- NOMENCLATURE: ZZ
- a. WHERE ZZ = PATCH PANEL DESIGNATION (RACK UNIT # FROM THE UPPER LEFT CORNER WHERE THE PANEL IS INSTALLED.
- b. WITHIN THE PATCH PANEL (BEHIND THE FRONT DOOR). c. NOMENCLATURE: SOURCE = X-#-ZZ AND DESTINATION = ZZ-##/##-TTT
- d. WHERE X = RMER DESIGNATION, WHICH IS "M".
- e. WHERE # = RACK DESIGNATION.
- f. WHERE ZZ = PATCH PANEL DESIGNATION (RACK UNIT # FROM UPPER LEFT CORNER WHEN PANEL IS INSTALLED).
- g. WHERE ##/## = STARTING STRAND NUMBER/END STRAND NUMBER. h. WHERE TTT = FIBER TYPE, OM2, OM3, OR OM4 FOR MULTIMODE OR OS2 FOR SINGLE MODE.

3.6 RACKS

- A. LABELS TO BE AFFIXED TO TOP FRONT AND TOP REAR OF RACK NOMENCLATURE: X#
 - a. WHERE X = RMER/RTR DESIGNATION, USE "M" FOR RMER AND "T" FOR RTR.
- b. WHERE # = RACK DESIGNATION (NUMERIC) c. TYPE: 1.5 IN. (38 MM) TEXT; MACHINE PRINTED TEXT. BLACK TEXT ON WHITE BACKGROUND.

SECTION 27 05 53 IDENTIFICATION FOR STRUCTURED CABLING

3.7 POWER DISTRIBUTION UNITS AND POWER STRIPS

A. CONDUIT PATHWAY LABELING SHALL BE LABELED AS FOLLOWS.

B. SLEEVE PATHWAY LABELING SHALL BE LABELED AS FOLLOWS.

2. NOMENCLATURE <SIZE>.<PATHWAY TYPE>. EXAMPLE: 4" SLEEVE

3.8 IT EQUIPMENT ASSET TAGS

3.9 CONDUIT AND SLEEVE PATHWAYS

A. POWER DISTRIBUTION UNITS AND STRIPS SHALL BE LABELED WITH THE BREAKER PANEL ID AND CIRCUIT NUMBER IT IS SERVED FROM.

1. 1.5 IN. (38 MM) TALL TEXT PLACED IN VISIBLE LOCATION ON PLASTIC BUSHING OR ON THE CONDUIT ITSELF NEAR THE END.

1. 1.5 IN. (38 MM) TALL TEXT PLACED IN VISIBLE LOCATION ON PLASTIC BUSHING OR ON THE SLEEVE ITSELF NEAR BOTH ENDS.

END OF SECTION

THE TOP FRONT IN A VISIBLE AREA THAT CAN BE EASILY ACCESSED WITH A BARCODE SCANNER.

2. NOMENCLATURE <SIZE>.<PATH A/B>TO<DISTANT END ROOM ID>. EXAMPLE: 4" A TO I-1

B. THESE ASSET TAGS WILL BE PROVIDED BY SOMEONE OTHER THAN THE STRUCTURED CABLING CONTRACTOR.

A. ALL POWERED IT EQUIPMENT, ASIDE FROM AUDIO-VISUAL OR CARRIER EQUIPMENT MUST BE LABELED WITH THE DEVICES HOSTNAME AND A

YELLOW ASSET TAG ON THE FRONT (COLD AISLE) SIDE OF THE DEVICE. A MACHINE GENERATED LABEL INDICATING THE SERIAL NUMBER OF THE DEVICE SHALL ALSO BE PLACED ON THE FRONT (COLD AISLE) SIDE OF THE DEVICE. ALL RACKS MUST HAVE A YELLOW ASSET TAG AT

JPMorgan Chase & Co

GLOBAL TECHNOLOGY INFRASTRUCTURE END USER SERVICES WORKPLACE TECHNOLOGY SERVICES STRUCTURED CABLING ENGINEERING 1111 POLARIS PARKWAY, COLUMBUS, OHIO 43240

NEW RETAIL BRANCH -**HWY 291 AND SE** LANGSFORD RD

keyplan

FOR REFERENCE ONLY **ISSUED AND** PERMITTED BY OTHERS

seal



issue 12.21.2020 ISSUED FOR COORDINATION 01.19.2021 ISSUED FOR CONSTRUCTION

site location JP MORGAN CHASE & CO 890 NE LANGSROD RD LEE'S SUMMIT, MO 64063

designed KB 12.21.2020 checked scale AS NOTED

TELECOM BOOK SPECS

OVP-38200P368999

PART 1 - GENERAL

1.1 DESCRIPTION

A. THIS SECTION SPECIFIES TECHNOLOGY INFRASTRUCTURE EQUIPMENT INCLUDING THE FOLLOWING

- J-HOOKS.
- CONDUITS AND BOXES
- INNERDUCT
- PULL BOXES.
- FIRE-RATED SLEEVES. MISC. ACCESSORIES.

2.1 GENERAL MATERIAL REQUIREMENTS

PART 2 - PRODUCTS

A. NEW MATERIALS

1. ALL CABLE AND MATERIALS SHALL BE NEW, UNLESS PREVIOUSLY APPROVED IN WRITING BY OPR. NEW EQUIPMENT AND MATERIALS SHALL BE WITHOUT BLEMISH OR DEFECT. NEW EQUIPMENT AND MATERIALS SHALL BE UNDERWRITERS LABORATORIES, INC. (U.L.) LABELED AND/OR LISTED WHERE SPECIFICALLY CALLED FOR, OR WHERE NORMALLY SUBJECT TO SUCH U.L. LABELING AND/OR LISTING SERVICES.

B. EQUIVALENTS

1. IT IS THE SOLE RESPONSIBILITY OF THE CONTRACTOR TO ENSURE THAT ALL PRODUCTS INSTALLED AT THIS FACILITY ARE COMPATIBLE WITH THE APPLICATION. THE OWNER MAKES NO REPRESENTATION REGARDING THE ACCURACY OF THE PART NUMBERS LISTED.

C. SUBSTITUTIONS

1. MATERIALS SHALL BE AS LISTED. NO SUBSTITUTIONS ARE ALLOWED WITHOUT WRITTEN CONSENT FROM THE JPMC STRUCTURED CABLING ENGINEERING TEAM. PROPOSALS FOR EQUIVALENT PRODUCTS MUST BE PRESENTED TO THE OPR VIA RFI'S, SUBMITTALS, AND/OR SHOP DRAWINGS. OPR WRITTEN APPROVAL IS REQUIRED BEFORE ANY SUBSTITUTIONS ARE MADE. MATERIALS MUST BE COMPATIBLE WITH THE END-TO-END SOLUTION BEING PROPOSED.

D. FIRE RATING

1. INNERDUCT SHALL BE RATED FOR THE PURPOSE. INNERDUCT LISTED IN THIS SECTION IS NOT PLENUM RATED. CONTRACTOR SHALL EXERCISE DILIGENCE IN ENSURING THAT THE INNERDUCT INSTALLED MEETS THE REQUIREMENTS OF AUTHORITIES HAVING JURISDICTION.

2. LOCAL OR NATIONAL CODES MAY OR MAY NOT REQUIRE PLENUM OR LOW SMOKE ZERO HALOGEN IN SOME APPLICATIONS. IT IS CONTRACTOR'S RESPONSIBILITY TO INSTALL MATERIALS THAT ARE APPROPRIATE TO THE ENVIRONMENT. IF CONTRACTOR INSTALLS INNERDUCT OR SOFT DUCT THAT IS INAPPROPRIATE TO THE ENVIRONMENT (E.G. PLENUM-RATED IN SPACES THAT DO NOT REQUIRE PLENUM, OR NON-PLENUM-RATED IN SPACES THAT REQUIRE PLENUM), CONTRACTOR SHALL BE EXPECTED TO REMOVE THE INAPPROPRIATE INNERDUCT OR SOFT DUCT AND INSTALL APPROPRIATE INNERDUCT OR SOFT DUCT AT THEIR SOLE EXPENSE.

2.2 J-HOOKS

A. REQUIREMENTS:

ABOVE ALL ACCESSIBLE CEILINGS, J-HOOKS ARE REQUIRED FOR PROPER CABLE SUPPORT.

- 2. J-HOOKS SHALL BE SPECIFICALLY DESIGNED FOR INTERIOR USE WITH DATA CABLES.
- 3. J-HOOKS SHALL BE PROVIDED AS REQUIRED WITH ALL THE MANUFACTURER'S RECOMMENDED INSTALLATION HARDWARE FOR THE INSTALLATION APPLICATION.
- APPROVED J-HOOK MANUFACTURERS ARE COOPER, CADDY, OR PANDUIT.
- B. SEE THE OPEN CABLE SUPPORT DETAIL ON THE CONSTRUCTION DRAWINGS FOR MANUFACTURERS AND PART NUMBERS FOR J-HOOK MOUNTING COMPONENTS.

2.3 CONDUITS AND BOXES

A. CONDUIT

- ALL WIRING IN THE BUILDING INTERIOR, INCLUDING HORIZONTAL DISTRIBUTION, VERTICAL RISER CONDUITS AND AUXILIARY WIRING MAY BE RUN IN EMT CONDUIT UNLESS OTHERWISE SPECIFIED. CONDUIT SIZES LARGER THAN 4" SHALL BE RIGID METALLIC CONDUIT
- 2. EMT SHALL NOT BE USED IN POURED CONCRETE, UNDERGROUND, IN UTILITY TUNNELS OR EXPOSED IN MECHANICAL EQUIPMENT ROOM
- 3. ALL EMT CONNECTORS AND COUPLINGS SHALL BE OF THE SETSCREW TYPE. ALL FITTINGS SHALL BE STEEL. NO DIE CAST FITTINGS WILL BE ALLOWED.

B. BOXES

- 1. THE OUTLET BACKBOXES SHALL BE 5" SQUARE BY 2.875" DEEP WITH A SINGLE GANG REDUCER AND INTEGRAL CABLE MANAGEMENT THE DEPTH OF THE RAISED SINGLE GANG REDUCER SHALL BE DETERMINED BY THE THICKNESS OF THE WALL MATERIAL THAT THE OUTLET BOX WILL BE INSTALLED WITHIN. THE CONTRACTOR SHALL COORDINATE THIS DIMENSION WITH THE GENERAL CONTRACTOR.
- 2. SEE THE SYMBOLS LIST ON THE CONSTRUCTION DRAWINGS FOR MANUFACTURERS AND PART NUMBERS.

2.4 INNERDUCT

- A. INNERDUCT IS A NONMETALLIC RACEWAY PLACED WITHIN A LARGER RACEWAY. FOR THE PURPOSES OF THIS SECTION, FOR THIS PROJECT FABRIC INNERDUCT SHALL BE USED. HARD SIDED INNERDUCT SHALL NOT BE USED UNLESS PERMISSION IS EXPLICITLY PROVIDED BY THE STRUCTURED CABLING ENGINEER. IF MULTIPLE CABLES ARE TO BE PULLED THROUGH A SINGLE INNERDUCT CELL. THEY SHOULD BE PULLED AT THE SAME TIME. FABRIC INNERDUCT PROVIDES MULTIPLE SLEEVES WITHIN CONDUITS AND EMPTY CELLS SHOULD BE PROVIDED FOR FUTURE GROWTH.
- 1. FABRIC INNERDUCT SHALL BE INSTALLED WITHIN CONDUIT.
- 2. CONTRACTOR SHOULD COORDINATE A SITE VISIT FROM THE FABRIC INNERDUCT MANUFACTURER TO OVERSEE THE INSTALLATION WHEN 1) THE CONTRACTOR HAS NEVER UTILIZED THIS PRODUCT IN THE PAST; OR 2) WHEN THE AGGREGATE LENGTH OF THE INSTALLATION EXCEEDS 1,500 M (5,000 FT.).
- B. FABRIC INNERDUCT SIZING
- 1. THE FABRIC INNERDUCT SHALL BE SIZED FOR THE CONDUIT IT IS BEING INSTALLED WITHIN.

C. FABRIC INNERDUCT

- 1. STANDARD OUTDOOR FABRIC INNERDUCT: MICRO (33MM), 2-INCH, 3-INCH AND 4-INCH SINGLE OR MULTI-CELL POLYESTER/NYLON FABRIC INNERDUCT CONTAINING 1250 LB. POLYESTER FLAT WOVEN PULL TAPE.
- 2. DETECTABLE OUTDOOR FABRIC INNERDUCT: MICRO (32MM), 2-INCH, 3-INCH AND 4-INCH SINGLE OR MULTI-CELL POLYESTER/NYLON FABRIC INNERDUCT CONTAINING 1250 LB. POLYESTER FLAT WOVEN PULL TAPE, AND A SOLID COPPER, POLYVINYL COLOR COATED CONDUCTOR (19AWG MINIMUM) FOR TRACING AND RATED FOR A MINIMUM OF 6 AMPS AND 600 VOLTS. CONDUCTOR SHALL BE PLACED IN THE SIDEWALL EDGE FOLD OF THE TEXTILE SLEEVE. DETECTABLE FABRIC INNERDUCT SHALL BE UTILIZED WHEN RUNNING FIBER OPTIC CABLING WITHIN NON-METALLIC UNDERGROUND CONDUITS.
- 3. INDOOR FABRIC INNERDUCT (RISER-LISTED): MICRO (32MM), 2-INCH, 3-INCH AND 4-INCH SINGLE OR MULTI-CELL NYLON FABRIC INNERDUCT CONTAINING 1250 LB. POLYESTER FLAT WOVEN PULL TAPE WHICH MEETS UL2024A FOR FLAME PROPAGATION AND SMOKE DENSITY VALUES FOR GENERAL APPLICATIONS.
- 4. PLENUM-LISTED FABRIC INNERDUCT: MICRO (32MM), 2-INCH AND 3-INCH SINGLE OR MULTI-CELL NYLON FABRIC INNERDUCT CONTAINING 200LB NYLON-RESIN FLAT WOVEN PULL TAPE WHICH MEETS UL2024A FOR FLAME PROPAGATION AND SMOKE DENSITY VALUES FOR USE IN AIR HANDLING SPACES.

D. FABRIC INNERDUCT FITTINGS

- 1. CONDUIT PLUGS: COMPRESSION-TYPE CONDUIT PLUGS WITH LOCKING NUTS FOR SEALING AND SECURING ONE OR MORE FABRIC INNERDUCTS WITHIN A 4-INCH INSIDE DIAMETER CONDUIT, E.G.: a. 4-INCH PLUG WITH NINE HOLES FOR CABLES IN A 3 PACK (9-CELL) CONFIGURATION
- 2. TERMINATION BAGS: INFLATION-TYPE BAGS FOR SEALING AND SECURING AROUND ONE OR MORE FABRIC INNERDUCTS AND CABLES WITHIN 2-INCH OUTSIDE DIAMETER OR LARGER CONDUIT.

6

2.5 PULL BOXES

- A. PULL BOXES SHALL BE MANUFACTURED FOR USE AS A JUNCTION BOX AND PULL BOX IN COMMERCIAL AND GENERAL INDUSTRIAL APPLICATIONS.
- B. COVERS SHALL BE SECURED TO THE ENCLOSURE BODY WITH PLATED SCREWS THROUGH KEYHOLE SLOTS PROVIDED IN THE COVER.
- C. FINISH SHALL BE A PHOSPHATE UNDERCOAT WITH ANSI 61 GRAY ACRYLIC FINISH.
- D. PULL BOXES SHALL COMPLY WITH NEMA STANDARDS TYPE 1
- E. PULL BOXES SHALL BE PROVIDED IN THE SIZES AS INDICATED ON THE PLANS. PULL BOXES SHALL HAVE HOLES PUNCHED OR CORED THROUGH THE ENCLOSURE BODY TO PROVIDE ACCESS INTO THE ENCLOSURE FOR THE CONDUITS INDICATED ON THE PLANS.

2.6 FIRE-RATED SLEEVES

- A. CABLES PASSING THROUGH RMER/RTR FLOORS OR WALLS SHALL PASS THROUGH FIRE-RATED WIRING DEVICES WHICH CONTAIN AN INTUMESCENT INSERT MATERIAL THAT ADJUSTS AUTOMATICALLY TO CABLE ADDITIONS OR SUBTRACTIONS.
- B. THE DEVICE (PER CODE REQUIREMENTS) SHALL INCLUDE BOTH INTERNAL AND EXTERNAL FIRESTOPPING.
- C. CABLES PENETRATING THROUGH RMER/RTR FLOORS OR WALLS SHALL UTILIZE FIRE-RATED PATHWAY DEVICES CAPABLE OF PROVIDING AN F RATING EQUAL TO THE RATING OF THE BARRIER IN WHICH THE DEVICE IS INSTALLED.
- D. THE DEVICE SHALL BE TESTED FOR SMOKE LEAKAGE (L RATING) AND SHALL NOT REQUIRE THE USE OF ANY OPTIONAL SEALING MATERIALS TO ACHIEVE THE PUBLISHED RATING.
- E. THE DEVICE SHALL UTILIZE A FIRE AND SMOKE SEALING SYSTEM THAT AUTOMATICALLY ADJUSTS TO THE ADDITION OR REMOVAL OF CABLES.
- F. WIRE DEVICES SHALL BE OF A SUFFICIENT SIZE TO ACCOMMODATE THE QUANTITY AND SIZE OF DATA CABLES REQUIRED AND SHALL BE SUITABLE FOR USE WITH NEW OR EXISTING CABLE INSTALLATIONS.
- G. THE INSTALLED DEVICE (IN NORMAL USE) SHALL REQUIRE NO MAINTENANCE AND SHALL ACCOMMODATE FUTURE CABLE CHANGES WITHOUT MECHANICAL ADJUSTMENT AND/OR REMOVAL OR REPLACEMENT OF PROTECTIVE MATERIALS.
- H. WIRE DEVICES TO BE PROVIDED WITH STEEL WALL PLATES ALLOWING FOR SINGLE OR MULTIPLE DEVICES TO BE GANGED TOGETHER
- I. THE DEVICE SHALL BE MODULAR AND SHALL PROVIDE MECHANICAL INSTALLATION OPTIONS FOR COMMON WALL AND FLOOR CONSTRUCTIONS AS WELL AS COMMON CONSTRUCTION CONDITIONS INCLUDING OVER-SIZED OR DAMAGED OPENINGS OR EXISTING
- J. INSTALL RADIUS CONTROL MODULES (RCM) ON ALL HORIZONTAL DEVICES. THE RCM'S PROVIDE A 1" MINIMUM BENDING RADIUS FOR CABLES.

K. COMPONENTS

WALL OR FLOOR SLEEVES: SPECIFIED TECHNOLOGIES INC. EZ-PATH SERIES CABLE RADIUS CONTROL WATERFALLS: SPECIFIED TECHNOLOGIES INC. RCM SERIES

2.7 MISCELLANEOUS ACCESSORIES

A. PULL STRING

PULL STRINGS: CONSTRUCTED OF SYNTHETIC FIBER.

B. PULL TAPE

1. PULL TAPE: MEASURING AND PULLING TAPE CONSTRUCTED OF SYNTHETIC FIBER, PRINTED WITH ACCURATE SEQUENTIAL FOOTAGE MARKS. COLOR-CODED.

C. PENETRATION SEALING MATERIALS

1. DUCT WATER SEAL: PRODUCTS SUITABLE FOR CLOSING UNDERGROUND AND ENTRANCE CONDUIT OPENINGS WHERE INNERDUCT OR CABLE IS INSTALLED, TO PREVENT ENTRY OF GASES, LIQUIDS, OR RODENTS INTO THE STRUCTURE.

PART 3 - EXECUTION

3.1 HANGERS AND SUPPORTS

- A. J-HOOKS SHALL BE INSTALLED WITHIN (1) ONE FOOT OF THE BUSHED CONDUIT ENDS STUBBED ABOVE THE CEILING AND WITHIN (1) ONE FOOT OF ANY BEND GREATER THAN 60 DEGREES.
- B. J-HOOKS SHALL BE INSTALLED WITH A MAXIMUM CENTER TO CENTER DISTANCE OF (4) FOUR FEET.
- C. ALL J-HOOKS SHALL BE ATTACHED SECURELY TO THE CEILING JOISTS OR CONCRETE DECK ABOVE UTILIZING THE MANUFACTURER'S RECOMMENDED HARDWARE AND INSTALLATION PRACTICES. CONTRACTOR SHALL UTILIZE UNISTRUT AND THREADED ROD ASSEMBLIES TO MAINTAIN THE (4) FOUR-FOOT CENTER TO CENTER REQUIREMENT BETWEEN CEILING JOIST MEMBERS AS REQUIRED

3.2 CONDUIT AND BOXES

- A. ALL CONDUITS ENTERING CABINETS, PULL BOXES, JUNCTION BOXES OR OUTLET BOXES SHALL BE SECURED WITH SET-SCREW TYPE BOX CONNECTORS.
- B. THE ENDS OF ALL CONDUITS UTILIZED FOR COMMUNICATIONS CABLING SHALL BE PROVIDED WITH NYLON PUSH-ON BUSHINGS AND A PULL STRING PROVIDED THROUGHOUT.
- C. EXTERIOR CONDUITS FOR TELECOMMUNICATIONS SERVICE PROVIDERS (CARRIERS) SHALL HAVE A PULL TAPE INSTALLED BY THE ELECTRICAL CONTRACTOR.
- D. ALL EXTERIOR CONDUITS SHALL BE SEALED AT THE OPENING WITHIN THE BUILDING BY THE ELECTRICAL CONTRACTOR.
- E. ALL CONDUIT RUNS SHALL HAVE A MAXIMUM OF TWO (2) 90-DEGREE BENDS PER CONDUIT RUN. WHEN MORE BENDS ARE NECESSARY IN A SINGLE RUN A PULL BOX SHALL BE INSTALLED. PULL BOXES SHALL NOT BE INSTALLED IN PLACE OF A 90-DEGREE BEND. PULL BOXES SHALL ALSO BE INSTALLED IN LONG RUNS AT A MAXIMUM SEPARATION OF 100'.
- F. ALL CONDUITS, EXCEPT IN CONCRETE SLAB OR EARTH, SHALL BE ROUTED PARALLEL AND PERPENDICULAR TO THE COLUMN LINES OF THE
- G. CONDUITS THAT ARE NOT INSTALLED PLUMB AND ROUTED PERPENDICULAR TO THE STRUCTURAL COLUMN SUPPORTS OF THE BUILDING WILL NOT BE ACCEPTED.
- H. UNLESS OTHERWISE NOTED, ALL CONDUITS SHALL BE RUN CONCEALED WITHIN THE BUILDING CONSTRUCTION WHEN INSTALLED IN FINISHED INTERIOR OR EXTERIOR AREAS. I. ALL CONDUITS SHALL BE SUBSTANTIALLY SUPPORTED BY USE OF PIPE STRAPS, SUITABLE CLAMPS OR HANGERS ATTACHED TO ELEMENTS

OF THE BUILDING STRUCTURE TO PROVIDE A RIGID INSTALLATION. UNDER NO CIRCUMSTANCE SHALL CONDUIT BE ATTACHED OR

SUPPORTED FROM ADJOINING PIPE OR INSTALLED IN SUCH A MANNER AS TO PREVENT THE READILY REMOVAL OF OTHER PIPE FOR

- REPAIRS. J. UNLESS OTHERWISE NOTED, INSTALL ALL OUTLET BOXES VERTICALLY.
- K. INSTALL OUTLET BOXES AT THE MOUNTING HEIGHTS INDICATED ON THE PLANS. COMMUNICATION OUTLET BOXES ADJACENT TO ELECTRIC OUTLETS SHALL BE INSTALLED AT THE SAME MOUNTING HEIGHT. ANY DISCREPANCY SHALL BE BROUGHT TO THE ATTENTION OF THE ARCHITECT AND ENGINEER PRIOR TO ROUGH-IN.

3.3 PULL BOXES

- A. PULL BOXES SHALL BE PROVIDED IN THE SIZES AS INDICATED ON THE PLANS.
- B. PULL BOXES SHALL HAVE HOLES PUNCHED OR CORED THROUGH THE ENCLOSURE BODY TO PROVIDE ACCESS INTO THE ENCLOSURE FOR THE CONDUITS INDICATED ON THE PLANS.
- C. ALL CONDUITS ENTERING THE PULL BOX SHALL BE SECURED WITH SET-SCREW TYPE BOX CONNECTORS.
- D. PULL BOXES SHALL BE INSTALLED IN SUCH A MANNER THAT PROVIDES EASY ACCESS INTO THE INSTALLED ENCLOSURE THROUGH THE REMOVABLE COVER.
- E. UNDER NO CIRCUMSTANCE SHALL A PULL BOX BE INSTALLED WITH THE COVER FACING UP. UNLESS CONDUITS ENTERING THE BOX MUST BE STACKED VERTICALLY, ALL PULL BOXES SHALL BE INSTALLED WITH THE COVER FACING DOWN. F. PULL BOX LOCATIONS SHALL BE COORDINATED WITH OTHER TRADES TO PROVIDE ADEQUATE CLEARANCE BETWEEN THE PULL BOX COVER

END OF SECTION

AND ANY OTHER OBJECT. THE MINIMUM CLEARANCE REQUIRED SHALL BE SIX TIMES THE DIAMETER OF THE LARGEST CONDUIT ENTERING

THE PULL BOX.

SECTION 27 11 00 - EQUIPMENT ROOM FITTINGS FOR STRUCTURED CABLING

PART 1 - GENERAL

1.1 DESCRIPTION

- A. THIS SECTION INCLUDES RMER/RTR EQUIPMENT RACKS, CABLE MANAGERS, LADDER RACKS, POWER DISTRIBUTION UNITS, PLYWOOD BACKBOARDS, AND ASSOCIATED COMPONENTS.
- B. THIS SPECIFICATION CONTAINS ALL PRODUCTS CURRENTLY APPROVED BY JPMC. THE CONTRACTOR SHOULD NOT ASSUME THAT ALL OF THE MATERIALS LISTED IN THE SPECIFICATIONS MUST BE INSTALLED BECAUSE THEY ARE LISTED IN THE SPECIFICATION. PROJECT-SPECIFIC REQUIRED MATERIALS ARE FURTHER DEFINED IN THE PROJECT CONSTRUCTION DRAWINGS.

PART 2 - PRODUCTS

- 2.1 REQUIREMENTS
- A. IN LOCATIONS THAT REQUIRE SEISMIC BRACING, CONSULT WITH THE OPR FOR GUIDANCE AND PRODUCT REQUIREMENTS.
- B. AS PART OF THEIR BASE QUOTATION, THE CONTRACTOR IS RESPONSIBLE FOR FURNISHING AND INSTALLING ALL MISCELLANEOUS HARDWARE (E.G. CAGE NUTS, SCREWS), REQUIRED TO ACCOMPLISH A COMPLETE WORKING INSTALLATION.
- C. WHERE ONE EQUIPMENT RACK IS INSTALLED, MOUNT ONE 6" VERTICAL CABLE MANAGER ON BOTH SIDES OF THE EQUIPMENT
- D. WHERE TWO EQUIPMENT RACKS ARE INSTALLED, MOUNT ONE 6" VERTICAL CABLE MANAGER ON BOTH ENDS OF THE ROW, AND ONE 10" VERTICAL CABLE MANAGER BETWEEN RACKS.
- E. WHERE A WALL MOUNTED EQUIPMENT CABINET IS INSTALLED, PROVIDE INTERNAL VERTICAL CABLE MANAGERS.

2.2 MATERIALS

- A. SEE THE RACK ELEVATIONS AND RACK EQUIPMENT SCHEDULE ON THE CONSTRUCTION DRAWINGS FOR MANUFACTURERS AND PART NUMBERS FOR THE FOLLOWING EQUIPMENT:
- 1. EQUIPMENT RACK AND ASSOCIATED COMPONENTS
- 2. CABLE MANAGEMENT RACK MOUNTED
- LADDER RACK AND ASSOCIATED COMPONENTS
- 4. POWER DISTRIBUTION UNITS (PDUS) FOR RMERS AND RTRS
- 5. POWER DISTRIBUTION UNITS (PDUS) FOR STAND ALONE ATM LOCATIONS 6. EQUIPMENT CABINET AND ASSOCIATED COMPONENTS
- 7. CABLE MANAGEMENT CABINET MOUNTED
- 8. POWER STRIPS FOR WALL MOUNTED CABINETS B. PLYWOOD BACKBOARDS
- 1. PROVIDE VOID-FREE, FIRE-RATED PLYWOOD MOUNTED VERTICALLY ON THE WALL. PLYWOOD BOARDS SHALL BE 3/4" THICK, 8' TALL, AND WIDTH AS SHOWN ON THE PLANS TO FIT THE ROOM.
- 2. EITHER FIRE RATED (WITH A UL FR-S CLASSIFICATION), OR IF NON-FIRE-RATED AND IF ACCEPTABLE TO THE AHJ -COVERED WITH TWO COATS OF FIRE-RETARDANT PAINT ON BOTH SIDES AND EDGES. FOR FIRE-RATED PLYWOOD THE CLASSIFICATION STAMP MUST NOT BE OBSCURED.

PART 3 - EXECUTION

3.1 INSTALLATION

- A. ALL RELAY RACKS, LADDER RACK, AND CABLE TRAY SHALL BE BONDED TO GROUND IN ACCORDANCE WITH MANUFACTURER SPECIFICATIONS, AND PREVAILING CODES AND STANDARDS. SEE SECTION 27 05 26 FOR FURTHER GROUNDING AND BONDING INFORMATION.
- B. RELAY RACKS SHALL BE ASSEMBLED AND MOUNTED IN LOCATIONS SHOWN IN THE DRAWINGS AND AS DESCRIBED HEREIN. EACH RACK SHALL BE ASSEMBLED IN ACCORDANCE WITH THE MANUFACTURER'S INSTRUCTIONS AND RECOMMENDATIONS. EACH RACK SHALL BE MOUNTED SUCH THAT THE SIDE RAILS ARE PLUMB. BOLTS SHALL BE TIGHTENED TO THE EXTENT THAT IT HOLDS THE MOUNTING HARDWARE FIRMLY, BUT NOT SO TIGHT AS TO DISTORT THE HARDWARE OR STRIP THE THREADS. EQUIPMENT RACKS ARE TO BE CO-LOCATED WITH POWER OUTLETS TO ALLOW FOR EASY CONNECTION OF RACK-MOUNTED EQUIPMENT TO THE POWER SYSTEM. RACKS AND CABLE MANAGEMENT HARDWARE SHALL BE SECURELY BOLTED TOGETHER.
- C. THE RACK SHOULD BE ATTACHED TO RMER/RTR FLOORS WITH % IN. LAG SCREWS OR EQUIVALENT HARDWARE. THE FLOOR UNDER THE RACK SHOULD BE LEVEL WITHIN 3/16 IN. USE A FLOOR-LEVELING CEMENT COMPOUND IF NECESSARY.
- D. CABLE TRAYS MUST BE INSTALLED IN A MANNER THAT ALLOWS AT LEAST 305 MM (12 IN) OF CLEARANCE ABOVE THE TOP OF THE TRAY.
- E. CABLE TRAYS MUST BE INSTALLED A MINIMUM OF 101.6 MM 152.4 MM (4 IN 6 IN) ABOVE CABINETS AND RACKS, WITH 304.8 MM (12 IN) BEING PREFERRED
- F. METALLIC CABLE TRAY MUST BE COMPLIANT WITH THE NEMA VE-1 STANDARD. INSTALLATION SHOULD FOLLOW THE GUIDELINES AND RECOMMENDATIONS - AS APPLICABLE - IN THE NEMA VE-2 STANDARD.

G. ALL METALLIC LADDER RACKS MUST BE BONDED TO GROUND PER NEC REQUIREMENTS. WHEN SECTIONS ARE NOT

- MECHANICALLY CONTINUOUS, BONDING CONDUCTORS MUST BE INSTALLED ACROSS THE SECTIONS. THIS INCLUDES LADDER RACK WHOSE SECTION CONNECTING HARDWARE IS NOT APPROVED AS A MEANS FOR PROVIDING GROUND CONTINUITY. H. A MINIMUM OF 915 MM (3 FT) OF CLEARANCE IN FRONT AND IN BACK OF RACKS. MORE CLEARANCE MUST BE PROVIDED WHEN DEEMED PRUDENT OR NECESSARY FOR USE, INSTALLATION, AND REMOVAL OF EQUIPMENT, OR TO MEET THERMAL
- I. A MINIMUM OF 1219 MM (3 FT) OF CLEARANCE AT THE END OF A ROW OF RACKS OR CABINETS
- J. A MINIMUM OF 305 MM (1 FT) ADDITIONAL CLEARANCE FROM A CARRIER (SERVICE PROVIDER) WALL FIELD BEYOND THE MINIMUMS SPECIFIED FOR RACKS AND CABINETS.
- K. AT LEAST 610 MM (2 FEET) OF CLEARANCE ABOVE RACKS AND CABINETS, WITH CABLE SUPPORT SYSTEMS BEING THE ONLY ALLOWABLE EXCEPTION.

SECTION 27 11 00 - EQUIPMENT ROOM

END OF SECTION

JPMorgan Chase & Co GLOBAL TECHNOLOGY INFRASTRUCTURE END USER SERVICES

WORKPLACE TECHNOLOGY SERVICES STRUCTURED CABLING ENGINEERING 1111 POLARIS PARKWAY, COLUMBUS, OHIO 43240

NEW RETAIL BRANCH -**HWY 291 AND SE** LANGSFORD RD

keyplan

FOR REFERENCE ONLY **ISSUED AND** PERMITTED BY OTHERS

seal



issue no date 12.21.2020 ISSUED FOR COORDINATION 01.19.2021 ISSUED FOR CONSTRUCTION

site location JP MORGAN CHASE & CO 890 NE LANGSROD RD LEE'S SUMMIT, MO

64063 designed KB 12.21.2020 checked scale AS NOTED

TELECOM BOOK SPECS

sheet

OVP-38200P368999

SECTION 27 05 28 PATHWAYS FOR STRUCTURED CABLING

FITTINGS FOR STRUCTURED CABLING

SECTION 27 13 00 - STRUCTURED CABLING - BACKBONE CABLING

PART 1 - GENERAL

1.1 DESCRIPTION

- A. THIS SECTION INCLUDES INSIDE PLANT MULTIMODE FIBER, OUTSIDE PLANT MULTIMODE FIBER, SINGLE MODE FIBER FOR CARRIER CIRCUIT EXTENSION, AND CATEGORY 6 CABLES FOR CARRIER CIRCUIT EXTENSION.
- B. ALL RETAIL STANDARDS REGARDING IDENTIFICATION APPLY TO THIS SECTION. SEE 27 05 53 OF THIS STANDARD FOR ADDITIONAL DETAIL.
- C. THE NATIONAL ELECTRIC CODE DEFINES DISTANCE LIMITATIONS FOR OSP CABLE RUNS WITHIN BUILDINGS NOT IN CONDUIT, AT 50 FT. MAXIMUM. ALL SUCH REQUIREMENTS SHALL BE COMPLIED WITH AT ALL JPMC FACILITIES.
- D. EXTENDED NETWORK CABLES ARE TYPICALLY COMPRISED OF SIX 4-PAIR CATEGORY 6 CABLES, OR VIA 12-STRAND SINGLE-MODE FIBER IF THE SERVICE IS SWITCHED ETHERNET.
- E. EXCEPT FOR THE PURPOSES OF EXTENDING T.1, SWITCHED ETHERNET, OR ANALOG SERVICES, IN NO CASE SHALL CATEGORY 6 CABLE RUNS EXCEED 90M (295 FT) IN LENGTH. IN CASES WHERE T.1 SERVICE IS EXTENDED OVER CATEGORY 6 CABLES, THE CABLE DISTANCE SHALL NOT EXCEED 677 FT.
- F. SWITCHED ETHERNET SERVICE IS EXTENDED OVER SINGLE-MODE FIBER BY THE CARRIER TO THE JPMC RMER. PRIMARY SERVICE (CIRCUIT) SHALL BE ROUTED UNDERGROUND IN TWO 2" SCHEDULE 80 PVC CONDUITS. ONCE THE CONDUIT ENTERS THE BUILDING, IF OVER 50 FEET FROM THE ENTRANCE AND WITHIN JPMC CONTROLLED SPACE TRANSITION TO EMT CONDUIT. TERMINATE CONDUIT IN THE RMER. SECONDARY SERVICE (CIRCUIT) IS CELLULAR. PROVIDE EMT CONDUIT FROM THE CELLULAR DONOR ANTENNA LOCATION TO THE RMER, IF THE ANTENNA LOCATION IS ON THE ROOF OR OUTSIDE. IF CONDUITS ARE RUN INSIDE THE BUILDING BUT OUTSIDE OF JPMC CONTROLLED SPACE, TRANSITION IS REQUIRED TO RMC THROUGH NON-JPMC SPACE.
- G. EXTENDED NETWORK CABLES ARE USED TO EXTEND ANALOG DIAL TONE SERVICE AND/OR HIGH-SPEED DATA (E.G. T-1, SWE) SERVICE FROM THE ILEC'S PRESENCE IN THE BUILDING TO THE JPMC RMER.
- H. THIS SPECIFICATION CONTAINS ALL PRODUCTS CURRENTLY APPROVED BY JPMC. THE CONTRACTOR SHOULD NOT ASSUME THAT ALL OF THE MATERIALS LISTED IN THE SPECIFICATIONS MUST BE INSTALLED BECAUSE THEY ARE LISTED IN THE SPECIFICATION. PROJECT-SPECIFIC REQUIRED MATERIALS ARE FURTHER DEFINED IN THE PROJECT CONSTRUCTION DRAWINGS.

PART 2 - PRODUCTS

2.1 GENERAL FIBER CABLING REQUIREMENTS

A. CABLE RATING

- 1. LOCAL OR NATIONAL CODES MAY REQUIRE SPECIFIC CABLE GRADING IN SPECIFIC APPLICATIONS. IT IS CONTRACTOR'S RESPONSIBILITY TO INSTALL CABLE THAT IS APPROPRIATE TO THE ENVIRONMENT. IF CONTRACTOR INSTALLS CABLE THAT IS INAPPROPRIATE TO THE ENVIRONMENT (E.G. RISER-RATED CABLE IN SPACES THAT REQUIRE PLENUM CABLE), CONTRACTOR SHALL BE EXPECTED TO REMOVE THE INAPPROPRIATE CABLE AND INSTALL APPROPRIATE CABLE AT THEIR SOLE EXPENSE.
- B. TERMINATION TYPE
 1. ONLY FACTORY TERMINATED FIBER PATCH CORDS MAY BE UTILIZED IN JPMC FACILITIES. FIBER PATCH CORDS CREATED BY PERSONNEL NOT DIRECTLY EMPLOYED BY THE MANUFACTURER IS NOT PERMISSIBLE.
- 2. FIELD-TERMINATED CONNECTORS FOR THE FIBER BACKBONE IS THE PREFERRED TERMINATION METHOD. FUSION-SPLICED OR CORNING UNICAM TERMINATIONS ARE PERMITTED.
- 3. MULTIMODE & SINGLE MODE FIBER SHALL BE TERMINATED INTO LC CONNECTORS UNLESS NOTED OTHERWISE.

C. CABLE JACKETING

- 1. CABLE JACKETING MAY OR MAY NOT BE ARMORED, DEPENDING UPON THE ENVIRONMENT AND THE APPLICATION.
- a. NON-ARMORED CABLE SHALL BE USED WHEN THE FIBER WILL BE INSTALLED WITHIN CONDUIT OR FOR A POINT-TO-POINT CONNECTION WITHIN THE RMER.
- b. ARMORED CABLE SHALL BE USED WHEN THE FIBER IS NOT INSTALLED WITHIN CONDUIT.

D. CABLE GRADE

- 1. OM3 MULTIMODE BACKBONE FIBER SHALL BE USED FOR CABLE DISTANCES UP TO 300M (984FT.).
- 2. SINGLE MODE BACKBONE FIBER SHALL BE USED FOR DISTANCE GREATER THAN 300M (984FT.) OR FOR TELECOMMUNICATIONS CARRIER CIRCUIT EXTENSIONS.
- 3. SINGLE MODE & CATEGORY 6 SHALL BE USED FOR TELECOMMUNICATIONS CARRIER CIRCUIT EXTENSIONS.

2.2 MATERIALS

- A. SEE THE CABLE SCHEDULE AND RACK EQUIPMENT SCHEDULE ON THE CONSTRUCTION DRAWINGS FOR MANUFACTURERS AND PART NUMBERS FOR THE FOLLOWING EQUIPMENT:
- SINGLE MODE FIBER MATERIALS (FOR EXTENSION OF CARRIER CIRCUIT)
- 2. FIBER TERMINATION PANELS.
- 3. MULTIMODE FIBER MATERIALS (FOR BACKBONE TO A RTR IF APPLICABLE)

PART 3 - EXECUTION

3.1 GENERAL CABLING INSTALLATION

- A. SLEEVES SHALL NOT BE OVER-POPULATED WITH CABLES. SUFFICIENT SPARE CAPACITY SHALL BE ALLOWED IN EACH SLEEVE TO ACCOMMODATE APPROPRIATE FIRESTOPPING MATERIALS IN ACCORDANCE WITH MANUFACTURER SPECIFICATIONS AND THE UL FIRE RESISTANCE DIRECTORY. NOTE THAT MANUFACTURERS TYPICALLY SPECIFY A 20% TO 40% FILL FOR THEIR PRODUCTS.
- B. MANUFACTURER'S STANDARD PULLING TENSION AND MINIMUM BEND RADII SHALL BE COMPLIED WITH AT ALL TIMES. CABLES SHALL BE DRESSED-IN, VELCRO® OR MILLEPEDE® MILLE-TIES RELEASABLE CABLE TIED, AND SECURED TO THE LADDER RACK, PLYWOOD BACKBOARD, AND/OR OTHER SUITABLE SURFACES SO AS TO ENSURE A PROFESSIONAL APPEARANCE, RUN STRAIGHT, LEVEL, AND ALIGNED WITH BUILDING LINES, WITH 90° CORNERS WHERE POSSIBLE, BEARING IN MIND MANUFACTURER'S RECOMMENDED BEND RADII.
- C. CONTRACTOR SHALL FURNISH AND INSTALL ADEQUATE CABLE STRAIN RELIEF (E.G. CABLE DROPOUTS) TO ACCOMMODATE THE ANTICIPATED MAGNITUDE OF CABLING. WHEREVER FIBER AND COPPER CABLES ARE SEGREGATED, DEDICATED MULTIMODE STRAIN RELIEF SHALL BE PROVIDED, INCLUDING ADEQUATE PROVISION FOR CABLE ROUTE DIVERSITY WHERE APPLICABLE.
- 3.2 FIBER CABLING INSTALLATION
- A. AFTER FIBER CABLE HAS BEEN SUCCESSFULLY TESTED IN ACCORDANCE WITH THIS STANDARD, ALL CONNECTOR DUST COVERS SHALL BE SECURELY RESTORED.
- B. EMPTY ADAPTER PANEL PORTS SHALL BE EQUIPPED WITH BLANK PANELS.
- C. ALL FIBER STRANDS ARE TERMINATED INTO LC PATCH PANELS AT BOTH ENDS UNLESS NOTED OTHERWISE
- D. IN SPACES WHERE ANY AIRBORNE DUST OR CONTAMINANTS MAY BE PRESENT, ESPECIALLY DURING CONSTRUCTION, CONTRACTOR SHALL FULLY AND PROPERLY PROTECT ANY AND ALL CONNECTORIZED CABLES TO AVOID TRANSMISSION PERFORMANCE DEGRADATION ASSOCIATED WITH DUST COMING IN CONTACT WITH CONNECTOR CONTACT POINTS. IF AT ALL POSSIBLE, AND WHERE ALLOWED BY THE PROJECT TIMELINE, CONTRACTOR'S FIRST CHOICE SHOULD BE TO AVOID THIS PROBLEM BY REFRAINING FROM INSTALLING ANY SUCH COMPONENTS UNTIL THE RISK OF AIRBORNE DUST AND CONTAMINANTS IS ELIMINATED (E.G. AFTER FLOORS AND CEILINGS ARE TREATED, AND WALLS RECEIVE THE FINAL COAT OF PAINT).
- 3.3 CARRIER CIRCUIT EXTENSION INSTALLATION
- A. CARRIER CIRCUIT EXTENSION CABLES SHALL BE INSTALLED BY CONTRACTOR. THE CABLE TERMINATIONS MAY BE PERFORMED EITHER BY CONTRACTOR, OR BY THE ILEC, DEPENDING UPON THE CUSTOMARY PRACTICE IN THAT ILEC'S REGION. CONTRACTOR SHALL COORDINATE THIS PORTION OF THE PROJECT WITH OPR.
- B. IF THE ROUTE FOR THE CARRIER CIRCUIT EXTENSION CABLES PASSES THROUGH SPACE THAT IS NOT CONTROLLED BY JPMC, IT IS VULNERABLE TO ACCIDENTAL OR INTENTIONAL SERVICE INTERRUPTION, AND SHOULD BE INSTALLED IN A PROPERLY-DESIGNED CONDUIT INFRASTRUCTURE. THE CONDUIT SIZING SHALL BE BASED ON A 40% FILL OF ALL CABLE TYPES BEING INSTALLED WITHIN THE CONDUIT.
- C. IN THE RMER, THE CATEGORY 6 CABLE IS TYPICALLY TERMINATED INTO A SMART JACK OR NTE (CIENA AND BEASBOX) FURNISHED BY THE ILEC. IN THE UNLIKELY EVENT THAT THE SMART JACK IS NOT LOCATED IN THE RMER, CONTRACTOR SHALL COORDINATE CONNECTIVITY REQUIREMENTS WITH THE OPR.
- D. CATEGORY 6 CABLES SHALL NOT BE KINKED OR UNDULY TWISTED, NOR SHALL THE INTEGRITY OF THE CABLE SHEATH BE COMPROMISED IN ANY FASHION. CABLE BUNDLES SHALL NOT BE CLINCHED OR TIED TOGETHER WITH EXCESSIVE FORCE, THEREBY HOLDING JACKET DEFORMATION TO A MINIMUM. INDIVIDUAL CABLE BEND RADII MAY BE NO LESS THAN FOUR TIMES THE CABLE DIAMETER OR 0.6 INCHES, WHICHEVER IS GREATER. TIE WRAPS SHALL NOT BE EMPLOYED FOR SECURING CATEGORY 6 CABLES.
- DURING TERMINATION, UTP PAIR TWISTS SHALL BE MAINTAINED AS CLOSE AS POSSIBLE TO THE TERMINATION POINT. IN ANY CASE, THE AMOUNT OF UNTWISTING MUST NOT EXCEED .5 INCHES AT THE POINT OF TERMINATION.

3.4 FIBER TESTING

- A. TESTS SHALL BE CARRIED OUT AT 850NM AND 1300NM FOR MULTI-MODE TESTING AND 1310NM AND 1550NM FOR SINGLE-MODE TESTING IN
- B. THE FIBER MANUFACTURER'S WARRANTY CONDITIONS SHALL BE USED TO PERFORM ALL FIBER TESTING. THESE STANDARDS ARE MORE STRINGENT THAN INTERNATIONAL AND NATIONAL STANDARDS. THE CONTRACTOR IS REQUIRED TO PERFORM CUSTOM TESTS USING THE TESTER AND IS THEREFORE TO ADJUST THE CONTACTOR LOSS VALUES IN THE TESTER SOFTWARE ACCORDINGLY.
- C. SHOULD INSTALLED FIBERS BE REQUIRED TO BE CONNECTED DIRECTLY INTO A SWITCH IN A HARNESS LINK TOPOLOGY, ALL FIBERS WILL BE PATCHED PRIOR TO TESTING COMMENCING, THEN INDIVIDUALLY UN-PATCHED, TESTED, AND FINALLY RE-PATCHED. THIS IS TO MITIGATE POLARITY CONCERNS.
- D. WHEN REFERENCING FIBER OPTIC TESTERS THE 1 JUMPER (METHOD B) METHODOLOGY SHALL BE EMPLOYED.
- E. FIBER TESTERS SHALL BE COMPLIANT WITH ENCIRCLE FLUX LAUNCH SOURCES/ CONDITIONS. ENCIRCLED FLUX TESTING PATCH LEADS SHALL BE USED AND SHOULD NOT BE MATED BEYOND THE MAXIMUM OF 500 TIMES.
- F. DELIVERED CABLE TESTS ARE NOT REQUIRED, HOWEVER A CERTIFICATE OF CONFORMANCE SHALL BE SUPPLIED WITH EACH TRUNK CABLE AND COPIES MADE AVAILABLE ON SITE AND PROVIDED IN THE FINAL HANDOVER DOCUMENTATION.
- G. INDIVIDUAL CABLE RUNS SHALL BE TRACEABLE TO THE DELIVERED TRUNK CERTIFICATION.
- 3.5 CATEGORY 6/6A UTP AND CATEGORY 6A F/UTP TESTING
- A. SEE SECTION 27 15 00 HORIZONTAL CABLING FOR TESTING REQUIREMENTS
- 3.6 DOCUMENTATION
- A. ALL TEST RESULTS ARE TO BE ISSUED IN PDF FORMAT A MAXIMUM OF TWO DAYS AFTER FINAL COMPLETION OF THE TESTING. THE PROJECT WILL NOT BE CONSIDERED COMPLETE AND INVOICES WILL NOT BE PAID UNTIL THIS IS ACHIEVED.
- B. PDF FILE SIZES ARE TO BE NO GREATER THAN 10MB AS EMAIL IS THE ONLY OPTION OF ISSUING THEM. PAPER COPIES ARE NOT REQUIRED.
- C. THE TEST RESULTS IN THE PDF DOCUMENT ARE TO BE SEQUENCED IN NUMERICAL ORDER, AND THE PORT DESCRIPTION SHOULD MATCH THE LABELLING NOMENCLATURE. IT IS IMPERATIVE THAT THE TEST RESULTS DETAIL THE LOCAL LENGTH MEASUREMENT UNITS.
- D. IT IS THE CONTRACTOR'S RESPONSIBILITY TO ENSURE ALL PORTS HAVE BEEN 100% TESTED PRIOR TO SUBMITTING THE TEST RESULTS.
- D. IT IS THE CONTRACTOR'S RESPONSIBILITY TO ENSURE ALL PORTS HAVE BEEN 1009
- E. CONTRACTOR SHALL PROVIDE IN ELECTRONIC FORMAT:1. A FINAL AS-BUILT FLOOR PLAN DRAWINGS DETAILING THE LABELING OF ALL DATA OUTLETS.
- 2. ALL FIBER OPTIC AND COPPER TEST RESULTS AS NOTED ABOVE.
- ALL FIBER OF TIC AND COFFER TEST RESULTS AS NOTED ABOVE.
 MANUFACTURER'S PERFORMANCE AND APPLICATION WARRANTY
- F. THE PROJECT WILL NOT BE CONSIDERED COMPLETE AND ALL INVOICES WILL NOT BE PAID UNTIL THIS IS ACHIEVED.

END OF SECTION

SECTION 27 53 19 - CELLULAR ANTENNA

PART 1 - GENERAL

1.1 DESCRIPTION

A. CELLULAR ANTENNAS ARE DEPLOYED FOR BRANCHES.

PART 2 - PRODUCTS

2.1 MATERIALS

- A. JPMC'S CELLULAR ANTENNA DEPLOYMENT UTILIZES THE FOLLOWING MAJOR MATERIALS:
- OUTDOOR OMNIDIRECTIONAL ANTENNA FOR 2G/3G/4G CELLULAR (JPMC SUPPLIED)
- 2. 4G LIGHTNING SUPPRESSORS/ARRESTORS FOR OUTDOOR ANTENNA INSTALLS
- CEILING MOUNT BRACKET (JDTECK) FOR INDOOR PANEL ANTENNAL INSTALLS
 DIRECTIONAL (PANEL OR LOG PERIODIC STYLE) ANTENNAS (JPMC SUPPLIED)
- 5. LMR-240 FLEXIBLE LOW LOSS COMMUNICATIONS COAX OR LMR-400 FLEXIBLE LOW LOSS COMMUNICATIONS COAX
- 6. TNC CONNECTORS (TO ROUTER), N CONNECTORS TO ANTENNA

PART 3 - EXECUTION

3.1 INSTALLATION

- A. CABLE & ANTENNA INSTALLATION
- 1. ROOFTOP INSTALLATION:
- a. PERFORM RF ASSESSMENT FROM THE ROOF FOR VERIZON WIRELESS AND AT&T WIRELESS LTE SERVICE TO CONFIRM BANKING CENTER HAS A USEABLE LTE SIGNAL BY THE TIME IT REACHES JPMC ROUTER IN THE RETAIL MAIN EQUIPMENT ROOM (RMER);
- 1) GNS SIGNAL STRENGTH & QUALITY GUIDELINES:
- 1) GNS SIGNAL STRENGTH & QUALITY GUIDELIN
- a. RSSI: > -80 DBM (SIGNAL STRENGTH LTE OR 3G)
 NOTE: SS POWER CAN BE USED IN PLACE OF RSSI ON THE CELL SURVEY TO INDICATE SIGNAL
- STRENGTH. SS POWER READING MUST BE ≥ 97 DBM b. RSRP: > -105 DBM (SIGNAL STRENGTH SPECIFIC TO LTE)
- c. RSRQ: > -13 DB (SIGNAL QUALITY SPECIFIC TO LTE)
- d. SNR: > 5 DB (SIGNAL QUALITY LTE OR 3G)
- b. PERFORM INITIAL SPEED TESTS WITH A LTE MODEM TECHNOLOGY THAT IS EQUAL TO RETAIL NETWORK STANDARD (LTE CATEGORY 3, CATEGORY 6, OR CATEGORY 18). RECORD LOCAL FREQUENCY BANDS AND TRANSMIT/RECEIVE CHANNELS IN USE FOR EACH PROVIDER, FOR USE WITH MORE PRECISE TESTING EQUIPMENT. (I.E., ANRITSU DEVICE). CONTACT RETAIL NETWORK TEAM FOR CURRENT LTE STANDARD BEING
- c. PROVIDE JPMC REAL ESTATE WITH A RECOMMENDATION FOR ANTENNA PLACEMENT JPMC TO APPROVE FINAL ANTENNA PLACEMENT PRIOR TO PLACEMENT
- d. INSTALL (1) CELLULAR ANTENNA (TBD). INSTALL (1) LMR 240 (OR LMR 400) COAX CABLE FROM THE RMER/RTR TO THE LIGHTNING ARRESTOR LOCATION USING EXISTING ROOFTOP PENETRATION WHEREVER FEASIBLE
- 1) TERMINATE BOTH ENDS OF THE LMR 240 (OR LMR 400) COAX CABLE WITH THE LIGHTNING ARRESTOR PROTECTED END UTILIZING (TBD) CONNECTOR TO CISCO 819 END UTILIZING TNC-TYPE MALE CONNECTOR)
- 2) PROVIDE 2 FEET OF SLACK AT THE MIDPOINT OF THE VERTICAL CABLE MANAGER, TO ASSURE BEND RADIUS AND CONNECTIVITY TO THE ROUTER.
- e. ATTACH THE ANTENNA-END OF THE CABLE TO THE CISCO 4G LIGHTNING ARRESTOR

f. EXTEND FROM SURGE PROTECTOR TO ANTENNA TO THE 4G COMPATIBLE LIGHTNING PROTECTOR.

- 1) TERMINATE BOTH ENDS OF THE LMR 240 (OR LMR 400) COAX CABLE WITH THE ANTENNA END UTILIZING N-TYPE MALE CONNECTOR, AND THE LIGHTNING ARRESTOR UNPROTECTED END UTILIZING TNC-TYPE MALE
- g. GROUND THE SURGE PROTECTOR WITH A #6 AWG GROUND WIRE TO NEAREST GROUND SOURCE. THE GROUND CABLE MAY NOT EXCEED 20 INCHES.
- h. WEATHERIZE ANY OUTDOOR CONNECTIONS AND FIRE-STOP ALL PENETRATIONS

2. CEILING-MOUNT INSTALLATION:

- a. INSTALL (1) JPMC-SUPPLIED CELLULAR ANTENNA [COMMSCOPE CELLMAX-D-CPUSE-O)] WITH CEILING MOUNT BRACKET JDTECK (CMB-YAMB-1) AT JPMC-DESIGNATED LOCATION WITHIN THE BANKING CENTER, IN ACCORDANCE WITH THE MANUFACTURER'S GUIDELINES.
- b. INSTALL (1) LMR 240 (OR LMR 400) COAX CABLE FROM THE RMER/RTR TO THE CELLULAR ANTENNA LOCATION

 1) PROVIDE 2 FEET OF SLACK AT THE MIDPOINT OF THE VERTICAL CABLE MANAGER, TO ASSURE BEND RADIUS
- c. TERMINATE BOTH ENDS OF THE LMR 240 (OR LMR 400) COAX CABLE WITH THE ANTENNA END UTILIZING TNC-FEMALE CONNECTOR AND THE CISCO 819 END UTILIZING TNC-TYPE MALE CONNECTOR)

B. TESTING/REMEDIATION/DOCUMENTATION

- 1. TEST COAXIAL (LMR 240 OR LMR 400) CABLE FROM ROUTER END TO ANTENNA END FOR; CONTINUITY, SHORTS,
- SIGNAL LOSS, ETC.

 2. TEST RF SIGNAL STRENGTH/QUALITY AT THE RTR/RMER END OF THE CONNECTION DELIVERED BY ANTENNA
- TEST RESIGNAL STRENGTH/QUALITY AT THE RTR/RMER END
 COMPARE SIGNAL LEVELS AT ROUTER TO DESIGN VALUES

AND CONNECTIVITY TO THE ROUTER.

- 4. REMEDIATE ANY SYSTEM ISSUES (ANTENNA OR CABLING) THAT DEVIATE FROM PLANNED VALUES
- 5. PROVIDE PHOTOS OF ANTENNA INSTALLATION AND RMER/RTR TERMINATION ALONG WITH FINAL TEST RESULTS FOR SWEEP AND RF SIGNAL LEVEL TESTS TO JPMC (REQUIREMENT FOR FINAL ACCEPTANCE)

SECTION 27 53 19

CELLULAR ANTENNA

END OF SECTION

JPMORGAN CHASE & CO.

GLOBAL TECHNOLOGY INFRASTRUCTURE
END USER SERVICES
WORKPLACE TECHNOLOGY SERVICES
STRUCTURED CABLING ENGINEERING
1111 POLARIS PARKWAY, COLUMBUS, OHIO 43240

NEW RETAIL

BRANCH
HWY 291 AND SE

LANGSFORD RD

keyplan

FOR REFERENCE ONLY
ISSUED AND
PERMITTED BY OTHERS

seal



issue			
no	date	issue	by
А	12.21.2020	ISSUED FOR COORDINATION	KB
В	01.19.2021	ISSUED FOR CONSTRUCTION	КВ

JP MORGAN CHASE & CO 890 NE LANGSROD RD LEE'S SUMMIT, MO

64063

designed KB date 12.21.2020 drawn KB checked CC scale AS NOTED

TELECOM BOOK SPECS

job no.

OVP-38200P368999

sheet

TC-004

SECTION 27 13 00
STRUCTURED CABLING - BACKBONE CABLING

9

SECTION 27 15 00 - STRUCTURED CABLING - HORIZONTAL CABLING

PART 1 - GENERAL

1.1 DESCRIPTION

- A. CATEGORY 6 HORIZONTAL CABLE INFRASTRUCTURE SHALL BE INSTALLED FOR ALL STANDARD WALL OUTLETS AND ATM CABLE RUNS UNLESS NOTED OTHERWISE. THESE CABLES SHALL BE TERMINATED IN THE RMER OR RTR ON A 24-PORT OR 48-PORT PATCH PANEL WITH CATEGORY 6, RJ-45 JACKS, EMPLOYING T568B TERMINATIONS
- B. CATEGORY 6A HORIZONTAL CABLE INFRASTRUCTURE SHALL BE INSTALLED FOR ALL WIRELESS ACCESS POINT AND SECURITY CAMERA LOCATIONS. THESE CABLES SHALL BE TERMINATED IN THE RMER OR RTR ON A 24-PORT PATCH PANEL WITH CATEGORY 6A, RJ-45 JACKS, EMPLOYING T568B TERMINATIONS.
- C. FOILED/UNSHIELDED TWISTED PAIR CATEGORY 6A HORIZONTAL CABLE INFRASTRUCTURE SHALL BE INSTALLED FOR ALL VIDEO MONITOR LOCATIONS WHERE IDENTIFIED TO SUPPORT HDBASE-T TECHNOLOGY. THESE CABLES SHALL BE TERMINATED IN THE RMER OR RTR ON A 24-PORT SHIELDED PATCH PANEL WITH CATEGORY 6A, SHIELDED, RJ-45 JACKS, EMPLOYING T568B TERMINATIONS.
- D. TELEPRESENCE CONTROLLER LOCATIONS WILL BE EQUIPPED WITH POINT-TO-POINT F/UTP CATEGORY 6A HORIZONTAL CABLES AND AUDIO CABLES.
- E. IN NO CASE SHALL CATEGORY 6 / 6A, AND F/UTP CATEGORY 6A CABLE RUNS EXCEED 90M (295 FT) IN LENGTH. IN THE EVENT THAT A CABLE RUNS EXCEEDS 90M (295FT) BUT NO MORE THAN 300M (984FT), THEN 50-MICRON, OM3-RATED MULTIMODE FIBER SHALL BE INSTALLED WITH FIBER-TO-COPPER MEDIA CONVERTERS ON BOTH ENDS OF THE CABLE RUN.
- F. THIS SPECIFICATION CONTAINS ALL PRODUCTS CURRENTLY APPROVED BY JPMC. THE CONTRACTOR SHOULD NOT ASSUME THAT ALL OF THE MATERIALS LISTED IN THE SPECIFICATIONS MUST BE INSTALLED BECAUSE THEY ARE LISTED IN THE SPECIFICATION. PROJECT-SPECIFIC REQUIRED MATERIALS ARE FURTHER DEFINED IN THE PROJECT CONSTRUCTION DRAWINGS.

PART 2 - PRODUCTS

2.1 PLENUM REQUIREMENTS

A. LOCAL OR NATIONAL CODES MAY ALLOW NON-PLENUM (PVC) CABLE IN SOME LOCATIONS, IN WHICH CASE CONTRACTOR SHALL INFORM OPR THAT PLENUM RATED CABLE IS NOT REQUIRED. IF THE USE OF PVC CABLE IS APPROVED BY OPR, CONTRACTOR SHALL QUOTE AND INSTALL PVC CABLE. IF NO INFORMATION EXISTS REGARDING PLENUM/PVC CABLE REQUIREMENTS. CONTRACTOR SHALL QUOTE AND INSTALL PLENUM RATED CABLE.

2.2 PATCH CORDS - GENERAL

- A. ONLY FACTORY TERMINATED PATCH CORDS MAY BE UTILIZED IN JPMC FACILITIES. UTP PATCH CORDS THAT ARE PRE-TERMINATED (E.G., CREATED BY PERSONNEL NOT DIRECTLY EMPLOYED BY THE MANUFACTURER) ARE NOT PERMISSIBLE, UNLESS PREVIOUSLY APPROVED IN WRITING BY OPR.
- B. QUANTITIES, TYPES, AND LENGTHS OF PATCH CORDS ARE SPECIFIED BY OPR.
- C. ALL PATCH CORDS FOR PRINTERS, MULTI-FUNCTION DEVICES (MFD), ETC. SHALL BE 7 FT. IN LENGTH.
- D. RMER/RTR PATCH CORDS SHALL BE FURNISHED AND INSTALLED BY THE CONTRACTOR, TO ENSURE APPROPRIATE LENGTHS AND TIMELY MATERIAL PROCUREMENT. PATCH CORDS SHALL HAVE NO MORE THAN 1' OF SLACK.
- E. PATCH CORDS SHALL BE COLORED AS FOLLOWS:
 - CATEGORY 6: GRAY

 - CATEGORY 6A: WHITE CATEGORY 6A F/UTP: WHITE

2.3 MATERIALS

- A. SEE THE WORK AREA OUTLET SCHEDULE, CABLE SCHEDULE, AND RACK EQUIPMENT SCHEDULE ON THE CONSTRUCTION DRAWINGS FOR MANUFACTURERS AND PART NUMBERS FOR THE FOLLOWING EQUIPMENT
- **CATEGORY 6 UTP MATERIALS**
- CATEGORY 6A UTP MATERIALS
- CATEGORY 6A F/UTP MATERIALS CATEGORY 6 OSP UTP MATERIALS
- CATEGORY 6A OSP UTP MATERIALS
- **FACEPLATES**

OUTSIDE PLANT HORIZONTAL MULTIMODE FIBER MATERIALS

- 2.4 COPPER AND FIBER OPTIC TESTING EQUIPMENT
- A. THE FOLLOWING PRODUCTS SHOULD BE USED WHEN TESTING STRUCTURED CABLING INFRASTRUCTURE:
 - TEST EQUIPMENT WHICH IS CAPABLE OF ELECTRONICALLY STORING TEST RESULT DATA. THE TESTER SHALL EXCEED ANSI/TIA-1152 LEVEL 2G
 - CATEGORY 6 AND CATEGORY 6A PERMANENT AND CHANNEL ADAPTERS
 - SINGLE-MODE AND MULTI-MODE FIBER ADAPTERS
 - ENCIRCLED FLUX REFERENCE CORDS
 - FIBER INSPECTION PROBE/ MICROSCOPE APPROPRIATE CONNECTOR CLEANING TOOLS/ TAPES
 - 2M CATEGORY 6 PATCH LEADS IF CHANNEL TESTING CATEGORY 6 CABLING
 - 2M CATEGORY 6A PATCH LEADS IF CHANNEL TESTING CATEGORY 6A CABLING

PART 3 - EXECUTION

3.1 INSTALLATION

- A. ALL RJ45 TERMINATIONS EMPLOY 568B TERMINATIONS
- B. ALL CABLES AND OUTLETS SHALL BE LABELED IN ACCORDANCE WITH SECTION 27 05 53.
- C. COMPLETED HORIZONTAL CABLES SHALL BE TESTED IN ACCORDANCE WITH PART 3.2 TESTING BELOW.
- D. CONTRACTOR SHALL POPULATE THE PATCH PANEL WITH OUTLET TERMINATIONS TO SUPPORT INITIAL WORK AREA OUTLET REQUIREMENTS, AND LEAVING A GROWTH FACTOR OF 10% AS OPEN POSITIONS.
- E. TO ENSURE OPTIMUM CABLE PERFORMANCE. BUNDLES OF 4-PAIR CABLES SHALL NOT BE TIGHTLY BUNDLED AND CAREFULLY ALIGNED FOR DESIRABLE AESTHETIC APPEARANCE.
- F. CATEGORY 6/6A CABLES SHALL NOT BE KINKED OR UNDULY TWISTED, NOR SHALL THE INTEGRITY OF THE CABLE SHEATH BE COMPROMISED IN ANY FASHION. CABLE BUNDLES SHALL NOT BE CLINCHED OR TIED TOGETHER WITH EXCESSIVE FORCE, THEREBY HOLDING JACKET DEFORMATION TO A MINIMUM. INDIVIDUAL CABLE BEND RADII MAY BE NO LESS THAN FOUR TIMES THE CABLE DIAMETER OR 0.6 INCHES, WHICHEVER IS GREATER.
- G. DURING TERMINATION, PAIR TWISTS SHALL BE MAINTAINED AS CLOSE AS POSSIBLE TO THE TERMINATION POINT. IN ANY CASE, THE AMOUNT OF UNTWISTING MUST NOT EXCEED .5 INCHES AT THE POINT OF TERMINATION.
- H. CABLES SHALL BE DRESSED-IN, VELCRO® OR MILLEPEDE® MILLE-TIES RELEASABLE CABLE TIED, AND SECURED TO THE LADDER RACK, PLYWOOD BACKBOARD, AND/OR OTHER SUITABLE SURFACES TO ENSURE A PROFESSIONAL APPEARANCE AND RUN STRAIGHT, LEVEL, AND PARALLEL TO BUILDING LINES, WITH 90° CORNERS WHERE POSSIBLE. CONTRACTOR SHALL COMPLY WITH MANUFACTURER'S STANDARD PULLING TENSION AND MINIMUM BEND RADII AT ALL TIMES.
- . IN THE RMER/RTR, CABLES ASSOCIATED WITH A GIVEN WORK AREA SHALL BE TERMINATED INTO CONTIGUOUS POSITIONS IN THE PATCH PANEL. FOR EXAMPLE, IF EACH WORK AREA IS EQUIPPED WITH TWO CATEGORY 6 CABLES, THE FIRST WORK AREA SHALL BE TERMINATED ON POSITIONS 1 AND 2 OF THE PATCH PANEL, THE SECOND WORK AREA SHALL BE TERMINATED ON POSITIONS 3 AND 4 OF THE PATCH PANEL, AND SO FORTH.
- J. IN THE RMER/RTR, A FLOOR PLAN MAP ILLUSTRATING THE TELECOM OUTLETS, WAPS AND IP CAMERA LOCATIONS AND NUMBERS SHALL BE MADE READILY AVAILABLE AND VIEWABLE.
- K. WHEREVER PRACTICAL. JACKS THAT ARE INSTALLED AT MODULAR FURNITURE LOCATIONS SHALL BE FULLY INTEGRATED INTO FURNITURE RACEWAY LOCATIONS THAT ARE DESIGNED FOR THE PURPOSE, AVOIDING THE USE OF BISCUIT JACKS. WHERE THE FURNITURE SYSTEM DOES NOT CONTAIN AN INTEGRAL RACEWAY, AND NO APPARENT CABLE MANAGEMENT METHOD IS PROVIDED, CABLING SHALL BE NEATLY DRESSED AND CONCEALED UPON REVIEW AND APPROVAL BY THE OPR. VELCRO, DOUBLE SIDED TAPE OR OTHER ADHESIVE MATERIALS WILL ONLY BE ACCEPTED IF PREVIOUSLY APPROVED IN WRITING BY THE OPR.
- . CABLING TO WALL MOUNTED WORKSTATION OUTLETS SHALL TERMINATE IN A SINGLE- OR DOUBLE-GANG BOX PROVIDED BY OTHERS. CONTRACTOR SHALL PROVIDE THE NECESSARY CONNECTORS (AS DESCRIBED ELSEWHERE) UNDER A SINGLE-GANG FACEPLATE. THE

TYPE OF FACEPLATE TO BE USED SHALL BE COORDINATED WITH THE ARCHITECT FOR COLOR, FINISH, ETC.

- M. CABLING TO FLOOR MOUNTED WORKSTATION OUTLETS SHALL BE TERMINATED IN A FLUSH OR SURFACE MOUNTED POKE-THRU OR SERVICE FITTING PROVIDED BY OTHERS. ALL CABLING AND CONNECTORS SHALL REMAIN WITHIN THE POKE-THRU OR SERVICE FITTING HOUSING. IF NECESSARY, THE CONTRACTOR SHALL MODIFY THE BLANK PLATES PROVIDED WITH THE POKE-THRU OR SERVICE FITTING IN ORDER TO ACCOMMODATE THE CONNECTORS.
- N. FOR HORIZONTAL FTP CABLING, GROUNDING OF THE SHIELD SHOULD BE MADE ON THE RMER END ONLY.
- O. FOR ALL HORIZONTAL CABLE RUNS THAT RUN EXTERIOR TO THE MAIN BUILDING, INSTALL OSP-RATED UTP OR FIBER CABLE. CONDUIT SHALL BE PROVIDED FROM THE OUTLET TO THE RMER/RTR. OSP CABLING SHALL NOT BE INSTALLED IN A PLENUM-RATE CEILING
- P. FOR EACH UTP OSP CABLE THAT TERMINATES OUTSIDE THE ROOF LINE OF THE BUILDING, FURNISH AND INSTALL ONE OSP PROTECTOR, MOUNTED TO THE PLYWOOD BACKBOARD IN THE EQUIPMENT ROOM, AND BONDED TO THE GROUNDING BUSBAR VIA A MINIMUM 14 AWG GREEN JACKETED GROUND WIRE. TERMINATE THE UTP OSP CABLE AT THE PROTECTOR PER MANUFACTURER SPECIFICATIONS. WHERE THE OSP CABLE IS TERMINATED IN AN RJ45 JACK AT AN ATM, PROTECTION IS FURNISHED BY OTHERS, AND A 6 FT SERVICE LOOP SHALL BE PROVIDED SO THAT THE SURFACE MOUNTED RJ45 SINGLE-OUTLET JACK CAN BE DRESSED INTO THE INTERIOR OF THE ATM BY OTHERS.
- Q. ALL OUTLET JACKS, CABLE, PATCH PANEL, PATCH CORDS MUST MATCH THE CATEGORY OR FIBER GRADE OF CABLE BEING DEPLOYED.

3.2 TESTING

A. DESCRIPTION

- PRIOR TO THE TESTING COMMENCING, THE CONTRACTOR IS TO PROVIDE A COMPREHENSIVE TESTING METHODOLOGY DOCUMENT FOR APPROVAL, PRIOR TO ANY TESTING COMMENCING. THIS DOCUMENT SHALL INCLUDE THE FOLLOWING INFORMATION:
- BRIEF OVERVIEW OF THE PROJECT (LOCATION, SCOPE ETC.)
- OVERVIEW OF THE TESTING PROCEDURE INCLUDING SUPPORTING DOCUMENTATION, ONSITE EQUIPMENT CALIBRATION/
- REFERENCING AND CLEANING PROCEDURE. DETAILS OF THE EQUIPMENT TO BE USED.
- CALIBRATION REQUIREMENTS AND CERTIFICATION FOR THE EQUIPMENT TO BE USED
- TEST RESULT BACKUP PROCEDURE
- DETAILS OF PROCEDURE FOR REMEDIATING ANY TEST RESULTS WHICH DO NOT PASS THE REQUIRED TESTS A PROGRAM OF WORKS FOR THE TESTING, SHOULD THIS NOT BE CLEAR IN THE OVERALL INSTALLATION PROGRAM
- ALL ELECTRONIC AND OPTICAL MEASURING (TEST) EQUIPMENT SHALL BE WITHIN 12 MONTHS OF A CALIBRATION THAT HAS BEEN CARRIED OUT BY AN APPROVED CALIBRATION HOUSE. ALL CALIBRATION CERTIFICATES SHALL BE AVAILABLE ON SITE DURING THE
- TESTING PHASE. ALL TEST RESULTS SHALL IDENTIFY THE EQUIPMENT SERIAL NUMBER (LOCAL AND REMOTE) OF TEST EQUIPMENT C. THE "STORE PLOT DATA" FUNCTION OF THE TESTER MUST BE ENABLED PRIOR TO ANY TESTING COMMENCING. THIS IS TO ENABLE
- ELECTRONIC RE-TESTING AT A LATER DATE SHOULD THIS BE REQUIRED. TEST RESULTS ISSUED WITHOUT THE PLOT DATA ENABLED WILL BE CONSIDERED NON-COMPLIANT AND RE-TESTING WILL BE REQUIRED AT THE CONTRACTORS COST.
- D. ALL MARGINAL (OR STAR *) PASSES SHALL BE CONSIDERED FAILS AND WILL REQUIRE REMEDIATION UNTIL A PASS IS ACHIEVED.
- E. ONCE ALL PRODUCTS (I.E. CABLES AND ASSOCIATED HARDWARE) HAVE BEEN FULLY INSTALLED IN THEIR FINAL LOCATIONS AND LABELLED, TESTING OF ALL CORES/ CABLES MAY COMMENCE.
- F. ALL CABLES/ CORES SHALL BE 100% TESTED IN ACCORDANCE WITH THE SECTIONS BELOW.
- G. IT IS THE CONTRACTOR'S RESPONSIBILITY TO REMEDIATE ALL FAULTS FOUND WHILST TESTING AT ITS OWN EXPENSE. ALL TEST EQUIPMENT SHALL BE BY THE CONTRACTOR.
- H. JPMC MAY CHOOSE TO WITNESS TEST RANDOM ELEMENTS OF THE INSTALLATION, WHICH SHOULD HAVE ALREADY BEEN ALLOWED FOR IN THE COSTS. THE CONTRACTOR SHALL PROVIDE 2 TESTING ENGINEERS AND ALL EQUIPMENT REQUIRED TO UNDERTAKE THE WITNESS TESTING (INCLUDING FULLY CHARGED TEST EQUIPMENT). CHANNEL TESTING (INCLUDING EXISTING PREVIOUSLY INSTALLED INFRASTRUCTURE MAY ALSO BE REQUIRED AS PART OF THE WITNESS TESTING, TO ENSURE THAT THE FULL CHANNEL IS COMPLIANT.
- I. THE PROJECT SHALL NOT BE CONSIDERED COMPLETE UNTIL ALL SCS INFRASTRUCTURE HAS BEEN 100% TESTED AND TEST RESULT ISSUED TO JPMC IN BOTH TESTER AND PDF FORMAT. TEST RESULTS ARE TO BE BROKEN DOWN INTO 10MB FILE SIZES AND EMAILED (FTP SITES, CDS OR FLASH DRIVES ARE NOT PERMITTED).

3.3 FIBER TESTING

- A. TESTS SHALL BE CARRIED OUT AT 850NM AND 1300NM FOR MULTI-MODE TESTING AND 1310NM AND 1550NM FOR SINGLE-MODE TESTING IN ONE DIRECTION.
- B. THE FIBER MANUFACTURER'S WARRANTY CONDITIONS SHALL BE USED TO PERFORM ALL FIBER TESTING. THESE STANDARDS ARE MORE STRINGENT THAN INTERNATIONAL AND NATIONAL STANDARDS. THE CONTRACTOR IS REQUIRED TO PERFORM CUSTOM TESTS USING THE TESTER AND IS THEREFORE TO ADJUST THE CONTACTOR LOSS VALUES IN THE TESTER SOFTWARE ACCORDINGLY.
- C. SHOULD INSTALLED FIBERS BE REQUIRED TO BE CONNECTED DIRECTLY INTO A SWITCH IN A HARNESS LINK TOPOLOGY, ALL FIBERS WILL BE PATCHED PRIOR TO TESTING COMMENCING, THEN INDIVIDUALLY UN-PATCHED, TESTED, AND FINALLY RE-PATCHED. THIS IS TO MITIGATE POLARITY CONCERNS.
- D. WHEN REFERENCING FIBER OPTIC TESTERS THE 1 JUMPER (METHOD B) METHODOLOGY SHALL BE EMPLOYED.
- E. FIBER TESTERS SHALL BE COMPLIANT WITH ENCIRCLE FLUX LAUNCH SOURCES/ CONDITIONS. ENCIRCLED FLUX TESTING PATCH LEADS SHALL BE USED AND SHOULD NOT BE MATED BEYOND THE MAXIMUM OF 500 TIMES.
- F. DELIVERED CABLE TESTS ARE NOT REQUIRED, HOWEVER A CERTIFICATE OF CONFORMANCE SHALL BE SUPPLIED WITH EACH TRUNK CABLE AND COPIES MADE AVAILABLE ON SITE AND PROVIDED IN THE FINAL HANDOVER DOCUMENTATION.
- G. INDIVIDUAL CABLE RUNS SHALL BE TRACEABLE TO THE DELIVERED TRUNK CERTIFICATION.

3.4 CATEGORY 6 AND CATEGORY 6A TESTING

- A. PERMENANT LINK AND CHANNEL TESTING SHOULD BE PERFORMED IN ACCORDANCE WITH THE FOLLOWING STANDRADS PER REGION:
 - ISO/IEC 11801
 - ANSI/TIA 568
- B. PERMANENT LINK TESTING SHOULD BE PERFORMED BETWEEN A PATCH PANEL AND AN RJ45 OUTLET
- C. CHANNEL TESTING SHOULD BE PERFORMED BETWEEN A PATCH PANEL AND A FACTORY TERMINATED RJ45 PLUG (WHEN A HARNESS LINK OR CONSOLIDATION POINT HAS BEEN DEPLOYED). CHANNEL TESTING BETWEEN TWO RJ45 OUTLETS IS NOT TYPICALLY REQUIRED.

ELTCTL (EQUAL LEVEL TRANSVERSE CONVERSION TRANSFER LOSS) - RECORDED FOR INFORMATION ONLY

D. SYSTEM ACCEPTANCE TESTS FOR CATEGORY 6 ARE DETAILED BELOW:

CATEGORY 6 WIRE MAP

- LENGTH PROPAGATION DELAY
- DELAY SKEW DC LOOP RESISTANCE - RECORDED FOR INFORMATION ONLY
- INSERTION LOSS
- NEXT (NEAR-END CROSSTALK)
- PS NEXT (POWER SUM NEAR-END CROSSTALK)
- ACR-N (ATTENUATION TO CROSSTALK RATIO NEAR-END) RECORDED FOR INFORMATION ONLY
- PS ACR-N (POWER SUM ATTENUATION TO CROSSTALK RATIO NEAR-END) RECORDED FOR INFORMATION ONLY
- ACR-F (ATTENUATION TO CROSSTALK RATIO FAR-END)
- PS ACR-F (POWER SUM ATTENUATION TO CROSSTALK RATIO FAR-END)

DC RESISTANCE UNBALANCE - RECORDED FOR INFORMATION ONLY

- RETURN LOSS
 - TCL (TRANSVERSE CONVERSION LOSS) RECORDED FOR INFORMATION ONLY

CATEGORY 6A & CATEGORY 6A (CATAGORY6A SHIELDED/FOILED CABLES FOR AUDIO-VIDEO CABLES ONLY

- WIRE MAP
- LENGTH
- PROPAGATION DELAY
- DELAY SKEW
- DC LOOP RESISTANCE
- DC RESISTANCE UNBALANCE WITHIN A PAIR DC RESISTANCE UNBALANCE BETWEEN PAIRS
- **INSERTION LOSS**
- NEXT (NEAR-END CROSSTALK) PS NEXT (POWER SUM NEAR-END CROSSTALK)
- ACR-N (ATTENUATION TO CROSSTALK RATIO NEAR-END)
- PS ACR-N (POWER SUM ATTENUATION TO CROSSTALK RATIO NEAR-END) ACR-F (ATTENUATION TO CROSSTALK RATIO FAR-END)
- PS ACR-F (POWER SUM ATTENUATION TO CROSSTALK RATIO FAR-END)
- RETURN LOSS
- TCL (TRANSVERSE CONVERSION LOSS)
- PS ANEXT (POWER SUM ALIEN NEAR-END CROSSTALK)
- AVERAGE PS ANEXT (AVERAGE POWER SUM ALIEN NEAR-END CROSSTALK)
- PS AACR-F (POWER SUM ALIEN ATTENUATION TO CROSSTALK RATIO FAR-END) AVERAGE PS AACR-F (AVERAGE POWER SUM ALIEN ATTENUATION TO CROSSTALK RATIO FAR-END)

ELTCTL (EQUAL LEVEL TRANSVERSE CONVERSION TRANSFER LOSS)

- SHIELD/FOIL CONTINUITY (FOR CATAGORY6A SHIELDED/FOILED CABLES ONLY)
- E. ALL MARGINAL (OR STAR *) PASSES SHALL BE CONSIDERED FAILS AND WILL REQUIRE REMEDIATION UNTIL A PASS IS ACHIEVED

3.3 DOCUMENTATION

- A. ALL TEST RESULTS ARE TO BE ISSUED IN PDF FORMAT A MAXIMUM OF TWO DAYS AFTER FINAL COMPLETION OF THE TESTING. THE PROJECT WILL NOT BE CONSIDERED COMPLETE AND INVOICES WILL NOT BE PAID UNTIL THIS IS ACHIEVED.
- B. PDF FILE SIZES ARE TO BE NO GREATER THAN 10MB AS EMAIL IS THE ONLY OPTION OF ISSUING THEM. PAPER COPIES ARE NOT
- C. THE TEST RESULTS IN THE PDF DOCUMENT ARE TO BE SEQUENCED IN NUMERICAL ORDER, AND THE PORT DESCRIPTION SHOULD
- MATCH THE LABELLING NOMENCLATURE. IT IS IMPERATIVE THAT THE TEST RESULTS DETAIL THE LOCAL LENGTH MEASUREMENT UNITS.

D. IT IS THE CONTRACTOR'S RESPONSIBILITY TO ENSURE ALL PORTS HAVE BEEN 100% TESTED PRIOR TO SUBMITTING THE TEST RESULTS

- E. THE CONTRACTOR SHALL PROVIDE AN ELECTRONIC COPY OF THE TEST RESULTS AND THE FINAL AS-BUILT DRAWINGS SHOWING ALL HORIZONTAL CABLE LABELS AT EACH OUTLET LOCATION. THE FINAL AS-BUILT CABLE LABEL SHALL BE IDENTICAL TO THE CABLE IDENTIFIER IN THE TEST RESULTS.
- THE CONTRACTOR SHALL PROVIDE THE FINAL MANUFACTURER PERFORMANCE AND ASSURANCE WARRANTY, TEST RESULTS AND FINAL AS-BUILT DRAWINGS AS A COMPLETE CLOSE OUT SUBMITTAL. THE PROJECT WILL NOT BE CONSIDERED COMPLETE AND INVOICES WILL NOT BE PAID UNTIL THIS IS ACHIEVED.

END OF SECTION

JPMorgan Chase & Co

GLOBAL TECHNOLOGY INFRASTRUCTURE END USER SERVICES WORKPLACE TECHNOLOGY SERVICES STRUCTURED CABLING ENGINEERING 1111 POLARIS PARKWAY, COLUMBUS, OHIO 43240

NEW RETAIL BRANCH -**HWY 291 AND SE** LANGSFORD RD

keyplan

FOR REFERENCE ONLY **ISSUED AND** PERMITTED BY OTHERS

seal



issue			
no	date	issue	by
А	12.21.2020	ISSUED FOR COORDINATION	KB
В	01.19.2021	ISSUED FOR CONSTRUCTION	KB
		_	

site location JP MORGAN CHASE & CO 890 NE LANGSROD RD LEE'S SUMMIT, MO


64063 designed KB 12.21.2020 checked scale AS NOTED

TELECOM BOOK SPECS

job no.

OVP-38200P368999

SECTION 27 15 00
STRUCTURED CABLING - HORIZONTAL CABLING

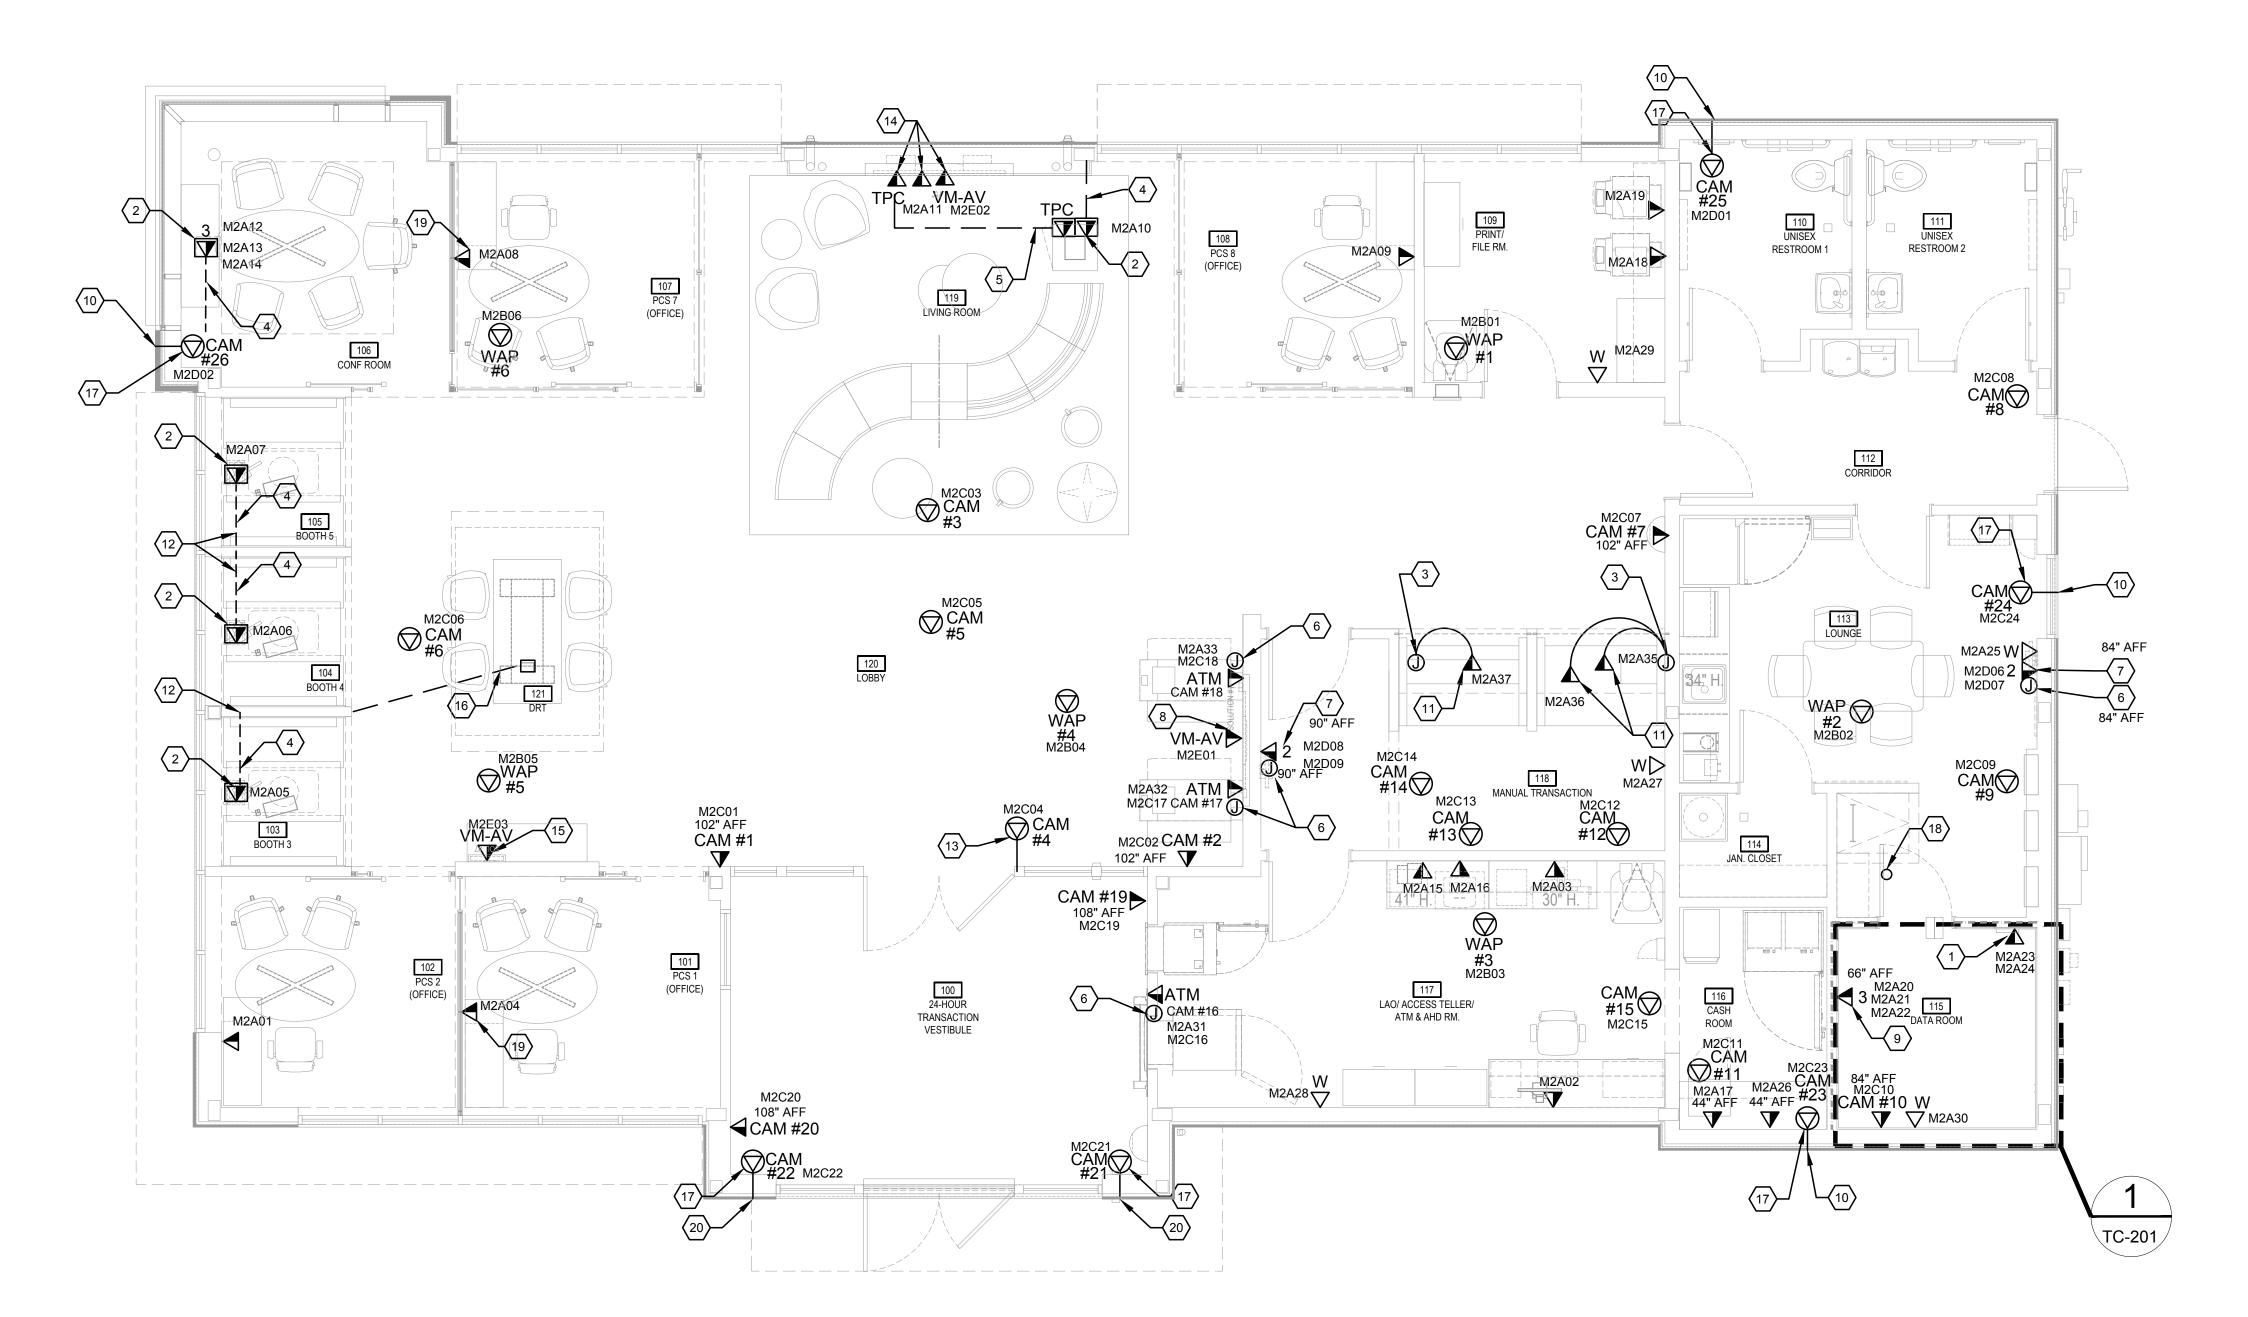

1 TELECOM FIRST FLOOR PLAN

SCALE: 1/4" = 1'-0"

TELECOM CEILING PLAN GENERAL NOTES

CAMERA LOCATIONS SHOWN ARE FOR ESTIMATION OF STRUCTURED CABLING SCOPE OF WORK. FINAL LOCATIONS AND QUANTITIES WILL BE DETERMINED CLOSER TO THE BRANCH OPENING DATE. COORDINATE THE ACTUAL LOCATIONS AND QUANTITIES WITH THE PROJECT MANAGER.

TELECOMMUNICATIONS PLAN NOTES

1. OUTLET FOR BUILDING AUTOMATION SYSTEM EQUIPMENT. COORDINATE THE EXACT LOCATION WITH THE BAS EQUIPMENT PRIOR TO ROUGH-IN.

- FLOOR OUTLET MOUNTED WITHIN DUAL SERVICE POWER AND LOW VOLTAGE RECESSED BOX WITH 1" CONDUIT TO ABOVE ACCESSIBLE CEILING. REFER TO SHEET TC-000 FOR ADDITIONAL INFORMATION.
- 3. JUNCTION BOX WITH CONDUIT TO ABOVE ACCESSIBLE CEILING FOR CABLING TO THE TELLER OUTLET. CONCEAL CABLING FROM JUNCTION BOX TO OUTLET WITHIN FLEXIBLE CONDUIT. SEE ARCHITECTURAL DETAILS FOR MORE INFORMATION.
- 4. PROVIDE 1" CONDUIT UNDER SLAB TO WALL AS SHOWN. ROUTE CONDUIT CONCEALED WITHIN WALL AND STUB OUT TO ABOVE ACCESSIBLE CEILING.
- 5. PROVIDE 1" CONDUIT TO DUAL SERVICE POWER AND LOW VOLTAGE RECESSED BOX FOR TELEPRESENCE CONTROL CABLING. REFER TO FACEPLATE DETAIL AND TERMINATION DETAILS ON SHEET TC-302. REFER TO AV STANDARDS FOR ADDITIONAL DETAIL.
- 6. PROVIDE A SINGLE GANG BACKBOX WITH A 1"
 CONDUIT TO ABOVE ACCESSIBLE CEILING THIS
 ROUGH-IN WILL BE FOR ONE RG59/U AND ONE 18/2
 CABLE PROVIDED BY THE SECURITY VENDOR.
- PROVIDE CAT6A CABLING.

7. OUTLET FOR SECURITY CAMERA MONITOR.

- 8. AV SOLUTION #1. REFER TO SHEET TC-501 FOR ADDITIONAL INFORMATION.
- 9. DATA CONNECTION FOR ACCESS CONTROL PANEL. COORDINATE WITH SECURITY CONTRACTOR TO PROVIDE ONE CONNECTION FOR EACH PANEL WITHIN SINGLE GANG BACK BOX AND FACEPLATE. REFER TO SHEET TC-201 FOR ADDITIONAL INFORMATION.
- 10.MOUNT EXTERNAL CONDUIT PENETRATION AT 10'-0" AFG. COORDINATE WITH ARCHITECTURAL ELEVATIONS TO ENSURE THAT CAMERA LENS CLEARS THE SOFFIT FOR AN UNOBSTRUCTED VIEW.
- 11.DATA OUTLET MOUNTED IN CASEWORK.
 COORDINATE MOUNTING LOCATIONS WITH
 ARCHITECT/JPMC PROJECT MANAGER.
- 12.DECORATIVE CEILING AREA. EXTEND CONDUIT TO NEAREST ACCESSIBLE CEILING.
- 13.MULLION MOUNTED MINI CAMERA. PROVIDE CONDUIT IN DOOR FRAME EXTENDING TO NEAREST ACCESSIBLE CEILING. COORDINATE FINAL MOUNTING WITH PROJECT MANAGER.
- 14. AV SOLUTION #3. REFER TO SHEET TC-502 FOR ADDITIONAL INFORMATION.
- 15. AV SOLUTION #7. REFER TO SHEET TC-503 FOR ADDITIONAL INFORMATION.
- 16.PROVIDE 3/4" CONDUIT FROM DUAL USE FLOOR BOX TO ABOVE ACCESSIBLE CEILING FOR FUTURE DATA CABLING. PROVIDE PULL STRING WITHIN CONDUIT.
- 17.PLENUM-RATED ABOVE CEILING CONNECTOR
 ASSEMBLY MOUNTED ABOVE ACCESSIBLE CEILING
 FOR EXTERIOR SECURITY CAMERA. REFER TO
 DETAIL ON SHEET TC-401 FOR ADDITIONAL
 INFORMATION. COORDINATE WITH SECURITY
 DESIGNER AND ARCHITECT FOR FINAL MOUNTING
 LOCATION AND CONDUIT EXTERIOR PENETRATION
 LOCATION.
- 18.RECOMMENDED LOCATION OF THE CELLULAR ANTENNA ROOF PENETRATION. COORDINATE LOCATION WITHIN 36" OF THE ACCESS LADDER. CONDUIT PATHWAY SHALL EXTEND FROM THE ROOF PENETRATION TO THE RMER DATA CLOSET. SEE TC-201 AND TC-402 FOR ADDITIONAL INFORMATION.
- 19. OUTLET MOUNTED IN PRE-MANUFACTURED FURNITURE WALL (AKA VIA WALL OR PRIVACY WALL). EC TO PROVIDE A 3/4" FLEXIBLE CONDUIT WITH PULL STRING ROUTED FROM THE COMMUNICATIONS OUTLET OPENING TO ABOVE FINISHED CEILING. TC TO PROVIDE CABLING TO COMMUNICATION OPENING AND PROVIDE OUTLET FACEPLATE AS SHOWN ON TC-301.
- 20. MOUNT EXTERNAL CONDUIT PENETRATION AT 9'-0"
 AFG. COORDINATE WITH ARCHITECTURAL
 ELEVATIONS TO ENSURE THAT CAMERA LENS
 CLEARS THE SOFFIT FOR AN UNOBSTRUCTED VIEW.

JPMORGAN CHASE & Co.

GLOBAL TECHNOLOGY INFRASTRUCTURE
END USER SERVICES
WORKPLACE TECHNOLOGY SERVICES
STRUCTURED CABLING ENGINEERING
1111 POLARIS PARKWAY, COLUMBUS, OHIO 43240

NEW RETAIL

BRANCH
HWY 291 AND SE

LANGSFORD RD

keyplan

FOR REFERENCE ONLY
ISSUED AND
PERMITTED BY OTHERS

Scal



issue			
no	date	issue	by
Α	12.21.2020	ISSUED FOR COORDINATION	КВ
В	01.19.2021	ISSUED FOR CONSTRUCTION	КВ

JP MORGAN CHASE & CO 890 NE LANGSROD RD LEE'S SUMMIT, MO 64063


designed KB date 01.19.2021 drawn KB checked CC scale AS NOTED

TELECOM FIRST FLOOR PLAN

job no.

OVP-38200P368999

sheet

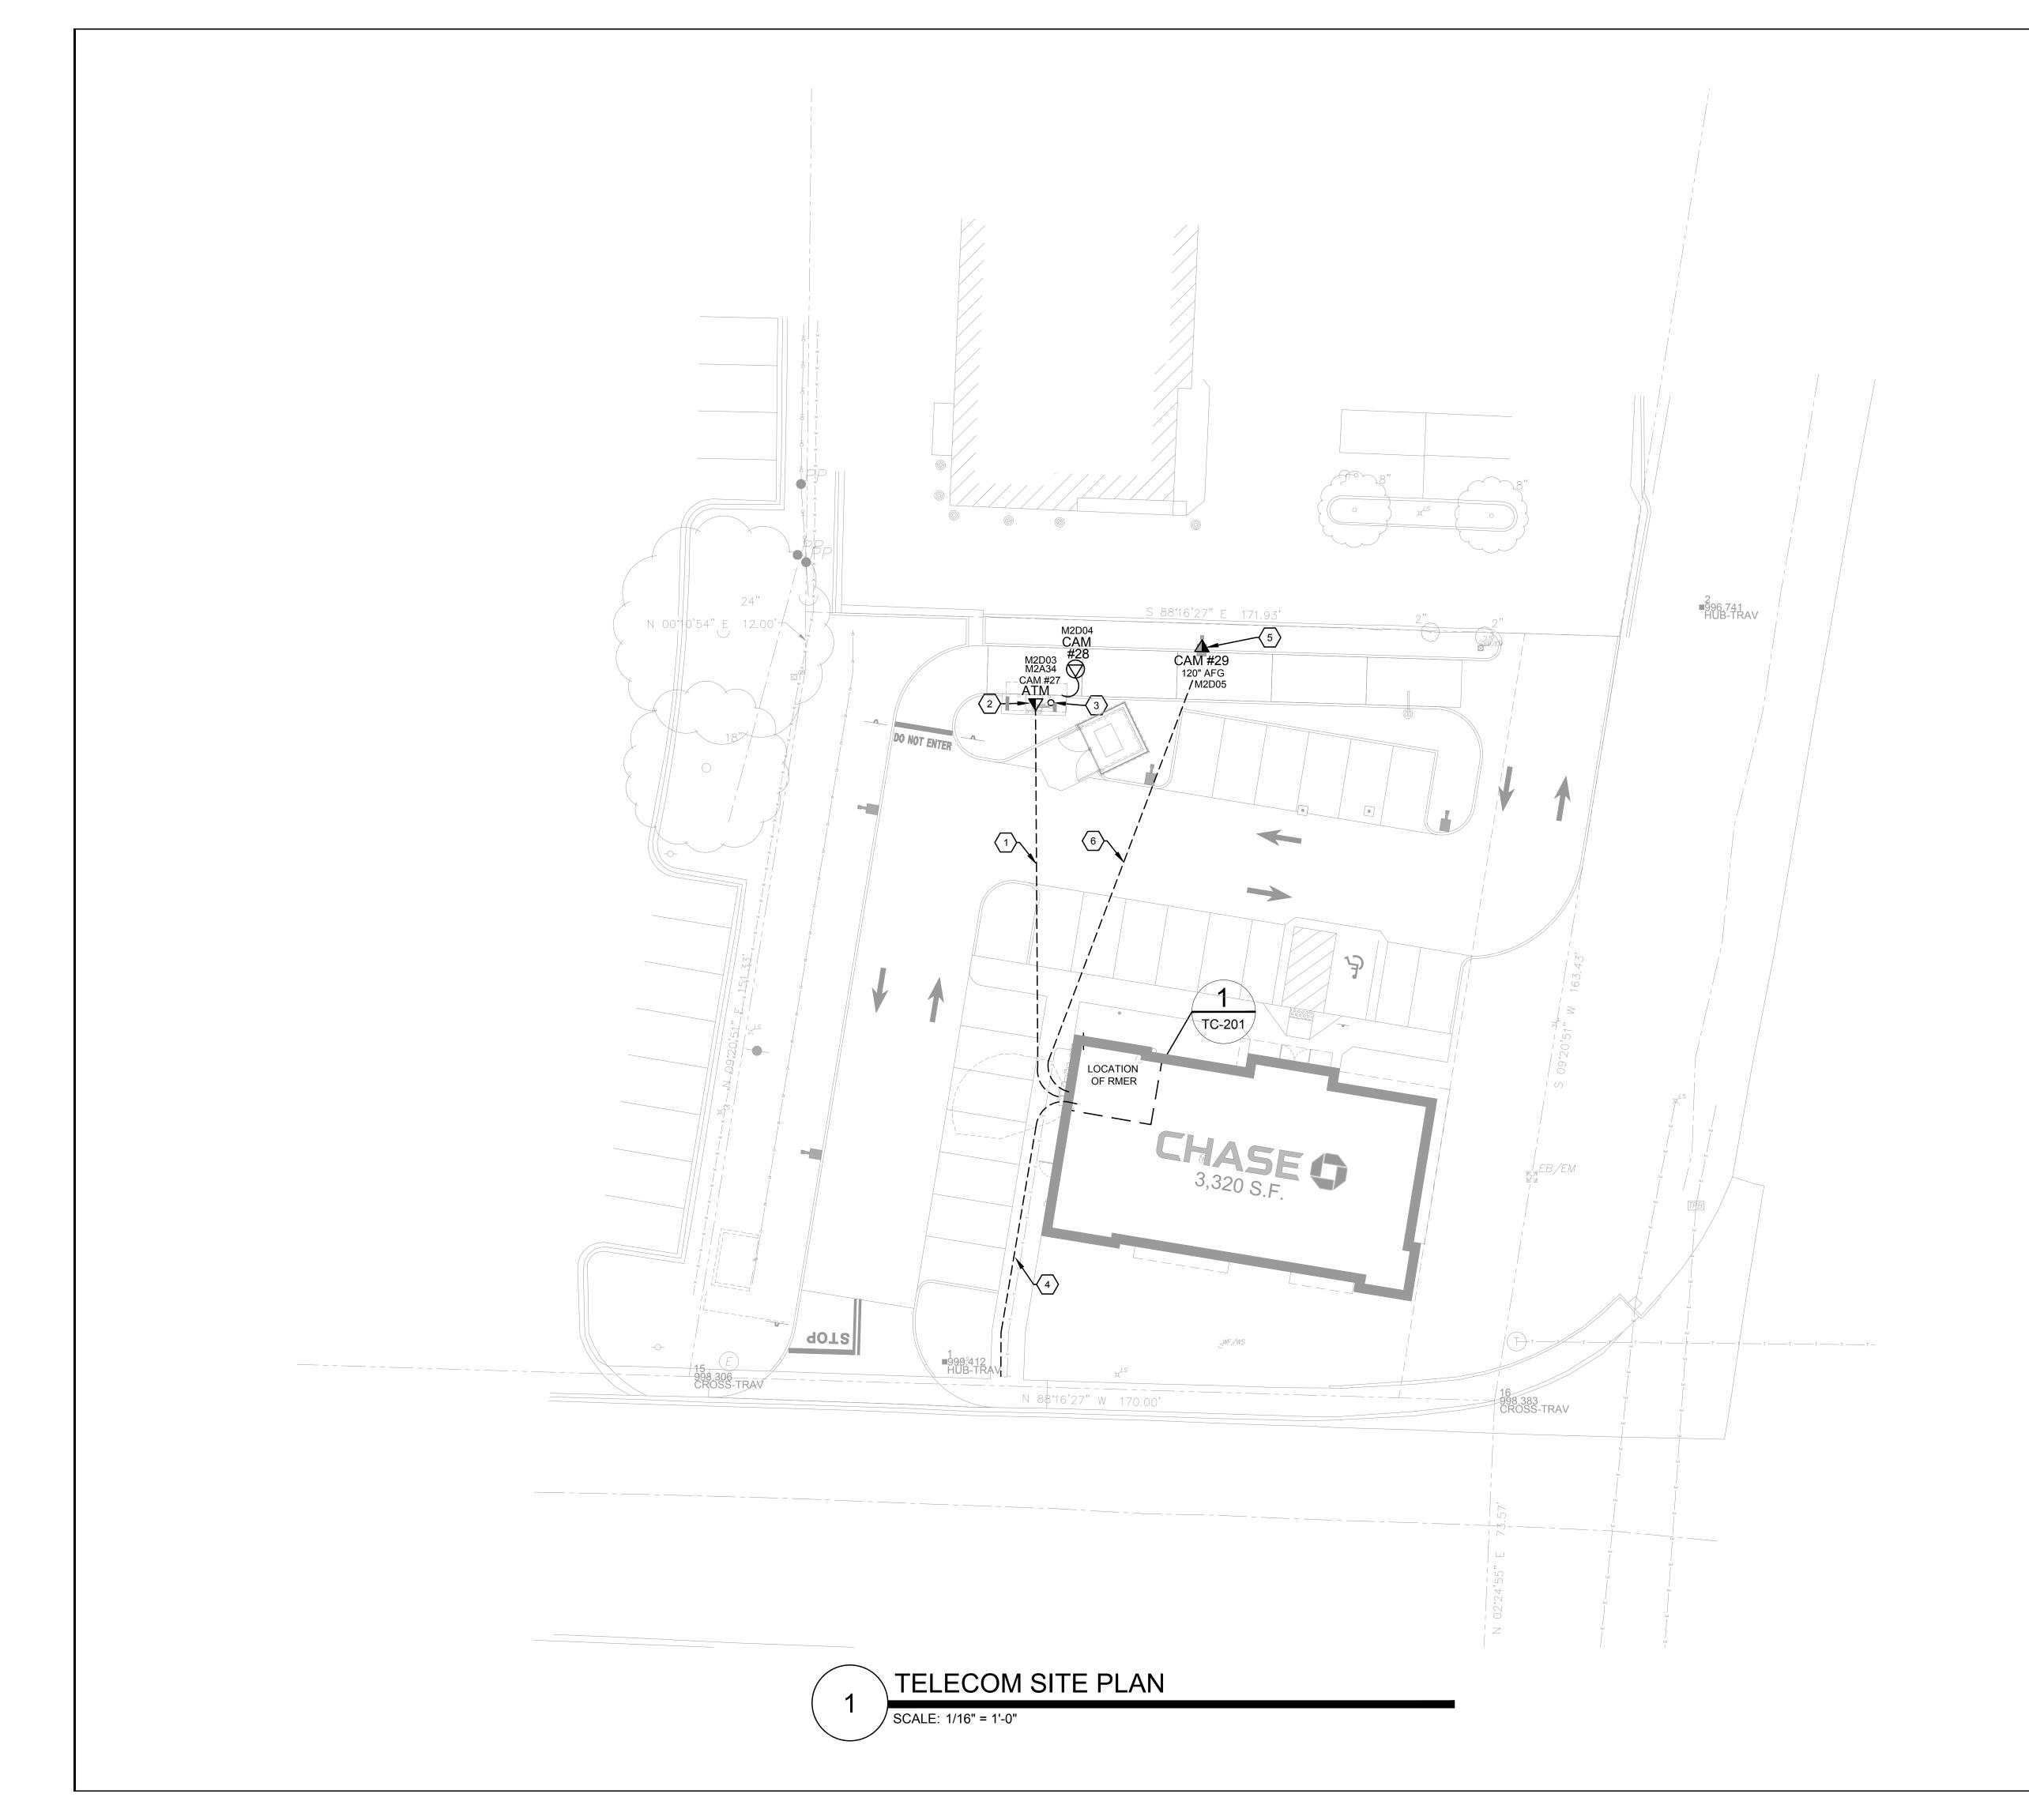

TELECOMMUNICATIONS PLAN NOTES (#)

- 1. PROVIDE ONE (1) 2" CONDUIT TO EXTERIOR ATM LOCATION FROM RMER. PROVIDE 2" 3-CELL MAXCELL INNERDUCT AND SWEEPING 90-DEGREE BENDS.
- PROVIDE ATM OUTLET AT THIS LOCATION UTILIZING WET LISTED CABLING. REFER TO DETAIL ON SHEET TC-302 FOR ADDITIONAL FACEPLATE CONFIGURATION INFORMATION.
- 3. PROVIDE 1" VERTICAL CONDUIT FROM ATM OUTLET LOCATION TO CEILING SOFFIT FOR TELECOM CABLING. PROVIDE CAT6A CEILING CONNECTOR ASSEMBLY WITH 18" LONG PIGTAIL WITHIN CANOPY JUNCTION BOX. REFER TO ATM CANOPY MOUNTED IP-CCTV CAMERA INSTALLATION DETAIL ON SHEET TC-401.
- 4. PROVIDE TWO (2) 2" CONDUIT TO EXTERIOR SERVICE PROVIDER POLE/HANDHOLE LOCATION FROM RMER. PROVIDE 2" 3-CELL MAXCELL INNERDUCT AND SWEEPING 90-DEGREE BENDS. COORDINATE FINAL PLACEMENT WITH SERVICE PROVIDER AND JPMC PROJECT MANAGER. PROVIDE IN-GRADE FLUSH MOUNTED HANDHOLE SIZED PER BICSI TDMM STANDARDS FOR ALL RUNS THAT EXCEED TWO (2) 90-DEGREE BENDS.
- 5. POLE MOUNTED CCTV CAMERA. PROVIDE CAT6A WET LISTED CABLE FROM RMER TO OUTLET. COORDINATE MOUNTING HEIGHT WITH JPMC PROJECT MANAGER. PROVIDE CAT6A CEILING CONNECTOR ASSEMBLY WITH 18" LONG PIGTAIL WITHIN POLE MOUNTED JUNCTION BOX. REFER TO TC-401 FOR ADDITIONAL INFORMATION.
- 6. PROVIDE (1) 1" CONDUIT WITH SWEEP 90-DEGREE BENDS FROM RMER TO CCTV OUTLET. PROVIDE WET LISTED CAT 6A CABLES FOR EACH OUTLET. REFER TO TC-401 FOR ADDITIONAL INFORMATION. COORDINATE CAMERA MOUNTING HEIGHT WITH JPMC PROJECT MANAGER.

UNDERGROUND CONDUIT GENERAL NOTE

A. PROVIDE HANDHOLES SIZED PER THE BICSI TDMM FOR ALL CONDUIT RUNS THAT EXCEED TWO 90 DEGREE BENDS. PROVIDE HANDHOLE IN THE STRAIGHT RUN SECTION OF CONDUIT. REFER TO DETAILS ON TC-402 FOR FURTHER INFORMATION.

JPMorgan Chase & Co.

GLOBAL TECHNOLOGY INFRASTRUCTURE
END USER SERVICES
WORKPLACE TECHNOLOGY SERVICES
STRUCTURED CABLING ENGINEERING
1111 POLARIS PARKWAY, COLUMBUS, OHIO 43240

NEW RETAIL

BRANCH
HWY 291 AND SE

LANGSFORD RD

keyplan

FOR REFERENCE ONLY
ISSUED AND
PERMITTED BY OTHERS

seal



issue			
no	date	issue	by
Α	12.21.2020	ISSUED FOR COORDINATION	КВ
В	01.19.2021	ISSUED FOR CONSTRUCTION	КВ

JP MORGAN CHASE & CO 890 NE LANGSROD RD LEE'S SUMMIT, MO

designed KB date 01.19.2021 drawn KB checked CC scale AS NOTED


TELECOM SITE PLAN


job no.


OVP-38200P368999

sheet

		1	RACK EQUIPMEI	NT SCH	IEDULE		
ITEM	DESCRIPTION	MANUFACT.	MODEL NUMBER	ITEM	DESCRIPTION	MANUFACT.	MODEL NUMBER
(1A)	2-POST RACK, 45RU, BLACK FINISH	CPI	66353-703	(8B)	12" WIDE LADDER RACK - BLACK FINISH	СРІ	10250-712
2A)	6" WIDE, DOUBLE-SIDED VERTICAL CABLE MANAGER, BLACK FINISH	CPI	30095-703	8C)	LADDER RACK STRINGER RADIUS DROP 10.3" W - BLACK FINISH	СРІ	12101-701
2B)	10" WIDE, DOUBLE-SIDED VERTICAL CABLE MANAGER, BLACK FINISH	СРІ	30096-703	8D	LADDER RACK CABLE RETAINING POSTS	CPI	10596-706
3A)	2RU HORIZONTAL CABLE MANAGER, BLACK FINISH	СРІ	30130-719	8E	LADDER RACK WALL ANGLE SUPPORT KIT	СРІ	11421-712
3B	1RU HORIZONTAL CABLE MANAGER, BLACK FINISH	CPI	30139-719	8F)	EQUIPMENT SHELF	CPI	11359-719
(4A)	MODULAR, ANGLED, 48-PORT PATCH PANEL	COMMSCOPE / SYSTIMAX	760187211	9A	NETWORK SWITCH	CISCO	PROVIDED BY OWNER
4 B	MODULAR, ANGLED, 24-PORT PATCH PANEL	COMMSCOPE / SYSTIMAX	760187203	9B)	NETWORK ROUTER	CISCO	PROVIDED BY OWNER
4C)	CATEGORY 6A RATED, ANGLED, SHIELDED 24-PORT PATCH PANEL	LEVITON	4S256-S24 WITH 6ASJK-RW6	90	CELLULAR NETWORK ROUTER WITH ANTENNA	CISCO	PROVIDED BY OWNER
5A)	1RU FIBER OPTIC PANEL WITH DUPLEX LC CONNECTOR PANELS	CORNING	CCH-01U WITH CCH-CP24-A9	9D	REMOTE ANTENNA FOR CELLULAR NETWORK ROUTER	CISCO	PROVIDED BY OWNER
6A)	RACK MOUNTED HORIZONTAL GROUNDING BUSBAR KIT (SEE GROUNDING SCHEMATIC)	PANDUIT	RGRB19U	9E)	DIGITAL SIGNAGE PC	BY AV INSTALLER	BY AV INSTALLER
7A)	BLACK VERTICAL POWER DISTRIBUTION UNIT WITH MOUNTING BRACKET FOR IT EQUIPMENT ONLY	CPI	TS1035241 WITH TS1012713	9F)	HDBASET TRANSMITTER	BY AV INSTALLER	BY AV INSTALLER
7B)	WHITE VERTICAL POWER DISTRIBUTION UNIT WITH MOUNTING BRACKET FOR IT EQUIPMENT ONLY	CPI	TS1035242 WITH TS1012713	9 G	SERVER AND MOUNTING BRACKET (CPI 12751-719)	PROVIDED BY OWNER	PROVIDED BY OWNER
7C)	HORIZONTAL POWER DISTRIBUTION UNIT FOR AV EQUIPMENT ONLY	CYBER POWER	BY AV INSTALLER	9H	UPS AND MOUNTING BRACKET	PROVIDED BY OWNER	PROVIDED BY OWNER
8A)	2RU BLANK PANEL - BLACK FINISH	СРІ	30024-702	10	RECEPTACLES MOUNTED ON A SE C-CHANNEL (UNISTRUT) BELOW THE LA & ABOVE THE RACKS.		PROVIDED BY EC
				11	ALL-THREAD TO STRUCTUR	E	PROVIDED BY TC

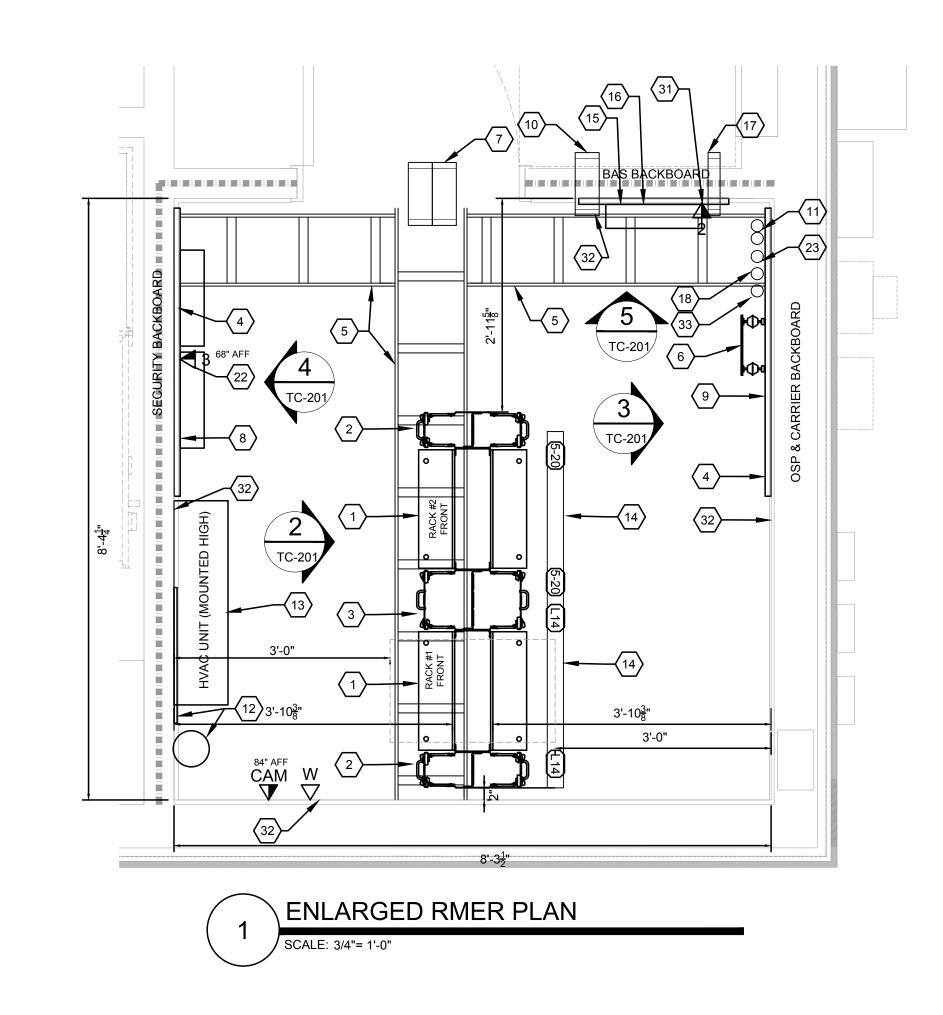

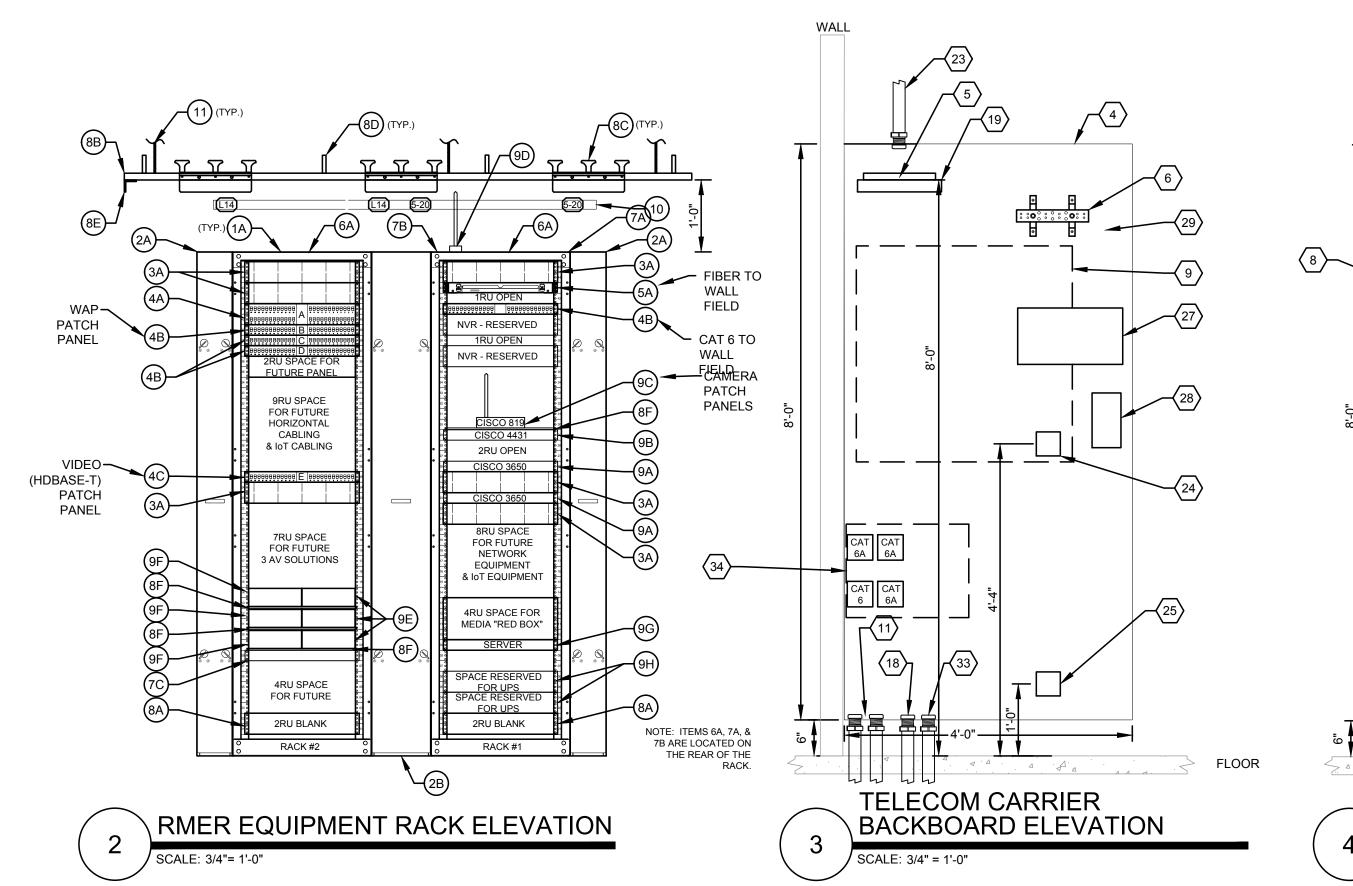

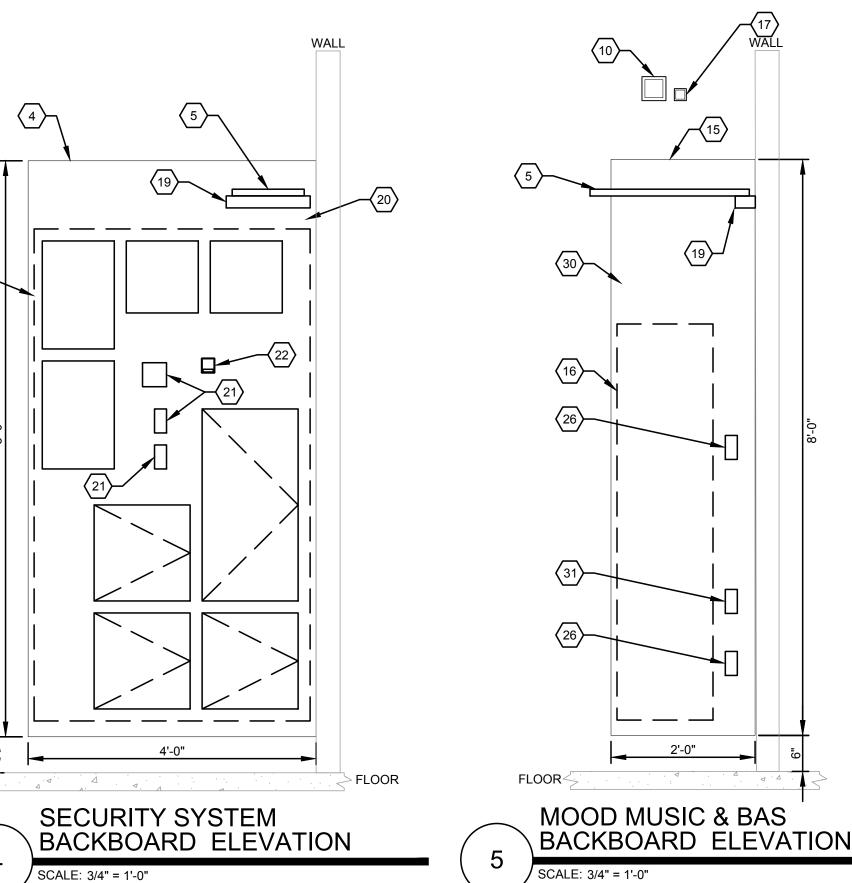

ENLARGED MAIN EQUIPMENT ROOM NOTES

- 1. NEW 2-POST RACK WITH BLACK FINISH.

- NEW WALL MOUNTED, FIRE-RATED PLYWOOD BACKBOARD, 4' WIDE BY 8' TALL BY 3/4" THICK, BOTTOM MOUNTED 6" ABOVE FINISHED FLOOR. PAINT WITH FIRE-RETARDANT PAINT TO MATCH ROOM COLOR AND LEAVE ONE FIRE-RATED STAMP VISIBLE.
- 5. NEW 12" WIDE LADDER RACK OVERHEAD WITH BLACK FINISH.
- MOUNT 6" BELOW THE BOTTOM OF THE LADDER RACK.
- SECURITY EQUIPMENT.

- 12. PROVIDE A DRAWING OF THE FLOOR PLAN AS-BUILT WITH ALL HORIZONTAL CABLING LABELS FOR EACH OUTLET. MOUNT DRAWING TO WALL. PROVIDE ADDITIONAL FULL SIZE DRAWING TUBE ADJACENT TO CABLING DRAWING WITH A COMPLETE FULL SIZE SET OF ALL CONSTRUCTION AS-BUILT DRAWINGS FOR SITE
- 13. SPACE FOR WALL MOUNTED HVAC UNIT. BOTTOM MOUNTED 8'-0" AFF WITH DRIP PAN AND DRIP PAN LEAK DETECTION. HVAC CONTRACTOR SHALL PROVIDE PROTECTION ON ALL SHARP CORNER EDGES.
- EZ-PATH PART # EZD22) FOR MOOD MUSIC SYSTEM AND BMS CABLING USE ONLY.
- 18. PROVIDE 2" CONDUIT TO EXTERIOR ATM LOCATION AS SHOWN SWEEPING 90-DEGREE BENDS.
- 20. ALL SECURITY SYSTEM CABLING MUST BE AFFIXED TO WALL AND/OR FIXED CONVEYANCE WITH HANGERS, VELCRO AND TIES. NO HANGING CABLES. (TYPICAL)
- PANEL FOR EQUIPMENT NETWORK CONNECTION. COORDINATE WITH SECURITY CONTRACTOR TO PROVIDE ONE CONNECTION FOR EACH PANEL WITHIN SINGLE GANG BACK BOX AND
- 23. PROVIDE 1" CONDUIT TO ROOF LOCATION FOR FUTURE ANTENNA CABLING. REFER TO SHEET TC-402 FOR ADDITIONAL
- 25. QUAD POWER OUTLET ON A DEDICATED CIRCUIT AND CONDUIT HOMERUN FOR FUTURE EQUIPMENT.
- 26. DEDICATED DUPLEX OUTLET FOR SOUND SYSTEM AND/OR
- 27. 12-PORT FIBER ENCLOSURE FOR EXTENSION OF CARRIER CONNECTIONS TO RACK. LABEL PORTS TO MATCH RACK
- CONNECTIONS TO RACK. COMMSCOPE PART #106658156.
- 29. ALL CARRIER CABLING MUST BE AFFIXED TO WALL AND/OR FIXED CONVEYANCE WITH HANGERS, VELCRO AND TIES. NO HANGING CABLES. (TYPICAL)
- 30. ALL SECURITY, BAS, & SOUND SYSTEM CABLING MUST BE VELCRO AND TIES. NO HANGING CABLES (TYPICAL).
- CONNECTION.
- 34. PROVIDE SURGE PROTECTION FOR EACH CAT6 AND CAT6A CABLE LEAVING THE ROOM TO SERVE POLE MOUNTED CAMERAS AND ANY FREESTANDING ATM ISLAND/CANOPY DEVICES. PROVIDE ITW #CAT6-75 PROTECTION FOR EACH CAT6 CABLE AND ITW #CAT6A-75 FOR EACH CAT6A CABLE. BOND TO THE

- 2. NEW 6" WIDE VERTICAL WIRE MANAGER WITH BLACK FINISH.
- 3. NEW 10" WIDE VERTICAL WIRE MANAGER WITH BLACK FINISH

- 6. LOCATION OF THE TELECOMMUNICATIONS GROUND BUSBAR.
- PROVIDE TWO 4" PRE-MANUFACTURED FIRE-RATED SLEEVES (STI EZ-PATH PART # EZD44S2) WITH WATERFALL ADAPTER (STI PART #EZRCM44S) FOR STRUCTURED CABLING USE ONLY. USE MUTLI-GANG PLATE (STI PART #EZP544W).
- 8. 4' WIDE BY 7'-0" TALL WALL FIELD AREA RESERVED FOR
- 9. 3' WIDE BY 3' TALL WALL FIELD AREA RESERVED ON BACKBOARD FOR CARRIER EQUIPMENT TO BE MOUNTED.
- 10. PROVIDE ONE 4" PRE-MANUFACTURED FIRE-RATED SLEEVE (STI EZ-PATH PART # EZDP44S2) FOR SECURITY CABLING USE ONLY.
- 11. E.C. TO PROVIDE TWO 2" CONDUITS FROM THE RMER TO THE CARRIER POINT OF ENTRY. ONE CONDUIT FOR THE SERVICE PROVIDER TO EXTEND THEIR DEMARCATION INTO THE NEW RMER. ONE CONDUIT WILL BE OWNER SPARE. THE E.C SHALL FIELD COORDINATE THIS ROUTE WITH THE BUILDING OWNER AND TELECOMMUNICATIONS CARRIER PRIOR TO INSTALLATION. PROVIDE 2" 3-CELL MAXCELL INNERDUCT AND SWEEPING 90-DEGREE BENDS.

- 14. EC TO PROVIDE A C-CHANNEL (UNI-STRUT) WITH TWO L14-30 OUTLET AT RACK #1 AND TWO NEMA 5-20 OUTLETS AT RACK #2 MOUNTED AT 7'-6" AFF. EACH OUTLET SHALL BE ON A DEDICATED CIRCUIT. EC TO MOUNT THIS INDEPENDENTLY FROM THE LADDER RACK.
- 15. NEW WALL MOUNTED, FIRE-RATED PLYWOOD BACKBOARD, 2' WIDE BY 8' TALL BY 3/4" THICK, BOTTOM MOUNTED 6" ABOVE FINISHED FLOOR. PAINT WITH FIRE-RETARDANT PAINT TO MATCH ROOM COLOR AND LEAVE ONE FIRE-RATED STAMP VISIBLE.
- 16. 1'-4" WIDE BY 5'-6" TALL WALL FIELD AREA RESERVED FOR MOOD MUSIC AND BUILDING AUTOMATION SYSTEM (BAS) EQUIPMENT.
- 17. PROVIDE ONE 2" PRE-MANUFACTURED FIRE-RATED SLEEVE (STI
- ON SHEET TC-102. PROVIDE 2" 3-CELL MAXCELL INNERDUCT AND
- 19. WALL MOUNTED SUPPORT BRACKET FOR LADDER RACK.
- 21. POWER CONNECTIONS ON DEDICATED CIRCUITS AND CONDUIT HOMERUN FOR SECURITY EQUIPMENT. EC TO COORDINATE ADDITIONAL CONNECTIONS REQUIRED, OUTLET MOUNTING HEIGHT, AND OUTLET CONFIGURATIONS & LOCATIONS ON THE BACKBOARD WITH THE SECURITY VENDOR.
- 22. SURFACE MOUNTED DATA OUTLETS FOR THE ACCESS CONTROL
- INFORMATION.

FACEPLATE.

- 24. QUAD POWER OUTLET ON A DEDICATED CIRCUIT AND CONDUIT HOMERUN FOR CARRIER EQUIPMENT.
- BUILDING AUTOMATION SYSTEM (BAS)EQUIPMENT.
- MOUNTED FIBER PANEL. CORNING PART # PWH-02P.
- 28. 12-PORT OUTLET FOR COPPER EXTENSION OF CARRIER
- AFFIXED TO WALL AND/OR FIXED CONVEYANCE WITH HANGERS,
- 31. SURFACE MOUNTED DATA OUTLET FOR THE BUILDING AUTOMATION SYSTEM (BAS) PANEL FOR EQUIPMENT NETWORK
- 32. LOCATION FOR CONVENIENCE ELECTRICAL RECEPTACLE (BY DIV
- 33. APPROXIMATE LOCATION OF THE 1" CONDUIT TO CCTV AND LIGHTING POLE. FIELD COORDINATE FINAL LOCATION.
- GROUNDING BAR PER MANUFACTURER REQUIREMENTS.

JPMORGAN CHASE & Co.

GLOBAL TECHNOLOGY INFRASTRUCTURE END USER SERVICES WORKPLACE TECHNOLOGY SERVICES STRUCTURED CABLING ENGINEERING 1111 POLARIS PARKWAY, COLUMBUS, OHIO 43240

NEW RETAIL BRANCH -**HWY 291 AND SE** LANGSFORD RD

keyplan

FOR REFERENCE ONLY ISSUED AND PERMITTED BY OTHERS

seal



issue			
no	date	issue	by
Α	12.21.2020	ISSUED FOR COORDINATION	KB
В	01.19.2021	ISSUED FOR CONSTRUCTION	KB

JP MORGAN CHASE & CO **890 NE LANGSROD RD** LEE'S SUMMIT, MO

designed KB 01.19.2021 scale AS NOTED checked

FIRST FLOOR ENLARGED RMER PLAN AND ELEVATIONS

job no.


OVP-38200P368999

sheet

REMOTE/U	SER END PATCH CO	ORD REQUIREMENTS	<u> </u>
OUTLET TYPE	CABLE CATEGORY	LENGTH	QTY PER OUTLET
WORKSTATION / CUBICLE / OFFICE (OUTLET TO PHONE)	CAT 6	7 FOOT	1
WORKSTATION / CUBICLE / OFFICE (PHONE TO COMPUTER)	CAT 6	5 FOOT	1
PRINTER	CAT 6	7 FOOT	1
ATM OUTLETS	CAT 6	7 FOOT	1
WALL PHONE OUTLET	F	PROVIDED WITH PHONE	
VIDEO MONITOR OUTLETS	CAT 6A SHIELDED	5 FOOT	1
TELEPRESENCE CONTROL OUTLETS	CAT 6A SHIELDED	5 FOOT	2
IP-CCTV CAMERA INTEGRAL TO ATM	CAT 6A	7 FOOT	1
RMER / R	TR END PATCH COF	RD REQUIREMENTS	
PATCH PANEL TYPE	CABLE TYPE	LENGTH	QTY PER PORT
CAT6 UTP PATCH PANEL SHORTER PULL	CAT 6	7 FOOT	1
CAT6 UTP PATCH PANEL LONGER PULL	CAT 6	10 FOOT	1
SHIELDED PATCH PANEL	CAT 6A SHIELDED	7 FOOT	1
CAT6A UTP PATCH PANEL SHORTER PULL	CAT 6A	7 FOOT	1
CAT6A UTP PATCH PANEL LONGER PULL	CAT 6A	10 FOOT	1
FIBER PATCH PANEL	SINGLE MODE - DUPLEX	1-2 METER	2

CONFIRM LENGTHS AND QUANTITIES PRIOR TO ORDERING. PULL/PATCH SCHEDULE TEMPLATE SHALL BE PROVIDED BY THE JPMC GTI PM AND TC SHALL BE RESPONSIBLE FOR FILLING THE REQUIRED COLUMNS AS DIRECTED. LENGHTS NOTED ARE FOR CONTRACTOR PRICING PURPOSES. EXACT LENGTHS SHALL BE FIELD VERIFIED PRIOR TO PURCHASING.

FOR RMER/RTR END, THE CONTRACTOR SHALL ORDER PATCH CORD LENGTHS SO THAT NO MORE THAN 1' OF SLACK IS INCLUDED IN EACH PATCH CORD AFTER INSTALLATION. THEREFORE, THE TC SHALL FIELD MEASURE THE REQUIRED LENGTHS. THE LENGTHS SHOWN ABOVE ARE FOR PRICING PURPOSES ONLY.

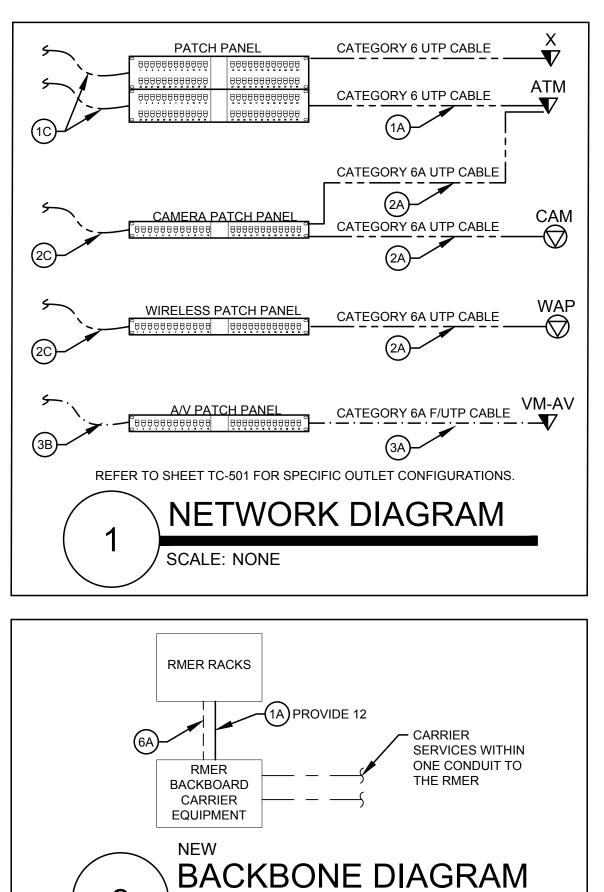


SCALE: NONE

		CABLE SCHED	ULE			
TYPE	NUMBER	DESCRIPTION	MANUFACTURER	MODEL NUMBER		
R 3 UTP	(1A)	CATEGORY 6, PLENUM RATED, HORIZONTAL UTP GRAY CABLE	COMMSCOPE/ SYSTIMAX	700210198 (REEL) 700214372 (BOX)		
INTERIOR CATEGORY 6 UTP	1B)	CATEGORY 6, NON-PLENUM RATED HORIZONTAL UTP GRAY CABLE	COMMSCOPE/ SYSTIMAX	700211923 (REEL) 700211931 (BOX)		
LIA CATE	1C)	CATEGORY 6 PATCH CORD	COMMSCOPE/ SYSTIMAX	CPC3312-03F0##, WHERE ## = LENGTH		
, 6A	2A)	CATEGORY 6A, PLENUM RATED, HORIZONTAL UTP WHITE CABLE	COMMSCOPE/ SYSTIMAX	760105940 (REEL) 760107268 (BOX)		ABLING INSTALLATION GENERAL NOTES:
INTERIOR CATEGORY 6A UTP	2B)	CATEGORY 6A, NON-PLENUM RATED, HORIZONTAL UTP WHITE CABLE	COMMSCOPE/ SYSTIMAX	760105817	-	CABLES ROUTED IN WALLS AND COLUM
CAT	2C)	CATEGORY 6A, PATCH CORD	COMMSCOPE/ SYSTIMAX	CPCSSX2-08F0##, WHERE ## = LENGTH		ROUTED IN FLOOR SLAB SHALL BE IN C IN JPMC OWNED SPACE SHALL BE IN CO CONDUIT QUANTITIES, PLACEMENT ANI
R ′6A	(3A)	CATEGORY 6A, PLENUM RATED, HORIZONTAL F/UTP BLUE CABLE	BERK-TEK	10143424	В.	CABLE PATHWAYS ARE SHOWN FOR DIA PATHWAYS MAY BE DIFFERENT. TC SH
INTERIOR CATEGORY 6 F/UTP	ЗВ	CATEGORY 6A, F/UTP, BLUE PATCH CORD	LEVITON	6AS10-##L, WHERE ## = LENGTH		TERMINATION LOCATION OF THE CABLE CABLES.
IN	3C)	CATEGORY 6A, F/UTP, BLUE PATCH CORD	LEVITON	6AS10-03L	C.	THE SINGLE LINE DIAGRAM IS DIAGRAM NOT BE USED FOR DISTANCE CALCULA
RIOR SORY IP	(4A)	CATEGORY 6, OSP RATED, HORIZONTAL UTP CABLE	COMMSCOPE/ SYSTIMAX	760008888	D.	SUPPORTED IN ACCORDANCE WITH AL
EXTERIOR CATEGORY 6 UTP	(4B)	CATEGORY 6, OSP RATED, PATCH CORD	COMMSCOPE/ SYSTIMAX	CO15542-01F0##, WHERE ## = LENGTH		RUN IN COMMON BUILDING AREAS AND FOR THE FULL RUN OUTSIDE OF JPMC ACCESSIBLE TO ANYONE OTHER THAN
SIOR SORY TP	(5A)	CATEGORY 6A, OSP RATED, HORIZONTAL UTP CABLE	COMMSCOPE/ SYSTIMAX	760178129		BOXES AND OTHER ACCESS POINTS RE PROVIDED WITH LOCKS SO THAT THE C THAN JPMC PERSONNEL.
EXTERIOR CATEGORY 6A UTP	(5B)	CATEGORY 6A, OSP RATED, PATCH CORD	COMMSCOPE/ SYSTIMAX	CO15582-01F0##, WHERE ## = LENGTH	E.	FOR EACH CAT 6 AND CAT 6A CABLING ISLAND ATM'S, ATM CANOPY CAMERAS
	6A)	12-STRAND SINGLE MODE, INDOOR, PLENUM RATED FIBER BACKBONE	CORNING	012E88-33131-29		PROVIDE A SURGE PROTECTION DEVIC SLAB PENETRATION.
FIBER	(6B)	HYBRID FIBER (2-STRAND SINGLE MODE) WITH COPPER (TWO 12AWG), OUTDOOR RATED HORIZONTAL CABLE	BERK-TEK	ONE-REACH SERIES		
<u> </u>	6C)	SINGLE MODE FIBER PATCH CORD - DUPLEX LC	CORNING	787802GD120###M, WHERE ### = LENGTH		CABLE LINE
	(6D)	MULTIMODE FIBER PATCH CORD - DUPLEX LC TO LC	CORNING	050502T5116###M, WHERE ### = LENGTH	-	— – – — — – – — UTP 4-F
NOTES		ATCH CORDS WITHOUT AN EXACT LENGTH	SPECIFIED THE CON		-	-·-·- F/UTP
1,0120		IE THE LENGTH SO THERE IS NO MORE THA			-	CARRIE
	B. ALL CA	BLE TYPES LISTED ABOVE MAY NOT BE US	ED ON EVERY PROJE	СТ.	_	SINGLE
	LC NON D	ENLIM CARLES CAN ONLY BE LISED WHEN	CITUED THE OADLING			HYBRIE

C. NON-PLENUM CABLES CAN ONLY BE USED WHEN EITHER THE CABLING IS TOTALLY WITHIN CONDUIT OR THE HVAC SYSTEM HAS A DUCTED AIR RETURN.

- A. CABLES ROUTED IN WALLS AND COLUMNS SHALL BE IN CONDUIT STUB-UPS. CABLES ROUTED IN FLOOR SLAB SHALL BE IN CONDUIT. ANY CABLE ROUTES THAT ARE NOT IN JPMC OWNED SPACE SHALL BE IN CONDUIT. (TC TO COORDINATE WITH EC FOR CONDUIT QUANTITIES, PLACEMENT AND SIZING).
- B. CABLE PATHWAYS ARE SHOWN FOR DIAGRAMMATICAL PURPOSES ONLY. ACTUAL PATHWAYS MAY BE DIFFERENT. TC SHALL VERIFY CABLE PATHWAYS AND RACK TERMINATION LOCATION OF THE CABLES IN THE FIELD PRIOR TO PULLING ANY
- C. THE SINGLE LINE DIAGRAM IS DIAGRAMMATIC FOR REFERENCE ONLY AND SHOULD NOT BE USED FOR DISTANCE CALCULATIONS OR QUANTITY TAKE-OFFS.
- D. ALL CABLING RUNS THAT REMAIN WITHIN JPMC AREAS SHALL BE PROPERLY SUPPORTED IN ACCORDANCE WITH ALL JPMC STANDARDS. ALL CABLING THAT IS RUN IN COMMON BUILDING AREAS AND OTHER TENANT SPACES MUST BE IN CONDUIT FOR THE FULL RUN OUTSIDE OF JPMC AREAS SUCH THAT NO JPMC CABLING IS ACCESSIBLE TO ANYONE OTHER THAN JPMC PERSONNEL. JUNCTION AND PULL BOXES AND OTHER ACCESS POINTS REQUIRED IN COMMON AREAS SHALL BE PROVIDED WITH LOCKS SO THAT THE CABLING IS INACCESSIBLE TO ANYONE OTHER THAN JPMC PERSONNEL.
- FOR EACH CAT 6 AND CAT 6A CABLING LEAVING THE BUILDING TO SERVE EXTERIOR ISLAND ATM'S, ATM CANOPY CAMERAS AND EXTERIOR POLE MOUNTED CAMERAS, PROVIDE A SURGE PROTECTION DEVICE WITHIN THE RMER AT THE LOCATION OF SLAB PENETRATION.

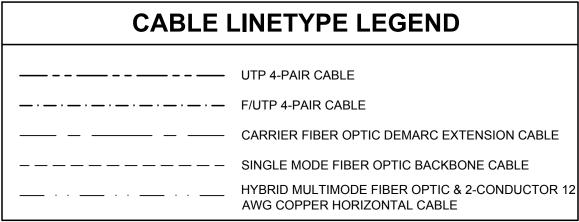

JPMORGAN CHASE & Co. GLOBAL TECHNOLOGY INFRASTRUCTURE

END USER SERVICES WORKPLACE TECHNOLOGY SERVICES STRUCTURED CABLING ENGINEERING 1111 POLARIS PARKWAY, COLUMBUS, OHIO 43240

NEW RETAIL BRANCH -**HWY 291 AND SE** LANGSFORD RD

keyplan

seal

FOR REFERENCE ONLY ISSUED AND PERMITTED BY OTHERS


no	date	issue	
Α	12.21.2020	ISSUED FOR COORDINATION	
В	01.19.2021	ISSUED FOR CONSTRUCTION	


JP MORGAN CHASE & CO 890 NE LANGSROD RD LEE'S SUMMIT, MO


designed KB 01.19.2021 scale AS NOTED checked

> **TELECOM** SINGLE LINE **DIAGRAM**

OVP-38200P368999

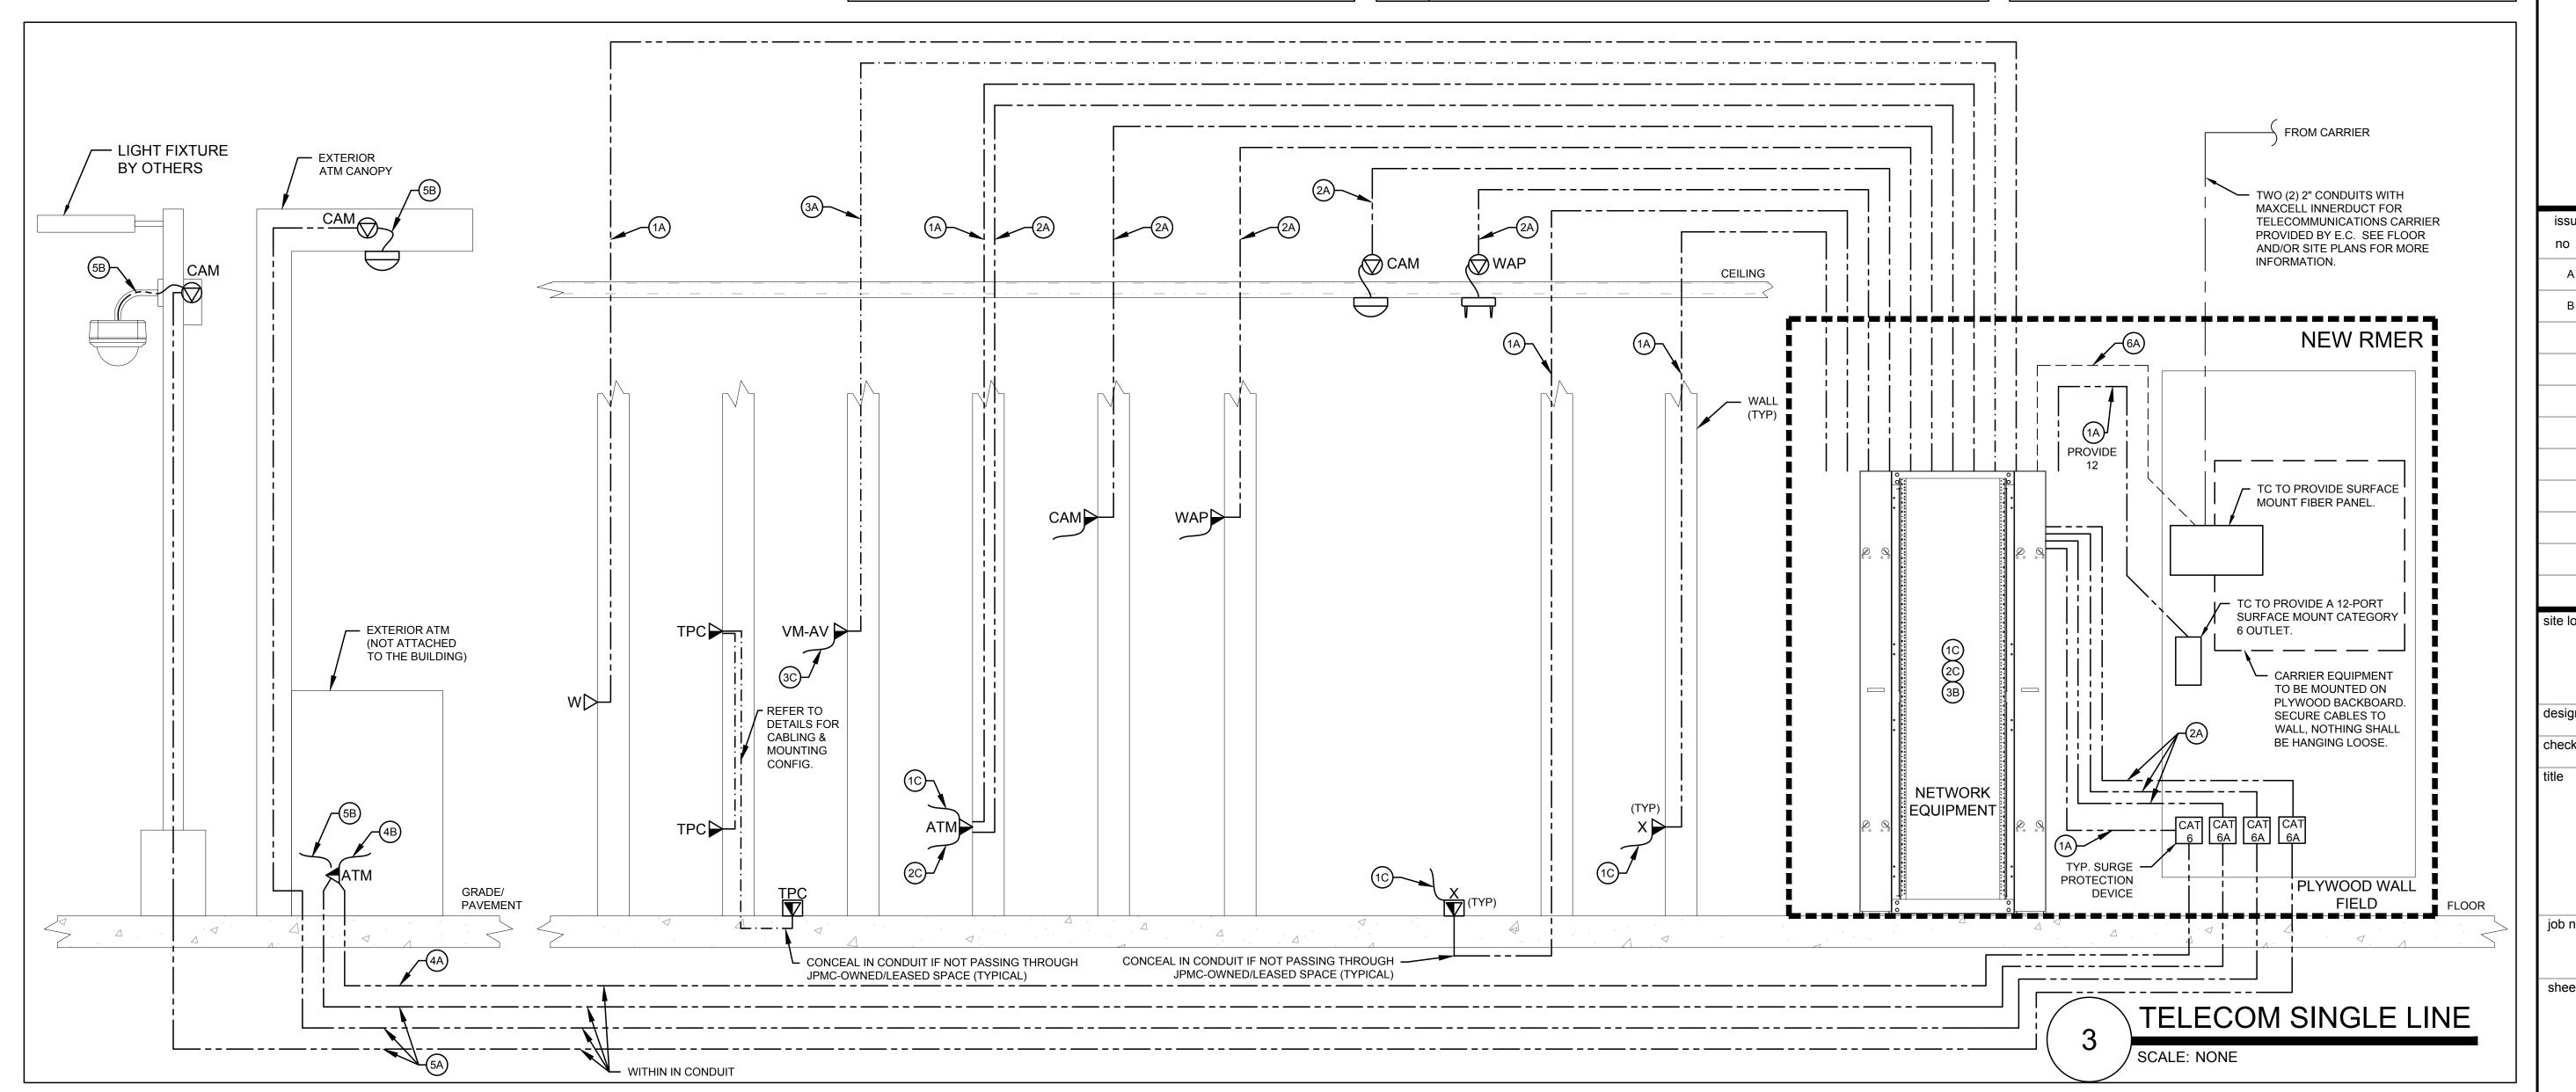

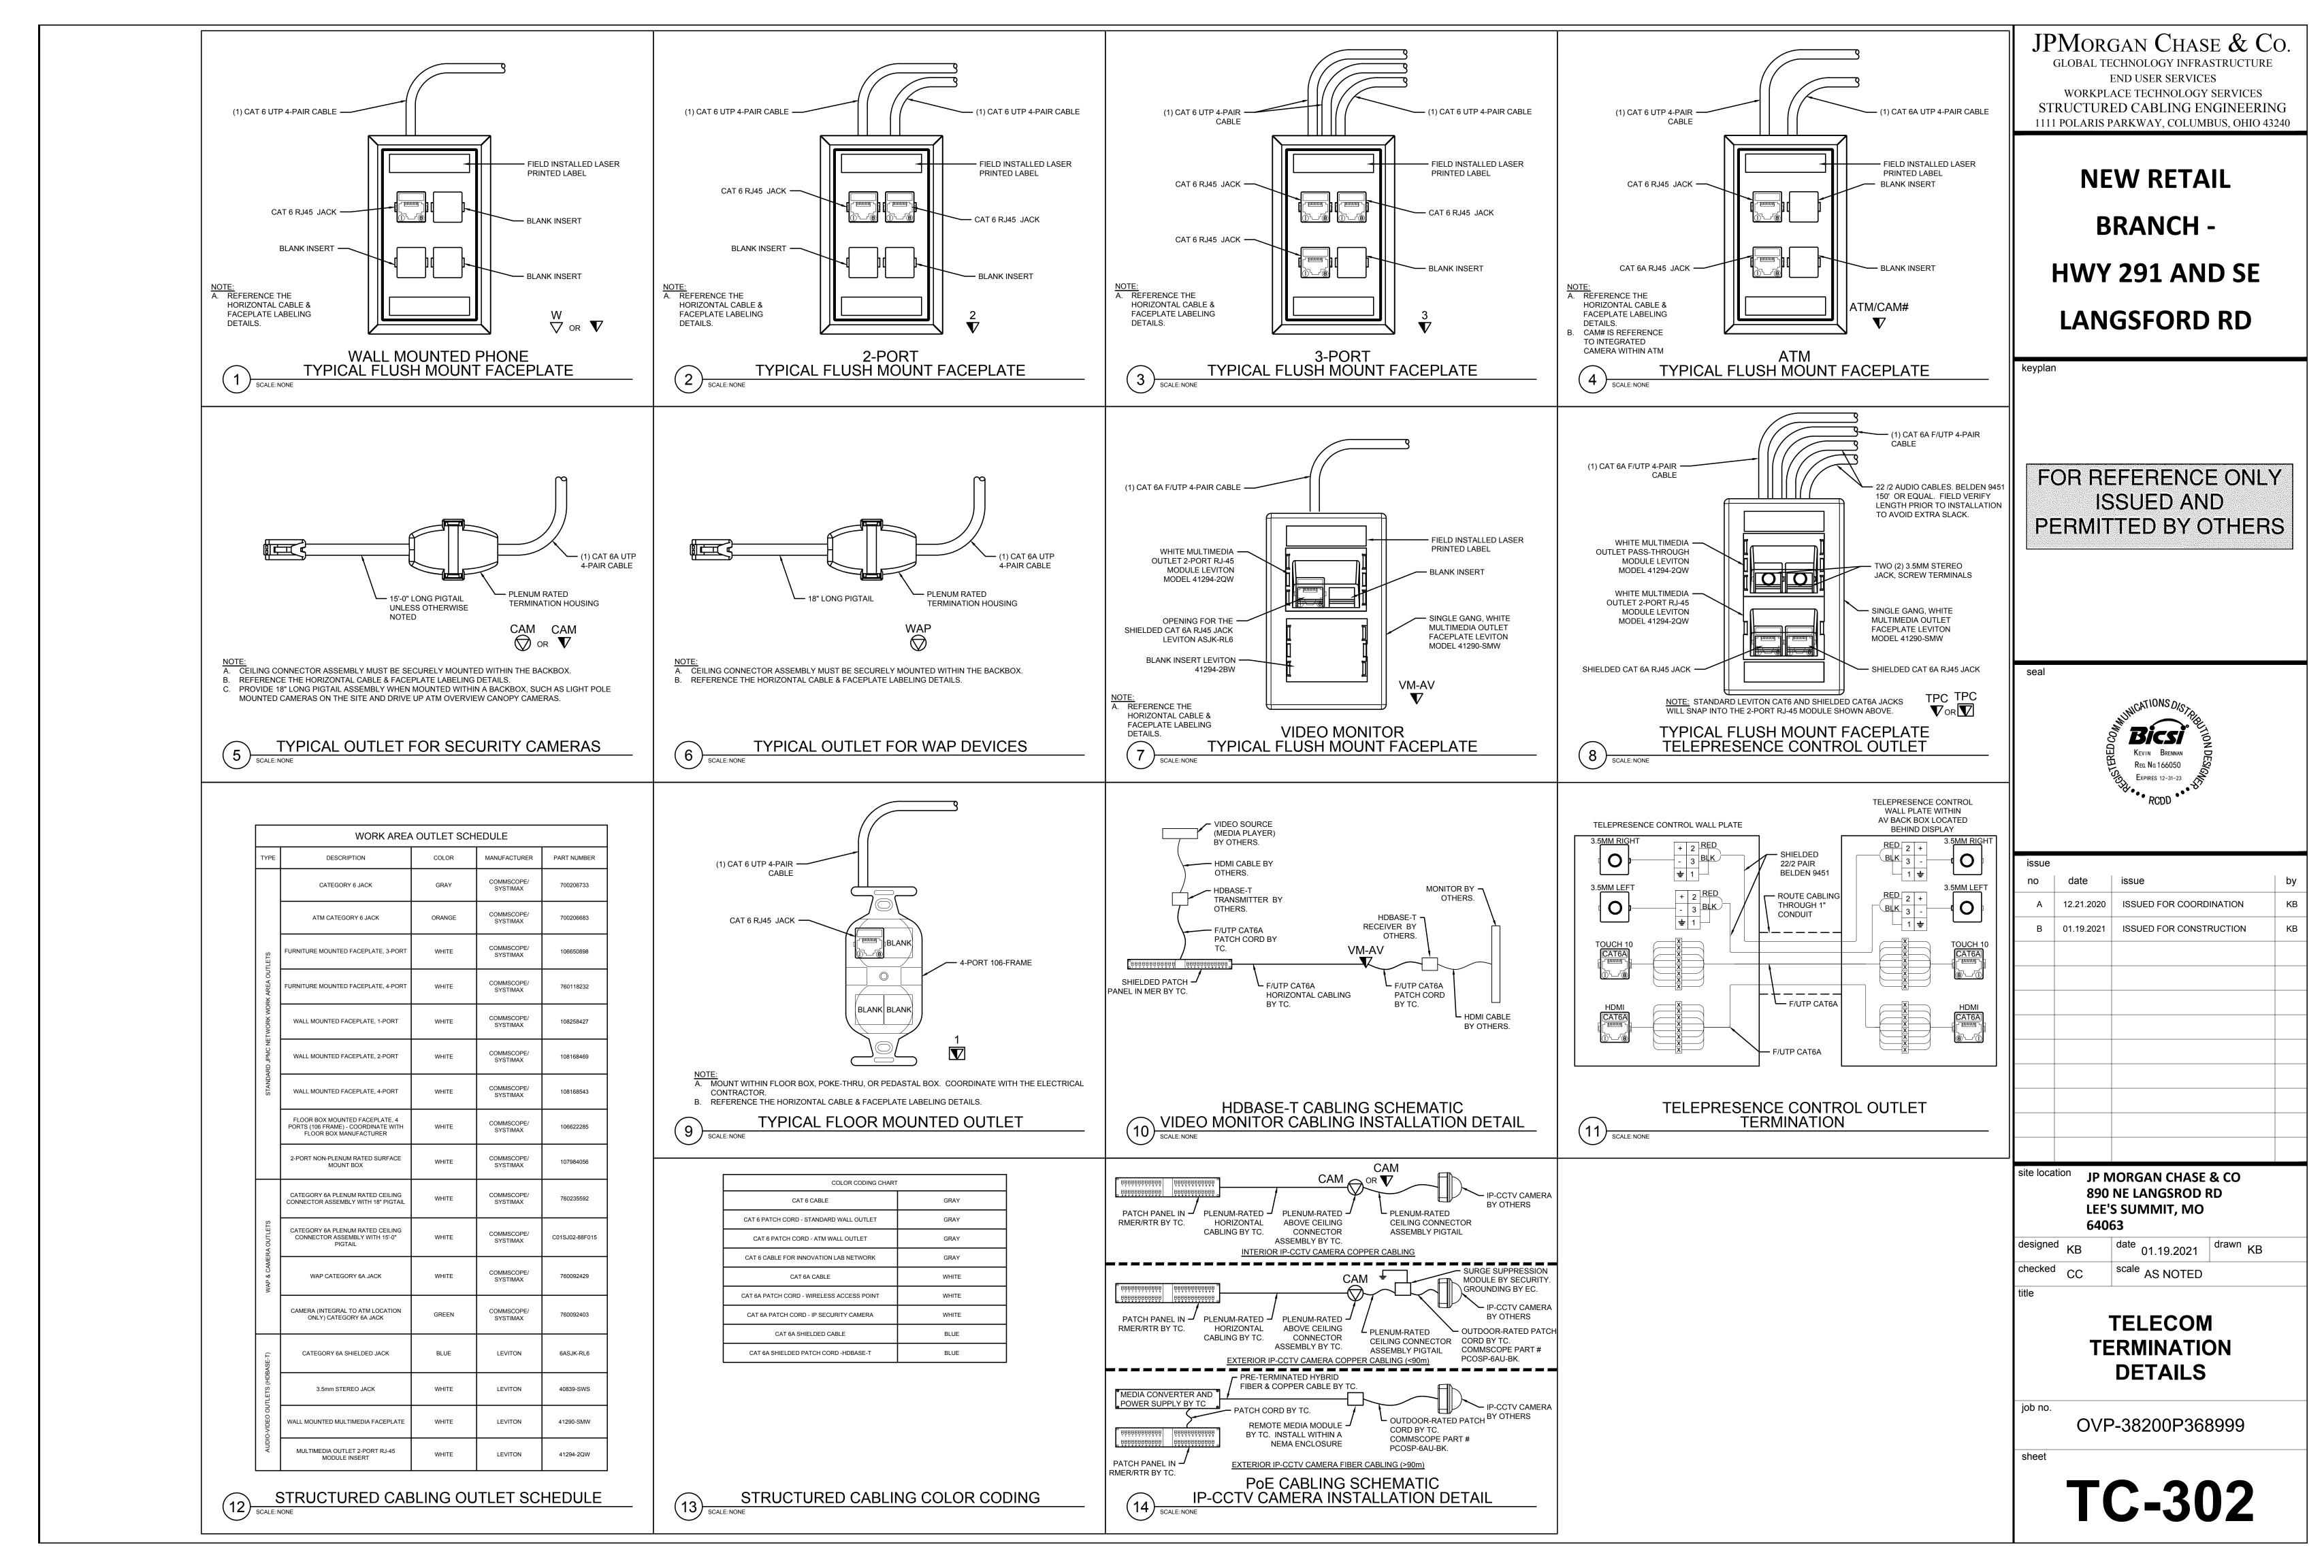

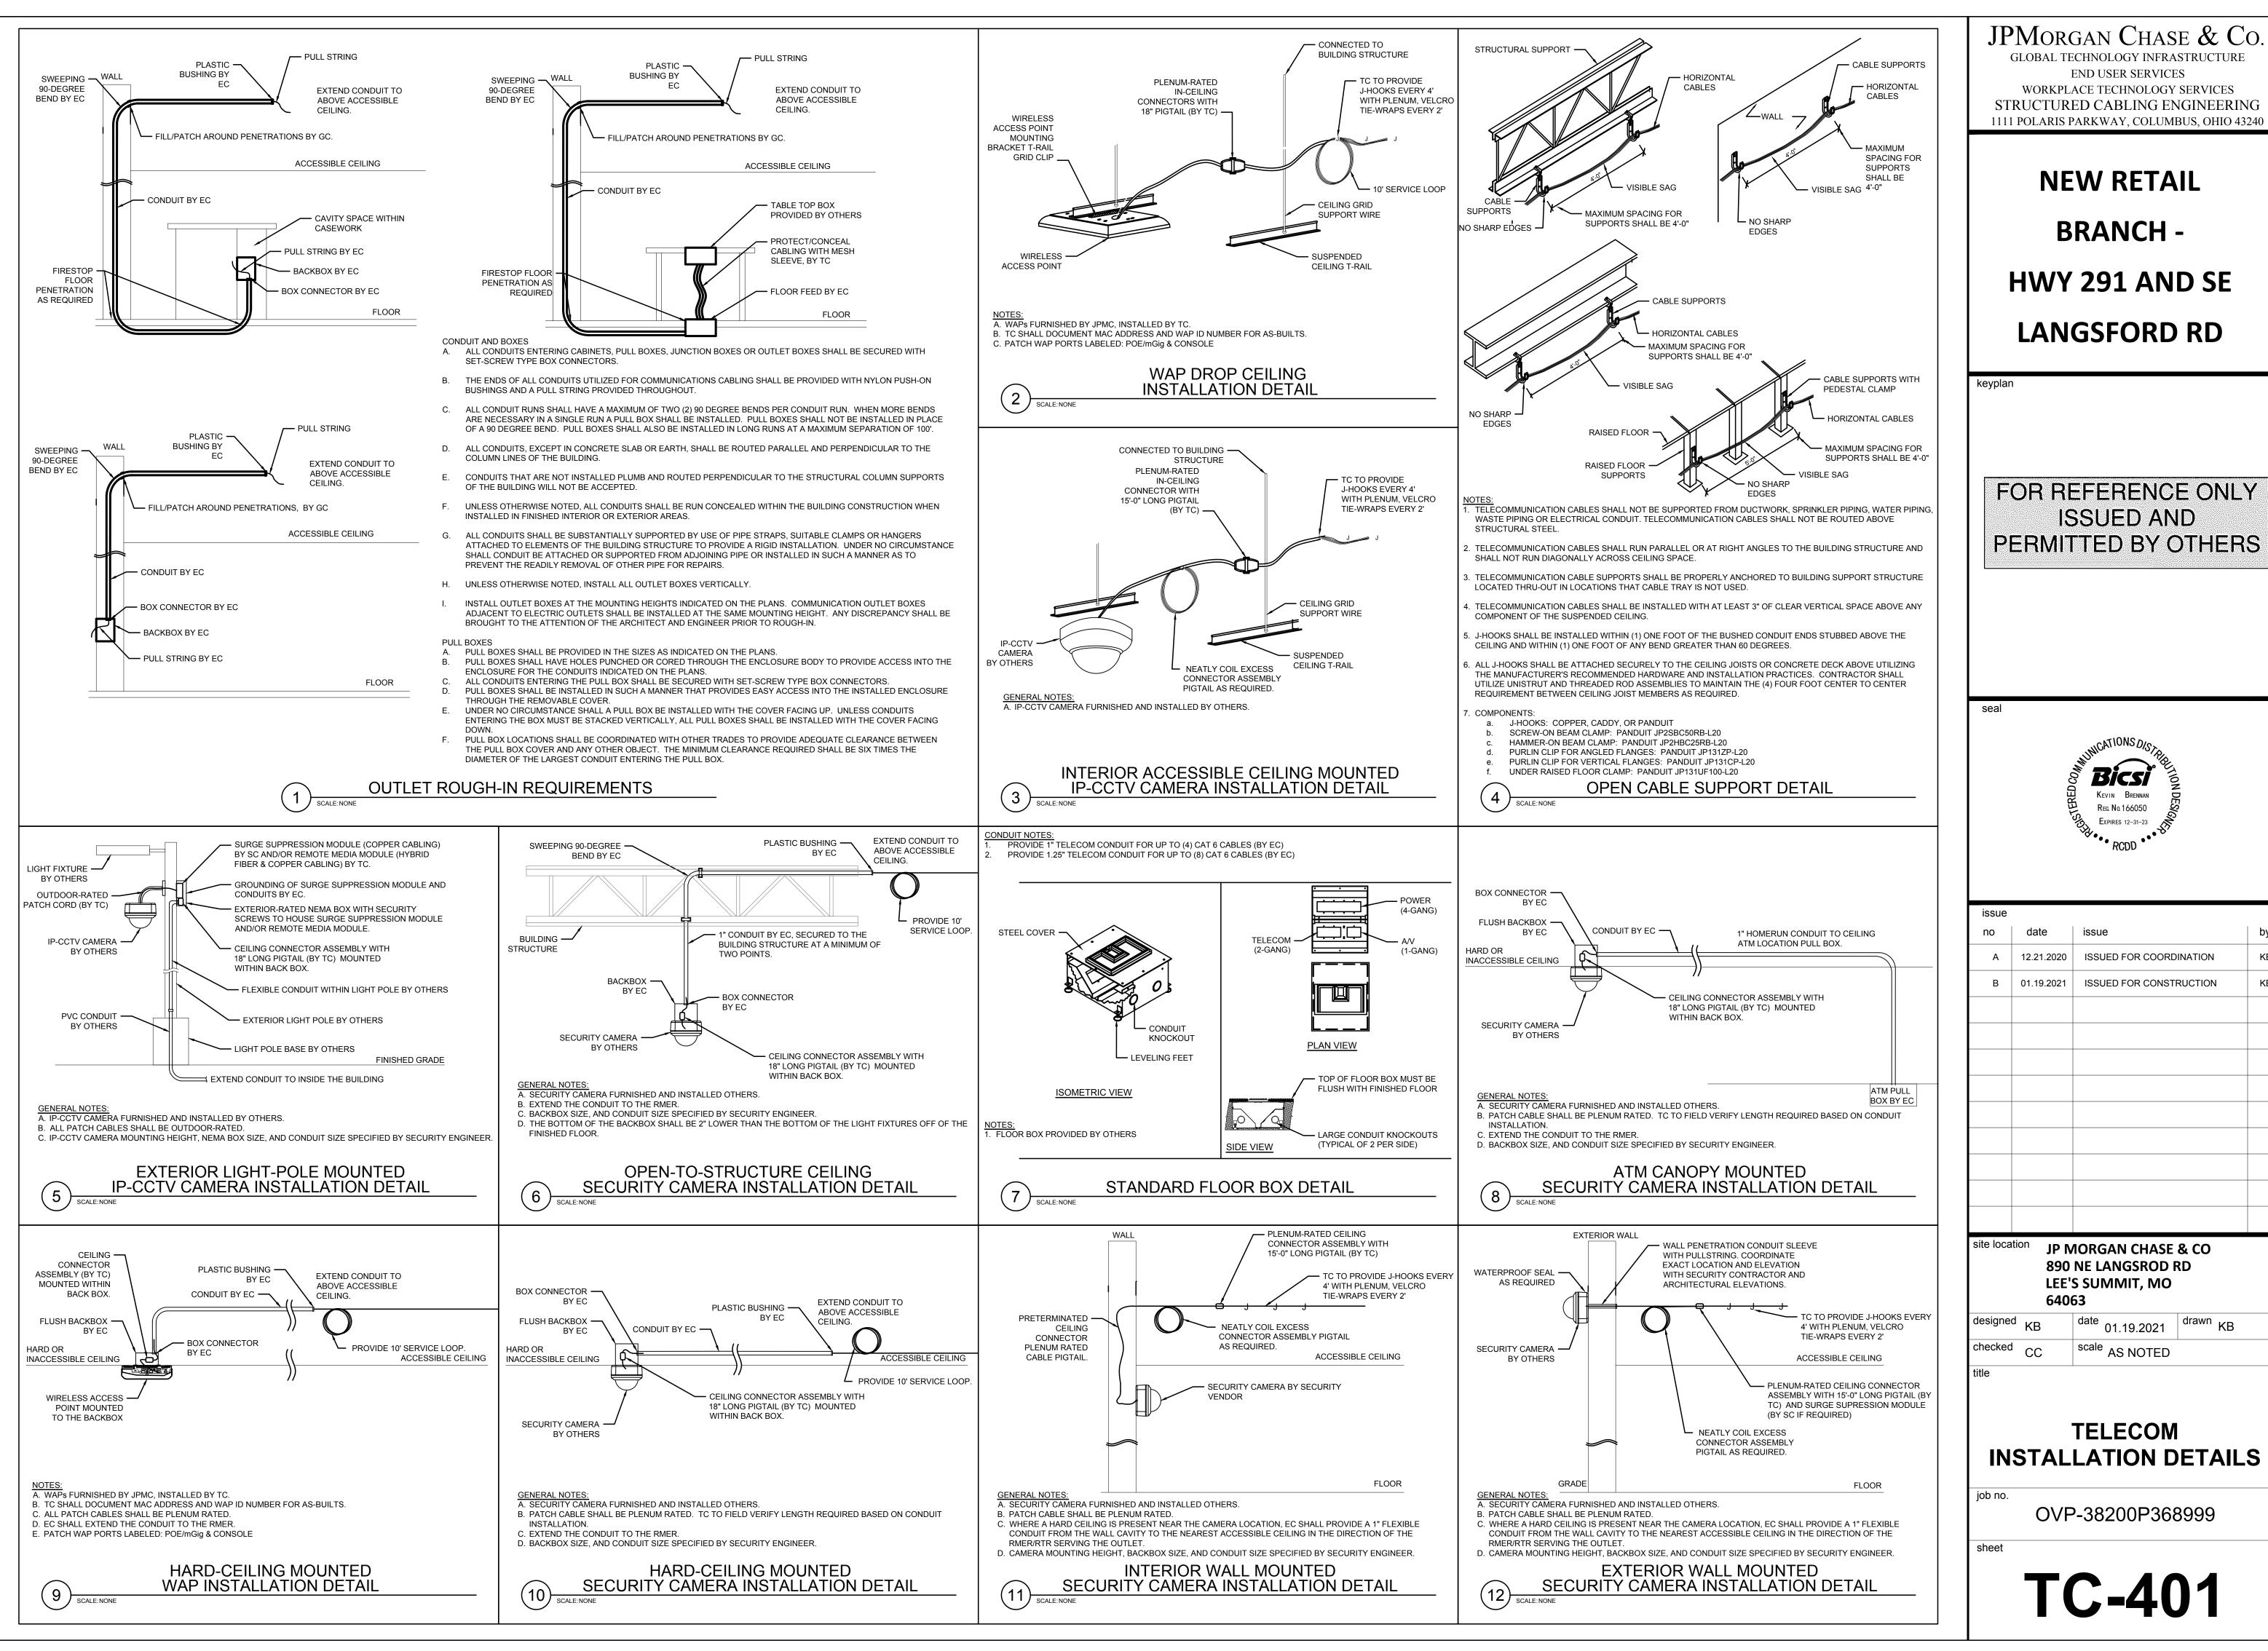

JPMORGAN CHASE & Co.

GLOBAL TECHNOLOGY INFRASTRUCTURE END USER SERVICES WORKPLACE TECHNOLOGY SERVICES STRUCTURED CABLING ENGINEERING

NEW RETAIL BRANCH -HWY 291 AND SE LANGSFORD RD

FOR REFERENCE ONLY **ISSUED AND** PERMITTED BY OTHERS




ISSUED FOR COORDINATION ISSUED FOR CONSTRUCTION

JP MORGAN CHASE & CO **890 NE LANGSROD RD** LEE'S SUMMIT, MO

drawn KB 01.19.2021 scale AS NOTED

TELECOM INSTALLATION DETAILS

OVP-38200P368999

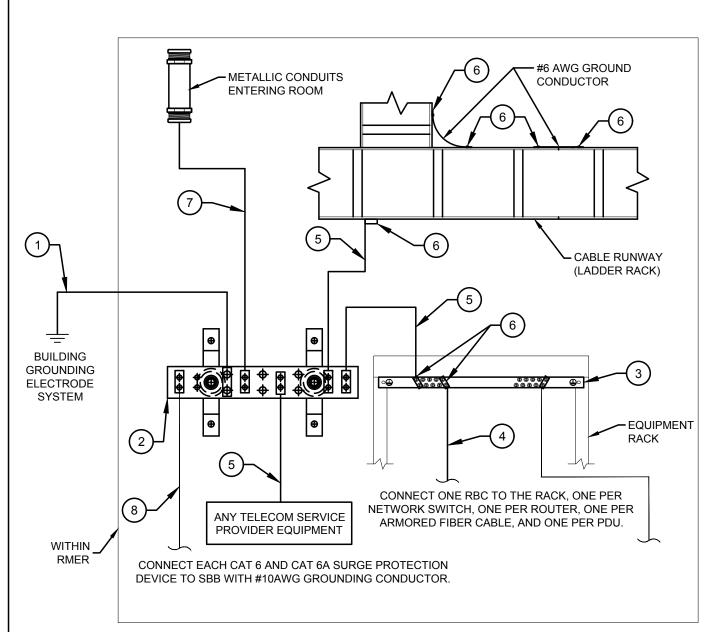


	GROUNDING COMPONENT SCHEDULE						
ITEM	DESCRIPTION	MANUFACTURER	PART NUMBER	PROVIDED BY			
1	TBC	N/A	N/A	EC			
2	SBB	PANDUIT	GB2B0304TPI-1	EC			
3	RBB	PANDUIT	RGRB19U	TC			
4	RBC	PANDUIT	RGREJ696Y	TC			
5	TEBC	PANDUIT	GJS6180U	TC			
6	TWO HOLE LONG BARREL LUGS	PANDUIT	LCC6 SERIES	TC			
7	TEBC	PANDUIT	GJS6180U	EC			
8	SURGE PROTECTION BONDING	N/A	N/A	TC			

DETAIL NOTES:


TELECOMMUNICATIONS GROUNDING SCHEMATIC

- A. DEFINITIONS:
 A.1. TELECOMMUNICATIONS BONDING CONDUCTOR (TBC)
- A.2. SECONDARY BONDING BUSBAR (SBB)
 A.3. RACK BONDING BUSBAR (RBB)
- A.3. RACK BONDING BUSBAR (RBB)
 A.4. RACK BONDING CONDUCTORS (RBC)
- A.3. TELECOMMUNICATIONS EQUIPMENT BONDING CONDUCTOR (TEBC)


 3. THE TBC SHALL BE SIZED BASED ON THE CONDUCTOR'S LENGTH. THE CONDUCTOR SH
- B. THE TBC SHALL BE SIZED BASED ON THE CONDUCTOR'S LENGTH. THE CONDUCTOR SHALL BE A STRANDED GROUNDING CONDUCTOR WITH A TWO (2) HOLE COPPER COMPRESSION LUG ON EACH END. PROVIDE A #6AWG FOR LENGTHS UP TO 100FT, #4AWG FOR LENGTHS GREATER THAN 100FT UP TO 200FT, #2AWG FOR LENGTHS GREATER THAN 200FT UP TO 400FT, #1AWG FOR LENGTHS GREATER THAN 400FT UP TO 500FT, #1/0AWG FOR LENGTHS GREATER THAN 500FT UP TO 600FT, #2/0AWG FOR LENGTHS GREATER THAN 600FT UP TO 700FT, #3/0AWG FOR LENGTHS GREATER THAN 700FT UP TO 800FT, AND #4/0AWG FOR LENGTHS GREATER THAN 800FT.
- C. THE TEBC & THE RBC SHALL BE A MINIMUM OF A #6-AWG STRANDED GROUNDING CONDUCTOR AND A TWO (2) HOLE COPPER COMPRESSION LUG ON EACH END.
- D. THE CONTRACTOR IS RESPONSIBLE FOR BONDING SECTIONS OF CABLE TRAY TOGETHER UTILIZING #6-AWG GROUNDING (EARTHING) STRAPS, THEN INSTALLING A #6-AWG GROUNDING (EARTHING) CONDUCTOR BETWEEN THE TRAY AND THE SBB THAT HAS BEEN INSTALLED IN THE ROOM
- E. IF GROUNDING (EARTHING) MUST BE APPLIED TO A LOCATION WHERE BARE METAL IS NOT EXPOSED, THE COVERING (E.G. PAINT) SHALL BE FULLY REMOVED TO EXPOSE BARE METIAL AND FACILITATE BONDING. AT EACH SUCH BONDING POINT, NO GREATER THAN 12MM (.5IN) AND NO LESS THAN 6MM (.25IN) OF EXPOSED METAL SHALL REMAIN AFTER BONDING IS COMPLETED.
- F. AFTER BOND HAS BEEN MADE, TC SHALL APPLY ANTI-OXIDANT JOINT COMPOUND OVER ANY AREA THAT BARE METAL IS EXPOSED BECAUSE OF SCRAPING.
- G. RACK BONDING BUSSBARS (RBB) SHALL BE INSTALLED IN EACH RACK TO GROUND (EARTH) MULTIPLE PIECES OF EQUIPMENT OR PATCH PANELS FOR SHIELDED CABLING. THE RBB MUST BE BONDED TO THE RACK. THEN TELECOMMUNICATIONS EQUIPMENT BONDING CONDUCTORS (TEBC) CONNECT THE RBB ON EACH RACK. TO THE SBB IN THE ROOM.
- H. THE T.C. IS RESPONSIBLE FOR FURNISHING AND INSTALLING A RACK BONDING BUSSBAR (RBB) AT ALL NEW EQUIPMENT RACKS AND CABINETS PER DESIGN DOCUMENTS. EACH RBB SHALL BE BONDED TO THE SBB THAT HAS BEEN INSTALLED IN THE ROOM.
- I. DAISY CHAIN FROM ONE RBB TO NEXT RBB NOT PERMITTED.
- J. A #6-AWG CONDUCTOR SHALL BE BONDED TO EACH RBB, THEN COILED AND STORED NEATLY AT EACH RACK FOR FUTURE USE.
- K. WHERE ARMORED CABLE IS DEPLOYED, IT SHALL BE BONDED TO GROUND (EARTH) AT ONE END IN ACCORDANCE WITH AHJ AND IN ACCORDANCE WITH THE MANUFACTURER'S GUIDELINES.
- L. MATERIALS SHALL BE AS LISTED OR SHALL BE EQUIVALENT PRODUCTS OF OTHER MANUFACTURERS MEETING THE INTENT AND QUALITY LEVEL OF THIS SPECIFICATION. MATERIALS MUST BE COMPATIBLE WITH THE END TO END SOLUTION BEING PROPOSED. PROPOSALS FOR EQUIVALENT PRODUCTS MUST BE PRESENTED TO THE OPR BY RFI'S, SUBMITTALS, AND/OR SHOP DRAWINGS. OPR WRITTEN APPROVAL IS REQUIRED BEFORE ANY SUBSTITUTIONS ARE MADE.
- M. PROVIDE BONDING OF ALL METAL CONDUITS ENTERING THE ROOM. PROVIDE GROUNDING BUSHING AS REQUIRED FOR CONNECTION.

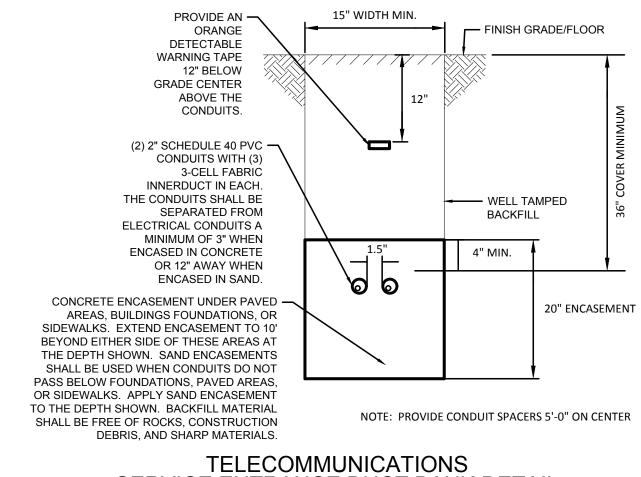



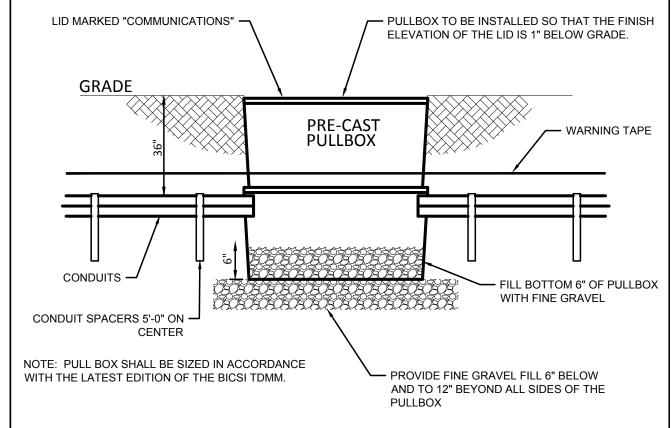

TELECOMMUNICATIONS SERVICE IN-GRADE PULL BOX DETAIL

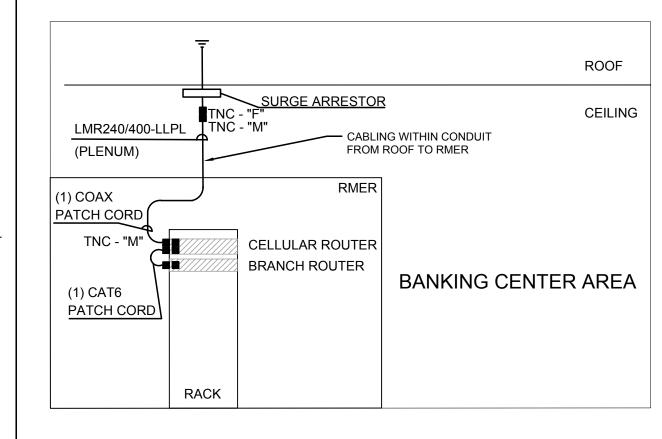

- NOTE:


 1. DETAIL IS SHOWN FOR REFERENCE ONLY. WIRELESS CELLULAR SYSTEM INFRASTRUCTURE WILL BE PROVIDED BY THIRD PARTY CONTRACTOR.
- 2. CODE REQUIRES THE OUTDOOR RATED COAX TO THE ROOF ANTENNA BE TRANSITIONED WITHIN 50 FEET OF PENETRATING THE ROOF, TO A PLENUM RATED COAX.
- SURGE ARRESTOR TO BE LOCATED AS CLOSE AS POSSIBLE TO CEILING PENETRATION.
 VERIFY ANTENNA, SURGE ARRESTOR, AND CELLULAR ROUTER CONNECTION TYPES PRIOR TO
- 5. ALL FIELD TERMINATED CABLES ARE TO BE TESTED

TERMINATING THE COAX CABLES.

MAJOR MATERIALS:

- OUTDOOR OMNIDIRECTIONAL ANTENNA FOR 2G/3G/4G CELLULAR (JPMC SUPPLIED)
 4G LIGHTNING SUPPRESSORS/ARRESTORS FOR OUTDOOR ANTENNA INSTALLS
- 4G LIGHTNING SUPPRESSORS/ARRESTORS FOR OUTDOOR ANTENNA INSTALLS
 CEILING MOUNT BRACKET (JDTECK) FOR INDOOR PANEL ANTENNAL INSTALLS
 DIRECTIONAL (PANEL OR LOG PERIODIC STYLE) ANTENNAS (JPMC SUPPLIED)
- 5. LMR-240 FLEXIBLE LOW LOSS COMMUNICATIONS COAX OR LMR-400 FLEXIBLE LOW LOSS COMMUNICATIONS COAX
- 6. TNC CONNECTORS (TO ROUTER), N CONNECTORS TO ANTENNA



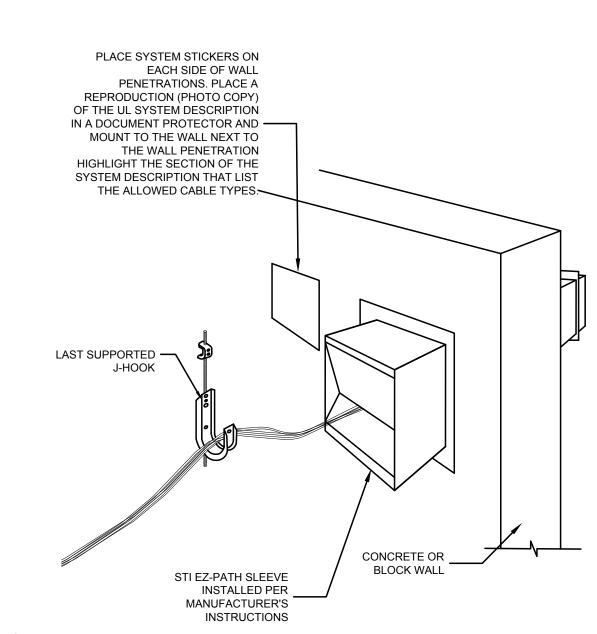

NOTES:

- A. BEFORE BEGINNING INSTALLATION, VERIFY THAT SUBSTRATE CONDITIONS PREVIOUSLY INSTALLED UNDER OTHER SECTIONS ARE ACCEPTABLE FOR INSTALLATION OF FIRESTOPPING IN ACCORDANCE WITH
- MANUFACTURER'S INSTALLATION INSTRUCTIONS AND TECHNICAL INFORMATION.


 B. SURFACES SHALL BE FREE OF DIRT, GREASE, OIL, SCALE, LAITANCE, RUST, RELEASE AGENTS, WATER
- REPELLANTS, AND ANY OTHER SUBSTANCES THAT MAY INHIBIT OPTIMUM ADHESION.
- C. PROVIDE MASKING AND TEMPORARY COVERING TO PROTECT ADJACENT SURFACES.
- D. DO NOT PROCEED UNTIL UNSATISFACTORY CONDITIONS HAVE BEEN CORRECTED.
- E. GENERAL: INSTALL SYSTEMS IN ACCORDANCE WITH PERFORMANCE CRITERIA AND IN ACCORDANCE WITH THE CONDITIONS OF TESTING AND CLASSIFICATION AS SPECIFIED IN THE PUBLISHED DESIGN.
- F. MANUFACTURER'S INSTRUCTIONS: COMPLY WITH MANUFACTURER'S INSTRUCTIONS FOR INSTALLATION OF
- G. KEEP AREAS OF WORK ACCESSIBLE UNTIL INSPECTION BY AUTHORITIES HAVING JURISDICTION.

 H. WHERE DEFICIENCIES ARE FOUND REPAIR FIRESTOPPING PRODUCTS SO THEY COMPLY

REMOVE EQUIPMENT, MATERIALS, AND DEBRIS, LEAVING AREA IN UNDAMAGED, CLEAN CONDITION.

- H. WHERE DEFICIENCIES ARE FOUND, REPAIR FIRESTOPPING PRODUCTS SO THEY COMPLY WITH REQUIREMENTS.
- J. CLEAN ALL SURFACES ADJACENT TO SEALED OPENINGS TO BE FREE OF EXCESS FIRESTOPPING MATERIALS AND SOILING AS WORK PROGRESSES.

CABLE BUNDLE THROUGH PENETRATION
DETAIL FOR WALL CONSTRUCTION

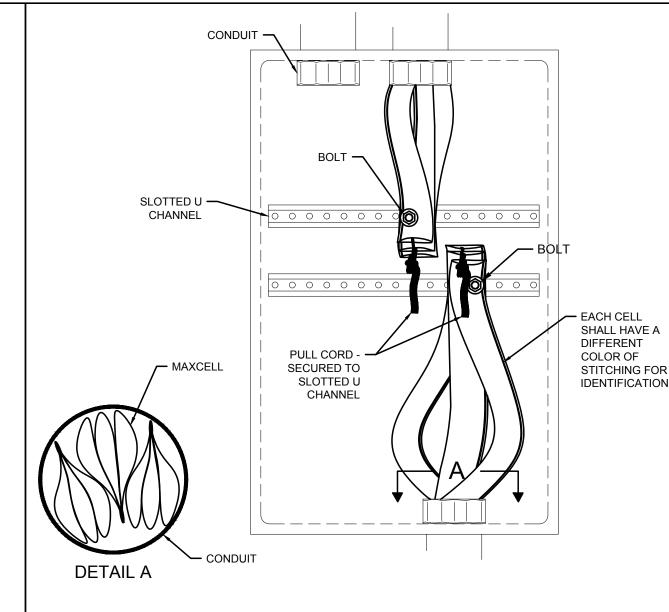


$\frac{\text{NOTES:}}{\text{1. FOR EACH 2 INCH CONDUIT, INSTALL (1) 2 IN - 3 CELL MAXCELL INNERDUCT.}}$

- 2. UNLESS WAIVED IN WRITING BEFORE COMMENCEMENT OF WORK, CONTRACTOR SHALL ENGAGE MANUFACTURER PRIOR TO THE PULL TO ASSURE RECOMMENDED INSTALLATION METHODS ARE FOLLOWED.
- 3. A BALL BEARING SWIVEL (BULL NOSE SWIVEL) MUST ALWAYS BE USED BETWEEN THE PULL ROPE AND MAXCELL. FAILURE TO DO SO MAY RESULT IN PULL ROPE OR TAPE INDUCING TWIST, CAUSING THE MAXCELL TO TWIST EXCESSIVELY AND MAY MAKE IT DIFFICULT TO PULL CABLE.
- 4. CELL ASSIGNMENTS MUST BE DOCUMENTED AT EACH APPEARANCE OF THE INNER DUCT.
- 5. EXCEPT WHERE NOTED, CONDUIT THAT IS 50 MM (2 IN) IN DIAMETER SHOULD BE EQUIPPED WITH 2" 3-CELL SOFT DUCT QUANTITY 1. CONDUIT THAT IS 75 MM (3 IN) SHOULD BE EQUIPPED WITH 3" 3-CELL SOFT DUCT, MAXIMUM QUANTITY 2; AND 100 MM (4 IN) IN DIAMETER SHOULD BE EQUIPPED WITH 3" 3-CELL SOFT DUCT, MAXIMUM QUANTITY
- WHEN 3" 3-CELL SOFT DUCT IS TOO SMALL TO ACCOMMODATE LARGE DIAMETER CABLES AND LARGE O.D. FACTORY TERMINATED PULLING GRIPS, CONDUIT THAT IS 75 MM (3 IN) SHOULD BE EQUIPPED WITH 4" 3-CELL SOFT DUCT, MAXIMUM QUANTITY 1; AND 100 MM (4 IN) IN DIAMETER SHOULD BE EQUIPPED WITH 4" 3-CELL SOFT DUCT, MAXIMUM QUANTITY 2.
- THE OUTSIDE DIAMETER OF PULLING GRIPS ASSOCIATED WITH FACTORY TERMINATED FIBER TRUNK CABLES WILL AFFECT THE SELECTION OF SOFT DUCT. SEE TABLE 1 FOR DETAIL,

TABLE 1 - SOFT DUCT SIZING GUIDELINE MAXIMUM CABLE/GRIP DIAMETER PER CELL MM(IN) CELL SIZE

26 (1.03) 3" 34 (1.34) 4" >34 (1.34) SEE OPR


6 TYPICAL MAXCELL 2", 3-CELL INNERDUCT

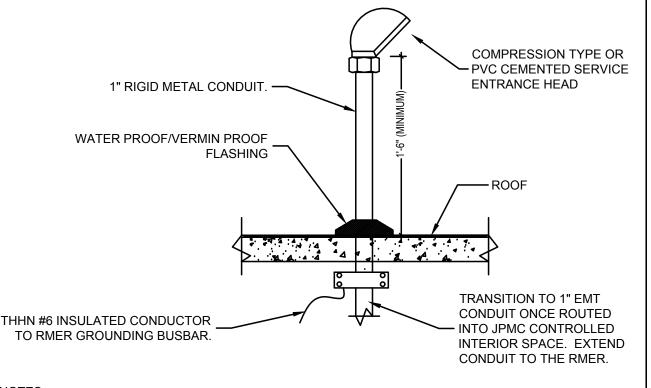

NOTES:

I. FOR REFERENCE ONLY. EC SHALL COORDINATE INSTALLATION METHOD WITH GC AND ROOF CONTRACTOR AND APPROVAL FROM BUILDING OWNER/MANAGEMENT.

7 ROOF CONDUIT WEATHERHEAD DETAIL

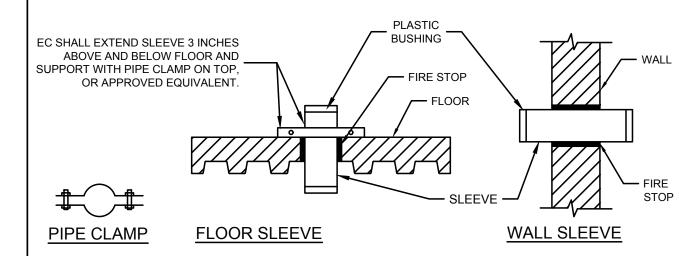


$\underline{\text{NOTES:}}$ 1. CLEAN CORE DRILL, ONE SIZE LARGER THAN SLEEVE.

2. PACK VOID BETWEEN SLEEVE AND FLOOR WITH NON-SHRINK, WATER TIGHT, APPROVED FIRE RATED MATERIAL
3. INSTALL PLASTIC BUSHINGS AT BOTH ENDS.

LOCATION: TYPICAL FOR ALL RETAIL TELECOM ROOMS / RETAIL MAIN EQUIPMENT ROOMS, SEE DRAWINGS FOR ALL PENETRATION LOCATIONS AND FIELD COORDINATE

TYPICAL FLOOR AND WALL SLEEVE PENETRATION DETAILS

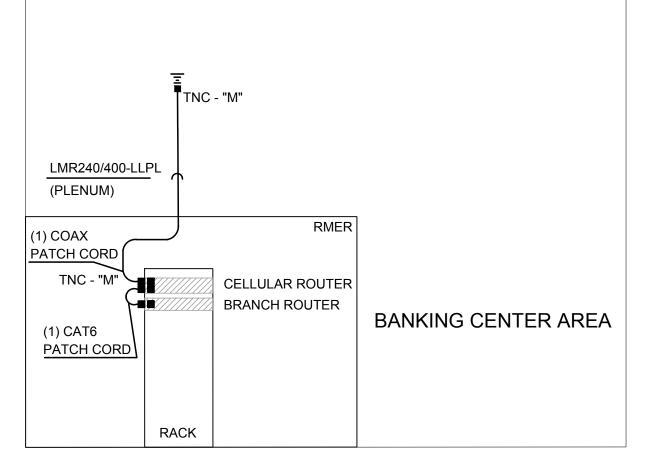

DETAIL IS SHOWN FOR REFERENCE ONLY. WIRELESS CELLULAR SYSTEM INFRASTRUCTURE WILL BE PROVIDED BY THIRD PARTY CONTRACTOR.

- 2. CODE REQUIRES THE OUTDOOR RATED COAX TO THE ROOF ANTENNA BE TRANSITIONED WITHIN 50 FEET OF PENETRATING THE ROOF, TO A PLENUM RATED COAX.
- FEET OF PENETRATING THE ROOF, TO A PLENUM RATED COAX.

 3. VERIFY ANTENNA, AND CELLULAR ROUTER CONNECTION TYPES PRIOR TO TERMINATING THE COAX
- CABLES.

 4. ALL FIELD TERMINATED CABLES ARE TO BE TESTED

MAJOR MATERIA

- OUTDOOR OMNIDIRECTIONAL ANTENNA FOR 2G/3G/4G CELLULAR (JPMC SUPPLIED)
- 4G LIGHTNING SUPPRESSORS/ARRESTORS FOR OUTDOOR ANTENNA INSTALLS
 CEILING MOUNT BRACKET (JDTECK) FOR INDOOR PANEL ANTENNAL INSTALLS
 DIRECTIONAL (PANEL OR LOG PERIODIC STYLE) ANTENNAS (JPMC SUPPLIED)
- LMR-240 FLEXIBLE LOW LOSS COMMUNICATIONS COAX OR LMR-400 FLEXIBLE LOW LOSS COMMUNICATIONS COAX
 TNC CONNECTORS (TO ROUTER), N CONNECTORS TO ANTENNA

CEILING ANTENNA MOUNTING OPTION

JPMORGAN CHASE & Co.

GLOBAL TECHNOLOGY INFRASTRUCTURE

END USER SERVICES

WORKPLACE TECHNOLOGY SERVICES

STRUCTURED CABLING ENGINEERING

1111 POLARIS PARKWAY, COLUMBUS, OHIO 43240

NEW RETAIL

BRANCH -

HWY 291 AND SE

LANGSFORD RD

FOR REFERENCE ONLY

ISSUED AND

PERMITTED BY OTHERS

EXPIRES 12-31-23

ISSUED FOR COORDINATION

ISSUED FOR CONSTRUCTION

keyplan

seal

issue

12.21.2020

01.19.2021


JP MORGAN CHASE & CO 890 NE LANGSROD RD LEE'S SUMMIT, MO 64063

designed KB date 01.19.2021 drawn KB checked CC scale AS NOTED

TELECOM INSTALLATION DETAILS

job no. OVP-38200P368999

et

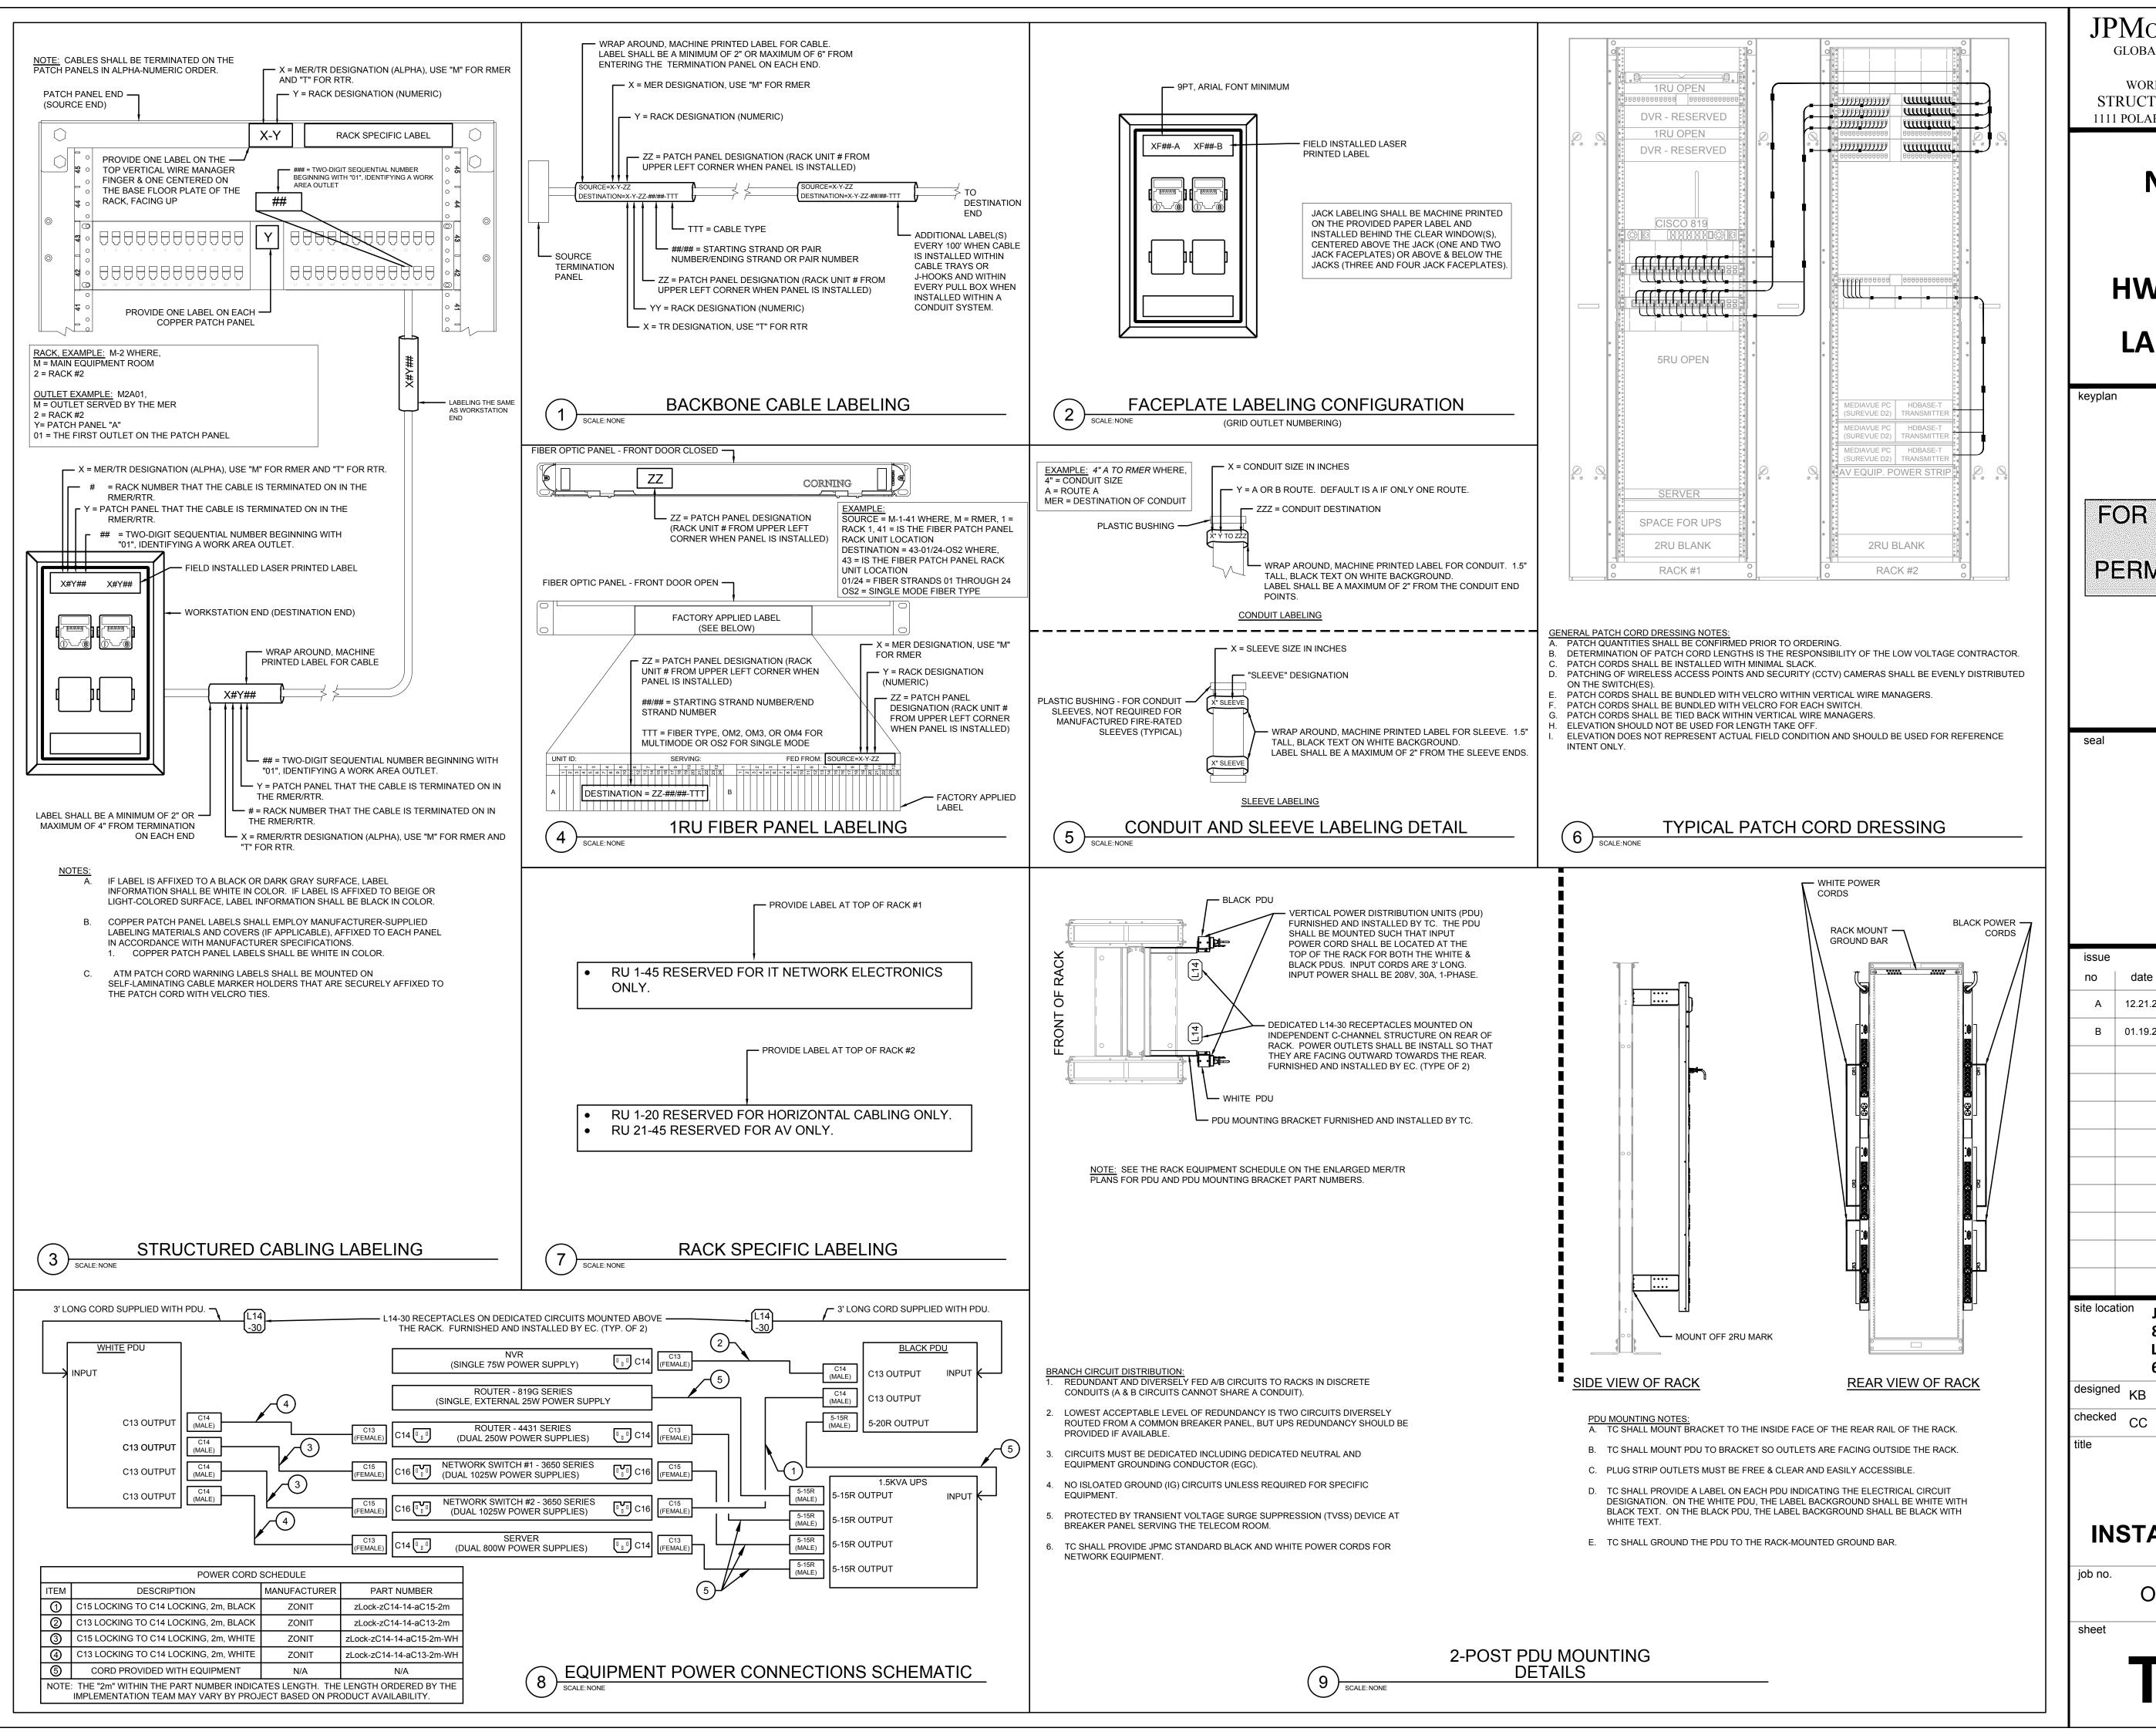

JPMORGAN CHASE & Co. GLOBAL TECHNOLOGY INFRASTRUCTURE

END USER SERVICES WORKPLACE TECHNOLOGY SERVICES STRUCTURED CABLING ENGINEERING 1111 POLARIS PARKWAY, COLUMBUS, OHIO 43240

NEW RETAIL BRANCH -**HWY 291 AND SE** LANGSFORD RD

FOR REFERENCE ONLY **ISSUED AND** PERMITTED BY OTHERS



no	date	issue	1
110	uale	Issue	
Α	12.21.2020	ISSUED FOR COORDINATION	
В	01.19.2021	ISSUED FOR CONSTRUCTION	
			1


890 NE LANGSROD RD LEE'S SUMMIT, MO 64063

01.19.2021 scale AS NOTED


TELECOM INSTALLATION DETAILS

OVP-38200P368999


DEVICE NAME	WEIGHT (LBS)
55" DISPLAY	37.70
WALL MOUNT	27.25
SPEAKERS	20.0
TOTAL	84.95

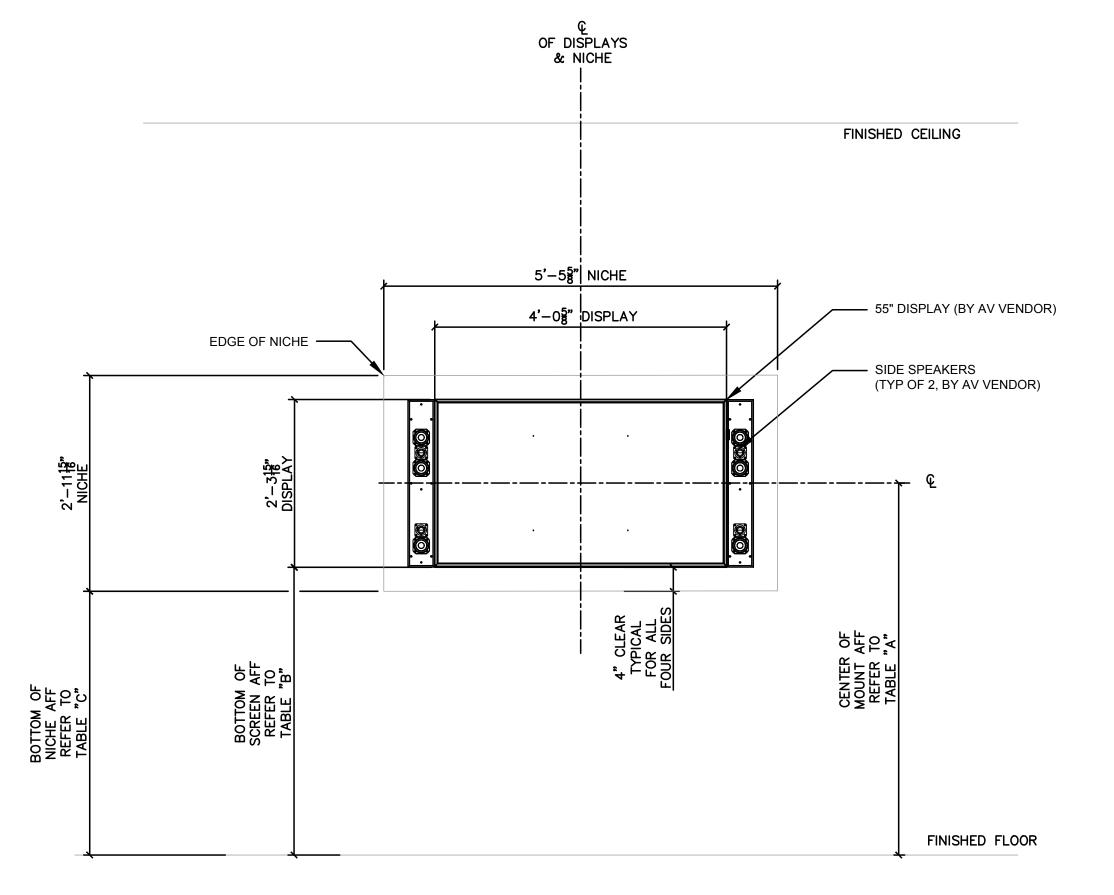

AUDIOVISUAL 55" DISPLAY ELEVATION

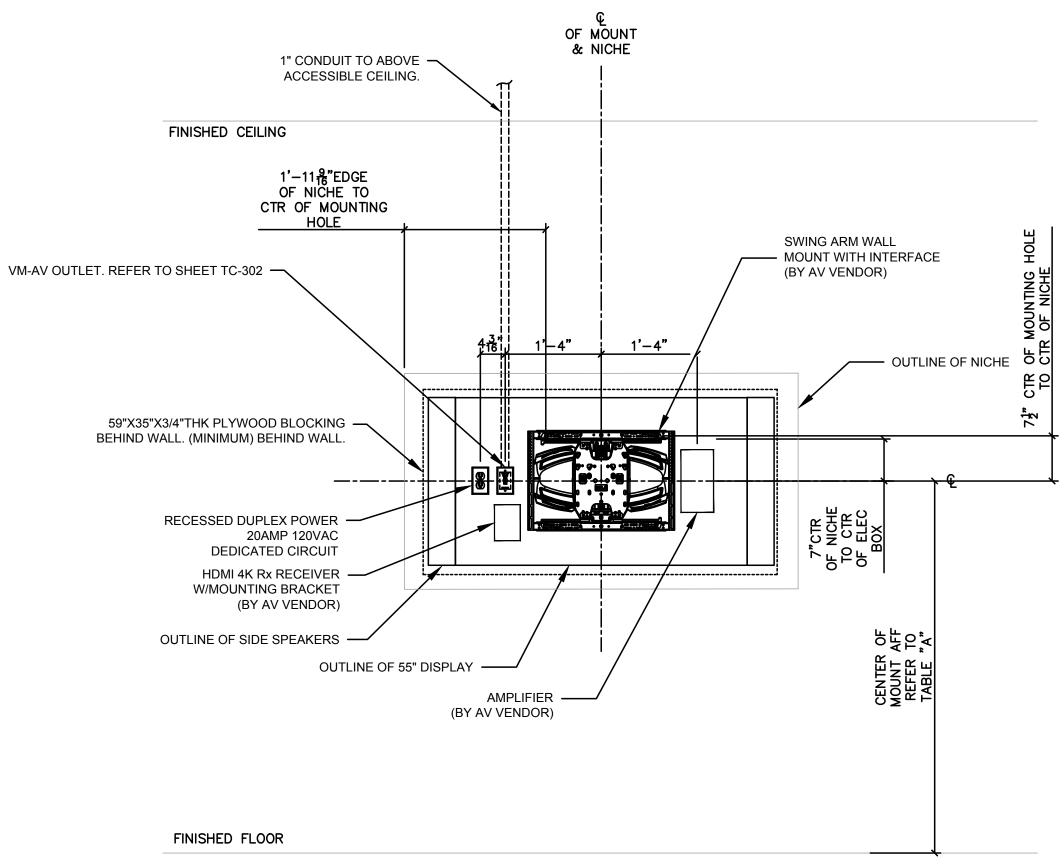



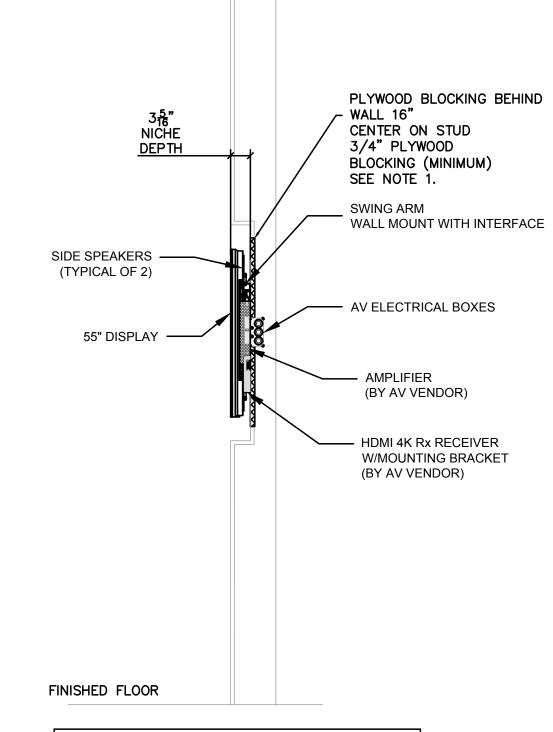


FINISHED CEILING

NOTE:

1. STRUCTURAL ASSESSMENT AND
BLOCKING REQUIREMENTS TO BE BY JPMC/GC.
GC TO SUPPLY & INSTALL PLYWOOD BLOCKING

C AUDIOVISUAL 55" DISPLAY WALL SECTION
SCALE: 3/4"=1'-0" SOLUTION 1

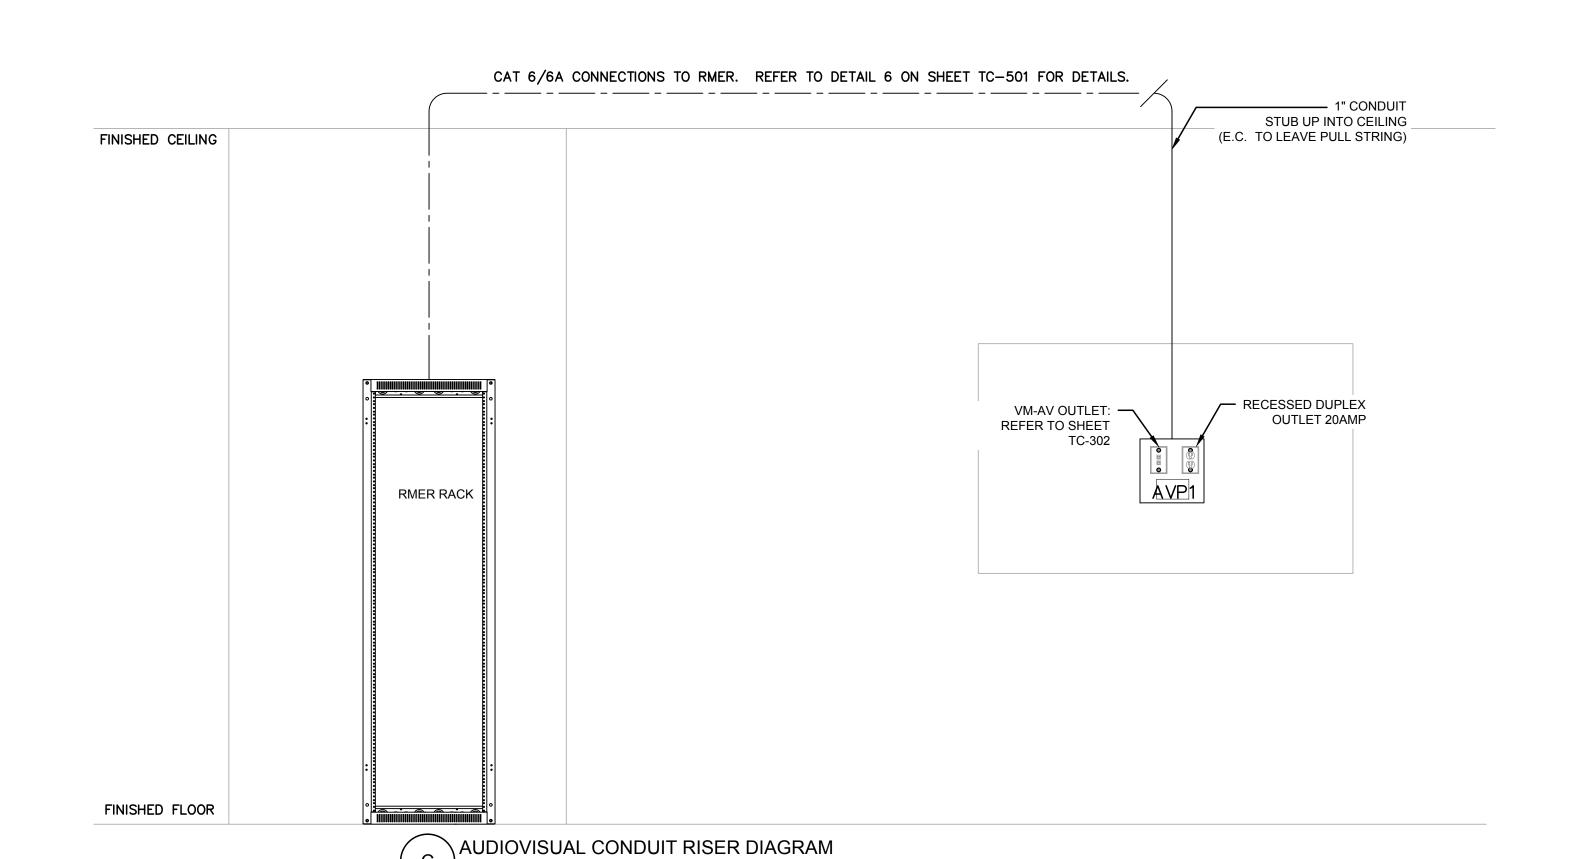

"A" HEIGHTS		"B" HEIGHTS		"C" HEIGHTS	
TYPE	DIMENSION	TYPE	DIMENSION	TYPE	DIMENSION
V3.0	7'-5"	V3.0	6'-3"	V3.0	5'-11"
DAB	6'-5"	DAB	5'-3"	DAB	4'-11"
LIVING ROOM	5'-5"	LIVING ROOM	4'-3"	LIVING ROOM	3'-11"
V2.5 ATM	6'-9"	V2.5 ATM	5'-7"	V2.5 ATM	5'-3"
BTL	7'-5"	BTL	6'-3"	BTL	5'-11"

		INSTALLATION R	EQUIREMENTS FROM SURVEY
MEASUREMENT	REQUIRED DIMENSION	MEASURED DIMENSION	NOTES
NICHE BOTTOM AFF	REF. TABLE - C		
NICHE WIDTH	5'-5 5/8"		
NICHE HEIGHT	2'-11 15/16"		
NICHE DEPTH	3-5/16"		
CORPORATE DATA QTY.	0		
AV STRUCTURED CABLE QTY.	1		
POWER	DUPLEX 15A 120V		
BLOCKING	SEE NOTE 1		

JPMORGAN CHASE & Co.

GLOBAL TECHNOLOGY INFRASTRUCTURE
END USER SERVICES
WORKPLACE TECHNOLOGY SERVICES
STRUCTURED CABLING ENGINEERING
1111 POLARIS PARKWAY, COLUMBUS, OHIO 43240

NEW RETAIL

BRANCH
HWY 291 AND SE

LANGSFORD RD

keyplan

FOR REFERENCE ONLY
ISSUED AND
PERMITTED BY OTHERS

sea



issue			
no	date	issue	b
Α	12.21.2020	ISSUED FOR COORDINATION	K
В	01.19.2021	ISSUED FOR CONSTRUCTION	K

JP MORGAN CHASE & CO 890 NE LANGSROD RD LEE'S SUMMIT, MO


designed KB date 01.19.2021 drawn KB checked CC scale AS NOTED

AV SOLUTION #1 55" DISPLAY NICHE/RECESS MOUNT

job no.

OVP-38200P368999

sheet

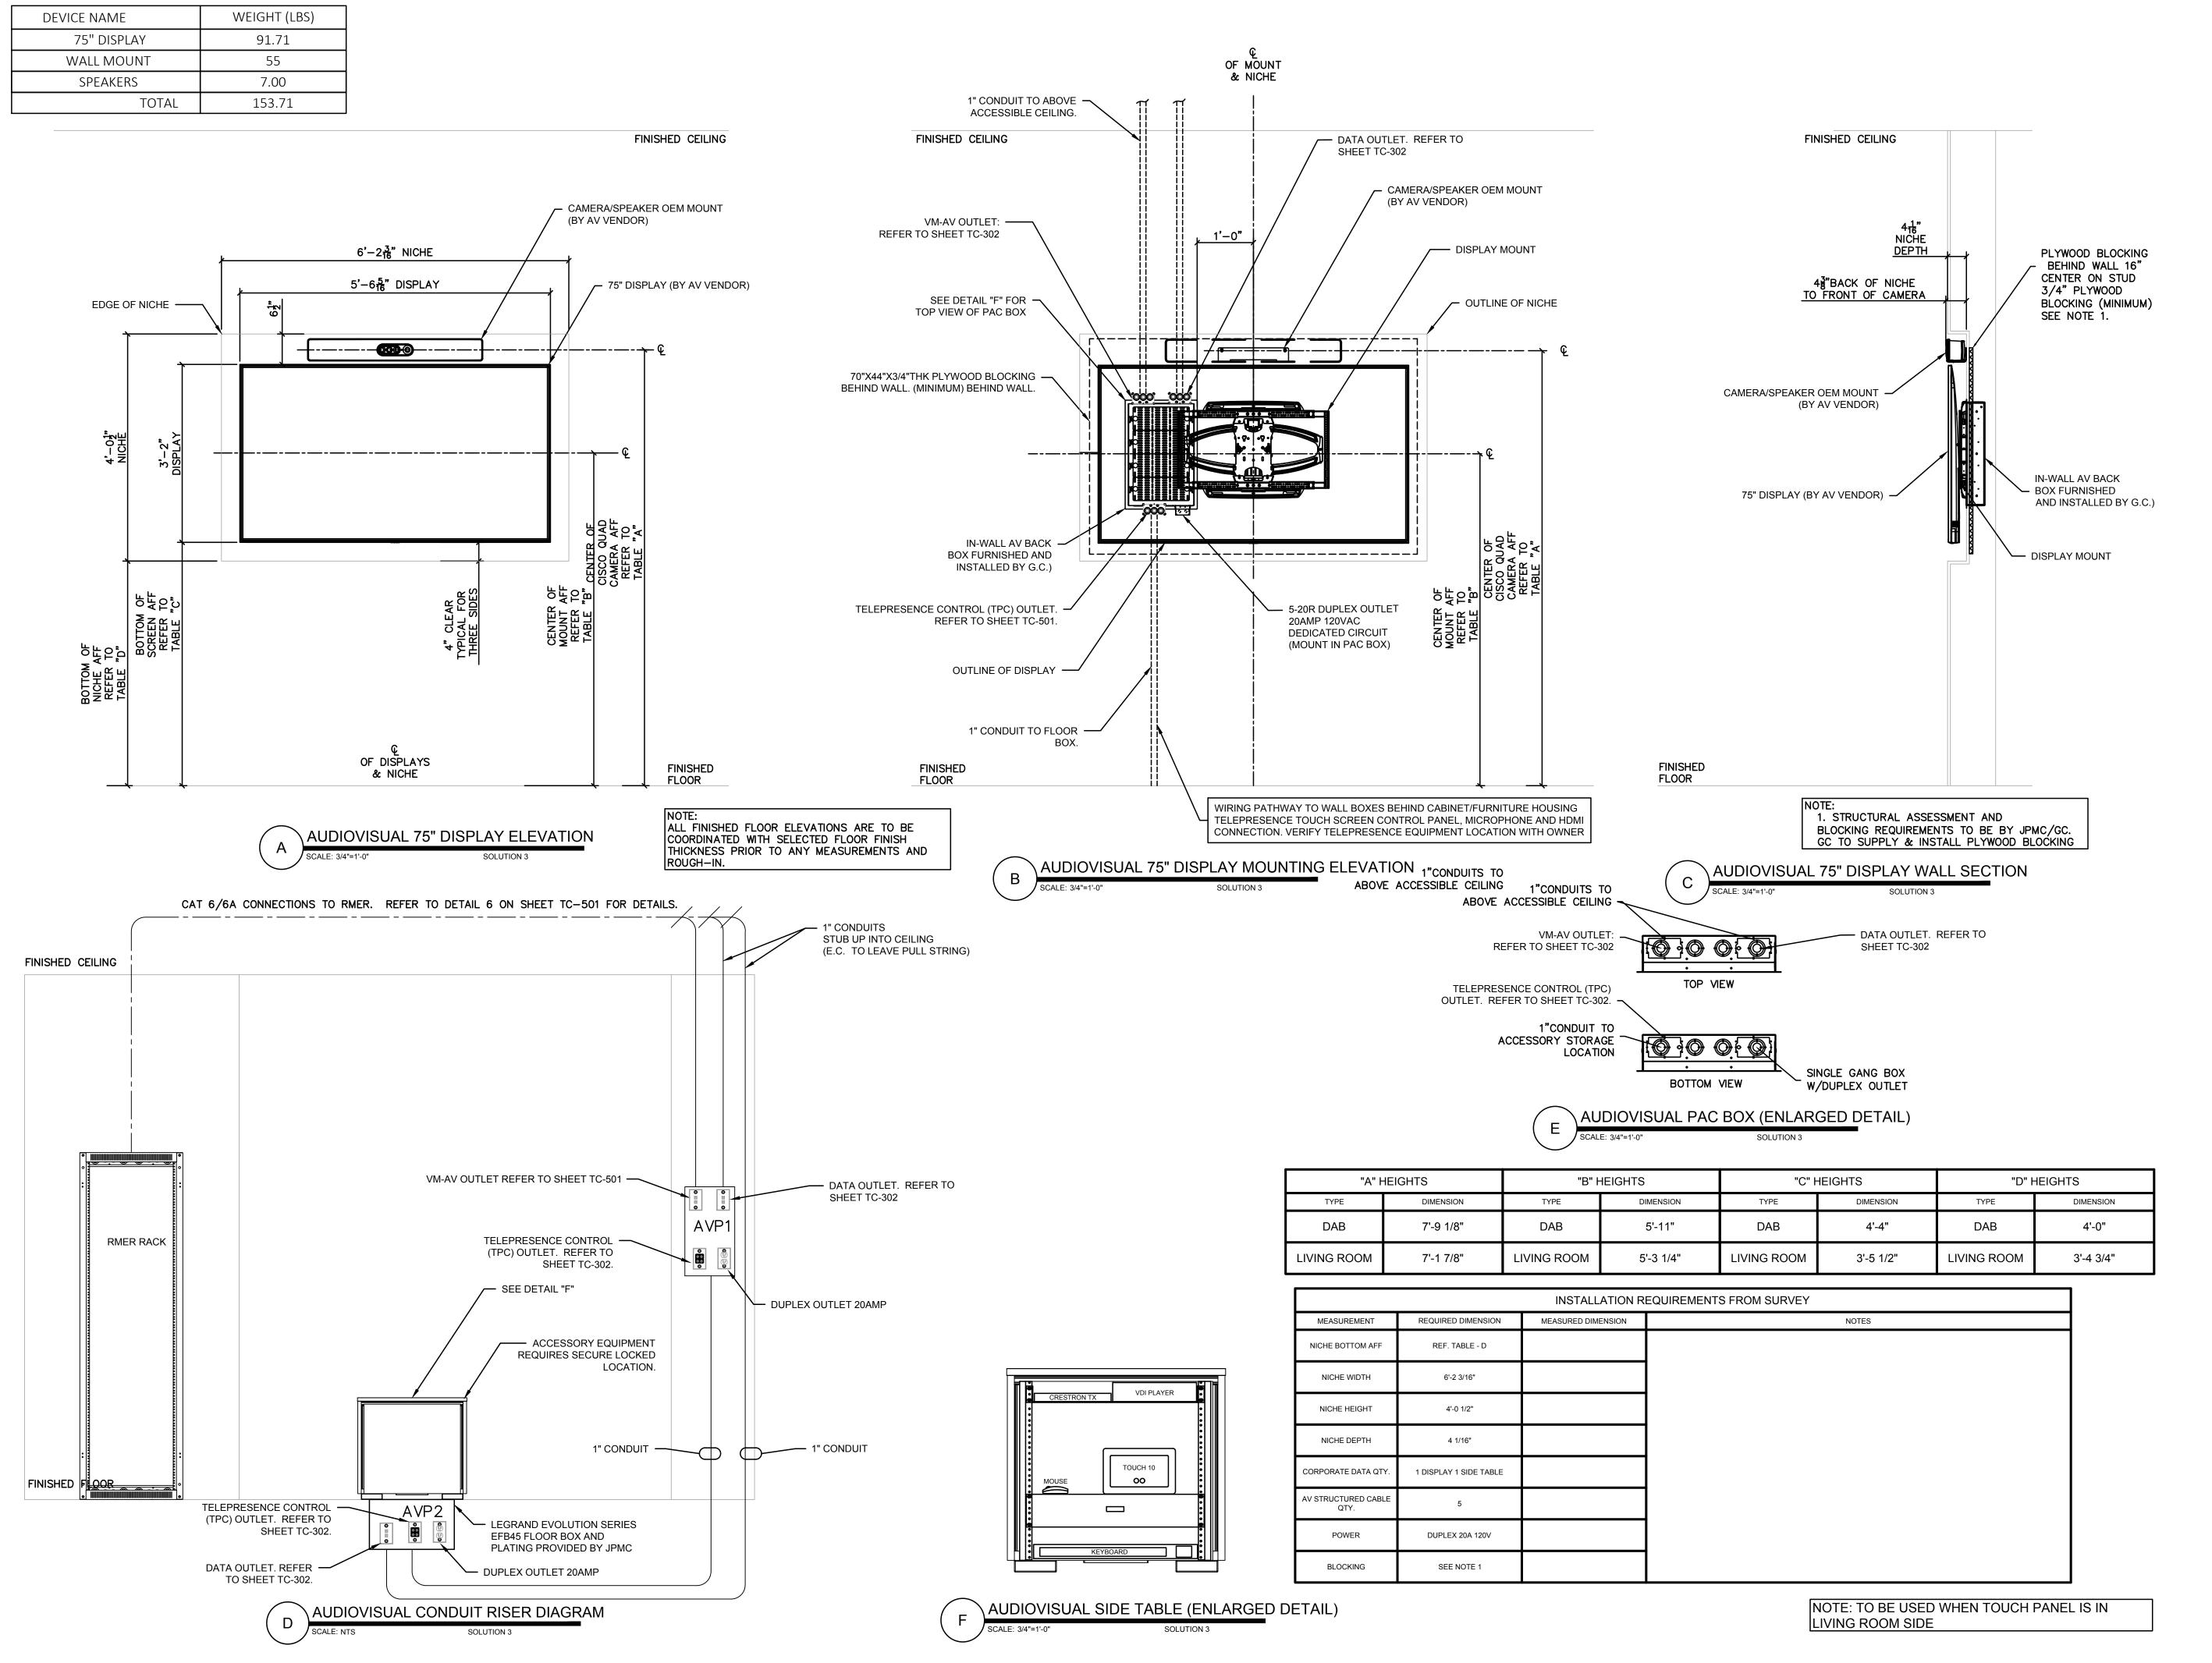

JPMORGAN CHASE & Co.

GLOBAL TECHNOLOGY INFRASTRUCTURE
END USER SERVICES
WORKPLACE TECHNOLOGY SERVICES
STRUCTURED CABLING ENGINEERING
1111 POLARIS PARKWAY, COLUMBUS, OHIO 43240

NEW RETAIL

BRANCH
HWY 291 AND SE

LANGSFORD RD

keypla

FOR REFERENCE ONLY
ISSUED AND
PERMITTED BY OTHERS

seal



issue			
no	date	issue	by
Α	12.21.2020	ISSUED FOR COORDINATION	KB
В	01.19.2021	ISSUED FOR CONSTRUCTION	KB

JP MORGAN CHASE & CO 890 NE LANGSROD RD LEE'S SUMMIT, MO

designed KB date 01.19.2021 drawn KB checked CC scale AS NOTED


title


AV SOLUTION #3
75" DISPLAY
NICHE/RECESS MOUNT
TO SIDE TABLE

job no.

OVP-38200P368999

DEVICE NAME	WEIGHT (LBS)
32" DISPLAY	10.70
WALL MOUNT	3.00
TOTAL	13.70

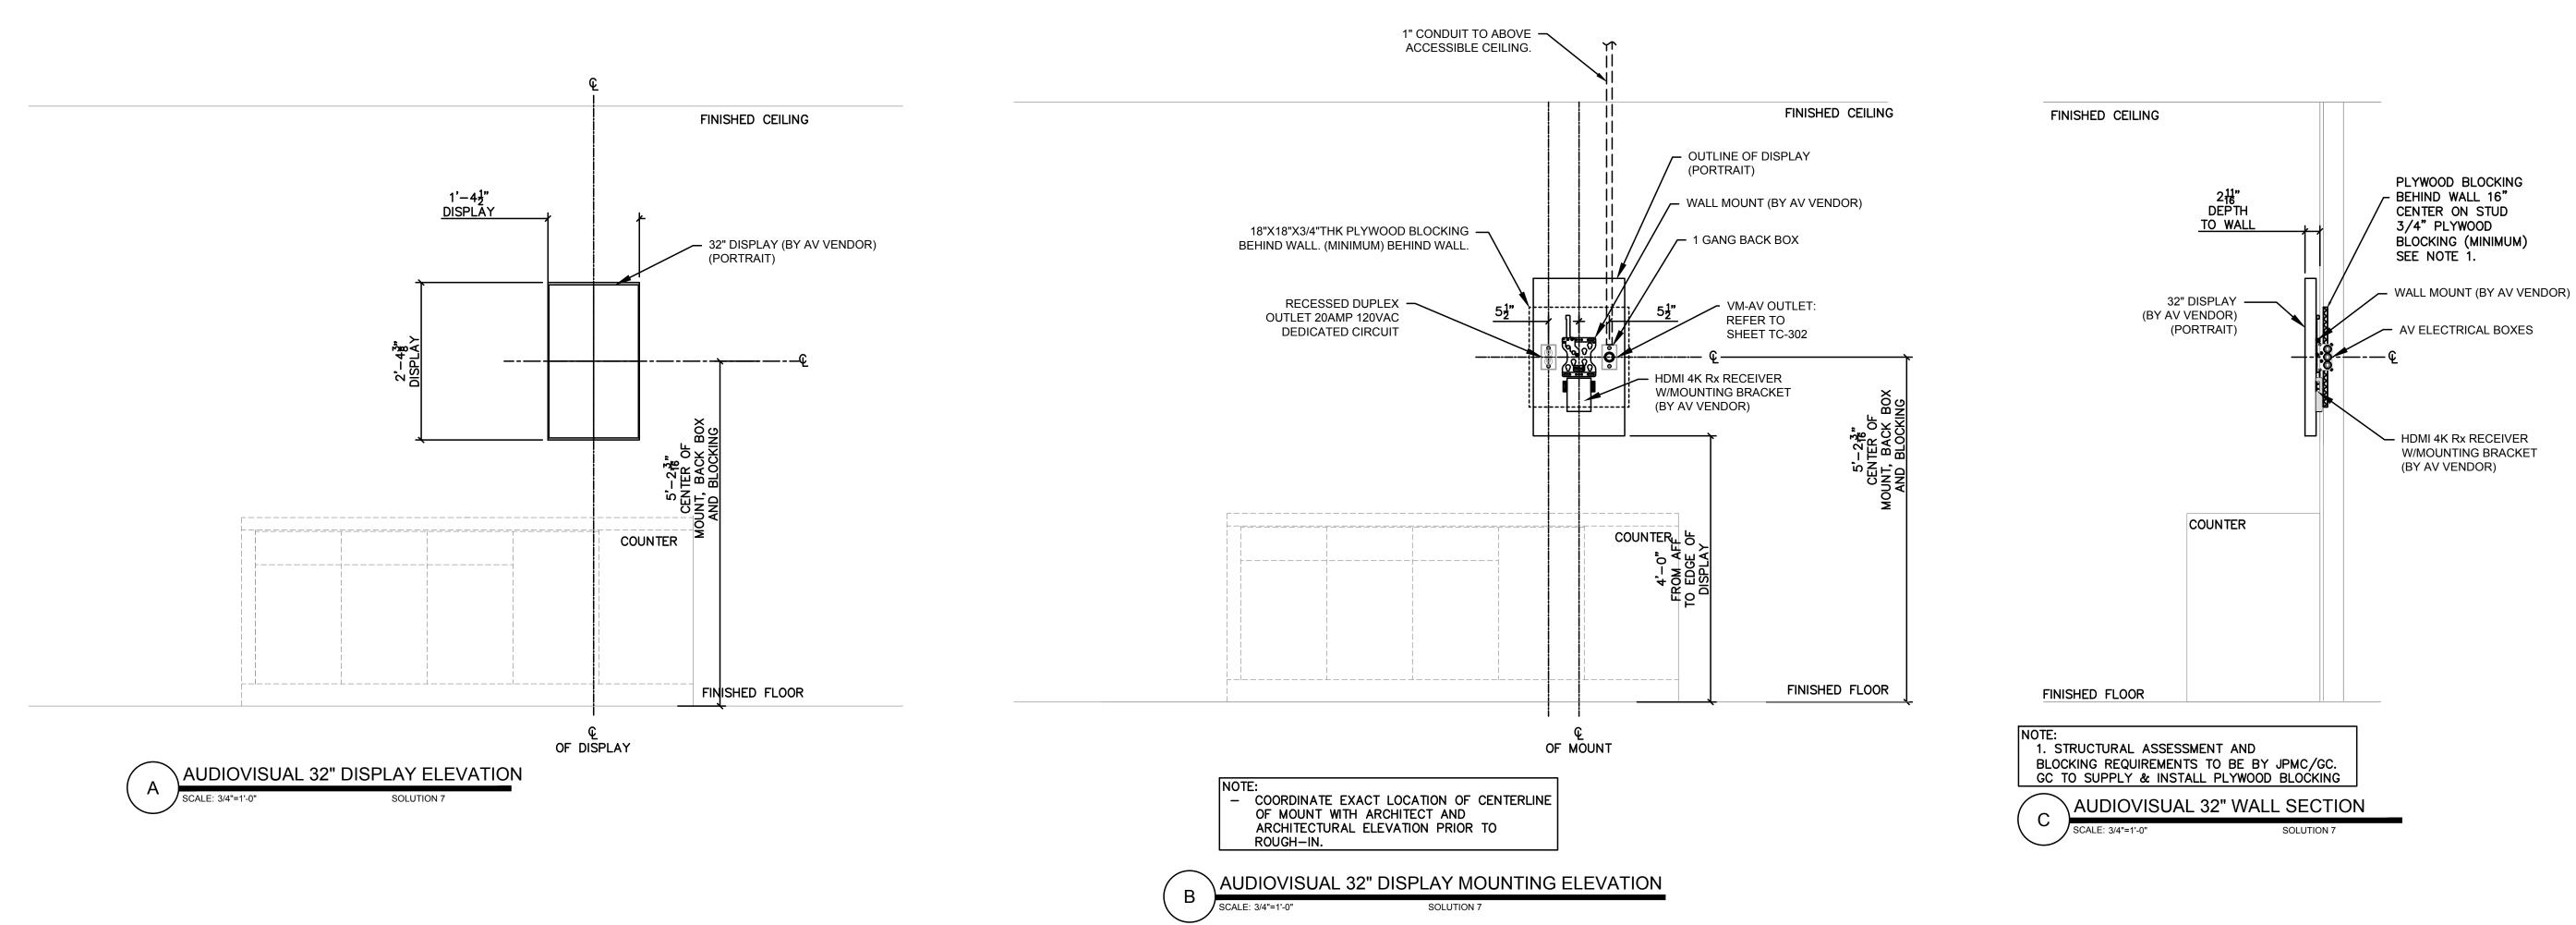

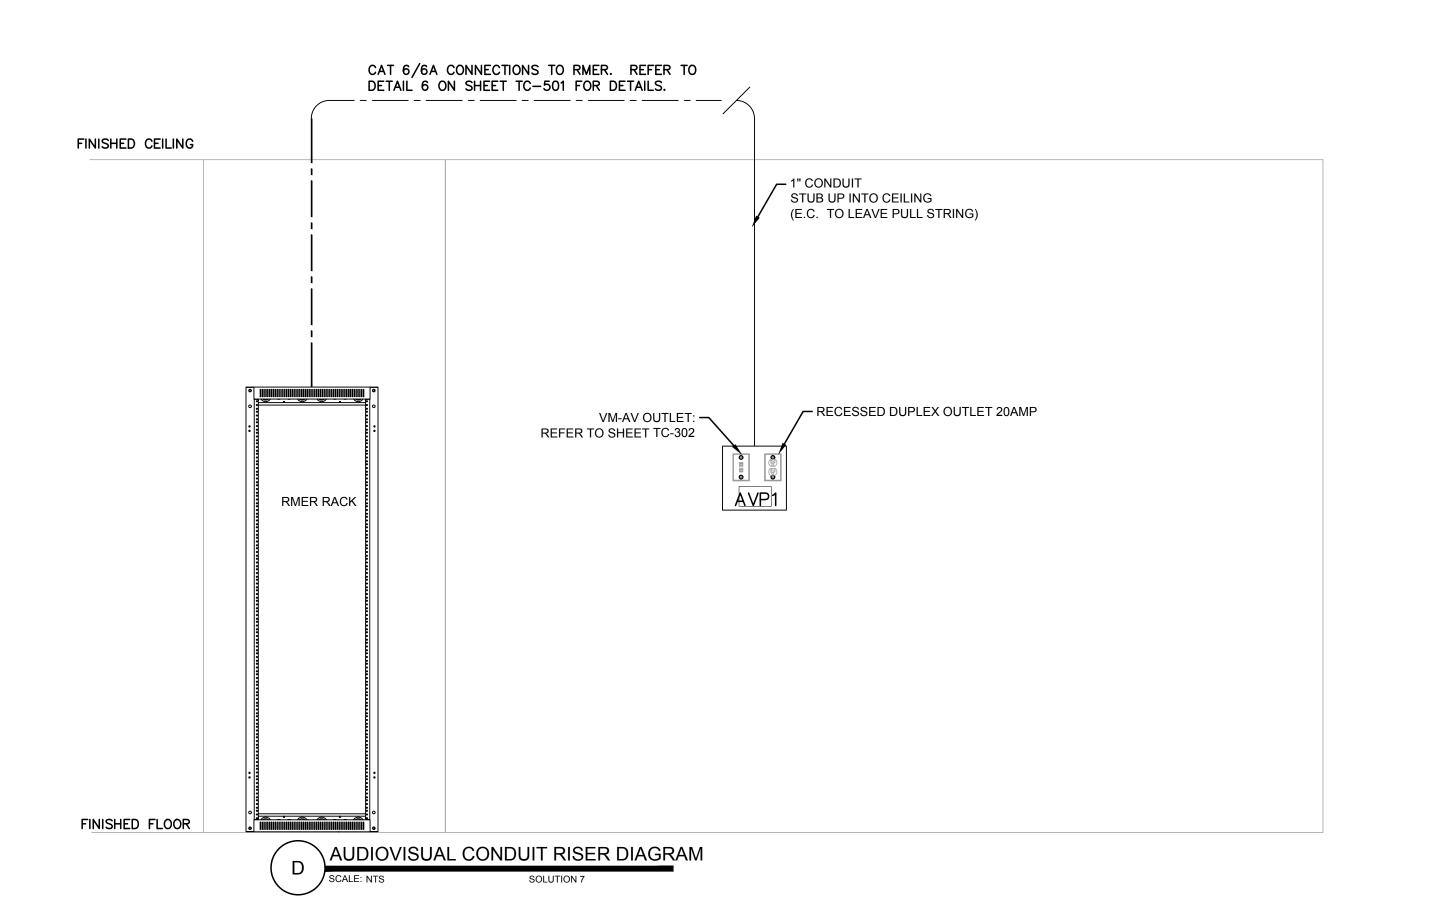

		INSTALLATION R	EQUIREMENTS FROM SURVEY
MEASUREMENT	REQUIRED DIMENSION	MEASURED DIMENSION	NOTES
CORPORATE DATA	0		
V STRUCTURED CABLE QTY.	1		
POWER	DUPLEX 15A 120V		
BLOCKING	SEE NOTE		

JPMORGAN CHASE & Co.

GLOBAL TECHNOLOGY INFRASTRUCTURE
END USER SERVICES
WORKPLACE TECHNOLOGY SERVICES
STRUCTURED CABLING ENGINEERING
1111 POLARIS PARKWAY, COLUMBUS, OHIO 43240

NEW RETAIL

BRANCH
HWY 291 AND SE

LANGSFORD RD

keyplan

FOR REFERENCE ONLY
ISSUED AND
PERMITTED BY OTHERS

sea



issue			
no	date	issue	
Α	12.21.2020	ISSUED FOR COORDINATION	
В	01.19.2021	ISSUED FOR CONSTRUCTION	
			+

JP MORGAN CHASE & CO 890 NE LANGSROD RD LEE'S SUMMIT, MO

designed KB date 01.19.2021 drawn KB checked CC scale AS NOTED

AV SOLUTION #7
32" DISPLAY
SURFACE MOUNTED

job no.

OVP-38200P368999

	PROJECT MAJOR M	IA I LINIAL INLU	CINEINIENIS	•		
CATEGORY	MATERIAL	MANUFACTURER	MODEL NUMBER	QTY	EXT	NOTES
	CATS, PLENUM RATED, HORIZONTAL UTP GRAY CABLE	COMMSCOPE/SYSTIMAX	700210198 (REEL)		LF	
	CAT6, PLENUM RATED, HORIZONTAL UTP GRAY CABLE	COMMSCOPE/SYSTIMAX	700214372 (BOX)	#	LF	
COPPER CABLING	CATEGORY 6, NON-PLENUM RATED HORIZONTAL UTP GRAY CABLE CATEGORY 6, NON-PLENUM RATED HORIZONTAL UTP	COMMSCOPE/SYSTIMAX	700211923 (REEL)	ø	UF	
	GRAY CABLE	COMMSCOPE/SYSTIMAX	700211931 (BOX)	ø	UF	
	CATEGORY 6 PATCH CORD SLATE	COMMSCOPE/SYSTIMAX	CPC3312-03F001	5	EA	
	CATEGORY 6 PATCH CORD SLATE	COMMSCOPE/SYSTIMAX	CPC3312-03F006	7	EA	
	CATEGORY 6 PATCH CORD SLATE	COMMSCOPE/SYSTIMAX	CPC3312-03F007	47	EA	
	CATEGORY 6 PATCH CORD SLATE CATEGORY 6A, PLENUM RATED, HORIZONTAL UTP	COMMSCOPE/SYSTIMAX	CPC3312-03F010	24	EA	
	WHITE CABLE CATEGORY 6A, PLENUM RATED, HORIZONTAL UTP	COMMSCOPE/SYSTIMAX	760105940 (REEL)	#	LF	
	WHITE CABLE CATEGORY 6A, NON-PLENUM RATED, HORIZONTAL UTP	COMMSCOPE/SYSTIMAX	760107268 (BOX)	#	LF	
	WHITE CABLE	COMMSCOPE/SYSTIMAX	760105817		Uf	
	CATEGORY 6A, PATCH CORD WHITE	COMMSCOPE/SYSTIMAX	CPCSSX2-08F007	21	EA	
	CATEGORY 6A, PATCH CORD WHITE CATEGORY 6A, PLENUM RATED, HORIZONTAL F/UTP	COMMSCOPE/SYSTIMAX	CPCSSX2-08F010	27	EA	
	BLUE CABLE	BERK-TEK	10143424	#	LF	
	5 CATEGORY 6A, F/UTP, BLUE PATCH CORD	LEVITON	6AS10-5L	9	EA	
	7 CATEGORY 6A, F/UTP, BLUE PATCH CORD	LEVITON	6AS10-7L	6	EA	
	CATEGORY 6, OSP RATED, HORIZONTAL UTP CABLE	COMMSCOPE/SYSTIMAX	760008888	#	LF	
	CATEGORY 6, OSP RATED, PATCH CORD BLACK	COMMSCOPE/SYSTIMAX	CO15542-01F007	1	EA	
	CATEGORY 6A, OSP RATED, HORIZONTAL UTP CABLE	COMMSCOPE/SYSTIMAX	780178129	a	LF.	
	CATEGORY 6A, OSP RATED, PATCH CORD BLACK	COMMSCOPE/SYSTIMAX	CO15582-01F007	3	EA	
	SHELDED 22/2 PAIR CABLING 12-STRAND SINGLE MODE, INDOOR, PLENUM RATED	BELDEN	9451		LF	
	FIBER BACKBONE REEL HYBRID FIBER (2-STRAND SINGLE MODE) WITH COPPER	CORNING	012E88-33131-29		UF	
FIBER	(TWO 12AWG), OUTDOOR RATED HORIZONTAL CABLE	BERK-TEK	ONE-REACH SERIES	#	UF	
	SINGLE MODE FIBER PATCH CORD - DUPLEX LC	CORNING	787802GD120002M	2	EA	
	MULTIMODE FIBER PATCH CORD - DUPLEX LC TO LC	CORNING	050502T5116002M	2	EA	
	CAT 6 RJ45 JACK (GREY)	COMMSCOPE/SYSTIMAX	7600206733	60	EA	
	CAT6 RJ45 JACK (ORANGE)	COMMSCOPE/SYSTIMAX	700206683	8	EA	
	CAT 6A RJ45 JACK (GREEN)	COMMSCOPE/SYSTIMAX	760092403	40	EA	
	CAT 6A RJ45 JACK (WHITE)	COMMSCOPE/SYSTIMAX	760092429	6	EA	
OXES	WALL MOUNTED FACEPLATE, 4-PORT	COMMSCOPE/SYSTIMAX	108168543	28	EA	
NO B	2-PORT NON-PLENUM RATED SURFACE MOUNT BOX 4-PORT 106-FRAME FACEPLATE FOR DECORATOR	COMMSCOPE/SYSTIMAX	107984058	2	EA	
ATEA	SYTLE FLOOR BOX CATEGORY 6A PLENUM RATED CEILING CONNECTOR	COMMSCOPE/SYSTIMAX	106622285	4	EA	
FACEPLATE AND BOXES	ASSEMBLY WITH 18" LONG PIGTAIL CATEGORY 6A PLENUM RATED CEILING CONNECTOR	COMMSCOPE/SYSTIMAX	760235592	8	EA	
2	ASSEMBLY WITH 15'-0" LONG PIGTAIL	COMMSCOPE/SYSTIMAX	C01SJ02-88F015	22	EA	
	CATEGORY 6A SHIELDED JACK	LEVITON	6ASJK-RL6	10	EA	
	WALL MOUNTED MULTIMEDIA FACEPLATE	LEVITON	41290-SMW	5	EA	
	WHITE MULTIMEDIA OUTLET 2-PORT RJ-45 MODULE	LEVITON	41294-2QW	16	EA	
	3.5mm STEREO JACKS	LEVITON	40839-SWS	4	EA	
8 9 9 9 9	RACK MOUNTED EQUIPMENT GROUND KIT W/ 96" JUMPER BUSBAR-TO-RACK GROUND BAR KIT W/ 15" JUMPER	PANDUIT	RGREJ696Y GJS6180U	10	EA EA	
GROUNDING	RACK MOUNTED HORIZONTAL GROUNDING BUSBAR KIT (SEE GROUNDING SCHEMATIC)	PANDUIT	RGRB19U	2	EA	
S M	TWO HOLE LONG BARREL LUG	PANDUIT	LCC6 SERIES		EA	
	2-POST RACK, 4SRU, BLACK FINISH	CPI	66353-703	2	EA	
	6" WIDE, DOUBLE-SIDED VERTICAL CABLE MANAGER,	CPI	30095-703	2	EA	
	BLACK FINISH 10" WIDE, DOUBLE-SIDED VERTICAL CABLE MANAGER.	CPI	30096-703	1	EA	
	BLACK FINISH 2RU HORIZONTAL CABLE MANAGER, BLACK FINISH	CPI	30130-719	6	EA	
	MODULAR, ANGLED, 48-PORT PATCH PANEL	COMMSCOPE/SYSTIMAX	760187211	1	EA	
	MODULAR, ANGLED, 24-PORT PATCH PANEL	COMMSCOPE/SYSTIMAX	760187203	4	EA	
	CATEGORY 6A RATED, ANGLED, SHELDED 24-PORT	LEVITON	4\$256-\$24	1	EA	
	PATCH PANEL 1RU FIBER OPTIC PANEL WITH DUPLEX LC CONNECTOR	CORNING	CCH-01U	1	EA	
	PANELS DUPLEX LC CONNECTOR PANELS	CORNING	CCH-CP24-A9	1	EA	
ENTS	BLACK VERTICAL POWER DISTRIBUTION UNIT	CPI	TS1035241	1	EA	
MPON	MOUNTING BRACKET BLACK	CPI	TS1012713	1	EA	
000	WHITE VERTICAL POWER DISTRIBUTION UNIT	CPI	TS1035242	1	EA	
EQUIPMENT ROOM/RACK AND ASSOCIATED COMPONENTS	MOUNTING BRACKET WHITE	CPI	TS1012713	1	EA	
ASSO	2RU BLANK PANEL - BLACK FINISH	CPI	30024-702	2	EA	
AND	12" WIDE LADDER RACK - BLACKFINISH	CPI	10250-712	15	LF	
RACK	LADDER RACK STRINGER RADIUS DROP 10.3° W -	CPI	12101-711	3	EA	
/wox	BLACK FINISH LADDER RACK CABLE RETAINING POSTS	CPI	10596-706	6	EA	
MTRC	LADDER RACK WALL ANGLE SUPPORT KIT	CPI	11421-712	4	EA	
IPME	EQUIPMENT SHELF	CPI	11359-719	4	EA	
EQU	SERVER MOUNTING BRACKET	CPI	12751-719	1	EA	
	12-PORT FIBER ENCLOSURE FOR EXTENSION OF	CORNING	12/61-/19 PWH-02P	1	EA	
	CARRIER CONNECTIONS TO RACK 12-PORT OUTLET FOR COPPER EXTENSION OF	COMMSCOPE	106658156	1	EA	
	CARRIER TO RACK C14-C15 LOCKING POWER CORD (BLACK) 2 METER	ZONIT	(1) zLock-zC14-14-aC15-	1	EA EA	
	C14-C15 LOCKING POWER CORD (BLACK) 2 METER C14-C15 LOCKING POWER CORD (WHITE) 2 METER	ZONIT	2m (1)zLock-zC14-14-eC15-	2	EA	
		ZONT	2m-WH (1) zLock-zC14-14-aC13-	1	EA	
	C14-C13 LOCKING POWER CORD (BLACK) 2 METER	12777	2m (1) ZLock-zC14-14-eC13-	-		
	C14-C13 LOCKING POWER CORD (WHITE) 2 METER	ZONIT	2m-WH	2	EA	
	CAT 6 SURGE PROTECTION DEVICE	ITW	CAT6-75A	1	EA	
	CAT 6A SURGE PROTECTION DEVICE	ITW	CAT6A-75	3	EA	
		A_0.2.0	A COLUMN TO SERVICE STATE OF THE SERVICE STATE OF T		2.0	
VES	4" PRE-MANUFACTURED FIRE RATED SLEEVE	SΠ	EZD44S2	2	EA	
SLEVES	4" PRE-MANUFACTURED FIRE RATED SLEEVE WATERFALL ADAPTER	sπ	EZRCM44S	3	EA	
FIRE RATED SLEEVES	4" PRE-MANUFACTURED FIRE RATED SLEEVE					

PORT#	LOCATION	ITEM	LABEL
1	PCS 2 108	DATA OUTLET	M2A01
2	LAO / ACCESS TELLER / ATM & AHD RM 117	DATA OUTLET	M2A02
3	LAO / ACCESS TELLER / ATM & AHD RM 117	DATA OUTLET	M2A03
4	PCS 1 101	DATA OUTLET	M2A04
5	BOOTH 3 103	DATA OUTLET	M2A06
6	BOOTH 4 104	DATA OUTLET	M2A06
7	BOOTH 5 105	DATA OUTLET	M2A07
8	PCS 7 111	DATA OUTLET	M2A08
9	PCS 8 108	DATA OUTLET	M2A09
10	LIVING ROOM 119	DATA OUTLET	M2A10
11	LIVING ROOM 119	DATA OUTLET	M2A11
12	CONFERENCE ROOM 110	DATA OUTLET	M2A12
13	CONFERENCE ROOM 110	DATA OUTLET	M2A13
14	CONFERENCE ROOM 110	DATA OUTLET	M2A14
15	LAO / ACCESS TELLER / ATM & AHD RM 117	DATA OUTLET	M2A16
16	LAO / ACCESS TELLER / ATM & AHD RM 117	DATA OUTLET	M2A16
17	CASH ROOM 116	DATA OUTLET	M2A 17
18	PRINT / FILE RM 109	DATA OUTLET	M2A 18
19	PRINT / FILE RM 109	DATA OUTLET	M2A19
20	RMER / DATA 115	DATA OUTLET	M2A20
21	RMER / DATA 115	DATA OUTLET	M2A21
22	RMER / DATA 115	DATA OUTLET	M2A22
23	RMER / DATA 115	DATA OUTLET	M2A23
24	RMER / DATA 115	DATA OUTLET	M2A24
25	LOUNGE 113	WALL PHONE	M2A25
26	CASH ROOM 116	DATA OUTLET	M2A26
27	MANUAL TRANSACTION 114	WALL PHONE	M2A27
28	LAO / ACCESS TELLER / ATM & AHD RM 117	WALL PHONE	M2A28
29	PRINT / FILE RM 109	WALL PHONE	M2A25
30	RMER / DATA 115	WALL PHONE	M2A30
31	LAO / ACCESS TELLER / ATM & AHD RM 117	ATM DATA OUTLET	M2A31
32	LOBBY 120	ATM DATA OUTLET	M2A30
33	LOBBY 120	ATM DATA OUTLET	M2A33
34	LOBBY 120	ATM DATA OUTLET	M2A34
35	MANUAL TRANSACTION 114	TELLER DATA OUTLET	M2A36
36	MANUAL TRANSACTION 114	TELLER DATA OUTLET	M2A36
37	MANUAL TRANSACTION 114	TELLER DATA OUTLET	M2A37
38			
39			
40			
41			
42			
43			
44			
45			
45			

ORT	LOCATION	ITEM	LABEL
1	PRINT/FILE RM. 109	WAP 1	M2801
2	LOUNGE 113	WAP 2	M2802
3	LAO / ACCESS TELLER / ATM & AHD RM. 117	WAP 3	M2803
4	LOBBY 120	WAP 4	M2804
5	ORT 121	WAP 5	M2805
6	PCS 7 107	WAP 6	M2806
7			
8			
9			
10			
11			1
12			
13			
14			
15			
16			
17			
18			
19			
20			
21			
22			
23			
24			- 1

PORT #	LOCATION	ITEM	LABEL	
1	LOBBY 120	CAM#1	M2C01	
2	LOBBY 120	CAM#2	M2C02	
3	LIVING ROOM 119	CAM#3	M2C03	
4	LOBBY 120	CAM #4	M2C04	
5	L088Y 120	CAM #5	M2C08	
6	DRT 121	CAM #6	M2C00	
7	LOBBY 120	CAM#7	M2C07	
8	CORRIDOR 112	CAM #8	M2C08	
9	LOUNGE 113	CAM #9	M2C09	
10	DATA / RMER 115	CAM #10	M2C10	
11	CASH ROOM 116	CAM #11	M2C11	
12	MANUAL TRANSACTION 118	CAM #12	M2C12	
13	MANUAL TRANSACTION 118 CAM #13		M2C13	
14	MANUAL TRANSACTION 118	MANUAL TRANSACTION 118 CAM #14		
15	LAO / ACCESS TELLER / ATM & AHD RM. 117 CAM #15		M2016	
16	LAO / ACCESS TELLER / ATM & AHD RM. 117 ATM CAM #16		M2C16	
17	L088Y 120	ATM CAM #17	M2C17	
18	LOBBY 120	ATM CAM #18	M2C18	
19	24 -HOUR TRANSACTION VESTIBULE	CAM #19	M2C19	
20	24 -HOUR TRANSACTION VESTIBULE CAM #20		M2C20	
21	24 -HOUR TRANSACTION VESTIBULE	EXT CAM #21	M2C2	
22	24 -HOUR TRANSACTION VESTIBULE	EXT CAM #22	M2C22	
23	CASH ROOM 116	EXT CAM #23	M2C2	

PATCH PANEL "D" - CAT6A CAMERA - SCHE			E
ORT#	LOCATION	ITEM	LABEL
1	UNISEX RESTROOM 1 110	EXT CAM #25	M2D01
2	CONF ROOM 106	EXT CAM #26	M2D02
3	SITE	A TM CAM #27	M2D03
4	SITE	EXT CAM #28	M2D04
5	SITE	EXT CAM #29	M2D05
6	LOUNGE 113	SECURITY MONITOR	M2D06
7	LOUNGE 113	SECURITY MONITOR	M2007
8	MANUAL TRANSACTION 118	SECURITY MONITOR	M2D08
9	MANUAL TRANSACTION 118	SECURITY MONITOR	M2D09
10			
11			
ORT II LOCATION	ITEM	LABEL
1 LOBBY 120	VM-AV OUTLET	M2E01
2 LIVING ROOM 119	VM-AV OUTLET	M2E02
3 COMMUNITY WALL	VM-AV OUTLET	M2E03
4		
5		
JPMORGAN CHASE & CO. GLOBAL TECHNOLOGY INFRASTRUCTURE

END USER SERVICES
WORKPLACE TECHNOLOGY SERVICES
STRUCTURED CABLING ENGINEERING
1111 POLARIS PARKWAY, COLUMBUS, OHIO 43240

NEW RETAIL

BRANCH
HWY 291 AND SE

LANGSFORD RD

keypla

FOR REFERENCE ONLY
ISSUED AND
PERMITTED BY OTHERS

se



issue			
no	date	issue	b
Α	12.21.2020	ISSUED FOR COORDINATION	K
В	01.19.2021	ISSUED FOR CONSTRUCTION	k

JP MORGAN CHASE & CO 890 NE LANGSROD RD LEE'S SUMMIT, MO

designed KB date 01.19.2021 drawn KB checked CC scale AS NOTED

TELECOM
MATERIALS AND PATCH
PANEL SCHEDULES

job no.

OVP-38200P368999

sheet

TC-601

- "#" DENOTES THAT THE CONTRACTOR IS TO FIELD VERIFY LENGTHS AND QUANTITIES PRIOR

- IT IS THE CONTRACTOR'S RESPONSIBILITY TO VERIFY ALL QUANTITIES PRIOR TO

TO PROCUREMENT.





PROJECT PANEL SCHEDULE