



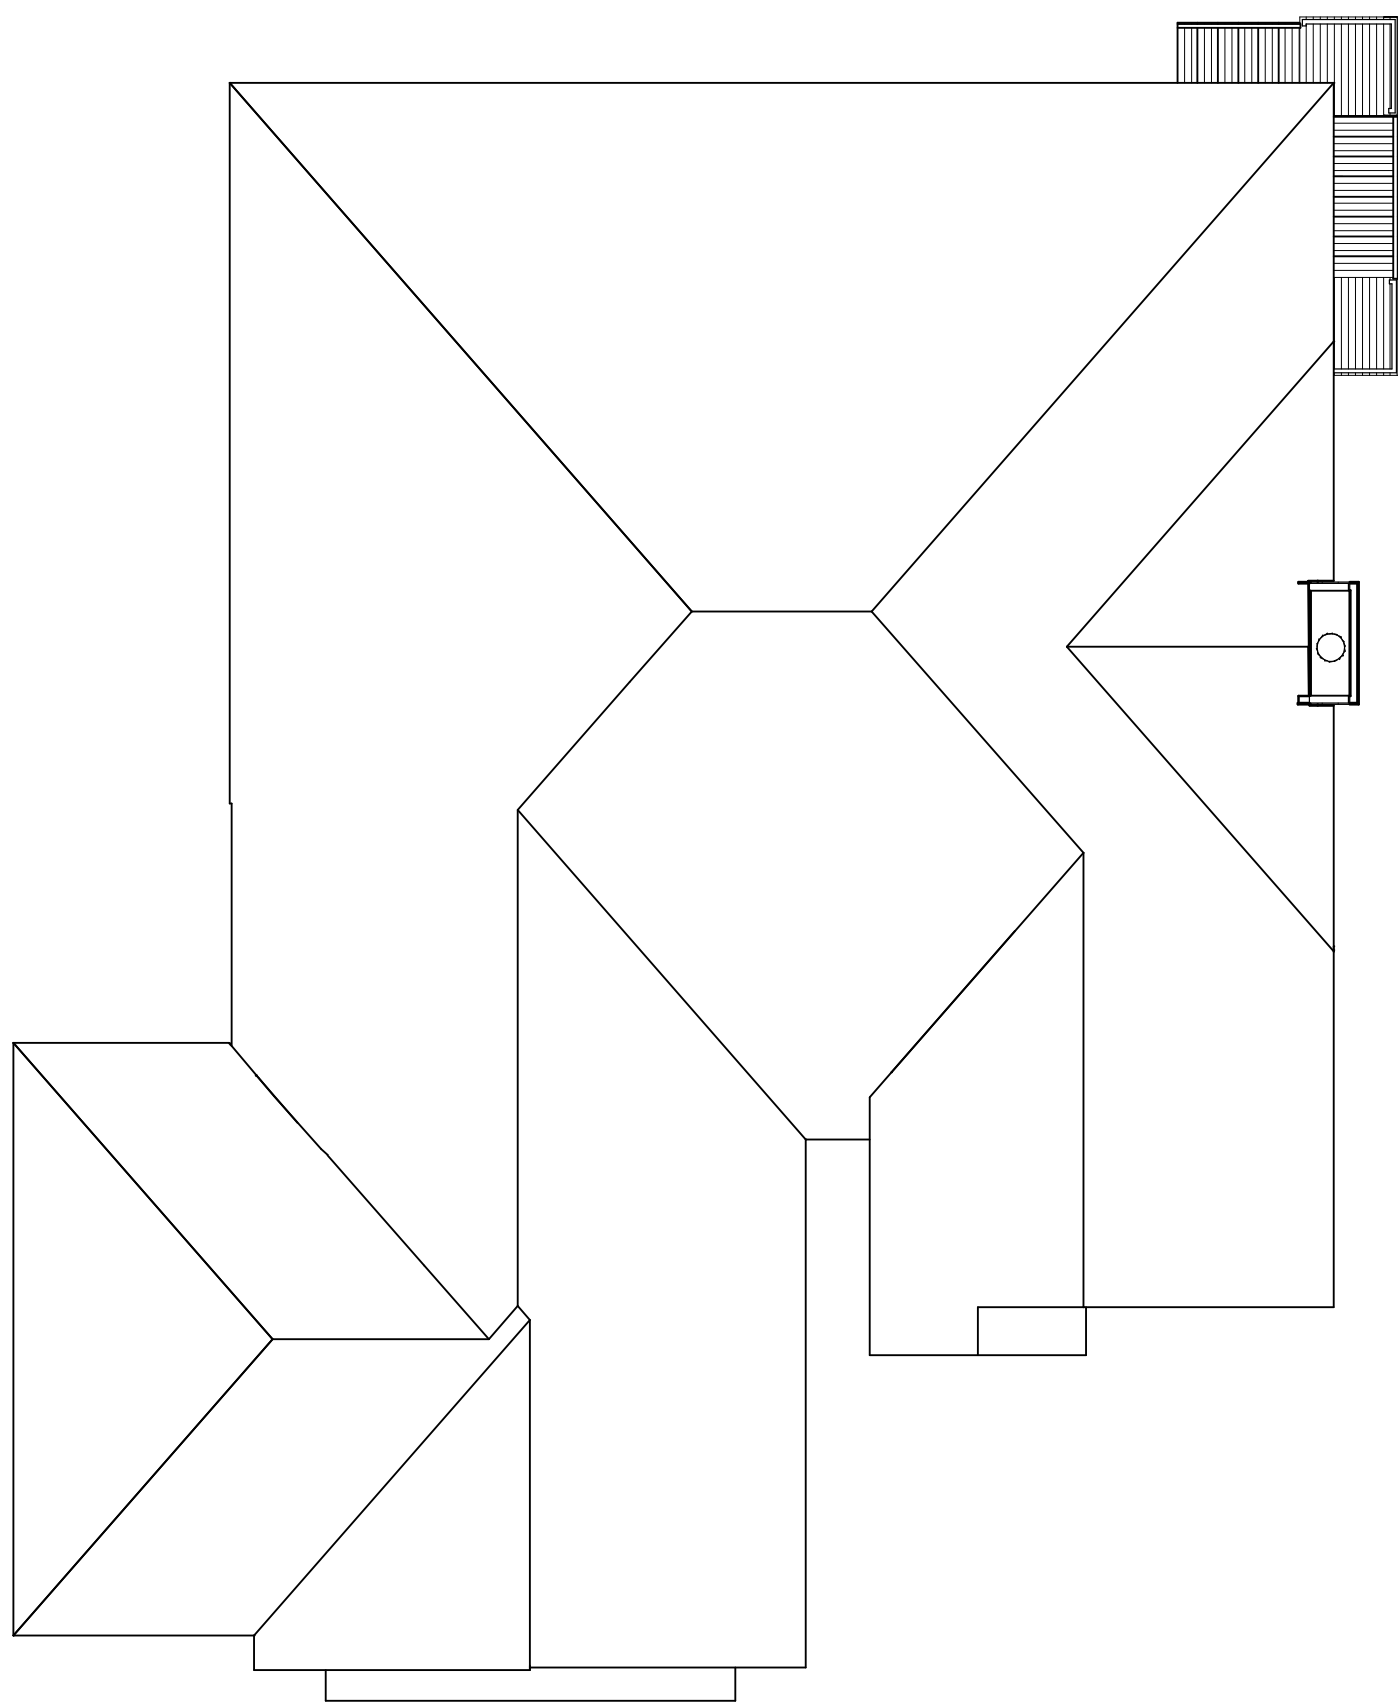


ROOF PLAN
1/8" = 1'-0"
SIDE TO SIDE 8/12
FRONT TO BACK 7/12


RAFTERS 2 X 6 DF NO 2 @ 16" OC TYP.
HIPS AND RIDGERS 2 X 8 DF NO 2 TYP.

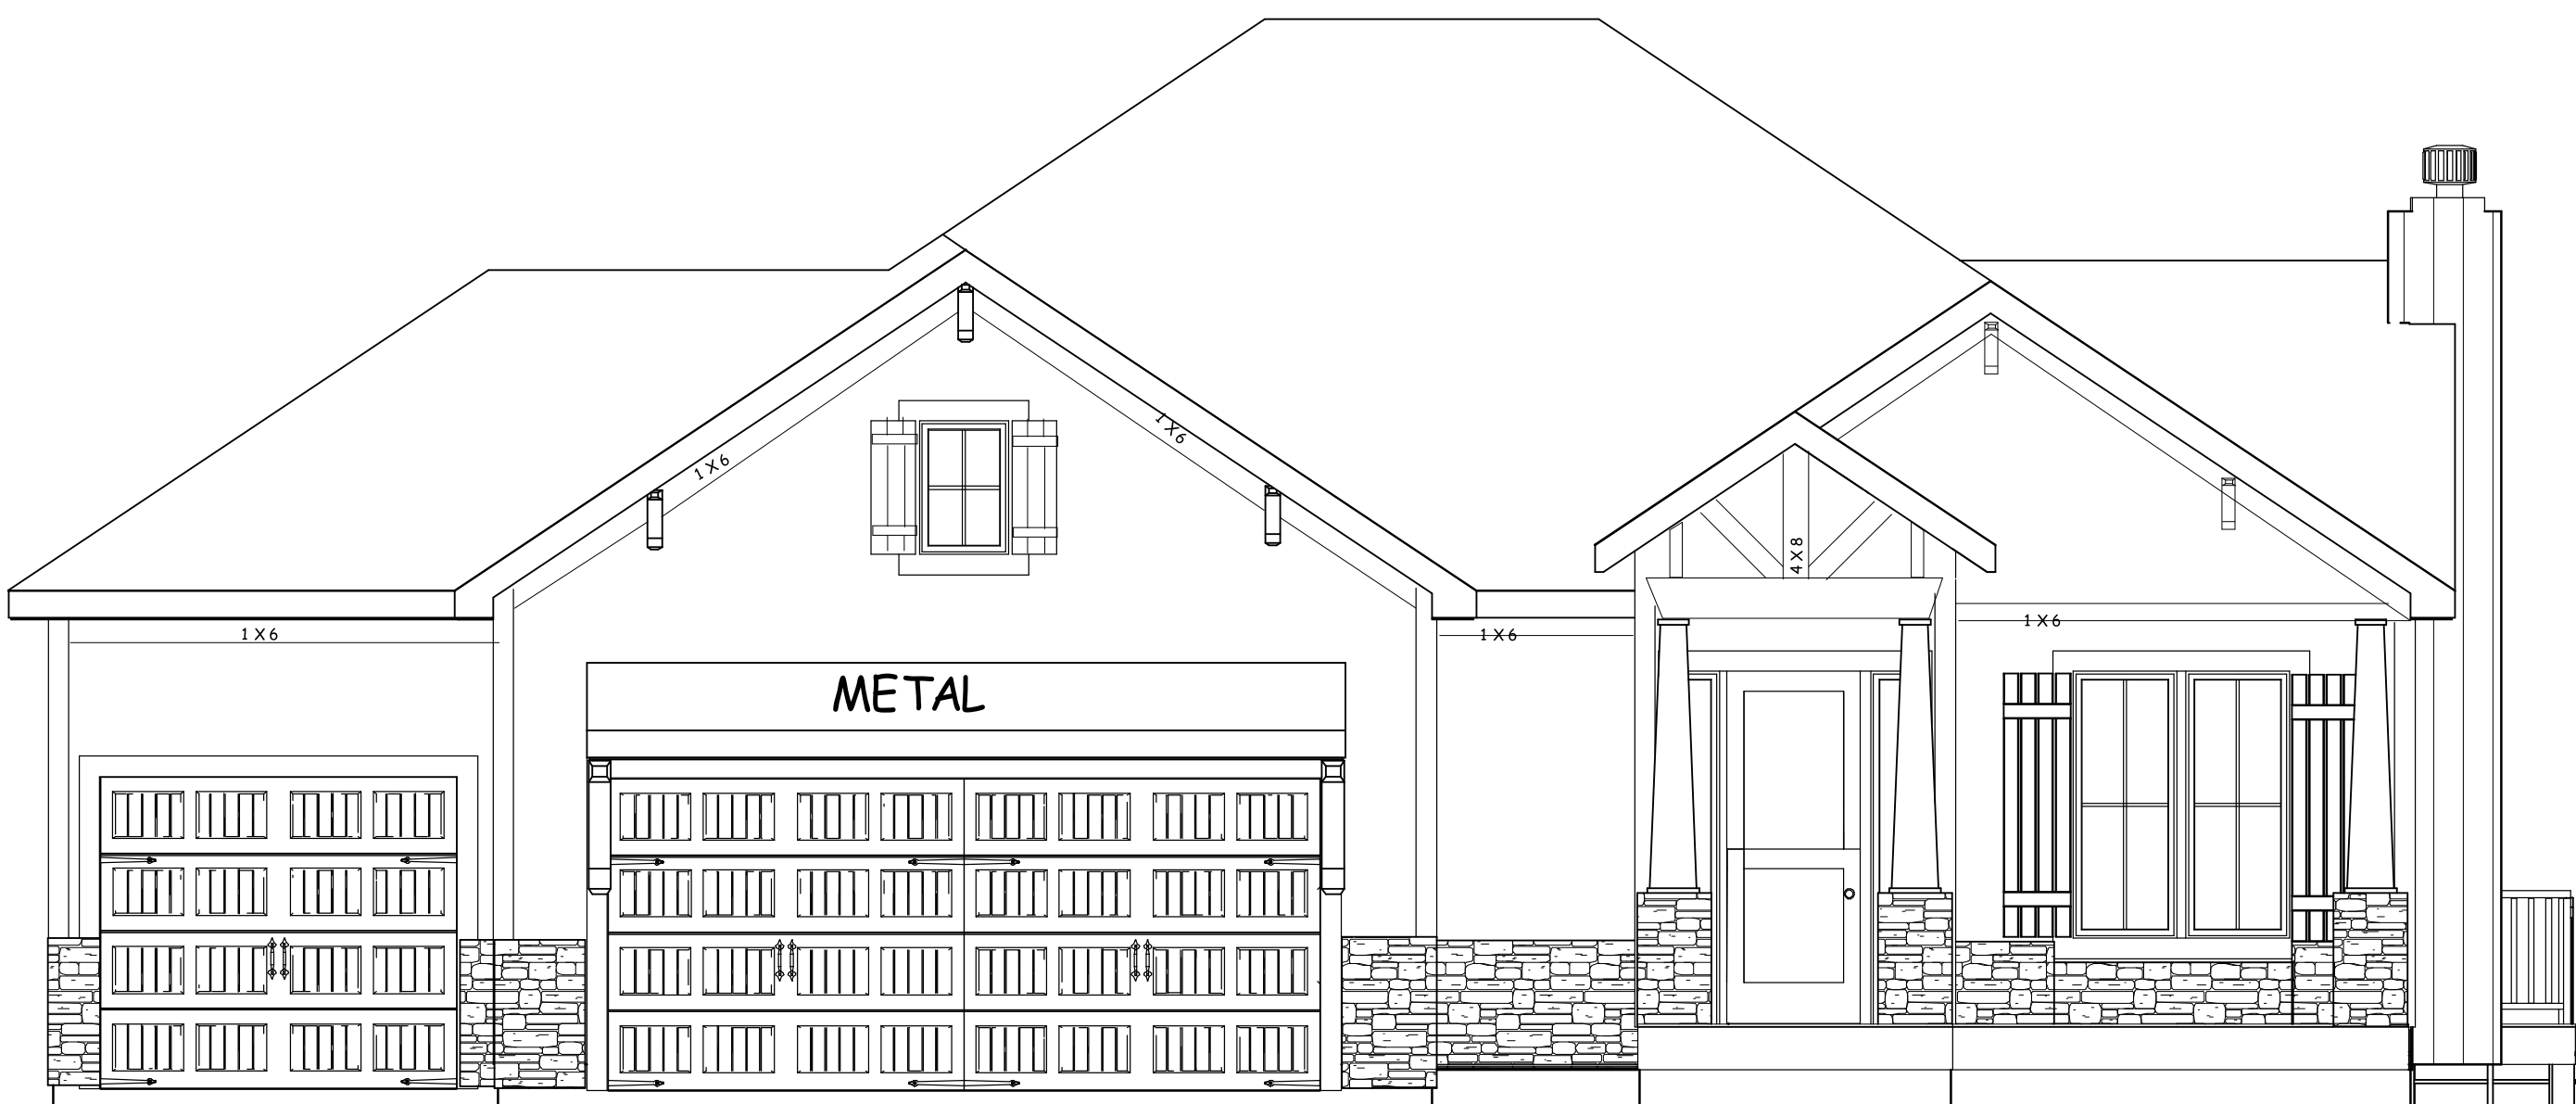

FRONT EL.
STUCCO & STONE

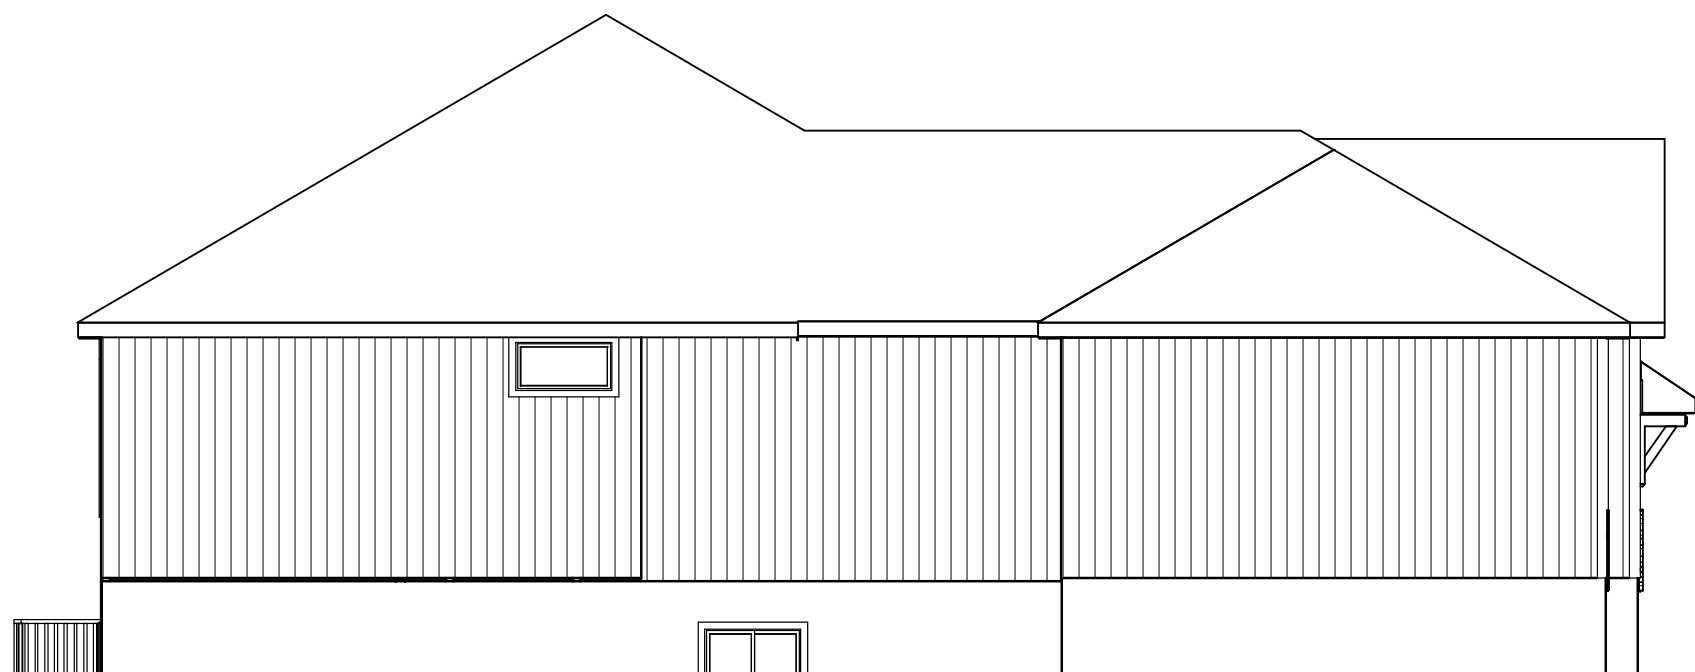

LEFT EL.
1/8" = 1'-0"

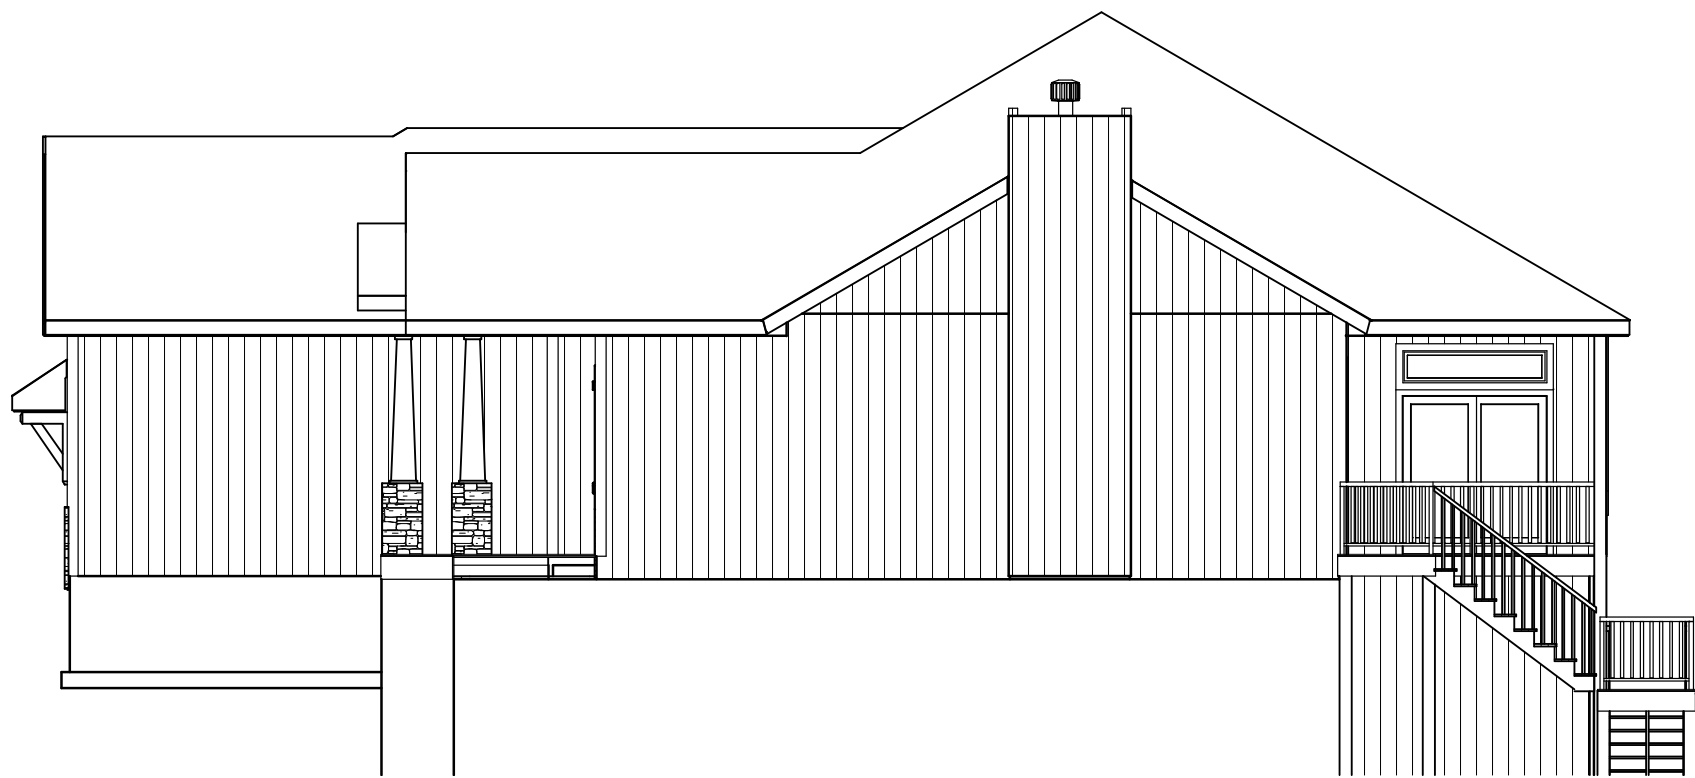

RIGHT EL.
1/8" = 1'-0"



REAR EL.
1/8" = 1'-0"

RELEASE FOR CONSTRUCTION
AS NOTED FOR PLAN REVIEW
DEVELOPMENT SERVICES
LEE'S SUMMIT, MISSOURI
07/19/2021



BUILD IN ACCORDANCE WITH
2018 INTERNATIONAL
RESIDENTIAL CODE AND
LOCAL CODES.

LOT 124 MONTICELLO
4816 NE JAMESTOWN DR
LEE SUMMIT MO


TRUARK HOMES
KYLE II

SCALE
1/4" = 1'-0"

DATE
6-26-21

PLAN NO.
3561


SHEET NO.
1 OF 5

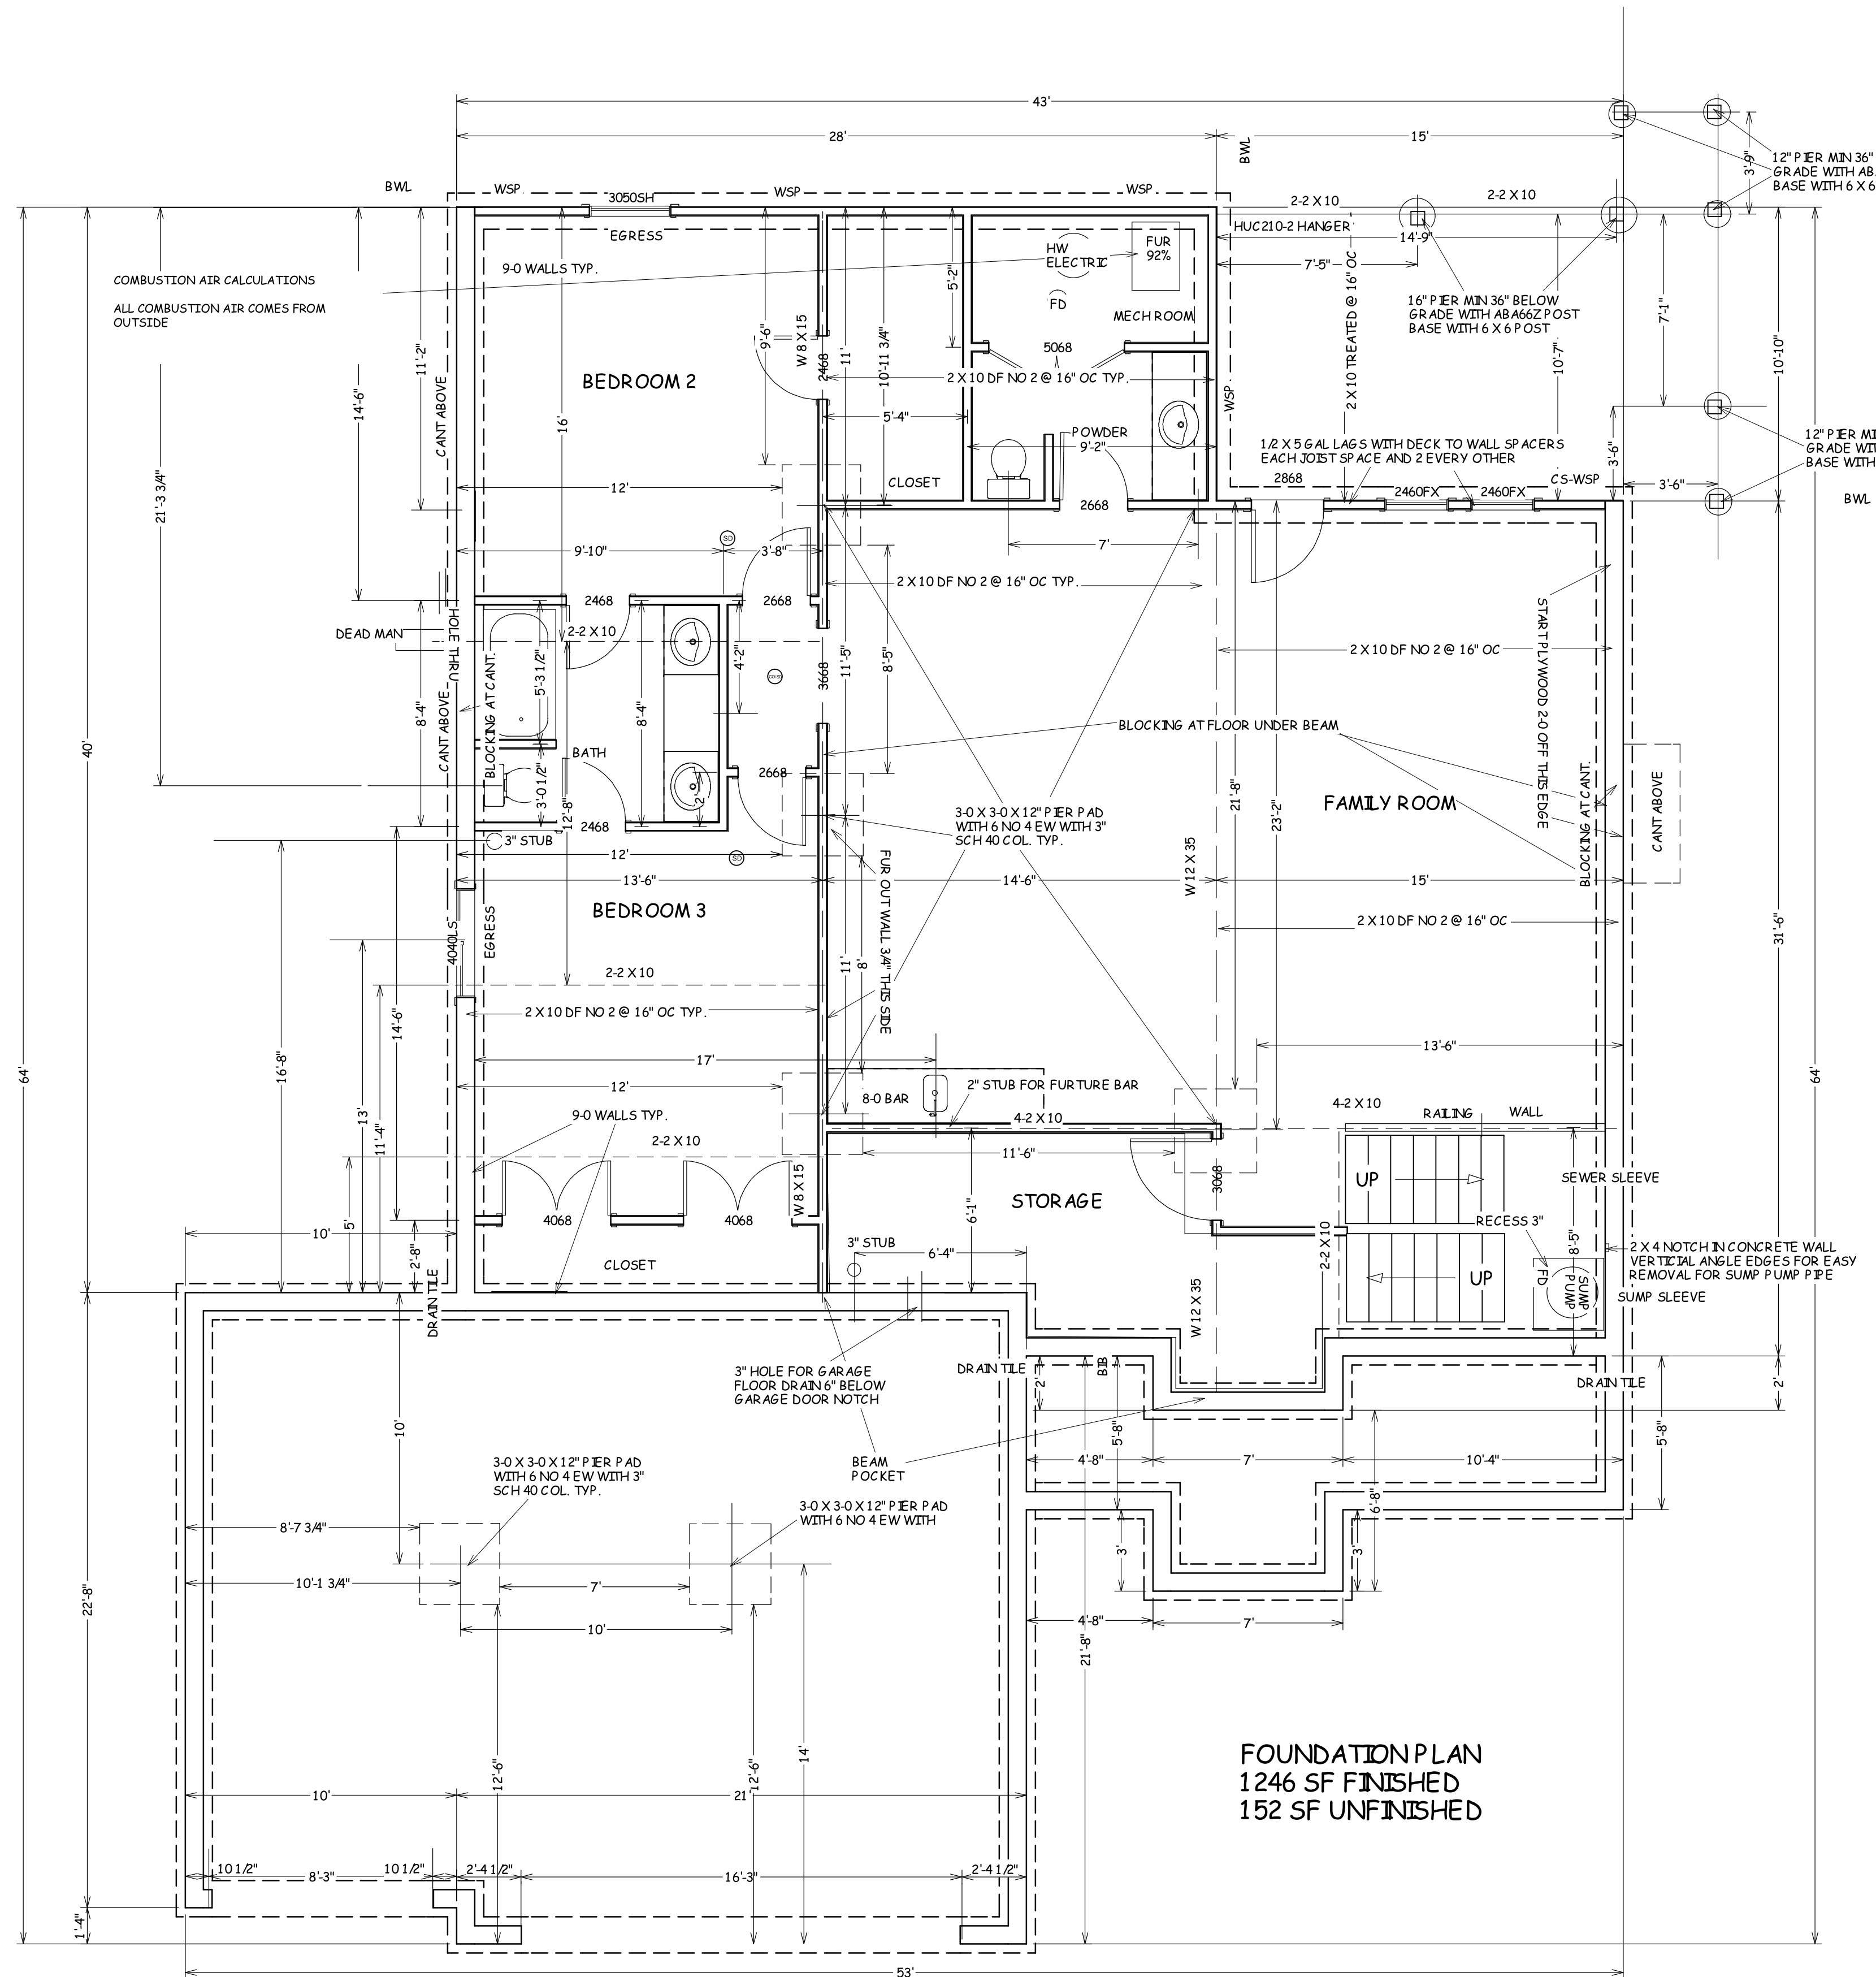

BUILD IN ACCORDANCE WITH 2018 INTERNATIONAL RESIDENTIAL CODE AND LOCAL CODES.	LOT 124 MONTICELLO 4816 NE JAMESTOWN DR LEE SUMMIT MO	TRUMARK HOMES KYLE II	SCALE 1/4" = 1'-0	DATE 6-26-21	PLAN NO. 3561	SHEET NO. 2 OF 5
--	---	--------------------------	----------------------	-----------------	------------------	---------------------

TYPICAL EXTERIOR CORNER FILE CORNER WITH STUDS

LADDER BLOCK WHERE INTERIOR WALLS INTERSECT WITH EXTERIOR WALLS

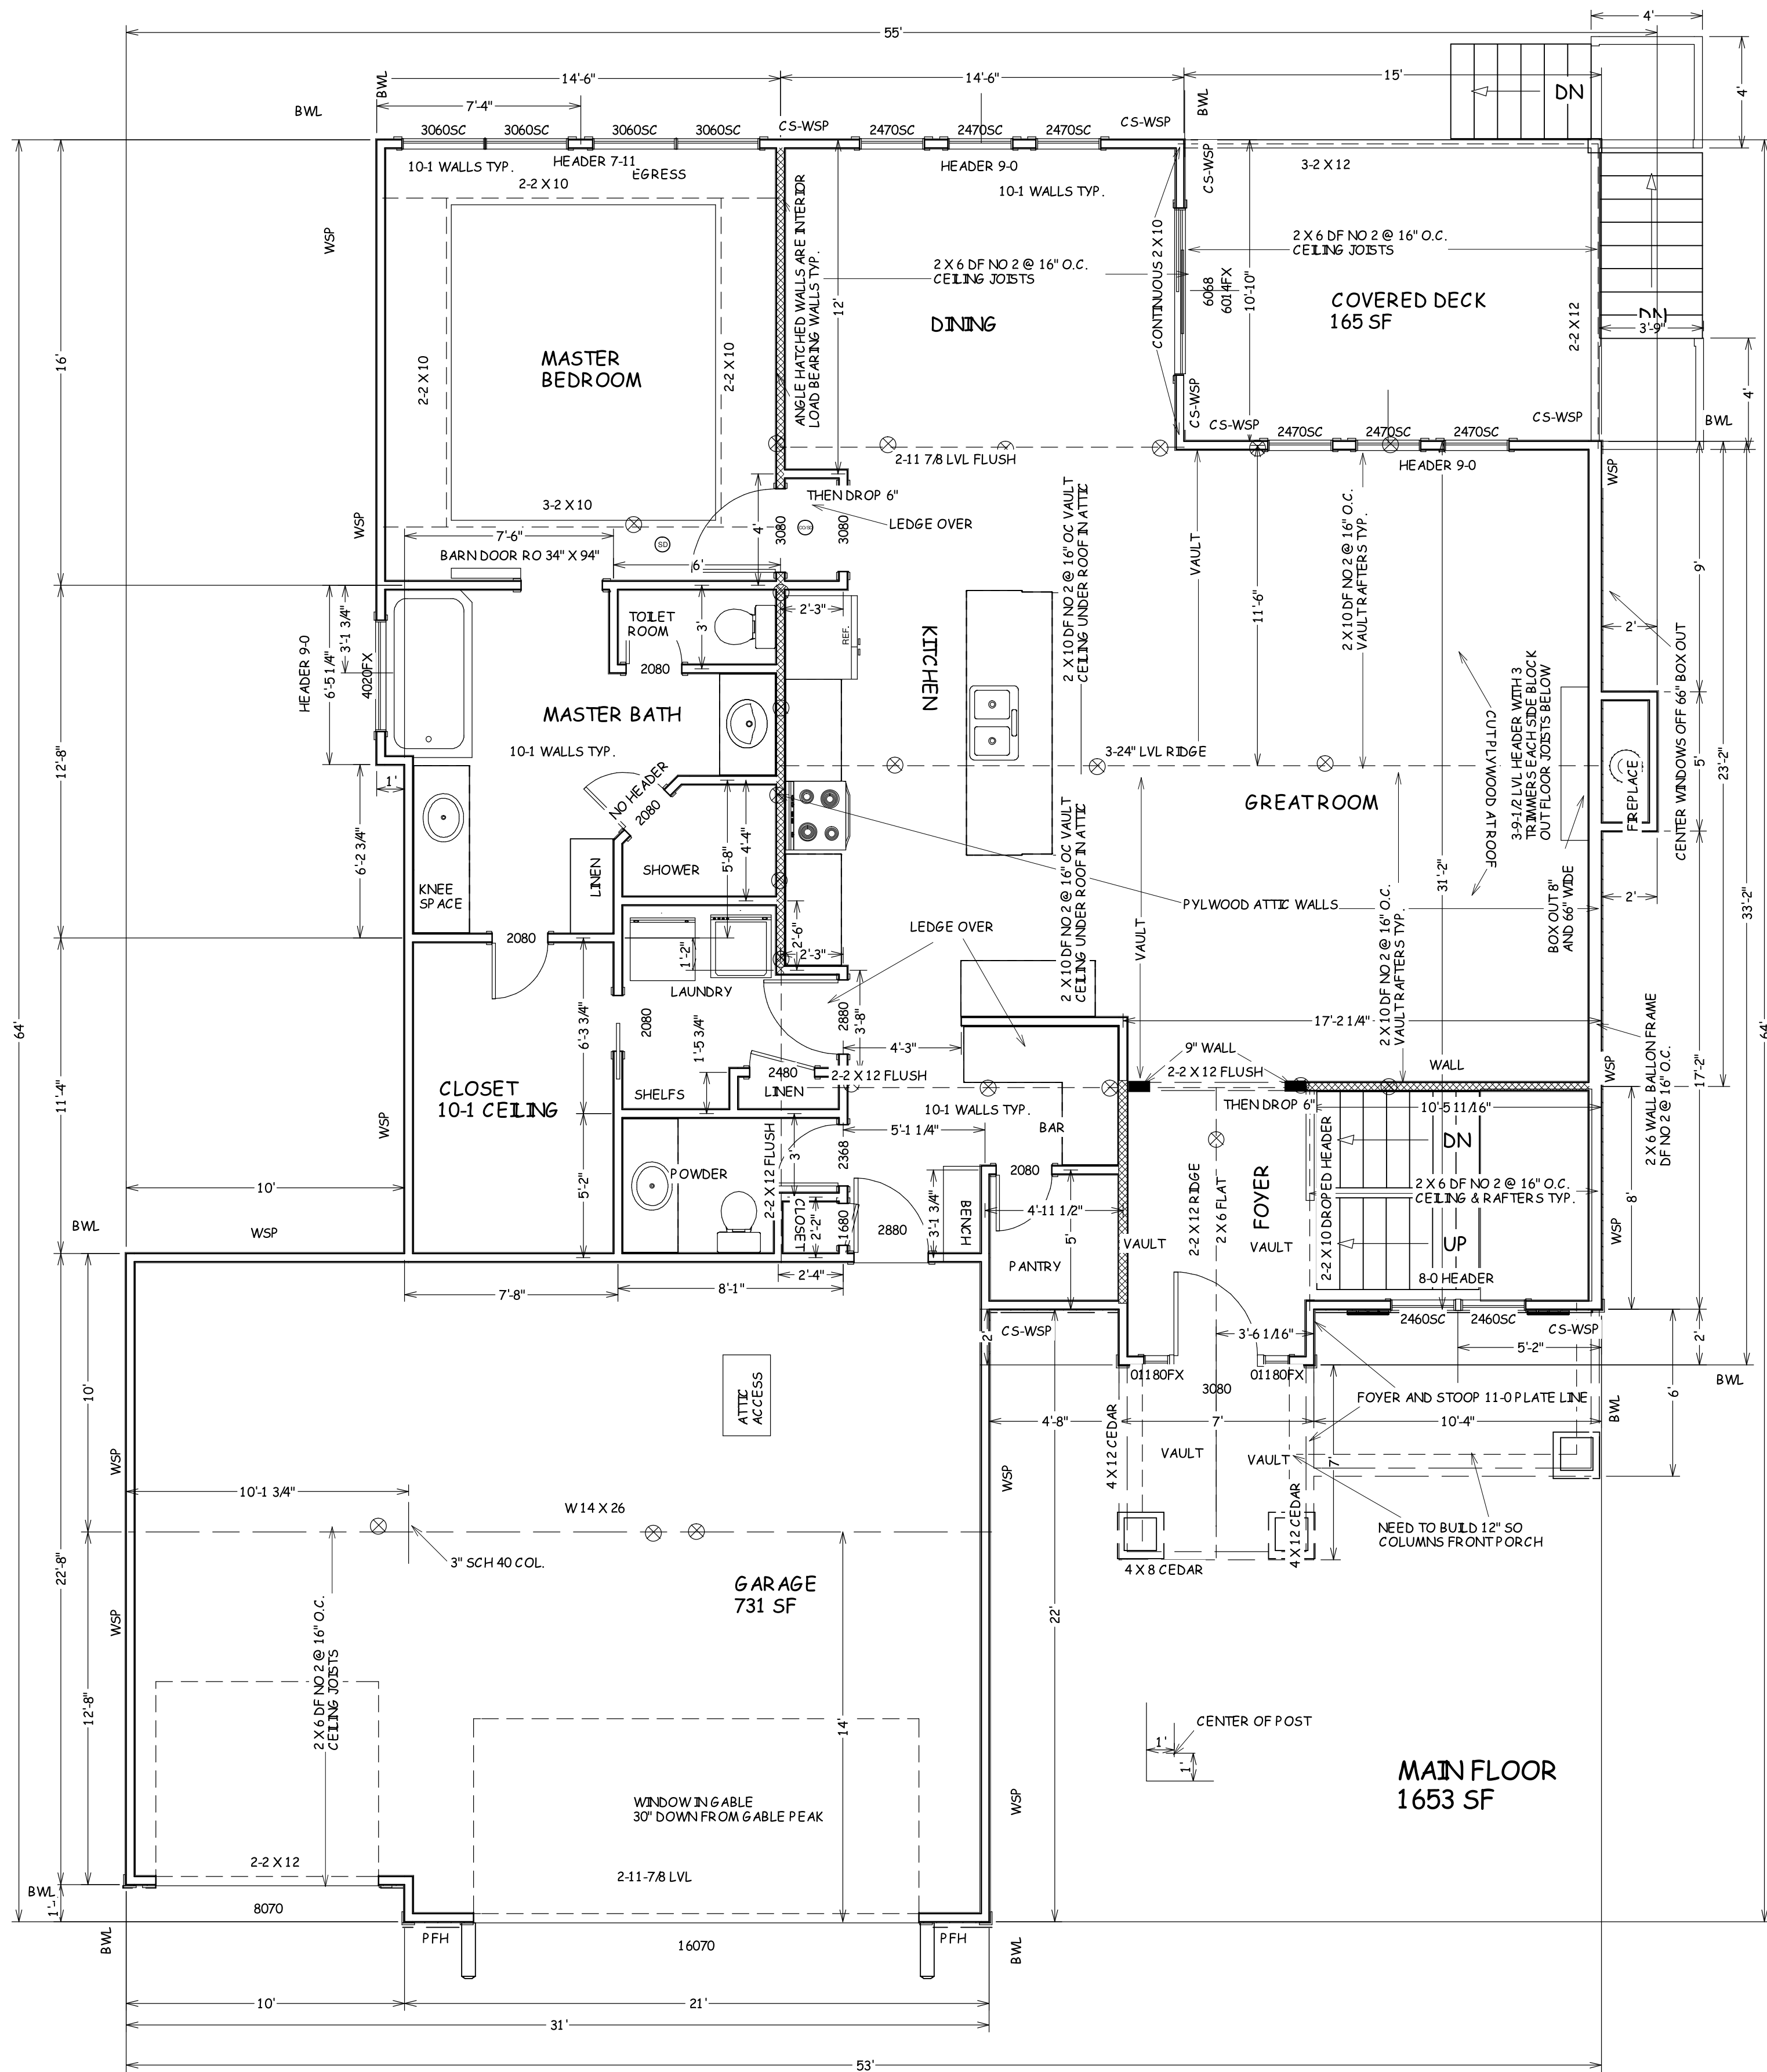

BUILD IN ACCORDANCE WITH
2018 INTERNATIONAL
RESIDENTIAL CODE AND
LOCAL CODES.

LOT 124 MONTICELLO
4816 NE JAMESTOWN DR
LEE SUMMIT MO

TRUEMARK HOMES
KYLE II

SCALE
1/4" = 1'-0

DATE
6-26-21

PLAN NO.
3561

SHEET NO.

3 OF 5

RELEASE FOR CONSTRUCTION
AS NOTED FOR PLAN REVIEW
DEVELOPMENT SERVICES
LEE'S SUMMIT, MISSOURI
07/19/2021

EXPOSURE CATEGORY B 10-FOOT MEAN ROOF HEIGHT 10-FOOT WALL HEIGHT 2 BRACED WALL LINES		MINIMUM TOTAL LENGTH (FEET) OF BRACED WALL PANELS REQUIRED ALONG EACH BRACED WALL LINE ^a				
Ultimate Design Wind Speed (mph)	Story Location	Braced Wall Line Spacing ^b (feet)	Method LIB ^c	Method GB	Methods DWB, WSP, SFB, PBS, PCP, HPS, BV-WSP, ABW, PFH, PFG, CS-SFB	Methods CS-WSP, CS-O, CS-PF
≤ 115		10	3.5	3.5	2.0	2.0
		20	6.5	6.5	3.5	3.5
		30	9.5	9.5	5.5	4.5
		40	12.5	12.5	7.0	6.0
		50	15.0	15.0	9.0	7.5
		60	18.0	18.0	10.5	9.0
		10	7.0	7.0	4.0	3.5
		20	12.5	12.5	7.5	6.5
		30	18.0	18.0	10.5	9.0
		40	23.5	23.5	13.5	11.5
		50	29.0	29.0	16.5	14.0
		60	34.5	34.5	20.0	17.0
		10	NP	10.0	6.0	5.0
		20	NP	18.5	11.0	9.0
		30	NP	27.0	15.5	13.0
		40	NP	35.0	20.0	17.0
		50	NP	43.0	24.5	21.0
		60	NP	51.0	29.0	25.0


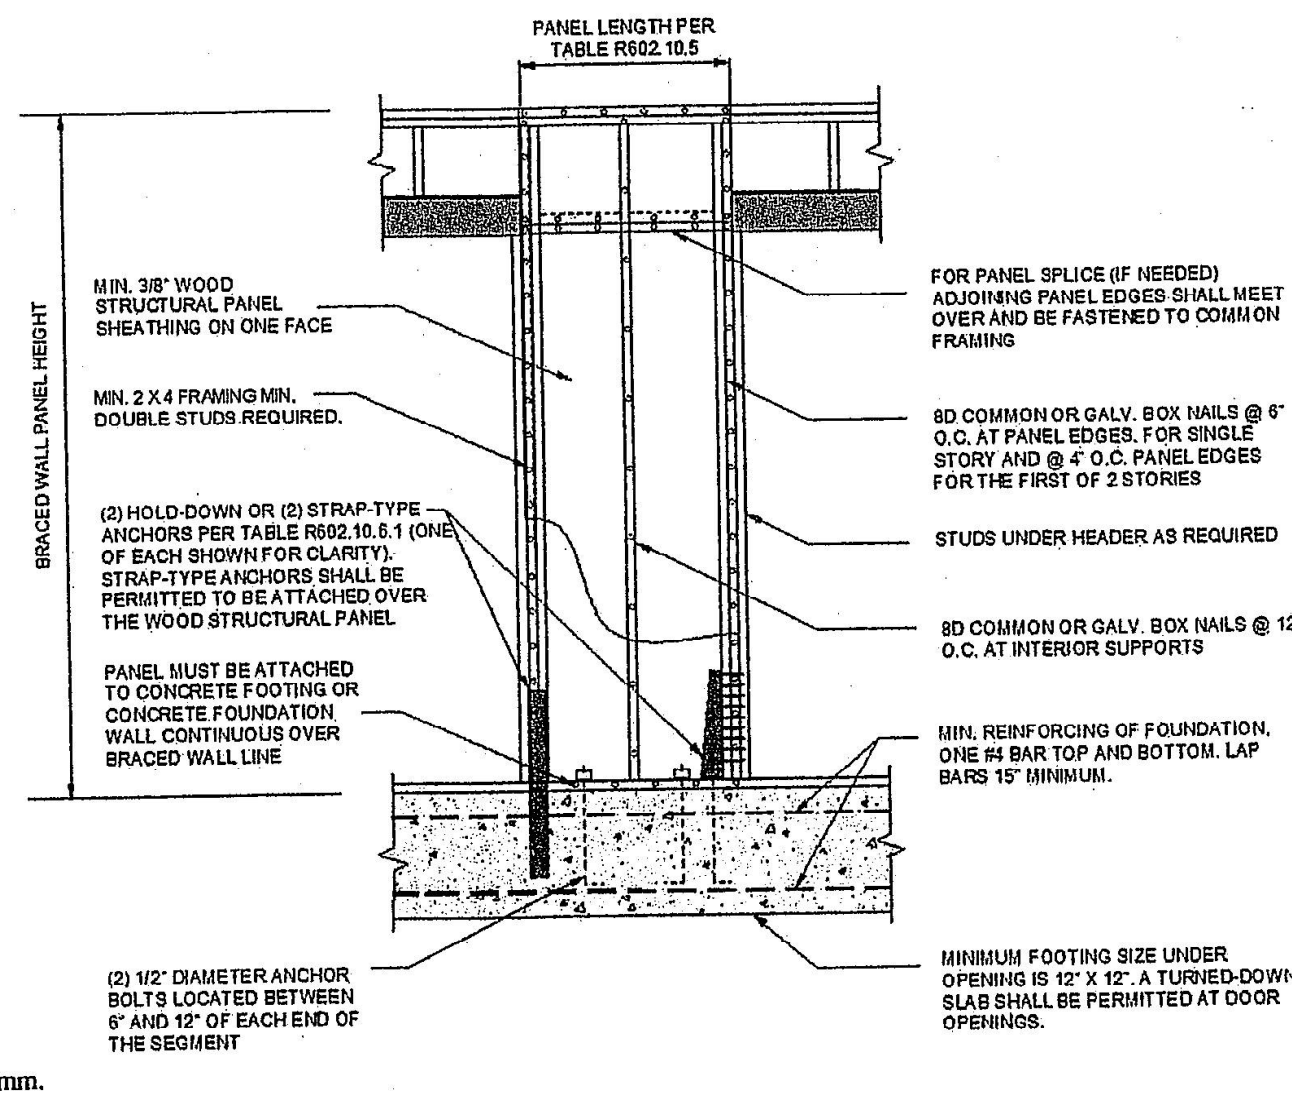


FIGURE R602.10.6.1
METHOD ABW—ALTERNATE BRACED WALL PANEL

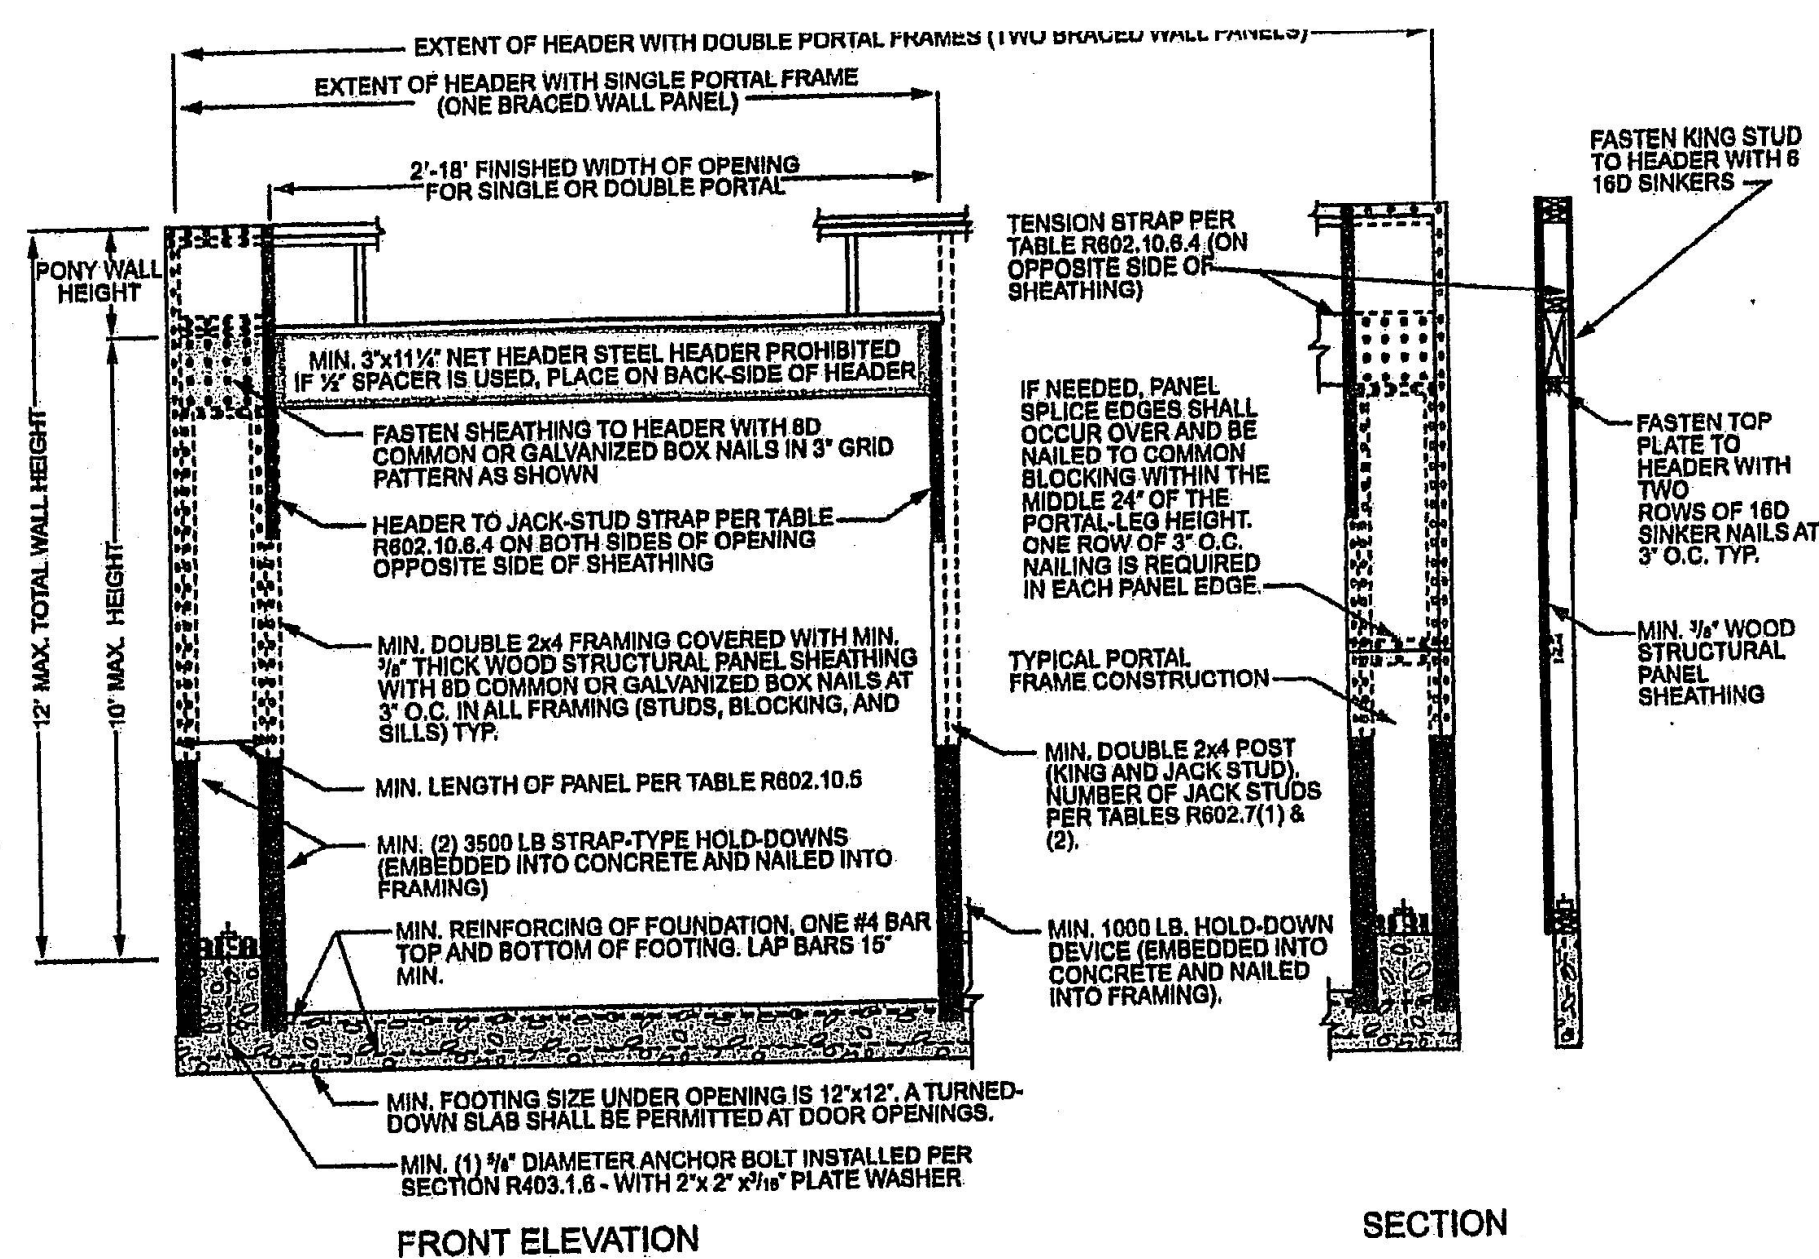

4 mm, 1 foot = 304.8 mm.

FIGURE R602.10.6.2
METHOD PFH—PORTAL FRAME WITH HOLD-DOWNS

METHODS, MATERIAL	MINIMUM THICKNESS	FIGURE	CONNECTION CRITERIA ^a	
			Fasteners	Spacing
LIB Let-in-bracing	1 × 4 wood or approved metal straps at 45° to 60° angles for maximum 16" stud spacing		Wood: 2-8d common nails or 3-8d (2 1/2" long × 0.113" dia.) nails Metal strap: per manufacturer	Wood: per stud and top and bottom plates Metal: per manufacturer
DWB Diagonal wood boards	3/4" (1" nominal) for maximum 24" stud spacing		2-8d (2 1/2" long × 0.113" dia.) nails or 2 - 1 1/4" long staples	Per stud
WSP Wood structural panel (See Section R604)	3/8"		Exterior sheathing per Table R602.3(3) Interior sheathing per Table R602.3(1) or R602.3(2)	6" edges 12" field Varies by fastener
BV-WSP Wood structural panels with stone or masonry veneer (See Section R602.10.6.5)	7/16"	See Figure R602.10.6.5	8d common (2 1/2" × 0.131") nails	4" at panel edges 12" at intermediate supports 4" at braced wall panel end posts
SFB Structural fiberboard sheathing	1/2" or 3/4" for maximum 16" stud spacing		1 1/2" long × 0.12" dia. (for 1/2" thick sheathing) 1 1/4" long × 0.12" dia. (for 3/4" thick sheathing) galvanized roofing nails	3" edges 6" field
GB Gypsum board	1/2"		Nails or screws per Table R602.3(1) for exterior locations Nails or screws per Table R702.3.5 for interior locations	For all braced wall panel locations: 7" edges (including top and bottom plates) 7" field
PBS Particleboard sheathing (See Section R605)	3/8" or 1/2" for maximum 16" stud spacing		For 3/8", 6d common (2" long × 0.113" dia.) nails For 1/2", 8d common (2 1/4" long × 0.131" dia.) nails	3" edges 6" field
PCP Portland cement plaster	See Section R703.7 for maximum 16" stud spacing		1 1/2" long, 11 gage, 1/16" dia. head nails or 7/8" long, 16 gage staples	6" o.c. on all framing members
HPS Hardboard panel siding	1/16" for maximum 16" stud spacing		0.092" dia., 0.225" dia. head nails with length to accommodate 1 1/2" penetration into studs	4" edges 8" field
ABW Alternate braced wall	3/8"		See Section R602.10.6.1	See Section R602.10.6.1

METHOD (See Table R602.10.4)	MINIMUM LENGTH ^a (inches)					CONTRIBUTING LENGTH (inches)
	8 feet	9 feet	10 feet	11 feet	12 feet	
DWB, WSP, SFB, PBS, PCP, HPS, BV-WSP	48	48	48	53	58	Actual ^b
GB	48	48	48	53	58	Double sided = Actual Single sided = 0.5 × Actual
LIB	55	62	69	NP	NP	Actual ^b
ABW	SDC A, B and C, ultimate design wind speed < 140 mph	28	32	34	38	42
	SDC D ₀ , D ₁ and D ₂ , ultimate design wind speed < 140 mph	32	32	34	NP	NP
CS-G	Adjacent clear opening height (inches)	24	27	30	33	36
CS-WSP, CS-SFB	≤ 64	24	27	30	33	36
	68	26	27	30	33	36
	72	27	27	30	33	36
	76	30	29	30	33	36
	80	32	30	30	33	36
	84	35	32	32	33	36
	88	38	35	33	33	36
	92	43	37	35	35	36
	96	48	41	38	36	36
	100	—	44	40	38	38
	104	—	49	43	40	39
	108	—	54	46	43	41
	112	—	—	50	45	43
	116	—	—	55	48	45
	120	—	—	60	52	48
	124	—	—	—	56	51
	128	—	—	—	61	54
	132	—	—	—	66	58
	136	—	—	—	—	62
	140	—	—	—	—	66
	144	—	—	—	—	72
PFH	Supporting roof only	16	16	16	Note c	Note c
	Supporting one story and roof	24	24	24	Note c	Note c
PFG		24	27	30	Note d	Note d
CS-PF	SDC A, B and C	16	18	20	Note e	Note e
	SDC D ₀ , D ₁ and D ₂	16	18	20	Note e	Note e


For SI: 1 inch = 25.4 mm, 1 foot = 304.8 mm, 1 mile per hour = 0.447 m/s.

- NP = Not Permitted.
a. Linear interpolation shall be permitted.
b. Use the actual length where it is greater than or equal to the minimum length.
c. Maximum header height for PFH is 10 feet in accordance with Figure R602.10.6.2, but wall height shall be permitted to be increased to 12 feet with pony wall.
d. Maximum header height for PFG is 10 feet in accordance with Figure R602.10.6.3, but wall height shall be permitted to be increased to 12 feet with pony wall.
e. Maximum header height for CS-PF is 10 feet in accordance with Figure R602.10.6.4, but wall height shall be permitted to be increased to 12 feet with pony wall.

METHODS, MATERIAL	MINIMUM THICKNESS	FIGURE	CONNECTION CRITERIA ^a	
			Fasteners	Spacing
PFH Portal frame with hold-downs	3/4"		See Section R602.10.6.2	See Section R602.10.6.2
PFG Portal frame at garage	7/16"		See Section R602.10.6.3	See Section R602.10.6.3
Continuous Sheathing Methods	CS-WSP Continuously sheathed wood structural panel		Exterior sheathing per Table R602.3(3) Interior sheathing per Table R602.3(1) or R602.3(2)	6" edges 12" field Varies by fastener
	CS-G ^b Continuously sheathed wood structural panel adjacent to garage openings		See Method CS-WSP	See Method CS-WSP
	CS-PF ^c Continuously sheathed portal frame		See Section R602.10.6.4	See Section R602.10.6.4
	CS-SFB ^d Continuously sheathed structural fiberboard		1 1/2" long × 0.12" dia. (for 1/2" thick sheathing) 1 1/4" long × 0.12" dia. (for 3/4" thick sheathing) galvanized roofing nails	3" edges 6" field

For SI: 1 inch = 25.4 mm, 1 foot = 304.8 mm, 1 degree = 0.0175 rad, 1 pound per square foot = 47.8 N/m², 1 mile per hour = 0.447 m/s.

- a. Adhesive attachment of wall sheathing, including Method GB, shall not be permitted in Seismic Design Categories C, D₀, D₁ and D₂.
b. Applies to panels next to garage door opening where supporting gable end wall or roof load only. Shall only be used on one wall of the garage. In Seismic Design Categories D₀, D₁ and D₂ roof covering dead load shall not exceed 3 psf.
c. Garage openings adjacent to a Method CS-G panel shall be provided with a header in accordance with Table R602.7(1). A full-height clear opening shall not be permitted adjacent to a Method CS-G panel.
d. Method CS-SFB does not apply in Seismic Design Categories D₀, D₁ and D₂.
e. Method applies to detached one- and two-family dwellings in Seismic Design Categories D₀ through D₂ only.

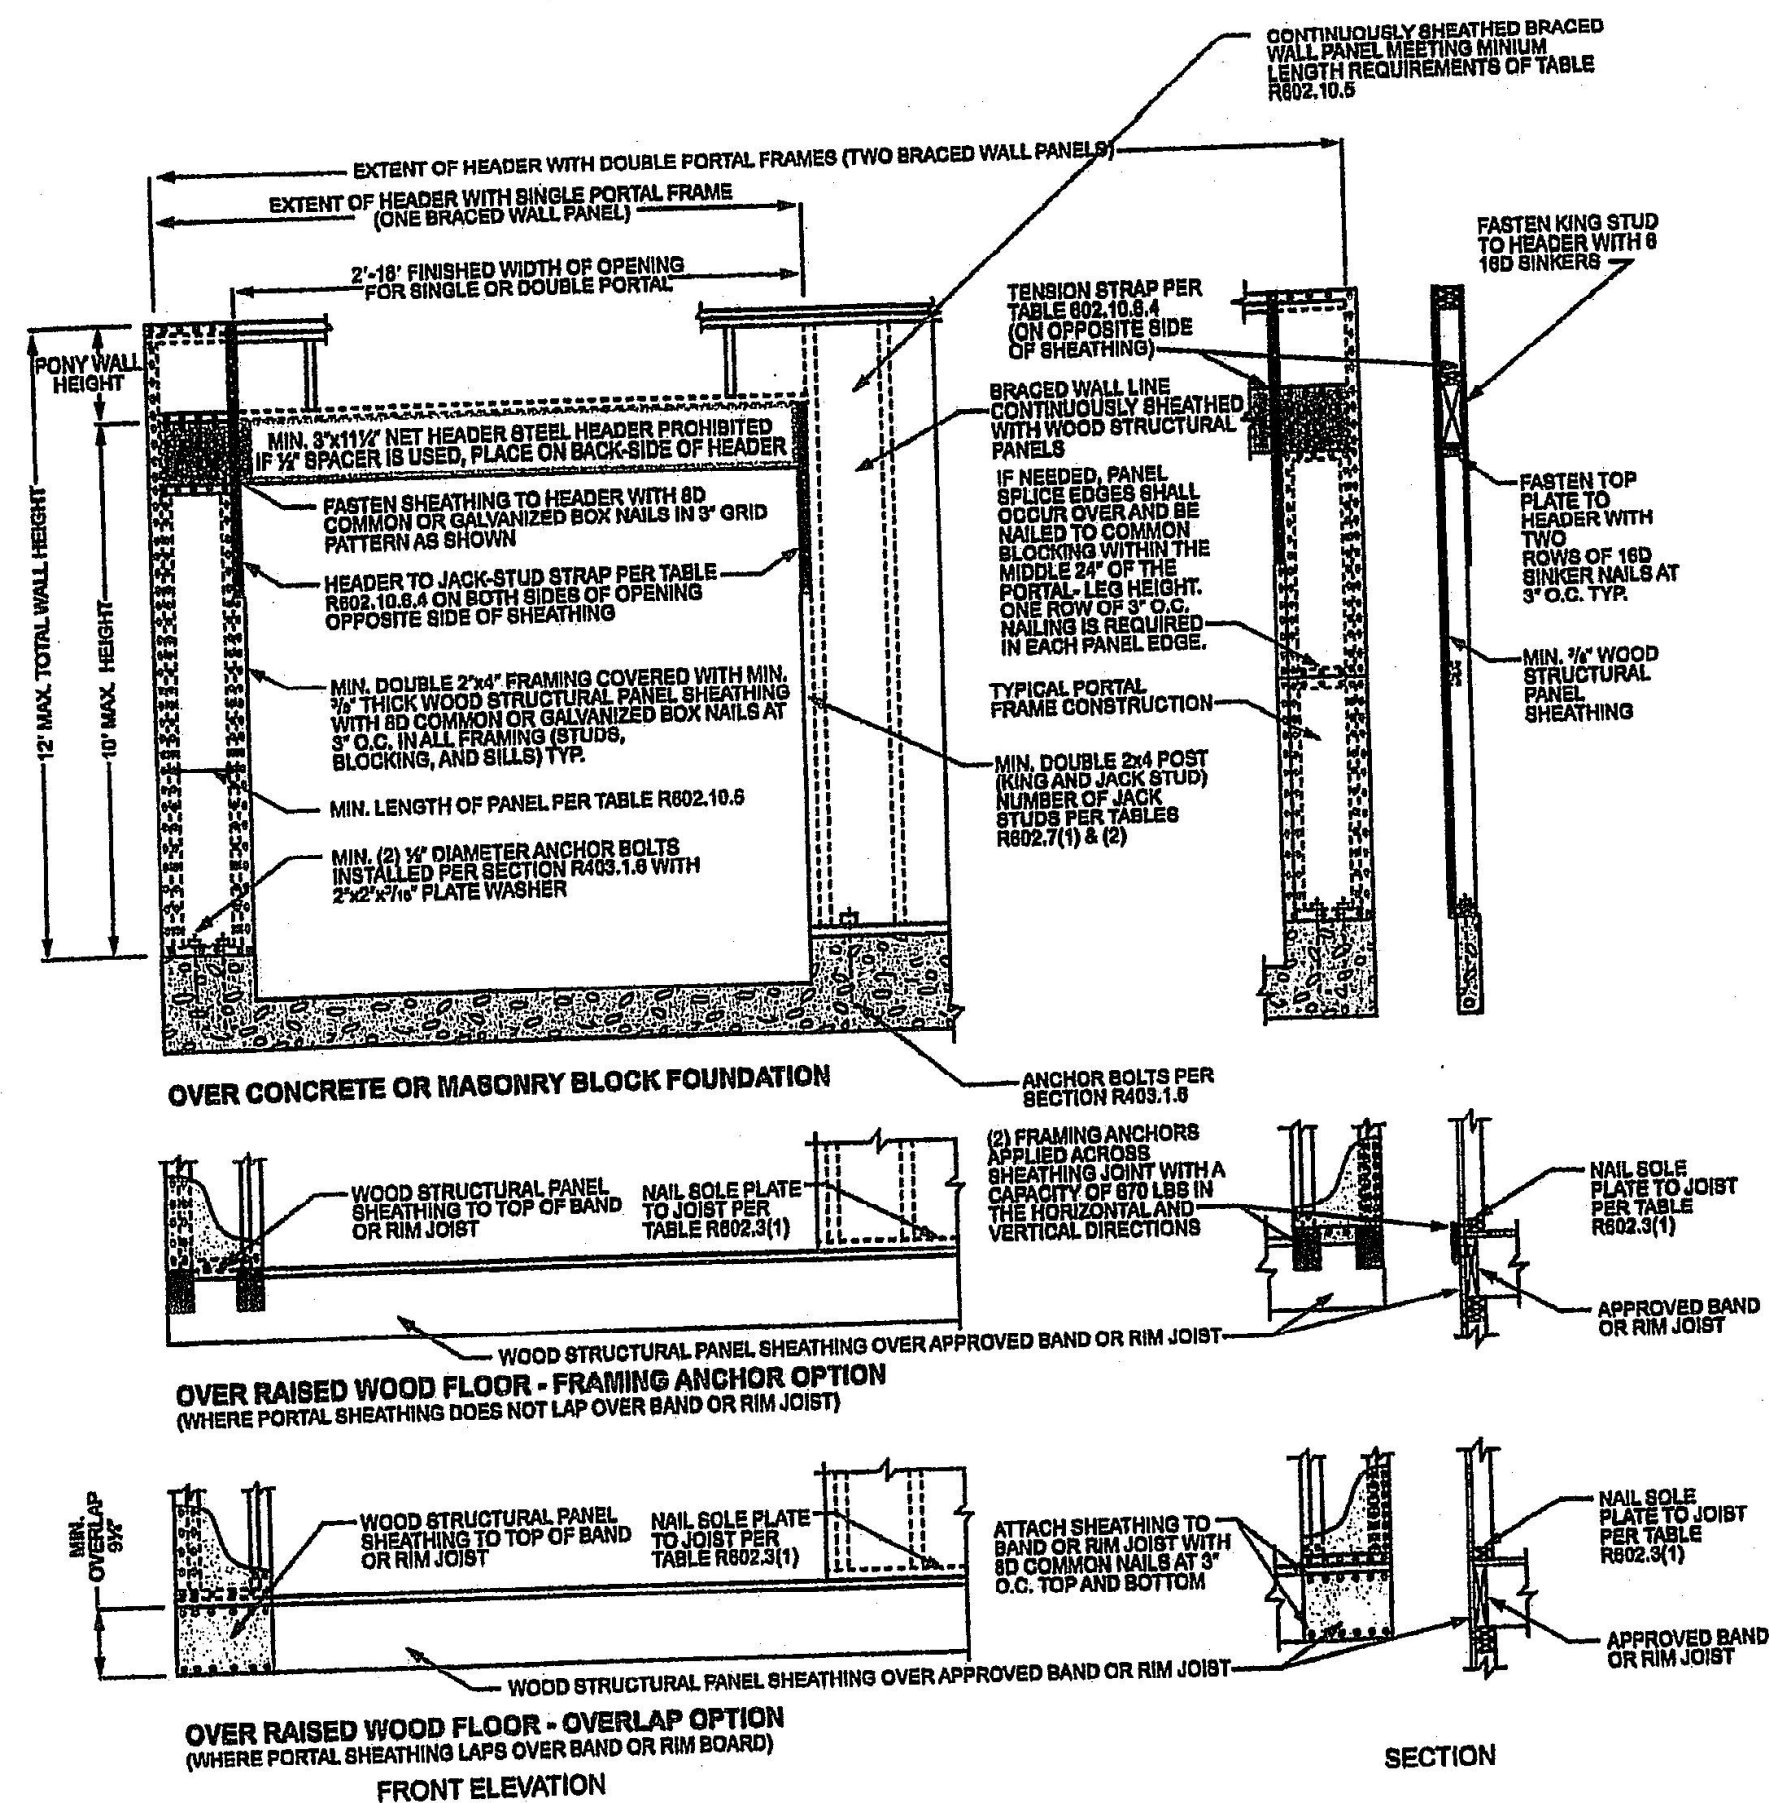

For SI: 1 inch = 25.4 mm, 1 foot = 304.8 mm.

FIGURE R602.10.6.4
METHOD CS-PF—CONTINUOUSLY SHEATHED PORTAL FRAME PANEL CONSTRUCTION

BUILD IN ACCORDANCE WITH
2018 INTERNATIONAL
RESIDENTIAL CODE AND
LOCAL CODES.

LOT 124 MONTICELLO
4816 NE JAMESTOWN DR
LEE SUMMIT MO

TRUMARK HOMES
KYLE II

SCALE
1/4" = 1'-0"

DATE
6-26-21

PLAN NO.
3561

SHEET NO.

5 OF 5

RELEASE FOR CONSTRUCTION
AS NOTED FOR PLAN REVIEW
DEVELOPMENT SERVICES
LEE'S SUMMIT, MISSOURI
07/19/2021