


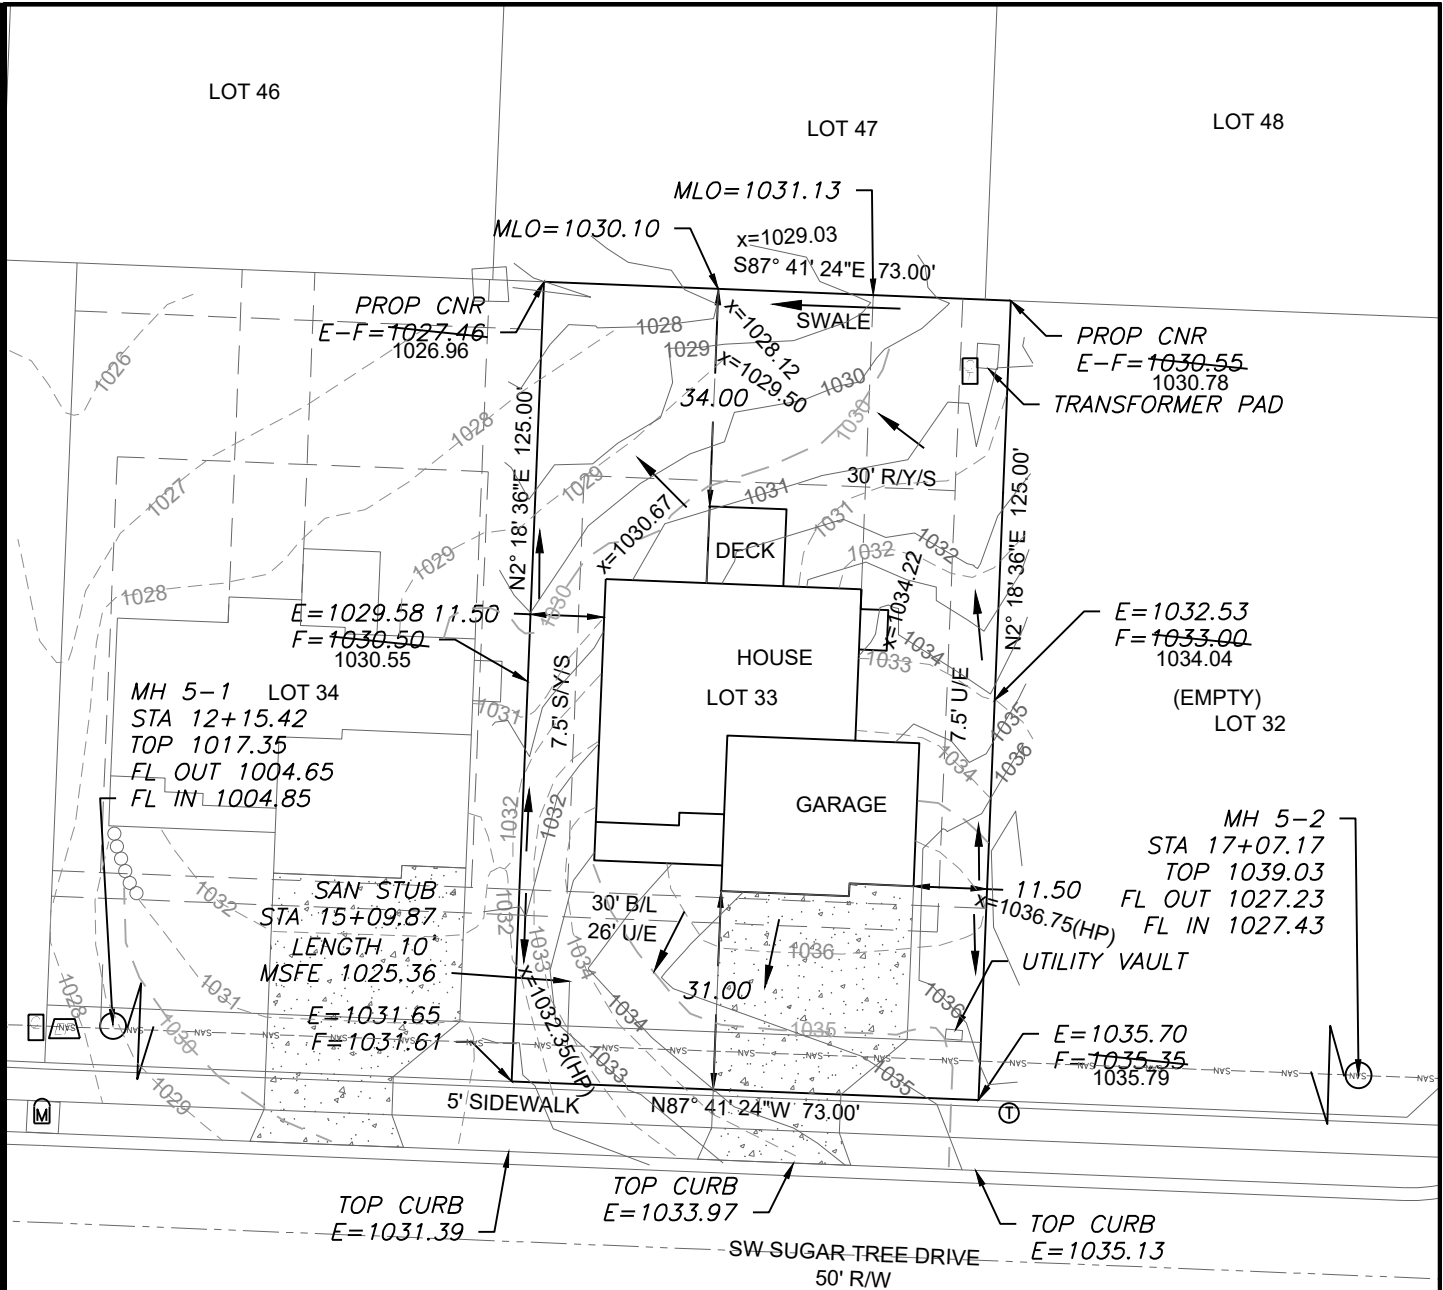

LEGEND

- Gas Meter
- Telephone or Fiber-Optic Pedestal
- Cable TV Pedestal
- Electric Pedestal
- Light Pole
- Mailbox
- Fire Hydrant
- Water Valve

PROPOSED HOUSE

TOP FOUNDATION = 1037.50
GARAGE FLOOR = 1036.50
TOP FOOTING = 1028.50
BASEMENT FLOOR = 1028.83

E = EXISTING ELEVATION
F = PROPOSED FINAL ELEVATION
G = ADJACENT GRADE AT EGRESS
U/E = UTILITY EASEMENT
B/L = BUILDING LINE
S/Y/S = SIDE YARD SETBACK
R/Y/S = REAR YARD SETBACK

NOTES

- BUILDER TO VERIFY ALL BUILDING ELEVATIONS AND DIMENSIONS.
- THIS PLOT PLAN DOES NOT CONSTITUTE A BOUNDARY SURVEY.
- THE EASEMENTS SHOWN ON THIS PLOT PLAN ARE TAKEN FROM THE FINAL PLAT. OTHER EASEMENTS MAY EXIST.



EXTENDED LOT AREA = 9928.0 SF
DRIVEWAY = 905.0 SF
DRIVEWAY APPROACH = 230.0 SF
SIDEWALK = 265.0 SF
DRIVEWAY SLOPE = 7.5%

X=###.## = Actual asbuilt ground shots taken on June 30, 2021.

Contours shown are asbuilt.

PROPOSED CONTOURS
AS-GRADED CONTOURS

AS-GRADED PLOT PLAN IS REQUIRED PRIOR TO SODDING

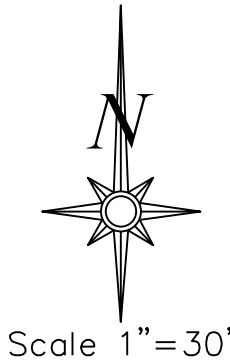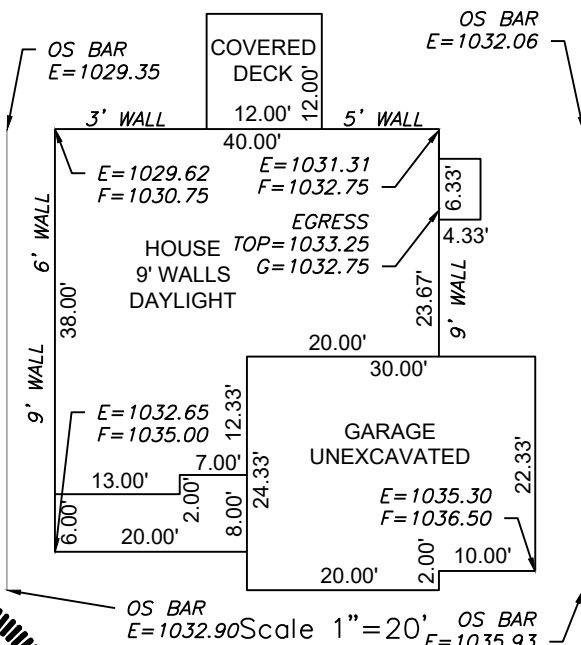


LOT INFORMATION

9125 SQ. FT.
MBOE = 1032.03 (RIGHT)
MBOE=1028.94 (LEFT)
MSFE =1025.36
ADDRESS
1504 SW SUGAR TREE DRIVE

LEGAL DESCRIPTION

LOT 33, HAWTHORN RIDGE 1ST PLAT, A SUBDIVISION AS RECORDED IN LEE'S SUMMIT, JACKSON COUNTY, MISSOURI.

ENGINEERING SOLUTIONS
ENGINEERING & SURVEYING
50 SE 30TH STREET
LEE'S SUMMIT, MO 64082
P(816) 623-9888 F(816)623-9849
WWW.ENGINEERINGSOLUTIONSKC.COM

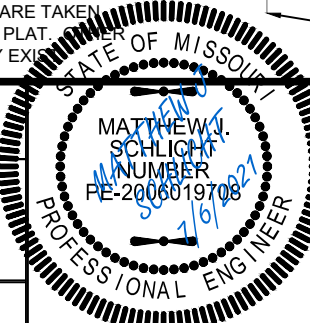

AS-GRADED PLOT PLAN - LOT 33

HAWTHORN RIDGE 1ST PLAT
LEE'S SUMMIT, JACKSON COUNTY, MISSOURI

SUMMIT HOMES
120 SE 30TH STREET
LEE'S SUMMIT, MO 64082

PROJECT NO.	FILE NAME	DATE	SHEET	OF
1	LOT 33 & 34, HAWTHORN RIDGE	7/17/20	1	1

THIS DRAWING IS NOT VALID UNLESS THE SIGNATURE, DATE AND SEAL OF THE ENGINEER WHO SUPERVISED THE PREPARATION OF THIS DRAWING HAS BEEN AFFIXED HERETO.